# ADDENDUM NO. 4

**June 11, 2021** 

# HANOVER COMMUNITY SCHOOL CORPORATION - NEW RESOURCE CENTER AND RELATED WORK

Cedar Lake, IN 46303

### TO: ALL BIDDERS OF RECORD

This Addendum forms a part of and modifies the Bidding Requirements, Contract Forms, Contract Conditions, the Specifications, and the Drawings dated May 17, 2021 by Gibraltar Design. Acknowledge receipt of the Addendum in the space provided on the Bid Form. Failure to do so may subject the Bidder to disqualification.

This Addendum consists of pages ADD 4-1 through ADD 4-3 and attached Addendum No. 4 from Gibraltar Design dated June 11, 2021 and consisting of 7 pages, Specification Section 11 11 44 - Maintenance and Mechanics Equipment, Specification Section 08 11 13 - Standard Steel Doors and Frames, and 46 Drawing Sheets.

# A. SPECIFICATION SECTION 00 00 10 - TABLE OF CONTENTS

#### 1. **Add:**

Specification Section 11 11 44 - Maintenance and Mechanics Equipment

### 2. Replace:

Specification Section 08 11 13 - Standard Steel Doors and Frames

### A. SPECIFICATION SECTION 01 12 00 - MULTIPLE CONTRACT SUMMARY

# 1. <u>BID CATEGORY NO. 1 - SITEWORK/UTILITES/PAVING</u>

#### a. Revise:

#### Clarification No. 10

The **Bid Category No. 1 Contractor** is responsible to provide all earthwork required for their scope of work including establishing the building pad extended to 5' around the building perimeter to within 12" below the finished floor elevation at slab type "A" and 10" below the finished floor elevation at slab type "B". The **Bid Category No. 2 Contractor** is responsible to provide excavation and backfill required to provide foundations, structural and architectural work including thickened slabs, recessed/raised slabs on grade, etc. from these elevations. The **Bid Category No. 2 Contractor** shall stockpile excavation spoils at agreed upon areas outside the building footprint for re-use or hauling off-site by the Upper Elementary School Site Contractor.

#### b. Add:

#### Clarification No. 14

Reference Drawings Sheet C-1.1; All mass excavation and grading was provided by a previous package to an elevation of 749.5. The **Bid Category No. 1 Contractor** shall verify all grades as required for their respective scope of work.

### 2. <u>BID CATEGORY NO. 2 - GENERAL TRADES</u>

#### a. Revise:

#### Clarification No. 6

The **Bid Category No. 1 Contractor** is responsible to provide all earthwork required for their scope of work including establishing the building pad extended to 5' around the building perimeter to within 12" below the finished floor elevation at slab type "A" and 10" below the finished floor elevation at slab type "B". The **Bid Category No. 2 Contractor** is responsible to provide excavation and backfill required to provide foundations, structural and architectural work including thickened slabs, recessed/raised slabs on grade, etc. from these elevations. The **Bid Category No. 2 Contractor** shall stockpile excavation spoils at agreed upon areas outside the building footprint for re-use or hauling off-site by the Upper Elementary School Site Contractor.

### b. Add:

Specification Section 11 11 44 - Maintenance and Mechanics Equipment

#### Clarification No. 14

Reference Specification Section 11 11 44 Maintenance and Mechanics Equipment; All compressors under this section shall be provided by The **Bid Category No. 9 Contractor.** The **Bid Category No. 9 and 10 Contractors** shall make final connections as required. All remaining requirements under this section shall be provided by the **Bid Category No. 2 Contractor.** 

#### Clarification No. 15

The **Bid Category No. 2 Contractor** shall provide all ancillary components and work that may not be shown on the documents but is required by the bus wash manufacturer to provide a complete and fully operational system. All equipment labeled as "by bus wash manufacturer" is to be provided by the **Bid Category No. 2 Contractor**.

#### 3. BID CATEGORY NO. 9 - MECHANICAL

#### a. Add:

#### Clarification No. 5

Reference Specification Section 11 11 44 Maintenance and Mechanics Equipment; All compressors under this section shall be provided by The **Bid Category No. 9 Contractor.** The **Bid Category No. 9 and 10 Contractors** shall make final connections as required. All remaining requirements under this section shall be provided by the **Bid Category No. 2 Contractor.** 

#### 4. BID CATEGORY NO. 10 - ELECTRICAL

#### a. Add:

#### Clarification No. 7

Reference Specification Section 11 11 44 Maintenance and Mechanics Equipment; All compressors under this section shall be provided by The **Bid Category No. 9 Contractor.** The **Bid Category No. 9 and 10 Contractors** shall make final connections as required. All remaining requirements under this section shall be provided by the **Bid Category No. 2 Contractor.** 



### ADDENDUM FOUR

**Addendum Four (AD.04)** to the drawings and specifications prepared by Gibraltar Design and The Skillman Corporation for **Hanover CSC New Resource Center and Related Work** for Hanover Community School Corporation, Cedar Lake, Indiana.

All Contractors bidding on this project shall read all of the items covered below and shall comply with all of the requirements as set forth, including any necessary refinements or additions generated by this Addendum and required by the intent of the original BID CATEGORY NO. Documents. All Contractors shall acknowledge on their bid form that they have received this Addendum, Addendum One, Addendum Two, and Addendum Three, and include the appropriate content of same within their bid proposal.

# **SPECIFICATIONS**

- 1. Specification Section 00 01 00 Table of Contents
  - A. Add new Specification Sections as follows:
    - 1. 11 11 44 Maintenance and Mechanics Equipment
- 2. Specification Section 04 20 00 Unit Masonry
  - A. Revise Paragraph 2.6 A.3 to read:
    - "3. Products:
    - a. Type "A": Belden 481-483 Velour, 4"X4"X12", utility.
    - b. Type "B": Not Used.
    - c. Type "C": Glen-Gery/Sioux City, Dekota Velour, 4"X4"x12", utility.
    - d. Type "D": Glen-Gery/Sioux City, Kodiac Velour, 4" X4" X12", utility."
- 3. Specification Section 08 11 13 Standard Steel Doors and Frames
  - A. Substitute New Specification Section 08 11 13, Standard Steel Doors and Frames, included in this addendum. Note added door panel information.
- 4. Specification Section 08 71 00 Door Hardware
  - A. Hardware Group No. 24 Remove narration stating "Operation: Pressing either actuator will cycle automatic operator and momentarily open door."
- 5. Specification Section 10 14 00 Signage
  - A. Add new Paragraph 2.1A.3. as follows:
    - "3. Letter/Number size is 12-inches high, cut aluminum plate, with minimum of 3-studs for anchoring to substrate, baked enamel finish. Color to be selected from manufacturers standard colors.
  - B. Add to Paragraph 2.1.B. just after the word 'Provide' the following: "cut Aluminum Letters....."
  - C. Delete Paragraph 2.1.B.1. in its entirety, adjust other numbers accordingly.
  - D. Add new Paragraph 2.D.1. as follows:



"1. Letter/Number size is to be 8-inches high, white vinyl, for text and number refer to front sheet for address of complex."

#### 6. Specification Section 11 11 26 Vehicle Wash System

- A. Add Paragraph 2.2. B. and 2.2. C. to read:
  - "B. Ross & White Company, Cary, Illinois.
  - C. InterClean Equipment, LLC, Ypsilanti, Michigan."
- B. Add new Paragraph 2.4. as follows:
  - "2.4. Accessories
    - A. Vehicle Wash System Supplier to provide the following equipment sized as required for complete system operation:
      - 1. Air Compressor System, Air Compressor Control Panel and all support equipment as required for complete operational system.
      - 2. Water Softener System: Provide Size of water softener unit to operate with once-a-week refilling of unit for minimum forty (40) washing of buses each week for operation of the system.
      - 3. Water Heater Unit: Provide a water heater unit sized for full system operation and for duration of standard daily operations for a facility of this size.
      - 4. Water Pump: Provide a water pump unit sized for full system operation and for duration of standard daily operations for a facility of this size."
- C. Clarification: Piping to be utilized in Bus Wash System is required to be Copper as specified in Construction Documents

#### 7. Specification Section 11 11 33 In-Ground Vehicle Lifts

- A. Add Paragraph 2.4. A. 3. and 2.4. A.4. to read:
  - "3. Control: Provide wire and remote-control operators.
  - 4. Size: Twenty-Four (24) Feet."
- B. Revise Paragraph 2.4. B. 1. to read:
  - "1. Provide Two-Post Configuration #FD2343 with addition of AK-HTA70-2PK Adaptor Kit."

#### 8. Specification Section 11 11 44 Maintenance and Mechanics Equipment

A. Add Specification Section 11 11 44, Maintenance and Mechanics Equipment, included in this Addendum, to the Project Manual.

### 9. Specification Section 13 33 00 Pre-Engineered Metal Canopies

- A. Add Paragraph 2.1 B. to read:
  - "B. TFC Canopy, Garrett, Indiana."

# 10. Specification Section 13 34 19 Canopies

- A. Paragraph 1.1 A.: Add "Light Fixtures" directly after "...metal roof".
- B. Add Paragraph 2.2 C. to read:
  - "C. Light Fixtures: Canopy manufacturer's standard 2X2 LED fixtures, total 8 fixtures centered over bus pathway, equally spaced."
- C. Add Paragraph 2.3 C.2 to read:



- "2. Painted Finish: Provide for three (3) colors for fascia, fascia trim and soffit panels either in fluorocarbon or baked enamel paint, as selected by Architect from manufacturer's standard colors."
- D. Paragraph 3.2 L.: Add second sentence to paragraph to read: "Contractor is to run conduit and wiring to connect power to canopy manufacturer's light fixtures."

#### 11. Specification Section 13 34 19 Pre-Engineered Buildings

- A. Add Paragraphs 2.1 A.6 and 2.1 A.7 to read:
  - "6. Schulte Building Systems, Hockley, Texas.
  - 7. CECO Building Systems, Tremont, Illinois."

#### 12. Specification Section 13 33 00 Pre-Engineered Metal Canopies

- A. Add Paragraph 2.1 B. to read:
  - "B. TFC Canopy, Garrett, Indiana."

#### 13. Specification Section 22 05 00 Plumbing General Conditions

- A. Add Paragraph 2.19 Compressed Air Piping to read:
  - "A. Compressed air piping shall be Schedule 40, Steel Pipe conforming to ASTM A53/A53M, Type E or S, Grade B, back or hot dip zinc coated with ends threaded according to ASME B1.20.1.
  - Compressed Air Fittings:
    - a. Steel Nipples: ASTM A733, made of ASTM A53/A53M or ASTM A106, Schedule 40,galvanized seamless steel pipe. Include ends matching joining method.
    - b. Malleable-Iron Fittings: ASME B16.3, Class 150 or 300, threaded.
    - c. Malleable-Iron Unions: ASME B16.39, Class 150 or 300, threaded.
    - d. Steel Flanges: ASME B16.5, Class 150 or 300, carbon steel, threaded.
    - e. Wrought-Steel Butt-Welding Fittings: ASME B16.9, Schedule 40.
    - f. Steel Flanges: ASME B16.5, Class 150 or 300, carbon steel."

#### 14. Specification Section 23 88 00 Ductwork

- A. Paragraph 2.4 D.1: Change ductwork lining thickness to 1-1/2".
- 15. Specification Section 26 06 30 Standby Power Generator System
  - A. Section 10.3 C.: Add Generac to list of acceptable manufacturers.

# **DRAWINGS**

#### 16. Sheet C-2.1

- A. Refer to revised, full size drawing included in this Addendum for the following revisions:
  - 1. Proposed flagpole on a 10'X10' concrete with two lights. Coordinate lighting with MEP plans.
    - a. Fuel depot location is revised.
    - b. Removed radii of pavement at the bus rolling gate entrance.

Gibraltar Design Project No.: 20-141

#### 17. Sheet C-3.1

- A. Refer to revised, full size drawing included in this Addendum for the following revisions:
  - 1. Along the south line of the property, the water line of 400'-8" DIWM CL 52 is corrected to 400'-10" DIWM CL 52.

#### 18. Sheet C-4.1

- A. Refer to revised, full size drawing included in this Addendum for the following revisions:
  - 1. Two (2) manholes, MH #44A and MH 44#B are added along the 12" RCP storm line, south of the Administration Center.

### 19. Sheet C-6.0

- A. Refer to revised, full size drawing included in this Addendum for the following revisions:
  - 1. Fuel Depot Detail is added.

#### 20. Sheet S-001

- A. Refer to revised, full size drawing included in this Addendum for the following revisions:
  - 1. Information added to the "Structural Legend" F 2", 20 Gauge composite galvanized metal floor deck and direction of span. (Two or more span loading condition).
  - 2. Lintel Schedule added to identify all brick lintels required for the Resource Center building.

#### 21. Sheet SB102

- A. Refer to revised, full size drawing included in this Addendum for the following revisions:
  - 1. Revised foundation section cut from 12/S-301 to 16/S-302; noting the foundation for buildings B & C only need be 8" CMU full grouted versus 14" CMU.

#### 22. Sheet SB103

A. Refer to revised, full size drawing included in this Addendum for added column piers and footing pads at grids 6 & 7/H.

#### 23. Sheet S-301

A. On Detail Cut 17/S-301 the pier size is identified on the drawing by showing a section through the pier near the top and refer to 15A/S-301. Therefore, along the PEMB typical framed bay 17/S-301 is used and along end bays 16/S-301 is required (See Plans

#### 24. Sheet S-302

A. Refer to revised, full size drawing included in this Addendum for added Detail 16/S-302 that shows 8" CW fully grouted foundation wall on footing.

#### 25. Sheets A-101

A. Refer to A-102 for correct wall types.

#### 26. Sheets A-102, A-103, A-104, A-105

A. Refer to Four (4) revised, full size drawings included in this Addendum for revisions.

#### 27. Sheet A-109

A. Refer to revised, full size drawing included in this Addendum for revisions.



#### 28. Sheet A-405

A. Refer to revised, full size drawing included in this Addendum for revisions.

#### 29. Sheet A-410

A. All soldier course to be 12" high in lieu of 8". Limestone windowsill on section 1/A-410 is to increase in height, refer to detail 1 on A-603 for dimensions.

#### 30. Sheet A-602

A. Refer to revised, full size drawing included in this Addendum for revisions.

#### 31. Sheet A-603

A. Refer to revised, full size drawing included in this Addendum for revisions.

#### 32. Sheet A-701

A. Refer to revised, full size drawing included in this Addendum for revisions.

#### 33. Sheet A-705

A. Refer to revised, full size drawing included in this Addendum for revisions.

#### 34. Sheet A-804

A. Refer to revised, full size drawing included in this Addendum for revisions.

#### 35. Sheet A-810

A. Refer to revised, full size drawing included in this Addendum for revisions.

#### 36. Sheet A-830

A. Refer to revised, full size drawing included in this Addendum for revisions.

#### 37. Sheet A-904

A. Refer to revised, full size drawing included in this Addendum for revisions.

#### 38. Sheet M-101

- A. Refer to revised, full size drawing included in this Addendum for the following revisions:
  - 1. Add base bid note to UH-12 and UH-13

#### 39. Sheet M-104

- A. Refer to revised, full size drawing included in this Addendum for the following revisions:
  - 1. Add base bid note to UH-12 and UH-13

#### 40. Sheet M-601

- A. Refer to revised, full size drawing included in this Addendum for the following revisions:
  - 1. Adjust remarks for resource center mechanical equipment schedule.

#### 41. Sheet M-602

- A. Refer to revised, full size drawing included in this Addendum for the following revisions:
  - 1. Adjusted heat recovery schedule.

#### 42. Sheet M-603

- A. Refer to revised, full size drawing included in this Addendum for the following revisions:
  - 1. Added emergency generator to Resource Center gas schedule



#### 43. Sheet P-001

- A. Refer to revised, full size drawing included in this Addendum for the following revisions to Plumbing Fixture and Equipment Schedule:
  - 1. Revised Sinks S-1 and S-2 model numbers.
  - 2. Remove WS-1 from equipment schedule.

#### 44. Sheet P-102

- A. Refer to revised, full size drawing included in this Addendum for the following revisions:
  - 1. Revised OS-2 symbol.

#### 45. Sheet P-103

- A. Refer to revised, full size drawing included in this Addendum for the following revisions:
  - 1. Remove WS-1 from equipment schedule.

#### 46. Sheet P-111

- A. Refer to revised, full size drawing included in this Addendum for the following revisions:
  - 1. Clarified length of trench drains in garage.
  - 2. Added domestic water piping in bus wash bay.
  - 3. Revised size of cold water piping to bus wash equipment.

### 47. Sheet P-112

- A. Refer to revised, full size drawing included in this Addendum for the following revisions:
  - 1. Revised symbol for OS-2.

#### 48. Sheet P-113

- A. Refer to revised, full size drawing included in this Addendum for the following revisions:
  - 1. Revised symbol for OS-1.

#### 49. Sheet P-502

- A. Refer to revised, full size drawing included in this Addendum for the following revisions:
  - 1. Revised domestic water pipe size to bus wash bay.

#### 50. Sheet E-002

- A. Refer to revised, full size drawing included in this Addendum for the following revisions:
  - 1. Added two flagpole lights.
  - 2. Revised sheet notes and general notes.
  - 3. Added/revised fuel pump station electrical components (associated panel schedules have been updated).

#### 51. Sheet EL-101 through EL-104

- A. Refer to (4) four revised, full size drawings included in this Addendum for the following revisions:
  - 1. Revised general note #3 to remove the reference to UL924 devices and include inverters or integral batteries.

#### 52. Sheet EP-103

A. Refer to revised, full size drawing included in this Addendum for the following revisions:



- 1. Added General Note #5 for bus lift coordination.
- 2. Revised Sheet Note #4 to refer to technology drawings for conduit information.

#### 53. Sheet EP-104

- A. Refer to revised, full size drawing included in this Addendum for the following revisions:
  - 1. Revised Sheet Note #8 to refer to technology drawings for conduit information.

#### 54. Sheet E-502

- A. Refer to revised, full size drawing included in this Addendum for the following revisions:
  - 1. Added flagpole light to luminaire schedule.

#### 55. Sheet E-505

- A. Refer to revised, full size drawing included in this Addendum for the following revisions:
  - 1. Added flood light detail.

#### 56. Sheet TS-001

- A. Refer to revised, full size drawing included in this Addendum for the following revisions:
  - 1. Location of the Middle connection.
  - 2. Rerouted conduits.

#### 57. Sheet T-101

- A. Refer to revised, full size drawing included in this Addendum for the following revisions:
  - 1. Addition of Plan Note 1 for overhead door controller.
  - 2. Addition of Card Reader for man door to A112.

#### 58. Sheet T-104

- A. Refer to revised, full size drawing included in this Addendum for the following revisions:
  - 1. Omit Card Reader for Door D-106b.
  - 2. Omit Card Reader for Door D-134b.
  - 3. Relocation of Card Reader for Door D-131a.

Pages 1 through 7, inclusive, Two Specification Sections, 08 11 13 and 11 11 44, and Fortysix (46) full size drawings constitute the total makeup of **Addendum Four**.



Y:\20-141 Hanover CSC - New Resource Center\Specs\Addendum #4\AD04.doc



# SECTION 08 11 13 STANDARD STEEL DOORS AND FRAMES

#### 1 General

#### 1.1 Section Includes

A. Steel doors, panels, and frames.

#### 1.2 Related Sections

- A. Section 08 14 16 Wood Doors.
- B. Section 08 71 00 Door Hardware.
- C. Section 08 81 00 Glazing.
- D. Section 09 91 00 Painting: Field painting of doors and frames.

#### 1.3 References

- A. ANSI A250.8 SDI-100. Standard Steel Doors and Frames.
- B. ANSI A250.11 Erection Instructions for Steel Frames.
- C. ASTM A366 Steel, Sheet, Carbon, Cold-Rolled, Commercial Quality.
- D. ASTM A568 Steel, Sheet, Carbon, and High-Strength, Low-Alloy, Hot-Rolled and Cold-Rolled, General Requirements.
- E. ASTM A569 Steel, Carbon (0.25 Maximum Percent), Hot-Rolled Sheet and Strip Commercial Quality.
- F. ASTM A620 Steel Sheet, Carbon, Cold-Rolled Drawing Quality, Special Killed.
- G. ASTM A653 Steel Sheet, Zinc-Coated (Galvanized) or Zinc-Iron Alloy-Coated (Galvannealed) by the Hot-Dip Process.
- H. ASTM A924 General Requirements for Steel Sheet, Metallic-Coated by the Hot-Dip Process.
- I. DHI Door Hardware Institute: The Installation of Commercial Steel Doors and Steel Frames, Insulated Steel Doors in Wood Frames and Builder's Hardware.

### 1.4 Regulatory Requirements

A. Conform to applicable code for fire rated frames and doors.



#### 1.5 Submittals

- A. Submit shop drawings, product data, and manufacturer's installation instructions under provisions of Division 1.
  - 1. Indicate frame configuration, anchor types and spacings, location of cutouts for hardware, reinforcement, and finish.
  - 2. Indicate door elevations, internal reinforcement, closure method, and cut outs for glazing.

### 1.6 Quality Assurance

A. Conform to requirements of ANSI A250.8

# 1.7 Delivery, Storage, And Protection

- A. Protect products under provisions of Division 1.
- B. Protect doors and frames with resilient packaging.

### 2 Products

# 2.1 Standard Steel Doors and Frames - Acceptable Manufacturers

- A. Ceco Door Division, Oak Brook, Illinois.
- B. Curries, Mason City, Iowa.
- C. Deansteel Manufacturing Inc., San Antonio, Texas.
- D. Metal Products, Inc., Corbin, Kentucky.
- E. Republic Builders Products Corporation, Jackson, Tennessee.
- F. Steelcraft, Cincinnati, Ohio.

#### 2.2 Materials

- A. Steel:
  - Doors and Frames: Commercial quality, stretcher leveled flatness, cold rolled steel, ASTM A366 or ASTM A620 and A568 general requirements or Ggalvanized steel sheet, ASTM A924 or A653 hot dip galvanized to A60 minimum coating weight standard.
  - 2. Internal Reinforcing: Hot rolled pickled and oiled steel, ASTM A569.

#### 2.3 Doors And Frames

- A. Interior Doors: ANSI A250.8, Level III (Extra Heavy Duty), Model 2 (Seamless); 16 gage minimum thickness.
- B. Interior Frames: 16 gage thick material.



#### 2.4 Door Core

A. Interior Doors: Impregnated cardboard honeycomb for interior doors.

#### 2.5 Accessories

- A. Jamb Anchors: Stirrup and strap type.
- B. Glazing Stops: Rolled steel channel shape, mitered corners; prepared for countersunk style screws.

### 2.6 Protective Coatings

- A. Bituminous Coating: As recommended by the manufacturer.
  - 1. Touch up damaged areas in the field.
- B. Primer: As recommended by the manufacturer.
  - 1. Touch up damaged areas in the field.

#### 2.7 Fabrication

- A. Fabricate frames as welded unit for knock down field assembly type.
  - 1. Grind all welds smooth.
  - 2. Verify throat opening and wall thickness prior to fabrication.
  - 3. Omit stops at transoms to receive louvers.
- B. Fabricate doors to 1 3/4 inches in thickness.
- C. Frabricate all exterior door leafs with solid welded cap flush with edge of door to prevent water from ponding on top of door leaf.
- D. Fabricate transom panels same as doors.
- E. Fabricate frames and doors with hardware reinforcement plates welded in place.
  - 1. Frames:
    - a. Hinges: Minimum 7 gage by 1-1/4 inches by 10 inches long.
    - b. Strike: Minimum 12 gage.
    - c. Flush Bolts: Minimum 12 gage.
    - d. Closers: Minimum 12 gage.
    - e. All Other Surface Mounted Hardware: Minimum 12 gage.
  - 2. Doors:
    - a. Hinges: Minimum 7 gage.



- b. Lock Face and Flush Bolts: Minimum 14 gage.
- c. All Other Surface Mounted Hardware: Minimum 16 gage.
- 3. Provide mortar guard boxes.
- F. Prepare interior frames for silencers.
  - 1. Provide three single rubber silencers for single doors on strike side.
  - 2. Provide two single silencers on frame head at double doors.
- G. Reinforce frames wider than 48 inches with roll formed steel channels fitted tightly into frame head, flush with top.
- H. Attach fire rating label to each frame and door unit where required.
- I. Close top edge of exterior door flush with inverted steel channel closure.
  - 1. Weld in place.
  - 2. Seal joints watertight.
- J. Provide junction boxes in all exterior door frames and in interior door frames specifically noted on the Drawings to receive electric or electronic hardware.
  - 1. Provide a junction box at the center hinge mounting location in the hinge jamb, the lock jamb behind the box strike, and 1/3 of the way from the latch side at the head.
  - 2. Verify locations with the hardware supplier.

#### 2.8 Finish

- A. Primer: Baked on.
- B. At frames installed in masonry, coat inside of frame profile in masonry with bituminous coating to a minimum thickness of 1/16 inch.
  - 1. Coating may be shop or field applied.

### 3 Execution

#### 3.1 Installation

- A. Install frames in accordance with ANSI A250.11.
- B. Install doors in accordance with DHI.
- C. Coordinate with wall construction for anchor placement.
- D. Install roll formed steel reinforcement channels between two abutting frames. Anchor to structure and floor.
- E. Coordinate installation of glass and glazing.



- 1. Install glazing beads on corridor side of frame where possible.
- F. Install sound isolating doors in accordance with the manufacturer's recommendations.

#### 3.2 Tolerances

A. Maximum Diagonal Distortion: 1/16 inch measured with straight edge, corner to corner.

# 3.3 Adjusting

A. Adjust hardware for smooth and balanced door movement.

# **END OF SECTION**



# **SECTION 11 11 44**

# MAINTENANCE AND MECHANICAL EQUIPMENT

#### 1 General

#### 1.1 Section Includes

- A. Packaged Storage Units for Operations.
- B. Compressors.

#### 1.2 Submittals

- A. Submit Shop Drawings and Product Data under provisions of Division 1.
- B. Submit manufacturers product and installation instructions under provisions of Division 1.

### 1.3 Delivery, Storage, and Protection

A. Protect Products under provisions of Division 1.

### 2 Products

# 2.1 Equipment

- A. Diesel Exhaust Fluid (DEF) Storage Units: Provide one (1) 330 gallon steel IBC Tote, double layered unit, caged on pallet, is to include compatible hose, dispenser and pump system for full operation.
  - 1. Manufacturers/Suppliers: Innovative Fluids, LLC, The Cary Company, Transtore, Snyder Industries, and Metano.
  - 2. Location: Mechanics Building, verify/coordinate exact location with Owner prior to delivery and installation.
- B. Diesel Coolant Storage Units: Provide one (1) 350 gallon steel IBC Tote, double layered unit, caged on pallet, is to include compatible hose, dispenser and pump system for full operation.
  - 1. Manufacturers/Suppliers: Innovative Fluids, LLC, The Cary Company, Transtore, Snyder Industries, and Metano.
  - 2. Location: Mechanics Building, verify/coordinate exact location with Owner prior to delivery and installation.
- C. Washer Fluid Storage Units: Provide one (1) 350 gallon steel IBC Tote, double layered unit, caged on pallet, is to include compatible hose, dispenser and pump system for full operation.



- 1. Manufacturers/Suppliers: Innovative Fluids, LLC, The Cary Company, Snyder Industries, and Metano.
- 2. Location: Mechanics Building, verify/coordinate exact location with Owner prior to delivery and installation.
- D. Oil Storage and Waste Oil Units: Provide steel tanks, double layered unit, caged on pallet for raising off floor, is to include compatible hose, dispenser and pump system for full operation.
  - 1. Manufacturers/Suppliers: Innovative Fluids, LLC, The Cary Company, Snyder Industries, and Metano.
  - Units Required: One (1) Vertical 500-gallon Container for 15W 40 Oil, One (1) Vertical 350-gallon for 15W 40 Oil, One (1) Vertical 350-gallon for Tranmission Fluid, and One (1) Vertical 330-gallon Waste Oil.
  - 3. Location: Mechanics Building, verify/coordinate exact location with Owner prior to delivery and installation.

# 2.2 Compressors


- A. Air Compressor Units: Provide Two (2) stationairy air-compressor units for the Mechanics Building, coordinate exact location for units with Owner.
  - 1. Size: 120 Gallon Tank.
  - 2. Electrical: 200/240 Volt, 3-Phase.
  - 3. Motor: 10 HP.
  - 4. CFM at Max Pressure: 72 to 75.
  - 5. Max Pressure: 175 PSI.
- B. Manufacturers: Provide from one of the following:
  - 1. Ingersoll Rand.
  - 2. Speedaire Grainger.

#### 3 Execution

#### 3.1 Installation

- A. Install equipment and systems in accordance with Manufacturers specifications and recommendations.
- B. Coordinate all system with other trades and Construction Manager.


### **END OF SECTION**

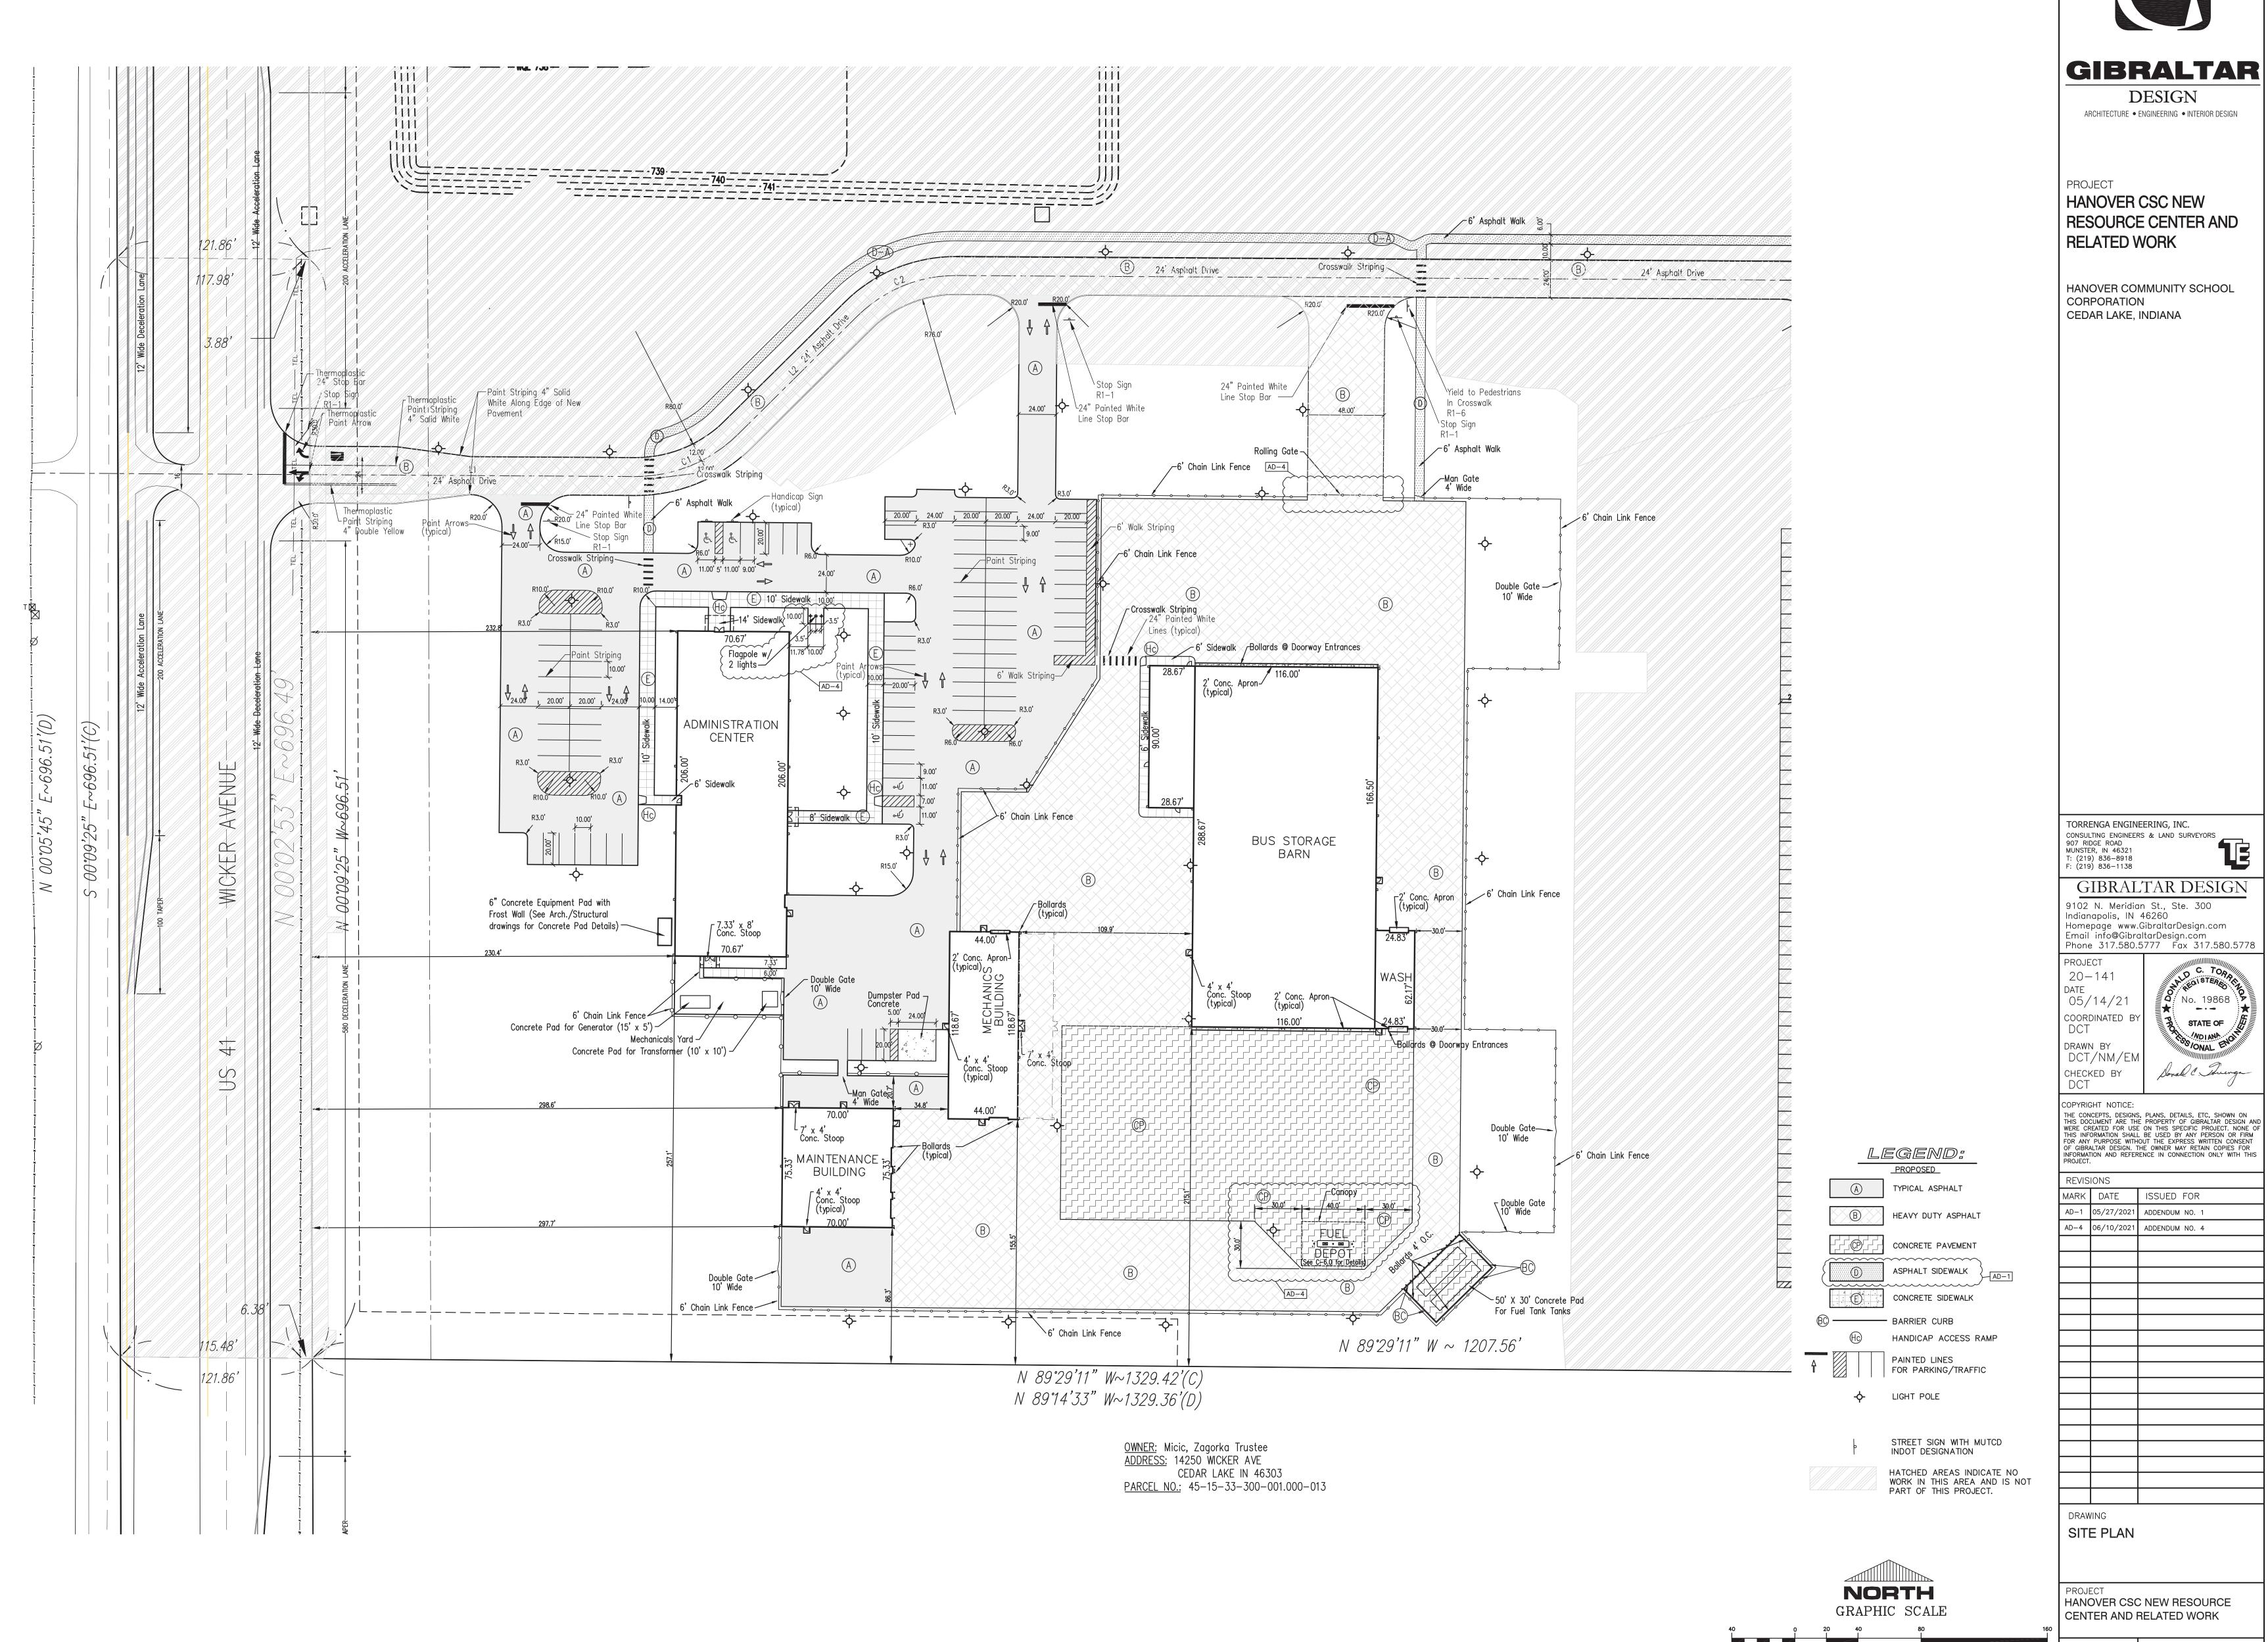

GIBRALTAR DESIGN C-2.1

( IN FEET )

1 inch = 40 ft.

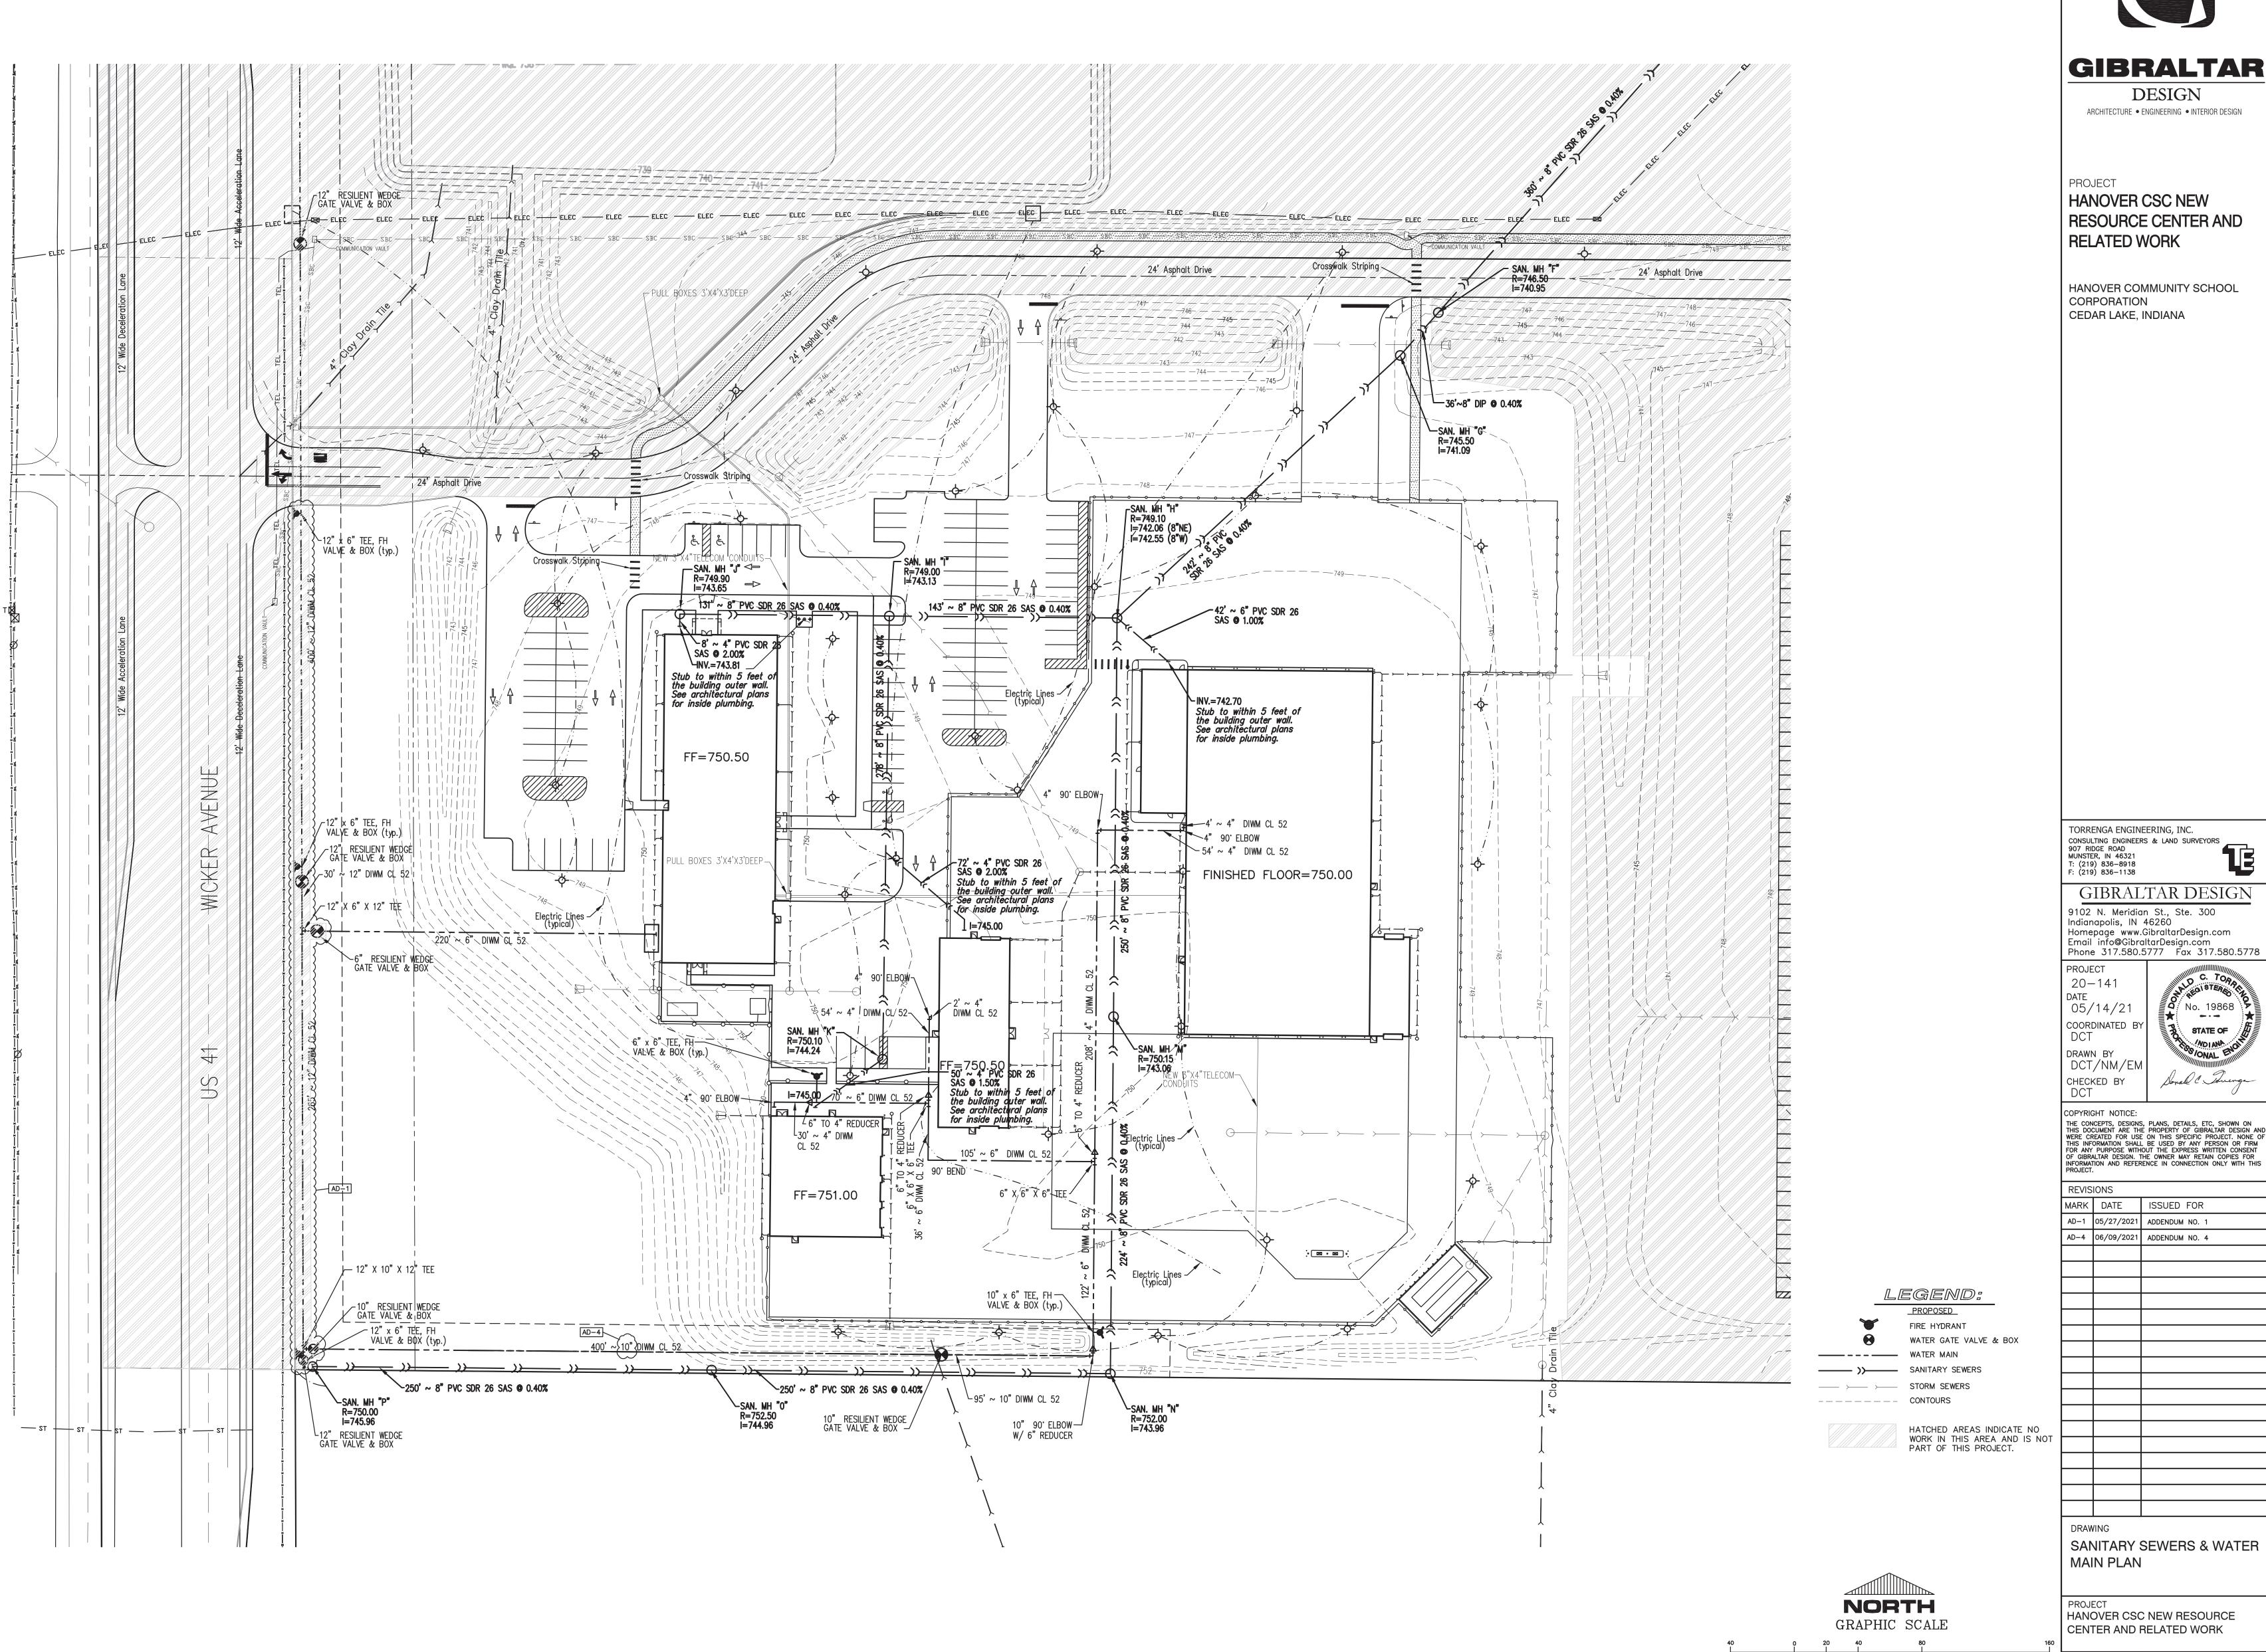

**GIBRALTAR** 

RESOURCE CENTER AND

HANOVER COMMUNITY SCHOOL

GIBRALTAR DESIGN 9102 N. Meridian St., Ste. 300

Donald C. Towerga


THE CONCEPTS, DESIGNS, PLANS, DETAILS, ETC, SHOWN ON THIS DOCUMENT ARE THE PROPERTY OF GIBRALTAR DESIGN AND WERE CREATED FOR USE ON THIS SPECIFIC PROJECT. NONE OF THIS INFORMATION SHALL BE USED BY ANY PERSON OR FIRM FOR ANY PURPOSE WITHOUT THE EXPRESS WRITTEN CONSENT OF GIBRALTAR DESIGN. THE OWNER MAY RETAIN COPIES FOR INFORMATION AND REFERENCE IN CONNECTION ONLY WITH THIS PROJECT.

HANOVER CSC NEW RESOURCE

GIBRALTAR DESIGN SHEET

1 inch = 40 ft.

C-3.1

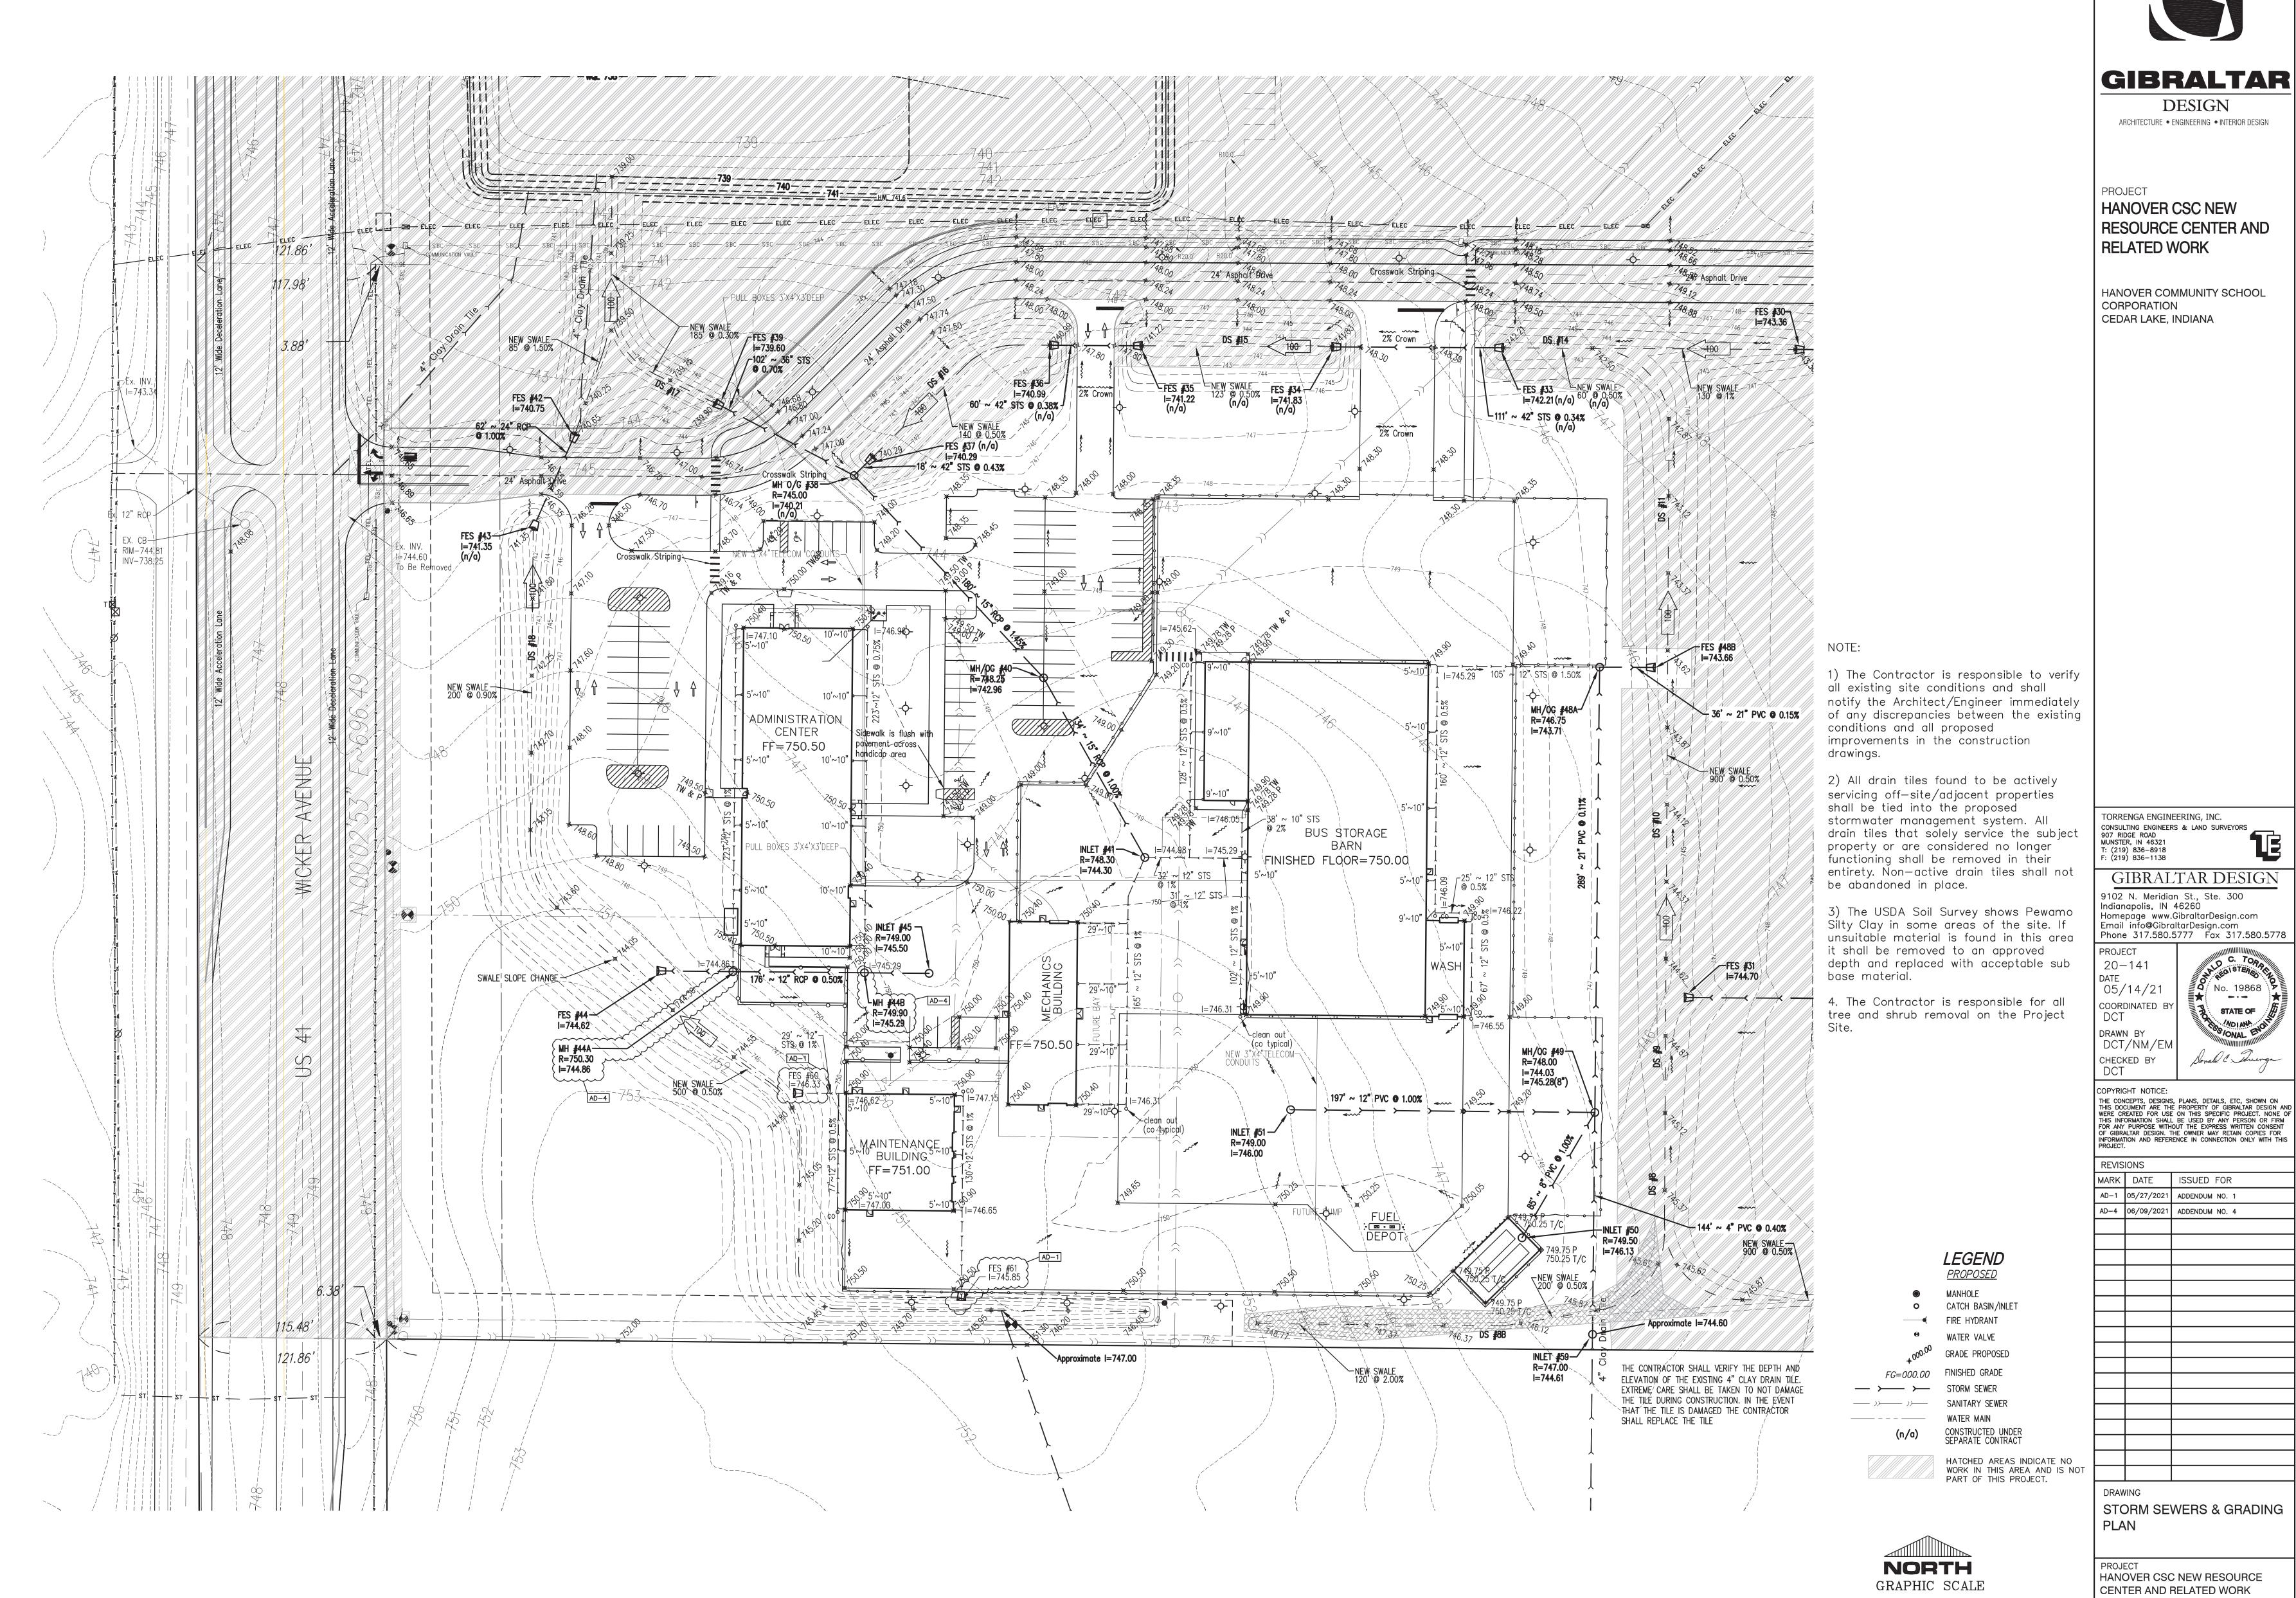



GIBRALTAR DESIGN SHEET


( IN FEET )


1 inch = 40 ft.

C-4.1

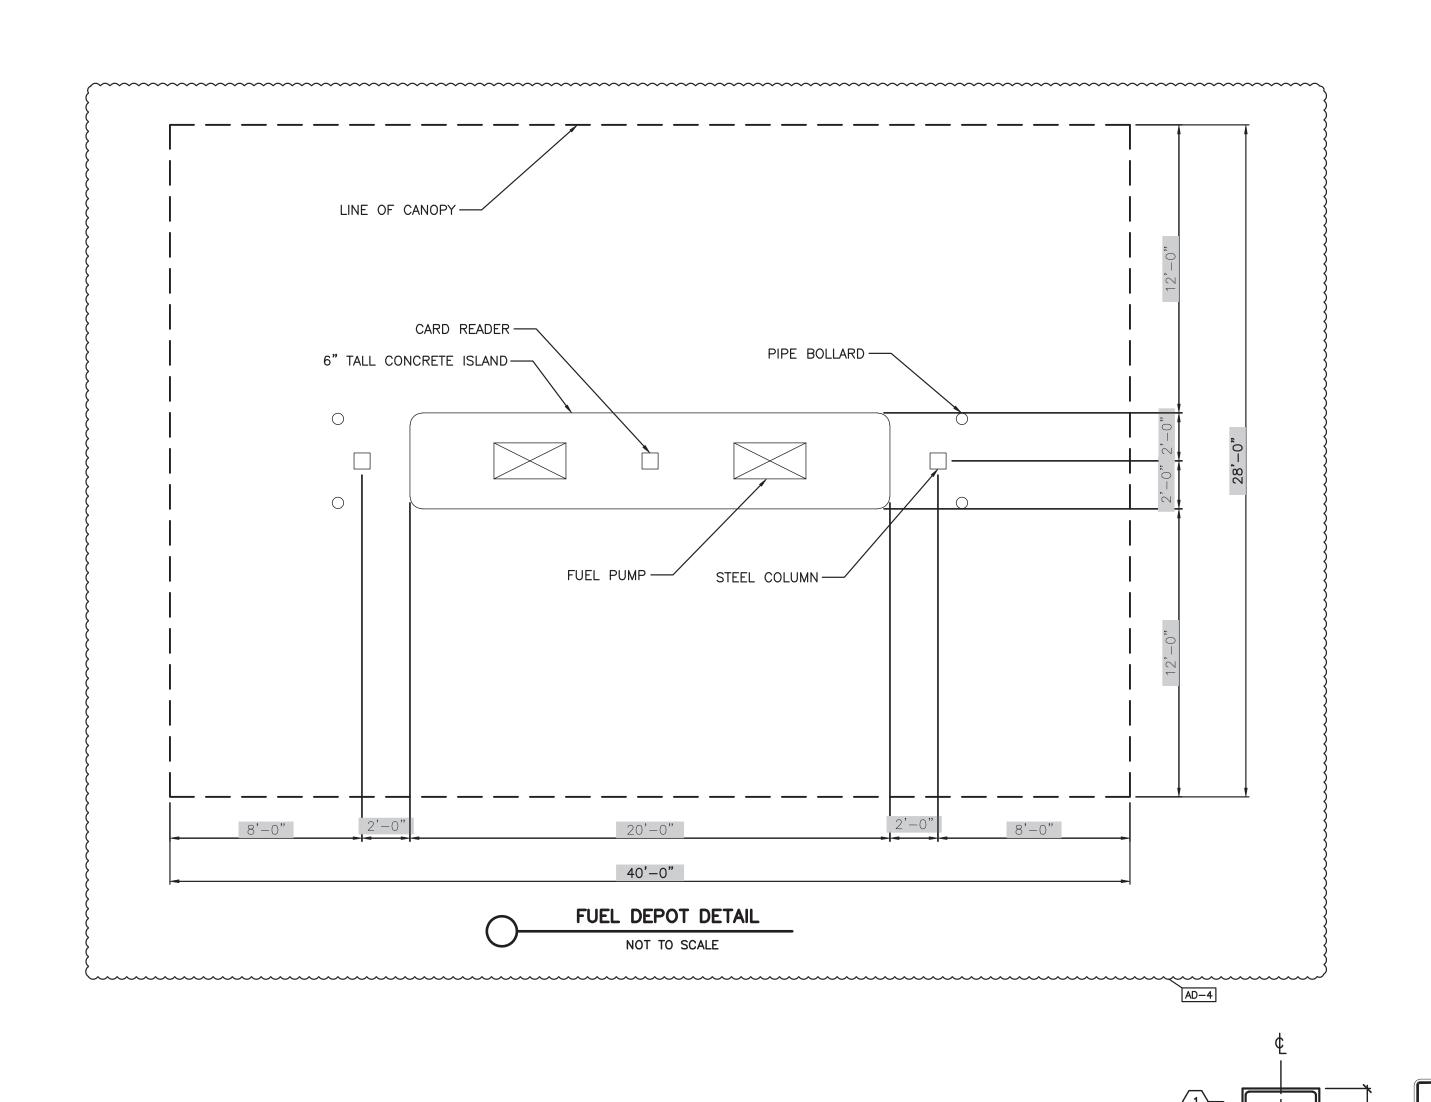

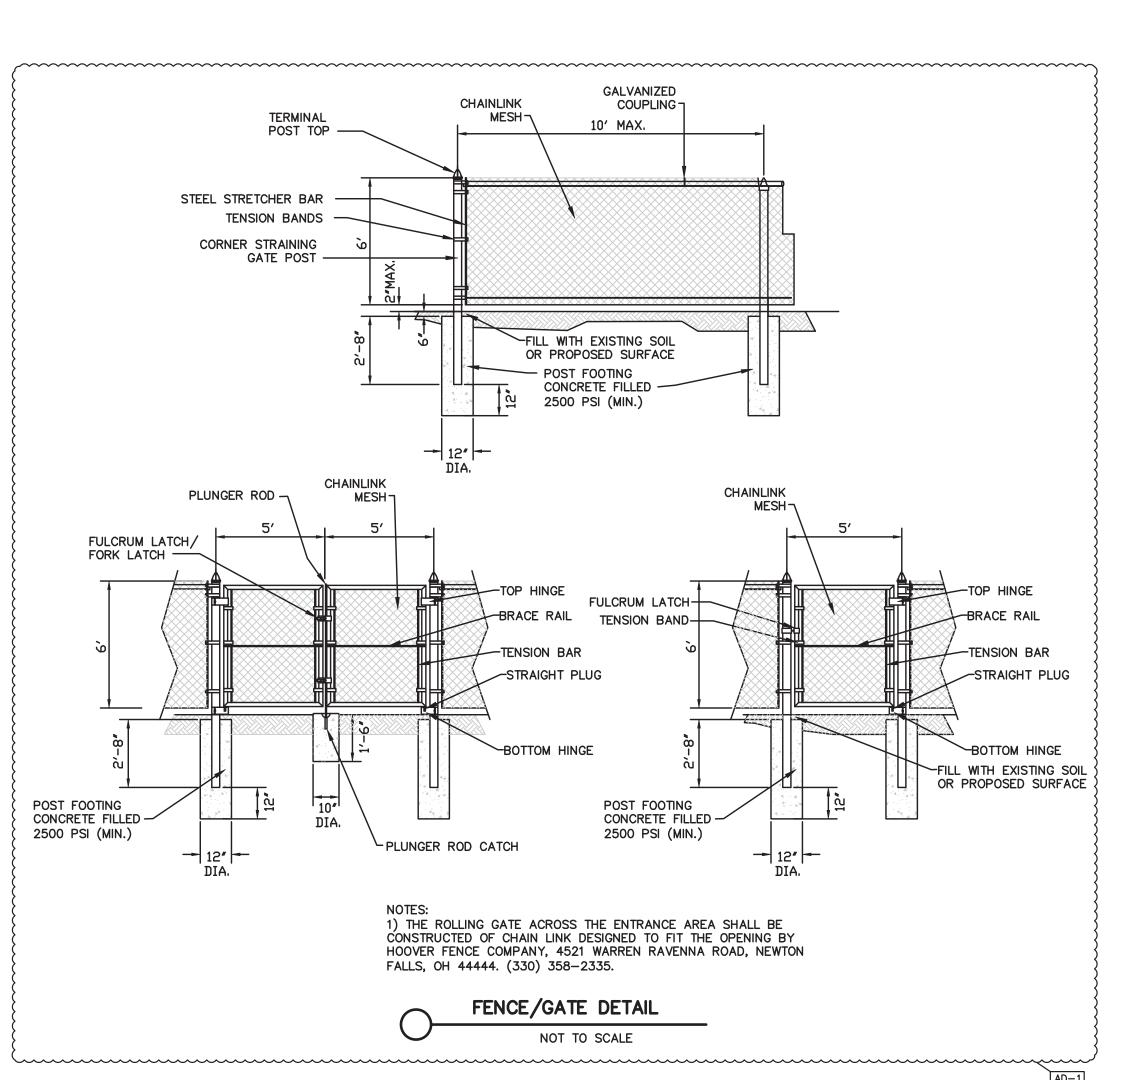


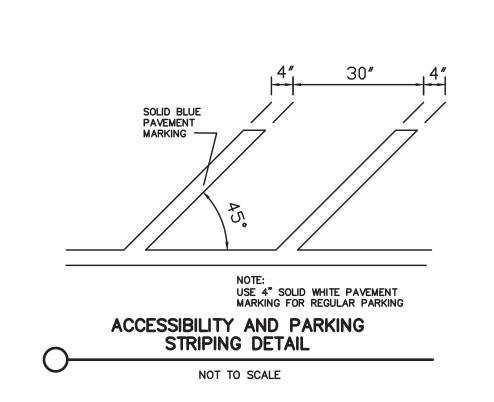

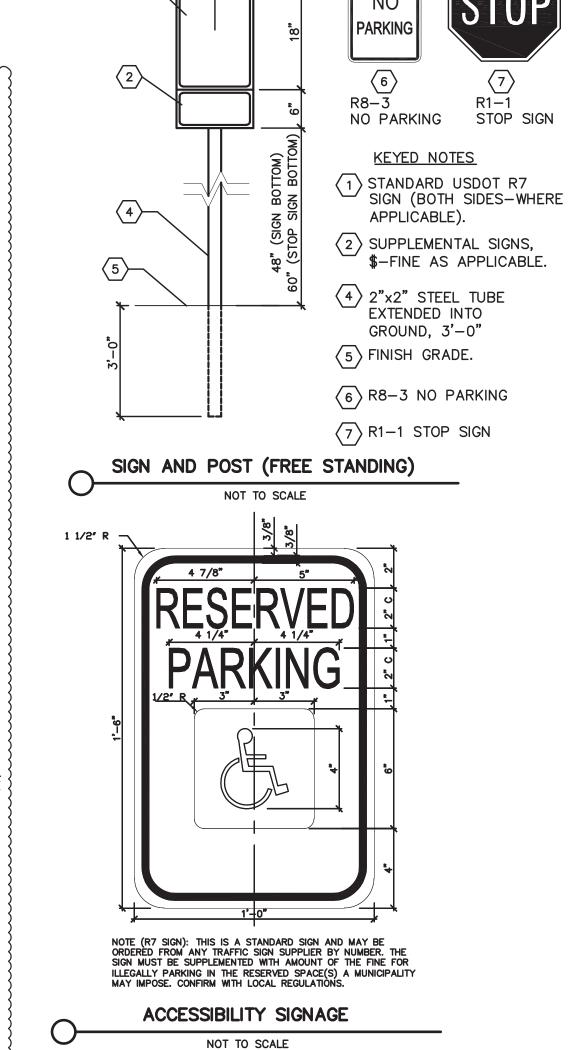




NOT TO SCALE

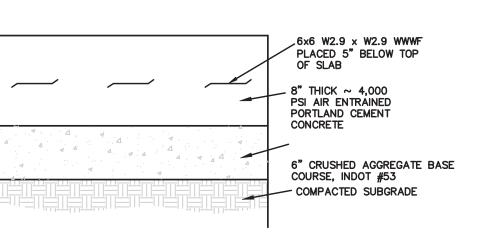


# CONCRETE PAVEMENT SECTION DETAIL NOT TO SCALE

1. WHERE FILL IS REQUIRED, SUBGRADE SHALL BE COMPACTED TO 95% OF THE MAXIMUM DRY DENSITY AS DETERMINED BY ASTM D698 METHOD OF TESTING. 2. THE CONTRACTOR IS RESPONSIBLE FOR CORRECTING ANY PONDING PROBLEMS THAT MAY OCCUR AFTER THE FINAL SURFACE IS LAID.

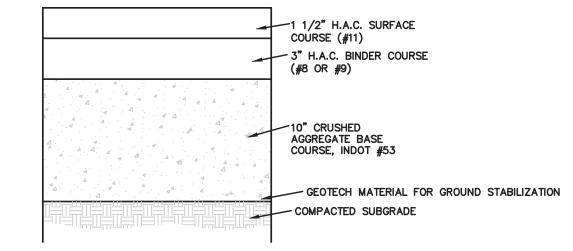


1. WHERE FILL IS REQUIRED, SUBGRADE SHALL BE COMPACTED TO 95% OF THE MAXIMUM DRY DENSITY AS DETERMINED BY ASTM D698 METHOD OF TESTING.

# ASPHALT PAVEMENT SECTION (NO SCALE)

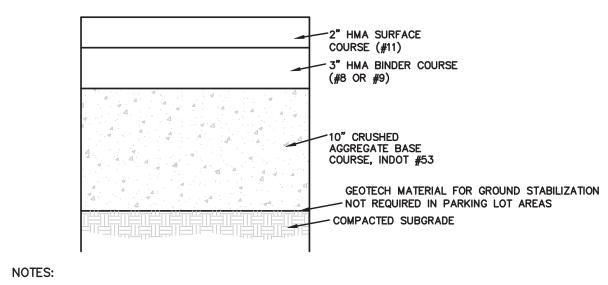

1. WHERE FILL IS REQUIRED, SUBGRADE SHALL BE COMPACTED TO 95% OF THE MAXIMUM DRY DENSITY AS DETERMINED BY ASTM D698 METHOD OF TESTING.

# (PARKING LOT) HEAVY DUTY ASPHALT PAVEMENT SECTION (NO SCALE)

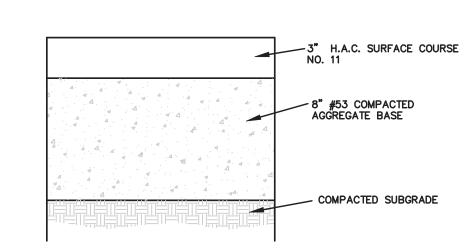

LIGHT DUTY PAVEMENT (PLAY AREA) ASPHALT PAVEMENT SECTION

NOT TO SCALE



//PÁVÉMÉNT/

(SEE DETAIL)

AGGREGATE

BARRIER CURB TYPE D

NOT TO SCALE

DUMPSTER PAD

NOT TO SCALE

1. WHERE FILL IS REQUIRED, SUBGRADE SHALL BE COMPACTED TO 95% OF THE MAXIMUM DRY DENSITY AS DETERMINED BY ASTM D698 METHOD OF TESTING.

2. THE CONTRACTOR IS RESPONSIBLE FOR CORRECTING ANY PONDING PROBLEMS THAT MAY OCCUR AFTER THE

(1) #4 BARS CONT.

TOP & BOTTOM -

STRUCTURE NUMBER	MANHOLE, INLET, CATCH BASIN, OR SPECIALTY STRUCTURE	CASTING TYPE	LENGTH & SLOPE	RIM ELEVATION	INVERT UPSTREAM	INVERT DOWNSTREAM	REMARKS
		Neenah R 1713	Ex. 12" RCP	744.00	730.51	730.45	Connect to EX. 12" RCF
TR #1B	FES		15' 12" PVC @ 0.50%		740.10	740.03	Connect to STR#1
OTR #2	Outlet Structure	Neenah R-1713	Ex. 12" RCP	745.56	740.93 741.00	740.26 740.07	Connect to EX. 12" RCF
TITTED	· =0	N	10 12 1 40 00 0.00 70		7 1 1.00	7 10.07	Connect to STR#2
STR #3	Outlet Structure	Neenah R-1713	17' - 12" RCP @ 0.50%	741.00	736.13	735.97	Connect to FES #4
STR #3B	FES		15' - 12" PVC @ 0.50%		736.80	736.73	Connect to STR#3
CTR #4	FES				735.97		
STR #5	FES				738.00		
STR#6	MH / OC	Necnah R-2561	335' - 36" RCP @ 0.50%	747.00	739.68	738.00	Connect to STR #5
STR #7	FES		15' - 24" RGP @ 1.00%		742.00	741.85	Cennect to STR #6
OTR #0	FEC					744.25	
OTR #9	MH/OG	Neenah R-2561	115' 12" PVC @ 0.50%	747.50	745.04	744.75	Connect to STR #8
STR #10	FES					745.53	
STR #11	FEC					740.25	
OTR #12	FEC		15' 24" RGP @ 1.00%		740.34	740.19	Connect to STR #6
OTR #13	FES					741.19	
STR #14	FES		50' 24" ROP @ 0.70%		741.14	740.79	Connect to STR #13
OTR #15	FES					741.59	
STR #16	MH/OG	Neenah R 2561	15' 24" RGP @ 0.70%	746.00	741.60	741.50	Connect to STR #15
STR #17	MH/ OG	Neenah R 2561	53' 24" RGP @ 0.35%	746.00	742.07	741.89	Cennect to STR #16
	Inlet	Neenah R-2561	72' ~ 12" RCP @ 0.79%	746.00	742.63	742.07	Connect to STR #17
OTR #19	FE8		58' 24" RGP @ 0.32%		742.20	742.07	Connect to STR #17
STR #20	FES					744.00	
OTR #21	MH / 00	Necnah R-2561	188' 12" RCP @ 1.00%	750.00	745.88	744.00	Connect to STR #20
STR #22	FE3					743.49	
STR #23	FES		00' ~ 18" RCP @ 1.00%		744.09	743.49	Connect to STR #22
STR #24	FES					745.55	00111100110 0 11111122
STR #25	FES					745.70	
OTR #26	MIT/OG	Necnah R-2561	178' - 12" ROP @ 0.50%	750.00	746.67	745.70	Connect to GTR #25
OTR #27	FES	Trochari it 2001	001 401 DOD @ 0.700/	7 00.00	745.06	744.50	Connect to CTR #20
STR #28	FES		00 10 100 @ 0.7070		740.00	744.50	Connecte CTT #20
OTR #29	FFC		90' 18" RCP @ 1.00%		744.40	743.36	Connect to STR #30
TD #00			00 - 10 101 (6 1.00%		742.20	740.00	Connect to 311\ #30
OTD #24					1-10.00	744.70	
OTD #22	lalet	Neenah R 2070, Type D	2221 - 42" DCD @ 0 200/	750.50	745 70	744.70	Connect to STR #31
OTR #33	FFC	Nechan N-2070, Type D	1441 40" CTC @ 0.340/	730.30	740.70	744.70	
	FFC		111' 42" STS @ 0.34%		17 <b>2.</b> 21	741.03	Connect to STR #34
OTD #05			COL 4011 CTC @ 0 200/		744.00	741.00	Connect to STR #36
<del>)                                      </del>	FFC		60' 42" STS @ 0.38%		141.22	7-10.00	Connect to STR #35
STR #86	FEC		401 4011 676 6 0 400/		740.00	740.99	O 11 OTD #00
STR #37	LO		10 42 010 (2) 0.43 /0	= 4= 00	740.20	740.21	Connect to STR #38
3 TT #30	MII/OG	Neenah R-2561	102' 40" RCP @ 0.30%	745.00	740.21	739.90	Connect to STR #39
STR #39	FES					739.90	
STR #40	MH/OG	Neenah R-2070, Type D	180' ~ 15" RCP @ 1.45%	748.25	742.96	740.35	Connect to STR #38
STR #41	INLET INDOT Type R	INDOT Type 13	134' ~ 15" RCP @ 1.00%	748.30	744.30	742.96	Connect to STR #40
	FES					740.05	
	FES		60' ~ 24" RCP @ 1.00%		741.35	740.75	Connect to STR #42
STR #44	FES					744.62	
STR #45	Inlet	Neenah R-2070, Type D	176' ~ 12" RCP @ 0.50%	749.00	745.50	744.62	Connect to STR #44
STR #48B	FES					743.66	
	MH/OG	Neenah R-2070, Type D	36' ~ 21" PVC @ 0.15%	746.75	743.71	743.66	Connect to STR #48E
	MH / OG	Neenah R-2561	289' ~ 21" PVC @ 0.11%	748.00	744.03	743.71	Connect to STR #48A
STR #50	INLET	Neenah R-2070, Type D	85' ~ 8" PVC @ 1.00%	749.50	746.13	745.28	Connect to STR #49
$\sigma$	INLET INDOT Type R	INDOT Type 13	197' ~ 12" PVC @ 1.00%	749.00	746.00	744.03	Connect to STR #49
STR #51			204' ~ 24" RCP @ 0.47%	749.00	743.67	742.71	Connect to EX. MH
	MH / OC	Necnah R-2561				743.67	Connect to STR #52
STR #51 STR #52	MH / OC	Neenah R-2501 Neenah R-2501	257' ~ 18" RCP @ 0.18%	748.00	/44.1.1	770.07	
STR #51 STR #52 STR #53		Neenah R-2561	204' - 24" RCP @ 0.47% 257' - 18" RCP @ 0.18% 86' 42" RCP @ 0.30%	740.00 740.50	744.13 744.39	744.40	
STR #51 STR #52 STR #53 STR #54	MH/OC MH/OC INLET	Neenah R-2501 Neenah R-2501	86' 12" ROP @ 0.30%	740.50	744.39	744.13	Connect to STR #53
STR #51 STR #52 STR #53 STR #54 STR #55	MH/OC MH/OC	Neenah R-2561 Neenah R-2561 Neenah R-2561	96' 12" RCP @ 0.30% 110' ~ 15" RCP @ 0.26%	740.50 740.00	744.39 744.44	744.13 744.13	Connect to STR #59 Connect to STR #59
STR #51 STR #52 STR #53 STR #54 STR #55 STR #56	MH / OC MH / OC INLET MH / OC Inlet	Necnah R-2561 Necnah R-2561 Necnah R-2561 Necnah R-2561	86' 12" ROP @ 0.30%	740.50 740.00 748.50	744.39 744.44 744.75	744.13	Connect to STR #53 Connect to STR #53 Connect to STR #55
STR #51 STR #52 STR #53 STR #54 STR #56 STR #56 STR #56	MH / OC MH / OC INLET MH / OC Inlet Outlet Structure	Neenah R-2561 Neenah R-2561 Neenah R-2561	96' 12" RCP @ 0.30% 110' - 15" RCP @ 0.26% 139' 15" RCP @ 0.25% Ex. 18" RCP	740.50 740.00	744.39 744.44 744.75 730.00	744.10 744.10 744.44	Connect to STR #53 Connect to STR #55 Connect to EX. 10" RC
STR #51 STR #52 STR #53 STR #54 STR #55 STR #56 STR #57	MH / OC MH / OC INLET MH / OC Inlet Outlet Structure FES	Neenah R-2561 Neenah R-2561 Neenah R-2561 Neenah R-2561 Neenah R-1713	96' 12" RCP @ 0.30% 110' ~ 15" RCP @ 0.26% 139' 15" RCP @ 0.25% Ex. 18" RCP 20' ~ 12" PVC @ 0.50%	740.50 740.00 740.50 744.00	744.99 744.44 744.75 730.00 730.00	744.13 744.13 744.44 738.90	Connect to STR #53 Connect to STR #55 Connect to EX. 18" R0 Connect to EX. 18" R0
STR #51 STR #52 STR #53 STR #54 STR #56 STR #56 STR #57 STR #57 STR #57B	MH / OC MH / OC INLET MH / OC Inlet Outlet Structure FES Outlet Structure	Neenah R-2501 Neenah R-2501 Neenah R-2501 Neenah R-2561 Neenah R-1713	96' 12" RCP @ 0.30% 110' ~ 15" RCP @ 0.26% 139' 15" RCP @ 0.25% Ex. 18" RCP 20' ~ 12" PVC @ 0.50% Ex. 12" RCP	748.50 748.50 748.50 744.86	744.99 744.44 744.75 790.90 730.90 730.54	744.13 744.13 744.44 738.00 736.46	Connect to STR #53 Connect to STR #55 Connect to STR #55 Connect to EX. 10" RCI Connect to STR #57 Connect to EX. 12" RCI
STR #51 STR #52 STR #53 STR #54 STR #55 STR #56 STR #56 STR #57 STR #57D STR #58	MH / OC MH / OC INLET MH / OC Inlet Outlet Structure FES Outlet Structure FES	Neenah R-2561 Neenah R-2561 Neenah R-2561 Neenah R-1713 Neenah R-1713	96' 12" RCP @ 0.30% 110' ~ 15" RCP @ 0.26% 130' 15" RCP @ 0.25% Ex. 18" RCP 20' ~ 12" PVC @ 0.50% Ex. 12" RCP 15' ~ 12" PVC @ 0.50%	740.50 740.00 740.50 744.00	744.99 744.44 744.75 730.90 730.90 796.54 738.90	744.13 744.13 744.44 738.90 736.46 737.93	Connect to STR #53 Connect to STR #55 Connect to EX. 18" ROI Connect to EX. 18" ROI Connect to EX. 12" ROI Connect to EX. 12" ROI Connect to EX. 12" ROI Connect to STR #58
STR #51 STR #52 STR #53 STR #54 STR #56 STR #56 STR #57 STR #57 STR #57B	MH / OC MH / OC INLET MH / OC Inlet Outlet Structure FES Outlet Structure	Neenah R-2561 Neenah R-2561 Neenah R-2561 Neenah R-2561 Neenah R-1713	96' 12" RCP @ 0.30% 110' ~ 15" RCP @ 0.26% 139' 15" RCP @ 0.25% Ex. 18" RCP 20' ~ 12" PVC @ 0.50% Ex. 12" RCP	740.50 740.00 740.50 744.00	744.99 744.44 744.75 790.90 730.90 730.54	744.13 744.13 744.44 738.00 736.46	Connect to STR #53 Connect to STR #55 Connect to STR #55 Connect to EX. 10" RCI Connect to STR #57 Connect to EX. 12" RCI

THE CONTRACTOR CAN SUBSTITUTE THE EQUIVALENT TYPE OF CASTING FOR EJIW

THIS SCHEDULE IS PROVIDED ONLY FOR THE CONVENIENCE OF THE CONTRACTOR AND SUPPLIER AND SHOULD BE VERIFIED WITH THE ENGINEERING PLANS BEFORE STRUCTURES ARE ORDERED

AGGREGATE BASE

(NO. 53)

\_4x4 W2.9 x W2.9 WWWF

PLACED 5" BELOW TOP

6" THICK CONCRETE WITH BROOM FINISH

- 4" COMP. GRANULAR

- COMPACTED SUBGRADE

LENGTH VARIES - SEE SITE PLAN

6x6 W2.9 x W2.9 -/

SLOPE PER GRADING PLAN


TYPICAL PERIMETER SIDEWALK

NOT TO SCALE


(1) #5 BARS CONT. TOP & BOTTOM

& TO BE EPOXY

OF SLAB

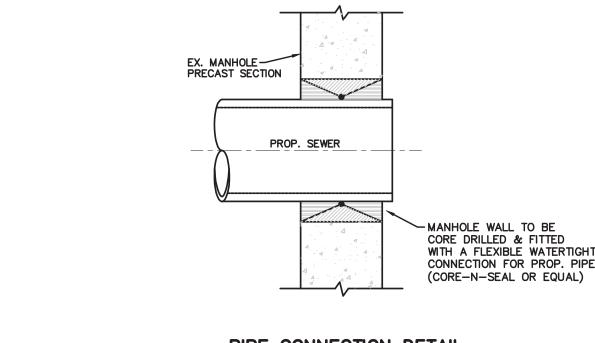

# PIPE CONNECTION DETAIL TO EXISTING MANHOLE NOT TO SCALE

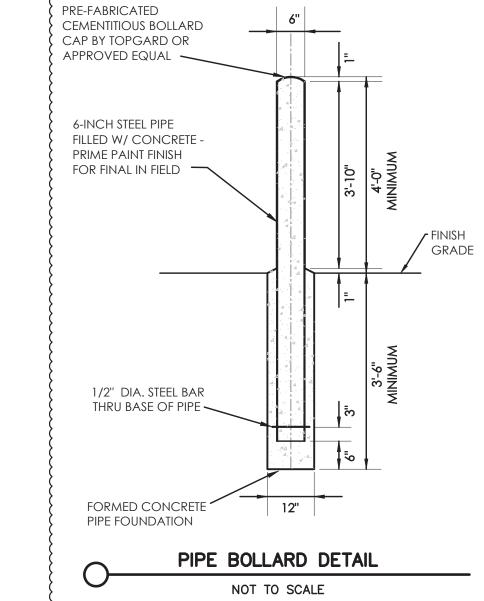

4" THICK CONC. BROOM FINISH WITH 6X6 W2.9XW2.9 WWWF 6" COMPACTED GRANULAR FILL 3 PROPOSED PAVEMENT

COMPRESSIBLE FILLER  $\frac{4}{3}$  (3/4" MAXIMUM). CUT BACK AND PROVIDE SEALANT, TYPICAL, AT ALL JOINTS WITH FILLER. (BUTTING BUILDING ONLY)  $\langle 5 \rangle$  1/4" TOOLED JOINT

(SEE TYPICAL SIDEWALK DETAIL)

PROJECT

© GIBRALTAR DESIGN SHEET

CORE DRILLED & FITTED WITH A FLEXIBLE WATERTIGHT CONNECTION FOR PROP. PIPE (CORE-N-SEAL OR EQUAL)

TORRENGA ENGINEERING, INC. CONSULTING ENGINEERS & LAND SURVEYORS 907 RIDGE ROAD MUNSTER, IN 46321 T: (219) 836-8918 F: (219) 836-1138

GIBRALTAR DESIGN 9102 N. Meridian St., Ste. 300 Indianapolis, IN 46260 Homepage www.GibraltarDesign.com Email info@GibraltarDesign.com Phone 317.580.5777 Fax 317.580.5778 PROJECT

**GIBRALTAR** 

DESIGN

ARCHITECTURE ● ENGINEERING ● INTERIOR DESIGN

HANOVER CSC NEW

**RELATED WORK** 

CEDAR LAKE, INDIANA

CORPORATION

RESOURCE CENTER AND

HANOVER COMMUNITY SCHOOL

PROJECT

20-141 COORDINATED I DCT DRAWN BY DCT/NM/EM

**★** -·- **★** STATE OF CHECKED BY


THE CONCEPTS, DESIGNS, PLANS, DETAILS, ETC, SHOWN ON THIS DOCUMENT ARE THE PROPERTY OF GIBRALTAR DESIGN AND WERE CREATED FOR USE ON THIS SPECIFIC PROJECT. NONE OF THIS INFORMATION SHALL BE USED BY ANY PERSON OR FIRM FOR ANY PURPOSE WITHOUT THE EXPRESS WRITTEN CONSENT OF GIBRALTAR DESIGN. THE OWNER MAY RETAIN COPIES FOR INFORMATION AND REFERENCE IN CONNECTION ONLY WITH THI PROJECT.

REVISIONS MARK DATE ISSUED FOR AD-1 05/27/2021 ADDENDUM NO. 1 AD-4 06/09/2021 ADDENDUM NO. 4


DRAWING **DETAILS AND SPECIFICATIONS** 

HANOVER CSC NEW RESOURCE CENTER AND RELATED WORK

C-6.0

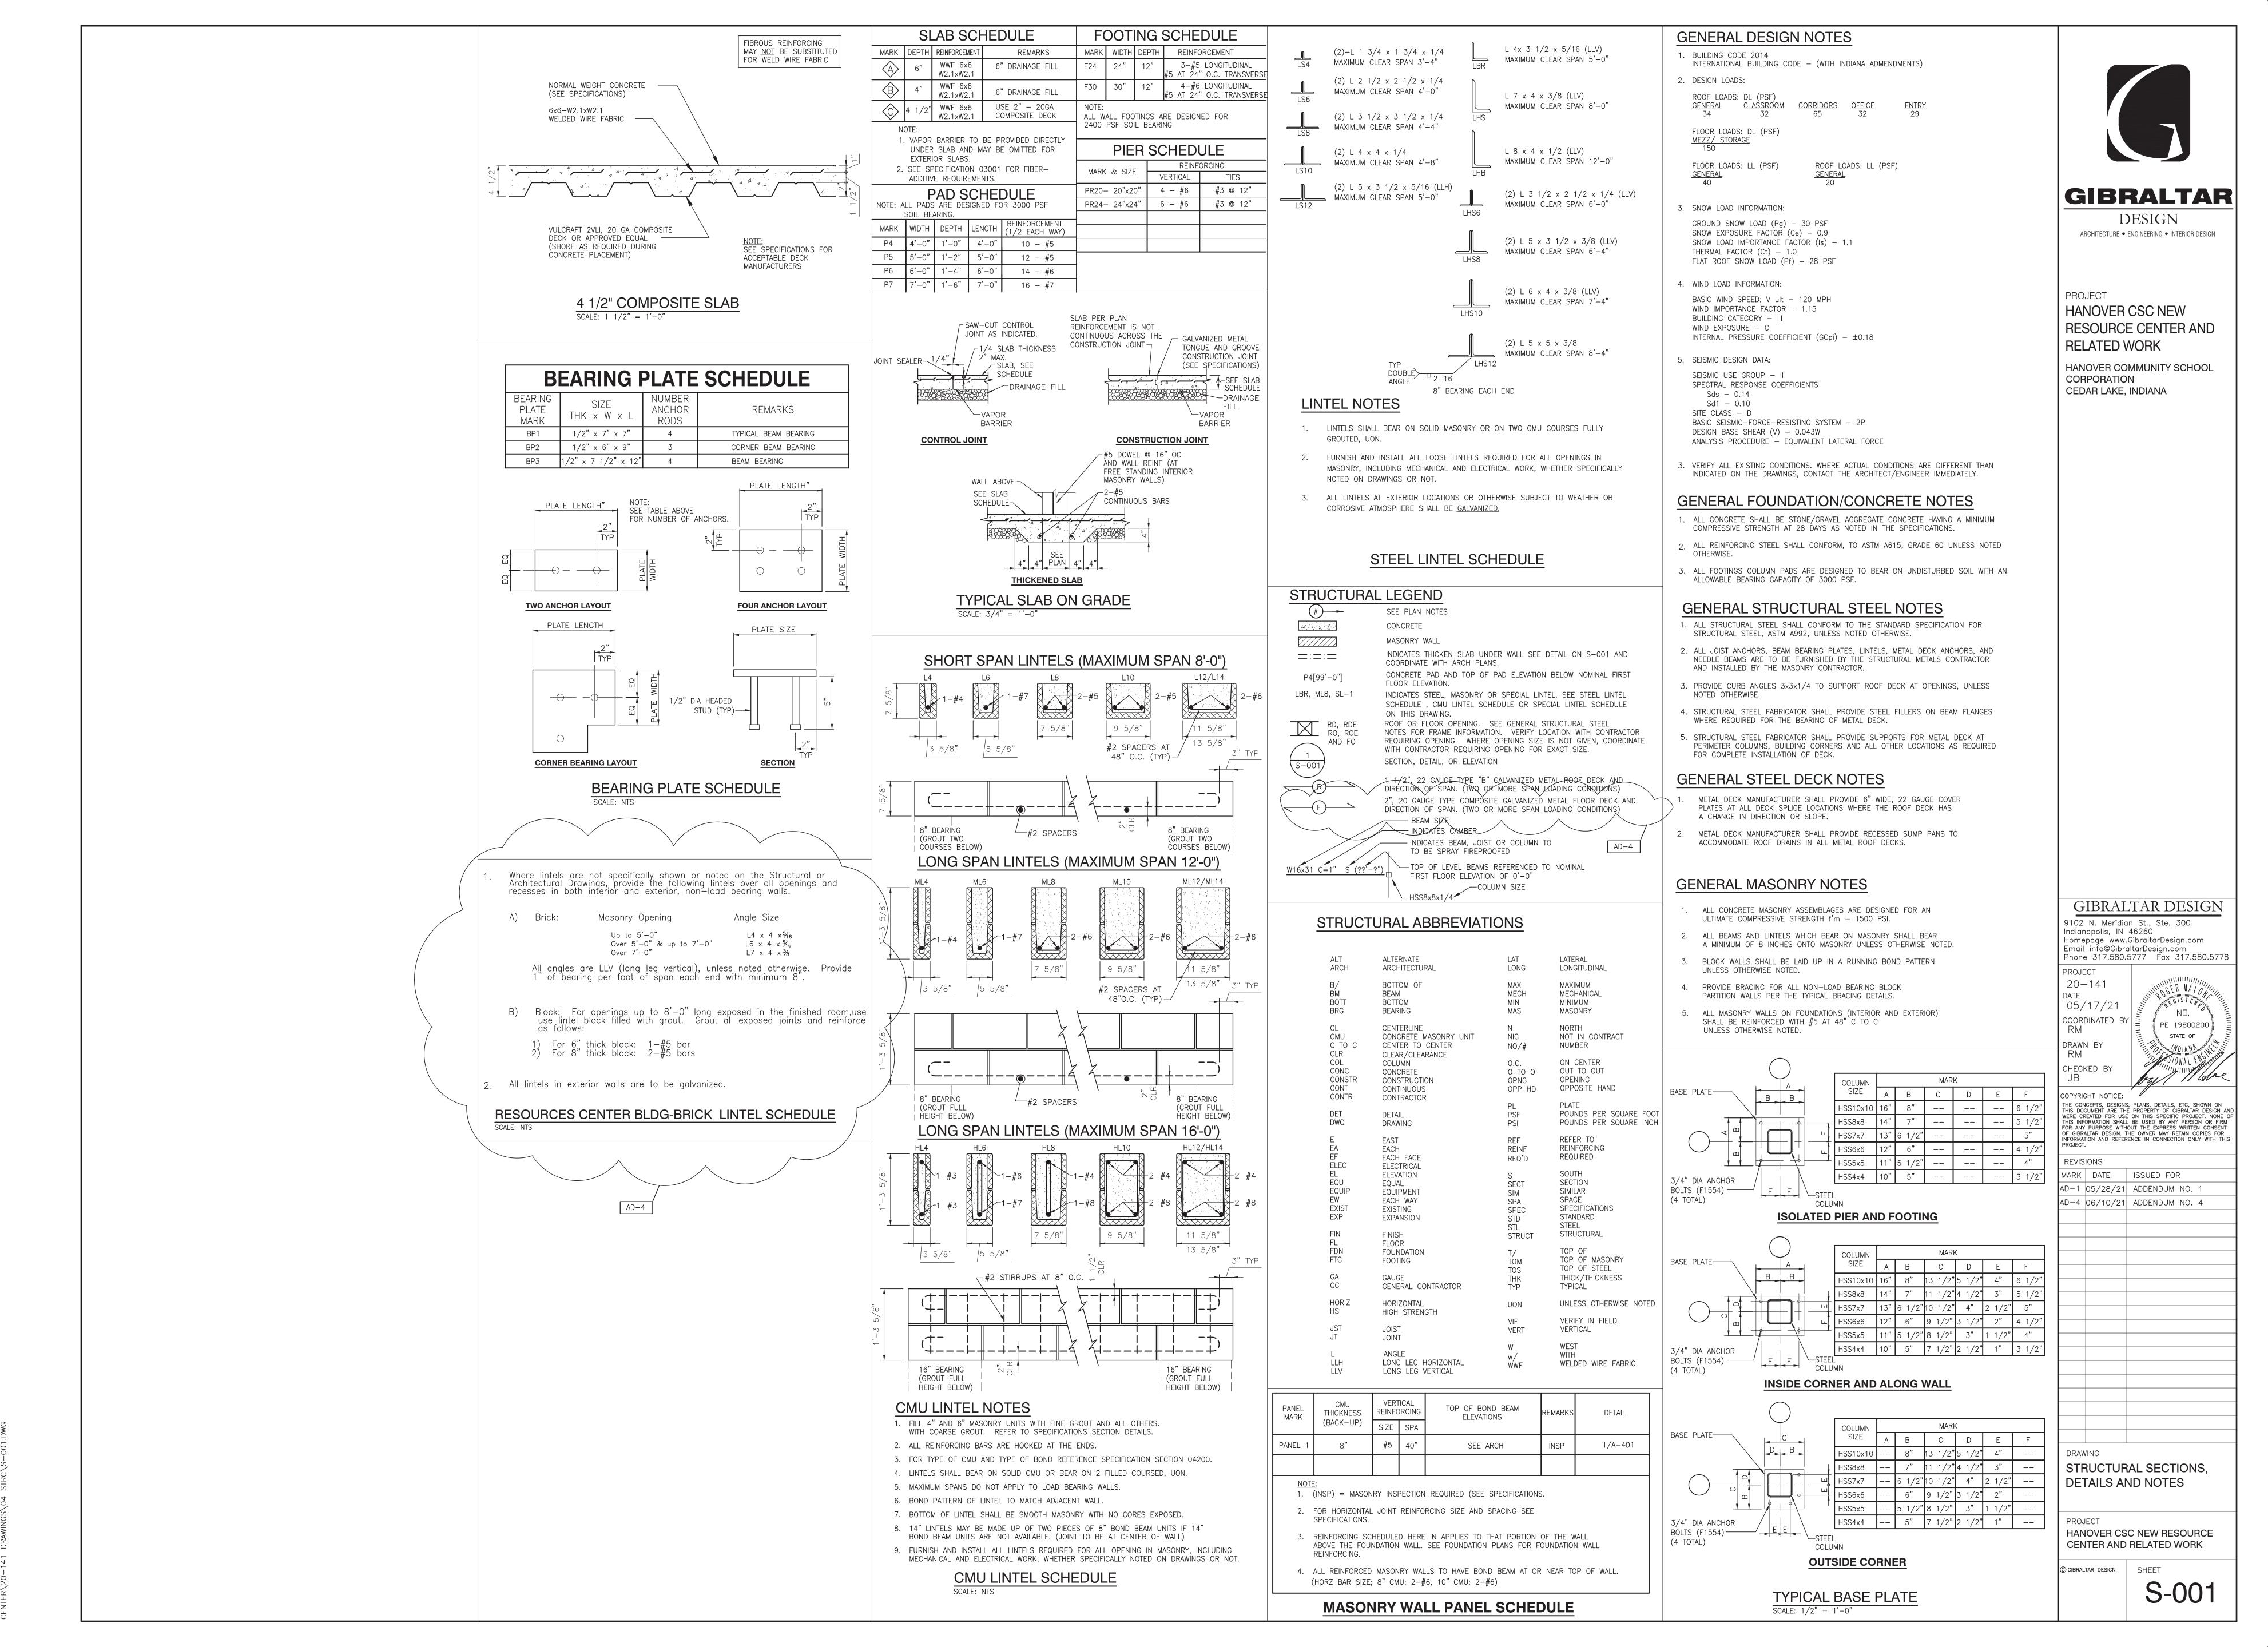

Wednesday, 6/9/2021 — 4:59 PM — LAST SAVED BY:RMALONE Y:\20—141 HANOVER CSC — NEW RESOURCE CENTER\20—141 DRAWINGS\04 STRC\S—001.DWG

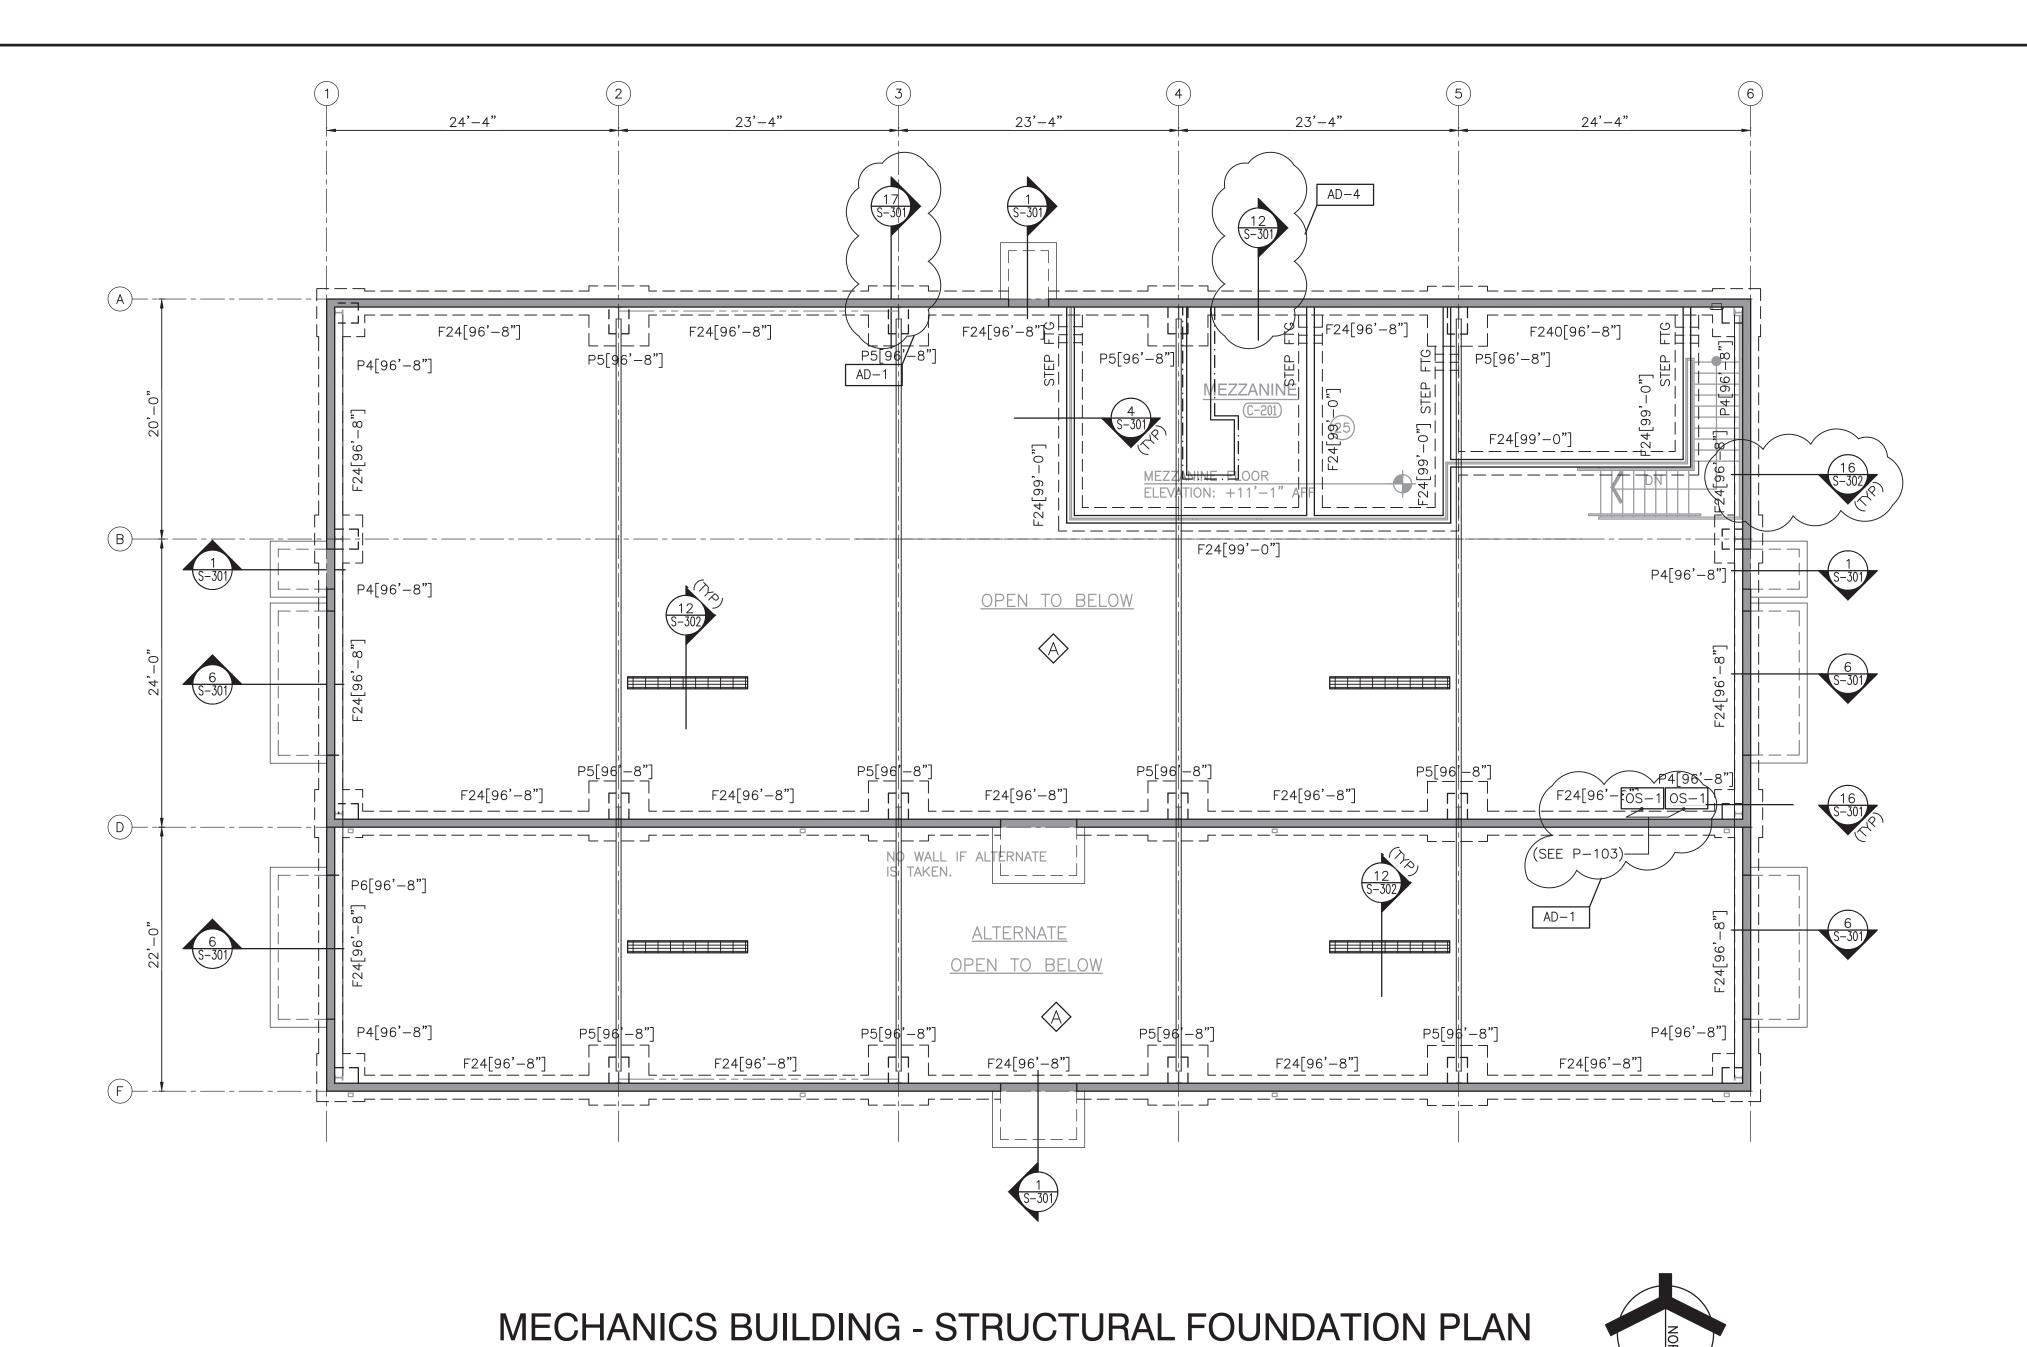

SCALE: 1/8" = 1'-0"

FOUNDATION/SLAB PLAN NOTES

- 1. SEE SHEET S-001 FOR GENERAL NOTES, STRUCTURAL LEGEND, SCHEDULES AND TYPICAL DETAILS.
- 2. ALL ELEVATIONS ARE REFERENCED FROM A FINISH FLOOR ELEVATION OF 100'-0" PER AREA. SEE PLAN
- AND VERIFY WITH ARCHITECTURAL FLOOR PLANS 3. SLAB CONTROL AND CONSTRUCTION JOINTS ARE TO BE LAID OUT PER CONTRACTOR PLANNED SEQUENCE OF
- COMPLETION. (SEE SPECIFICATION) 4. SEE S-301 AND S-302 FOR FOUNDATION AND FRAMING DETAILS.

GIBRALTAR DESIGN ARCHITECTURE • ENGINEERING • INTERIOR DESIGN

PROJECT HANOVER CSC NEW RESOURCE CENTER AND RELATED WORK

HANOVER COMMUNITY SCHOOL CORPORATION CEDAR LAKE, INDIANA

GIBRALTAR DESIGN 9102 N. Meridian St., Ste. 300 Indianapolis, IN 46260 Homepage www.GibraltarDesign.com Email info@GibraltarDesign.com Phone 317.580.5777 Fax 317.580.5778

20-141 05/17/21

COORDINATED E DRAWN BY

CHECKED BY

COPYRIGHT NOTICE: THE CONCEPTS, DESIGNS, PLANS, DETAILS, ETC, SHOWN ON THIS DOCUMENT ARE THE PROPERTY OF GIBRALTAR DESIGN AND WERE CREATED FOR USE ON THIS SPECIFIC PROJECT. NONE OF THIS INFORMATION SHALL BE USED BY ANY PERSON OR FIRM FOR ANY PURPOSE WITHOUT THE EXPRESS WRITTEN CONSENT OF GIBRALTAR DESIGN. THE OWNER MAY RETAIN COPIES FOR INFORMATION AND REFERENCE IN CONNECTION ONLY WITH THIS PROJECT.

MARK DATE ISSUED FOR AD-1 05/28/21 ADDENDUM NO. 1


AD-4 06/10/21 ADDENDUM NO. 4

STRUCTURAL FOUNDATION


HANOVER CSC NEW RESOURCE CENTER AND RELATED WORK

SB102



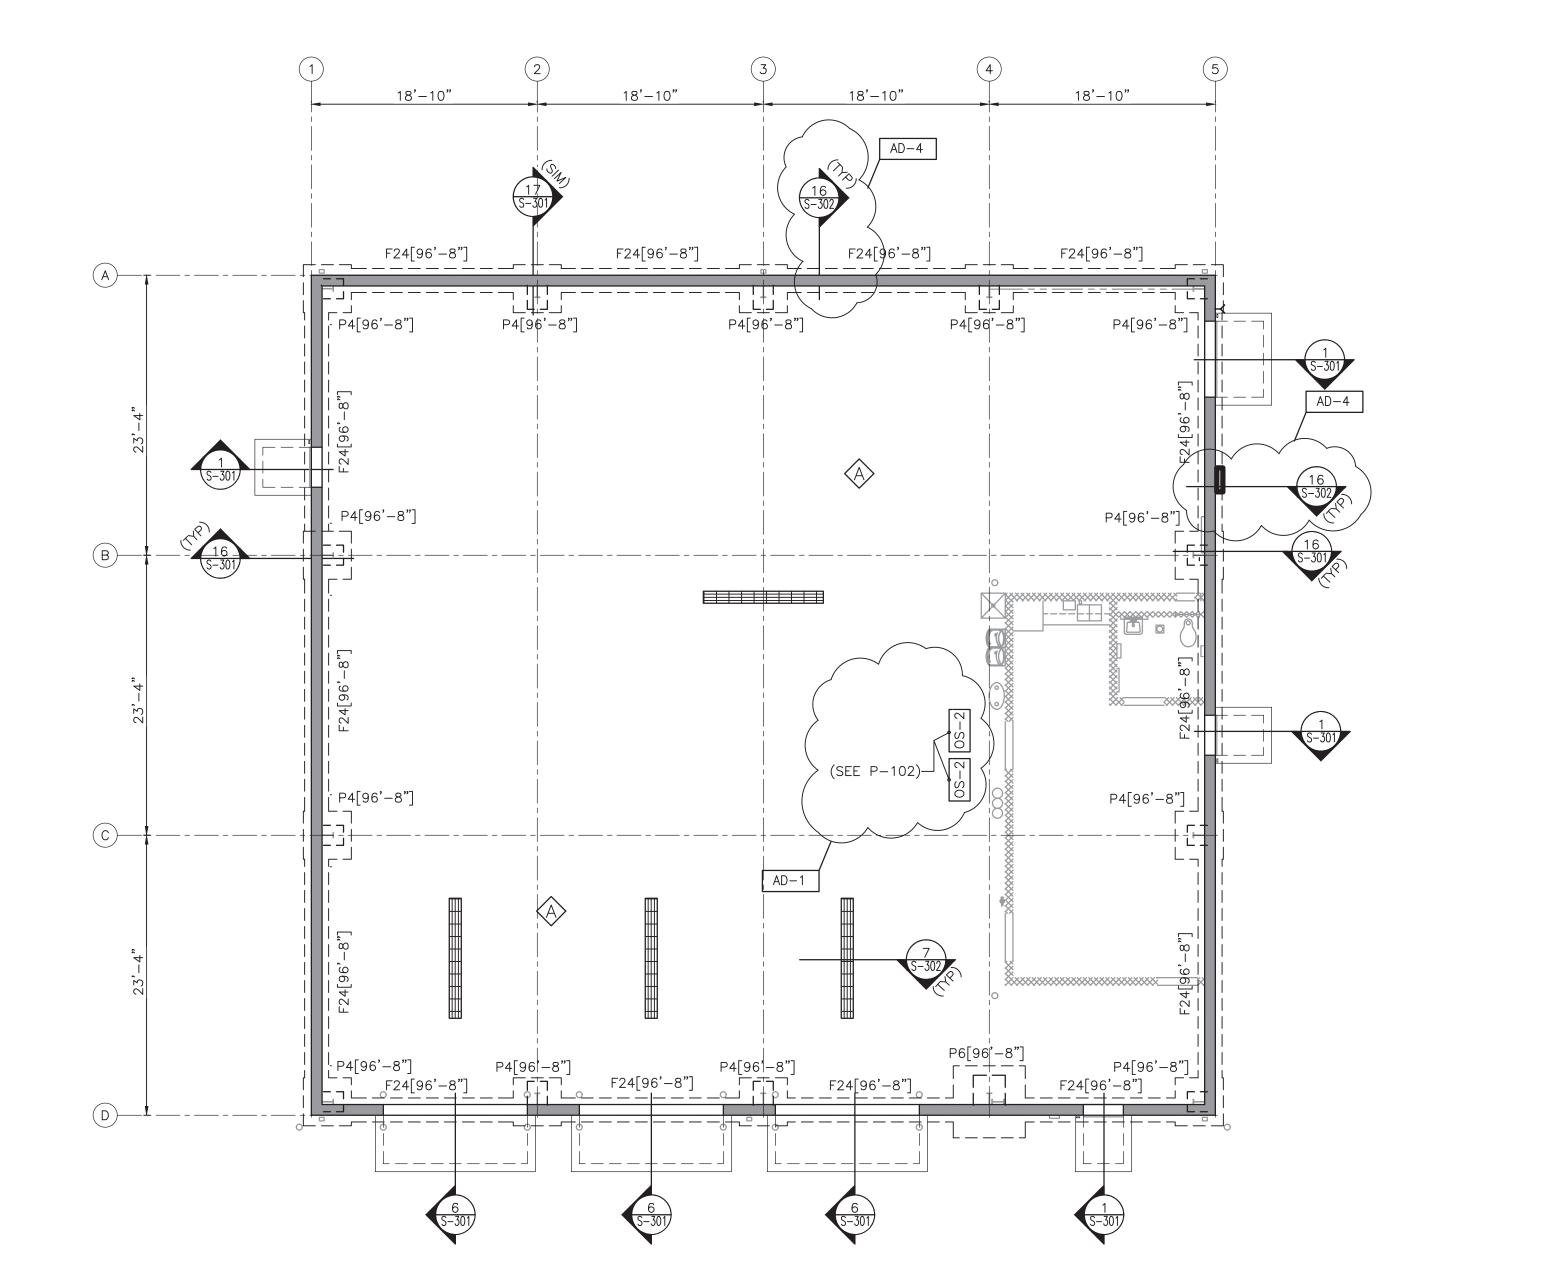



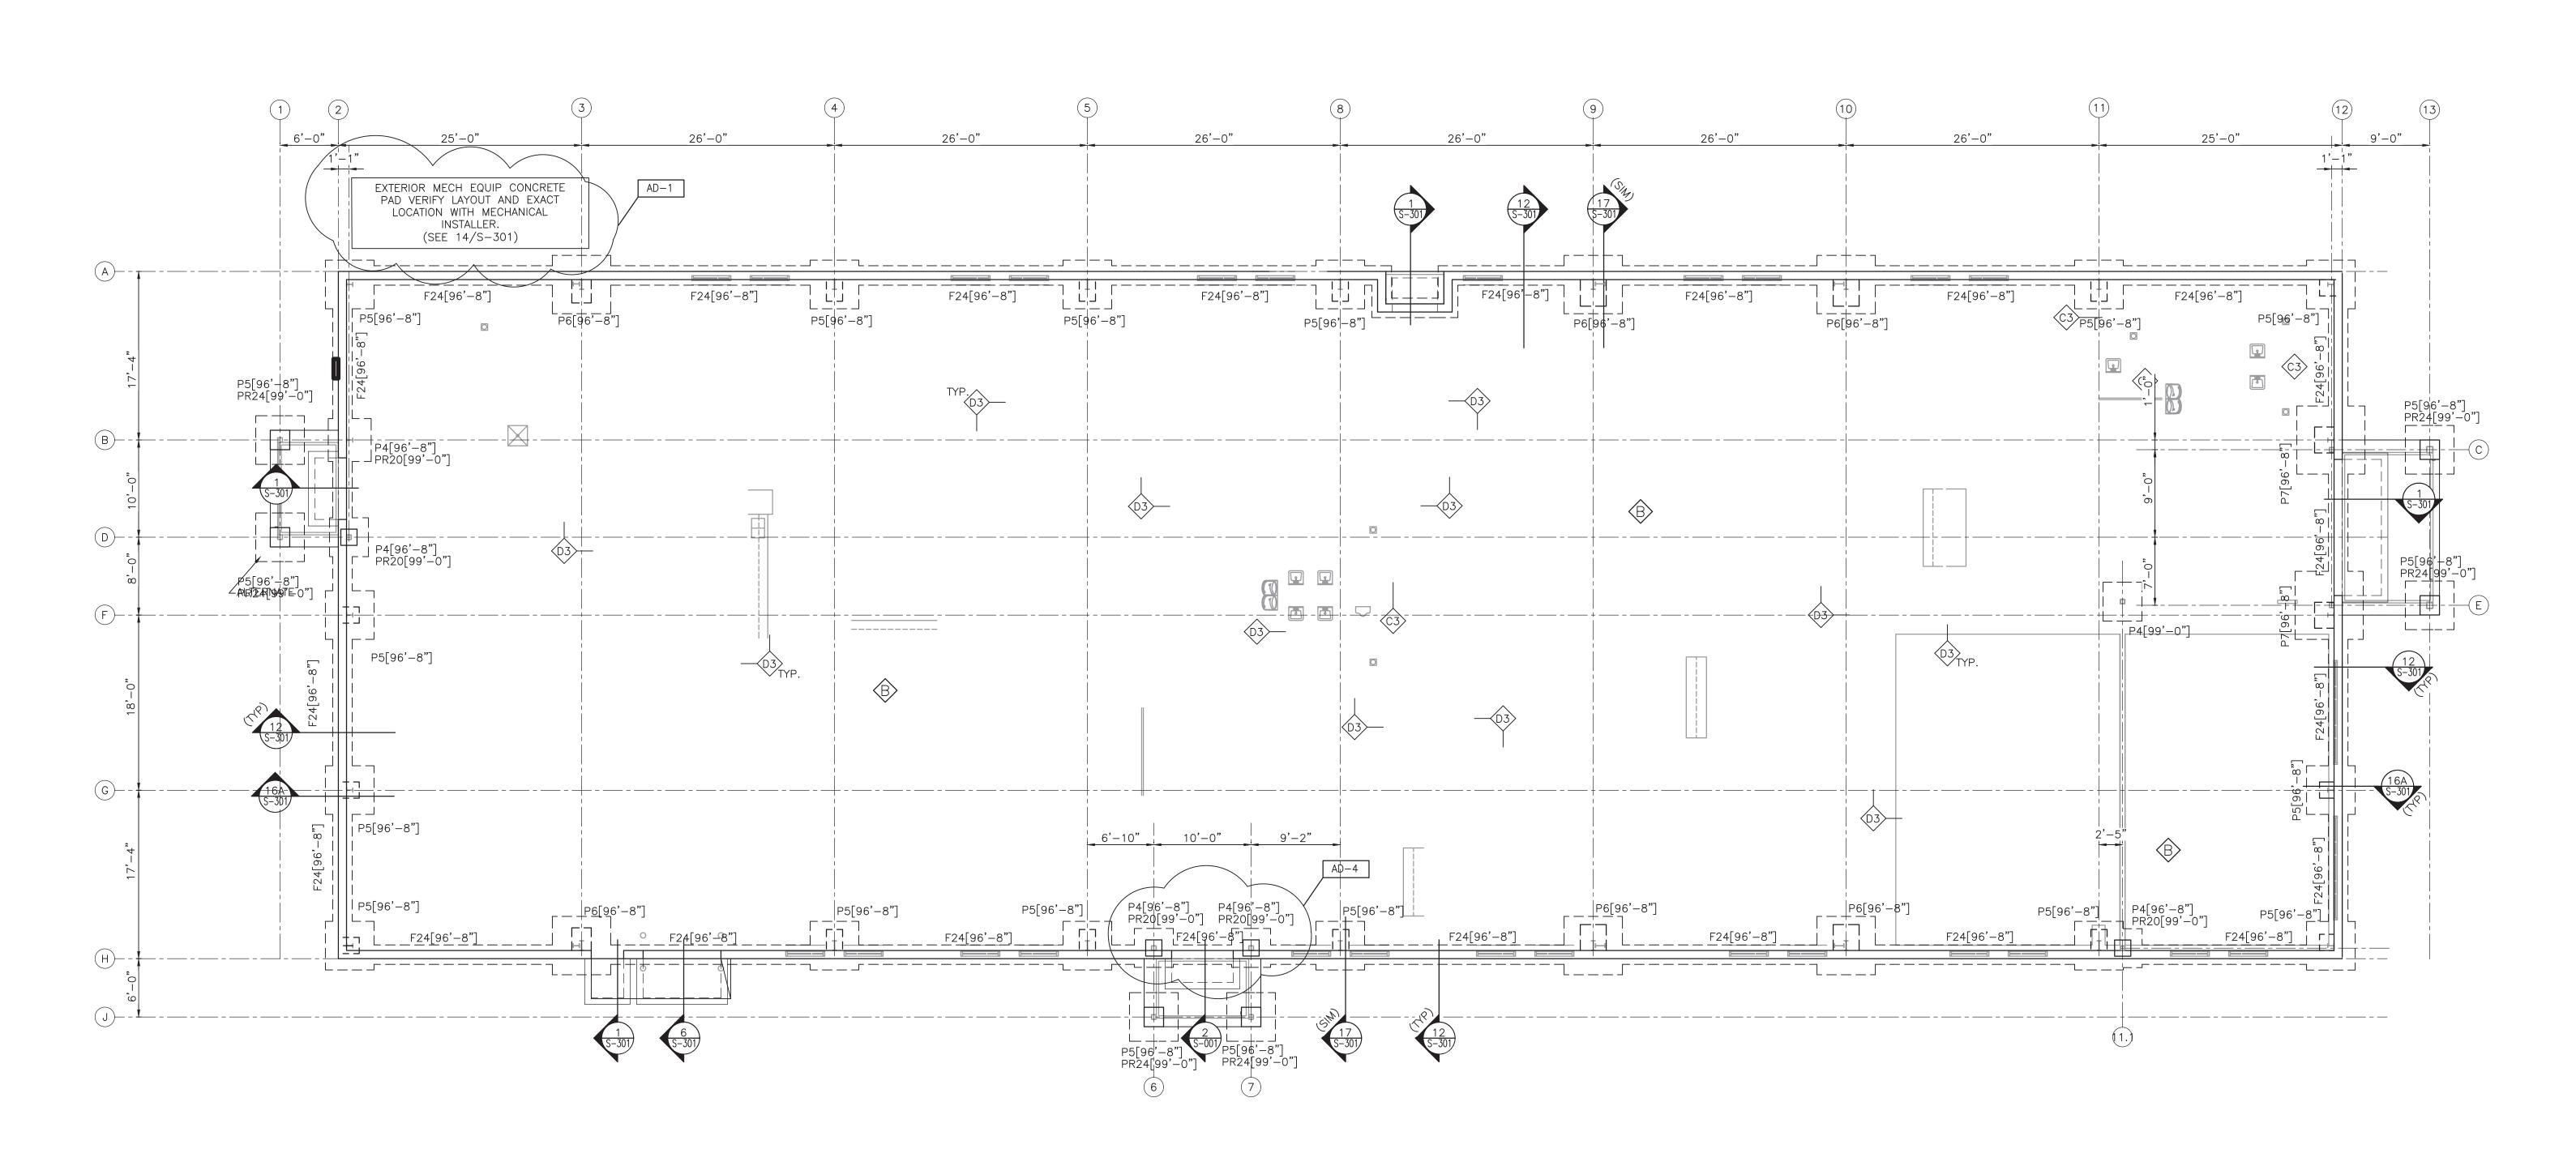

RESOURCES CENTER - FOUNDATION PLAN SCALE: 1/8" = 1'-0"



# FOUNDATION/SLAB PLAN NOTES

- SEE SHEET S-001 FOR GENERAL NOTES, STRUCTURAL LEGEND, SCHEDULES AND TYPICAL DETAILS.
- 3. SLAB CONTROL AND CONSTRUCTION JOINTS ARE TO BE LAID OUT PER CONTRACTOR PLANNED SEQUENCE OF COMPLETION. (SEE SPECIFICATION)
- 4. SEE S-301 AND S-302 FOR FOUNDATION AND FRAMING DETAILS.

GIBRALTAR

DESIGN ARCHITECTURE • ENGINEERING • INTERIOR DESIGN

PROJECT HANOVER CSC NEW RESOURCE CENTER AND RELATED WORK

HANOVER COMMUNITY SCHOOL CORPORATION CEDAR LAKE, INDIANA

GIBRALTAR DESIGN

9102 N. Meridian St., Ste. 300 Indianapolis, IN 46260 Homepage www.GibraltarDesign.com Email info@GibraltarDesign.com Phone 317.580.5777 Fax 317.580.5778

20-141 05/17/21 COORDINATED E

DRAWN BY CHECKED B

THE CONCEPTS, DESIGNS, PLANS, DETAILS, ETC, SHOWN ON THIS DOCUMENT ARE THE PROPERTY OF GIBRALTAR DESIGN AND WERE CREATED FOR USE ON THIS SPECIFIC PROJECT. NONE OF THIS INFORMATION SHALL BE USED BY ANY PERSON OR FIRM FOR ANY PURPOSE WITHOUT THE EXPRESS WRITTEN CONSENT OF GIBRALTAR DESIGN. THE OWNER MAY RETAIN COPIES FOR INFORMATION AND REFERENCE IN CONNECTION ONLY WITH THIS PROJECT.

MARK DATE ISSUED FOR AD-1 | 05/28/21 | ADDENDUM NO. 1AD-4 06/10/21 ADDENDUM NO. 4


STRUCTURAL FOUNDATION


HANOVER CSC NEW RESOURCE CENTER AND RELATED WORK

© GIBRALTAR DESIGN SHEET

SB103

- ALL ELEVATIONS ARE REFERENCED FROM A FINISH FLOOR ELEVATION OF 100'-0" PER AREA. SEE PLAN AND VERIFY WITH ARCHITECTURAL FLOOR PLANS

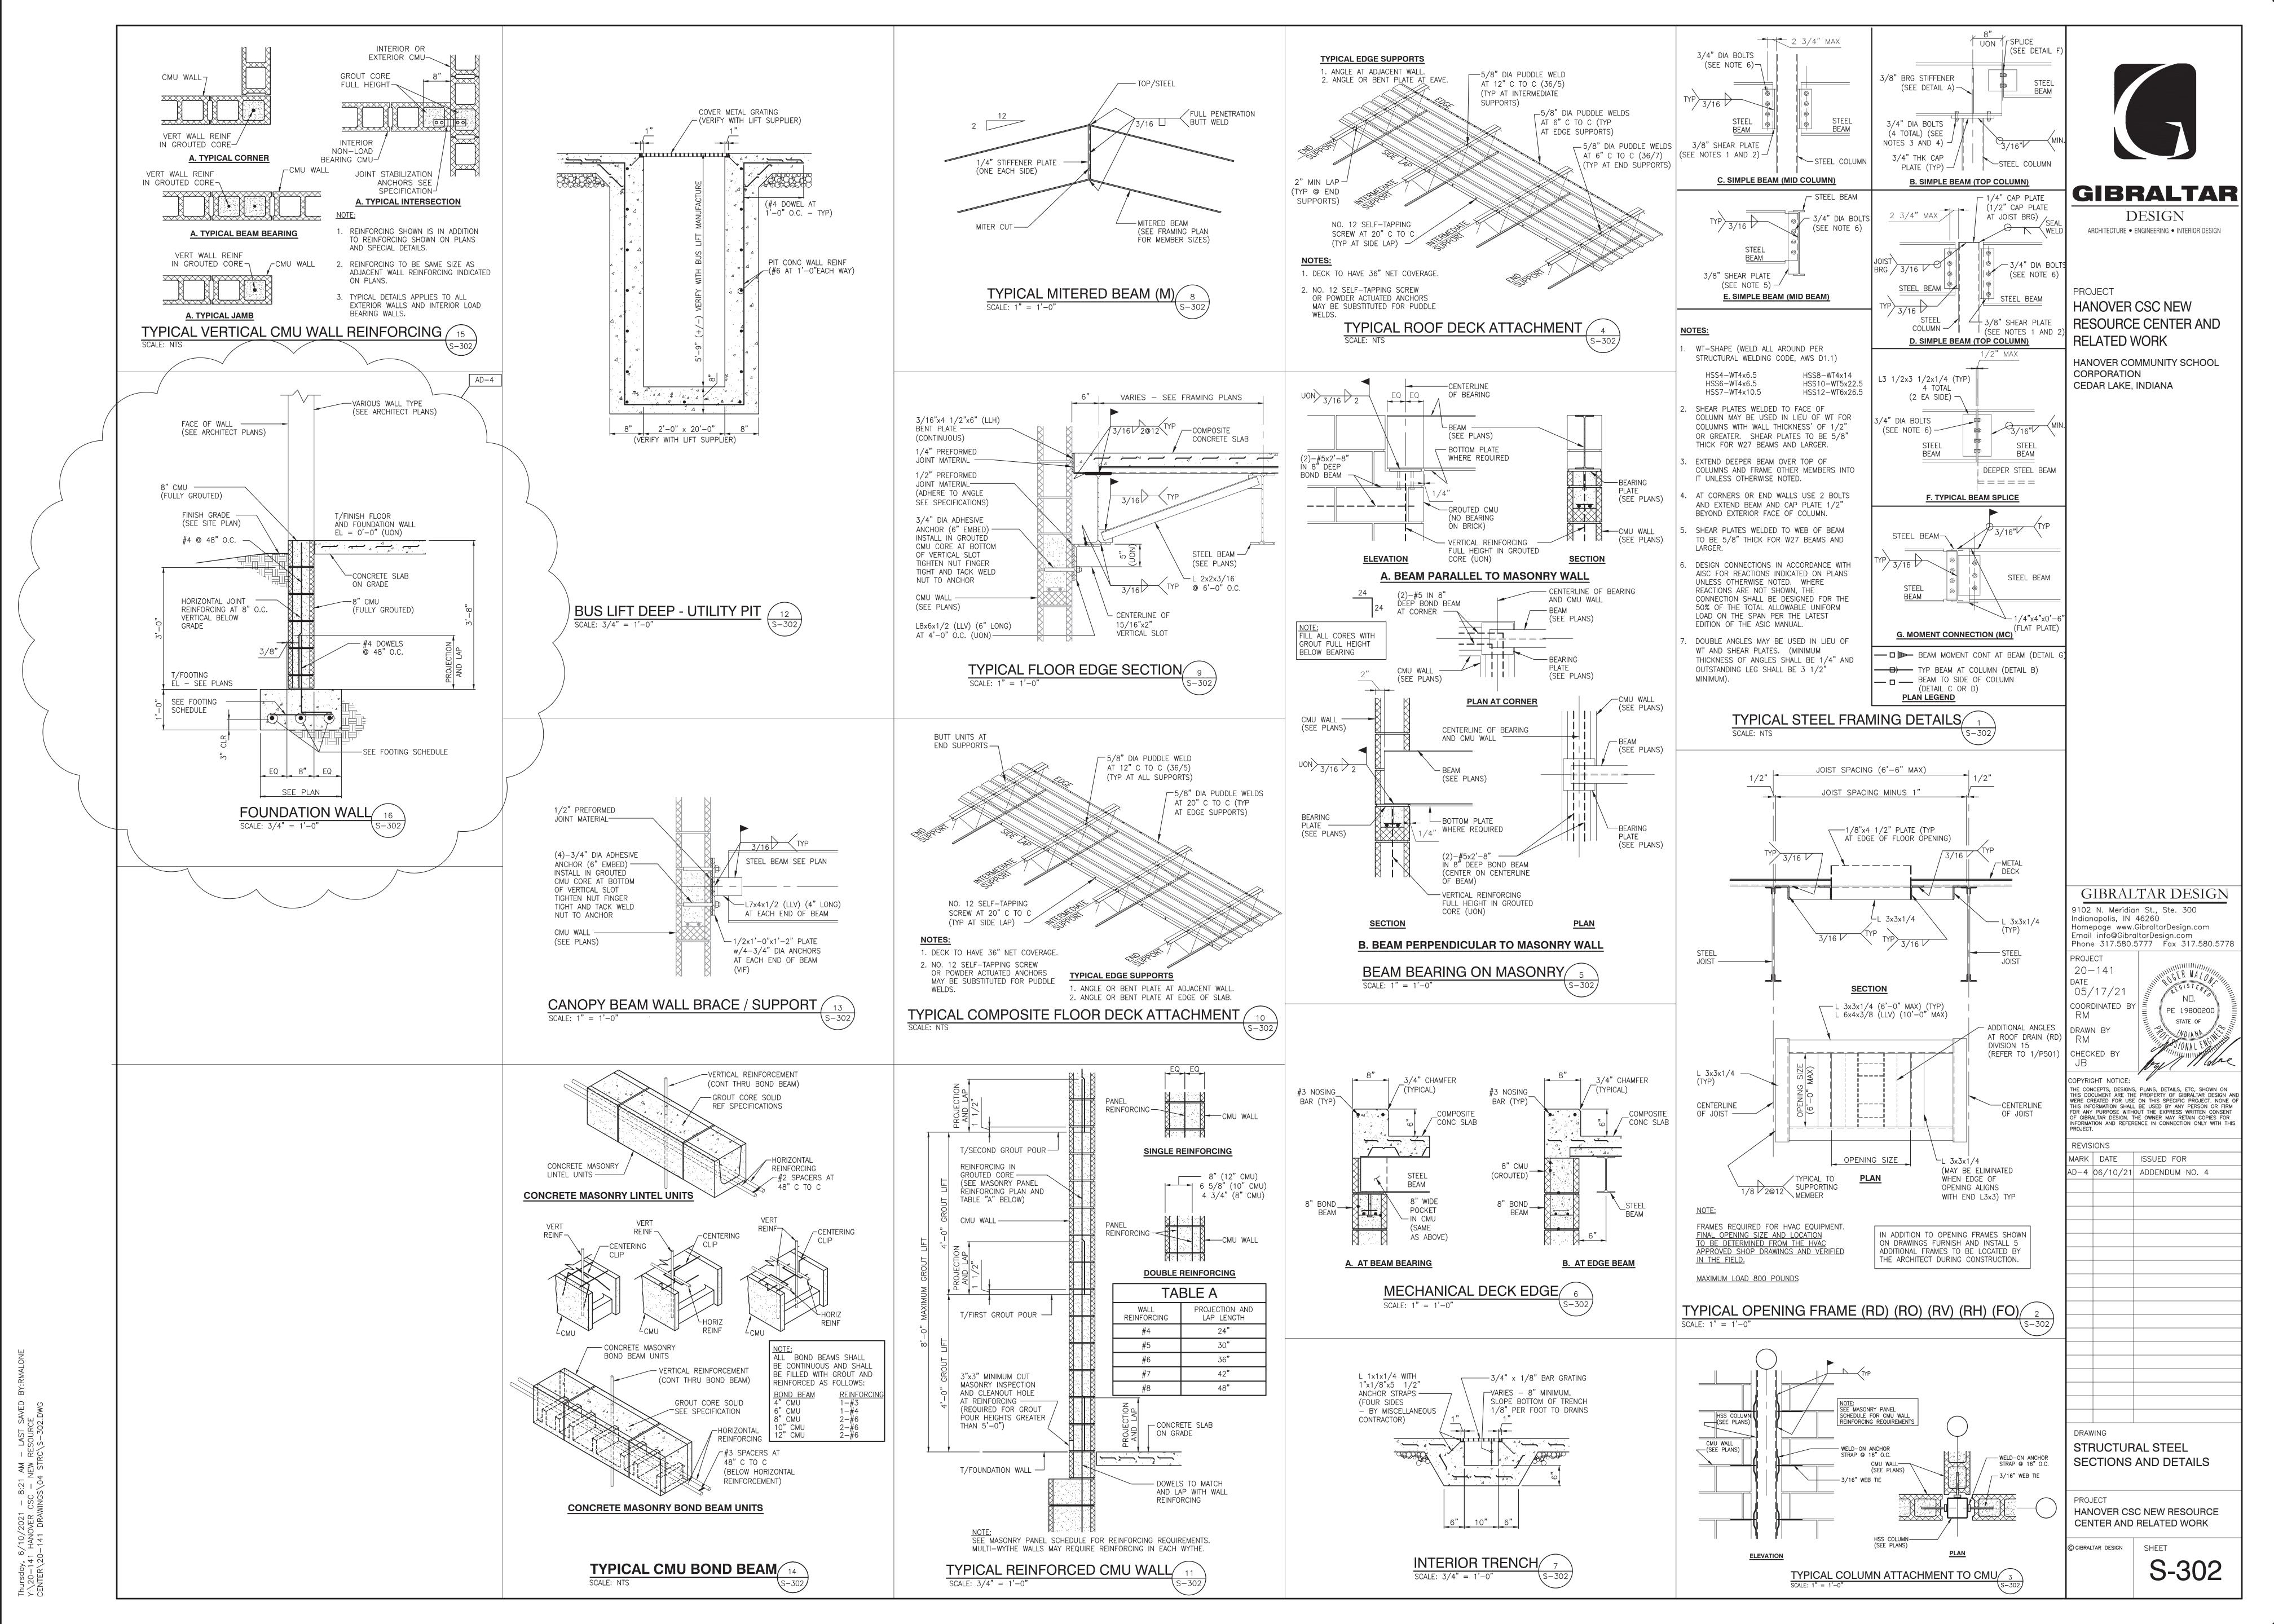

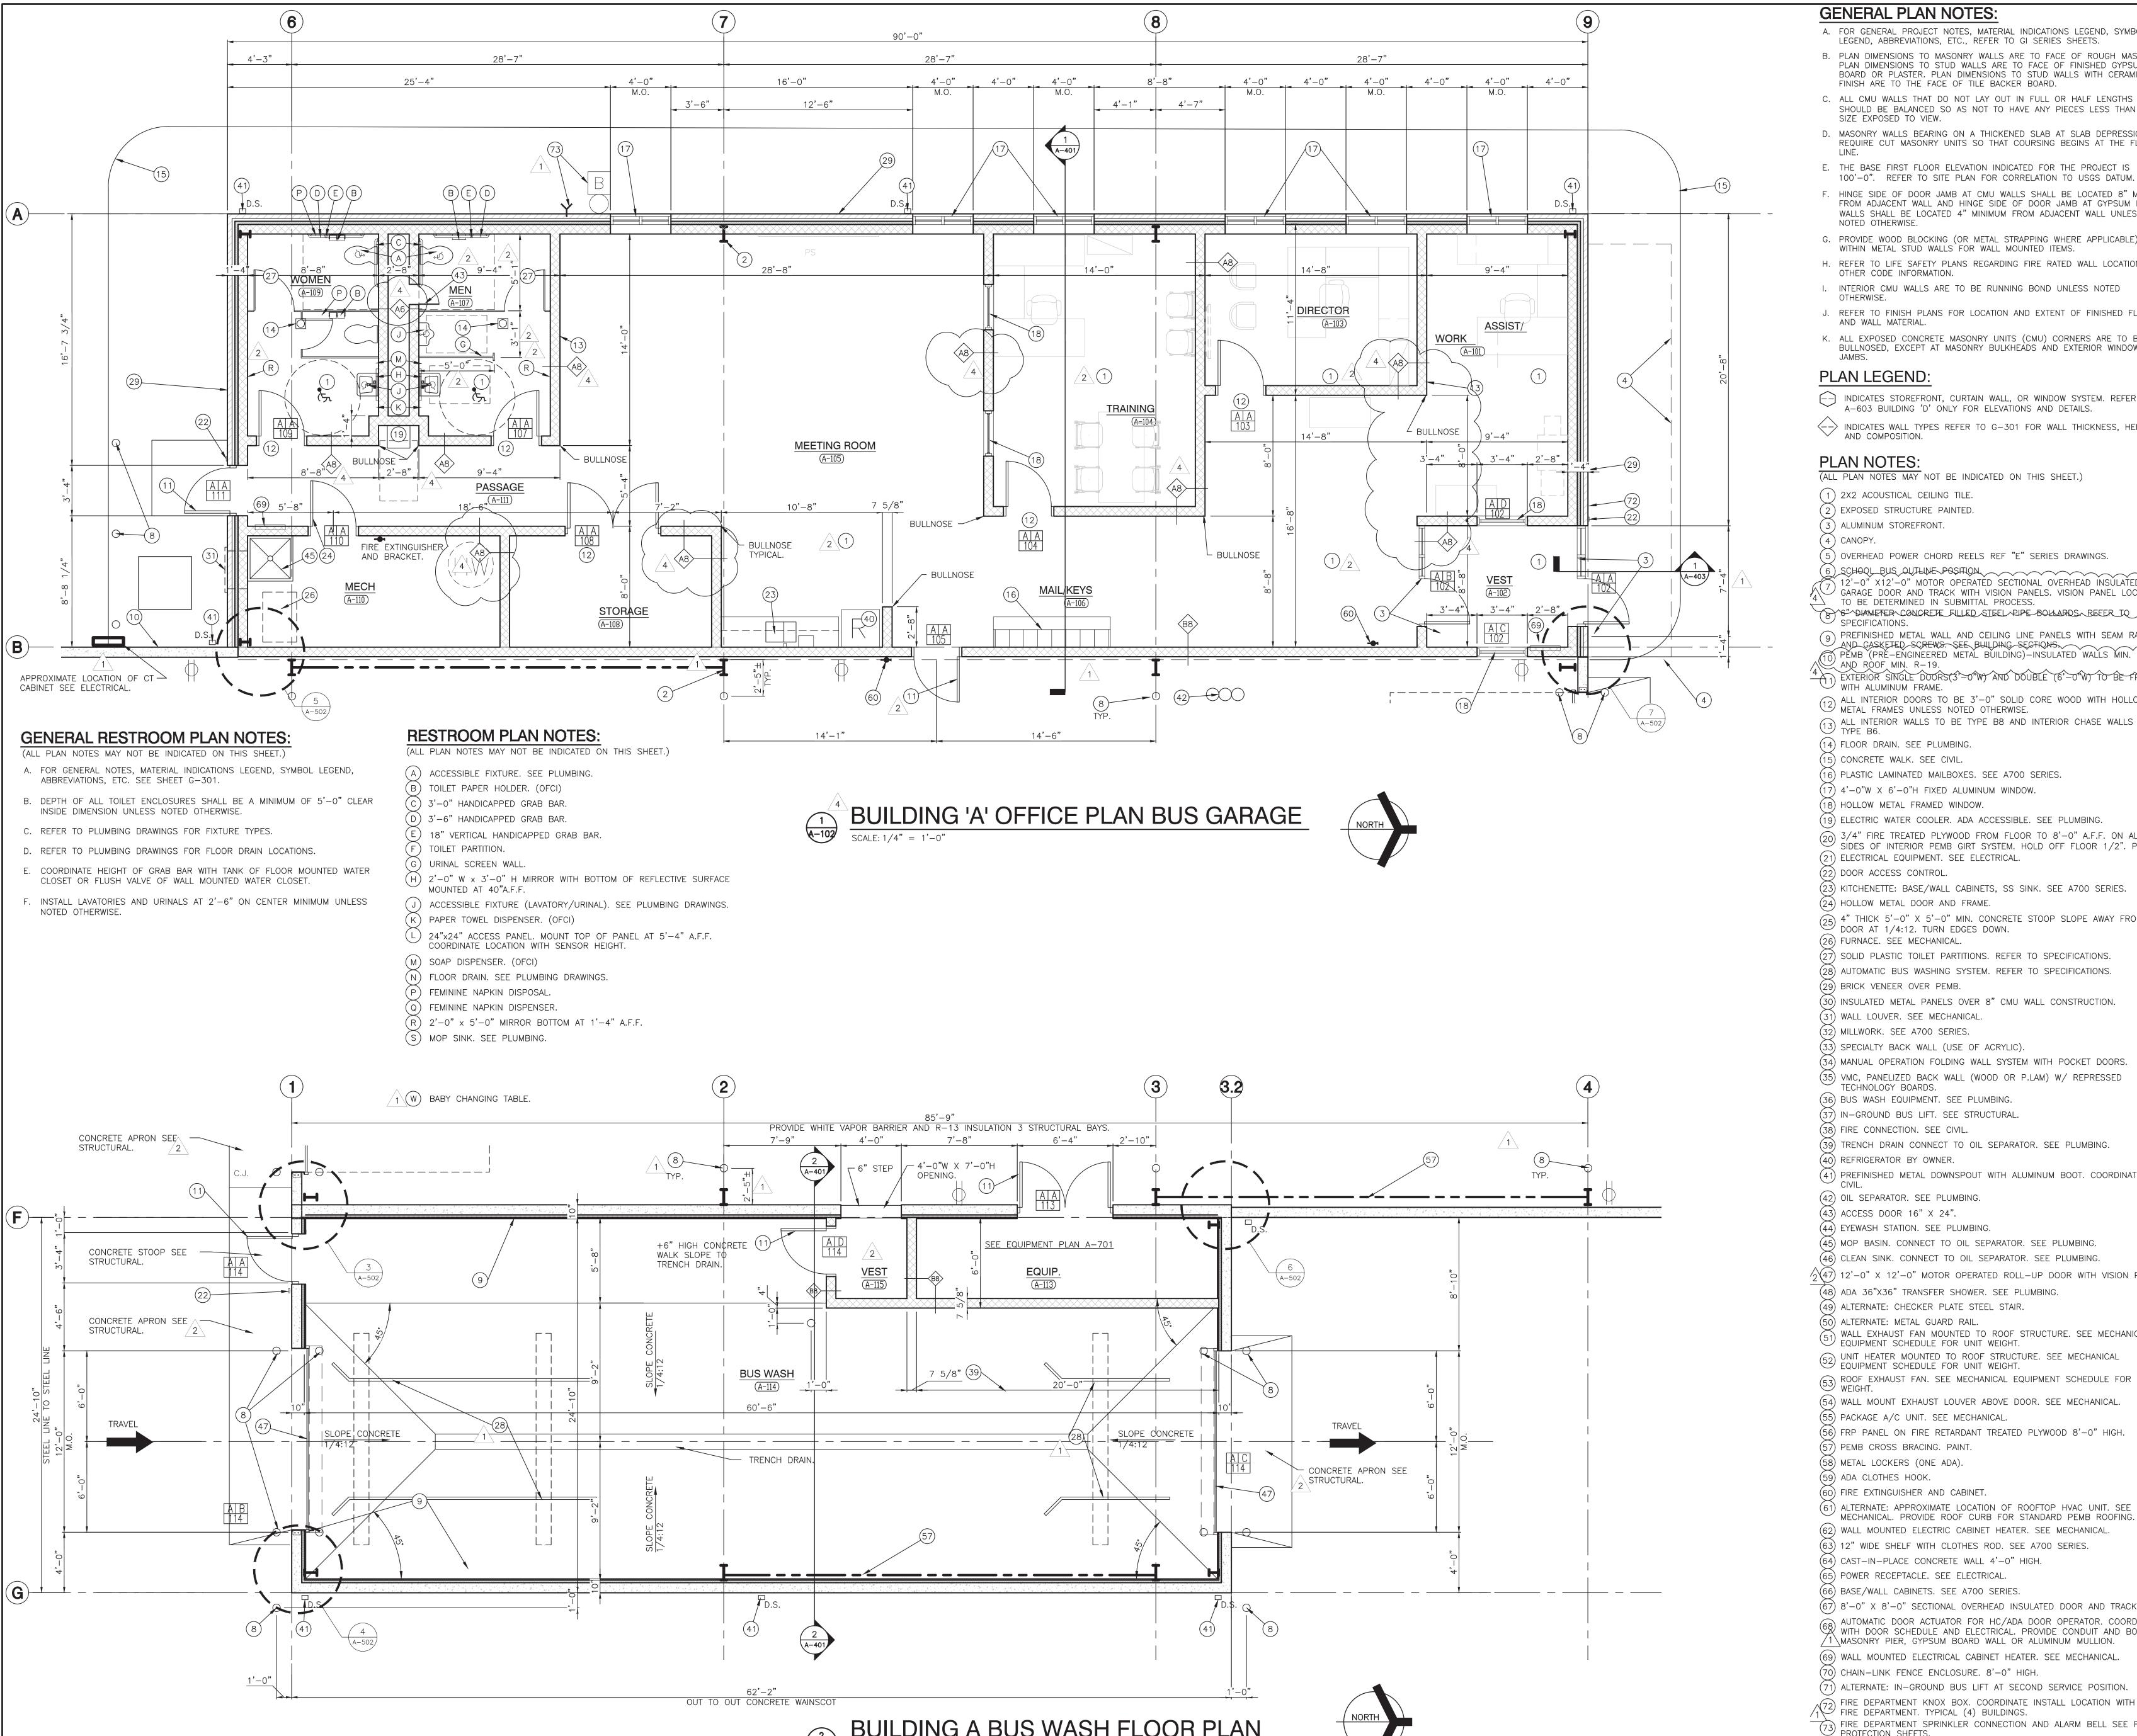

**GENERAL PLAN NOTES:** 

- A. FOR GENERAL PROJECT NOTES, MATERIAL INDICATIONS LEGEND, SYMBOL LEGEND, ABBREVIATIONS, ETC., REFER TO GI SERIES SHEETS.
- B. PLAN DIMENSIONS TO MASONRY WALLS ARE TO FACE OF ROUGH MASONRY. PLAN DIMENSIONS TO STUD WALLS ARE TO FACE OF FINISHED GYPSUM BOARD OR PLASTER. PLAN DIMENSIONS TO STUD WALLS WITH CERAMIC TILE FINISH ARE TO THE FACE OF TILE BACKER BOARD.
- C. ALL CMU WALLS THAT DO NOT LAY OUT IN FULL OR HALF LENGTHS SHOULD BE BALANCED SO AS NOT TO HAVE ANY PIECES LESS THAN 4" IN SIZE EXPOSED TO VIEW.
- D. MASONRY WALLS BEARING ON A THICKENED SLAB AT SLAB DEPRESSIONS REQUIRE CUT MASONRY UNITS SO THAT COURSING BEGINS AT THE FLOOR
- E. THE BASE FIRST FLOOR ELEVATION INDICATED FOR THE PROJECT IS 100'-0". REFER TO SITE PLAN FOR CORRELATION TO USGS DATUM.
- F. HINGE SIDE OF DOOR JAMB AT CMU WALLS SHALL BE LOCATED 8" MINIMUM FROM ADJACENT WALL AND HINGE SIDE OF DOOR JAMB AT GYPSUM BOARD WALLS SHALL BE LOCATED 4" MINIMUM FROM ADJACENT WALL UNLESS NOTED OTHERWISE.
- G. PROVIDE WOOD BLOCKING (OR METAL STRAPPING WHERE APPLICABLE) WITHIN METAL STUD WALLS FOR WALL MOUNTED ITEMS.

GIBRALTAR

DESIGN

ARCHITECTURE • ENGINEERING • INTERIOR DESIGN

HANOVER CSC NEW

RELATED WORK

CEDAR LAKE, INDIANA

CORPORATION

RESOURCE CENTER AND

HANOVER COMMUNITY SCHOOL

GIBRALTAR DESIGN

Phone 317.580.5777 Fax 317.580.5778

THE CONCEPTS, DESIGNS, PLANS, DETAILS, ETC, SHOWN ON THIS DOCUMENT ARE THE PROPERTY OF GIBRALTAR DESIGN ANI

WERE CREATED FOR USE ON THIS SPECIFIC PROJECT. NONE OF THIS INFORMATION SHALL BE USED BY ANY PERSON OR FIRM FOR ANY PURPOSE WITHOUT THE EXPRESS WRITTEN CONSENT OF GIBRALTAR DESIGN. THE OWNER MAY RETAIN COPIES FOR INFORMATION AND REFERENCE IN CONNECTION ONLY WITH THIS PROJECT.

MARK DATE ISSUED FOR

ENLARGED PLANS

HANOVER CSC NEW RESOURCE

CENTER AND RELATED WORK

BUS GARAGE

BUILDING A

05/28/21 ADDENDUM #1

06/03/21 ADDENDUM #2

06/08/21 ADDENDUM #3

06/10/21 ADDENDUM #4

AR11600005

9102 N. Meridian St., Ste. 300

Email info@GibraltarDesign.com

Homepage www.GibraltarDesign.com

Indianapolis, IN 46260

PROJECT

20 - 141

05/17/21

COORDINATED E

DRAWN BY

JKF, AB

REVISIONS

CHECKED BY

PROJECT

- H. REFER TO LIFE SAFETY PLANS REGARDING FIRE RATED WALL LOCATIONS AND OTHER CODE INFORMATION.
- I. INTERIOR CMU WALLS ARE TO BE RUNNING BOND UNLESS NOTED
- J. REFER TO FINISH PLANS FOR LOCATION AND EXTENT OF FINISHED FLOOR AND WALL MATERIAL.
- K. ALL EXPOSED CONCRETE MASONRY UNITS (CMU) CORNERS ARE TO BE BULLNOSED, EXCEPT AT MASONRY BULKHEADS AND EXTERIOR WINDOW

# PLAN LEGEND:


- [--] INDICATES STOREFRONT, CURTAIN WALL, OR WINDOW SYSTEM. REFER TO A-603 BUILDING 'D' ONLY FOR ELEVATIONS AND DETAILS.
- $\langle 
  angle$  indicates wall types refer to G-301 for wall thickness, height,

- (ALL PLAN NOTES MAY NOT BE INDICATED ON THIS SHEET.)
- (1) 2X2 ACOUSTICAL CEILING TILE.
- (3) ALUMINUM STOREFRONT.
- 4) CANOPY.
- 5) OVERHEAD POWER CHORD REELS REF "E" SERIES DRAWINGS.
- ) SCHOOL BUS OUTLINE POSITION. 12'-0" X12'-0" MOTOR OPERATED SECTIONAL OVERHEAD INSULATED  $^{\prime}$  garage door and track with vision panels. Vision panel location)
- PREFINISHED METAL WALL AND CEILING LINE PANELS WITH SEAM RAPE
- AND GASKETED SCREWS. SEE BUILDING SECTIONS.

  PEMB (PRE-ENGINEERED METAL BUILDING)-INSULATED WALLS MIN. R-13 AND ROOF MIN. R-19.
- EXTERIOR SINGLE DOORS (3'-0"W) AND DOUBLE (6'-0"W) TO BE FRE WITH ALUMINUM FRAME. ALL INTERIOR DOORS TO BE 3'-0" SOLID CORE WOOD WITH HOLLOW
- METAL FRAMES UNLESS NOTED OTHERWISE. ALL INTERIOR WALLS TO BE TYPE B8 AND INTERIOR CHASE WALLS TO BE
- (14) FLOOR DRAIN. SEE PLUMBING.
- 15) CONCRETE WALK. SEE CIVIL.
- 16) PLASTIC LAMINATED MAILBOXES. SEE A700 SERIES.
- (17) 4'-0"W X 6'-0"H FIXED ALUMINUM WINDOW.
- (18) HOLLOW METAL FRAMED WINDOW.
- (19) ELECTRIC WATER COOLER. ADA ACCESSIBLE. SEE PLUMBING.
- 3/4" FIRE TREATED PLYWOOD FROM FLOOR TO 8'-0" A.F.F. ON ALL SIDES OF INTERIOR PEMB GIRT SYSTEM. HOLD OFF FLOOR 1/2". PAINT.
- 21) ELECTRICAL EQUIPMENT. SEE ELECTRICAL. (22) DOOR ACCESS CONTROL.
- 23) KITCHENETTE: BASE/WALL CABINETS, SS SINK. SEE A700 SERIES.
- (24) HOLLOW METAL DOOR AND FRAME.
- 4" THICK 5'-0" X 5'-0" MIN. CONCRETE STOOP SLOPE AWAY FROM DOOR AT 1/4:12. TURN EDGES DOWN.
- (26) FURNACE. SEE MECHANICAL.
- 27) SOLID PLASTIC TOILET PARTITIONS. REFER TO SPECIFICATIONS.
- (28) AUTOMATIC BUS WASHING SYSTEM. REFER TO SPECIFICATIONS.
- 29) BRICK VENEER OVER PEMB. (30) INSULATED METAL PANELS OVER 8" CMU WALL CONSTRUCTION.
- 31) WALL LOUVER. SEE MECHANICAL.
- 32) MILLWORK. SEE A700 SERIES.
- (33) SPECIALTY BACK WALL (USE OF ACRYLIC).
- (34) MANUAL OPERATION FOLDING WALL SYSTEM WITH POCKET DOORS.
- (35) VMC, PANELIZED BACK WALL (WOOD OR P.LAM) W/ REPRESSED TECHNOLOGY BOARDS.
- (36) BUS WASH EQUIPMENT. SEE PLUMBING.
- (37) IN-GROUND BUS LIFT. SEE STRUCTURAL.
- (38) FIRE CONNECTION. SEE CIVIL.
- (40) REFRIGERATOR BY OWNER. (41) PREFINISHED METAL DOWNSPOUT WITH ALUMINUM BOOT. COORDINATE WITH
- (42) OIL SEPARATOR. SEE PLUMBING.
- (43) ACCESS DOOR 16" X 24". (44) EYEWASH STATION. SEE PLUMBING.
- (45) MOP BASIN. CONNECT TO OIL SEPARATOR. SEE PLUMBING.
- (46) CLEAN SINK. CONNECT TO OIL SEPARATOR. SEE PLUMBING.  $\sqrt{2}$ (47) 12'-0" X 12'-0" MOTOR OPERATED ROLL-UP DOOR WITH VISION PANEL.
- (48) ADA 36"X36" TRANSFER SHOWER. SEE PLUMBING.
- (49) ALTERNATE: CHECKER PLATE STEEL STAIR.
- (50) ALTERNATE: METAL GUARD RAIL.
- WALL EXHAUST FAN MOUNTED TO ROOF STRUCTURE. SEE MECHANICAL EQUIPMENT SCHEDULE FOR UNIT WEIGHT.
- UNIT HEATER MOUNTED TO ROOF STRUCTURE. SEE MECHANICAL EQUIPMENT SCHEDULE FOR UNIT WEIGHT.
- (5.3) ROOF EXHAUST FAN. SEE MECHANICAL EQUIPMENT SCHEDULE FOR UNIT
- (54) WALL MOUNT EXHAUST LOUVER ABOVE DOOR. SEE MECHANICAL.
- (55) PACKAGE A/C UNIT. SEE MECHANICAL. (56) FRP PANEL ON FIRE RETARDANT TREATED PLYWOOD 8'-0" HIGH.
- 57) PEMB CROSS BRACING. PAINT.
- (58) METAL LOCKERS (ONE ADA).
- 59) ADA CLOTHES HOOK.
- (60) FIRE EXTINGUISHER AND CABINET.
- (61) ALTERNATE: APPROXIMATE LOCATION OF ROOFTOP HVAC UNIT. SEE MECHANICAL. PROVIDE ROOF CURB FOR STANDARD PEMB ROOFING.
- 62) WALL MOUNTED ELECTRIC CABINET HEATER. SEE MECHANICAL.
- (63) 12" WIDE SHELF WITH CLOTHES ROD. SEE A700 SERIES.
- (64) CAST-IN-PLACE CONCRETE WALL 4'-0" HIGH. (65) POWER RECEPTACLE. SEE ELECTRICAL.
- (66) BASE/WALL CABINETS. SEE A700 SERIES. (67) 8'-0" X 8'-0" SECTIONAL OVERHEAD INSULATED DOOR AND TRACK.
- AUTOMATIC DOOR ACTUATOR FOR HC/ADA DOOR OPERATOR. COORDINATE 1\MASONRY PIER, GYPSUM BOARD WALL OR ALUMINUM MULLION.
- (69) WALL MOUNTED ELECTRICAL CABINET HEATER. SEE MECHANICAL. (70) CHAIN—LINK FENCE ENCLOSURE. 8'—0" HIGH.
- 71) ALTERNATE: IN-GROUND BUS LIFT AT SECOND SERVICE POSITION. FIRE DEPARTMENT KNOX BOX. COORDINATE INSTALL LOCATION WITH LOCAL FIRE DEPARTMENT. TYPICAL (4) BUILDINGS.

© GIBRALTAR DESIGN SHEET 73 FIRE DEPARTMENT SPRINKLER CONNECTION AND ALARM BELL SEE FIRE PROTECTION SHEETS. A-102

BUILDING A BUS WASH FLOOR PLAN

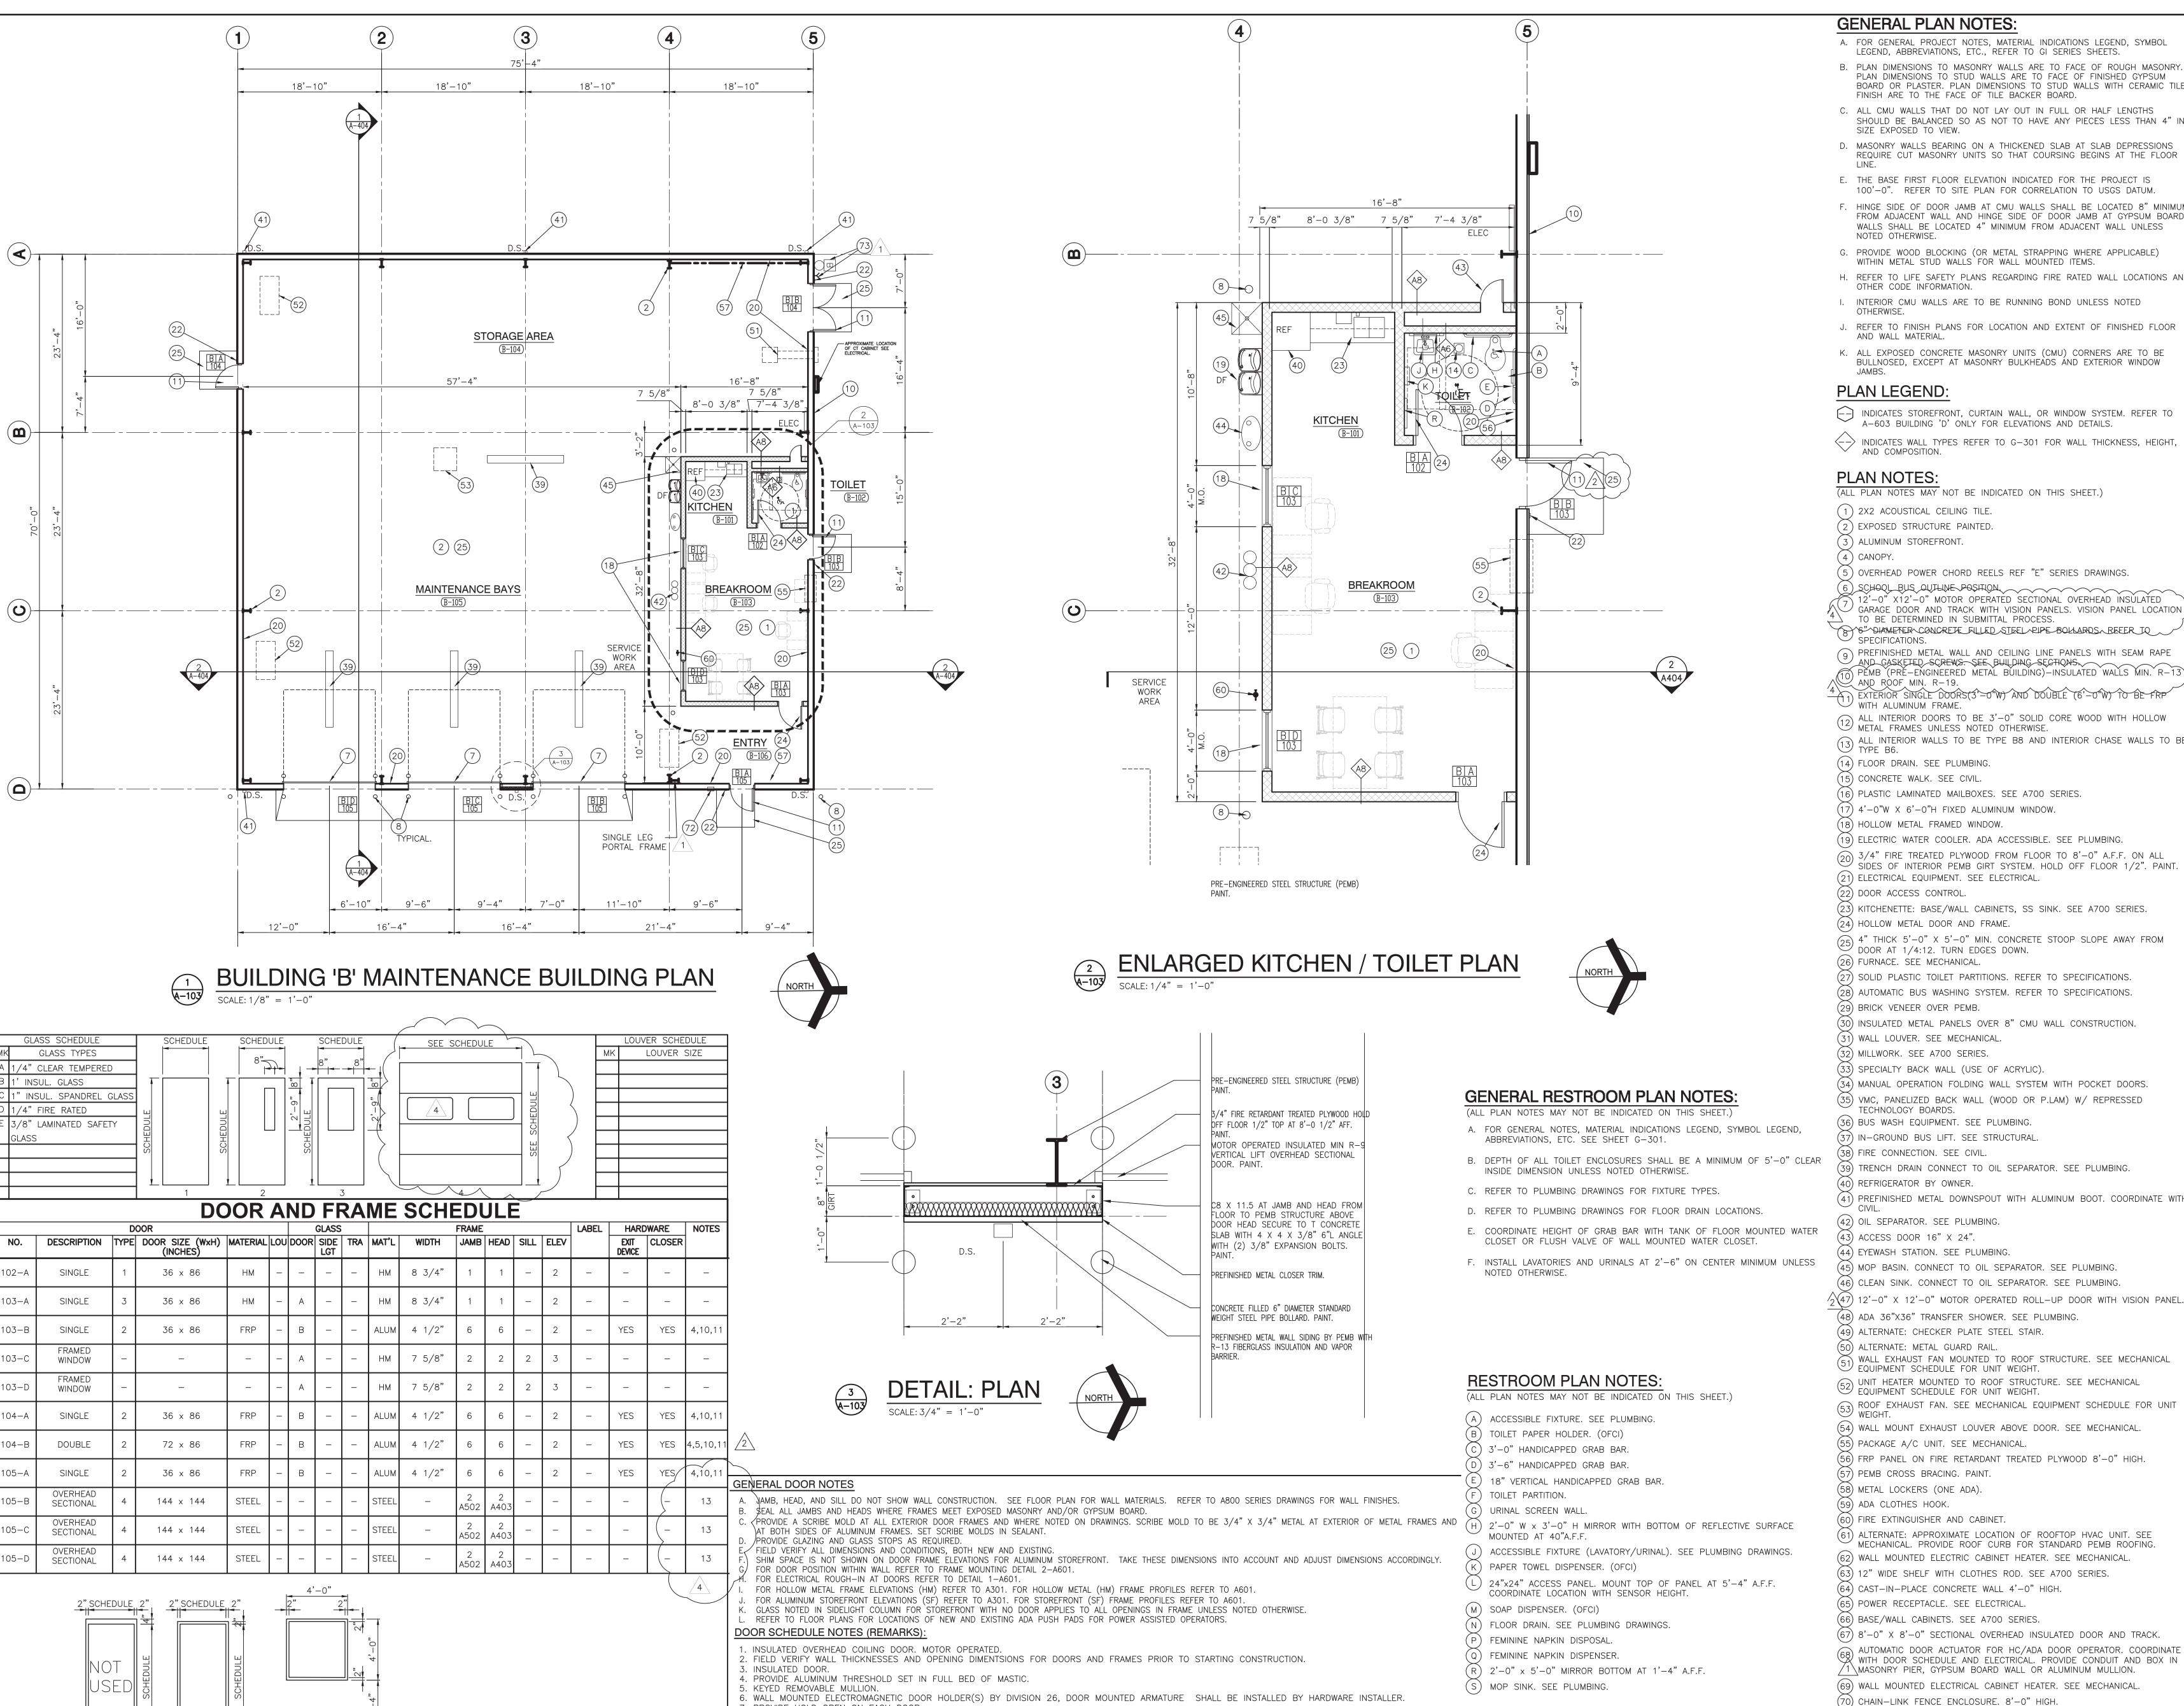

7. PROVIDE HOLD OPEN ON EACH DOOR.

9. PROVIDE DÓOR RELEASE ON AI PHONE LOCATED AT RECEPTION DESK.

10. PANIC DEVICE TO HAVE ELECTRIC LATCH BOLT. PREPARE FRAME FOR ELECTRIFIED HINGE.

11. DOOR TO BE CONTROLLED BY CARD READER/FOB. REFER TO ELECTRICAL DRAWINGS FOR ROUGH IN.

12. PROVIDE POWER ASSISTED OPERATOR ON ONE LEAF OF DOUBLE DOORS.

13. MOTOR OPERATED WISULATED OVERHEAD SECTIONAL DOOR WITH VISION PANELS. VISION PANEL LOCATION TO BE DETERMINED IN SUBMITTAL

8. (NOT USED)

FRAME TYPE ELEVATIONS

SCALE: 1/4" = 1'-0"

**GENERAL PLAN NOTES:** 

SIZE EXPOSED TO VIEW.

- A. FOR GENERAL PROJECT NOTES, MATERIAL INDICATIONS LEGEND, SYMBOL LEGEND, ABBREVIATIONS, ETC., REFER TO GI SERIES SHEETS.
- B. PLAN DIMENSIONS TO MASONRY WALLS ARE TO FACE OF ROUGH MASONRY. PLAN DIMENSIONS TO STUD WALLS ARE TO FACE OF FINISHED GYPSUM BOARD OR PLASTER. PLAN DIMENSIONS TO STUD WALLS WITH CERAMIC TILE
- FINISH ARE TO THE FACE OF TILE BACKER BOARD. C. ALL CMU WALLS THAT DO NOT LAY OUT IN FULL OR HALF LENGTHS SHOULD BE BALANCED SO AS NOT TO HAVE ANY PIECES LESS THAN 4" IN
- D. MASONRY WALLS BEARING ON A THICKENED SLAB AT SLAB DEPRESSIONS REQUIRE CUT MASONRY UNITS SO THAT COURSING BEGINS AT THE FLOOR
- E. THE BASE FIRST FLOOR ELEVATION INDICATED FOR THE PROJECT IS
- 100'-0". REFER TO SITE PLAN FOR CORRELATION TO USGS DATUM. F. HINGE SIDE OF DOOR JAMB AT CMU WALLS SHALL BE LOCATED 8" MINIMUM GIBRALTAR FROM ADJACENT WALL AND HINGE SIDE OF DOOR JAMB AT GYPSUM BOARD WALLS SHALL BE LOCATED 4" MINIMUM FROM ADJACENT WALL UNLESS
- G. PROVIDE WOOD BLOCKING (OR METAL STRAPPING WHERE APPLICABLE) WITHIN METAL STUD WALLS FOR WALL MOUNTED ITEMS.
- H. REFER TO LIFE SAFETY PLANS REGARDING FIRE RATED WALL LOCATIONS AND OTHER CODE INFORMATION.
- I. INTERIOR CMU WALLS ARE TO BE RUNNING BOND UNLESS NOTED
- OTHERWISE. J. REFER TO FINISH PLANS FOR LOCATION AND EXTENT OF FINISHED FLOOR AND WALL MATERIAL.
- K. ALL EXPOSED CONCRETE MASONRY UNITS (CMU) CORNERS ARE TO BE BULLNOSED, EXCEPT AT MASONRY BULKHEADS AND EXTERIOR WINDOW

# PLAN LEGEND:

NOTED OTHERWISE.

AND COMPOSITION.

 $\leftarrow$  - Indicates wall types refer to G-301 for wall thickness, height,

A-603 BUILDING 'D' ONLY FOR ELEVATIONS AND DETAILS.

# **PLAN NOTES:**

(1) 2X2 ACOUSTICAL CEILING TILE.

(2) EXPOSED STRUCTURE PAINTED. (3) ALUMINUM STOREFRONT.

(4) CANOPY.

(5) OVERHEAD POWER CHORD REELS REF "E" SERIES DRAWINGS.

(6) SCHOOL BUS OUTLINE POSITION. 12'-0" X12'-0" MOTOR OPERATED SECTIONAL OVERHEAD INSULATED  $^\prime$  Garage door and track with vision panels. Vision panel location TO BE DETERMINED IN SUBMITTAL PROCESS. 6"^6"^DIAMETER CONCRETE FILLED STEEL PIPE BOLLARDS DEFER TO

PREFINISHED METAL WALL AND CEILING LINE PANELS WITH SEAM RAPE ND GASKETED SCREWS. SEE BUILDING SECTIONS. ή PĚMB (PRĚ-EŇGINEERED METAL BŮILDÍNG)-INSULATED WALLS MIN. R-13 AND ROOF MIN. R-19.

A 1 EXTERIOR SINGLE DOORS(3'-0"W) AND DOUBLE (6'-0"W) TO BE FRE ' WITH ALUMINUM FRAME. ALL INTERIOR DOORS TO BE 3'-0" SOLID CORE WOOD WITH HOLLOW

METAL FRAMES UNLESS NOTED OTHERWISE. ALL INTERIOR WALLS TO BE TYPE B8 AND INTERIOR CHASE WALLS TO BE

(14) FLOOR DRAIN. SEE PLUMBING.

(15) CONCRETE WALK. SEE CIVIL. (16) PLASTIC LAMINATED MAILBOXES. SEE A700 SERIES.

(17) 4'-0"W X 6'-0"H FIXED ALUMINUM WINDOW.

(18) HOLLOW METAL FRAMED WINDOW.

(19) ELECTRIC WATER COOLER. ADA ACCESSIBLE. SEE PLUMBING. 3/4" FIRE TREATED PLYWOOD FROM FLOOR TO 8'-0" A.F.F. ON ALL  $^{\prime}$  SIDES OF INTERIOR PEMB GIRT SYSTEM. HOLD OFF FLOOR 1/2". PAINT.

21) ELECTRICAL EQUIPMENT. SEE ELECTRICAL. 22) DOOR ACCESS CONTROL.

23) KITCHENETTE: BASE/WALL CABINETS, SS SINK. SEE A700 SERIES.

(24) HOLLOW METAL DOOR AND FRAME. 4" THICK 5'-0" X 5'-0" MIN. CONCRETE STOOP SLOPE AWAY FROM

DOOR AT 1/4:12. TURN EDGES DOWN. (26) FURNACE. SEE MECHANICAL

(7) SOLID PLASTIC TOILET PARTITIONS. REFER TO SPECIFICATIONS. 28) AUTOMATIC BUS WASHING SYSTEM. REFER TO SPECIFICATIONS 29) BRICK VENEER OVER PEMB.

60) INSULATED METAL PANELS OVER 8" CMU WALL CONSTRUCTION.

1) WALL LOUVER. SEE MECHANICAL

32) MILLWORK. SEE A700 SERIES. 33) SPECIALTY BACK WALL (USE OF ACRYLIC).

(34) MANUAL OPERATION FOLDING WALL SYSTEM WITH POCKET DOORS. 35) VMC, PANELIZED BACK WALL (WOOD OR P.LAM) W/ REPRESSED

TECHNOLOGY BOARDS. 36) BUS WASH EQUIPMENT. SEE PLUMBING. 57) IN—GROUND BUS LIFT. SEE STRUCTURAL

38) FIRE CONNECTION. SEE CIVIL. (9) TRENCH DRAIN CONNECT TO OIL SEPARATOR. SEE PLUMBING.

(40) REFRIGERATOR BY OWNER.

(41) PREFINISHED METAL DOWNSPOUT WITH ALUMINUM BOOT. COORDINATE WIT

(42) OIL SEPARATOR. SEE PLUMBING.

) ACCESS DOOR 16" X 24". 44) EYEWASH STATION. SEE PLUMBING.

45) MOP BASIN. CONNECT TO OIL SEPARATOR. SEE PLUMBING.

(46) CLEAN SINK. CONNECT TO OIL SEPARATOR. SEE PLUMBING.

(47) 12'-0" x 12'-0" motor operated roll-up door with vision panel

(48) ADA 36"X36" TRANSFER SHOWER. SEE PLUMBING. (49) ALTERNATE: CHECKER PLATE STEEL STAIR.

50) ALTERNATE: METAL GUARD RAIL

WALL EXHAUST FAN MOUNTED TO ROOF STRUCTURE. SEE MECHANICAL ン EQUIPMENT SCHEDULE FOR UNIT WEIGHT. 50 UNIT HEATER MOUNTED TO ROOF STRUCTURE. SEE MECHANICAL

ROOF EXHAUST FAN. SEE MECHANICAL EQUIPMENT SCHEDULE FOR UNIT

(54) WALL MOUNT EXHAUST LOUVER ABOVE DOOR. SEE MECHANICAL. (55) PACKAGE A/C UNIT. SEE MECHANICAL.

1\masonry pier, gypsum board wall or aluminum mullion.

(71) ALTERNATE: IN-GROUND BUS LIFT AT SECOND SERVICE POSITION.

773) FIRE DEPARTMENT SPRINKLER CONNECTION AND ALARM BELL SEE FIRE

(56) FRP PANEL ON FIRE RETARDANT TREATED PLYWOOD 8'-0" HIGH.

57) PEMB CROSS BRACING. PAINT. 58) METAL LOCKERS (ONE ADA). 59) ADA CLOTHES HOOK.

(60) FIRE EXTINGUISHER AND CABINET.

(61) ALTERNATE: APPROXIMATE LOCATION OF ROOFTOP HVAC UNIT. SEE MECHANICAL. PROVIDE ROOF CURB FOR STANDARD PEMB ROOFING.

FIRE DEPARTMENT. TYPICAL (4) BUILDINGS.

PROTECTION SHEETS.

(62) WALL MOUNTED ELECTRIC CABINET HEATER. SEE MECHANICAL. (63) 12" WIDE SHELF WITH CLOTHES ROD. SEE A700 SERIES.

(64) CAST-IN-PLACE CONCRETE WALL 4'-0" HIGH. (65) POWER RECEPTACLE. SEE ELECTRICAL.

(W) BABY CHANGING TABLE.

GIBRALTAR DESIGN 102 N. Meridian St., Ste. 300 ndianapolis, IN 46260 Homepage www.GibraltarDesign.com Email info@GibraltarDesign.com Phone 317.580.5777 Fax 317.580.5778

DESIGN

ARCHITECTURE • ENGINEERING • INTERIOR DESIGN

HANOVER CSC NEW

RELATED WORK

CEDAR LAKE, INDIANA

CORPORATION

RESOURCE CENTER AND

HANOVER COMMUNITY SCHOOL

20 - 141

05/17/21 AR11600005 COORDINATED E DRAWN BY JKF, AB CHECKED BY

THE CONCEPTS, DESIGNS, PLANS, DETAILS, ETC, SHOWN ON THIS DOCUMENT ARE THE PROPERTY OF GIBRALTAR DESIGN A THIS INFORMATION SHALL BE USED BY ANY PERSON OR FIRM FOR ANY PURPOSE WITHOUT THE EXPRESS WRITTEN CONSENT OF GIBRALTAR DESIGN. THE OWNER MAY RETAIN COPIES FOR FORMATION AND REFERENCE IN CONNECTION ONLY WITH TH

MARK DATE ISSUED FOR |05/28/21| ADDENDUM #1 |06/03/21| ADDENDUM #2 06/08/21 ADDENDUM #3


|06/10/21| ADDENDUM #4

DRAWING FLOOR PLAN MAINTENANCE BUILDING

HANOVER CSC NEW RESOURCE CENTER AND RELATED WORK

BUILDING B

FIRE DEPARTMENT KNOX BOX. COORDINATE INSTALL LOCATION WITH LOCAL CIBRALTAR DESIGN SHEET

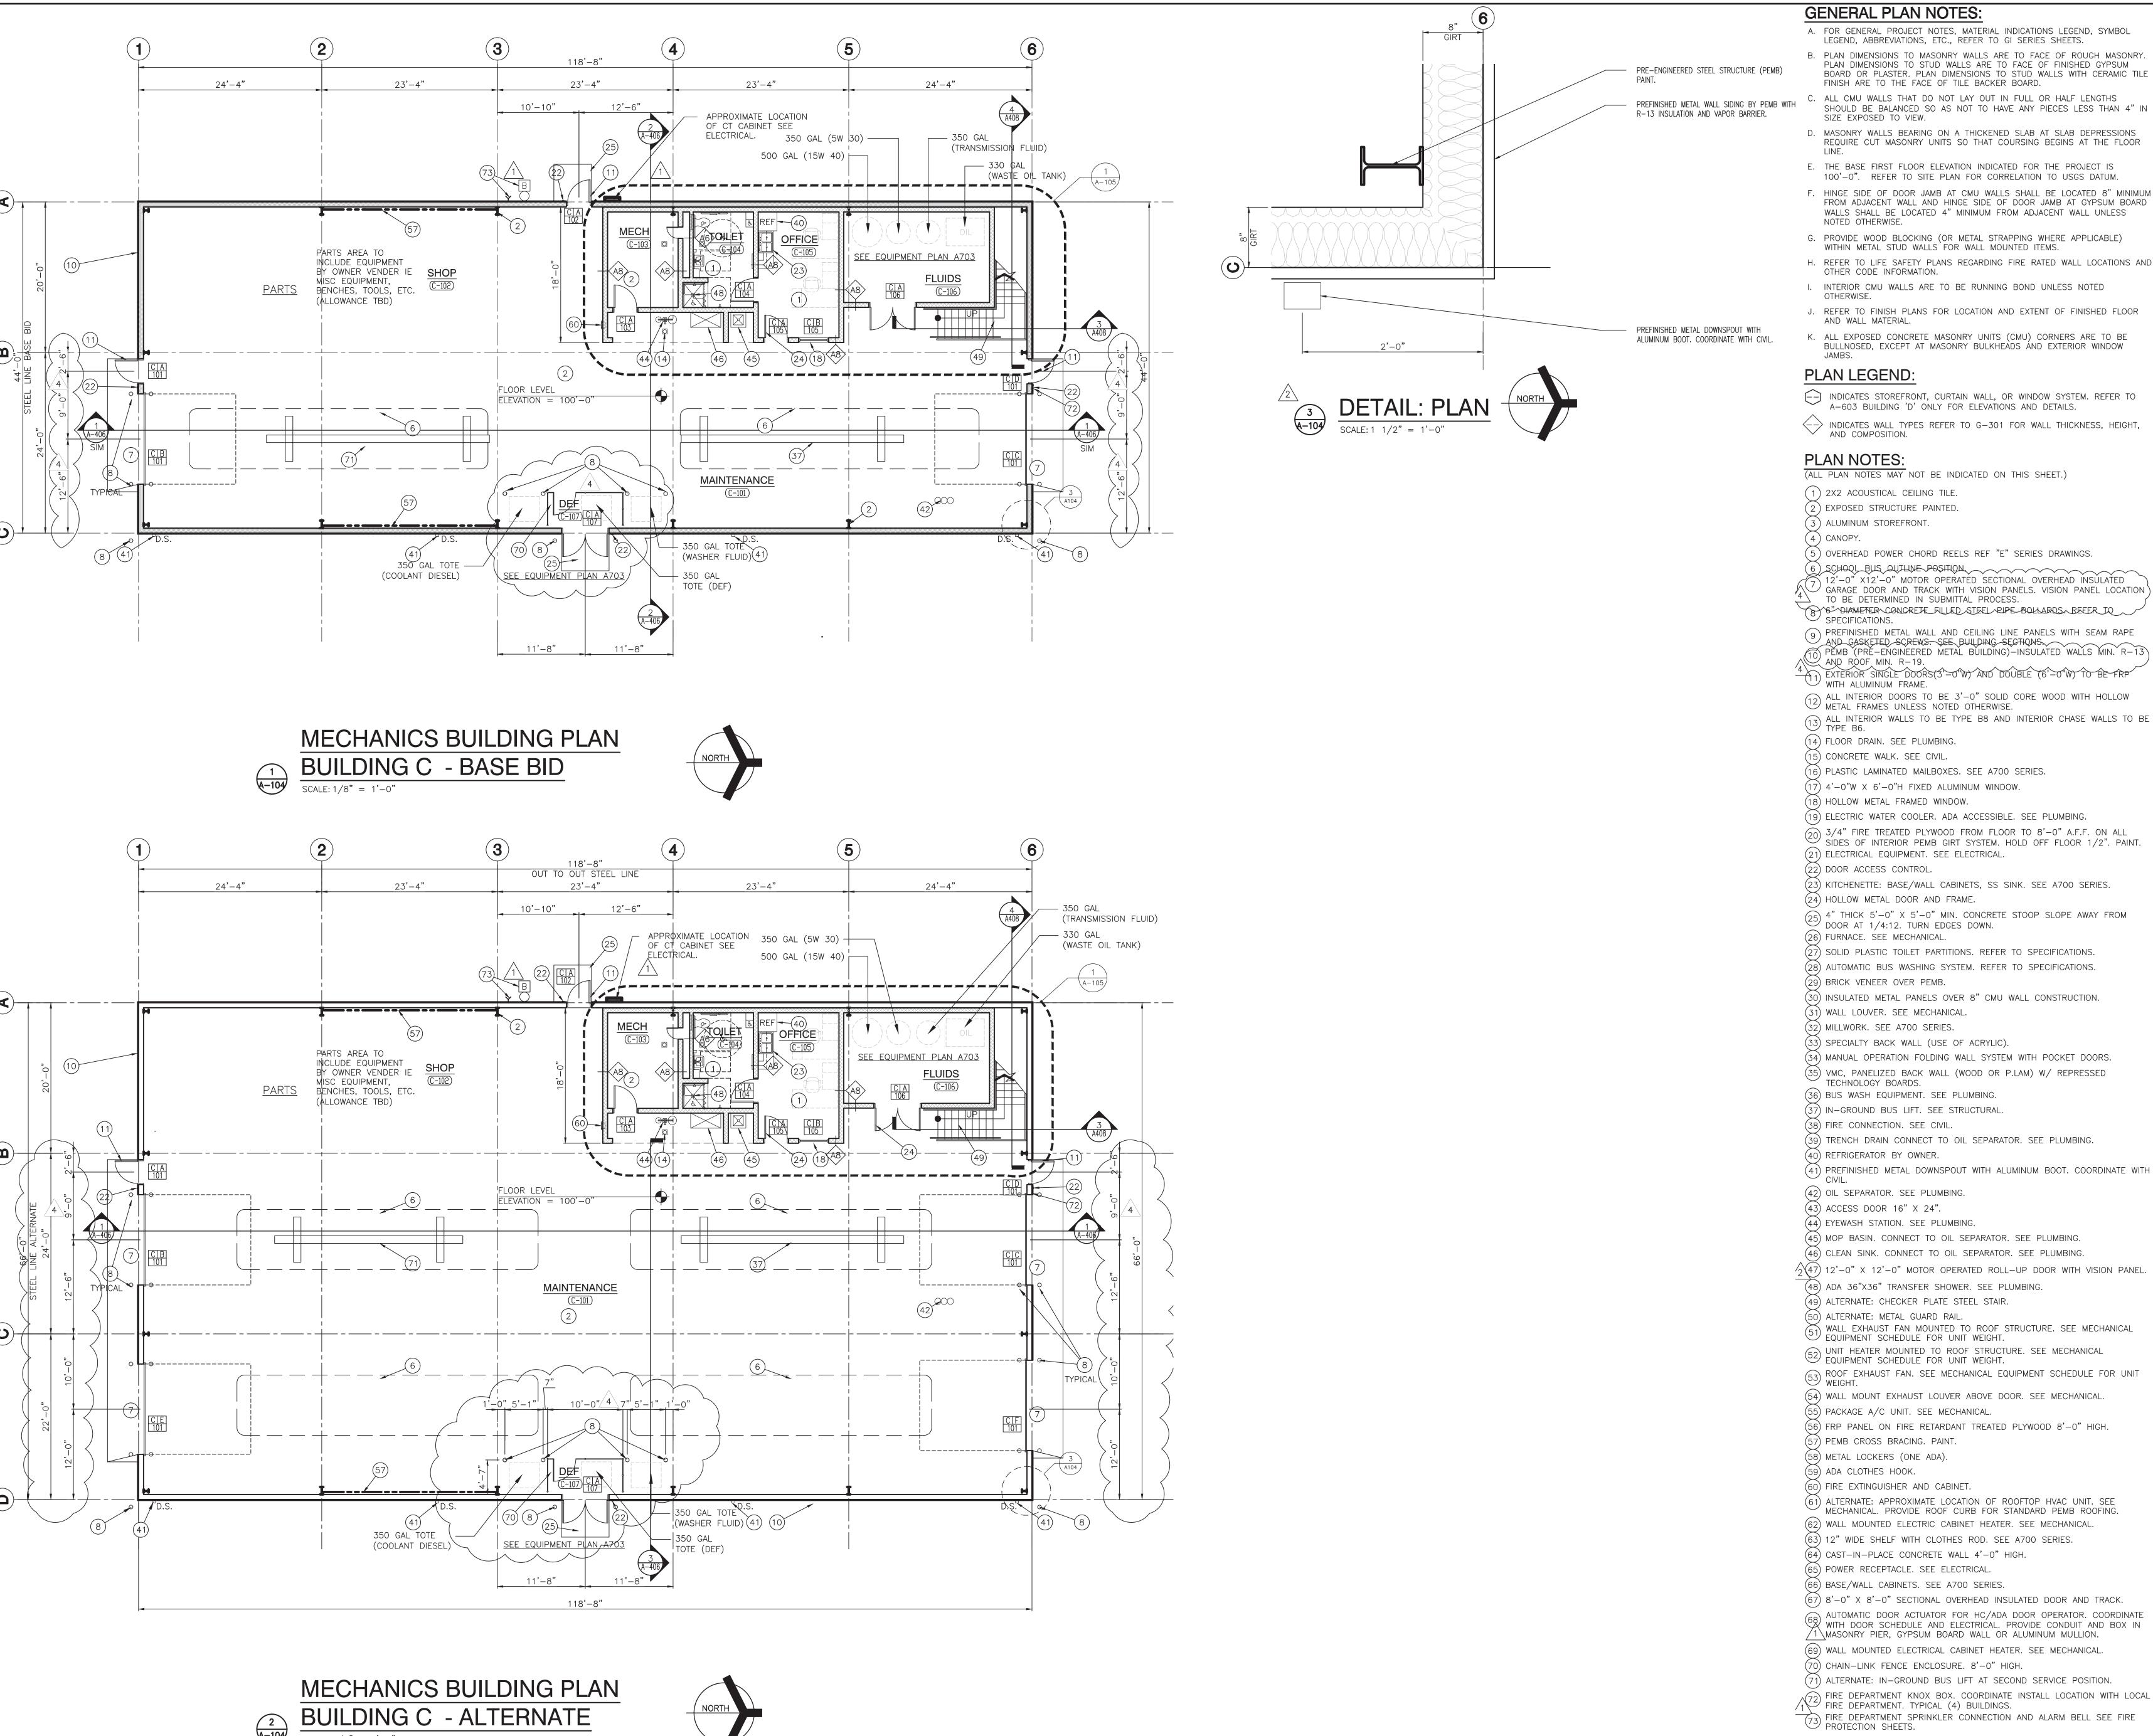

**GENERAL PLAN NOTES:** 

A. FOR GENERAL PROJECT NOTES, MATERIAL INDICATIONS LEGEND, SYMBOL LEGEND, ABBREVIATIONS, ETC., REFER TO GI SERIES SHEETS.

B. PLAN DIMENSIONS TO MASONRY WALLS ARE TO FACE OF ROUGH MASONRY. PLAN DIMENSIONS TO STUD WALLS ARE TO FACE OF FINISHED GYPSUM BOARD OR PLASTER. PLAN DIMENSIONS TO STUD WALLS WITH CERAMIC TILE

FINISH ARE TO THE FACE OF TILE BACKER BOARD. C. ALL CMU WALLS THAT DO NOT LAY OUT IN FULL OR HALF LENGTHS SHOULD BE BALANCED SO AS NOT TO HAVE ANY PIECES LESS THAN 4" IN SIZE EXPOSED TO VIEW.

D. MASONRY WALLS BEARING ON A THICKENED SLAB AT SLAB DEPRESSIONS REQUIRE CUT MASONRY UNITS SO THAT COURSING BEGINS AT THE FLOOR

E. THE BASE FIRST FLOOR ELEVATION INDICATED FOR THE PROJECT IS 100'-0". REFER TO SITE PLAN FOR CORRELATION TO USGS DATUM.

F. HINGE SIDE OF DOOR JAMB AT CMU WALLS SHALL BE LOCATED 8" MINIMUM GIBRALTAR FROM ADJACENT WALL AND HINGE SIDE OF DOOR JAMB AT GYPSUM BOARD WALLS SHALL BE LOCATED 4" MINIMUM FROM ADJACENT WALL UNLESS

G. PROVIDE WOOD BLOCKING (OR METAL STRAPPING WHERE APPLICABLE) WITHIN METAL STUD WALLS FOR WALL MOUNTED ITEMS.

OTHER CODE INFORMATION. I. INTERIOR CMU WALLS ARE TO BE RUNNING BOND UNLESS NOTED

J. REFER TO FINISH PLANS FOR LOCATION AND EXTENT OF FINISHED FLOOR

K. ALL EXPOSED CONCRETE MASONRY UNITS (CMU) CORNERS ARE TO BE BULLNOSED, EXCEPT AT MASONRY BULKHEADS AND EXTERIOR WINDOW

# PLAN LEGEND:

INDICATES STOREFRONT, CURTAIN WALL, OR WINDOW SYSTEM. REFER TO A-603 BUILDING 'D' ONLY FOR ELEVATIONS AND DETAILS.

 $\langle -- \rangle$  INDICATES WALL TYPES REFER TO G-301 FOR WALL THICKNESS, HEIGHT,

# **PLAN NOTES:**

(2) EXPOSED STRUCTURE PAINTED.

(3) ALUMINUM STOREFRONT.

(5) OVERHEAD POWER CHORD REELS REF "E" SERIES DRAWINGS.

(6) SCHOOL BUS OUTLINE POSITION

12'-0" X12'-0" MOTOR OPERATED SECTIONAL OVERHEAD INSULATED o garage door and track with vision panels. Vision panel location TO BE DETERMINED IN SUBMITTAL PROCESS. TO 16" DIAMETER CONCRETE FILLED STEEL PLPE BOLLARDS BEFER TO

9 PREFINISHED METAL WALL AND CEILING LINE PANELS WITH SEAM RAPE AND GASKETED SCREWS. SEE BUILDING SECTIONS. PĚMB (PRĚ-ENGINEERED METAL BŮILDÍNG)-INSULATED WALLS MIN. R-13 AND ROOF MIN. R-19.

WITH ALUMINUM FRAME. ALL INTERIOR DOORS TO BE 3'-0" SOLID CORE WOOD WITH HOLLOW

METAL FRAMES UNLESS NOTED OTHERWISE.

ALL INTERIOR WALLS TO BE TYPE B8 AND INTERIOR CHASE WALLS TO BE

(14) FLOOR DRAIN. SEE PLUMBING.

(15) CONCRETE WALK. SEE CIVIL.

(16) PLASTIC LAMINATED MAILBOXES. SEE A700 SERIES.

(17) 4'-0"W X 6'-0"H FIXED ALUMINUM WINDOW.

(18) HOLLOW METAL FRAMED WINDOW. (19) ELECTRIC WATER COOLER. ADA ACCESSIBLE. SEE PLUMBING.

 $_{20}$  3/4" FIRE TREATED PLYWOOD FROM FLOOR TO 8'-0" A.F.F. ON ALL SIDES OF INTERIOR PEMB GIRT SYSTEM. HOLD OFF FLOOR 1/2". PAINT.

21) ELECTRICAL EQUIPMENT. SEE ELECTRICAL.

(23) KITCHENETTE: BASE/WALL CABINETS, SS SINK. SEE A700 SERIES.

(24) HOLLOW METAL DOOR AND FRAME.  $_{25}$  4" THICK 5'-0" X 5'-0" MIN. CONCRETE STOOP SLOPE AWAY FROM

DOOR AT 1/4:12. TURN EDGES DOWN. (26) FURNACE. SEE MECHANICAL.

27) SOLID PLASTIC TOILET PARTITIONS. REFER TO SPECIFICATIONS.

 $\left(28
ight)$  automatic bus washing system. Refer to specifications.

(29) BRICK VENEER OVER PEMB.

30) INSULATED METAL PANELS OVER 8" CMU WALL CONSTRUCTION. 31) WALL LOUVER. SEE MECHANICAL.

32) MILLWORK. SEE A700 SERIES.

(33) SPECIALTY BACK WALL (USE OF ACRYLIC).

(34) MANUAL OPERATION FOLDING WALL SYSTEM WITH POCKET DOORS. 35) VMC, PANELIZED BACK WALL (WOOD OR P.LAM) W/ REPRESSED

TECHNOLOGY BOARDS. (36) BUS WASH EQUIPMENT. SEE PLUMBING.

(37) IN—GROUND BUS LIFT. SEE STRUCTURAL.

(38) FIRE CONNECTION. SEE CIVIL.

(39) TRENCH DRAIN CONNECT TO OIL SEPARATOR. SEE PLUMBING.

(40) REFRIGERATOR BY OWNER.

(41) PREFINISHED METAL DOWNSPOUT WITH ALUMINUM BOOT. COORDINATE WIT

(42) OIL SEPARATOR. SEE PLUMBING.

(43) ACCESS DOOR 16" X 24".

(44) EYEWASH STATION. SEE PLUMBING. (45) MOP BASIN. CONNECT TO OIL SEPARATOR. SEE PLUMBING.

(46) CLEAN SINK. CONNECT TO OIL SEPARATOR. SEE PLUMBING.

(47) 12'-0" X 12'-0" MOTOR OPERATED ROLL-UP DOOR WITH VISION PANEL

(48) ADA 36"X36" TRANSFER SHOWER. SEE PLUMBING.

(49) ALTERNATE: CHECKER PLATE STEEL STAIR.

(50) ALTERNATE: METAL GUARD RAIL. WALL EXHAUST FAN MOUNTED TO ROOF STRUCTURE. SEE MECHANICAL EQUIPMENT SCHEDULE FOR UNIT WEIGHT.

ROOF EXHAUST FAN. SEE MECHANICAL EQUIPMENT SCHEDULE FOR UNIT

(54) WALL MOUNT EXHAUST LOUVER ABOVE DOOR. SEE MECHANICAL.

(55) PACKAGE A/C UNIT. SEE MECHANICAL. (56) FRP PANEL ON FIRE RETARDANT TREATED PLYWOOD 8'-0" HIGH.

(57) PEMB CROSS BRACING. PAINT.

(58) METAL LOCKERS (ONE ADA).

(59) ADA CLOTHES HOOK. (60) FIRE EXTINGUISHER AND CABINET.

(61) ALTERNATE: APPROXIMATE LOCATION OF ROOFTOP HVAC UNIT. SEE

MECHANICAL. PROVIDE ROOF CURB FOR STANDARD PEMB ROOFING. (62) WALL MOUNTED ELECTRIC CABINET HEATER. SEE MECHANICAL.

(63) 12" WIDE SHELF WITH CLOTHES ROD. SEE A700 SERIES.

(64) CAST-IN-PLACE CONCRETE WALL 4'-0" HIGH.

(65) POWER RECEPTACLE. SEE ELECTRICAL.

(66) BASE/WALL CABINETS. SEE A700 SERIES.

(67) 8'-0" X 8'-0" SECTIONAL OVERHEAD INSULATED DOOR AND TRACK.

AUTOMATIC DOOR ACTUATOR FOR HC/ADA DOOR OPERATOR. COORDINATE 1\masonry pier, gypsum board wall or aluminum mullion.

(69) WALL MOUNTED ELECTRICAL CABINET HEATER. SEE MECHANICAL. (70) CHAIN-LINK FENCE ENCLOSURE. 8'-0" HIGH.

(71) ALTERNATE: IN-GROUND BUS LIFT AT SECOND SERVICE POSITION. FIRE DEPARTMENT KNOX BOX. COORDINATE INSTALL LOCATION WITH LOCAL CIBRALTAR DESIGN SHEET FIRE DEPARTMENT. TYPICAL (4) BUILDINGS.

773) FIRE DEPARTMENT SPRINKLER CONNECTION AND ALARM BELL SEE FIRE

DESIGN ARCHITECTURE • ENGINEERING • INTERIOR DESIGN

HANOVER CSC NEW **RESOURCE CENTER AND RELATED WORK** 

HANOVER COMMUNITY SCHOOL CORPORATION CEDAR LAKE, INDIANA

GIBRALTAR DESIGN 9102 N. Meridian St., Ste. 300 ndianapolis, IN 46260 Homepage www.GibraltarDesign.com Email info@GibraltarDesign.com

Phone 317.580.5777 Fax 317.580.5778

PROJECT 20 - 14105/17/21 COORDINATED B DRAWN BY JKF, AB

CHECKED BY

AR11600005

THE CONCEPTS, DESIGNS, PLANS, DETAILS, ETC, SHOWN ON THIS DOCUMENT ARE THE PROPERTY OF GIBRALTAR DESIGN AN WERE CREATED FOR USE ON THIS SPECIFIC PROJECT. NONE OI THIS INFORMATION SHALL BE USED BY ANY PERSON OR FIRM FOR ANY PURPOSE WITHOUT THE EXPRESS WRITTEN CONSENT OF GIBRALTAR DESIGN. THE OWNER MAY RETAIN COPIES FOR INFORMATION AND REFERENCE IN CONNECTION ONLY WITH THIS DEPOLICE.


MARK DATE ISSUED FOR

|05/28/21| ADDENDUM #1 06/03/21 ADDENDUM #2 06/08/21 ADDENDUM #3 |06/10/21| ADDENDUM #4

DRAWING

FLOOR PLANS MECHANICS BUILDING **BUILDING C** 

HANOVER CSC NEW RESOURCE CENTER AND RELATED WORK

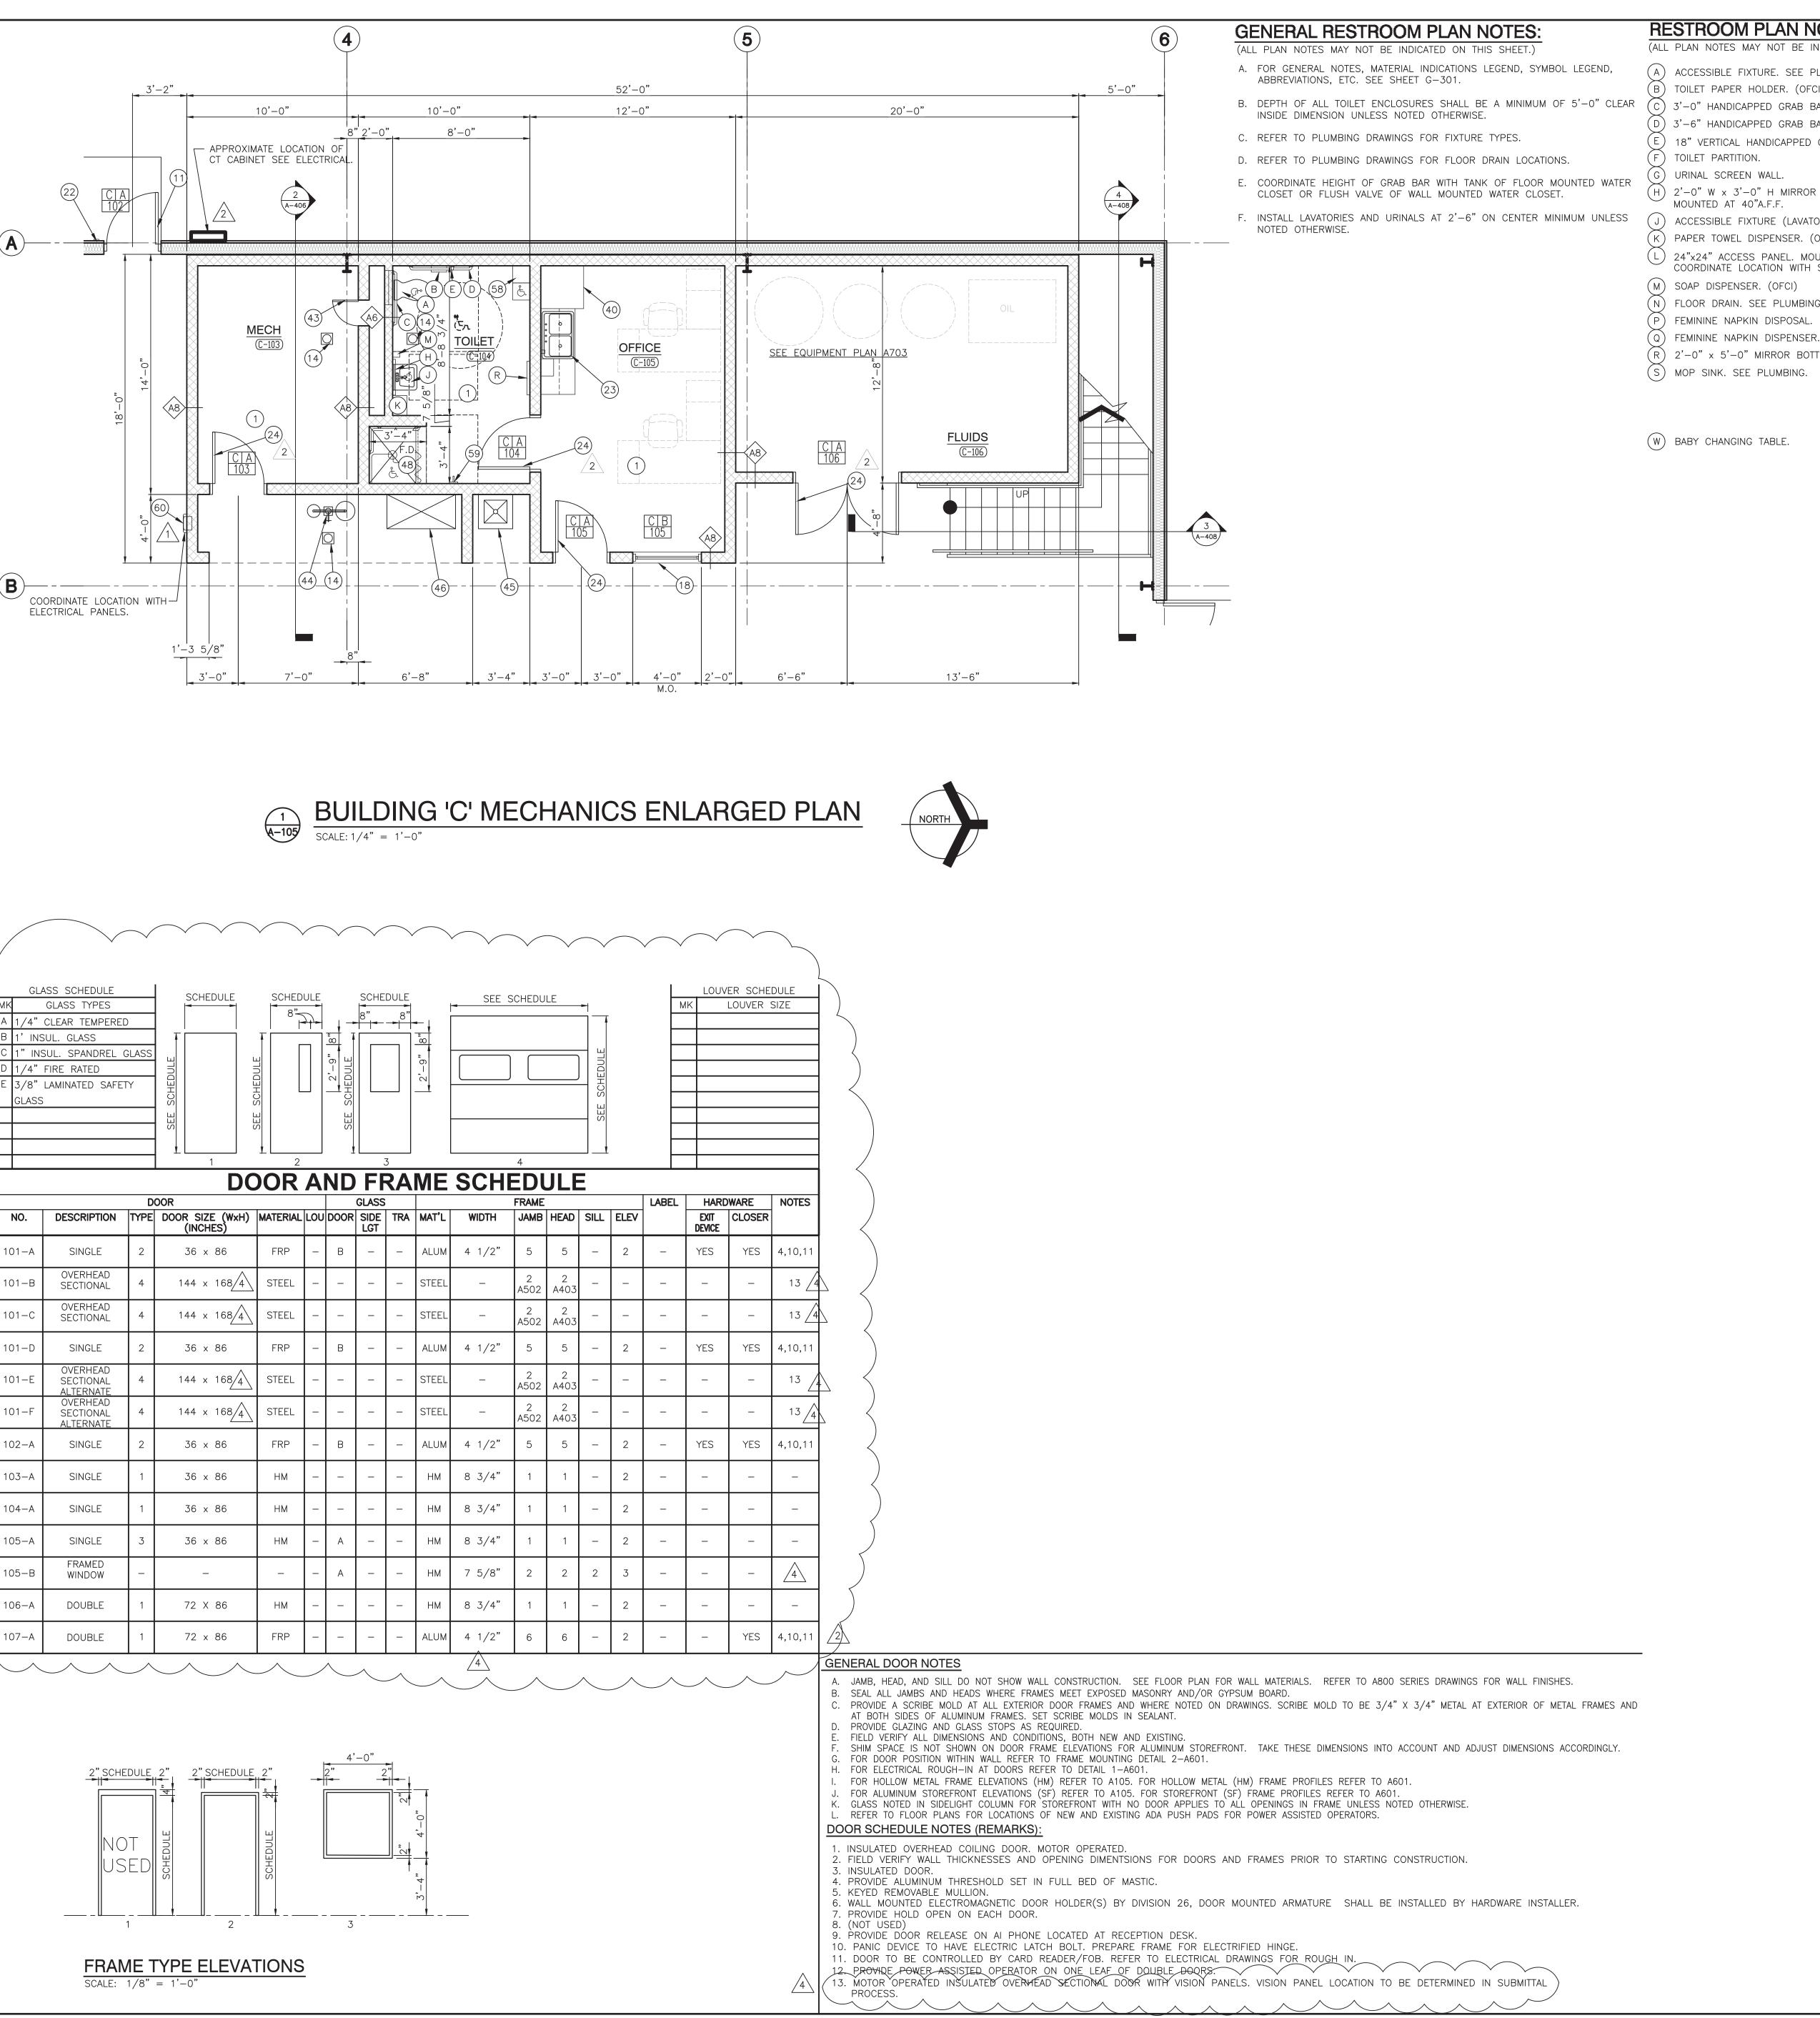

**RESTROOM PLAN NOTES:** 

(ALL PLAN NOTES MAY NOT BE INDICATED ON THIS SHEET.)

(A) ACCESSIBLE FIXTURE. SEE PLUMBING. (B) TOILET PAPER HOLDER. (OFCI)

(C) 3'-0" HANDICAPPED GRAB BAR.

(D) 3'-6" HANDICAPPED GRAB BAR. (E) 18" VERTICAL HANDICAPPED GRAB BAR.

G) URINAL SCREEN WALL.

(H) 2'-0" W  $\times$  3'-0" H MIRROR WITH BOTTOM OF REFLECTIVE SURFACE MOUNTED AT 40"A.F.F.

J) ACCESSIBLE FIXTURE (LAVATORY/URINAL). SEE PLUMBING DRAWINGS. (K) PAPER TOWEL DISPENSER. (OFCI)

L) 24"x24" ACCESS PANEL. MOUNT TOP OF PANEL AT 5'-4" A.F.F. COORDINATE LOCATION WITH SENSOR HEIGHT.

(M) SOAP DISPENSER. (OFCI)

(N) FLOOR DRAIN. SEE PLUMBING DRAWINGS. (P) FEMININE NAPKIN DISPOSAL.

(R)  $2'-0" \times 5'-0"$  MIRROR BOTTOM AT 1'-4" A.F.F.

# **GENERAL PLAN NOTES:**

- A. FOR GENERAL PROJECT NOTES, MATERIAL INDICATIONS LEGEND, SYMBOL LEGEND, ABBREVIATIONS, ETC., REFER TO GI SERIES SHEETS.
- B. PLAN DIMENSIONS TO MASONRY WALLS ARE TO FACE OF ROUGH MASONRY. PLAN DIMENSIONS TO STUD WALLS ARE TO FACE OF FINISHED GYPSUM BOARD OR PLASTER. PLAN DIMENSIONS TO STUD WALLS WITH CERAMIC TILE FINISH ARE TO THE FACE OF TILE BACKER BOARD.
- C. ALL CMU WALLS THAT DO NOT LAY OUT IN FULL OR HALF LENGTHS SHOULD BE BALANCED SO AS NOT TO HAVE ANY PIECES LESS THAN 4" IN SIZE EXPOSED TO VIEW.
- D. MASONRY WALLS BEARING ON A THICKENED SLAB AT SLAB DEPRESSIONS REQUIRE CUT MASONRY UNITS SO THAT COURSING BEGINS AT THE FLOOR
- E. THE BASE FIRST FLOOR ELEVATION INDICATED FOR THE PROJECT IS
- 100'-0". REFER TO SITE PLAN FOR CORRELATION TO USGS DATUM. F. HINGE SIDE OF DOOR JAMB AT CMU WALLS SHALL BE LOCATED 8" MINIMUM GIBRALTAR FROM ADJACENT WALL AND HINGE SIDE OF DOOR JAMB AT GYPSUM BOARD WALLS SHALL BE LOCATED 4" MINIMUM FROM ADJACENT WALL UNLESS
- G. PROVIDE WOOD BLOCKING (OR METAL STRAPPING WHERE APPLICABLE) WITHIN METAL STUD WALLS FOR WALL MOUNTED ITEMS.
- H. REFER TO LIFE SAFETY PLANS REGARDING FIRE RATED WALL LOCATIONS AND OTHER CODE INFORMATION.
- I. INTERIOR CMU WALLS ARE TO BE RUNNING BOND UNLESS NOTED
- OTHERWISE. J. REFER TO FINISH PLANS FOR LOCATION AND EXTENT OF FINISHED FLOOR AND WALL MATERIAL.
- K. ALL EXPOSED CONCRETE MASONRY UNITS (CMU) CORNERS ARE TO BE BULLNOSED, EXCEPT AT MASONRY BULKHEADS AND EXTERIOR WINDOW

# PLAN LEGEND:

[--] INDICATES STOREFRONT, CURTAIN WALL, OR WINDOW SYSTEM. REFER TO A-603 BUILDING 'D' ONLY FOR ELEVATIONS AND DETAILS.

 $\langle - 
angle$  INDICATES WALL TYPES REFER TO G-301 FOR WALL THICKNESS, HEIGHT, AND COMPOSITION.

# **PLAN NOTES:**

(ALL PLAN NOTES MAY NOT BE INDICATED ON THIS SHEET.) (1) 2X2 ACOUSTICAL CEILING TILE.

(2) EXPOSED STRUCTURE PAINTED.

 $(\ 3\ )$  ALUMINUM STOREFRONT. (4) CANOPY.

(5) OVERHEAD POWER CHORD REELS REF "E" SERIES DRAWINGS.

(6) SCHOOL BUS OUTLINE POSITION 12'-0" X12'-0" MOTOR OPERATED SECTIONAL OVERHEAD INSULATED  $^{\prime\prime}$  garage door and track with vision panels. Vision panel location TO BE DETERMINED IN SUBMITTAL PROCESS.

ANY 6" A DHAMETER CONCRETE FILLED STEEL PLPE BOLLARDS A REFER TO

SPECIFICATIONS. PREFINISHED METAL WALL AND CEILING LINE PANELS WITH SEAM RAPE AND GASKETED SCREWS. SEE BUILDING SECTIONS. PĚMB (PRĚ-EŇGINEERED METAL BŮILDÍNG)-INSULATED WALLS MIN. R-13

AND ROOF MIN. R-19. A DEXTERIOR SINGLE DOORS (3'-0"W) AND DOUBLE (6'-0"W) TO BE FRE WITH ALUMINUM FRAME.

ALL INTERIOR DOORS TO BE 3'-0" SOLID CORE WOOD WITH HOLLOW METAL FRAMES UNLESS NOTED OTHERWISE.

ALL INTERIOR WALLS TO BE TYPE B8 AND INTERIOR CHASE WALLS TO BE

(14) FLOOR DRAIN. SEE PLUMBING.

(15) CONCRETE WALK. SEE CIVIL.

(16) PLASTIC LAMINATED MAILBOXES. SEE A700 SERIES.

(17) 4'-0"W X 6'-0"H FIXED ALUMINUM WINDOW.

(18) HOLLOW METAL FRAMED WINDOW. (19) ELECTRIC WATER COOLER. ADA ACCESSIBLE. SEE PLUMBING.

20 3/4" FIRE TREATED PLYWOOD FROM FLOOR TO 8'-0" A.F.F. ON ALL SIDES OF INTERIOR PEMB GIRT SYSTEM. HOLD OFF FLOOR 1/2". PAINT.

(21) ELECTRICAL EQUIPMENT. SEE ELECTRICAL. (22) DOOR ACCESS CONTROL.

(23) KITCHENETTE: BASE/WALL CABINETS, SS SINK. SEE A700 SERIES. (24) HOLLOW METAL DOOR AND FRAME.

 $\sqrt{25}$  4" THICK 5'-0" X 5'-0" MIN. CONCRETE STOOP SLOPE AWAY FROM

DOOR AT 1/4:12. TURN EDGES DOWN. (26) FURNACE. SEE MECHANICAL.  $\left(27
ight)$  SOLID PLASTIC TOILET PARTITIONS. REFER TO SPECIFICATIONS.

(28) AUTOMATIC BUS WASHING SYSTEM. REFER TO SPECIFICATIONS (29) BRICK VENEER OVER PEMB.

(30) INSULATED METAL PANELS OVER 8" CMU WALL CONSTRUCTION.

31) WALL LOUVER. SEE MECHANICAL.

(32) MILLWORK. SEE A700 SERIES. (33) SPECIALTY BACK WALL (USE OF ACRYLIC). (34) MANUAL OPERATION FOLDING WALL SYSTEM WITH POCKET DOORS.

(35) VMC, PANELIZED BACK WALL (WOOD OR P.LAM) W/ REPRESSED TECHNOLOGY BOARDS. (36) BUS WASH EQUIPMENT. SEE PLUMBING.

(37) IN-GROUND BUS LIFT. SEE STRUCTURAL. (38) FIRE CONNECTION. SEE CIVIL.

(39) TRENCH DRAIN CONNECT TO OIL SEPARATOR. SEE PLUMBING.

(40) REFRIGERATOR BY OWNER.

(41) PREFINISHED METAL DOWNSPOUT WITH ALUMINUM BOOT. COORDINATE WIT

(42) OIL SEPARATOR. SEE PLUMBING.

(43) ACCESS DOOR 16" X 24". (44) EYEWASH STATION. SEE PLUMBING.

(45) MOP BASIN. CONNECT TO OIL SEPARATOR. SEE PLUMBING.

(46) CLEAN SINK. CONNECT TO OIL SEPARATOR. SEE PLUMBING.  $\mathcal{N}(47)$  12'-0" X 12'-0" MOTOR OPERATED ROLL-UP DOOR WITH VISION PANEL

(48) ADA 36"X36" TRANSFER SHOWER. SEE PLUMBING.

(49) ALTERNATE: CHECKER PLATE STEEL STAIR.

(50) ALTERNATE: METAL GUARD RAIL NALL EXHAUST FAN MOUNTED TO ROOF STRUCTURE. SEE MECHANICAL

 $\stackrel{\smile\smile}{\smile}$  equipment schedule for unit weight. (52) UNIT HEATER MOUNTED TO ROOF STRUCTURE. SEE MECHANICAL EQUIPMENT SCHEDULE FOR UNIT WEIGHT.

ROOF EXHAUST FAN. SEE MECHANICAL EQUIPMENT SCHEDULE FOR UNIT (54) WALL MOUNT EXHAUST LOUVER ABOVE DOOR. SEE MECHANICAL.

(55) PACKAGE A/C UNIT. SEE MECHANICAL. (56) FRP PANEL ON FIRE RETARDANT TREATED PLYWOOD 8'-0" HIGH.

(57) PEMB CROSS BRACING. PAINT. (58) METAL LOCKERS (ONE ADA). (59) ADA CLOTHES HOOK.

(60) FIRE EXTINGUISHER AND CABINET.

(61) ALTERNATE: APPROXIMATE LOCATION OF ROOFTOP HVAC UNIT. SEE MECHANICAL. PROVIDE ROOF CURB FOR STANDARD PEMB ROOFING.

(62) WALL MOUNTED ELECTRIC CABINET HEATER. SEE MECHANICAL.

(63) 12" WIDE SHELF WITH CLOTHES ROD. SEE A700 SERIES. (64) CAST-IN-PLACE CONCRETE WALL 4'-0" HIGH.

(65) POWER RECEPTACLE. SEE ELECTRICAL. (66) BASE/WALL CABINETS. SEE A700 SERIES.

(67) 8'-0" X 8'-0" SECTIONAL OVERHEAD INSULATED DOOR AND TRACK.

AUTOMATIC DOOR ACTUATOR FOR HC/ADA DOOR OPERATOR. COORDINATE 1\masonry pier, gypsum board wall or aluminum mullion. (69) WALL MOUNTED ELECTRICAL CABINET HEATER. SEE MECHANICAL.

(70) CHAIN-LINK FENCE ENCLOSURE. 8'-0" HIGH. (71) ALTERNATE: IN-GROUND BUS LIFT AT SECOND SERVICE POSITION.

FIRE DEPARTMENT KNOX BOX. COORDINATE INSTALL LOCATION WITH LOCAL CIBRALTAR DESIGN SHEET FIRE DEPARTMENT. TYPICAL (4) BUILDINGS. FIRE DEPARTMENT SPRINKLER CONNECTION AND ALARM BELL SEE FIRE PROTECTION SHEETS.



ARCHITECTURE • ENGINEERING • INTERIOR DESIGN

PROJECT HANOVER CSC NEW RESOURCE CENTER AND **RELATED WORK** 

HANOVER COMMUNITY SCHOOL CORPORATION CEDAR LAKE, INDIANA

GIBRALTAR DESIGN 3102 N. Meridian St., Ste. 300 ndianapolis, IN 46260

Email info@GibraltarDesign.com Phone 317.580.5777 Fax 317.580.5778 PROJECT 20 - 14105/17/21

DRAWN BY

JKF, AB

Homepage www.GibraltarDesign.com


AR11600005 COORDINATED E CHECKED BY

THE CONCEPTS, DESIGNS, PLANS, DETAILS, ETC, SHOWN ON THIS DOCUMENT ARE THE PROPERTY OF GIBRALTAR DESIGN AI THIS INFORMATION SHALL BE USED BY ANY PERSON OR FIRM FOR ANY PURPOSE WITHOUT THE EXPRESS WRITTEN CONSENT OF GIBRALTAR DESIGN. THE OWNER MAY RETAIN COPIES FOR FORMATION AND REFERENCE IN CONNECTION ONLY WITH THIS

MARK DATE ISSUED FOR |05/28/21| ADDENDUM #1 |06/03/21| ADDENDUM #2 06/08/21 ADDENDUM #3 |06/10/21| ADDENDUM #4

DRAWING FLOOR PLANS MECHANICS BUILDING BUILDING C

HANOVER CSC NEW RESOURCE CENTER AND RELATED WORK

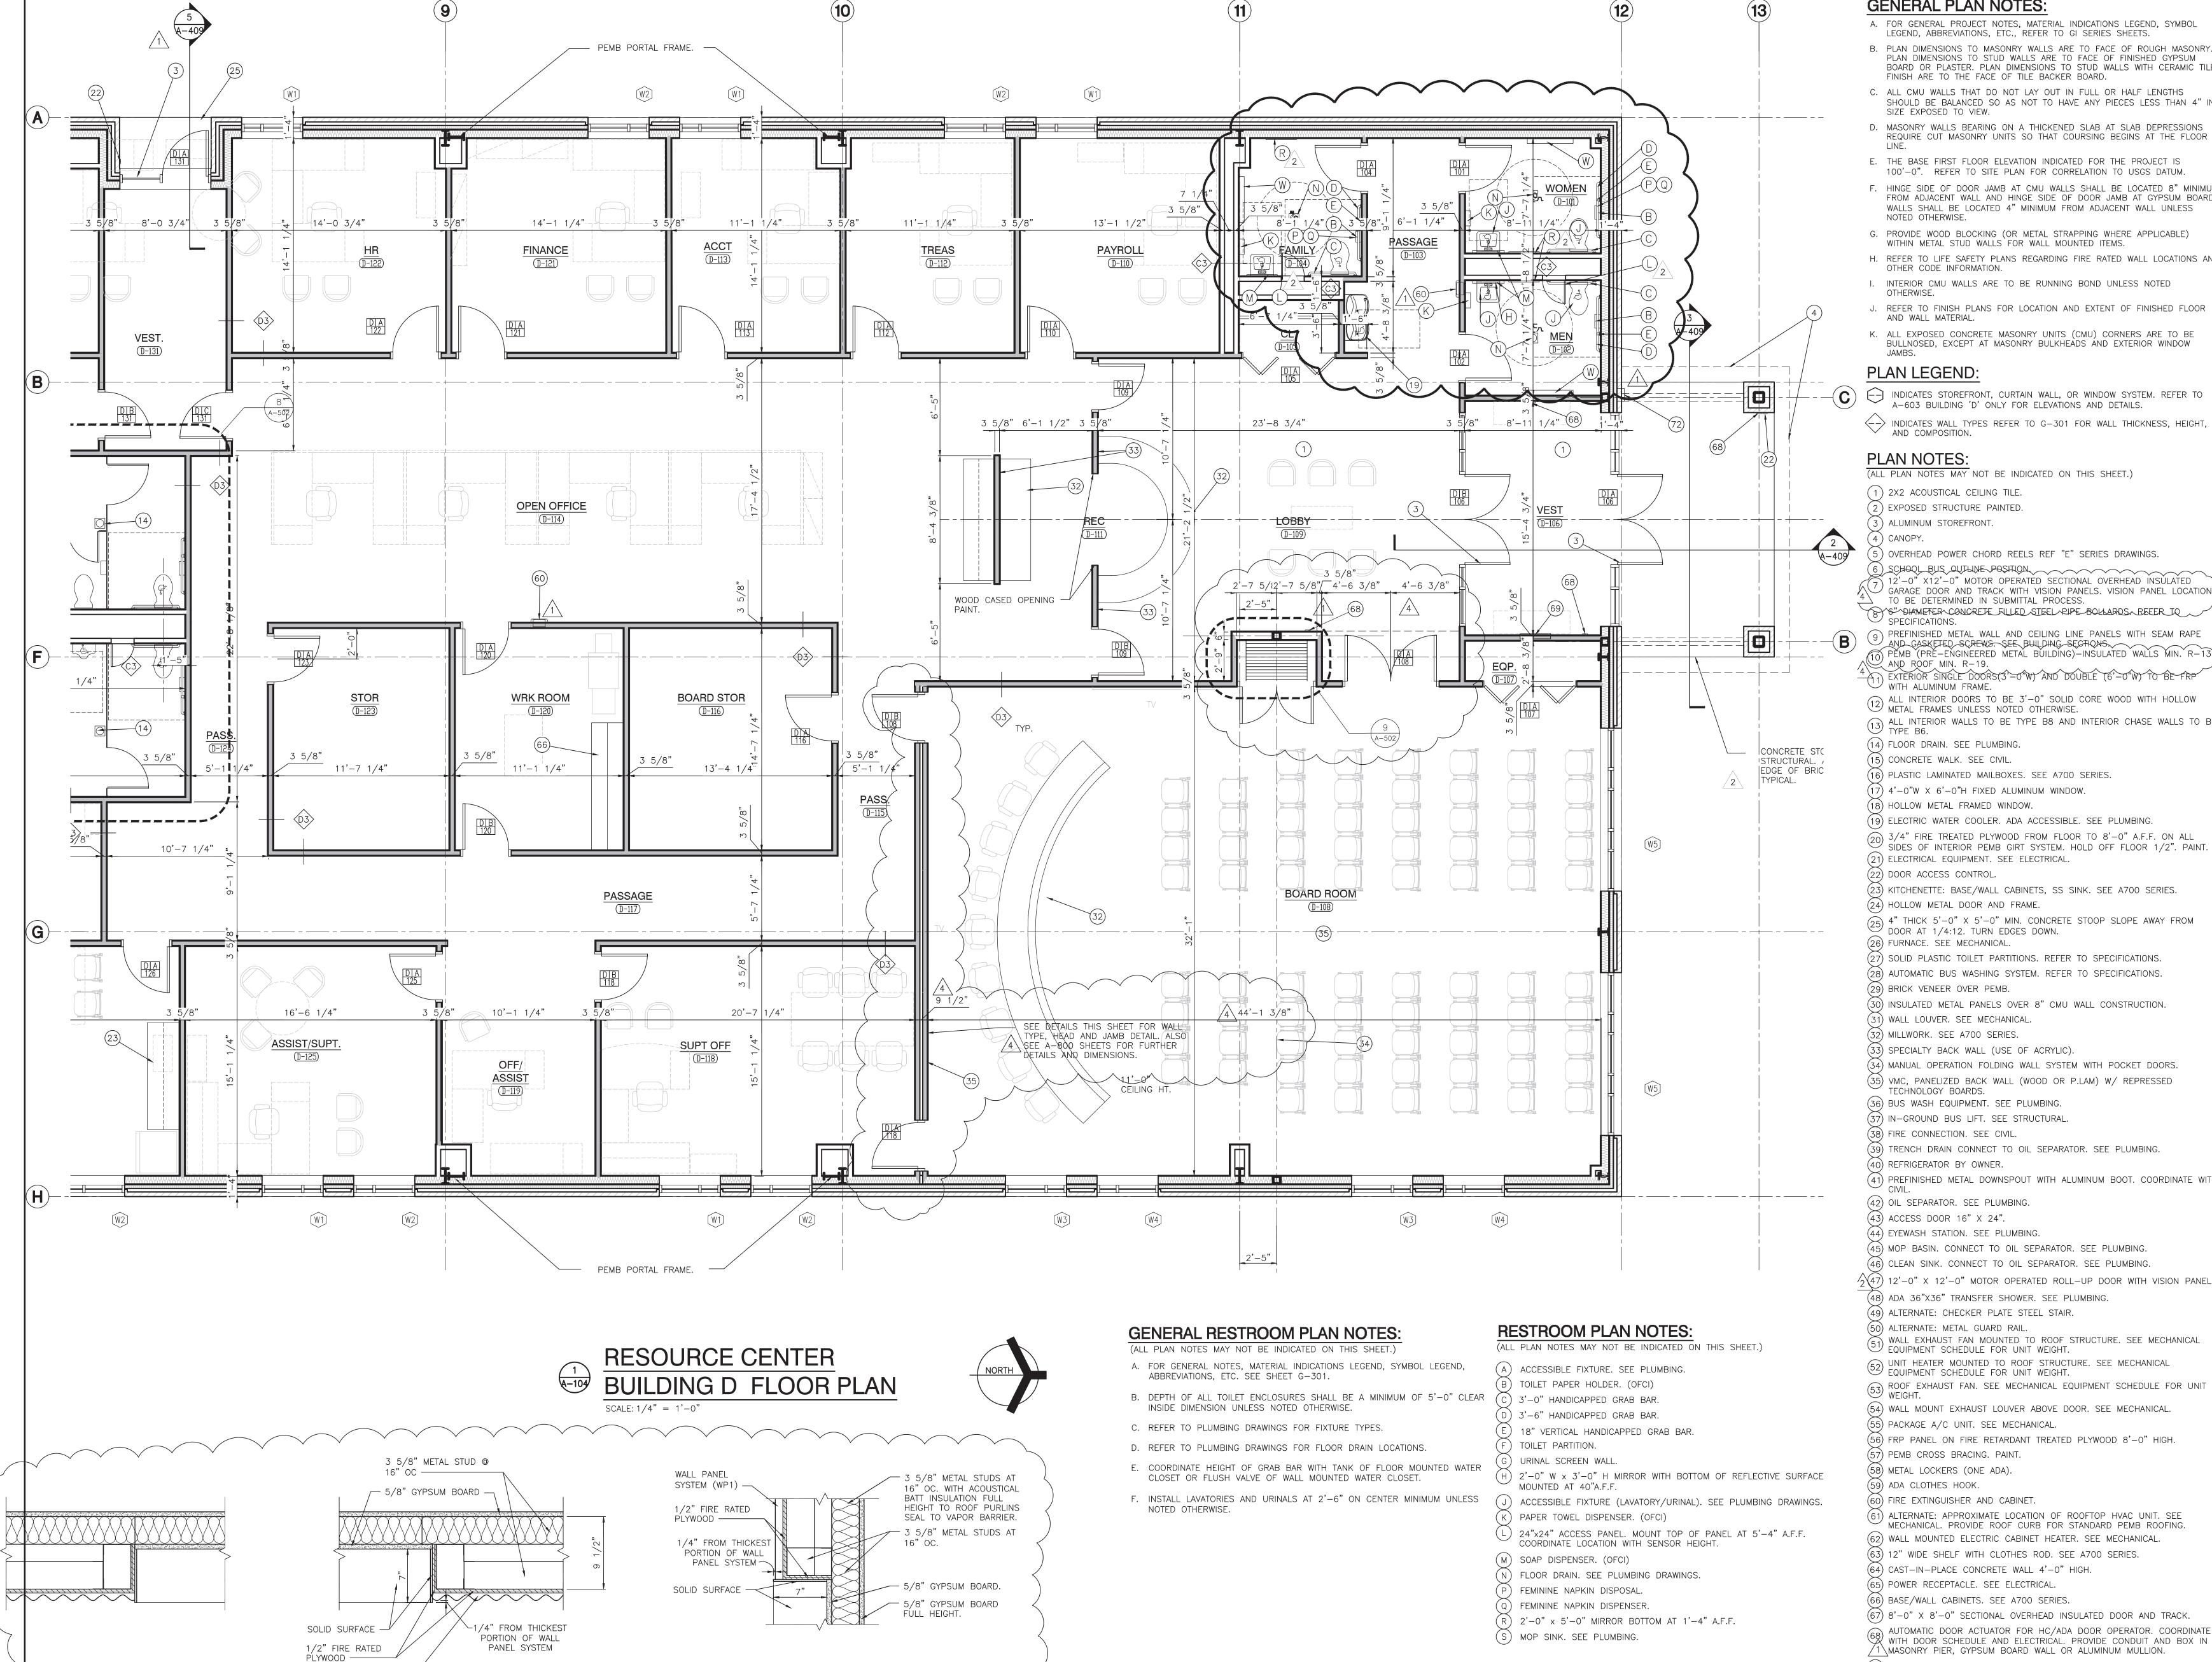

**DETAIL: HEAD SOUTH WALL** 

**BOARD ROOM D-108** 

WALL PANEL SYSTEM

(WP1) ———

**DETAIL: JAMB SOUTH WALL** 

**BOARD ROOM D-108** 

**GENERAL PLAN NOTES:** 

- A. FOR GENERAL PROJECT NOTES, MATERIAL INDICATIONS LEGEND, SYMBOL LEGEND, ABBREVIATIONS, ETC., REFER TO GI SERIES SHEETS.
- B. PLAN DIMENSIONS TO MASONRY WALLS ARE TO FACE OF ROUGH MASONRY. PLAN DIMENSIONS TO STUD WALLS ARE TO FACE OF FINISHED GYPSUM BOARD OR PLASTER. PLAN DIMENSIONS TO STUD WALLS WITH CERAMIC TILE
- C. ALL CMU WALLS THAT DO NOT LAY OUT IN FULL OR HALF LENGTHS SHOULD BE BALANCED SO AS NOT TO HAVE ANY PIECES LESS THAN 4" IN
- D. MASONRY WALLS BEARING ON A THICKENED SLAB AT SLAB DEPRESSIONS REQUIRE CUT MASONRY UNITS SO THAT COURSING BEGINS AT THE FLOOR
- E. THE BASE FIRST FLOOR ELEVATION INDICATED FOR THE PROJECT IS
- 100'-0". REFER TO SITE PLAN FOR CORRELATION TO USGS DATUM. F. HINGE SIDE OF DOOR JAMB AT CMU WALLS SHALL BE LOCATED 8" MINIMUM GIBRALTAR FROM ADJACENT WALL AND HINGE SIDE OF DOOR JAMB AT GYPSUM BOARD WALLS SHALL BE LOCATED 4" MINIMUM FROM ADJACENT WALL UNLESS
- G. PROVIDE WOOD BLOCKING (OR METAL STRAPPING WHERE APPLICABLE) WITHIN METAL STUD WALLS FOR WALL MOUNTED ITEMS.
- H. REFER TO LIFE SAFETY PLANS REGARDING FIRE RATED WALL LOCATIONS AND OTHER CODE INFORMATION.
- I. INTERIOR CMU WALLS ARE TO BE RUNNING BOND UNLESS NOTED OTHERWISE.
- J. REFER TO FINISH PLANS FOR LOCATION AND EXTENT OF FINISHED FLOOR AND WALL MATERIAL.
- K. ALL EXPOSED CONCRETE MASONRY UNITS (CMU) CORNERS ARE TO BE BULLNOSED, EXCEPT AT MASONRY BULKHEADS AND EXTERIOR WINDOW

# PLAN LEGEND:

- INDICATES STOREFRONT, CURTAIN WALL, OR WINDOW SYSTEM. REFER TO A-603 BUILDING 'D' ONLY FOR ELEVATIONS AND DETAILS.
- $\langle 
  angle$  indicates wall types refer to G–301 for wall thickness, height, AND COMPOSITION.

# **PLAN NOTES:**

(ALL PLAN NOTES MAY NOT BE INDICATED ON THIS SHEET.)

(1) 2X2 ACOUSTICAL CEILING TILE. (2) EXPOSED STRUCTURE PAINTED. ) ALUMINUM STOREFRONT.

5) OVERHEAD POWER CHORD REELS REF "E" SERIES DRAWINGS.

) SCHOOL BUS OUTLINE POSITION. 2'-0" X12'-0" MOTOR OPERATED SECTIONAL OVERHEAD INSULATED TO BE DETERMINED IN SUBMITTAL PROCESS. TO 6" DIAMETER CONCRETE FILLED STEEL PLPE BOLLARDS REFER TO

PREFINISHED METAL WALL AND CEILING LINE PANELS WITH SEAM RAPE AND GASKETED SCREWS. SEE BUILDING SECTIONS. , PĚMB (PRĚ-EŇGINEERED METAL BŮILDÍNG)-INSULATED WALLS MIN. R-13 AND ROOF MIN. R-19. A 1 EXTERIOR SINGLE DOORS(3'-0"W) AND DOUBLE (6'-0"W) TO BE FRE

WITH ALUMINUM FRAME. ALL INTERIOR DOORS TO BE 3'-0" SOLID CORE WOOD WITH HOLLOW METAL FRAMES UNLESS NOTED OTHERWISE.

ALL INTERIOR WALLS TO BE TYPE B8 AND INTERIOR CHASE WALLS TO BE

(14) FLOOR DRAIN. SEE PLUMBING. 15) CONCRETE WALK. SEE CIVIL.

(16) PLASTIC LAMINATED MAILBOXES. SEE A700 SERIES.

(17) 4'-0"W X 6'-0"H FIXED ALUMINUM WINDOW. (18) HOLLOW METAL FRAMED WINDOW.

(19) ELECTRIC WATER COOLER. ADA ACCESSIBLE. SEE PLUMBING.

20 3/4" FIRE TREATED PLYWOOD FROM FLOOR TO 8'-0" A.F.F. ON ALL  $^\prime$  SIDES OF INTERIOR PEMB GIRT SYSTEM. HOLD OFF FLOOR 1/2". PAINT. 21) ELECTRICAL EQUIPMENT. SEE ELECTRICAL.

23) KITCHENETTE: BASE/WALL CABINETS, SS SINK. SEE A700 SERIES. (24) HOLLOW METAL DOOR AND FRAME.

4" THICK 5'-0" X 5'-0" MIN. CONCRETE STOOP SLOPE AWAY FROM DOOR AT 1/4:12. TURN EDGES DOWN. (26) FURNACE. SEE MECHANICAL.

27) SOLID PLASTIC TOILET PARTITIONS. REFER TO SPECIFICATIONS. 28) AUTOMATIC BUS WASHING SYSTEM. REFER TO SPECIFICATIONS 29) BRICK VENEER OVER PEMB.

0) INSULATED METAL PANELS OVER 8" CMU WALL CONSTRUCTION.

1) WALL LOUVER. SEE MECHANICAL.

32) MILLWORK. SEE A700 SERIES.

33) SPECIALTY BACK WALL (USE OF ACRYLIC). (34) MANUAL OPERATION FOLDING WALL SYSTEM WITH POCKET DOORS. 35) VMC, PANELIZED BACK WALL (WOOD OR P.LAM) W/ REPRESSED

TECHNOLOGY BOARDS. (36) BUS WASH EQUIPMENT. SEE PLUMBING.

(37) IN—GROUND BUS LIFT. SEE STRUCTURAL (38) FIRE CONNECTION. SEE CIVIL.

(39) TRENCH DRAIN CONNECT TO OIL SEPARATOR. SEE PLUMBING.

(41) PREFINISHED METAL DOWNSPOUT WITH ALUMINUM BOOT. COORDINATE WIT

(42) OIL SEPARATOR. SEE PLUMBING.

(43) ACCESS DOOR 16" X 24".

(44) EYEWASH STATION. SEE PLUMBING. (45) MOP BASIN. CONNECT TO OIL SEPARATOR. SEE PLUMBING.

(46) CLEAN SINK. CONNECT TO OIL SEPARATOR. SEE PLUMBING.

(47) 12'-0" X 12'-0" MOTOR OPERATED ROLL-UP DOOR WITH VISION PANEL

(48) ADA 36"X36" TRANSFER SHOWER. SEE PLUMBING. (49) ALTERNATE: CHECKER PLATE STEEL STAIR.

50) ALTERNATE: METAL GUARD RAIL WALL EXHAUST FAN MOUNTED TO ROOF STRUCTURE. SEE MECHANICAL ン EQUIPMENT SCHEDULE FOR UNIT WEIGHT.

UNIT HEATER MOUNTED TO ROOF STRUCTURE. SEE MECHANICAL EQUIPMENT SCHEDULE FOR UNIT WEIGHT. ROOF EXHAUST FAN. SEE MECHANICAL EQUIPMENT SCHEDULE FOR UNIT

(54) WALL MOUNT EXHAUST LOUVER ABOVE DOOR. SEE MECHANICAL. (55) PACKAGE A/C UNIT. SEE MECHANICAL.

(56) FRP PANEL ON FIRE RETARDANT TREATED PLYWOOD 8'-0" HIGH. 57) PEMB CROSS BRACING. PAINT.

(69) WALL MOUNTED ELECTRICAL CABINET HEATER. SEE MECHANICAL.

(71) ALTERNATE: IN-GROUND BUS LIFT AT SECOND SERVICE POSITION.

773) FIRE DEPARTMENT SPRINKLER CONNECTION AND ALARM BELL SEE FIRE

(70) CHAIN—LINK FENCE ENCLOSURE. 8'—0" HIGH.

FIRE DEPARTMENT. TYPICAL (4) BUILDINGS.

PROTECTION SHEETS.

(58) METAL LOCKERS (ONE ADA). 59) ADA CLOTHES HOOK.

(60) FIRE EXTINGUISHER AND CABINET.

(61) ALTERNATE: APPROXIMATE LOCATION OF ROOFTOP HVAC UNIT. SEE MECHANICAL. PROVIDE ROOF CURB FOR STANDARD PEMB ROOFING. 62) WALL MOUNTED ELECTRIC CABINET HEATER. SEE MECHANICAL.

(W) BABY CHANGING TABLE.

GIBRALTAR DESIGN 9102 N. Meridian St., Ste. 300 ndianapolis, IN 46260 Homepage www.GibraltarDesign.com

Phone 317.580.5777 Fax 317.580.5778

Email info@GibraltarDesign.com

DESIGN

ARCHITECTURE • ENGINEERING • INTERIOR DESIGN

HANOVER CSC NEW

**RELATED WORK** 

CEDAR LAKE, INDIANA

CORPORATION

RESOURCE CENTER AND

HANOVER COMMUNITY SCHOOL

PROJECT 20 - 14105/17/21 COORDINATED E

DRAWN BY

JKF, AB

CHECKED BY

AR11600005

THIS INFORMATION SHALL BE USED BY ANY PERSON OR FIRM FOR ANY PURPOSE WITHOUT THE EXPRESS WRITTEN CONSENT OF GIBRALTAR DESIGN. THE OWNER MAY RETAIN COPIES FOR INFORMATION AND REFERENCE IN CONNECTION ONLY WITH THIS


MARK DATE ISSUED FOR |05/28/21| ADDENDUM #1 |06/03/21| ADDENDUM #2 |06/08/21| ADDENDUM #3 |06/10/21| ADDENDUM #4

DRAWING ENLARGED FLOOR PLAN RESOURCE CENTER

HANOVER CSC NEW RESOURCE

CENTER AND RELATED WORK FIRE DEPARTMENT KNOX BOX. COORDINATE INSTALL LOCATION WITH LOCAL © GIBRALTAR DESIGN SHEET

BUILDING D

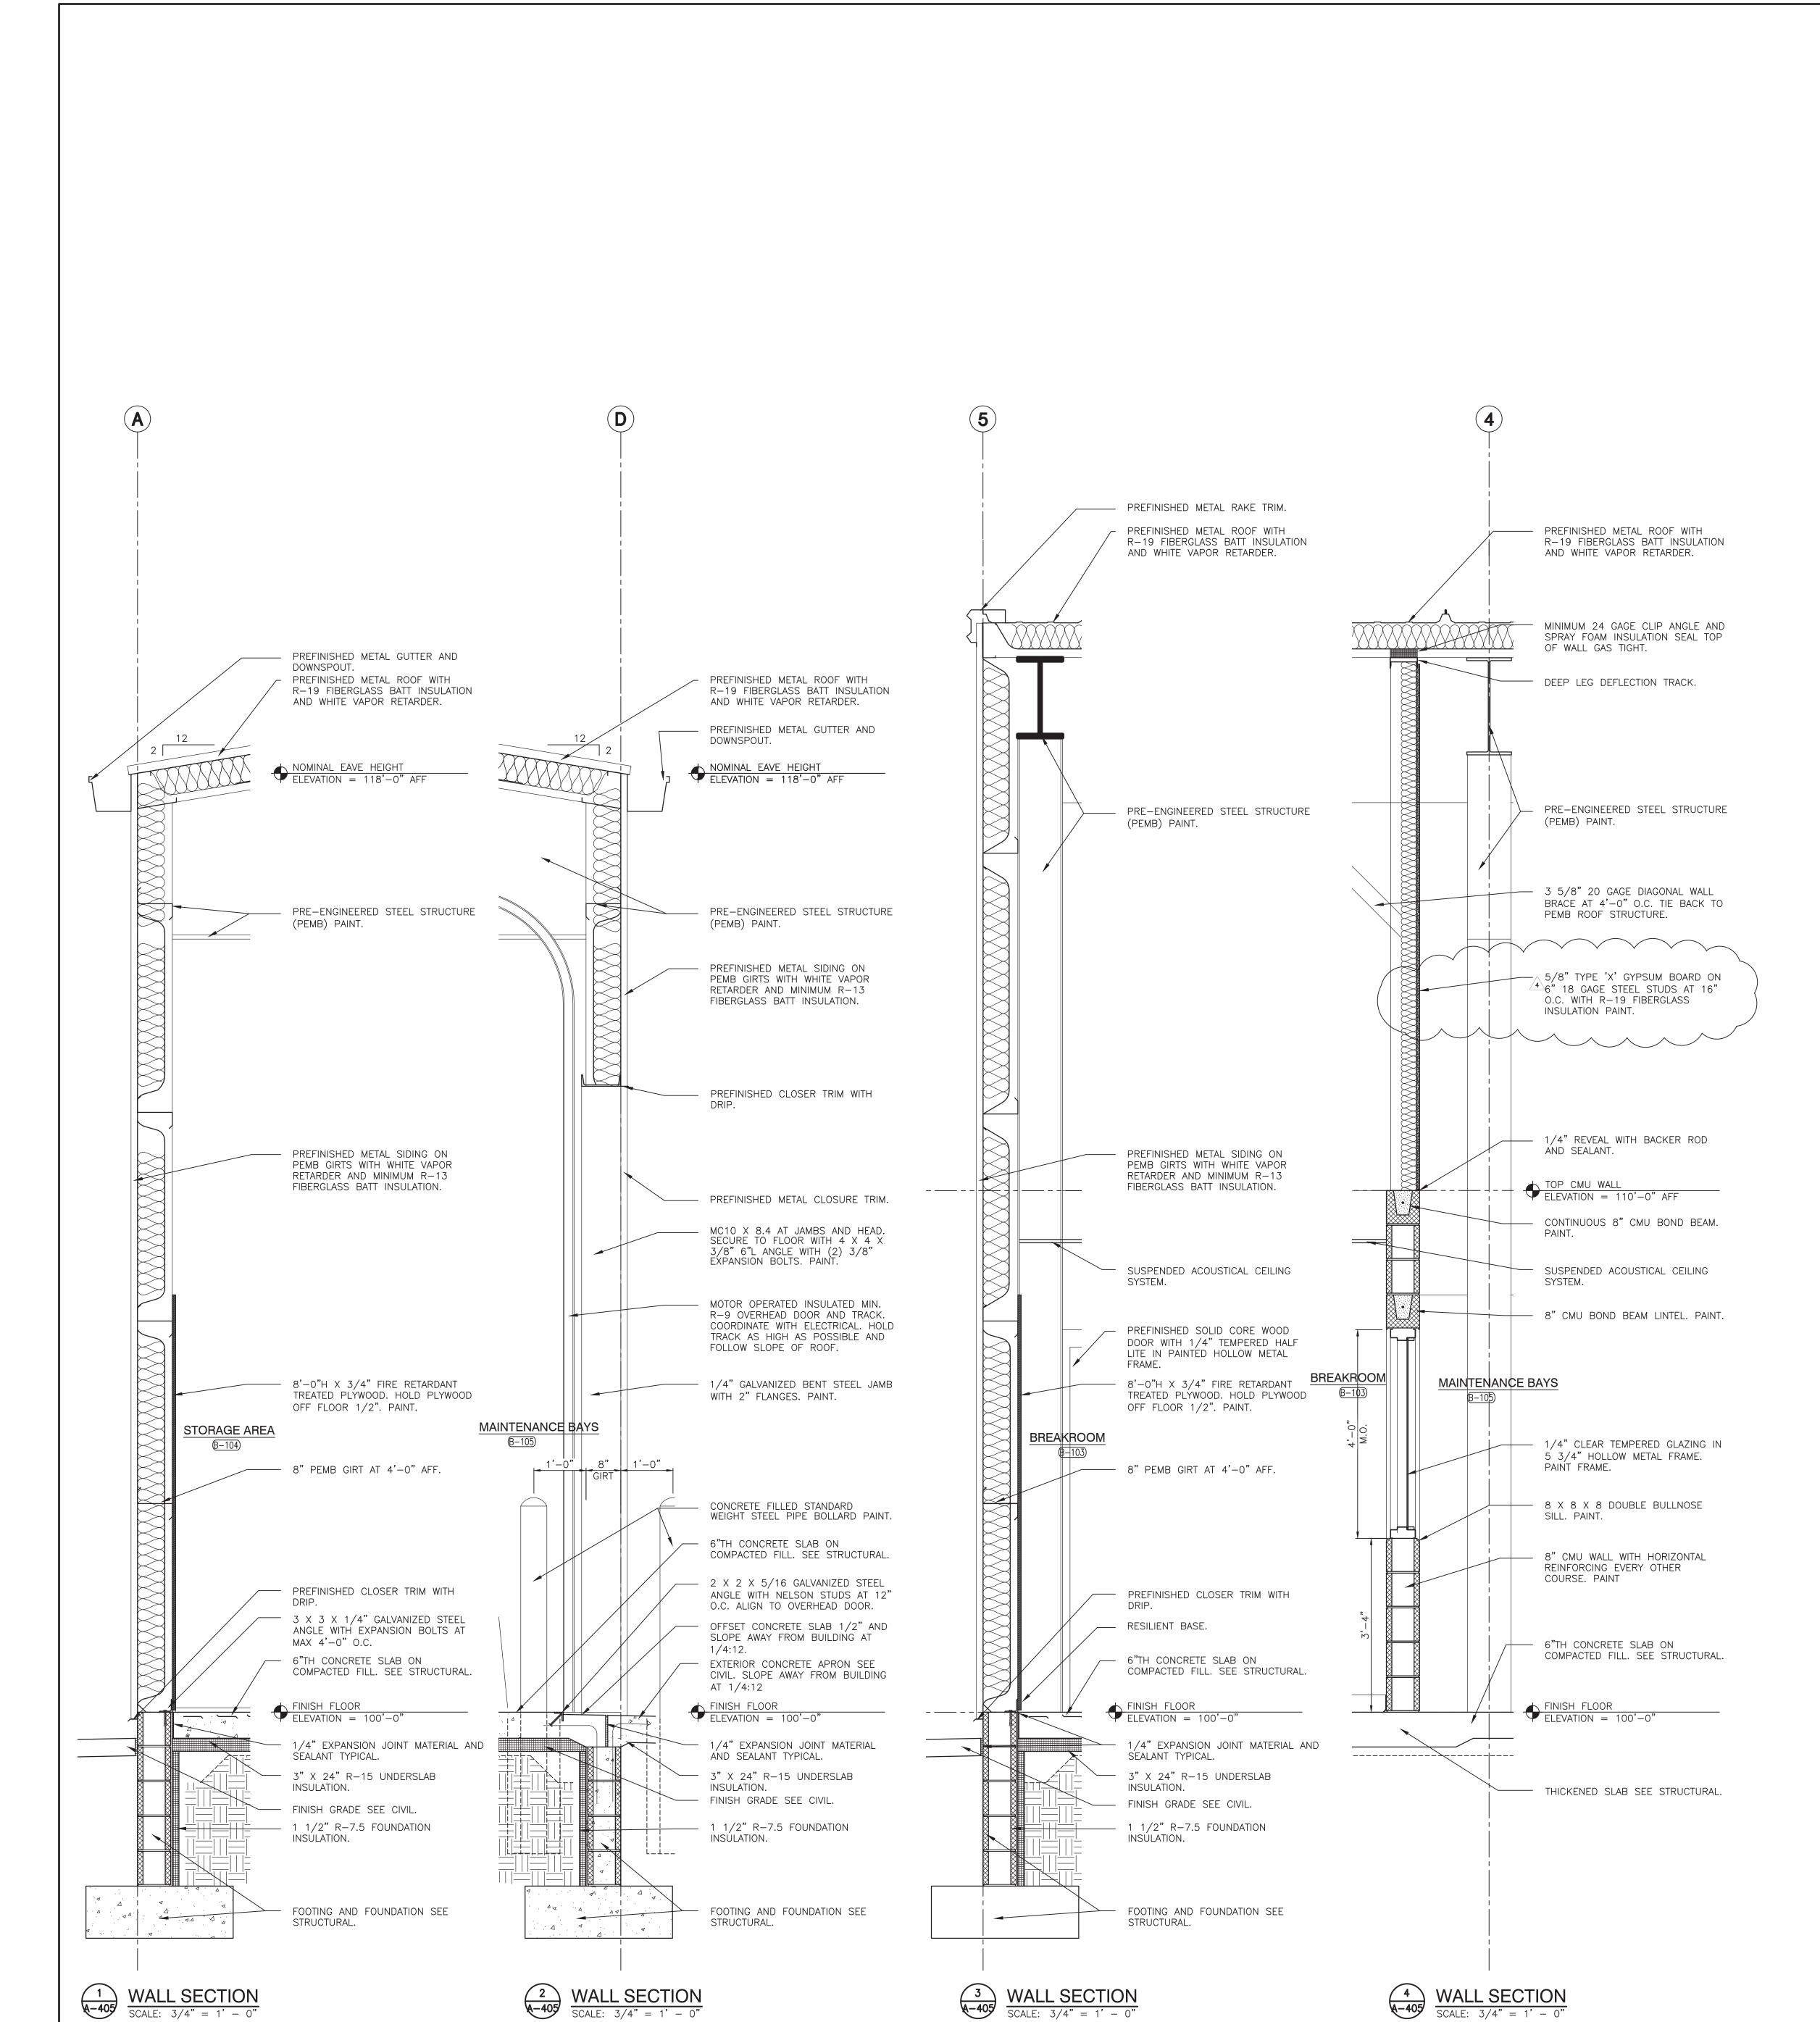



PROJECT HANOVER CSC NEW RESOURCE CENTER AND RELATED WORK

HANOVER COMMUNITY SCHOOL CORPORATION CEDAR LAKE, INDIANA

GIBRALTAR DESIGN 9102 N. Meridian St., Ste. 300 Indianapolis, IN 46260

Homepage www.GibraltarDesign.com

Phone 317.580.5777 Fax 317.580.5778


Email info@GibraltarDesign.com

PROJECT 20-141 05/17/21 COORDINATED BY

DRAWN BY

JKF, AB

CHECKED BY

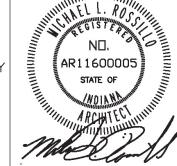

COPYRIGHT NOTICE: THE CONCEPTS, DESIGNS, PLANS, DETAILS, ETC, SHOWN ON THIS DOCUMENT ARE THE PROPERTY OF GIBRALTAR DESIGN AND WERE CREATED FOR USE ON THIS SPECIFIC PROJECT. NONE OF THIS INFORMATION SHALL BE USED BY ANY PERSON OR FIRM FOR ANY PURPOSE WITHOUT THE EXPRESS WRITTEN CONSENT OF GIBRALTAR DESIGN. THE OWNER MAY RETAIN COPIES FOR INFORMATION AND REFERENCE IN CONNECTION ONLY WITH THIS PROJECT

MARK DATE ISSUED FOR | 05/28/21 | ADDENDUM #1 06/03/21 ADDENDUM #2 06/08/21 ADDENDUM #3


06/10/21 ADDENDUM #4

DRAWING WALL SECTIONS MAINTENANCE GARAGE


HANOVER CSC NEW RESOURCE CENTER AND RELATED WORK

©GIBRALTAR DESIGN | SHEET

BUILDING B

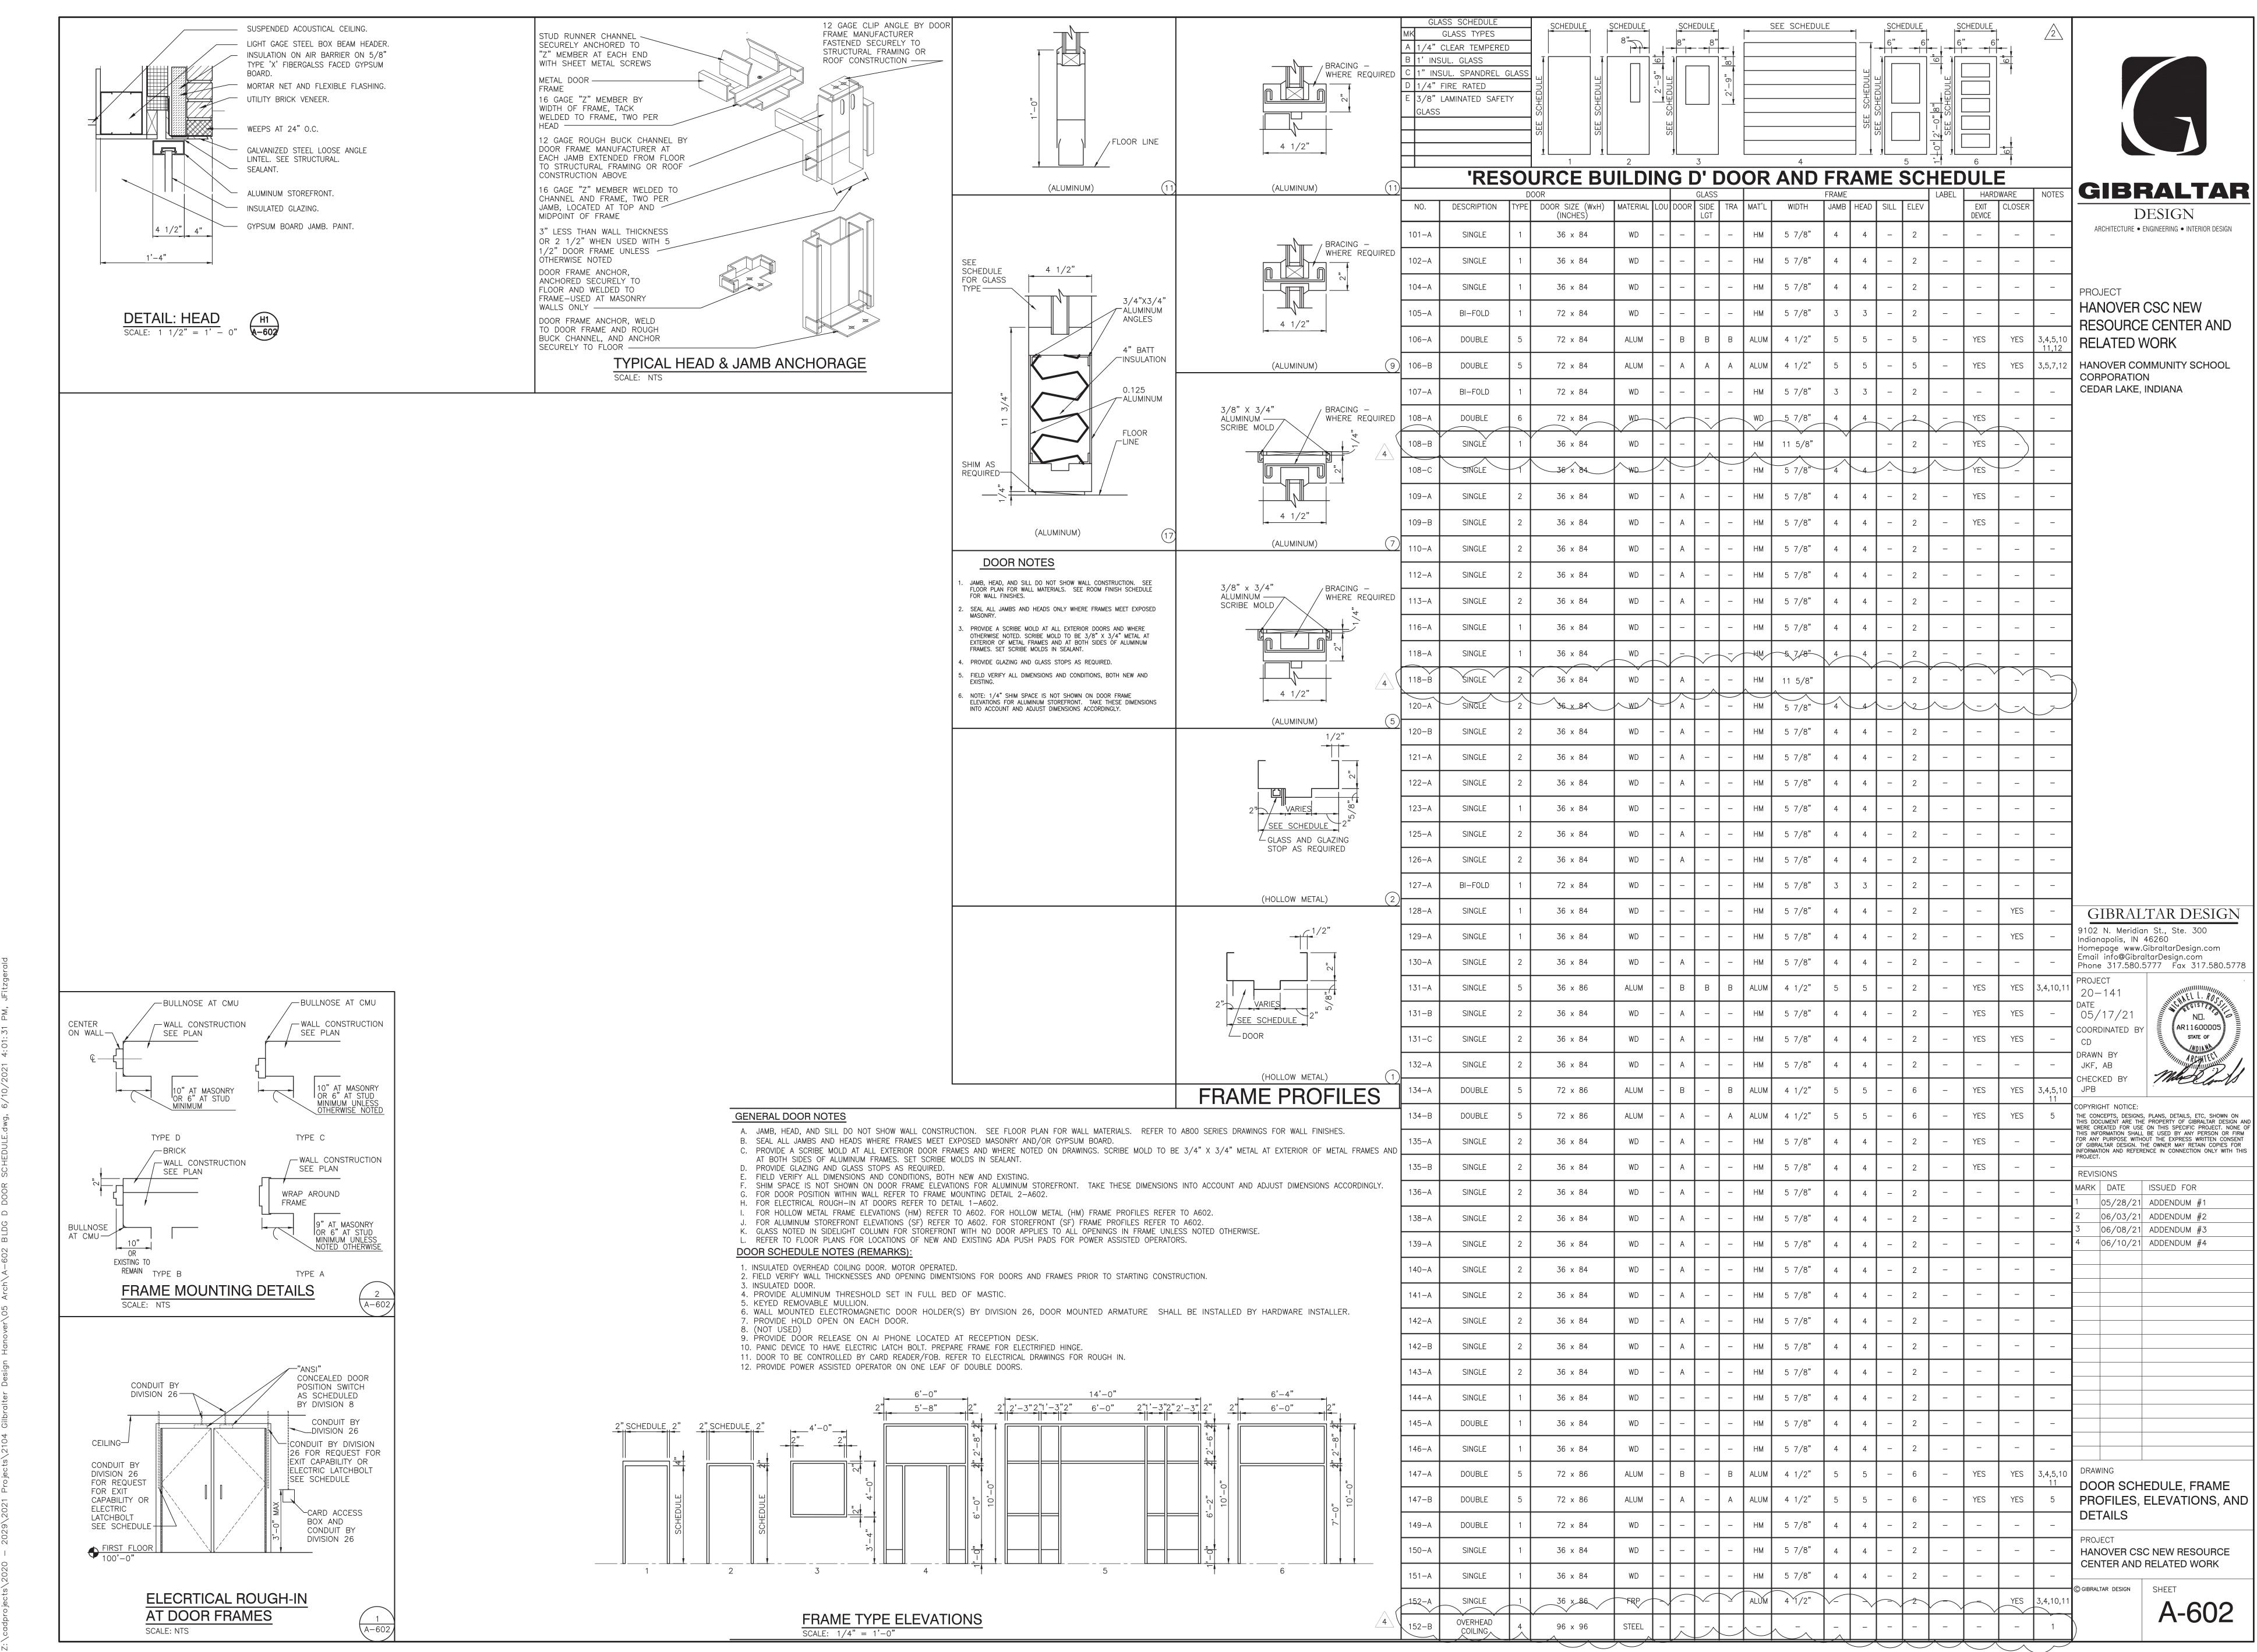


DOOR SCHEDULE.DWG , , ,

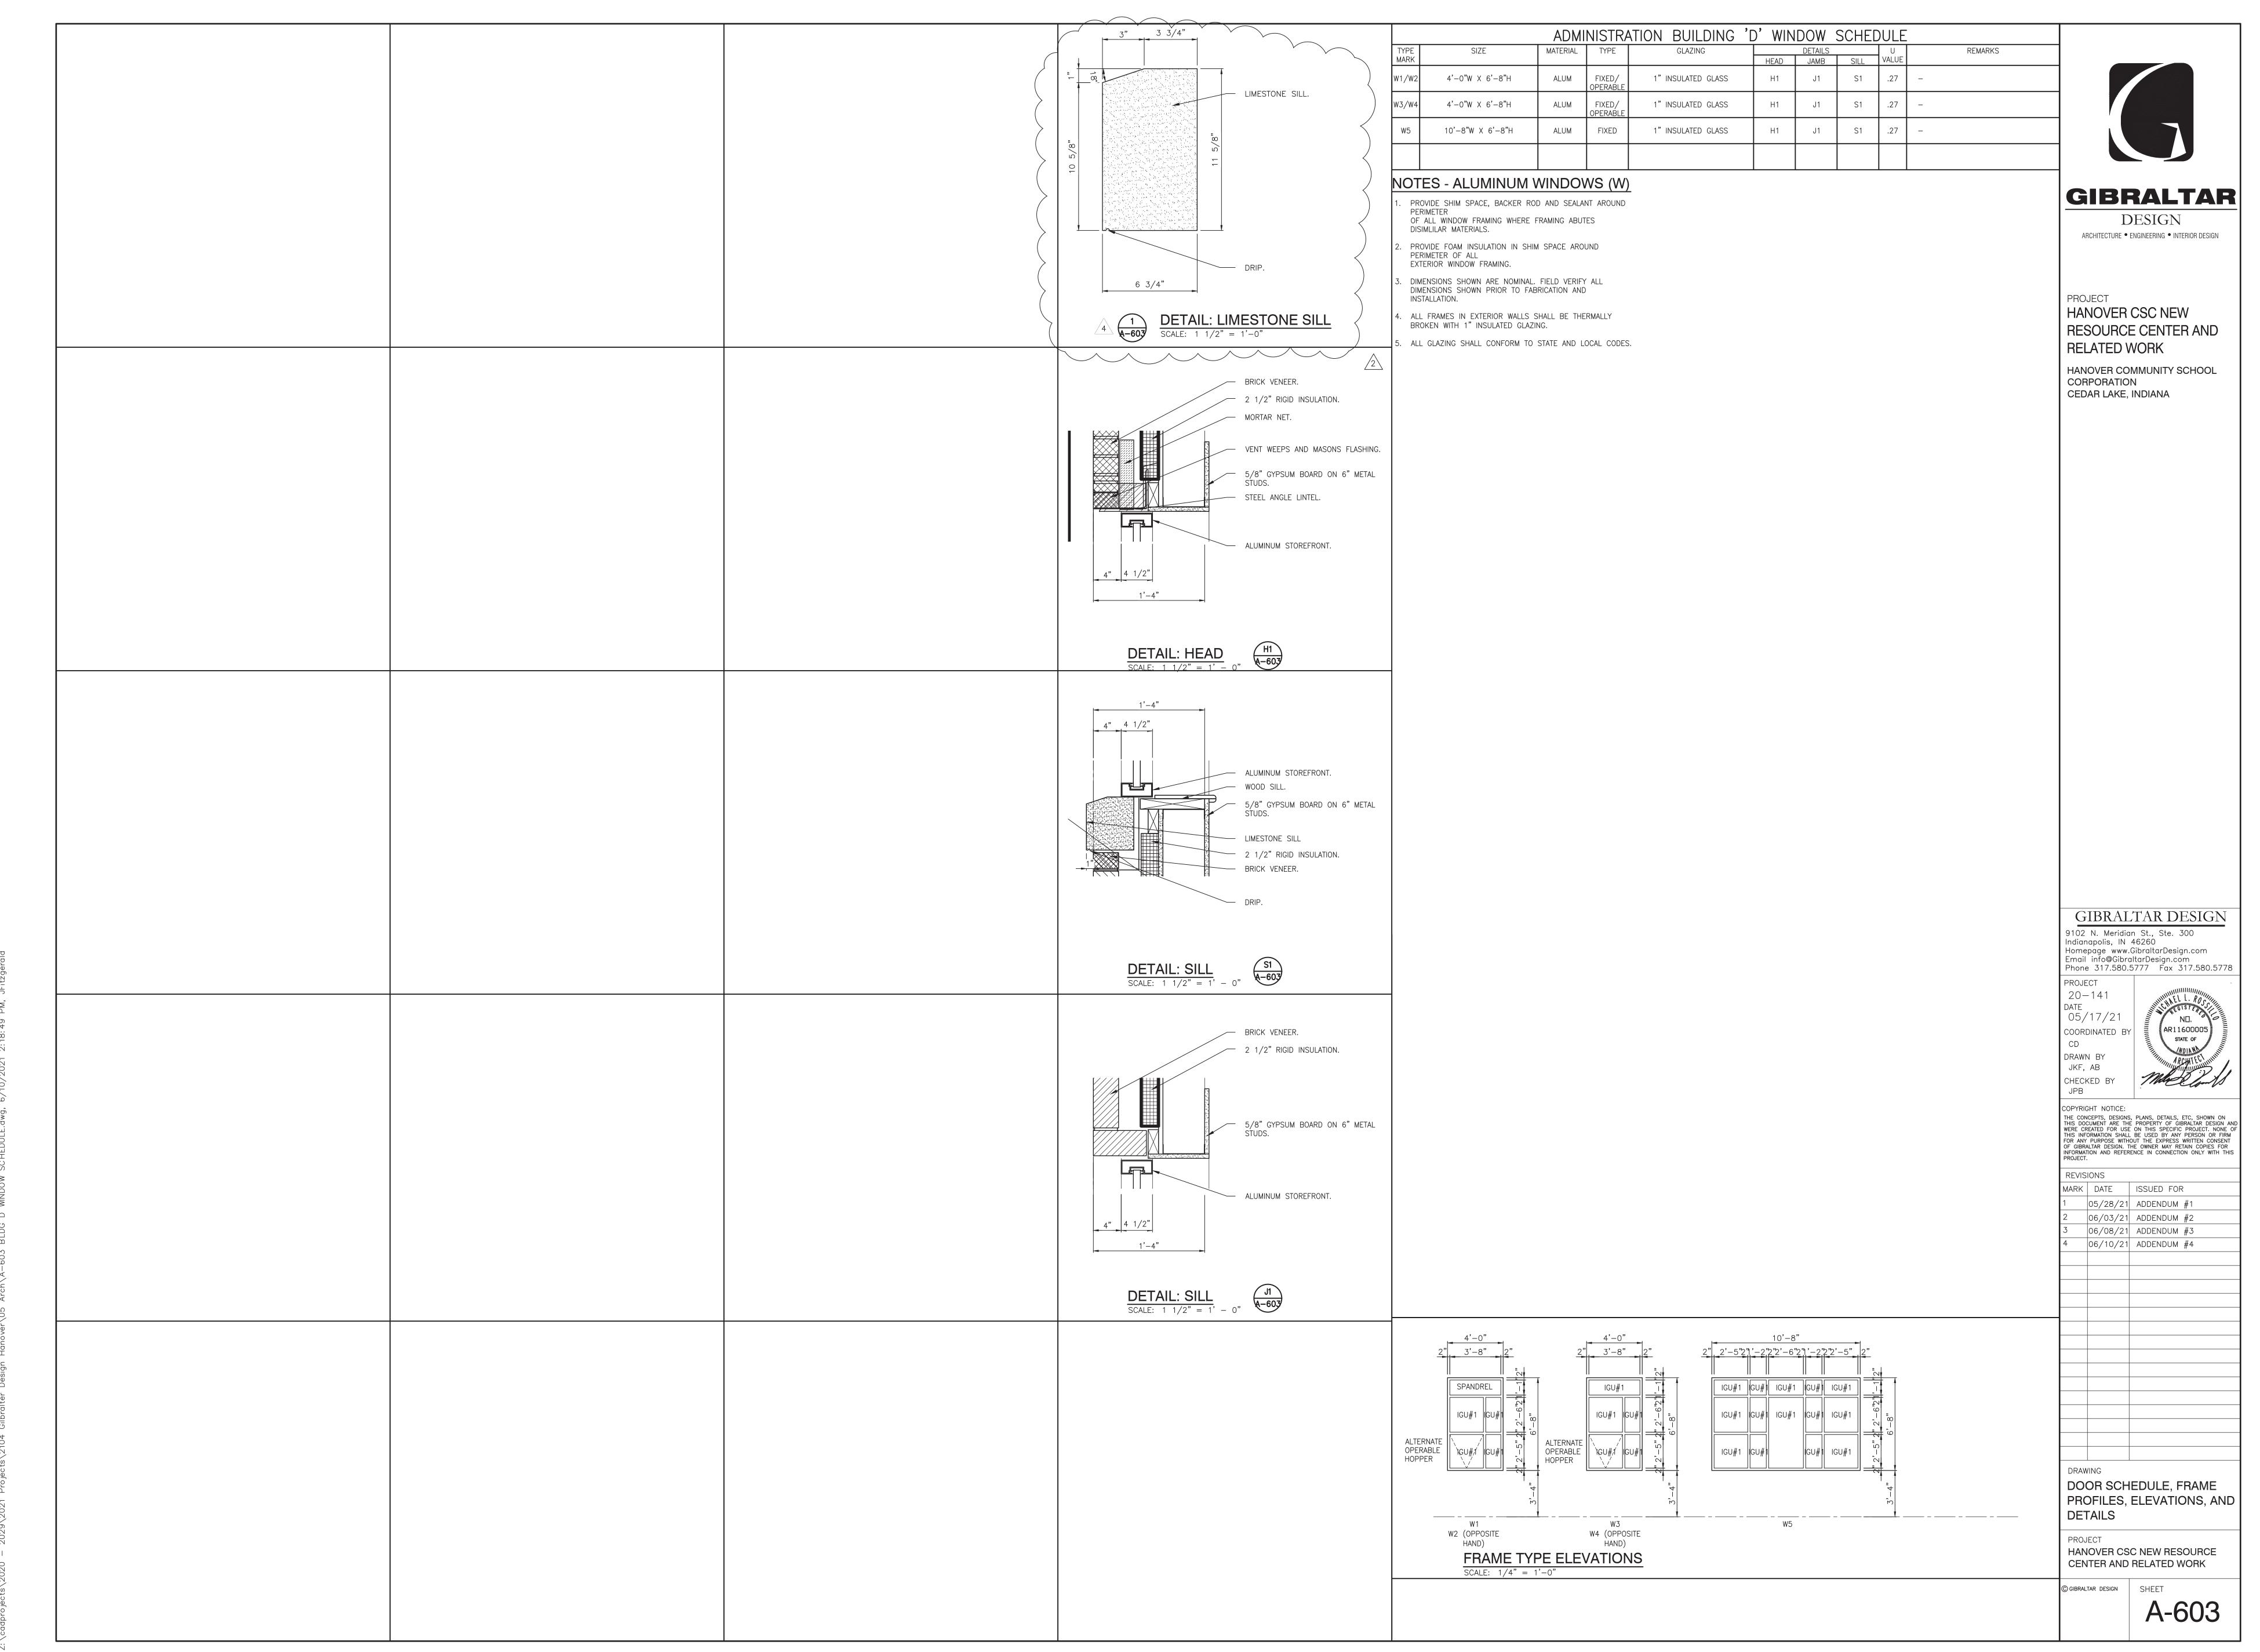

W COTIFFORMS

WE COTIFF TO THE STATE OF THE

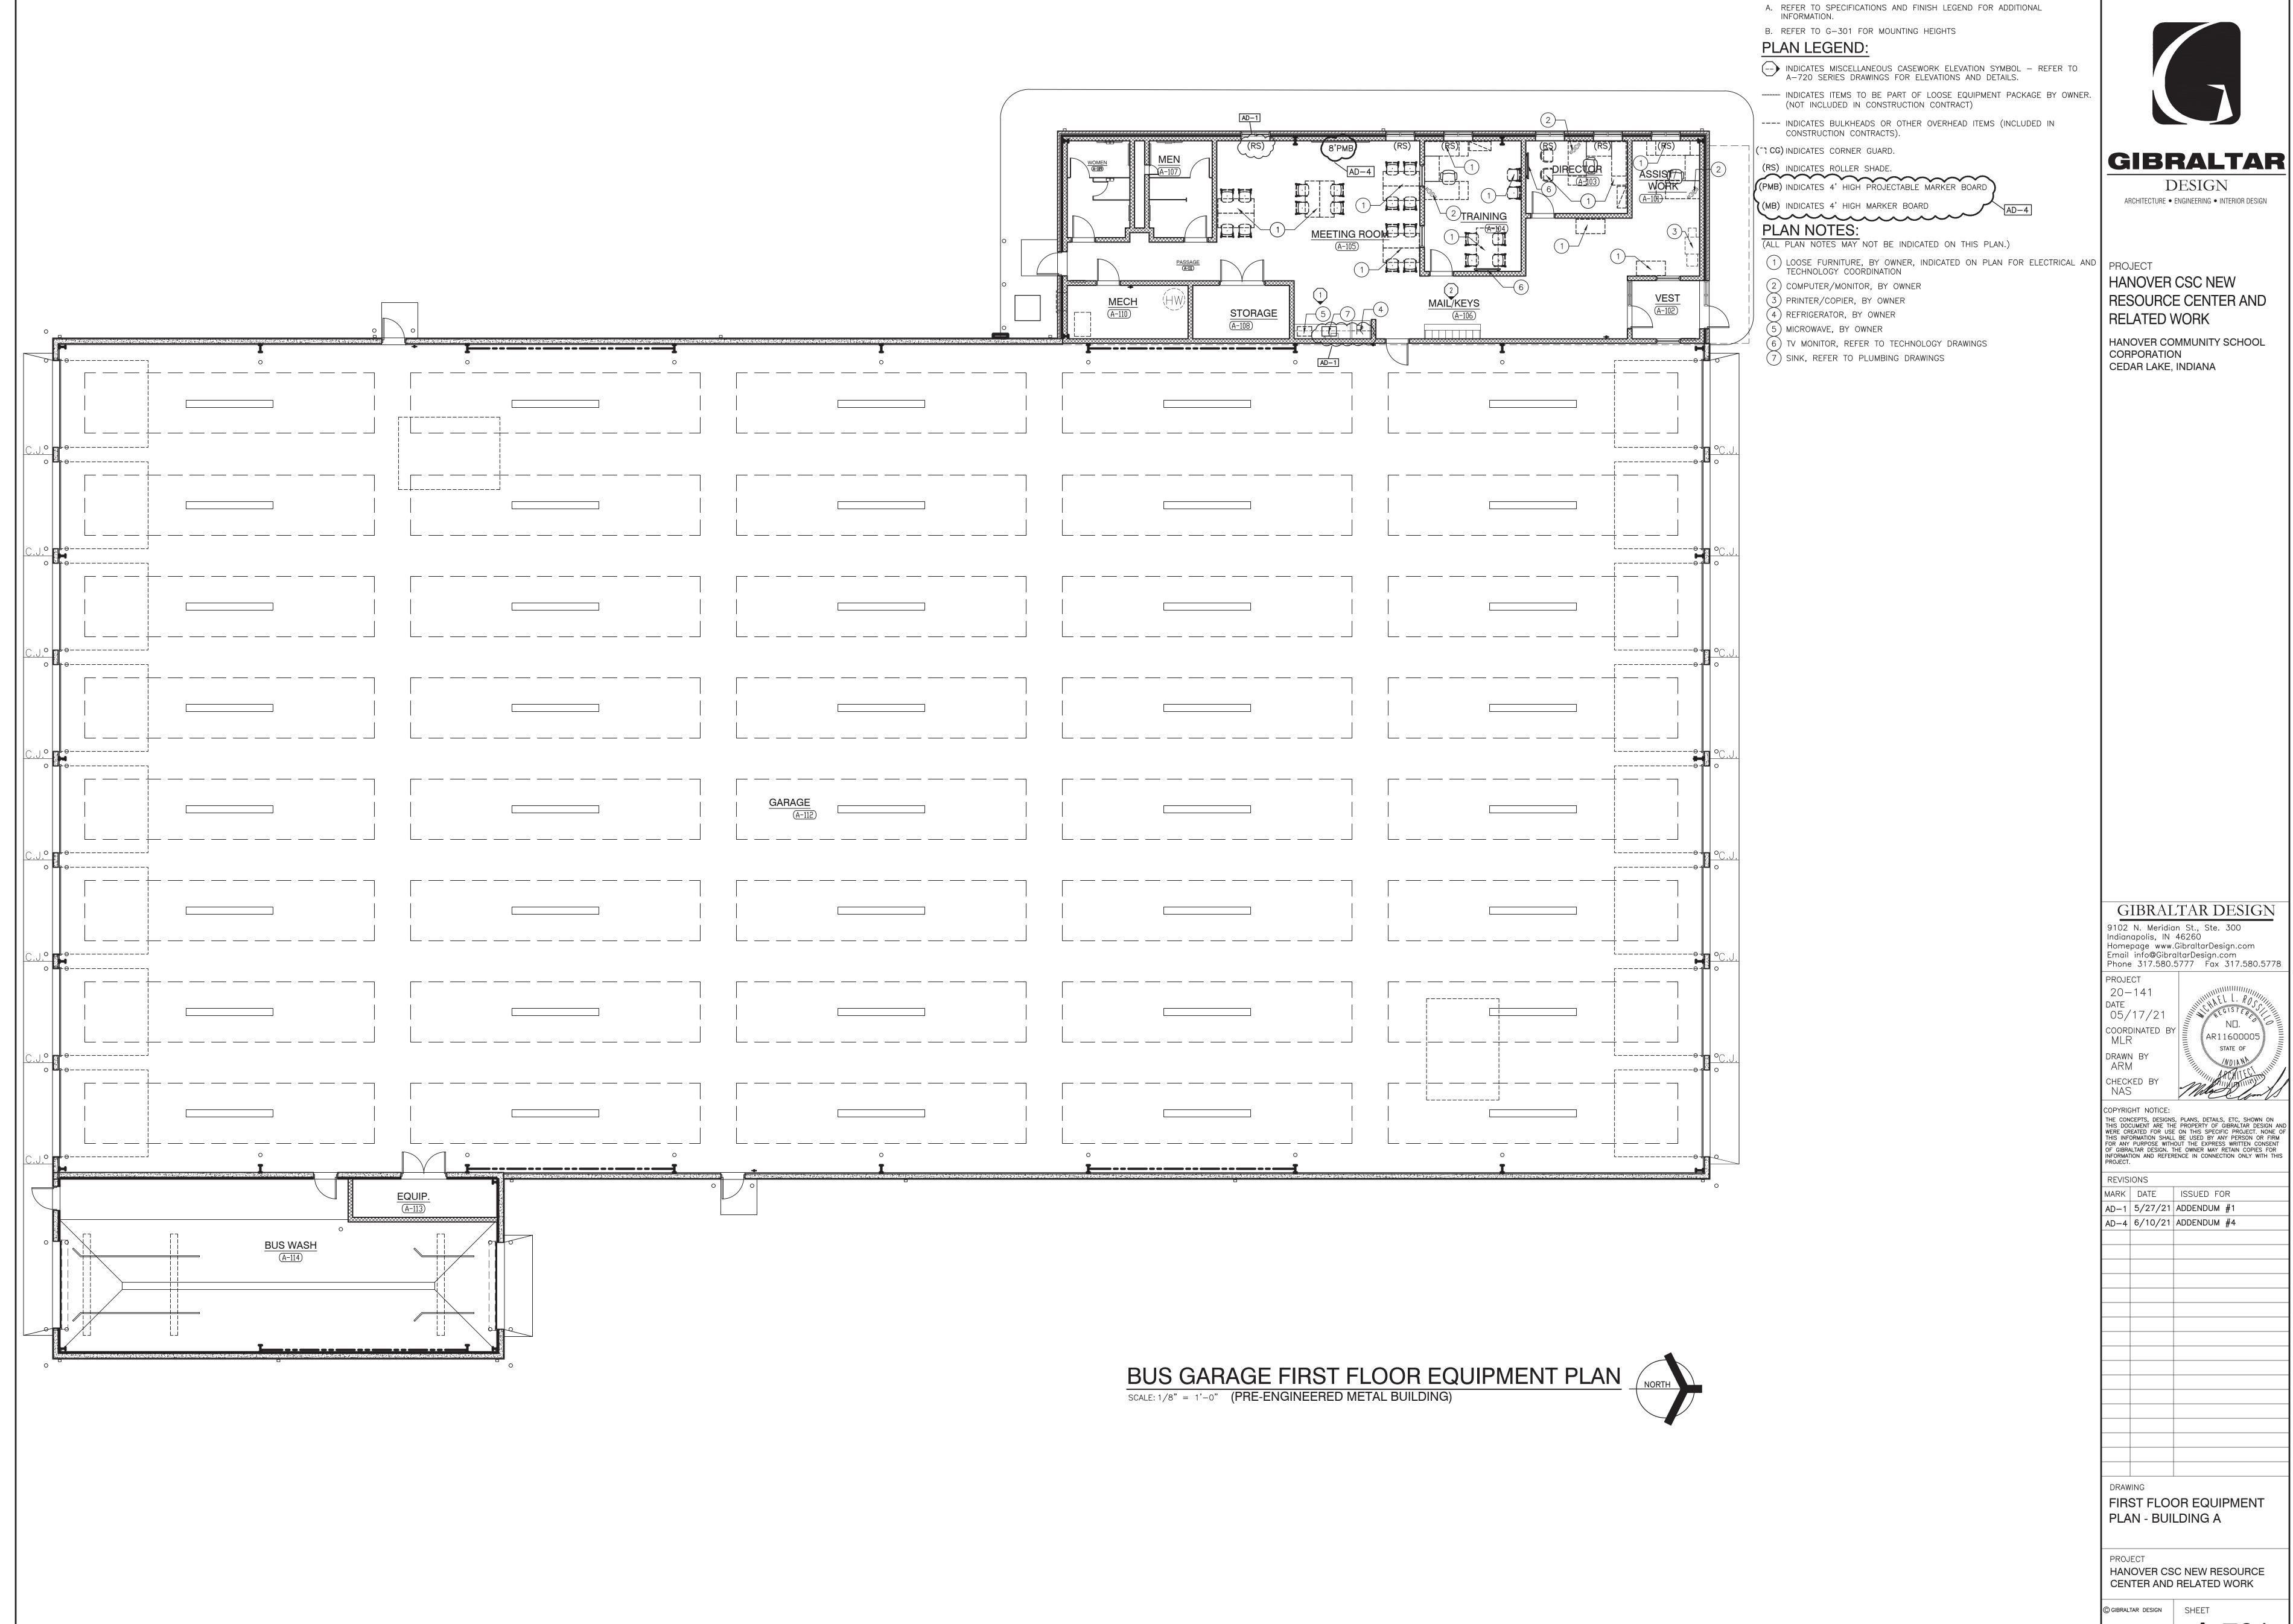

GENERAL EQUIPMENT NOTES:

B. REFER TO G-301 FOR MOUNTING HEIGHTS

GENERAL EQUIPMENT NOTES:

A. REFER TO SPECIFICATIONS AND FINISH LEGEND FOR ADDITIONAL INFORMATION.

PLAN LEGEND:

INDICATES MISCELLANEOUS CASEWORK ELEVATION SYMBOL - REFER TO A-720 SERIES DRAWINGS FOR ELEVATIONS AND DETAILS. ----- INDICATES ITEMS TO BE PART OF LOOSE EQUIPMENT PACKAGE BY OWNER. (NOT INCLUDED IN CONSTRUCTION CONTRACT)

---- INDICATES BULKHEADS OR OTHER OVERHEAD ITEMS (INCLUDED IN CONSTRUCTION CONTRACTS).

(~7 CG) INDICATES CORNER GUARD.

(RS) INDICATES ROLLER SHADE. (PMB) INDICATES 4' HIGH PROJECTABLE MARKER BOARD (MB) INDICATES 4' HIGH MARKER BOARD

**PLAN NOTES:** 

(ALL PLAN NOTES MAY NOT BE INDICATED ON THIS PLAN.)

1) LOOSE FURNITURE, BY OWNER, INDICATED ON PLAN FOR ELECTRICAL AND PROJECT TECHNOLOGY COORDINATION

(2) COMPUTER/MONITOR, BY OWNER

(3) PRINTER/COPIER, BY OWNER (4) REFRIGERATOR, BY OWNER

(5) MICROWAVE, BY OWNER


(6) TV MONITOR, REFER TO TECHNOLOGY DRAWINGS

(7) SINK, REFER TO PLUMBING DRAWINGS

**GIBRALTAR** DESIGN ARCHITECTURE • ENGINEERING • INTERIOR DESIGN

HANOVER CSC NEW RESOURCE CENTER AND RELATED WORK

HANOVER COMMUNITY SCHOOL CORPORATION CEDAR LAKE, INDIANA

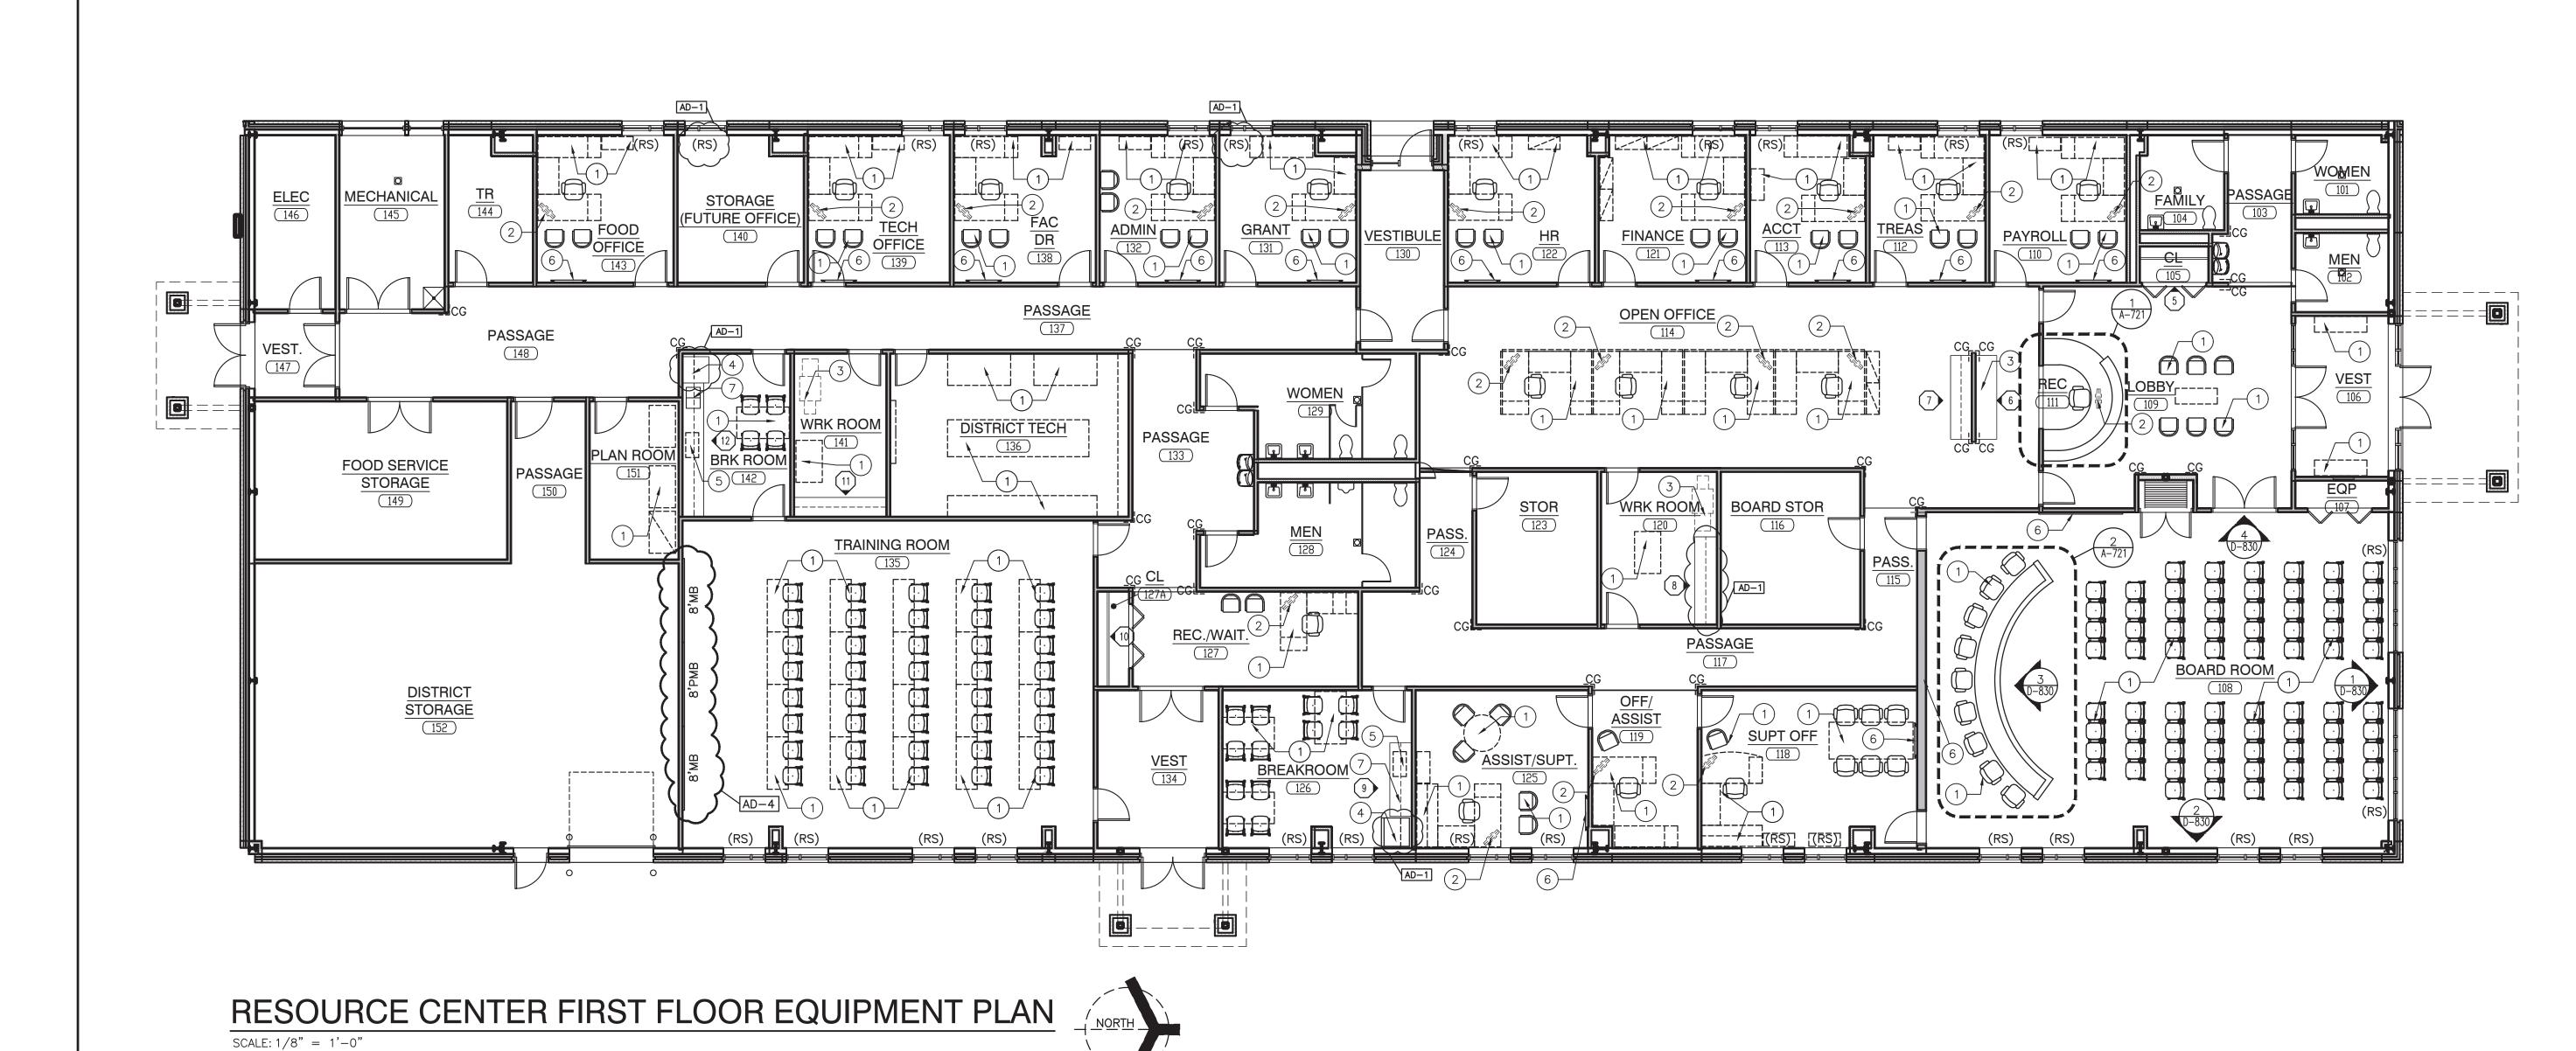

GIBRALTAR DESIGN 9102 N. Meridian St., Ste. 300 Indianapolis, IN 46260 Homepage www.GibraltarDesign.com Email info@GibraltarDesign.com Phone 317.580.5777 Fax 317.580.5778

> AR11600005 STATE OF

20-141


05/17/21 COORDINATED E DRAWN BY ARM

CHECKED BY NAS COPYRIGHT NOTICE: THE CONCEPTS, DESIGNS, PLANS, DETAILS, ETC, SHOWN ON THIS DOCUMENT ARE THE PROPERTY OF GIBRALTAR DESIGN AND WERE CREATED FOR USE ON THIS SPECIFIC PROJECT. NONE OF THIS INFORMATION SHALL BE USED BY ANY PERSON OR FIRM FOR ANY PURPOSE WITHOUT THE EXPRESS WRITTEN CONSENT OF GIBRALTAR DESIGN. THE OWNER MAY RETAIN COPIES FOR INFORMATION AND REFERENCE IN CONNECTION ONLY WITH THIS PROJECT.

MARK DATE ISSUED FOR AD-1 5/27/21 ADDENDUM #1 AD-4 6/10/21 ADDENDUM #4

FIRST FLOOR EQUIPMENT PLAN - BUILDING D

HANOVER CSC NEW RESOURCE CENTER AND RELATED WORK

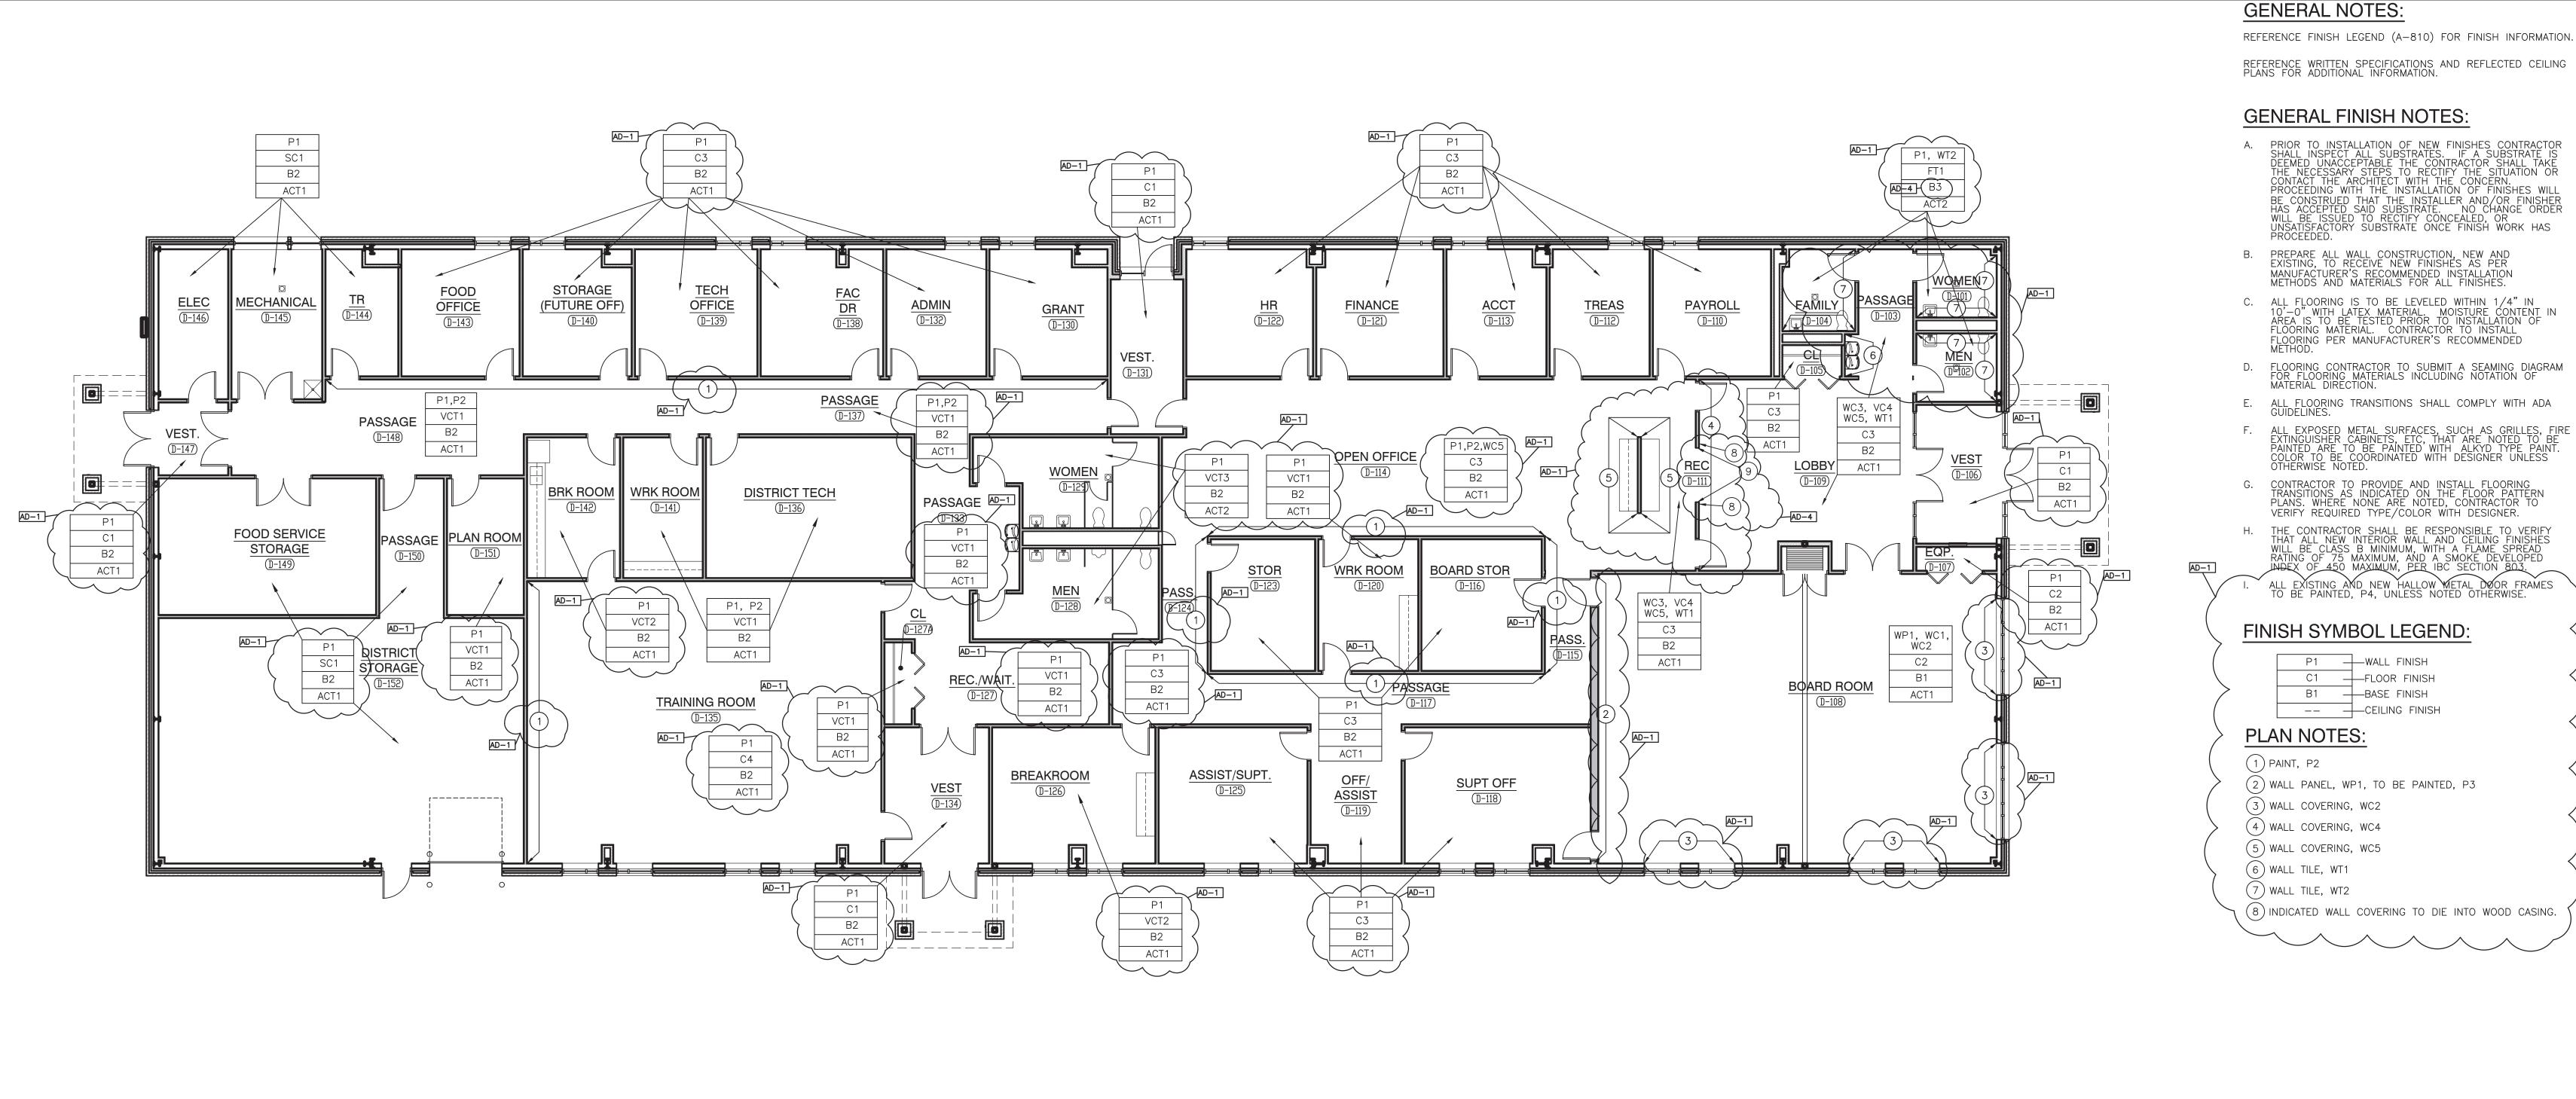

FIRST FLOOR FINISH PLAN - BUILDING D

SCALE: 1/8" = 1'-0"

GIBRALTAR DESIGN

**GIBRALTAR** 

DESIGN

ARCHITECTURE • ENGINEERING • INTERIOR DESIGN

HANOVER CSC NEW

**RELATED WORK** 

CEDAR LAKE, INDIANA

CORPORATION

RESOURCE CENTER AND

HANOVER COMMUNITY SCHOOL

PROJECT

9102 N. Meridian St., Ste. 300 Indianapolis, IN 46260 Homepage www.GibraltarDesign.com Email info@GibraltarDesign.com Phone 317.580.5777 Fax 317.580.5778

AR11600005

PROJECT
20-141
DATE
05/17/21
COORDINATED BY
MLR

MLR

DRAWN BY

JFK,AB,ARM

CHECKED BY

JPB NAS

COPYRIGHT NOTICE:

THE CONCEPTS, DESIGNS, PLANS, DETAILS, ETC, SHOWN ON THIS DOCUMENT ARE THE PROPERTY OF GIBRALTAR DESIGN AND WERE CREATED FOR USE ON THIS SPECIFIC PROJECT. NONE OF THIS INFORMATION SHALL BE USED BY ANY PERSON OR FIRM FOR ANY PURPOSE WITHOUT THE EXPRESS WRITTEN CONSENT OF GIBRALTAR DESIGN. THE OWNER MAY RETAIN COPIES FOR INFORMATION AND REFERENCE IN CONNECTION ONLY WITH THIS PROJECT.

REVISIONS

MARK DATE ISSUED FOR

AD-1 5/27/21 ADDENDUM #1

AD-4 6/10/21 ADDENDUM #4

IG

DRAWING
FIRST FLOOR FINISH PLAN
RESOURCE CENTER
BUILDING D

PROJECT
HANOVER CSC NEW RESOURCE
CENTER AND RELATED WORK

© GIBRALTAR DESIGN SHEET

SURFACE	MARK	DESCRIPTION	MANUFACTURER	PATTERN/FINISH	NUMBER/COLOR	SIZE	COMMENTS
CEILING MATERIAL		1 2 2 3 1 11 11 2 11					
OLILINO MATERIAL	ACT1	ACOUSTICAL CEILING	ARMSTRONG	SQUARE LAY-IN	1728 FINE FISSURED	2'X2'	WITH HUMIGUARD PLUS PERFORMAN
	ACT2	ACOUSTICAL CEILING	ARMSTRONG	CLEAN ROOM	VL-NONPERFORATED	2'X2'	WITH HUMIGUARD PLUS PERFORMAN
	ESSP	EXPOSED STRUCTURE	SHERWIN WILLIAMS	SW 7007	CEILING BRIGHT WHITE	Z	WITH HOMIGOARD 1 EOS 1 ERFORMAL
		PAINTED					
	ESSNP	EXPOSSED STRUCTURE	NON-PAINTED				
WALL BASE			$\sim\sim\sim$	~~~~~		~~~~	
	B1	WOOD BASE	<u> </u>	EASED EDGE	STAIN TO MATCH DOOR	6"H X 1/2	" 人
	₩ B2	RESILIENT BASE	JOHNSONITE	COVE	20 CHARCOAL	4,"	AD-4
	B3	PORCELAIN BASE	DALTILĖ	PORTFOLIO	IPFU6 IRUN GREY	6" X 12"	I Y
FLOOR MATERIALS						\\\\\\\\\\\\\\\\\\\\\\\\\\\\\\\\\\\\\\	
	C1	CARPET TILE	TARKETT	ABRASIVE ACTION II	WINTER GRAY 19103	24"X24"	
	C2	CARPET TILE	TARKETT	AIDA CLOTH	INDIGO RUN	18"X36"	1
	C3	CARPET TILE	TARKETT		38501 DEEP SKY	24"X24"	
	C4	CARPET TILE	TARKETT	01957 CRAYON	48002 TIDAL WAVE	24"X24"	
	FT1	PORCELAIN TILE	DALTILE	PORTFOLIO	PF06 IRON GREY	12"X24"	
	VCT1	VINYL COMPOSITE TILE	ARMSTRONG	IMPERIAL TEXTURE	57551 PERFECT STORM	12"X12"	
	VCT2	VINYL COMPOSITE TILE	·	CROWN TEXTURE	5C230 VICTORIA BLUE	12"X12"	
	VCT3	VINYL COMPOSITE TILE		IMPERIAL TEXTURE	51934 LAVENDER SHADOW	12"X12"	
	SC	SEALED CONCRETE					
WALL MATERIALS							'
WALL IVIA I ERIALS	D1	DAINIT	CLIEDWINI WILLIAMS	DACCIVE	CW 7004		1
	P1	PAINT PAINT			SW 7064 SW 9170 AD-4		
	P2		SHERWIN WILLIAMS	ACIER MARCH WIND	SW 7668		
	P3	PAINT	SHERWIN WILLIAMS	WEB GRAY	SW 7075		
	P4 WC1	PAINT WALLCOVERING	MDC-BOLTA CONTRACT		PENCIL		
	WC2	WALLCOVERING	MDC-BOLTA CONTRACT		CHANTON SHADOW		
	WC3	WALLCOVERING	SYMPHONY	ON STAGE	VENUE GREY		
	WC4	WALLCOVERING	SYMPHONY	ON STAGE	MOONDANCE		+
	WC5	WALLCOVERING	SYMPHONY	ON STAGE	SAPPHIRE SOLO		+
		WALL TILE	CROSSVILLE LAMINAM	CALCE	GRIGO	1MX3M	+
	WT1	WALL TILE	CROSSVILLE LAMINAM	I NATURALI	OSSIDIANA VENA CHIARA	1MX3M	+
	WT2 WP1	WALL PANEL	MODULARARTS	INTERLOCKING ROCK	VEIL PANELS	32"X32"	
CASEWORK AND M		TIALL I AINLL	MODOLANANIO	MATERIZOONING NOON	VEIL I MILES	JZ //JZ	1
OVOFAMORY WIND IM		SOLID SLIDEAGE	I CODIANI	T	LIMESTONE DDIMA		1
	SS1 SS2	SOLID SURFACE		<u> </u>	LIMESTONE PRIMA SILVER GRAY — AD-4		
	PL1	PLASTIC LAMINATE	CORIAN WILSONART	FINEGRAIN FINISH	MONTANA WALNUT		
	PL2	PLASTIC LAMINATE  PLASTIC LAMINATE	FORMICA	MATTE FINISH	FOLKSTONE CELESTA		+
	PL3	PLASTIC LAMINATE	FORMICA	MATTE FINISH	GRAPHITE TWILL		
	PL4	PLASTIC LAMINATE	FORMICA	PAPER FINISH	NATURAL GRAY FELT		
	PL5	PLASTIC LAMINATE	FORMICA	MATTE FINISH	STORM		
	PL6	PLASTIC LAMINATE	FORMICA	MATTE FINISH	FOLKSTONE GRAFIX		
MICC	1 LO	I POUC PUMINATE					I
MISC.			TOOLULITED	TOODNIED.	AD-4		1
	TRIM1	TILE TRIM	SCHLUTER	CORNER	FULL RANGE		
	TRIM2	TILE TRIM	SCHLUTER	EDGE	<u></u>		
	CG1	CORNER GUARD	CS	FS SERIES	<u></u>		FULL HEIGHT
	WG1,	WALL PROTECTION	ACROVYN		FULL RANGE		
	WD1	WOOD DOOR	SHERWIN WILLIAMS		NUTMEG - MATCH DOOR MANUFACT. )		
	TP1	TOILET PARTITION	SCRANTON				

Thursday, 6/10/2021 — 1:53 PM — LAST SAVED Y:\20—141 HANOVER CSC — NEW RESOURCE CENTER\20—141 DRAWINGS\05 ARCH\A—810.DWG 

ARCHITECTURE ● ENGINEERING ● INTERIOR DESIGN

HANOVER CSC NEW
RESOURCE CENTER AND
RELATED WORK

HANOVER COMMUNITY SCHOOL CORPORATION CEDAR LAKE, INDIANA

1X2 STAINED WOOD TRIM  5/8" GYPSUM BOARD 3 5/8" METAL STUD 1X STAINED WOOD TRIM 1X2 STAINED WOOD TRIM  1X2 STAINED WOOD TRIM  1X2 STAINED WOOD TRIM  5/8" GYPSUM BOARD
WOOD CASEMENT DETAIL  SCALE: 1 1/2" = 1'-0"  A-810

GIBRALTAR DESIGN
9102 N. Meridian St., Ste. 300 Indianapolis, IN 46260
Homepage www.GibraltarDesign.com

PROJECT

20-141

DATE

OF (17/21)

DATE
05/17/21
COORDINATED BY
MR
DRAWN BY
ARM

REVISIONS

CHECKED BY
NAS

COPYRIGHT NOTICE:

THE CONCEPTS, DESIGNS, PLANS, DETAILS, ETC, SHOWN ON THIS DOCUMENT ARE THE PROPERTY OF GIBRALTAR DESIGN AND WERE CREATED FOR USE ON THIS SPECIFIC PROJECT. NONE OF THIS INFORMATION SHALL BE USED BY ANY PERSON OR FIRM FOR ANY PURPOSE WITHOUT THE EXPRESS WRITTEN CONSENT OF GIBRALTAR DESIGN. THE OWNER MAY RETAIN COPIES FOR INFORMATION AND REFERENCE IN CONNECTION ONLY WITH THIS PROJECT.

MARK	DATE	ISSUED FOR
AD-1	5/27/21	ADDENDUM #1
AD-4	6/10/21	ADDENDUM #4


DRAWING
FINISH LEGEND


PROJECT
HANOVER CSC NEW RESOURCE
CENTER AND RELATED WORK

© GIBRALTAR DESIGN SHEET

INTERIOR ELEVATION

SCALE: 1/4" = 1'-0"

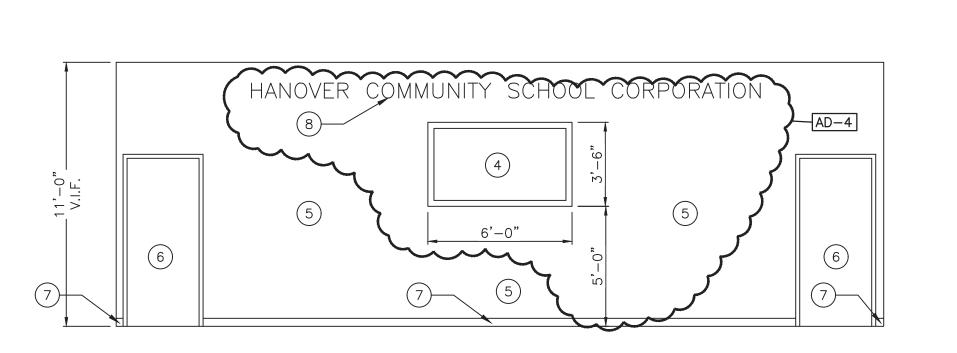

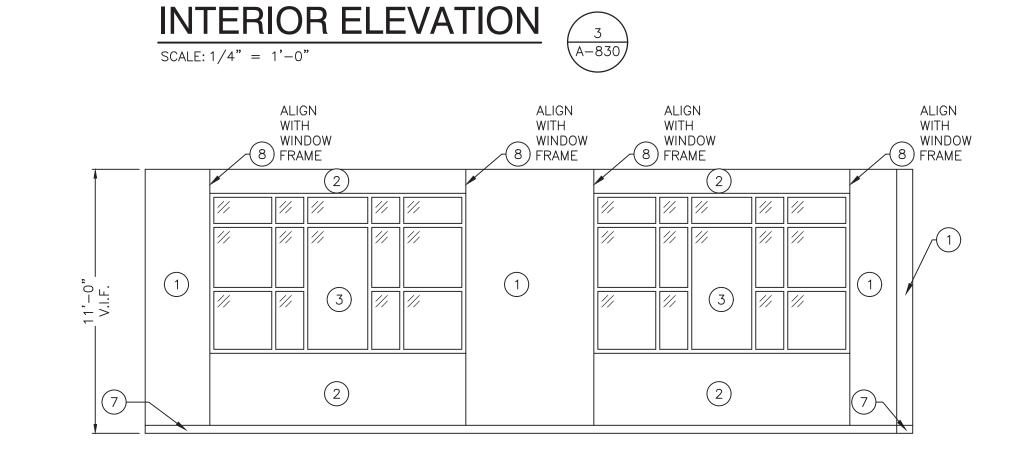

INTERIOR ELEVATION

SCALE: 1/4" = 1'-0"

**ELEVATION GENERAL NOTES:** 

A. REFERENCE FINISH LEGEND (A-810) FOR FINISH INFORMATION.

B. REFERENCE WRITTEN SPECIFICATIONS, EQUIPMENT PLANS, FINISH PLANS AND REFLECTED CEILING PLANS FOR ADDITIONAL INFORMATION **ELEVATION NOTES:** 

(1) WALL COVERING, WC1 (2) WALL COVERING, WC2 (3) WINDOW (4) TV MONITOR 5 WALL PANEL, WP1, PAINT P3
6 DOOR
7 WALL BASE, B1



PROJECT HANOVER CSC NEW RESOURCE CENTER AND RELATED WORK

HANOVER COMMUNITY SCHOOL CORPORATION CEDAR LAKE, INDIANA

GIBRALTAR DESIGN

AR11600005 STATE OF

9102 N. Meridian St., Ste. 300 Indianapolis, IN 46260 Homepage www.GibraltarDesign.com Email info@GibraltarDesign.com Phone 317.580.5777 Fax 317.580.5778

PROJECT 20-141 05/17/21 coordinated e MLR

drawn by ARM CHECKED BY NAS COPYRIGHT NOTICE:

THE CONCEPTS, DESIGNS, PLANS, DETAILS, ETC, SHOWN ON THIS DOCUMENT ARE THE PROPERTY OF GIBRALTAR DESIGN AND WERE CREATED FOR USE ON THIS SPECIFIC PROJECT. NONE OF THIS INFORMATION SHALL BE USED BY ANY PERSON OR FIRM FOR ANY PURPOSE WITHOUT THE EXPRESS WRITTEN CONSENT OF GIBRALTAR DESIGN. THE OWNER MAY RETAIN COPIES FOR INFORMATION AND REFERENCE IN CONNECTION ONLY WITH THIS PROJECT.


MARK DATE ISSUED FOR

AD-4 6/10/21 ADDENDUM #4


DRAWING INTERIOR ELEVATIONS AND DETAILS

HANOVER CSC NEW RESOURCE CENTER AND RELATED WORK

© GIBRALTAR DESIGN SHEET

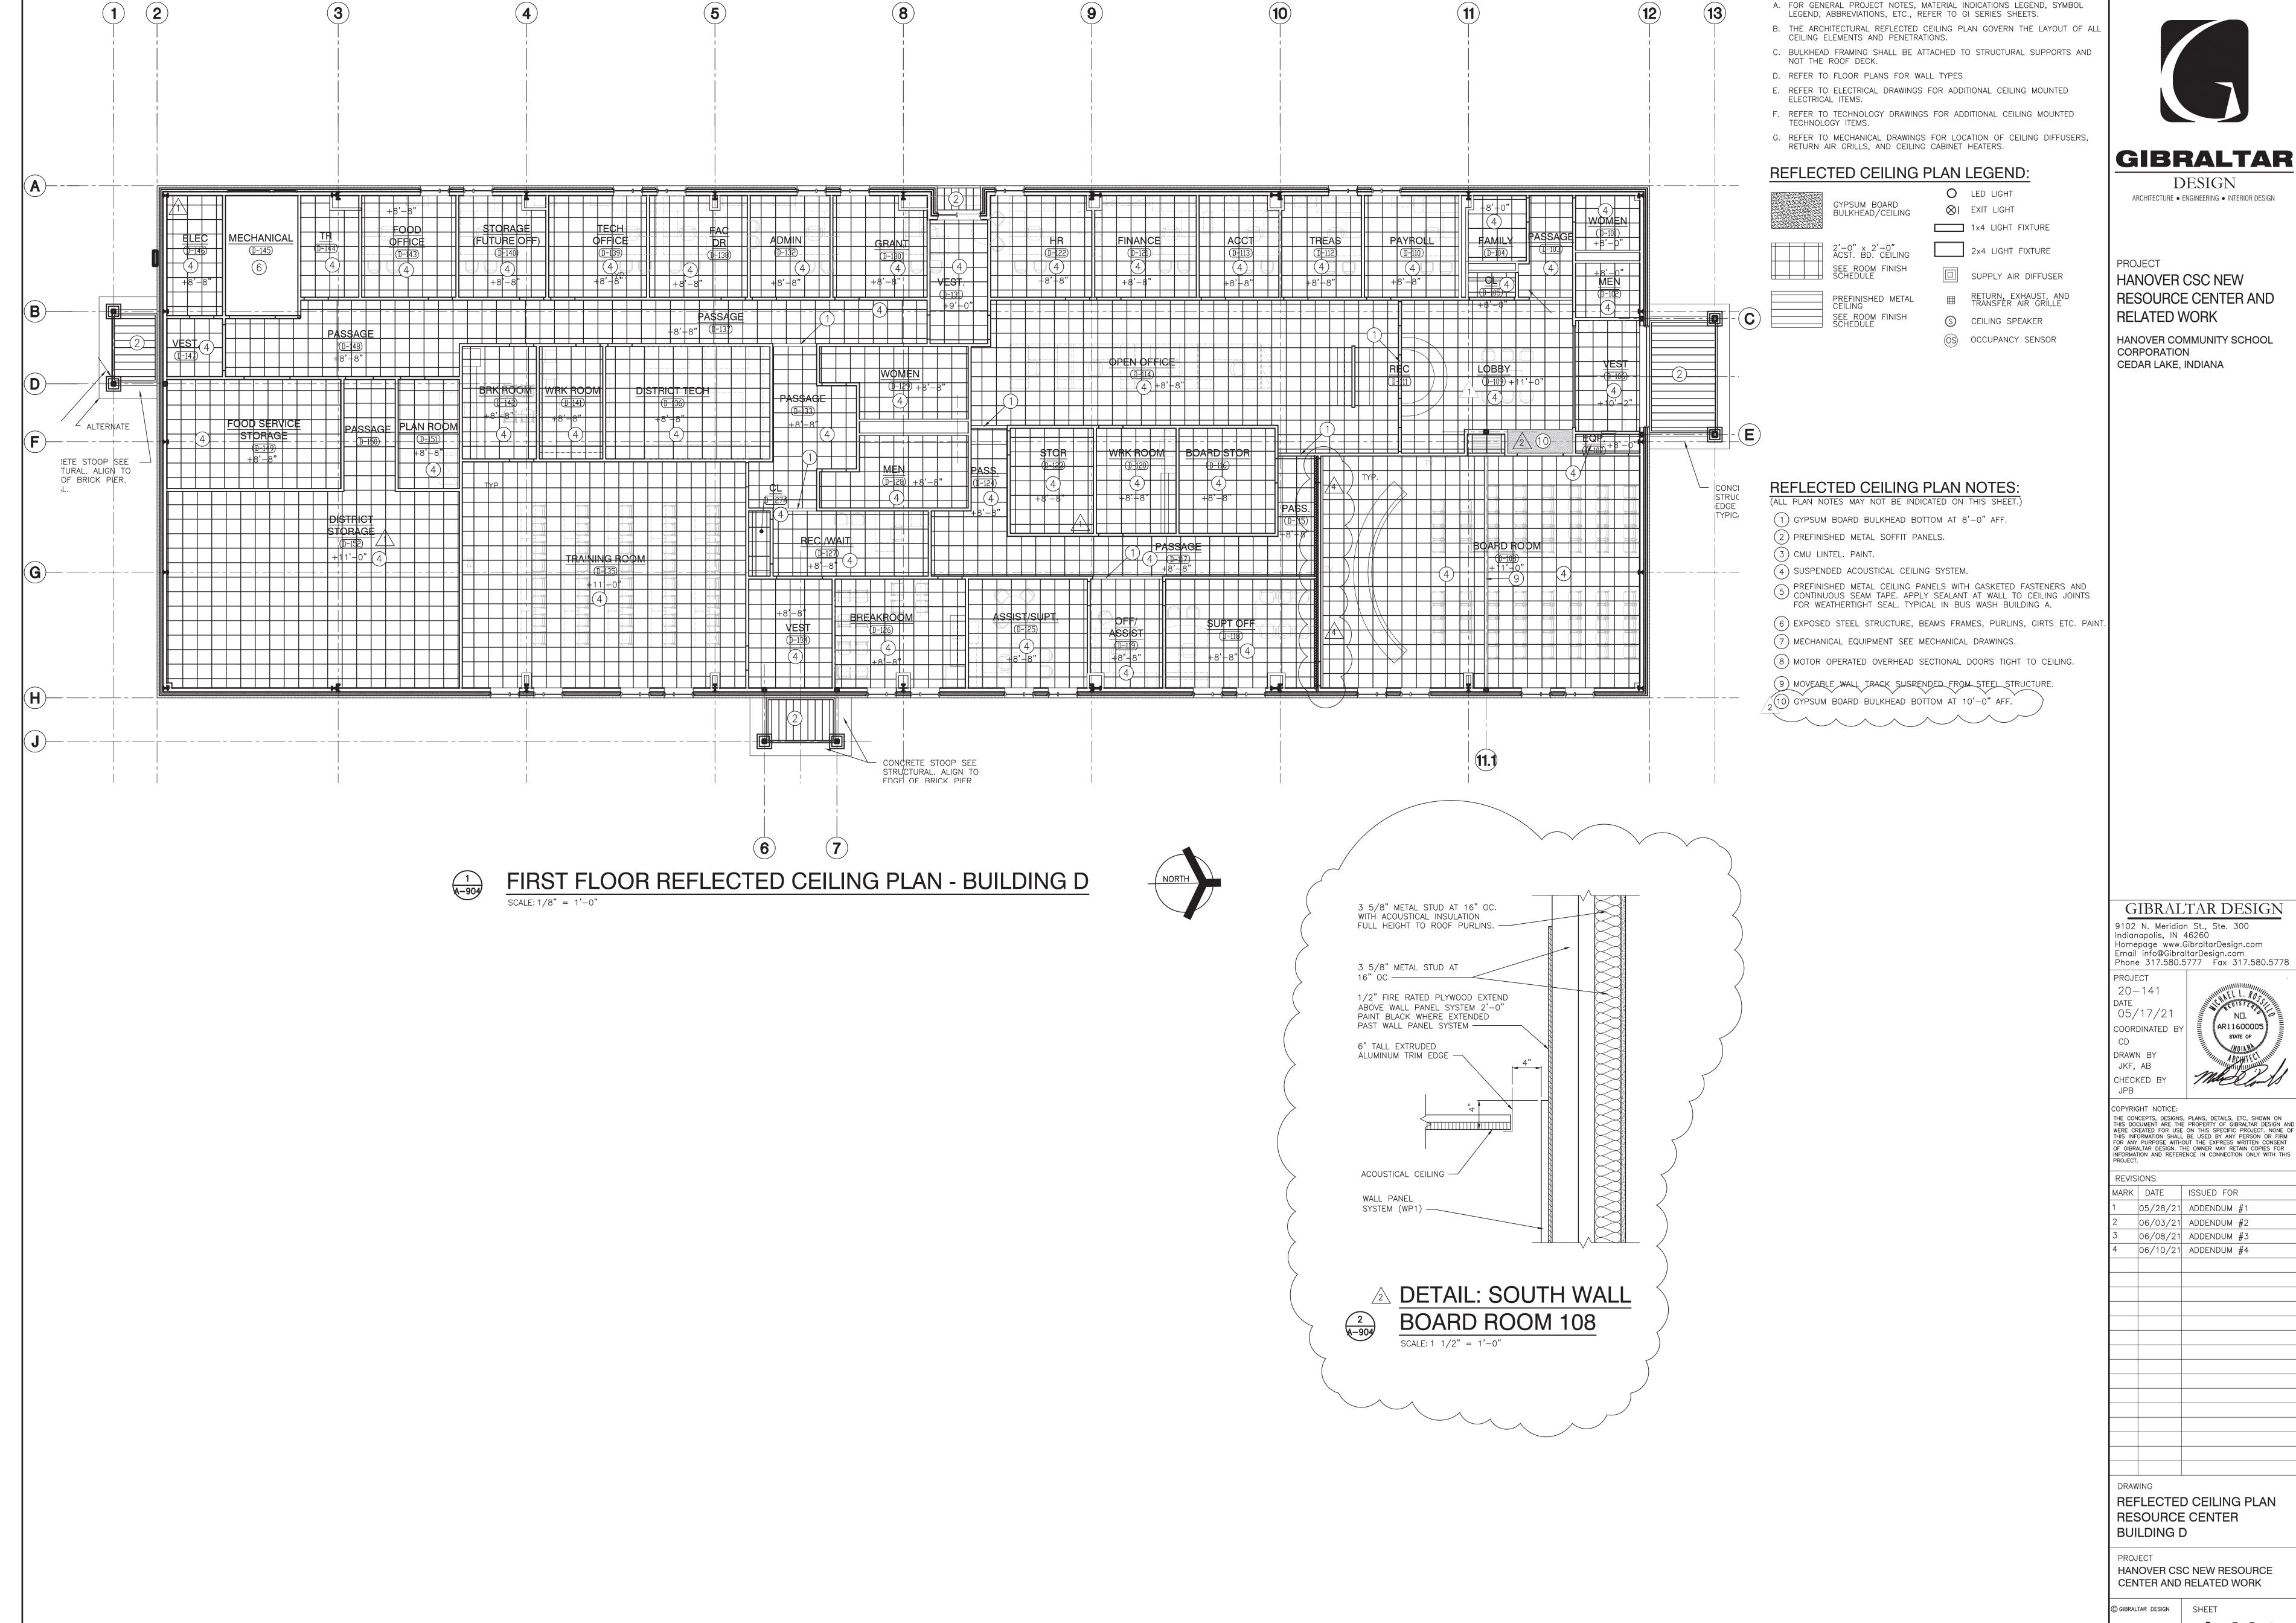

GENERAL REFLECTED CEILING PLAN NOTES:

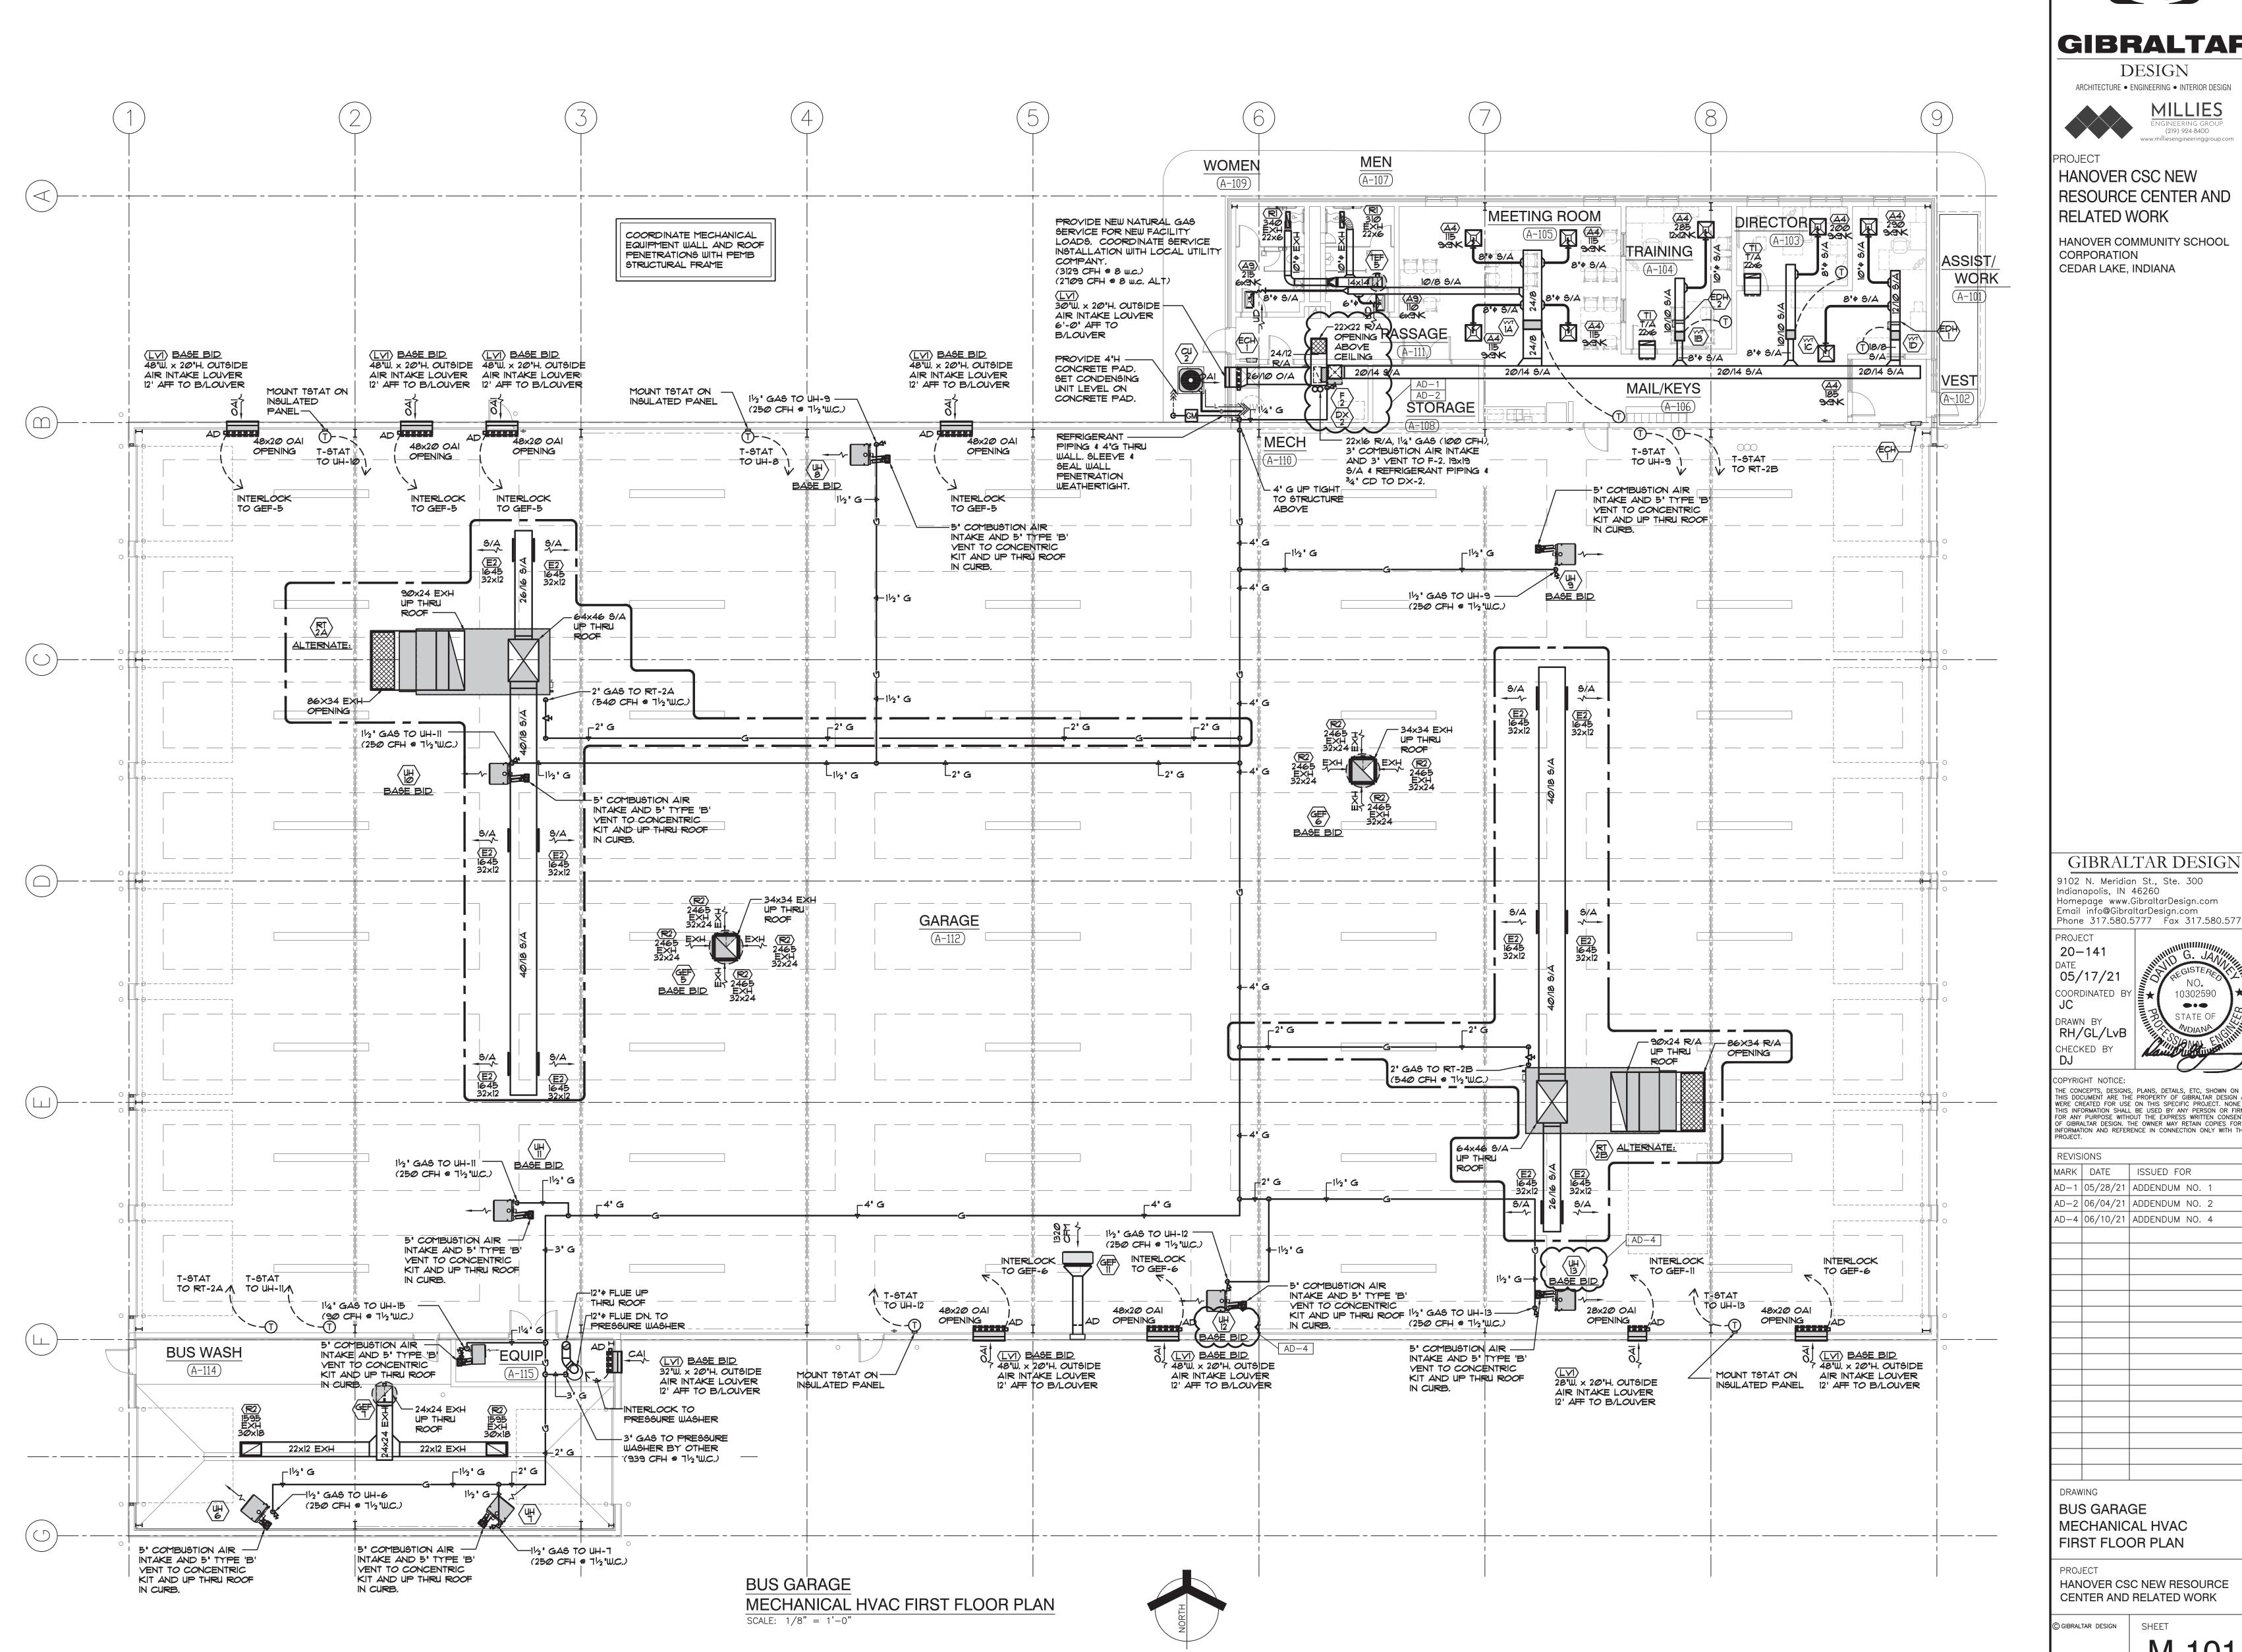



GIBRALTAR

(219) 924-8400

DESIGN ARCHITECTURE • ENGINEERING • INTERIOR DESIGN

HANOVER CSC NEW RESOURCE CENTER AND **RELATED WORK** 

HANOVER COMMUNITY SCHOOL CORPORATION CEDAR LAKE, INDIANA

GIBRALTAR DESIGN Indianapolis, IN 46260 Homepage www.GibraltarDesign.com Email info@GibraltarDesign.com

10302590

05/17/21 COORDINATED

THIS INFORMATION SHALL BE USED BY ANY PERSON OR FIRM FOR ANY PURPOSE WITHOUT THE EXPRESS WRITTEN CONSENT OF GIBRALTAR DESIGN. THE OWNER MAY RETAIN COPIES FOR INFORMATION AND REFERENCE IN CONNECTION ONLY WITH THIS PROJECT.

MARK DATE ISSUED FOR |AD-1|05/28/21|ADDENDUM NO. 1


AD-2 | 06/04/21 | ADDENDUM NO. 2AD-4 | 06/10/21 | ADDENDUM NO. 4

DRAWING BUS GARAGE MECHANICAL HVAC

FIRST FLOOR PLAN HANOVER CSC NEW RESOURCE

© GIBRALTAR DESIGN SHEET

M-101

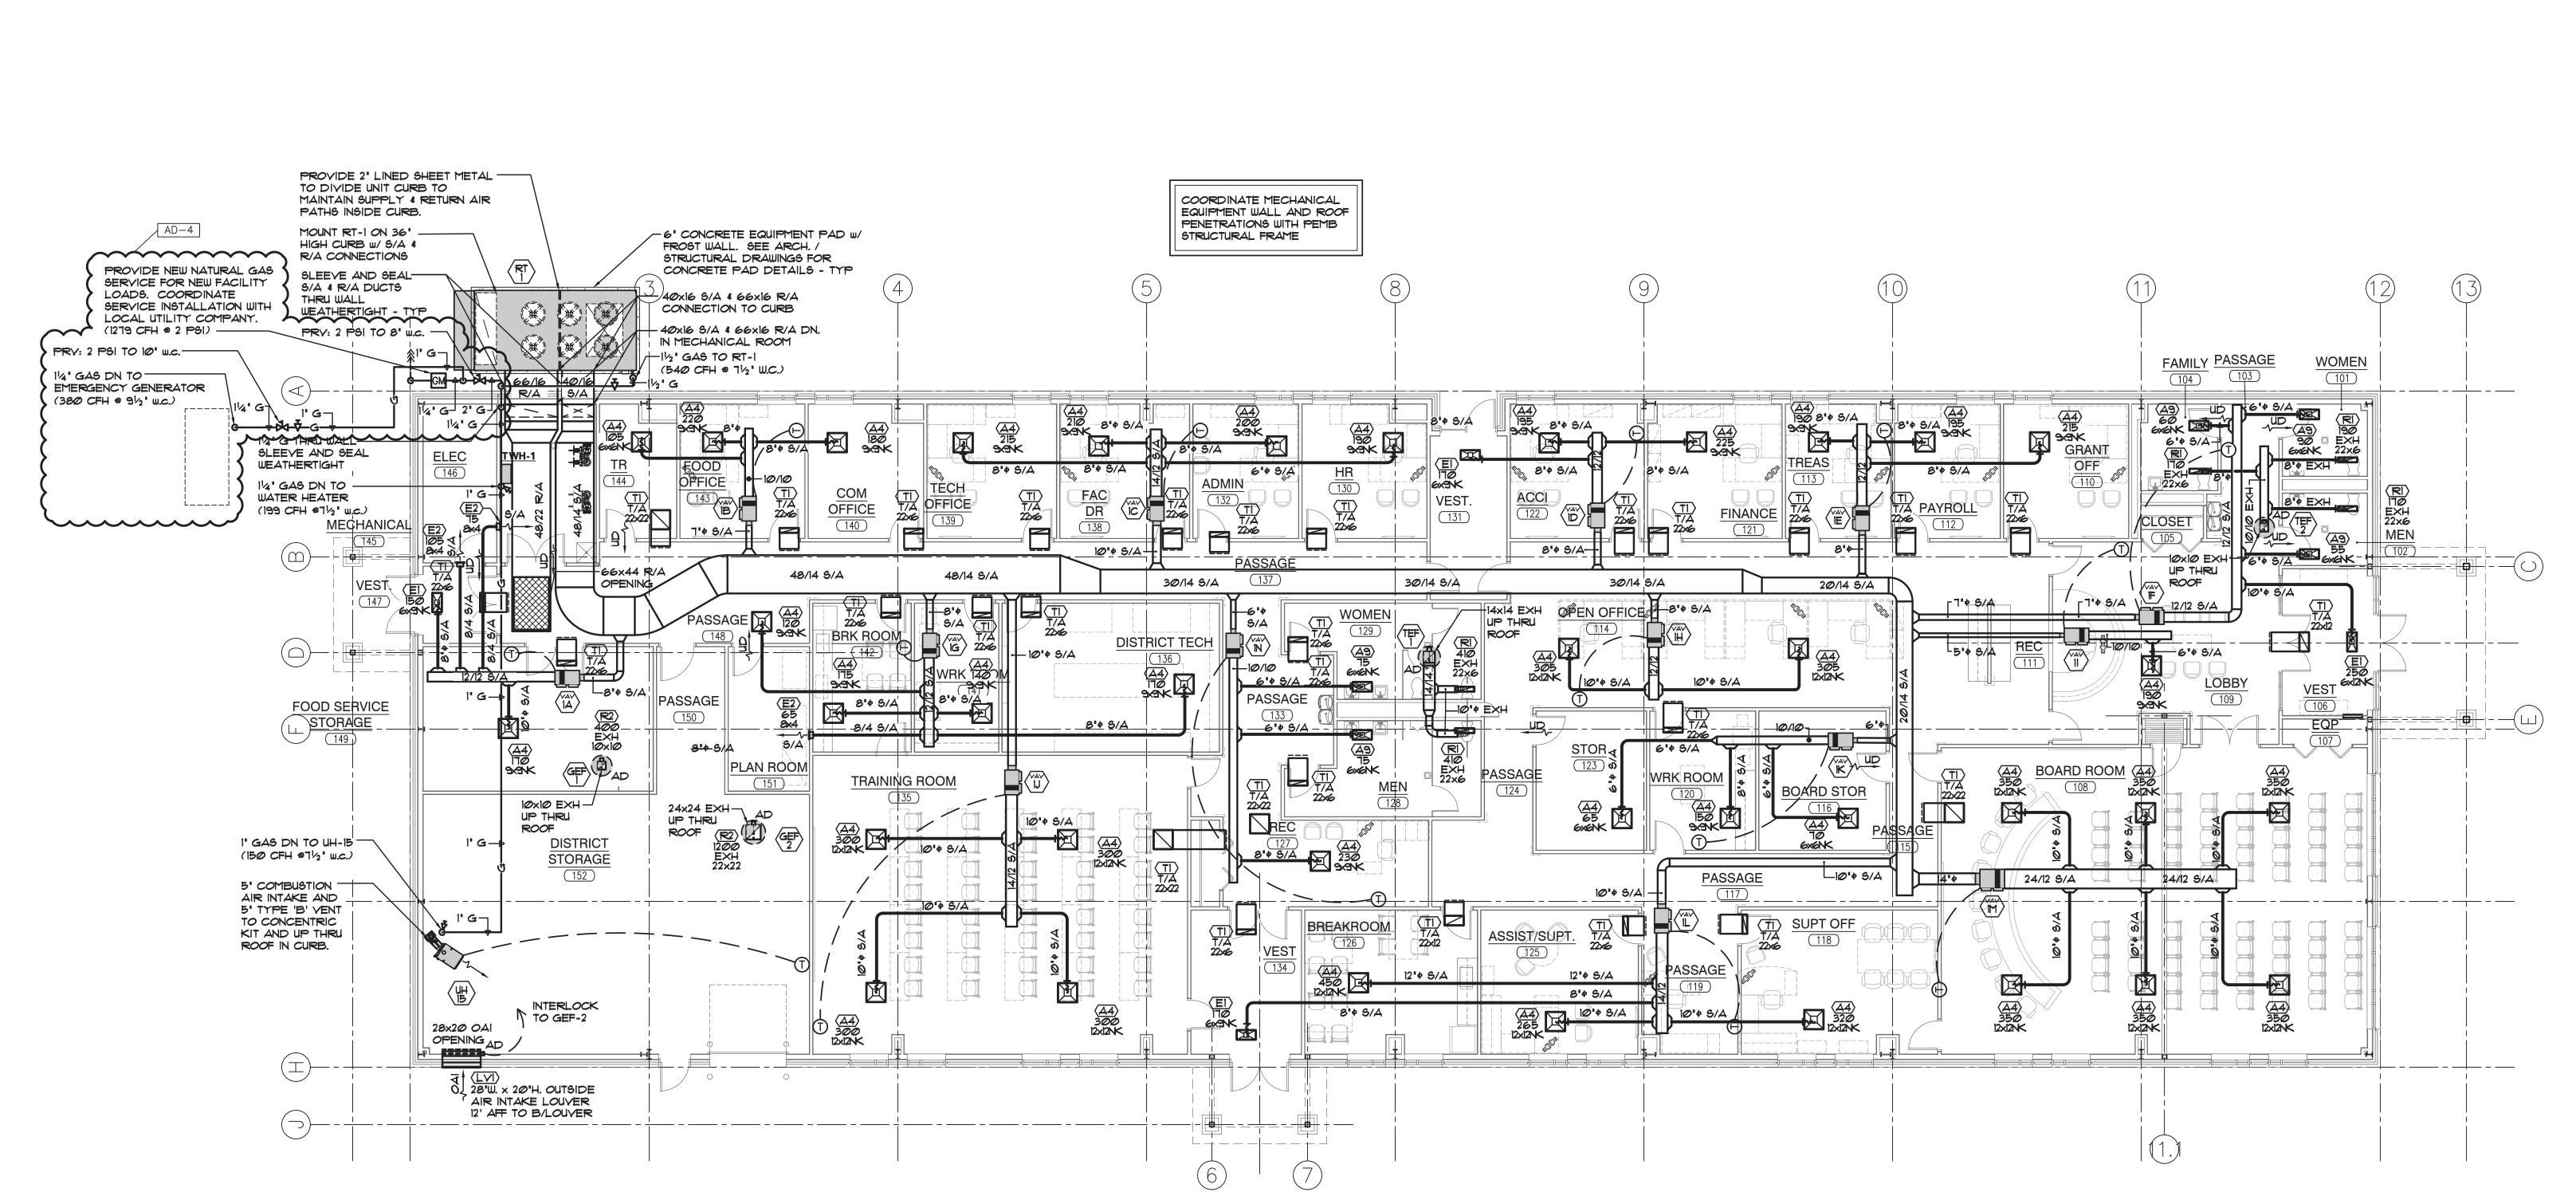



GIBRALTAR DESIGN



HANOVER CSC NEW RESOURCE CENTER AND RELATED WORK

HANOVER COMMUNITY SCHOOL CORPORATION CEDAR LAKE, INDIANA

GIBRALTAR DESIGN 9102 N. Meridian St., Ste. 300 Indianapolis, IN 46260 Homepage www.GibraltarDesign.com Email info@GibraltarDesign.com Phone 317.580.5777 Fax 317.580.5778

20-141 05/17/21 COORDINATED E 10302590 DRAWN BY RH/GL/LvB CHECKED BY

COPYRIGHT NOTICE: THE CONCEPTS, DESIGNS, PLANS, DETAILS, ETC, SHOWN ON THIS DOCUMENT ARE THE PROPERTY OF GIBRALTAR DESIGN AND WERE CREATED FOR USE ON THIS SPECIFIC PROJECT. NONE OF THIS INFORMATION SHALL BE USED BY ANY PERSON OR FIRM FOR ANY PURPOSE WITHOUT THE EXPRESS WRITTEN CONSENT OF GIBRALTAR DESIGN. THE OWNER MAY RETAIN COPIES FOR INFORMATION AND REFERENCE IN CONNECTION ONLY WITH THIS PROJECT.

MARK DATE ISSUED FOR AD-4 | 06/10/21 | ADDENDUM NO. 4

MECHANICAL FLOOR PLAN RESOURCE CENTER BUILDING D

HANOVER CSC NEW RESOURCE CENTER AND RELATED WORK

© GIBRALTAR DESIGN SHEET

M-104

MECHANICAL FLOOR PLAN RESOURCE CENTER BUILDING D SCALE: 1/8" = 1'-0"



						ME	CHA	NIC	AL E	QUII	PME	ENT	SCH	<del>I</del> EDL	JLE	- F	RES	OUR	CE	CEN	ITE	3													
					FAN MO	DTOR DA	ΓΑ			EXHAU	ST FANS	3	D	× COOLI	NG EQUIP	MENT/C	OIL DAT	ΓΑ		GAS FIR	ED HEA	TING EQU	UIPMENT	DATA					EL	ECTRICAL	DATA		UNITS	EQUIPME	ENT
TAG	MANUFACTURER	MODEL NUMBER	DESCRIPTION	EFFICIENCY		MIN														MBH	MBH				LOAD							STARTER BY:	CONTROLLED	WEIGHT	T REMARKS
					CFM	OAI	TSP E	SP BHF	P HP RP	M CFM	ESP E	BHP H	P RPM N	MBH SHO	EDB	EWB !	LDB L	WB CAT	STAGES	(IN)	(OUT)	EAT	LAT	STAGES	HP	MCA 1	LA AMF	S MOC	P VOL	_T PHASE	. HZ.	MC. EC.	BY		
RT-1	AAON	RN-040	GRADE MOUNTED PACKAGED HVAC ROOFTOP - DX/GAS FIRED (YAY)	10 EER	9985	2275	-	2 8.21	1 15 137	5 9985	0.55	1.6	3 1205	411 3@3	T.er &	64.8	50.4 4	9.8 95	MOD	540	432	39.7	3.61	MOD	-	217		25@	20	8 3	60	× -	FMS	7435	NOTE 1
UH-15	STERLING	XF-15Ø	INTERIOR SUSPENDED GAS FIRED UNIT HEATER	-	2400	-	-	-   -	1/4 105	o -	-	-   -	-   -		-	-	-		-	150	124.5	60	90	1	-	-	- 4.7	-	12@	1	60	- ×	FMS	157	NOTE 2
GEF-1	TWIN CITY	DCRD-Ø95BE	ROOF MOUNTED GENERAL EXHAUST FAN	-	-	-	-			395	0.5	- 1/	4 1341		-	-	-	-   -	-	-	-	-	-	-	1/4	-		-	12@	) 1	60	- ×	FMS	100	NOTE 3.
GEF-2	TWIN CITY	DCRD-160BE	ROOF MOUNTED GENERAL EXHAUST FAN	-	-	-	-			1200	0.5	- 1	1 919		-	-	-	-   -	-	-	-	-	-	-	1	-		-	12@	) 1	60	- ×	FMS	200	NOTE 3.
TEF-1	TWIN CITY	DCRD-120BE	ROOF MOUNTED TOILET EXHAUST FAN	-	-	-	-			820	0.5	- 1/	/2   13Ø4		-	-	-		-	-	-	-	-	-	1/2	-		-	12@	1	60	- ×	WALL SWITCH	175	NOTE 3.
TEF-2	TWIN CITY	DCRD-Ø95BE	ROOF MOUNTED TOILET EXHAUST FAN	-	-	-	-			530	0.5	- 1/	4 1422		-	-	-		-	-	-	-	-	-	1/4	-		-	12@	1	60	- ×	WALL SWITCH	100	NOTE 3.

1. PROYIDE WITH:

PROVIDE WITH: · DX COOLING CAPACITIES INDICATED BASED ON A TOTAL EQUIVALENT COOLING FROM A COMBINATION OF DX

SECTION & ERY COOLING INTEGRATED ECONOMIZER WITH DIFFERENTIAL ENTHALPY SENSORS

• FEEDBACK SIGNAL W/ IECC 2015 COMPLIANT LOW LEAK

ECONOMIZER DAMPER, • S/A & POW EXH DIRECT DRIVE FANS W/VFD,

 NON-FUSED DISCONNECT SWITCH HINGED ACCESS PANELS

 VIBRATION ISOLATION CURB W/ HUSHCORE DECK DS-52 ACOUSTICAL TREATMENT.

 POWERED EXHAUST FAN W/BLDG PRESSURIZATION A SOUTH SOUT

STAINCESS STEEL HEAT EXCHANGER MODULATING GAS W/HIGH TURNDOWN (SEE SCHEDULE)

 FLUE DEFLECTOR · CON

2. PROVIDE WITH:

 VIBRATION ISOLATION HANGERS CONCENTRIC YENT KIT SEE SPECIFICATIONS FOR ADDITIONAL REQUIREMENTS

3. PROVIDE WITH: DISCONNECT SWITCH

ROOF CURB

• ECM MOTOR WITH POTENTIOMETER SPEED CONTROLLER MOTORIZED DAMPER BIRD SCREEN

SEE SPECIFICATIONS FOR ADDITIONAL REQUIREMENTS

METAL MESH OUTSIDE AIR INTAKE HOOD FILTER	
CONDENSER FAN W/YFD W/HEAD PRESSURE CONTROL \$	
SITE GLASS	
<ul> <li>YAY HEATING &amp; COOLING</li> </ul>	
HAIL CONDENSER COIL GUARD PROTECTION	
• FILTERS: ERY(OAI) - 2" 30%, ERY(EXH) - 2" 30%,	
EYAPORATOR - 4" MERY 13	
SPECIFICATIONS FOR ADDITIONAL REQUIREMENTS.	

$\bigcirc$						MEC	CHANIC	AL I	EQI	UIPM	EN'	T SC	HEC	DULE	<b>-</b>	BUS	GAR	AGE														
					FAN MO	OTOR DAT	Ä		E	XHAUST FA	ANS		DX C	OOLING E	QUIPM	ENT/COIL DATA		G	:AS FIRED	HEATING	EQUIPME	ENT DATA					ELE	ECTRICAL	L DATA		UNITS	EQUIP
TAG	MANUFACTURER	MODEL NUMBER	DESCRIPTION	EFFICIENCY		MIN													MBH 1	1BH			LOAD						57	ARTER:	CONTROLLED	WEIGHT REMARKS
					CFM	OAI	TSP ESP BH	P HP 1	RPM (	CFM ESP	BHP	HP RP	M MBH	SHC ED	OB E	WB LDB LWE	CAT ST	AGES	(IN) (	OUT) EA	T LA	STAGE	8 HP	MCA	FLA AM	PS MOC	P VOL	T PHAS	BE HZ. 1	1C. EC	; BY	
RT-2A	AAON	RN-031	ROOF MOUNTED PACKAGED HVAC ROOFTOP - HEATING ONLY GAS FIRED (CV)	-	9870	9870	- 1 7.9	15	1358 9	0.5	5.9	Ø.25 124	<b>н</b> -		-		-	-	540	432 42	82.5	MOD	-	50	-	70	460	) 3	60	× -	CO2 SENSOR CONTROL	5768 NOTE 1
RT-2B	AAON	RN-031	ROOF MOUNTED PACKAGED HYAC ROOFTOP - HEATING ONLY GAS FIRED (CV)	-	9870	9870	- 1 7.9	15 1	1358 9	0.5	5.9	0.25 124	- F		-		-	-	540	432 42	82.5	MOD	-	50	-	70	460	) 3	60	× -	CO2 SENSOR CONTROL	5768 NOTE 1
F-2/DX-2	CARRIER	59TP6BI00//CNPVP60	VERTICAL UPFLOW GAS FIRED FURNACE (96% AFUE) / DX COOLING COIL	-	1790	360	- 0.5 -	-	-		-		55.5	40.9	1.9	55.1 567 54.9	-	-	100	- re	-	2	-	19.4	-	20	120	1	60	× -	FMS/WALL MTD TSTAT	- NOTE 2
CU-2	CARRIER	24ABB36	GRADE-MOUNTED AIR COOLED CONDENSING UNIT (+14.0 SEER)	-	-	-		-	-		-		55.5		-		95	1	-		_	-	-	10.5	-	15	460	) 3	60	× -	INTER'K TO F-2	23Ø NOTE 3
UH-6	STERLING	×F-25∅	INTERIOR SUSPENDED GAS FIRED UNIT HEATER	82%	2950	-		1/3 1	1050	-   -	-		-	-	-		-	-	250	207 60	100	1	-	-	- 5	8 -	120	1	60	× -	WALL MTD TSTAT	292 NOTE 4
UH-7	STERLING	×F-25∅	INTERIOR SUSPENDED GAS FIRED UNIT HEATER	82%	2950	-		1/3	1725	-   -	-		-		-		-	-	250	207 60	100	1	-	-	- 5	8 -	120	1	60	× -	WALL MTD TSTAT	260 NOTE 4
uH-8	STERLING	×F-25∅	INTERIOR SUSPENDED GAS FIRED UNIT HEATER	82%	2950	-		1/3	1725	-   -	-		-		-		-	-	250	207 60	100	1	-	-	- 5	8 -	120	1	60	× -	WALL MTD TSTAT	260 NOTE 4
uH-9	STERLING	×F-25∅	INTERIOR SUSPENDED GAS FIRED UNIT HEATER	82%	2950	-		1/3	1725	-   -	-		-		-		-	-	250	207 60	100	1	-	-	- 5	8 -	120	1	60	× -	WALL MTD TSTAT	260 NOTE 4
UH-10	STERLING	×F-25∅	INTERIOR SUSPENDED GAS FIRED UNIT HEATER	82%	2950	-		1/3	1725	-   -	-		-		-		-	-	250	207 60	100	1	-	-	- 5	8 -	120	1	60	× -	WALL MTD TSTAT	260 NOTE 4
UH-11	STERLING	×F-25∅	INTERIOR SUSPENDED GAS FIRED UNIT HEATER	82%	2950	-		1/3	1725		-		-		-		-	-	250	207 60	100	1	-	-	- 5	8 -	120	1	60	× -	WALL MTD TSTAT	260 NOTE 4
UH-12	STERLING	×F-25∅	INTERIOR SUSPENDED GAS FIRED UNIT HEATER	82%	2950	-		1/3	1725		-		-		-		-	-	250	207 60	100	1	-	-	- 5	8 -	120	1	60	× -	WALL MTD TSTAT	260 NOTE 4
UH-13	STERLING	×F-25∅	INTERIOR SUSPENDED GAS FIRED UNIT HEATER	82%	2950	-		1/3	1725	-   -	-		-		-		-	-	250	207 60	100	1	-	-	- 5	8 -	120	1	60	× -	WALL MTD TSTAT	260 NOTE 4
UH-14	STERLING	GG-90	INTERIOR SUSPENDED GAS FIRED UNIT HEATER	82%	1100	-		1/10 1	1050	-   -	-		-		-		-	-	3Ø .	13.8 60	100	1	-	-	- 4	2 -	120	1	60	× -	WALL MTD TSTAT	95 NOTE 4
GEF-5	TWIN CITY	DCRD-36ØD	ROOF MOUNTED GENERAL EXHAUST FAN	-	-	-		-	- 0	0.5	-	2 45	- F		-		-	-	-		_	-	2	-	-	-	480	) 3	60	× -	CO2 SENSOR CONTROL	400 NOTE 5
GEF-6	TWIN CITY	DCRD-36ØD	ROOF MOUNTED GENERAL EXHAUST FAN	-	-	-		-	- 0	0.5	-	2 45	- F		-		-	-	-		_	-	2	-	-	-	480	) 3	60	× -	CO2 SENSOR CONTROL	400 NOTE 5
GEF-7	TWIN CITY	DCRD-180BE	ROOF MOUNTED GENERAL EXHAUST FAN	-	-	-		-	- 3	3190 0.5	-	1 102	27 -		-		-	-	-		_	-	1	-	-	-	120	1	60	× -	CO2 SENSOR CONTROL	25Ø NOTE 5
GEF-II	TWIN CITY	T1500H	CABINET GENERAL EXHAUST FAN W/INTEGRAL GRILLE	-	-	-		-	- 1	1320 0.5	-	3/4 94	<i>o</i> -		-		-	-	-		_	-	3/4	-	-	-	120	1	60	- ×	CONTINUOUS	50 NOTE 6
TEF-5	TWIN CITY	DCRD-085BE	ROOF MOUNTED TOILET EXHAUST FAN	-	-	-	-   -   -	-	-	170 0.5	-	1/6 114	5 -	-   .	-	-   -   -	-	-	-		-	-	1/6	-	-	-	120	1	60	- ×	WALL SWITCH	100 NOTE 5

1. PROVIDE WITH: PROVIDE WITH:

INTEGRATED ECONOMIZER WITH DIFFERENTIAL ENTHALPY

• FEEDBACK SIGNAL W/ IECC 2015 COMPLIANT LOW LEAK ECONOMIZER DAMPER, S/A & POW EXH DIRECT DRIVE FANS W/VFD,

 NON-FUSED DISCONNECT SWITCH HINGED ACCESS PANELS

VIBRATION ISOLATION CURB W/ HUSHCORE DECK DS-52 ACOUSTICAL TREATMENT.
 POWERED EXHAUST FAN W/BLDG PRESSURIZATION

ENERGY RECOVERY WHEEL W/DEFROST & ECONOMIZER

BYPASS - SEE HEAT RECOVERY SCHEDULE MODULATING HOT GAS REHEAT AND DEHUMIDIFICATION

CONTROLS STAINLESS STEEL HEAT EXCHANGER

 MODULATING GAS W/HIGH TURNDOWN (SEE SCHEDULE) FLUE DEFLECTOR

 METAL MESH OUTSIDE AIR INTAKE HOOD FILTER CONDENSER FAN W/VFD FOR HEAD PRESSURE CONTROL

SITE GLASS

 SINGLE ZONE YAY HEATING & COOLING HAIL CONDENSER COIL GUARD PROTECTION

 FILTERS: ERV(OAI) - 2" 30%, ERV(EXH) - 2" 30%, EVAPORATOR - 4" MERY 13 SPECIFICATIONS FOR ADDITIONAL REQUIREMENTS.

SEE SPECIFICATIONS FOR ADDITIONAL REQUIREMENTS

2. PROVIDE WITH: · CASED DX COIL

CONCENTRIC VENT ADAPTER KIT

30% FILTERS AND RACKPROGRAMMABLE THERMOSTAT SEE SPECIFICATIONS FOR ADDITIONAL REQUIREMENTS

3. PROVIDE WITH:
NON FUSED DISCONNECT
4" CONCRETE EQUIPMENT PAD
SEE SPECIFICATIONS FOR ADDITIONAL REQUIREMENTS

4. PROVIDE WITH: VIBRATION ISOLATION HANGERS

CONCENTRIC VENT KIT

SEE SPECIFICATIONS FOR ADDITIONAL REQUIREMENTS 5. PROVIDE WITH:

 DISCONNECT SWITCH ECM MOTOR WITH POTENTIOMETER SPEED CONTROLLER
MOTORIZED DAMPER

 BIRD SCREEN ROOF CURB

SEE SPECIFICATIONS FOR ADDITIONAL REQUIREMENTS

6. PROVIDE WITH: BUILT IN BACK DRAFT DAMPER

 VIBRATION ISOLATORS SEE SPECIFICATIONS FOR ADDITIONAL REQUIREMENTS



DESIGN ARCHITECTURE • ENGINEERING • INTERIOR DESIGN



ROJECT HANOVER CSC NEW RESOURCE CENTER AND RELATED WORK

HANOVER COMMUNITY SCHOOL CORPORATION CEDAR LAKE, INDIANA

GIBRAL'	TAR DESIGN
mail info@Gibral	-6260 iibraltarDesign.com
ROJECT 20-141	min G. JANNI

10302590 •••

COORDINATED E DRAWN BY RH/GL/LvB

CHECKED BY

OPYRIGHT NOTICE: THE CONCEPTS, DESIGNS, PLANS, DETAILS, ETC, SHOWN ON THIS DOCUMENT ARE THE PROPERTY OF GIBRALTAR DESIGN AND WERE CREATED FOR USE ON THIS SPECIFIC PROJECT. NONE OF THIS INFORMATION SHALL BE USED BY ANY PERSON OR FIRM FOR ANY PURPOSE WITHOUT THE EXPRESS WRITTEN CONSENT OF GIBRALTAR DESIGN. THE OWNER MAY RETAIN COPIES FOR INFORMATION AND REFERENCE IN CONNECTION ONLY WITH THIS PROJECT.

MARK	DATE	ISSUED FOR
AD-4	06/10/21	ADDENDUM NO. 4

MECHANICAL SCHEDULES

HANOVER CSC NEW RESOURCE CENTER AND RELATED WORK

© GIBRALTAR DESIGN SHEET

M-601

$\bigcirc$						MEC	CHA	NIC	AL	EQ	UIPN	NEN.	T S	CHE	DULE	-	MAIN	ITE	NANC	E	GAR	AG	E												
					FAN MO	OTOR DAT	·A				EXHAUST	FANS		DX C	OOLING EC	QUIPME	NT/COIL DAT	TA		GAS FIR	ED HEA	TING EQU	IIPMENT (	DATA					ELE	CTRICAL	DATA		UNITS	EQUIPME	.NT
TAG	MANUFACTURER	MODEL NUMBER	DESCRIPTION	EFFICIENCY		MIN														MBH	MBH			ļ	LOAD						STAF	TER BY:	CONTROLLED	WEIGHT	T REMARKS
					CFM	OAI	TSP E	SP BHF	P HP	RPM	CFM ES	BHP	HP R	PM MBH	SHC ED	OB EU	B LDB LI	WB CA	AT STAGES	(IN)	(OUT)	EAT	LAT S	BTAGES	HP	MCA FL	_A A1	MPS MO	CP YOL	T PHASE	HZ. MC.	EC.	BY		
PTAC-1	FRIGIDAIRE	FRPIST	PACKAGED TERMINAL AIR CONDITIONING UNIT W/ELECTRIC HEAT	-	315	35	-		-	-	-   -		-	- 14.6	-   -	-   -	-	- 9	1	-	-	-	-	-	-	205 -	-	- 34	208	1	60 -	-	INTEGRAL TSTAT	דוו	NOTE 1
uH-3	STERLING	GG-120	INTERIOR SUSPENDED GAS FIRED UNIT HEATER	82%	1475	-	-		1/10	1050	-   -	-   -	-			-   -	-	-   -		120	98.4	60	100	1	-		-   -	4.2 -	120	1	60 ×	-	WALL MTD TSTAT	110	NOTE 2
UH-4	STERLING	GG-120	INTERIOR SUSPENDED GAS FIRED UNIT HEATER	82%	1475	-	-		1/10	1050		-   -	-			-   -	-	-   -		120	98.4	60	100	1	-			4.2 -	120	1	60 ×	-	WALL MTD TSTAT	110	NOTE 2
uH-5	STERLING	GG-120	INTERIOR SUSPENDED GAS FIRED UNIT HEATER	82%	1475	-	-		1/10	1050	-   -	-   -	-			-   -	-	-   -		120	98.4	60	100	1	-			4.2 -	120	1	60 ×	-	WALL MTD TSTAT	110	NOTE 2
GEF-4	TWIN CITY	DCRD-160BE	ROOF MOUNTED GENERAL EXHAUST FAN	-	-	-	-		_	-	2050 0	.5 -	1 11	Ø8 -			-			-	-	-	-	-	1		-		115	1	60 -	×	CO2 SENSOR SYS	25Ø	NOTE 3
GEF-10	TWIN CITY	T300V	CABINET GENERAL EXHAUST FAN W/INTEGRAL GRILLE	-	-	-	-		-	-	140 0	.5 -	1/3 6	- 86			-			-	-	-	-	-	1/3		-		115	1	60 -	×	CONTINUOUS	50	NOTE 4
TEF-4	TWIN CITY	DCRD-060BE	ROOF MOUNTED TOILET EXHAUST FAN	-	-	-	-		-	-	130 0	.4 -	1/6 16			-   -	-			-	-	-	-	-	1/6		-		115	1	60 -	×	WALL SWITCH	90	NOTE 3

1. PROVIDE WITH:

• INTEGRAL S/A & R/A GRILLES · WALL SLEEVE AND LOUVER

SEE SPECIFICATIONS FOR ADDITIONAL REQUIREMENTS

2. PROVIDE WITH: VIBRATION ISOLATION HANGERS CONCENTRIC VENT KIT SEE SPECIFICATIONS FOR ADDITIONAL REQUIREMENTS

3. PROVIDE WITH:
DISCONNECT SWITCH
ECM MOTOR WITH POTENTIOMETER SPEED CONTROLLER

 MOTORIZED DAMPER · BIRD SCREEN ROOF CURB

SEE SPECIFICATIONS FOR ADDITIONAL REQUIREMENTS

4. PROVIDE WITH: BUILT IN BACK DRAFT DAMPER VIBRATION ISOLATORS

 WALL CAP SEE SPECIFICATIONS FOR ADDITIONAL REQUIREMENTS

MECHANICAL EQUIPMENT SCHEDULE - MECHANICS BUILDING

					FAN M	OTOR DA	4T <i>A</i>				EXHAUS	T FANS		<b>[</b>	OX COOL	.ING EQUI	PMENT/	COIL DA	ATA		GAS	FIRED	HEATING B	<u>QUIPM</u>	ENT DATA						ELEC.	TRICAL D	DATA		UNITS	EQUIP	
TAG	MANUFACTURER	MODEL NUMBER	DESCRIPTION	EFFICIENCY		MIN															ME	3H ME	зн			LO	D							STARTER BY	CONTROLLED	WEIGHT	REMARKS
					CFM	OAI	TSP	ESP B	HP HF	PPM	CFM I	ESP BHP	HP F	RPM 1	MBH SH	C EDB	EWB	LDB I	LWB CA	AT STAG	ES (IN	1) (0	JT) EAT	LA	STAGE	S H	MC4	4 FLA	AMP	MOCF	VOLT	PHASE	HZ.	MC. EC.	BY		
F-1/DX-1	CARRIER	59TP6B060/CNPVP36	VERTICAL UPFLOW GAS FIRED FURNACE (96% AFUE) / DX COOLING COIL	96.30%	1050	145	-	0.5	-   -	-	-		-	-	31 25	.5 78.5	64.7	56	54.9 -	-	60	Ø 5	8 59	109.	3 2	-	10.9	- 6	-	15	120	1	60	× -	WALL MTD TSTAT	188	NOTE 1
CU-1	CARRIER	24ABB336	GRADE-MOUNTED AIR COOLED CONDENSING UNIT (+14.0 SEER)	II EER	-		-	-	-   -	1	-		-	-	31 -	.   -	-	-	- 9	5 1	-		-	-	-	-	т.т	-	-	15	460	3	60	× -	INTERLOCK TO F-1	170	NOTE 2
uH-1	STERLING	×F-175	INTERIOR SUSPENDED GAS FIRED UNIT HEATER	82%	2850	ı	-	-	- 1/3	3 1050	-		-	-	-   -		-	-		-	17!	5 14	5.2 60	100	1	-	-	-	5.8	-	120	1	60	× -	WALL MTD TSTAT	195	NOTE 3
UH-2	STERLING	XF-175	INTERIOR SUSPENDED GAS FIRED UNIT HEATER	82%	2851		-	-	- 1/3	3 1050	-		-	-		.   -	-	-	-   -		179	5 14	5.2 60	100	1	-	-	-	5.8	-	120	1	60	× -	WALL MTD TSTAT	195	NOTE 3
UH-1A	STERLING	×F-175	INTERIOR SUSPENDED GAS FIRED UNIT HEATER (ALTERNATE)	82%	2852		-	-	- 1/3	3 1050	-		-	-		.   -	-	-	-   -		179	5 14	5.2 60	100	1	-	-	-	5.8	-	120	1	60	× -	WALL MTD TSTAT	195	NOTE 3
UH-2A	STERLING	×F-175	INTERIOR SUSPENDED GAS FIRED UNIT HEATER (ALTERNATE)	82%	2853	ı	-	-	- 1/3	3 1050	-		-	-	-   -		-	-	-   -	-	ודו	5 14	5.2 60	100	1	-	-	-	5.8	-	120	1	60	× -	WALL MTD TSTAT	195	NOTE 3
GEF-3	TWIN CITY	DCRD-160BE	ROOF MOUNTED GENERAL EXHAUST FAN	-	-	ı	-	-		-	2445	0.5 -	1 12	2Ø7	-   -		-	-	-   -	-	_			-	•	1	-	-	-	-	115	1	60	- ×	CO2 SENSOR SYS	25Ø	NOTE 4
GEF-3A	TWIN CITY	DCRD-180BE	ROOF MOUNTED GENERAL EXHAUST FAN (ALTERNATE)	-	-	-	-	-		-	44Ø5	Ø.5 -	2 1:	245	-   -		-	-		-	-			-	-	2	-	-	-	-	208	1	60	- ×	CO2 SENSOR SYS	275	NOTE 4
GEF-8	TWIN CITY	T300V	CABINET GENERAL EXHAUST FAN W/INTEGRAL GRILLE	-	-		-	-	-   -	1	165	Ø.5 -	1/3	שוד		.   -	-	-	-   -		-		-	-	-	1/3	-	-	-	-	115	1	60	- ×	CONTINUOUS	5Ø	NOTE 5
GEF-9	TWIN CITY	TTOOH	CABINET GENERAL EXHAUST FAN W/INTEGRAL GRILLE	-	-	-	-	-		-	295	Ø.5 -	1/2 -	104			-	-						_	-	1/2	-	-	-	-	115	1	60	- ×	CONTINUOUS	50	NOTE 5
TEF-3	TWIN CITY	DCRD-Ø95BE	ROOF MOUNTED TOILET EXHAUST FAN	-	-	-	-	-	-   -	-	290	0.5 -	1/4 1	1281			-	-	-   -		-			-	-	1/-	-	-	-	-	115	1	60	- ×	WALL SWITCH	100	NOTE 4

NOTE: 1. PROVIDE WITH:

CASED DX COIL

 CONCENTRIC YENT ADAPTER KIT • 30% FILTERS AND RACK

 PROGRAMMABLE THERMOSTAT SEE SPECIFICATIONS FOR ADDITIONAL REQUIREMENTS 2. PROYIDE WITH: NON FUSED DISCONNECT

CONCENTRIC YENT KIT

 4' CONCRETE EQUIPMENT PAD SEE SPECIFICATIONS FOR ADDITIONAL REQUIREMENTS

SEE SPECIFICATIONS FOR ADDITIONAL REQUIREMENTS

3. PROYIDE WITH: VIBRATION ISOLATION HANGERS · DISCONNECT SWITCH

4. PROVIDE WITH:

• ECM MOTOR WITH POTENTIOMETER SPEED CONTROLLER MOTORIZED DAMPER

 BIRD SCREEN · ROOF CURB SEE SPECIFICATIONS FOR ADDITIONAL REQUIREMENTS 5. PROVIDE WITH: BUILT IN BACK DRAFT DAMPER VIBRATION ISOLATORS

 WALL CAP SEE SPECIFICATIONS FOR ADDITIONAL REQUIREMENTS

											HE	AT R	EC	OV	ER	RY S	SCH	IEDI	JLE												
	MIXED (	SUPPLY,	AIR				RETUR	RN Ali	R				EXHA	UST AIR					OUTS	IDE AI	R			HEAT WHE	EL DIS	CHARGI	E				
	SUMMER	!	WINTE	R			SUMME	ER	WI	NTER			SUMM	ER	1	WINTER			sumi	1ER	WI	NTER			SUMM	ER	l	JINTER			
CFM	PB	WB	PB	WB		CFM	DB	WB	تا	2B_J		CFM C	PB	WB		PB	WB		1 DB			ZB WE	3	CFM	DB.	WB		DB_	WB		REMARKS
		F			F				F		F				F		F				F		F				F		Ŧ	=  -	
OF8,E						0	T					9,870							- <sub>T</sub> -	75			. – .–	9,870	-1					7 -	<del>~~~~</del>
<b>9</b> ,53 <i>0</i>	81.2	66.9 F	41.9	36.0	F	Ø	75	63	F 7	10	53 F	9,570	88.4	ר.שר	F	16.0	16.0 F	9,87	Ø 95	75	<b>F</b> -	10 -1	1 F	@F8,e	81.2	66.9	F	41.9	36.0 F	=  -	
	CFM 9,870	SUMMER DB DB 9,870 812	SUMMER DB WB F 9,870 81.2 66.9 F	CFM DB WB DB PB 9,870 81.2 66.9 F 41.9	SUMMER WINTER  DB WB  PB WB  9,870 81.2 66.9 F 41.9 36.0	SUMMER WINTER  DB WB  F  F  9,870  812 66.9 F  41.9 36.0 F	SUMMER WINTER  DB WB DB WB CFM  9,870 81.2 66.9 F 41.9 36.0 F 0	SUMMER WINTER SUMME  CFM DB WB DB WB CFM DB  9,870 81.2 66.9 F 41.9 36.0 F 0 T5	SUMMER   WINTER   SUMMER   DB WB   CFM   DB WB   DB WB	SUMMER WINTER SUMMER WINTER  PB WB PB	MIXED SUPPLY AIR  SUMMER  BUNTER  BUNT	MIXED SUPPLY AIR  SUMMER  BUMMER  BUMM	MIXED SUPPLY AIR  SUMMER  BUNTER  BUMMER  BUMM	MIXED SUPPLY AIR  SUMMER  SUMM	MIXED SUPPLY AIR  SUMMER  SUMM	MIXED SUPPLY AIR  SUMMER  SUMM	MIXED SUPPLY AIR  RETURN AIR  SUMMER  SUMMER	MIXED SUPPLY AIR  RETURN AIR  SUMMER  SUMMER  SUMMER  SUMMER  SUMMER  SUMMER  SUMMER  SUMMER  DB WB  DB WB  DB WB  DB WB  PB WB	MIXED SUPPLY AIR  RETURN AIR  SUMMER  SUMMER	SUMMER WINTER SUMMER WINTER SUMMER SU	MIXED SUPPLY AIR  RETURN AIR  SUMMER  SUMMER	MIXED SUPPLY AIR  RETURN AIR  SUMMER  SUMMER	MIXED SUPPLY AIR  RETURN AIR  RETURN AIR  SUMMER  SUMM	MIXED SUPPLY AIR  RETURN AIR  RETURN AIR  SUMMER  SUMM	MIXED SUPPLY AIR  RETURN AIR  RETURN AIR  EXHAUST AIR  OUTSIDE AIR  HEAT WHE  SUMMER  WINTER  SUMMER  WINTER  SUMMER  F  F  F  F  F  F  F  F  F  F  F  F  F	MIXED SUPPLY AIR  RETURN AIR  RETURN AIR  EXHAUST AIR  OUTSIDE AIR  HEAT WHEEL DIS  SUMMER  SU	MIXED SUPPLY AIR  RETURN AIR  RETURN AIR  EXHAUST AIR  OUTSIDE AIR  HEAT WHEEL DISCHARGE  SUMMER  SUMM	MIXED SUPPLY AIR  RETURN AIR  RETURN AIR  EXHAUST AIR  OUTSIDE AIR  HEAT WHEEL DISCHARGE  SUMMER  SUMM	MIXED SUPPLY AIR  RETURN AIR  RETURN AIR  EXHAUST AIR  OUTSIDE AIR  HEAT WHEEL DISCHARGE  SUMMER  SUMM	MIXED SUPPLY AIR  RETURN AIR  RETURN AIR  EXHAUST AIR  OUTSIDE AIR  HEAT WHEEL DISCHARGE  SUMMER  SUMM	MIXED SUPPLY AIR  RETURN AIR  EXHAUST AIR  OUTSIDE AIR  HEAT WHEEL DISCHARGE  SUMMER  WINTER  SUMMER  WINTER  DB WB  DB WB  CFM  DB WB  DB WB  CFM  DB WB  DB WB  CFM  DB WB

$\bigcirc$		MECHAI	NICAL EQUIPMENT S	CHE	DUL	-E	- [	ELE	CTRIC	СН	EA	<b>\TE</b>	RS						
				FAN DATA	A ELECT	TRIC H	EAT DA			ELECT	RICAL	DATA		ļ.,			UNITS	EQUI	
TAG	MANUFACTURER	MODEL NUMBER	DESCRIPTION	S/A CFM	MBH	KW	EAT	1	HP MCA FLA	AMPS	MOCF	VOLTI	PHASE I		SC. SI C. E		TROLLED BY	WEIGH	TREMARKS
ECH-1	QMARK	AWH4404F	WALL MOUNTED ELECTRIC CABINET HEATER	100	10.2	3.0	60	154		14.4	-	208	1 6	Ø	-	× INTEG	RAL T-STA	T 40	-

$\rangle$			GRILLE, F	REGISTER	& DIFFUS	ER S	CHEDU	LE
'AG	MANUFACTURER	MODEL NO.	DESCRIPTION	AIR PATTERN	MOUNTING	SIZE	TYPE OF CONTROL	REMARKS
Δ4	NAILOR	6500-0	SUPPLY CEILING DIFFUSER	4-WAY	2' × 2' LAY-IN PANEL	SEE Plans	OBD.	-
AS	NAILOR	6500-0	SUPPLY CEILING DIFFUSER	3-WAY	2' X I' LAY-IN PANEL	SEE Plans	O.B.D.	-
A9	NAILOR	6500-0	SUPPLY CEILING DIFFUSER	4-WAY	2' X I' LAY-IN PANEL	SEE Plans	0.B.D.	-
ΕI	NAILOR	61DH-0	SUPPLY CEILING REGISTER	DOUBLE DEFLECTION	2' X I' LAY-IN PANEL	SEE Plans	O.B.D.	HORIZONTAL FRONT BARS, VERTICAL BACK BARS
E2	NAILOR	61DH-0	SUPPLY CEILING REGISTER	DOUBLE DEFLECTION	SURFACE MOUNTED	SEE Plans	OBD.	HORIZONTAL FRONT BARS, VERTICAL BACK BARS
KI	NAILOR	61DHC	SUPPLY REGISTER	DOUBLE DEFLECTION	DUCT MOUNTED	SEE Plans	FULL LENGTH EXTRACTOR	PROVIDE w/ MILL FINISH
RI	NAILOR	6145H-O	RETURN/EXHAUST REGISTER	LOUVERED GRILLE	LAY-IN PANEL	SEE Plans	O.B.D.	-
R2	NAILOR	6145H-O	RETURN/EXHAUST REGISTER	LOUVERED GRILLE	SURFACE MOUNTED	SEE Plans	O.B.D.	-
ΤI	NAILOR	6145H	RETURN/EXHAUST/T.A. GRILLE	LOUVERED GRILLE	LAY-IN PANEL	SEE Plans	-	-
T2	NAILOR	6145H	RETURN/EXHAUST/T.A. GRILLE	LOUVERED GRILLE	SURFACE MOUNTED	SEE Plans	-	-

igwedge			17 1 - 1	777		7141114	L SCI	ILDULI				
TAG	MANUFACTURER	MODEL	INLET	CFM SETTIN	G	HEATING	ELEC REHEAT	COIL DATA	ELECT	RICAL D	ATA	REMARKS
			DIA.	MAX	MIN	MIN	KW	No OF	VOLTS	PHASE	HZ	
				CFM	CFM	CFM		STEPS				
14	NAILOR	D30RE-08	8'	620	137	25Ø	5.0	3	208	3	60	NOTE 1
18	NAILOR	D30RE-07	7*	505	111	250	4.0	3	208	1	60	NOTE 1
10	NAILOR	D30RE-10	10"	815	180	333	6.5	3	208	3	60	NOTE 1
D	NAILOR	D30RE-08	8'	590	130	250	4.5	3	208	3	60	NOTE 1
11=	NAILOR	D30RE-08	8'	600	132	250	4.5	3	208	3	60	NOTE 1
1F	NAILOR	D30RE-01	יד	475	105	250	3.5	3	208	1	60	NOTE 1
IG	NAILOR	D3ØRE-Ø8	8'	640	141	250	2.0	2	208	1	60	NOTE 2
11-1	NAILOR	D3ØRE-Ø8	8'	785	173	250	2.0	2	208	1	60	NOTE 2
11	NAILOR	D3ØRE-Ø5	5'	190	42	167	1.5	2	208	1	60	NOTE 2
IJ	NAILOR	D30RE-10	10"	1,205	266	333	9.5	3	208	3	60	NOTE 1
11<	NAILOR	D3ØRE-06	6'	285	63	167	1.5	2	208	1	60	NOTE 2
11_	NAILOR	D30RE-10	10"	1,125	248	333	9.0	3	208	3	60	NOTE 1
IM	NAILOR	D30RE-14	14"	2,085	460	750	16.0	3	208	3	60	NOTE 1
1N	NAILOR	D30RE-06	6'	390	86	167	1.5	2	208	1	60	NOTE 2

			LOUVER SCH	HEDULE	
TAG	MANUFACTURER	MODEL NO.	DESCRIPTION	SIZE	REMARKS
LV-1	NAILOR	16Ø5WD	OUTSIDE AIR INTAKE LOUVER	SEE DRAWINGS	ALUMINUM KYNAR 500 CUSTOM FINISH SUBMIT COLOR CHARTS FOR APPROVAL

NOTE 2: OPEN/CLOSE SEQUENCE

		F-2 V	VT TE	ERMINAI	L SCH	<b>EDUL</b>	E
TAG	MANUFACTURER	MODEL	INLET	CFM SETTING		MAX	
				MAX.	MIN.	PD	REMARKS
14	CARRIER	33CSDC24Ø8	8×24	1,180	186	.1"	-
B	CARRIER	33C5DCDR08	8'	285	45	.1"	-
IC	CARRIER	33C5DCDR08	8'	200	31	.1"	-
1D	CARRIER	33CSDC18Ø8	SxIS	625	98	.1"	-



GIBRALTAR DESIGN

ARCHITECTURE • ENGINEERING • INTERIOR DESIGN

**MILLIES** ENGINEERING GROU (219) 924-8400

HANOVER CSC NEW RESOURCE CENTER AND RELATED WORK

HANOVER COMMUNITY SCHOOL CORPORATION CEDAR LAKE, INDIANA

GIBRALTAR DESIGN 9102 N. Meridian St., Ste. 300 ndianapolis, IN 46260 Homepage www.GibraltarDesign.com

Email info@GibraltarDesign.com Phone 317.580.5777 Fax 317.580.5778 PROJECT 20-141 05/17/21 COORDINATED E

10302590 DRAWN BY RH/GL/LvB CHECKED BY COPYRIGHT NOTICE:

THE CONCEPTS, DESIGNS, PLANS, DETAILS, ETC, SHOWN ON THIS DOCUMENT ARE THE PROPERTY OF GIBRALTAR DESIGN AND WERE CREATED FOR USE ON THIS SPECIFIC PROJECT. NONE OF THIS INFORMATION SHALL BE USED BY ANY PERSON OR FIRM FOR ANY PURPOSE WITHOUT THE EXPRESS WRITTEN CONSENT OF GIBRALTAR DESIGN. THE OWNER MAY RETAIN COPIES FOR INFORMATION AND REFERENCE IN CONNECTION ONLY WITH THIS PROJECT.

MARK DATE ISSUED FOR AD-4 06/10/21 ADDENDUM NO. 4

MECHANICAL SCHEDULES

HANOVER CSC NEW RESOURCE CENTER AND RELATED WORK

© GIBRALTAR DESIGN SHEET M-602

REFER TO SPECIF	FICATIONS FOR ADDITIONAL INSULATION REQUIREMEN	NTS
	INSULAT	ION TYPE
DUCTWORK TYPE	CONCEALED	EXPOSED
SUPPLY AIR DUCTWORK		
RECTANGULAR	11/2" LINER	11/2" LINER
ROUND	11/2" WRAP, NOTE 1.	PERFORATED DOUBLE WALL
RETURN AIR DUCTWORK		
RECTANGULAR	11/2" LINER, WITHIN 30'-0" OF UNIT	11/2" LINER, WITHIN 30'-0" OF UNIT
ROUND	PERFORATED DOUBLE WALL, WITHIN 30'-0' OF UNIT	PERFORATED DOUBLE WALL, WITHIN 30'-0' OF UNIT
VAV BOXES		
INLET COLLAR	1½" WRAP	1½" WRAP
HOT WATER REHEAT COIL	1½" WRAP	1½" WRAP
EXHAUST DUCTWORK		
WITHIN 10'-0" OF EXHAUST FAN	1/2" LINER	1/2" LINER

	EL	ECTRIC I	DUCT	HE	ATER S	SCHED	ULE			
TAG	MANUFACTURER	MODEL	INLET	MAX	ELEC REHEAT	COIL DATA	ELECT	RICAL D	ATA	
			SIZE	CFM	KW	No OF	VOLTS	PHASE	HZ	REMARKS
						STEPS				
EDH-1	THERMOLEC	sc-	1Ø×12	475	3.5	1	208	1	60	-
EDH-2	THERMOLEC	sc-	10×10	285	2.Ø	1	208	1	60	-

NATURAL GAS CONNECTION SCHEDULE - BUS GARAGE									
TAG	DESCRIPTION	LOCATION	CAPACITY CFH	REMARKS					
F-2	VERTICAL UPFLOW GAS FIRED FURNACE (96% AFUE)	MECH	100	-					
UH-6	INTERIOR SUPSENDED GAS FIRED UNIT HEATER	BUS WASH	25Ø	-					
uH-7	INTERIOR SUPSENDED GAS FIRED UNIT HEATER	BUS WASH	25Ø	-					
uH-8	INTERIOR SUPSENDED GAS FIRED UNIT HEATER	GARAGE	25Ø	-					
uH-9	INTERIOR SUPSENDED GAS FIRED UNIT HEATER	GARAGE	25Ø	-					
UH-10	INTERIOR SUPSENDED GAS FIRED UNIT HEATER	GARAGE	25Ø	-					
UH-11	INTERIOR SUPSENDED GAS FIRED UNIT HEATER	GARAGE	25Ø	-					
UH-12	INTERIOR SUPSENDED GAS FIRED UNIT HEATER	GARAGE	25Ø	-					
UH-13	INTERIOR SUPSENDED GAS FIRED UNIT HEATER	GARAGE	25Ø	-					
UH-14	INTERIOR SUPSENDED GAS FIRED UNIT HEATER	EQUIP	3Ø	-					
	PRESSURE WASHER	EQUIP	939	ESTIMATE					
		TOTAL	3129	CFH @ 8' w.c.					

NATU	NATURAL GAS CONNECTION SCHEDULE - BUS GARAGE ALT										
ŤA <b>G</b>	DESCRIPTION	LOCATION	CAPACITY CFH	REMARKS							
RT-2A	INTERIOR SUSPENDED HEATING/VENTILATING UNIT (ALTERNATE)	GARAGE	540	-							
RT-2B	INTERIOR SUSPENDED HEATING/VENTILATING UNIT (ALTERNATE)	GARAGE	540	-							
F-2	VERTICAL UPFLOW GAS FIRED FURNACE (96% AFUE)	MECH	100	-							
UH-6	INTERIOR SUPSENDED GAS FIRED UNIT HEATER	BUS WASH	25Ø	-							
uH-7	INTERIOR SUPSENDED GAS FIRED UNIT HEATER	BUS WASH	25Ø	-							
UH-14	INTERIOR SUPSENDED GAS FIRED UNIT HEATER	EQUIP	30	-							
	PRESSURE WASHER	EQUIP	939	ESTIMATE							
		TOTAL	27/09	CFH @ 8" w.c.							

NATUR	NATURAL GAS CONNECTION SCHEDULE - MECHANICS BUILDING										
TAG	DESCRIPTION	LOCATION	CAPACITY CFH	REMARKS							
F-1	VERTICAL UPFLOW GAS FIRED FURNACE (96% AFUE)	GRADE	60	-							
UH-1	INTERIOR SUPSENDED GAS FIRED UNIT HEATER	MAINTENANCE	175	-							
UH-2	INTERIOR SUPSENDED GAS FIRED UNIT HEATER	MAINTENANCE	175	-							
UH-1A	INTERIOR SUPSENDED GAS FIRED UNIT HEATER (ALTERNATE)	MAINTENANCE	175	-							
UH-2A	INTERIOR SUPSENDED GAS FIRED UNIT HEATER (ALTERNATE)	MAINTENANCE	175	-							
		TOTAL	760	CFH @ 8" w.c.							

NATUF	NATURAL GAS CONNECTION SCHEDULE - MAINTENANCE GARAGE											
TAG	DESCRIPTION	LOCATION	CAPACITY CFH	REMARKS								
uH-3	INTERIOR SUPSENDED GAS FIRED UNIT HEATER	STORAGE	120	-								
uH-4	INTERIOR SUPSENDED GAS FIRED UNIT HEATER	MAINTENANCE	120	-								
uH-5	INTERIOR SUPSENDED GAS FIRED UNIT HEATER	MAINTENANCE	120	-								
		TOTAL	360	CFH @ 8' w.c.								

NATURAL GAS CONNECTION SCHEDULE - RESOURCE CENTER							
TAG	DESCRIPTION	LOCATION	CAPACITY CFH	REMARKS			
RT-1	GRADE MOUNTED PACKAGED HYAC ROOFTOP - DX/GAS FIRED (SZYAY)	GRADE	540	-			
UH-15	VERTICAL UPFLOW GAS FIRED FURNACE (96% AFUE)	DISTRICT STORAGE	150	-			
~~~~	TANKLESS WATER HEATER	MECHANICAL	199				
	EMERGENCY GENERATOR	GRADE	38Ø	-			
		TOTAL	1269	CFH @ 2 PSI			



DESIGN ARCHITECTURE • ENGINEERING • INTERIOR DESIGN

HANOVER CSC NEW RESOURCE CENTER AND RELATED WORK

HANOVER COMMUNITY SCHOOL CORPORATION CEDAR LAKE, INDIANA

GIBRALTAR DESIGN 9102 N. Meridian St., Ste. 300 Indianapolis, IN 46260 Homepage www.GibraltarDesign.com Email info@GibraltarDesign.com Phone 317.580.5777 Fax 317.580.5778

PROJECT 20-141 05/17/21 COORDINATED BY

CHECKED BY

10302590 DRAWN BY
RH/GL/LvB

COPYRIGHT NOTICE: THE CONCEPTS, DESIGNS, PLANS, DETAILS, ETC, SHOWN ON THIS DOCUMENT ARE THE PROPERTY OF GIBRALTAR DESIGN AND WERE CREATED FOR USE ON THIS SPECIFIC PROJECT. NONE OF THIS INFORMATION SHALL BE USED BY ANY PERSON OR FIRM FOR ANY PURPOSE WITHOUT THE EXPRESS WRITTEN CONSENT OF GIBRALTAR DESIGN. THE OWNER MAY RETAIN COPIES FOR INFORMATION AND REFERENCE IN CONNECTION ONLY WITH THIS PROJECT.

MARK DATE ISSUED FOR AD-4 06/10/21 ADDENDUM NO. 4

MECHANICAL SCHEDULES

PROJECT
HANOVER CSC NEW RESOURCE
CENTER AND RELATED WORK

© GIBRALTAR DESIGN SHEET

M-603

TAC		ر المراجعة ا المراجعة المراجعة ال	المرابا المحال المرابع المرابع	ACCES+ 151 5		خصماند م من بلان جماراجراج	ACCES+ 151 -					-AI		
TAG NO.	FIXTURE/EQUIPMENT  TYPE	FIXTURE/EQUIPMENT  DESCRIPTION	FIXTURE/EQUIPMENT  MANUFACTURER AND MODEL NO.	ACCEPTABLE MANUF.	FIXTURE VALVE/FAUCET  TYPE	FIXTURE VALVE/FAUCET  TYPE	ACCEPTABLE MANUF.	ACCESSORIES/REMARKS  (SEE SPECIFICATIONS FOR ADDITIONAL INFORMATION)	HP KU			MOCP V	OLT F	°H
WC-1		VITREOUS CHINA, WALL MOUNTED	AMERICAN STANDARD #2257.103	NOTE #1	MANUAL FLUSH VALVE	SLOAN "REGAL PRO" #16-1.6	NOTE #10	BEMIS *2155-C SEAT		,	-	-		
WC-2	WATER CLOSET	VITREOUS CHINA, WALL MOUNTED, ADA	AMERICAN STANDARD #2257.103	NOTE #1	MANUAL FLUSH VALVE	SLOAN "REGAL PRO" #111-1.6	NOTE #10	BEMIS *2155-C SEAT	1 - 1 -	,	-	-		
UR-1	URINAL	VITREOUS CHINA, WALL MOUNTED, ADA	AMERICAN STANDARD *6501.010	NOTE #1	MANUAL FLUSH VALVE	SLOAN "REGAL PRO" *186-1.0	NOTE #10	-		,	-	-		
L-1	LAVATORY	VITREOUS CHINA, WALL MOUNTED, 20"XIS", ADA	AMERICAN STANDARD #0355.012	NOTE #1	ELECTRONIC BATTERY SENSOR, 4" CENTERS	SLOAN *EBF-187	NOTE #11	MCGUIRE *PW-2150-WC 1-1/2" PROWRAP, MCQUIRE *H2167CCLK SUPPLIES		,	-	-		
WC-1	ELECTRIC WATER COOLER	ELECTRIC WALL MOUNTED W/ BOTTLE FILLER	ELKAY *LZS8WSLP	NOTE #2	-	-	-	-			-	- 12	20 1	1
WC-2	ELECTRIC WATER COOLER	ELECTRIC WALL MOUNTED , DUAL LEVEL W/ BOTTLE FILLER	ELKAY *LZSTL&WSLP	NOTE #2	-	-	-	-		- 4.8	3 -	- 1	115 1	1
SH-1	SHOWER	-		-	1-HANDLE PRESSURE/TEMP. BALANCED	POWERS *E110-M-2-6-B-W	NOTE #11	HANDHELD SHOWER HEAD, HOSE, WALL BRACKET, VACUUM BREAKER AND 24" SLIDEBAR			-	-		,
S-1	SINK	TWO COMPARTMENT SINK	ELKAY *LRADQ-3319	NOTE #3	2 HANDLE, HIGH GOOSENECK	CHICAGO FAUCET CO. #785	NOTE #11	ELKAY *35 STRAINER, ELKAY *LK-53 DRAIN ASSEMBLY, MCGUIRE *H2167CCLK SUPPLIES		-	-	-	-	-
S-2	SINK	SINGLE COMPARTMENT 48'x20'x5-1/2"	ELKAY *WEMA48204	NOTE #3	WALL MOUNTED SERVICE FAUCET	CHICAGO FAUCET CO. #897	NOTE #11	STRAINER, DRAIN ASSEMBLY, MCGUIRE #H216TCCLK SUPPLIES		-	-	-	-	
MB-1	MOP BASIN	MOLDED STONE, 30'x30'x6"H	FIAT #9B-3Ø3Ø	NOTE #4	WALL MOUNTED SERVICE FAUCET	CHICAGO FAUCET CO. *897	NOTE #11	W/ 3/4" HOSE THREAD, VACUUM BREAKER, WALL BRACE			-	-	-	
FD-1	FLOOR DRAIN	CAST IRON BODY, ADJUSTABLE 6'x6' NICKEL BRONZE TOP	WADE #100-G6	NOTE #5	-	-	-	VANDALPROOF SCREWS, PLUGGED TRAP PRIMER		-	-	-	-	
FS-1	FLOOR SINK	CAST IRON, 8-1/8" DEEP, ACID RESISTING, 12"x12" TOP	WADE #9140	NOTE #5	-	-		ALUMINUM DOME STRAINER, SECURED HINGED GRATE, SLOPED RIM		-	-	-	-	
SC-1	SILLCOCK	NON-FREEZE, VACUUM BREAKER, REMOVABLE KEY	WADE *8600	NOTE *6	-	-	-	-			-	-		-
TW-1	TEMPERED WATER VALVE	TEMPERED WATER VALVE	BRADLEY *559-4000A TMV	NOTE #7	-	-	-	-		-	-	-		
DB-1	DOMESTIC BOOSTER PUMP	15 GPM @ 65 PSI DISCHARGE W/ SUCTION @ 30 PSI	METROPOLITAN #MS-MTIII-2D-PHI-35B	-	-	-		W/ 106 GAL. TANK, 3" SUCTION/ 3" DISCHARGE, (50-GPM ® 80-FT. TDH EA. PUMP)	(2) 2 -	.   -	-	- 4	80 3	3
ΓWH-1	TANKLESS WATER HEATER	199 MBH, 4.1 GPM @ 90 DEGREE RISE (GAS FIRED)	NORITZ *NCC1991-DY	-	-	-	-	ISOLATION KIT, TEMP. RELIEF VALVE, DRAIN VALVE AND CONDENSATE PIPED TO FLOOR DRAI	1	-	-	- 1	20 1	1
WH-1	WATER HEATER	15 KW, 77 GPH, 50 GAL. STORAGE	STATE *CSB 52 15 SFE	NOTE *8	-	-	-	-	- 15	-	-	- 29	<i>0</i> 8 1	1
WH-2	WATER HEATER	6 KW, 24 GPH, 30 GAL. STORAGE	STATE *PCE 3Ø 20LSA	NOTE *8	-	-	-	-	- 6	, –	-	- 2	<i>Ø</i> 8 1	1
IWH-1	WATER HEATER	56° RISE @ 0.5 GPM FLOW RATE, UNIT TO OPERATE AT 30 PSI MIN.	EEMAX *SPEX42Ø8T	-	-	-	-	-	- 4.	.1 -	-	- 2	<i>0</i> 8 1	1
WH-2	WATER HEATER	56° RISE @ 0.5 GPM FLOW RATE, UNIT TO OPERATE AT 30 PSI MIN.	EEMAX *SPEX42Ø8T	-	-	-	-	-	- 4.	.1 -	-	- 2	<i>0</i> 8 1	1
WH-3		59° RISE @ 1 GPM FLOW RATE, UNIT TO OPERATE AT 30 PSI MIN.	EEMAX *SPEXØ1224ØT	-	]-	-	-		- 8.	1 -	-	- 26	Ø8 1	1
WH-4	WATER HEATER	59° RISE @ 1 GPM FLOW RATE, UNIT TO OPERATE AT 30 PSI MIN.	EEMAX *SPEXØ1224ØT	-	-	-	-	-	- 8.	1 -	-		08 1	
OS-1		314 GPM, 560 GAL. STORAGE	STRIEM OT-500		-	-		-		_	-	-	-	
OS-2	OIL SEPARATOR	314 GPM, 560 GAL. STORAGE	STRIEM OT-500	-	-	-	-	-		-	-	-	-	
os-3	OIL SEPARATOR	100 GPM, 250 GAL. STORAGE	STRIEM 05-100	-	-	-	-	-		-	-	-	-	
MEW-1	EMERGENCY EYEWASH	BOWL AND DUST COVER, ADA	BRADLEY *619224	-	-	-	-	PROVIDED W/ NAVIGATOR 619-2000 EFX8 EMERGENCY THERMOSTATIC MIXING VALVE			-	-	-	
SD-1		INSTALLED IN 'TD-1' TRENCH DRAIN	ZURN *Z881-6-HD							-		-		
TD-1	TRENCH DRAIN	PRESLOPED HIGH DENSITY POLYPROPYLENE	ZURN *Z-886-LC	-	-	-	-	STAINLESS STEEL LOCKDOWN, WITH HEAVY DUTY GRATE			-	-		-
RCP-1	RECIRCULATING PUMP	2.5 GPM @ 14' HEAD, ALL BRONZE CONSTRUCTION	B4G * PL-36	NOTE #9	-	-	-	W/ STRAP ON AQUASTAT	1/6 -	.   -	-	- 12	20 1	1
~~~										~~~				

NOTE \*1: GERBER, CRANE, KOHLER, ZURN NOTE \* 2: OASIS, HAWS, SUNROC NOTE #3: JUST NOTE \*4: MUSTEE, SWAN NOTE #5: ZURN, JOSAM, J.R. SMITH, MIFAB

NOTE \*6: JOSAM, ZURN, J.R. SMITH, WOODFORD

NOTE \*7: LEONARD, POWERS, LAWLER

NOTE \*8: LOCHINYAR, A.O. SMITH NOTE \*9: METROPOLITAN, TACO NOTE #10: ZURN, TOTO

NOTE \*11: ZURN, DELTA, T&S BRASS, CHICAGO FAUCET CO.

## GENERAL NOTES

- A. WORK SHALL COMPLY WITH LOCAL, MUNICIPAL, AND STATE PLUMBING CODES.
- B. THE SCOPE OF WORK SPECIFIED HEREIN AND IN THE SPECIFICATIONS SHALL BE COORDINATED WITH THE CONSTRUCTION MANAGER - REFER TO THE SCOPE OF WORK FOR EACH TRADE. ANY DISCREPANCIES BETWEEN THE CONSTRUCTION DOCUMENTS AND CONSTRUCTION MANAGERS SCOPE SHALL BE BROUGHT TO THE ATTENTION OF THE ARCHITECT/ENGINEER FOR CLARIFICATION. THE ARCHITECT/ENGINEER'S DECISION SHALL BE FINAL.
- C. LAYOUT IS DIAGRAMMATIC. INSTALL PIPING AND EQUIPMENT TO MEET ACTUAL FIELD CONDITIONS. REVIEW PROJECT SPECIFICATIONS BEFORE STARTING ANY WORK, SUBMIT SHOP DRAWINGS OF WORK AS PER SPECIFICATIONS.
- D. LAYOUT WORK TO AVOID CONFLICTS BETWEEN DUCTWORK, LIGHTING, CEILINGS, PIPING AND BUILDING STRUCTURE.
- E. VERIFY LOCATION AND ELEVATION OF PLUMBING EQUIPMENT, FIXTURES, PIPING, PANELS, ETC. EXPOSED WITHIN OCCUPIED SPACES BEFORE THE START OF ANY ROUGH-IN OR INSTALLATION.
- F. COORDINATE EQUIPMENT ELECTRICAL REQUIREMENTS (VOLTAGES, PHASE, LOAD, ETC.) BEFORE ORDERING ANY EQUIPMENT.
- G. COORDINATE VENT THROUGH ROOF LOCATIONS WITH OUTDOOR AIR INTAKE LOCATIONS TO MAINTAIN A MINIMUM SEPARATION OF TEN FEET.
- H. PROVIDE AND INSTALL PLENUM WRAP, TESTED TO UL 84 AND UL 910, ON ALL EXISTING PVC PIPING IN NEW OR EXISTING RETURN AIR CEILING PLENUMS.
- PROVIDE ROUGH-IN AND FINAL CONNECTIONS TO PLUMBING EQUIPMENT AND FIXTURES. SET FIXTURES/EQUIPMENT AND FURNISH AND INSTALL NECESSARY FITTINGS, TRAPS, STOPS, ETC. AS REQUIRED.
- J. ISOLATION VALVES SHALL BE INSTALLED OVER ACCESSIBLE CEILINGS. WHEN ISOLATION VALVES ARE INSTALLED OVER INACCESSIBLE CEILING AREAS, IT SHALL BE THE RESPONSIBILITY OF THIS CONTRACTOR TO FURNISH AND INSTALL 12" X 12" (MINIMUM) CEILING ACCESS DOORS, TYPE TO BE YANDALPROOF, TAMPERPROOF ASSEMBLIES. INSTALLATION TO BE COORDINATED WITH GENERAL
- K. INVERT ELEVATIONS SHALL BE FIELD COORDINATED WITH FINAL GRADING PLANS TO ENSURE PROPER
- L. REFER TO ARCHITECTURAL INTERIOR ELEVATIONS FOR FINAL MOUNTING HEIGHTS OF PLUMBING FIXTURES.
- M. PROTECT DRAIN OPENINGS AND SANITARY LINES DURING CONSTRUCTION TO PREVENT BLOCKAGE

CONTRACTOR.

N. REPAIR AND/OR REPLACE DAMAGED PIPE INSULATION THAT OCCURS AS THE RESULT OF THIS CONSTRUCTION.

## SYMBOLS AND ABBREVIATIONS

	UNDERGROUND SANITARY SEWER
	COLD WATER PIPING
	HOT WATER PIPING
	HOT WATER RECIRCULATION PIPING
	VENT PIPING
	OVERHEAD SANITARY PIPING
ow	OIL WASTE SANITARY
<b>C</b> —	PIPE DOWN
O—	PIPE UP

SHUT-OFF YALYE CHECK YALYE HOSE BIBB/SILL COCK RELIEF YALYE SHOWER HEAD BALANCING COCK/MANUAL FLOW CONTROL YALVE

THERMOMETER PRESSURE GAUGE SHEET NOTE TAG

ELECTRIC WATER COOLER FLOOR CLEANOUT FLOOR DRAIN FIN. FL. FINISHED FLOOR FIN, GR. FINISHED GRADE FLOOR SINK HOSE BIBB HOT WATER HOT WATER RECIRCULATION ICEMAKER VALVE BOX INSTANTANEOUS WATER HEATER

DOMESTIC BOOSTER PUMP

EMERGENCY SHOWER AND EYEWASH

CLEANOUT

COLD WATER

INY. EL. INVERT ELEVATION LAVATORY MOP BASIN HOT WATER RECIRCULATION PUMP SILL COCK SHOWER TRENCH DRAIN TEMPERED WATER TANKLESS WATER HEATER VENT THROUGH ROOF WATER CLOSET WC

WATER HEATER

YCO YARD CLEANOUT

GIBRALTAR DESIGN

ARCHITECTURE ◆ ENGINEERING ◆ INTERIOR DESIGN

HANOVER CSC NEW RESOURCE CENTER AND RELATED WORK

HANOVER COMMUNITY SCHOOL CORPORATION CEDAR LAKE, INDIANA

GIBRALTAR DESIGN 9102 N. Meridian St., Ste. 300 Indianapolis, IN 46260 Homepage www.GibraltarDesign.com Email info@GibraltarDesign.com Phone 317.580.5777 Fax 317.580.5778

PROJECT 20-141 05/17/21 COORDINATED E 10302590 ••• DRAWN BY RH/GL/LvB CHECKED BY

COPYRIGHT NOTICE: THE CONCEPTS, DESIGNS, PLANS, DETAILS, ETC, SHOWN ON THIS DOCUMENT ARE THE PROPERTY OF GIBRALTAR DESIGN AND WERE CREATED FOR USE ON THIS SPECIFIC PROJECT. NONE OF THIS INFORMATION SHALL BE USED BY ANY PERSON OR FIRM FOR ANY PURPOSE WITHOUT THE EXPRESS WRITTEN CONSENT OF GIBRALTAR DESIGN. THE OWNER MAY RETAIN COPIES FOR INFORMATION AND REFERENCE IN CONNECTION ONLY WITH THIS PROJECT.

REVIS	IONS	
MARK	DATE	ISSUED FOR
AD-1	05/28/21	ADDENDUM NO. 1
AD-2	06/04/21	ADDENDUM NO. 2
AD-4	06/10/21	ADDENDUM NO. 4

DRAWING PLUMBING NOTES, SYMBOLS, ABBREVIATIONS & SCHEDULES

HANOVER CSC NEW RESOURCE CENTER AND RELATED WORK

© GIBRALTAR DESIGN SHEET

## **SHEET NOTES**

- 1. 4" SANITARY UP TO WATER CLOSET
- 2. 2" SANITARY UP TO URINAL
- 3. 1/2" SANITARY UP TO LAVATORY
- 4. 2' SANITARY UP TO (2) LAVATORY
- 5. 2" SANITARY UP TO SINK
- 6. 4' SANITARY UP TO FLOOR DRAIN/SINK
- 7. 4' SANITARY UP TO MOP BASIN
- 8. 2" VENT UP
- 9. 4' SANITARY UP TO TRENCH DRAIN

  10. 11/2' SANITARY UP TO ELECTRIC WATER COOLER
- 11. 2" SANITARY UP TO EMERGENCY EYEWASH
- 12. 4' INCOMING WATER SERVICE UP




GIBRALTAR



MILLIES
ENGINEERING GROUP
(219) 924-8400
www.milliesengineeringgroup.com


HANOVER CSC NEW
RESOURCE CENTER AND
RELATED WORK

HANOVER COMMUNITY SCHOOL CORPORATION CEDAR LAKE, INDIANA

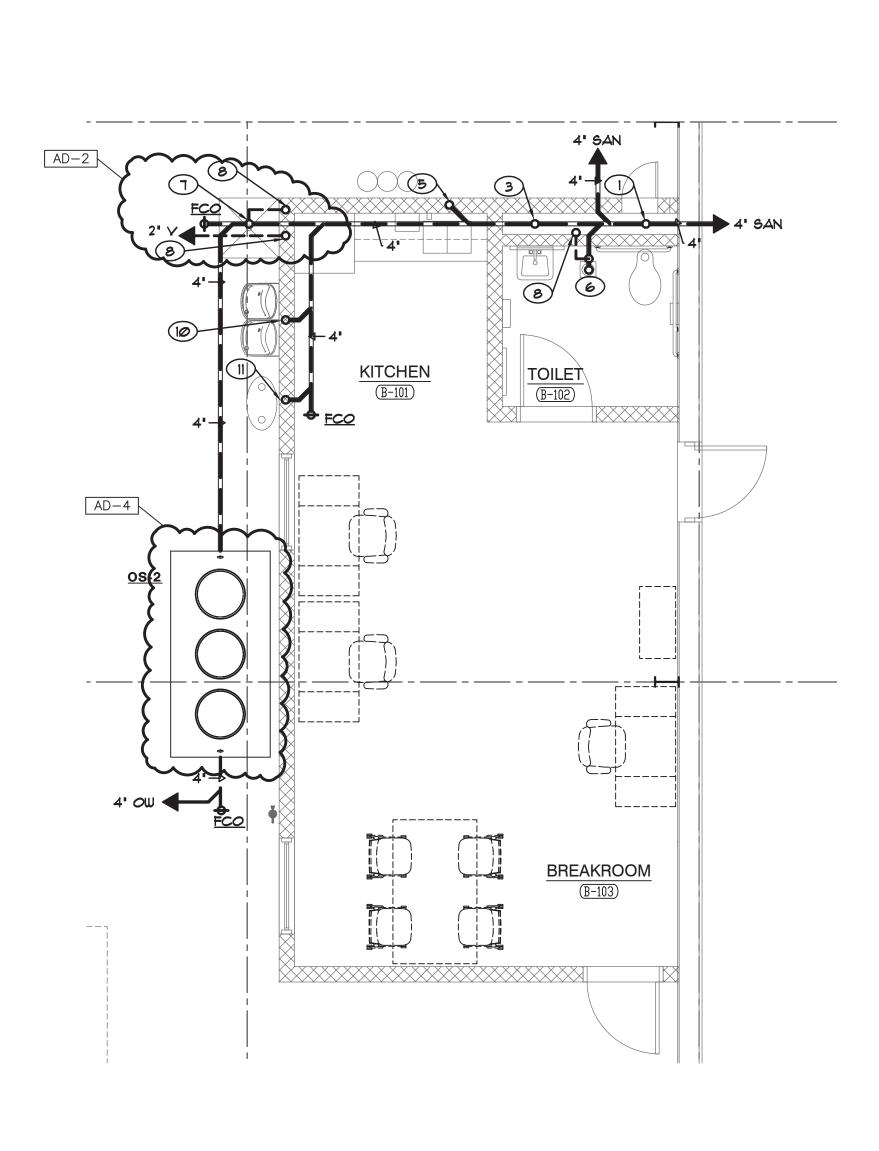

ENLARGED KITCHEN/TOILET
PLUMBING UNDERFLOOR PLAN
SCALE: 1/4" = 1'-0"



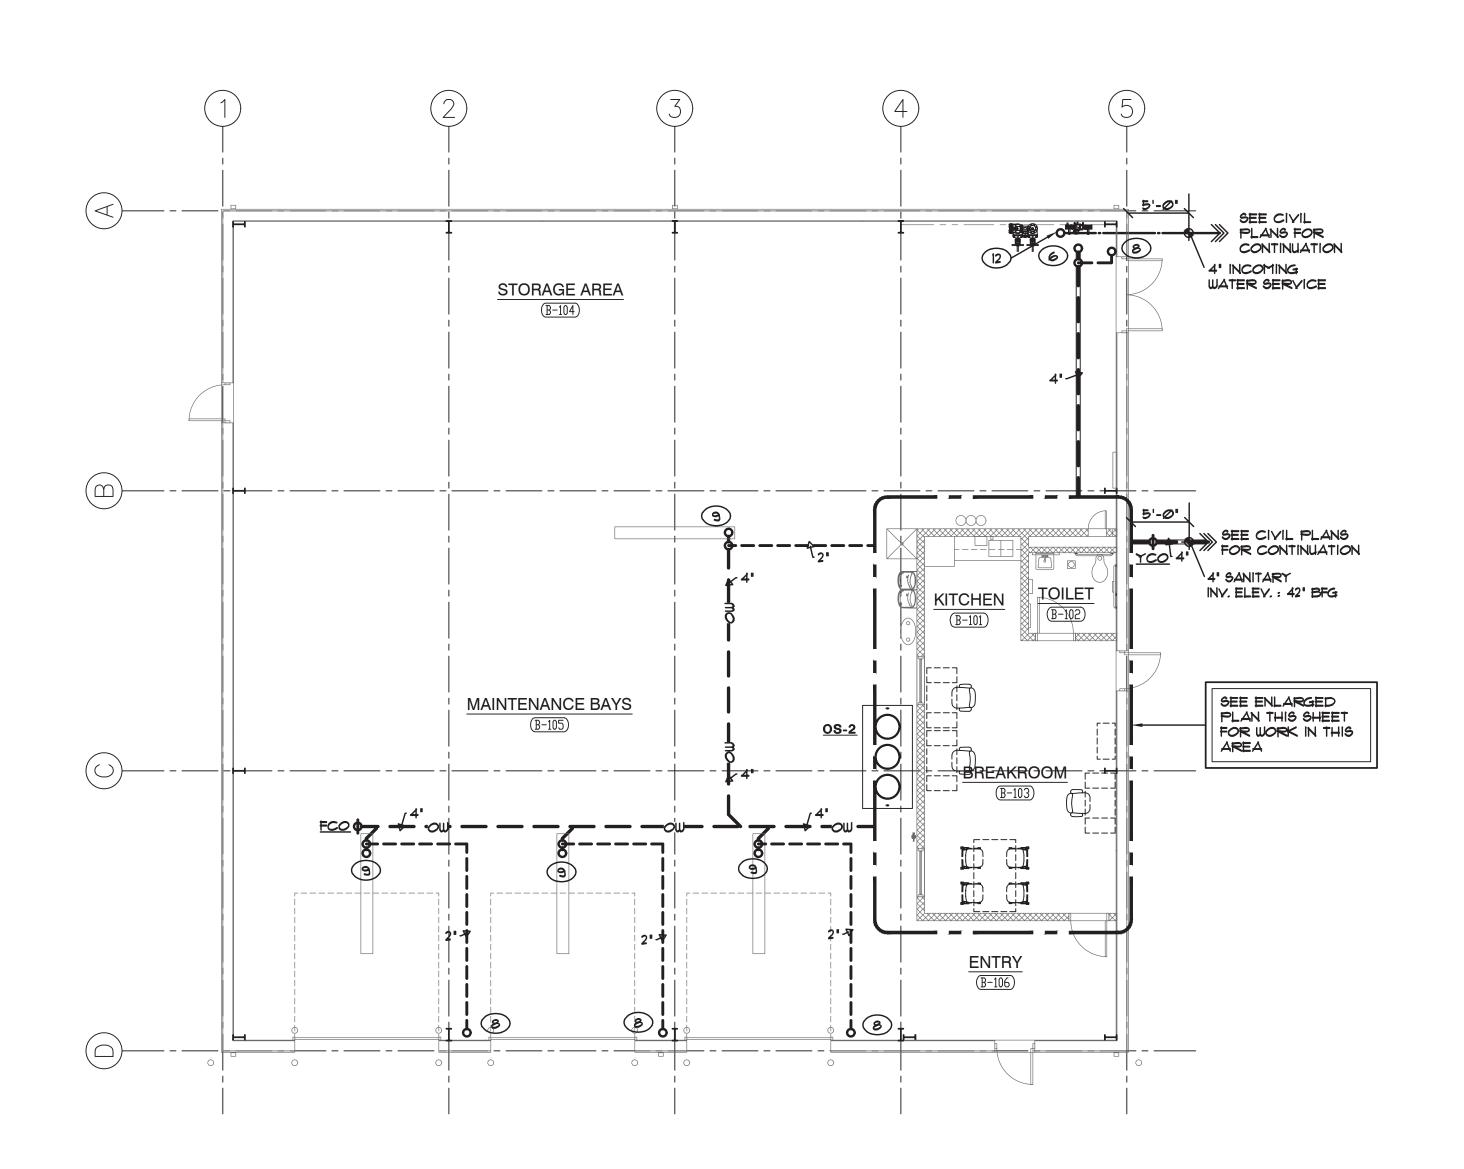

PLUMBING UNDERFLOOR PLAN
MAINTENANCE BUILDING
BUILDING B

SCALE: 1/8" = 1'-0"



G	IBRAI	LTAR D	DESIGN				
Indian Home Email	apolis, IN page www. info@Gibro	.GibraltarDes altarDesign.c	sign.com com 317.580.577				
DATE 05/ COORI JC DRAWN RH/	-141 '17/21 DINATED BY	10 A S	C. JANNA GISTERED NO. 0302590 TATE OF VOIANA ENGINE	Thinnan III			
THE CON THIS DOO WERE CF THIS INF FOR ANY OF GIBRA	CUMENT ARE TH REATED FOR USI ORMATION SHALI PURPOSE WITH ALTAR DESIGN. T FION AND REFER	IE PROPERTY OF TE ON THIS SPECIF L BE USED BY AN HOUT THE EXPRES THE OWNER MAY	S, ETC, SHOWN ON GIBRALTAR DESIGN FIC PROJECT. NONE NY PERSON OR FIR S WRITTEN CONSEN RETAIN COPIES FOR TION ONLY WITH TH	OF M IT			
REVIS	IONS						
MARK	DATE	ISSUED FO	)R				
AD-2	06/04/21	ADDENDUM	NO. 2				
AD-4	06/10/21	ADDENDUM	NO. 4				

DRAWING

PLUMBING UNDERFLOOR PLANS
MAINTENANCE BUILDING
BUILDING B

PROJECT
HANOVER CSC NEW RESOURCE
CENTER AND RELATED WORK

© GIBRALTAR DESIGN SHEET

## **SHEET NOTES**

- 1. 4' SANITARY UP TO WATER CLOSET
- 2. 2" SANITARY UP TO URINAL
- 3. 11/2" SANITARY UP TO LAVATORY 4. 2" SANITARY UP TO (2) LAYATORY
- 5. 2" SANITARY UP TO SINK
- 6. 4' SANITARY UP TO FLOOR DRAIN/SINK
- 7. 4' SANITARY UP TO MOP BASIN

8. 2" VENT UP


- 9. 4" SANITARY UP TO TRENCH DRAIN
- 10. 2" SANITARY UP TO EMERGENCY EYEWASH
- 11. 4" INCOMING WATER SERVICE UP



HANOVER CSC NEW RESOURCE CENTER AND RELATED WORK

ENGINEERING GROUP (219) 924-8400

HANOVER COMMUNITY SCHOOL CORPORATION CEDAR LAKE, INDIANA

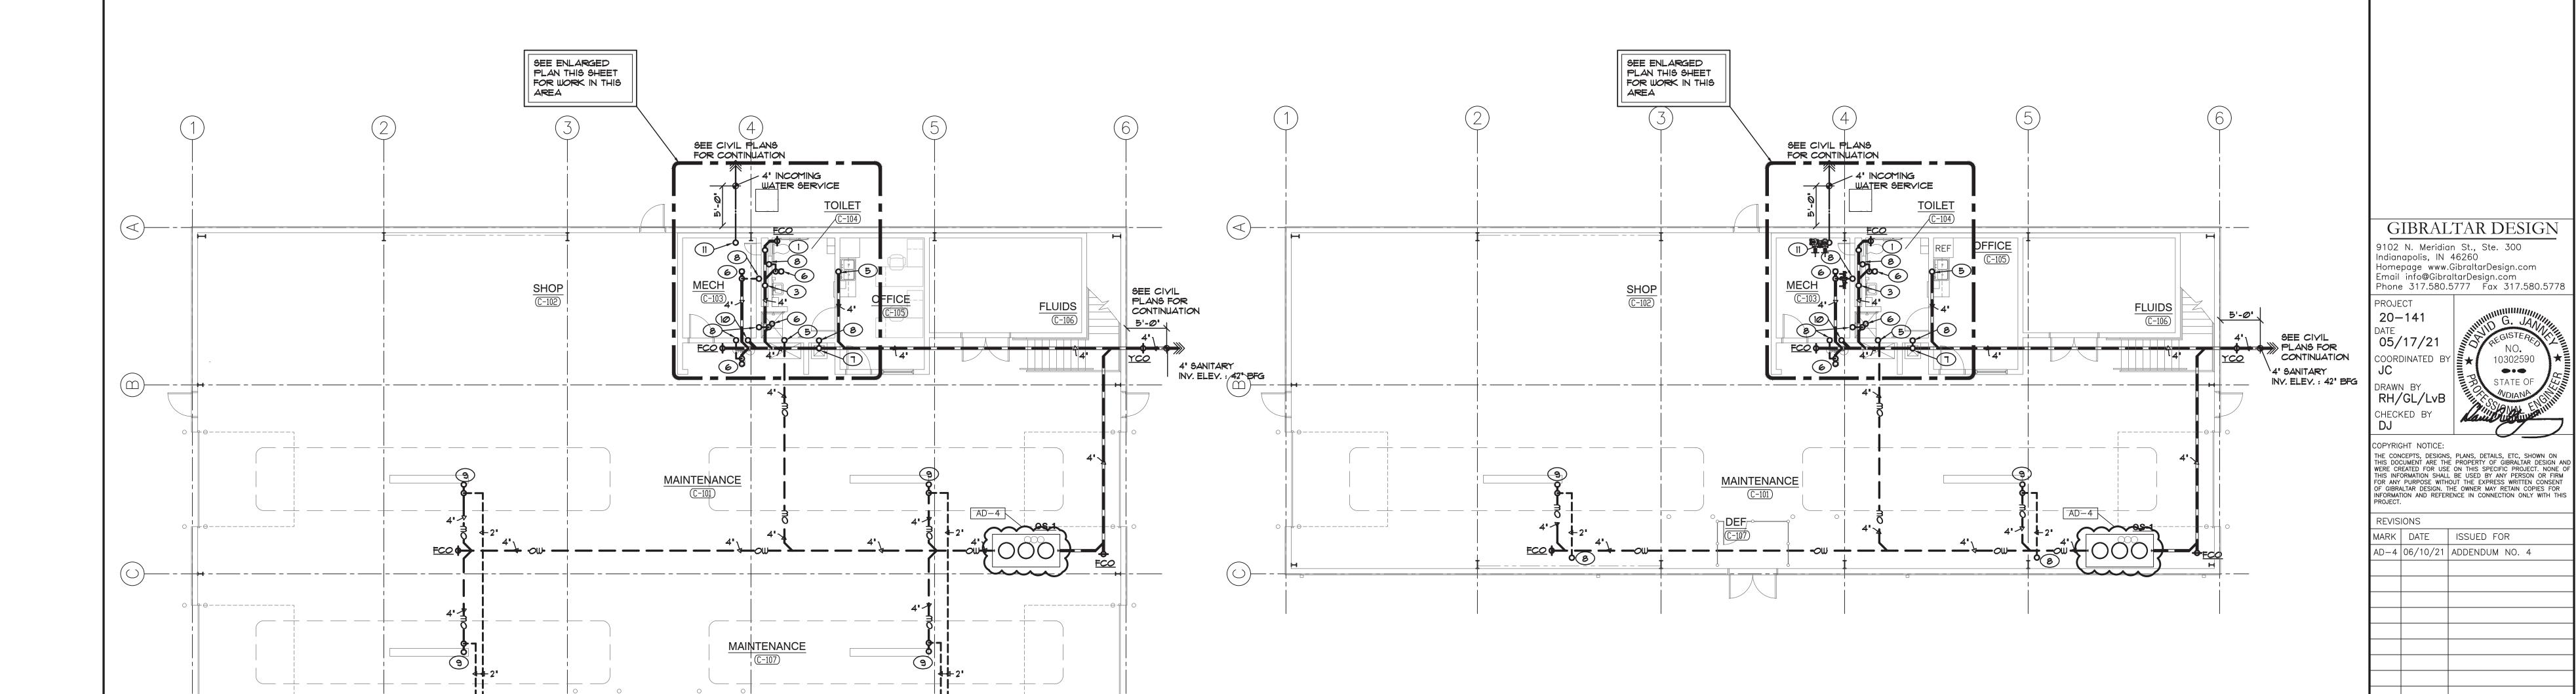

PLUMBING UNDERFLOOR PLAN MECHANICS BUILDING BUILDING C - ALTERNATE

SCALE: 1/8" = 1'-0"

PLUMBING UNDERFLOOR PLAN MECHANICS BUILDING BUILDING C - BASE BID

SCALE: 1/8" = 1'-0"


PLUMBING UNDERFLOOR PLANS MECHANICS BUILDING BUILDING C

HANOVER CSC NEW RESOURCE CENTER AND RELATED WORK

© GIBRALTAR DESIGN SHEET

P-103

10302590

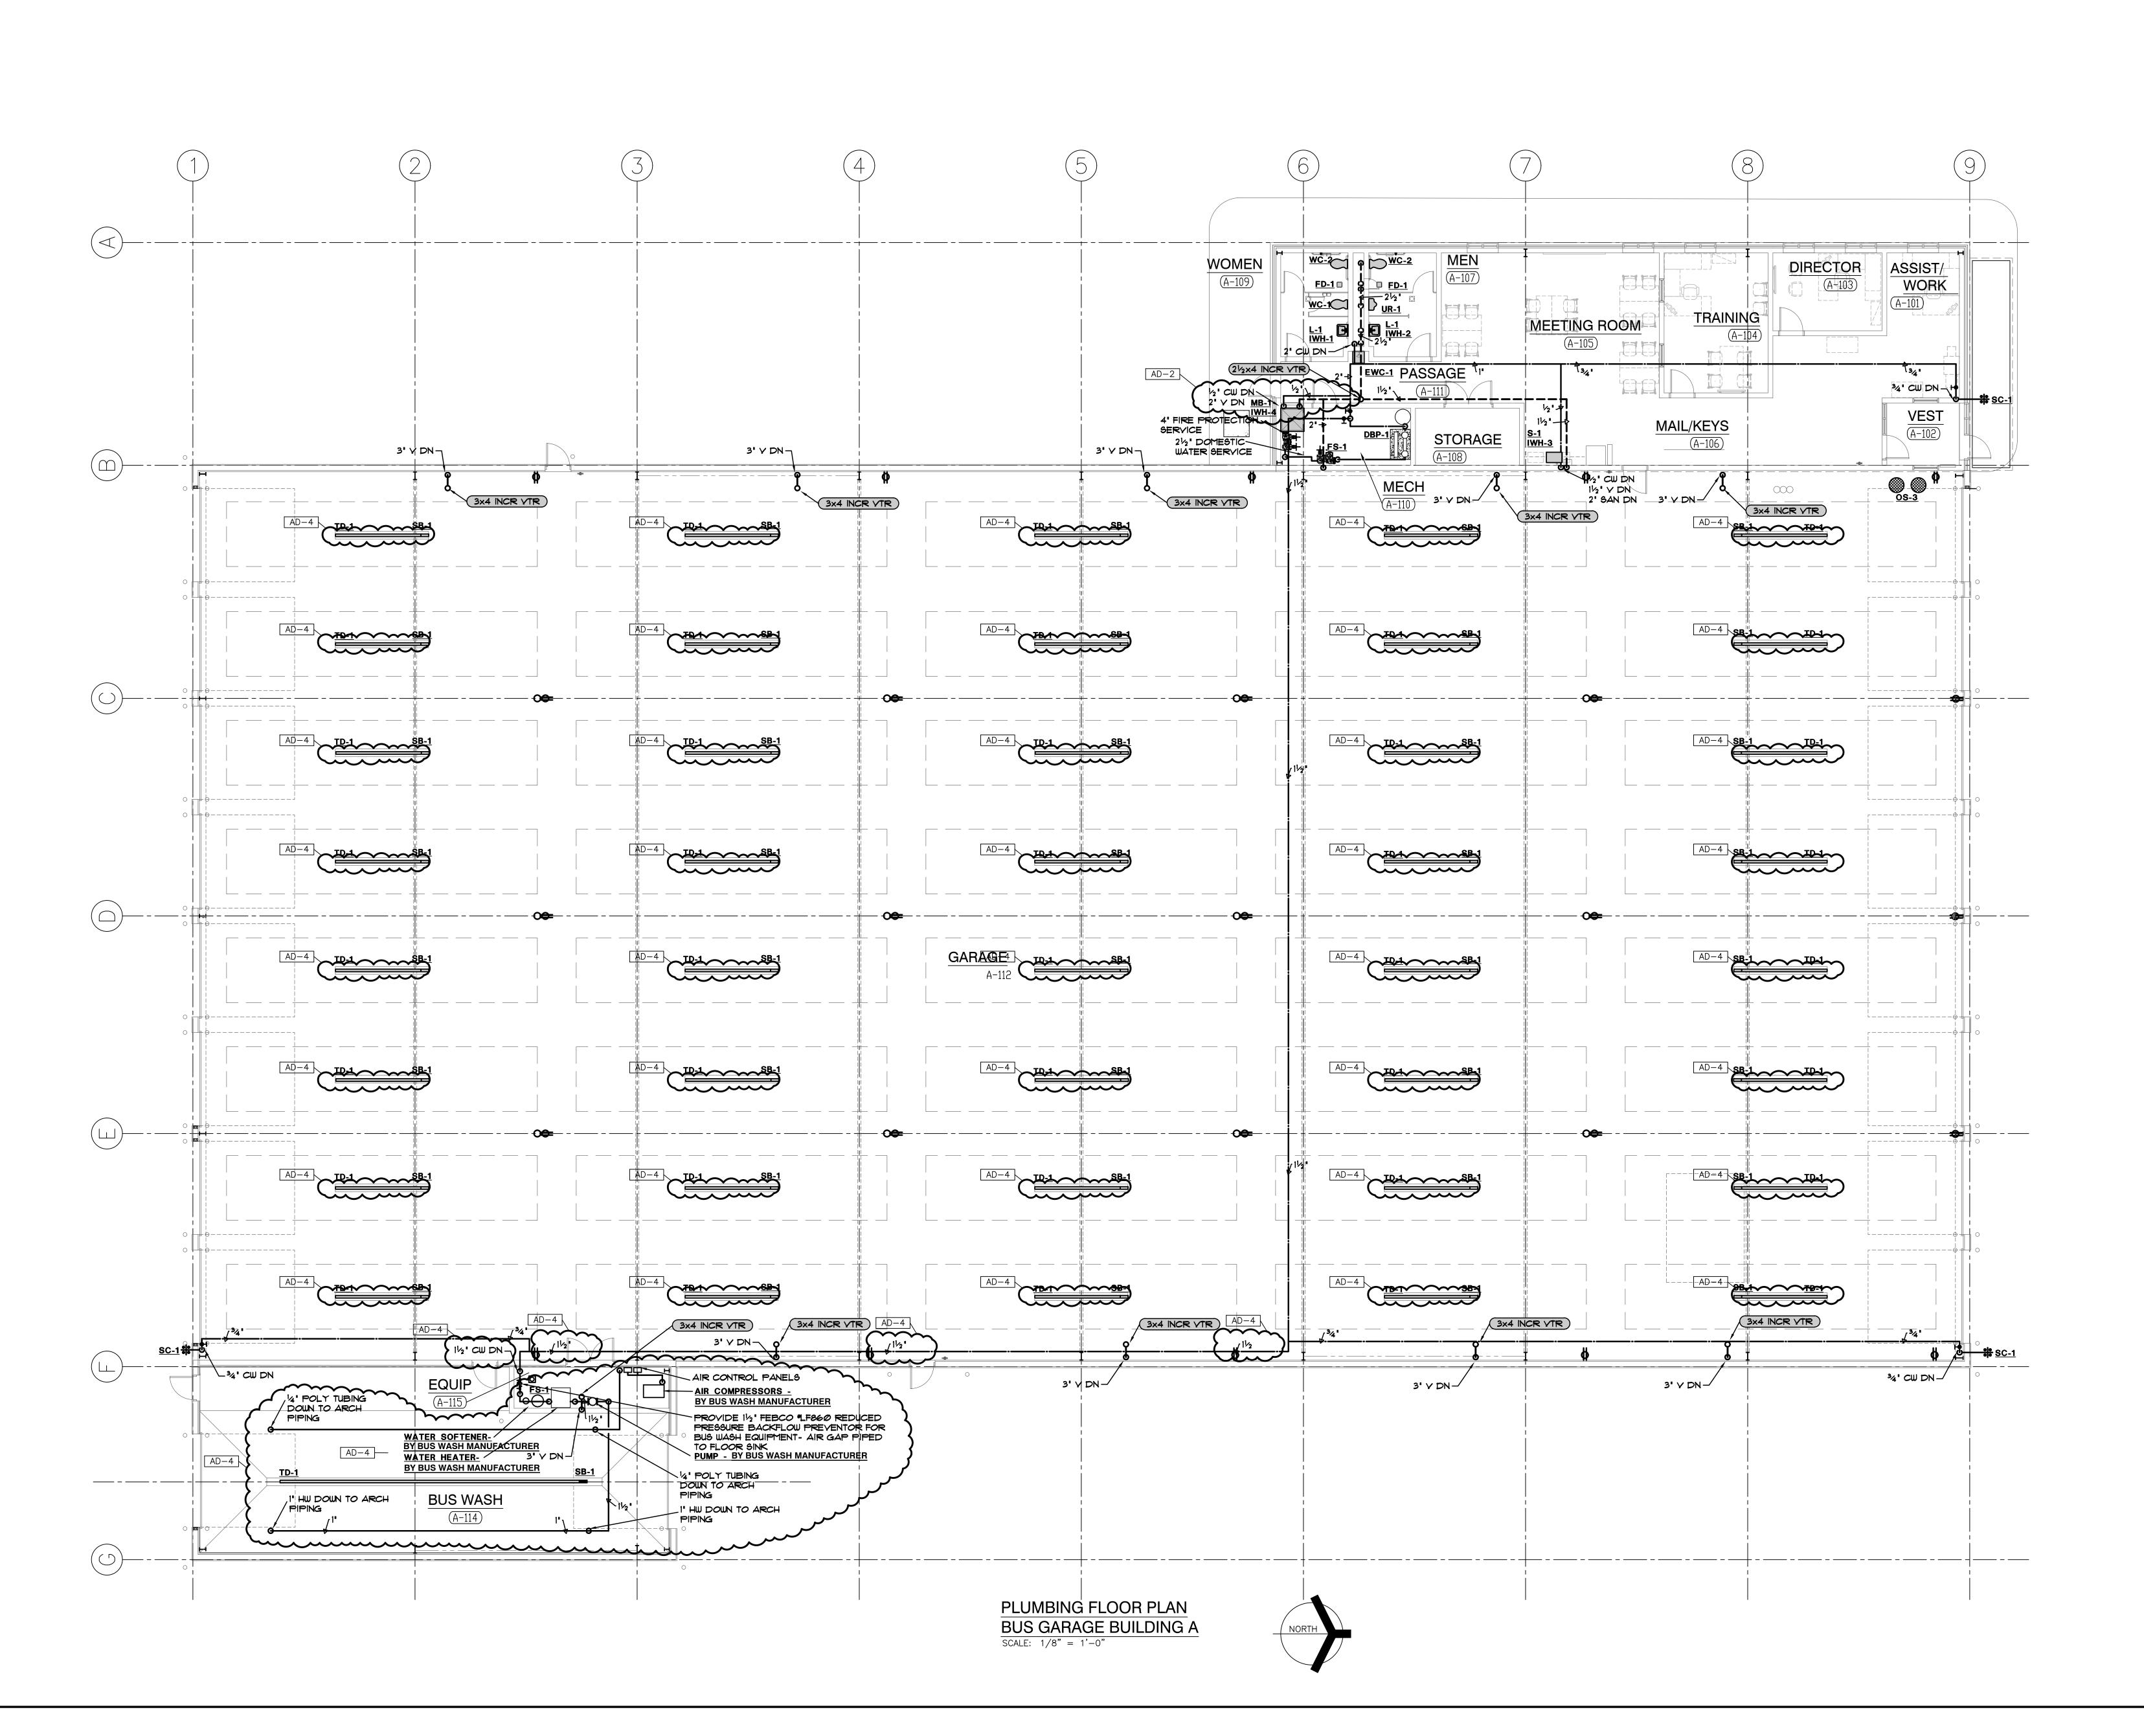



GIBRALTAR

DESIGN

ARCHITECTURE • ENGINEERING • INTERIOR DESIGN



HANOVER CSC NEW
RESOURCE CENTER AND
RELATED WORK

HANOVER COMMUNITY SCHOOL CORPORATION CEDAR LAKE, INDIANA

GIBRALTAR DESIGN
9102 N. Meridian St., Ste. 300
Indianapolis, IN 46260
Homepage www.GibraltarDesign.com
Email info@GibraltarDesign.com
Phone 317.580.5777 Fax 317.580.5778

Phone 317.580.5777

PROJECT
20-141

DATE
05/17/21

COORDINATED BY
JC
DRAWN BY
RH/GL/LvB
CHECKED BY
DJ

COPYRIGHT NOTICE:

COPYRIGHT NOTICE:

THE CONCEPTS, DESIGNS, PLANS, DETAILS, ETC, SHOWN ON THIS DOCUMENT ARE THE PROPERTY OF GIBRALTAR DESIGN WERE CREATED FOR USE ON THIS SPECIFIC PROJECT. NONE THIS INFORMATION SHALL BE USED BY ANY PERSON OR FIR FOR ANY PURPOSE WITHOUT THE EXPRESS WRITTEN CONSEN OF GIBRALTAR DESIGN. THE OWNER MAY RETAIN COPIES FOR INFORMATION AND REFERENCE IN CONNECTION ONLY WITH THE PROJECT.

REVISIONS

MARK DATE ISSUED FOR

AD-2 06/04/21 ADDENDUM NO. 2


AD-4 06/10/21 ADDENDUM NO. 4

RAWING


PLUMBING FLOOR PLAN BUS GARAGE BUILDING A

PROJECT
HANOVER CSC NEW RESOURCE
CENTER AND RELATED WORK

© GIBRALTAR DESIGN SHEET

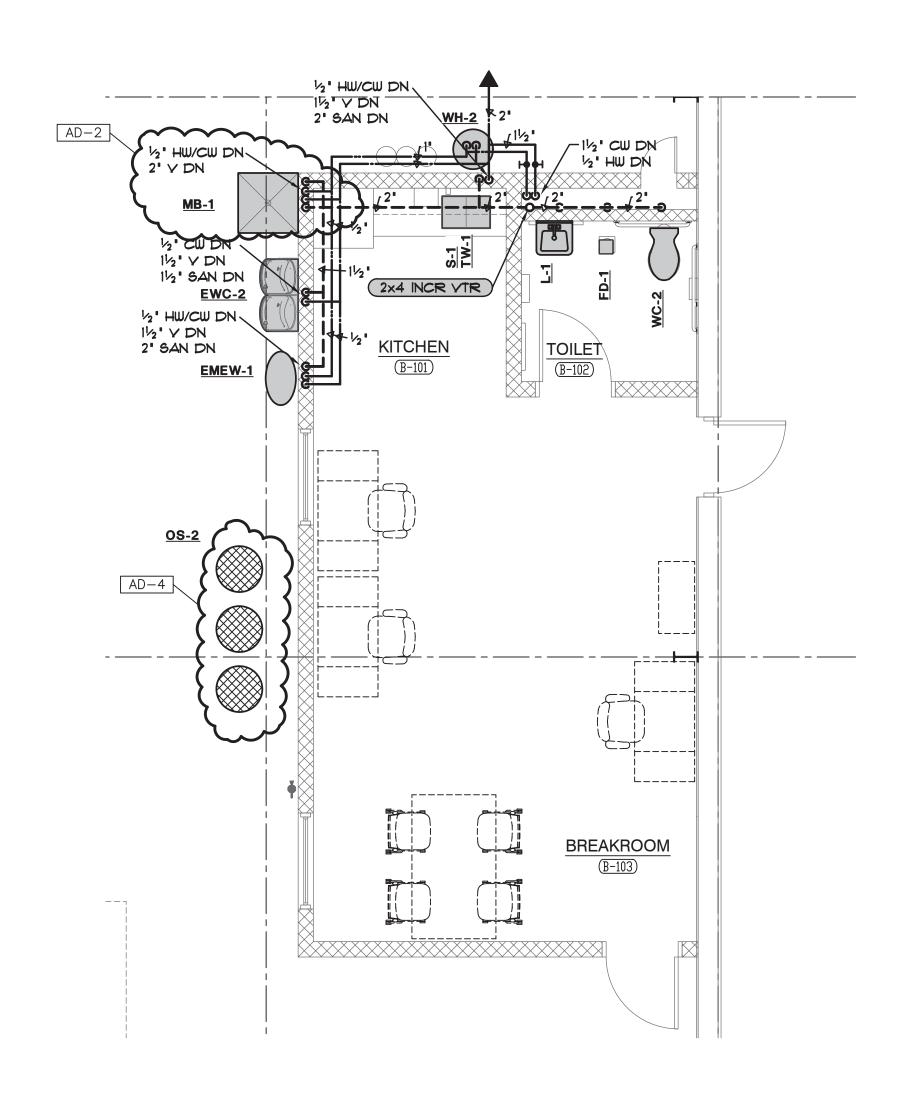



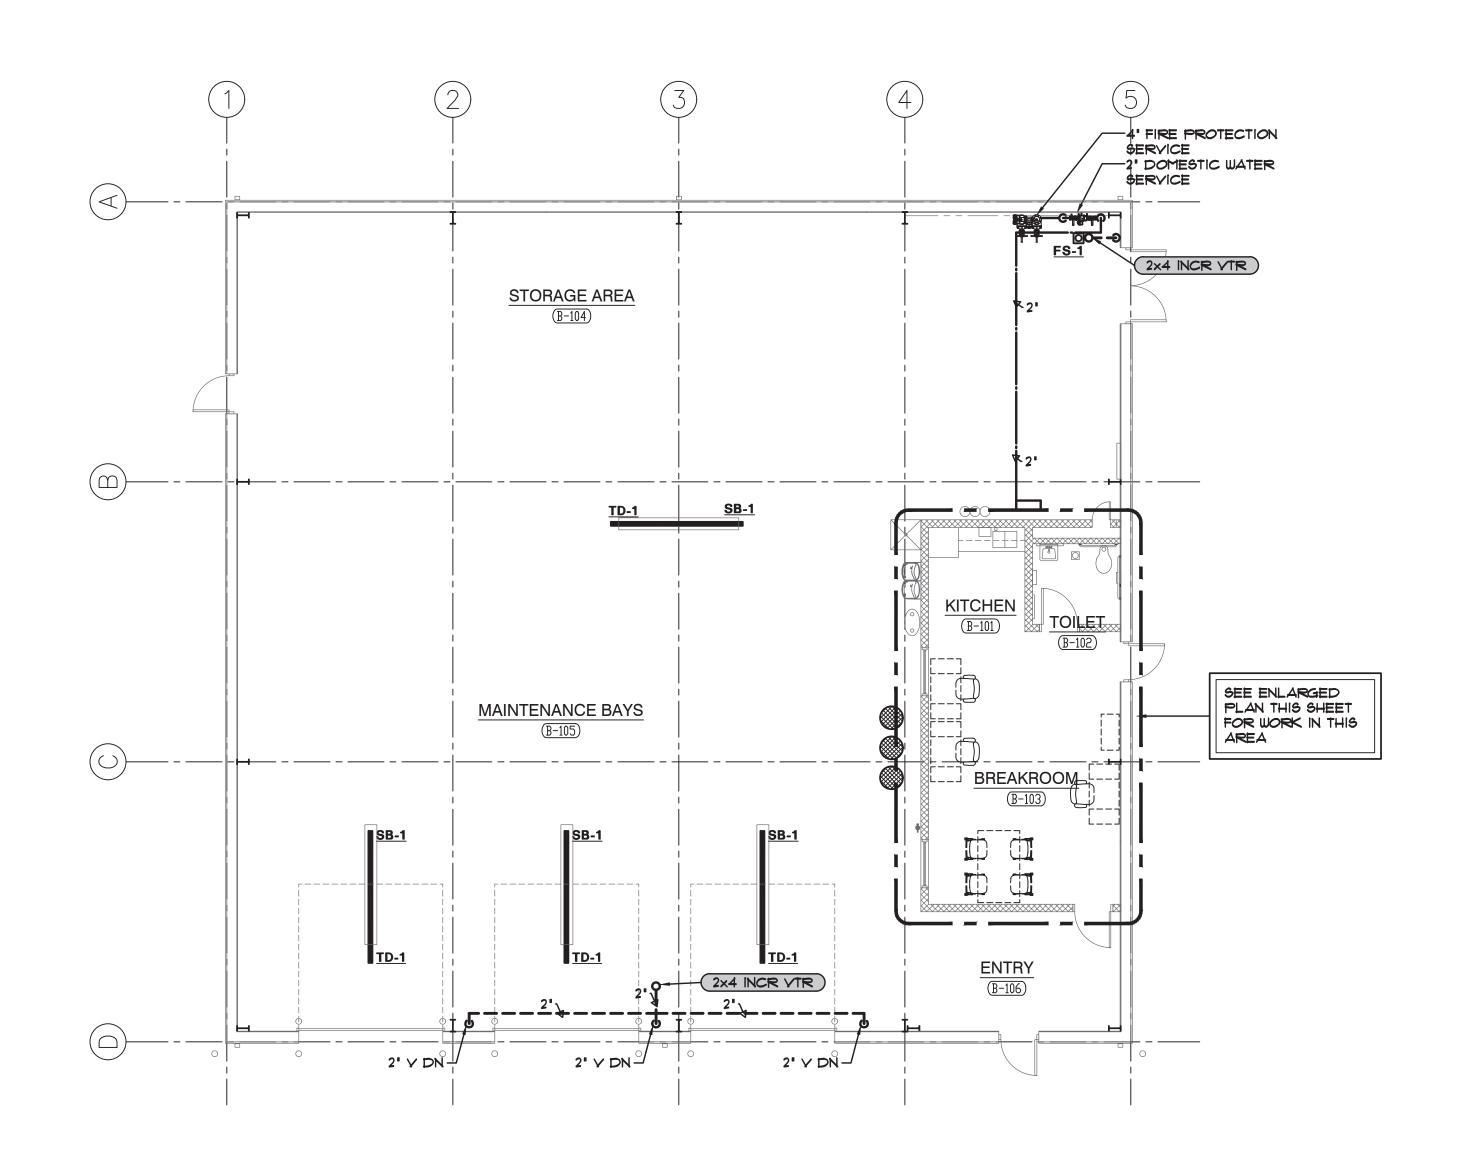

PLUMBING FLOOR PLAN MAINTENANCE BUILDING BUILDING B

SCALE: 1/8" = 1'-0"





GIBRALTAR

DESIGN



HANOVER CSC NEW RESOURCE CENTER AND RELATED WORK

HANOVER COMMUNITY SCHOOL CORPORATION CEDAR LAKE, INDIANA

GIBRALTAR DESIGN 9102 N. Meridian St., Ste. 300 Indianapolis, IN 46260 Homepage www.GibraltarDesign.com Email info@GibraltarDesign.com Phone 317.580.5777 Fax 317.580.5778

20-141 05/17/21 COORDINATED E DRAWN BY
RH/GL/LvB

COPYRIGHT NOTICE: THE CONCEPTS, DESIGNS, PLANS, DETAILS, ETC, SHOWN ON THIS DOCUMENT ARE THE PROPERTY OF GIBRALTAR DESIGN AND WERE CREATED FOR USE ON THIS SPECIFIC PROJECT. NONE OF THIS INFORMATION SHALL BE USED BY ANY PERSON OR FIRM FOR ANY PURPOSE WITHOUT THE EXPRESS WRITTEN CONSENT OF GIBRALTAR DESIGN. THE OWNER MAY RETAIN COPIES FOR INFORMATION AND REFERENCE IN CONNECTION ONLY WITH THIS PROJECT.

CHECKED BY


MARK DATE ISSUED FOR AD-2 06/04/21 ADDENDUM NO. 2 AD-4 06/10/21 ADDENDUM NO. 4

DRAWING

PLUMBING PLANS MAINTENANCE BUILDING BUILDING B

HANOVER CSC NEW RESOURCE CENTER AND RELATED WORK

© GIBRALTAR DESIGN SHEET

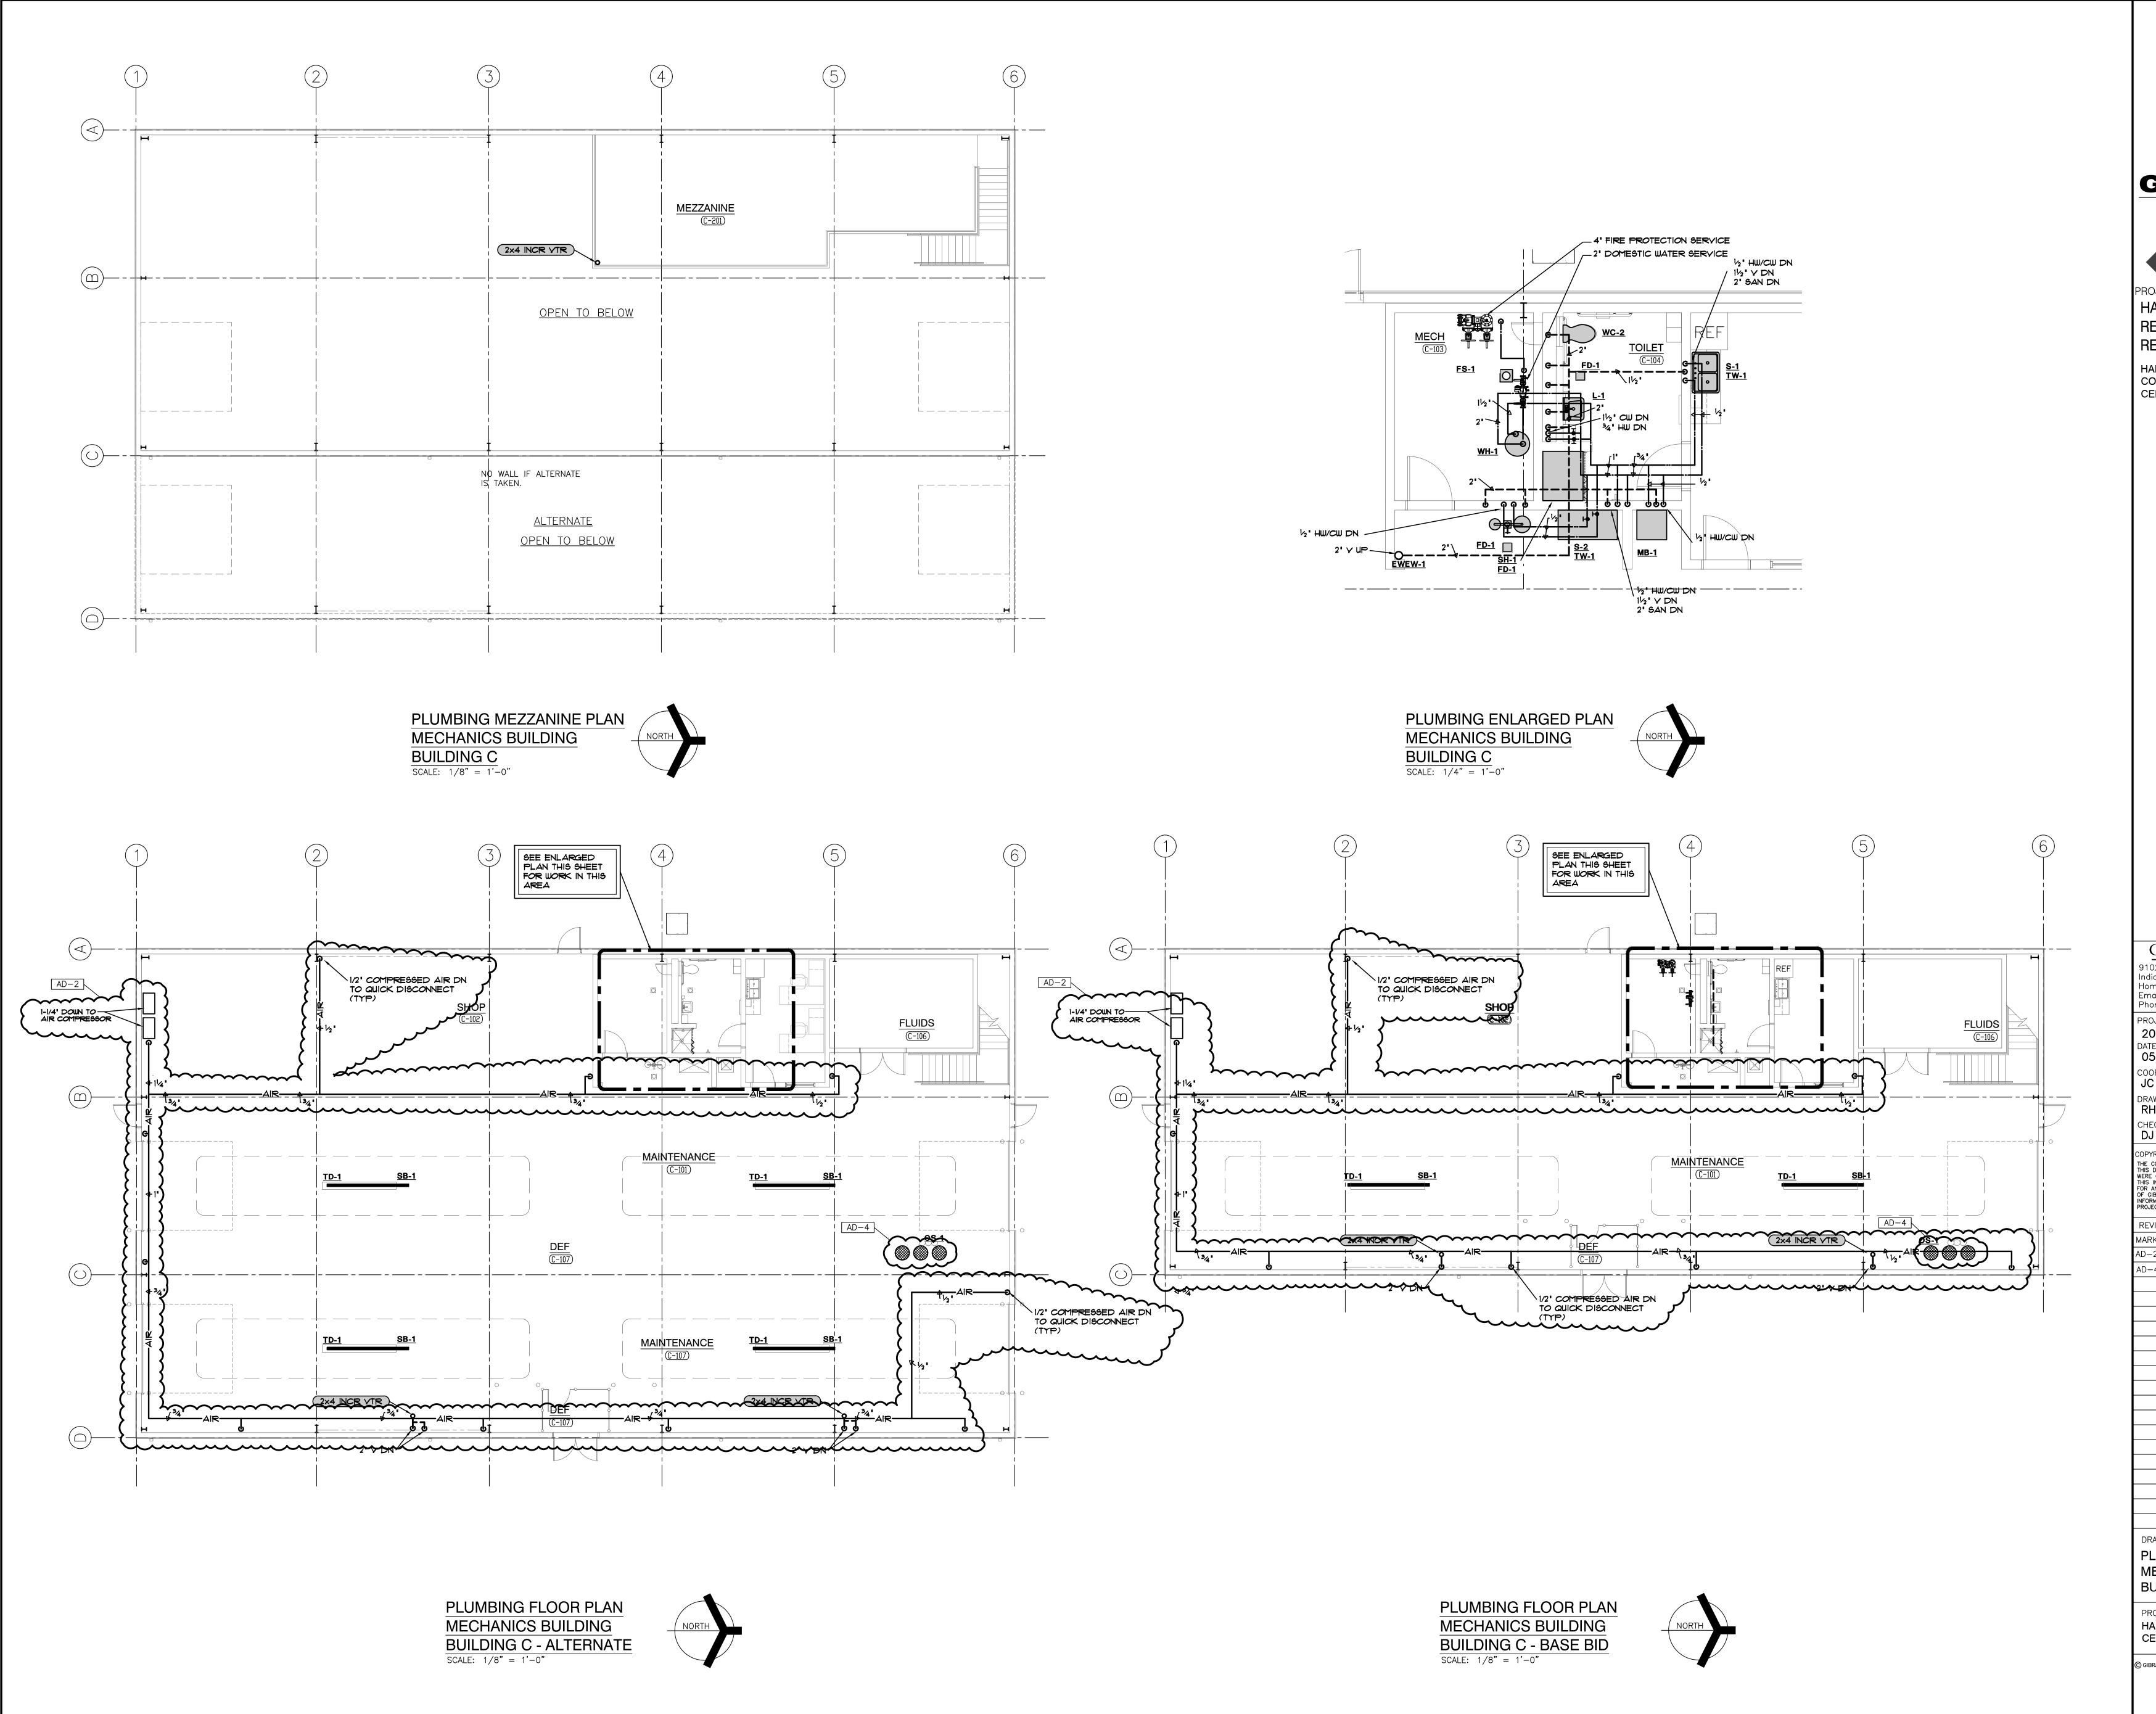

GIBRALTAR

DESIGN

ARCHITECTURE • ENGINEERING • INTERIOR DESIGN

ENGIN (2)
www.millieso

HANOVER CSC NEW
RESOURCE CENTER AND
RELATED WORK

HANOVER COMMUNITY SCHOOL CORPORATION CEDAR LAKE, INDIANA

GIBRALTAR DESIGN
9102 N. Meridian St., Ste. 300
Indianapolis, IN 46260
Homepage www.GibraltarDesign.com
Email info@GibraltarDesign.com
Phone 317.580.5777 Fax 317.580.5778

PROJECT
20-141
DATE
05/17/21
COORDINATED BY
JC

COORDINATED BY
JC

DRAWN BY
RH/GL/LvB

CHECKED BY
DJ

COPYRIGHT NOTICE:

THE CONCEPTS, DESIGNS, PLANS, DETAILS, ETC, SHOWN ON THIS DOCUMENT ARE THE PROPERTY OF GIBRALTAR DESIGN AND WERE CREATED FOR USE ON THIS SPECIFIC PROJECT. NONE OF THIS INFORMATION SHALL BE USED BY ANY PERSON OR FIRM FOR ANY PURPOSE WITHOUT THE EXPRESS WRITTEN CONSENT OF GIBRALTAR DESIGN. THE OWNER MAY RETAIN COPIES FOR INFORMATION AND REFERENCE IN CONNECTION ONLY WITH THIS PROJECT.

EVISIONS ARK DATE

MARK DATE ISSUED FOR

AD-2 06/04/21 ADDENDUM NO. 2


AD-4 06/10/21 ADDENDUM NO. 4


DRAWING
PLUMBING PLANS

PLUMBING PLANS
MECHANICS BUILDING
BUILDING C

PROJECT
HANOVER CSC NEW RESOURCE
CENTER AND RELATED WORK

© GIBRALTAR DESIGN SHEET

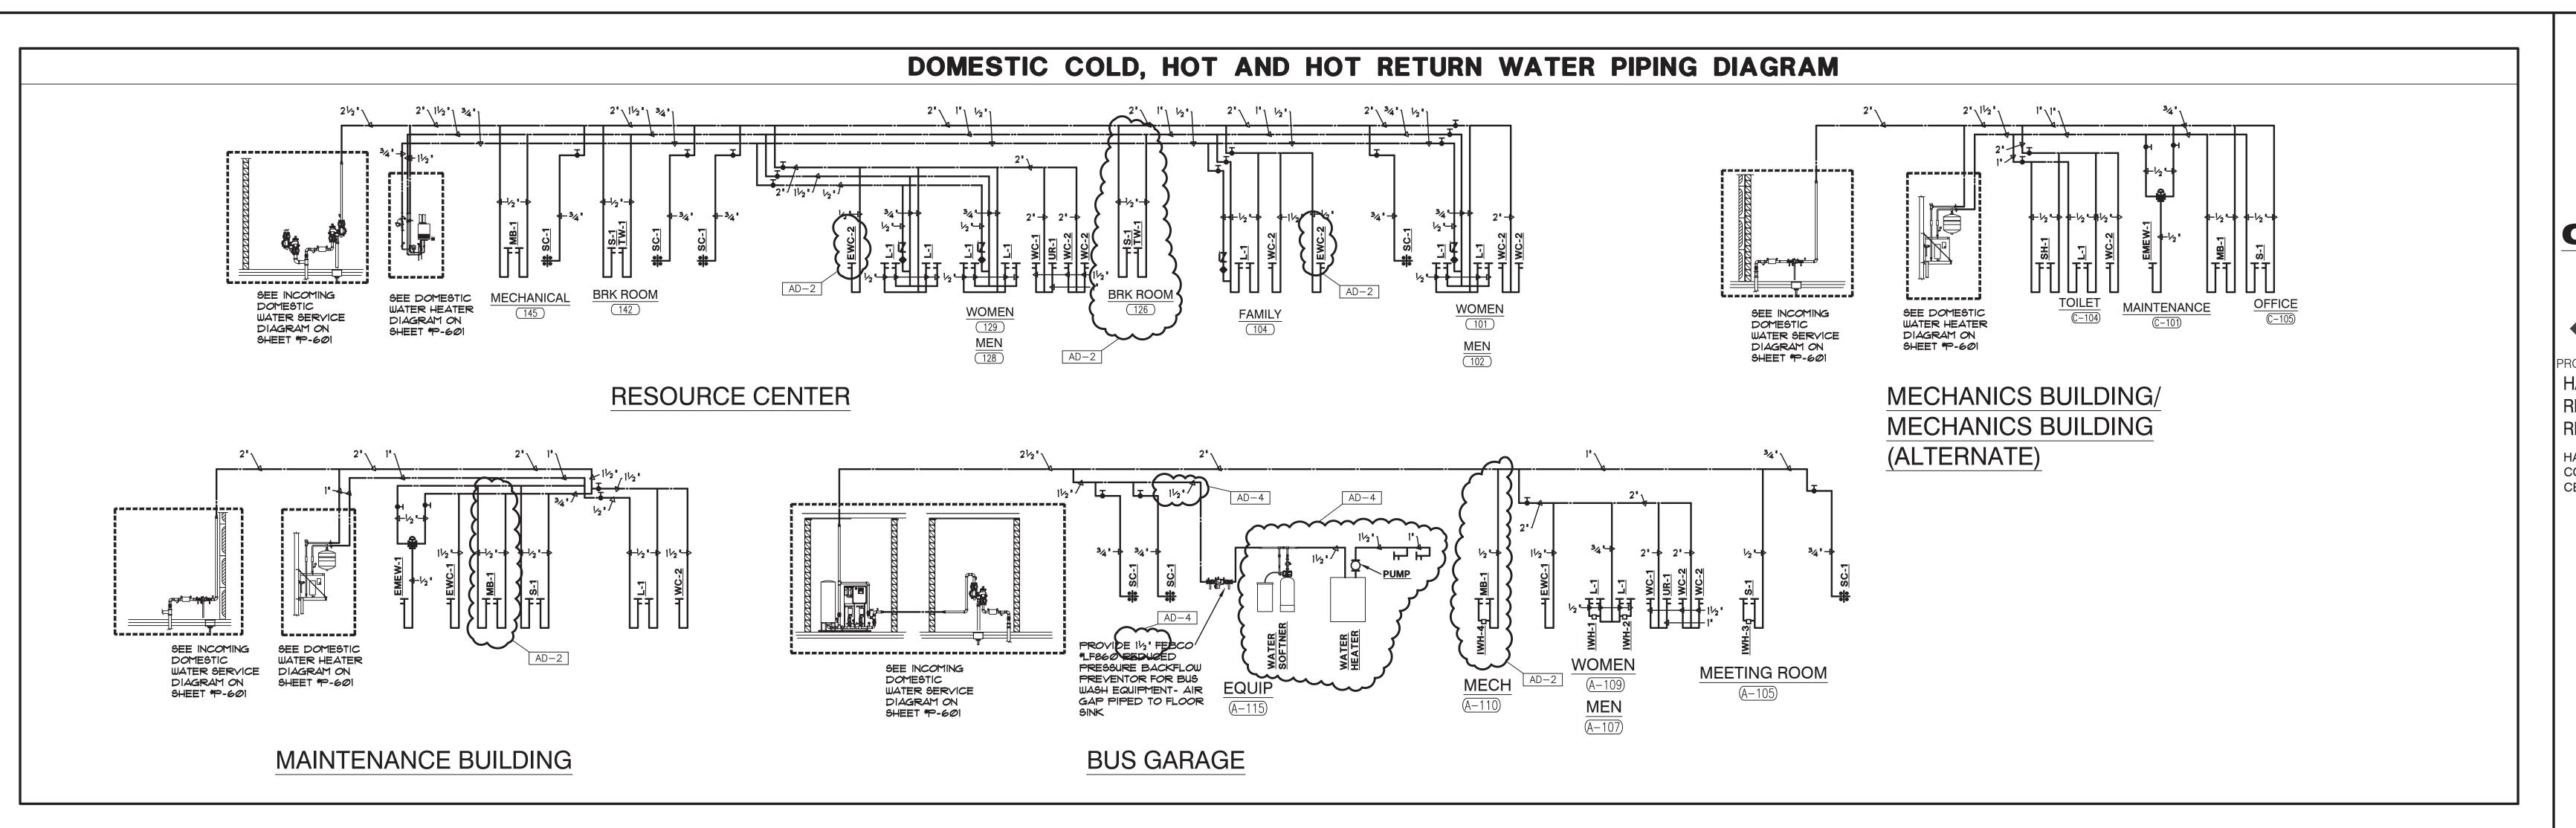

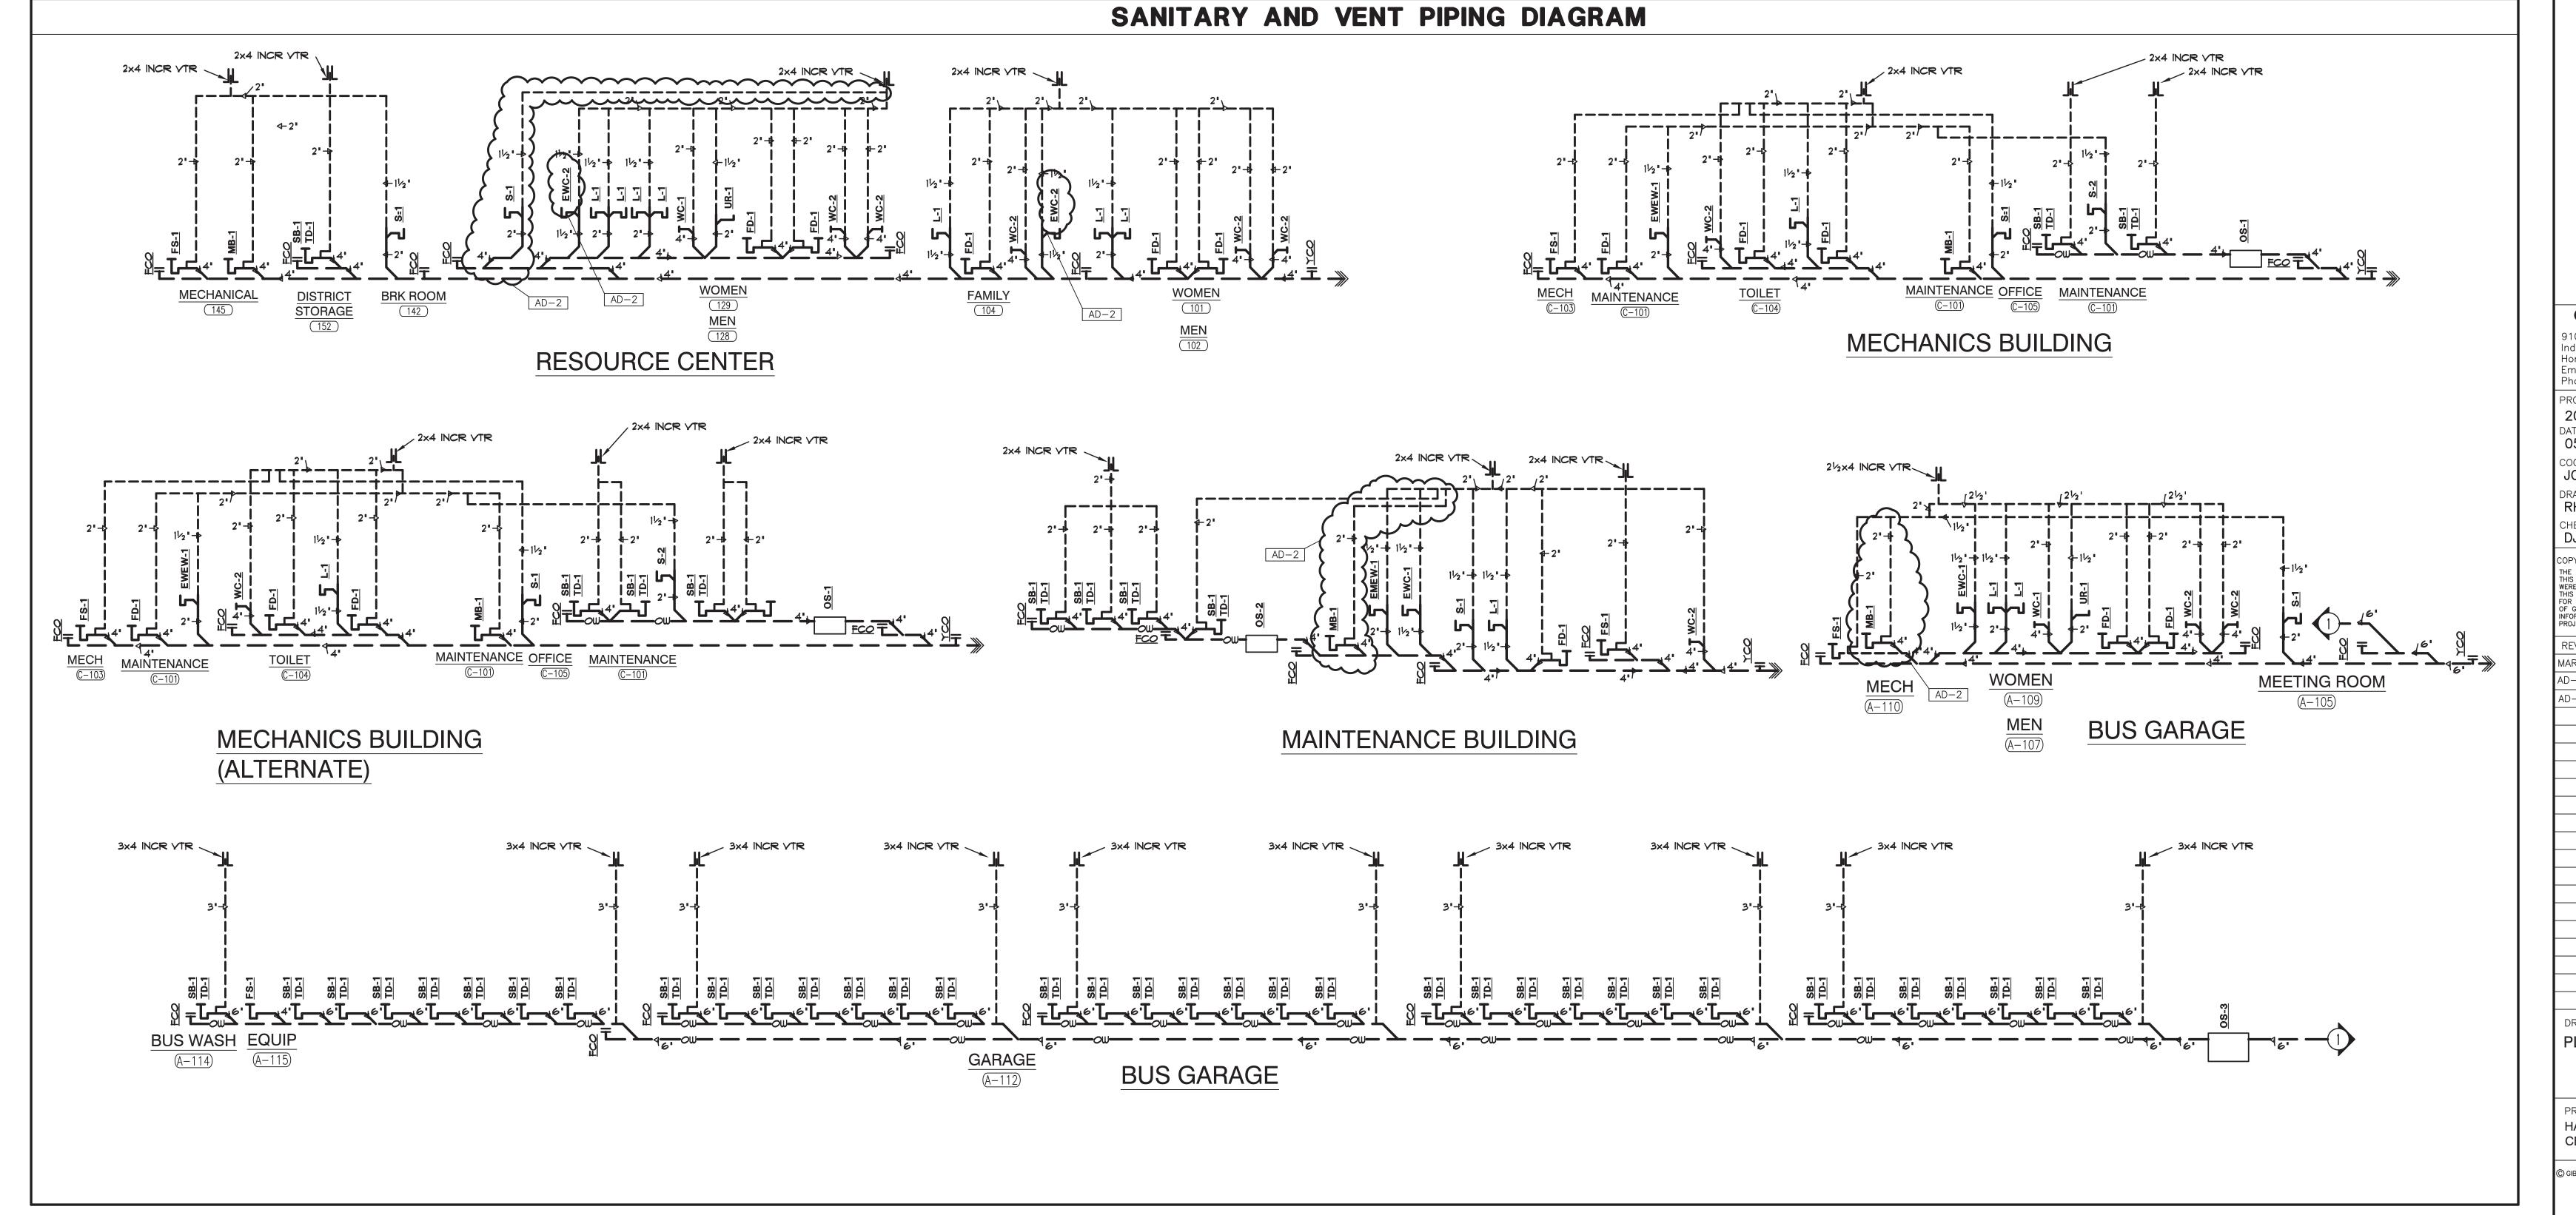



DESIGN ARCHITECTURE • ENGINEERING • INTERIOR DESIGN

HANOVER CSC NEW RESOURCE CENTER AND RELATED WORK

HANOVER COMMUNITY SCHOOL CORPORATION CEDAR LAKE, INDIANA

GIBRALTAR DESIGN 9102 N. Meridian St., Ste. 300 Indianapolis, IN 46260 Homepage www.GibraltarDesign.com Email info@GibraltarDesign.com Phone 317.580.5777 Fax 317.580.577


20-141

RH/GL/LvB

MARK DATE ISSUED FOR AD-2 06/04/21 ADDENDUM NO. 2 AD-4 06/10/21 ADDENDUM NO. 4

PLUMBING RISER DIAGRAMS

HANOVER CSC NEW RESOURCE CENTER AND RELATED WORK

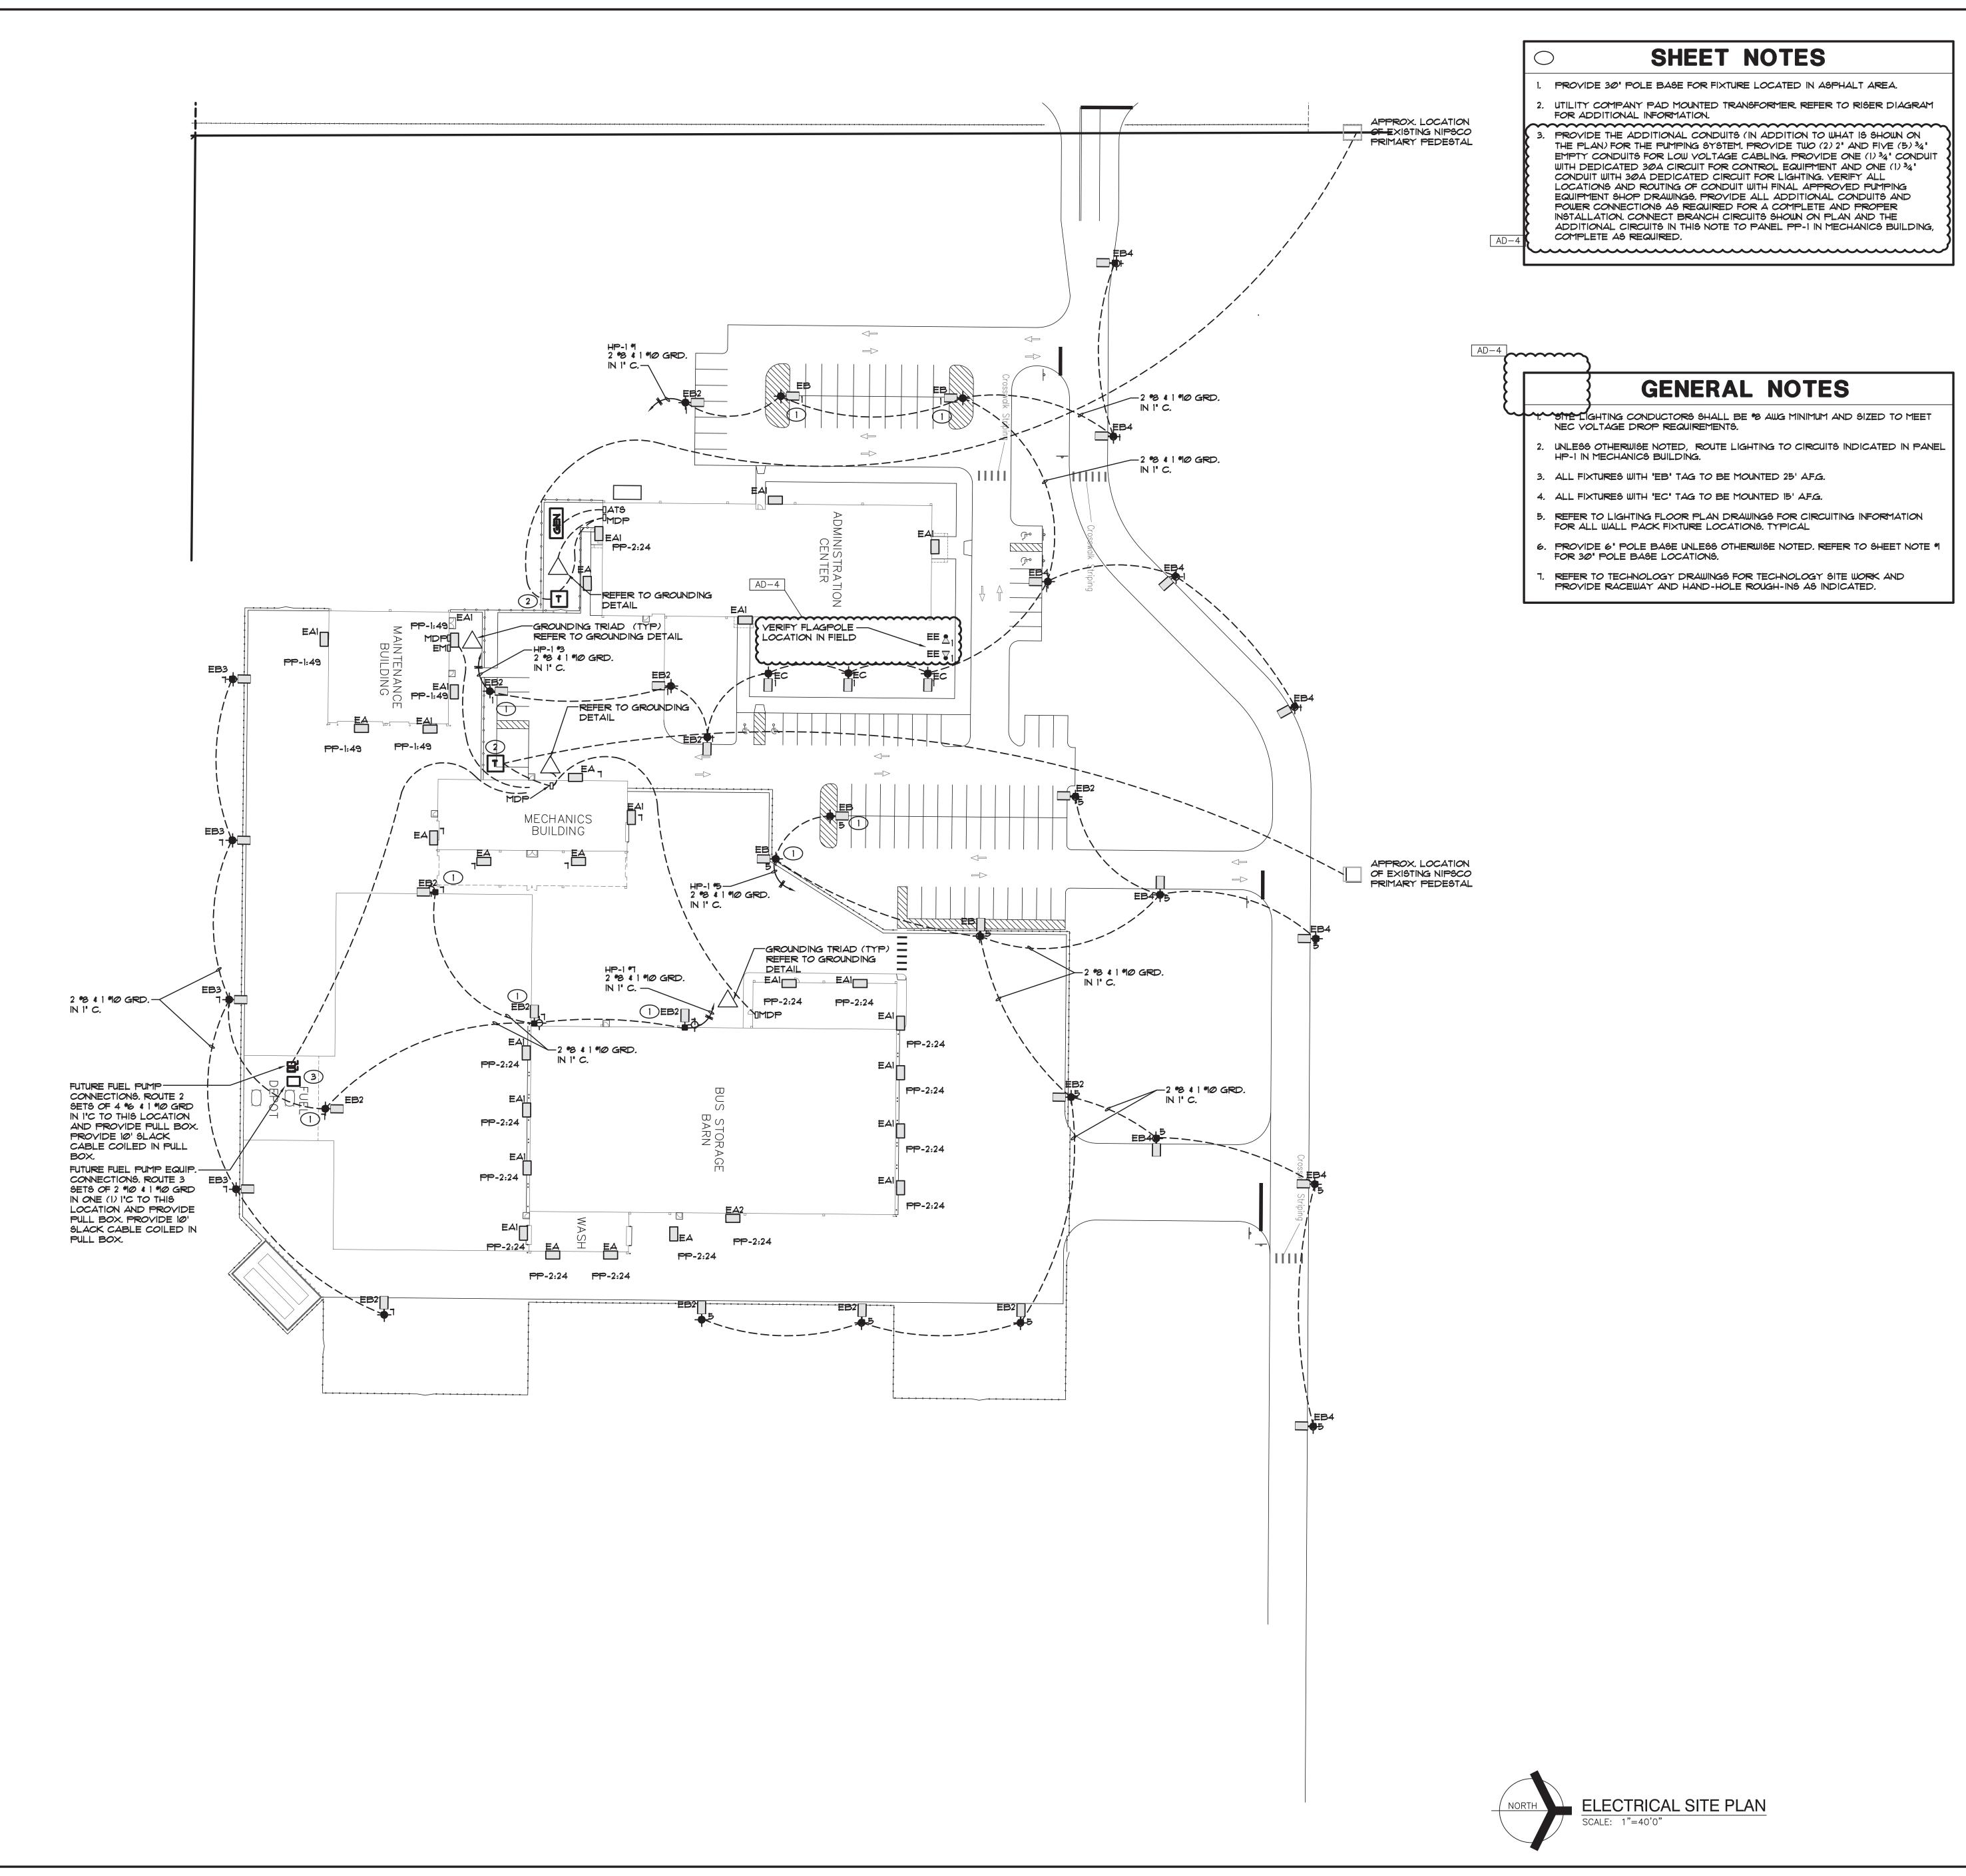



DESIGN
ARCHITECTURE • ENGINEERING • INTERIOR DESIGN



HANOVER CSC NEW
RESOURCE CENTER AND
RELATED WORK

HANOVER COMMUNITY SCHOOL CORPORATION CEDAR LAKE, INDIANA

GIBRALTAR DESIGN
9102 N. Meridian St., Ste. 300

Indianapolis, IN 46260
Homepage www.GibraltarDesign.com
Email info@GibraltarDesign.com
Phone 317.580.5777 Fax 317.580.5778

PROJECT
20-141
DATE
05/17/21
COORDINATED BY
JC

DRAWN BY
RH/GL/LvB
CHECKED BY
DJ

COPYRIGHT NOTICE:

10302590

COPYRIGHT NOTICE:

THE CONCEPTS, DESIGNS, PLANS, DETAILS, ETC, SHOWN ON THIS DOCUMENT ARE THE PROPERTY OF GIBRALTAR DESIGN AND WERE CREATED FOR USE ON THIS SPECIFIC PROJECT. NONE OF THIS INFORMATION SHALL BE USED BY ANY PERSON OR FIRM FOR ANY PURPOSE WITHOUT THE EXPRESS WRITTEN CONSENT OF GIBRALTAR DESIGN. THE OWNER MAY RETAIN COPIES FOR INFORMATION AND REFERENCE IN CONNECTION ONLY WITH THIS PROJECT.

MARK DATE ISSUED FOR
AD-4 06/10/21 ADDENDUM NO. 4

DRAWING

ELECTRICAL SITE PLAN

PROJECT
HANOVER CSC NEW RESOURCE
CENTER AND RELATED WORK

© GIBRALTAR DESIGN SHEET

E-002

INTERIOR LIGHTING SHALL BE CONNECTED TO CIRCUITS INDICATED IN PANEL PP-2 UNLESS NOTED OTHERWISE. INTERIOR LIGHTING CIRCUIT TAGS WITH AN "E" PREFIX SHALL BE CIRCUITED TO CIRCUIT INDICATED IN PANEL EM. EMERGENCY FIXTURES WITH SWITCH TAG SHALL BE PROVIDED WITH CONSTANT HOT FEED AS REQUIRED.

2. EXTERIOR LIGHTING SHALL BE CONNECTED TO CIRCUITS INDICATED IN PANEL PP-2 VIA TIME CLOCK, PHOTOCELL AND CONTACTORS UNLESS NOTED OTHERWISE.

3. EXTERIOR LIGHTING WITH AN 'E' PREFIX CIRCUIT TAG SHALL BE CONNECTED TO CIRCUIT INDICATED IN PANEL EM VIA TIME CLOCK, PHOTOCELL, CONTACTORS, AND



ARCHITECTURE • ENGINEERING • INTERIOR DESIGN

HANOVER CSC NEW

RELATED WORK

CEDAR LAKE, INDIANA

CORPORATION

RESOURCE CENTER AND

HANOVER COMMUNITY SCHOOL

(219) 924-8400



GIBRALTAR DESIGN
9102 N. Meridian St., Ste. 300
Indianapolis, IN 46260
Homepage www.GibraltarDesign.com
Email info@GibraltarDesign.com
Phone 317.580.5777 Fax 317.580.5778

PROJECT
20-141
DATE
05/17/21
COORDINATED BY
JC
DRAWN BY

DRAWN BY
RH/GL/LvB
CHECKED BY
DJ

COPYRIGHT NOTICE:

COPYRIGHT NOTICE:

THE CONCEPTS, DESIGNS, PLANS, DETAILS, ETC, SHOWN ON THIS DOCUMENT ARE THE PROPERTY OF GIBRALTAR DESIGN AND WERE CREATED FOR USE ON THIS SPECIFIC PROJECT. NONE OF THIS INFORMATION SHALL BE USED BY ANY PERSON OR FIRM FOR ANY PURPOSE WITHOUT THE EXPRESS WRITTEN CONSENT OF GIBRALTAR DESIGN. THE OWNER MAY RETAIN COPIES FOR INFORMATION AND REFERENCE IN CONNECTION ONLY WITH THIS PROJECT.

MARK	DATE	ISSUED FOR
AD-1	05/28/21	ADDENDUM NO. 1
AD-4	06/10/21	ADDENDUM NO. 4
		·

DRAWING

ELECTRICAL LIGHTING FLOOR PLAN
BUS GARAGE
BUILDING A

PROJECT
HANOVER CSC NEW RESOURCE
CENTER AND RELATED WORK

© GIBRALTAR DESIGN SHEET

EL101

INTERIOR LIGHTING SHALL BE CONNECTED TO CIRCUITS INDICATED IN PANEL PP-1 UNLESS NOTED OTHERWISE. INTERIOR LIGHTING CIRCUIT TAGS WITH AN "E" PREFIX SHALL BE CIRCUITED TO CIRCUIT INDICATED IN PANEL EM. EMERGENCY FIXTURES WITH SWITCH TAG SHALL BE PROVIDED WITH CONSTANT HOT FEED AS REQUIRED.

EXTERIOR LIGHTING SHALL BE CONNECTED TO CIRCUITS INDICATED IN PANEL PP-1 VIA TIME CLOCK, PHOTOCELL AND CONTACTORS UNLESS NOTED OTHERWISE. 3. EXTERIOR LIGHTING WITH AN 'E' PREFIX CIRCUIT TAG SHALL BE CONNECTED TO CIRCUIT INDICATED IN PANEL EM VIA TIME CLOCK, PHOTOCELL, CONTACTORS, AND LIGHTING INVERTER (OR INTEGRAL BATTERIES).




**MILLIES** ENGINEERING GROUI (219) 924-8400

ARCHITECTURE • ENGINEERING • INTERIOR DESIGN


HANOVER CSC NEW RESOURCE CENTER AND RELATED WORK

HANOVER COMMUNITY SCHOOL CORPORATION CEDAR LAKE, INDIANA

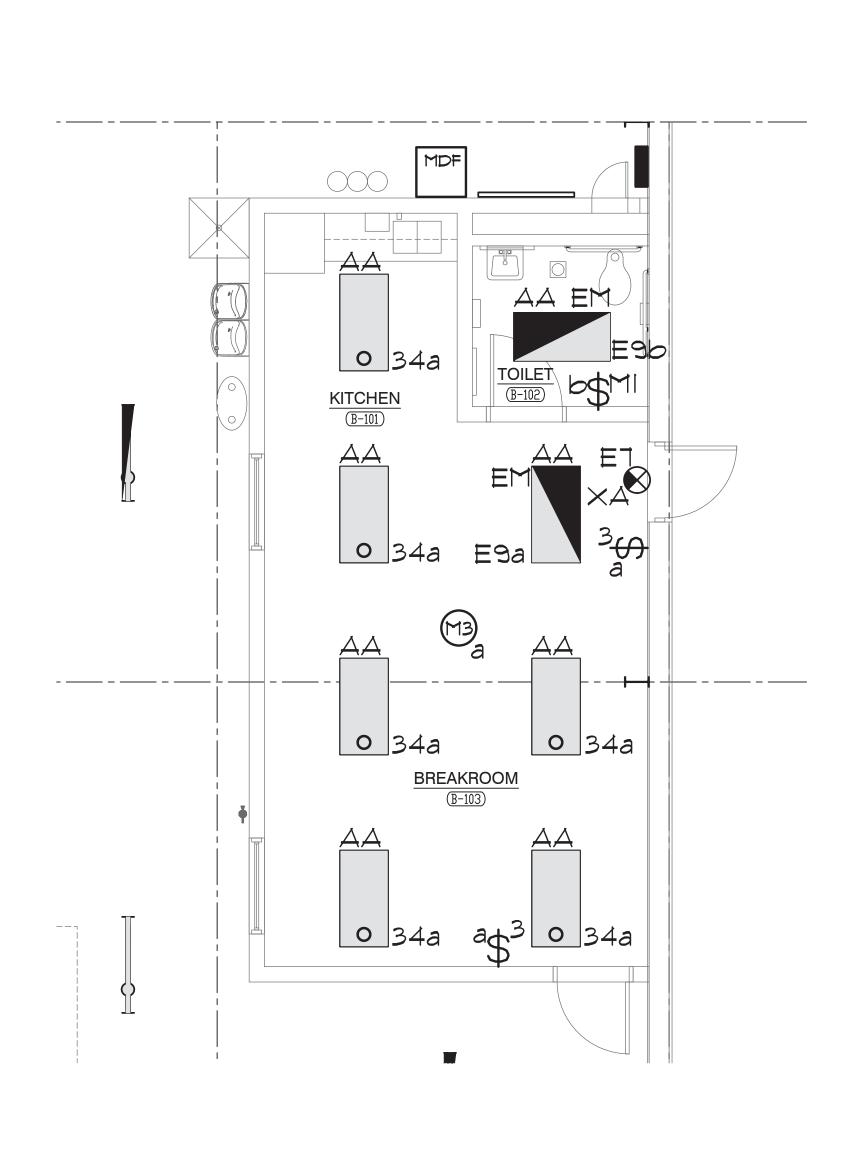


ENLARGED KITCHEN, TOILET AND BREAK ROOM NORTH LIGHTING FLOOR PLAN

SCALE: 1/8" = 1'-0"

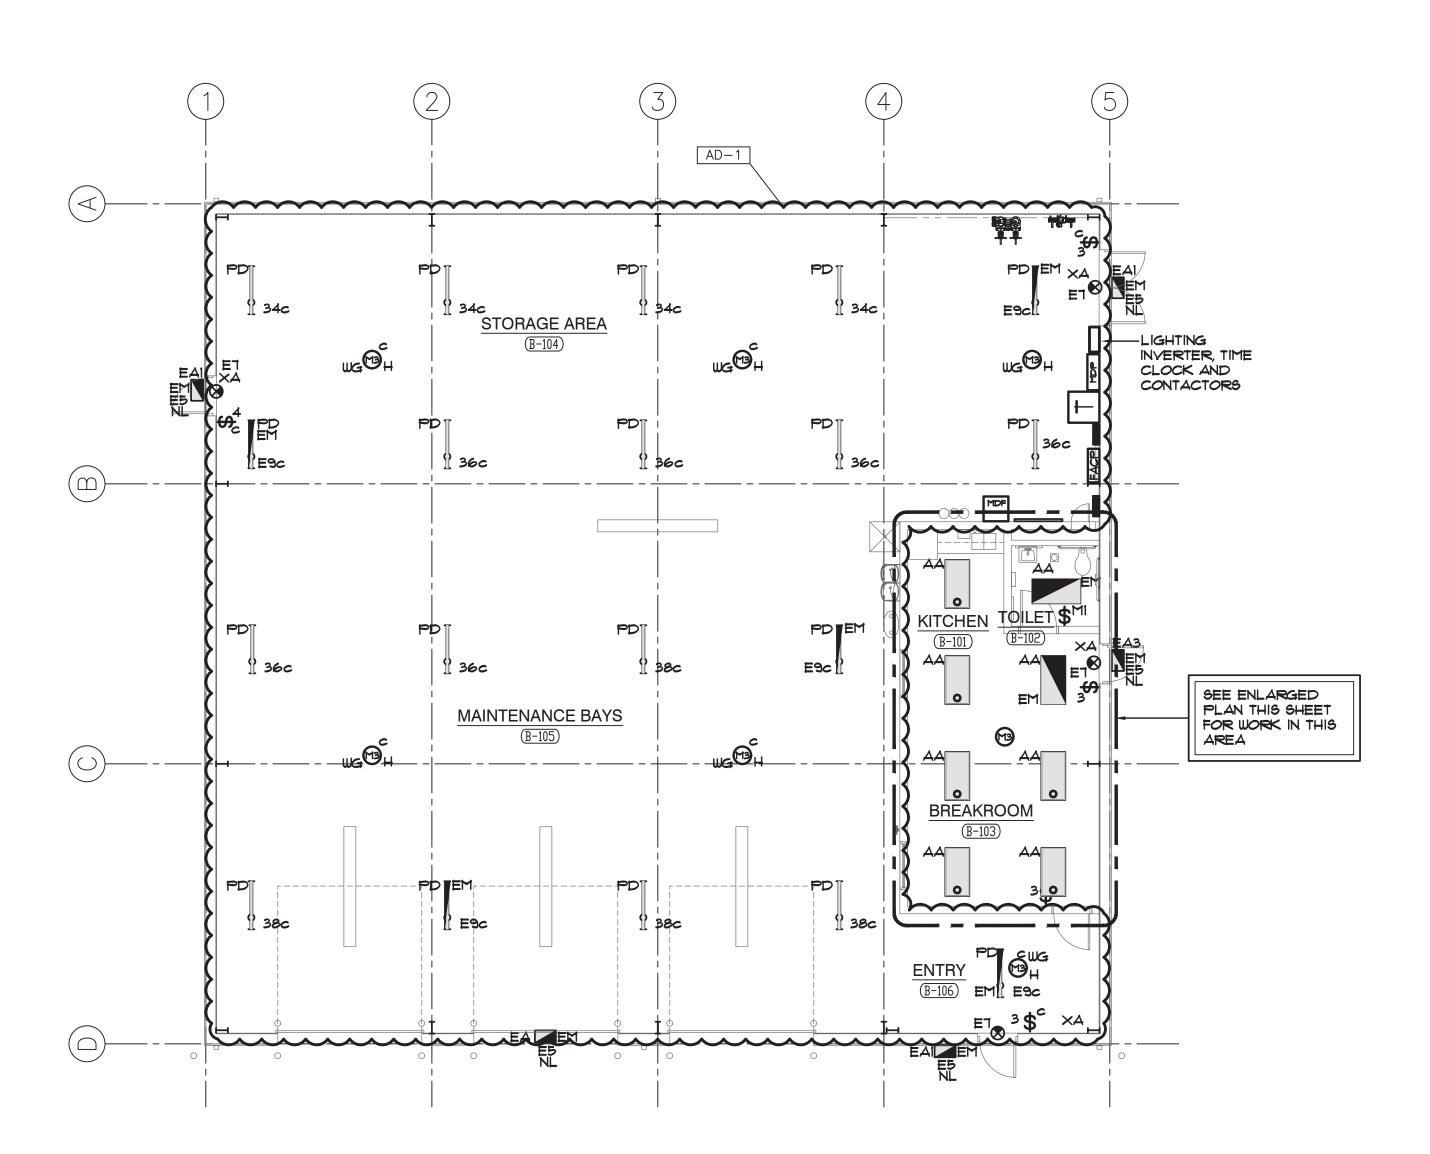

ELECTRICAL LIGHTING FLOOR PLAN MAINTENANCE BUILDING BUILDING B

SCALE: 1/8" = 1'-0"

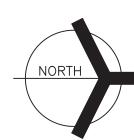

G	GIBRALTAR DESIGN						
Indian Home Email	apolis, IN page www. info@Gibro	46260 GibraltarD altarDesign	n St., Ste. 300 46260 GibraltarDesign.com ItarDesign.com 5777 Fax 317.580.5778				
DATE 05/ COORI JC DRAWN RH/	-141 '17/21 DINATED BY		G. JA FGISTER NO. 10302590 STATE OF WOLAND SIGNAL F	**************************************			
THE CON THIS DOO WERE CR THIS INFO FOR ANY OF GIBRA	GHT NOTICE: ICEPTS, DESIGNS CUMENT ARE THI REATED FOR USE ORMATION SHALL PURPOSE WITH ALTAR DESIGN. TI ION AND REFER	E PROPERTY C : ON THIS SPE . BE USED BY OUT THE EXPR HE OWNER MA	OF GIBRALTAR ECIFIC PROJEC ANY PERSON RESS WRITTEN NY RETAIN CO	DESIGN AND CT. NONE OF N OR FIRM CONSENT PIES FOR			
REVIS	IONS						
MARK	DATE	ISSUED	FOR				
AD-1	05/28/21	ADDENDU	M NO. 1				
AD-4	06/10/21	ADDENDU	M NO. 4				

DRAWING

BUILDING B


© GIBRALTAR DESIGN SHEET

ELECTRICAL LIGHTING PLANS

MAINTENANCE BUILDING

HANOVER CSC NEW RESOURCE CENTER AND RELATED WORK

EL102

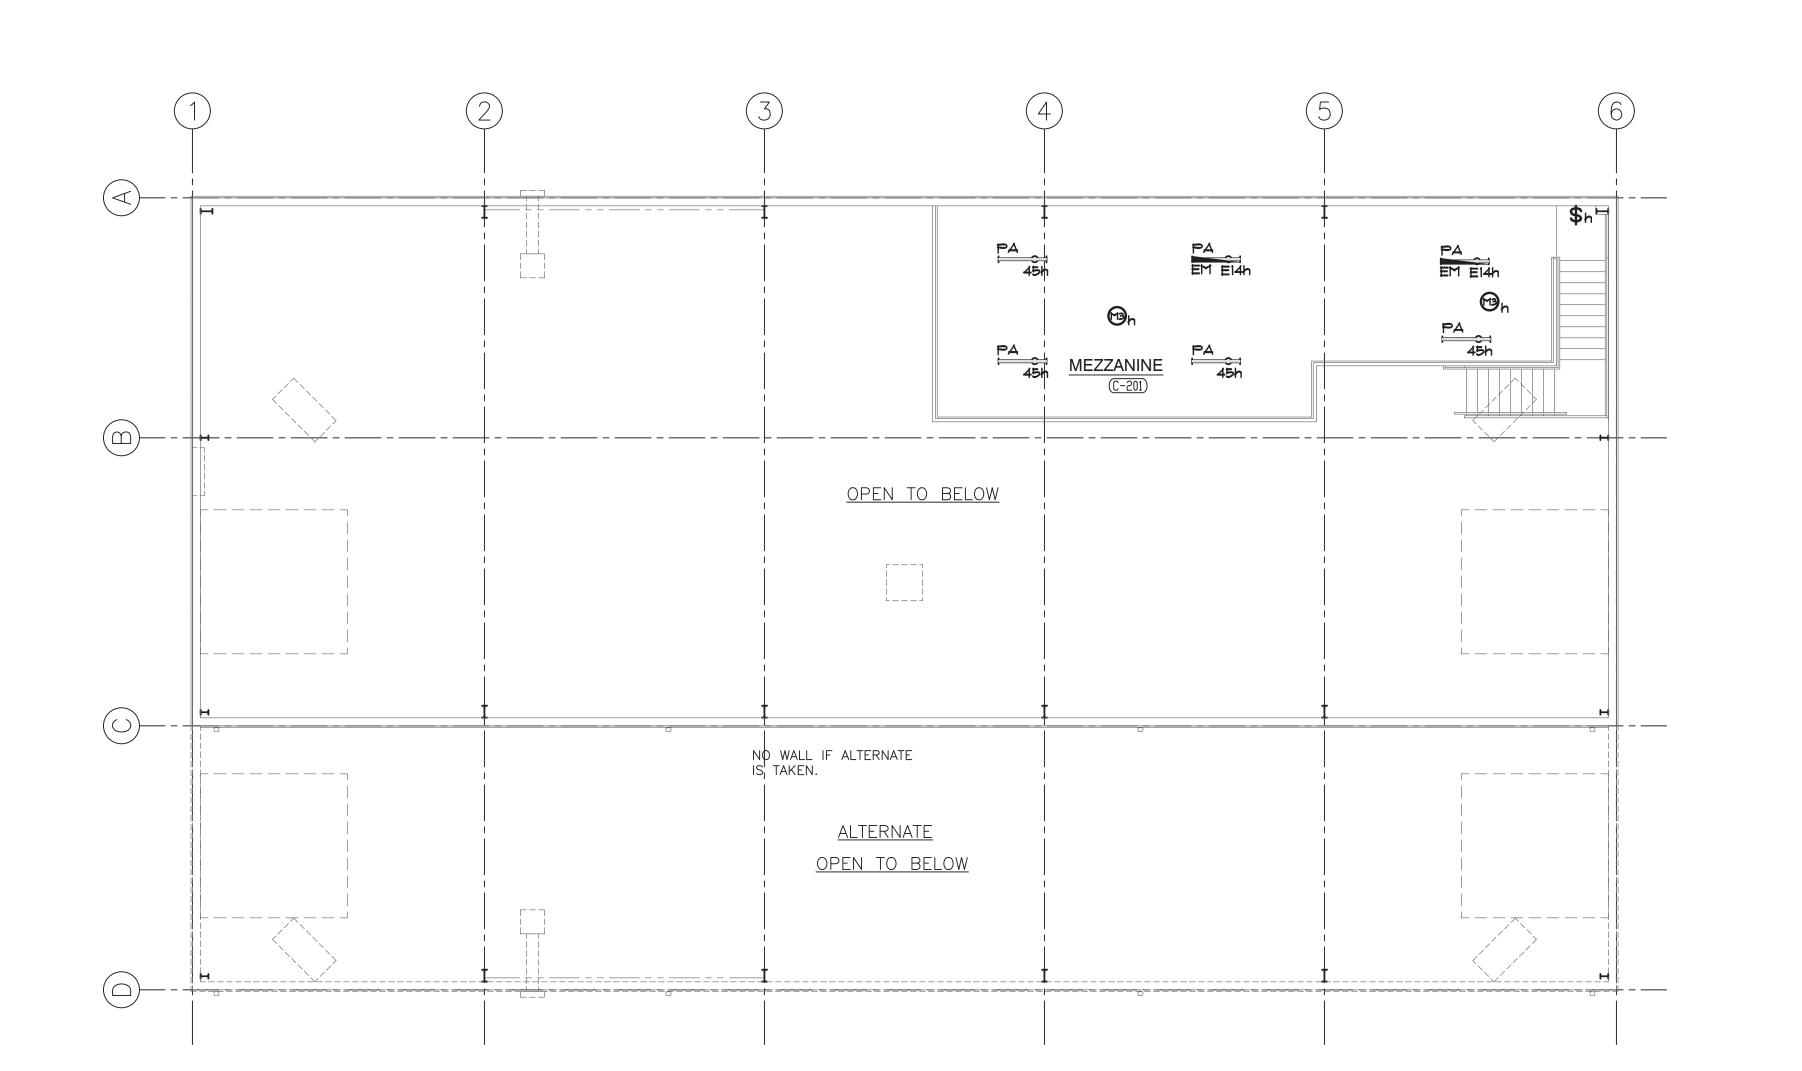

1. INTERIOR LIGHTING SHALL BE CONNECTED TO CIRCUITS INDICATED IN PANEL PP-1 UNLESS NOTED OTHERWISE. INTERIOR LIGHTING CIRCUIT TAGS WITH AN "E" PREFIX SHALL BE CIRCUITED TO CIRCUIT INDICATED IN PANEL EM. EMERGENCY FIXTURES WITH SWITCH TAG SHALL BE PROVIDED WITH CONSTANT HOT FEED AS REQUIRED.

2. EXTERIOR LIGHTING SHALL BE CONNECTED TO CIRCUITS INDICATED IN PANEL PP-1 VIA TIME CLOCK, PHOTOCELL AND CONTACTORS UNLESS NOTED OTHERWISE.

3. EXTERIOR LIGHTING WITH AN 'E' PREFIX CIRCUIT TAGE SHALL BE CONNECTED TO CIRCUIT INDICATED IN PANEL EM VIA TIME CLOCK, PHOTOCELL, CONTACTORS, AND LIGHTING INVERTER (OR INTEGRAL BATTERIES).



DESIGN

ARCHITECTURE • ENGINEERING • INTERIOR DESIGN

MILLIES

ENGINEERING GROV
(219) 924-8400

HANOVER CSC NEW
RESOURCE CENTER AND
RELATED WORK

HANOVER COMMUNITY SCHOOL CORPORATION CEDAR LAKE, INDIANA


ELECTRICAL LIGHTING MEZZANINE PLAN


MECHANICS BUILDING

BUILDING C

SCALE: 1/8" = 1'-0"



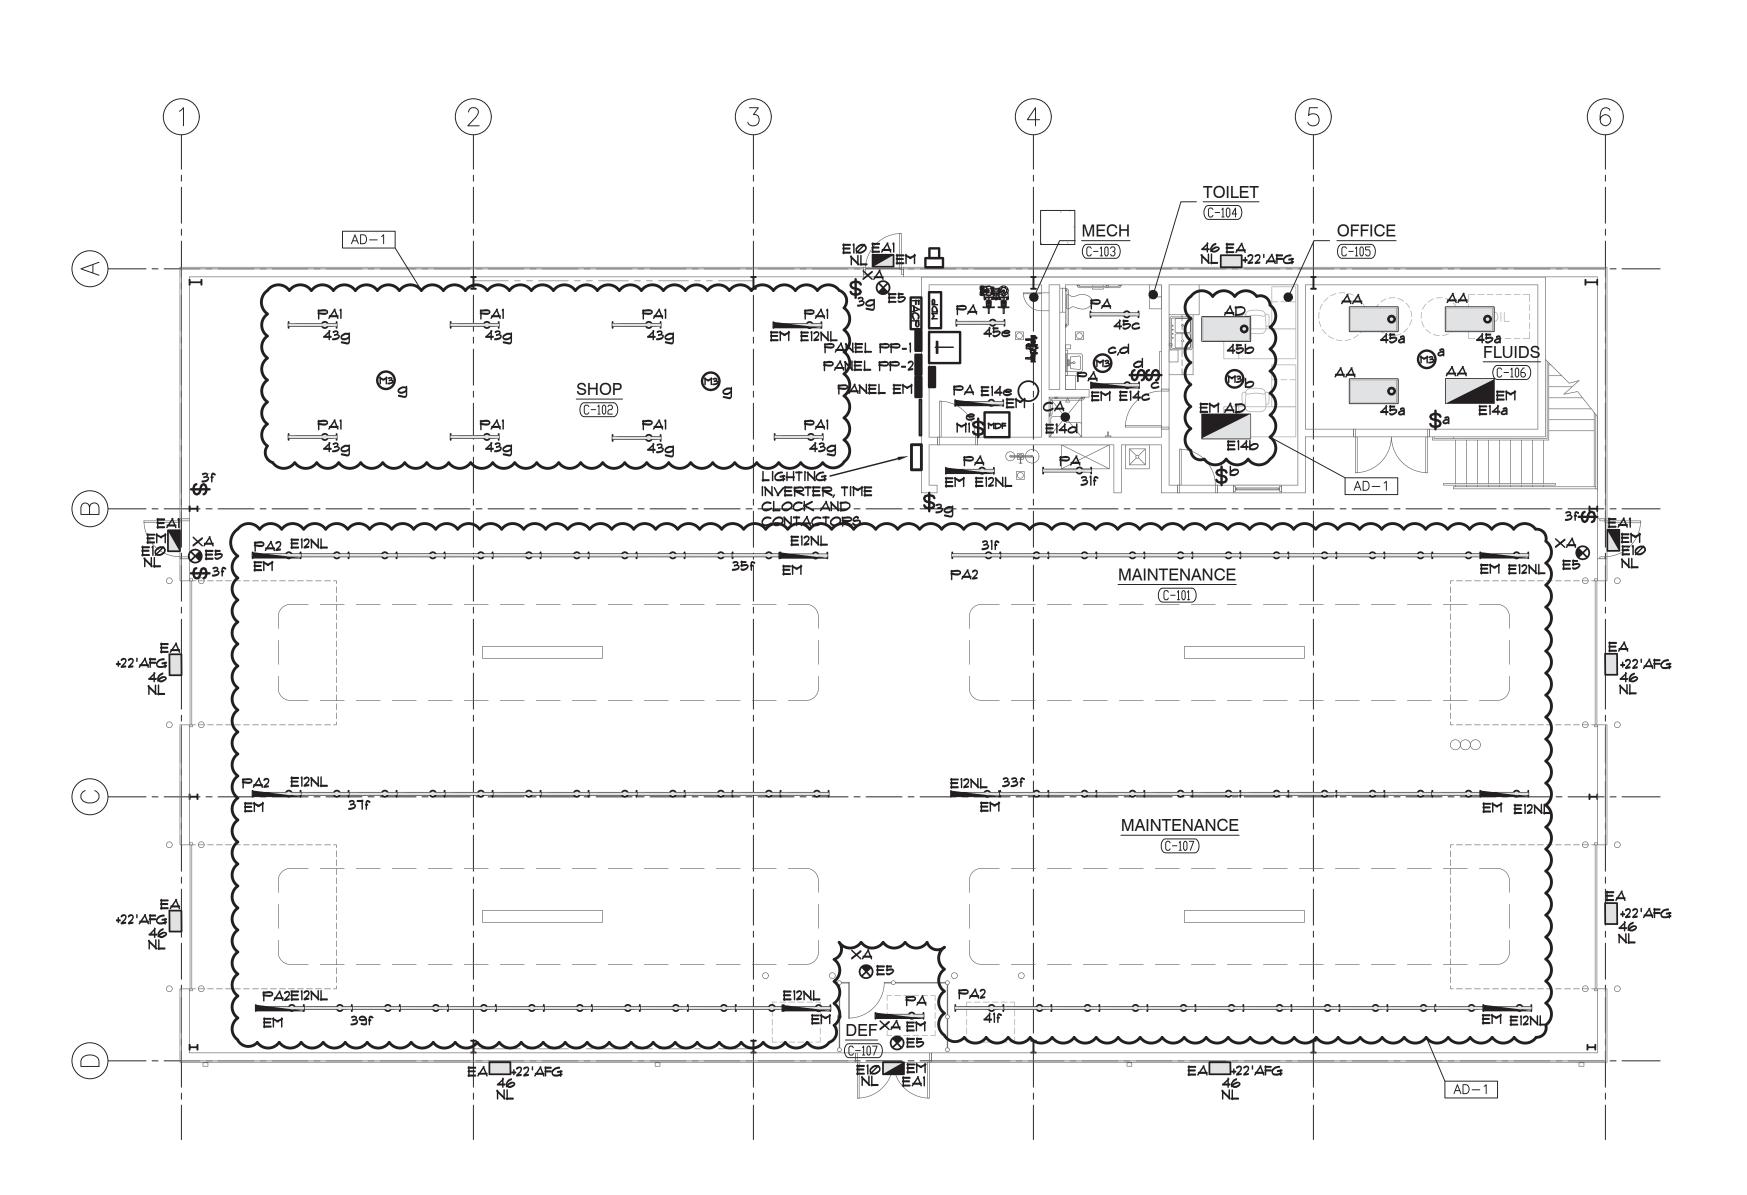

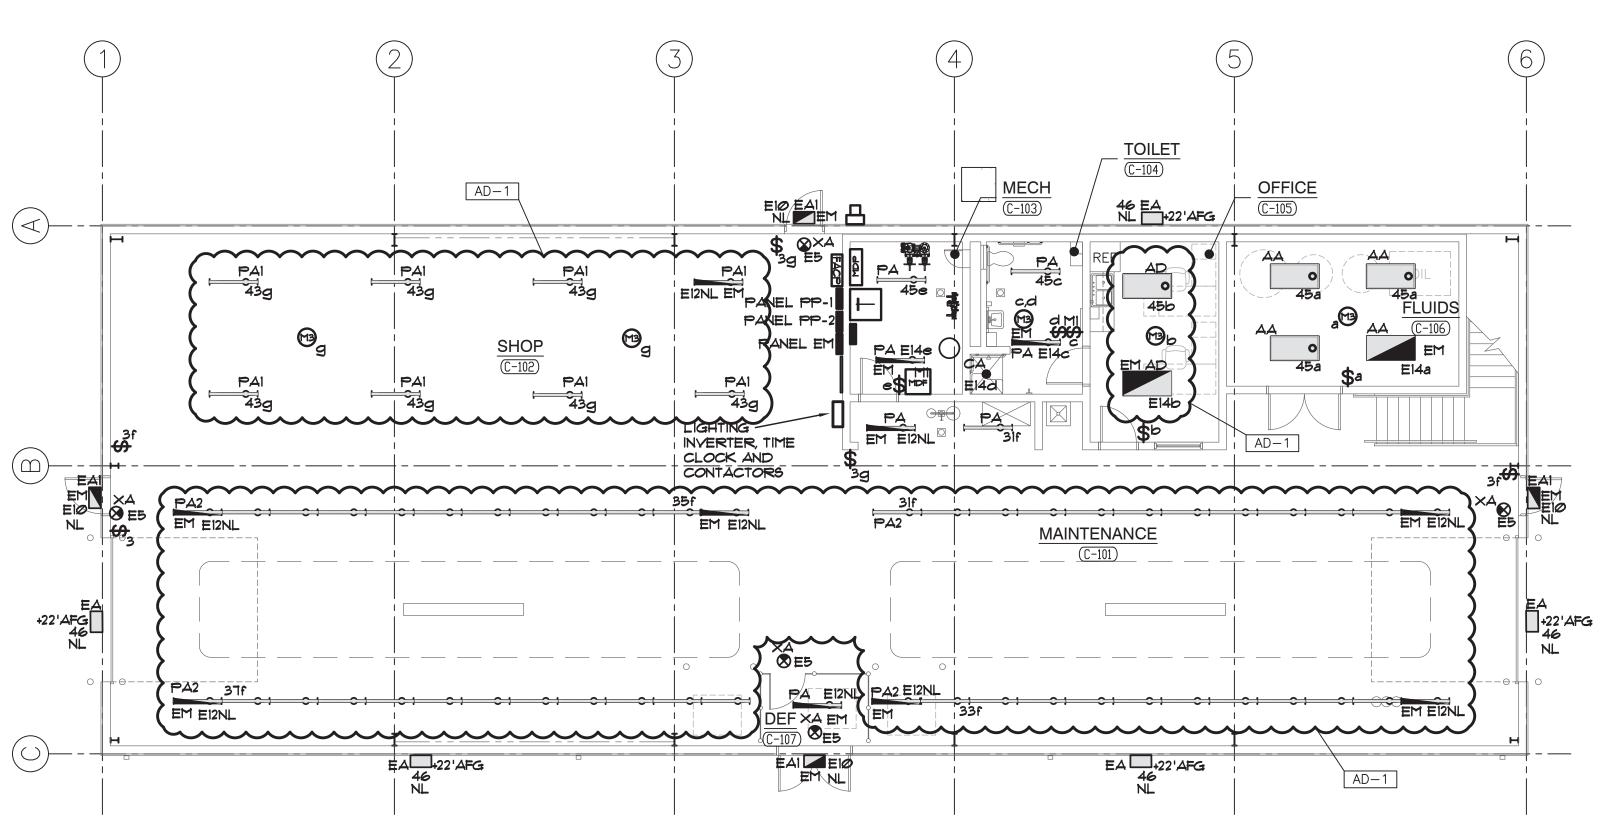

NORTH

ELECTRICAL LIGHTING FLOOR PLAN
MECHANICS BUILDING
BUILDING C - BASE BID

SCALE: 1/8" = 1'-0"

NORTH

ELECTRICAL LIGHTING FLOOR PLAN
MECHANICS BUILDING
BUILDING C - ALTERNATE

SCALE: 1/8" = 1'-0"



O5/17/21

COORDINATED BY JC

DRAWN BY RH/GL/LvB

CHECKED BY DJ

COPYRIGHT NOTICE:

20-141

GIBRALTAR DESIGN

9102 N. Meridian St., Ste. 300 Indianapolis, IN 46260 Homepage www.GibraltarDesign.com Email info@GibraltarDesign.com Phone 317.580.5777 Fax 317.580.5778

WERE CREATED FOR USE ON THIS SPECIFIC PROJECT. NONE THIS INFORMATION SHALL BE USED BY ANY PERSON OR FIR FOR ANY PURPOSE WITHOUT THE EXPRESS WRITTEN CONSEN OF GIBRALTAR DESIGN. THE OWNER MAY RETAIN COPIES FOR INFORMATION AND REFERENCE IN CONNECTION ONLY WITH THE PROJECT.

REVISIONS

AD-4 | 06/10/21 | ADDENDUM NO. 4

MARK DATE ISSUED FOR AD-1 05/28/21 ADDENDUM NO. 1

DRAWING

ELECTRICAL LIGHTING PLANS
MECHANICS BUILDING
BUILDING C

PROJECT
HANOVER CSC NEW RESOURCE
CENTER AND RELATED WORK

© GIBRALTAR DESIGN SHEET

EL103

INTERIOR LIGHTING SHALL BE CONNECTED TO CIRCUITS INDICATED IN PANEL PP-2 UNLESS NOTED OTHERWISE. INTERIOR LIGHTING CIRCUIT TAGS WITH AN "E" PREFIX SHALL BE CIRCUITED TO CIRCUIT INDICATED IN PANEL EM. EMERGENCY FIXTURES WITH SWITCH TAG SHALL BE PROVIDED WITH CONSTANT HOT FEED AS REQUIRED.


. EXTERIOR LIGHTING SHALL BE CONNECTED TO CIRCUITS INDICATED IN PANEL PP-2 VIA TIME CLOCK, PHOTOCELL AND CONTACTORS UNLESS NOTED OTHERWISE. 3. EXTERIOR LIGHTING WITH AN 'E' PREFIX CIRCUIT TAG SHALL BE CONNECTED TO CIRCUIT INDICATED IN PANEL EM VIA TIME CLOCK, PHOTOCELL, CONTACTORS, AND LIGHTING INVERTER (OR INTEGRAL BATTERIES)



(219) 924-8400

HANOVER CSC NEW RESOURCE CENTER AND RELATED WORK

HANOVER COMMUNITY SCHOOL CORPORATION CEDAR LAKE, INDIANA

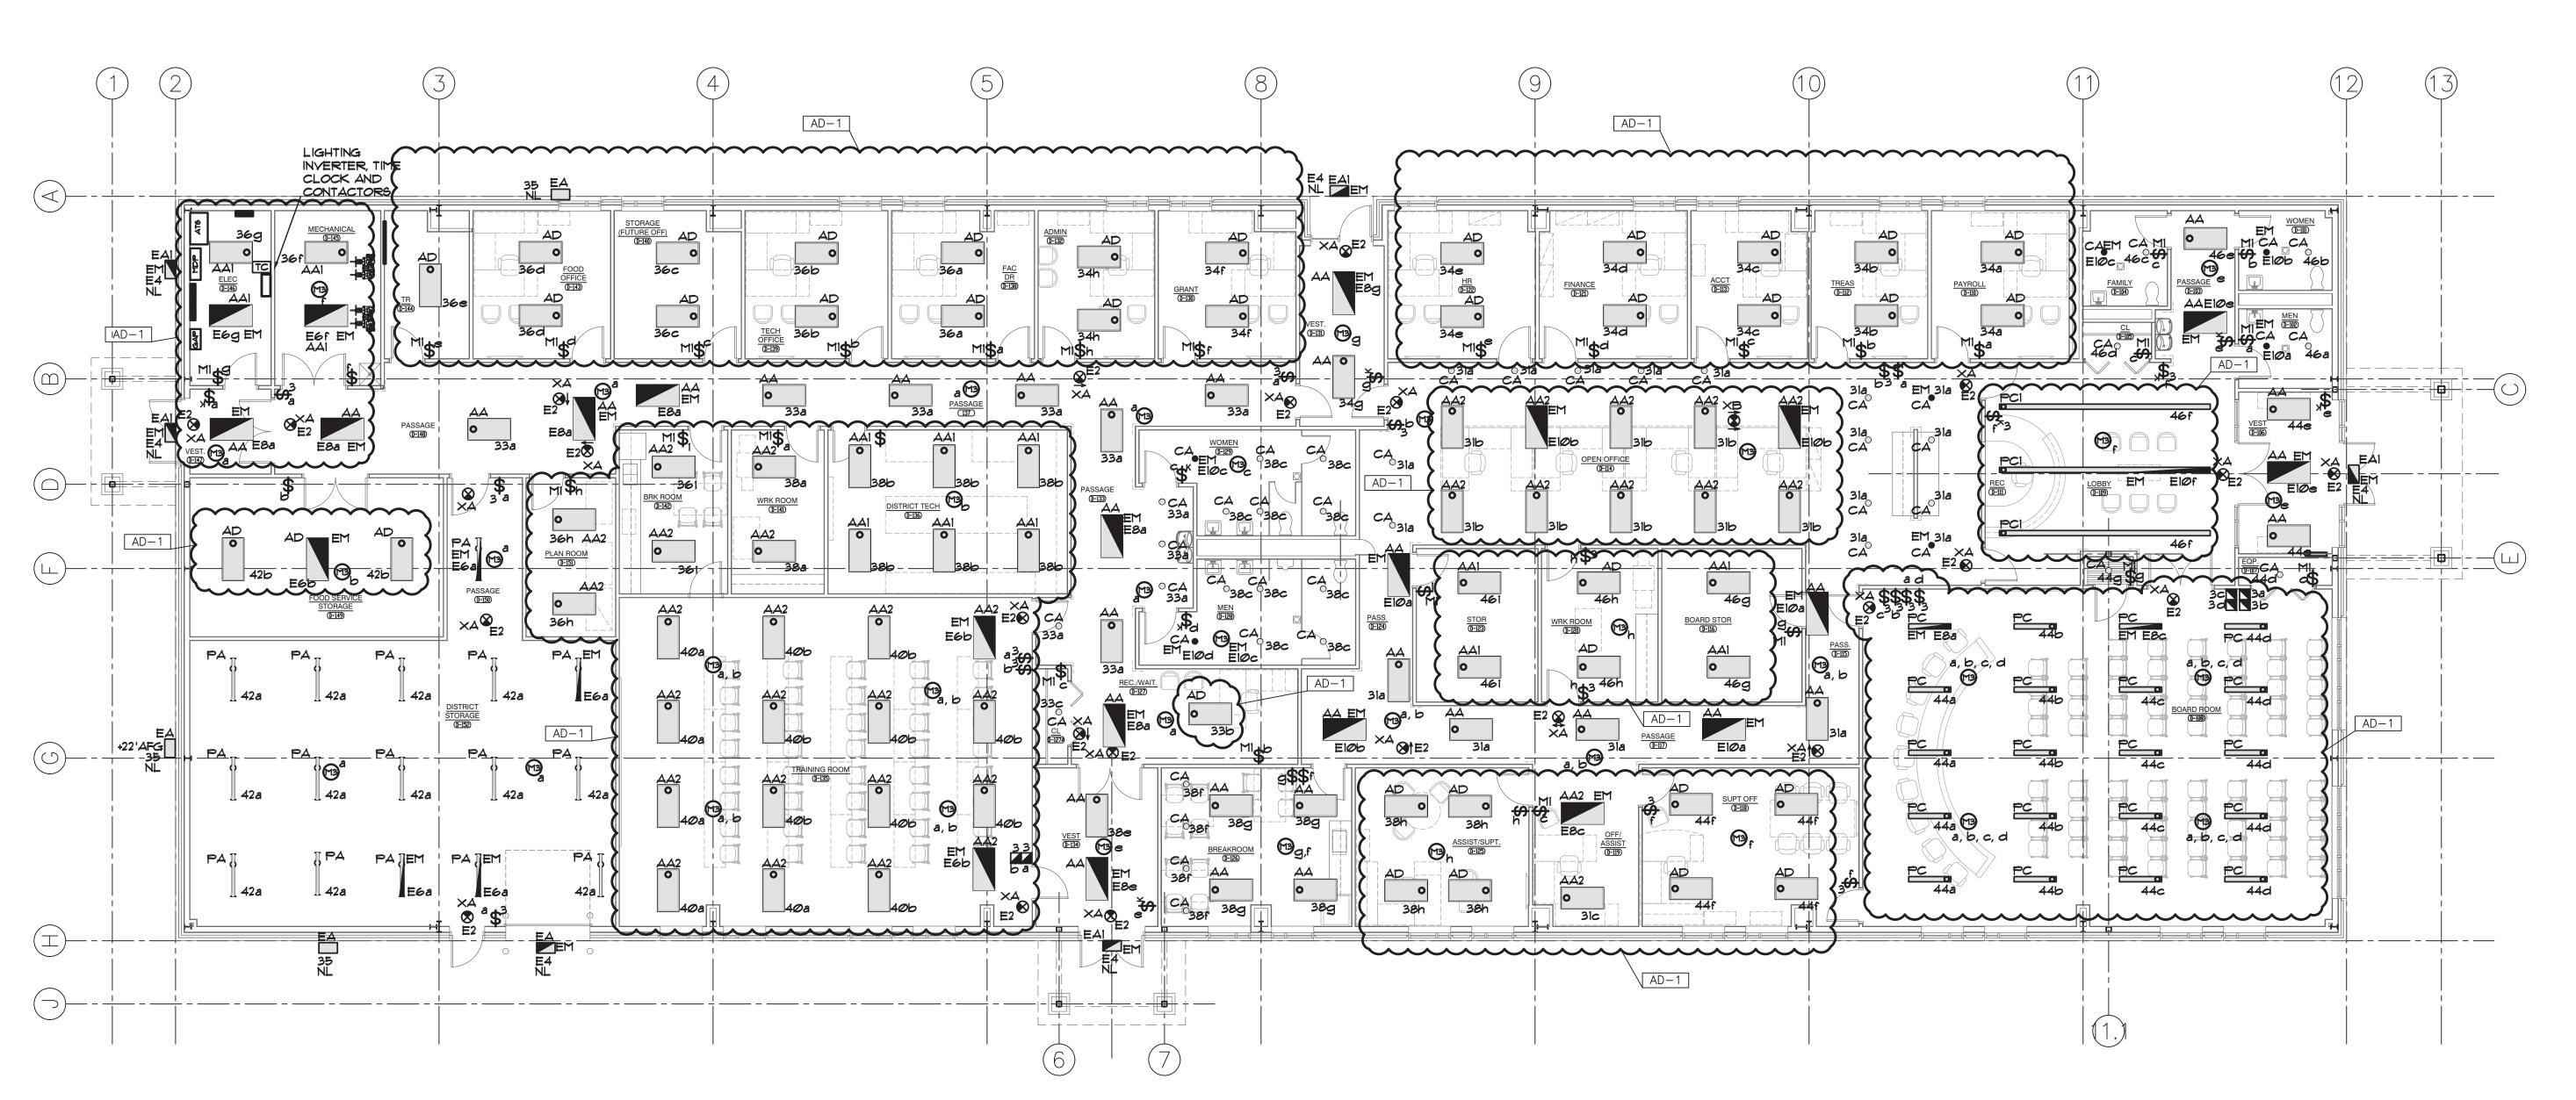

GIBRALTAR DESIGN 9102 N. Meridian St., Ste. 300

ndianapolis, IN 46260 Homepage www.GibraltarDesign.com Email info@GibraltarDesign.com Phone 317.580.5777 Fax 317.580.5778

20-141 05/17/21 COORDINATED E DRAWN BY RH/GL/LvB

CHECKED BY THE CONCEPTS, DESIGNS, PLANS, DETAILS, ETC, SHOWN ON THIS DOCUMENT ARE THE PROPERTY OF GIBRALTAR DESIGN AND WERE CREATED FOR USE ON THIS SPECIFIC PROJECT. NONE OF THIS INFORMATION SHALL BE USED BY ANY PERSON OR FIRM FOR ANY PURPOSE WITHOUT THE EXPRESS WRITTEN CONSENT OF GIBRALTAR DESIGN. THE OWNER MAY RETAIN COPIES FOR INFORMATION AND REFERENCE IN CONNECTION ONLY WITH THIS PROJECT.

MARK DATE ISSUED FOR

AD-1 | 05/28/21 | ADDENDUM NO. 1AD-4 06/10/21 ADDENDUM NO. 4

DRAWING

ELECTRICAL LIGHTING FLOOR PLAN RESOURCE CENTER BUILDING D

HANOVER CSC NEW RESOURCE CENTER AND RELATED WORK


© GIBRALTAR DESIGN SHEET

EL104

ELECTRICAL LIGHTING FLOOR PLAN RESOURCE CENTER BUILDING D

SCALE: 1/8" = 1'-0"



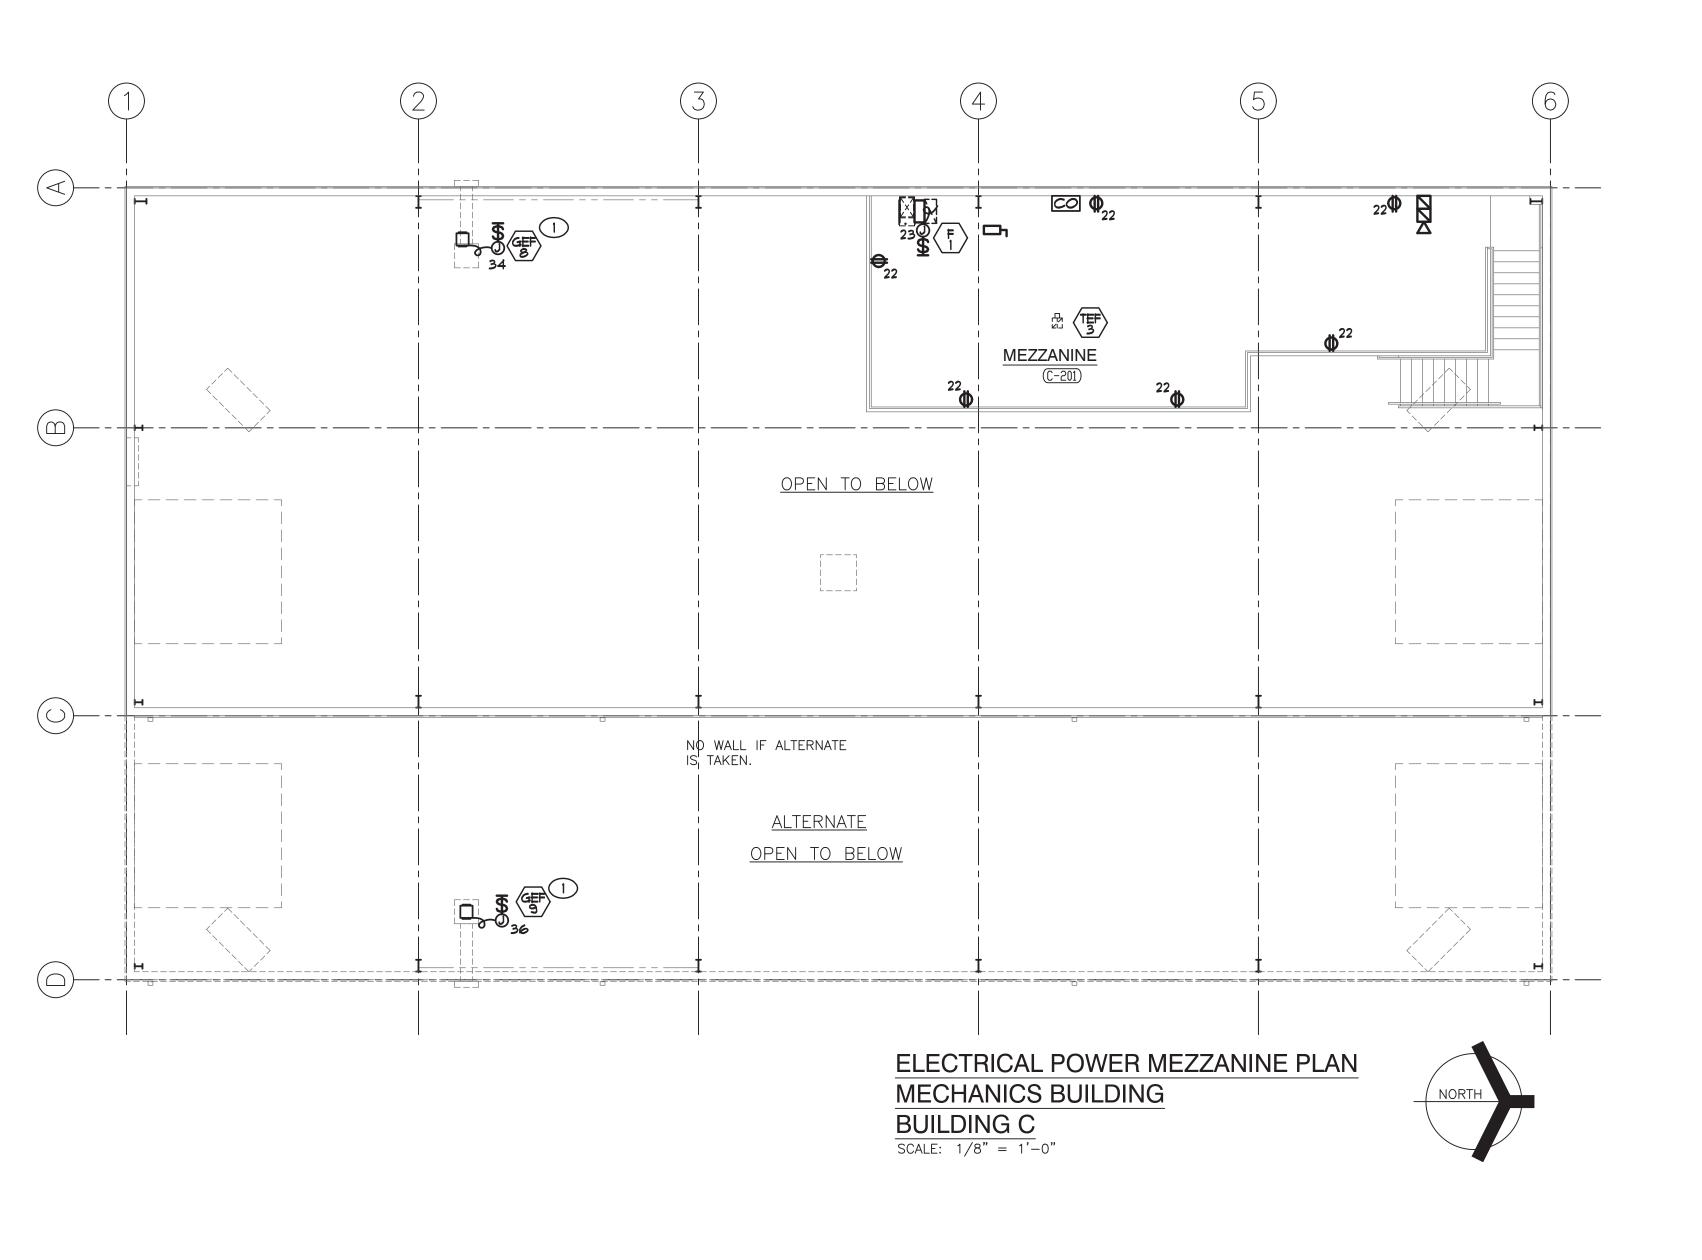

- ALL DEVICES SHALL BE CIRCUITED TO CIRCUIT INDICATED IN PANEL PP-1, UNLESS OTHERWISE NOTED.
- 2. ALL DEVICES WITH AN "E" PREFIX SHALL BE CIRCUITED TO PANEL EM.
- 3. CONTACT UTILITY COMPANY TO DETERMINE EXACT ELECTRICAL BOX LOCATION, AND ALL CONDUIT/WIRE SIZES AND ROUTING PRIOR TO CALCULATING FINAL WIRE LENGTHS AND ORDERING EQUIPMENT. VERIFY ALL

LOCATIONS IN FIELD, COMPLETE AS REQUIRED.

- 4. FOR SITE LIGHTING AND BUILDING MOUNTED EXTERIOR
  LIGHTING CIRCUITS CALCULATE FINAL WIRE LENGTHS IN
  FIELD AND PROVIDE LARGER, PROPERLY SIZED WIRE TO
  COMPLY WITH NEC VOLTAGE DROP REQUIREMENTS PRIOR
  TO ROUGH-IN, COMPLETE AS REQUIRED.
  - E. CONTRACTOR SHALL COORDINATE REQUIREMENTS FOR LIFTS AND SHOP EQUIPMENT WITH APPROVED FINAL EQUIPMENT SHOP DRAWINGS. PROVIDE ALL DISCONNECT SWITCHES, POWER CONNECTIONS, FEEDERS, CIRCUIT BREAKERS, ACCESSORIES, ETC. FOR A COMPLETE AND PROPER INSTALLATION.

#### SHEET NOTES

- 1. REFER TO MECHANICAL EQUIPMENT CONNECTION SCHEDULE AND ONE-LINE DIAGRAM FOR ADDITIONAL CIRCUITING AND WIRING INFORMATION.
- 2. MAIN SERVICE SECONDARY FEEDER REFER TO ONE-LINE

DIAGRAM FOR ADDITIONAL INFORMATION.

- 3. UTILITY PRIMARY FEED. COORDINATE WITH UTILITY COMPANY TO ROUTE CONDUIT, UNDERGROUND, TO UTILITY COMPANY ELECTRICAL BOX. VERIFY EXACT ROUTING, CONDUIT SIZE AND ELECTRICAL BOX LOCATION IN FIELD WITH UTILITY COMPANY. PROVIDE PULL BOX TO MATCH UTILITY COMPANY STANDARDS.

  AD-4
- 4. PROVIDE LOW VOLTAGE SERVICE ROUGH-IN CONDUIT. VERIFY REQUIREMENTS WITH LOW VOLTAGE TECHNOLOGY DRAWINGS.
- 5. APPROXIMATE LOCATION OF EXTERIOR MOUNTED UTILITY METER AND C/T CABINET FOR MAIN ELECTRICAL SERVICE. PROVIDE C/T CABINET AND UTILITY METER PER UTILITY COMPANY REQUIREMENTS. COORDINATE PROPER CLEARANCES, GROUNDING, MOUNTING, MOUNTING HEIGHT, LOCATION AND ANY ADDITIONAL REQUIREMENTS WITH UTILITY COMPANY STANDARDS PRIOR TO PROVIDING BID. VERIFY EXACT LOCATION IN FIELD WITH UTILITY COMPANY AND OWNER'S REPRESENTATIVE.
- 6. UTILITY COMPANY PAD MOUNTED TRANSFORMER.
  COORDINATE WITH ELECTRICAL CONTRACTOR TO FURNISH
  AND INSTALL TRANSFORMER PAD PER UTILITY COMPANY
  STANDARDS AND SPECIFICATIONS, INCLUDING GROUNDING,
  PAD SIZE, CLEARANCES, ETC.



GIBRALTAR

DESIGN

ARCHITECTURE • ENGINEERING • INTERIOR DESIGN


MILLIES

ENGINEERING GROUP

(219) 924-8400

HANOVER CSC NEW
RESOURCE CENTER AND
RELATED WORK

HANOVER COMMUNITY SCHOOL CORPORATION CEDAR LAKE, INDIANA

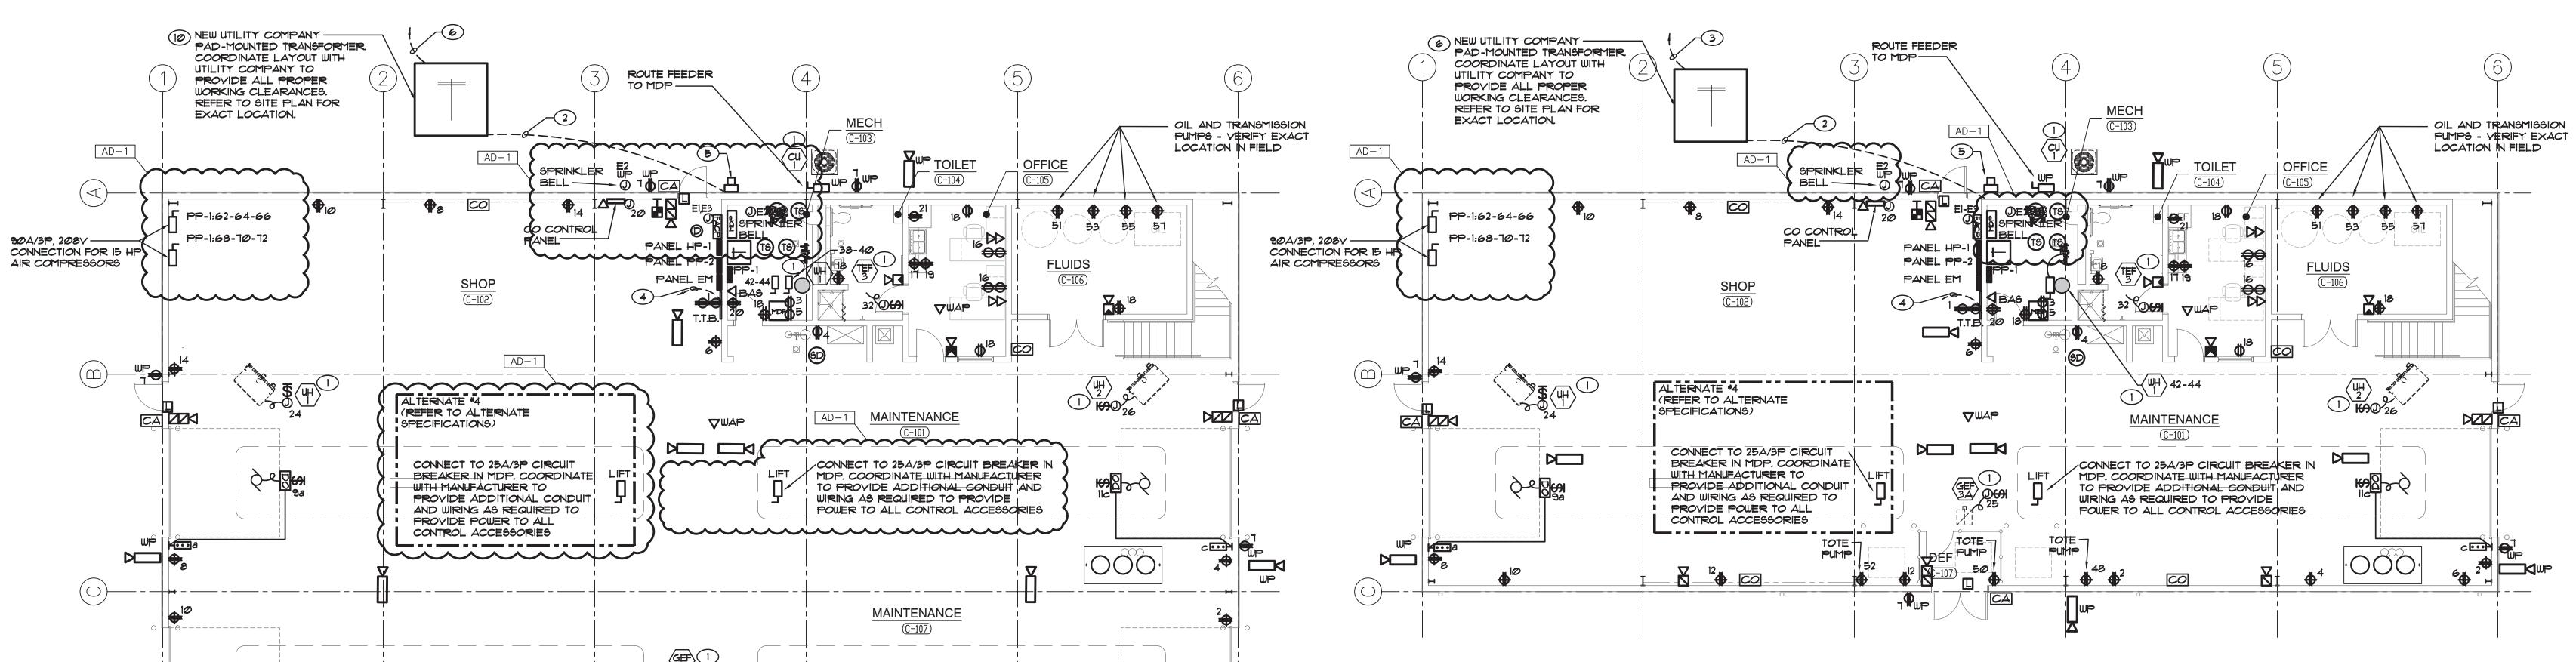

ELECTRICAL POWER FLOOR PLAN

MECHANICS BUILDING

BUILDING C - ALTERNATE #1

SCALE: 1/8" = 1'-0"



ELECTRICAL POWER FLOOR PLAN
MECHANICS BUILDING
BUILDING C - BASE BID

SCALE: 1/8" = 1'-0"



GIBRALTAR DESIGN
9102 N. Meridian St., Ste. 300
Indianapolis, IN 46260
Homepage www.GibraltarDesign.com
Email info@GibraltarDesign.com
Phone 317.580.5777 Fax 317.580.5778

PROJECT

PROJECT

20-141

DATE

05/17/21

COORDINATED BY
JC

DRAWN BY
RH/GL/LvB

CHECKED BY
DJ

COPYRIGHT NOTICE:

THE CONCEPTS, DESIGNS, PLANS, DETAILS, ETC, SHOWN ON THIS DOCUMENT ARE THE PROPERTY OF GIBRALTAR DESIGN AND WERE CREATED FOR USE ON THIS SPECIFIC PROJECT. NONE OF THIS INFORMATION SHALL BE USED BY ANY PERSON OR FIRM FOR ANY PURPOSE WITHOUT THE EXPRESS WRITTEN CONSENT OF GIBRALTAR DESIGN. THE OWNER MAY RETAIN COPIES FOR INFORMATION AND REFERENCE IN CONNECTION ONLY WITH THIS PROJECT.

REVISIONS

MARK DATE ISSUED FOR

AD-1 05/28/21 ADDENDUM NO. 1

AD-4 06/10/21 ADDENDUM NO. 4

DRAWING

ELECTRICAL POWER PLANS
MECHANICS BUILDING
BUILDING C

PROJECT
HANOVER CSC NEW RESOURCE
CENTER AND RELATED WORK

) GIBRALTAR DESIGN SHEET

EP103


- ALL DEVICES SHALL BE CIRCUITED TO CIRCUIT INDICATED IN PANEL PP-1, UNLESS OTHERWISE NOTED. CIRCUIT TAGS WITH A 'P' PREFIX SHALL BE CONNECTED TO CIRCUITS INDICATED IN PANEL PP-2.
- ALL DEVICES WITH AN "E" PREFIX SHALL BE CIRCUITED TO PANEL EM.
- CONTACT UTILITY COMPANY TO DETERMINE EXACT ELECTRICAL BOX LOCATION, AND ALL CONDUIT/WIRE SIZES AND ROUTING PRIOR TO CALCULATING FINAL WIRE LENGTHS AND ORDERING EQUIPMENT. YERIFY ALL LOCATIONS IN FIELD, COMPLETE AS REQUIRED.
- . FOR SITE LIGHTING AND BUILDING MOUNTED EXTERIOR LIGHTING CIRCUITS CALCULATE FINAL WIRE LENGTHS IN FIELD AND PROVIDE LARGER, PROPERLY SIZED WIRE TO COMPLY WITH NEC VOLTAGE DROP REQUIREMENTS PRIOR TO ROUGH-IN, COMPLETE AS REQUIRED.

### SHEET NOTES

REFER TO MECHANICAL EQUIPMENT CONNECTION SCHEDULE AND ONE-LINE DIAGRAM FOR ADDITIONAL CIRCUITING AND WIRING INFORMATION.

- NEW FEEDER FROM GENERATOR TO ATS-EM, REFER TO ONE-LINE DIAGRAM AND GENERATOR WIRING SCHEMATIC FOR ADDITIONAL INFORMATION.
- ROUTE 3 \*12 & 1 \*12 GRD. IN 1°C. FROM ENGINE BLOCK HEATER TO PANEL EM.
- ROUTE 3 \*12 & 1 \*12 GRD. IN 1°C. FROM BATTERY CHARGER TO PANEL EM.
- ROUTE ONE (1) I'C. FROM GENERATOR TO ATS-EM FOR CONTROL WIRING.
- . MAIN SERVICE SECONDARY FEEDER REFER TO ONE-LINE DIAGRAM FOR ADDITIONAL INFORMATION.
- UTILITY PRIMARY FEED. COORDINATE WITH UTILITY COMPANY TO ROUTE CONDUIT, UNDERGROUND, TO UTILITY COMPANY ELECTRICAL BOX. YERIFY EXACT ROUTING, CONDUIT SIZE AND ELECTRICAL BOX LOCATION IN FIELD WITH UTILITY COMPANY, PROVIDE PULL BOX TO MATCH UTILITY COMPANY STANDARDS. AD-4
- PROVIDE LOW YOLTAGE SERVICE ROUGH-IN CONDUIT. VERIFY REQUIREMENTS WITH LOW VOLTAGE TECHNOLOGY
- APPROXIMATE LOCATION OF EXTERIOR MOUNTED UTILITY METER FOR MAIN ELECTRICAL SERVICE. PROVIDE C/T AND UTILITY METER PER UTILITY COMPANY REQUIREMENTS. COORDINATE PROPER CLEARANCES, GROUNDING, MOUNTING, MOUNTING HEIGHT, LOCATION AND ANY ADDITIONAL REQUIREMENTS WITH UTILITY COMPANY STANDARDS PRIOR TO PROVIDING BID. VERIFY EXACT LOCATION IN FIELD WITH UTILITY COMPANY AND OWNER'S REPRESENTATIVE.
- 10. UTILITY COMPANY PAD MOUNTED TRANSFORMER. COORDINATE WITH ELECTRICAL CONTRACTOR TO FURNISH AND INSTALL TRANSFORMER PAD PER UTILITY COMPANY STANDARDS AND SPECIFICATIONS, INCLUDING GROUNDING, PAD SIZE, CLEARANCES, ETC.

FURNITURE LOCATIONS AND STUB UP INTO FLOOR BOX OR FURNITURE SYSTEM. EXTEND WIRING AND CONDUIT WITHIN FURNITURE SYSTEMS WITH FLEXIBLE CONDUIT. COORDINATE FURNITURE FEEDS WITH FURNITURE LOCATIONS AND REQUIREMENTS. ROUTE 14'C ADJACENT TO POWER CONDUIT

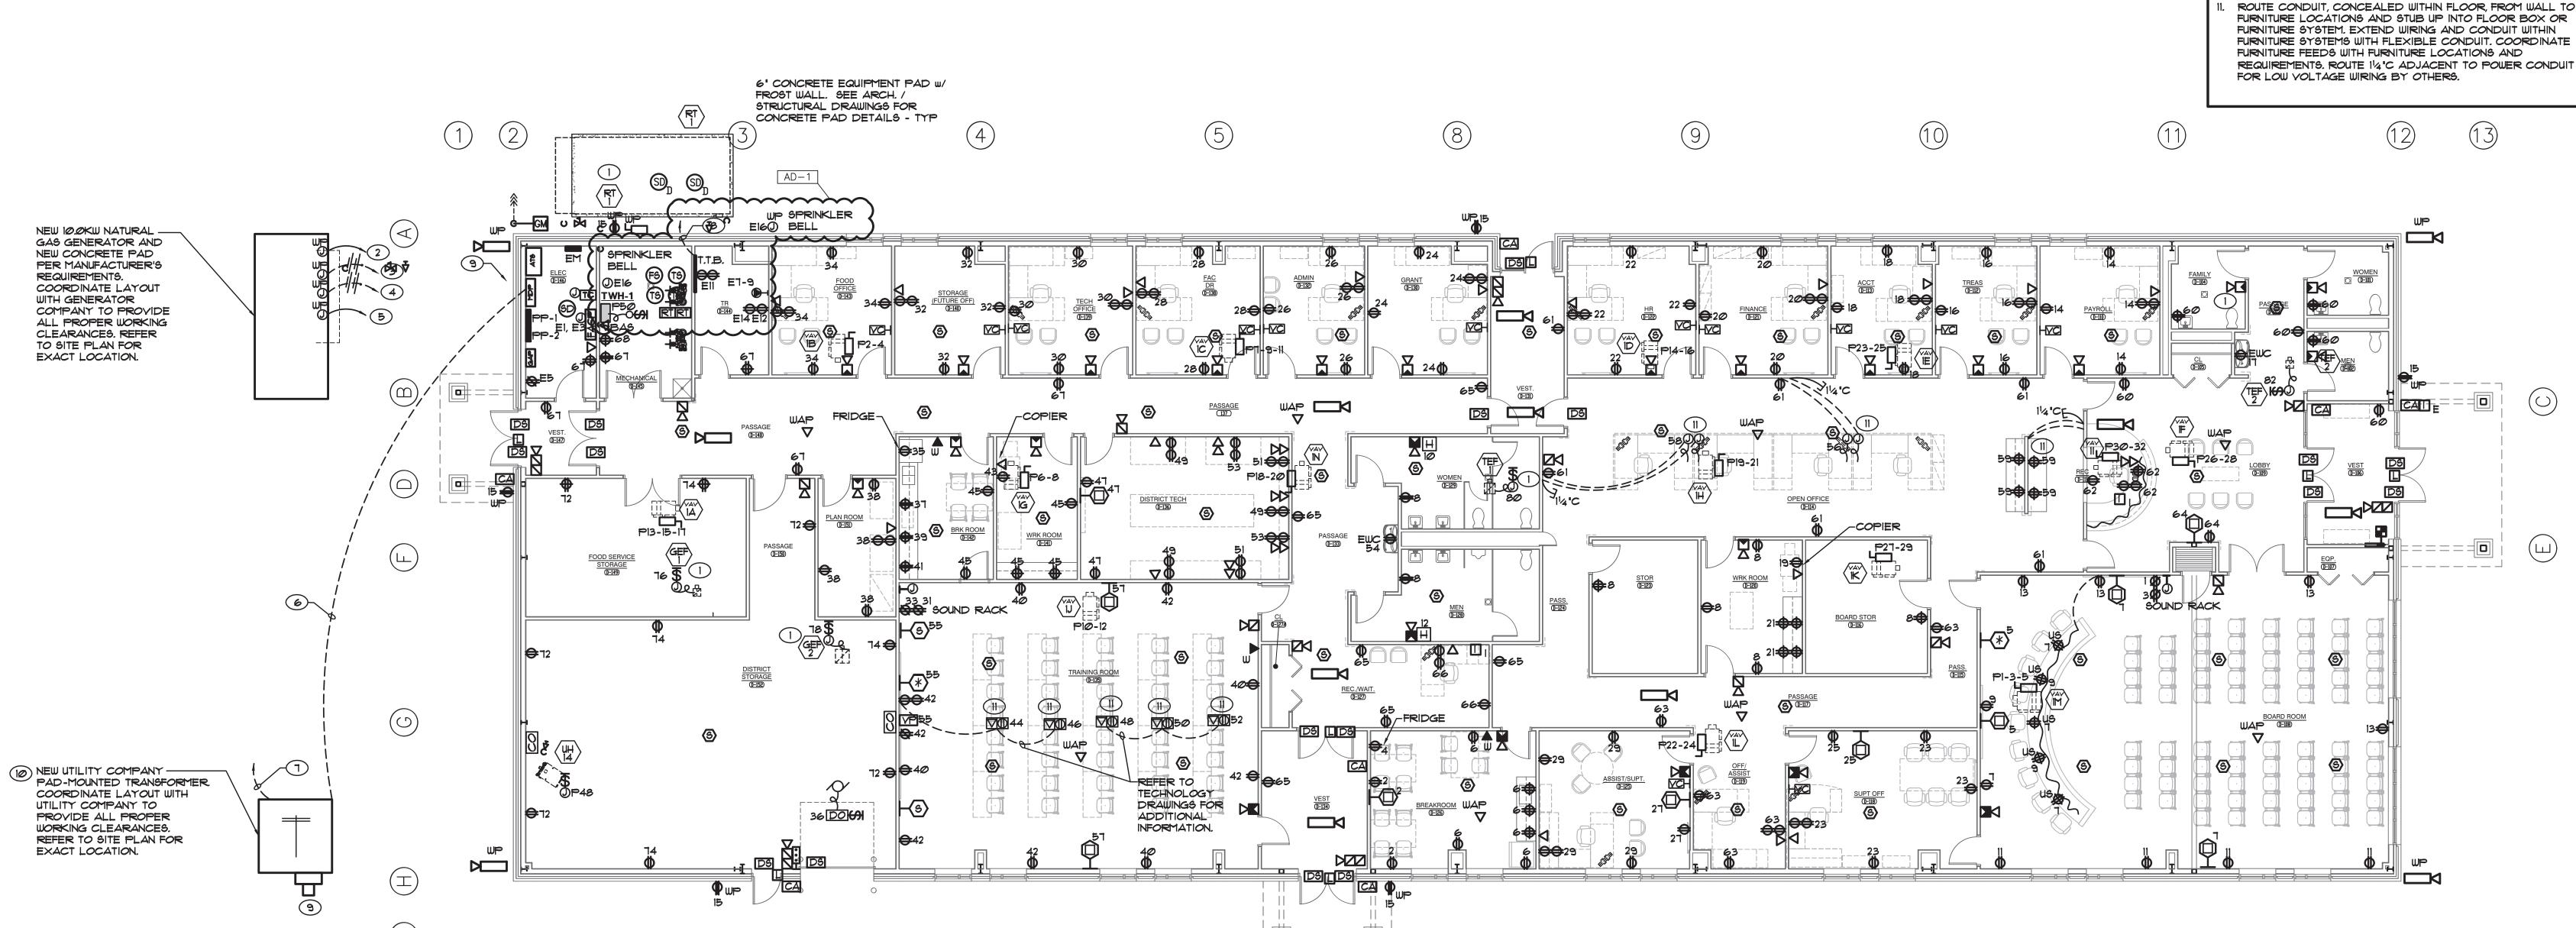

ELECTRICAL POWER FLOOR PLAN RESOURCE CENTER BUILDING D SCALE: 1/8" = 1'-0"



GIBRALTAR DESIGN

GIBRALTAR

DESIGN

ARCHITECTURE • ENGINEERING • INTERIOR DESIGN

HANOVER CSC NEW

**RELATED WORK** 

CEDAR LAKE, INDIANA

CORPORATION

RESOURCE CENTER AND

HANOVER COMMUNITY SCHOOL

PROJECT

**MILLIES** 

(219) 924-8400

9102 N. Meridian St., Ste. 300 Indianapolis, IN 46260
Homepage www.GibraltarDesign.com
Email info@GibraltarDesign.com
Phone 317.580.5777 Fax 317.580.5778

20-141 05/17/21 COORDINATED E DRAWN BY

RH/GL/LvB CHECKED BY COPYRIGHT NOTICE:

10302590

THE CONCEPTS, DESIGNS, PLANS, DETAILS, ETC, SHOWN ON THIS DOCUMENT ARE THE PROPERTY OF GIBRALTAR DESIGN AND WERE CREATED FOR USE ON THIS SPECIFIC PROJECT. NONE OF THIS INFORMATION SHALL BE USED BY ANY PERSON OR FIRM FOR ANY PURPOSE WITHOUT THE EXPRESS WRITTEN CONSENT OF GIBRALTAR DESIGN. THE OWNER MAY RETAIN COPIES FOR INFORMATION AND REFERENCE IN CONNECTION ONLY WITH THIS PROJECT. MARK DATE ISSUED FOR

AD-1 | 05/28/21 | ADDENDUM NO. 1AD-4 | 06/10/21 | ADDENDUM NO. 4

DRAWING

ELECTRICAL POWER FLOOR PLAN RESOURCE CENTER BUILDING D


HANOVER CSC NEW RESOURCE CENTER AND RELATED WORK


GIBRALTAR DESIGN SHEET

**EP104** 

#### FIXTURE GENERAL NOTES

- INTERIOR FIXTURES, EXTERIOR FIXTURES AND POLE FINISHES AND COLORS TO BE SELECTED BY ARCHITECT. THE ARCHITECT MAY, AT THEIR DISCRETION, CHOOSE A CUSTOM COLOR AT NO
- 2. PENDANT FIXTURES SPECIFIED ON THIS PROJECT SHALL BE CAREFULLY COORDINATED WITH CONTRACT DOCUMENTS AND FIXTURE MANUFACTURER AS EACH PENDANT FIXTURE IS A CUSTOM MANUFACTURED FIXTURE. PROVIDE PENDANT EMERGENCY SECTIONS AND EMERGENCY CIRCUITS AS SHOWN. COORDINATE WITH FIXTURE MANUFACTURER AND PROVIDE ADDITIONAL ACCESSORIES FOR A COMPLETE AND PROPER INSTALLATION. PROVIDE PROPER FIXTURE LENGTH, FEEDS, SINGLE AND DUAL CIRCUITING AND SUSPENSION LENGTH AS SHOWN ON DRAWINGS. PROVIDE FABRICATION DRAWINGS FOR REVIEW AS PART OF THE SHOP DRAWING SUBMITTAL PROCESS.
- 3. LED FIXTURES (LESS THAN 10000 LUMENS) SHALL BE PROVIDED WITH FACTORY INSTALLED INTEGRAL EMERGENCY BATTERY UNITS BATTERY UNITS SHALL PROVIDE A MINIMUM OF 1400 LUMENS.
- 4. FIXTURES THAT CANNOT BE PROVIDED WITH EMERGENCY BALLASTS OR FIXTURES WITH GREATER THAN 10000 LUMENS SHALL BE PROVIDED WITH EMERGENCY INVERTER (MYERS \*LY SERIES OR APPROVED EQUAL) WITH SUITABLE CAPACITY TO POWER FIXTURE FOR A MINIMUM OF 90 MINUTES PER CODE. VERIFY SIZING AND REQUIREMENTS WITH CONTRACT DOCUMENTS PRIOR TO ORDERING.
- 5. SHADED FIXTURES SHALL HAVE AN EMERGENCY SOURCE OF POWER AS SPECIFIED.
- 6. EXTERIOR LIGHTING POLES SHALL BE PROVIDED WITH STRAIGHT SQUARE STEEL POLES WITH CAST BASE COVERS AND VIBRATION DAMPENERS. THE POLES SHALL BE SIZED PROPERLY TO SUPPORT FIXTURE WEIGHT AT 100 MPH WIND WITH A 1.3 GUST FACTOR, MINIMUM POLE SIZE TO BE 5" SQUARE, PROVIDE ADDITIONAL MOUNTING, ACCESSORIES AS REQUIRED FOR A COMPLETE AND PROPER INSTALLATION.
- 1. FOR EXTERIOR POLE MOUNTED LIGHTING, PROVIDE FACTORY MOUNTED HOUSE SIDE SHIELDS INTEGRAL TO THE FIXTURE AS SPECIFIED. ADDITIONALLY, PROVIDE CUSTOM FABRICATED POLE MOUNTED HOUSE SIDE SHIELDING AS REQUIRED TO CONTROL LIGHT TRESPASS AND COMPLY WITH LOCAL REQUIREMENTS.
- 8. FIXTURES WITH EMERGENCY BATTERIES SHALL BE PROVIDED WITH CONSTANT HOT SENSING WIRE SO THAT FIXTURE CAN BE SWITCHED ON AND OFF WITHOUT ACTIVATING EMERGENCY BALLAST. UPON LOSS OF POWER, THE FIXTURE SHALL BE ILLUMINATED FOR A MINIMUM OF 90 MINUTES REGARDLESS OF THE LIGHT SWITCH POSITION. PROVIDE TEST SWITCH AND CHARGING INDICATOR FOR EMERGENCY BATTERY AS SPECIFIED.
- 9. CAREFULLY COORDINATE MOUNTING REQUIREMENTS FOR FIXTURES WITH CONTRACT DOCUMENTS AND FIXTURE MANUFACTURER. PROVIDE APPROPRIATE MOUNTING FRAMES FOR LAY-IN OR GYPSUM CEILINGS. VERIFY CEILING REQUIREMENTS WITH FINAL ARCHITECTURAL REFLECTED CEILING PLAN.
- 10. VERIFY FIXTURE MOUNTING HEIGHTS WITH ARCHITECT PRIOR TO ROUGH-IN.
- 11. PROVIDE CUSTOM ANTI-SWAY BRACING FOR PENDANT TO ELIMINATE PENDANT MOVEMENT DUE TO AIR MOVEMENT OR ENVIRONMENTAL CAUSES.
- 12. COORDINATE LOCATIONS OF INTERIOR AND EXTERIOR LIGHTING FIXTURES WITH FINAL ARCHITECTURAL DRAWINGS. FIXTURES THAT ARE NOT INSTALLED IN THE CORRECT LOCATION SHALL BE RELOCATED AND REINSTALLED IN THE CORRECT LOCATION AT NO ADDITIONAL CHARGE.
- 13. FIXTURES SHALL BE CAREFULLY COORDINATED WITH MANUFACTURER TO DELIVER THE SPECIFIED PRODUCT IN SUFFICIENT TIME TO MEET PROJECT DEADLINES. EQUIPMENT DELIVERY LEAD TIME SHALL NOT BE HELD AS A VALID REASON FOR REQUESTING LUMINAIRE SUBSTITUTION UNLESS LUMINAIRE LEAD TIME FROM SPECIFIED MANUFACTURER IS IN EXCESS OF 14 WEEKS. IT SHALL BE THE SOLE RESPONSIBILITY OF THE ELECTRICAL CONTRACTOR TO DETERMINE NECESSARY EQUIPMENT LEAD TIMES, DELIVER SUBMITTALS FOR REVIEW IN A TIMELY FASHION, AND PLACE ORDERS ACCORDINGLY TO ENSURE TIMELY DELIVERY.
- 14. EVALUATION OF APPROVED EQUALS SHALL BE AT THE SOLE DISCRETION OF THE ARCHITECT AND ENGINEER. IF THE PRODUCT SUBMITTED DURING THE REVIEW PROCESS IS NOT JUDGED AS AN EQUAL BY THE REVIEWING ENGINEER, THE CONTRACTOR SHALL PROVIDE THE PRODUCT SPECIFIED.
- 15. CAREFULLY COORDINATE VOLTAGES OF FIXTURES PRIOR TO ORDERING FIXTURES.
- 16. APPROVED EQUALS WILL BE CONSIDERED FROM THE FOLLOWING VENDORS: KSA LIGHTING (630.307.6955), FORCE CHICAGO (312.986.1515) OR PG ENLIGHTEN (847.228.1199).
- 17. CAREFULLY VERIFY COLOR TEMPERATURE OF FIXTURES WITH ARCHITECT PRIOR TO ORDERING.

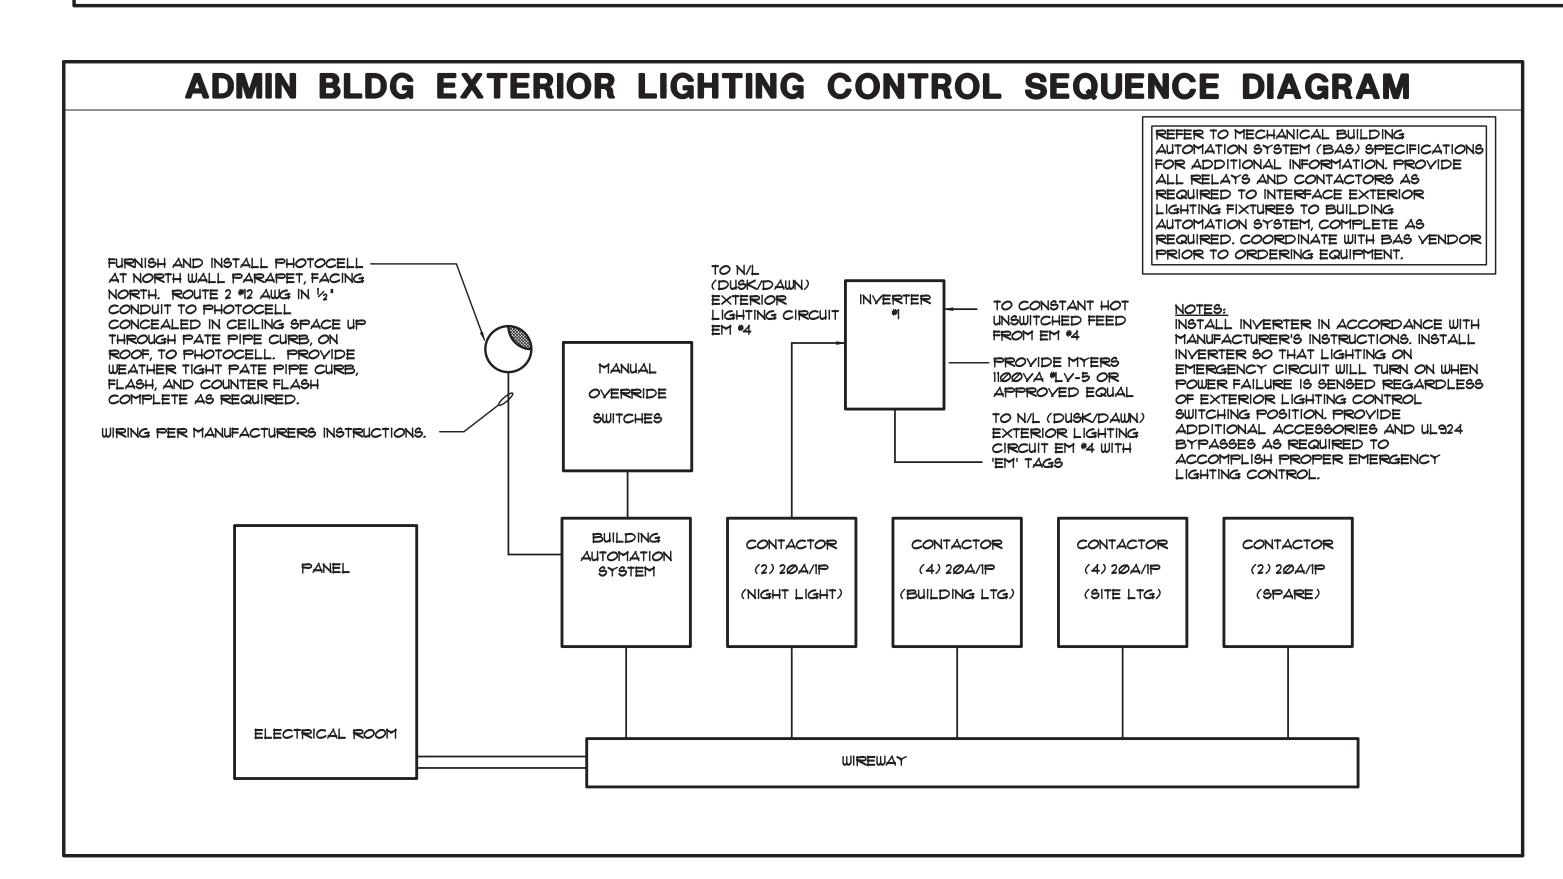

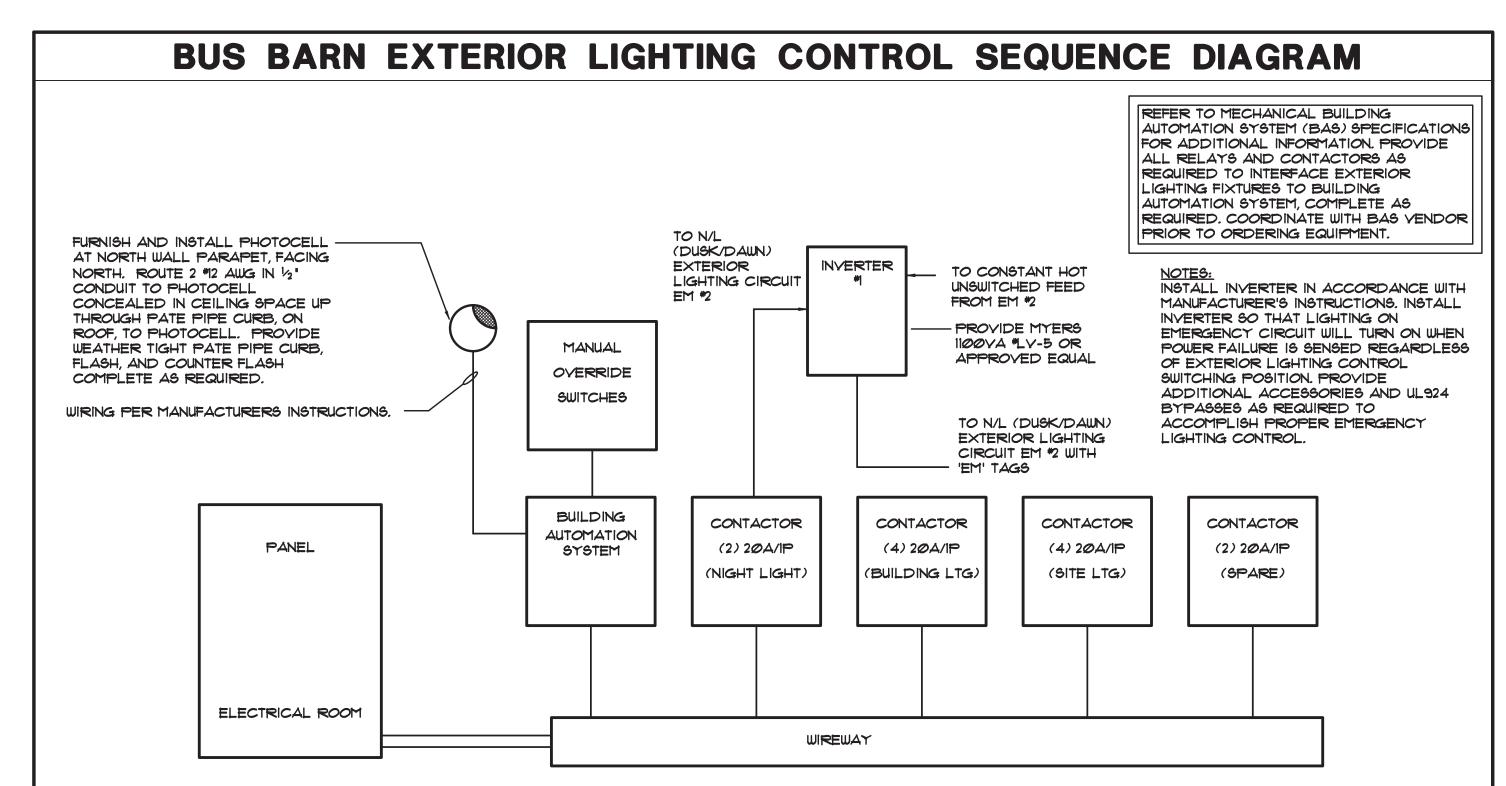

		INTERIO	OR LIGHTING LUMINAIRE	ESCH	EDULE		
TAG	SYMBOL	DESCRIPTION	MANUFACTURER SERIES  OR CATALOG NUMBER	VOLTAGE/ BALLAST	LAMPS/CROSS SECTION	MOUNTING	REMARKS
ДД		2' × 4' LED DIRECT/INDIRECT FIXTURE	LITHONIA #2YTL4-40L-ADP-EZI-LP840 COLUMBIA #LCAT24-40LW-G-EDI-U METALUX #24CZ2-40-UNV-L840-CDI-U	277 YOLT Ø-1ØY DIM - -	LED 4000K MAX 32 W MIN 4000 LM	RECESSED LAY-IN	- - - -
ДДІ		2' × 4' LED DIRECT/INDIRECT FIXTURE	LITHONIA *2YTL4-48L-ADP-EZI-LP840 COLUMBIA *LCAT24-40ML-G-EDI-U METALUX *24CZ2-50-UNY-L840-CDI-U	277 YOLT Ø-1ØY DIM - -	LED 4000K MAX 39 W MIN 4800 LM	RECESSED LAY-IN	- - - -
AA2		2' X 4' LED DIRECT/INDIRECT FIXTURE	LITHONIA *2VTL4-60L-ADP-EZI-LP840 COLUMBIA *LCAT24-40HL-G-EDI-U METALUX *24CZ2-60-UNY-L840-CDI-U	277 VOLT Ø-1ØV DIM - -	LED 4000K MAX 48 W MIN 6000 LM	RECESSED LAY-IN	- - -
AB		2' X 2' LED DIRECT/INDIRECT FIXTURE	LITHONIA *2VTL2-48L-ADP-EZI-LP840 COLUMBIA *LCAT22-40LY-G-EDI-U METALUX *22CZ2-50-UNY-L840-CDI-U	277 VOLT Ø-1ØV DIM - -	LED 4000K MAX 39 W MIN 4800 LM	RECESSED LAY-IN	- - - -
AC	0	2' X 4' LED KITCHEN FIXTURE	LITHONIA *2GTL4-60L-EZI-LP840 COLUMBIA *LJT24-40HLG-FSAI2-EU METALUX *24GRLED-LD5-64-FI-UNV-L840-CDI-U	277 YOLT Ø-1ØY DIM -	LED 4000K MAX 49 W MN-6000 LM	RECESSED LAY-IN	- - -
AD		2' × 4' LED DIRECT/INDIRECT FIXTURE	LITHONIA *2VTL4-85L-ADP-EZI-LP840 OR APPROVED EQUAL BY COLUMBIA OR METALUX	120/277 VOLT 0-10V DIM -	LED 4000K MAX 68 W MIN 8500 LM	RECESSED LAY-IN	- - - -
CA	°	FINISH TO BE SELECTED BY ARCHITECT	LITHONIA LENG 40-15-LOG XX-LSG MYOLT EZIV LITEISTRY #LTR-6RD-H-5L15L-DM1-LTR-6RD-T-5L-40K8-MD-5/B24	9-10Y DIM	4000K MAX 18 W	GRID/GYPSUM	WITH ARCHITECT
PA	<b>₩</b>	4', LED INDUSTRIAL FIXTURE	LITHONIA *CLX-L48-5000LM-SEF-RDL-MYOLT-EZI-40K-80CRI COLUMBIA *MPS4-40HL-C-W-EDI-U/MPSWG4/CSHC METALUX *4SNLED-LD5-SLW-52SL-UNY-L840-CDI-U/WG-SNF-4FT/AYC-CHAIN/SET	277 VOLT Ø-IØV DIM -	LED 4000 K MIN 5000 LM MAX 36 W	SUSPENDED 13'-0' AFF	-COORD LOCATIONS WITH DUCTWORK & PIPING
PAI	<b>:</b>	4', LED INDUSTRIAL FIXTURE WITH WIREGUARD AND SAFETY CHAINS	LITHONIA *CLX-L48-10000LM-SEF-RDL-MVOLT-EZI-40K-80CRI OR APPROVED EQUAL BY COLUMBIA OR METALUX	120/277 VOLT 0-10V DIM -	LED 4000 K MIN 10000 LM MAX 74 W	SUSPENDED CHAIN	-COORD LOCATIONS WITH DUCTWORK & PIPING
PA2	₩	4', LED INDUSTRIAL FIXTURE WITH WIREGUARD AND SAFETY CHAINS	LITHONIA *CLX-L48-7000LM-SEF-RDL-MVOLT-EZI-40K-80CRI OR APPROVED EQUAL BY COLUMBIA OR METALUX	120/277 VOLT 0-10V DIM	LED 4000 K MIN 7000 LM MAX 50 W	SUSPENDED CHAIN	-COORD LOCATIONS WITH DUCTWORK & PIPING
PB	₩ <b>₩</b>	HIGH RESCOURE WET LOCATION SPECIAL ENVIRONMENT FIXTURE FOR BUS WASH AREA	LITHONIA JEHE-124-ROQOLM-ACL-MQ-MVOLT-GZIO- 35K-80CRI-XX-XX OR APPROVED EQUAL	MVALI	~~~	~~~	~~~~~
PC		LED 4' CONTINUOUS DIRECT/INDIRECT PENDANT FIXTURE	AXIS LIGHTING: #TB4DILED-400-1000-80-40-50-50-XX-XX-UNV-DP-1-XX OR APPROVED EQUAL BY NULITE OR LUMENWERX	277 VOLT Ø-1ØV DIM - -	LED 4000 K MIN 1400LM MAX 12W/ft	SUSPENDED @9'-@' AFF.	-VERIFY FINISH WITH ARCHITECT. -COORDINATE RUN LENGTHS WITH DRAWINGS
PCI	<b>——</b>	LED 4' CONTINUOUS DIRECT/INDIRECT PENDANT FIXTURE	AXIS LIGHTING  *TB4ILED-800-0-80-40-SO-SO-XX-XX-UNV-DP-1-XX OR APPROVED EQUAL BY NULITE OR LUMENWERX	277 YOLT Ø-10Y DIM - -	LED 4000 K MIN 800LM MAX 30W/ft	SUSPENDED #9'-Ø" AFF.	-VERIFY FINISH WITH ARCHITECT. -COORDINATE RUN LENGTHS WITH DRAWINGS
PD	<b>:</b>	LED HIGH BAY FIXTURE	LITHONIA *BE-L48-22000LM-ATC-MD-MVOLT-GZI0-40K-80CRI-WGX-X-X OR APPROVED EQUAL BY METALUX OR COLUMBIA	120/277 VOLT	LED 4000 K MIN 22000LM MAX 165W	PENDANT MOUNTED	-PROVIDE WIRE GUARD PROTECTION -PROVIDE RIGID MOUNTING -
~~		AINGLE FACE EXITE GREEN		NEARTHOUT		CELLING	FURNISH WITH ARROWS AS REQ'D BY CODE
×A	<u> </u>	DOUBLE FACE EXIT 6" GREEN	DUAL LITE *SEDG SERIES SURE LITES *CX6-1-G  LITHONIA LE SERIES	10.0 0000 1.70	MAX 5W	WALL	REQ'D BY CODE -PROVIDE WIREGUARD WHERE INDICATED ON PLANS -FURNISH WITH ARROWS AS
XB	1€1	LETTERS CAST ALUM BODY, AC ONLY		120/277 VOLT	LED. MAX 5W	CEILING/ WALL	REQ'D BY CODE -PROVIDE WIREGUARD WHERE INDICATED ON PLANS
NL		CONSTANT HOT, UNSWITCHED NIGHT LIGHT FIXTURE					
EM		FIXTURE ON EMERGENCY CIRCUIT WITH 90 MINUTE, HIGH	FIXTURES LESS THAN 10000 LM: BODINE FACTORY INSTALLED BATTERY OR, AT CONTRACTOR'S DISCRETION, MYERS LV SERIES INVERTER (SIZE AND QUANTITY AS REQUIRED)  FIXTURES GREATER THAN 10000LM: MYERS LV SERIES INVERTER (SIZE AND QUANTITY AS REQUIRED)	12Ø/277 VOLT	-	IN FIXTURE/ REMOTE	-PROVIDE TEST SWITCH AND CHARGING INDICATOR -INTEGRAL BATTERIES NOT ALLOWED IN FIXTURES WITH GREATER THAN 10000 LUMENS

			RIOR LIGHTING LUMII				
AG	SYMBOL	DESCRIPTION	MANUFACTURER SERIES OR CATALOG NUMBER	VOLTAGE/ BALLAST	LAMPS/CROSS SECTION	MOUNTING	REMARKS
<b>E</b> A		EXTERIOR LED WALLPACK	LITHONIA *MRW-LED-PI-SR3-40K-MYOLT HUBBELL *QSPI-12L20-4KT-3-UNY-XX MCGRAW EDISON *165 SERIES	MVOLT - -	LED 2244 LM 20 W 4000K	WALL MTD 10'-0' AFG OR AS NOTED ON DWGS.	-
E∆1		EXTERIOR LED WALLPACK	LITHONIA *MRW-LED-P3-6R3-40K-MVOLT HUBBELL *Q6P2-24L50-4K7-4-UNV-XX MCGRAW EDISON *166 SERIES	MVOLT - -	LED 4486 LM 40 W 4000K	WALL MTD 10'-0" AFG OR AS NOTED ON DWGS.	-
A2		EXTERIOR LED WALLPACK	LITHONIA *MRW-LED-P4-SR4-40K-MVOLT HUBBELL *QSP2-24L70-4K7-4-UNV-XX MCGRAW EDISON *199 SERIES	MVOLT - -	LED 5991 LM 61 W 4000K	WALL MTD 9'-0' AFG	-
В	•	EXTERIOR LED FIXTURE MOUNTED ON A STRAIGHT, ROUND 30' ALUMINUM POLE	LITHONIA *OMERO MR2-LED-60C-1000-40K-T3M KIM *UR28-96L-170-4K7-3-480-A34-XX/RSA30 MCGRAW EDISON *TOP TIER POST TOP	MVOLT (480V) -	LED 21418 LM 206 W 4000K	POLE MTD 30'-0' AFG -	-
BI	•-	EXTERIOR LED FIXTURE MOUNTED ON A STRAIGHT, ROUND 30' ALUMINUM POLE	LITHONIA *OMERO MR2-LED-60C-1000-40K-T5M KIM *UR28-96L-170-4K7-5-480-A34-XX/RSA30 MCGRAW EDISON *TOP TIER POST TOP	MVOLT (480V) -	LED 21647 LM 206 W 4000K	POLE MTD 30'-0" AFG -	-
B2	-		LITHONIA *OMERO MR2-LED-60C-1000-40K-T4M KIM *UR28-96L-170-4K7-4-480-A34-XX/RSA30 MCGRAW EDISON *TOP TIER POST TOP	MVOLT (480V) -	LED 21282 LM 206 W 4000K	POLE MTD 30'-0" AFG -	-
B3		EXTERIOR LED FIXTURE MOUNTED ON A STRAIGHT, ROUND 30' ALUMINUM POLE	LITHONIA *OMERO-MR2-LED-60C-1000-40K-T4M-HS KIM *UR28-96L-170-4K7-4-480-A34-XX/RSA30 MCGRAW EDISON *TOP TIER POST TOP	MYOLT (48ØY) -	LED 21282 LM 206 W 4000K	POLE MTD 30'-0' AFG -	-
B4	•	EXTERIOR LED FIXTURE MOUNTED ON A STRAIGHT, ROUND 30' ALUMINUM POLE	LITHONIA *OMERO MR2-LED-60C-1000-40K-T2M KIM *UR28-96L-170-4K7-2-480-A34-XX/RSA30 MCGRAW EDISON *TOP TIER POST TOP	MVOLT (480V) -	LED 20224 LM 206 W 4000K	POLE MTD 30'-0" AFG -	-
EC	•-	EXTERIOR LED FIXTURE MOUNTED ON A STRAIGHT, ROUND 15' ALUMINUM POLE	LITHONIA *OMERO-MRP-LED-42C-530-40K-5R3-MYOLT KIM *UR20-28L-70-4K7-3-UNY-FM33-XX/RSAIS INVUE *MESA LED	MVOLT (480V) -	LED 6581 LM 75 W 4000K	POLE MTD 15'-Ø' AFG -	-
ici	•—	EXTERIOR LED FIXTURE MOUNTED ON A STRAIGHT, ROUND 15' ALUMINUM POLE	LITHONIA *OMERO-MRP-LED-42C-530-40K-5R2-MVOLT KIM *UR20-28L-70-4K7-2-UNV-FM33-XX/RSAIS INVUE *MESA LED	MVOLT (480V) -	LED 6605 LM 75 W 4000K	POLE MTD 15'-Ø' AFG -	-
ED (	0	FINISH TO BE SELECTED BY ARCHITECT	LITHONIA *LDN6-35-15-LO6-XX-LSS-MVOLT-EZI LITEISTRY*LTR-GRD-H-SLI5L-DMI-LTR-GRD-T-SL -40K8-MD-S HALO *HCGI5DOID / HMG12840 / GIMDHUF	120/277 VOLT 0-10V DIM	LED 4000K MAX 18 W MIN 1500 LM	RECESSED CANOPY MOUNTED	-VERIFY TRIM FIN WITH ARCHITECT
E	•		LITHONIA *D\$XF3-LED-6-P1-4ØK-N\$P-MVOLT-XX-XX -FV-VG-XX OR APPROVED EQUAL	MVOLT - -	LED 4000K MIN 11816LM MAX 101W	MTD ON CONCRETE PAD	-STANDARD COL TO BE SELECTED BYARCHITECT -PROVIDE MTG ACCESS AS REQUIRED

AD-4



**GIBRALTAR** DESIGN

ARCHITECTURE ● ENGINEERING ● INTERIOR DESIGN

HANOVER CSC NEW RESOURCE CENTER AND RELATED WORK

HANOVER COMMUNITY SCHOOL CORPORATION CEDAR LAKE, INDIANA

AD-1

GIBRALTAR DESIGN 9102 N. Meridian St., Ste. 300 ndianapolis, IN 46260 Homepage www.GibraltarDesign.com

Email info@GibraltarDesign.com

Phone 317.580.5777 Fax 317.580.577 20-141 05/17/21 COORDINATED

DRAWN BY RH/GL/LvB CHECKED BY

10302590 

COPYRIGHT NOTICE: THE CONCEPTS, DESIGNS, PLANS, DETAILS, ETC, SHOWN ON THIS DOCUMENT ARE THE PROPERTY OF GIBRALTAR DESIGN AND WERE CREATED FOR USE ON THIS SPECIFIC PROJECT. NONE OF THIS INFORMATION SHALL BE USED BY ANY PERSON OR FIRM FOR ANY PURPOSE WITHOUT THE EXPRESS WRITTEN CONSENT OF GIBRALTAR DESIGN. THE OWNER MAY RETAIN COPIES FOR NFORMATION AND REFERENCE IN CONNECTION ONLY WITH TH

MARK DATE ISSUED FOR AD-1 05/28/21 ADDENDUM NO. AD-4 | 06/10/21 | ADDENDUM NO. 4


DRAWING


ELECTRICAL DETAILS & **DIAGRAMS** 


HANOVER CSC NEW RESOURCE CENTER AND RELATED WORK

© GIBRALTAR DESIGN SHEET

E-502

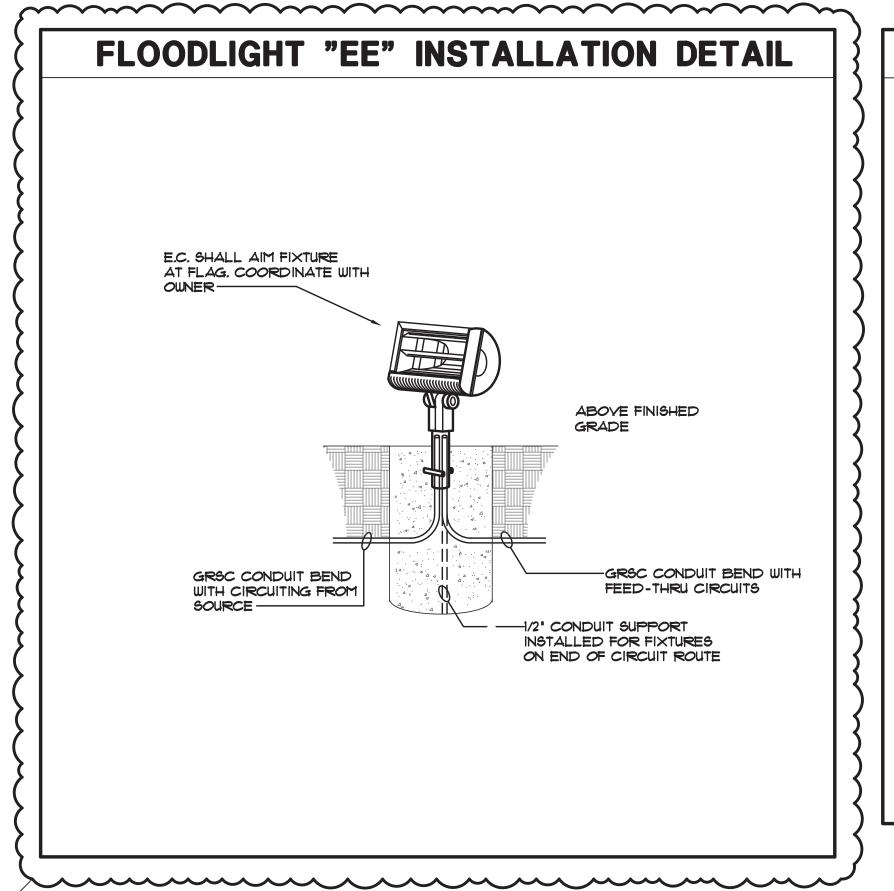

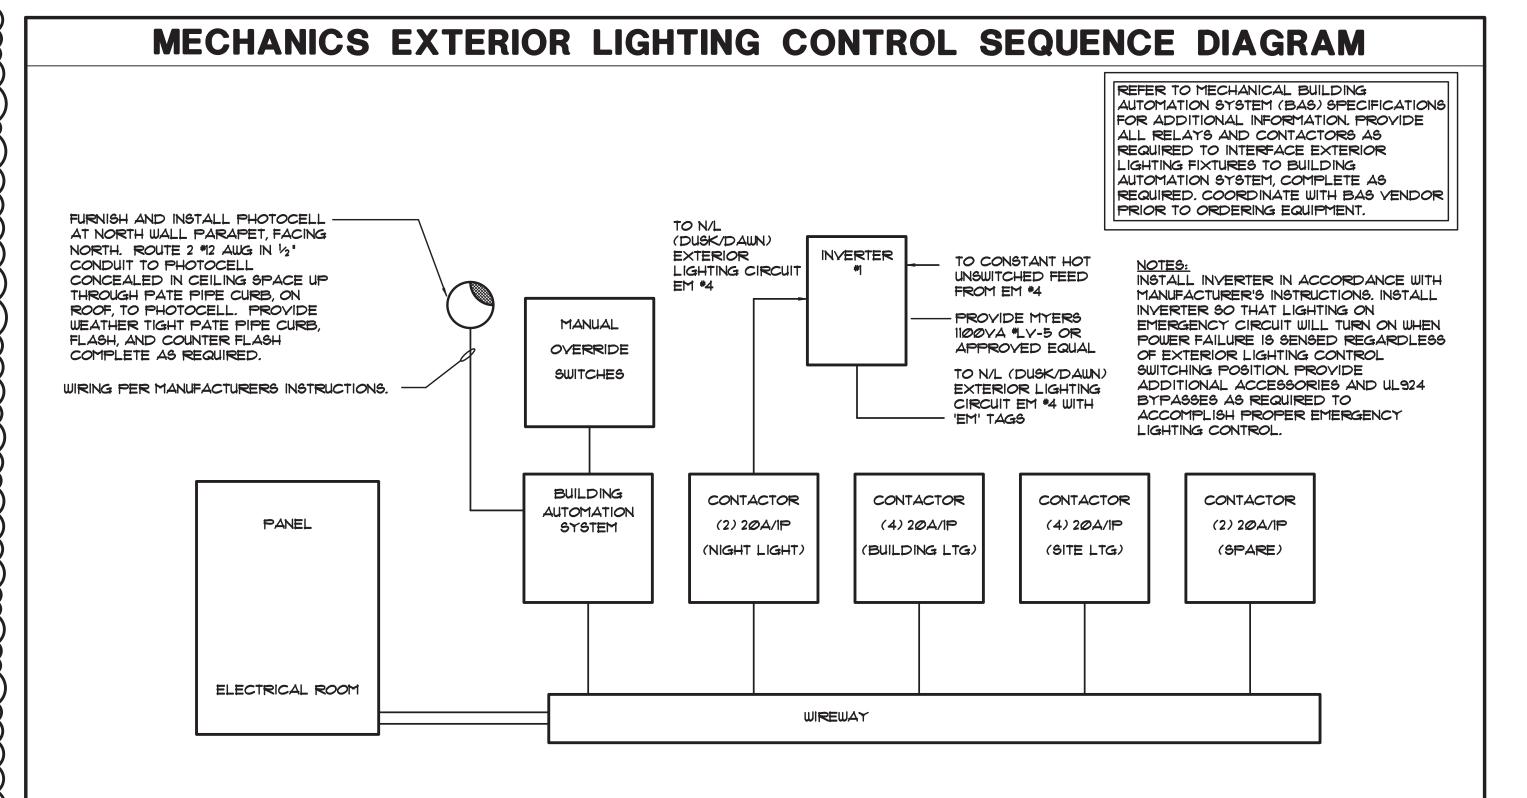

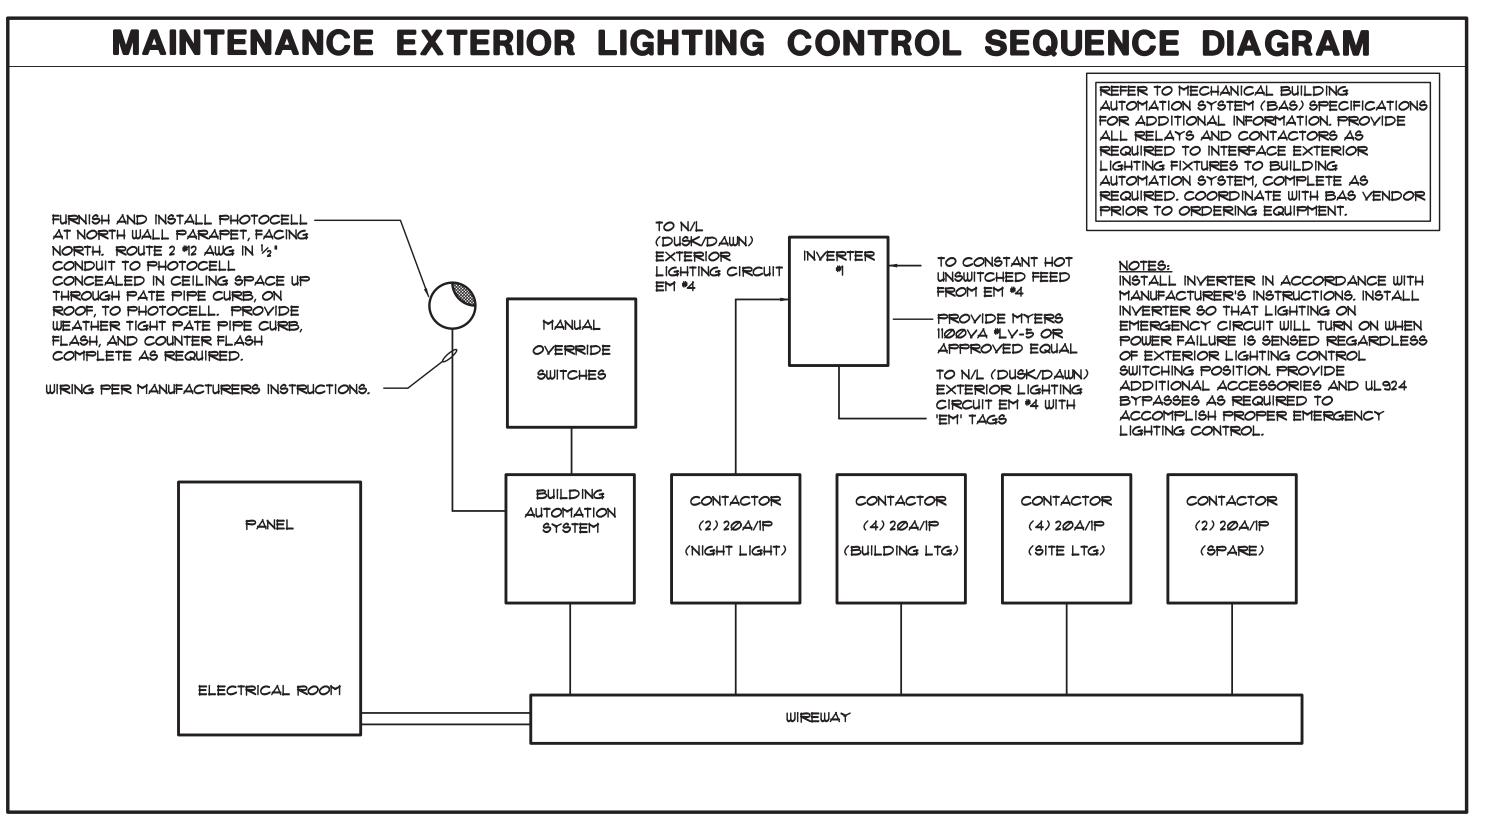



DESIGN

ARCHITECTURE • ENGINEERING • INTERIOR DESIGN



HANOVER CSC NEW
RESOURCE CENTER AND
RELATED WORK

HANOVER COMMUNITY SCHOOL CORPORATION CEDAR LAKE, INDIANA

GIBRALTAR DESIGN
9102 N. Meridian St., Ste. 300

Indianapolis, IN 46260 Homepage www.GibraltarDesign.com Email info@GibraltarDesign.com Phone 317.580.5777 Fax 317.580.5778

PROJECT
20-141
DATE
05/17/21
COORDINATED BY
JC
DRAWN BY
RH/GL/LvB

CHECKED BY

COPYRIGHT NOTICE:

THE CONCEPTS, DESIGNS, PLANS, DETAILS, ETC, SHOWN ON THIS DOCUMENT ARE THE PROPERTY OF GIBRALTAR DESIGN AND WERE CREATED FOR USE ON THIS SPECIFIC PROJECT. NONE OF THIS INFORMATION SHALL BE USED BY ANY PERSON OR FIRM FOR ANY PURPOSE WITHOUT THE EXPRESS WRITTEN CONSENT OF GIBRALTAR DESIGN. THE OWNER MAY RETAIN COPIES FOR INFORMATION AND REFERENCE IN CONNECTION ONLY WITH THIS PROJECT.

TREVISIONS							
	DATE	ISSUED FOR					
AD-4	06/10/21	ADDENDUM NO. 4					


DRAWING
ELECTRICAL DIAGRAMS

PROJECT
HANOVER CSC NEW RESOURCE
CENTER AND RELATED WORK

© GIBRALTAR DESIGN SHEET

E-505



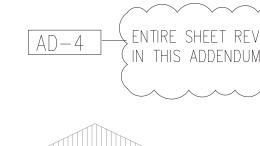

NORTH

NOT TO SCALE

AD-4 ENTIRE SHEET REVISED IN THIS ADDENDUM 

SITE PLAN PROJECT HANOVER CSC NEW RESOURCE

TELECOMMUNICATIONS

HANOVER CSC NEW

RELATED WORK

RESOURCE CENTER AND

HANOVER COMMUNITY SCHOOL CORPORATION CEDAR LAKE, INDIANA

GIBRALTAR DESIGN

Phone 317.580.5777 Fax 317.580.5778

THE CONCEPTS, DESIGNS, PLANS, DETAILS, ETC, SHOWN ON THIS DOCUMENT ARE THE PROPERTY OF GIBRALTAR DESIGN AND WERE CREATED FOR USE ON THIS SPECIFIC PROJECT. NONE OF THIS INFORMATION SHALL BE USED BY ANY PERSON OR FIRM FOR ANY PURPOSE WITHOUT THE EXPRESS WRITTEN CONSENT OF GIBRALTAR DESIGN. THE OWNER MAY RETAIN COPIES FOR INFORMATION AND REFERENCE IN CONNECTION ONLY WITH THIS PROJECT.

MARK DATE ISSUED FOR AD-4 6/10/21 ADDENDUM 4

Brian K Scott BICSI ID#114038.

EXPIRES 12-31-21. V. Beglit .. V

9102 N. Meridian St., Ste. 300 Indianapolis, IN 46260

PROJECT

DRAWN BY


CHECKED BY


COPYRIGHT NOTICE:


Homepage www.GibraltarDesign.com Email info@GibraltarDesign.com

© GIBRALTAR DESIGN SHEET


CENTER AND RELATED WORK

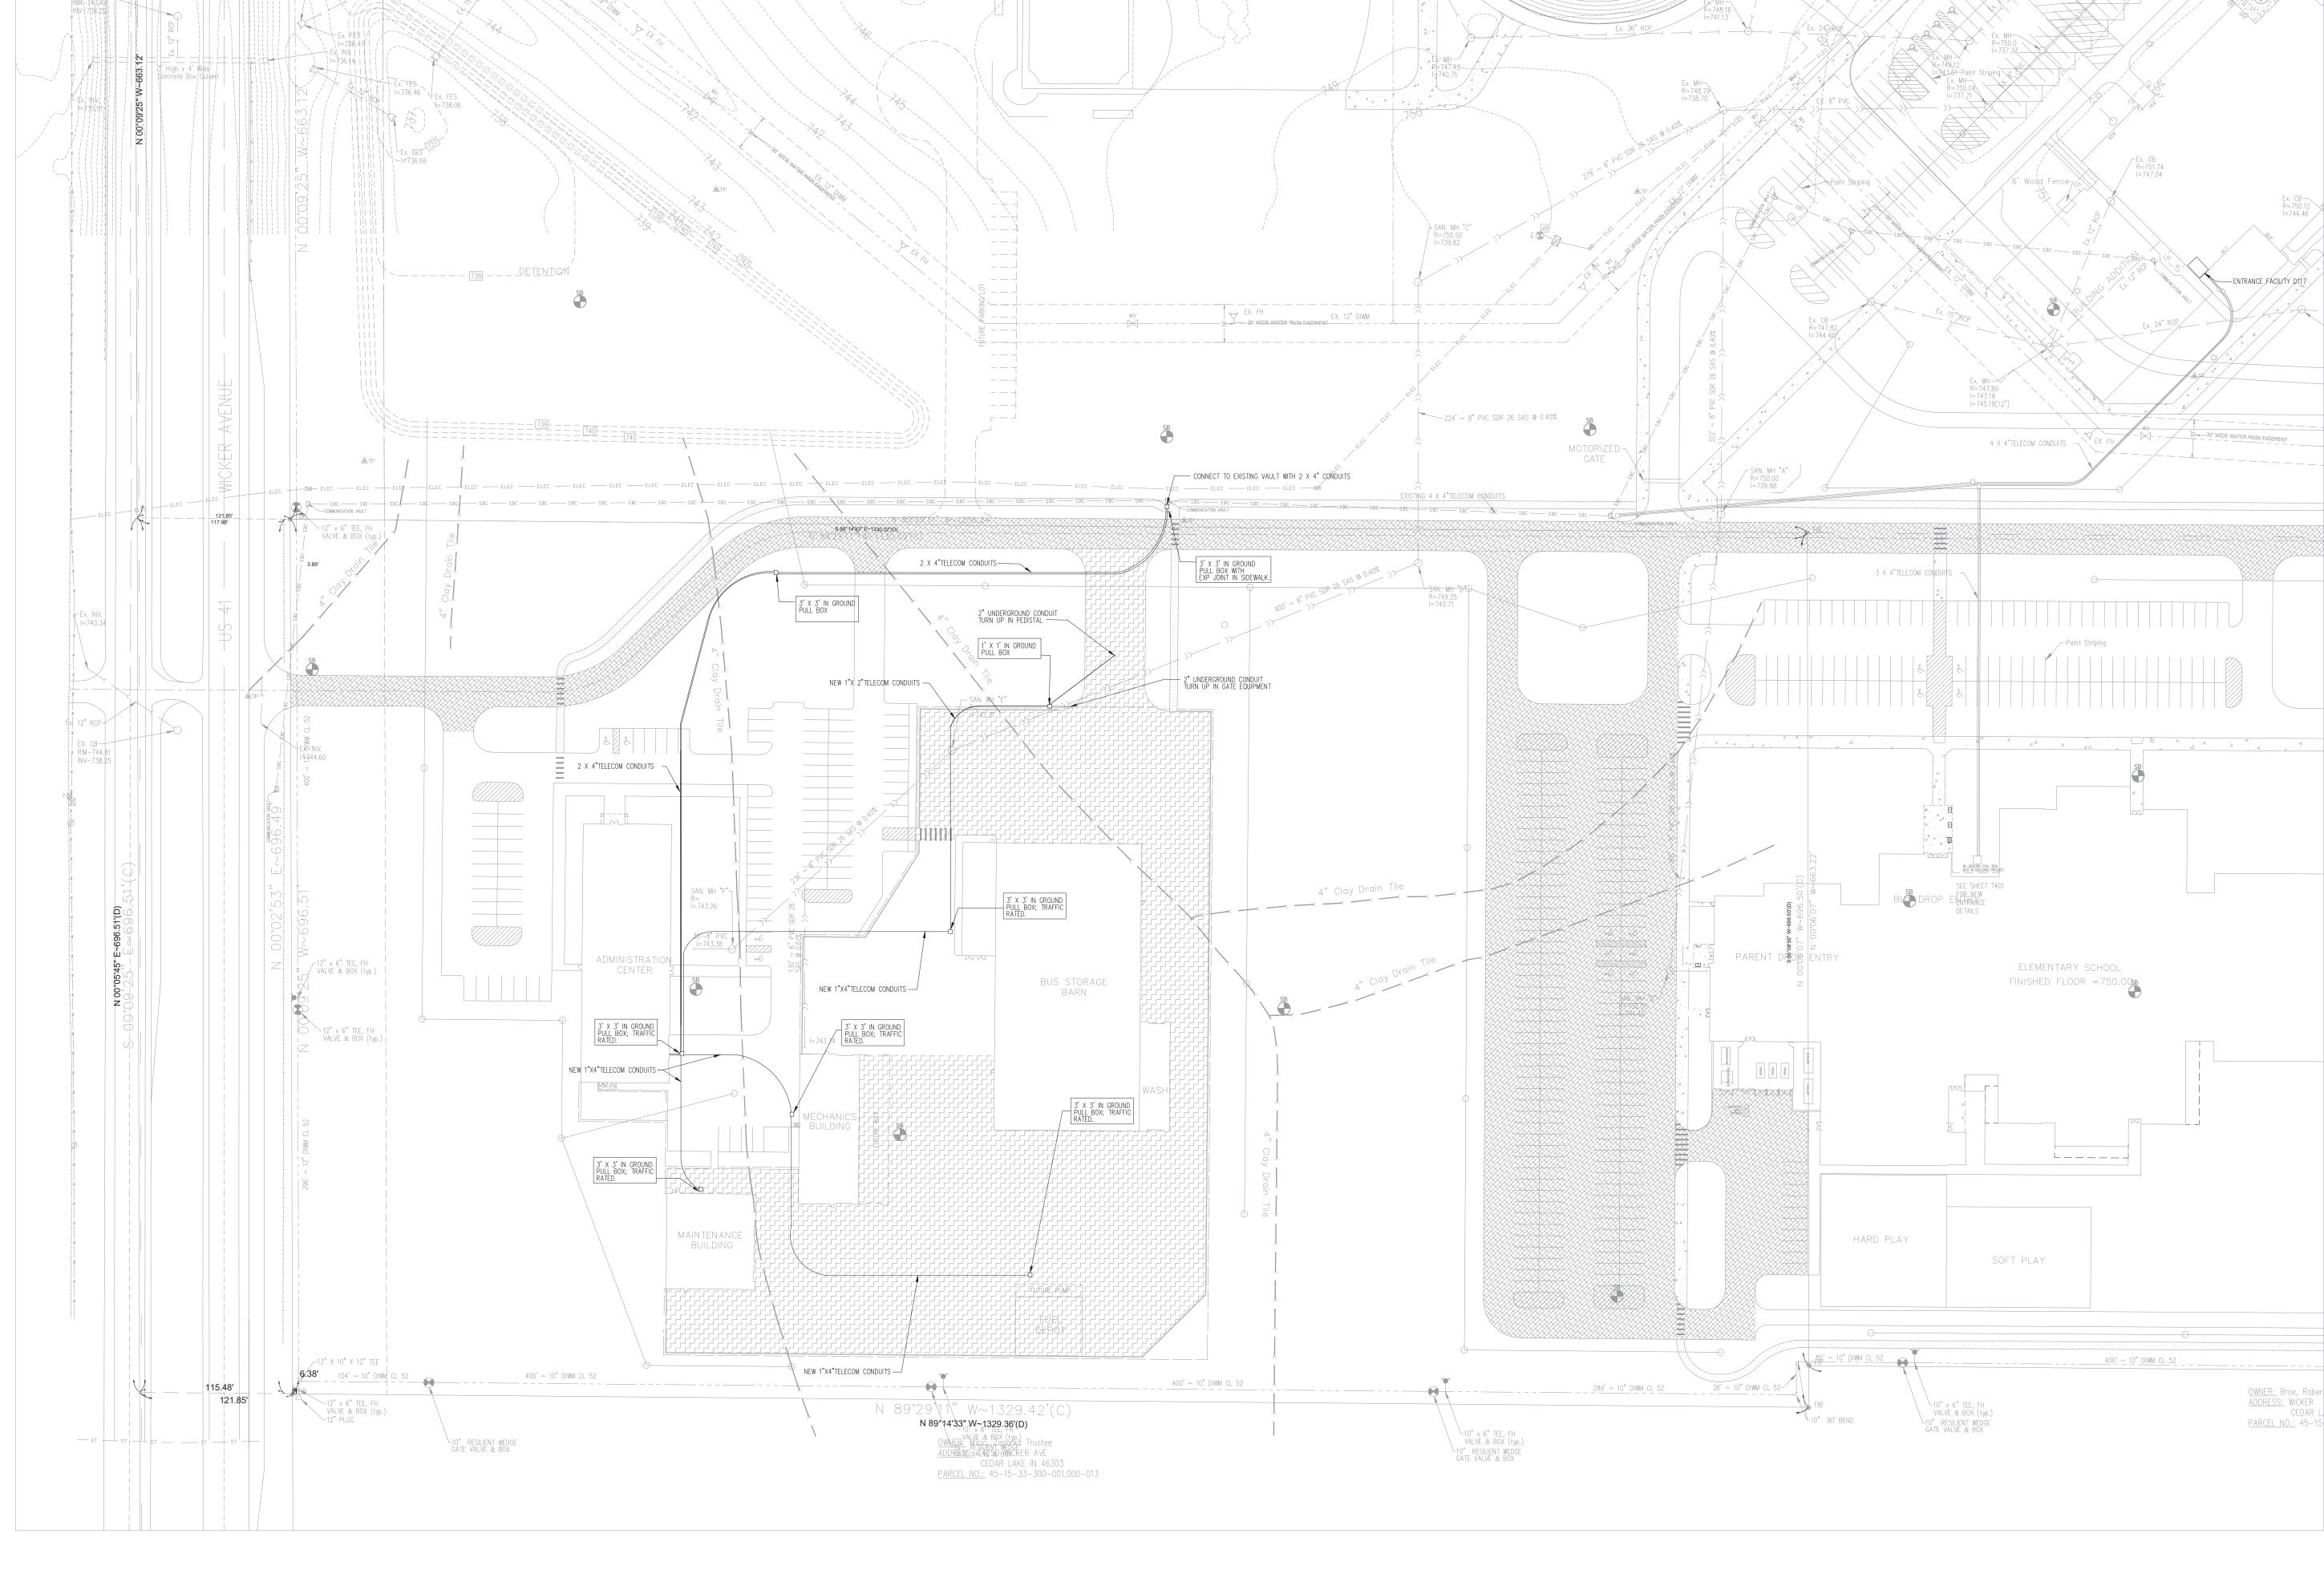

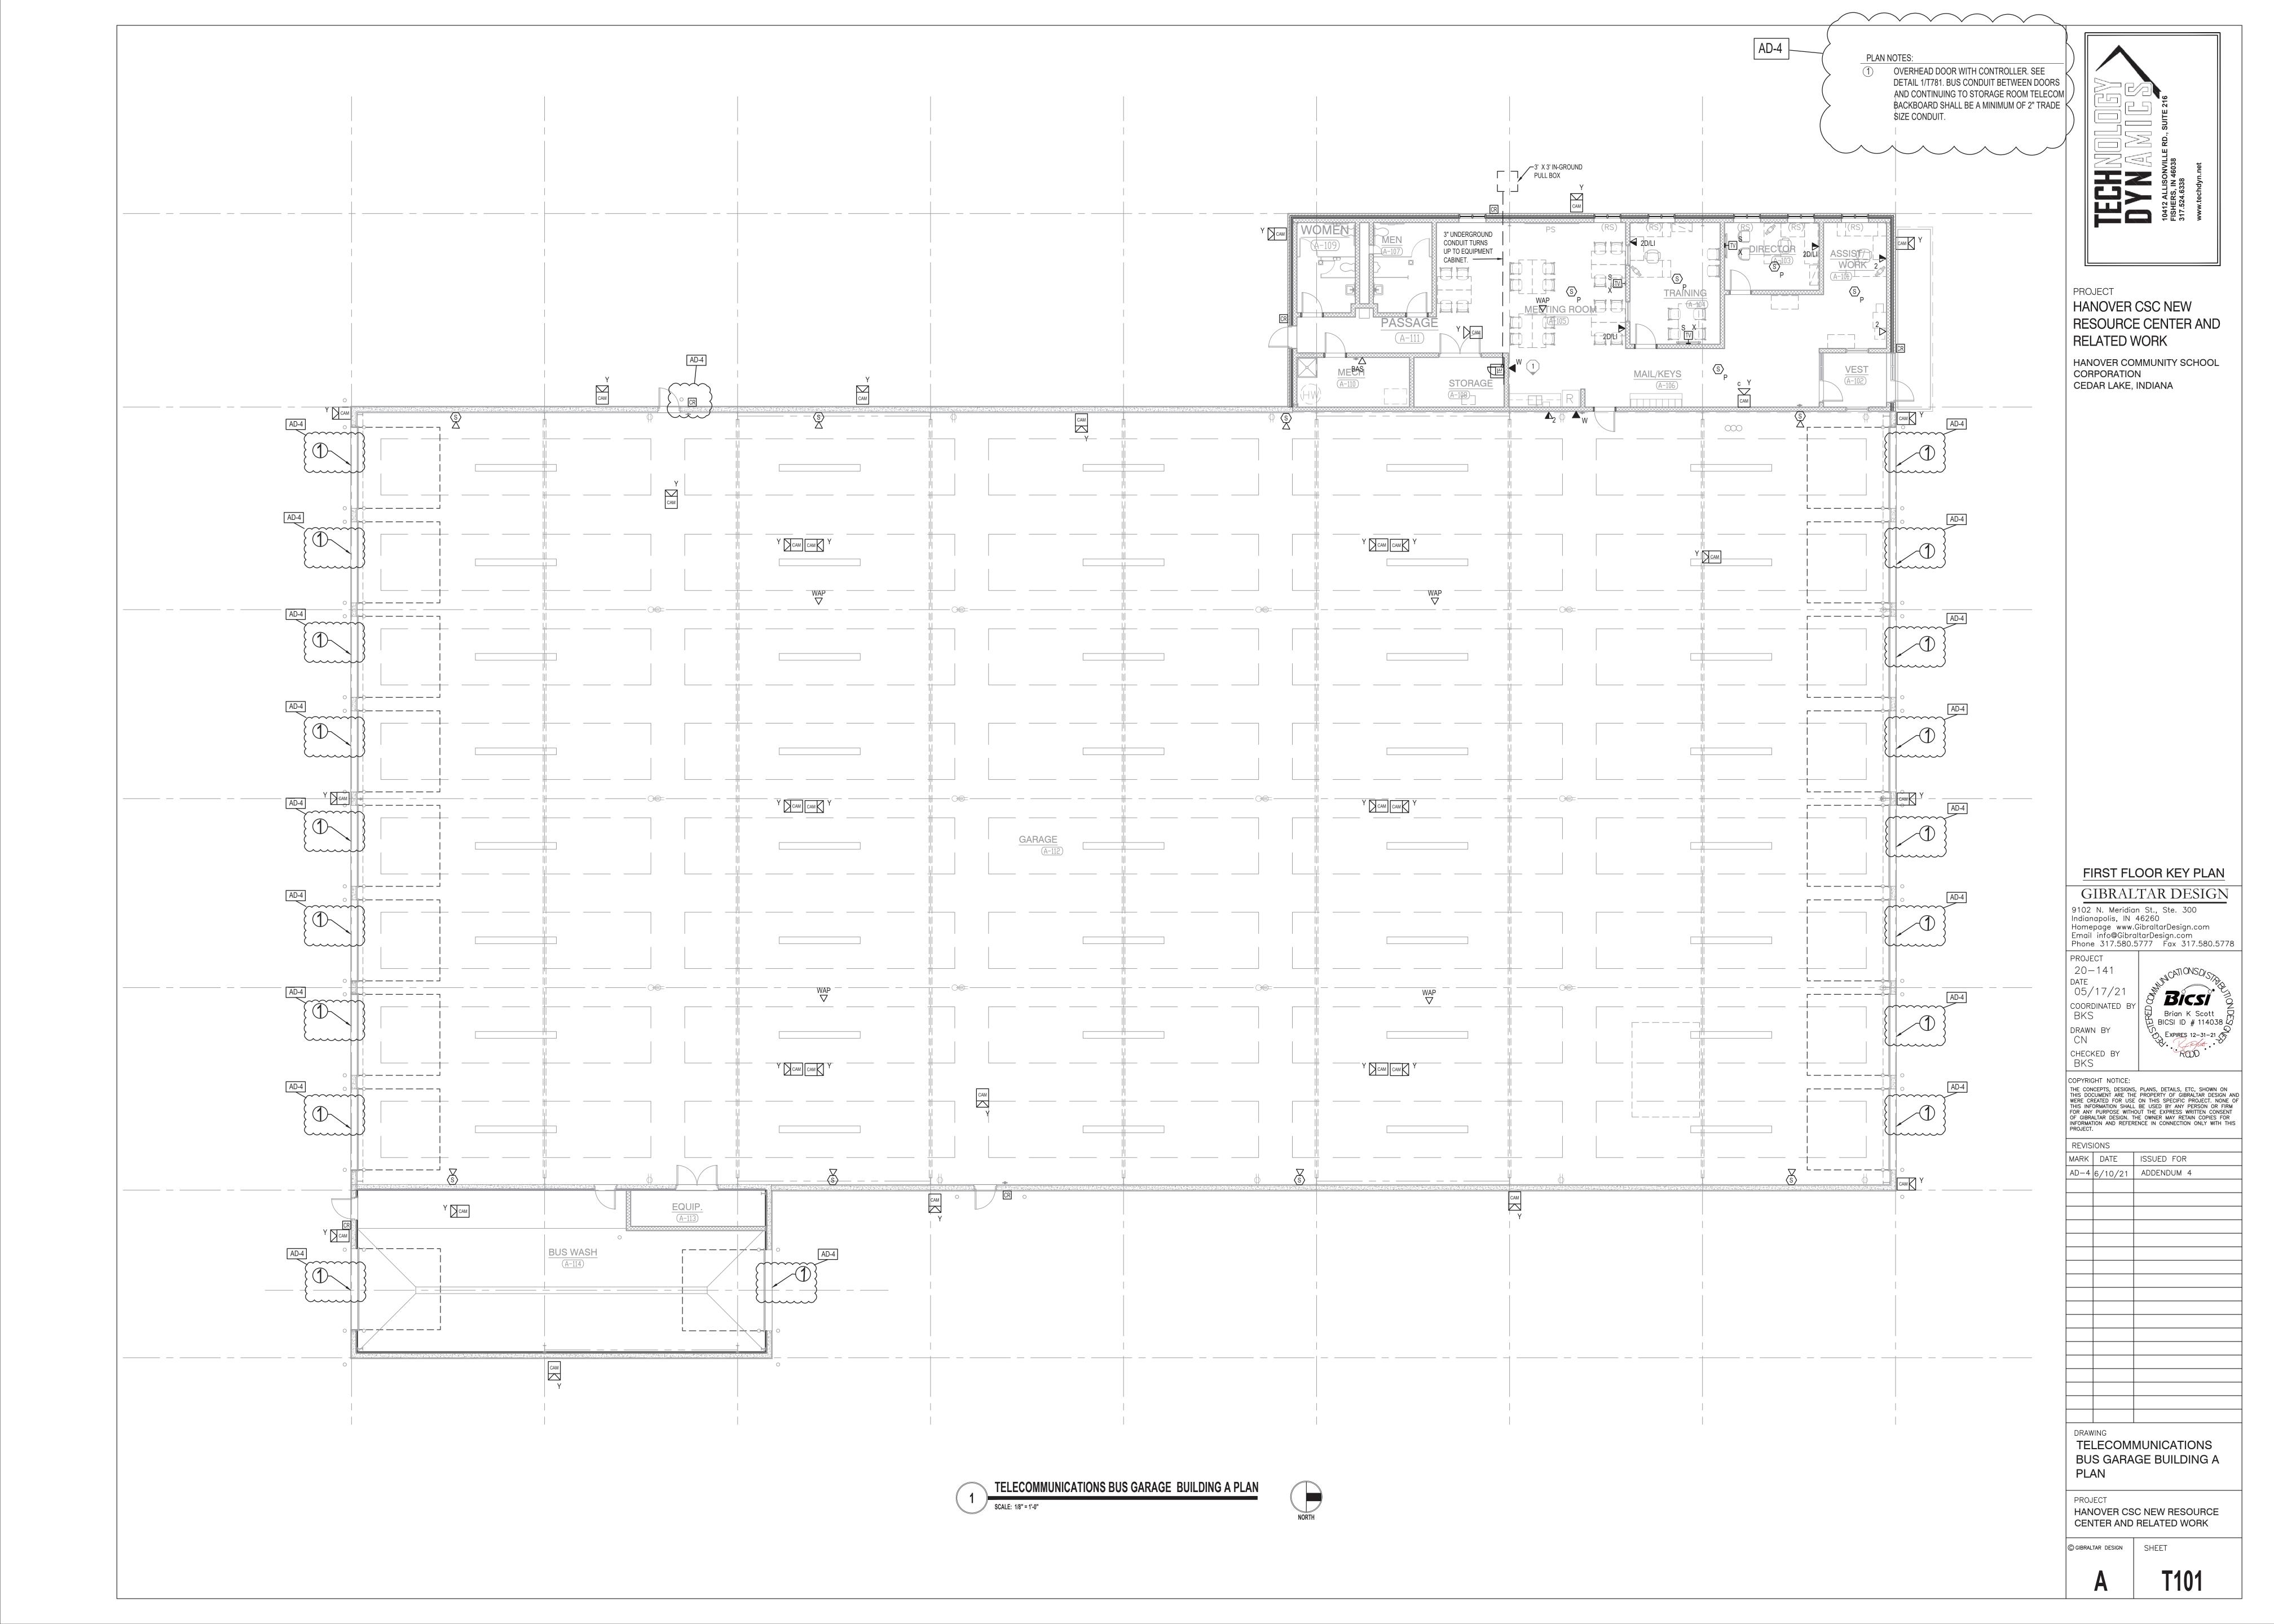

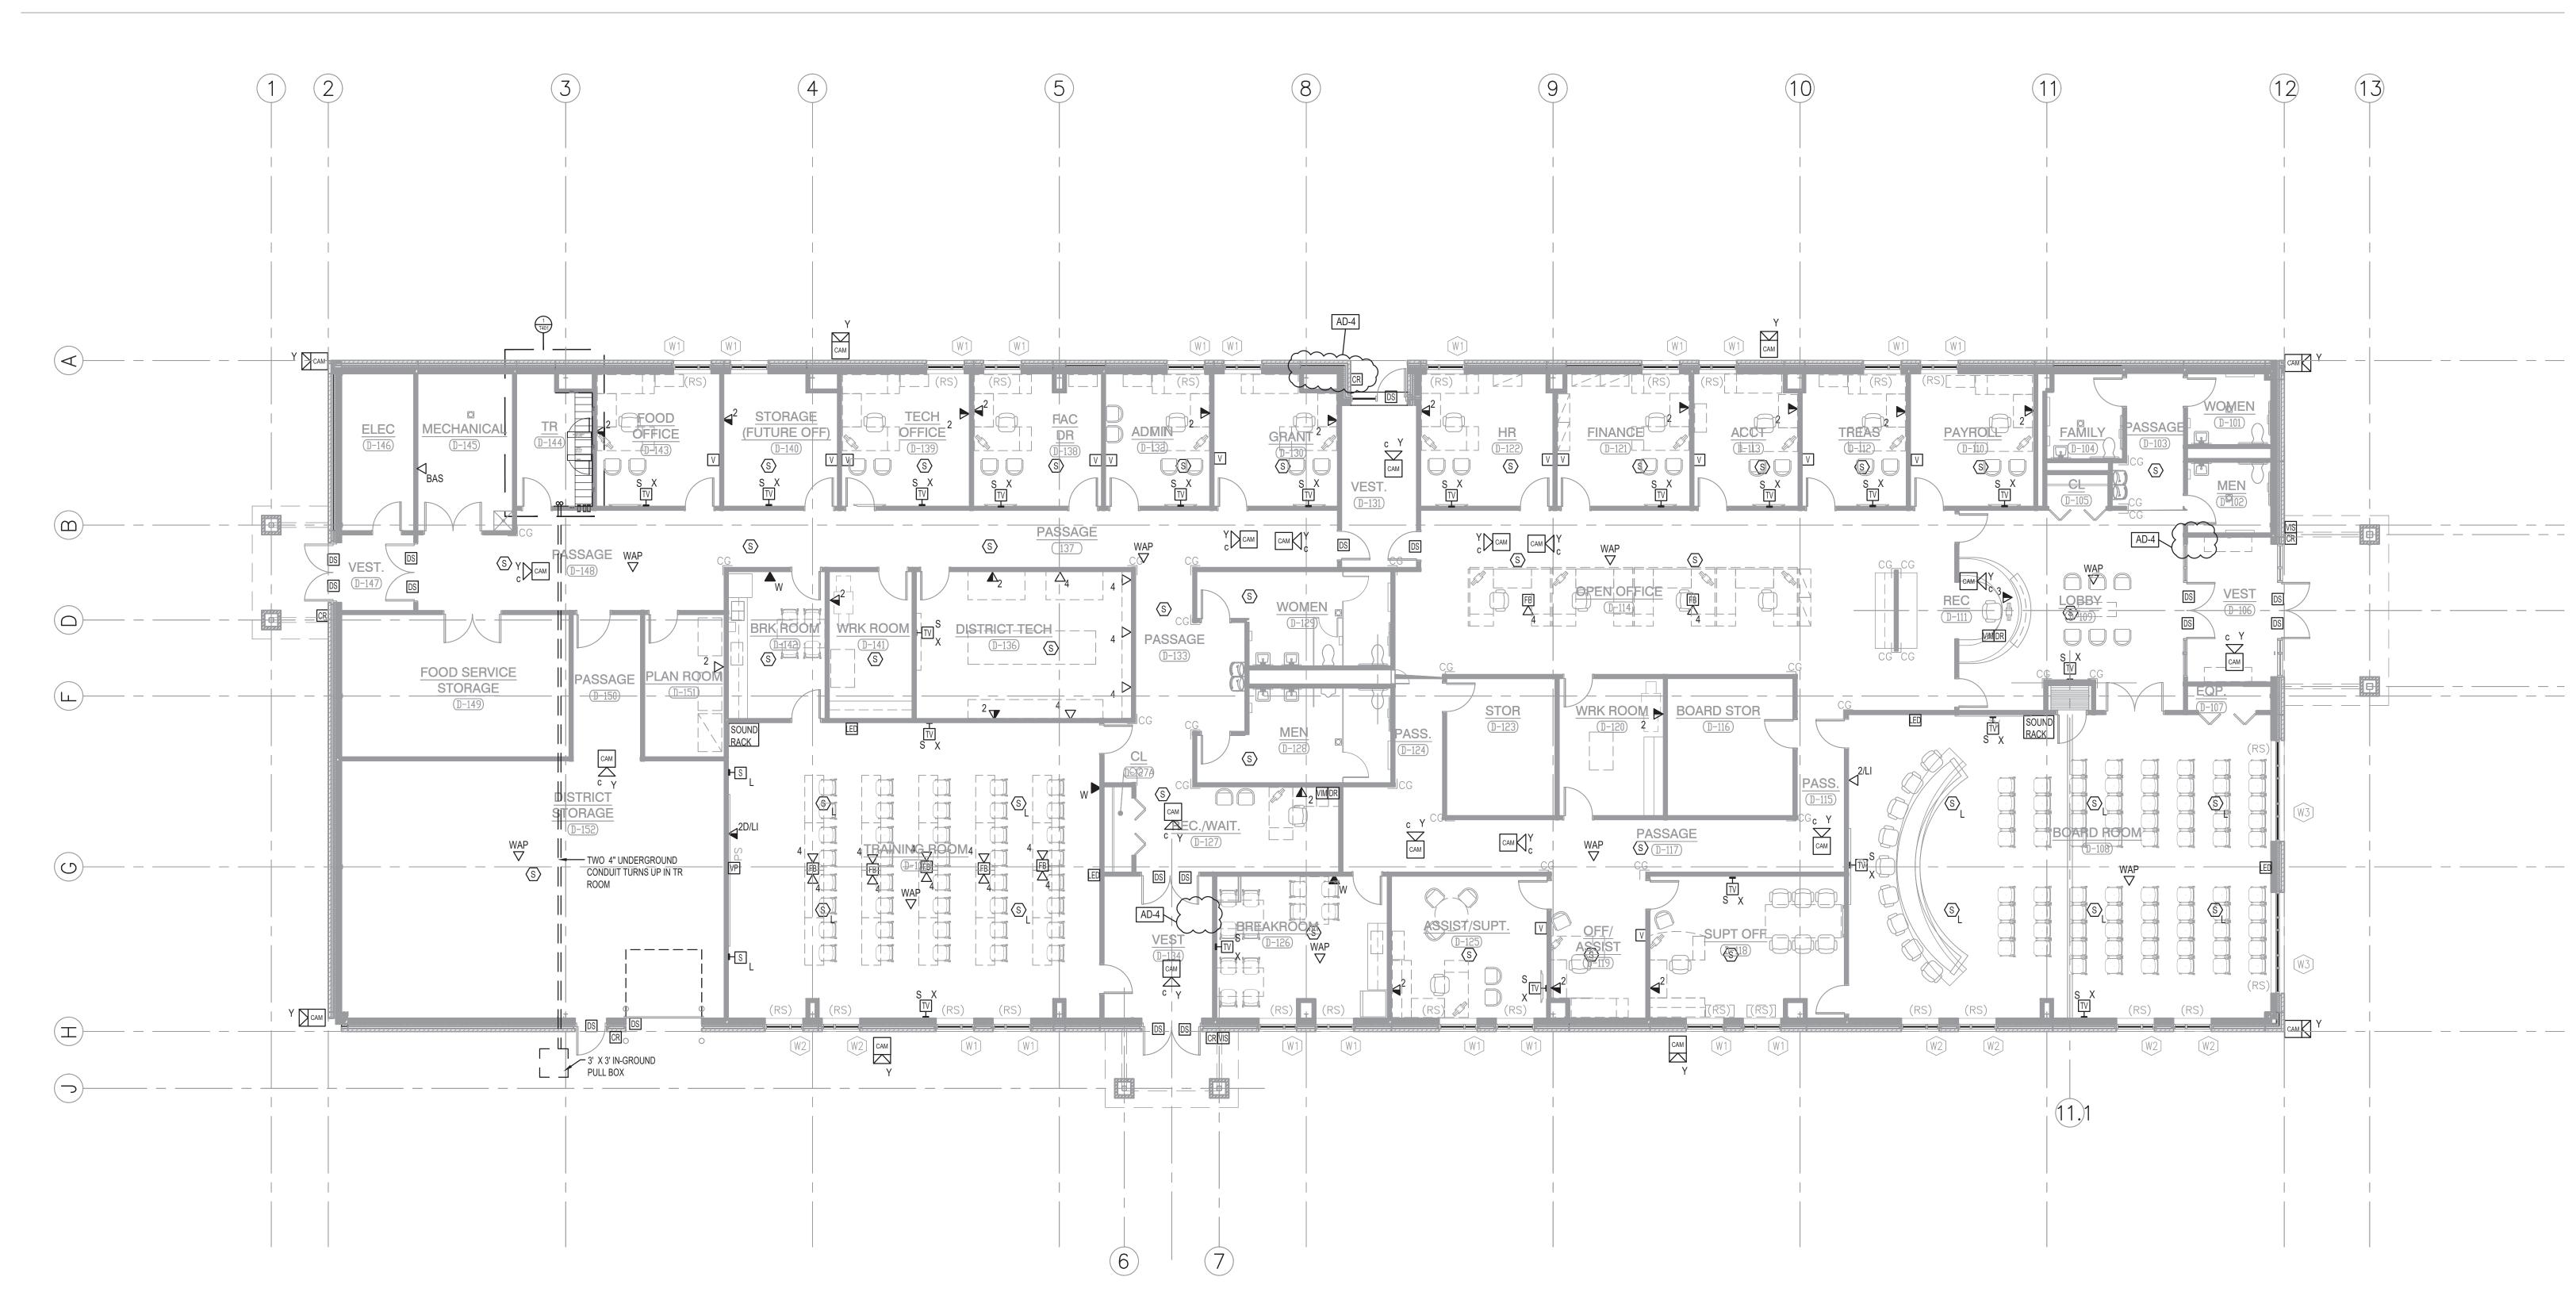



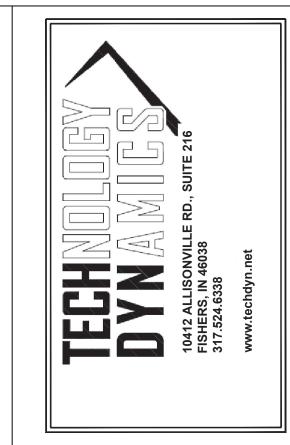

PROJECT
HANOVER CSC NEW RESOURCE CENTER AND RELATED WORK

HANOVER COMMUNITY SCHOOL CORPORATION CEDAR LAKE, INDIANA

FIRST FLOOR KEY PLAN

Bicsi

☑ BICSI ID # 114038 🐼

EXPIRES 12-31-21

GIBRALTAR DESIGN 9102 N. Meridian St., Ste. 300 Indianapolis, IN 46260 Homepage www.GibraltarDesign.com Email info@GibraltarDesign.com Phone 317.580.5777 Fax 317.580.5778

PROJECT 20-141 05/17/21

COORDINATED E BKS DRAWN BY CN CHECKED BY

BKS COPYRIGHT NOTICE: THE CONCEPTS, DESIGNS, PLANS, DETAILS, ETC, SHOWN ON THIS DOCUMENT ARE THE PROPERTY OF GIBRALTAR DESIGN AND WERE CREATED FOR USE ON THIS SPECIFIC PROJECT. NONE OF THIS INFORMATION SHALL BE USED BY ANY PERSON OR FIRM FOR ANY PURPOSE WITHOUT THE EXPRESS WRITTEN CONSENT OF GIBRALTAR DESIGN. THE OWNER MAY RETAIN COPIES FOR INFORMATION AND REFERENCE IN CONNECTION ONLY WITH THIS PROJECT.

MARK DATE ISSUED FOR AD-4 6/10/21 ADDENDUM 4

> TELECOMMUNICATIONS RESOURCE CENTER **BUILDING D PLAN**

HANOVER CSC NEW RESOURCE CENTER AND RELATED WORK

© GIBRALTAR DESIGN SHEET