

ADDENDUM NO. 03

May 5, 2022

LOPER ELEMENTARY SCHOOL RENOVATION

**901 Loper Drive
Shelbyville, IN 46176**

TO: ALL BIDDERS OF RECORD

This Addendum forms a part of and modifies the Bidding Requirements, Contract Forms, Contract Conditions, the Specifications, and the Drawings dated April 6, 2022, by Lancer+Beebe, LLC. Acknowledge receipt of the Addendum in the space provided on the Bid Form. Failure to do so may subject the Bidder to disqualification.

This Addendum consists of Pages ADD 3-1 through ADD 3-2 and attached Lancer+Beebe, LLC, Addendum No. 3 dated May 4, 2022, consisting of 5 pages, Specification Sections 22 42 00 – Plumbing Fixtures and Trim, 27 15 00 – Security System, and Drawing Sheets: G000, A720, A751, HD101A, HP101A, H-501, H-502, P-101A, ED101A, ED101B, ED101C, EP101A, ET101A, ET101B, ET101C, and E-502

A. SPECIFICATION SECTION 01 12 00 – MULTIPLE CONTRACT SUMMARY

1. Paragraph 3.03 Bid Categories

A. Bid Category No. 1 – General Trades

Revise the following Project Specific Clarification

3. The General Trades Contractor is to mow the grass and maintain the weeds within the project limits for the duration of the project. The project limit is defined as within and immediately adjacent to any temporary construction fence or stone laydown area.
5. The General Trades Contractor shall daylight (hydro-vacuum excavation) all existing utilities to confirm depths, sizes, and locations prior to starting any excavation work required to complete this Bid Category's Scope of Work.

Add the following Project Specific Clarifications

16. The General Trades Contractor is NOT responsible for selective demolition of flooring products such as carpet, sheet flooring, etc. that is installed over top of asbestos material. These flooring products are to be removed as part of the asbestos abatement procedure by separate Contract.
17. The General Trades Contractor is to provide and install all Work related to the Media Circulation Desk, with exception of wall base, paint, electrical, and technology. This Work includes but is not limited to wall framing, gypsum board assemblies, wood blocking and sheathing, plastic laminate, solid surface countertop, angle brackets, drawer assemblies and accessories, etc. Contractor to review drawings A101A, A112, A763, and A766 for reference.

F. Bid Category No. 6 – Casework

Add the following Project Specific Clarification

3. The General Trades Contractor is to provide and install all Work related to the Media Circulation Desk, with exception of wall base, paint, electrical, and technology. This Work includes but is not limited to wall framing, gypsum board assemblies, wood blocking and sheathing, plastic laminate, solid surface countertop, angle brackets, drawer assemblies and accessories, etc. Contractor to review drawings A101A, A112, A763, and A766 for reference.

G. Bid Category No. 7 – Plumbing & Mechanical

Add the following Project Specific Clarification

5. The Plumbing & Mechanical Contractor shall daylight (hydro-vacuum excavation) all existing utilities to confirm depths, sizes, and locations prior to starting any excavation work required to complete this Bid Category's Scope of Work.

H. Bid Category No. 8 – Electrical & Technology

Add the following Project Specific Clarification

3. The Electrical & Technology Contractor shall daylight (hydro-vacuum excavation) all existing utilities to confirm depths, sizes, and locations prior to starting any excavation work required to complete this Bid Category's Scope of Work.

LANCER + BEEBE, LLC

Project # 21140

ADDENDUM NO. THREE

PROJECT: Shelbyville Central Schools – 2022 Loper Elementary Renovation

PROJECT NUMBER: 21140

DATE OF ADDENDUM: May 4, 2022



THIS ADDENDUM FORMS A PART OF THE CONTRACT DOCUMENTS AND IS ISSUED IN ACCORDANCE WITH THE INSTRUCTIONS TO BIDDERS. ACKNOWLEDGE RECEIPT OF THIS ADDENDUM BY SIGNING THE ADDENDUM ACKNOWLEDGMENT SECTION OF THE BID FORM.

QUESTIONS:

Q: Rest rooms G2,4 G12,13 G26,27 the finish key calls for PT-1
Please verify the wall tile is limited to the common wall between
The rest rooms shown on elevations 4,5,6 on sheet A751

A: The wall tile in the restrooms is limited to just the wall with the sink, as shown in the elevations. The remaining walls will receive PT-1.

Q: Can the architect clarify the countertop finishes over the standard casework. Are solid surface tops only required at sinks? Section details show all tops as solid surface. Also in section 123216 only solid surface tops are specified.

A: Yes, solid surface countertops are only being placed where sinks are located. Refer to General Casework Note 9.

LANCER + BEEBE, LLC

Project # 21140

Q: Does Selective demolition include demolition of the existing flooring And adhesive?

A: Yes

Q: Is the Review of the floor slab mitigation is limited to testing the slab For the current moisture levels.

A: No. Moisture mitigation and testing should be included at all locations. See allowance for moisture mitigation.

Q: Sheet A002 shows both ceiling types as tegular tile, whereas the specs call out square edge tiles. Please confirm which is correct.

A: Tegular is correct.

Q: Spec section 095100 Acoustical Ceilings – Spec section calls for 10% attic stock for ceiling tiles. 2% is more typical. Please confirm which is correct.

A: 10% is desired.

Q: Spec section 095100, Section 2.3 – Please confirm that batt insulation and gypsum board are not a part of this spec section or Bid category No. 5.

A: Bid Category No. 5 – Acoustic Treatments and Ceilings is responsible for all products and accessories required to provide the complete system as required in this specification section.

Q: Spec section 095100, Section 1.6 – Please confirm what the seismic design category of the building will be.

A: The seismic design category is C.

SPECIFICATIONS:

1. None

DRAWINGS:

1. Drawing Sheet Number: G000
Drawing Sheet Title: Cover
Change:
 - Removed sheets S100 and A141 from sheet index
2. Drawing Sheet Number: A720
Drawing Sheet Title: Interior Finish Legend
Change:
 - Adjusted WT-1 and WT-2, and removed WT-3
3. Drawing Sheet Number: A751
Drawing Sheet Title: Interior Elevations
Change:
 - Adjusted Elevations 4, 5, 6, and 7 with new tile sizes
4. Drawing Sheet Number: P-101A
Drawing Sheet Title: First Floor Plumbing Plan – Unit A
Change:
 - Added EWC-L1 and EWC-L2

Attachments:

Mech and Elec Addendum Three Attachment

Plumbing Addendum Three Attachment

END OF ADDENDUM NO. THREE



**ADDENDUM
NUMBER: 3**

PROJECT NAME: Loper Elementary School
PROJECT NO.: 21102.B

ISSUED FROM	ISSUE DATE	BID DATE
Circle Design Group	May 03, 2022	05/11/2022

This Addendum No. 3 to the drawings and specification shall supplement, amend, and become a part of the bidding documents, plans, and specifications. All bids and construction contracts shall be based on these modifications to the original contract documents.

PART 1. BIDDING AND CONTRACT DOCUMENTS

1.01

PART 2. SPECIFICATIONS

2.01

Section 23 34 00 HVAC Fans

- A. ADD Twin City to the list of acceptable manufacturers.
- B. ADD ACME to the list of acceptable manufacturers.

2.02

Section 23 82 19 Fan and Coil Units

- A. ADD Nailor to the list of acceptable manufacturers.

2.03

Section 23 82 39 Terminal Heating Units

- A. ADD Sterling to the list of acceptable manufacturers for HEATING WATER RADIANT CEILING PANELS and CONVECTORS.
- B. ADD Price to the list of acceptable manufacturers for HEATING WATER RADIANT CEILING PANELS and CONVECTORS.

2.04

Section 27 15 00 SECURITY SYSTEM

- A. Delete section in total. No security system work by contractor.

PART 3. DRAWINGS

3.01

P-101A – FIRST FLOOR PLUMBING PLAN – UNIT A

- A. Revise water coolers in corridor F20

3.02

H-501 – HVAC SCHEDULES

- A. Revise Pump Schedule.
- B. Revise Hydronic Unit Heater Schedule.

3.03

H-502 – HVAC SCHEDULES

- A. Revise Ductless Split Air Conditioner Schedule. Change CFM to correct value.

3.04

HD101A – HVAC DEMO PLAN – UNIT A

- A. Demo existing Circuit Setters.
- B. Revise Sheet Plan Note #13.

3.05

HP101A – FIRST FLOOR HVAC PIPING PLAN – UNIT A

- A. Add HUH-G46 and associated thermostat.
- B. Add new Circuit Setters.
- C. Add Plan Note #11.
- D. Add Plan Note #12.
- E. Add Plan Note #13.

3.06

E-502 – Electrical Schedules

address

9229 Delegates Row, Suite 150
Indianapolis, IN 46240

phone

317.781.6200
Page 1 of 1

- A. Motorized equipment schedule updated for CWP sizes
- 3.07 EP101A- First Floor Power Plan – Unit A
 - A. Plan note 1 added for mechanical equipment HUH-G46
 - B. Plan note 29 added for CWP circuitry
- 3.08 ED101A – First Floor Demo Plan – Unit A
 - A. Shading updated for existing to remain data outlets.
 - B. Plan note 14 added for CWP circuitry
- 3.09 ET101A – First Floor Technology Plan – Unit A
 - A. Added existing WAP locations.
 - B. Updated plan note G to call out number of data cables from data outlets.
 - C. Added note calling out MDF room.
 - D. Added data for scoreboards.
- 3.010 ET101B – First Floor Technology Plan – Unit B
 - A. Added existing WAP locations.
 - B. Updated plan note G to call out number of data cables from data outlets.
 - C. Added note calling out IDF room.
- 3.011 ET101C – First Floor Technology Plan – Unit C
 - A. Added existing WAP locations

ATTACHMENTS

Specifications:

Drawings: H-501, HD101A, HP101A, E-502, EP101A, ED101A, ET101A, ET101B, ET101C |

END OF ADDENDUM

address

9229 Delegates Row, Suite 150
Indianapolis, IN 46240

phone

317.781.6200
Page 2 of 1

1.01 22 42 00 PLUMBING FIXTURES AND TRIM

- A. Delete paragraph 2.10 ELECTRIC WATER COOLER/BOTTLE FILLERS (BI-LEVEL), in its entirety and replace with the following:

2.10 ELECTRIC WATER COOLER/BOTTLE FILLER (WALL MOUNTED):

- A. A. Electric Water Cooler / Bottle Filler (EWC-L2): ADA compliant, 34" to centerline of bubbler, Oasis PG8EBQ-SS, modular, wall mounted, 34" to spout, UL labeled, front and side push pads, barrier-free self-contained electric water cooler with one piece stainless steel top, and stainless steel cabinet, flexible bubbler guards, hands free bottle filler with programmable shut-off timer, integrated bottle counter and filter monitor.
1. Unit to have steel mounting frame, nonferrous waterways, built-in pressure regulator, automatically operated permanently lubricated air-cooled hermetically sealed cooling unit with freeze-up protection, and adjustable temperature control.
 2. Electrical rating: 115 VAC, provide cord and plug.
 3. Minimum cooling capacity 8.0 GPH (80 degrees entering to 50 degrees drinking at 90 degrees ambient).
 4. Chrome plated straightway stop with supply tubing chrome plated nipples and escutcheons.
 5. Provide 17-gauge adjustable P-trap with cleanout plug with escutcheon.
 6. Adjustable two-piece chrome plated cast-brass P-trap with cleanout with escutcheon.
 7. Chicago Faucet 1017-CP supply pipes with loose key stops, lock shield caps, wall flanges, and flexible tube risers.

SHELBYVILLE RENOVATIONS - LOPER ELEMENTARY SCHOOL

SECTION 27 15 00

SECURITY SYSTEM

PART 1 - GENERAL

1.01 Delete section in total per Addendum 3.



SHELBYVILLE CENTRAL SCHOOLS
1121 E. STATE RD. 44
SHELBYVILLE, IN 46176
Telephone: 317.392.2505

www.scs.shelbycs.org
OWNER



LANCER+BEEBE, LLC
220 N. College Ave.
Indianapolis, IN 46202
Telephone: 317.750.5373

www.lancerbbeebe.com
ARCHITECT



CIRCLE DESIGN GROUP
9229 Delegates Row, Ste 150
Indianapolis, IN 46240
Telephone: 317.781.6200

www.circledesigngroup.com
CIVIL, MECH, ELEC, PLUMB ENGINEER



THE SKILLMAN CORPORATION
3834 S Emerson Ave
Indianapolis, IN 46203
Telephone: 317.783.6151

www.skillman.com
CONSTRUCTION MANAGER




ARSEE ENGINEERS, INC.
9715 Kincaid Dr, Ste 100
Fishers, IN 46037
Telephone: 317.594.5152

www.arsee-engineers.com
STRUCTURAL ENGINEER

SHELBYVILLE CENTRAL SCHOOLS LOPER ELEMENTARY SCHOOL RENOVATIONS

100% CONSTRUCTION DOCUMENTS
04.06.2022

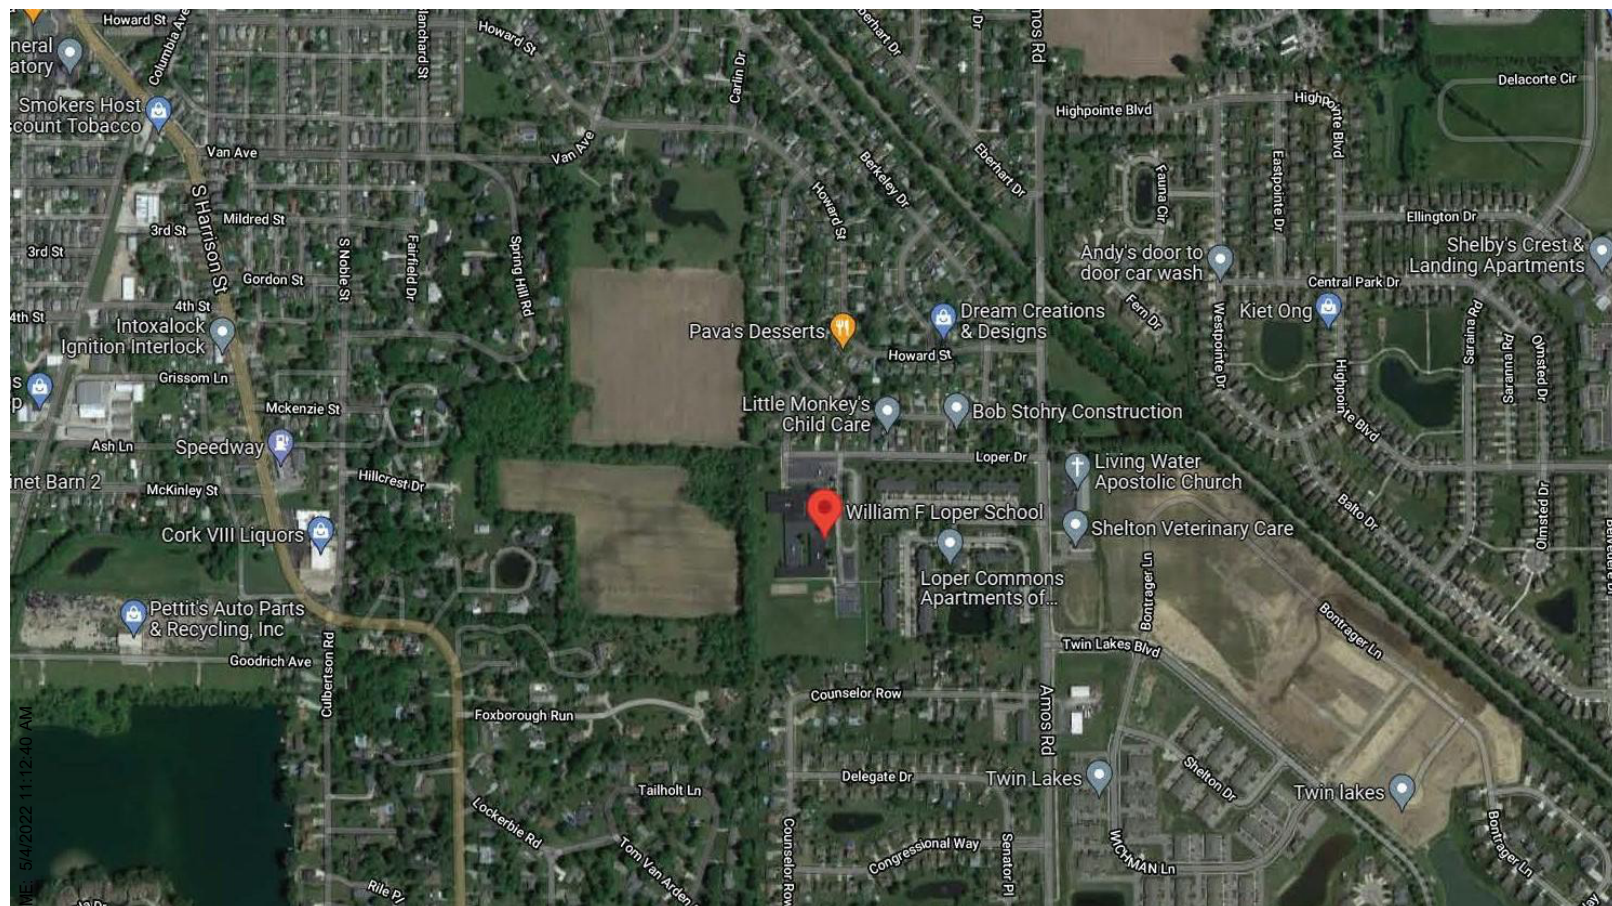

PROJECT LOCATION: 901 LOPER DRIVE
SHELBYVILLE, IN 46176

BOARD OF SCHOOL TRUSTEES

PRESIDENT: CURT JOHNSON
VICE PRESIDENT: JOHN C. DEPREZ, IV
SECRETARY: DR. JAMES REES
BOARD MEMBER: DAVID M. FINKEL
BOARD MEMBER: TROY MERRICK
BOARD MEMBER: MICHAEL TURNER
BOARD MEMBER: MIKE WARBLE

SUPERINTENDENT: MARY HARPER
DIRECTOR OF FACILITIES: KATHLEEN MILTZ
PRINCIPAL: MR. HARPRING
ASSISTANT PRINCIPAL: MRS. O'CONNOR

OWNER DIRECTORY



Loper
ELEMENTARY SCHOOL

SHEET INDEX	SHEET INDEX
00. GENERAL	H-101C FIRST FLOOR HVAC PLAN - UNIT C
LS001 LIFE SAFETY PLAN - FIRST FLOOR	HP101C FIRST FLOOR HVAC PIPING PLAN - UNIT C
01. CIVIL	H-102 OVERALL HVAC ROOF PLAN
C101 SITE DEMOLITION PLAN - LOPER	H-301 ENLARGED HVAC PLANS
C201 SITE LAYOUT PLAN - LOPER	H-302 ENLARGED HVAC PLANS
C301 GRADING & DRAINAGE PLAN - LOPER	H-401 HEATING WATER SYSTEM DIAGRAM
C401 EROSION CONTROL PLAN - LOPER	H-402 CHILLED WATER SYSTEM DIAGRAM
C801 SITE CONSTRUCTION DETAILS - LOPER	H-501 HVAC SCHEDULES
02. STRUCTURAL	H-502 HVAC SCHEDULES
S101A ENLARGED PLAN AND SECTION	H-601 HVAC DETAILS
S200 MASONRY ELEVATIONS	H-602 HVAC DETAILS
04. ARCHITECTURE	H-603 AHU DETAILS
A001 ARCHITECTURAL GENERAL NOTES	H-604 CHILLER DETAILS
A002 INTERIOR TYPES	06. PLUMBING
A011 FLOOR PLAN - FIRST FLOOR - OVERALL	PD101A FIRST FLOOR PLUMBING DEMO PLAN - UNIT A
AD101A DEMOLITION PLAN - FIRST FLOOR - UNIT A	PD101B FIRST FLOOR PLUMBING DEMO PLAN - UNIT B
AD101B DEMOLITION PLAN - FIRST FLOOR - UNIT B	P-100A UNDER FLOOR PLUMBING PLAN - UNIT A
AD101C DEMOLITION PLAN - FIRST FLOOR - UNIT C	P-100B UNDER FLOOR PLUMBING PLAN - UNIT B
A101A FLOOR PLAN - FIRST FLOOR - UNIT A	P-101A FIRST FLOOR PLUMBING PLAN - UNIT A
A101B FLOOR PLAN - FIRST FLOOR - UNIT B	P-101B FIRST FLOOR PLUMBING PLAN - UNIT B
A101C FLOOR PLAN - FIRST FLOOR - UNIT C	P-501 PLUMBING SCHEDULES AND DETAILS
A112 ENLARGED PLANS	P-502 PLUMBING SCHEDULE AND DETAILS
A121A REFLECTED CEILING PLAN - FIRST FLOOR - UNIT A	P-901 PLUMBING ISOMETRICS - UNIT A
A121B REFLECTED CEILING PLAN - FIRST FLOOR - UNIT B	P-902 PLUMBING ISOMETRICS - UNIT B
A121C REFLECTED CEILING PLAN - FIRST FLOOR - UNIT C	07. ELECTRICAL
A601 DOOR SCHEDULE	E-000 ELECTRICAL SYMBOLS AND ABBREVIATIONS
A720 INTERIOR FINISH LEGEND	ES101 ELECTRICAL SITE PLAN
A721A INTERIOR FINISH PLAN - FIRST FLOOR - UNIT A	ED101A FIRST FLOOR ELECTRICAL DEMO PLAN - UNIT A
A721B INTERIOR FINISH PLAN - FIRST FLOOR - UNIT B	ED101B FIRST FLOOR ELECTRICAL DEMO PLAN - UNIT B
A721C INTERIOR FINISH PLAN - FIRST FLOOR - UNIT C	ED101C FIRST FLOOR ELECTRICAL DEMO PLAN - UNIT C
A751 INTERIOR ELEVATIONS	EL101A FIRST FLOOR LIGHTING PLAN - UNIT A
A761 CASEWORK ELEVATIONS	EL101B FIRST FLOOR LIGHTING PLAN - UNIT B
A762 CASEWORK ELEVATIONS	EL101C FIRST FLOOR LIGHTING PLAN - UNIT C
A763 CASEWORK ELEVATIONS	EP101A FIRST FLOOR POWER PLAN - UNIT A
A764 CASEWORK ELEVATIONS - ALTERNATES	EP101B FIRST FLOOR POWER PLAN - UNIT B
A765 CASEWORK DETAILS	EP101C FIRST FLOOR POWER PLAN - UNIT C
A766 CASEWORK DETAILS	ET101A FIRST FLOOR TECHNOLOGY PLAN - UNIT A
05. MECHANICAL	ET101B FIRST FLOOR TECHNOLOGY PLAN - UNIT B
M-000 MECHANICAL SYMBOLS, LEGENDS & ABBREVIATIONS	ET101C FIRST FLOOR TECHNOLOGY PLAN - UNIT C
HD101A FIRST FLOOR HVAC DEMO PLAN - UNIT A	E-401 ELECTRICAL ONELINE DIAGRAM
HD101B FIRST FLOOR HVAC DEMO PLAN - UNIT B	E-501 ELECTRICAL SCHEDULES
HD101C FIRST FLOOR HVAC DEMO PLAN - UNIT C	E-502 ELECTRICAL SCHEDULES
HD102 OVERALL HVAC ROOF DEMO PLAN	E-601 ELECTRICAL DETAILS
HD301 ENLARGED HVAC DEMO PLANS	E-602 ELECTRICAL DETAILS
HD302 ENLARGED HVAC DEMO PLANS	
H-101A FIRST FLOOR HVAC PLAN - UNIT A	
HP101A FIRST FLOOR HVAC PIPING PLAN - UNIT A	
H-101B FIRST FLOOR HVAC PLAN - UNIT B	
HP101B FIRST FLOOR HVAC PIPING PLAN - UNIT B	

SHELBYVILLE CENTRAL SCHOOLS
LOPER ELEMENTARY SCHOOL RENOVATIONS
901 LOPER DRIVE
SHELBYVILLE, IN 46176

REVISIONS:
DATE DESC.

100% CONSTRUCTION
DOCUMENTS
PROJECT: #21140
DATE: 04.06.2022
DRAWN BY: Author

COVER

G000

LANCER+BEEBE, LLC
ARCHITECTURE | PLANNING | INTERIORS
220 N. COLLEGE AVE
INDIANAPOLIS, IN 46202

FINISH LEGEND

NOTES

ETR EXISTING TO REMAIN

FLOOR COVERING

CARPET TILE
CPT-1: MFG: INTERFACE
TYPE: 50CM X 50CM CARPET TILE
PATTERN: HUMAN CONNECTIONS, FLAGSTONE
COLOR: 105578 FLINT
INSTALL: QUARTER TURN REF. PLAN FOR PATTERN
LOCATION: PRIMARY CPT
CPT-2: MFG: INTERFACE
TYPE: 50CM X 50CM CARPET TILE
PATTERN: HUMAN CONNECTIONS, KERBSTONE
COLOR: 105574 FLINT
INSTALL: QUARTER TURN REF. PLAN FOR PATTERN
LOCATION: ACCENT
CPT-3: MFG: INTERFACE
TYPE: 50CM X 50CM CARPET TILE
PATTERN: HUMAN CONNECTIONS, SETT IN STONE
COLOR: 105570 FLINT
INSTALL: QUARTER TURN REF. PLAN FOR PATTERN
LOCATION: ACCENT
CPT-4: MFG: INTERFACE
TYPE: 50CM X 50CM CARPET TILE
PATTERN: HUMAN CONNECTIONS, MOSS IN STONE
COLOR: 105566 FLINT EDGE
INSTALL: QUARTER TURN REF. PLAN FOR PATTERN
LOCATION: LIBRARY
CPT-5: MFG: INTERFACE
TYPE: 50CM X 50CM CARPET TILE
PATTERN: HUMAN CONNECTIONS, MOSS
COLOR: 105562 FLINT/MOSS
INSTALL: QUARTER TURN REF. PLAN FOR PATTERN
LOCATION: LIBRARY
CPT-6: MFG: INTERFACE
TYPE: CUSTOM BROADLOOM
PATTERN: HUMAN CONNECTIONS, FLAGSTONE
COLOR: 105578 FLINT
INSTALL: PROVIDE CUSTOM BROADLOOM WITH SPECIFIED PATTERN AND COLOR WHERE REQUIRED AT STAIR TREAD & RISER- "UNBACKED 2 METER WIDE AT STAIRS" PROVIDE CARPET TILE AND MATCH UP WITH BROADLOOM AT OTHER LOCATIONS
LOCATION: MUSIC
WOM-1: MFG: INTERFACE
TYPE: 50CM X 50CM WALK-OFF CARPET
PATTERN: STEP REPEAT, SR899
COLOR: 105540 IRON
INSTALL: QUARTER TURN
LOCATION: VESTIBULES

RESILIENT FLOOR

LVT-1: MFG: INTERFACE
TYPE: 50CM X 50CM LUXURY VINYL TILE
PATTERN: A003 TEXTURED STONES
COLOR: A00309 MEDIUM CONCRETE
INSTALL: MONOLITHIC
LOCATION: PRIMARY LVT
LVT-2: MFG: INTERFACE
TYPE: 25CM X 1M LUXURY VINYL PLANK
PATTERN: A007 STUDIO SET
COLOR: A00702 PEWTER
INSTALL: ASHLAR
LOCATION: CORRIDORS + CAFETERIA
LVT-3: MFG: INTERFACE
TYPE: 25CM X 1M LUXURY VINYL PLANK
PATTERN: A007 STUDIO SET
COLOR: A00721 ELECTRIC BLUE
INSTALL: ASHLAR
LOCATION: CORRIDORS + CAFETERIA
LVT-4: MFG: INTERFACE
TYPE: 25CM X 1M LUXURY VINYL PLANK
PATTERN: A007 STUDIO SET
COLOR: A00716 ORANGE
INSTALL: ASHLAR
LOCATION: CORRIDORS + CAFETERIA

EPX-1: MFG: SHERWIN WILLIAMS GENERAL POLYMERS
TYPE: DECO FLAKE MOSAIC EPOXY
COLOR: 18" FLAKES, CRESCENT MOON
INSTALL: 4" INTEGRAL COVE BASE REF. SPECS
LOCATION: RESTROOMS, STORAGE

RS-1: MFG: SHERWIN WILLIAMS GENERAL POLYMERS
TYPE: FASTOP MULTI TOPFLOOR SL45 AT 1/4" NOMINAL WITH 40-60 MESH DRY SILICA SAND BROADCAST TO REJECTION
COLOR: #53 CHARCOAL, FASTOP T100 TOPCOAT AT 10-15 MILS DFT
INSTALL: 4" INTEGRAL COVE BASE REF. SPECS
LOCATION: KITCHEN

WALL BASE

RUBBER BASE
RB-1: MFG: JOHNSONITE
TYPE: 4" VINYL WALL BASE
COLOR: 63 BURNT UMBER
LOCATION: STANDARD

EPOXY/RESINOUS BASE
EB-1: MFG: SHERWIN WILLIAMS GENERAL POLYMERS
TYPE: 4" DECORATIVE MOSAIC EPOXY WALL BASE
COLOR: 18" FLAKES, CRESCENT MOON
INSTALL: INTEGRAL BASE, REF. SPECS
LOCATION: RESTROOMS, STORAGE CLOSETS

RSB-1: MFG: SHERWIN WILLIAMS GENERAL POLYMERS
TYPE: 4" INTEGRAL FASTOP WALL BASE, REF RS-1 AND SPECS
COLOR: #53 CHARCOAL
INSTALL: INTEGRAL BASE, REF. SPECS
LOCATION: KITCHEN

PAINT/WALL FINISH

PAINT
PT-1: MFG: SHERWIN WILLIAMS
TYPE: REF. SPECS
COLOR: SW7570 EGRET WHITE
LOCATION: STANDARD
PT-2: MFG: SHERWIN WILLIAMS
TYPE: REF. SPECS
COLOR: SW7069 IRON ORE
LOCATION: ACCENT, HM DOOR AND WINDOW FRAMES
PT-3: MFG: SHERWIN WILLIAMS
TYPE: REF. SPECS
COLOR: SW 6787 JAY BLUE
LOCATION: ACCENT
PT-4: MFG: SHERWIN WILLIAMS
TYPE: REF. SPECS
COLOR: EGGSHELL FINISH
LOCATION: ACCENT
PT-5: MFG: SHERWIN WILLIAMS
TYPE: REF. SPECS
COLOR: EGGSHELL FINISH
LOCATION: ACCENT

WALL TILE
WT-1: MFG: CROSSVILLE TILE
TYPE: 3"x12" GLAZED CERAMIC WALL TILE
PATTERN: SWATCHES
COLOR: COTTON, GLOSS
INSTALL: VARIES, REF. ELEVATIONS
REMARKS: AT RESTROOM WALL LOCATIONS, USE EB-1. BEGIN WT-1 AT 4" AFF. AT WATER FOUNTAIN LOCATIONS, OMIT EB-1 AND USE SCHLUTER DILEX-AHKA AT FINISHED FLOOR
WT-2: MFG: CROSSVILLE TILE
TYPE: 3"x12" GLAZED CERAMIC WALL TILE
PATTERN: SHADOW, GLOSS
INSTALL: VARIES, REF. ELEVATIONS
WT-3: NOT USED

PLASTIC LAMINATE/SOLID SURFACE

PLASTIC LAMINATE
PL-1: MFG: FORMICA
TYPE: PLASTIC LAMINATE
COLOR: 05794-NG BEIGE ELM (NATURAL GRAIN FINISH)
INSTALL: MONOLITHIC, HORIZONTAL GRAIN
PL-2: MFG: FORMICA
TYPE: PLASTIC LAMINATE
COLOR: 6698-46 PALOMA POLAR (MATTE FINISH)
INSTALL: MONOLITHIC
SOLID SURFACE
SS-1: MFG: FORMICA
TYPE: 1/2" SOLID SURFACE
COLOR: 758 BIANCO MINERAL
INSTALL: MONOLITHIC
REMARKS: SOLID SURFACE COUNTER TO GO WHERE SINKS ARE LOCATED

MISCELLANEOUS

ACOUSTIC PANELS
AP-1: MFG: MDC ZINTRA
TYPE: ZINTRA 1/2" WALL SHEETS
SHAPE: 4'X9' SHEETS, CUT TO SHAPE AND SIZE, REF ELEVATIONS
COLOR: PEBBLE
LOCATION: CAFETERIA
REMARKS: DIRECT GLUE DOWN, REF SPECS
AP-2: MFG: MDC ZINTRA
TYPE: ZINTRA 1/2" WALL SHEETS
SHAPE: 4'X9' SHEETS, CUT TO SHAPE AND SIZE, REF ELEVATIONS
COLOR: FOSSIL
LOCATION: CAFETERIA
REMARKS: DIRECT GLUE DOWN, REF SPECS
AP-3: MFG: MDC ZINTRA
TYPE: ZINTRA 1/2" WALL SHEETS
SHAPE: 4'X9' SHEETS, CUT TO SHAPE AND SIZE, REF ELEVATIONS
COLOR: SLATE
LOCATION: CAFETERIA
REMARKS: DIRECT GLUE DOWN, REF SPECS
AP-4: MFG: MDC ZINTRA
TYPE: ZINTRA 1/2" WALL SHEETS
SHAPE: 4'X9' SHEETS
COLOR: DIGITAL PRINT, DESIGNER TO APPROVE FINAL DESIGN
LOCATION: CAFETERIA
REMARKS: DIRECT GLUE DOWN, REF SPECS

CORNER GUARDS

CG-1: MFG: ACROVYN
TYPE: VA SERIES - FULL HEIGHT CORNER GUARD
COLOR: TO MATCH PT-1, DESIGNER TO APPROVE
LOCATION: PROVIDE AT ALL EXTERIOR DRYWALL CORNERS

WALL PROTECTION

WP-1: MFG: ACROVYN
TYPE: 4H WALL COVERING
COLOR: TO MATCH PT-1, DESIGNER TO APPROVE, SUEDE TEXTURE
INSTALL: KINDERGARTEN RESTROOMS
REMARKS: USE TRIM PIECES AS REQUIRED BY MANUFACTURER


REVISIONS:

#	Date	Desc.

100% CONSTRUCTION DOCUMENTS

PROJECT: #21140
DATE: 04.06.2022
DRAWN BY: Author


INTERIOR
FINISH LEGEND

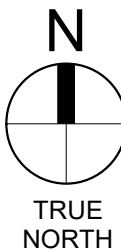


GENERAL NOTES
1. PROVIDE SCHLUTER TRIM WHERE TILE MEETS DISSIMILAR MATERIALS
2. DO NOT INSTALL GYPSUM BOARD BEHIND BACKER BOARD WHERE TILE FINISH IS INDICATED
3. VERIFY ALL WATER FOUNTAIN LOCATIONS IN FIELD

ELEVATION NOTES - INTERIOR

- 1 ACOUSTICAL PANELS (AP-1), REF FINISH LEGEND
2 WALL TILE 1 (WT-1), REF FINISH LEGEND
3 UPPER CABINETS ABOVE CUBBIES AS ALTERNATE.
4 WALL TILE 2 (WT-2), REF FINISH LEGEND
5 ACOUSTICAL PANELS (AP-2), REF FINISH LEGEND
6 ACOUSTICAL PANELS (AP-3), REF FINISH LEGEND
7 4" EPOXY BASE (EB-1), USE SCHLUTER JOLLY WHERE TILE AND EPOXY BASE MEET, REF FINISH LEGEND
8 NOT USED
9 HEAVY DUTY SHELVING WITH ADJUSTABLE BRACKETS ON TRACK SYSTEM, REF SPECS.
10 ACOUSTICAL PANELS (AP-4), REF FINISH LEGEND
11 WATERFALL SOLID SURFACE SS-1, REF FINISH LEGEND
12 PROVIDE ACCENT PAINT (PT-2) AND RB-1 AT THIS LOCATION, REF FINISH LEGEND
13 PROVIDE PL-1 AT THIS LOCATION, REF FINISH LEGEND

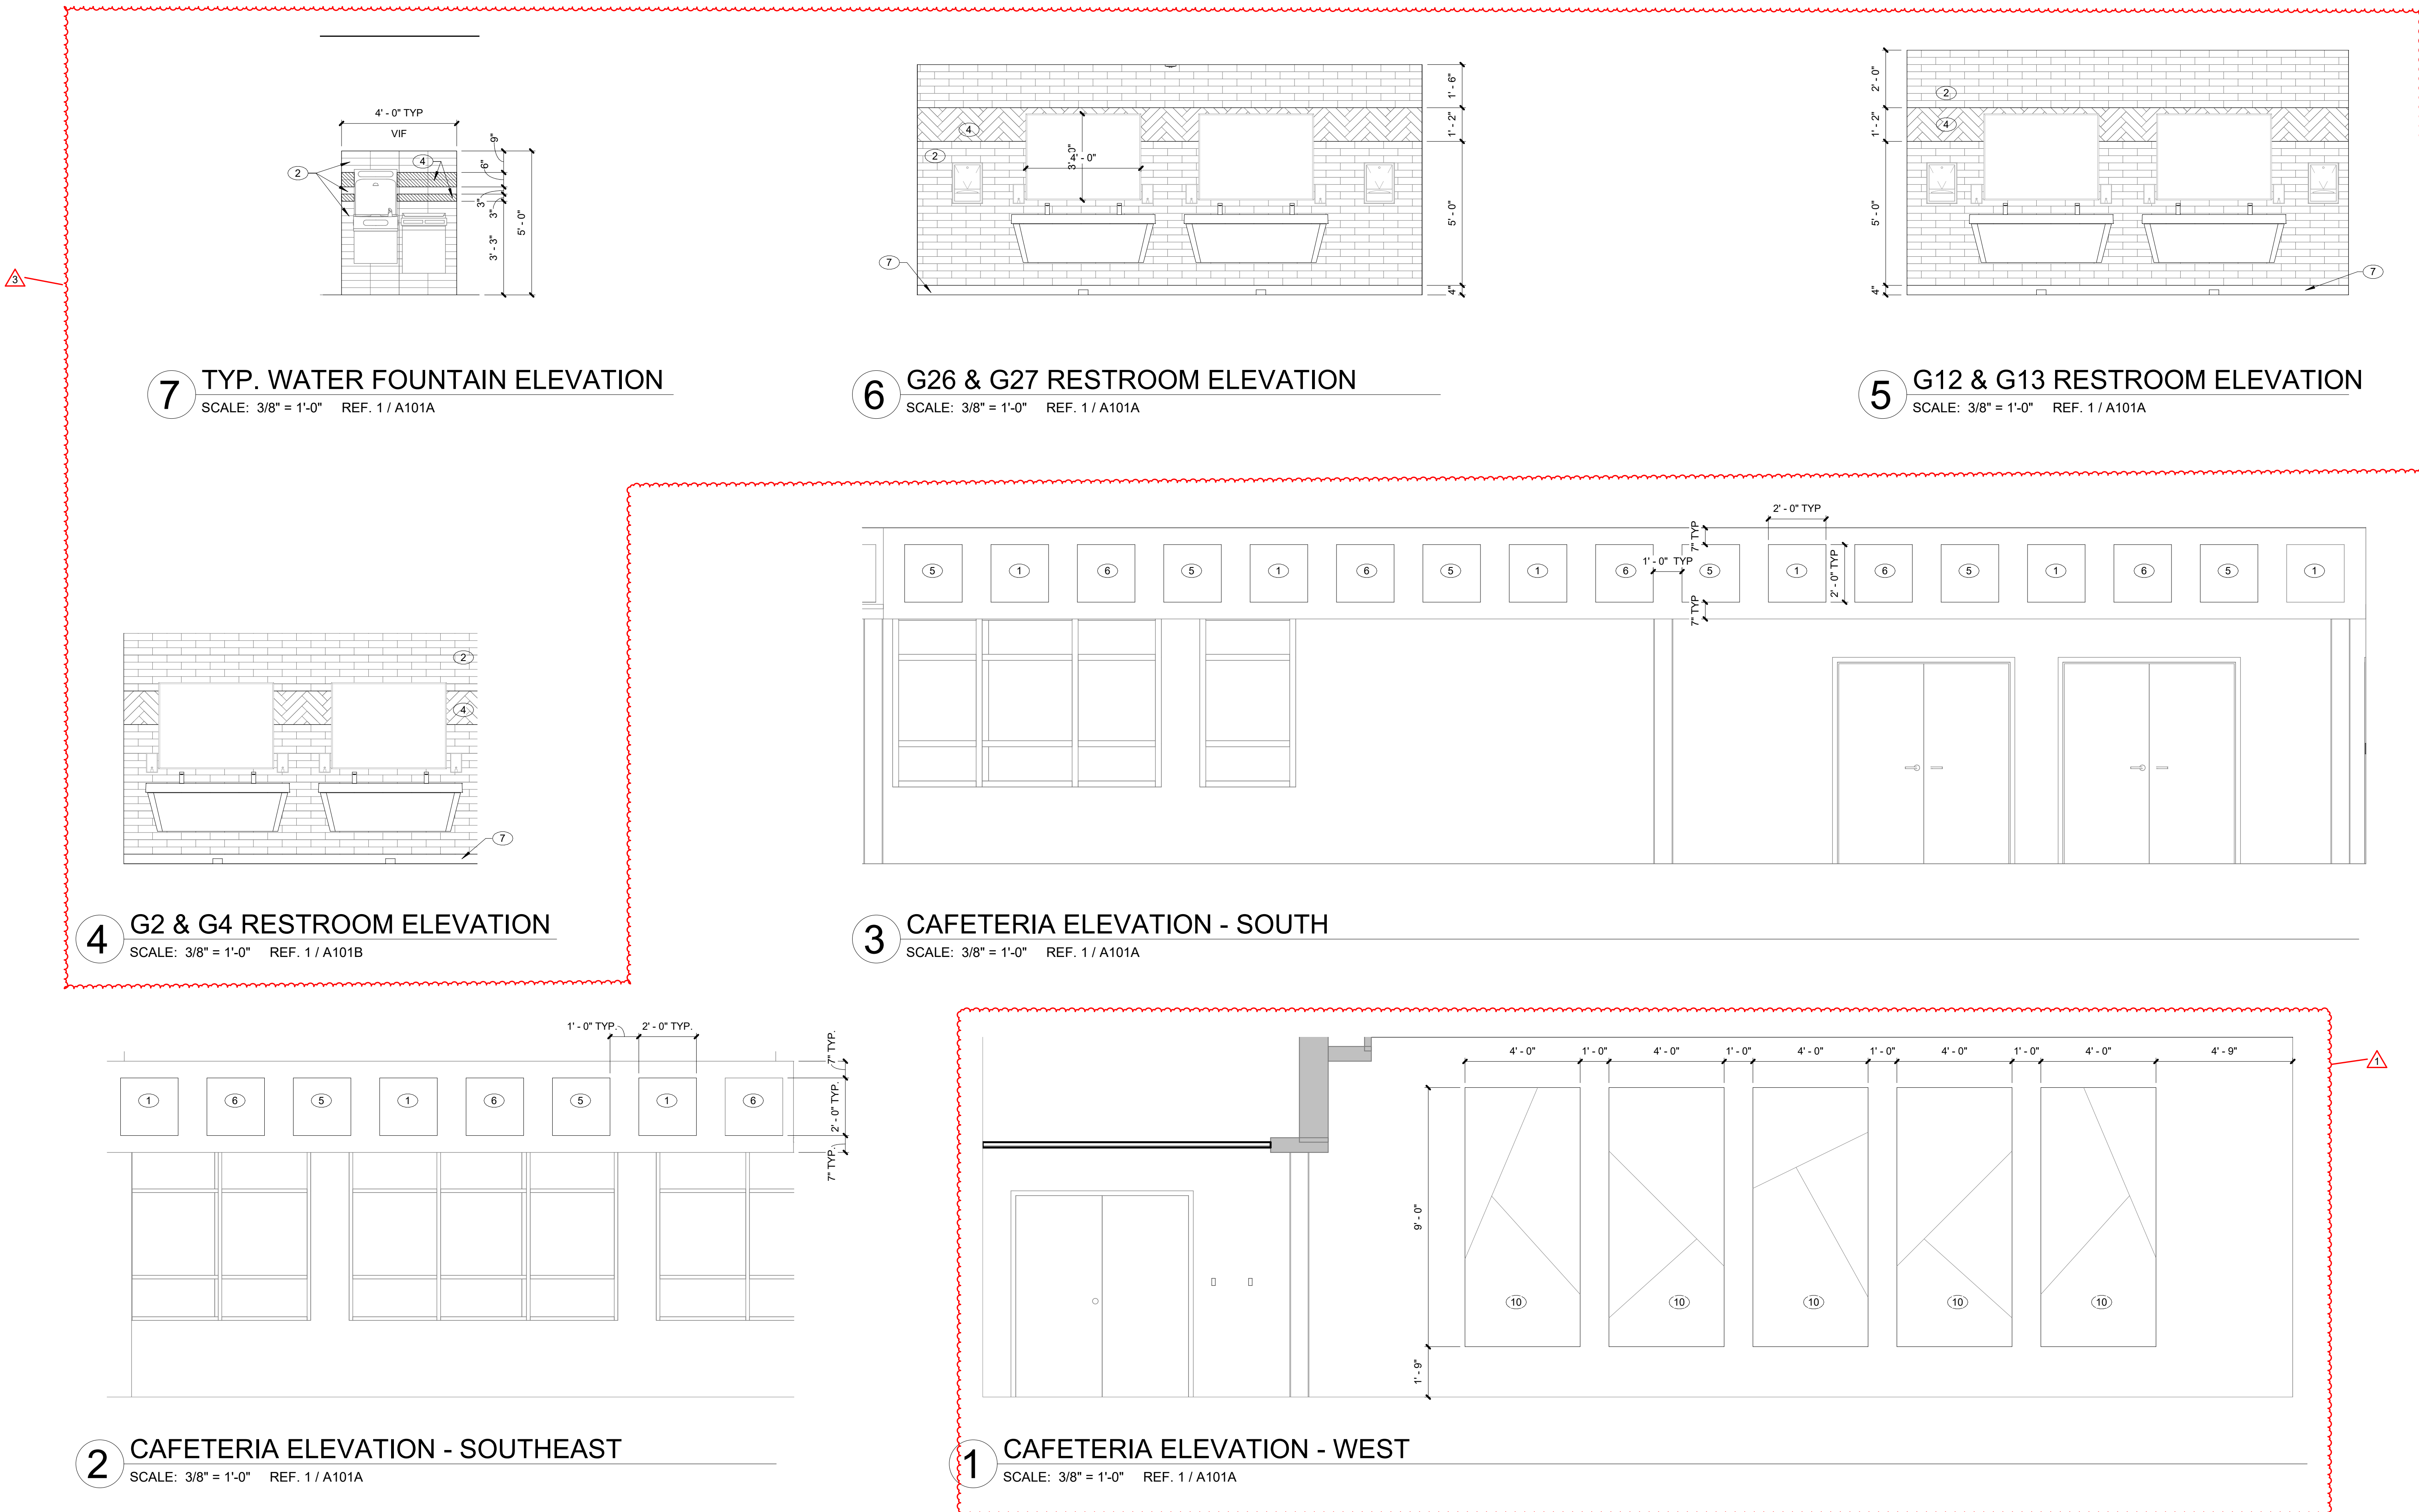


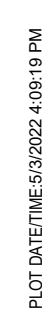

- 1 REMOVE WALL FIN TUBE RADIATION AND ALL HEATING HOT WATER PIPING LOCATED BEHIND UNIT AND PIPING AND CASEWORK COMPLETE
- 2 REMAINING WALL OPENINGS SHALL BE PATCHED BY OTHERS
- 3 DISCONNECT AND REMOVE EXISTING FRESH AIR PIPING FROM TRANSITION LOUVER. EXISTING EXTERIOR LOUVER TO REMAIN. CONFIRM LOUVER IS SEALED WEATHER TIGHT AND INSULATED WITHIN WALL VAPOR BARRIER. PROVIDE 2" CEILING PANEL ON EXISTING TRANSITION LOUVER WITH PAINTED SHEET METAL FLANGE SEALED TIGHT TO WALL. PAINT SHEETMETAL TO MATCH INTERIOR PANEL COLOR. COORDINATE WITH DIV. 26 FOR POWER CIRCUIT DISCONNECT WORK
- 4 REMOVE EXPOSED CEILING MOUNTED FAN COIL UNIT COMPLETE
- 5 REMOVE EXISTING DIV. 26 FAN OR POWER CIRCUIT DISCONNECT WORK. DISCONNECT FROM HEATING AND CHILLED WATER ROUNDOUTS MAKE READY FOR NEW UNIT INSTALLATION.
- 6 REMOVE EXISTING FRESH AIR TRANSITION FROM BACK INLET CONNECTIONS OF FCM MAKE READY EXISTING 10"X6 DUCT FOR NEW WORK.
- 7 REMOVE WALL MOUNTED TRANSITION GRILLE FROM JUMPER DUCT. JUMPER DUCT SHALL REMAIN AND WILL BE LOCATED ABOVE NEW CLASSROOM CEILING
- 8 REMOVE FRESH AIR SHOWN BACK TO LOCATION SHOWN AND CAP OF DUCT
- 9 REMOVE PIPING SHOWN BEHIND CEILING
- 10 REMOVE DIFFUSER, REGISTER, GRILLE FROM PANEL AND MAKE READY TO DISCONNECT. WIRING ROUTING AS POSSIBLE. REWORK ANY LOCATIONS WHERE DUCTWORK
- 11 REMOVE TRANSITION GRILLE FROM CEILING COMPLETE
- 12 REMOVE EXISTING WALL STAT, CONTROL WIRING, PNEUMATIC LINES COMPLETE. RE-USE LOCATION AND PATHWAY FOR NEW WALL STAT AND CONTROL WIRING ROUTING AS POSSIBLE. REWORK ANY LOCATIONS WHERE DUCTWORK
- 13 DISCONNECT AND REMOVE EXISTING CIRCUIT SETTER. PREPARE AND PROTECT FRESH OPENINGS FOR NEW WALL STAT AND CONTROL WIRING. READY CURBS FOR NEW FAN AND PROVIDE A4-CURBS AS REQUIRED. COORDINATE WITH DIV. 26
- 14 REMOVE EXISTING WALL STAT COMPLETE. PATCH REPAIRS WALL OPENING TO MATCH ADJACENT WALL
- 16 REMOVE EXISTING WALL MOUNTED CONVERTOR UNIT BACK TO PIPING CONNECTIONS TO FRESH AIR CEILING
- 17 REMOVE EXISTING STAT LOCATED ABOVE CEILING MOUNTED ON JOIST AND ASSOCIATED CONTROL WIRING, PNEUMATIC LINES COMPLETE.
- 18 COORDINATE WITH DIV. 26 FOR RE-CONNECTION TO NEW FAN COIL UNIT
- 19 EXISTING DOOR AIR CURTAIN TO REMAIN
- 20 DISCONNECT AND REMOVE VAV BOX WITH HYDRONIC COIL. INSTALLATION, DISCONNECT AND REMOVE FRESH AIR PIPING FOR NEW BOX INSTALLATION.
- 21 REMOVE EXISTING FRESH AIR PIPING FROM TRANSITION AND CHILLED WATER SUPPLY AND RETURN PIPING BACK TO 6" AWAY FROM WALL PREPARE AND PROTECT FRESH OPENINGS FOR NEW FAN COIL UNIT
- 22 EXISTING DOORWORK AND SUPPLY DIFFUSERS TO REMAIN. SEE SHEET H-101A FOR NEW WORK DETAILS
- 23 DISCONNECT AND REMOVE CONDENSATE DRAIN PIPING BACK TO POINT OF ORIGIN. PREPARE RE-CONNECTION FOR RECONNECTION TO NEW FAN COIL CONDENSATE DRAIN
- 24 SUPPLY AND RETURN DUCT UP TO HEXAGON ON ROOF.
- 25 REMOVE EXISTING DUCT FROM TRANSITION. PREPARE FOR RE-CONNECTION TO NEW EXHAUST AIR DUCTWORK.
- 26 REMOVE EXISTING FRESH AIR DUCT SHOWN DASHED COMPLETE. PREPARE AND PROTECT DUCT FOR TRANSITION TO NEW 8" O.D. DUCTWORK.
- 27 REMOVE EXISTING TRANSITION FROM TRANSITION TO TRANSITION AND ASSOCIATED DUCTWORK SHOWN DASHED BACK TO MAIN AND SEAL REMAINING OPENING AIR TIGHT. INSULATE TO MATCH EXISTING CONDITIONS.
- 28 REMOVE EXISTING AND REMOVE CHSRHCR AND CHSRHCR PATCH BACK TO MAIN COMPLETE AND CAP OFF
- 29 REMOVE DIFFUSER, REGISTER, GRILLE COMPLETE. PATCH OPENING TO MATCH EXISTING DASH AIR TIGHT
- 30 REMOVE EXISTING TRANSITION FROM TRANSITION TO POINT SHOWN. CAP OFF END OF EXISTING EXHAUST DUCT UP TO ROOF 8" ABOVE FINISHED CEILING. PREPARE FOR RE-CONNECTION TO NEW EXHAUST AIR DUCTWORK
- 31 EXISTING DUCT UP TO ROOF-MOUNTED GRAVITY VENTILATOR TO REMAIN. PREPARE AND PROTECT GRAVITY VENTILATOR. PREPARE FOR RE-CONNECTION TO ROOF-MOUNTED GRAVITY VENTILATOR
- 32 REMOVE EXISTING CABINET UNIT HEATER AND RELATED PIPING, CONTROLS
- 33 REMOVE EXISTING CABINET UNIT HEATER
- 34 REMOVE FRESH AIR DUCTWORK AND ALL ASSOCIATED APPURTENANCES BACK TO WHERE SHOWN
- 35 REMOVE EXISTING AND REMOVE EXISTING RADIANT CEILING PANEL AND ASSOCIATED SUPPORTS COMPLETE. REMOVE EXISTING FRESH PIPING AS REQUIRED TO ALLOW FOR INSTALLATION OF NEW RADIANT CEILING PANELS. PREPARE AND PROTECT FRESH OPENINGS FOR NEW RADIANT CEILING PANELS
- 36 EXISTING CONDENSATE LINE DOWN TO SINK DRAIN TO REMAIN

HD101A


PLT DATE/TIME: 5/20/2022 3:52:11 PM

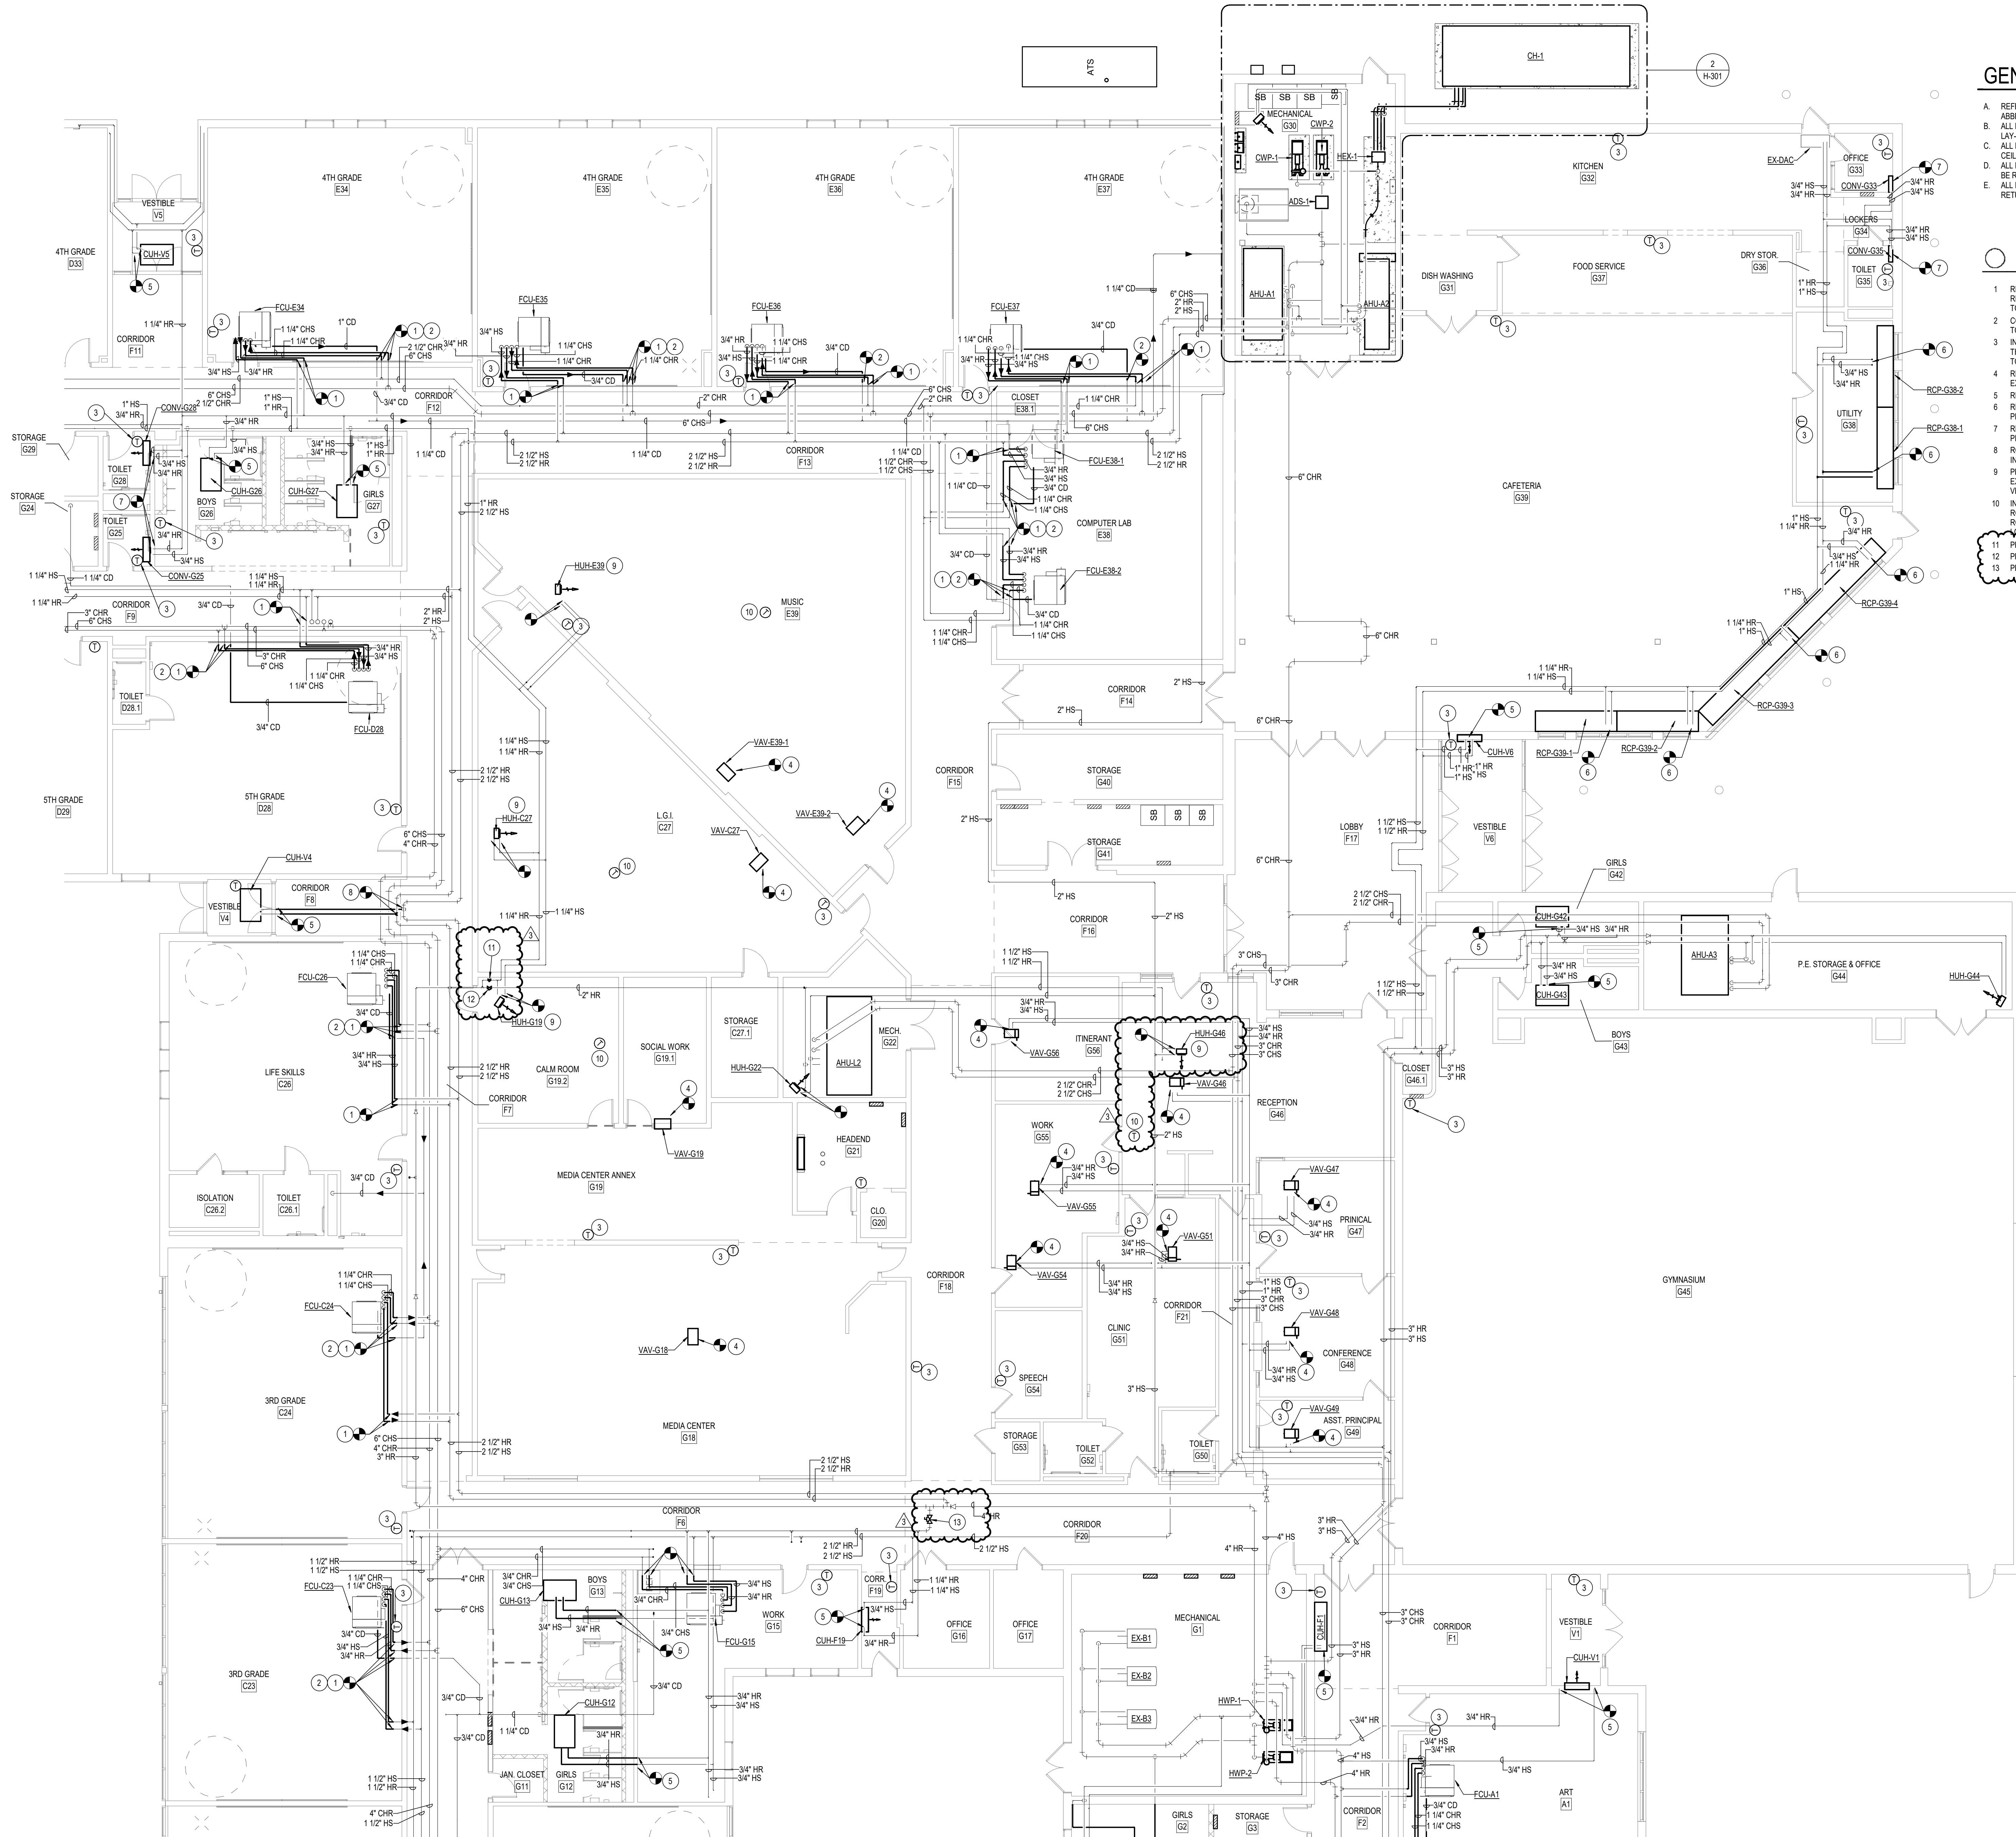

1 FIRST FLOOR HVAC PIPING PLAN - UNIT A
1/8" = 1'-0"

GENERAL MECHANICAL NOTES:

- A. REFERENCE SHEET M-000 FOR MECHANICAL SYMBOLS, LEGENDS, ABBREVIATIONS AND ADDITIONAL GENERAL NOTES.
- B. ALL NEW HORIZONTAL 4 PIPE FAN COIL UNITS ARE LOCATED ABOVE NEW LAY-IN CEILING.
- C. ALL FAN COIL UNITS SHALL UTILIZE A FILTERED RETURN GRILLE IN NEW CEILING WITH HINGED ACCESS DOOR.
- D. ALL PNEUMATIC CONTROLS, TUBING, AND ASSOCIATED APPURTENANCES TO BE REMOVED AND REPLACED WITH NEW DDC CONTROLS.
- E. ALL FAN COIL UNITS ARE TO BE INSTALLED WITH PERFORATED FACE FILTER RETURN GRILLES.

SHEET PLAN NOTES

- 1 RE-CONNECT EXISTING CHILLED AND HOT WATER SUPPLY AND RETURN PIPING TO NEW FAN COIL UNIT. EXTEND PIPING AS REQUIRED TO MAKE CONNECTION TO THE UNIT.
- 2 CONNECT NEW CONDENSATE DRAIN PIPING TO EXISTING AND ROUTE TO NEW FAN COIL UNIT PER MANUFACTURERS INSTRUCTIONS.
- 3 INSTALL NEW WALL STAT 4" AFF AT EXISTING LOCATION. ROUTE THROUGH EXISTING PATHWAY FOR NEW CONTROL WIRING ROUTING TO NEW EQUIPMENT AS REQUIRED.
- 4 RE-CONNECT EXISTING HSHR TO NEW VAV TERMINAL UNIT. CONFIRM EXISTING PIPE SIZING AND ROUTING.
- 5 RE-CONNECT NEW CABINET UNIT HEATER TO EXISTING HSHR PIPING.
- 6 RE-CONNECT NEW RADIANT CEILING PANEL TO EXISTING HSHR PIPING.
- 7 RE-CONNECT NEW HOT WATER CONNECTOR TO EXISTING HSHR PIPING.
- 8 ROUTE NEW HSHR PIPING FROM NEW CABINET UNIT HEATER AND TAP INTO EXISTING MAIN.
- 9 PROVIDE NEW HYDRONIC UNIT HEATER ABOVE CEILING. RECONNECT EXISTING HSHR TO HEATER AND INSULATE PIPE TO MATCH EXISTING. VERIFY UNIT LOCATION AND SIZE PRIOR TO BID.
- 10 INSTALL NEW WALL STAT ABOVE CEILING AT EXISTING LOCATION. ROUTE THROUGH EXISTING PATHWAY FOR NEW CONTROL WIRING ROUTING TO NEW EQUIPMENT AS REQUIRED. VERIFY THERMOSTAT TYPE AND LOCATION.
- 11 PROVIDE NEW CIRCUIT SETTER SET TO 31.6 GPM.
- 12 PROVIDE NEW CIRCUIT SETTER SET TO 19.1 GPM.
- 13 PROVIDE NEW CIRCUIT SETTER SET TO 63.9 GPM.

ILANCER + BEEBE, LLC
ARCHITECTURE | PLANNING | INTERIORS
220 N. COLLEGE AVE
INDIANAPOLIS, IN 46202



CIRCLE
DESIGN GROUP
INDIANAPOLIS, IN | 317.761.6200
CIRCLEDESIGNGROUP.COM

GRILLE AND DIFFUSER SCHEDULE

DIFFUSER

TYPE \swarrow CFM
NECK SIZE

GRILLE

TYPE \swarrow CFM
SIZE

DRAWING LEGEND

SLOT/LINEAR DIFFUSER

TYPE \swarrow CFM
NO. OF SLOTS - LENGTH

LINEAR BAR DIFFUSER

TYPE \swarrow CFM
WIDTH - LENGTH


TYPE	DESCRIPTION	SPECIAL NOTES & FINISHES
B	24"x24" SQUARE CONE CEILING DIFFUSER	
C	12"x12" SQUARE PLAQUE SUPPLY	ROUND NECK
D	24" X 24" SQUARE PLAQUE CEILING DIFFUSER	ROUND NECK
FR	FILTER RETURN GRILLE	
G	LOUVERED RETURN GRILLE	
H	LOUVERED EXHAUST GRILLE	OPPOSED BLADE DAMPER
K	PLENUM SLOT DIFFUSER	
R	SQUARE RETURN GRILLE	ALUMINUM CONSTRUCTION
EX	EXISTING GRILLE/DIFFUSER	BALANCE TO CFM LISTED


PUMP SCHEDULE																			
MARK	LOCATION	SYSTEM	TYPE	ENERGY EFFICIENCY RATINGS		DESIGN CAPACITY (GPM)	DESIGN CAPACITY (FT. HD)	MIN EFF.	PUMP DATA			MOTOR DATA				WEIGHT (LBS.)	MANUFACTURER WITH MODEL NUMBER	NOTES	
				PUMP & MOTOR PElcl	PUMP/MOTOR/DRIVE PElcl				IMP SIZE (IN)	SUCT. (IN)	DISCH (IN)	HP	BHP	RPM	VOLTS				PH
HWP-1	MECH G1	HEATING WATER	BASE MOUNTED END SUCTION	0.92	0.45	300	100	73.6	10.375	4	3	15	10.1	1800	208	3	510	BELL & GOSSETT e-1510 3EB	1
HWP-2	MECH G1	HEATING WATER	BASE MOUNTED END SUCTION	0.92	0.45	300	100	73.6	10.375	4	3	15	10.1	1800	208	3	510	BELL & GOSSETT e-1510 3EB	1
CWP-1	MECH G30	CHILLED WATER	BASE MOUNTED END SUCTION	0.89	0.44	410	125	74.9	12.5	4	3	25	17.3	1800	208	3	798	BELL & GOSSETT e-1510 3GB	1
CWP-2	MECH G30	CHILLED WATER	BASE MOUNTED END SUCTION	0.89	0.44	410	125	74.9	12.5	4	3	25	17.3	1800	208	3	798	BELL & GOSSETT e-1510 3GB	1
NOTES																			
1. VFD CONTROLS																			

SHELBYVILLE CENTRAL SCHOOLS
CORPORATION
LOPER ELEMENTARY RENOVATIONS & ADDITIONS
901 LOPER DRIVE

AIR DIRT SEPARATOR SCHEDULE						
MARK	SYSTEM	SIZE	DESIGN FLOW (GPM)	WPD	MANUFACTURER WITH MODEL NUMBER	NOTES
ADS-1	CHILLED WATER	6"	425	1.33"	BELL & GOSSETT CRSN-6F	1-3
NOTES: 1. 6" FLANGED COALESCING STYLE AIR & SEDIMENT COMBO SEPARATOR.						

HOT WATER REHEAT TERMINAL UNIT SCHEDULE																	
MARK	LOCATION	AIRFLOW DATA			UNIT INLET SIZE	MAX PRESS LOSS IN VYG	MAX DIS NC	HYDRONIC HEATING COIL DATA								MANUFACTURER WITH MODEL NUMBER	NOTES
		DESIGN CFM	MIN CFM	HEAT HTR MIN CFM				MIN MBH	EAT	LAT	ROWS	EWIT	LWT	GPM	MAX WPD		
VAV-G27	L.G.I.	1700	510	1020	14"	0.45	25	42.7	55	93.6	3	130	100	2.8	0.6		1
VAV-E39-1	MUSIC	1150	345	690	12"	0.44	25	26.6	55	90.5	3	130	100	1.8	0.6	TRANE VCVF 12	1
VAV-E39-2	MUSIC	1150	345	690	12"	0.44	25	26.6	55	90.5	3	130	100	1.8	0.6	TRANE VCVF 12	1
VAV-G18	MEDIA CENTER	1300	390	780	14"	0.29	25	34.9	55	96.2	3	130	100	2.3	0.6	TRANE VCVF 14	1
VAV-G19	MEDIA CENTER ANNEX	1300	390	780	14"	0.29	25	34.9	55	96.2	3	130	100	2.3	0.6	TRANE VCVF 14	1
VAV-G46	RECEPTION	480	240	290	8"	0.38	25	10.7	55	89	3	130	100	0.8	0.6	TRANE VCVF 8	1
VAV-G47	PRINCIPAL	130	70	80	4"	0.04	25	3.3	55	92.7	1	130	100	0.5	0.6	TRANE VCVF 4	1
VAV-G48	CONFERENCE	225	115	135	4"	0.12	25	5.7	55	94.2	2	130	100	0.5	0.6	TRANE VCVF 4	1
VAV-G49	ASST. PRINCIPAL	100	50	60	4"	0.03	25	2.9	55	99.1	1	130	100	0.5	0.6	TRANE VCVF 4	1
VAV-G51	CLINIC	235	120	145	5"	0.14	25	5.9	55	92.7	2	130	100	0.5	0.6	TRANE VCVF 5	1
VAV-G54	WORK	150	75	90	4"	0.04	25	3.5	55	90.3	1	130	100	0.5	0.6	TRANE VCVF 4	1
VAV-G55	WORK	400	200	240	8"	0.29	25	9.25	55	90.5	3	130	100	0.7	0.6	TRANE VCVF 8	1
VAV-G56	ITNERANT	230	115	140	5"	0.130	25	5.8	55	93.4	2	130	100	0.5	0.6	TRANE VCVF 5	1
NOTES:																	
1.	MANUFACTURER PROVIDED DISCONNECT SWITCH.																





No. 11700201
STATE OF
INDIANA
NATIONAL ARCHIVES AND RECORDS ADMINISTRATION

DATE SIGNED
DATE EXPIRES

04/06/22
07/31/22

REVISIONS:

#	Date	Desc.
2	04-26-2022	ADDENDUM #2
3	05-03-2022	ADDENDUM #3

100% CONSTRUCTION

CDC PROJECT: 211120B

DOCUMENTS

DATE: 04.06.2022

DRAWN BY: Author

FAN COIL UNIT SCHEDULE (4-PIPE)																																							
MARK	LOCATION	CONFIGURATION	SUPPLY FAN DATA										HYDRONIC HEATING COIL SELECTION DATA										HYDRONIC COOLING COIL SELECTION DATA										FILTER DATA		UNIT WEIGHT (LBS)	MANUFACTURER WITH MODEL NUMBER	NOTES		
			SUPPLY CFM	OA CFM	ESP	QTY	RPM	DRIVE TYPE	HP	MCA	VOLTS	PH	MIN MBH	EAT	LAT	ROWS	FINS/ INCH	EWT	LWT	GPM	MAX WFO	TOTAL MBH	SENS MBH	EAT		LAT		ROWS	FINS/INCH	EWT	GPM	MAX WPD	TYPE	EFF					
																								DB	WB	DB	WB												
FCU-A1	ART	HORIZONTAL HIDEAWAY	1200	480	0.32	2	1000	EA	DIRECT	1/4 EA	3.6	208	1	37.9	70	99.2	3	10	130	100	2.4	0.96	30.4	23.1	75	64	57.5	55.4	4	10	42	4.7	5.95	1" PLEATED	MERV 8	224	KRUEGER KHSP 14	1.2,3	
FCU-A2	1ST GRADE	HORIZONTAL HIDEAWAY	1200	480	0.32	2	1000	EA	DIRECT	1/4 EA	3.6	208	1	37.9	70	99.2	3	10	130	100	2.4	0.96	30.4	23.1	75	64	57.5	55.4	4	10	42	4.7	5.95	1" PLEATED	MERV 8	224	KRUEGER KHSP 14	1.2,3	
FCU-A3	1ST GRADE	HORIZONTAL HIDEAWAY	1200	480	0.32	2	1000	EA	DIRECT	1/4 EA	3.6	208	1	37.9	70	99.2	3	10	130	100	2.4	0.96	30.4	23.1	75	64	57.5	55.4	4	10	42	4.7	5.95	1" PLEATED	MERV 8	224	KRUEGER KHSP 14	1.2,3	
FCU-A4	1ST GRADE	HORIZONTAL HIDEAWAY	1200	480	0.32	2	1000	EA	DIRECT	1/4 EA	3.6	208	1	37.9	70	99.2	3	10	130	100	2.4	0.96	30.4	23.1	75	64	57.5	55.4	4	10	42	4.7	5.95	1" PLEATED	MERV 8	224	KRUEGER KHSP 14	1.2,3	
FCU-A5	1ST GRADE	HORIZONTAL HIDEAWAY	1200	480	0.32	2	1000	EA	DIRECT	1/4 EA	3.6	208	1	37.9	70	99.2	3	10	130	100	2.4	0.96	30.4	23.1	75	64	57.5	55.4	4	10	42	4.7	5.95	1" PLEATED	MERV 8	224	KRUEGER KHSP 14	1.2,3	
FCU-A6	1ST GRADE	HORIZONTAL HIDEAWAY	1200	480	0.32	2	1000	EA	DIRECT	1/4 EA	3.6	208	1	37.9	70	99.2	3	10	130	100	2.4	0.96	30.4	23.1	75	64	57.5	55.4	4	10	42	4.7	5.95	1" PLEATED	MERV 8	224	KRUEGER KHSP 14	1.2,3	
FCU-A7	1ST GRADE	HORIZONTAL HIDEAWAY	1200	480	0.32	2	1000	EA	DIRECT	1/4 EA	3.6	208	1	37.9	70	99.2	3	10	130	100	2.4	0.96	30.4	23.1	75	64	57.5	55.4	4	10	42	4.7	5.95	1" PLEATED	MERV 8	224	KRUEGER KHSP 14	1.2,3	
FCU-B12	KINDERGARTEN	HORIZONTAL HIDEAWAY	1200	48																																			

MARK#	LOCATION	CFM		COOLING BTUH	ELECTRICAL DATA				SEER	REFRIG.	WEIGHT (LBS)	MANUFACTURER WITH MODEL NUMBER (INDOOR/OUTDOOR)	NOTES
		HIGH	LOW		MCA	MOPC	VOLTS	PH					
AC-1	STORAGE G9	1095	600	33	23	30	208	1	18.5	R410A	-	LG LSN363HLV3 / LG LSL363HLV3	1,2,3,4,5,6,7,8
AC-2	HEADEND G21	340	95	12	10	15	208	1	22.7	R410A	-	LG LSN120HSV5 / LG LSL120HSV5	1,2,3,4,5,6,7,8
NOTES: 1. INDOOR UNIT POWERED FROM OUTDOOR UNIT. 2. WIND BAFFLE FOR LOW AMBIENT COOLING, WB-P4, WB-SD4, AND WB-RE4. 3. INDOOR AND OUTDOOR UNITS TO BE FACTORY MATCHED. 4. PROVIDE CONDENSATE PUMP FOR INSTALLATION IN THE FIELD. 5. DISCONNECT PROVIDED BY EC 6. MANUFACTURER TO SIZE RS/RL PIPING LINE SET. RS/RL PIPING TO BOTH BE INSULATED. SEE DETAIL MM-H01. 7. MOUNT UNIT TO ROOF EQUIPMENT SUPPORT CURBS. 8. PROVIDE BACNET CONTROLLER FOR INTEGRATION TO BMS													

HYDRONIC CONVECTOR SCHEDULE										
MARK	LOCATION	CABINET TYPE	HEATING ELEMENT SELECTION DATA					MANUFACTURER WITH MODEL NUMBER	NOTES	
			MIN MBH	EAT	AVG EWT	ROWS	GPM			MAX WPD
CONV-G8	TOILET G8	SLOPE TOP CONVECTOR	1.5	70	115	2	0.1	-	MODINE SLO43818	1.2
CONV-G25	TOILET G25	SLOPE TOP CONVECTOR	1.5	70	115	2	0.1	-	MODINE SLO43818	1.2
CONV-G28	TOILET G28	SLOPE TOP CONVECTOR	1.5	70	115	2	0.1	-	MODINE SLO43818	1.2
CONV-G33	OFFICE G33	SLOPE TOP CONVECTOR	1.5	70	115	2	0.1	-	MODINE SLO43818	1.2
CONV-G35	TOILET G35	SLOPE TOP CONVECTOR	1.5	70	115	2	0.1	-	MODINE SLO43818	1.2
NOTES:										
1. FINAL COLOR TO BE CHOSEN BY ARCHITECT.										
2. PROVIDE WALL MOUNTED THERMOSTAT.										

RADIANT CEILING PANEL SCHEDULE												
SPECIFICATION SECTION 23 82 39												
MARK	LOCATION	PANEL LENGTH	PANEL WIDTH	CAPACITY BUTHLIN FT.	# OF PASSES	# OF TUBES	AVERAGE WATER TEMP. °F	GPM	WATER PRESSURE DROP PER 100 FT	HWS-R RUNOUT SIZE (IN)	MANUFACTURER WITH MODEL NUMBER	NOTES
RCP-B14	ACTIVITY LAB B14	16'	12"	78	4	1	115	0.1	0.5	5/8	VULCAN LRP 16	1
RCP-B14.1	LAB STORAGE B14.1	14'	24"	167	8	1	115	0.2	0.5	5/8	VULCAN LRP 14	1
RCP-G10	STORAGE G10	14'	24"	167	8	1	115	0.2	0.5	5/8	VULCAN LRP 14	1
RCP-G38-1	UTILITY G38	10'	24"	167	8	1	115	0.1	0.5	5/8	VULCAN LRP 10	1
RCP-G38-2	UTILITY G38	10'	24"	167	8	1	115	0.1	0.5	5/8	VULCAN LRP 10	1
RCP-G39-1	CAFETERIA G39	10'	30"	200	10	1	115	0.15	0.5	5/8	VULCAN LRP 10	1
RCP-G39-2	CAFETERIA G39	10'	30"	200	10	1	115	0.15	0.5	5/8	VULCAN LRP 10	1
RCP-G39-3	CAFETERIA G39	15'	30"	200	10	1	115	0.2	0.5	5/8	VULCAN LRP 15	1
RCP-G39-4	CAFETERIA G39	15'	30"	200	10	1	115	0.2	0.5	5/8	VULCAN LRP 15	1
RCP-F4-1	CORRIDOR F4	10'	24"	167	8	1	115	0.1	0.5	5/8	VULCAN LRP 10	1
RCP-F4-2	CORRIDOR F4	15'	24"	167	8	1	115	0.2	0.5	5/8	VULCAN LRP 15	1
RCP-F4-3	CORRIDOR F4	15'	24"	167	8	1	115	0.2	0.5	5/8	VULCAN LRP 15	1
RCP-F4-4	CORRIDOR F4	15'	24"	167	8	1	115	0.2	0.5	5/8	VULCAN LRP 15	1
NOTES												
1. PROVIDE WALL MOUNTED THERMOSTAT.												

LANCER + BEEBE, LLC
ARCHITECTURE | PLANNING | INTERIORS

220 N. COLLEGE AVE
INDIANAPOLIS, IN 46202

SHELBYVILLE CENTRAL SCHOOLS
CORPORATION
LOPER ELEMENTARY RENOVATIONS & ADDITIONS
901 LOPER DRIVE



DATE SIGNED 04/06/22
DATE EXPIRES 07/31/22


#	Date	Desc.
2	04/26/2022	ADDENDUM #2
3	05/03/2022	ADDENDUM #3

**100% CONSTRUCTION
DOCUMENTS**

CDG PROJECT: #21102B
DATE: 04.06.2022
DRAWN BY: TC

HVAC SCHEDULES

H-502

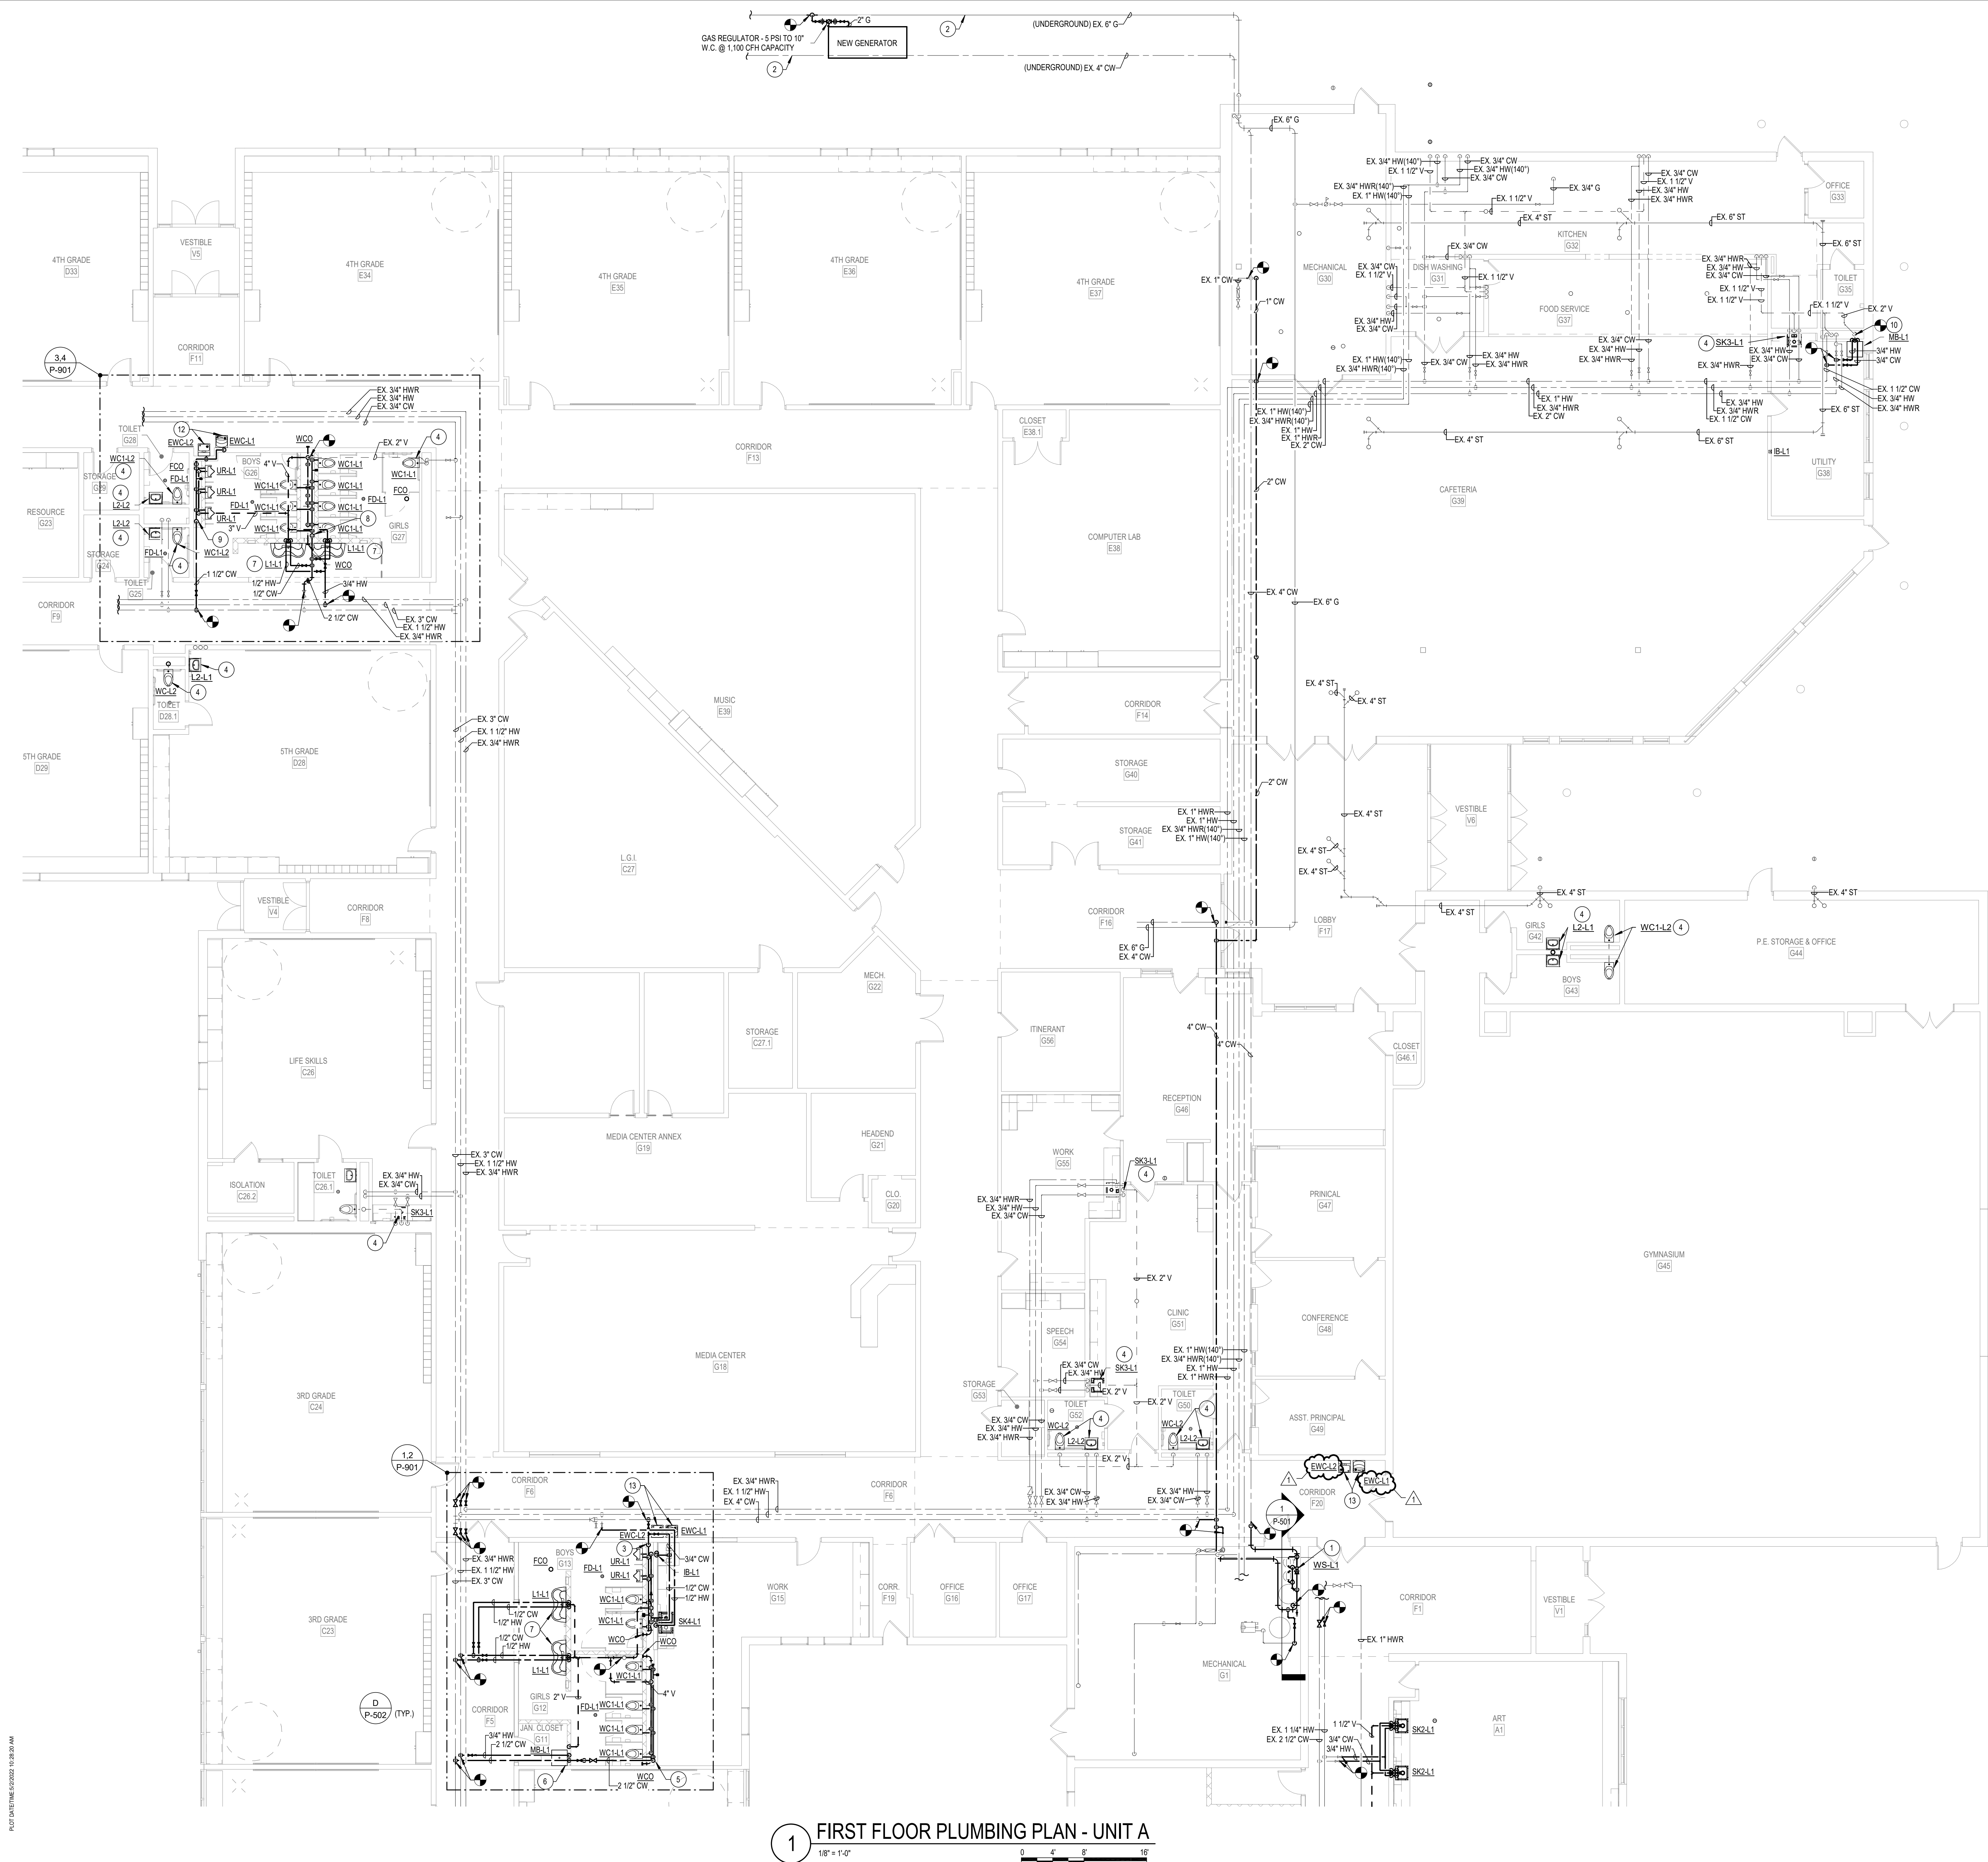

GENERAL PLUMBING NOTES:

A. REFERENCE SHEET M-000 FOR PLUMBING SYMBOLS, LEGENDS, ABBREVIATIONS AND ADDITIONAL GENERAL NOTES.

SHEET PLAN NOTES

- 1 DUPLEX WATER SOFTENER TO SERVE DOMESTIC HOT AND COLD WATER SYSTEMS.
- 2 CONTRACTOR TO VERIFY LOCATION OF UNDERGROUND UTILITIES - RELOCATE UNDERGROUND MAINS FROM BELOW FOOTPRINT OF GENERATOR.
- 3 2" CW DOWN IN CHASE, ROUTE 2" CW LINE FULL SIZE. PROVIDE WHA 'B'.
- 4 CONNECT NEW PLUMBING FIXTURE TO EXISTING WATER, WASTE, AND VENT PIPING.
- 5 2 1/2" CW DOWN IN CHASE, ROUTE 2 1/2" CW LINE FULL SIZE. PROVIDE WHA 'C'.
- 6 3/4" CW AND 3/4" HW DROP, 2" V RISE, 3" W DOWN. PROVIDE CHECK VALVE ON CW AND HW DROP.
- 7 1/2" CW AND 1/2" HW DROP, 1 1/2" V RISE, 2" W DOWN.
- 8 2 1/2" CW DOWN IN CHASE, ROUTE 2 1/2" CW LINE FULL SIZE. PROVIDE WHA 'D'.
- 9 1 1/2" CW DOWN IN CHASE, ROUTE 1 1/2" CW LINE FULL SIZE. PROVIDE WHA 'B'.
- 10 CONNECT NEW 2" VENT PIPING FROM MOP BASIN TO EXISTING 2" VENT PIPING IN CHASE.
- 12 CONNECT NEW PLUMBING FIXTURE TO NEW WATER PIPING AND EXISTING WASTE AND VENT PIPING.
- 13 CONNECT NEW PLUMBING FIXTURE TO EXISTING WATER, WASTE, AND VENT PIPING. PROVIDE SHUT OFF VALVE ON COLD WATER LINE.


REVISIONS:			
#	Date	Desc.	
1	04.06.2022	Addendum 3	

100% Construction Documents


CDG PROJECT: #211028
DATE: 04.06.2022
DRAWN BY: CCW/IOP


FIRST FLOOR
PLUMBING
PLAN - UNIT A

P-101A

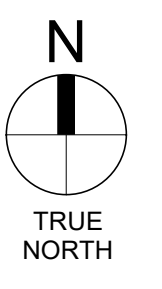

1 FIRST FLOOR PLUMBING PLAN - UNIT A
1/8" = 1'-0"

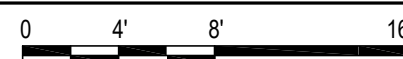

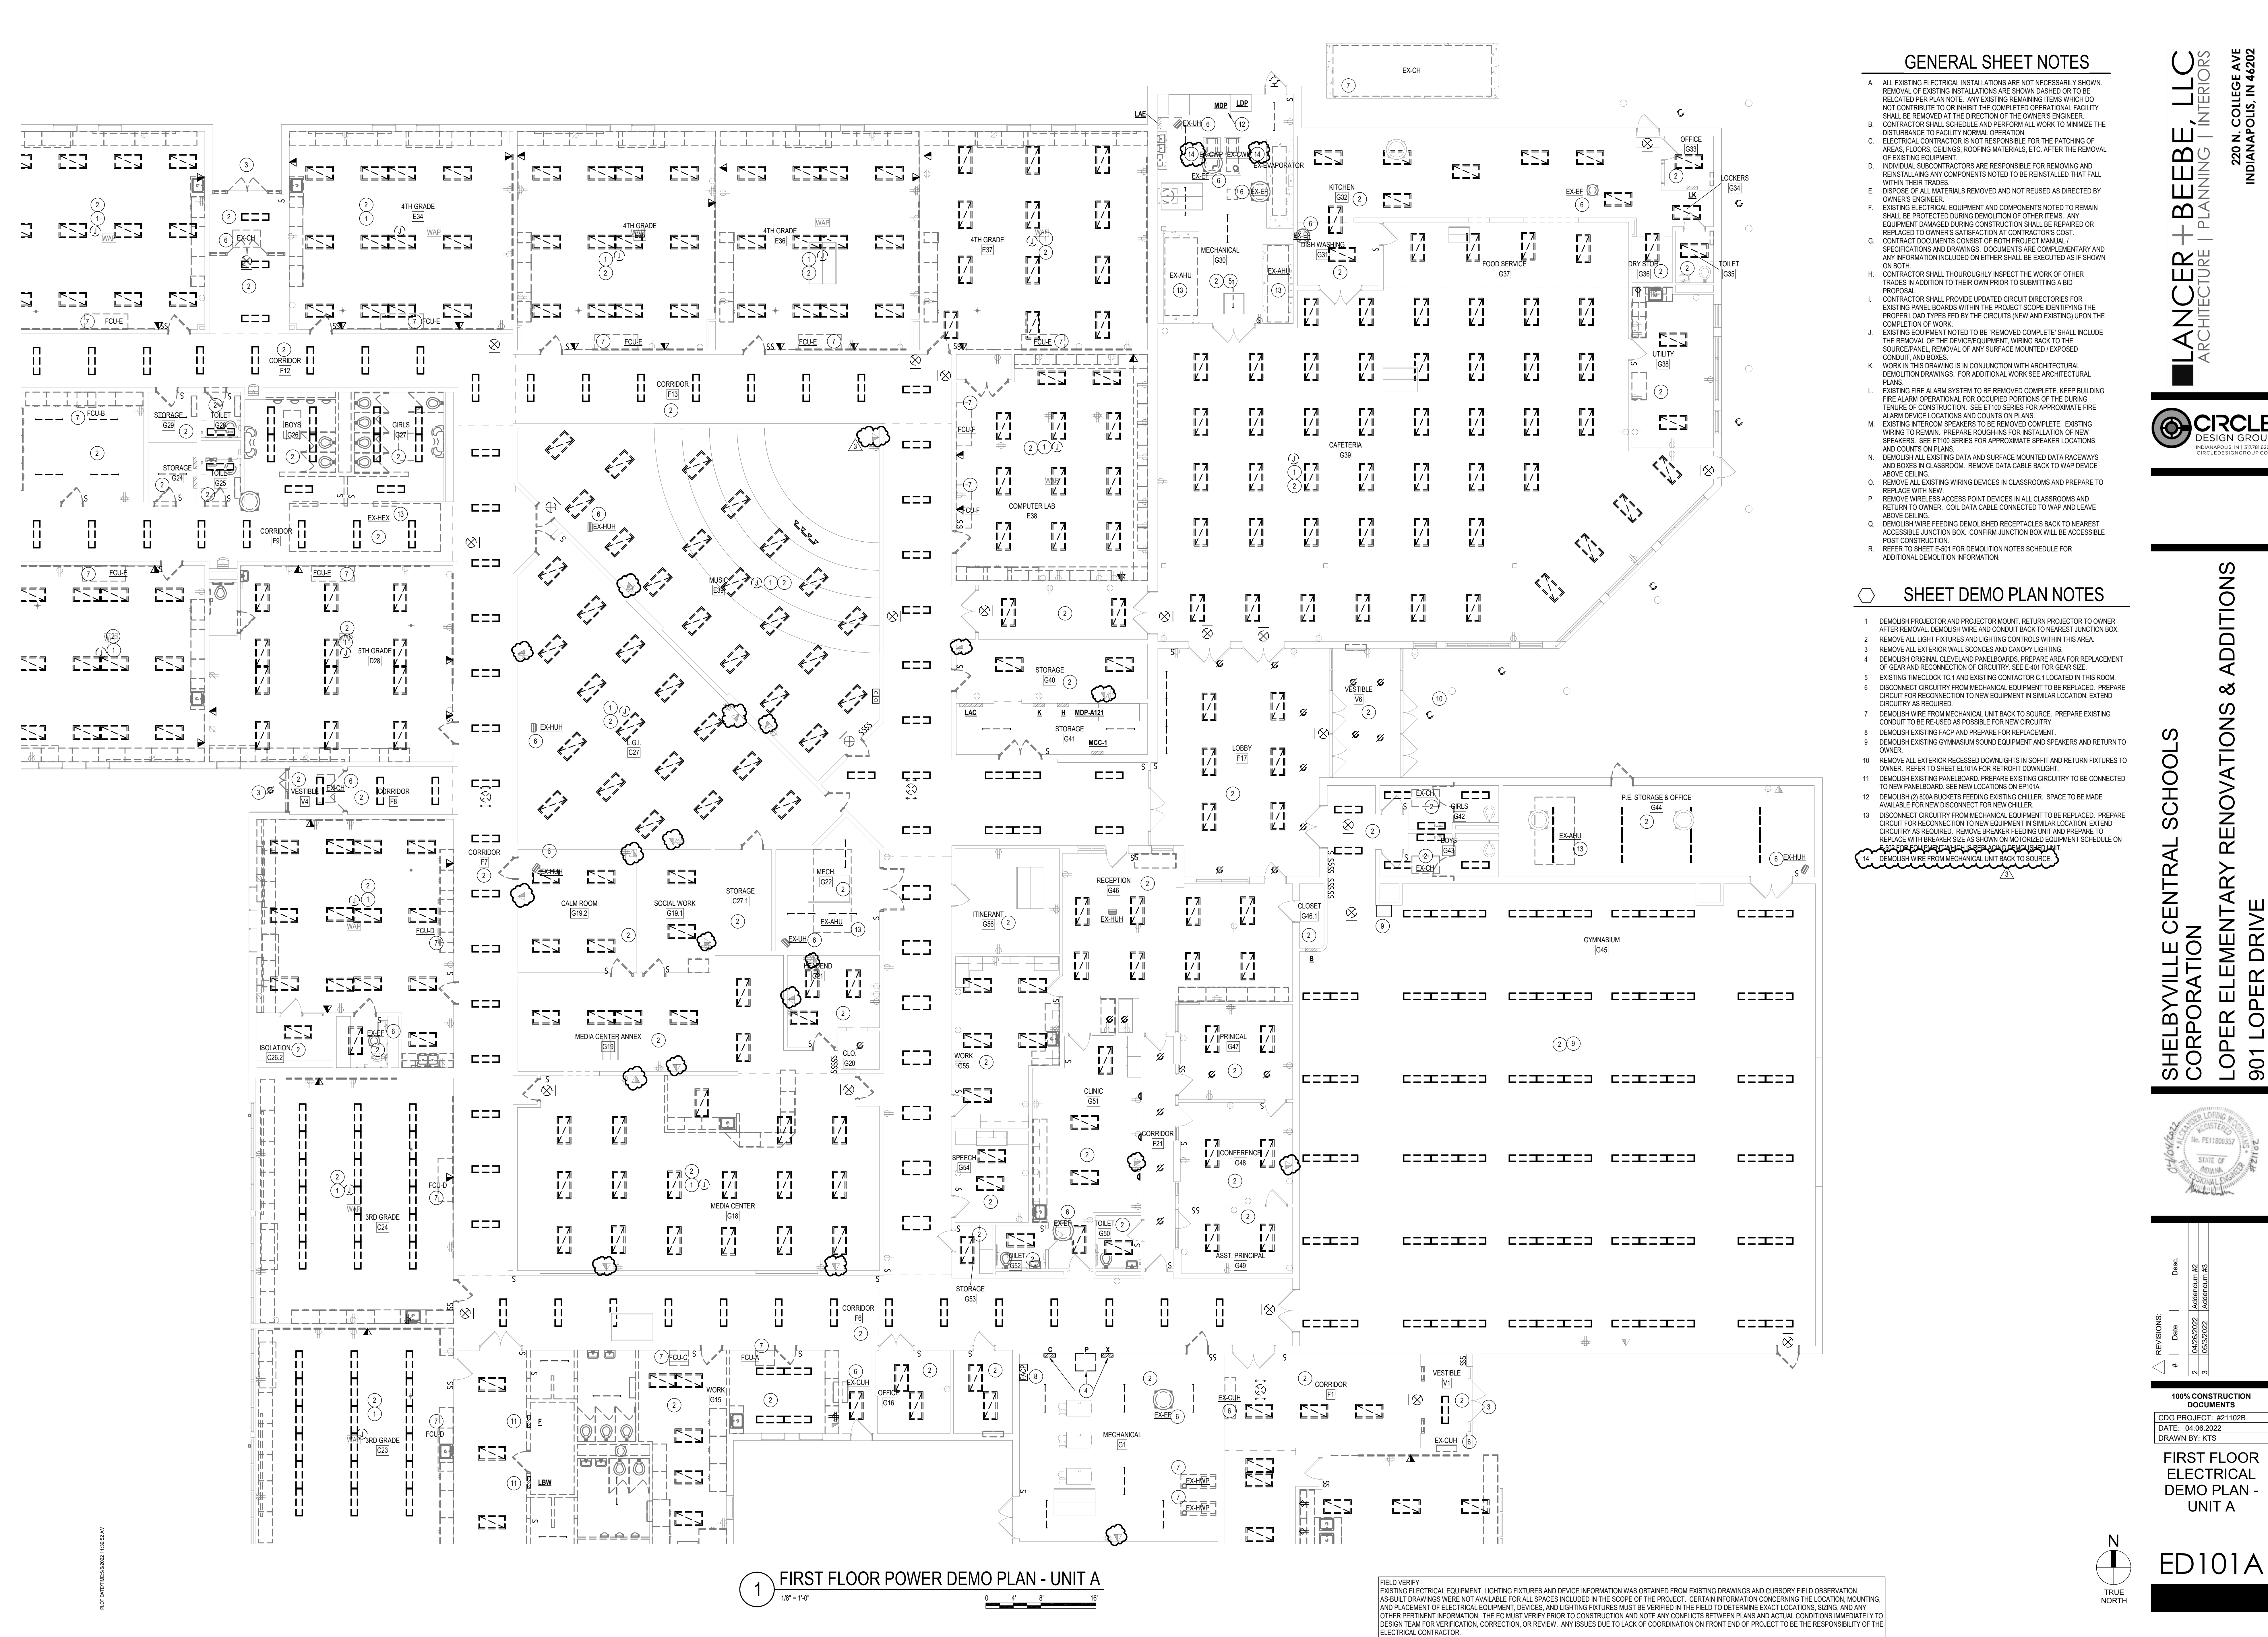

GENERAL SHEET NOTES

- A. ALL EXISTING ELECTRICAL INSTALLATIONS ARE NOT NECESSARILY SHOWN. REMOVAL OF EXISTING INSTALLATIONS ARE SHOWN DASHED OR TO BE RELOCATED PER PLAN NOTE. ANY EXISTING REMAINING ITEMS WHICH DO NOT CONTRIBUTE TO OR INHIBIT THE COMPLETED OPERATIONAL FACILITY SHALL BE REMOVED AT THE DIRECTION OF THE OWNER'S ENGINEER.
- B. CONTRACTOR SHALL SCHEDULE AND PERFORM ALL WORK TO MINIMIZE THE DISTURBANCE TO FACILITY NORMAL OPERATION.
- C. ELECTRICAL CONTRACTOR IS NOT RESPONSIBLE FOR THE PATCHING OF AREAS, FLOORS, CEILINGS, ROOFING MATERIALS, ETC. AFTER THE REMOVAL OF EXISTING EQUIPMENT.
- D. INDIVIDUAL SUBCONTRACTORS ARE RESPONSIBLE FOR REMOVING AND REINSTALLING ANY COMPONENTS NOTED TO BE REINSTALLED THAT FALL WITHIN THEIR TRADES.
- E. DISPOSE OF ALL MATERIALS REMOVED AND NOT REUSED AS DIRECTED BY OWNER'S ENGINEER.
- F. EXISTING ELECTRICAL EQUIPMENT AND COMPONENTS NOTED TO REMAIN SHALL BE PROTECTED DURING DEMOLITION OF OTHER ITEMS. ANY EQUIPMENT DAMAGED DURING CONSTRUCTION SHALL BE REPAIRED OR REPLACED TO OWNER'S SATISFACTION AT CONTRACTOR'S COST.
- G. CONTRACT DOCUMENTS CONSIST OF BOTH PROJECT MANUAL, SPECIFICATIONS AND DRAWINGS. DOCUMENTS ARE COMPLEMENTARY AND ANY INFORMATION INCLUDED ON EITHER SHALL BE EXECUTED AS IF SHOWN ON BOTH.
- H. CONTRACTOR SHALL THOROUGHLY INSPECT THE WORK OF OTHER TRADES IN ADDITION TO THEIR OWN PRIOR TO SUBMITTING A BID PROPOSAL.
- I. CONTRACTOR SHALL PROVIDE UPDATED CIRCUIT DIRECTORIES FOR EXISTING PANEL BOARDS WITHIN THE PROJECT SCOPE IDENTIFYING THE PROPER LOAD TYPES FED BY THE CIRCUITS (NEW AND EXISTING) UPON THE COMPLETION OF WORK.
- J. EXISTING EQUIPMENT NOTED TO BE "REMOVED COMPLETE" SHALL INCLUDE THE REMOVAL OF THE DEVICE/EQUIPMENT, WIRING BACK TO THE SOURCE/PANEL, REMOVAL OF ANY SURFACE MOUNTED/ EXPOSED CONDUIT, AND BOXES.
- K. WORK IN THIS DRAWING IS IN CONJUNCTION WITH ARCHITECTURAL DEMOLITION DRAWINGS. FOR ADDITIONAL WORK SEE ARCHITECTURAL PLANS.
- L. EXISTING FIRE ALARM SYSTEM TO BE REMOVED COMPLETE. KEEP BUILDING FIRE ALARM OPERATIONAL FOR OCCUPIED PORTIONS OF THE DURING TENURE OF CONSTRUCTION. SEE E1100 SERIES FOR APPROXIMATE FIRE ALARM DEVICE LOCATIONS AND COUNTS ON PLANS.
- M. EXISTING INTERCOM SPEAKERS TO BE REMOVED COMPLETE. EXISTING WIRING TO REMAIN. PREPARE ROUGH-INS FOR INSTALLATION OF NEW SPEAKERS. SEE E1100 SERIES FOR APPROXIMATE SPEAKER LOCATIONS AND COUNTS ON PLANS.
- N. DEMOLISH ALL EXISTING DATA AND SURFACE MOUNTED DATA RACEWAYS AND BOXES IN CLASSROOM. REMOVE DATA CABLE BACK TO WAP DEVICE ABOVE CEILING.
- O. REMOVE ALL EXISTING WIRING DEVICES IN CLASSROOMS AND PREPARE TO REPLACE WITH NEW.
- P. REMOVE WIRELESS ACCESS POINT DEVICES IN ALL CLASSROOMS AND RETURN TO OWNER. COIL DATA CABLE CONNECTED TO WAP AND LEAVE ABOVE CEILING.
- Q. DEMOLISH WIRE FEEDING DEMOLISHED RECEPTACLES BACK TO NEAREST ACCESSIBLE JUNCTION BOX. CONFIRM JUNCTION BOX WILL BE ACCESSIBLE POST CONSTRUCTION.
- R. REFER TO SHEET E-501 FOR DEMOLITION NOTES SCHEDULE FOR ADDITIONAL DEMOLITION INFORMATION.

SHEET DEMO PLAN NOTES

1. DEMOLISH PROJECTOR AND PROJECTOR MOUNT. RETURN PROJECTOR TO OWNER AFTER REMOVAL. DEMOLISH WIRE AND CONDUIT BACK TO NEAREST JUNCTION BOX.
2. REMOVE ALL LIGHT FIXTURES AND LIGHTING CONTROLS WITHIN THIS AREA.
3. REMOVE ALL EXTERIOR WALL SCONCES AND CANOPY LIGHTING.
4. DEMOLISH ORIGINAL CLEVELAND PANELBOARDS. PREPARE AREA FOR REPLACEMENT OF GEAR AND RECONNECTION OF CIRCUITRY. SEE E-401 FOR GEAR SIZE.
5. EXISTING TIMECLOCK T.C.1 AND EXISTING CONTRACTOR C.1 LOCATED IN THIS ROOM.
6. DISCONNECT CIRCUITRY FROM MECHANICAL EQUIPMENT TO BE REPLACED. PREPARE CIRCUIT FOR RECONNECTION TO NEW EQUIPMENT IN SIMILAR LOCATION. EXTEND CIRCUITRY AS REQUIRED.
7. DEMOLISH WIRE FROM MECHANICAL UNIT BACK TO SOURCE. PREPARE EXISTING CONDUIT TO BE RE-USED AS POSSIBLE FOR NEW CIRCUITRY.
8. DEMOLISH EXISTING FACP AND PREPARE FOR REPLACEMENT.
9. DEMOLISH EXISTING GYMNASIUM SOUND EQUIPMENT AND SPEAKERS AND RETURN TO OWNER.
10. REMOVE ALL EXTERIOR RECESSED DOWNLIGHTS IN SOFFIT AND RETURN FIXTURES TO OWNER. REFER TO SHEET E101A FOR RETROFIT DOWNLIGHT.
11. DEMOLISH EXISTING PANELBOARD. PREPARE EXISTING CIRCUITRY TO BE CONNECTED TO NEW PANELBOARD. SEE NEW LOCATIONS ON EPTVIA.
12. DEMOLISH (2) 800A BUCKETS FEEDING EXISTING CHILLER. SPACE TO BE MADE AVAILABLE FOR NEW DISCONNECT FOR NEW CHILLER.
13. DISCONNECT CIRCUITRY FROM MECHANICAL EQUIPMENT TO BE REPLACED. PREPARE CIRCUIT FOR RECONNECTION TO NEW EQUIPMENT IN SIMILAR LOCATION. EXTEND CIRCUITRY AS REQUIRED. REMOVE BREAKER FEEDING UNIT AND PREPARE TO REPLACE WITH BREAKER SIZE AS SHOWN ON MOTORIZED EQUIPMENT SCHEDULE ON E-501 FOR EQUIPMENT WHICH IS RE-USED IN THIS UNIT.
14. DEMOLISH WIRE FROM MECHANICAL UNIT BACK TO SOURCE.

1 FIRST FLOOR POWER DEMO PLAN - UNIT A
1/8" = 1'-0"


FIELD VERIFY
EXISTING ELECTRICAL EQUIPMENT, LIGHTING FIXTURES AND DEVICE INFORMATION WAS OBTAINED FROM EXISTING DRAWINGS AND CURSORY FIELD OBSERVATION. AS-BUILT DRAWINGS WERE NOT AVAILABLE FOR ALL SPACES INCLUDED IN THE SCOPE OF THE PROJECT. CERTAIN INFORMATION CONCERNING THE LOCATION, MOUNTING, AND PLACEMENT OF ELECTRICAL EQUIPMENT, DEVICES, AND LIGHTING FIXTURES MUST BE VERIFIED IN THE FIELD TO DETERMINE EXACT LOCATIONS, SIZING, AND ANY OTHER PERTINENT INFORMATION. THE EC MUST VERIFY PRIOR TO CONSTRUCTION AND NOTE ANY CONFLICTS BETWEEN PLANS AND ACTUAL CONDITIONS IMMEDIATELY TO DESIGN TEAM FOR VERIFICATION, CORRECTION, OR REVIEW. ANY ISSUES DUE TO LACK OF COORDINATION ON FRONT END OF PROJECT TO BE THE RESPONSIBILITY OF THE ELECTRICAL CONTRACTOR.

REVISIONS:		Date	Desc.
1		04/06/2022	Initial
2		05/02/2022	Revised
3			

100% CONSTRUCTION DOCUMENTS	
CDG PROJECT: #211028	
DATE: 04/06/2022	
DRAWN BY: KTS	

FIRST FLOOR
ELECTRICAL
DEMO PLAN -
UNIT A

POST DATE/TIME: 04/08/2022 7:53:59 AM

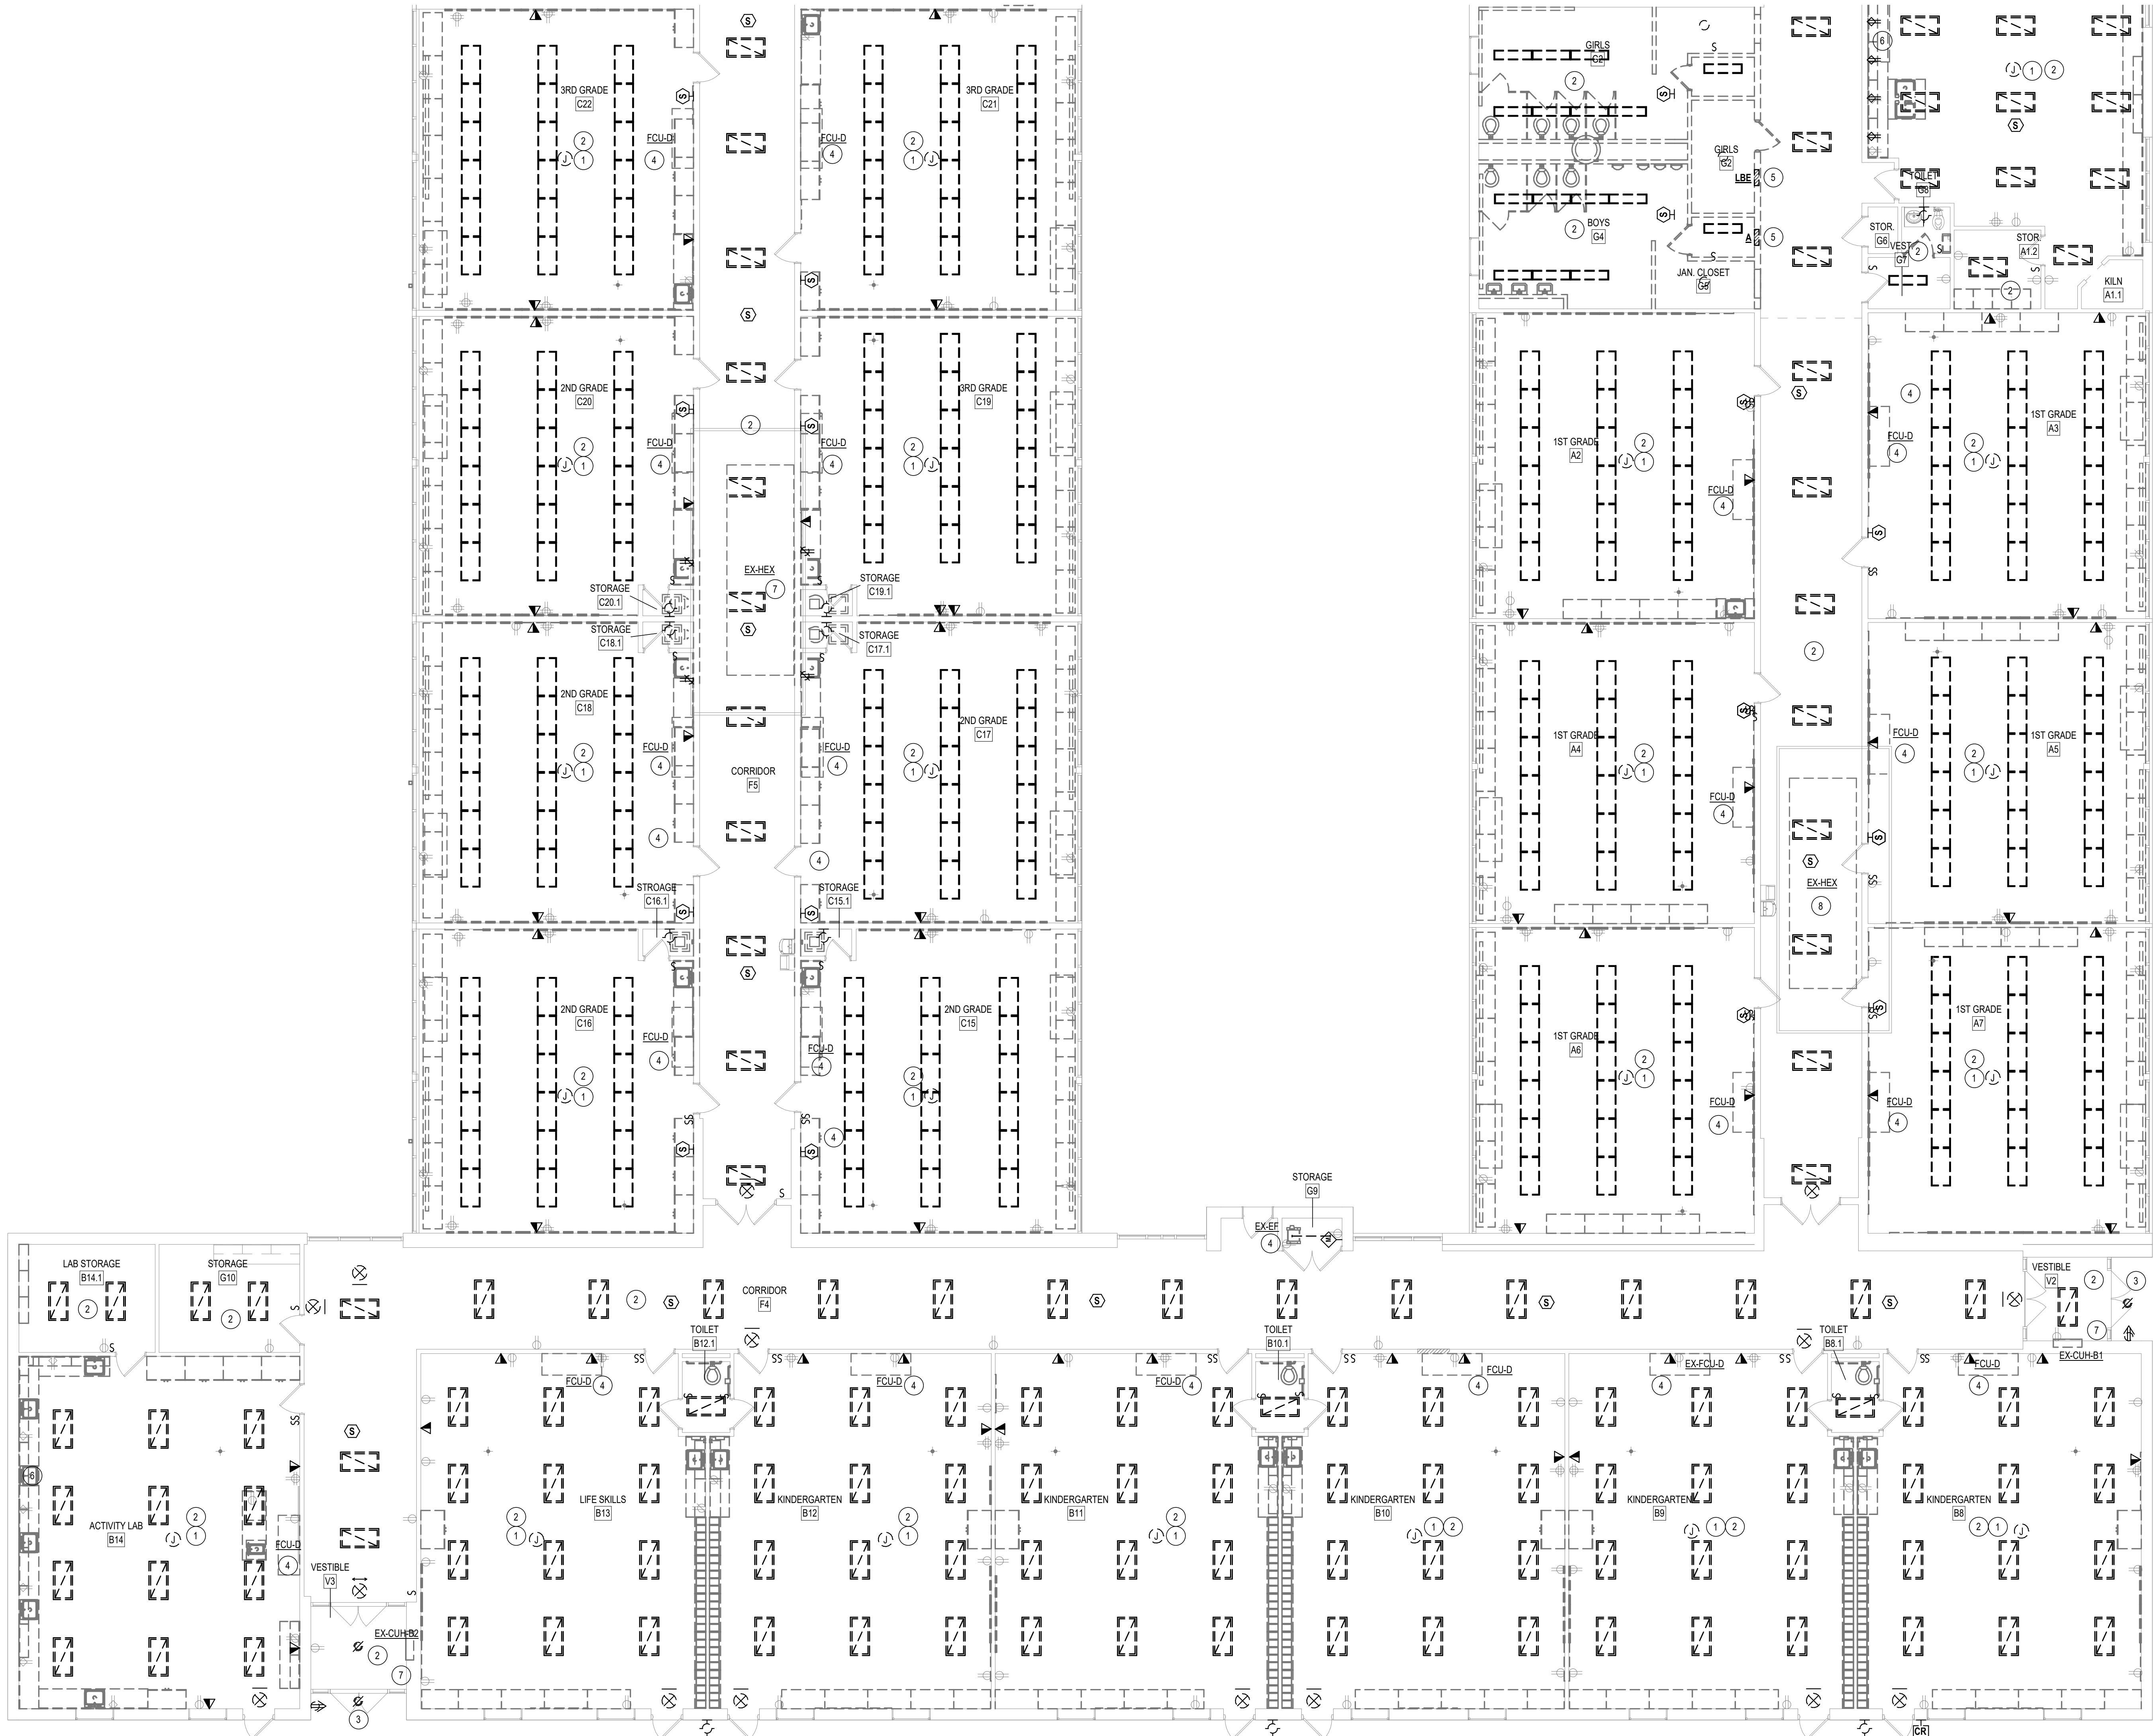

1 FIRST FLOOR POWER DEMO PLAN - UNIT B
1/8" = 1'-0"

FIELD VERIFY
EXISTING ELECTRICAL EQUIPMENT, LIGHTING FIXTURES AND DEVICE INFORMATION WAS OBTAINED FROM EXISTING DRAWINGS AND CURSORS FIELD OBSERVATION. AS-BUILT DRAWINGS WERE NOT AVAILABLE FOR ALL SPACES INCLUDED IN THE SCOPE OF THE PROJECT. CERTAIN INFORMATION CONCERNING THE LOCATION, MOUNTING, AND PLACEMENT OF ELECTRICAL EQUIPMENT, DEVICES, AND LIGHTING FIXTURES MUST BE VERIFIED IN THE FIELD TO DETERMINE EXACT LOCATIONS, SIZING, AND ANY OTHER PERTINENT INFORMATION. THE GC MUST VERIFY PRIOR TO CONSTRUCTION AND NOTE ANY CONFLICTS BETWEEN PLANS AND ACTUAL CONDITIONS IMMEDIATELY TO DESIGN TEAM FOR VERIFICATION, CORRECTION, OR REVIEW. ANY ISSUES DUE TO LACK OF COORDINATION ON FRONT END OF PROJECT TO BE THE RESPONSIBILITY OF THE ELECTRICAL CONTRACTOR.

GENERAL SHEET NOTES

- ALL EXISTING ELECTRICAL INSTALLATIONS ARE NOT NECESSARILY SHOWN. REMOVAL OF EXISTING INSTALLATIONS ARE SHOWN DASHED OR TO BE RELATED PER PLAN NOTE. ANY EXISTING REMAINING ITEMS WHICH DO NOT CONTRIBUTE TO OR INHIBIT THE COMPLETED OPERATIONAL FACILITY SHALL BE REMOVED AT THE DIRECTION OF THE OWNER'S ENGINEER.
- CONTRACTOR SHALL SCHEDULE AND PERFORM ALL WORK TO MINIMIZE THE DISTURBANCE TO FACILITY NORMAL OPERATION.
- ELECTRICAL CONTRACTOR IS NOT RESPONSIBLE FOR THE PATCHING OF AREAS, FLOORS, CEILINGS, ROOFING MATERIALS, ETC. AFTER THE REMOVAL OF EXISTING EQUIPMENT.
- INDIVIDUAL SUBCONTRACTORS ARE RESPONSIBLE FOR REMOVING AND REINSTALLING ANY COMPONENTS NOTED TO BE REINSTALLED THAT FALL WITHIN THEIR TRADES.
- DISPOSE OF ALL MATERIALS REMOVED AND NOT REUSED AS DIRECTED BY OWNER'S ENGINEER.
- EXISTING ELECTRICAL EQUIPMENT AND COMPONENTS NOTED TO REMAIN SHALL BE PROTECTED DURING DEMOLITION OF OTHER ITEMS. ANY EQUIPMENT DAMAGED DURING CONSTRUCTION SHALL BE REPAIRED OR REPLACED TO OWNER'S SATISFACTION AT CONTRACTOR'S COST.
- CONTRACT DOCUMENTS CONSIST OF BOTH PROJECT MANUAL, SPECIFICATIONS AND DRAWINGS. DOCUMENTS ARE COMPLEMENTARY AND ANY INFORMATION INCLUDED ON EITHER SHALL BE EXECUTED AS IF SHOWN ON BOTH.
- CONTRACTOR SHALL THOROUGHLY INSPECT THE WORK OF OTHER TRADES IN ADDITION TO THEIR OWN PRIOR TO SUBMITTING A BID PROPOSAL.
- CONTRACTOR SHALL PROVIDE UPDATED CIRCUIT DIRECTORIES FOR EXISTING PANEL BOARDS WITHIN THE PROJECT SCOPE IDENTIFYING THE PROPER LOAD TYPES FED BY THE CIRCUITS (NEW AND EXISTING) UPON THE COMPLETION OF WORK.
- EXISTING EQUIPMENT NOTED TO BE "REMOVED COMPLETE" SHALL INCLUDE THE REMOVAL OF THE DEVICE/EQUIPMENT, WIRING BACK TO THE SOURCE/PANEL, REMOVAL OF ANY SURFACE MOUNTED EXPOSED CONDUIT, AND BOXES.
- WORK IN THIS DRAWING IS IN CONJUNCTION WITH ARCHITECTURAL DEMOLITION DRAWINGS. FOR ADDITIONAL WORK SEE ARCHITECTURAL PLANS.
- EXISTING FIRE ALARM SYSTEM TO BE REMOVED COMPLETE. KEEP BUILDING FIRE ALARM OPERATIONAL FOR OCCUPIED PORTIONS OF THE DURING TENURE OF CONSTRUCTION. SEE ET100 SERIES FOR APPROXIMATE FIRE ALARM DEVICE LOCATIONS AND COUNTS ON PLANS.
- EXISTING INTERCOM SPEAKERS TO BE REMOVED COMPLETE. EXISTING WIRING TO REMAIN. PREPARE ROUGH-INS FOR INSTALLATION OF NEW SPEAKERS. SEE ET100 SERIES FOR APPROXIMATE SPEAKER LOCATIONS AND COUNTS ON PLANS.
- DEMOLISH ALL EXISTING DATA AND SURFACE MOUNTED DATA RACEWAYS AND BOXES IN CLASSROOM. REMOVE DATA CABLE BACK TO WAP DEVICE ABOVE CEILING.
- REMOVE ALL EXISTING WIRING DEVICES IN CLASSROOMS AND PREPARE TO REPLACE WITH NEW.
- REMOVE WIRELESS ACCESS POINT DEVICES IN ALL CLASSROOMS AND RETURN TO OWNER. COIL DATA CABLE CONNECTED TO WAP AND LEAVE ABOVE CEILING.
- DEMOLISH WIRE FEEDING DEMOLISHED RECEPTACLES BACK TO NEAREST ACCESSIBLE JUNCTION BOX. CONFIRM JUNCTION BOX WILL BE ACCESSIBLE POST CONSTRUCTION.
- REFER TO SHEET E-201 FOR DEMOLITION NOTES SCHEDULE FOR ADDITIONAL DEMOLITION INFORMATION.

SHEET DEMO PLAN NOTES

- DEMOLISH PROJECTOR AND PROJECTOR MOUNT. RETURN PROJECTOR TO OWNER AFTER REMOVAL. DEMOLISH WIRE AND CONDUIT BACK TO NEAREST JUNCTION BOX.
- REMOVE ALL LIGHT FIXTURES AND LIGHTING CONTROLS WITHIN THIS AREA.
- REMOVE ALL EXTERIOR WALL SCONCES AND CANOPY LIGHTING.
- DEMOLISH WIRE FROM MECHANICAL UNIT BACK TO SOURCE. PREPARE EXISTING CONDUIT TO BE RE-USED AS POSSIBLE FOR NEW CIRCUITRY.
- DEMOLISH EXISTING PANELBOARD. PREPARE EXISTING CIRCUITRY TO BE CONNECTED TONEW PANELBOARD. SEE NEW LOCATIONS ON EP101B.
- CASEWORK TO BE REPLACED. DEMOLISH RECEPTACLES AND PREPARE CIRCUIT TO BE RECONNECTED TO NEW RECEPTACLES IN SIMILAR LOCATION.
- DISCONNECT CIRCUITRY FROM MECHANICAL EQUIPMENT TO BE REPLACED. PREPARE CIRCUIT FOR RECONNECTION TO NEW EQUIPMENT IN SIMILAR LOCATION. EXTEND CIRCUITRY AS REQUIRED.
- DISCONNECT CIRCUITRY FROM MECHANICAL EQUIPMENT TO BE REPLACED. PREPARE CIRCUIT FOR RECONNECTION TO NEW EQUIPMENT IN SIMILAR LOCATION. EXTEND CIRCUITRY AS REQUIRED. REMOVE BREAKER FEEDING UNIT AND PREPARE TO REPLACE WITH BREAKER SIZE AS SHOWN ON MOTORIZE.



INDIANAPOLIS, IN 3377816020
CIRCLEDESIGNGROUP.COM

LANCER + BEEBE, LLC
ARCHITECTURE | PLANNING | INTERIORS

220 N. COLLEGE AVE
INDIANAPOLIS, IN 46202

SHELBYVILLE CENTRAL SCHOOLS
CORPORATION
LOPER ELEMENTARY RENOVATIONS & ADDITIONS
901 LOPER DRIVE




REVISIONS:

#	Date	Desc.
2	04/08/2022	Addendum #2

100% CONSTRUCTION DOCUMENTS

CDG PROJECT: #211028
DATE: 04/08/2022
DRAWN BY: KTS

FIRST FLOOR
ELECTRICAL
DEMO PLAN -
UNIT B

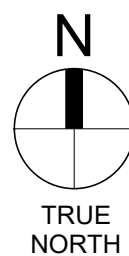

ED101B

1 FIRST FLOOR POWER DEMO PLAN - UNIT C

1/8" = 1'-0"

0 4 8 16'

FIELD VERIFY
EXISTING ELECTRICAL EQUIPMENT, LIGHTING FIXTURES AND DEVICE INFORMATION WAS OBTAINED FROM EXISTING DRAWINGS AND CURSORY FIELD OBSERVATION. AS-BUILT DRAWINGS WERE NOT AVAILABLE FOR ALL SPACES INCLUDED IN THE SCOPE OF THE PROJECT. CERTAIN INFORMATION CONCERNING THE LOCATION, MOUNTING, AND PLACEMENT OF ELECTRICAL EQUIPMENT, DEVICES, AND LIGHTING FIXTURES MUST BE VERIFIED IN THE FIELD TO DETERMINE EXACT LOCATIONS, SIZING, AND ANY OTHER PERTINENT INFORMATION. THE EC MUST VERIFY PRIOR TO CONSTRUCTION AND NOTE ANY CONFLICTS BETWEEN PLANS AND ACTUAL CONDITIONS IMMEDIATELY TO DESIGN TEAM FOR VERIFICATION, CORRECTION, OR REVIEW. ANY ISSUES DUE TO LACK OF COORDINATION ON FRONT END OF PROJECT TO BE THE RESPONSIBILITY OF THE ELECTRICAL CONTRACTOR.

GENERAL SHEET NOTES

- A. ALL EXISTING ELECTRICAL INSTALLATIONS ARE NOT NECESSARILY SHOWN. REMOVAL OF EXISTING INSTALLATIONS ARE SHOWN DASHED OR TO BE RELOCATED PER PLAN NOTE. ANY EXISTING REMAINING ITEMS WHICH DO NOT CONTRIBUTE TO OR INHIBIT THE COMPLETED OPERATIONAL FACILITY SHALL BE REMOVED AT THE DIRECTION OF THE OWNER'S ENGINEER.
- B. CONTRACTOR SHALL SCHEDULE AND PERFORM ALL WORK TO MINIMIZE THE DISTURBANCE TO FACILITY NORMAL OPERATION.
- C. ELECTRICAL CONTRACTOR IS NOT RESPONSIBLE FOR THE PATCHING OF AREAS, FLOORS, CEILINGS, ROOFING MATERIALS, ETC. AFTER THE REMOVAL OF EXISTING EQUIPMENT.
- D. INDIVIDUAL SUBCONTRACTORS ARE RESPONSIBLE FOR REMOVING AND REINSTALLING ANY COMPONENTS NOTED TO BE REINSTALLED THAT FALL WITHIN THEIR TRADES.
- E. DISPOSE OF ALL MATERIALS REMOVED AND NOT REUSED AS DIRECTED BY OWNER'S ENGINEER.
- F. EXISTING ELECTRICAL EQUIPMENT AND COMPONENTS NOTED TO REMAIN SHALL BE PROTECTED DURING DEMOLITION OF OTHER ITEMS. ANY EQUIPMENT DAMAGED DURING CONSTRUCTION SHALL BE REPAIRED OR REPLACED TO OWNER'S SATISFACTION AT CONTRACTOR'S COST.
- G. CONTRACT DOCUMENTS CONSIST OF BOTH PROJECT MANUAL, SPECIFICATIONS AND DRAWINGS. DOCUMENTS ARE COMPLEMENTARY AND ANY INFORMATION INCLUDED ON EITHER SHALL BE EXECUTED AS IF SHOWN ON BOTH.
- H. CONTRACTOR SHALL THOROUGHLY INSPECT THE WORK OF OTHER TRADES IN ADDITION TO THEIR OWN PRIOR TO SUBMITTING A BID PROPOSAL.
- I. CONTRACTOR SHALL PROVIDE UPDATED CIRCUIT DIRECTORIES FOR EXISTING PANEL BOARDS WITHIN THE PROJECT SCOPE IDENTIFYING THE PROPER LOAD TYPES FED BY THE CIRCUITS (NEW AND EXISTING) UPON THE COMPLETION OF WORK.
- J. EXISTING EQUIPMENT NOTED TO BE 'REMOVED COMPLETE' SHALL INCLUDE THE REMOVAL OF THE DEVICE/EQUIPMENT, WIRING BACK TO THE SOURCE/PANEL, REMOVAL OF ANY SURFACE MOUNTED / EXPOSED CONDUIT, AND BOXES.
- K. WORK IN THIS DRAWING IS IN CONJUNCTION WITH ARCHITECTURAL DEMOLITION DRAWINGS. FOR ADDITIONAL WORK SEE ARCHITECTURAL PLANS.
- L. EXISTING FIRE ALARM SYSTEM TO BE REMOVED COMPLETE. KEEP BUILDING FIRE ALARM OPERATIONAL FOR OCCUPIED PORTIONS OF THE DURING TENURE OF CONSTRUCTION. SEE ET100 SERIES FOR APPROXIMATE FIRE ALARM DEVICE LOCATIONS AND COUNTS ON PLANS.
- M. EXISTING INTERCOM SPEAKERS TO BE REMOVED COMPLETE. EXISTING WIRING TO REMAIN. PREPARE ROUGH-INS FOR INSTALLATION OF NEW SPEAKERS. SEE ET100 SERIES FOR APPROXIMATE SPEAKER LOCATIONS AND COUNTS ON PLANS.
- N. DEMOLISH ALL EXISTING DATA AND SURFACE MOUNTED DATA RACEWAYS AND BOXES IN CLASSROOM. REMOVE DATA CABLE BACK TO WAP DEVICE ABOVE CEILING.
- O. REMOVE ALL EXISTING WIRING DEVICES IN CLASSROOMS AND PREPARE TO REPLACE WITH NEW.
- P. REMOVE WIRELESS ACCESS POINT DEVICES IN ALL CLASSROOMS AND RETURN TO OWNER. COIL DATA CABLE CONNECTED TO WAP AND LEAVE ABOVE CEILING.
- Q. DEMOLISH WIRE FEEDING DEMOLISHED RECEPTACLES BACK TO NEAREST ACCESSIBLE JUNCTION BOX. CONFIRM JUNCTION BOX WILL BE ACCESSIBLE POST CONSTRUCTION.
- R. REFER TO SHEET E-501 FOR DEMOLITION NOTES SCHEDULE FOR ADDITIONAL DEMOLITION INFORMATION.

SHEET DEMO PLAN NOTES

- 1 DEMOLISH PROJECTOR AND PROJECTOR MOUNT. RETURN PROJECTOR TO OWNER AFTER REMOVAL. DEMOLISH WIRE AND CONDUIT BACK TO NEAREST JUNCTION BOX.
- 2 REMOVE ALL LIGHT FIXTURES AND LIGHTING CONTROLS WITHIN THIS AREA.
- 3 DEMOLISH WIRE FROM MECHANICAL UNIT BACK TO SOURCE. PREPARE EXISTING CONDUIT TO BE RE-USED AS POSSIBLE FOR NEW CIRCUITRY.

SHELBYVILLE CENTRAL SCHOOLS
CORPORATION
LOPER ELEMENTARY RENOVATIONS & ADDITIONS
901 LOPER DRIVE




#	Date	Desc.	Addendum #2
2	04/26/2022		

100% CONSTRUCTION DOCUMENTS


CDG PROJECT: #21102B
DATE: 04/06/2022
DRAWN BY: KTS

FIRST FLOOR
ELECTRICAL
DEMO PLAN -
UNIT C

ED101C


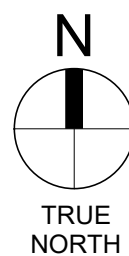


LANCER + BEEBE, LLC
ARCHITECTURE | PLANNING | INTERIORS
220 N. COLLEGE AVE
INDIANAPOLIS, IN 46202

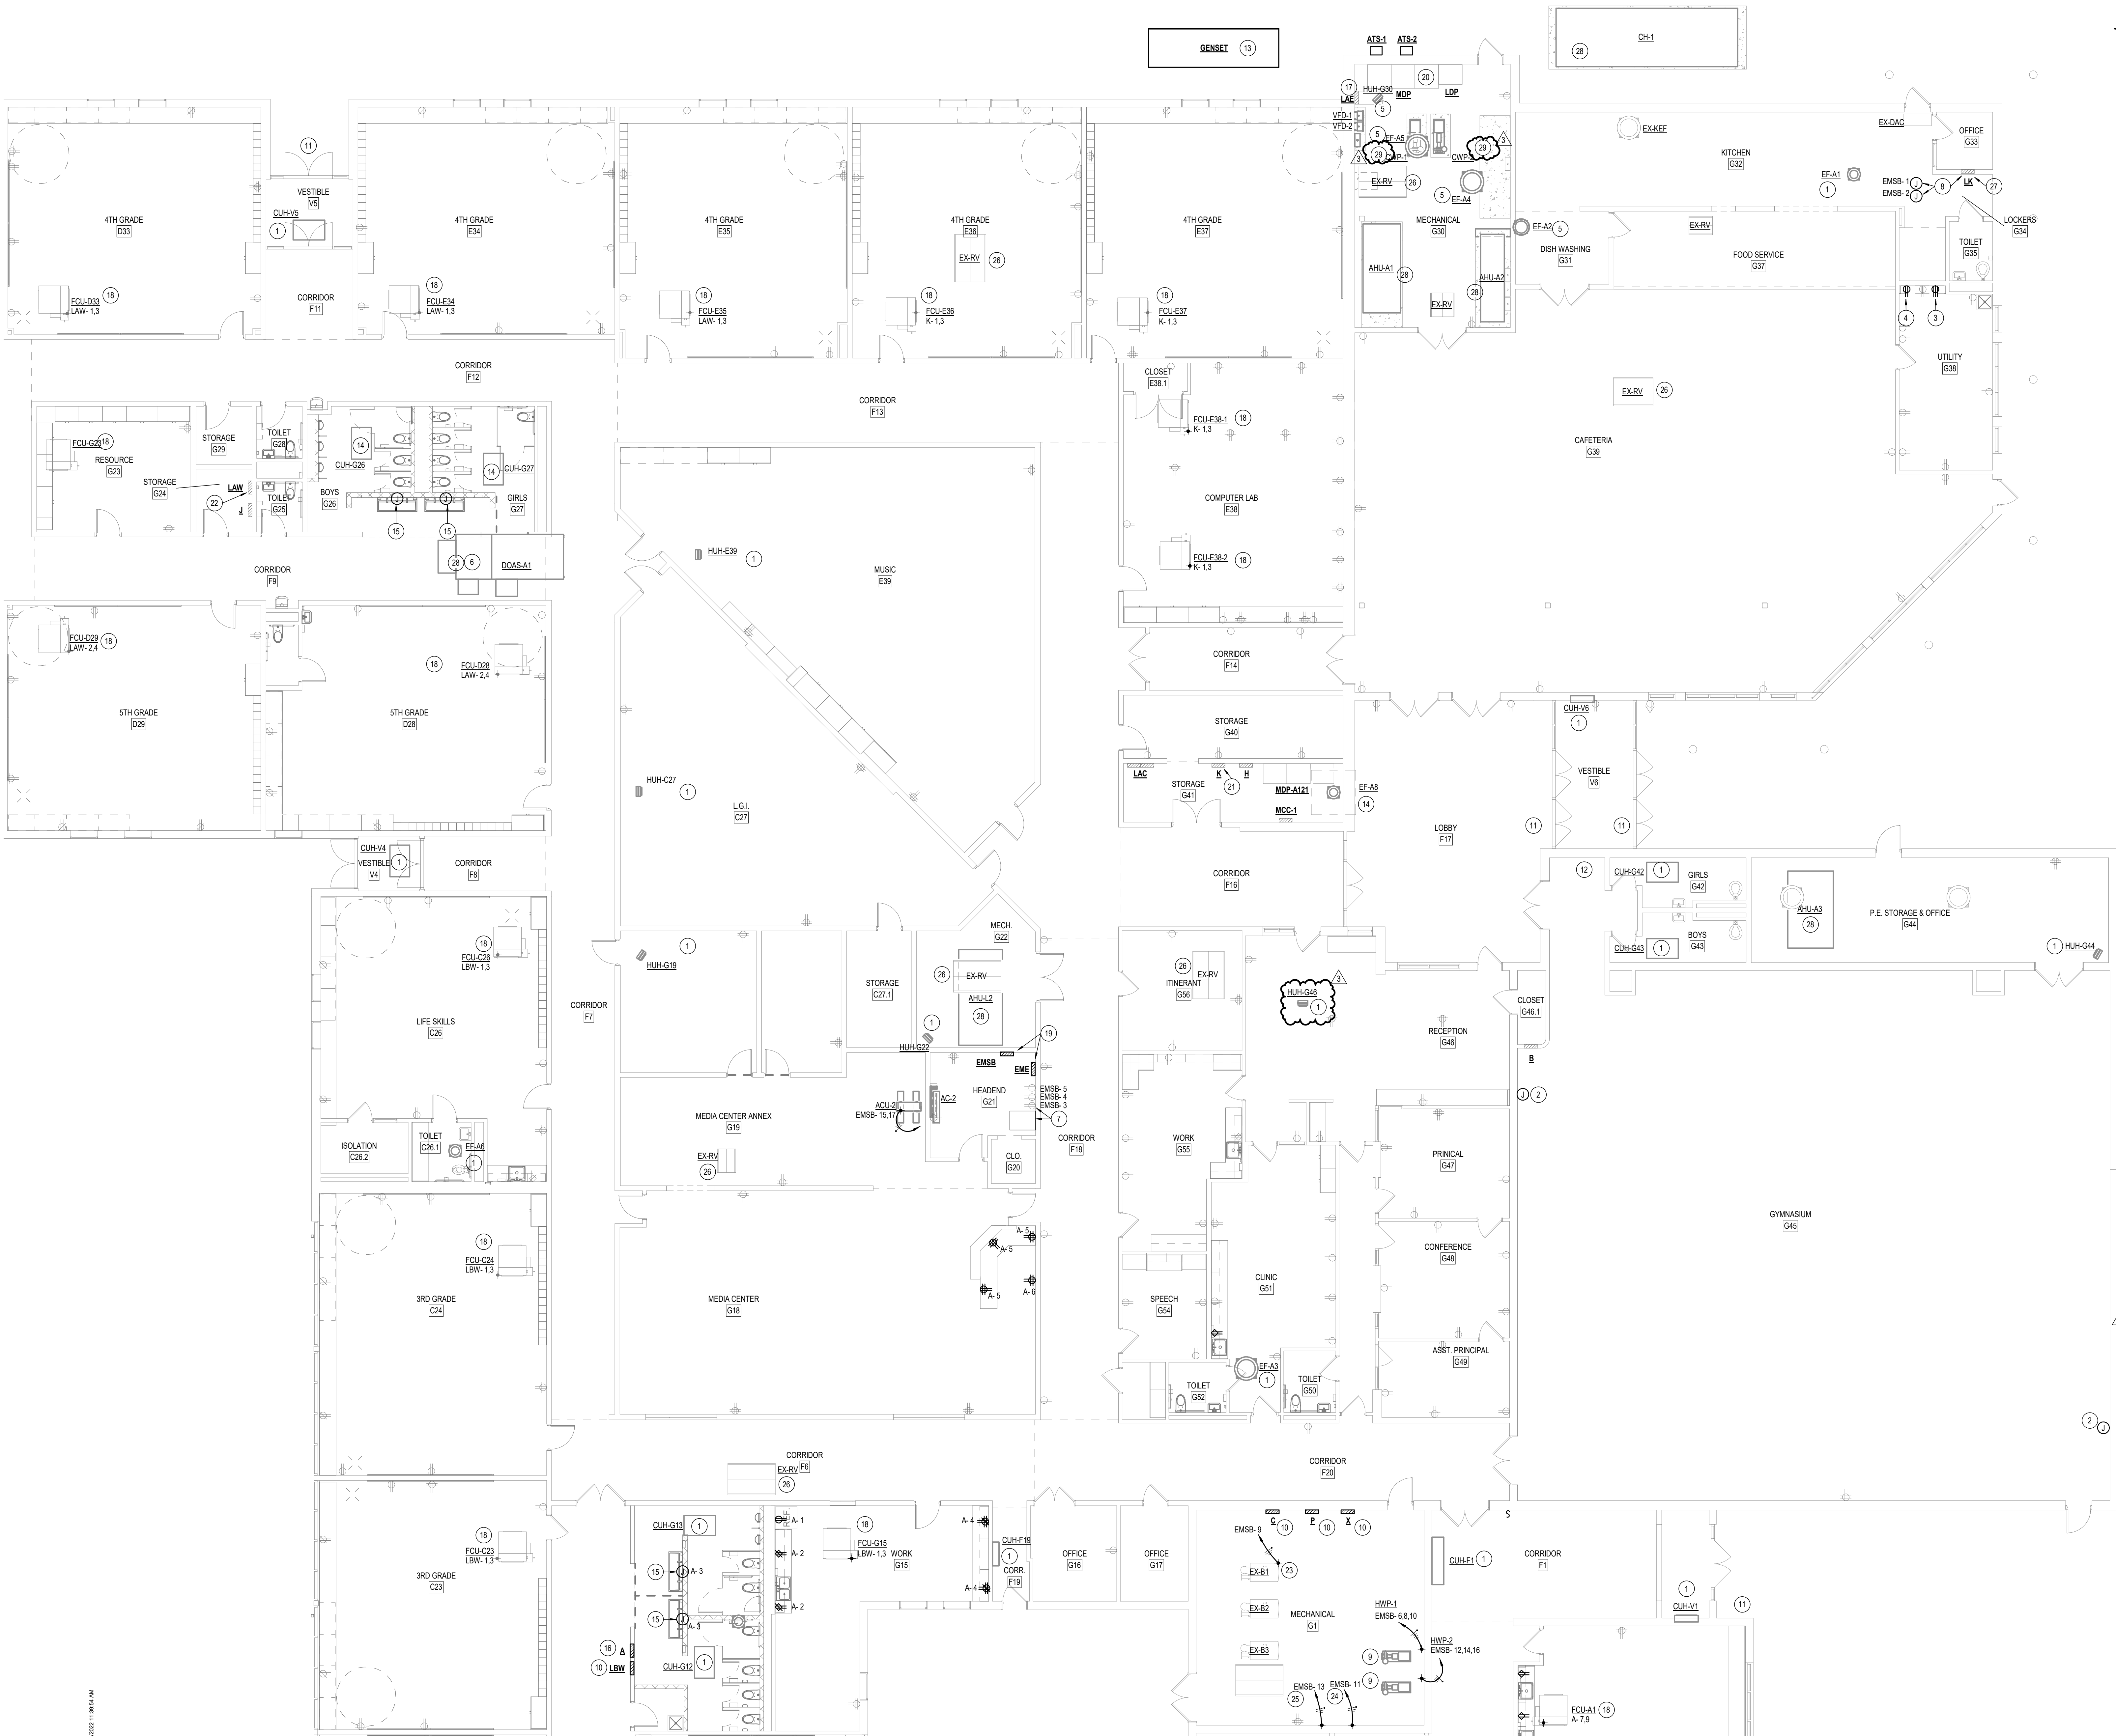

- ### GENERAL SHEET NOTES
- A. SEE SHEET E-000 FOR SYMBOLS AND ABBREVIATIONS.
B. SEE SHEET E-401 FOR ONE-LINE DIAGRAM.
C. SEE SHEET E-502 FOR MOTORIZED EQUIPMENT SCHEDULE AND PANEL SCHEDULES.
D. SEE SHEETS E-601 AND E-602 FOR ELECTRICAL DETAILS.
E. WIRING SYSTEM SHALL BE CONDUIT AND CONDUCTOR UNLESS NOTED OTHERWISE. USE SOLID CONDUCTOR FOR SIZE #10 AWG AND SMALLER. USE STRANDED CONDUCTOR FOR LARGER SIZES.
F. ALL COVER PLATES FOR ELECTRICAL DEVICES SHALL BE OF A COLOR TO MATCH THE AREA COLOR SCHEME AS DIRECTED BY THE INTERIOR DESIGNER.
G. ALL WORK SHALL COMPLY WITH ALL NATIONAL, STATE AND LOCAL CODES AND ORDINANCES PERTAINING TO THE WORK IN THIS PROJECT.
H. EXPOSED CONDUIT SHALL BE RUN PARALLEL TO AND AT RIGHT ANGLES TO BUILDING LINES.
I. REFER TO ARCHITECTURAL DRAWINGS FOR DESIGNATION AND LISTING OF FIRE RATED ASSEMBLIES. COORDINATE ALL DESIGN EFFORTS WITH FIRE RESISTANCE OF MATERIALS AND CONSTRUCTION.
J. ALL EXTERIOR EQUIPMENT AND DEVICES SHALL BE WEATHER PROOF AND RAIN TIGHT.
K. ELECTRICAL CONTRACTOR SHALL FURNISH AND INSTALL ALL INTERCONNECT WIRING FOR MECHANICAL AND PLUMBING EQUIPMENT FURNISHED BY OTHERS.
L. REPLACE ALL WIRING DEVICES AND COVER PLATES IN CLASSROOMS WITH NEW.
M. CONNECT NEW WIRING DEVICES IN CLASSROOMS TO NEAREST AVAILABLE CIRCUIT WITH AVAILABLE AMPACITY UNLESS OTHERWISE NOTED. SURFACE MOUNT NEW DEVICES AS REQUIRED. WIREMOLD 4000 SERIES RACEWAY OR APPROVED EQUIVALENT.
N. DASHED CIRCLES AND X'S DENOTE PRIMARY AND SECONDARY TEACHER'S DESK LOCATIONS. CIRCLE IS PRIMARY LOCATION AND 'X' IS SECONDARY LOCATION. POWER IS REQUIRED AT THESE LOCATIONS AS SHOWN.
- ### SHEET PLAN NOTES
- EXTEND EXISTING CIRCUITRY AS REQUIRED FROM DEMOLISHED MECHANICAL UNIT TO CONNECT TO NEW UNIT.
 - SCOREBOARDS: PROVIDE POWER FOR (2) LED SCOREBOARDS PER MANUFACTURER'S INSTRUCTIONS. CONFIRM EXACT LOCATIONS WITH ARCHITECT PRIOR TO ROUGH-IN.
 - FURNISH AND INSTALL 14-30R TYPE RECEPTACLE FOR DRYER. POWER FROM NEW 30A/2P 208V BREAKER IN PANEL LK.
 - FURNISH AND INSTALL DEDICATED 20A RECEPTACLE FOR WASHER. POWER FROM SPARE 20A/1P 120V BREAKER IN PANEL LK.
 - RECONNECT EXISTING CIRCUITRY TO NEW MECHANICAL UNIT.
 - EQUIPMENT IS LOCATED ON ROOF. CONNECT NEW UNIT TO EXISTING CIRCUITRY. EXTEND CIRCUITRY AS REQUIRED. MATCH EXISTING WIRE SIZE.
 - EXISTING I.T. EQUIPMENT TO BE POWERED BY NEW STANDBY POWER PANEL EMSB. PROVIDE (3) DEDICATED 120V/1P CIRCUIT TO EQUIPMENT. NEW RECEPTACLES ARE SHOWN FOR REFERENCE. POWER EXISTING EQUIPMENT AND RECEPTACLES AS REQUIRED.
 - KITCHEN FREEZER & REFRIGERATOR TO BE POWERED BY NEW STANDBY POWER PANEL DISCONNECT FREEZER AND REFRIGERATOR FROM PANEL LK AND CONNECT TO PANEL EMSB. MATCH EXISTING CIRCUIT SIZE. COORDINATE SPECIFIC FREEZE AND FREEZERS WITH OWNER.
 - PUMP TO BE POWERED BY NEW STANDBY POWER PANEL EMSB. SEE MOTORIZED EQUIPMENT SCHEDULE FOR CIRCUIT SIZING.
 - REPLACE DEMOLISHED PANELBOARD. MATCH EXISTING BREAKER SIZES. PANEL CONTAINS 8 SPARE 20A/1P BREAKERS. USE SPARES TO FEED NEW FAN COIL UNITS AS REQUIRED. EXTEND FEEDER AS REQUIRED WITH SAME WIRE SIZE. RECONNECT EXISTING CIRCUITRY TO NEW PANELBOARD. SEE PANELBOARD SIZES ON E-401.
 - PROVIDE 120V/1PH CIRCUIT TO DOOR CONTROLLER FOR DOOR FROM NEAREST AVAILABLE 120V CIRCUIT WITH AVAILABLE AMPACITY. MINIMUM WIRE SIZE #12.
 - PROVIDE DEDICATED 120V/1P CIRCUIT FROM PANEL B TO ADA PUSHBUTTONS. MINIMUM WIRE SIZE #12.
 - SEE E-401 FOR GENERATOR SIZE AND RATINGS. GENERATOR TO BE CONNECTED TO NATURAL GAS UTILITY. PROVIDE 60A/3P CIRCUIT TO GENERATOR FROM PANEL LAE IN MECHANICAL ROOM. WIRE SIZE TO BE #6 W/ #10 GND IN 1" C.
 - PROVIDE 120V/1P EQUIPMENT FROM NEAREST AVAILABLE UNSWITCHED CIRCUIT WITH AVAILABLE AMPACITY. MINIMUM WIRE SIZE #12.
 - PROVIDE 120V/1P CIRCUIT TO LAVATORY STATION. COORDINATE FINAL JUNCTION BOX LOCATION WITH LAVATORY SHOP DRAWINGS. MINIMUM WIRE SIZE #12.
 - REPLACE DEMOLISHED PANELBOARD. MATCH EXISTING BREAKER SIZES. EXTEND FEEDER AS REQUIRED WITH SAME WIRE SIZE. RECONNECT EXISTING CIRCUITRY TO NEW PANELBOARD. NOTE NEW CIRCUITS REQUIRED IN WORK ROOM G15.
 - FURNISH AND INSTALL 60A/3P BREAKER IN PANEL LAE FOR GENERATOR ON-BOARD PANEL.
 - PROVIDE 208V/1P CIRCUIT TO UNIT FROM NEAREST AVAILABLE PANEL. NEW BREAKERS TO BE INSTALLED IN PANELS TO ACCOMMODATE 208V/1P UNITS. MINIMUM WIRE SIZE 2#12 W/ #12 GND IN 3/4" CONDUIT. RE-USE EXISTING CONDUIT AS POSSIBLE. NEW FAN COIL UNITS HAVE LARGER HORSEPOWER THAN EXISTING DEMOLISHED UNITS. (4) FAN COIL UNITS PER 20A 208V/1P CIRCUIT BREAKER. PANEL AND CIRCUIT NUMBERING ARE SHOWN FOR SUGGESTED GROUPING PURPOSES ONLY.
 - FURNISH AND INSTALL NEW EMERGENCY EGRESS AND EMERGENCY STANDBY PANELS. SEE E-502 FOR PANEL SCHEDULES.
 - FURNISH AND INSTALL SWITCHED BUCKETS IN MDP FOR PANEL EME AND EMSB. SEE E-401 FOR SWITCH AND FUSE SIZING. CORE WALL AS REQUIRED TO CONNECT TO AUTOMATIC TRANSFER SWITCHES.
 - FURNISH AND INSTALL NEW 20A 208V/1P BREAKERS IN PANEL TO FEED NEW FAN COIL UNITS. ADJUST BREAKERS IN PANEL AS REQUIRED TO FIT NEW BREAKERS. (4) FAN COIL UNITS PER BREAKER. PANEL CONTAINS 4 SPARES/SPACES.
 - FURNISH AND INSTALL NEW 20A 208V/1P BREAKERS IN PANEL TO FEED NEW FAN COIL UNITS. ADJUST BREAKERS IN PANEL AS REQUIRED TO FIT NEW BREAKERS. (4) FAN COIL UNITS PER BREAKER. PANEL CONTAINS 4 SPARES/SPACES.
 - EXISTING BOLLER TO BE POWERED BY NEW STANDBY POWER PANEL EMSB. MINIMUM WIRE SIZE 2#12 W/ #12 GND IN 3/4" C.
 - PROVIDE CIRCUIT TO NEW HOT WATER CONTROL PANEL FROM PANEL EMSB. COORDINATE FINAL CONTROL PANEL LOCATION WITH TEMPERATURE CONTROLS CONTRACTOR. MINIMUM WIRE SIZE 2#12 W/ #12 GND IN 3/4" C.
 - PROVIDE CIRCUIT TO NEW BUILDING AUTOMATION SYSTEM CONTROL PANEL FROM PANEL EMSB. COORDINATE FINAL CONTROL PANEL LOCATION WITH TEMPERATURE CONTROLS CONTRACTOR. MINIMUM WIRE SIZE 2#12 W/ #12 GND IN 3/4" C.
 - PROVIDE 120V/1P CIRCUIT FROM NEAREST AVAILABLE UNSWITCHED CIRCUIT WITH AVAILABLE AMPACITY FOR NEW MOTORIZED GRAVITY DAMPER ON ROOF. COORDINATE GRAVITY DAMPER REPLACEMENT WITH MECHANICAL CONTRACTOR. MINIMUM WIRE SIZE #12.
 - FURNISH AND INSTALL NEW 30A/2P 208V BREAKER TO FEED NEW DRYER IN UTILITY G38.
 - FURNISH AND INSTALL NEW BREAKER SIZED ACCORDING TO MOTORIZED EQUIPMENT SCHEDULE ON E-502. PANEL WHICH SERVES UNIT. RECONNECT EXISTING FEEDER TO NEW MECHANICAL UNIT. EXTEND CIRCUITRY AS REQUIRED.
 - FURNISH AND INSTALL NEW CIRCUITRY TO CHILLED WATER PUMP. FURNISH AND INSTALL NEW BREAKER IN PANEL FEEDING CHILLED WATER PUMP. SEE MOTORIZED EQUIPMENT SCHEDULE ON E-502 FOR BREAKER AND WIRE SIZES.

1 FIRST FLOOR POWER PLAN - UNIT A
1/8" = 1'-0"

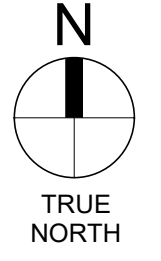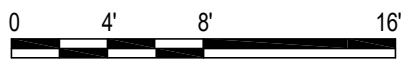


REVISIONS:		
#	Date	Desc.
1	04/20/2022	Addendum #1
2	04/26/2022	Addendum #2
3	05/02/2022	Addendum #3

100% CONSTRUCTION DOCUMENTS
CDG PROJECT: #211028
DATE: 04.06.2022
DRAWN BY: KTS

FIRST FLOOR
POWER PLAN -
UNIT A

EP101A

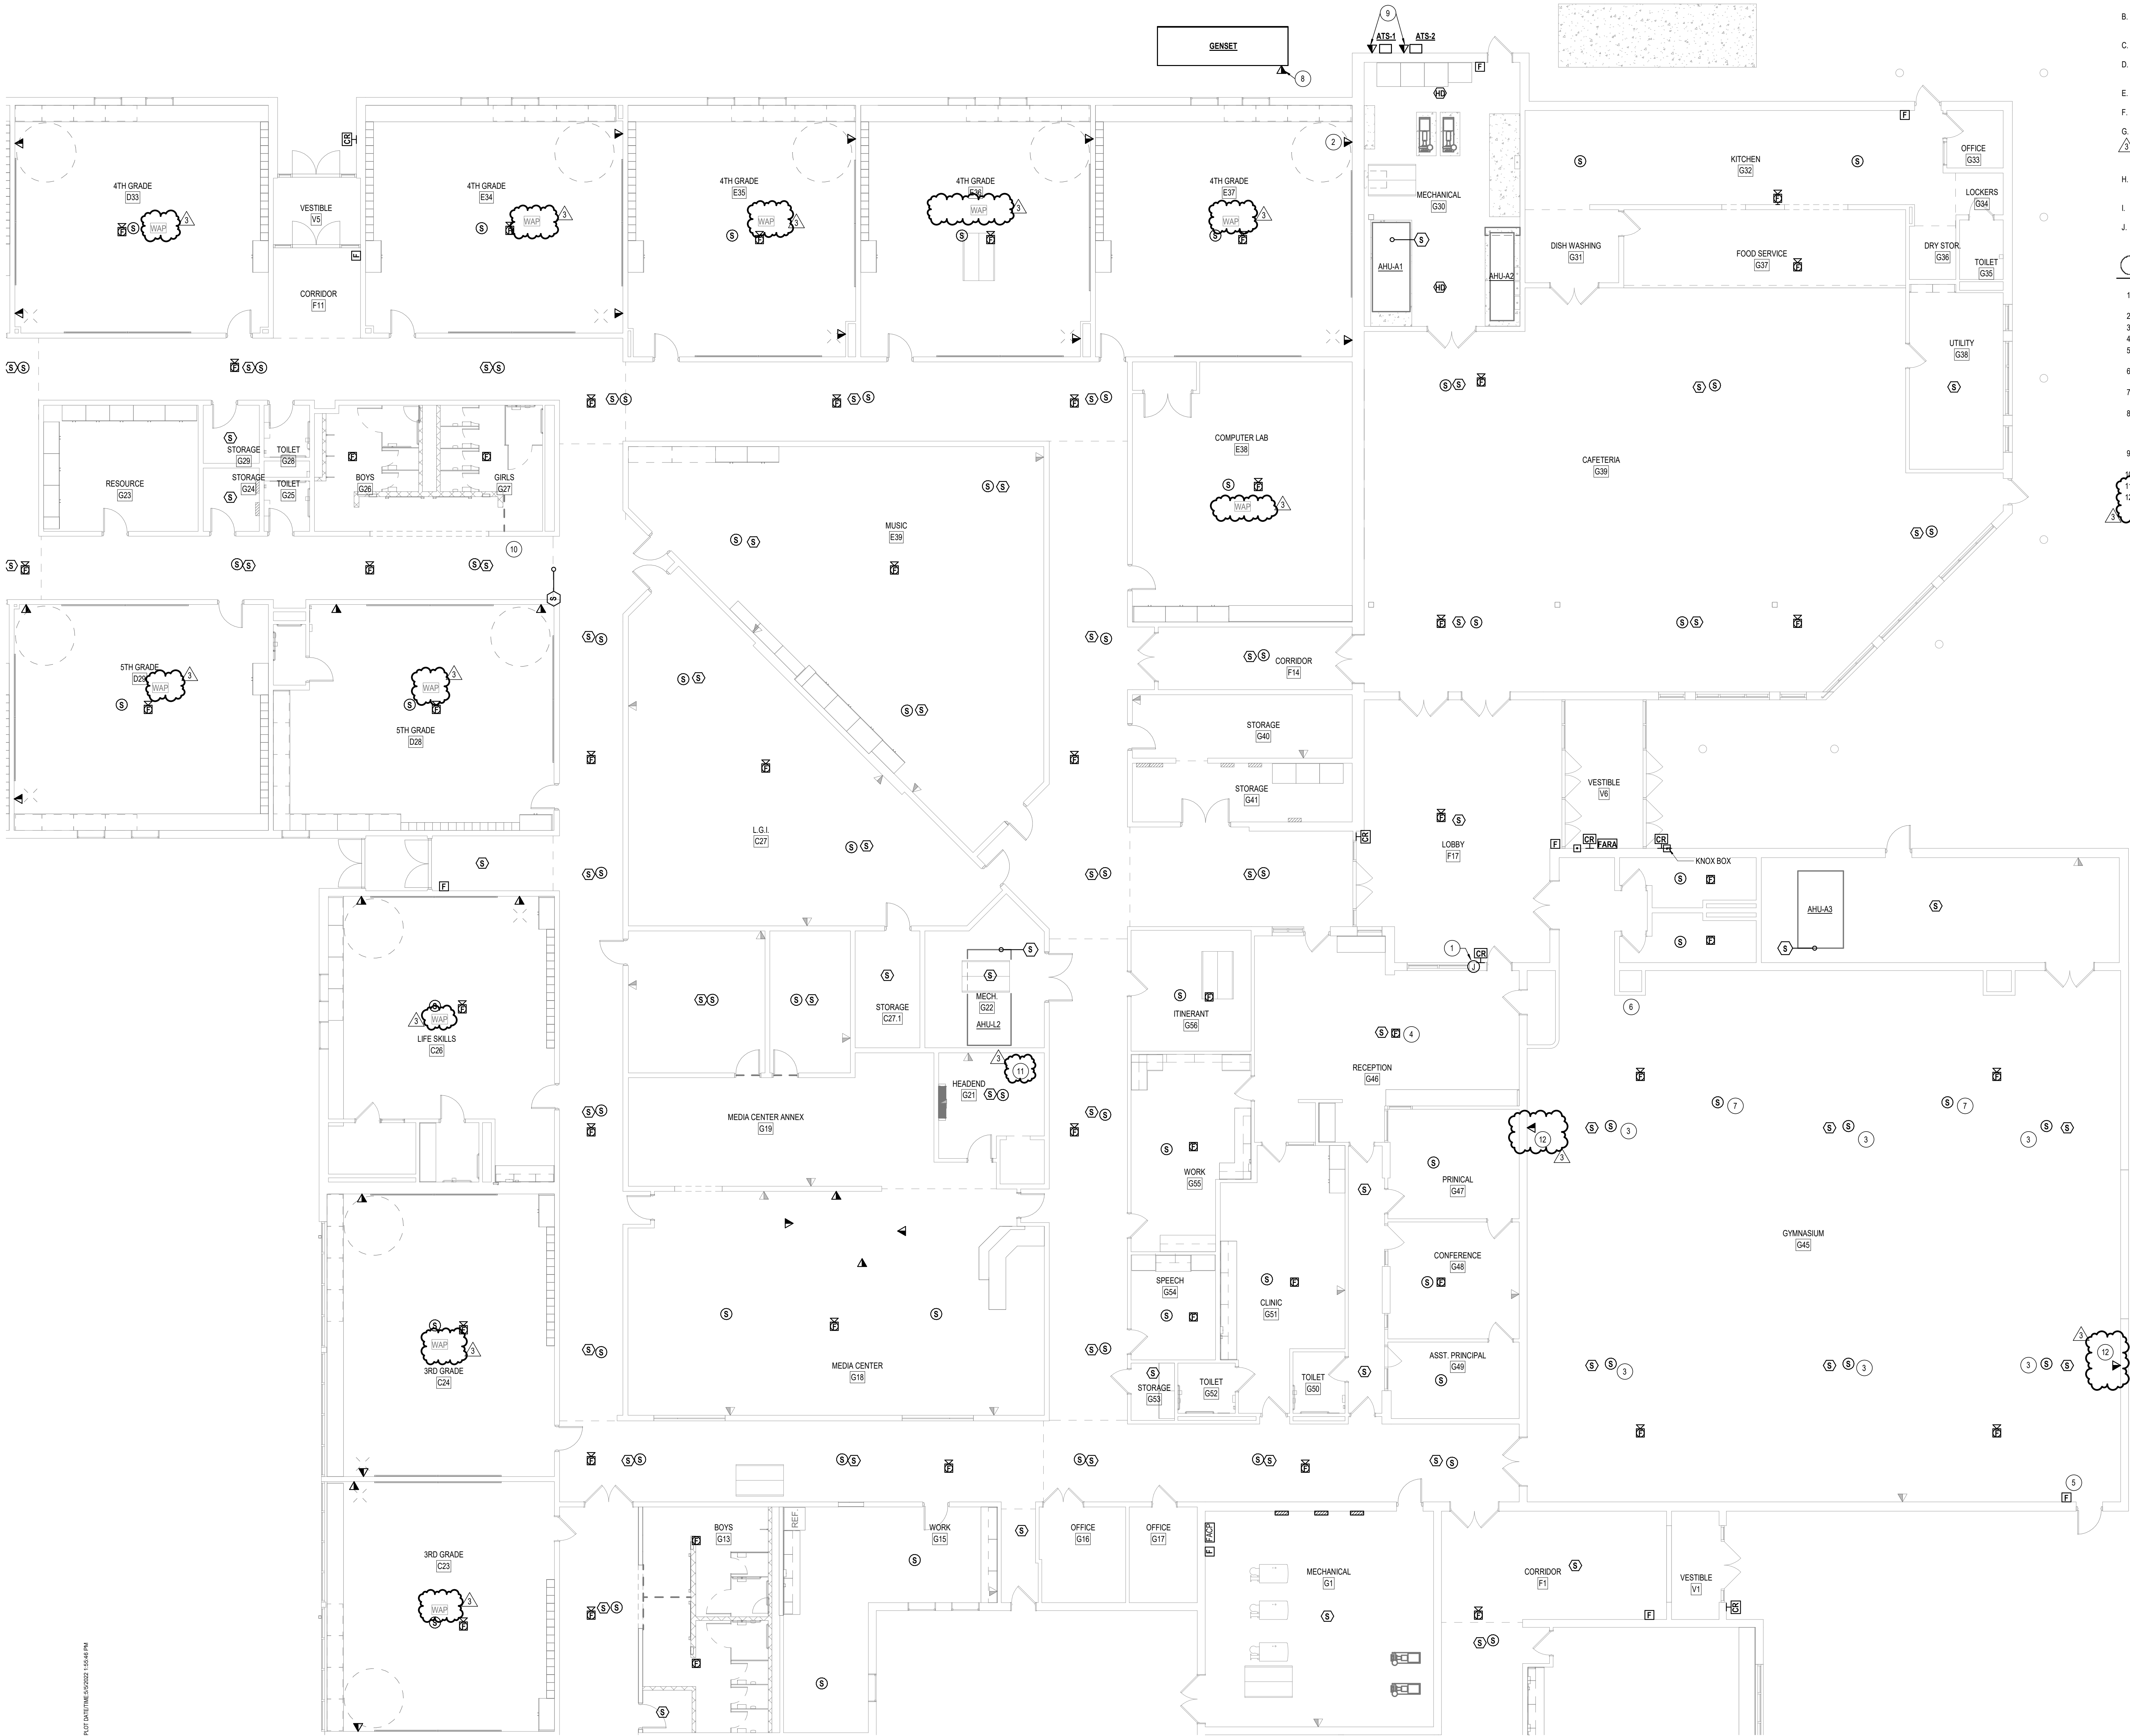

- GENERAL SHEET NOTES**
- A. ALL COVER PLATES FOR ELECTRICAL DEVICES SHALL BE OF A COLOR TO MATCH THE AREA COLOR SCHEME AS DIRECTED BY THE INTERIOR DESIGNER.
 - B. ALL WORK SHALL COMPLY WITH ALL NATIONAL, STATE AND LOCAL CODES AND ORDINANCES PERTAINING TO THE WORK IN THIS PROJECT. WHEN DISCREPANCIES ARISE, THE MOST STRINGENT CODE SHALL APPLY.
 - C. EXPOSED CONDUIT SHALL BE RUN PARALLEL TO AND AT RIGHT ANGLES TO BUILDING LINES.
 - D. REFER TO ARCHITECTURAL DRAWINGS FOR DESIGNATION AND LISTING OF FIRE RATED ASSEMBLIES. COORDINATE ALL DESIGN EFFORTS WITH FIRE RESISTANCE OF MATERIALS AND CONSTRUCTION.
 - E. ALL EXTERIOR EQUIPMENT AND DEVICES SHALL BE WEATHER PROOF AND RAIN TIGHT.
 - F. COLOR CODING AS PER OWNERS STANDARDS. COORDINATE AT TIME OF SUBMITTAL.
 - G. CONTRACTOR TO RUN DATA CABLE FROM NEW DATA OUTLETS TO EXISTING DATA CABLE ACCESS POINT LOCATION ABOVE CEILING.
 - H. DASHED CIRCLES AND X'S DENOTE PRIMARY AND SECONDARY TEACHER'S DESK LOCATIONS. CIRCLE IS PRIMARY LOCATION AND 'X' IS SECONDARY LOCATION. DATA OUTLET IS REQUIRED AT THESE LOCATIONS.
 - I. INTERCOM SPEAKERS SHOWN ON PLANS ARE TYPE 2 UNLESS OTHERWISE NOTED.
 - J. INTERCOM SPEAKERS AND FIRE ALARM DEVICES SHOWN ON PLANS ARE APPROXIMATED. CONTRACTOR TO FIELD VERIFY LOCATION AND COUNT OF EXISTING DEVICES TO BE REPLACED.
- SHEET PLAN NOTES**
- 1. VIDEO INTERCOM. REPLACE EXISTING ALPHONE WITH SYSTEM THAT MATCHES OR EXCEEDS ALPHONE SPECIFICATIONS.
 - 2. PURNISH AND INSTALL DATA OUTLET ADJACENT TO TEACHERS DESK LOCATION.
 - 3. TYPE 2 SPEAKER FOR GYMNASIUM AUDIO SYSTEM.
 - 4. INTERCOM. PROVIDE "PANIC" BUTTON IN ADMIN AREA.
 - 5. FIRE ALARM. FIRE ALARM PULL STATION TO BE PROVIDED WITH PROTECTIVE COVER.
 - 6. SOUND SYSTEM RACK LOCATION. INSTALL NEW SOUND RACK IN PLACE OF EXISTING SOUND RACK. RETURN EXISTING SOUND EQUIPMENT TO OWNER.
 - 7. TYPE 1 SPEAKER FOR GYMNASIUM SOUND SYSTEM SUSPENDED AT FREE THROW LINE OF BASKETBALL COURT.
 - 8. PROVIDE DATA CABLE TO GENSET FROM MDF FOR MONITORING CONNECTIVITY. VERIFY DATA CABLE REQUIREMENTS WITH MANUFACTURERS SPECIFICATIONS. GENSET TO BE MONITORED BY BUILDING AUTOMATION SYSTEM. PROVIDE PROVISIONS FOR MONITORING GENERATOR WITH BAS.
 - 9. PROVIDE DATA CABLE TO ATS FROM MDF FOR MONITORING CONNECTIVITY. VERIFY DATA CABLE REQUIREMENTS WITH MANUFACTURERS SPECIFICATIONS.
 - 10. MECH. ROOM.
 - 11. MECH. ROOM.
 - 12. INSTALL DATA OUTLET AT SCOREBOARD HEIGHT. CABLE TO BE RUN TO SOUND RACK AT PLAN NOTE 8.

1 FIRST FLOOR TECHNOLOGY PLAN - UNIT A
1/8" = 1'-0"




REVISIONS:		Date	Desc.
#			
3		05/02/2022	Addendum #3


100% CONSTRUCTION DOCUMENTS

CDG PROJECT: #21102B
DATE: 04/06/2022
DRAWN BY: KTS

FIRST FLOOR
TECHNOLOGY
PLAN - UNIT A

ET101A

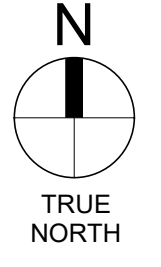

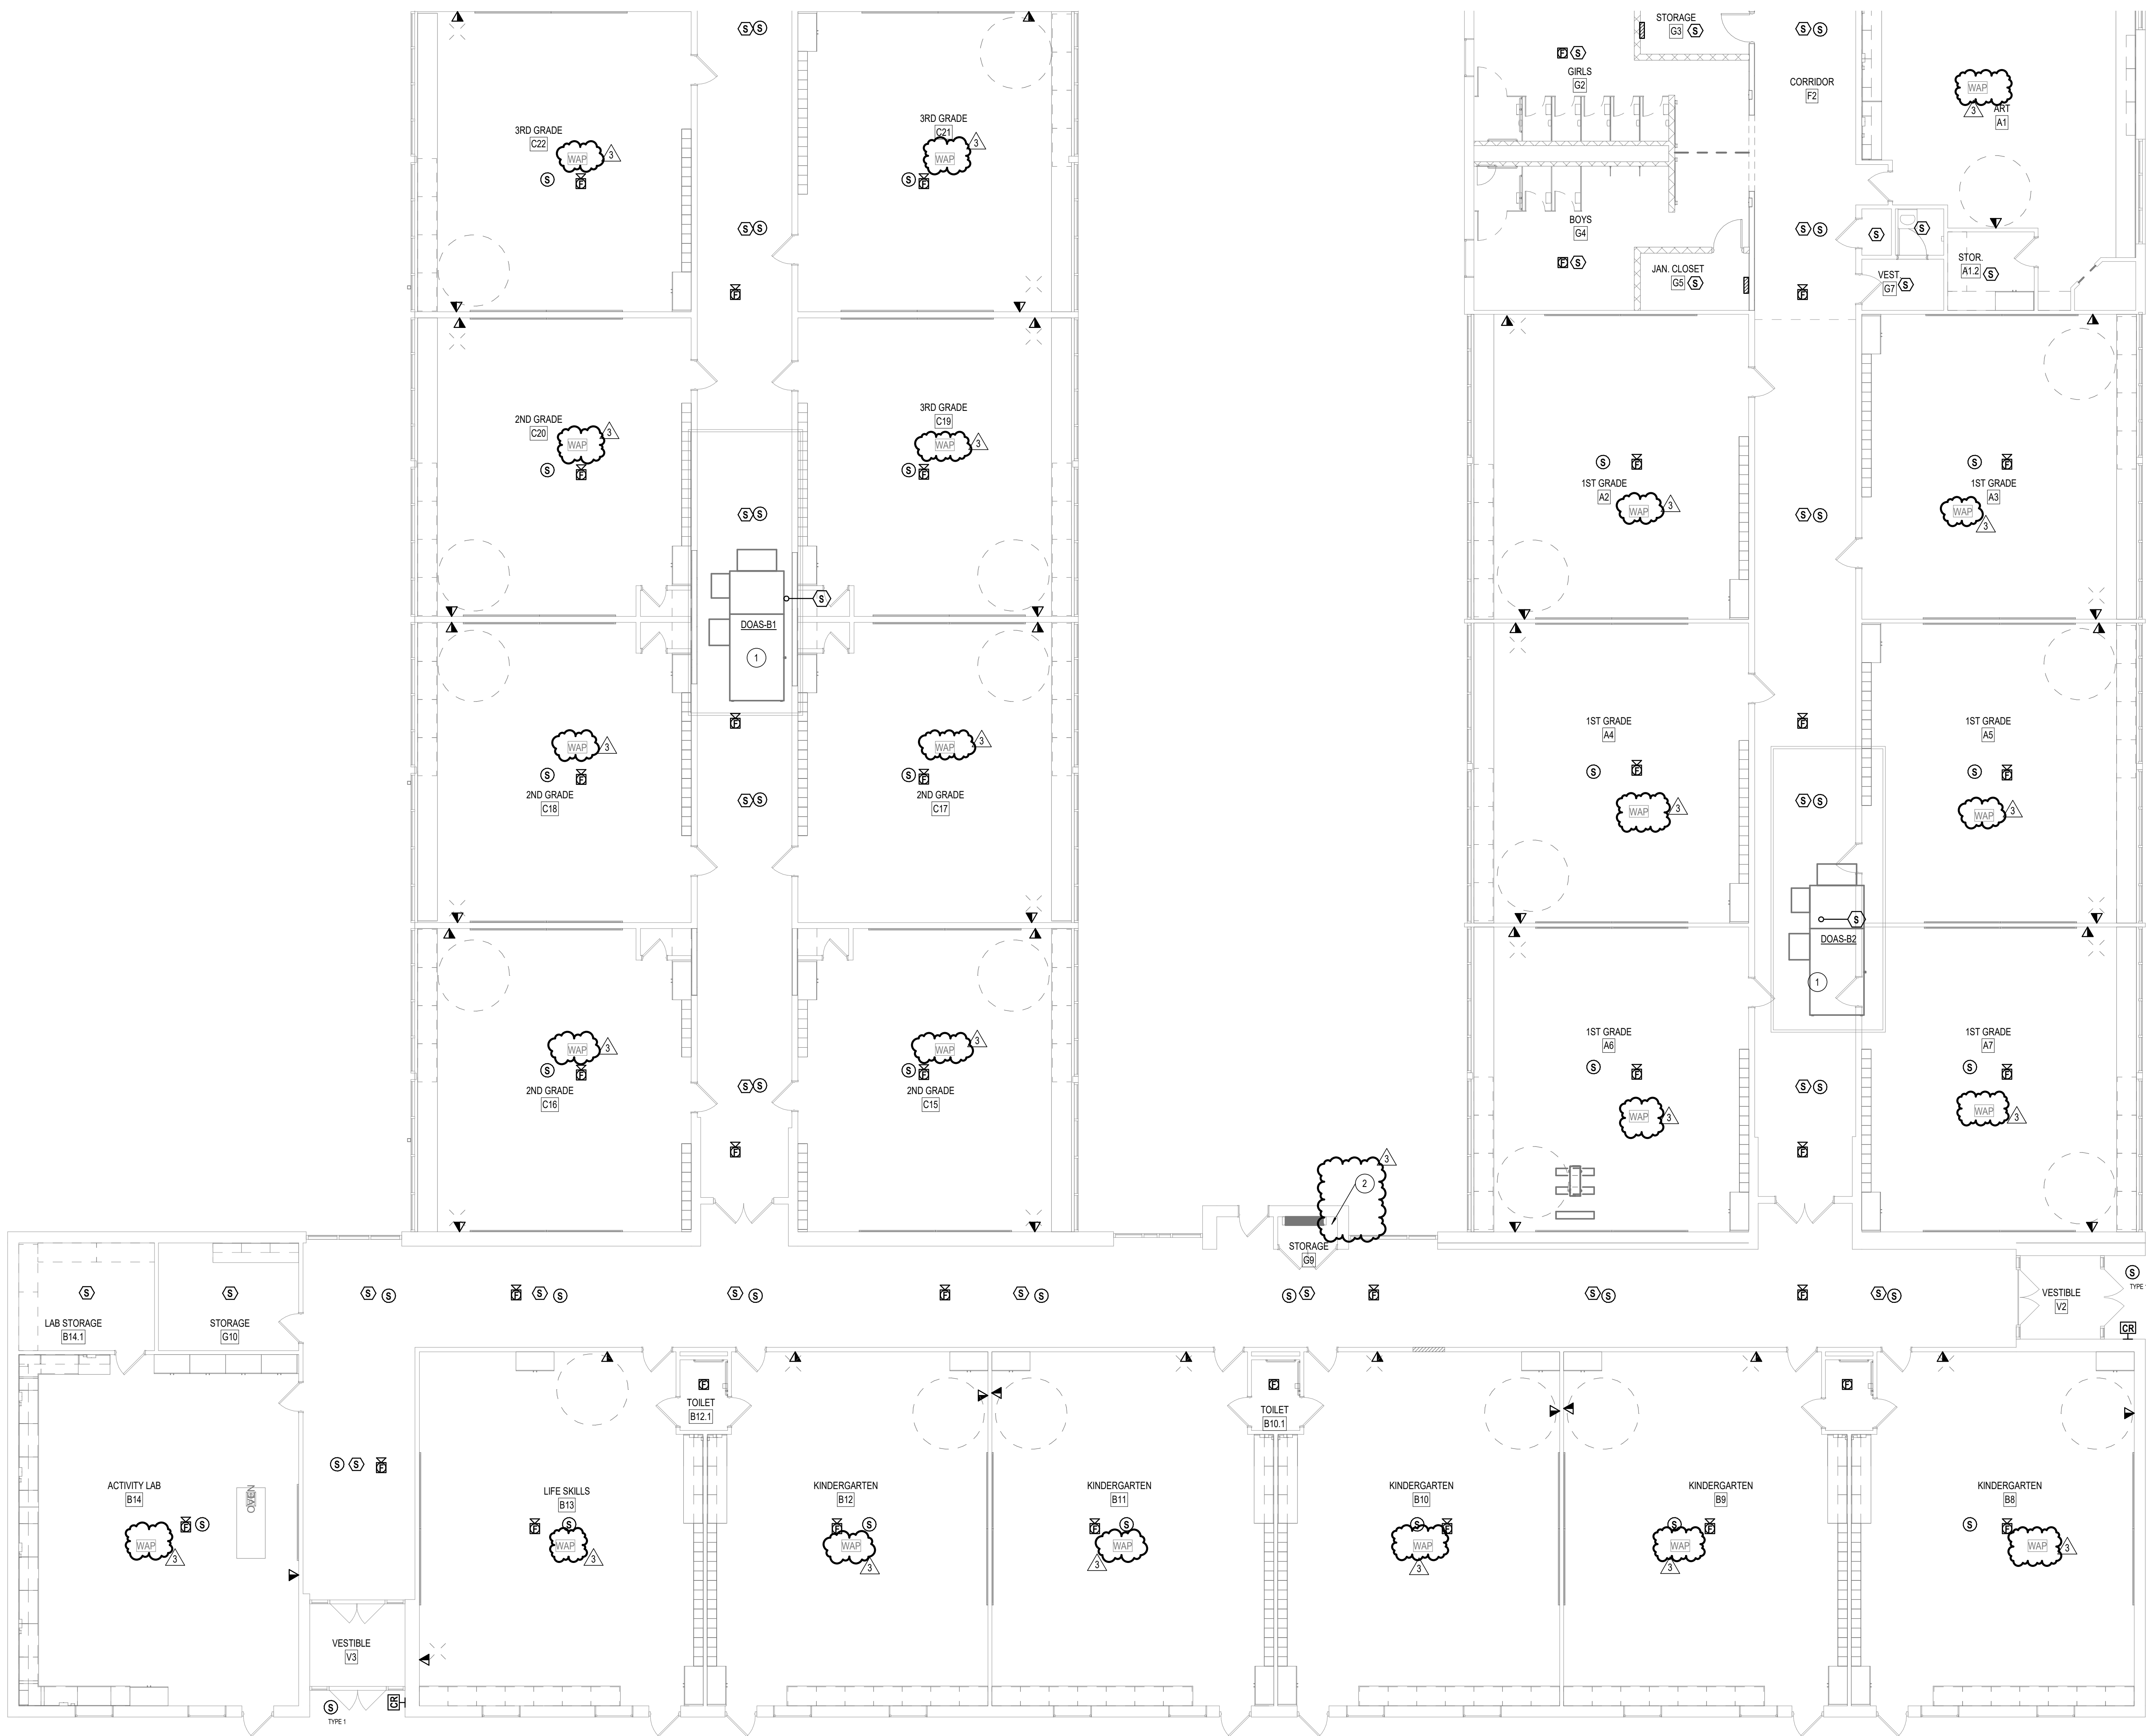

1 FIRST FLOOR TECHNOLOGY PLAN - UNIT B
1/8" = 1'-0"

GENERAL SHEET NOTES

- ALL COVER PLATES FOR ELECTRICAL DEVICES SHALL BE OF A COLOR TO MATCH THE AREA COLOR SCHEME AS DIRECTED BY THE INTERIOR DESIGNER.
- ALL WORK SHALL COMPLY WITH ALL NATIONAL, STATE AND LOCAL CODES AND ORDINANCES PERTAINING TO THE WORK IN THIS PROJECT. WHEN DISCREPANCIES ARISE, THE MOST STRINGENT CODE SHALL APPLY.
- EXPOSED CONDUIT SHALL BE RUN PARALLEL TO AND AT RIGHT ANGLES TO BUILDING LINES.
- REFER TO ARCHITECTURAL DRAWINGS FOR DESIGNATION AND LISTING OF FIRE RATED ASSEMBLIES. COORDINATE ALL DESIGN EFFORTS WITH FIRE RESISTANCE OF MATERIALS AND CONSTRUCTION.
- ALL EXTERIOR EQUIPMENT AND DEVICES SHALL BE WEATHER PROOF AND RAIN TIGHT.
- COLOR CODING AS PER OWNERS STANDARDS. COORDINATE AT TIME OF SUBMITTAL.
- CONTRACTOR TO RUN DATA CABLE FROM NEW DATA OUTLETS TO EXISTING WIRELESS ACCESS POINT LOCATION ABOVE CEILING.
- DATA CABLES PER OUTLET TO BE RUN AND SECURE CABLE AS REQUIRED.
- WIRELESS ACCESS POINTS IN CLASSROOMS AND CONNECT NEW DATA CABLE TO WAP.
- DASHED CIRCLES AND X'S DENOTE PRIMARY AND SECONDARY TEACHER'S DESK LOCATIONS. CIRCLE IS PRIMARY LOCATION AND 'X' IS SECONDARY LOCATION. DATA OUTLET IS REQUIRED AT THESE LOCATIONS.
- INTERCOM SPEAKERS SHOWN ON PLANS ARE TYPE 2 UNLESS OTHERWISE NOTED.
- INTERCOM SPEAKERS AND FIRE ALARM DEVICES SHOWN ON PLANS ARE APPROXIMATED. CONTRACTOR TO FIELD VERIFY LOCATION AND COUNT OF EXISTING DEVICES TO BE REPLACED.


SHEET PLAN NOTES




REVISIONS:	Date	Desc.
#		
3	05/02/22	Addendum #3

100% CONSTRUCTION DOCUMENTS
CDG PROJECT: #21102B
DATE: 04/06/2022
DRAWN BY: KTS

FIRST FLOOR
TECHNOLOGY
PLAN - UNIT B

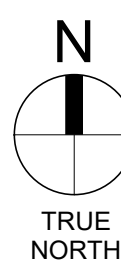

ET101B

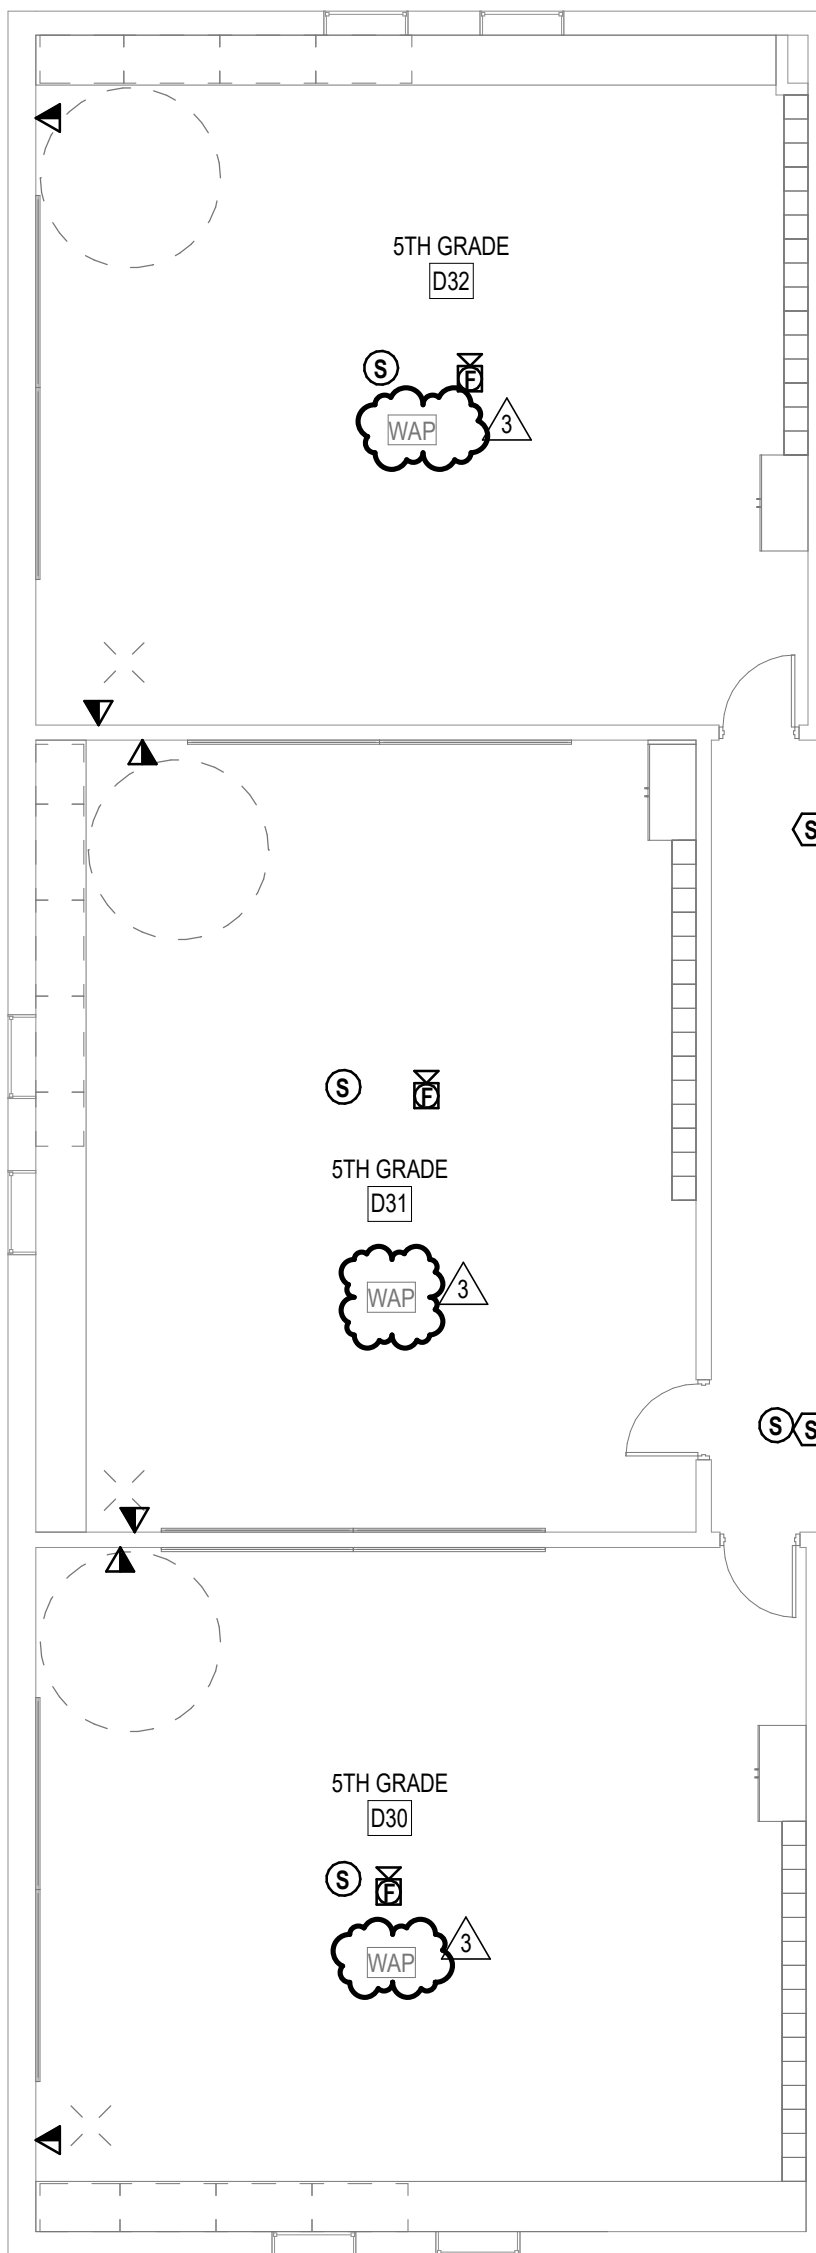

1 FIRST FLOOR TECHNOLOGY PLAN - UNIT C
1/8" = 1'-0"

GENERAL SHEET NOTES

- ALL COVER PLATES FOR ELECTRICAL DEVICES SHALL BE OF A COLOR TO MATCH THE AREA COLOR SCHEME AS DIRECTED BY THE INTERIOR DESIGNER.
- ALL WORK SHALL COMPLY WITH ALL NATIONAL, STATE AND LOCAL CODES AND ORDINANCES PERTAINING TO THE WORK IN THIS PROJECT. WHEN DISCREPANCIES ARISE, THE MOST STRINGENT CODE SHALL APPLY.
- EXPOSED CONDUIT SHALL BE RUN PARALLEL TO AND AT RIGHT ANGLES TO BUILDING LINES.
- REFER TO ARCHITECTURAL DRAWINGS FOR DESIGNATION AND LISTING OF FIRE RATED ASSEMBLIES. COORDINATE ALL DESIGN EFFORTS WITH FIRE RESISTANCE OF MATERIALS AND CONSTRUCTION.
- ALL EXTERIOR EQUIPMENT AND DEVICES SHALL BE WEATHER PROOF AND RAIN TIGHT.
- COLOR CODING AS PER OWNERS STANDARDS. COORDINATE AT TIME OF SUBMITTAL.
- CONTRACTOR TO RUN DATA CABLE FROM NEW DATA OUTLETS TO EXISTING ACCESS POINT LOCATION ABOVE CEILING.
- DATA CABLES PER OUTLET, COIL AND SECURE CABLE AS REQUIRED.
- CONNECT NEW DATA CABLE TO WAP.
- DASHED CIRCLES AND 'X'S' DENOTE PRIMARY AND SECONDARY TEACHER'S DESK LOCATIONS. CIRCLE IS PRIMARY LOCATION AND 'X' IS SECONDARY LOCATION. DATA OUTLET IS REQUIRED AT THESE LOCATIONS.
- INTERCOM SPEAKERS SHOWN ON PLANS ARE TYPE 2 UNLESS OTHERWISE NOTED.
- INTERCOM SPEAKERS AND FIRE ALARM DEVICES SHOWN ON PLANS ARE APPROXIMATED. CONTRACTOR TO FIELD VERIFY LOCATION AND COUNT OF EXISTING DEVICES TO BE REPLACED.



LANCER + BEEBE, LLC
ARCHITECTURE | PLANNING | INTERIORS
220 N. COLLEGE AVE
INDIANAPOLIS, IN 46202

SHELBYVILLE CENTRAL SCHOOLS
CORPORATION
LOPER ELEMENTARY RENOVATIONS & ADDITIONS
901 LOPER DRIVE




REVISIONS:			Date		Desc:	
#						
3			05/02/22		Addendum #3	

100% CONSTRUCTION DOCUMENTS

CDG PROJECT: #21102B
DATE: 04.06.2022
DRAWN BY: KTS

FIRST FLOOR
TECHNOLOGY
PLAN - UNIT C

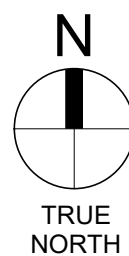

ET101C

MOTORIZED EQUIPMENT SCHEDULE																			
TAG	QUAN	FURN. BY	HP	AMPS	KW	VOLT	PHA SE	STARTER DATA			DISCONNECT SWITCH			CONTROLS		REMA RKS	FEEDER	PANEL/CIRCUIT BREAKER	
								TYPE	NEMC. ENCL	CONTR OLS	BY	TYPE	NEMA ENCL	BY	TYP E				
AC-1			--	23	4.784	208	1					UNIT MTD	3R	MF	MA		EXISTING	DISCONNECT/RECONNECT	
AHU-A1		MC	--	21.8	7.848	208	3	VFD			MC	INTEGRAL	--	MF			EXISTING	35A/3P	
AHU-A2		MC	--	10	3.600	208	3	VFD			EC	30A/3P	3R	EC			EXISTING	15A/3P	
AHU-A3		MC	--	23	8.280	208	3	VFD			EC	40A/3P	3R	EC			EXISTING	40A/3P	
AHU-L2		MC	--	21.8	7.848	208	3	VFD			MC	INTEGRAL	--	MF			EXISTING	35A/3P	
CH-1		MC	--	959	345	208	3	VFD			MC	INTEGRAL	3R	MF	CP	MC	3#500 W/ #2/0 GND IN 4"C	1000A/3P	
CUH-F1		MC	1/4	5.8	0.696	120	1					INTEGRAL	--	MF	CP	MC	EXISTING	DISCONNECT/RECONNECT	
CUH-F19		MC	1/4	5.8	0.696	120	1					INTEGRAL	--	MF	CP	MC	EXISTING	DISCONNECT/RECONNECT	
CWP-1		MC	25	78.2	28.139	208	3					200A/3P	1	EC			3#2 w/ #6 GND IN 1-1/2"C	110/3P	
CWP-2		MC	25	78.2	28.139	208	3					200A/3P	1	EC			3#2 w/ #6 GND IN 1-1/2"C	110/3P	
DOAS-A1		MC	--	95.4	34.344	208	3					UNIT MTD	--	MF			EXISTING	100A/3P	
DOAS-B1		MC	--	95.4	34.344	208	3					UNIT MTD	--	MF			EXISTING	100A/3P	
DOAS-B2		MC	--	87.2	31.392	208	3					UNIT MTD	--	MF			EXISTING	90A/3P	
EF-A1		MC	1/4	5.8	0.696	120	1					INTEGRAL	--	MF	BMS	EXISTING	EXISTING	DISCONNECT/RECONNECT	
EF-A2		MC	1/4	5.8	0.696	120	1					INTEGRAL	--	MF	BMS	EXISTING	EXISTING	DISCONNECT/RECONNECT	
EF-A3		MC	1/15	1.62	0.194	120	1					INTEGRAL	--	MF	BMS	EXISTING	EXISTING	DISCONNECT/RECONNECT	
EF-A4		MC	1/3	7.2	0.864	120	1					INTEGRAL	--	MF	BMS	EXISTING	EXISTING	DISCONNECT/RECONNECT	
EF-A5		MC	1/15	1.62	0.194	120	1					INTEGRAL	--	MF	BMS	EXISTING	EXISTING	DISCONNECT/RECONNECT	
EF-A6		MC	1/4	5.8	0.696	120	1					INTEGRAL	--	MF	BMS	EXISTING	EXISTING	DISCONNECT/RECONNECT	
EF-A7		MC	1/4	5.8	0.696	120	1					INTEGRAL	--	MF	BMS	EXISTING	EXISTING	DISCONNECT/RECONNECT	
EF-A8		MC	--	0.17	0.0204	120	1					INTEGRAL	--	MF	BMS	EXISTING	EXISTING	DISCONNECT/RECONNECT	
EF-B1		MC	1/4	5.8	0.696	120	1					INTEGRAL	--	MF	BMS	EXISTING	EXISTING	DISCONNECT/RECONNECT	
FCU-A1		MC	1/4	3.6	0.748	208	1					INTEGRAL	--	MF			2#12 w/ #12 GND IN 3/4"C	20A/2P	
FCU-A2		MC	1/4	3.6	0.748	208	1					INTEGRAL	--	MF			2#12 w/ #12 GND IN 3/4"C	20A/2P	
FCU-G23		MC	1/6	2.25	0.468	208	1					INTEGRAL	--	MF			2#12 w/ #12 GND IN 3/4"C	20A/2P	
HUH-G22		MC	1/12	1.9	0.228	120	1					INTEGRAL	--	MF			EXISTING	DISCONNECT/RECONNECT	
HUH-G30		MC	1/8	2.9	0.348	120	1					INTEGRAL	--	MF			EXISTING	DISCONNECT/RECONNECT	
HUH-G44		MC	1/8	2.9	0.348	120	1					INTEGRAL	--	MF			EXISTING	DISCONNECT/RECONNECT	
HWP-1		MC	15	48.3	17.4	208	3					100A/3P	1	EC			3#3 W/ #8 GND IN 1-1/4" C	90A/3P	
HWP-2		MC	15	48.3	17.4	208	3					100A/3P	1	EC			3#3 W/ #8 GND IN 1-1/4" C	90A/3P	

AS	AQUA SWITCH	MSS	MANUAL MOTOR STARTER
AUX	AUXILIARY CONTACTS	NA	NOT APPLICABLE
CB	CIRCUIT BREAKER	NF	NON-FUSED
CM	COMBINATION MAGNETIC	PB	PUSH BUTTON
CP	CONTROL PACKAGE	PE	PNEUMATIC/ELECTRIC SWITCH
EP	ELECTRIPNEUMATIC SWITCH	PL	PILOT LIGHT
ES	END SWITCH	PS	PUMP SEQUENCER
F	FUSED	PEV	REVERSING
FL	FLOW SWITCH	SD	SMOKE DETECTOR
FS	FREEZE STAT	SO	SOLENOID VALVE
HD	HEAT DETECTOR	SS	START/STOP PUSH BUTTON
HOA	HANDOFF/AUTO SWITCH	T	CONTROL CIRC TRANS (120V)
HS	HUMIDISTAT	TC	TIME CLOCK
INT	INTERLOCKED TO	TS	THERMOSTAT
LL	LEAD-LAG SWITCH	2S	TWO SPEED
MC	MECHANICAL CONTRACTOR	VFD	VARIABLE FREQUENCY DRIVE
MCC	MOTOR CONTROL CENTER	BMS	BUILDING MANAGEMENT SYSTEM
MF	MANUFACTURER		
DS	DOOR SWITCH		