

**ADDENDUM  
NO. 02**

**March 14, 2022**

**Warren Central High School Phase 3 Renovation and Addition  
9500 E. 16<sup>th</sup> Street  
Indianapolis, IN 46229**

**TO: ALL BIDDERS OF RECORD**

This Addendum forms a part of and modifies the Bidding Requirements, Contract Forms, Contract Conditions, the Specifications and the Drawings dated January 3, 2023, by CSO Architects. Acknowledge receipt of the Addendum in the space provided on the Bid Form. Failure to do so may subject the Bidder to disqualification.

This Addendum consists of Pages ADD 2-1 through ADD 2- 5, and attached CSO Architects Addendum No. 2 , dated March 13, 2023, consisting of 11 Pages, Specification Section 02 01 00 – Maintenance of Existing Conditions, and Addendum 2 Drawings: C101, C102, C401, C501, C502, C503, LD001, L101, L106, L201, L206, L301, L306, S201PRT, S202PRT, S501, S601, AD201N, A201M, A201N, A202N, A211G, A211M, A211N, A401, A404, A423, A431, A432, A600, A601, A602, A603, A611, A612, A701, A702, A703, A800, A801F, A801J, A801M, A801N, A801P, A801R, A801T, A802F, A802N, A802P, A802R, A802T, A900A, A900B, A901K, A902U, A903, A904, A905, A906, MD201F, MD201H, MD201J, MD201K, MD201L, MD202HJ, MD202N, M201F, M201J, M201K, M201L, M201N, M202HJ, M202N, M211F, M211H, M211J, M211K, M211L, M211N, M212HJ, M301, M303.

**A. SPECIFICATION SECTION 01 12 00 - MULTIPLE CONTRACT SUMMARY**

**Paragraph 3.03 Bid Categories**

**A. Bid Category No. 1 – General Trades**

Add the following Specification:

Section        10 25 57        High Density Storage

Remove the following Specification:

Section        07 42 43        Metal Composite Material Wall Panels



Add the following Clarifications:

15. The Bid Category No. 1 Contractor shall provide work as described in specification Section 11 21 53 Barber and Beauty Shop Equipment as “Work by General Trades Contractor” **and additionally described as “Work by the Salon Equipment Contractor”.**
16. Specification Section 02 01 00 Maintenance of Existing Conditions, added by addendum and included in this scope of work, describes but is not limited to removal, storage, and re-installation of the Owner’s existing equipment. Any mechanical or electrical work required in the execution of this work SHALL BE THE RESPONSIBILITY OF THE BID CATEGORY NO. 1 CONTRACTOR. Storage of the existing equipment may be on site within the “high bay” section of the Career Center in a location convenient to and agreeable to the Owner.

**B. Bid Category No. 2 – Masonry**

Add the following Clarifications:

4. Provide rigid insulation and air barrier at locations indicated on details 12/421 and 11/A422 as shown following which are typical of wall conditions.

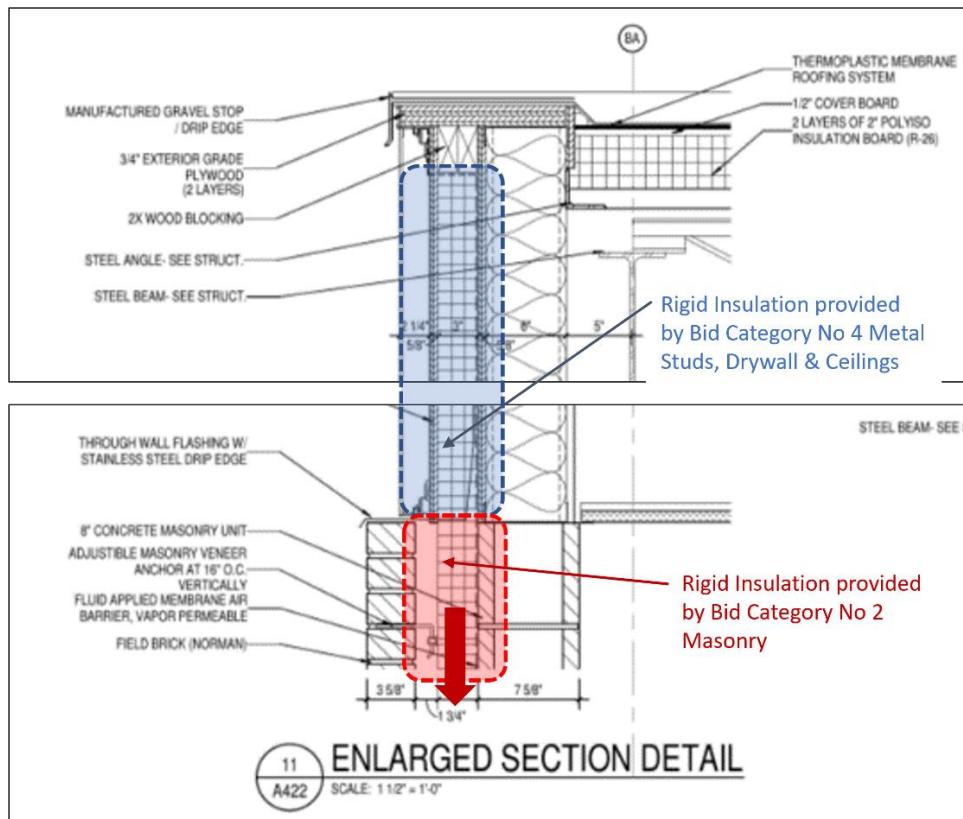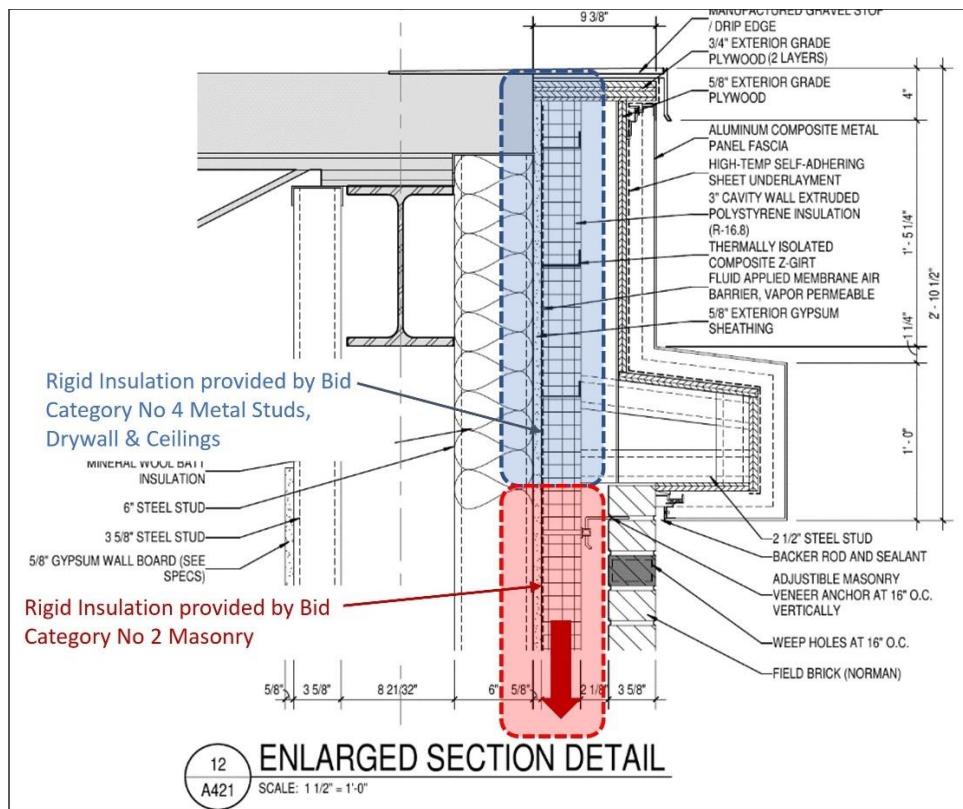

**C. Bid Category No. 4 – Metal Studs, Drywall and Ceilings.**

Add the following Specification:

Section 07 42 43 Metal Composite Material Wall Panels

Add the following Clarifications:

5. Provide rigid insulation and air barrier at locations indicated on details 12/421 and 11/A422 as shown above which are typical of wall conditions.

**K. Bid Category No. 10 – Plumbing and HVAC**

Add the following Specification:

Section 11 21 53 Barber and Beauty Shop Equipment

Add the following Clarifications:

2. Cutting and removal of existing concrete floors as noted on Plumbing Demolition drawings, as well as granular fill and patching/replacement of concrete slab on grade is included in this bid Category. Provide investigation of the existing slab to verify presence of under slab utilities including but not limited to Ground Penetrating Radar examination.
3. The Bid Category No. 10 Contractor shall provide work as described in specification Section 11 21 53 Barber and Beauty Shop Equipment as “Work by Mechanical Contractor”

**L. Bid Category No. 11 – Electrical and Technology:**

Add the following Specification:

Section 11 21 53 Barber and Beauty Shop Equipment

Add the following Clarifications:

3. The Bid Category No. 11 Contractor shall provide work as described in specification Section 11 21 53 Barber and Beauty Shop Equipment as “Work by Electrical Contractor”.

## **B. SPECIFICATION SECTION 01 21 00 – ALLOWANCES**

Revise as follows:

### **3.02 CONTINGENCY ALLOWANCES**

Allow a lump sum for additional work required but not indicated in Drawings or Specifications or otherwise reasonably anticipated.

A. Bid Category No. 1 - General Trades:	\$225,000
B. Bid Category No. 2 – Masonry:	\$40,000
C. Bid Category No. 3 – Structural Steel & Misc. Metals:	\$10,000
D. Bid Category No. 4 – Metal Studs, Drywall, Ceilings:	\$50,000
E. Bid Category No. 5 – Al. Windows and Storefront:	\$15,000
F. Bid Category No. 6 – Flooring:	\$45,000
G. Bid Category No. 7 – Painting and Wallcoverings:	\$45,000
H. Bid Category No. 8 – Casework:	\$25,000
I. Bid Category No. 9 – Fire Protection:	\$15,000
J. Bid Category No. 10 – Plumbing & HVAC:	\$150,000
K. Bid Category No. 11 – Electrical and Technology:	\$80,000

# ADDENDUM

ADDENDUM NO: 2

BID PACKAGE NO: ALL

PROJECT: Warren Central High School – Phase 3 Renovation & Addition

PROJECT NO: 2021056

DATE: March 13, 2023

BY: Jason E. Bruce, AIA

This Addendum is issued in accordance with the provisions of "The General Conditions of the Contract for Construction," Article 1, "Contract Documents" and becomes a part of the Contract Documents as provided therein. This Addendum includes:

Addendum Pages: ADD2-1 through ADD2-11

Attached Documents: 02 01 00 – MAINTENANCE OF EXISTING CONDITIONS

Attached Drawing Sheets:

C101	C102	C401	C501	C502	C503	LD001	L101
L106	L201	L206	L301	L306	S201PRT	S202PRT	S501
S601	AD201N	A201M	A201N	A202N	A211G	A211M	A211N
A401	A404	A423	A431	A432	A600	A601	A602
A603	A611	A612	A701	A702	A703	A800	A801F
A801J	A801M	A801N	A801P	A801R	A801T	A802F	A802N
A802P	A802R	A802T	A900A	A900B	A901K	A902U	A903
A904	A905	A906	MD201F	MD201H	MD201J	MD201K	MD201L
MD202HJ	MD202N	M201F	M201J	M201K	M201L	M201N	M202HJ
M202N	M211F	M211H	M211J	M211K	M211L	M211N	M212HJ
M301	M303						

## PART 0 - GENERAL INFORMATION

- A. Refer to Addendum #2 information provided by The Skillman Corporation attached to this Addendum.
- B. SECTION 00 00 10 – TABLE OF CONTENTS
  1. DELETE Section 12 24 13 – Roller Window Shades

## PART 1 - BIDDING REQUIREMENTS

- A. Refer to Addendum #2 information provided by The Skillman Corporation attached to this Addendum.

## PART 2 - SPECIFICATIONS

### 2.1 SECTION 02 01 00 – MAINTENANCE OF EXISTING CONDITIONS

- A. ADD Section 02 01 00 – MAINTENANCE OF EXISTING CONDITIONS, attached.

2.2 SECTION 08 11 33 – HOLLOW METAL DOORS AND FRAMES

A. ADD line 2.01.A.8 as follows:

1. "8. De La Fontaine" as an approved manufacturer.

2.3 SECTION 09 91 23 – INTERIOR PAINTING

A. DELETE Article 2.01 in its entirety and REPLACE with the following:

"2.01 MANUFACTURERS

A. Manufacturer: Except as indicated in Paragraph B, provide products by Sherwin-Williams.

B. Specialty Manufacturers: At specific locations indicated on the Drawings, and subject to compliance with requirements, provide products by one of the following:

1. Benjamin Moore & Company

C. Products: Subject to compliance with requirements, provide one of the products listed in other Part 2 articles for the paint category indicated."

2.4 SECTION 09 96 00 – HIGH-PERFORMANCE COATINGS

A. DELETE Article 2.01 in its entirety and REPLACE with the following:

"2.01 MANUFACTURERS

A. Manufacturer: Except as indicated in Paragraph B, provide products by Sherwin-Williams.

B. Specialty Manufacturers: At specific locations indicated on the Drawings, and subject to compliance with requirements, provide products by one of the following:

1. Benjamin Moore & Company

C. Products: Subject to compliance with requirements, provide one of the products listed in other Part 2 articles for the paint category indicated."

2.5 SECTION 12 24 13 – ROLLER WINDOW SHADES

A. DELETE Section 12 24 13 in its entirety without replacement.

**PART 3 - DRAWINGS**

3.1 SHEET C101 – EXISTING CONDITIONS AND DEMOLITION PLAN

A. REPLACE Sheet in its entirety with the attached, re-issued Sheet.

3.2 SHEET C102 – EXISTING CONDITIONS AND DEMOLITION PLAN  
A. REPLACE Sheet in its entirety with the attached, re-issued Sheet.

3.3 SHEET C401 – STORMWATER POLLUTION PREVENTION PLAN  
A. REPLACE Sheet in its entirety with the attached, re-issued Sheet.

3.4 SHEET C501 – UTILITY PLAN  
A. REPLACE Sheet in its entirety with the attached, re-issued Sheet.

3.5 SHEET C502 – UTILITY PLAN  
A. REPLACE Sheet in its entirety with the attached, re-issued Sheet.

3.6 SHEET C503 – UTILITY PLAN  
A. REPLACE Sheet in its entirety with the attached, re-issued Sheet.

3.7 SHEET LD001 – TREE PROTECTION PLAN  
A. Sheet updated to show additional extents of Tree Protection.

3.8 SHEET L101 – MATERIALS AND NOTES PLAN  
A. Sheet updated with additional paving and fencing replacement.

3.9 SHEET L106 – MATERIALS AND NOTES PLAN  
A. Sheet updated with additional paving and fencing replacement.

3.10 SHEET L201 – PLANTING PLAN  
A. Sheet updated with additional lawn replacement extents.

3.11 SHEET L206 – PLANTING PLAN  
A. Sheet updated with additional lawn replacement extents.

3.12 SHEET L301 – LAYOUT PLAN  
A. Paving and fencing layout updated.

3.13 SHEET L306 – LAYOUT PLAN  
A. Paving and fencing layout updated.

3.14 SHEET S201PRT – FOUNDATION PLAN – UNITS P, R& T

A. MODIFY column grid PA & PB dimensions as indicated on attached, re-issued Sheet S201PRT.

3.15 SHEET S202PRT – ROOF FRAMING PLANS – UNITS P, R & T

A. DELETE column PA-P2.4. REPLACE with steel beam spanning between existing columns to re-support existing roof beam end as indicated on attached, re-issued Sheet S202PRT.

B. MODIFY column grid PA & PB dimensions. MODIFY low canopy roof framing spacing and upper roof cantilevered edge dimensions as indicated on attached Sheet.

C. MODIFY alternate canopy roof framing steel elevation as indicated on attached Sheet.

3.16 SHEET S501 – FOUNDATION SECTIONS

A. MODIFY sections 2 and 6 on attached, re-issued Sheet S501.

3.17 SHEET S601 – FRAMING SECTIONS

A. MODIFY sections 7 and 8 on attached, re-issued Sheet S601.

3.18 SHEET AD201N – FIRST FLOOR DEMOLITION PLAN – UNIT – N

A. ADD Alternate Demolition Plan 2/AD201N as indicated on attached, re-issued Sheet AD201N.

3.19 SHEET A201M – FIRST FLOOR PLAN – UNIT M

A. ADD aluminum tubes for mounting of mirrors as indicated on attached, re-issued Sheet A201M.

3.20 SHEET A201N – FIRST FLOOR PLAN – UNIT N

A. REVISE 2/A201N as indicated on attached, re-issued Sheet A201N

3.21 SHEET A202N – SECOND FLOOR PLAN – UNIT N

A. REVISE 3/A202N as indicated on attached, re-issued Sheet A202N

3.22 SHEET A211G – FIRST FLOOR REFLECTED CEILING PLAN – UNIT G

A. REVISE Ceiling at Corridor W000D as indicated on attached, re-issued Sheet A211G.

3.23 SHEET A211M – FIRST FLOOR REFLECTED CEILING PLAN – UNIT M

A. REVISE Ceilings at Corridor F002 as indicated on attached, re-issued Sheet A211M.

B. ADD Bulkhead at Salon F110C, as indicated on attached A211M.

3.24 SHEET A211N – FIRST FLOOR REFLECTED CEILING PLAN – UNIT N

- A. REVISE ceilings at vestibule as indicated on attached, re-issued Sheet A211N

3.25 SHEET A401 – PARTIAL BUILDING SECTIONS

- A. REVISE section 1 as indicated on attached, re-issued Sheet A401
- B. ADD sections 3 and 6 as indicated on attached Sheet.

3.26 SHEET A404 – WALL SECTIONS AND DETAILS

- A. REVISE section 4 as indicated on attached, re-issued Sheet. A404.

3.27 SHEET A423 – ENLARGED SECTION DETAILS

- A. ADD attached Sheet A423.

3.28 SHEET A431 – ENLARGED PLAN DETAILS

- A. REVISE Detail 1/A431 as indicated on attached, re-issued Sheet A431.

3.29 SHEET A432 – ENLARGED PLAN DETAILS

- A. ADD attached Sheet A432.

3.30 SHEET A600 – MILLWORK ELEVATIONS & DETAILS

- A. REVISE elevation names and detail numbers as indicated on attached, re-issued Sheet A600.

3.31 SHEET A601 – INTERIOR ELEVATIONS

- A. ADD dimensions to acoustic wall panels as indicated on attached re-issued Sheet A601.
- B. REMOVE structural grid lines for clarity.

3.32 SHEET A602 – INTERIOR ELEVATIONS

- A. ADD dimensions to acoustic wall panels as indicated on attached re-issued Sheet A602.
- B. REMOVE structural grid lines for clarity.

3.33 SHEET A603 – INTERIOR ELEVATIONS

- A. ADD dimensions to acoustic wall panels as indicated on attached re-issued Sheet A603.
- B. REMOVE structural grid lines for clarity.

3.34 SHEET A611 – INTERIOR FINISH ELEVATIONS & DETAILS

A. Sheet reissued in its entirety with the following changes:

1. Elevation 13/A611 added as shown on sheet.
2. Elevation 14/A611 number change to 12/A611 as shown on sheet.

3.35 SHEET A612 – INTERIOR FINISH ELEVATIONS & DETAILS

A. Sheet reissued in its entirety with the following changes:

1. Elevation 12/A612 added as shown on sheet.
2. Elevation 13/A612 added as shown on sheet.
3. Additional detail information added to 6/A612 as shown on sheet.

3.36 SHEET A701 – ENLARGED RESTROOM PLANS

A. REVISE annotation and dimensions as indicate on attached, re-issued Sheet A701.

3.37 SHEET A702 – ENLARGED RESTROOM PLANS

A. REVISE annotation and dimensions as indicate on attached, re-issued Sheet A702.

B. ADD Enlarged Restroom Plan 10/A702 as indicated on attached Sheet.

3.38 SHEET A703 – ENLARGED RESTROOM PLANS

A. REVISE annotation and dimensions as indicate on attached, re-issued Sheet A703.

3.39 SHEET A800 – FINISH LEGEND & NOTES

A. Sheet reissued in its entirety with the following changes:

1. Elevations rearranged and renumbered as shown on sheet.
2. General Finish Note 21 added as shown on sheet.
3. Keyed Finish Note F4 elevation reference corrected to '1-2/A800' as shown on sheet.
4. Keyed Finish Note F5 elevation reference corrected to '11/A800' as shown on sheet.
5. Keyed Finish Note F7 no longer used.
6. Keyed Finish Note F8 elevation reference corrected to '5/A800' as shown on sheet.
7. Keyed Finish Note F11 elevation reference corrected to '4/A800' as shown on sheet.

8. Keyed Finish Note F14 no longer used.
9. Keyed Finish Note F21 FRP height corrected to '8'-0" AFF' as shown on sheet.
10. Keyed Finish Note F25 elevation references corrected to '4/A800 & 3/A800' respectively as shown on sheet.
11. Keyed Finish Note F30 no longer used.
12. Keyed Finish Note 32 no longer used.
13. Keyed Finish Note F35 no longer used.
14. Keyed Finish Note F58 elevation reference corrected to '15/A800' as shown on sheet.
15. Keyed Finish Note F59 elevation reference corrected to '10/A800' as shown on sheet.
16. Keyed Finish Note F62 brick reference changed from TBD to 'BELDEN SIENNA BLEND VELOUR'
17. Finish LVT4 install revised to read "ASHLAR, HALF-DROP"
18. Finish LVT5 install revised to read 'RANDOM, NO LESSTHAN 6" OVERLAP'
19. Finish LVT6 install revised to read 'ASHLAR, HALF-DROP'
20. Epoxy base finishes B2-B6 revised to include 'NOTE: SCHLUTER SCHIENE TO BE USED AT TOP OF COVE,TYP.'
21. Finish WT1 install elevation updated to '5/A800' as shown on sheet.
22. Finish WT2 install elevation updated to '5/A800' as shown on sheet.
23. Finish WT3 install elevation updated to '5/A800' as shown on sheet.

3.40 SHEET A801F – FIRST FLOOR FINISH PLAN – UNIT F

A. Keyed Finish Note F8 leader extents revised at ALL EWC locations to indicate back wall only receiving tile.

3.41 SHEET A801J – FIRST FLOOR FINISH PLAN – UNIT J

A. W336 Computer Networking: Keyed Finish Note F44 moved to center of opposite wall.

3.42 SHEET A801M – FIRST FLOOR FINISH PLAN – UNIT M

A. Sheet reissued in its entirety with the following changes:

1. 1/A801M FIRST FLOOR FINISH PLAN – UNIT M
  - a. Keyed Finish Note F8 leader extents revised at ALL EWC locations to indicate back wall only receiving tile.
  - b. Keyed Finish Note F34 added to door entry niches as shown on sheet.
2. 2/A801M SALON/BARBER ENLARGED FINISH PLAN
  - a. Salon F110C: finish elevations of North and West walls added as shown on sheet (12-13/A612).
  - b. Toilet F110B room name and finish tags added as shown on sheet.

3.43 SHEET A801N – FIRST FLOOR FINISH PLAN – UNIT N

A. Keyed Finish Note F8 leader extents revised at ALL EWC locations to indicate back wall only receiving tile.

3.44 SHEET A801P – FIRST FLOOR FINISH PLAN – UNIT P

A. Keyed Finish Note F8 leader extents revised at ALL EWC locations to indicate back wall only receiving tile.

3.45 SHEET A801R – FIRST FLOOR FINISH PLAN – UNIT R

A. Keyed Finish Note F8 leader extents revised at ALL EWC locations to indicate back wall only receiving tile.

3.46 SHEET A801T – FIRST FLOOR FINISH PLAN – UNIT T

A. Keyed Finish Note F8 leader extents revised at ALL EWC locations to indicate back wall only receiving tile.

3.47 SHEET A802F – SECOND FLOOR FINISH PLAN – UNIT F

A. Keyed Finish Note F8 leader extents revised at ALL EWC locations to indicate back wall only receiving tile.

3.48 SHEET A802N – SECOND FLOOR FINISH PLAN – UNIT N

A. Keyed Finish Note F8 leader extents revised at ALL EWC locations to indicate back wall only receiving tile.

3.49 SHEET A802P – SECOND FLOOR FINISH PLAN – UNITS P & Q

- A. Keyed Finish Note F8 leader extents revised at ALL EWC locations to indicate back wall only receiving tile.

3.50 SHEET A802R – SECOND FLOOR FINISH PLAN – UNIT R

- A. Keyed Finish Note F8 leader extents revised at ALL EWC locations to indicate back wall only receiving tile.

3.51 SHEET A802T – SECOND FLOOR FINISH PLAN – UNIT T

- A. Keyed Finish Note F8 leader extents revised at ALL EWC locations to indicate back wall only receiving tile.

3.52 SHEET A900A – EQUIPMENT & CASEWORK SCHEDULE

- A. REVISE Equipment Schedule as indicated on the attached, reissued sheet A900A.

3.53 SHEET A900B – EQUIPMENT & CASEWORK SCHEDULE

- A. REVISE Equipment Schedule as indicated on the attached, reissued sheet A900B.

3.54 SHEET A901K – FIRST FLOOR EQUIPMENT PLAN – UNIT K

- A. Annotation has been modified for readability.

3.55 SHEET A902U – SECOND FLOOR EQUIPMENT PLAN – UNIT U

- A. ADD enlarged plan annotation as indicated on attached, re-issued Sheet A902U.
- B. REMOVE and revise interior elevation annotation tags as indicated on attached Sheet.

3.56 SHEET A903 – CASEWORK ELEVATIONS

- A. REVISE interior elevations as indicated on attached, re-issued Sheet A903.

3.57 SHEET A904 – CASEWORK ELEVATIONS

- A. REVISE interior elevations as indicated on attached, re-issued Sheet A904.

3.58 SHEET A905 – CASEWORK ELEVATIONS

- A. REVISE interior elevations as indicated on attached, re-issued Sheet A905.

3.59 SHEET A906 – CASEWORK ELEVATIONS

- A. REVISE interior elevations as indicated on attached, re-issued Sheet A906.

3.60 MD201F – First Floor Mechanical Demolition Plan – Unit F

A. REPLACE Sheet in its entirety with the attached, re-issued Sheet.

3.61 MD201H – First Floor Mechanical Demolition Plan – Unit H

A. REPLACE Sheet in its entirety with the attached, re-issued Sheet.

3.62 MD201J – First Floor Mechanical Demolition Plan – Unit J

A. REPLACE Sheet in its entirety with the attached, re-issued Sheet.

3.63 MD201K – First Floor Mechanical Demolition Plan – Unit K

A. REPLACE Sheet in its entirety with the attached, re-issued Sheet.

3.64 MD201L – First Floor Mechanical Demolition Plan – Unit L

A. REPLACE Sheet in its entirety with the attached, re-issued Sheet.

3.65 MD202HJ – Second Floor Mechanical Demolition Plan – Unit HJ\

A. REPLACE Sheet in its entirety with the attached, re-issued Sheet.

3.66 MD202N – Second Floor Mechanical Demolition Plan – Unit N

A. REPLACE Sheet in its entirety with the attached, re-issued Sheet.

3.67 M201F – First Floor Mechanical Plan – Unit F

A. REPLACE Sheet in its entirety with the attached, re-issued Sheet.

3.68 M201J – First Floor Mechanical Plan – Unit J

A. REPLACE Sheet in its entirety with the attached, re-issued Sheet.

3.69 M201K – First Floor Mechanical Plan – Unit K

A. REPLACE Sheet in its entirety with the attached, re-issued Sheet.

3.70 M201L – First Floor Mechanical Plan – Unit L

A. REPLACE Sheet in its entirety with the attached, re-issued Sheet.

3.71 M201N – First Floor Mechanical Plan – Unit N

A. REPLACE Sheet in its entirety with the attached, re-issued Sheet.

3.72 M202HJ – Second Floor Mechanical Plan – Unit HJ

A. REPLACE Sheet in its entirety with the attached, re-issued Sheet.

3.73 M202N – Second Floor Mechanical Plan – Unit N

A. REPLACE Sheet in its entirety with the attached, re-issued Sheet.

3.74 M211F – First Floor Mechanical Piping Plan – Unit F

A. REPLACE Sheet in its entirety with the attached, re-issued Sheet.

3.75 M211H – First Floor Mechanical Piping Plan – Unit H

A. REPLACE Sheet in its entirety with the attached, re-issued Sheet.

3.76 M211J – First Floor Mechanical Piping Plan – Unit J

A. REPLACE Sheet in its entirety with the attached, re-issued Sheet.

3.77 M211K – First Floor Mechanical Piping Plan – Unit K

A. REPLACE Sheet in its entirety with the attached, re-issued Sheet.

3.78 M211L – First Floor Mechanical Piping Plan – Unit L

A. REPLACE Sheet in its entirety with the attached, re-issued Sheet.

3.79 M211N – First Floor Mechanical Piping Plan – Unit N

A. REPLACE Sheet in its entirety with the attached, re-issued Sheet.

3.80 M212HJ – Second Floor Mechanical Piping Plan – Unit HJ

A. REPLACE Sheet in its entirety with the attached, re-issued Sheet.

3.81 M301 – Mechanical Schedules and Details

A. REPLACE Sheet in its entirety with the attached, re-issued Sheet.

3.82 M303 – Mechanical Sections

A. ADD attached Sheet M303.

**PART 4 - ATTACHED ADDENDA** - NOT USED**END ADDENDUM #2**

SECTION 02 01 00 – MAINTENANCE OF EXISTING CONDITIONS

PART 1 - GENERAL

1.01 RELATED DOCUMENTS

A. Drawings and general provisions of the Contract, including General and Supplementary Conditions and Division 01 Specification Sections, apply to this Section.

1.02 SUMMARY

A. Section Includes:

1. Temporary removal, storage, and re-installation of automotive repair equipment.
2. Inspection and maintenance of automotive equipment.
3. Inspection and maintenance of sectional overhead doors and operators.
4. Inspection and maintenance of automotive spray booth.
5. Inspection and maintenance training.

B. Familiarization with Equipment: PRIOR TO THE SUBMISSION OF BIDS, Contractor shall familiarize himself with the specific items to be temporarily removed, inspected, maintained and re-installed.

1.03 DEFINITIONS

A. Remove: Detach items from existing construction and legally dispose of them off-site unless indicated to be removed and salvaged or removed and reinstalled.

B. Remove and Salvage: Carefully detach from existing construction, in a manner to prevent damage, and deliver to Owner ready for reuse.

C. Remove and Reinstall: Detach items from existing construction, prepare for reuse, and reinstall where indicated.

D. Existing to Remain: Existing items of construction that are not to be permanently removed and that are not otherwise indicated to be removed, removed and salvaged, or removed and reinstalled.

1.04 PRECONSTRUCTION MEETINGS

A. Preconstruction Conference: Conduct conference at Project site.

1. Inspect and discuss condition of equipment to be temporarily removed & reinstalled and maintained.
2. Review locations for storage of removed items to be reinstalled. Review routes from original to temporary locations. Review return routes from temporary to re-installation locations. Confirm routes have sufficient space, bearing capacity, and will be minimally disruptive to the Owner's operations.
3. Review and finalize schedule and verify availability of materials, qualified personnel, equipment, and facilities needed to make progress and avoid delays.
4. Review requirements of work performed by other trades.
5. Review areas where existing construction is to remain and requires protection.

6. Review storage conditions, including temporary shoring if required and securing stored items with temporary partitions or in existing securable spaces determined by the Construction Manager.

1.05 INFORMATIONAL SUBMITTALS

- A. Qualification Data: For inspection and maintenance personnel.
- B. Proposed Protection Measures: Submit report, including drawings if needed, that indicates the measures proposed for protecting individuals and property, for environmental protection, for dust control and, for noise control. Indicate proposed locations and construction of barriers.
- C. Warranties: Documentation indicated that existing warranties are still in effect upon completion of the Work.

1.06 CLOSEOUT SUBMITTALS

- A. Inspection Summaries: Submit inspection reports indicating proposed additional maintenance needs in the next two to five years.
- B. Service Agreement Proposals: Submit proposal for two-year service agreement for the Owner's consideration.

1.07 QUALITY ASSURANCE

- A. Provide equipment manufacturer certification (for manufacturers with such a program), certification from an independent, nationally recognized, equipment-specific organization (i.e. Automotive Lift Institute), other documentation indicating completion of training, and experience related to items being serviced.

1.08 FIELD CONDITIONS

- A. Owner will occupy portions of building immediately adjacent to the Work area. Conduct Work so Owner's operations will not be disrupted. Provide advanced notices of at least two weeks and again not less than 72 hours to Construction Manager and Owner of activities that will affect Owner's operations.
- B. Maintain access to existing parking, drives, walkways, corridors, and other adjacent occupied or used facilities.
  1. Do not close or obstruct parking, drives, walkways, corridors, or other occupied or used facilities without written permission from authorities having jurisdiction.
- C. Conditions existing at time of inspection for bidding purposes will be maintained by Owner as far as practical.
- D. Notify Architect of discrepancies between existing conditions and Drawings before proceeding.
- E. Utility Service: Maintain existing utilities indicated to remain in service and protect them against damage during construction.

## PART 2 - PRODUCTS

### 2.01 PEFORMANCE REQUIREMENTS

- A. Regulatory Requirements: Comply with all regulatory requirements in the performance of the Work and for final product.
- B. Standards: Perform all work in accordance with equipment manufacturer's recommendations and requirements, and with industry best practices.

### 2.02 REPAIR MATERIALS

- A. Use repair materials identical to existing materials.
  - 1. If identical materials are unavailable or cannot be used for exposed surfaces, use materials that visually match existing adjacent surfaces to the fullest extent possible.
  - 2. Use materials whose installed performance equals or surpasses that of existing materials.
- B. Comply with material and installation requirements of item manufacturer.

### 2.03 REPLACEMENT PARTS

- A. Use replacement parts, consumable parts such as filters, and lubricants from the equipment manufacturer, or in compliance with manufacturer's requirements and recommendations.

## PART 3 - EXECUTION

### 3.01 SEQUENCE

- A. Contractor shall determine when to perform maintenance items (prior to removal, during storage or after re-installation) of each piece of equipment. This determination shall be made in conjunction with the Construction Manager, and in accordance with the published project schedule.
- B. An initial inspection shall be performed prior to removal of items.

### 3.02 UTILITY SERVICES AND MECHANICAL/ELECTRICAL SYSTEMS

- A. Existing Services/Systems to Remain: Maintain services/systems indicated to remain and protect them against damage.
  - 1. Comply with requirements for existing services/systems interruptions specified in Division 01 Section "Summary."
- B. Existing Services/Systems to Equipment to Be Removed or Relocated: Locate, identify, disconnect, and seal or cap off indicated utility services at disconnect or shut-off adjacent to equipment being temporarily removed.
  - 1. Arrange to have utilities turned off and made safe by other Contractors through the Construction Manager.

- a. Equipment to Be Removed and Reinstalled: Disconnect and cap services and remove, clean, and store equipment; when appropriate, reinstall, reconnect, and make equipment operational.
- b. Ducts to Be Removed: Remove portion of ducts indicated to be removed and plug remaining ducts with same or compatible ductwork material.

### 3.03 PREPARATION

- A. Dangerous Materials: Drain, purge, or otherwise remove, collect, and dispose of chemicals, gases, explosives, acids, flammables, hydraulic fluids, greases, filters, and other dangerous materials before removing items from original location.
- A. Temporary Facilities: Provide temporary barricades and other protection required to prevent injury to people and damage to adjacent construction to remain.
- B. Temporary Shoring: Provide and maintain shoring, bracing, and structural supports as required to preserve stability and prevent movement or falling of stored equipment.

### 3.04 TEMPORARY REMOVAL, STORAGE, AND RE-INSTALLATION OF AUTOMOTIVE REPAIR EQUIPMENT

- A. Removal of Items for Storing: Carefully unfasten items indicated on Drawings to be relocated.
- B. Relocation of Items: Move items to and from temporary storage location coordinated with the Construction Manager. Move items along route and to storage location established during the preconstruction meeting. Protect existing construction to remain while moving.
- C. Storage: Shore or otherwise brace items during storage to prevent toppling or other movement which might cause personal injury or damage to equipment or surroundings.
- D. Reinstallation: Reinstall each item in original location in accordance with the equipment manufacturer's recommendations.

### 3.05 INSPECTION AND MAINTENANCE OF AUTOMOTIVE REPAIR EQUIPMENT

- A. Initial Inspection: Inspect each vehicle lift and alignment rack indicated on the Drawings to be removed and re-installed. Additionally inspect one tire changer, two wheel balancers, and two wheel aligners.
  1. Inspect all moving parts, safety locks, hydraulic hoses and connections, controls, cables belts and pulleys, electrical connections, cylinders, pumps, rod and rod ends, calibrations, turntables, slip plates, clamps, centering cones, framework, and any other items normally included in an annual inspection per the manufacturer's recommendations.
  2. Prepare a written report indicating any items in need of correction.
    - a. Report shall include the name and contact information of the inspector and company, date of inspection, a detailed list of inspection points for each item inspected with results, and any additional notes or recommendations.
    - b. Indicate any item in immediate need of repair or replacement. Include a proposal with pricing for the Owner's consideration.

- c. Indicate any deficiencies which will need correction within two to five years.
- d. Forward the report to the Construction Manager, and Architect within two weeks of the inspection.

B. Removal of Items for Storing: Carefully unfasten items indicated on Drawings to be relocated. Move items to temporary storage location as directed by the Construction Manager. Shore or otherwise brace items during storage to prevent toppling or other movement which might cause personal injury or damage to equipment or surroundings.

C. Maintenance: Perform maintenance on each vehicle lift and alignment rack indicated on the Drawings to be removed and re-installed. Additionally maintain one tire changer, two wheel balancers, and two wheel aligners.

- 1. Replace all fluids, filters, rubber belts, and any other consumable items recommended to be replaced by the manufacturer on an annual basis.
- 2. Grease all fittings.
- 3. Power wash lifts and alignment racks. Clean all pieces of equipment.
- 4. Disassemble portions of equipment recommended by the manufacturer to be torn down, cleaned, oiled, and checked for tightness or for free movement.
- 5. Update software. Verify with Owner prior to performing update.
- 6. Replace or repair any parts indicated in the inspection report as being in need of immediate correction only as directed by the Owner based on the pricing proposal.
- 7. Verify anchor bolts are not corroded, and remain firmly anchored in floor. Replace if bolts are damaged or loose.

### 3.06 INSPECTION AND MAINTENANCE OF SECTIONAL OVERHEAD DOORS AND OPERATORS

A. Inspect all moving parts, safety devices, controllers, cables and pulleys, electrical connections, springs, tracks and rollers, and any other items normally included in an annual inspection per the manufacturer's recommendations. Inspect the following:

- 1. Condition of door panel sections
- 2. Alignment of door
- 3. Door rollers and bearings
- 4. Springs, tracks, hangers, and operator fasteners
- 5. Hinges and hardware for wear and proper operation
- 6. Cables for fraying or other damage
- 7. Drums for wear or damage
- 8. Operator limit switches, belts, roller chains, brakes, and clutches
- 9. Test disconnect
- 10. Sprockets for wear or damage
- 11. Test all safety devices.

B. Written Inspection Report: Prepare a written report indicating any items in need of correction.

- a. Report shall include the name of the inspector and company, date of inspection, a detailed list of inspection points for each door inspected with results, and any additional notes or recommendations.
- b. Indicate any item in immediate need of repair or replacement (except seals/gasketing). Include a proposal with pricing for the Owner's consideration.

- c. Indicate any deficiencies which will need correction within two to five years.
- d. Forward the report to the Construction Manager, and Architect within two weeks of the inspection.

C. Maintenance: Perform maintenance on each sectional overhead door indicated on the Drawings to be maintained.

- 1. Replace all seals/gasketing, including bottom seal
- 2. Adjust door panels and all safety devices for proper alignment.
- 3. Tighten any loose fasteners.
- 4. Lubricate door rollers and bearings, roller chains, operator bearings, and any additional moving parts recommended by the manufacturer to be lubricated.
- 5. Adjust and lubricate springs
- 6. Adjust limit switches, belts, brakes, and clutches
- 7. Tighten and adjust hinges and hardware
- 8. Tighten all sprockets.
- 9. Replace or repair any parts indicated in the inspection report as being in need of immediate correction only as directed by the Owner based on the pricing proposal.

### 3.07 INSPECTION AND MAINTENANCE OF AUTOMOTIVE SPRAY BOOTH

A. Initial Inspection: Inspect the automotive spray booth. Include all items normally included in an annual inspection per the manufacturer's recommendations.

- 1. Inspect the following:
  - a. Lights/bulbs
  - b. Control panel cooling fan
  - c. Exhaust fan and make-up air unit bearings
  - d. Exhaust fan and make-up air unit belts and belt tension
  - e. Exhaust fan and make-up air unit pulley alignment
  - f. Fan blade cleanliness and damage
  - g. Make-up air unit blower fasteners, set screws and lock collars
  - h. All fans and blowers
  - i. Burner
  - j. All electrical connections.
- 2. Prepare a written report indicating any items in need of correction.
  - a. Report shall include the name of the inspector and company, date of inspection, a detailed list of inspection points for each item inspected with results, and any additional notes or recommendations.
  - b. Indicate any item in immediate need of repair or replacement. Include a proposal with pricing for the Owner's consideration.
  - c. Indicate any deficiencies which will need correction within two to five years.
  - d. Forward the report to the Construction Manager, and Architect within two weeks of the inspection.

B. Maintenance: Perform maintenance on the automotive spray booth in accordance with the manufacturer's recommendations for incremental maintenance (daily, monthly, quarterly, semi-annually, and annually). Also include any of the following not on the manufacturer's list:

1. Replace all filters.
2. Grease all fittings.
3. Remove all debris.
4. Clean all surfaces of overspray build-up.
5. Clean any filters without a replaceable medium.
6. Clean exhaust and intake plenums and ductwork.
7. Adjust all belt tensions and pulley alignments.
8. Tighten all fasteners, set screws, and lock collars as required.
9. Clean the blower, gas controls, electrical controls, exhaust fan motor, exhaust fan blades, make-up air motor, make-up air blower.
10. Lubricate the exhaust fan motor and make-up air blower.
11. Service the burner.
12. Service all electrical components and tighten all electrical connections.
13. Replace or repair any parts indicated in the inspection report as being in need of immediate correction only as directed by the Owner based on the pricing proposal.
14. Coordinate replacement of any items in need of replacement covered under warranty with the warrantor.

C. The fire suppression system is maintained separately and is excluded from the Work of this section. Contractor shall meet with the Owner's vendor prior to the Work of this Section to coordinate any shut-down, and to review any potential interaction with the fire suppression system. Any work involving the fire suppression system shall be performed by the Owner's vendor.

### 3.08 PATCHING AND REPAIR OF EXISTING ADJACENT CONSTRUCTION

A. General: Promptly repair damage to adjacent construction caused by relocation or maintenance of equipment.

B. Repairs: Where repairs to existing surfaces are required, patch to produce surfaces suitable for new materials.

1. Completely fill holes and depressions in existing masonry walls that are to remain with an approved masonry patching material applied according to manufacturer's written recommendations.

C. Finishes: Restore exposed finishes of patched areas and extend restoration into adjoining construction in a manner that eliminates evidence of patching and refinishing.

D. Floors and Walls: Where walls or partitions are damaged, patch and repair floor and wall surfaces. Provide an even surface of uniform finish color, texture, and appearance.

1. Patch with durable seams that are as invisible as possible. Provide materials and comply with installation requirements specified in other Sections of these Specifications.
2. Where patching occurs in a painted surface, apply primer and intermediate paint coats over patch and apply final paint coat over entire unbroken surface containing patch. Provide additional coats until patch blends with adjacent surfaces.

3.09 CLEANING

A. Clean adjacent structures and improvements of dust, dirt, and debris caused by relocation and maintenance operations. Return adjacent areas to condition existing before each stage of the Work began.

3.10 TRAINING

A. Automotive Repair Equipment: Provide training sessions to be recorded by the Owner for their continued use.

1. Training shall review the incremental (daily, weekly, etc.) inspection and maintenance procedures to be performed by the Owner/users for each piece of equipment included in this Section. Review when each activity should take place and the methods recommended for user-provided maintenance.
2. If available, provide a reproducible graphic checklist/poster showing each inspection/maintenance point and an image of the equipment. If a graphic is not available, provide a written checklist indicating each inspection/maintenance point and schedule.
3. Provide a session for each piece of equipment. All sessions may be recorded at the same time, but no single session should last more than approximately 30 minutes. Coordinate dates and times for training sessions with the Owner.

B. Automotive Spray Booth: Provide a training session to be recorded by the Owner for their continued use.

1. Training shall review the incremental (daily, weekly, etc.) inspection and maintenance procedures to be performed by the Owner/users. Review when each activity should take place and the methods recommended for user-provided maintenance.
2. If available, provide a reproducible graphic checklist/poster showing each inspection/maintenance point and an image of each part of the booth. If a graphic is not available, provide a written checklist indicating each inspection/maintenance point and schedule.
3. The session may be recorded in increments, with no single increment lasting more than approximately 30 minutes. Coordinate dates and times for training sessions with the Owner.

3.11 CLOSEOUT

A. Service Agreement:

1. Provide written service agreement proposals for the Owner's consideration indicating the annual cost to provide inspection and maintenance for each of the following:
  - a. Automotive Repair Equipment
  - b. Sectional Overhead Doors and Operators
  - c. Automotive Spray Booth
2. Agreement shall be for two years and shall include a detailed list of all points of inspection, and all points of maintenance proposed.
3. Owner is not under any obligation to enter into a service agreement.

B. Inspection Reports:

1. Provide inspection reports as required in each Article above, attached to each associated Service Agreement Proposal.
2. In addition to initial inspection items, perform a final inspection after completion of the Work and provide a written report indicating each inspection point has been performed and is in an acceptable condition for continued use. Include a list of items replaced including part manufacturers and numbers.

END OF SECTION

2021056  
Warren Central High School  
Phase 3 Renovation and Addition  
MSD of Warren Township

SECTION 02 01 00  
MAINTENANCE OF EXISTING CONDITIONS

THIS PAGE INTENTIONALLY LEFT BLANK



## EXISTING CONDITIONS LEGEND

— SANITARY SEWER & MANHOLE		POWER POLE
— STORM SEWER; END SECTION, INLET & M.H.		GUY WIRE
— G — GAS LINE		UTILITY RISER; TELEPHONE, ELECTRIC & CABLE TV
— W — WATER LINE		ELECTRIC TRANSFORMER
— ELECTRIC LINE (AERIAL)		AIR CONDITIONER UNIT
— T — TELEPHONE LINE (AERIAL)		STREET LIGHT
— CABLE TELEVISION (AERIAL)		LIGHT POLE
— BURIED TELE. CABLE		FLOOD LIGHT
— BURIED ELEC. CABLE		TRAFFIC MANHOLE AND SIGNAL POLE
— FENCE LINE (FNC)		FIRE HYDRANT
— V — BURIED CABLE TV		VALVE; GAS & WATER
— I — GUARDRAIL		STREET SIGN
— R — RIGHT OF WAY LINE (R/W)		WATER, TELEPHONE AND ELECTRIC MANHOLE
— PROPERTY LINE		SEWER CLEANOUT
— EASEMENT LINE		ELECTRIC, GAS AND WATER METER
— CENTER LINE		PIPELINE MARKER POST
— SWALE LINE		MAILBOX
N		GUARD POST
ENSIION		SPRINKLER HEAD
N		IRRIGATION CONTROL BOX
G ELEVATION		SPOT GRADE
ON		TOP CURB/GUTTER GRADE
ELEVATION		
ANCHMARK		MONITORING WELL
EBAR WITH YELLOW PLASTIC CAP SET.		FIRE SERVICE STAND PIPE
RM NO. 0055" UNLESS OTHERWISE NOTED.		GAS VENT PIPE
TH WASHER SET. WASHER STAMPED		SEPTIC TANK LID
UNLESS OTHERWISE NOTED.		WELL CAP
		AIR RELIEF VALVE
		UNDERGROUND TANK FILLER PIPE

## DEMOLITION PLAN LEGEND

The image shows a header for a demolition plan. It features a grey square icon on the left, a white square with a black speckled pattern on the right, and a horizontal line with five dashes in the center. Below these elements is the text "DEMOLITION PLAN NOTES" in a large, bold, black font. Above the notes, centered, is the text "SAWCUT AND REMOVE CONCRETE FROM SITE" in a smaller, black font.

APPROXIMATE THE CONTRACTOR IS TO DETERMINE AND FIELD VERIFY ALL

COORDINATE ALL WORK ASSOCIATED WITH THE ABANDONMENT, REMOVAL, LOCATION OF UTILITIES WITH EVERY UTILITY COMPANY AND OBTAIN THEIR APPROVAL FOR ANY UTILITY WORK.

ALL TO BECOME THE PROPERTY OF THE CONTRACTOR UNLESS OTHERWISE NOTED, DISPOSED OF OFF-SITE.

ALL EROSION CONTROL MEASURES PER SHEET C401-C405 AND 410-412 PRIOR TO COMMENCEMENT.

GE IN DEMOLITION AREAS.

ASPHALT SURFACES FOR REMOVAL AS NOTED.

BE RESPONSIBLE FOR REPAIRING DAMAGE TO ALL BUILDINGS AND/OR SITE EQUIPMENT AND PROPERTY.

SCUT SHALL BE SAWCUT TO THE NEAREST CONCRETE JOINT BEYOND THE LIMITS OF THE EXISTING CONCRETE. SAWCUT IF JOINT IS OVER ONE (1) FOOT FROM LINE SHOWN.

OF ALL LANDSCAPING MUST BE COORDINATED WITH OWNER.

CONFLICTS WHICH BECOME APPARENT BEFORE OR DURING CONSTRUCTION SHALL BE REPORTED TO THE ENGINEER IMMEDIATELY SO THAT CLARIFICATION OR REDESIGN CAN BE MADE.

ESTABLISH NEW LOCAL SURVEY CONTROL SYSTEM (VERTICAL AND HORIZONTAL) PRIOR TO COMMENCEMENT OF CONSTRUCTION ACTIVITY. MANY TEMPORARY BENCHMARKS UTILIZED IN THE TOPOGRAPHIC SURVEY FOR THE DESIGN WILL BE RELOCATED AS PART OF THE CONSTRUCTION ACTIVITY.

KEYNOTE LEGEND

REMAIN.  
IN.  
(BASE BID). REPLACE WITH PROPOSED SEWER PER SHEET C502.  
(ALTERNATE BID #4A).  
THE STORM SEWER PIPE INSTALLATION IF NECESSARY.  
CONCRETE SIDEWALK AS NEEDED FOR THE CONSTRUCTION OF SEWER LINE.  
E HARDSCAPE/LANDSCAPE SITE PLANS.   
CHAIN LINK FENCE AS NEEDED FOR THE CONSTRUCTION OF SEWER LINE. SEE  
NEW FENCE LIMITS.  
ASPHALT PAVEMENT AS NEEDED FOR THE CONSTRUCTION OF SEWER LINE.  
E HARDSCAPE/LANDSCAPE SITE PLANS.  
CONCRETE CURB AS NEEDED FOR THE CONSTRUCTION OF SEWER LINE.  
E HARDSCAPE/LANDSCAPE SITE PLANS.  
(ALTERNATE BID #4A). REPLACE WITH PROPOSED SEWER PER SHEET C502 OR  
(ALTERNATE BID #4B). REPLACE WITH PROPOSED SEWER PER SHEET C502 OR  
NATE BID #4A).   
E SECTION OF PIPE UNDER THE EXISTING BUILDING.

SHALL  
CN  
R

---

PROJECT:  
**MSD OF WARREN TOWNSHIP**

---

**WARREN CENTRAL HIGH**  
**PHASE 3 RENOVATION &**

1

SEE	
2 OR	
2 OR	
	<b>REVISIONS:</b>
	1. ADDENDUM #2 03-13-2023

THE INFLUENCE OF THE CULTURE OF THE PARENTS ON THE CHILD'S LANGUAGE 11

ISSUE DATE	DRAWN BY	CHECKED
02-17-2023	S. PIERRE	S. PIERRE

**DRAWING TITLE:**

**EXISTING  
CONDITIONS AND  
DEMOLITION PLAN**

**CERTIFIED BY:**


*Stev Pierre*




STEV PIERRE  
REGISTERED  
No. PE11600721  
STATE OF  
INDIANA  
PROFESSIONAL ENGINEER

03-13-2023

**DRAWING NUMBER**  
**C101**

 <b>82-5544</b> TOLL FREE	<b>PROJECT NUMBER</b> <b>18142</b> <b>CRYPE No. 180242-2</b>
---------------------------------	--

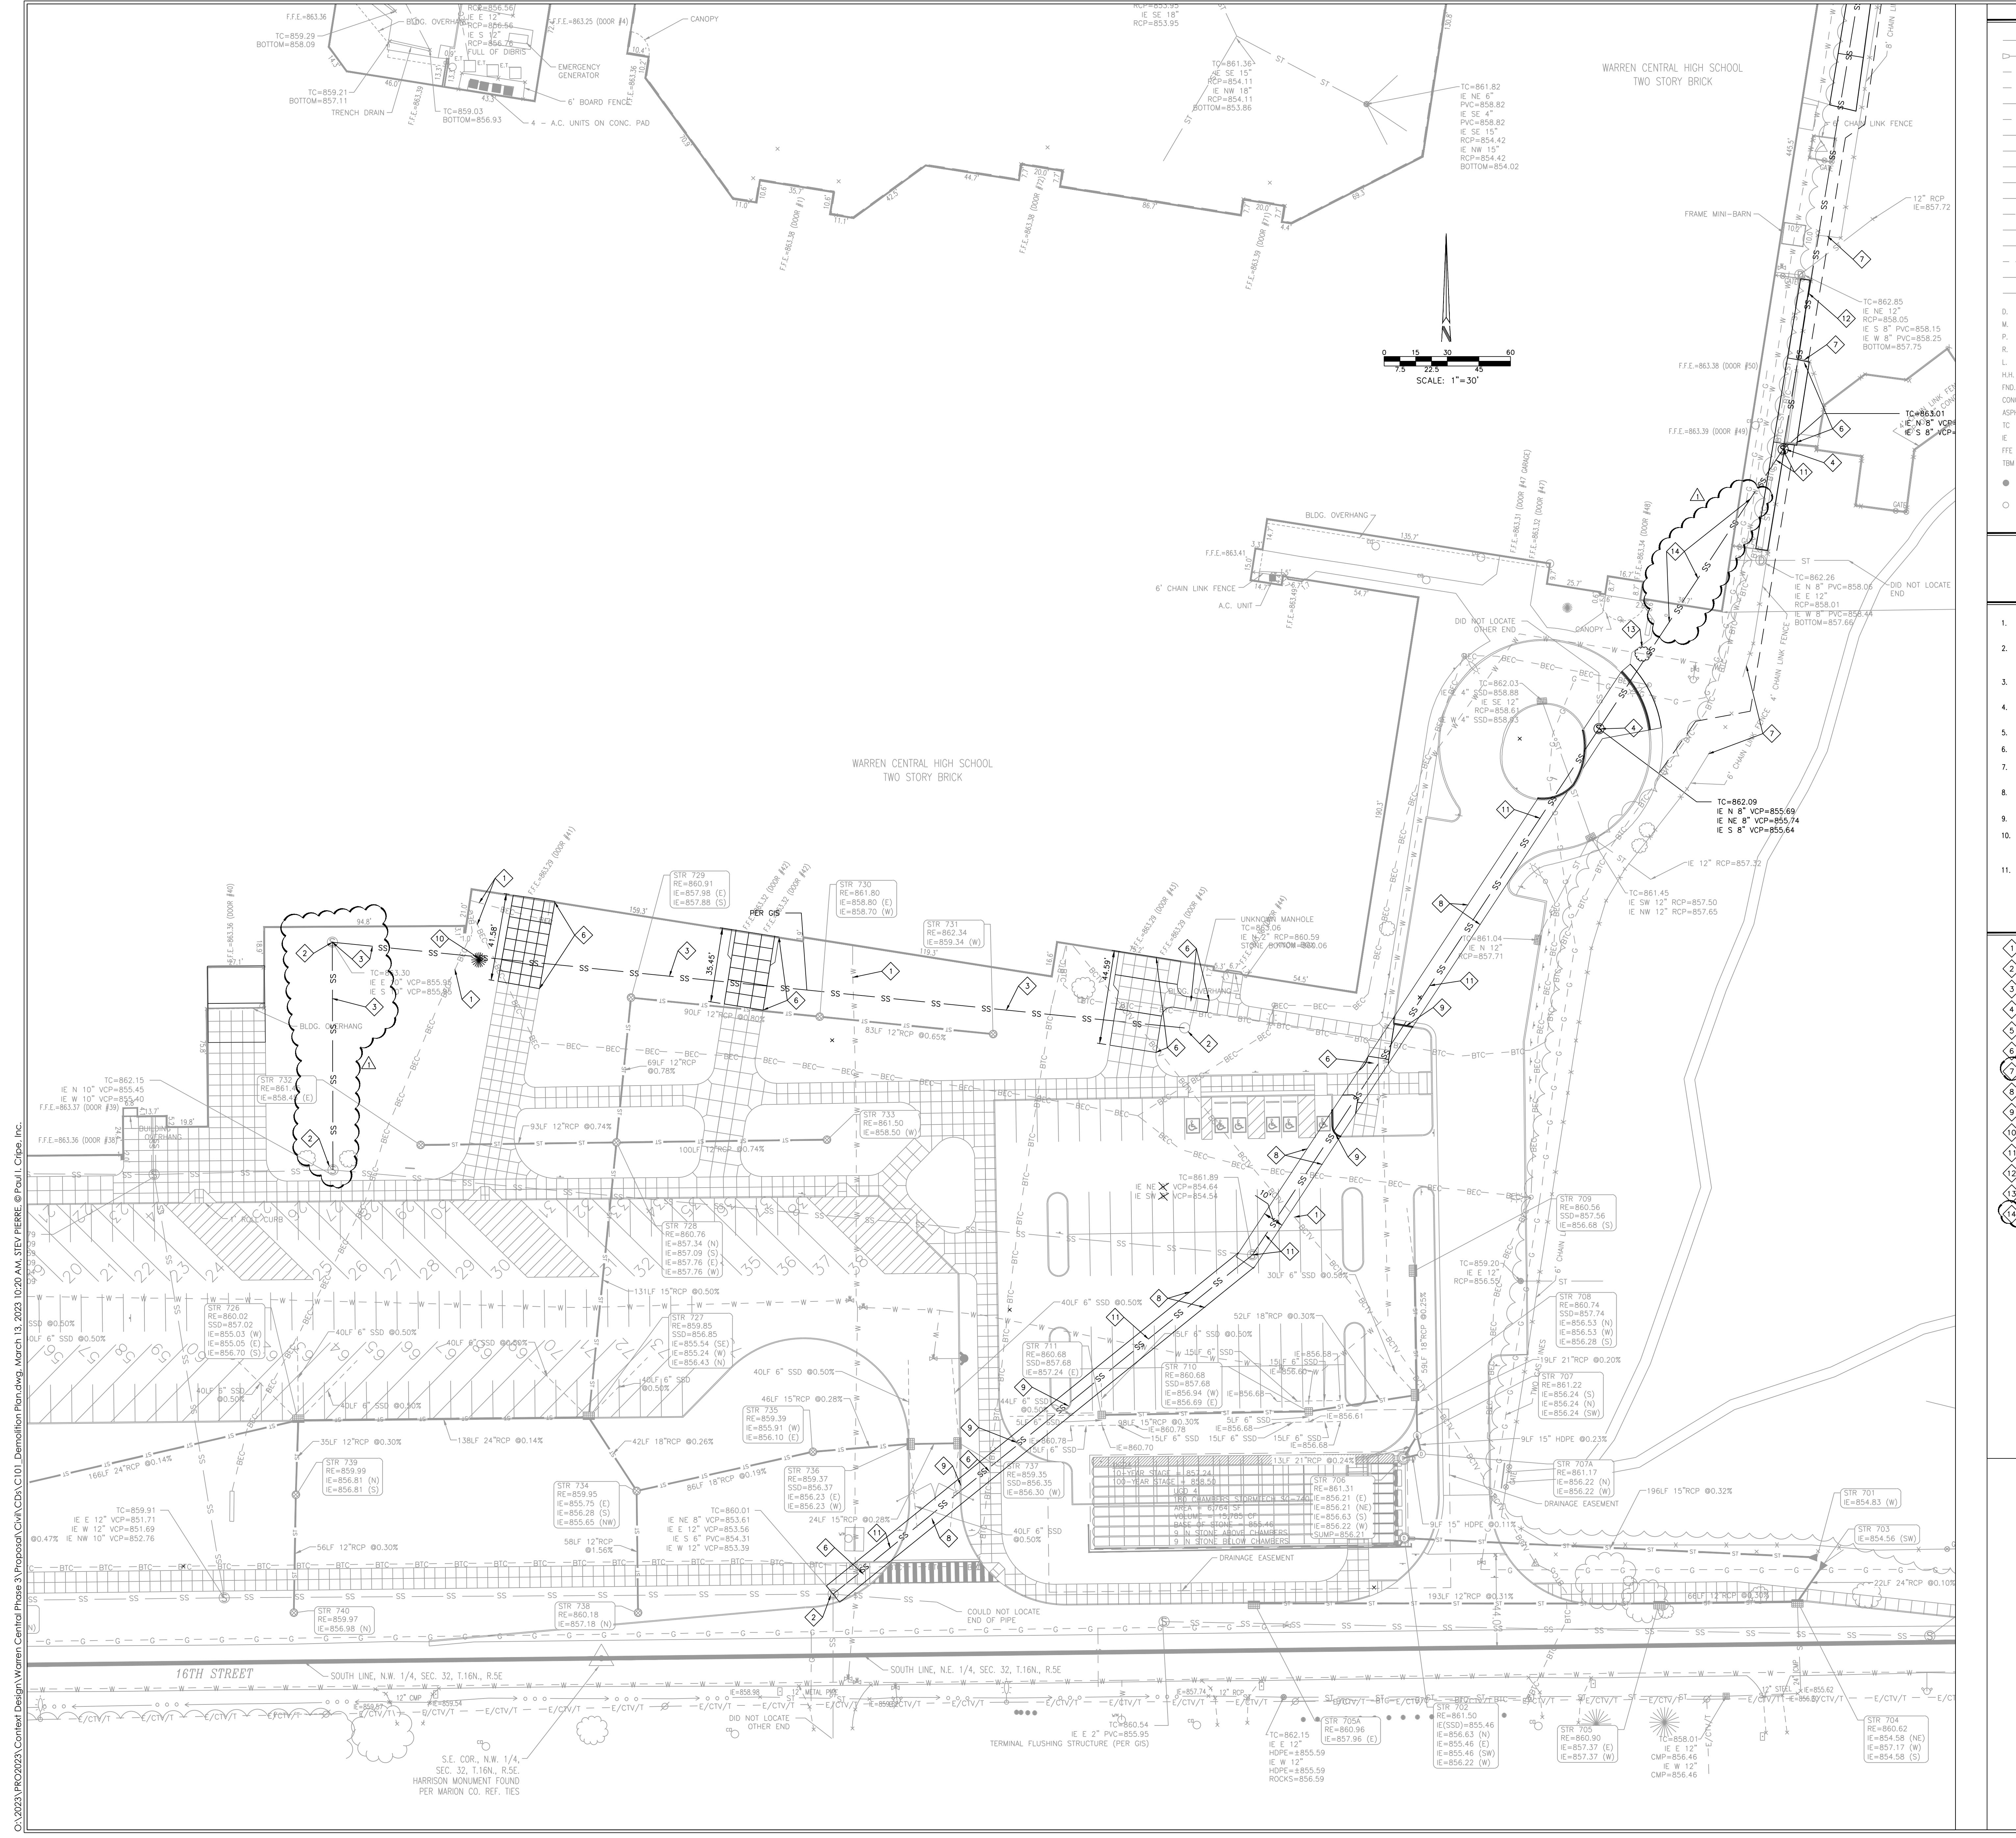

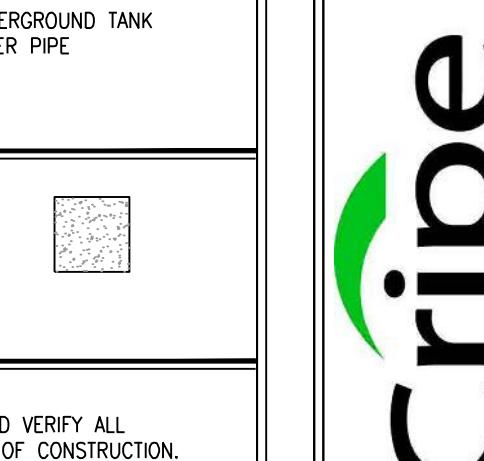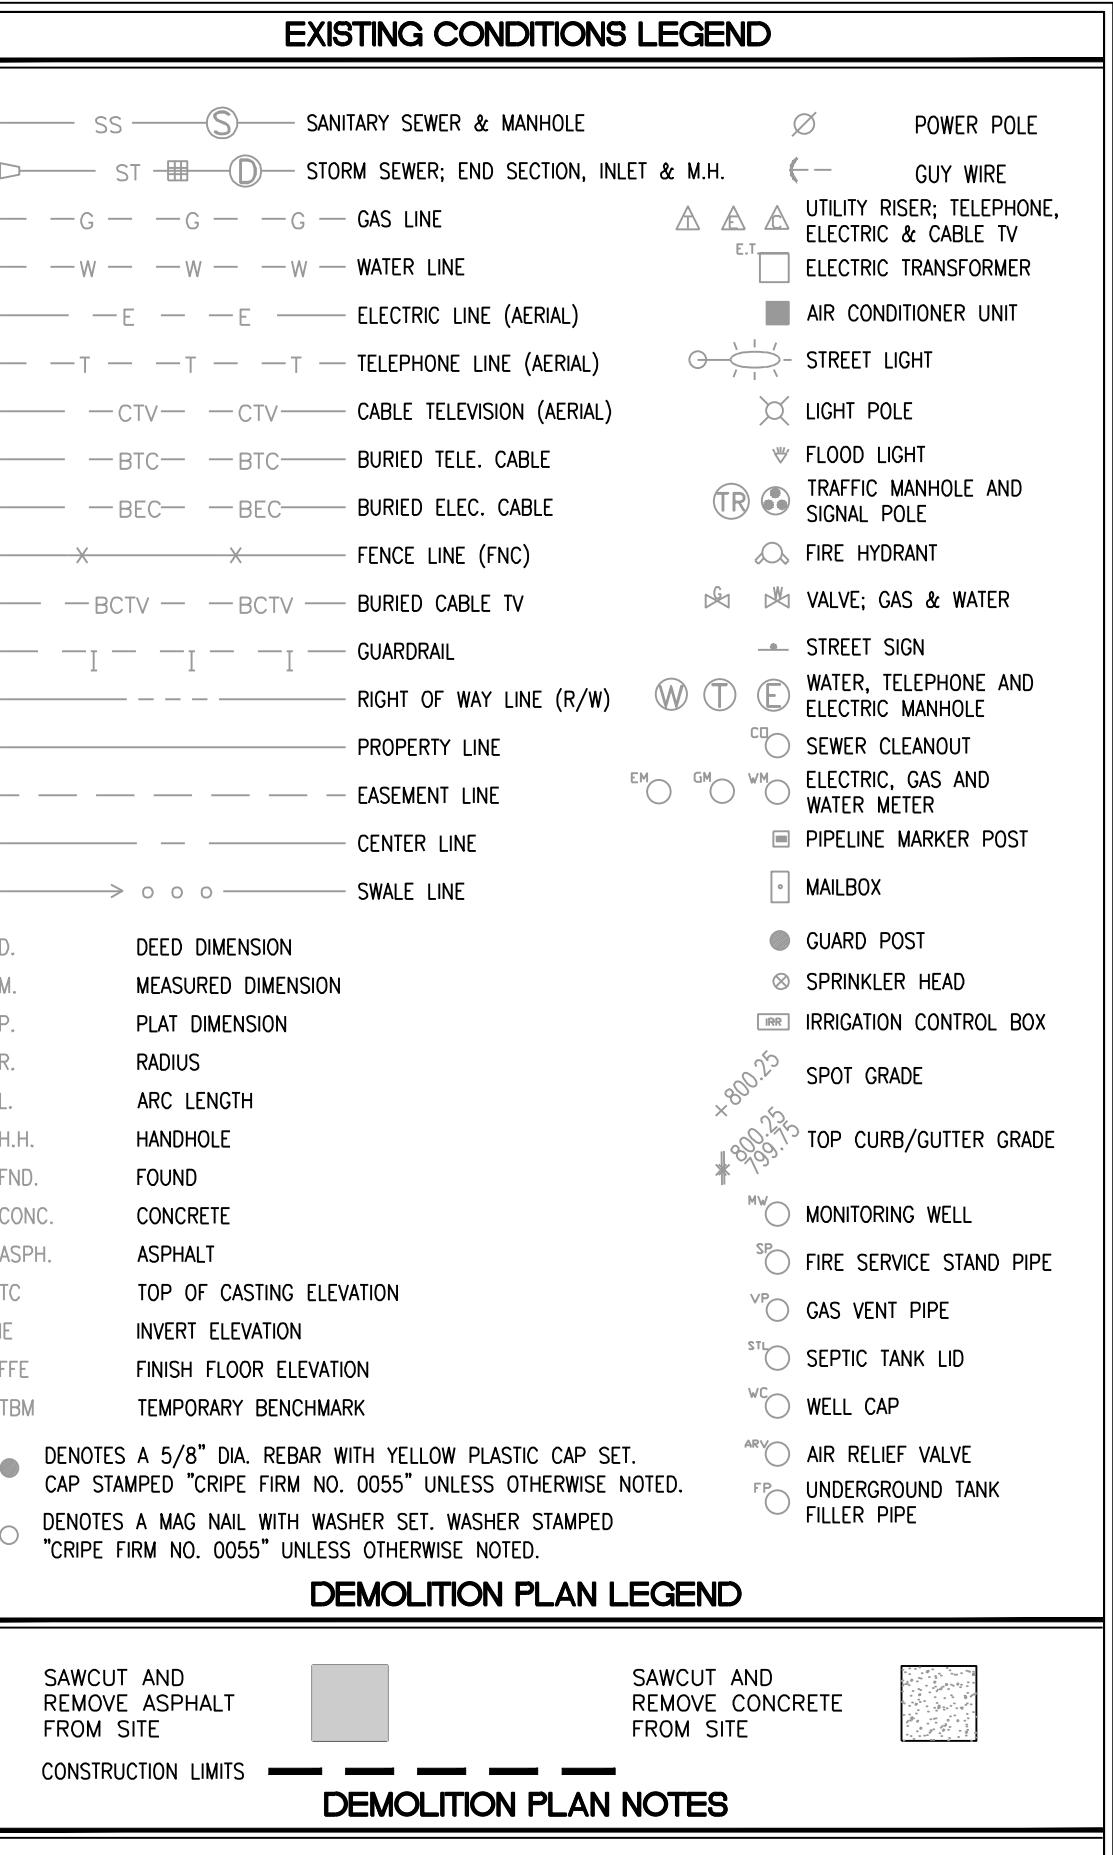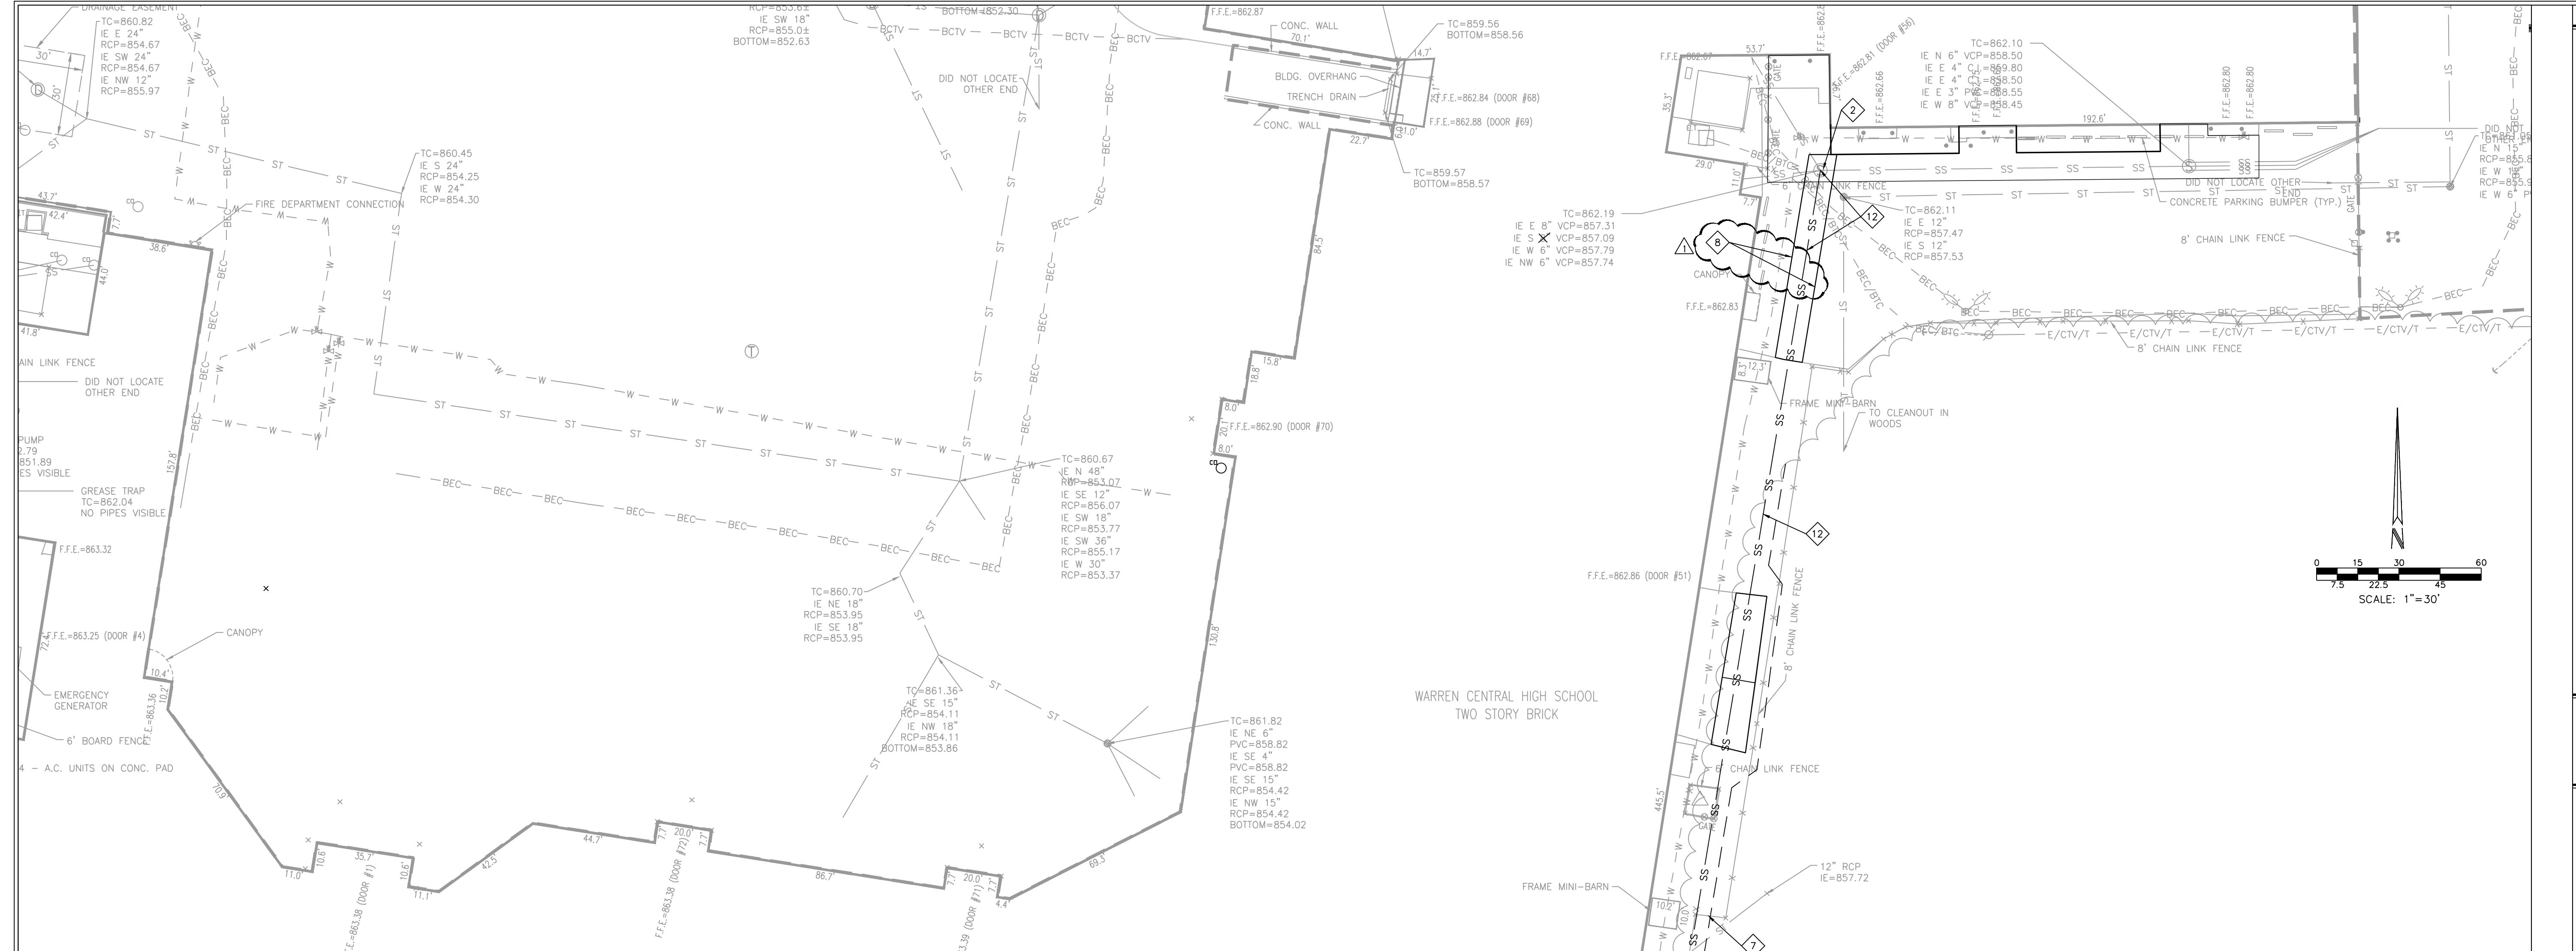

Solutions by Design Since 1937

3939 Priority Way, Drive, Suite 200

INDIANAPOLIS, IN 46240

www.cripe.com

## PROJECT: MSD OF WARREN TOWNSHIP

### WARREN CENTRAL HIGH SCHOOL PHASE 3 RENOVATION & ADDITION


9500 EAST 16th STREET, INDIANAPOLIS, IN 46229

REVISIONS:

- ADDENDUM #2 03-13-2023

ISSUE DATE 02-17-2023 DRAWN BY S. PIERRE CHECKED BY S. PIERRE

DRAWING TITLE: EXISTING CONDITIONS AND DEMOLITION PLAN

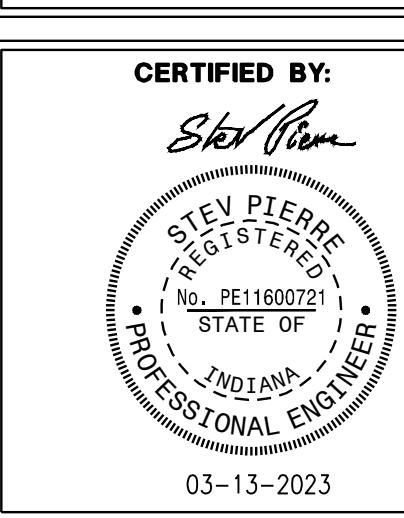
CERTIFIED BY: 

Steve Pierre, P.E. No. PE16000721  
REGISTERED STATE OF INDIANA  
03-13-2023

DRAWING NUMBER C102

PROJECT NUMBER 18142

CRYPE No. 180242-20050

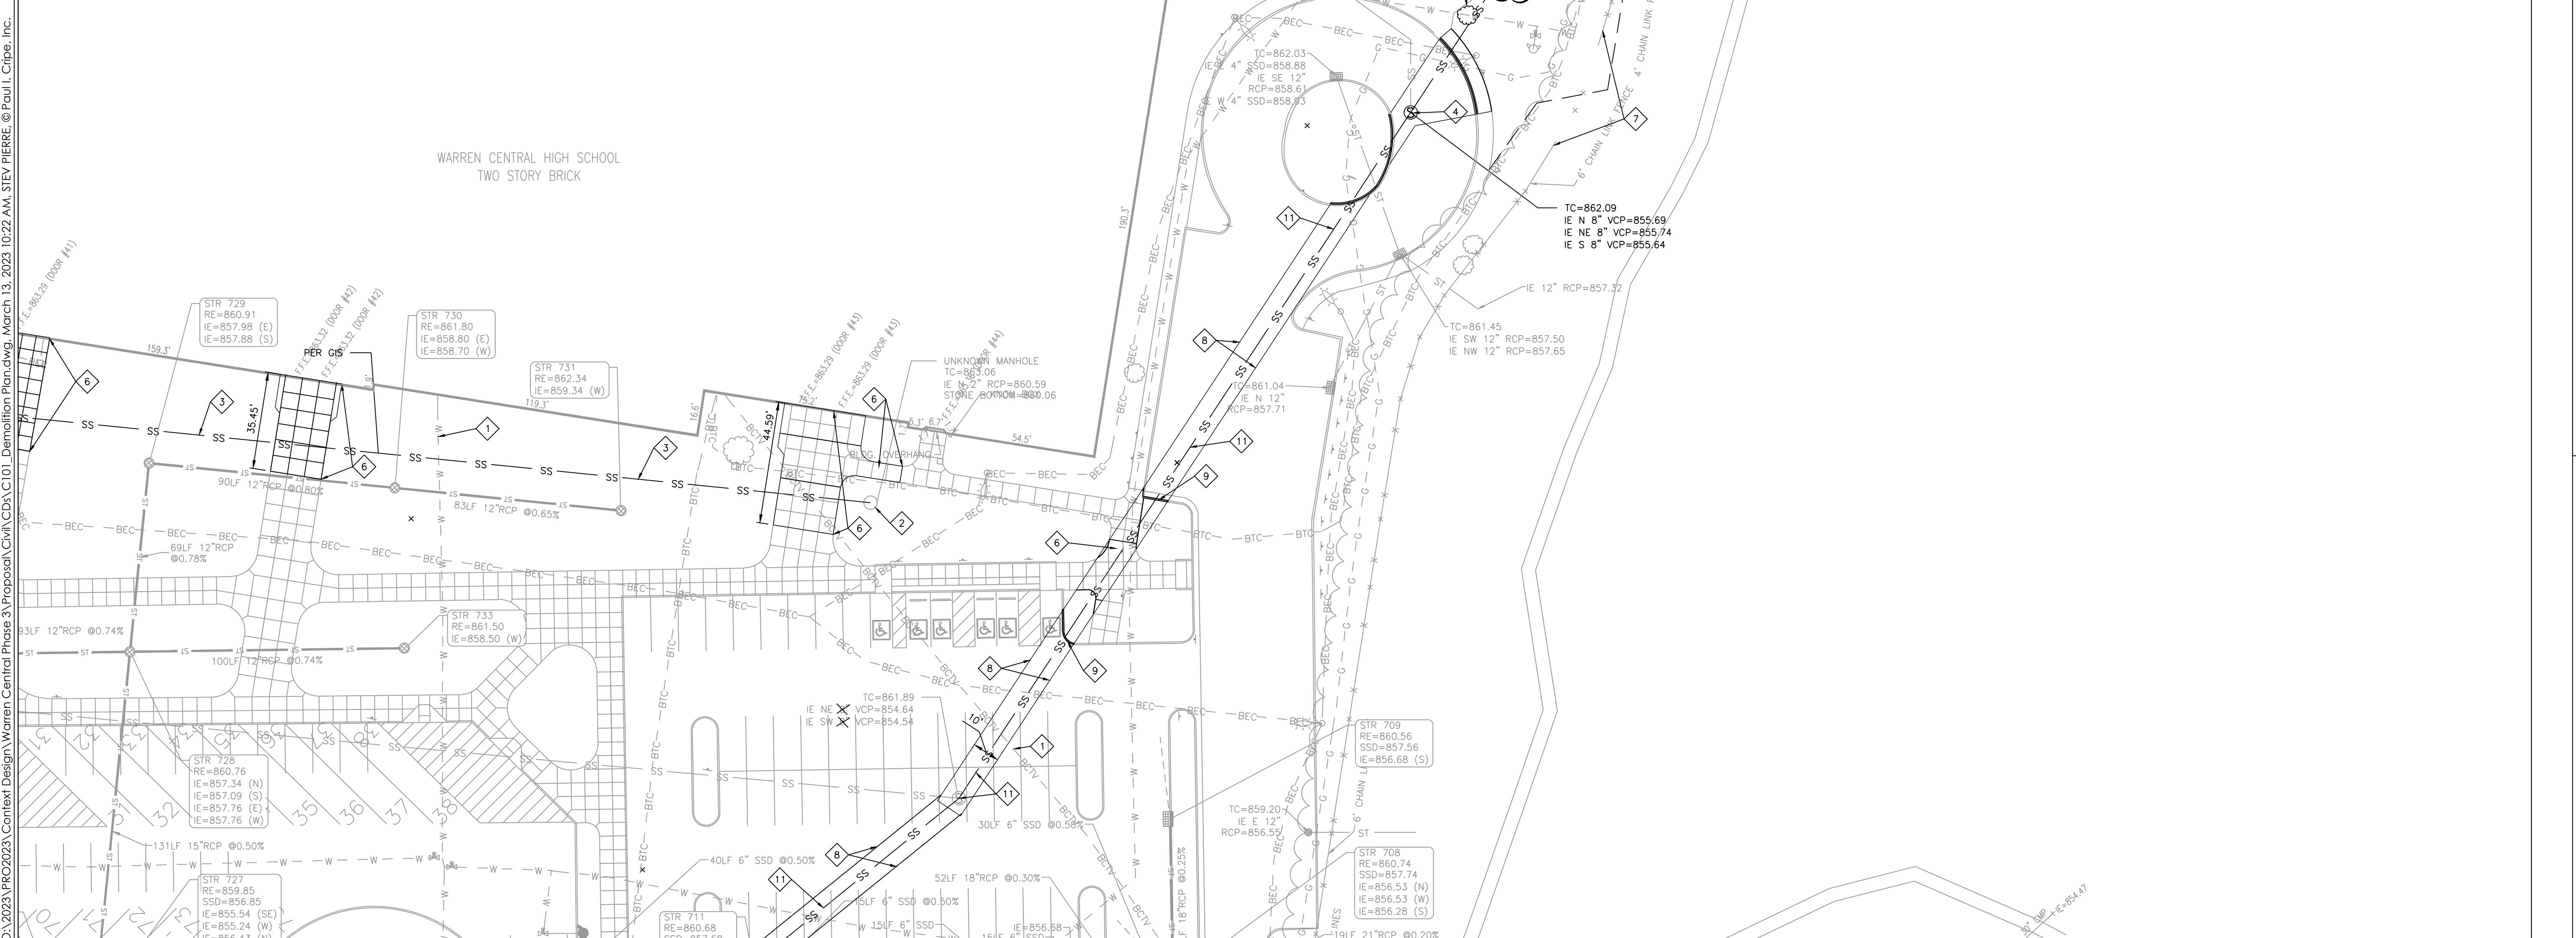

PERMANENT SEEDING - IF THERE IS A CONFLICT BETWEEN THESE NOTES AND THE LANDSCAPE PLANS OR SPECIFICATIONS, THE LANDSCAPE PLANS AND SPECIFICATIONS CONTROL.

Application Site Preparation

- Grade the site to achieve positive drainage.
- Add topsoil or compost mulch to achieve needed depth for establishment of vegetation. (Compost material may be added to improve soil moisture holding capacity, soil friability, and nutrient availability.)

Seeding

- Test soil to determine pH and nutrient levels.
- Apply soil amendments as recommended by the soil test and work into the upper two to four inches of soil. Tilling is not done, apply the material per tons of 12-12-12 analysis, fertilizer, or equivalent.
- Till the soil to a depth of one-half inch to a depth of one-half inch. Till the soil to a depth of one-half inch to a depth of one-half inch. Till the soil to a depth of one-half inch to a depth of one-half inch.
- Optimum seeding dates are March 1 to May 10 and August 10 to September 30. Permanent seeding done between May 10 and August 10 need to be irrigated. Seeding outside or beyond optimum seeding dates is still possible with the understanding that reseeding or overseeding may be required if adequate surface cover is not achieved. Reseeding or overseeding can be easily accomplished if the soil surface remains well protected with mulch.
1. Select seeding mixture or rate of seed as recommended from Table 1 Permanent Seeding Recommendations. Select seed mixture based on site conditions, soil pH, intended land use, intended level of maintenance.
2. Apply the seed mixture to the soil surface by broadcast. Place the seed to a depth of one-half inch to a depth of one-half inch. If drilling or cultipacker after completing seeding operations. (If seeding is done with a hydroseeder, do not apply the seed to a depth of one-half inch to a depth of one-half inch.)
3. Mulch the seed mixture and use appropriate methods to anchor the mulch in place. Consider using erosion control blankets on sloping areas and conveyance channels.

Maintenance



- Inspect within 24 hours of each rain event and at least once every seven calendar days until the vegetation is successfully established.
- Characteristics of a successful stand include vigorous dark green or bluishgreen seedlings with a uniform appearance and a density of 80% or more.
- Check for erosion or movement of mulch.
- Repair damaged, bare, gullied, or sparsely vegetated areas and then fertilize, reseed, and apply and anchor mulch.
- If plant cover is sparse or patchy, evaluate the plant materials chosen, soil fertility, moisture condition, and mulch application; repair affected areas either by overseeding or preparing a new seedbed and reseeding. Apply and anchor mulch on the newly seeded areas.
- If fertilizer is needed to get a satisfactory stand, do so according to soil test recommendations.
- Additional fertilization is needed to the following growing season. Fertilizer according to soil test recommendations.
- Fertilizer application rates for new seedings are as follows: for warm-season grasses, apply one-half of the fertilizer in late spring and one-half in early fall. For warm-season grasses, apply one-third in early spring, one-third in late spring, and the remaining one-third in middle summer.

Table 1 Permanent Seeding Recommendations

This table provides several seed mixture options. Additional seed mixtures are available commercially. When selecting a mixture, consider intended land use and site conditions, including soil properties (e.g., soil pH and drainage), slope aspect, and the tolerance of each species to shade and drought.

Seed Mixtures	Rate per Acre	Optimum Soil pH
1. Bluegrass	140 lbs.	5.5 to 7.0
2. Perennial ryegrass (turf type)	60 lbs.	5.6 to 7.0
3. Tall fescue (turf type) 2-bluegrass	90 lbs.	5.6 to 7.5
30 lbs.		

### SEEDING NOTES

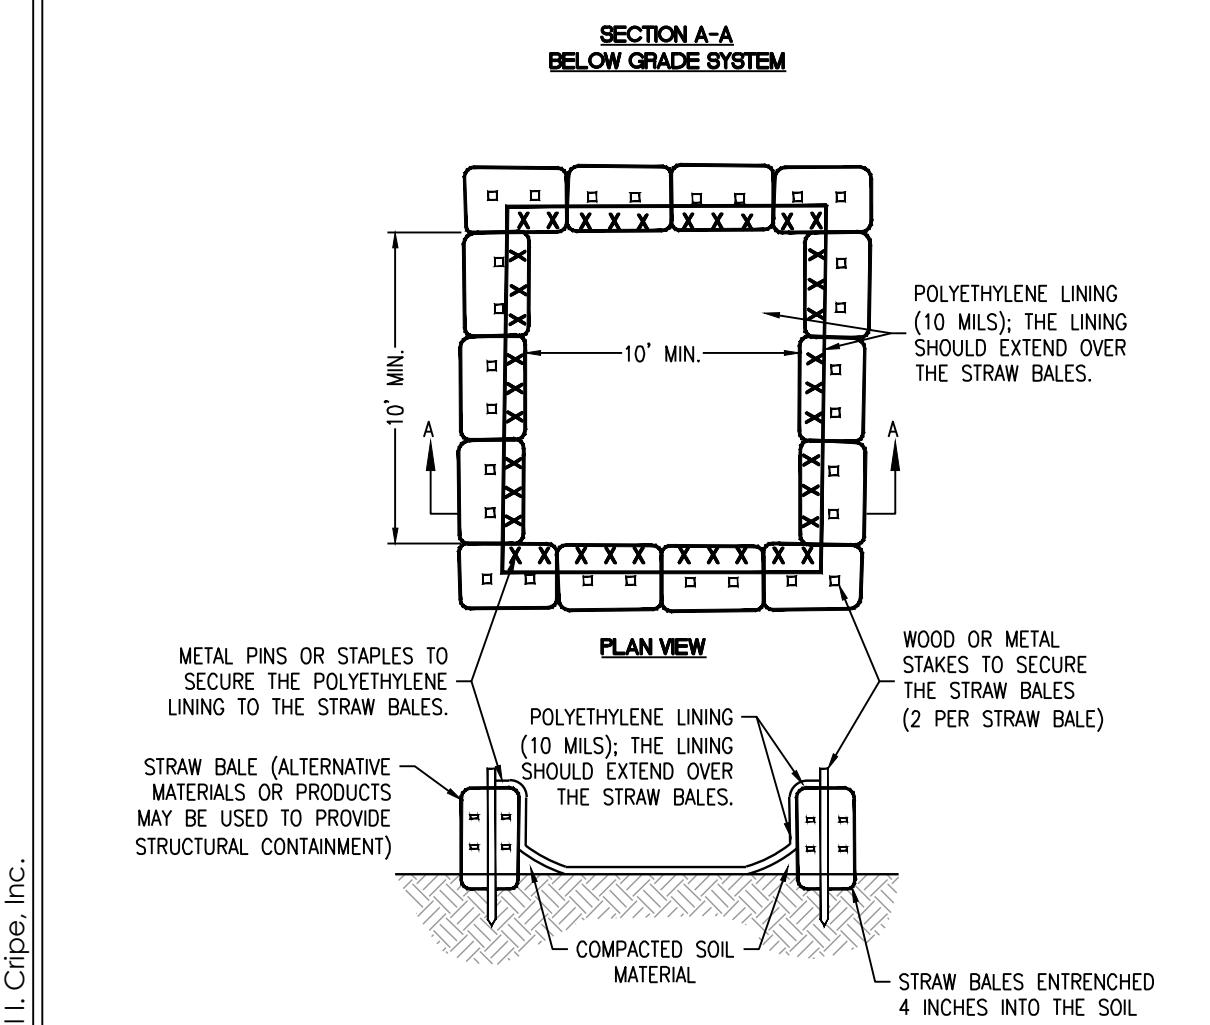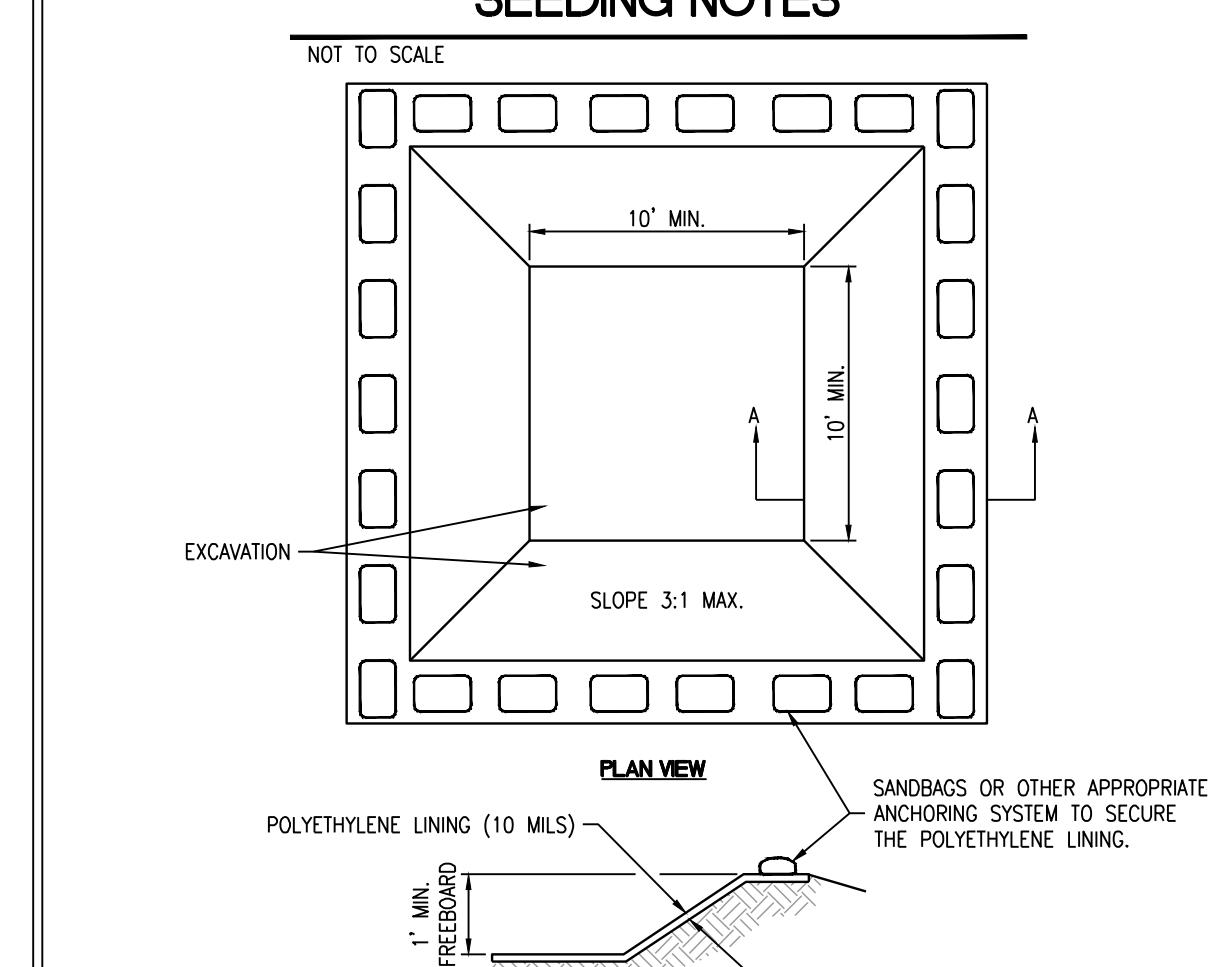

INSTALLATION

PREFABRICATED WASHOUT SYSTEMS/CONTAINERS

- Install and locate according to the manufacturer's recommendations.

DESIGNED AND INSTALLED SYSTEMS

- Utilize and follow the design in the storm water pollution prevention plan to install the system.
- Dependent upon the type of system, either excavate the pit or install the containment system.
- Do not use the system if the site is free of rocks and other debris that may cause tears or punctures in the polyethylene lining.
- Install the polyethylene lining. For excavated systems, the lining should extend over the entire excavation area, including the bottom of the trench. For containment systems, the lining should extend over the material to extend the lining over the berm or containment system. The lining should be secured with pins, staples, or other fasteners.
- Place a non-safety fencing or equivalent to provide a barrier to construction equipment and other traffic.
- Place a non-collapsing, non-water holding cover over the washout facility prior to a predicted rain event to prevent infiltration and possible overflow of the system (optional).
- Install signs to identify concrete washout areas.
- Post signs directing contractors and suppliers to designated locations.
- Where necessary, provide stable ingress and egress or alternative approach pad for concrete washout systems.

Maintenance

- Inspect daily and after each storm event.
- Inspect the integrity of the overall structure including, where applicable, the containment system.
- Inspect the filter fabric for damage and tracking of soil by equipment.
- Inspect the polyethylene lining for failure, including tears and punctures.
- Once concrete wastes are taken, remove and dispose of the materials. If the waste reaches 50 percent of the design capacity, use of the system should be discontinued until appropriate measures can be initiated to clean the structure. Prefabricated systems should also utilize this criterion, unless the manufacturer specifies otherwise.
- Upon removal of the solids, inspect the structure. Repair the structure as needed or construct a new system.

DISPOSAL

- Dispose of all concrete in a legal manner. Reuse the material on site, recycle, or haul the material to an approved construction/demolition landfill site. Recycling of material is encouraged. The waste material can be used for multiple applications including, but not limited to roadbeds and building foundations.
- The plastic liner should be replaced after every cleaning. The removal of material will usually damage the lining.
- The concrete washout system should be repaired or enlarged as necessary to maintain capacity for concrete waste.
- Concrete washout systems are designed to promote evaporation. If they do not do so, provide a pump or near capacity unit, or if necessary to vacuum or remove the liquids and dispose of them in an acceptable method. Disposal may be allowed at the local sanitary sewer authority provided their national pollution discharge elimination system permits allow for accepting the waste.

OTHER

- Prefabricated units are often pumped and the waste surface the unit provides this service. If prefabricated units are used, the user should refer to the manufacturer's specifications for the affected portion of the system.

PERMANENT SEEDING

- Optimum seeding dates are March 1 to May 10 and August 10 to September 30. Permanent seeding done between May 10 and August 10 need to be irrigated. Seeding outside or beyond optimum seeding dates is still possible with the understanding that reseeding or overseeding may be required if adequate surface cover is not achieved. Reseeding or overseeding can be easily accomplished if the soil surface remains well protected with mulch.

CONCRETE WASHOUT

- Inspect within 24 hours of a rain event and at least once every seven calendar days.
- Inspect daily and after each storm event.
- Inspect the integrity of the overall structure including, where applicable, the containment system.
- Inspect the filter fabric for damage and tracking of soil by equipment.
- Inspect the polyethylene lining for failure, including tears and punctures.
- Once concrete wastes are taken, remove and dispose of the materials. If the waste reaches 50 percent of the design capacity, use of the system should be discontinued until appropriate measures can be initiated to clean the structure. Prefabricated systems should also utilize this criterion, unless the manufacturer specifies otherwise.
- Upon removal of the solids, inspect the structure. Repair the structure as needed or construct a new system.

DISPOSAL

- Dispose of all concrete in a legal manner. Reuse the material on site, recycle, or haul the material to an approved construction/demolition landfill site. Recycling of material is encouraged. The waste material can be used for multiple applications including, but not limited to roadbeds and building foundations.

OTHER

- Prefabricated units are often pumped and the waste surface the unit provides this service. If prefabricated units are used, the user should refer to the manufacturer's specifications for the affected portion of the system.

PERMANENT SEEDING

- Optimum seeding dates are March 1 to May 10 and August 10 to September 30. Permanent seeding done between May 10 and August 10 need to be irrigated. Seeding outside or beyond optimum seeding dates is still possible with the understanding that reseeding or overseeding may be required if adequate surface cover is not achieved. Reseeding or overseeding can be easily accomplished if the soil surface remains well protected with mulch.

CONCRETE WASHOUT

- Inspect within 24 hours of a rain event and at least once every seven calendar days.
- Inspect daily and after each storm event.
- Inspect the integrity of the overall structure including, where applicable, the containment system.
- Inspect the filter fabric for damage and tracking of soil by equipment.
- Inspect the polyethylene lining

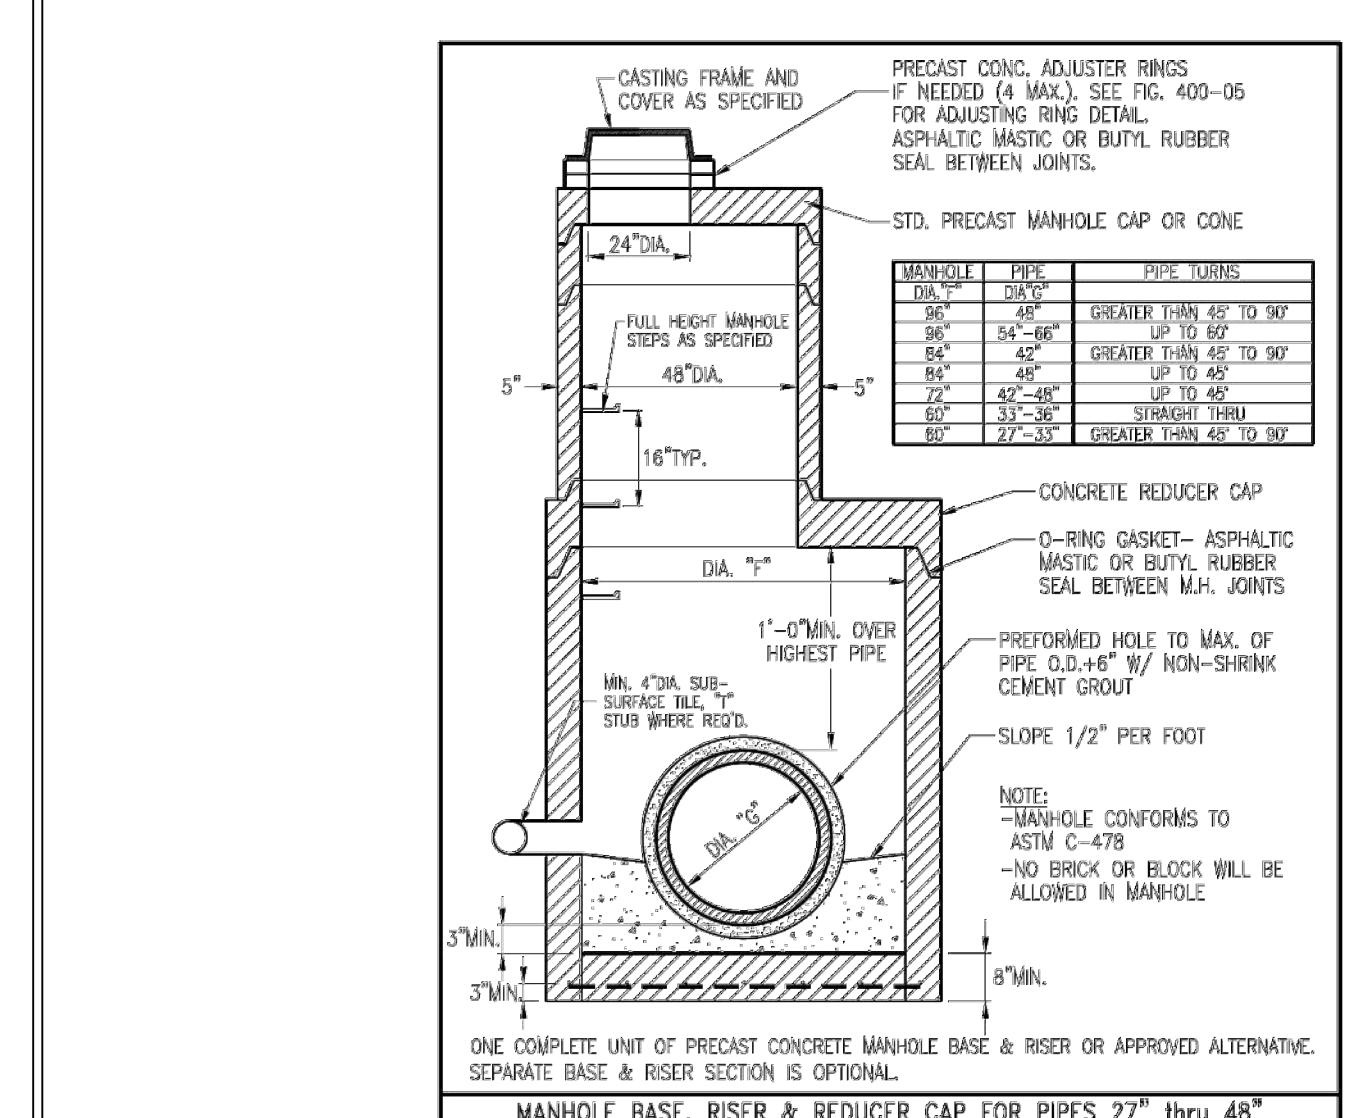
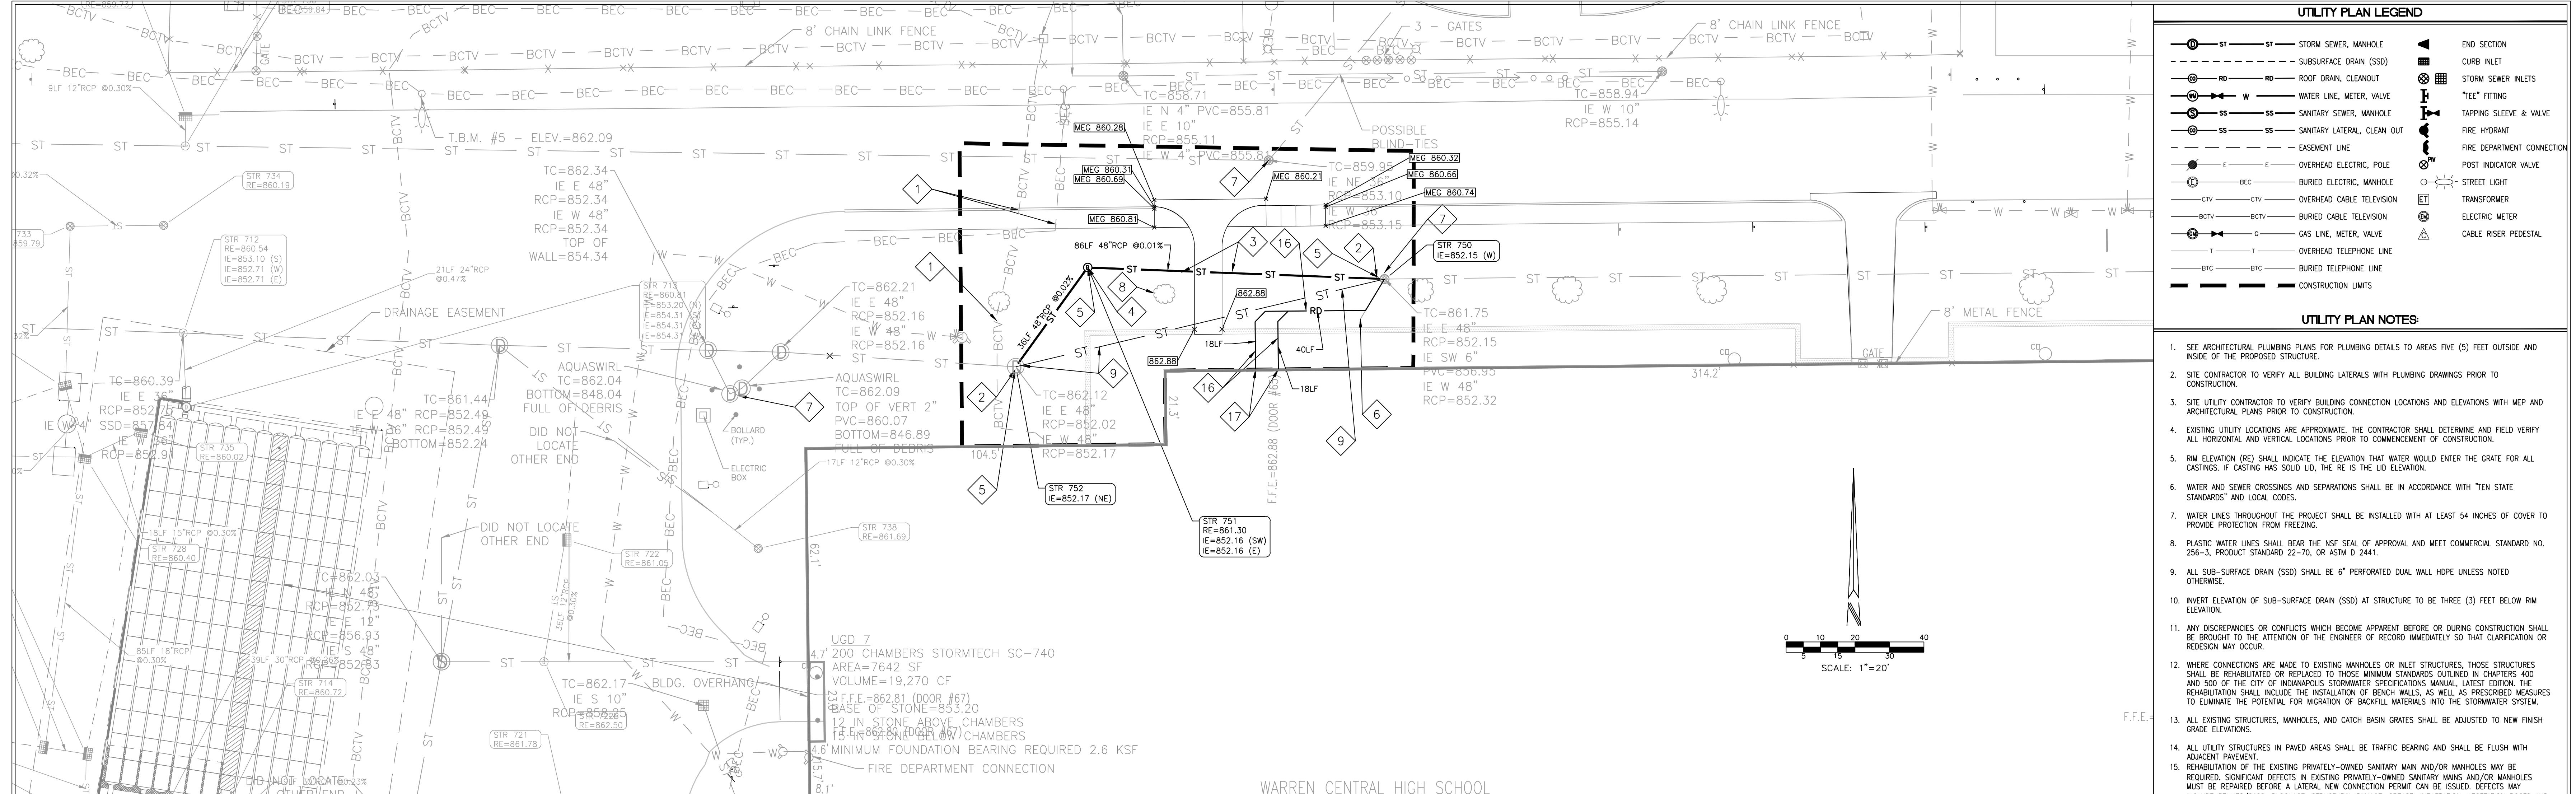


FIGURE 400-02: Manhole Base, Riser & Reducer Cap for Pipes 27" thru 48"

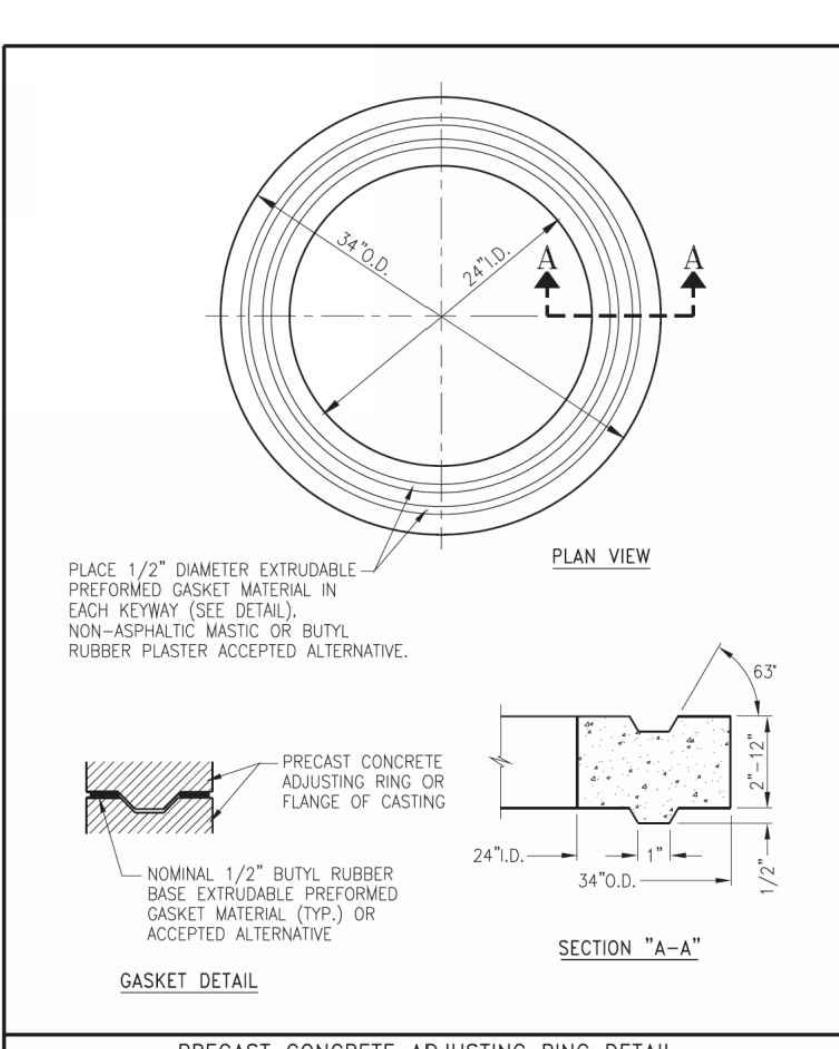


FIGURE 400-10: Precast Concrete Adjusting Ring Detail


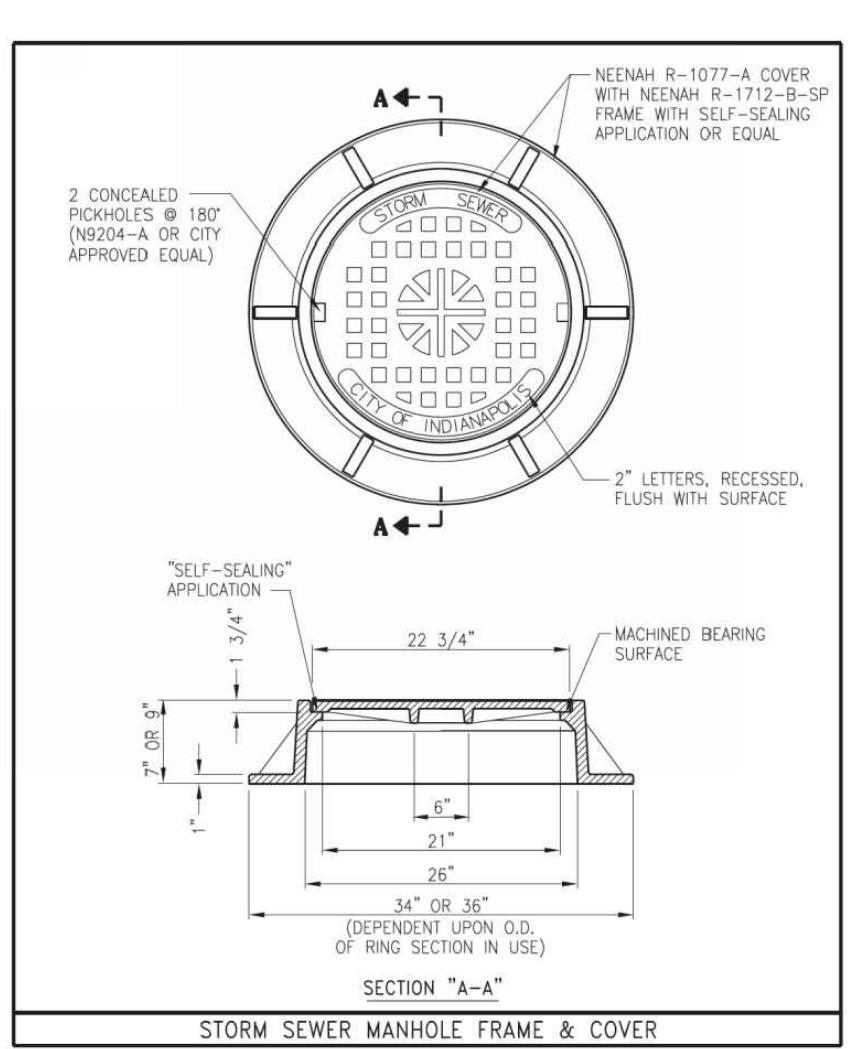


FIGURE 400-11: Storm Sewer Manhole Frame & Cover

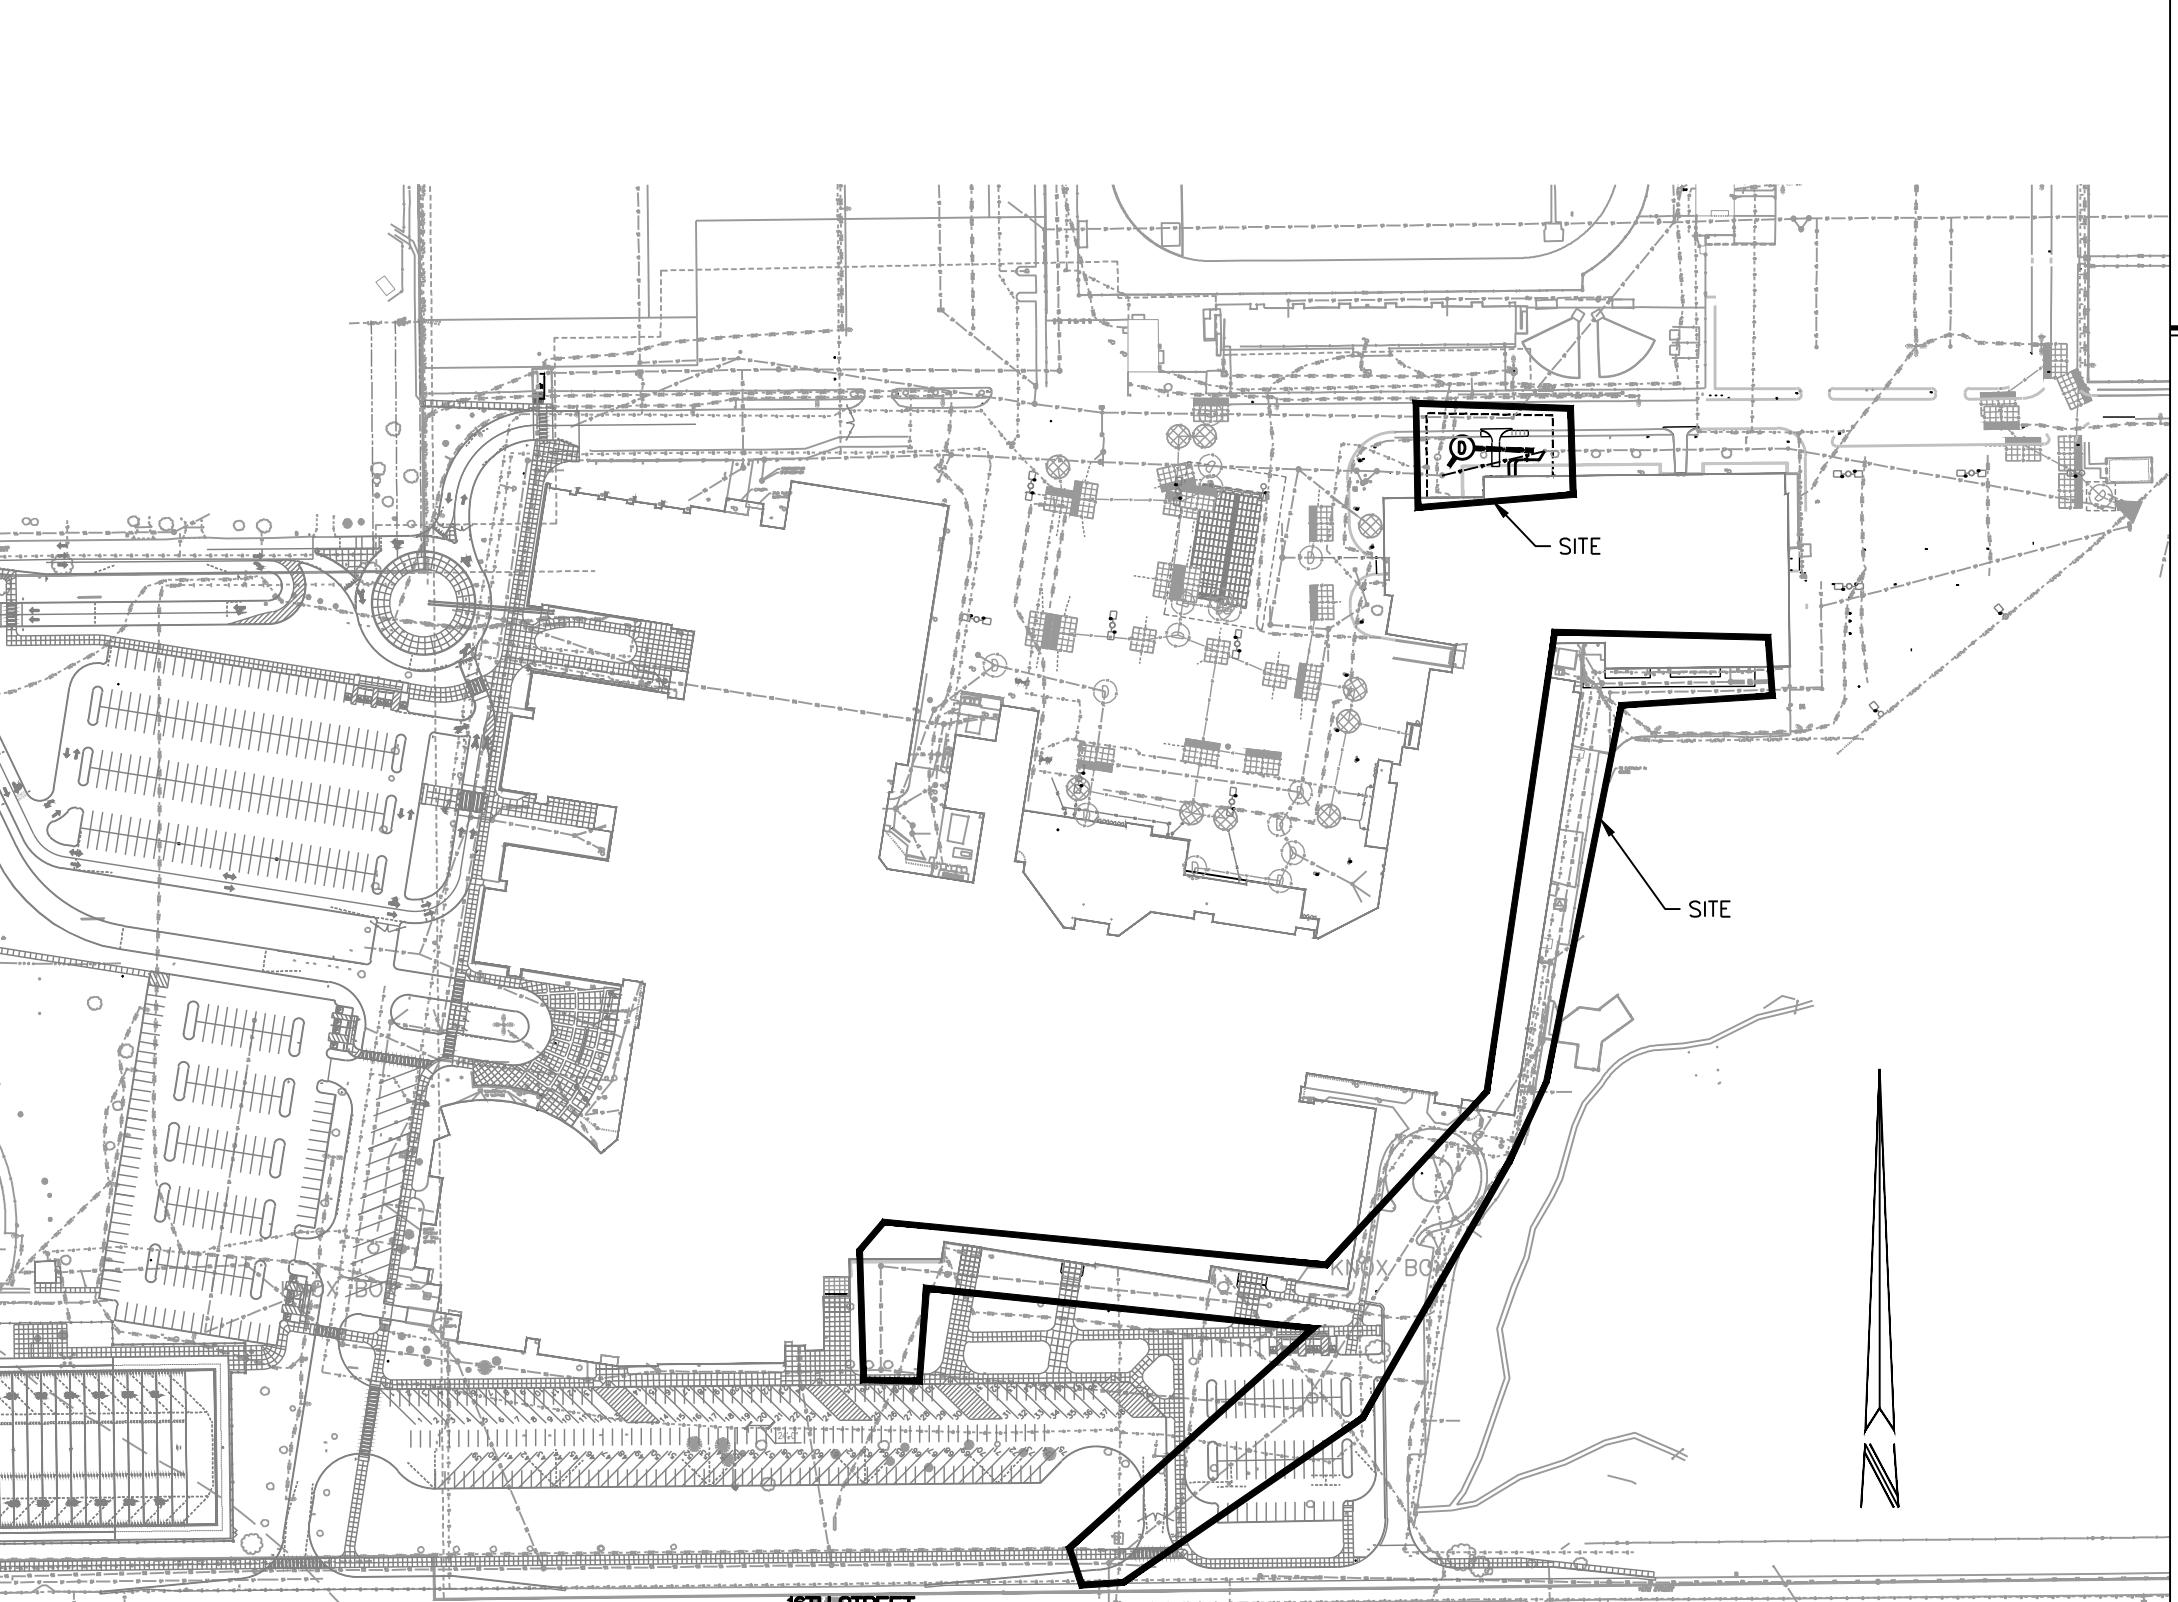

KEY MAP

NOT TO SCALE

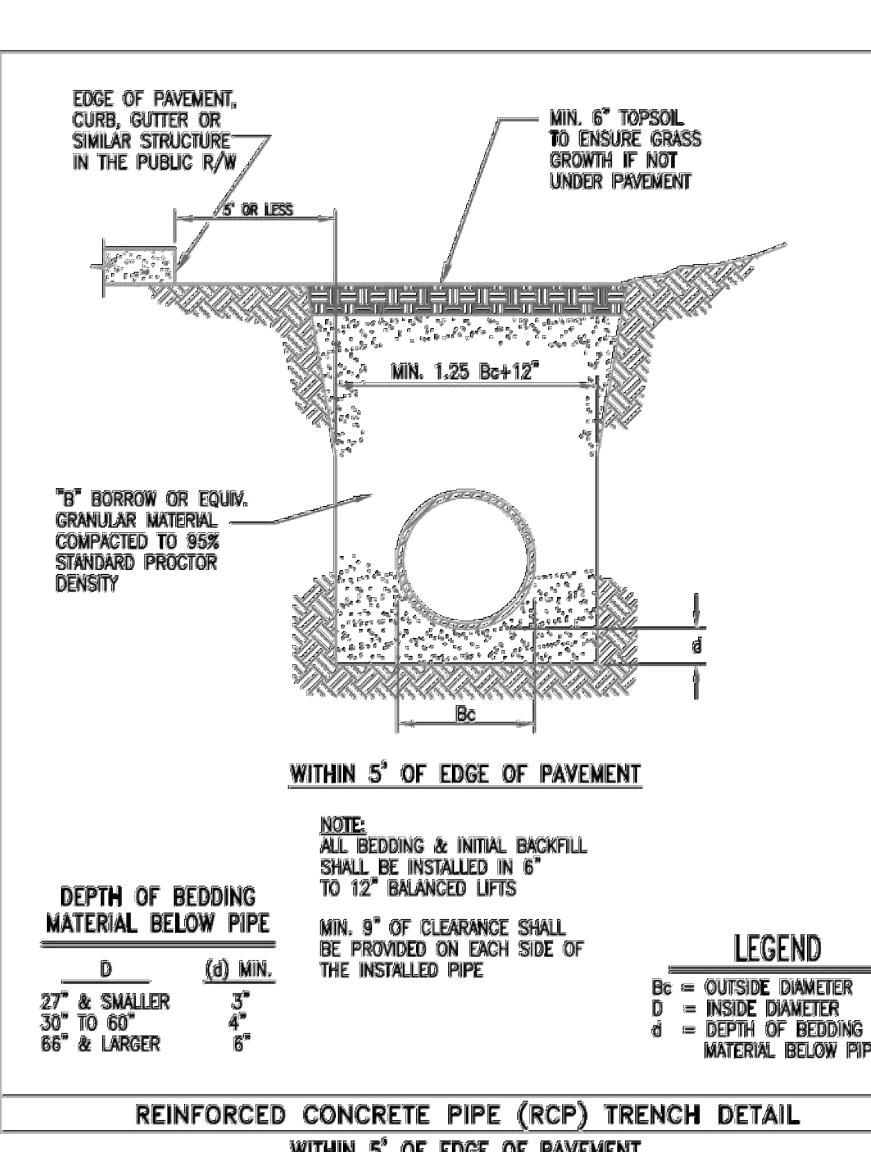


FIGURE 501-05: Reinforced Concrete Pipe (RCP) Trench Detail - within five feet of edge of pavement

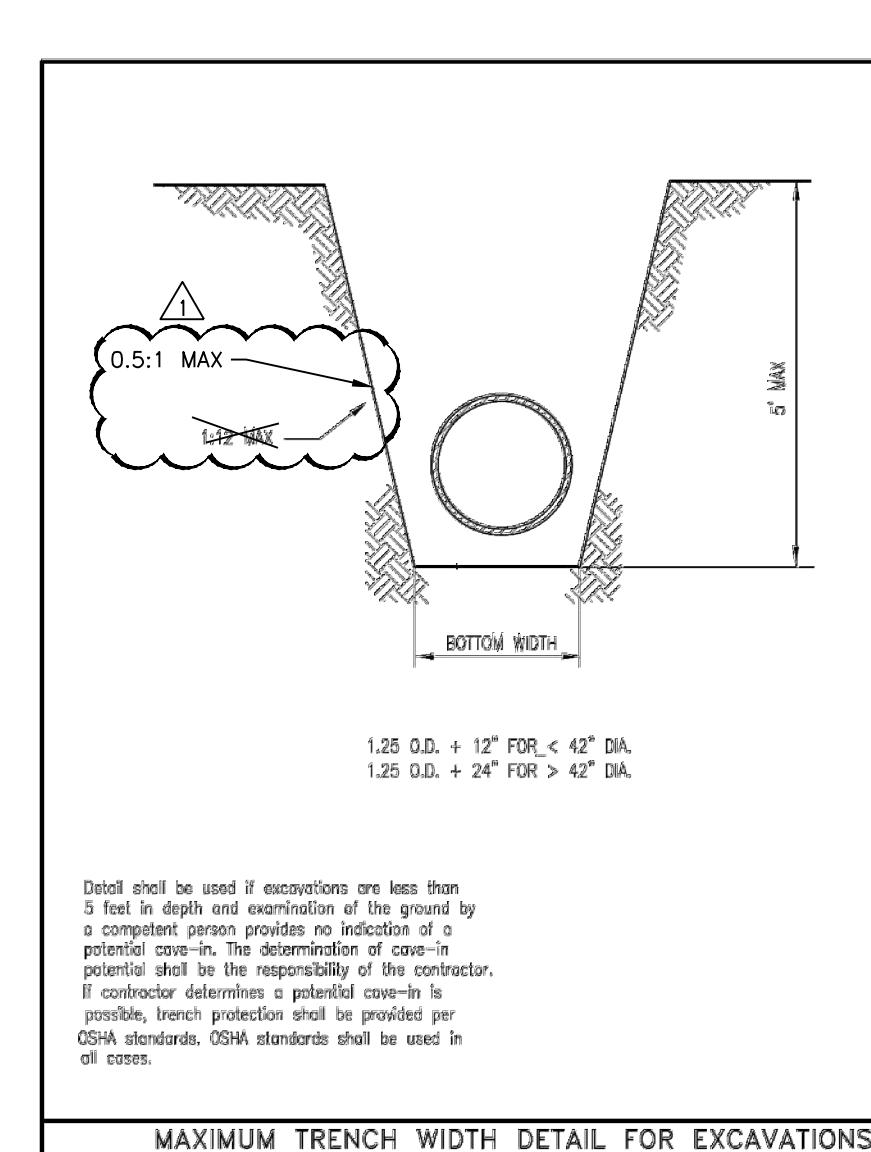


FIGURE 501-02: Maximum Trench Width Detail for Excavations - within five feet of edge of pavement


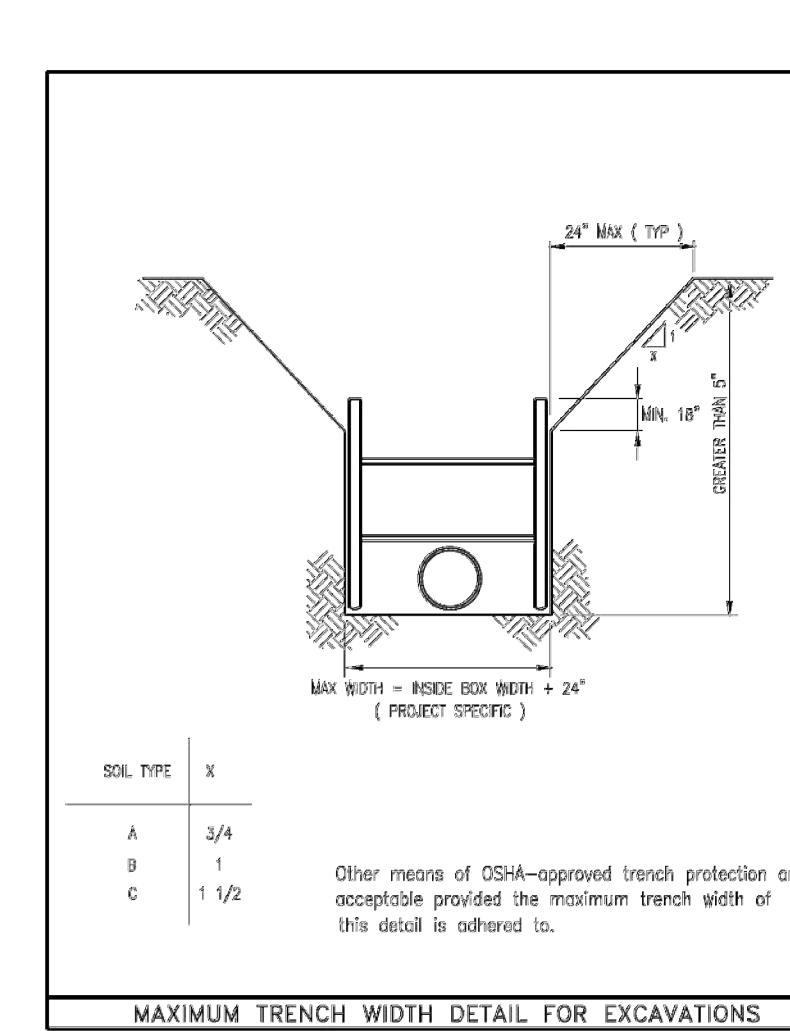


FIGURE 501-01: Maximum Trench Width Detail for Excavations - greater than five feet from edge of pavement

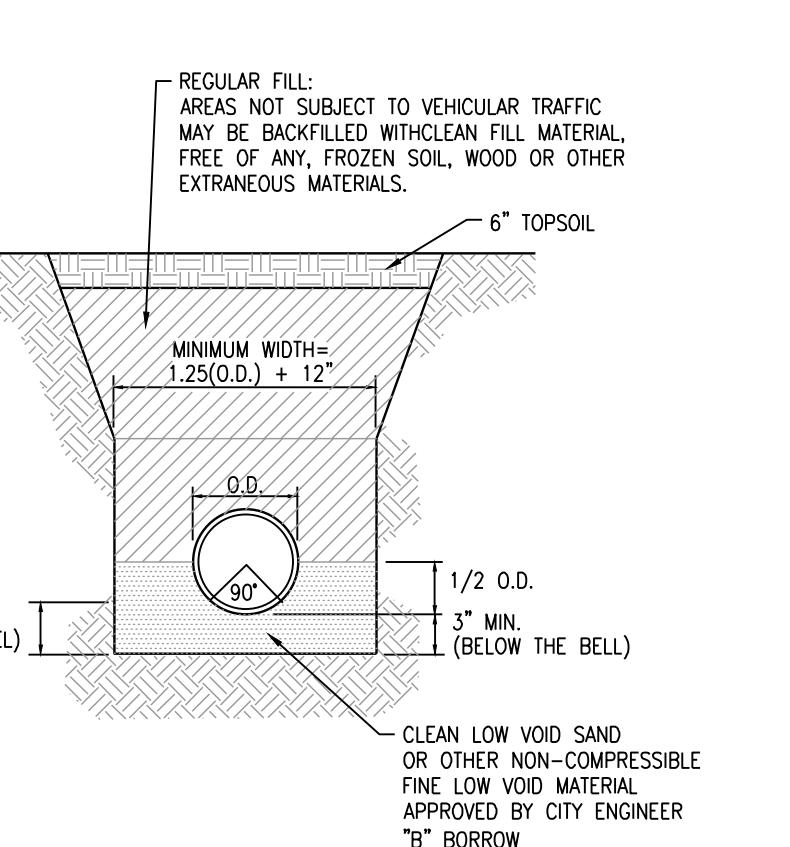

RIGID PIPE BEDDING DETAIL (STORM)  
GREATER THAN 5' FROM EDGE OF PAVEMENT

NOT TO SCALE

CONCRETE PIPE AND CWP

ISSUE DATE 02-17-2023 DRAWN BY S. PIERRE CHECKED BY S. PIERRE

DRAWING TITLE: UTILITY PLAN

REVISIONS:

1. ADDENDUM # 03-13-2023

CERTIFIED BY:

STEVE PIERRE, REGISTERED STATE OF INDIANA PROFESSIONAL ENGINEER  
No. PE1600721  
03-13-2023

DRAWING NUMBER C501

PROJECT NUMBER 18142

CRYPE No. 180242-20080

FOR CONTRACTOR

Indiana 811  
Know your buried  
Call before you dig


811 1-800-382-5544

CRYPE No. 180242-20080

SCCSO  
8831 Keystone Crossing Indianapolis, IN 46240  
317-584-2800 | cso.com

© 2020 SCCSO, Inc. All rights reserved.

**Crype**  
Solutions by Design Since 1937  
3939 Priority Way, Suite 200  
Indianapolis, IN 46240  
(317) 584-2800 | www.cso.com

 

60 CSO

8831 Keystone Crossing Indianapolis, IN 46240

31748.200 | cso.net


**Cripe**

Solutions by Design Since 1937



3939 Priority Way, Suite 200

Indianapolis, IN 46257

www.cripe.com

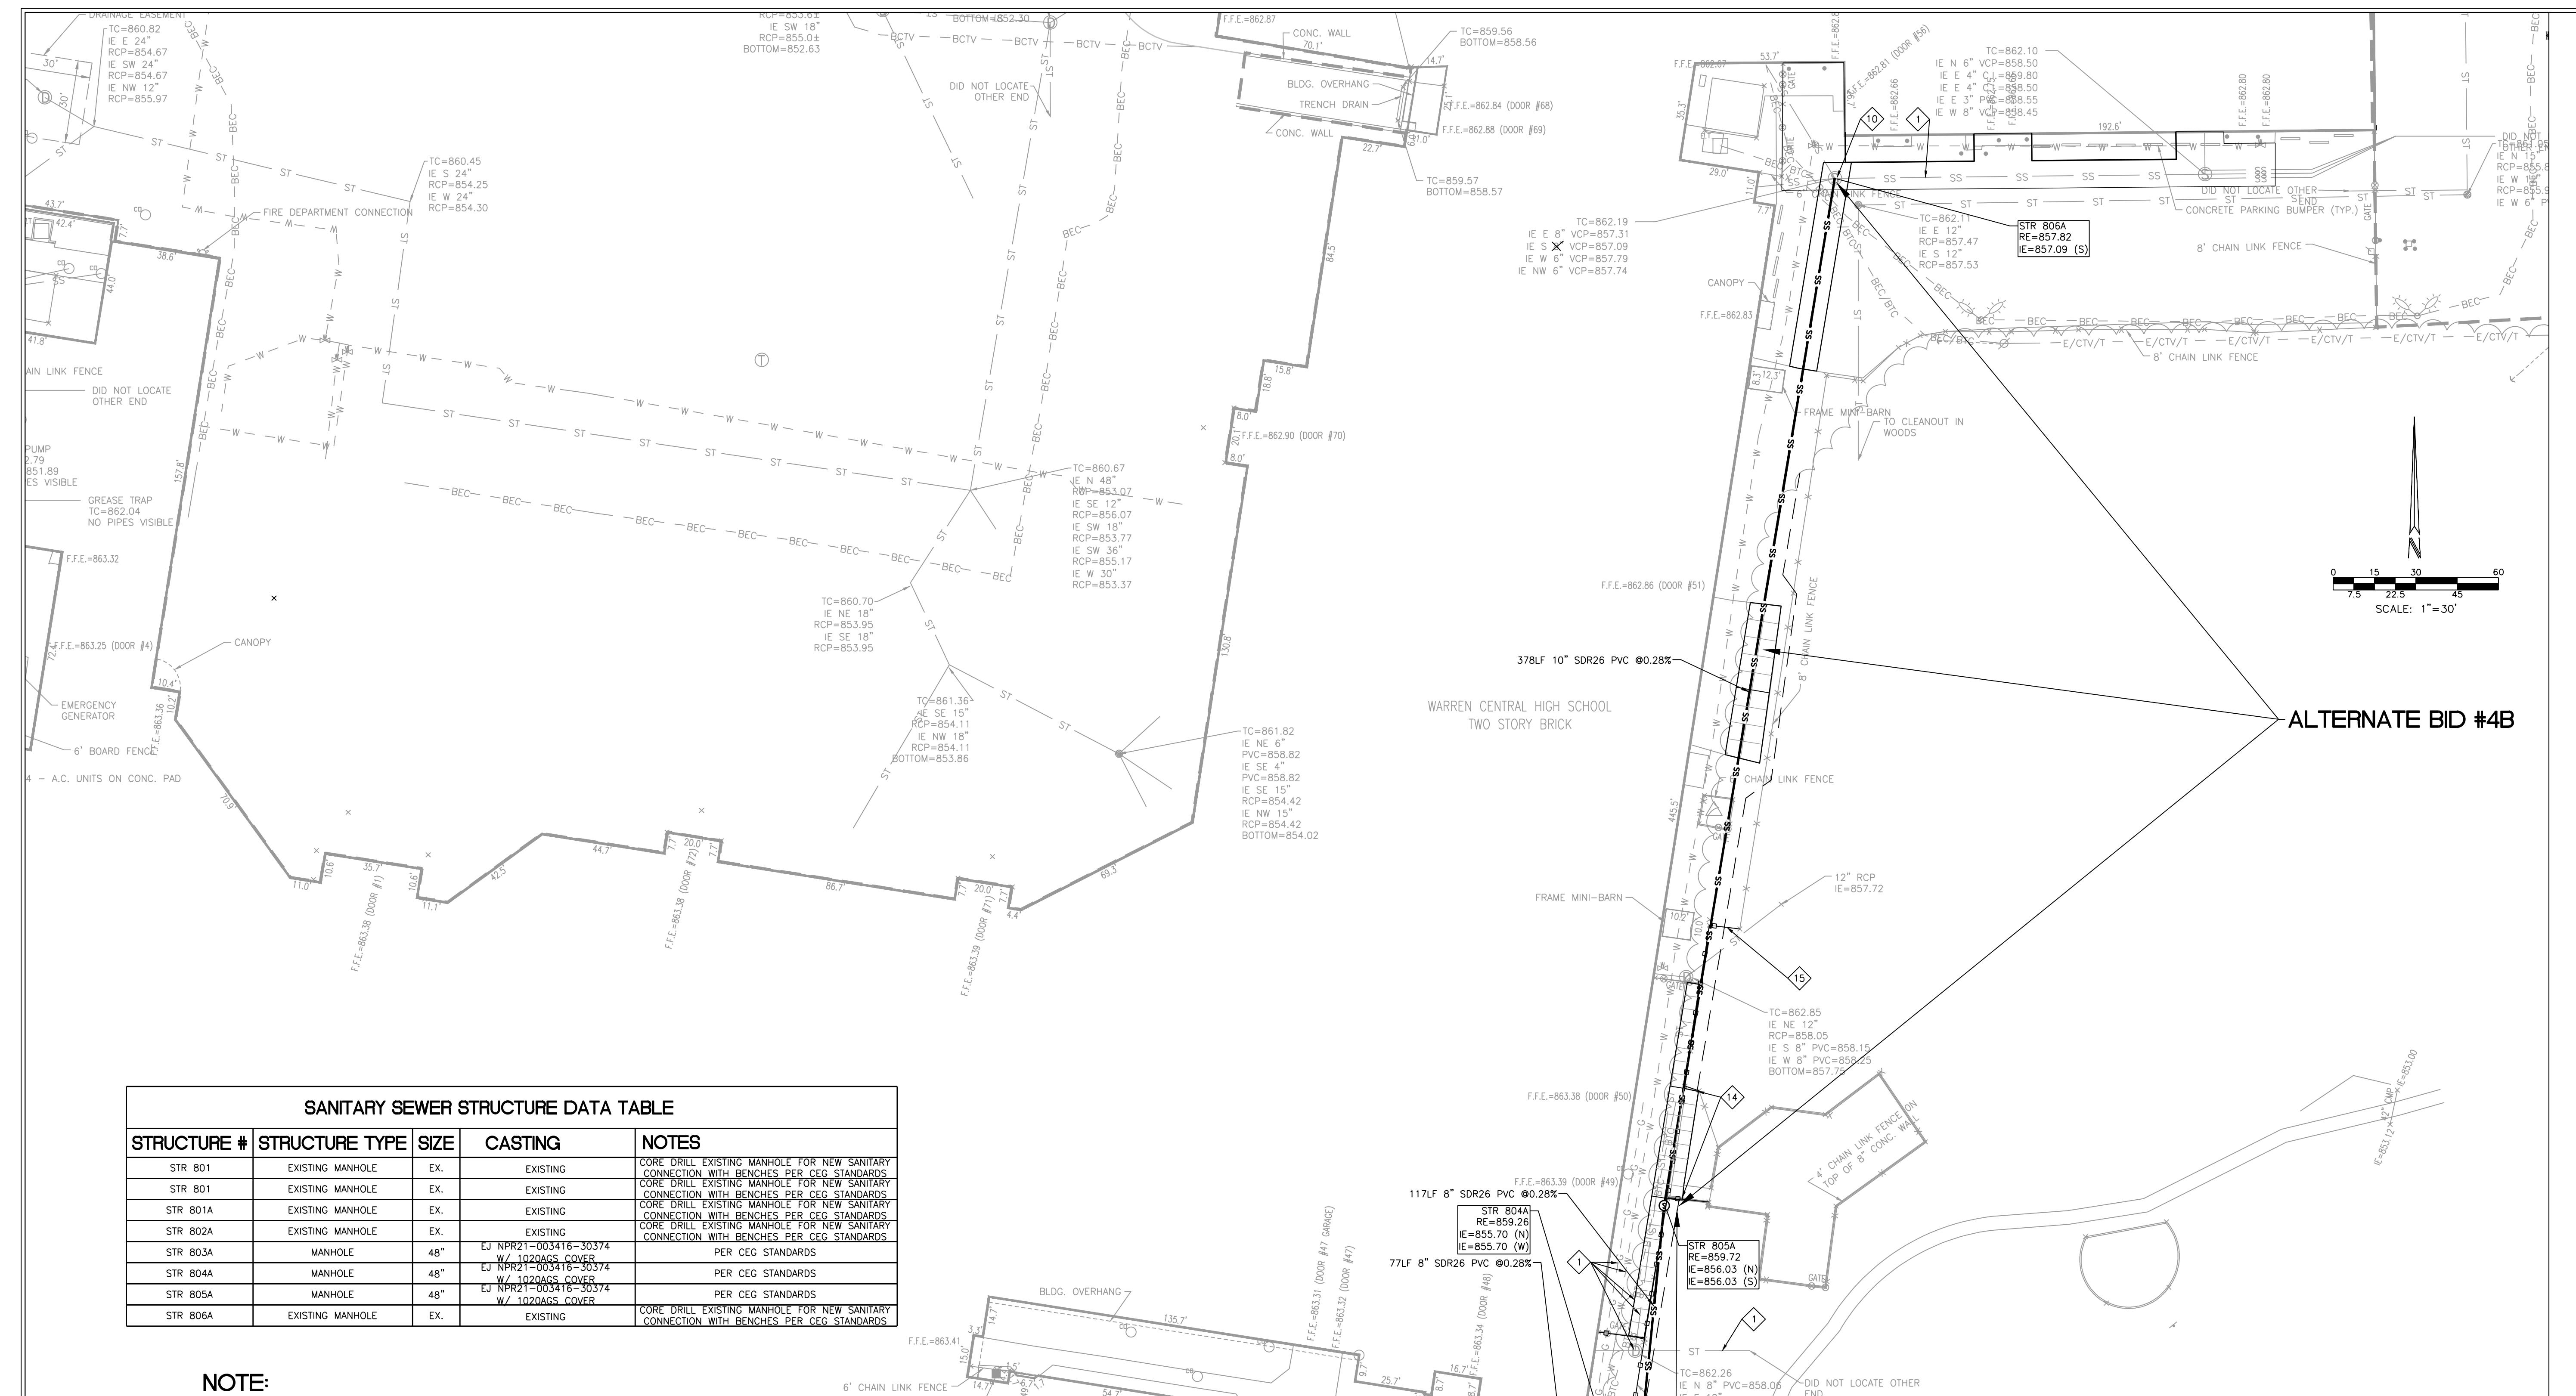

**NOTE:**  
CONTRACTOR TO FIELD VERY THE LOCATION OF  
ALL EXISTING AND PROPOSED SANITARY  
LATERALS FROM THE BUILDING. CONTRACTOR TO  
CONNECT ALL LATERALS TO THE PROPOSED  
SEWER RESPECTIVELY TO THE SEWER LOCATION.

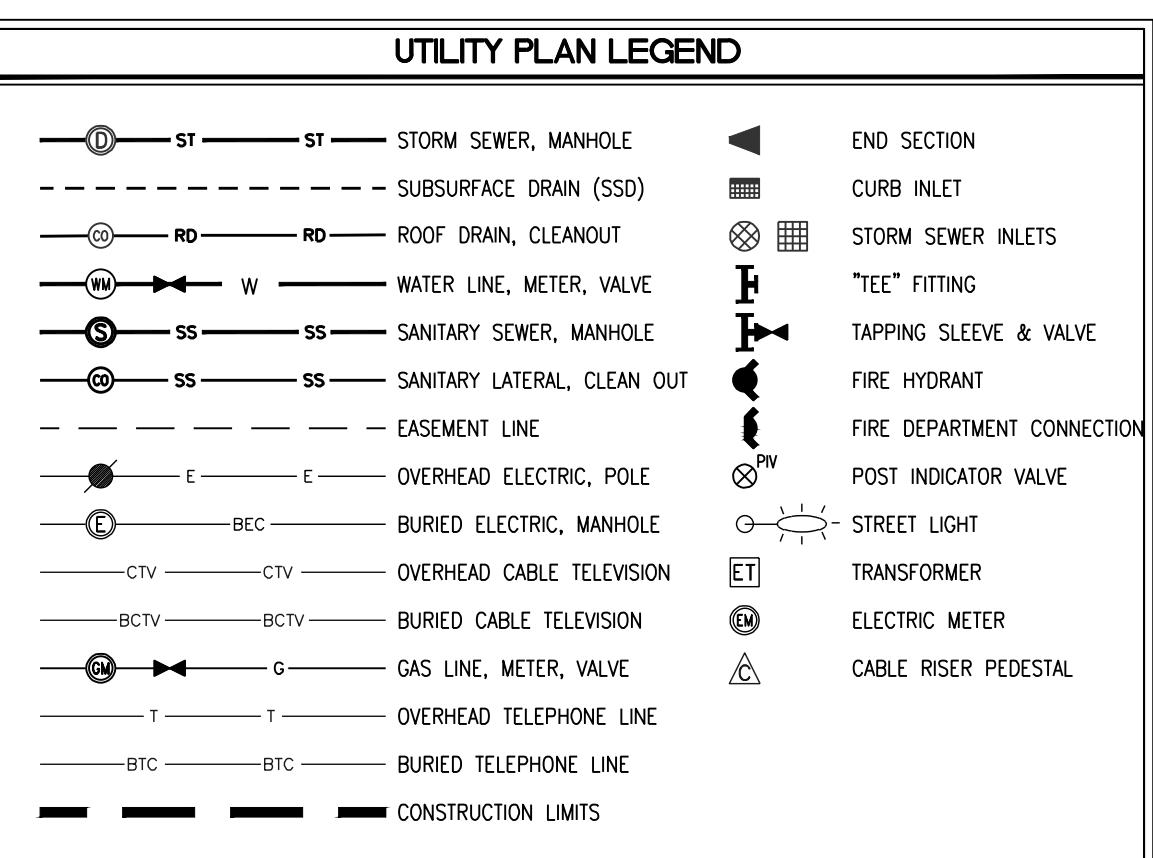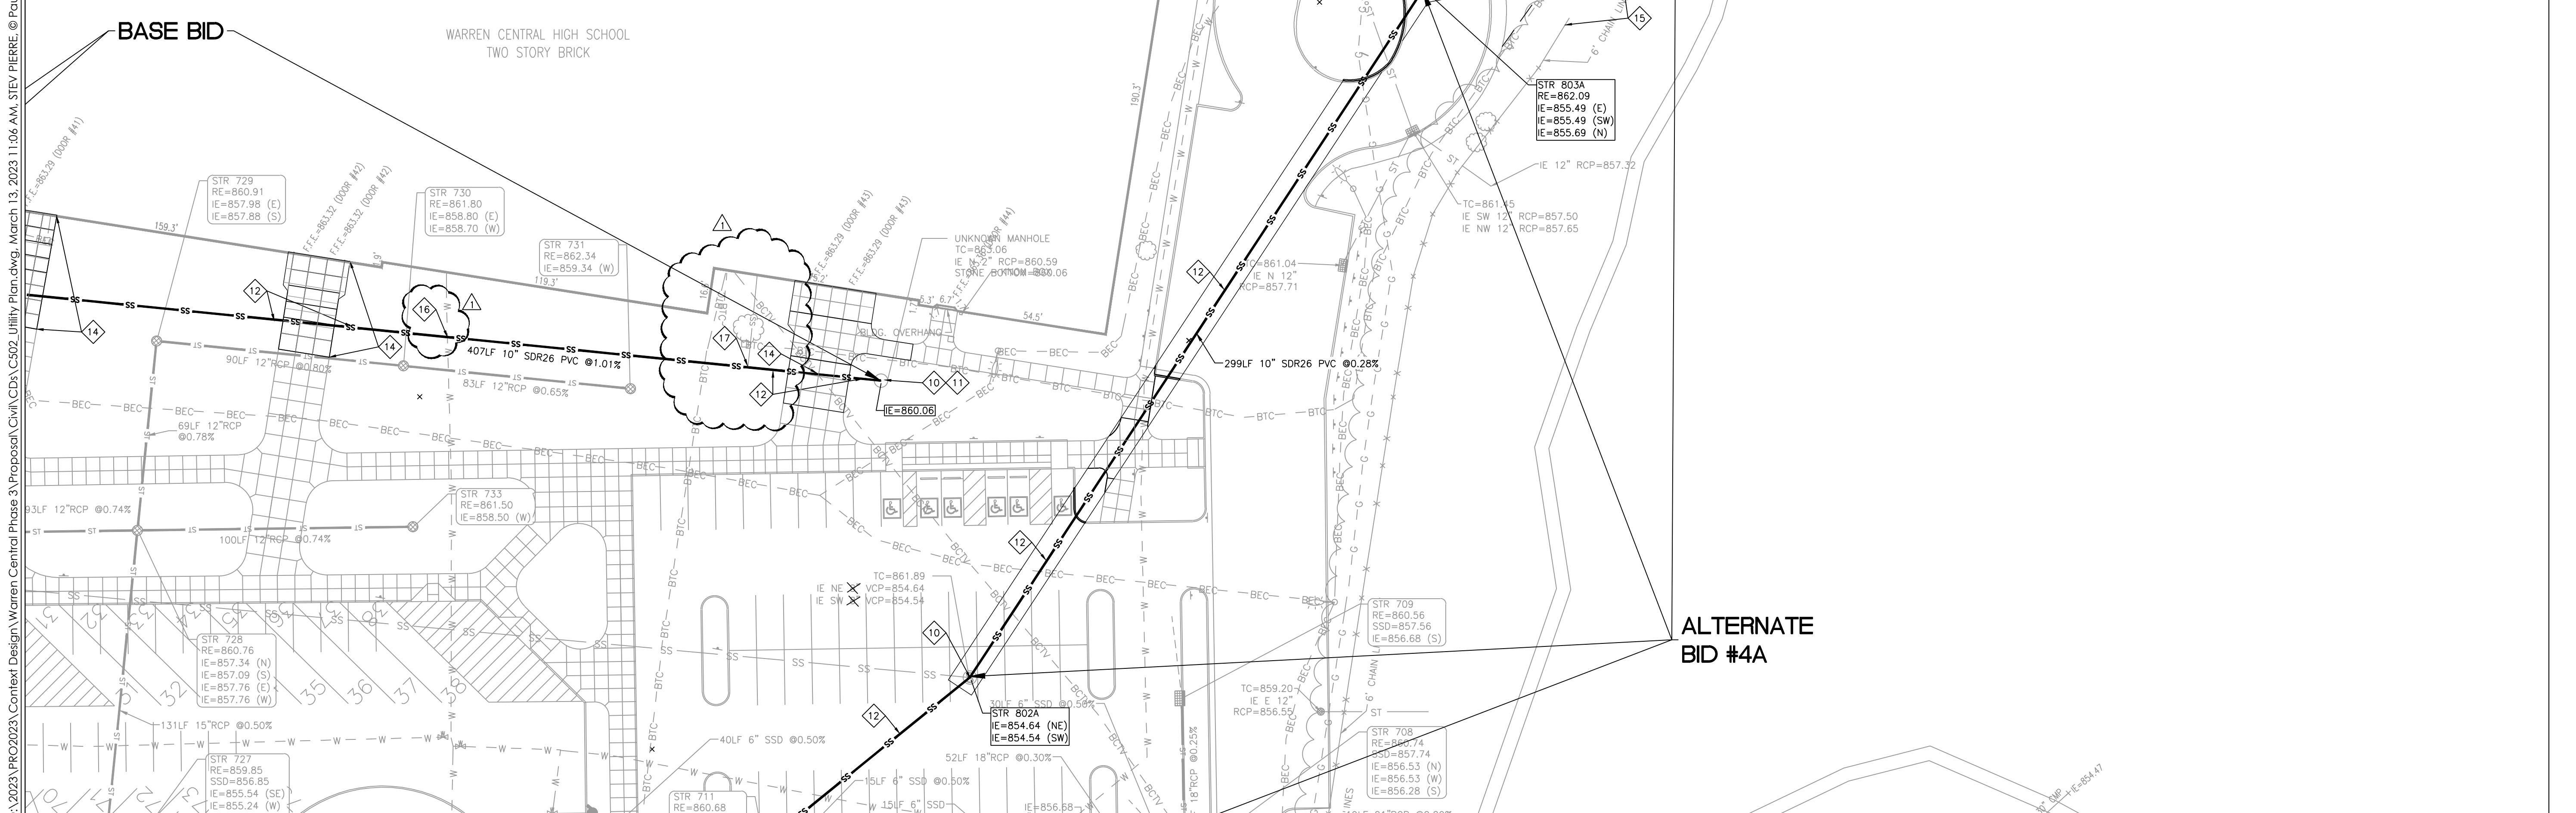

## UTILITY PLAN NOTES:

MBING PLANS FOR PLUMBING DETAILS TO AREAS FIVE (5) FEET OUTSIDE AND  
D STRUCTURE.

RIFY ALL BUILDING LATERALS WITH PLUMBING DRAWINGS PRIOR TO  
R TO VERIFY BUILDING CONNECTION LOCATIONS AND ELEVATIONS WITH MEP AND  
RIOR TO CONSTRUCTION.

NS ARE APPROXIMATE. THE CONTRACTOR SHALL DETERMINE AND FIELD VERIFY  
RTICAL LOCATIONS PRIOR TO COMMENCEMENT OF CONSTRUCTION.

LL INDICATE THE ELEVATION THAT WATER WOULD ENTER THE GRATE FOR ALL  
AS SOLID LID, THE RE IS THE LID ELEVATION.

SINGS AND SEPARATIONS SHALL BE IN ACCORDANCE WITH "TEN STATE  
CODES.

UT THE PROJECT SHALL BE INSTALLED WITH AT LEAST 54 INCHES OF COVER TO  
OM FREEZING.

ALL BEAR THE NSF SEAL OF APPROVAL AND MEET COMMERCIAL STANDARD NO.  
ARD 22-70, OR ASTM D 2441.

I (SSD) SHALL BE 6" PERFORATED DUAL WALL HDPE UNLESS NOTED

B-SURFACE DRAIN (SSD) AT STRUCTURE TO BE THREE (3) FEET BELOW RIM

CONFLICTS WHICH BECOME APPARENT BEFORE OR DURING CONSTRUCTION SHALL  
ENTION OF THE ENGINEER OF RECORD IMMEDIATELY SO THAT CLARIFICATION OR

E MADE TO EXISTING MANHOLES OR INLET STRUCTURES, THOSE STRUCTURES  
OR REPLACED TO THOSE MINIMUM STANDARDS OUTLINED IN CHAPTERS 400  
F INDIANAPOLIS STORMWATER SPECIFICATIONS MANUAL, LATEST EDITION. THE  
INCLUDE THE INSTALLATION OF BENCH WALLS, AS WELL AS PRESCRIBED MEASURES  
ENTIAL FOR MIGRATION OF BACKFILL MATERIALS INTO THE STORMWATER SYSTEM.

S, MANHOLES, AND CATCH BASIN GRATES SHALL BE ADJUSTED TO NEW FINISH


IN PAVED AREAS SHALL BE TRAFFIC BEARING AND SHALL BE FLUSH WITH

EXISTING PRIVATELY-OWNED SANITARY MAIN AND/OR MANHOLES MAY BE  
EFFECTS IN EXISTING PRIVATELY-OWNED SANITARY MAINS AND/OR MANHOLES  
RE A LATERAL NEW CONNECTION PERMIT CAN BE ISSUED. DEFECTS MAY  
BLOCKAGE, STRUCTURAL DAMAGE, GREASE, INFILTRATION, VEGETATION ROOTS AND  
C. CCTV CAMERA INVESTIGATION OF THE EXISTING SANITARY FEATURES IS  
INVESTIGATION INDICATES THAT REPAIRS AND/OR A STRUCTURAL LINER ARE  
S MUST BE SUBMITTED WITH A SEPARATE "REPAIR" OR "REPAIR-LINER" LATERAL  
MANHOLE REPAIR PLAN MUST SHOW THE PROPOSED INTERNAL DROP CONNECTION  
PROPOSED REPAIRS AND MANHOLE LINERS ARE EVALUATED ON A  
LEASE BE SURE TO INCLUDE THE LINING MATERIAL, CURING METHOD AND THE  
CONTACT AND PRODUCT INFORMATION. PLEASE NOTE THAT STYRENE LINERS ARE

CTIONS FOR SHALLOW SEWERS, PLEASE NOTE THAT LATERAL CONNECTS TO  
AL WITH WATERTIGHT PLUG FOR FUTURE CONNECTION.  
TOP OF THE LATERAL FROM THE BUILDING CLEANOUT TO THE DOWNSTREAM

## KEYNOTE LEGEND

---

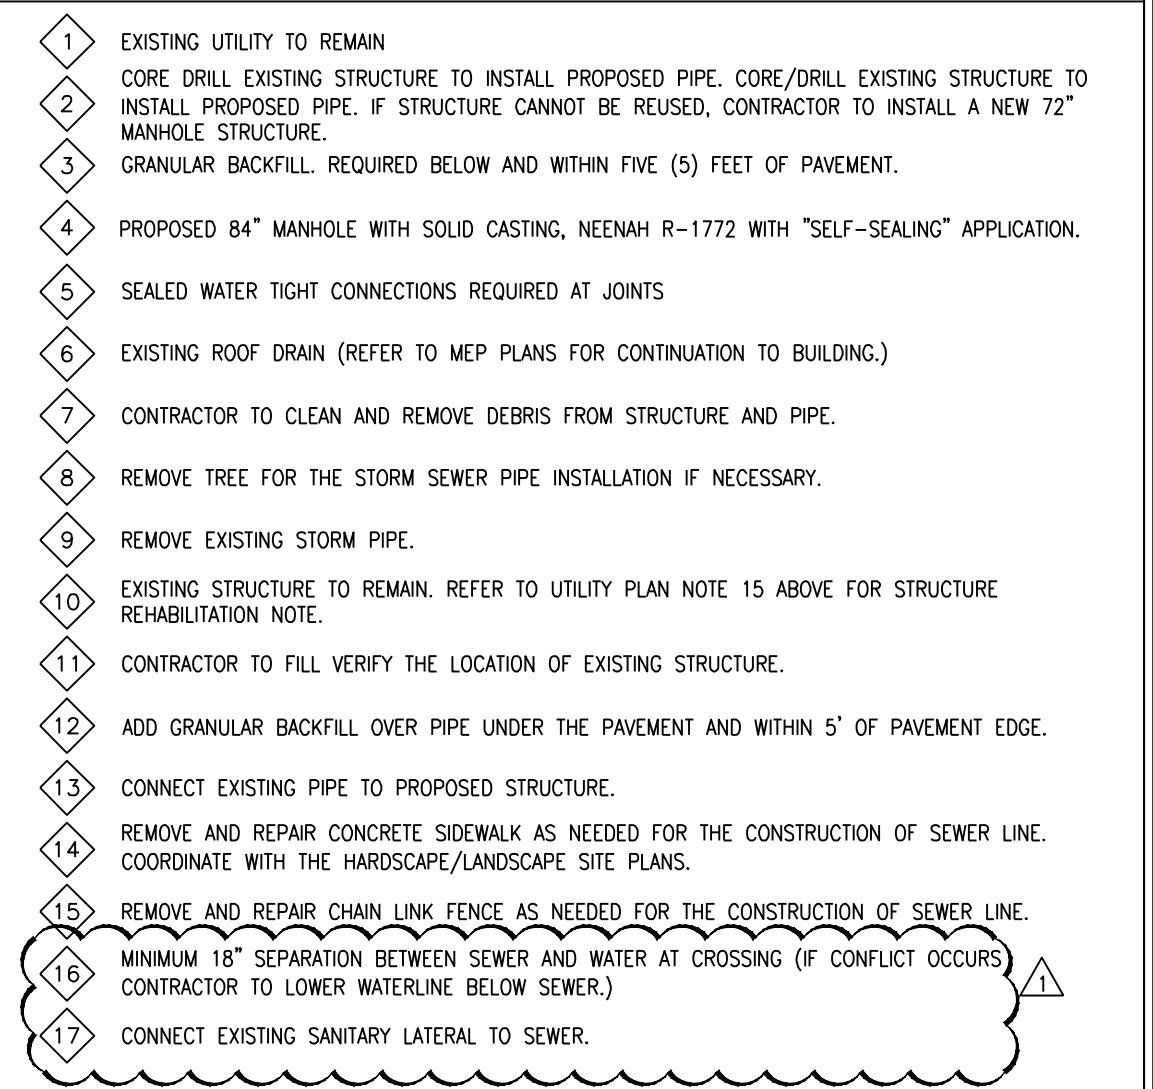

**PROJECT:**  
**MSD OF WARREN TOWNSHIP**  
**WARREN CENTRAL HIGH SCHOOL**  
**PHASE 3 RENOVATION & ADDITION**

**REVISIONS:**

<b>ISSUE DATE</b>	<b>DRAWN BY</b>	<b>CHECKED BY</b>
<b>02-17-2023</b>	<b>S. PIERRE</b>	<b>S. PIERRE</b>

**DRAWING TITLE:**

The image shows a circular registration stamp. At the top, it says "CERTIFIED BY:" followed by a handwritten signature. The center of the circle contains the text "STEV PIERRE" and "REGISTERED". Below that is the number "No. PE11600721". The bottom half of the circle contains "STATE OF" and "INDIANA". The outer ring of the circle has "PROFESSIONAL ENGINEER" written around it. At the bottom of the stamp, the date "03-13-2023" is printed.

C503

PROJECT NUMBER  
**18142**  
SPINE N. 10001



SS CSO

8831 Keystone Crossing, Indianapolis, IN 46240  
317.248.3900 | cso@csosoftware.com

context  
DESIGN

5825 Loxley Loop E.D. | Indianapolis, IN 46216  
317.485.6900 | www.context-design.com

PROJECT:  
MSD OF WARREN TOWNSHIP  
WARREN CENTRAL HIGH SCHOOL  
PHASE 3 RENOVATION & ADDITION  
9500 EAST 16th STREET, INDIANAPOLIS, IN 46229

SCOPE DRAWINGS  
These scope drawings are issued in support of the project in terms of architectural design, concept, the dimensions of the project, and the description of the work required for the full performance and completion of the project. They are not to be construed as the final description of the work required for the full performance and completion of the project. The final description of the work required for the full performance and completion of the project will be contained in the final contract documents.

REVISIONS:  
Addendum 02 03-13-23



ISSUE DATE: 2023-02-17  
DRAWN BY: AMJ  
CHECKED BY: CCH

DRAWING TITLE:  
TREE  
PROTECTION  
PLAN

CERTIFIED BY:  
REEDIE J. PIAZZA, RA  
REGISTERED  
No. 2020-0052  
STATE OF  
INDIANA  
ARCHITECT  
EXPIRES 12-31-2021

DRAWING NUMBER  
LD001

PROJECT NUMBER  
2021056

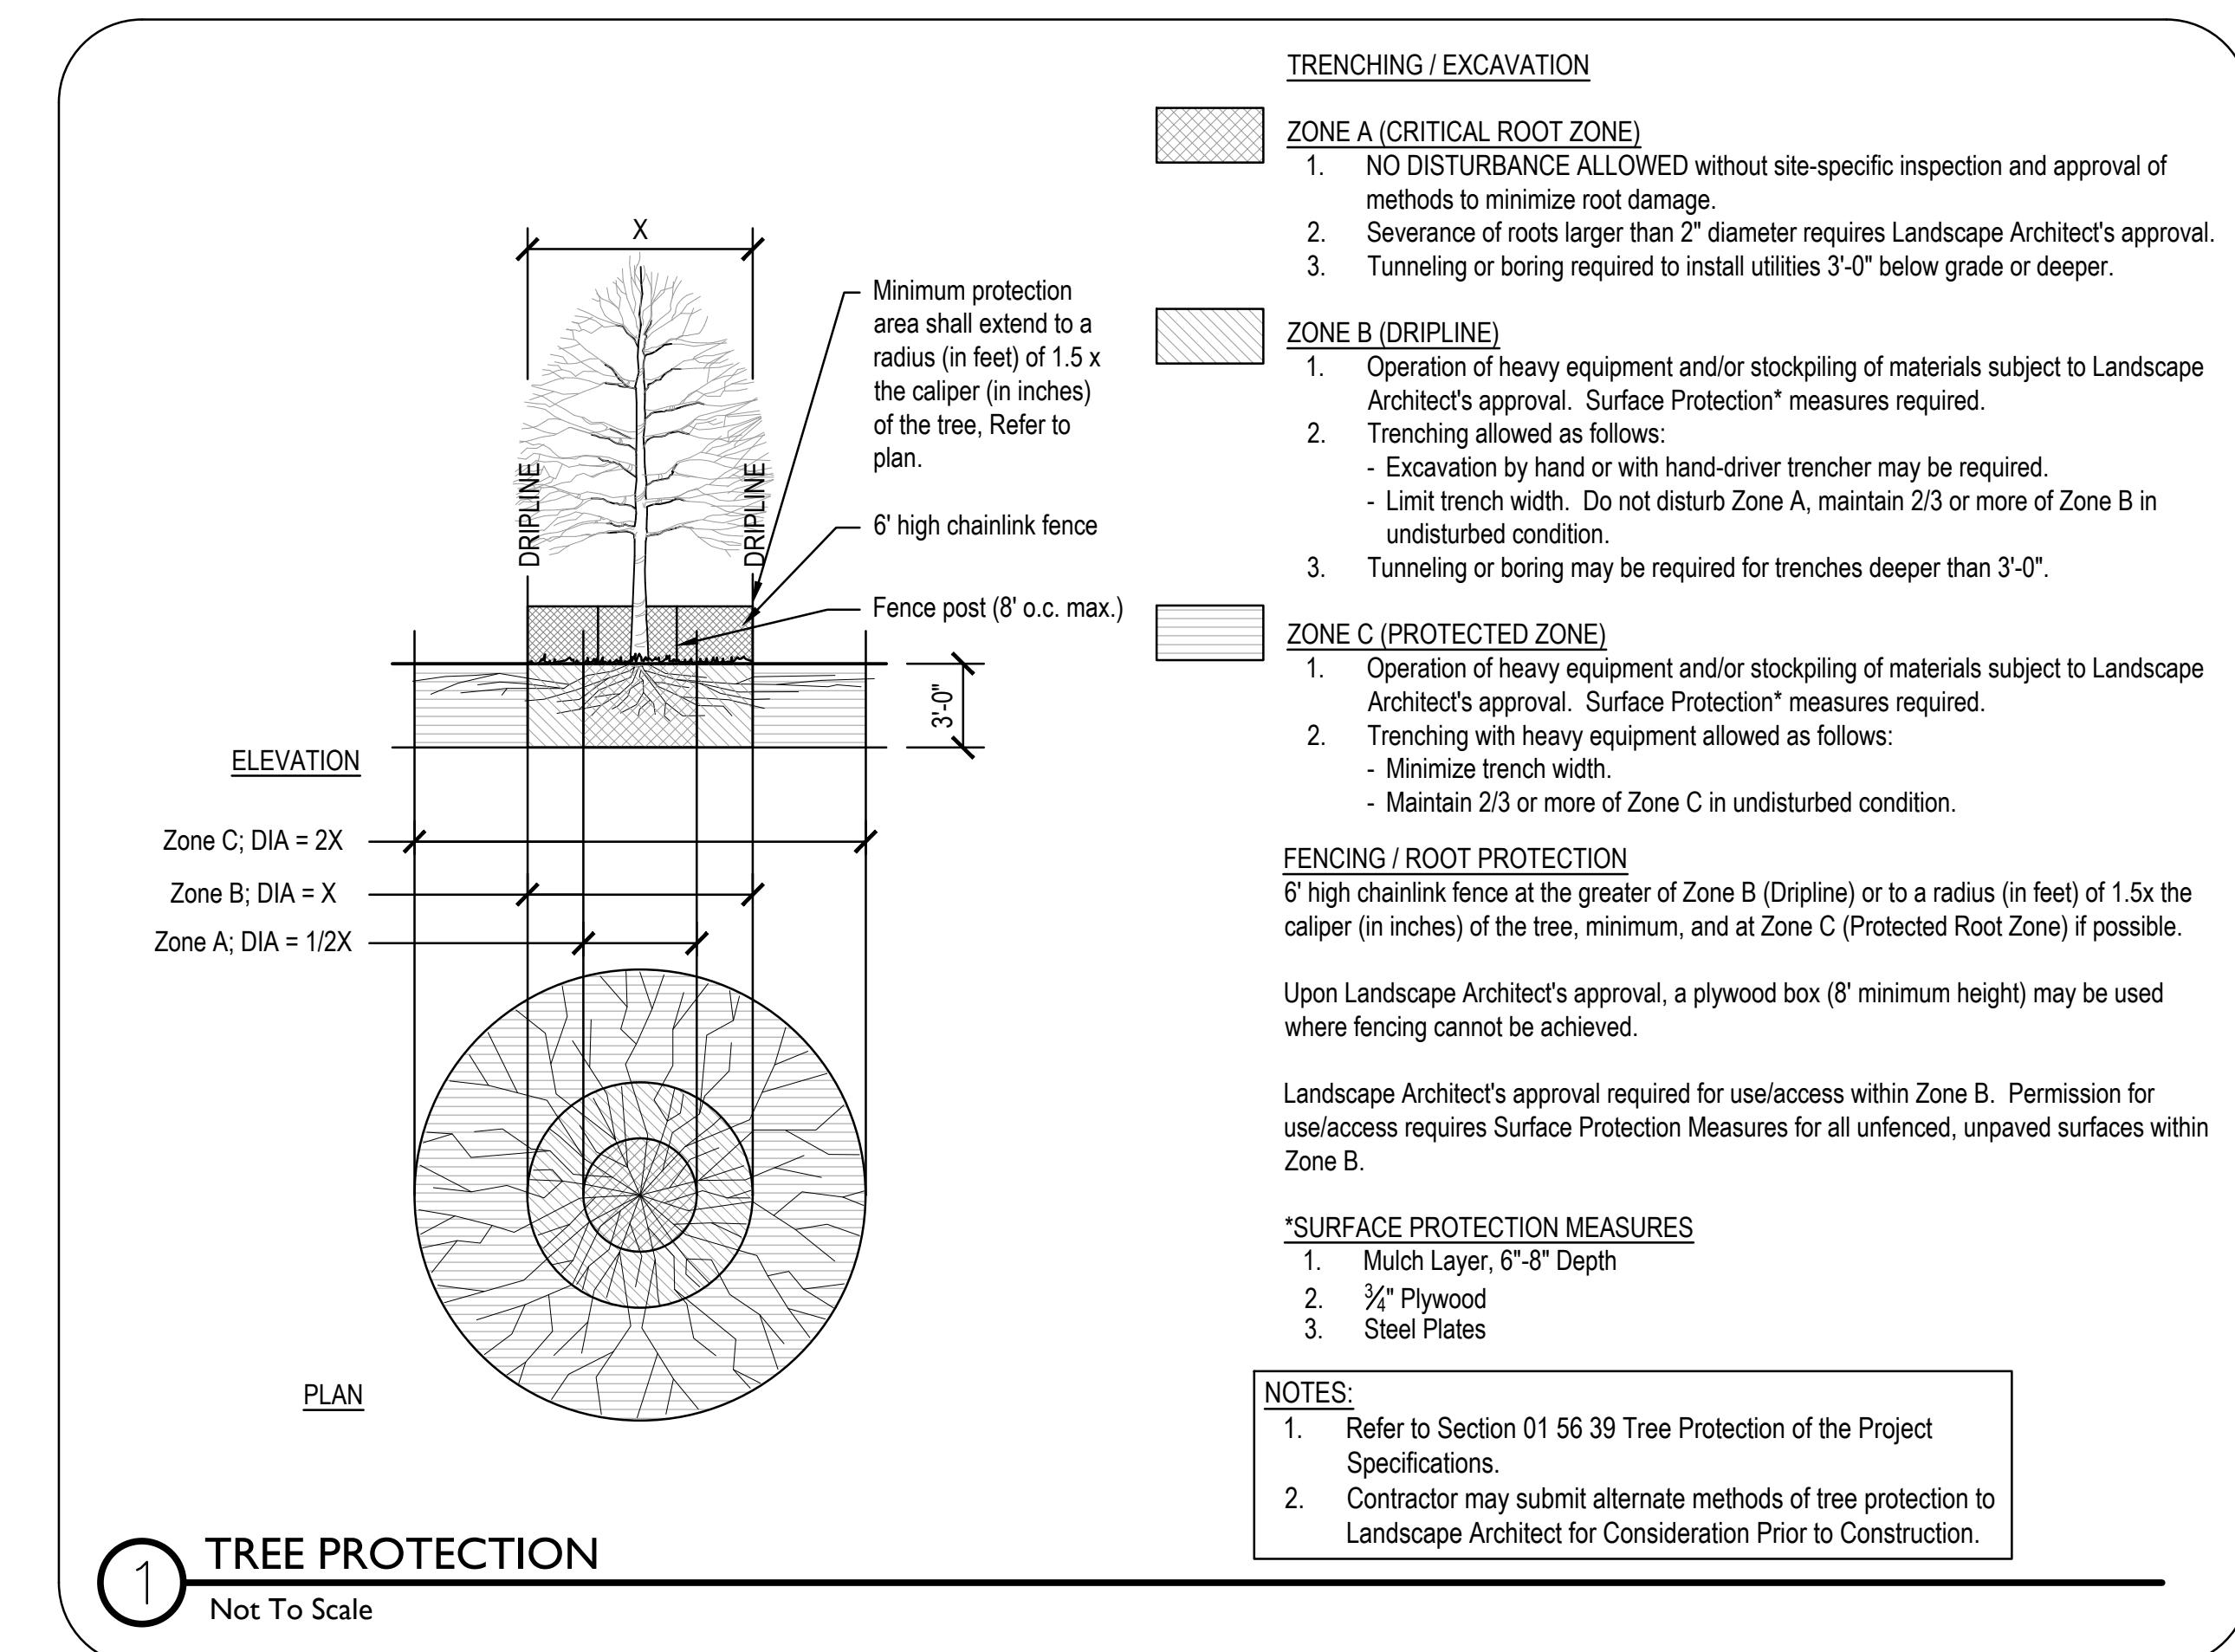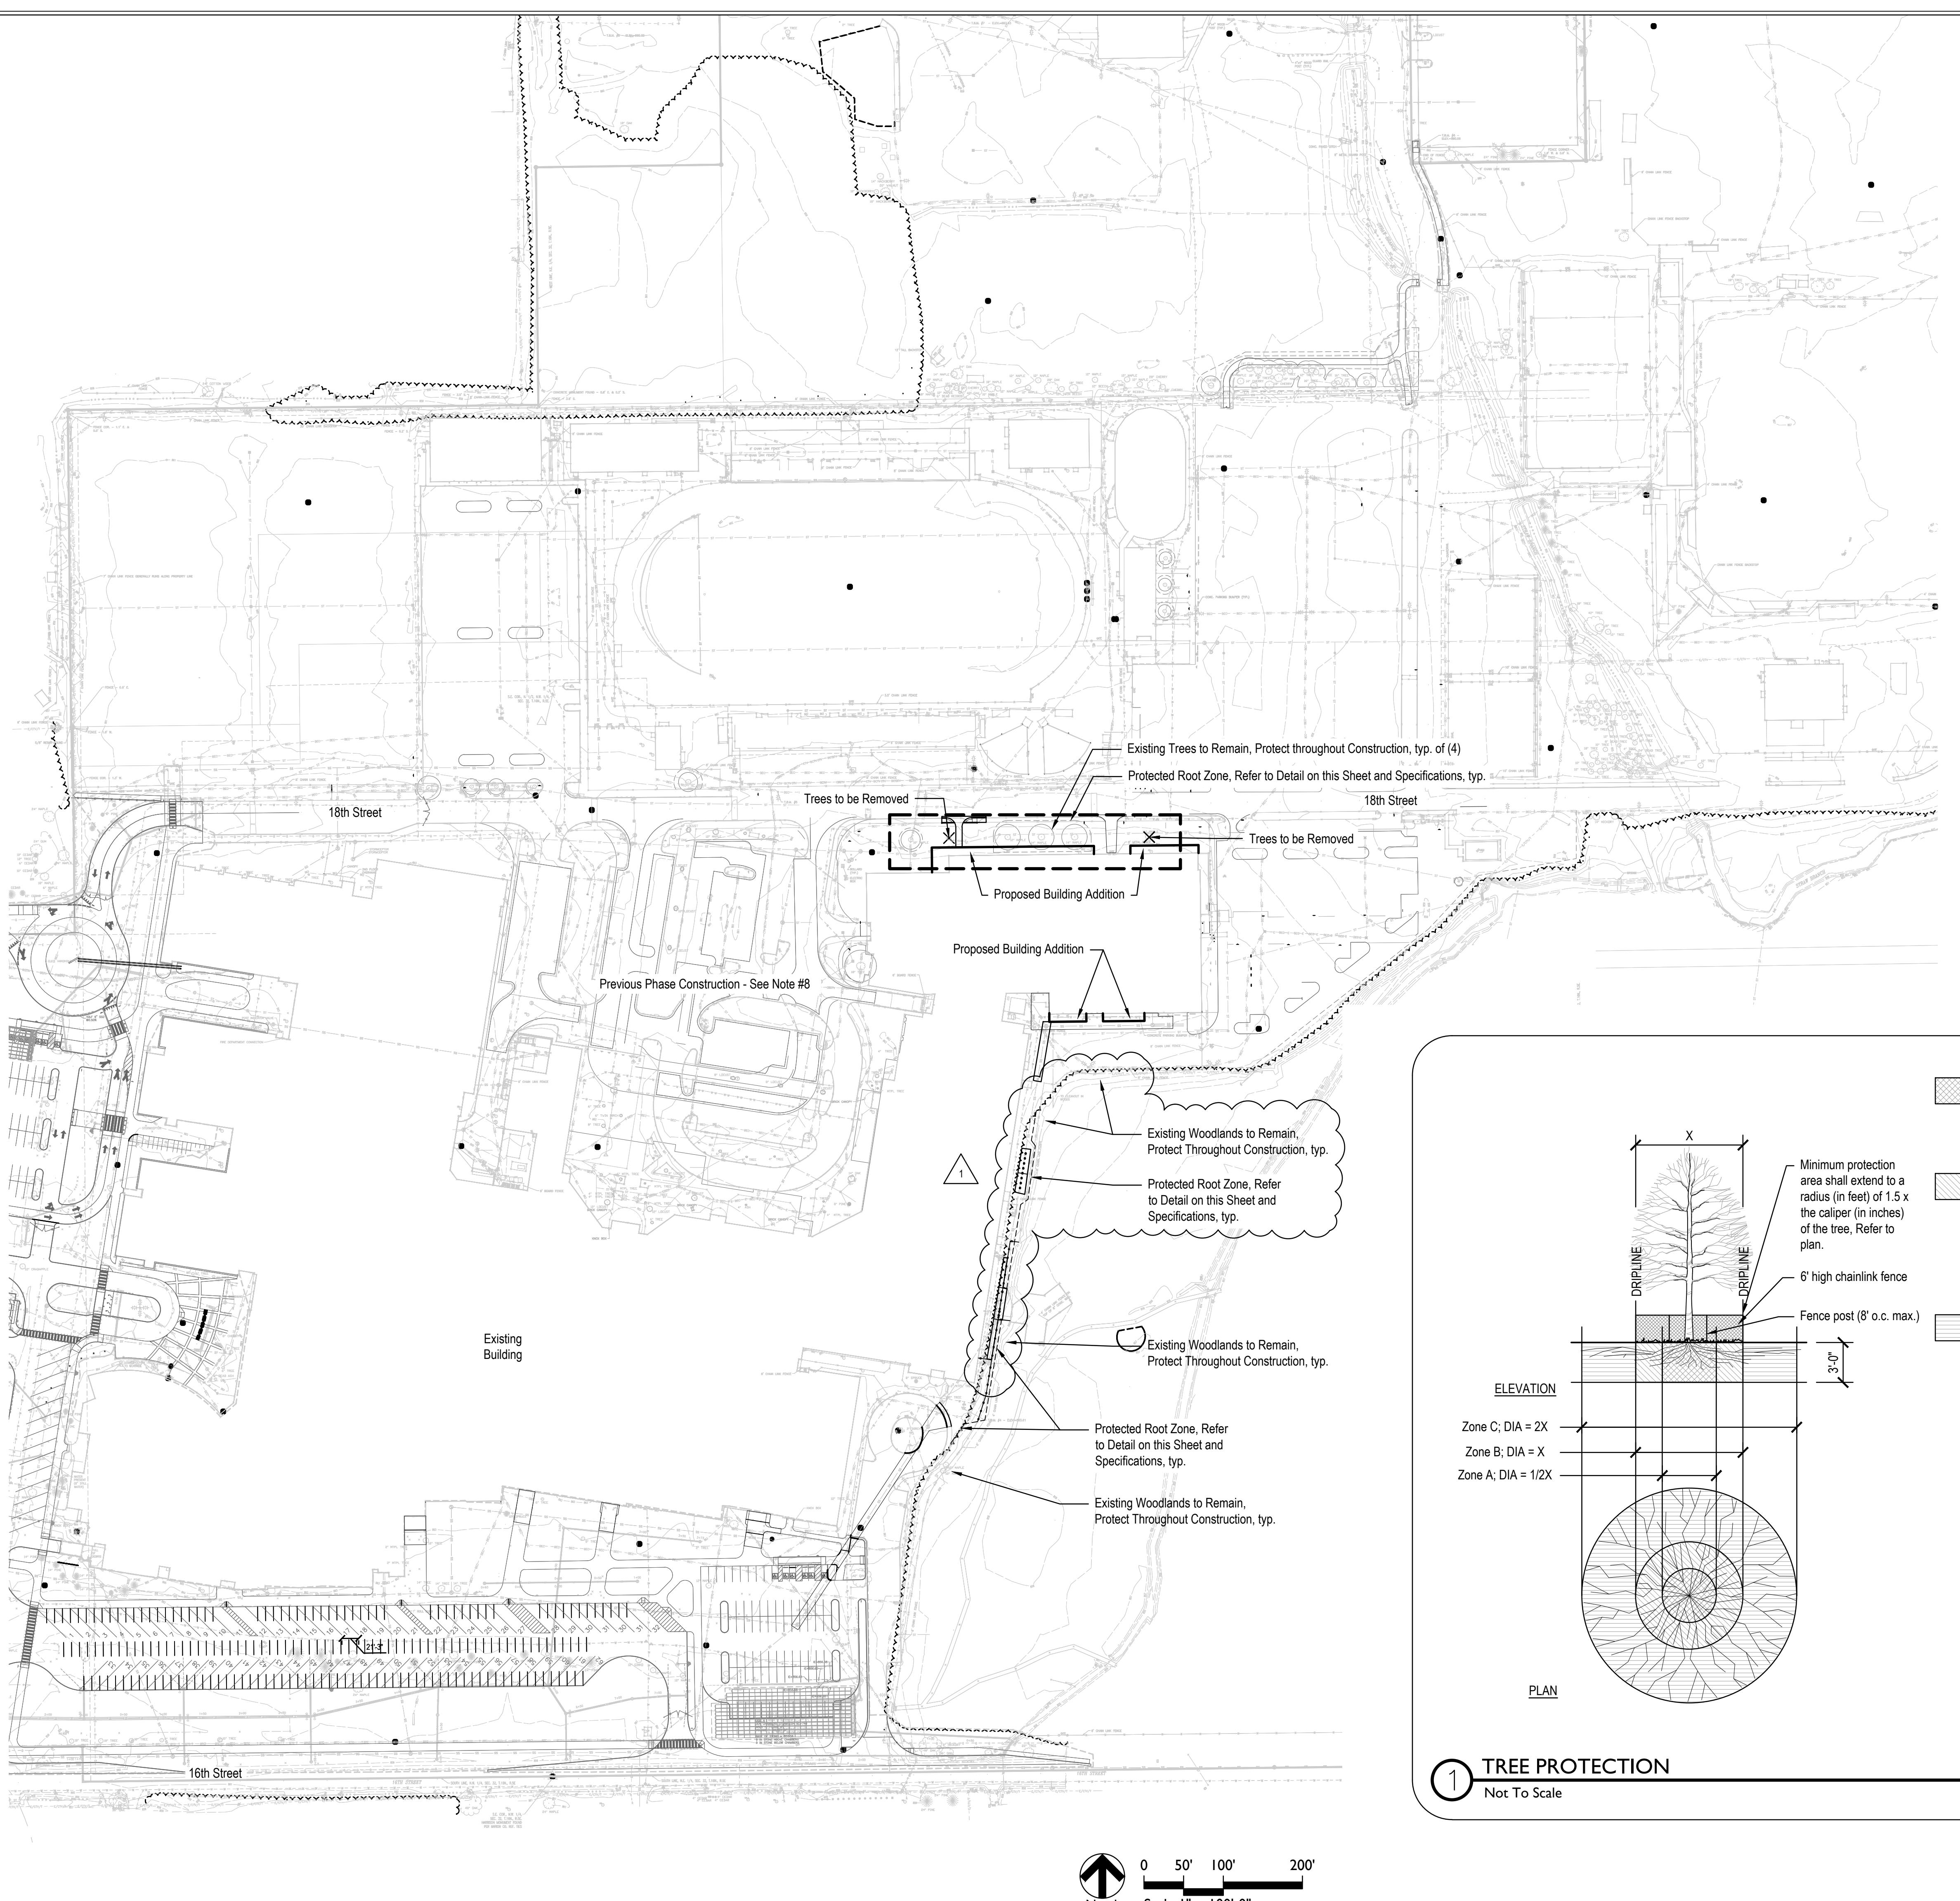

## TREE PROTECTION GENERAL NOTES

1. Underground utilities, if shown, are based on above ground indications and construction drawings on file with the Owner. There is no guarantee that all underground utilities in service or abandoned as shown. Underground utilities are shown as accurately as possible but still may not be exact. No physical underground utility locations were made.
2. Tree Protection Fencing locations are fixed. Install per plans and details. Any adjustments to fencing locations must be approved by the Landscape Architect and the Owner. Damages will be assessed if tree protection fence location is adjusted without approval of the Landscape Architect and the Owner. Fence location deviations shall be corrected immediately at no additional cost to the Owner.
3. All tree pruning and limb restraint will be performed under the direct supervision of a Certified Arborist. Contractor shall not prune trees or restrain limbs.
4. No staging, equipment, material storage, or vehicles are allowed on non-paved areas unless indicated otherwise on plan.
5. Abandon all utilities to be removed when located within a Protected Root Zone.
6. Backfill all depressed and void areas with top soil following removal of vegetation. Soil shall be free of debris. Compact soils to ensure settling and sedimentation do not occur.
7. Coordinate locations of Tree Protection Fencing and Construction Fencing prior to the start of construction activities. In areas where Tree Protection and Construction Fences overlap, the Contractor may elect to install the more restrictive fence type of the two provided that the single fence accommodates the requirements of both fences.
8. Tree Protection of Site is Specified in Phase 1 and Phase 2 Documents. No Tree Work for Phase 01 and Phase 02 is permitted in Phase 03 Scope.





SS CSO

8831 Keystone Crossing, Indianapolis, IN 46240


317.248.5900 | context.com

context

DESIGN

3625 Loxley Loop P.D., Indianapolis, IN 46216

317.485.6900 | www.context-design.com

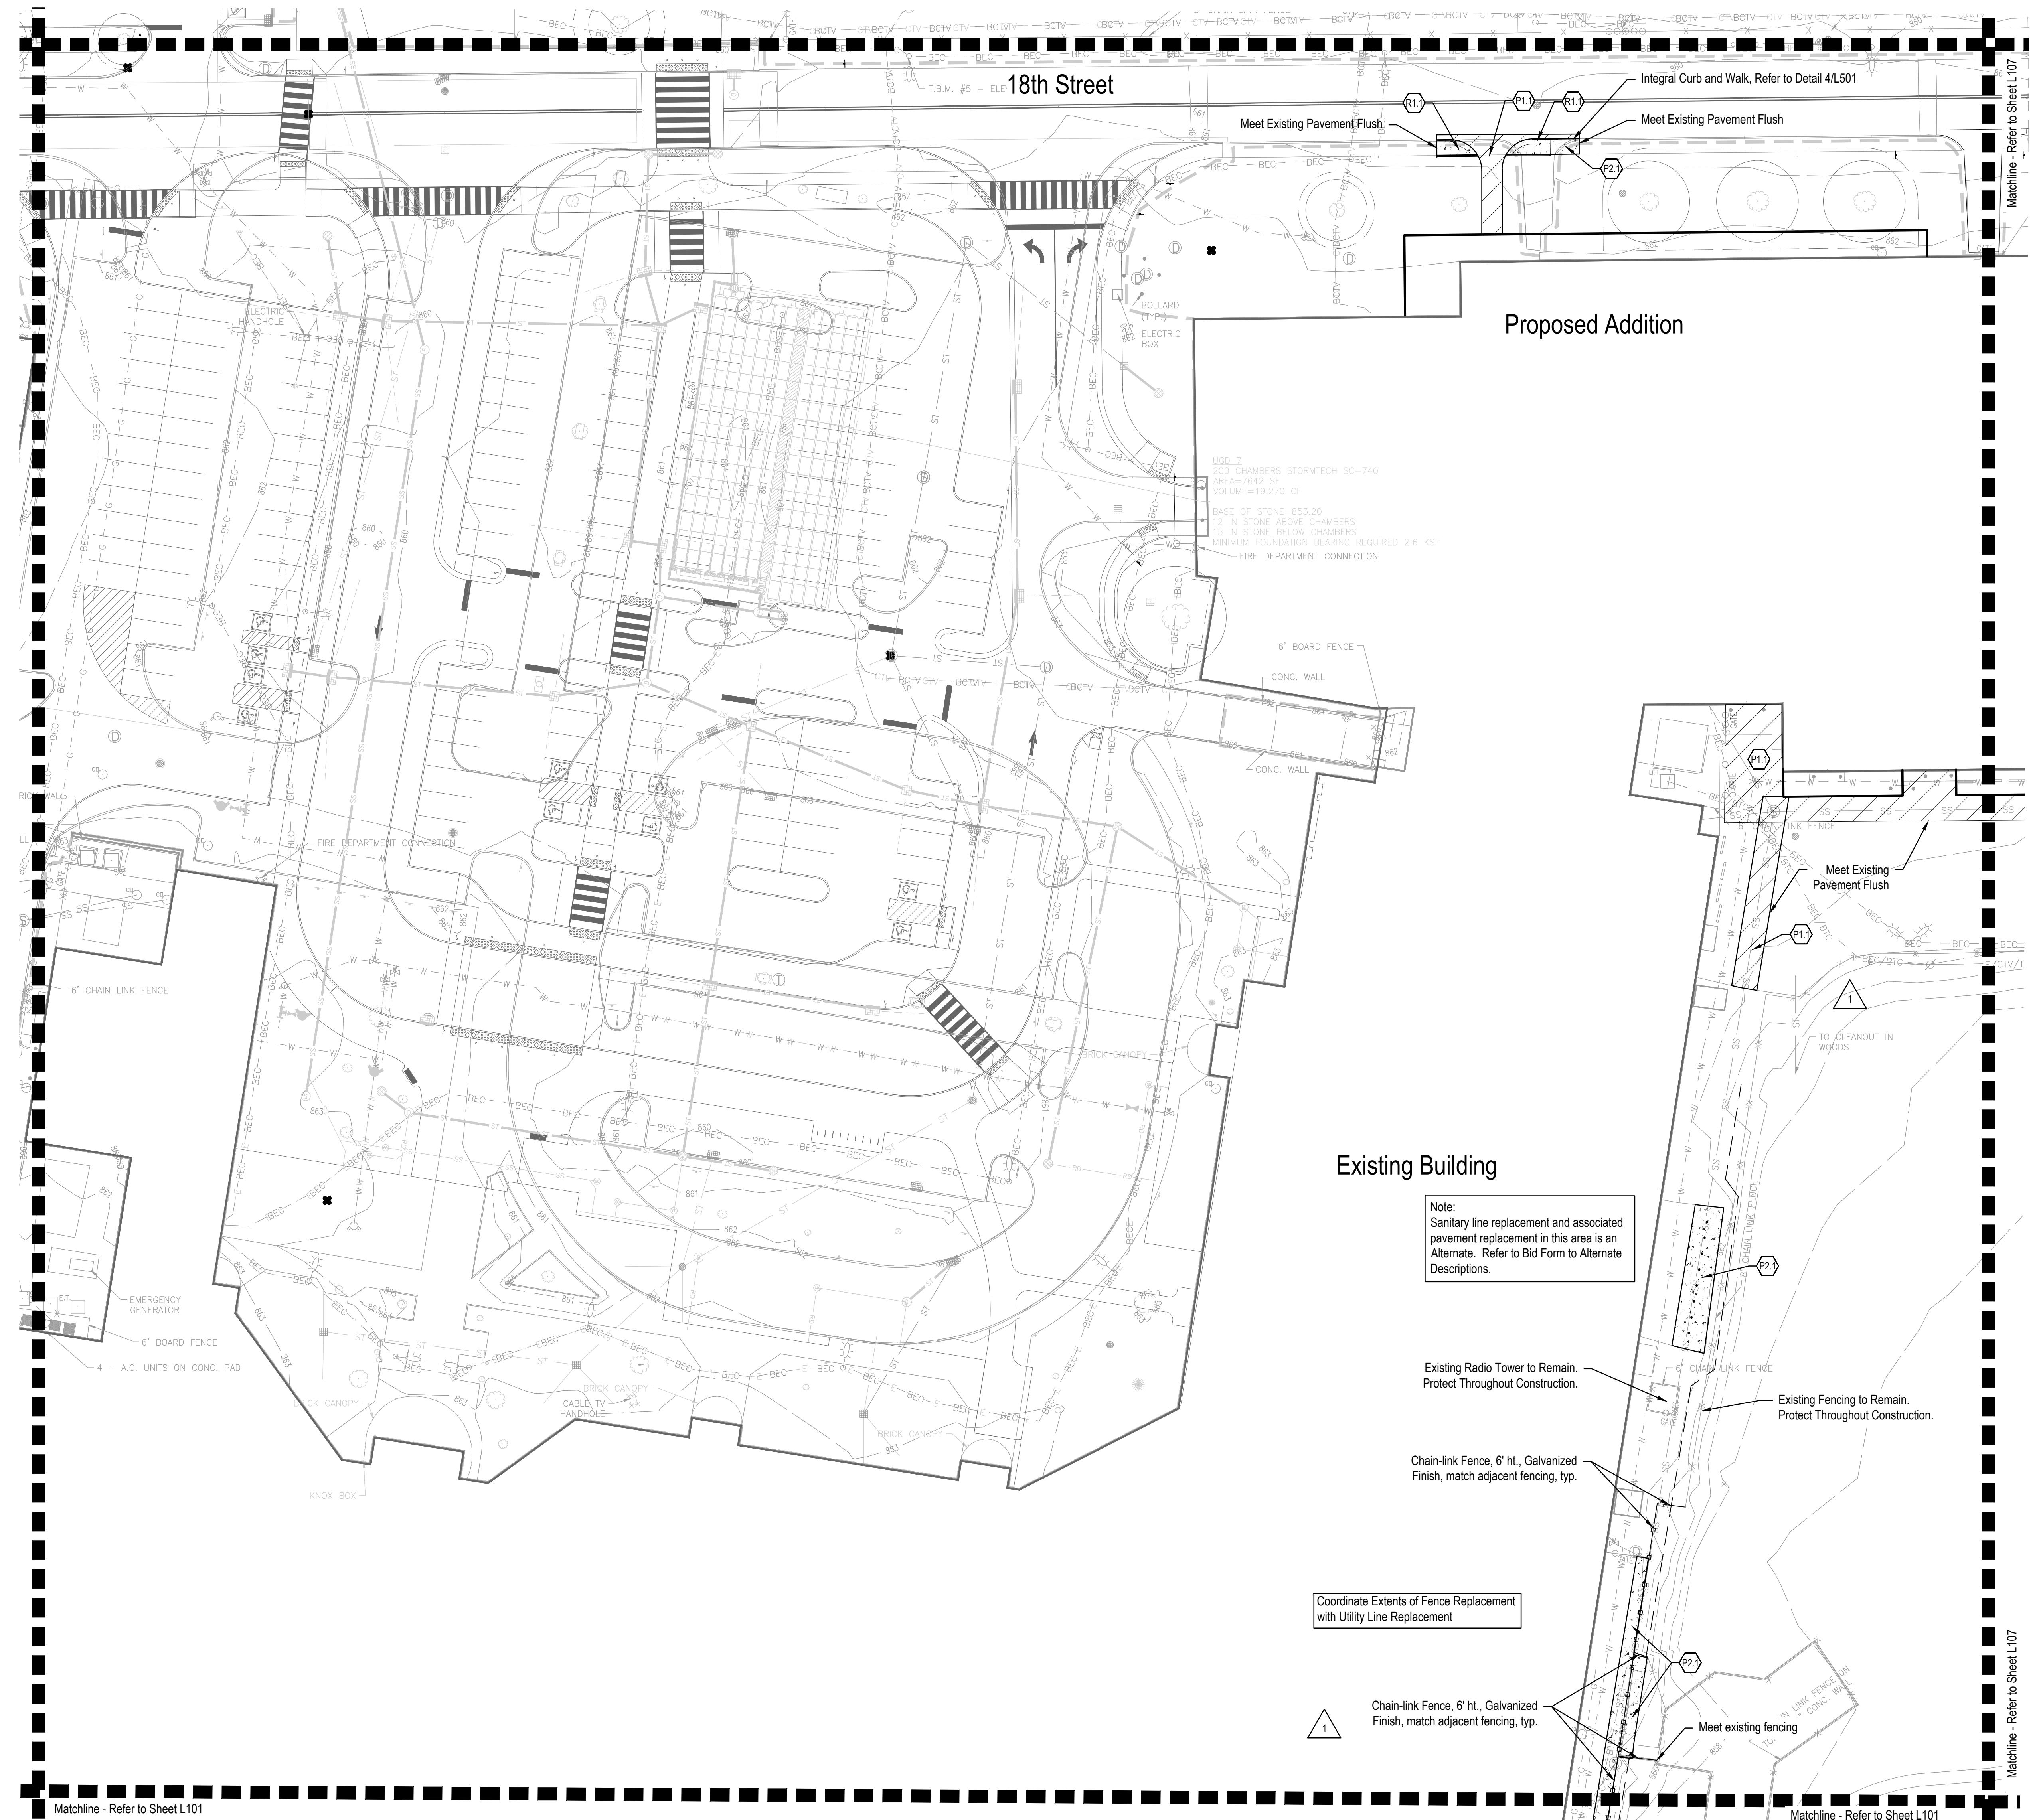



SS CSO

8831 Keystone Crossing, Indianapolis, IN 46240

317-2848-9000 | cso@context.com

context

DESIGN

5825 Landon Loop P.D. | Indianapolis, IN 46216

317-483-6900 | www.context-design.com

PROJECT:  
MSD OF WARREN TOWNSHIP  
WARREN CENTRAL HIGH SCHOOL  
PHASE 3 RENOVATION & ADDITION  
9500 EAST 16th STREET, INDIANAPOLIS, IN 46229

SCOPE DRAWINGS

These scope drawings are a part of the architectural design concept, the dimensions of the property, and the location of the building. They are intended to provide a general description of the work required for the full performance and completion of the project. They are not to be used for the final layout or description of the work.

REVISIONS:

Addendum 02 03-13-23

ISSUE DATE: 2023-02-17

DRAWN BY: AMJ

CHECKED BY: CCH


DRAWING TITLE:  
PLANTING  
PLAN

CERTIFIED BY:



DRAWING NUMBER  
L201

PROJECT NUMBER  
2021056

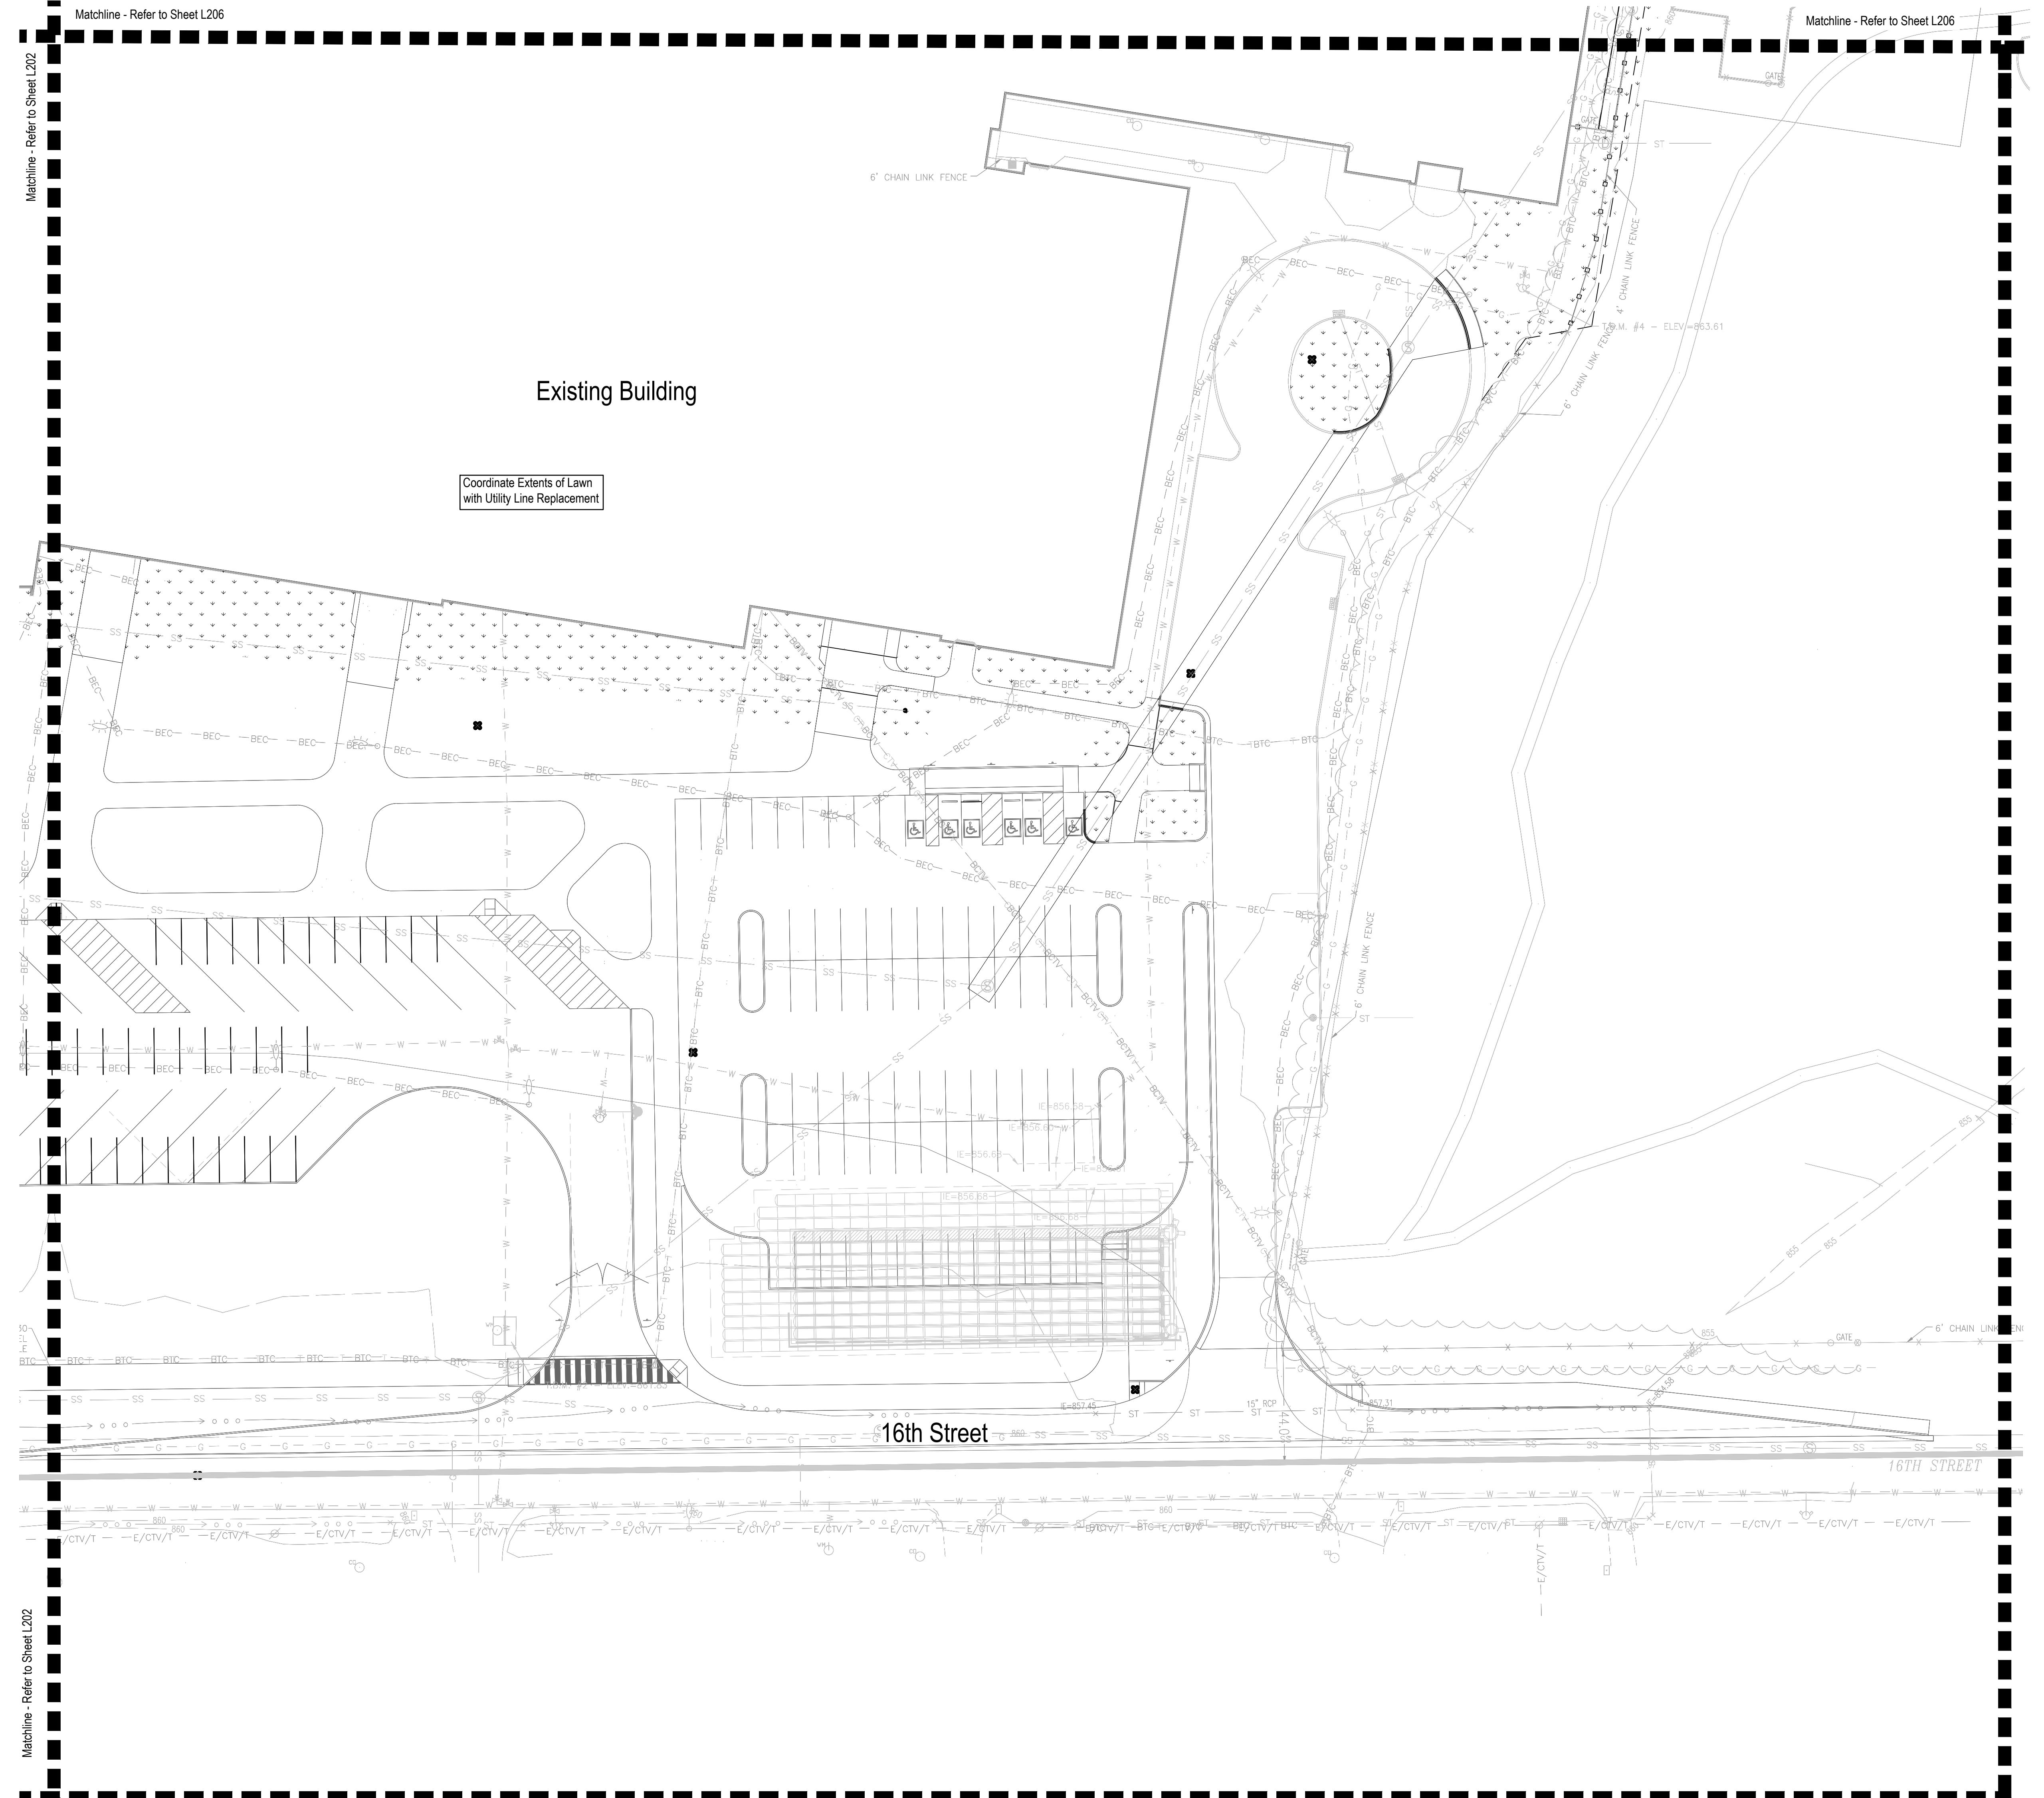

## GENERAL LANDSCAPE AND PLANTING NOTES

- Refer to Project Manual for Planting Specifications and Topsoil requirements. Refer to Plant Schedule and Planting Details for additional information.
- All materials are subject to the approval of the Landscape Architect and Owner at any time. Landscape Architect to inspect all plant locations and plant bed conditions prior to installation. On-site adjustments may be required.
- Rootballs shall meet or exceed size standards as set forth in 'American Standards for Nursery Stock'. MAIN LEADERS OF ALL TREES SHALL REMAIN INTACT.
- Remove from the site any plant material that turns brown or defoliates within five (5) days after planting. Replace immediately with approved, specified material.
- Plant counts indicated on drawings are for Landscape Architect's use only. Contractor shall make own plant quantity takeoffs using drawings, specifications, and plant schedule requirements (i.e., spacing), unless otherwise directed by Landscape Architect. Contractor to verify bed measurements and install appropriate quantities as governed by plant spacing per schedule. Plant material quantities shown on plan are minimum quantities. Additional material may be needed to meet spacing requirements and field conditions.
- Seed all areas disturbed by construction activities that are not otherwise noted to receive pavement, planting bed, or sod treatment.
- The Contractor shall install and/or amend topsoil in all proposed bed areas to meet Specifications. Contractor shall coordinate quantity and placement of topsoil. Landscaper shall verify depth of topsoil prior to plant installation. (Refer to specifications for topsoil source and placement requirements)
- All tree locations shall be marked with 2x2" stakes prior to planting for review and approval by the Landscape Architect. Any plant material installed in an incorrect location, by the judgment of the Landscape Architect, shall be reinstalled at the Contractor's expense.
- All plant beds shall receive 3" minimum of shredded hardwood bark mulch (unless otherwise noted).
- Verify all utility locations in the field prior to beginning work. Repair all damaged utilities to Owner's satisfaction at no additional cost.
- The Contractor shall maintain all plant material and lawns until the project is fully accepted by the Landscape Architect, unless otherwise noted.
- All workmanship and materials shall be guaranteed by the Contractor for a period of one calendar year after Final Acceptance.
- Install all plant material in accordance with all local codes and ordinances. Coordinate with the Owner to obtain any required permits necessary to complete work.
- Contractor shall test all tree pits for drainage. Any tree pit that holds water for more than 24 hours shall be installed using tree pit drainage.
- Tree Protection Fencing is the responsibility of the Contractor. Minimum protected area shall include the full drip line of the canopy. NO construction activities, material storage, etc. may occur within that area. The Contractor shall ensure that no soil compaction or tree damage occurs in any Protected areas, at any time during the construction process.
- Trees shall be matched in groups unless otherwise noted.
- Contractor to provide a spade edge at all conditions where a planting bed meets adjacent lawn, unless otherwise noted. Refer to Detail 5L601.

Area to be Seeded



SS CSO

8831 Keystone Crossing, Indianapolis, IN 46240

© 2020 CSO Architects, Inc. All Rights Reserved

context

DESIGN

5825 Loxley Loop E.D. | Indianapolis, IN 46216

317-485-6900 | www.context-design.com

PROJECT:  
MSD OF WARREN TOWNSHIP  
WARREN CENTRAL HIGH SCHOOL  
PHASE 3 RENOVATION & ADDITION  
9500 EAST 16th STREET, INDIANAPOLIS, IN 46229

SCOPE DRAWINGS

REVISIONS:

Addendum 02 03-13-23

ISSUE DATE: 2023-02-17

DRAWN BY: AMJ


CHECKED BY: CCH

DRAWING TITLE:  
PLANTING  
PLAN

CERTIFIED BY:  
REEDIE J. PIAZZA, RA  
REGISTERED  
No. 2020-0052  
STATE OF  
INDIANA  
ARCHITECT  
EXPIRES 12-31-2021

DRAWING NUMBER  
L206

PROJECT NUMBER  
2021056

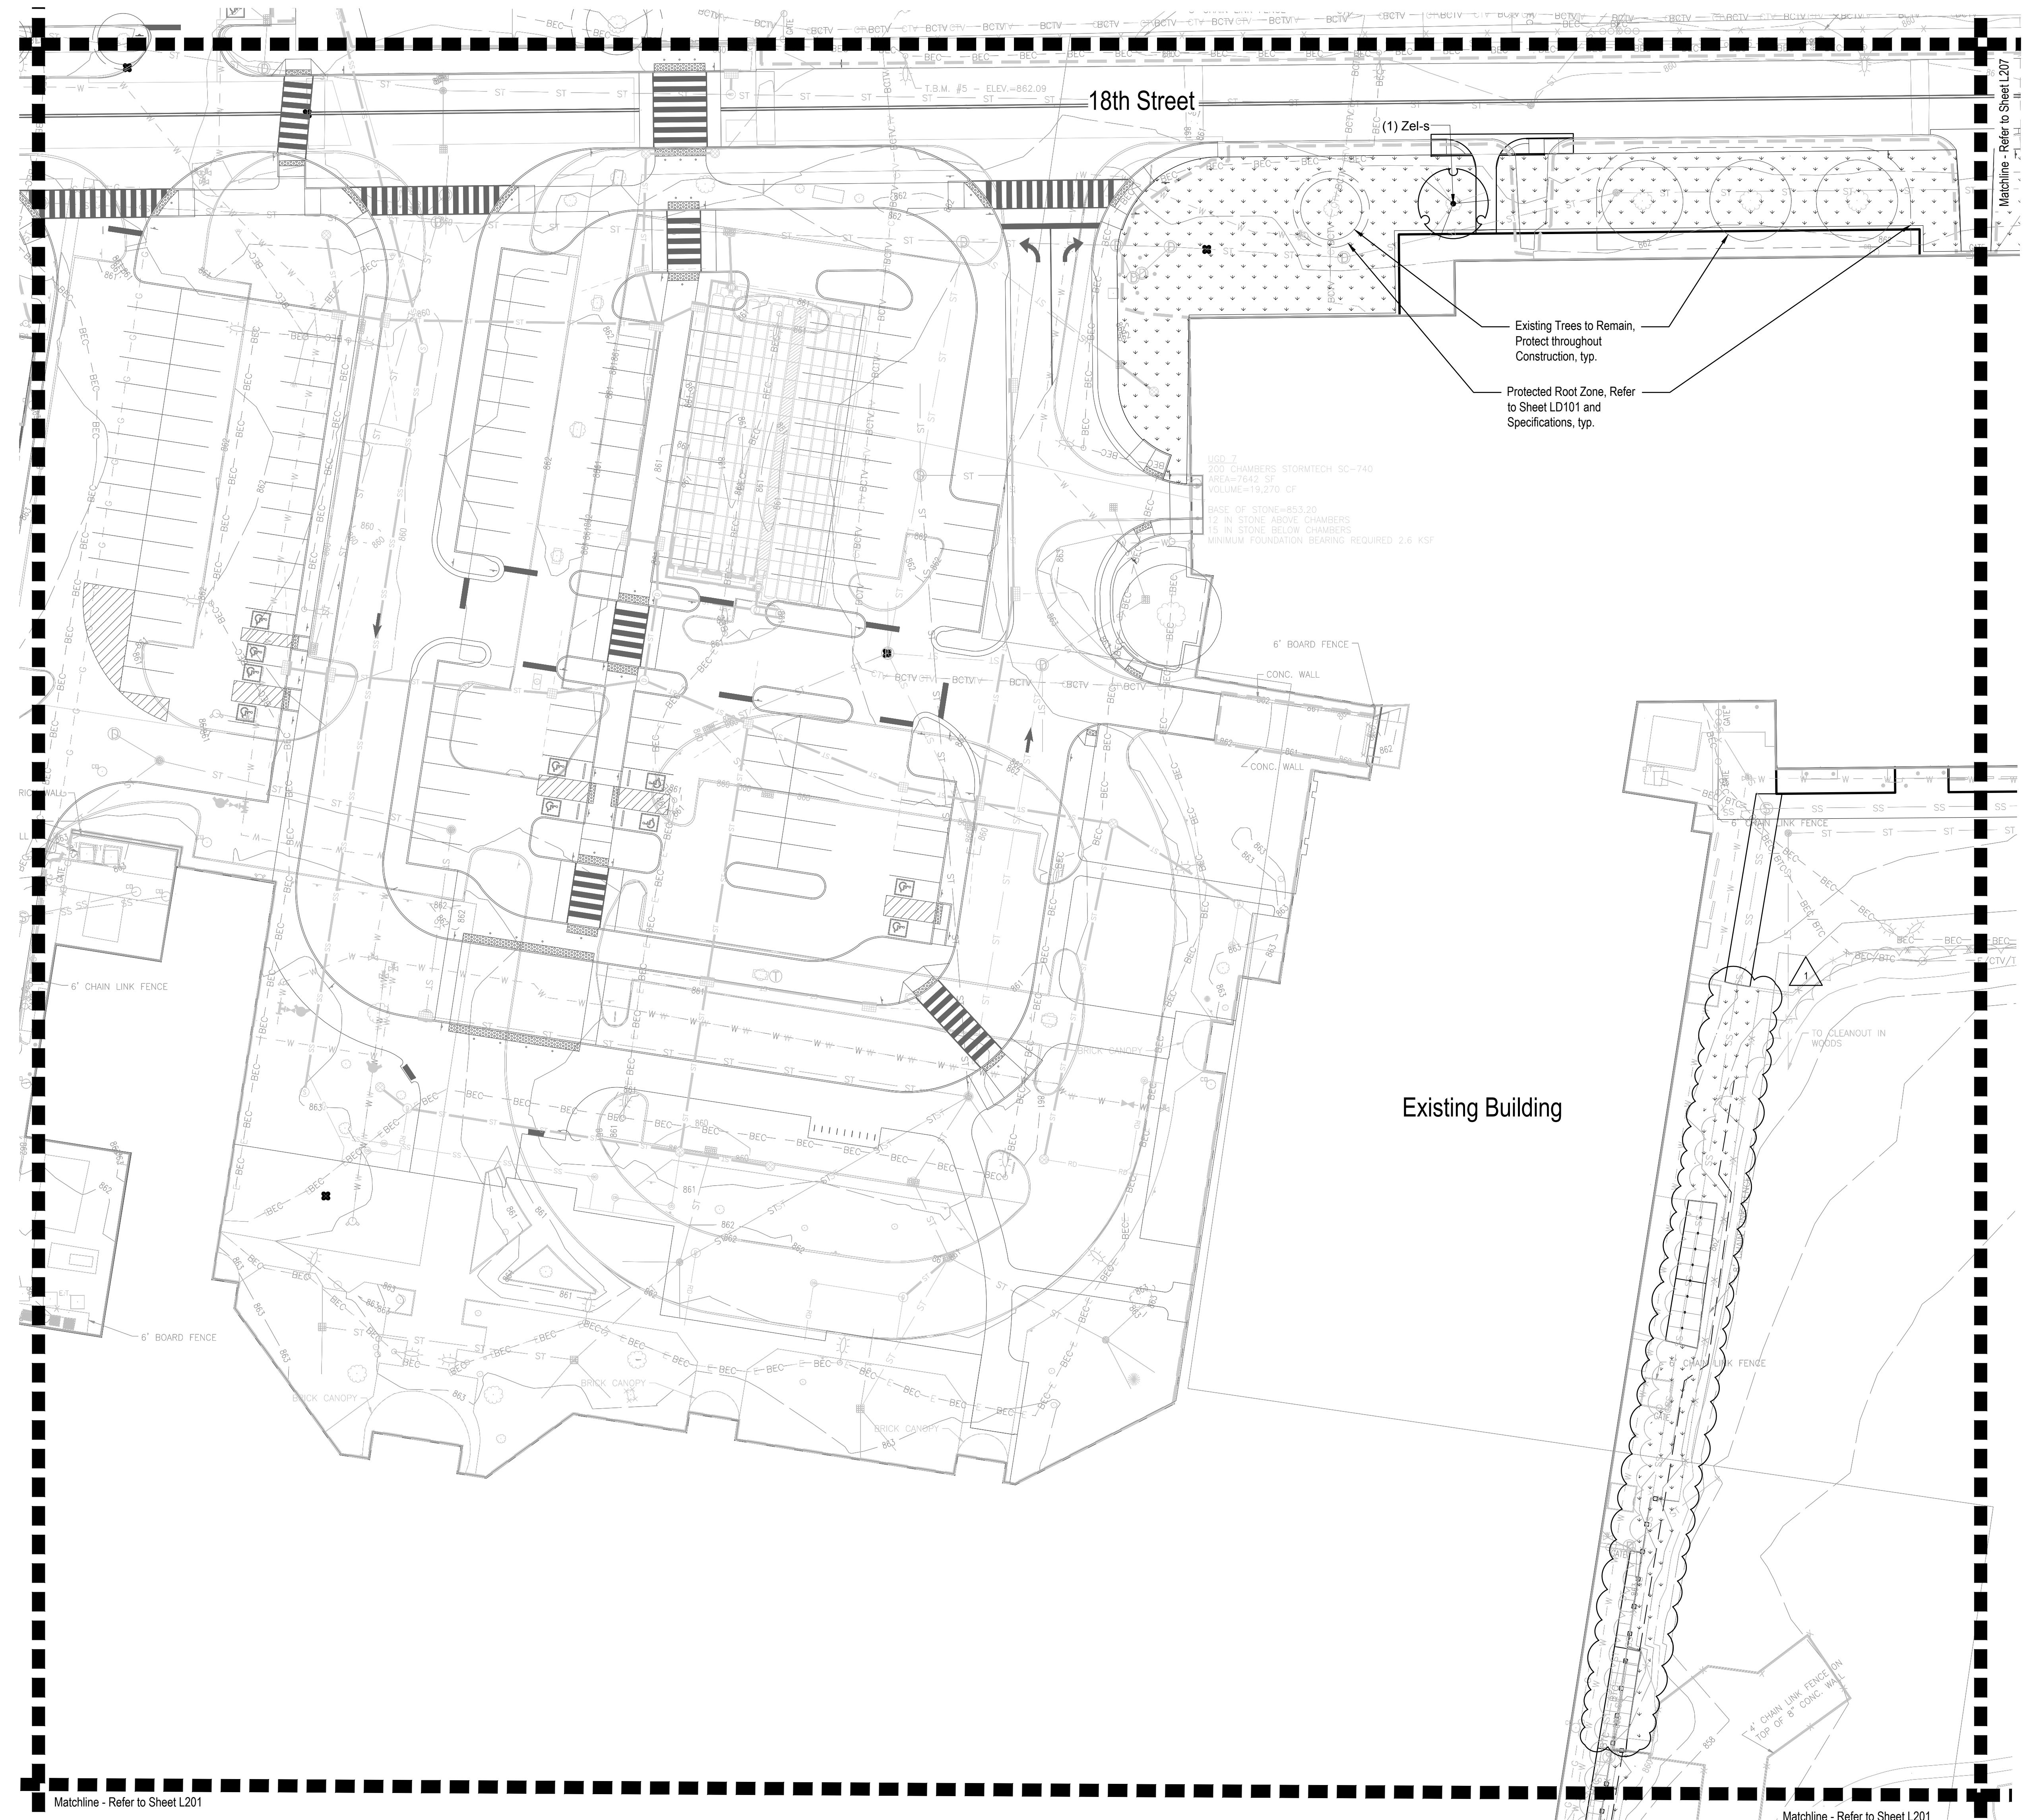

## GENERAL LANDSCAPE AND PLANTING NOTES

- Refer to Project Manual for Planting Specifications and Topsoil requirements. Refer to Plant Schedule and Planting Details for additional information.
- All materials are subject to the approval of the Landscape Architect and Owner at any time. Landscape Architect to inspect all plant locations and plant bed conditions prior to installation. On-site adjustments may be required.
- Rootballs shall meet or exceed size standards as set forth in 'American Standards for Nursery Stock'. MAIN LEADERS OF ALL TREES SHALL REMAIN INTACT.
- Remove from the site any plant material that turns brown or degrades within five (5) days after planting. Replace immediately with approved, specified material.
- Plant counts indicated on drawings are for Landscape Architect's use only. Contractor shall make own plant quantity takeoffs using drawings, specifications, and plant schedule requirements (i.e., spacing), unless otherwise directed by Landscape Architect. Contractor to verify bed measurements and install appropriate quantities as governed by plant spacing per schedule. Plant material quantities shown on plan are minimum quantities. Additional material may be needed to meet spacing requirements and field conditions.
- Seed all areas disturbed by construction activities that are not otherwise noted to receive pavement, planting bed, or sod treatment.
- The Contractor shall install and/or amend topsoil in all proposed bed areas to meet Specifications. Contractor shall coordinate quantity and placement of topsoil. Landscaper shall verify depth of topsoil prior to plant installation. (Refer to specifications for topsoil source and placement requirements)
- All tree locations shall be marked with 2x2" stakes prior to planning for review and approval by the Landscape Architect. Any plant material installed in an incorrect location, by the judgment of the Landscape Architect, shall be reinstated at the Contractor's expense.
- All plant beds shall receive 3" minimum of shredded hardwood bark mulch (unless otherwise noted).
- Verify all utility locations in the field prior to beginning work. Repair all damaged utilities to Owner's satisfaction at no additional cost.
- The Contractor shall maintain all plant material and lawns until the project is fully accepted by the Landscape Architect, unless otherwise noted.
- All workmanship and materials shall be guaranteed by the Contractor for a period of one calendar year after Final Acceptance.
- Install all plant material in accordance with all local codes and ordinances. Coordinate with the Owner to obtain any required permits necessary to complete work.
- Contractor shall test all free pits for drainage. Any tree pit that holds water for more than 24 hours shall be installed using tree pit drainage.
- Tree Protection Fencing is the responsibility of the Contractor. Minimum protected area shall include the full drip line of the canopy. NO construction activities, material storage, etc. may occur within that area. The Contractor shall ensure that no soil compaction or tree damage occurs in any Protected areas, at any time during the construction process.
- Trees shall be matched in groups unless otherwise noted.
- Contractor to provide a spade edge at all conditions where a planting bed meets adjacent lawn, unless otherwise noted. Refer to Detail 5L601.

Area to be Seeded



SS CSO

8831 Keystone Crossing, Indianapolis, IN 46240


317-248-3900 | context.com

context

DESIGN

3625 Loxley Loop E.D., Indianapolis, IN 46216

317-485-6900 | www.context-design.com

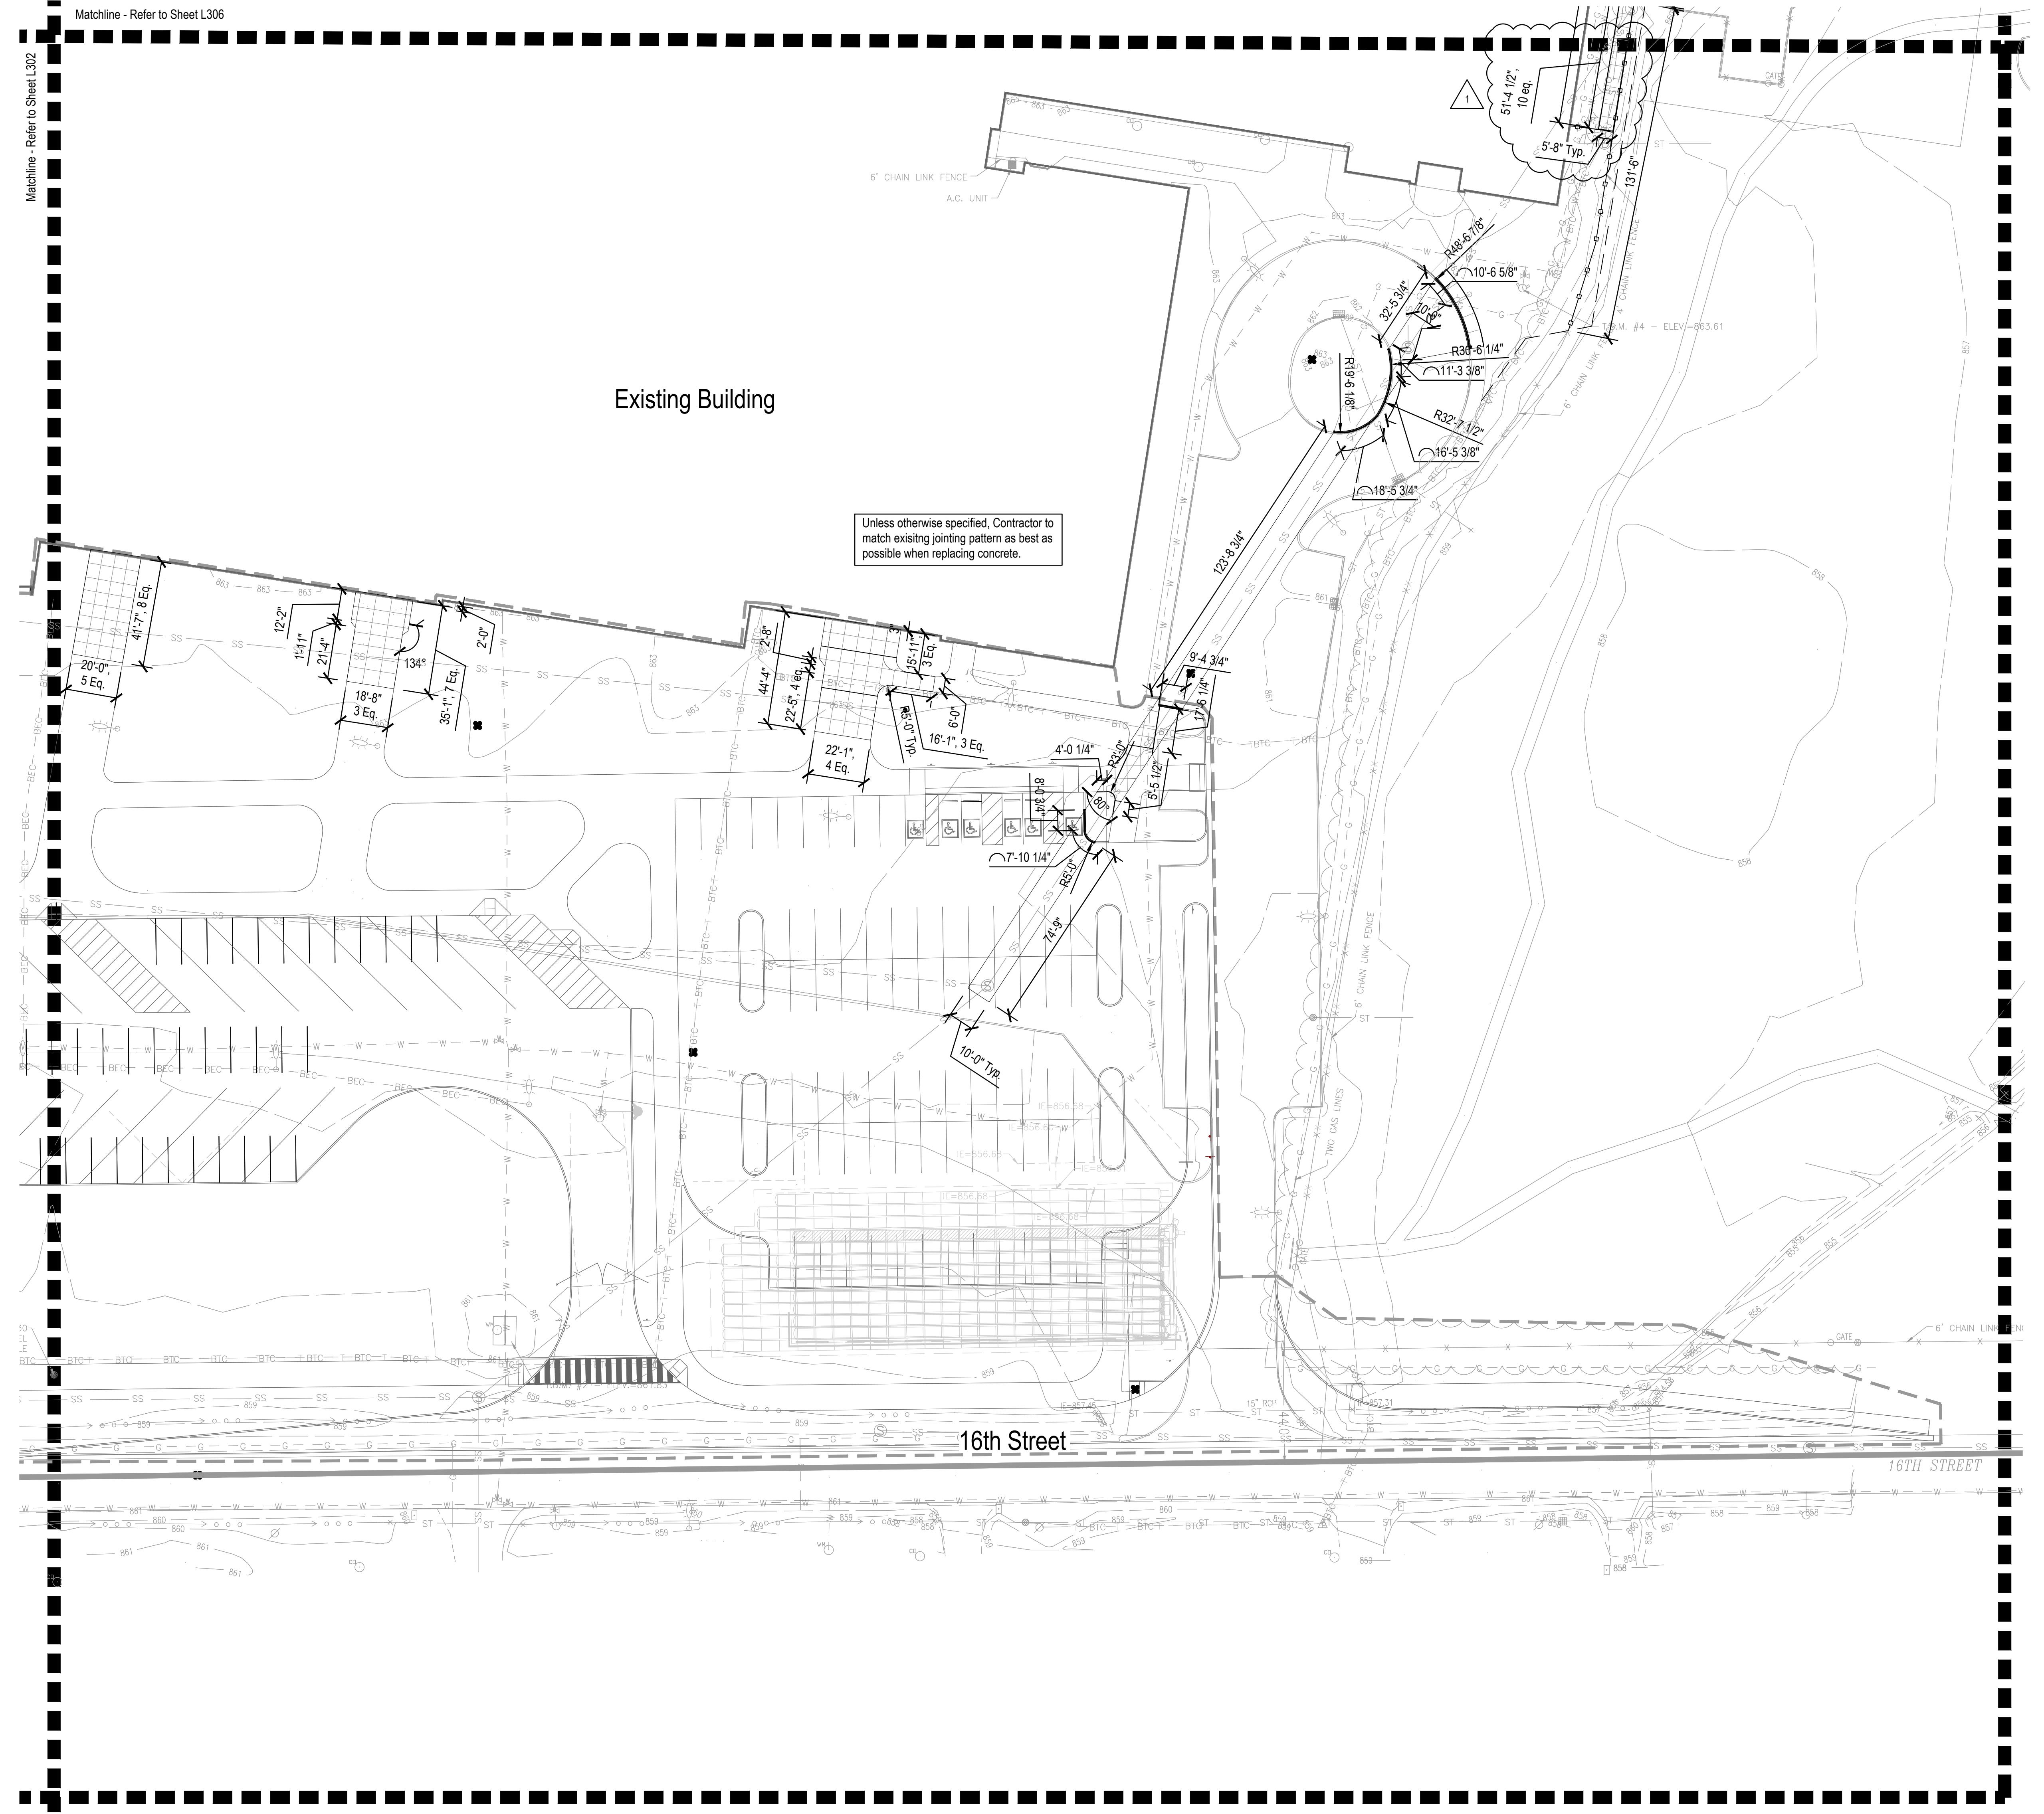

#### LAYOUT NOTES

- Dimensions are shown to Face of Curb unless otherwise noted.
- Contractor shall coordinate first joint locations in the field with the Landscape Architect. Align to existing conditions when practical, including at building and wall corners, connections to existing work, and the centerlines of doors.
- Space control joints evenly between all bands and expansion joints as shown, unless otherwise dimensioned. Space interim joints equally whenever possible.
- Digital AutoCAD files will be provided to the successful bidder as a courtesy to assist with field layout Upon Receipt of Signed Waiver. The Contractor maintains all responsibility for the use, accuracy, and confirmation of such data.
- All pavement striping shown shall adhere to Specifications. The Contractor shall include in their bid any miscellaneous copy, striping, or curb painting that may be requested by the Fire Marshal.
- All disturbed areas not proposed to receive pavements shall be dressed with topsoil and seeded per Specifications.
- Contractor shall provide and install Accessible Parking Signs per requirements of accessible parking space indicated in plans on Sheet L123. Coordinate final location in the field with Landscape Architect.
- Contractor to provide a 2'-0" min. width strip of full depth asphalt replacement at new curb installation.

PROJECT:  
MSD OF WARREN TOWNSHIP  
WARREN CENTRAL HIGH SCHOOL  
PHASE 3 RENOVATION & ADDITION  
9500 EAST 16th STREET, INDIANAPOLIS, IN 46229

SCOPE DRAWINGS  
These drawings are a part of the architectural design concept, the dimensions of which are to be used for the layout of the site. They do not detail the structure, mechanical, mechanical and electrical systems of the project. They are to be used to describe the work required for full performance and completion of the project. They are not to be used for the bidding of the project. They are to be used for the project execution and completion of the work.

REVISIONS:  
Addendum 02 03-13-23

ISSUE DATE DRAWN BY CHECKED BY  
2023-02-17 AMJ CCH

DRAWING TITLE:  
LAYOUT  
PLAN

CERTIFIED BY:  
REGGIE J. PLAZA, RA  
REGISTERED  
No. 2020-0052  
STATE OF  
INDIANA  
ARCHITECT  
EXPIRES 12-31-2021

DRAWING NUMBER  
L301


PROJECT NUMBER  
2021056





**SCCSO**  
8311 Keystone Crossing, Indianapolis, IN 46240

© 2020 CCSO Architects, Inc. All rights reserved.

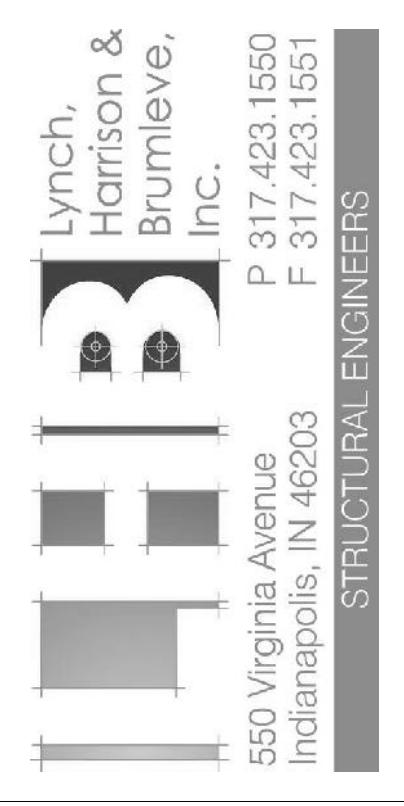

8311 Keystone Crossing, Indianapolis, IN 46240

**PROJECT:**  
MSD OF WARREN TOWNSHIP  
WARREN CENTRAL HIGH SCHOOL  
PHASE 3 ADDITION & RENOVATION  
9500 E. 16th STREET, INDIANAPOLIS, IN 46229

9500 E. 16th Street, Indianapolis, IN 46229

### FOUNDATION PLAN NOTES

- REF. S001 & S002 FOR STRUCTURAL NOTES, DESIGN DATA, SCHEDULES & LEGENDS.
- REF. THE S400 SERIES FOR TYPICAL FOUNDATION AND MASONRY DETAILS.
- ALL CONTRACTORS ARE REQUIRED TO COORDINATE THEIR WORK WITH ALL DISCIPLINES TO AVOID CONFLICTS. THE MECHANICAL, ELECTRICAL AND PLUMBING ASPECTS ARE NOT IN THE SCOPE OF THESE DRAWINGS. THEREFORE, ALL REQUIRED MATERIALS AND WORK MAY NOT BE INDICATED.
- ALL ELEVATIONS ARE REFERENCED FROM THE EXISTING FIRST FLOOR FIN. FLOOR ELEVATION -0'-0". VERIFY ELEVATION WITH CIVIL DWGS.
- ALL WALLS SHALL BE LAID OUT FROM THE ARCHITECTURAL DRAWINGS.
- REF. ARCH. DRAWINGS. FOR ALL DIMENSIONS NOT SHOWN, CONTRACTOR SHALL VERIFY ALL DIMENSIONS PRIOR TO CONSTRUCTION AND IMMEDIATELY NOTIFY ARCHITECT/ENGINEER OF ANY DISCREPANCIES.
- COORDINATE EXACT SIZE & LOCATION OF ALL MECHANICAL OPENINGS FOR WALLS WITH THE MECHANICAL, ELECTRICAL & PLUMBING CONTRACTORS.
- NOTE: PERIMETER FOOTINGS SHALL BE LOWERED AND/OR SLEVED TO PASS BELOW PLUMBING LINES (E.G. SANITARY & STORM LINES, WATER LINES, ETC.) SHOWN ON THE PLUMBING DRAWINGS. PROVIDE FOOTING STEPS AS NEEDED.
- ALL SLAB RECESSES SHALL BE LOCATED PER THE ARCHITECTURAL DRAWINGS. COORDINATE DEPTHS OF ALL SLAB RECESSES WITH THE ARCHITECTURAL DRAWINGS AND/OR THE FLOORING CONTRACTOR.
- PROVIDE CMU REINFORCING AS NOTED ON PLANS & SECTIONS. IF NOT SHOWN ELSEWHERE, MINIMUM CMU WALL REINFORCING TO BE PLACED IS 6" @ 42" OC. MAX VERT. SPACING. PROVIDE REINFORCING AT CHANGES IN CMU THICKNESS, AND WHERE INDICATED ON PLANS & SECTIONS (10'-0" OC MAX VERT. SPACING). PROVIDE 1/2 OF INTERRUPTED VERTS AT JAMS OF OPENINGS AND PROVIDE ADDITIONAL VERTS AT ENDS OF WALLS.
- COORDINATE REINFORCING DOVELS FOR CMU VERTICAL REINFORCING WITH THE FLOORING CONTRACTOR.
- GROUT ALL CORNERS OF CMU SOLID BELOW IN. FLOOR ELEVATION.
- PROVIDE THICKENED SLAB UNDER ALL INTERIOR CMU WALLS WITHOUT FOOTINGS. SEE S401 FOR THICKENED SLAB DETAIL. REF. THE ARCHITECTURAL DRAWINGS FOR LOCATIONS OF CMU WALLS.
- ALL FOOTINGS SHALL BEAR ON APPROVED SOIL. UNDERCUT AS REQ'D. TO SUITABLE BEARING MATERIAL AS DETERMINED BY THE GEOTECHNICAL TESTER. PROVIDE FOUNDRY GRADE CONCRETE (REF. S402).
- PROVIDE CONTROL CONTRACTOR JOINTS IN SLABS ON GRADE (REF. TYPICAL DETAILS ON S401). ALL JOINTS IN SLABS TO RECEIVE THIN OR THICK-SET TERRAZZO CERAMIC OR PORCELAIN TILE, VINYL COMPOSITION TILE (VCT) OR VINYL SHEET GOODS. EPOXY OR SIMILAR THIN-FILM FINISH FLOORING (REF. S401). PROVIDE JOINTS IN SLABS AS DETERMINED BY CONTRACTOR. THE CONTRACTOR SHALL SUBMIT SLAB JOINT LAYOUT TO ARCHITECT/ENGINEER FOR REVIEW PRIOR TO PLACING SLAB.
- EARTH-FORMED FOOTINGS ARE ACCEPTABLE WHERE SOIL CONDITIONS PERMIT (I.E. WHERE THE BANKS OF THE EXCAVATION WILL HOLD WITHOUT SUPPORT). EARTH-FORMED FOOTINGS ARE TO BE 12" IN. THICKNESS OF EARTH-FORMED FOOTINGS MUST BE INCREASED TO 2" ALONG ALL EDGES TO ACCOUNT FOR INACCURACIES ASSOCIATED WITH EARTH-FORMING (I.E. 2'-0" WIDE WALL FOOTINGS SHALL BE 2'-4" WIDE AND 4'-0" SQUARE COLUMN FOOTINGS SHALL BE 4'-4" SQUARE).
- REF. ARCHITECTURAL DWGS. FOR MASONRY CONTROL & EXPANSION JOINT LOCATIONS.
- ALL EXISTING CONSTRUCTION SHOWN IN PLAN AND/OR SECTION WAS DERIVED FROM EXISTING DRAWINGS AND MUST BE FIELD VERIFIED. IF ANY DISCREPANCIES ARE DISCOVERED BETWEEN INFORMATION SHOWN ON THE DRAWINGS AND ACTUAL CONDITIONS, NOTIFY THE ARCHITECT/ENGINEER IMMEDIATELY FOR DIRECTION PRIOR TO PROCEEDING WITH THE WORK.

**19. PLAN LEGEND:**

F.F.	DENOTES FIN. FLOOR
T/X	DENOTES TOP OF FG, SLAB, PIER, ETC.
B/X	DENOTES BOTTOM OF GRADE BEAM, ETC.
C.J.	DENOTES SLAB ON GRADE
P25 -0'-8"	DENOTES CONCRETE PIER MARK & TOP OF PIER ELEVATION (REF. PIER SCHED. ON S402)
WF24 -2'-4"	DENOTES WIRE FABRIC MARK & TOP OF FOOTING ELEVATION (REF. WALL FTG SCHEDULE)
TB24x24 -1'-4"	DENOTES TIE BEAM MARK & TIE BEAM ELEVATION (REF. TIE BEAM SCHEDULE)
—	DENOTES WALL FOOTING WITH STEPS. REF. TYP. DETAIL ON S401
—	DENOTES CMU FOUNDATION WALL
—	DENOTES CMU FDN. WALL HELD DOWN AT OPENINGS
—	DENOTES THICKENED SLAB UNDER INTERIOR NON-LOAD BEARING CMU WALLS

4" CONC. SOG  
1"SLAB -0'-0"

DENOTES SLAB ON GRADE THICKNESS & FLOOR ELEVATION. ALL SLABS ON GRADE TO BE PLACED ON 6" MIN. COMPACTED GRANULAR FILL & VAPOR BARRIER/RETARDER PER SPEC. PROVIDE THE FOLLOWING WELDED WIRE FABRIC REINFORCING:

4" SLAB: 6xW14W1 -WWF  
8" SLAB: 6xW29W23 -WWF

DENOTES COLUMN FOOTING MARK & TOP OF ELEVATION (SEE COL. FTG. SCHED. ON S402)

F7.0 -2'-8"  
P24 -4'-8"

DENOTES PIER MARK & TOP OF PIER ELEVATION (SEE PIER SCHED. ON S402)

HS58x65x16

DENOTES COLUMN SIZE FOR STUB COL. NOT SHOWN ON FDN. PLAN

CONCRETE PIER

STEEL COLUMN

ADJUST THICKNESS OF FOOTINGS MARKED "SP" ON PLAN SO THAT BOTTOM OF FOOTING HATCHES BOTTOM OF EXISTING ADJACENT FOOTING


**SCOPE DRAWINGS:**  
These drawings are a portion of the project. In terms of architectural design concept, the dimensions of the structures, mechanical and electrical systems, the location of the structures, and the requirements of the Contract. The drawings and the scope indicated or implied, the trade contractors shall furnish all items required for the proper execution and completion of the work.

**REVISIONS:**

1 ADDENDUM 2 3/13/23


**ISSUE DATE:** 02-17-2023 **DRAWN BY:** JRO **CHECKED BY:** MDL

**DRAWING TITLE:**  
**FOUNDATION PLAN - UNITS P R & T**

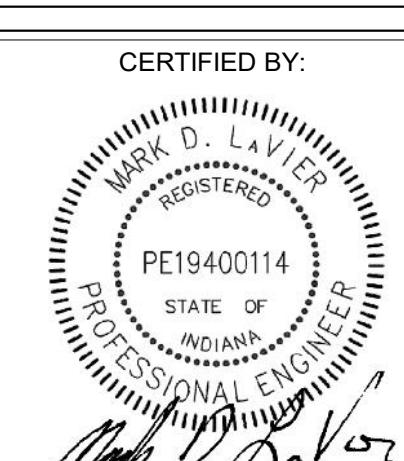


**DRAWING NUMBER:** S201PRT

**PROJECT NUMBER:** 18035

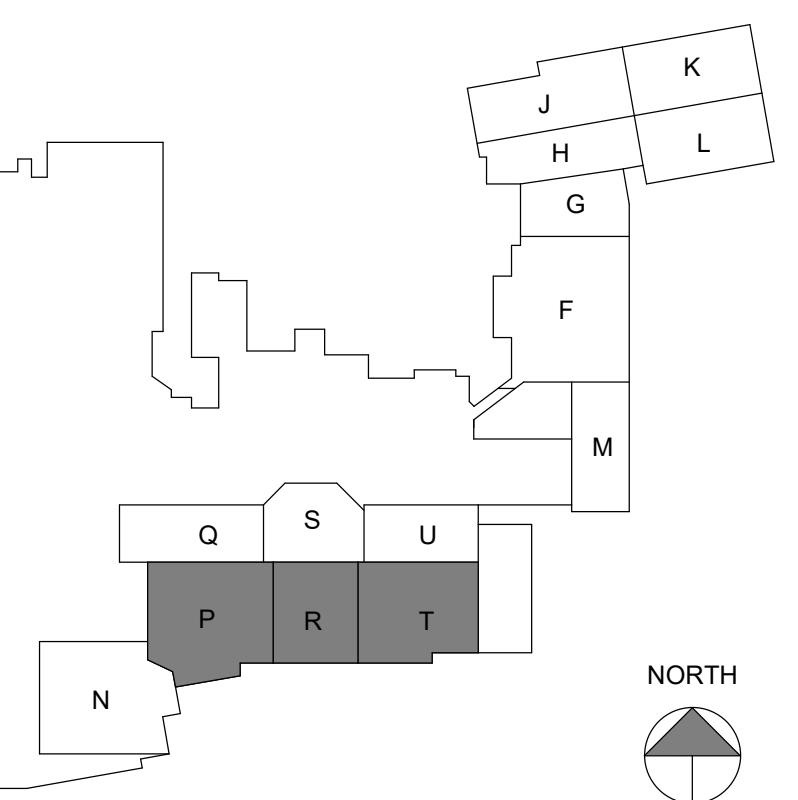


NORTH


**1** UNIT P & R FOUNDATION PLAN  
S201PRT SCALE: 1/8" = 1'-0"

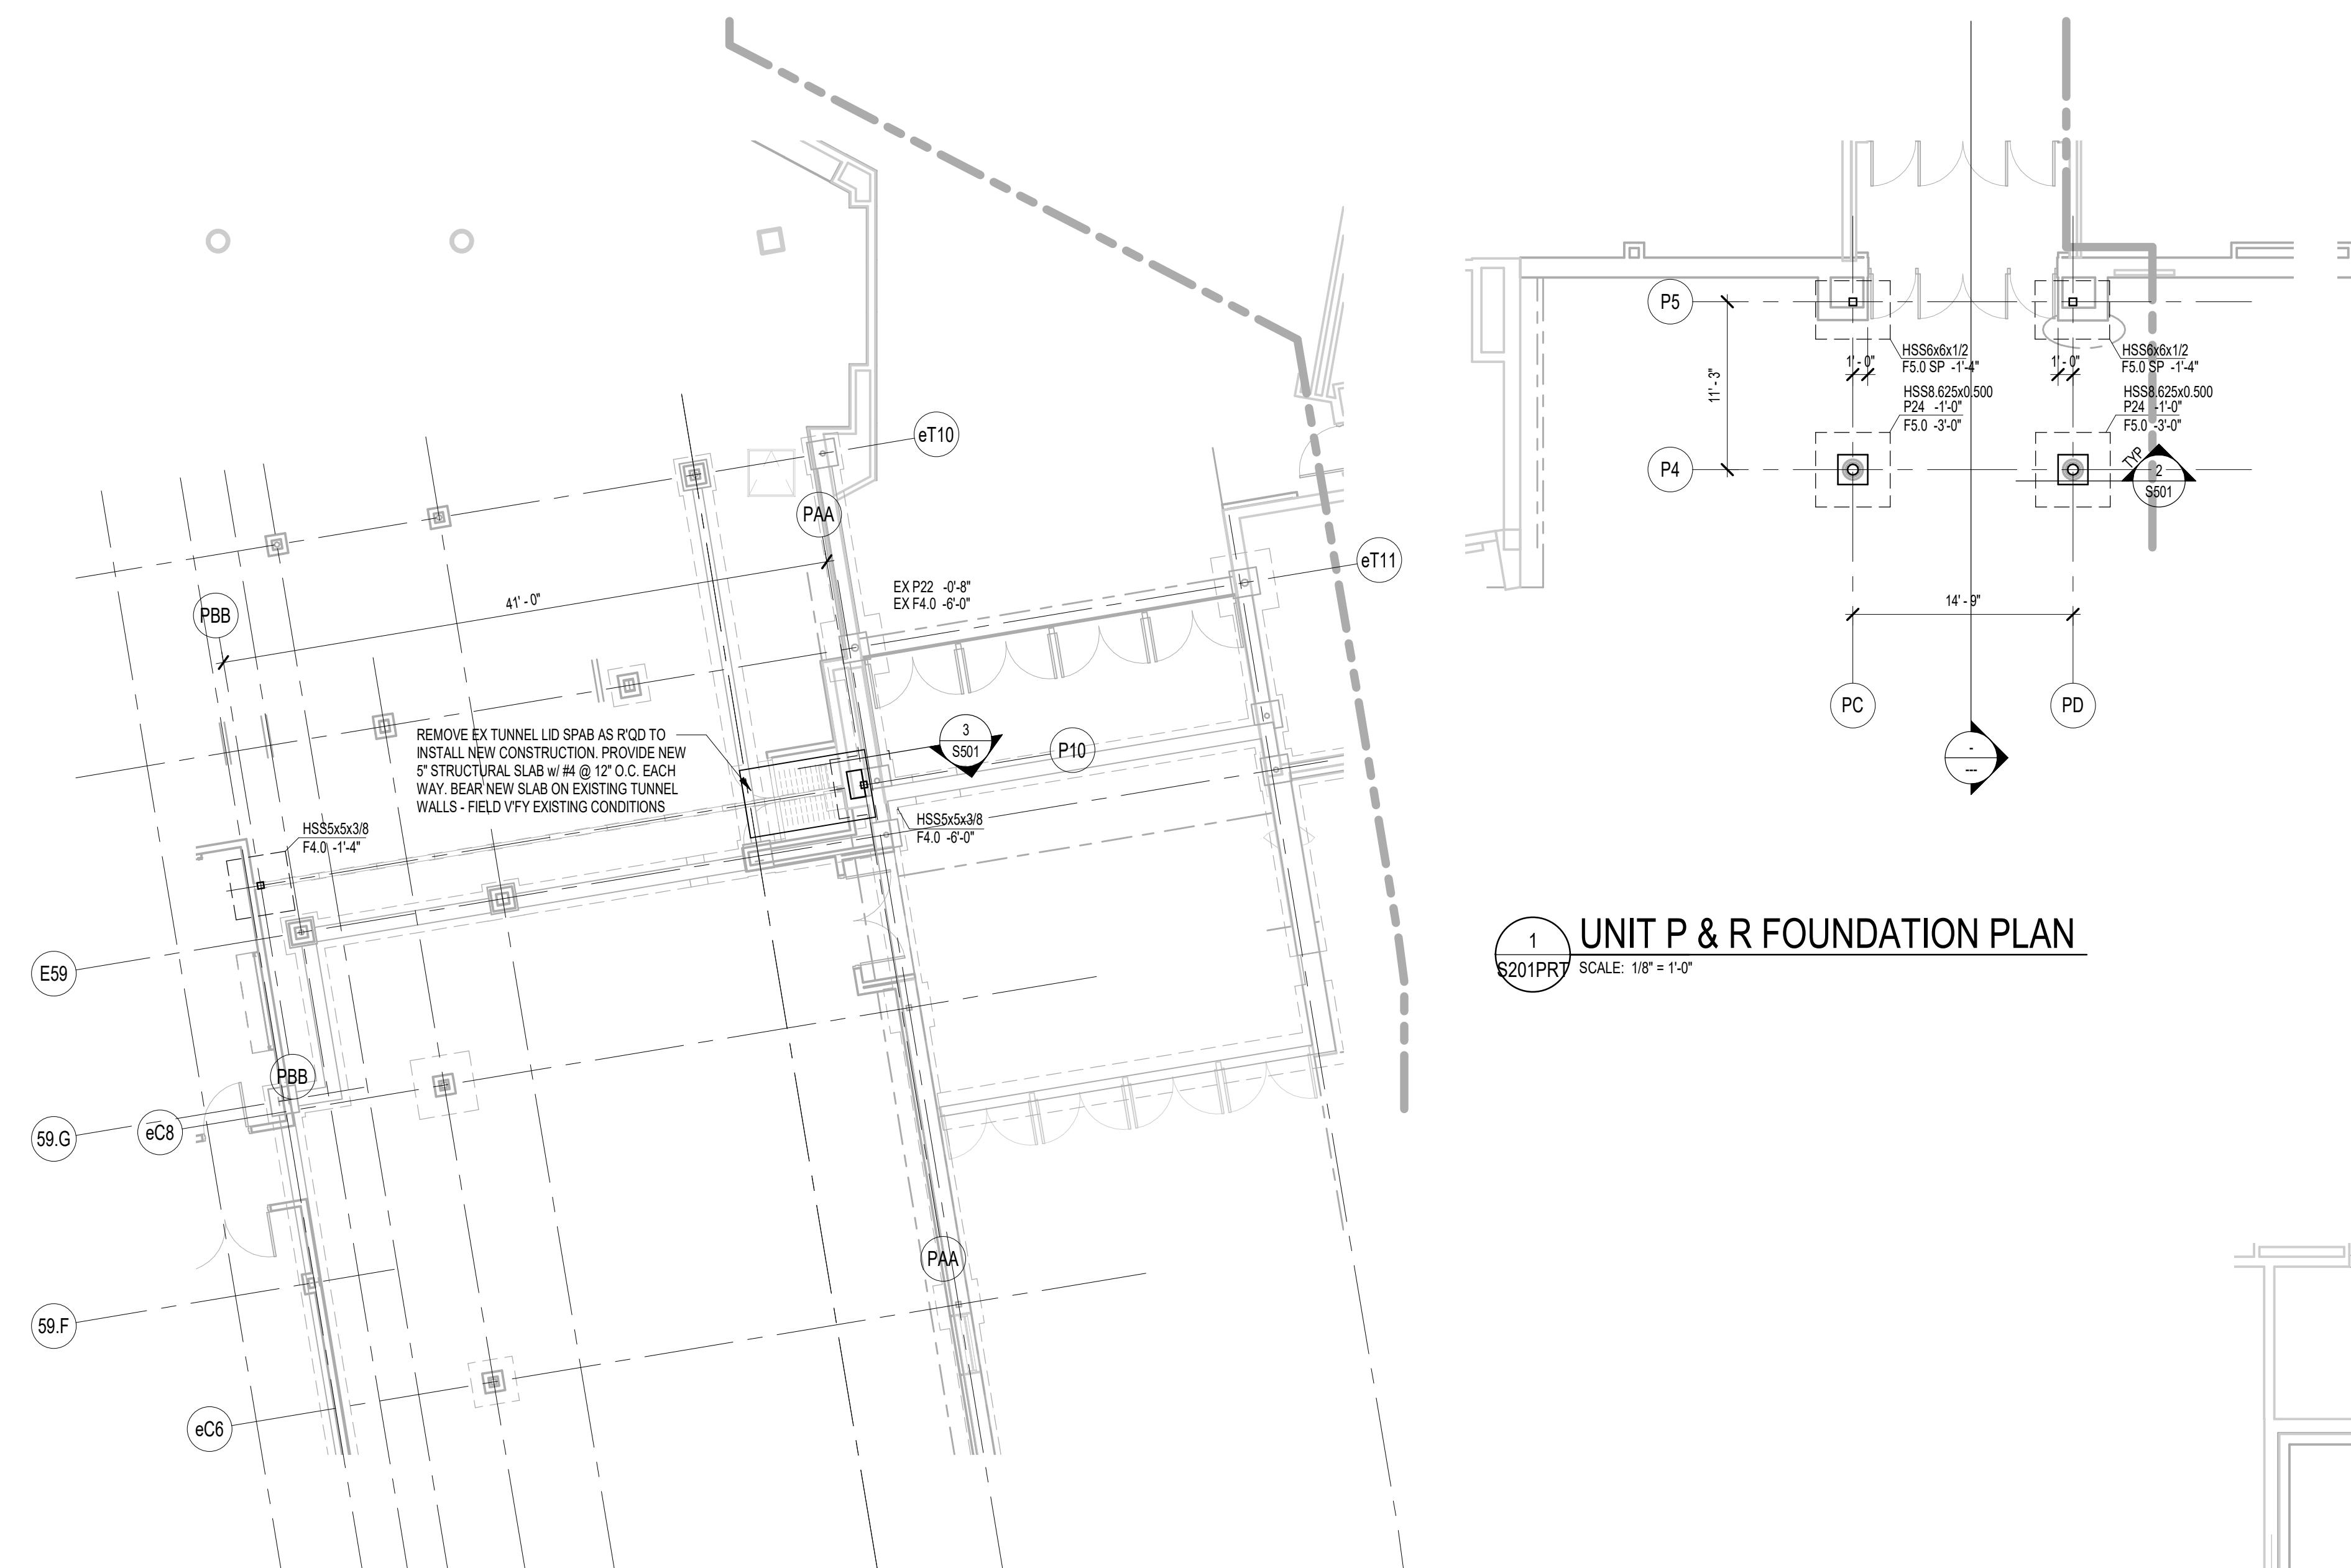

**2** UNIT T FOUNDATION PLAN  
S201PRT SCALE: 1/8" = 1'-0"

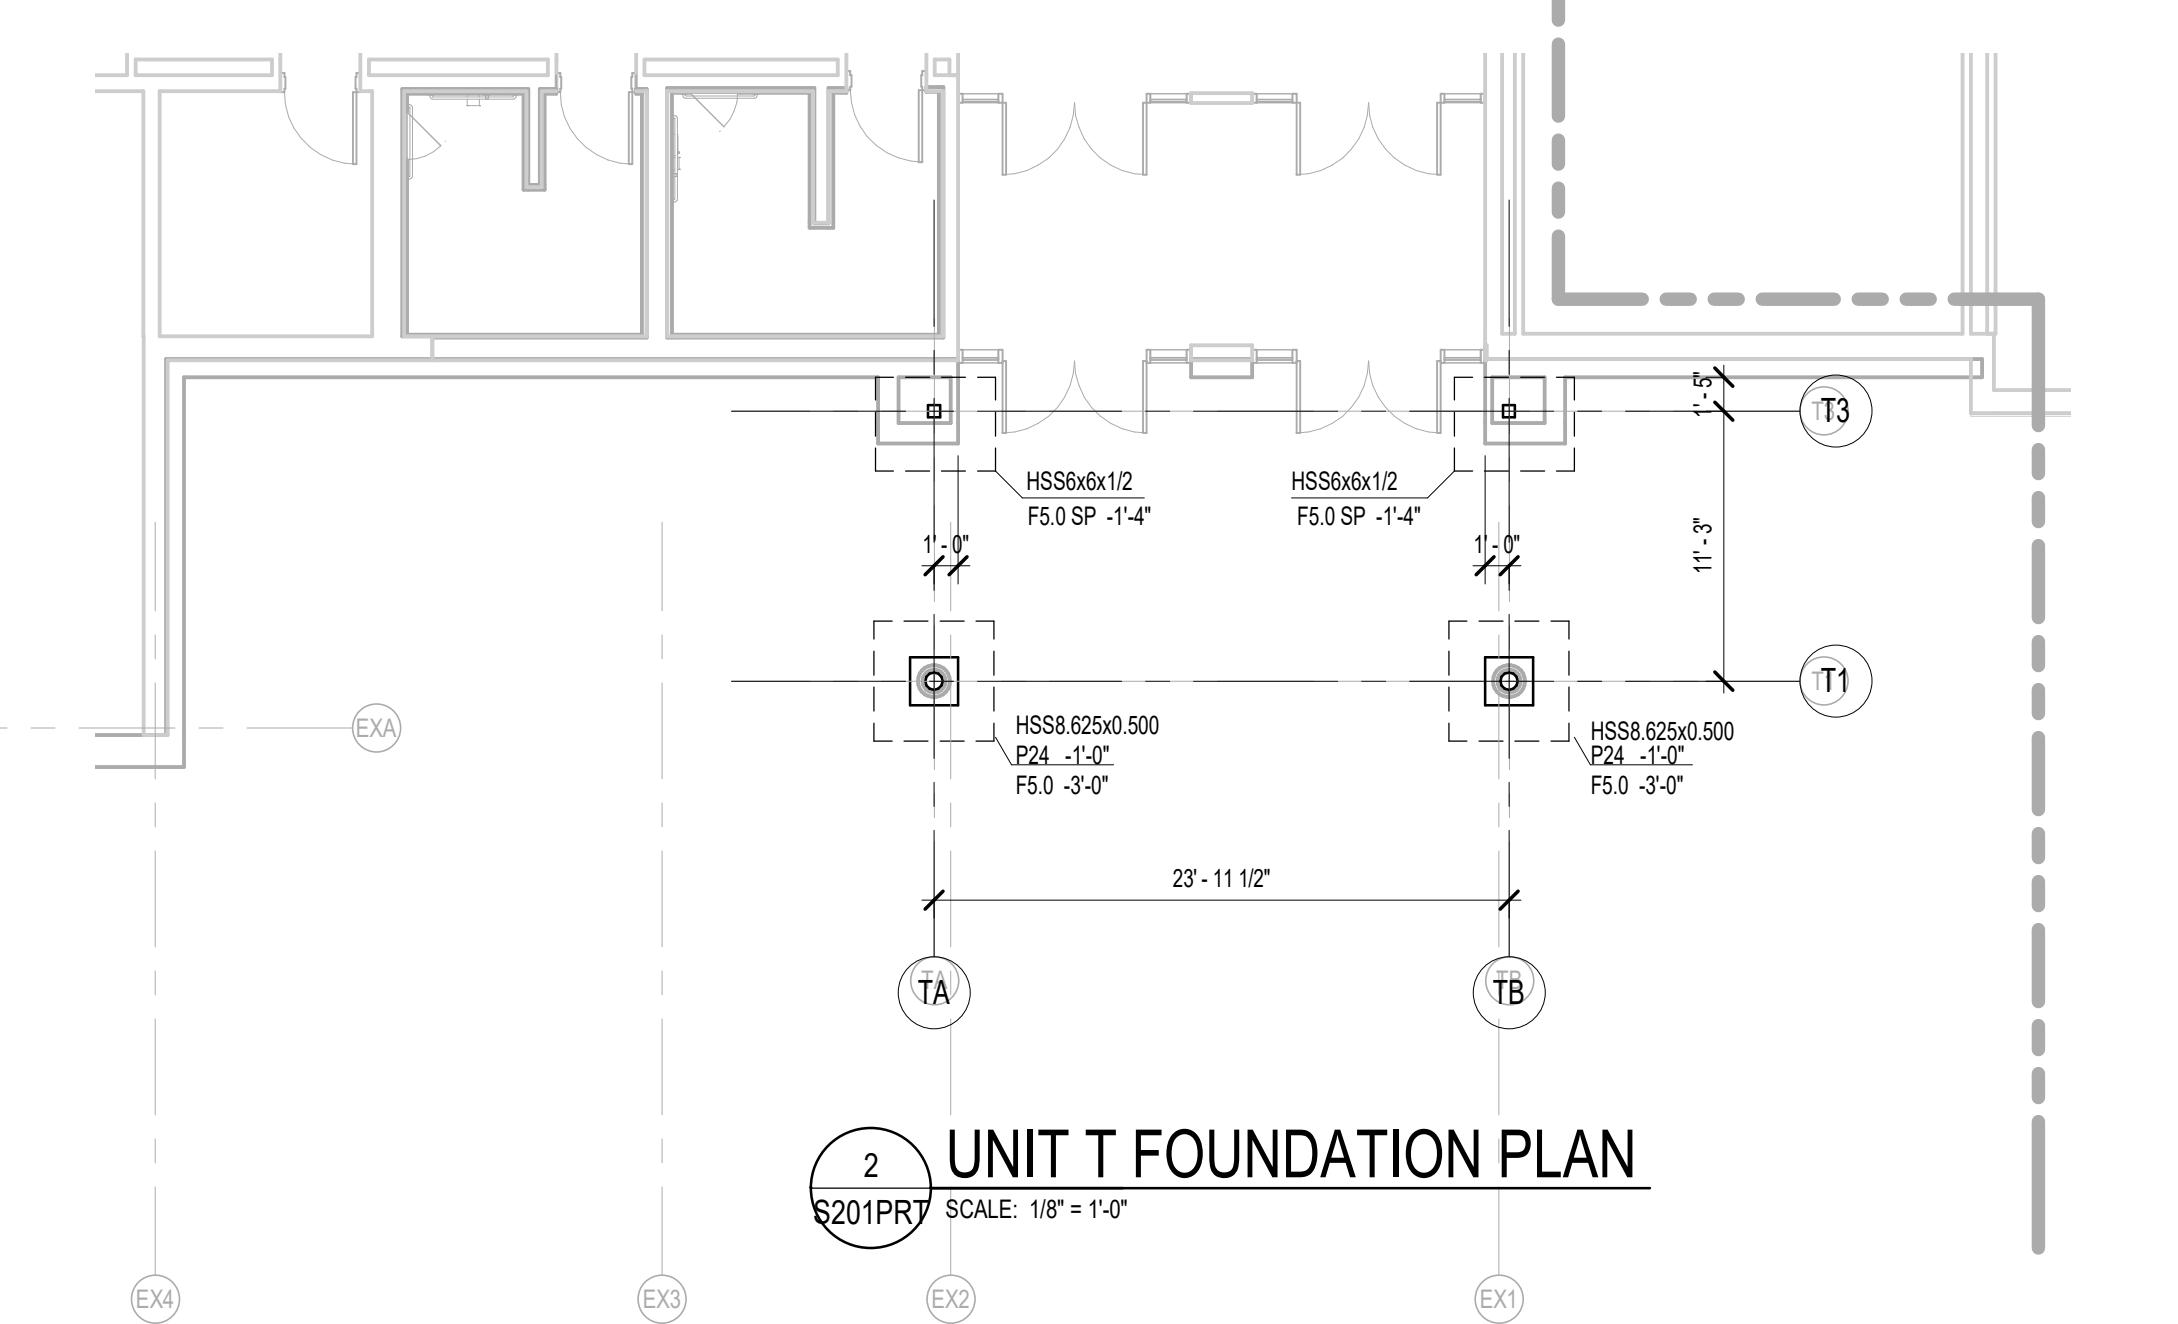

**3** UNIT P & R FOUNDATION PLAN - ALTERNATE  
S201PRT SCALE: 1/8" = 1'-0"

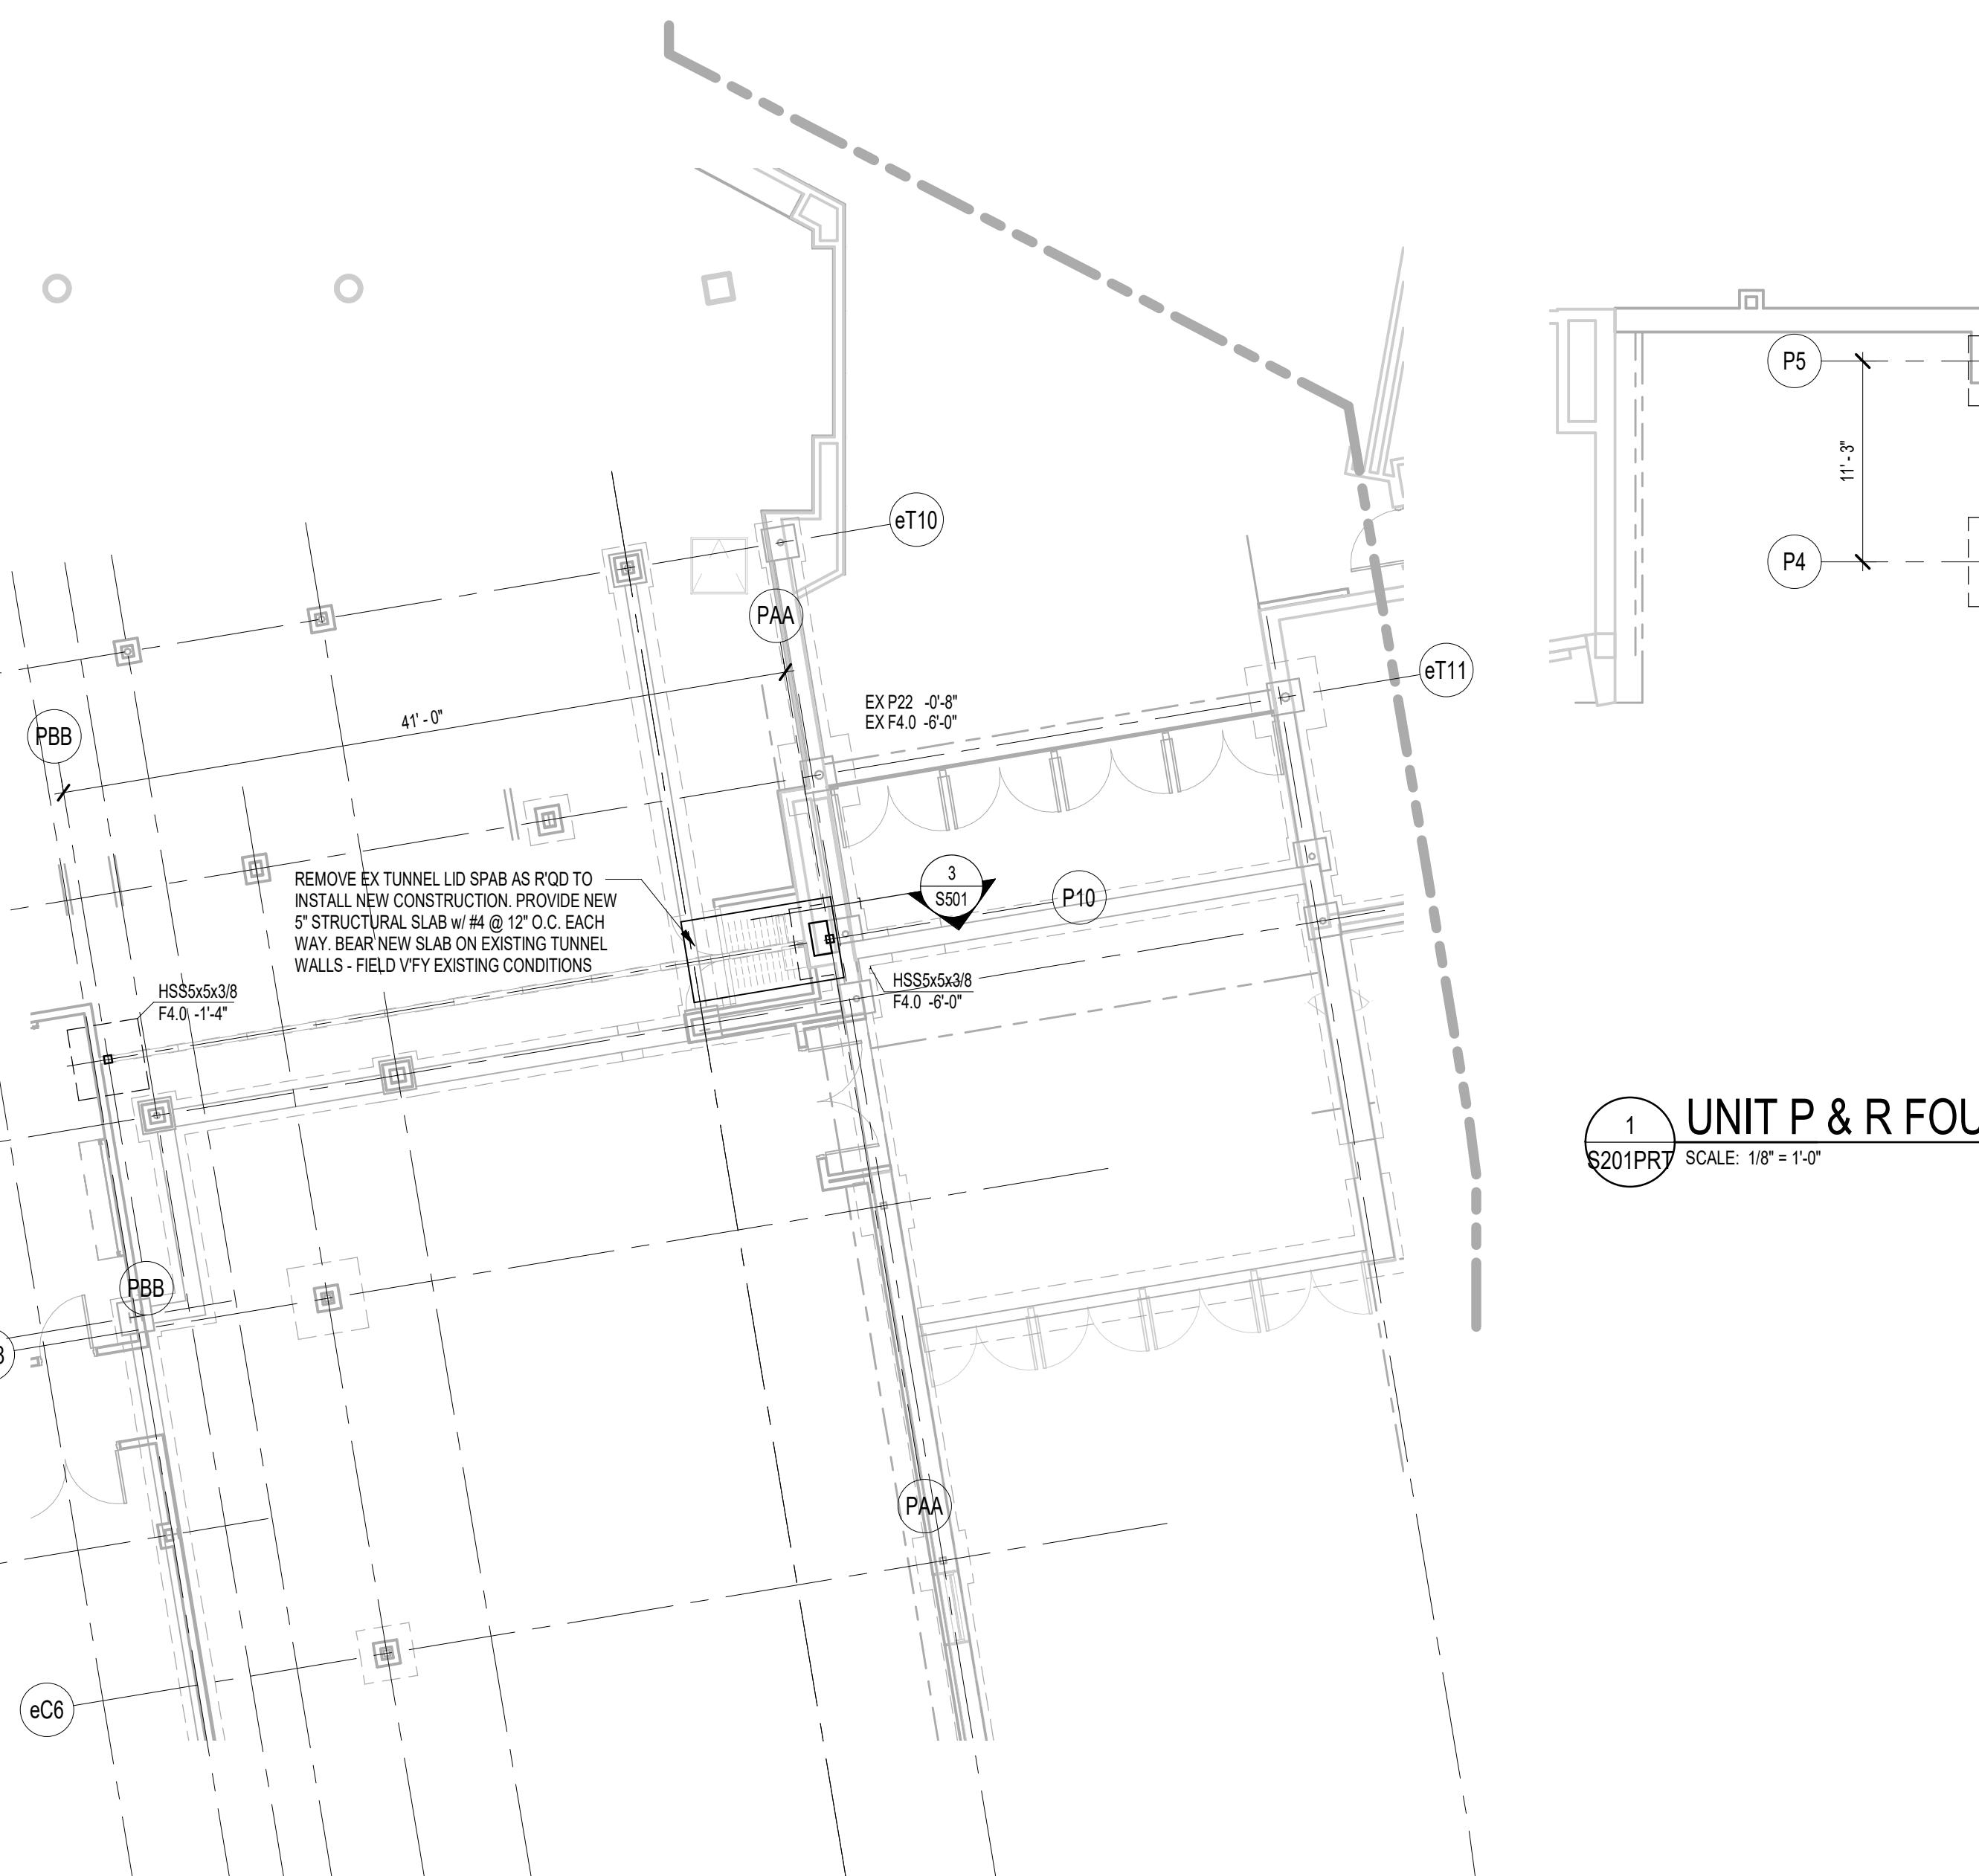






SCCSO

© 2020 CCSO Architects, Inc. All rights reserved.

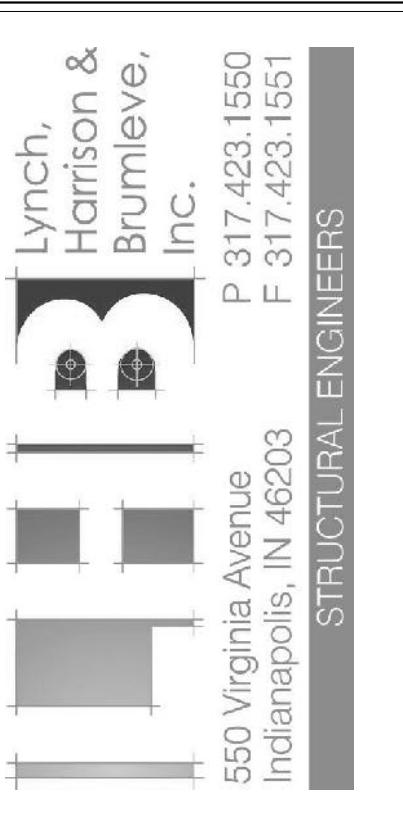

8831 Keystone Crossing, Indianapolis, IN 46240

317.448.7800 | ccsone.com

P 317.423.1550  
F 317.423.1551

STRUCTURAL ENGINEERS

PROJECT:  
MSD OF WARREN TOWNSHIP  
WARREN CENTRAL HIGH SCHOOL  
PHASE 3 ADDITION & RENOVATION  
9500 E. 16th STREET, INDIANAPOLIS, IN 46229


SCOPE DRAWINGS:  
These drawings provide the scope of the project in terms of architectural design concept, the dimensions of the structures, and the location of the structures. They also describe the structural, mechanical and electrical systems. The drawings shall be used to determine the requirements of the project. The drawings shall be used to determine the requirements of the Contract. The drawings shall be used to determine the requirements of the work.

REVISIONS:

1 ADDENDUM 2 3/13/23


ISSUE DATE: 02-17-2023 DRAWN BY: JRO CHECKED BY: MDL

DRAWING TITLE:  
FOUNDATION SECTIONS

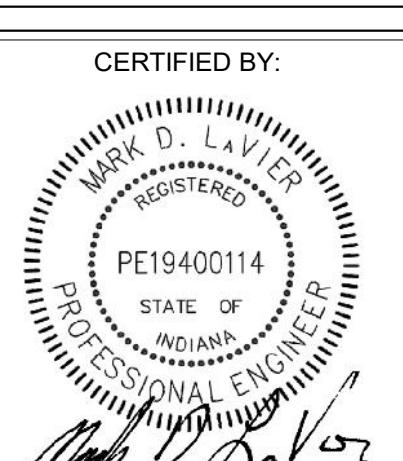

DRAWING NUMBER:  
S501


PROJECT NUMBER:  
18035

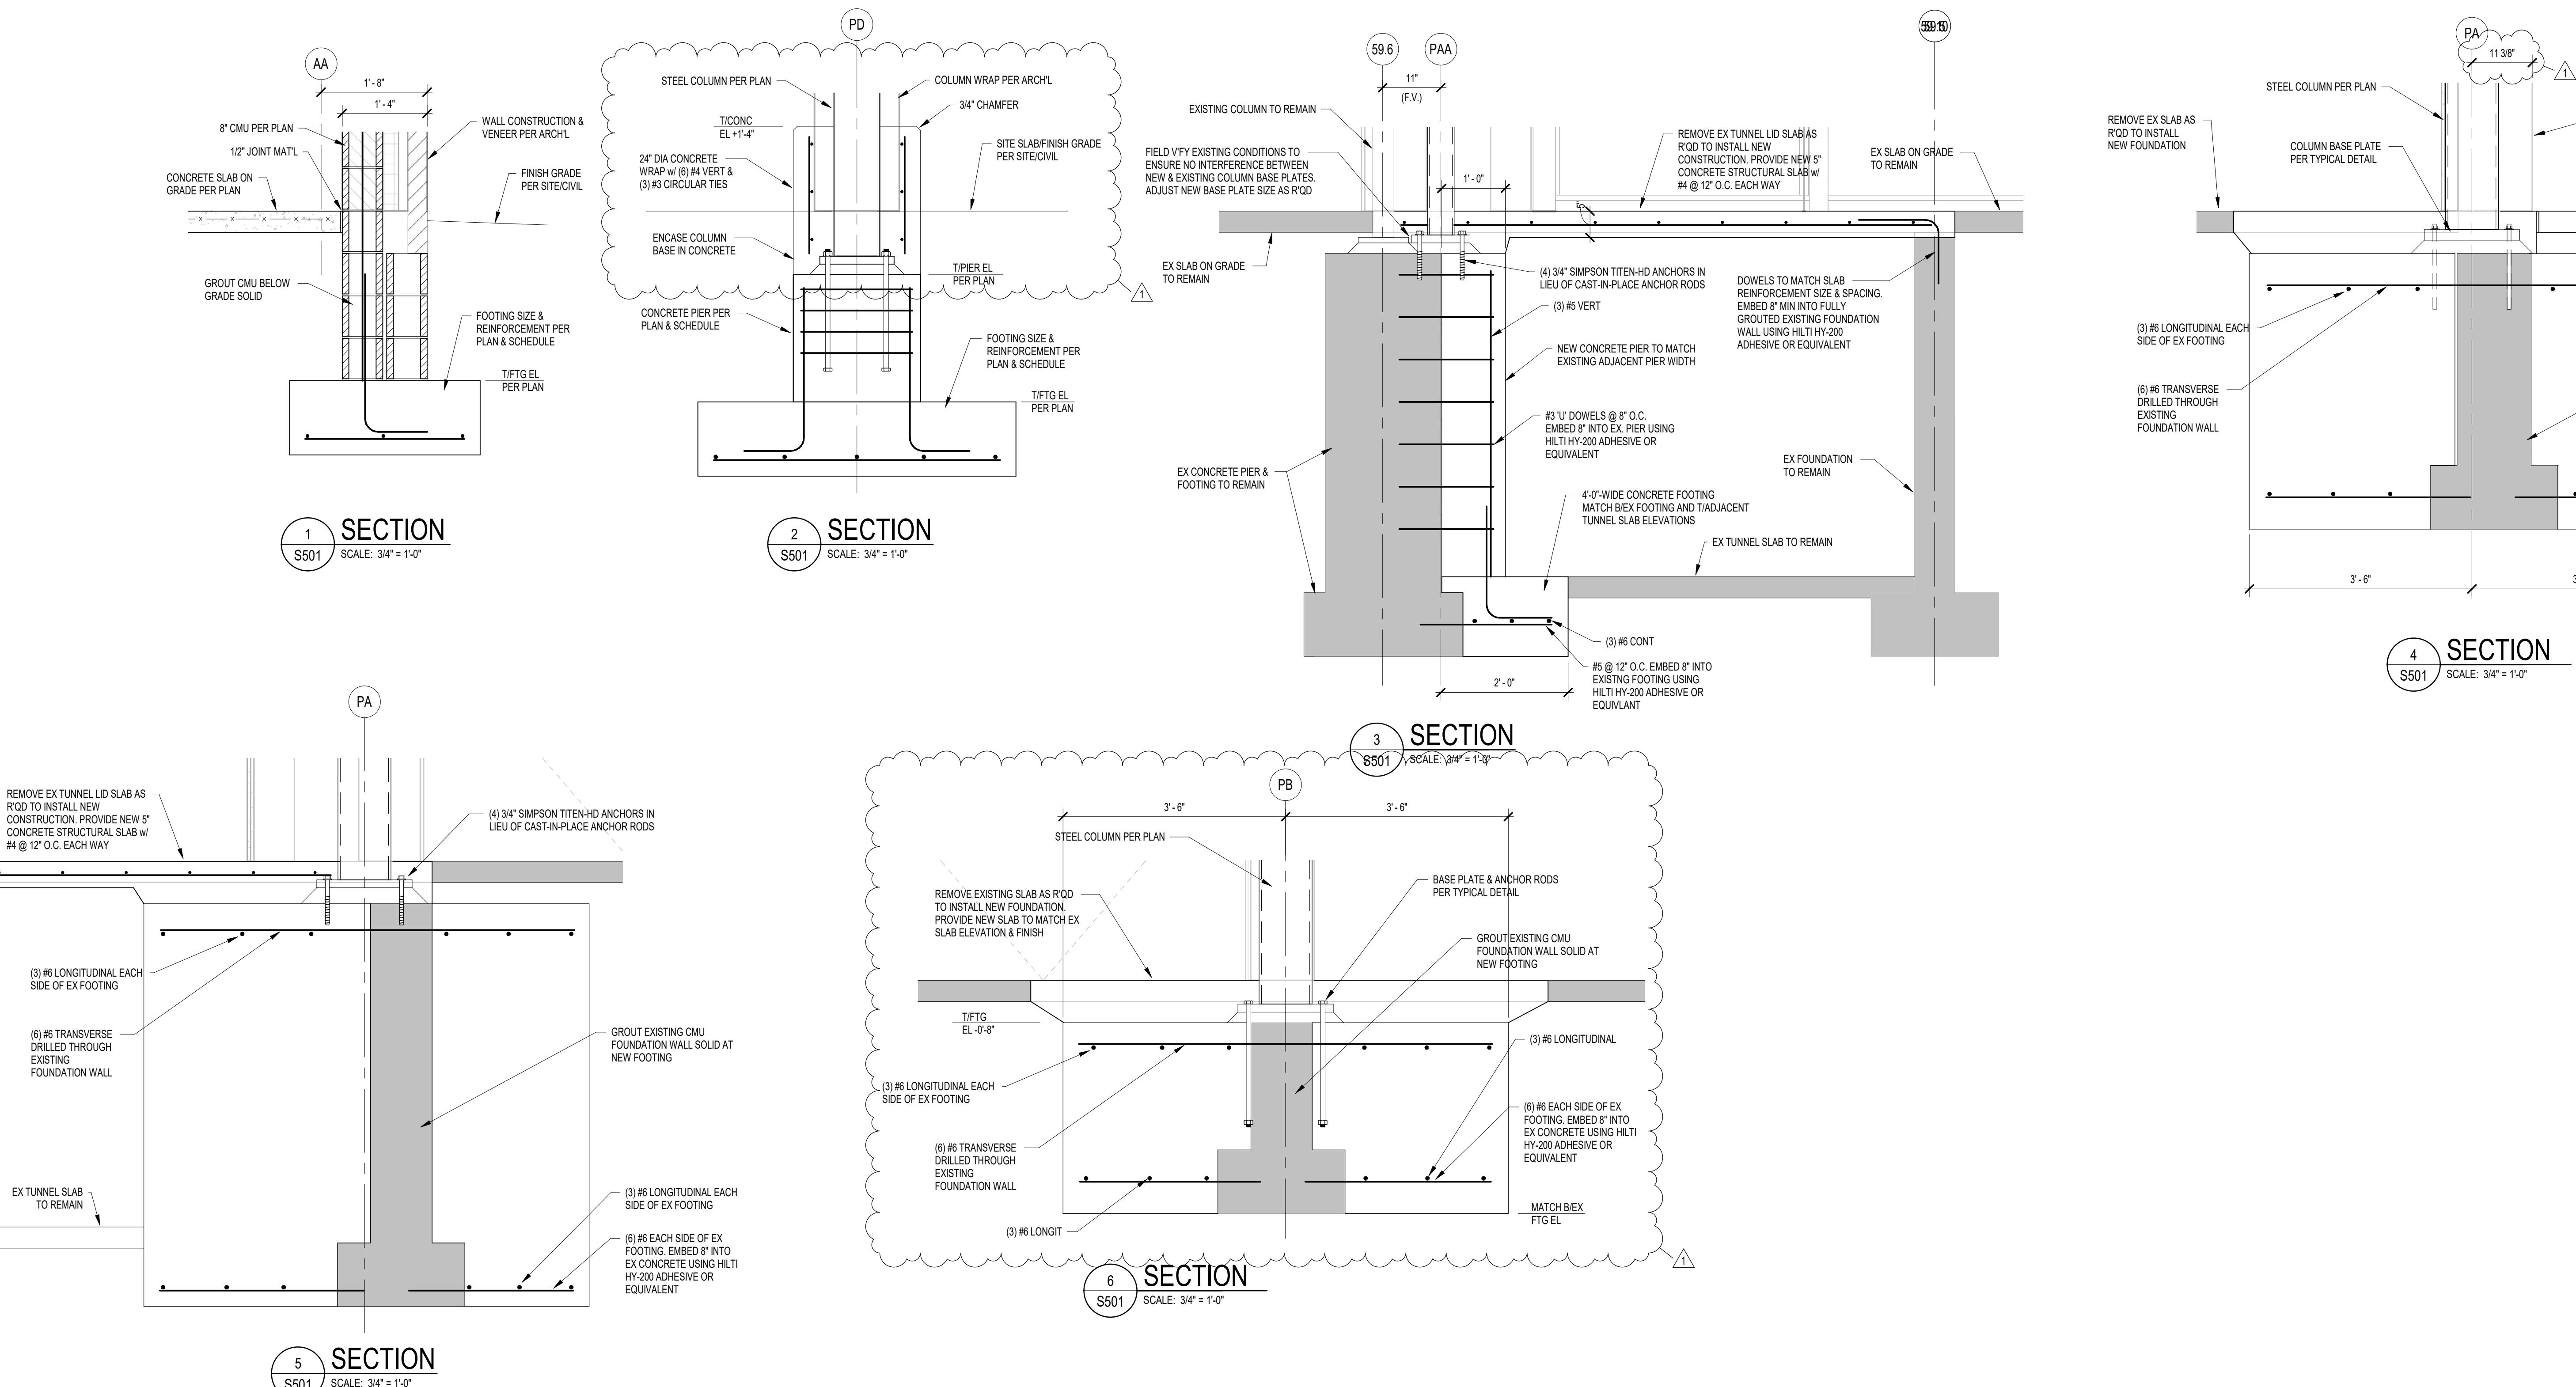



**SCCSO**

© 2020 CCSO Architects, Inc. All rights reserved.

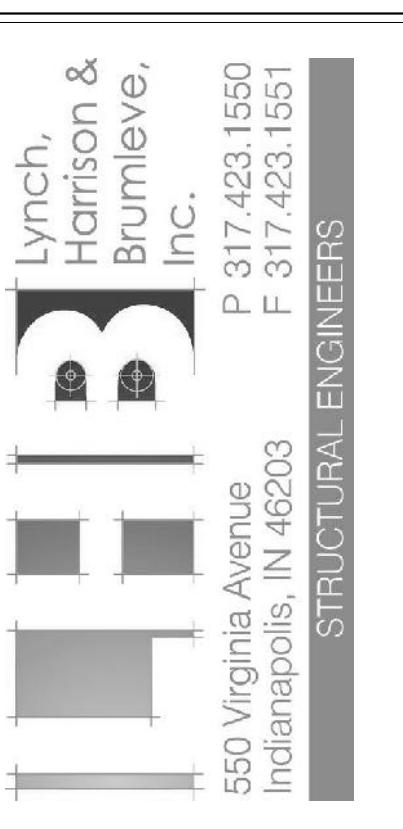

**PROJECT:**  
WARREN CENTRAL HIGH SCHOOL  
PHASE 3 ADDITION & RENOVATION  
9500 E. 16th STREET, INDIANAPOLIS, IN 46229


88311 Keystone Crossing, Indianapolis, IN 46240  
317.448.7800 | ccsco.com

**SCOPE DRAWINGS:**  
These drawings are a scope of the project in terms of architectural design concept, the dimensions of the structure, and the location of the structural, mechanical and electrical systems. All the drawings shall be used in conjunction with the requirements of the Contract.  
The architect and engineer shall furnish all items required for the proper execution and completion of the work.

**REVISIONS:**  
1 ADDENDUM 2 3/13/23


ISSUE DATE 02-17-2023 DRAWN BY JRO CHECKED BY MDL

**DRAWING TITLE:**  
**FRAMING SECTIONS**

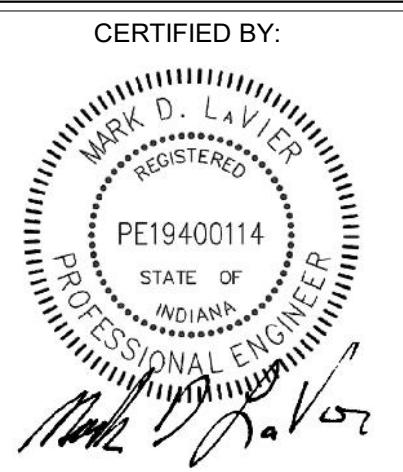

**DRAWING NUMBER:**  
**S601**

**PROJECT NUMBER:**  
**18035**

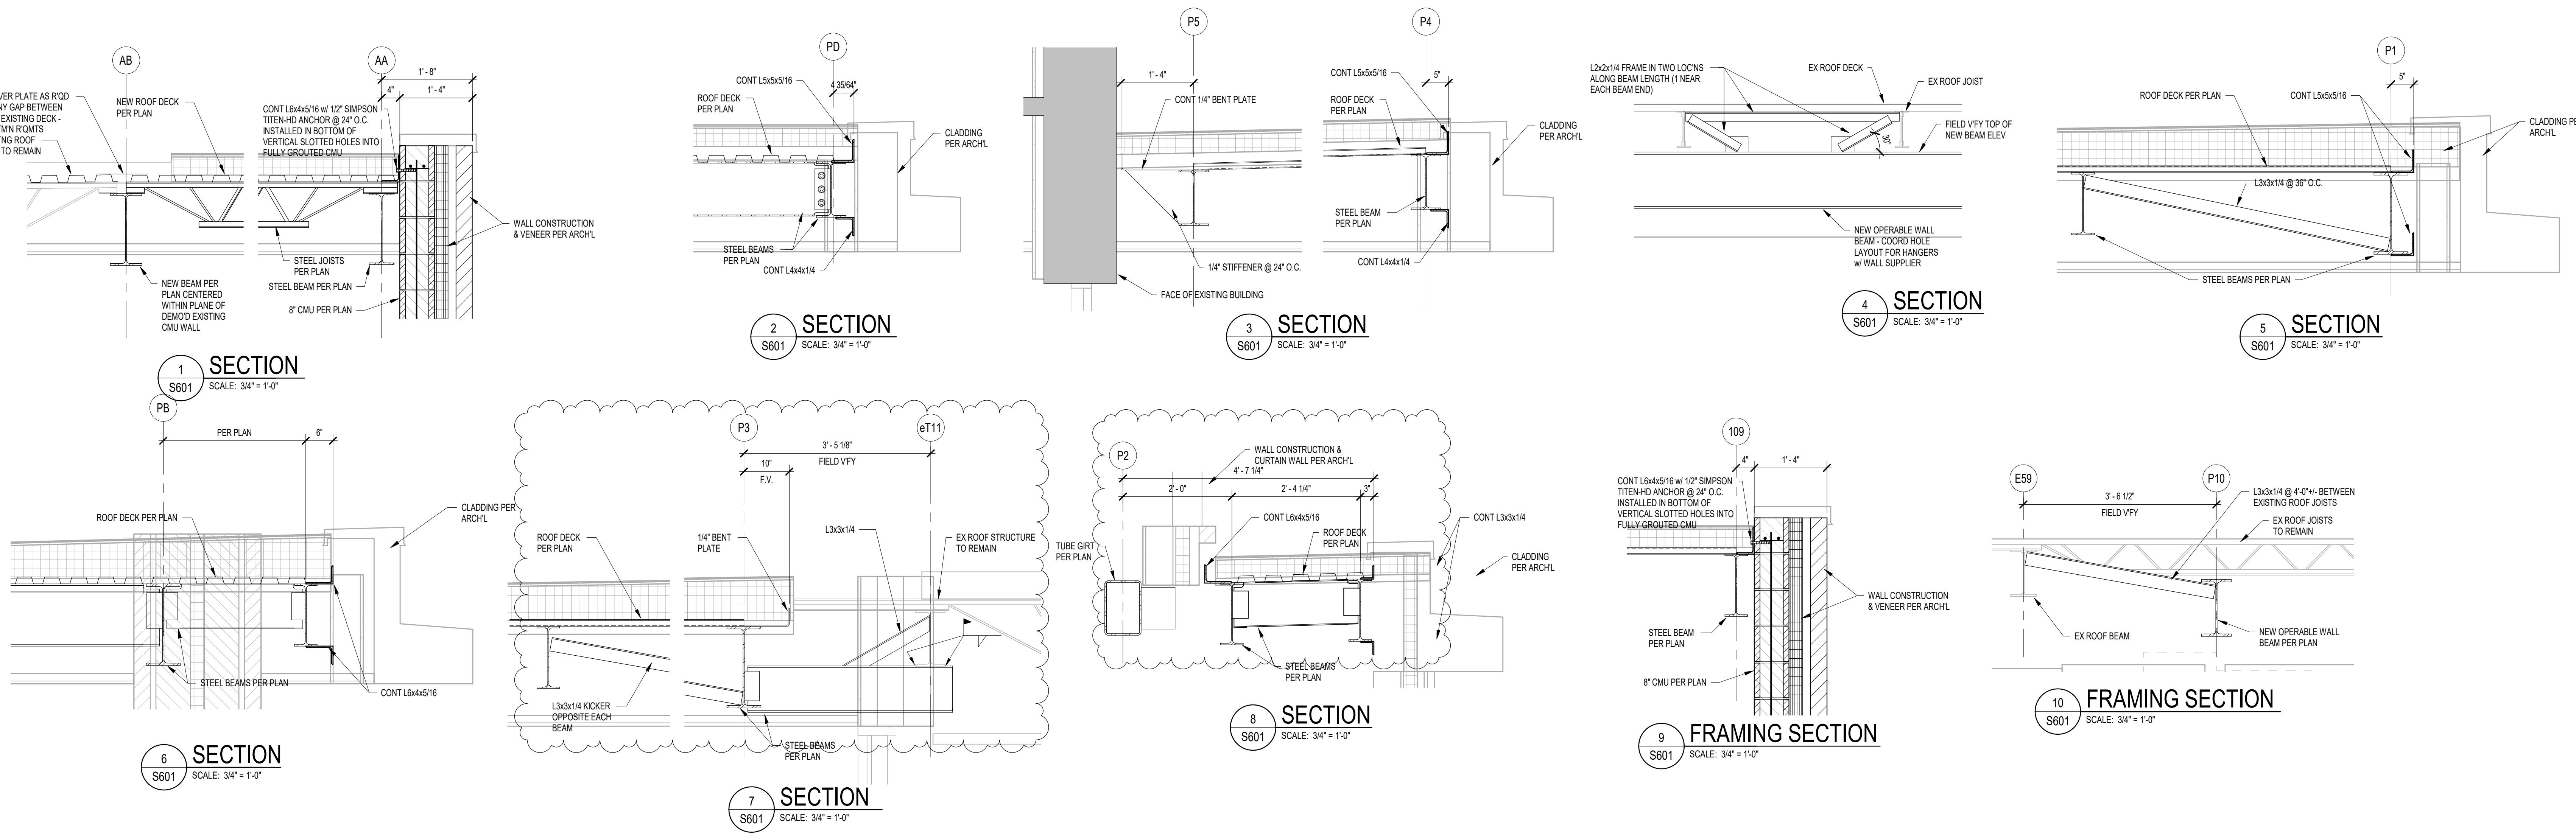





SCCSO  
317.648.7800 | [www.cssoarchitects.com](http://www.cssoarchitects.com)

317.648.7800 | [www.cssoarchitects.com](http://www.cssoarchitects.com)

PROJECT:  
WARREN CENTRAL HIGH SCHOOL  
PHASE 3 ADDITION & RENOVATION  
9500 E. 6th STREET, INDIANAPOLIS, IN 46229


SCOPE DRAWINGS:  
These drawings represent a portion of the project in terms of the architectural design concept, the dimensions of the structures, and the location of the structural, mechanical and electrical systems. They are intended to describe all the requirements of the Contract. The drawings are not to be construed as a complete description of the requirements of the Contract.

REVISIONS:

1 ADDENDUM #2 03-13-2023

ISSUE DATE DRAWN BY CHECKED BY  
02-21-2023 Author Checker

DRAWING TITLE:  
FIRST FLOOR  
PLAN - UNIT M

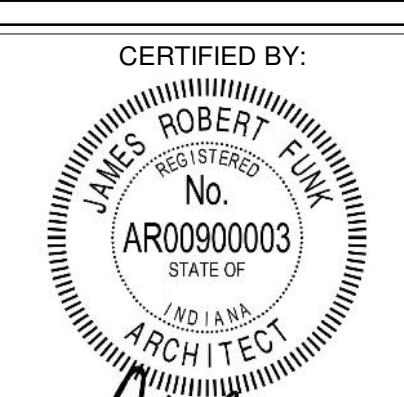

CERTIFIED BY:  
JAMES ROBERT PINK  
REGISTERED ARCHITECT  
No. AR00900003  
STATE OF INDIANA  
ARCHITECT  
*[Signature]*

DRAWING NUMBER  
A201M


PROJECT NUMBER  
2021056

GENERAL NOTES


- A. COORDINATE THE WORK OF EACH TRADE WITH THE WORK OF OTHER TRADES.
- B. ALL WORK IS TO BE COMPLETED IN STRICT ACCORDANCE WITH ALL APPLICABLE CODES, ORDINANCES, RULES, REGULATIONS AND STANDARDS INCLUDING, BUT NOT LIMITED TO THOSE LISTED ON THE COVER SHEET. ALL TRADES AND TRADES REGULATIONS ARE TO BE THE MOST RECENTLY ADOPTED EDITIONS.
- C. FIELD VERIFY EXISTING CONDITIONS AND DIMENSIONS PRIOR TO THE COMMENCEMENT OF WORK. DISCREPANCIES BETWEEN THE DOCUMENTS AND THE ACTUAL CONDITIONS SHALL BE BROUGHT TO THE ATTENTION OF THE ARCHITECT PRIOR TO THE COMMENCEMENT OF WORK.
- D. ALL DIMENSIONS ARE FROM CENTERLINE OF STRUCTURE, FINISH FACE OF WALL, FACE OF MASONRY, OR FACE OF EXISTING WALL.
- E. ANNOTATIONS AND SHOWS WHICH ARE UNLISTED ARE TO BE VERIFIED BY THE ARCHITECT. DO NOT SCALE DRAWINGS.
- F. REFER TO WALL TYPE SCHEDULE SHEET A201 TO DETERMINE WHICH WALLS EXTEND TO DECK. SEE STRUCTURAL FOR TOP SUPPORT DETAIL. WHERE NOT SHOWN, REFER TO DECK. PROVIDE SUP CONNECTIONS FOR ROOF DECK DEFLECTION.
- G. ALL STEEL STUDS ARE TO BE BRACED ACCORDING TO MANUFACTURER LUMA HEIGHT (L240).
- H. WHERE NOT SHOWN, SOUND WALLS EXTEND TO DECK. FILL DECK FULFILS WITH INSULATION. SOUND ATTENUATION REFER TO PLUMBING PLANS FOR LOCATION OF FLOOR DRAINS.
- I. WHERE ACCESS PANELS ARE SHOWN IN TOILET ROOM CHASES, FINAL LOCATION SHALL BE COORDINATED WITH OTHER TRADES PRIOR TO INSTALLATION.
- K. ALL CONCRETE MASONRY UNITS (CMU) SHALL BE LAYING BOND UNLESS OTHERWISE NOTED. CMU WALLS THAT DO NOT LAY OUT IN FULL OR HALF LENGTHS SHALL NOT EXCEED 12" AND IS NOT TO HAVE ANY PIECES LESS THAN 4" IN SIZE EXPOSED TO VIEW.
- L. ALL INTERIOR MASONRY WALLS THAT RUN TO UNDERSIDE OF DECK ABOVE SHALL HAVE A 2" JOINT (U.O.) AT THE DECK TO BE FILLED WITH FIBERGLASS INSULATION. DO NOT USE POLYESTER FIBER OR MINERAL WOOL AT THE NON-RATED WALLS TO ALLOW FOR DEFLECTION.
- M. THERE SHALL BE PERIMETER INSULATION CONTINUOUS AROUND THE ENTIRE PERIMETER OF THE BUILDING EXTENDING 2'-0" MINIMUM (R-15 MM) HORIZONTAL.
- N. PROVIDE MISCELLANEOUS SUPPORT FOR ALL CEILING SUSPENDED ITEMS.
- O. DOOR AND FRAME NUMBERS CORRESPOND TO ROOM NUMBERS. WHERE MORE THAN ONE DOOR OCCURS IN A ROOM, A SUFFIX HAS BEEN ADDED (E.G. A100-1). SEE A50 SERIES DRAWINGS FOR DOOR SCHEDULE AND DETAILS.
- P. ALL DOOR FRAMES SHALL BE LOCATED 4" OFF FINISH WALLS OR 4" OFF MASONRY UNLESS OTHERWISE NOTED.
- Q. ALL GLASS AT INTERIOR DOOR FRAMES, DOOR LITES AND WINDOW FRAMES IS TO BE 1/4" CLEAR TEMPERED GLASS UNLESS NOTED OTHERWISE.
- R. AT THE EXPANSION JOINTS, ALL PARTITIONS, CEILINGS, FLOORS AND ALL WALL, FLOOR OR CEILING MOUNTED ITEMS SHALL BE ANCHORED TO THE BUILDING STRUCTURE ONLY ON ONE SIDE OF THE EXPANSION JOINTS. CONTRACTOR SHALL COORDINATE CONSTRUCTION OR INSTALLATION OF ALL ITEMS NOTED TO ASSURE THAT NO SUCH ITEMS BREAK OR DAMAGE THE EXPANSION JOINTS.
- S. ALL SLAB-ON-GRADE CONTROL JOINTS TO BE CLEARED AND CAULKED PRIOR TO PLACEMENT OF FLOOR FINISH.
- T. SEE REFLECTED CEILING PLANS FOR BULKHEAD LOCATIONS AND DETAILS.
- U. REFER TO MECHANICAL DRAWINGS FOR WALL LOUVER LOCATIONS, SIZES AND QUANTITIES.
- V. SEE A500 SERIES DRAWINGS FOR FINISH SCHEDULE AND PLANS.
- W. SEE A500 SERIES DRAWINGS FOR EQUIPMENT SCHEDULE AND PLANS. PROVIDE BLOCKING IN STUD WALLS AND/OR GROUTED MASONRY CORES AS REQUIRED TO SUPPORT EQUIPMENT.
- X. PROVIDE REINFORCED WOOD BLOCKING SUPPORTS AS REQUIRED FOR ALL SUPPORTS.
- Y. WHERE DISIMILAR FLOOR MATERIALS MEET, THEY SHALL DO SO UNDER THE CENTERLINE OF THE DOOR UNLESS NOTED OTHERWISE.
- Z. APPLY SEALANT AT ALL JUNCTURES BETWEEN DIFFERENT MATERIALS (E.G. METAL TO CONCRETE). USE THE APPROPRIATE TYPE, PER SPECIFICATIONS, COLOR TO BE SELECTED BY ARCHITECT. APPLY SEALANT AT ALL COUNTERTOPS AND BLACKSPASHES AT JUNCTURE WITH WALL.
- AA. ALL DOORS SHALL BE INSTALLED WITH AT LEAST THE MINIMUM MANUFACTURING CLEARANCE AT THE DOOR APPROACH PER THE MOST CURRENT AMERICANS WITH DISABILITIES ACT.
- BB. BASE FLOOR ELEVATION INDICATED FOR THIS PROJECT IS 100' 0". REFER TO A5000 SERIES DRAWINGS FOR DATUM.
- CC. AT ALL NEW OR MODIFIED OPENINGS IN EXISTING MASONRY WALLS, REMOVE ADDITIONAL WALL ABOVE OPENING AND INSTALL A NEW LINTEL SIMILAR TO THE REQUIREMENTS FOR A NEW MASONRY WALL. REFER TO THE STRUCTURAL DRAWINGS FOR ADDITIONAL INFORMATION. MASONRY INFILL SHALL MATCH ADJACENT CONSTRUCTION.

KEYED PLAN NOTES

- 1 LINE OF CANOPY ABOVE
- 2 INFILL EXISTING OPENING AS REQUIRED TO MATCH EXISTING WALL. CONCRETE BLOCKS SHALL BE EXPOSED IN THE FINISH WORK. MATCH EXISTING BRICK OR BLOCK AS REQUIRED. PREPARE SURFACES FOR INSTALLATION OF NEW FINISH WHERE APPLICABLE
- 3 VISUAL DISPLAY BOARD. REFER TO INTERIOR ELEVATION AND EQUIPMENT SCHEDULE (A600 SHEETS) FOR ADDITIONAL INFORMATION.
- 4 CORNER GUARD
- 5 18" DIA. COLD RIVETED ALUMINUM COMPOSITE METAL PANEL COLUMN COVER
- 6 REINFORCED FOR OWNER-PROVIDED AIRLINE
- 7 ROUGH-IN FOR OWNER-PROVIDED CARD READER
- 8 AUTO OPERATOR PUSH BUTTON
- 9 THIS DIMENSION SHALL BE +/- AND V.I.F. COORDINATE WITH EXISTING STRUCTURE. NOTIFY ARCHITECT OF ANY DISCREPANCY
- 10 ALIGN FINISH FACES
- 11 ALUMINUM ENTRANCE DOOR
- 12 PATCH AND REPAIR EXISTING DOOR
- 13 RE-INSTALL TIME CARD READER IN ORIGINAL LOCATION AND IN ACCORDANCE WITH MANUFACTURER'S RECOMMENDATIONS
- 14 REINSTALL EQUIPMENT IN NEW LOCATION AS DIRECTED BY THE CONSTRUCTION MANAGER. INSTALLATION SHALL BE IN ACCORDANCE WITH OEM RECOMMENDATIONS.
- 15 PATCH AND REPAIR WALL WHERE INTERSECTING WALL HAS BEEN REMOVED.
- 16 RE-INSTALL SPECIALTY SEDANAGE PREVIOUSLY REMOVED AT EACH LAB.
- 17 RE-INSTALL STORED TIME PUNCH MACHINE AND CARD HOLDERS.
- 18 INSTALL GLASSING FILM AT ALL GLASS SURFACES OF EXISTING WINDOW. REFER TO A600 SHEETS FOR ADDITIONAL INFORMATION.
- 19 RE-INSTALL STORED MEDICAL EQUIPMENT IN PREVIOUS LOCATION. REFER TO AD200 SHEETS FOR ADDITIONAL INFORMATION.
- 20 INSTALL NEW ELECTRIC WATER COOLER WITH EXISTING ROUGH-IN AT THIS LOCATION.
- 21 REFER TO 1A403 & 4A402 FOR INFORMATION REGARDING NEW FOUNDATION WALL ADDED ON TOP OF EXISTING FOOTING.
- 22 MATCH ADJACENT WALL CONSTRUCTION AND ALIGN FINISH FACES
- 23 TUCKPOINT, CLEAN, AND SEAL LIMESTONE VENEER. REFER TO MAINTENANCE OF UNIT MASONRY SPECIFICATIONS
- 24 PAIR OF 1/4" x 4" x 18" CLEAR ANODIZED ALUMINUM TUBES WITH A CROSS RAIL. PROVIDE COOLED MOUNTING TO TOP OF PALL AND BOTTOM OF BULKHEAD.

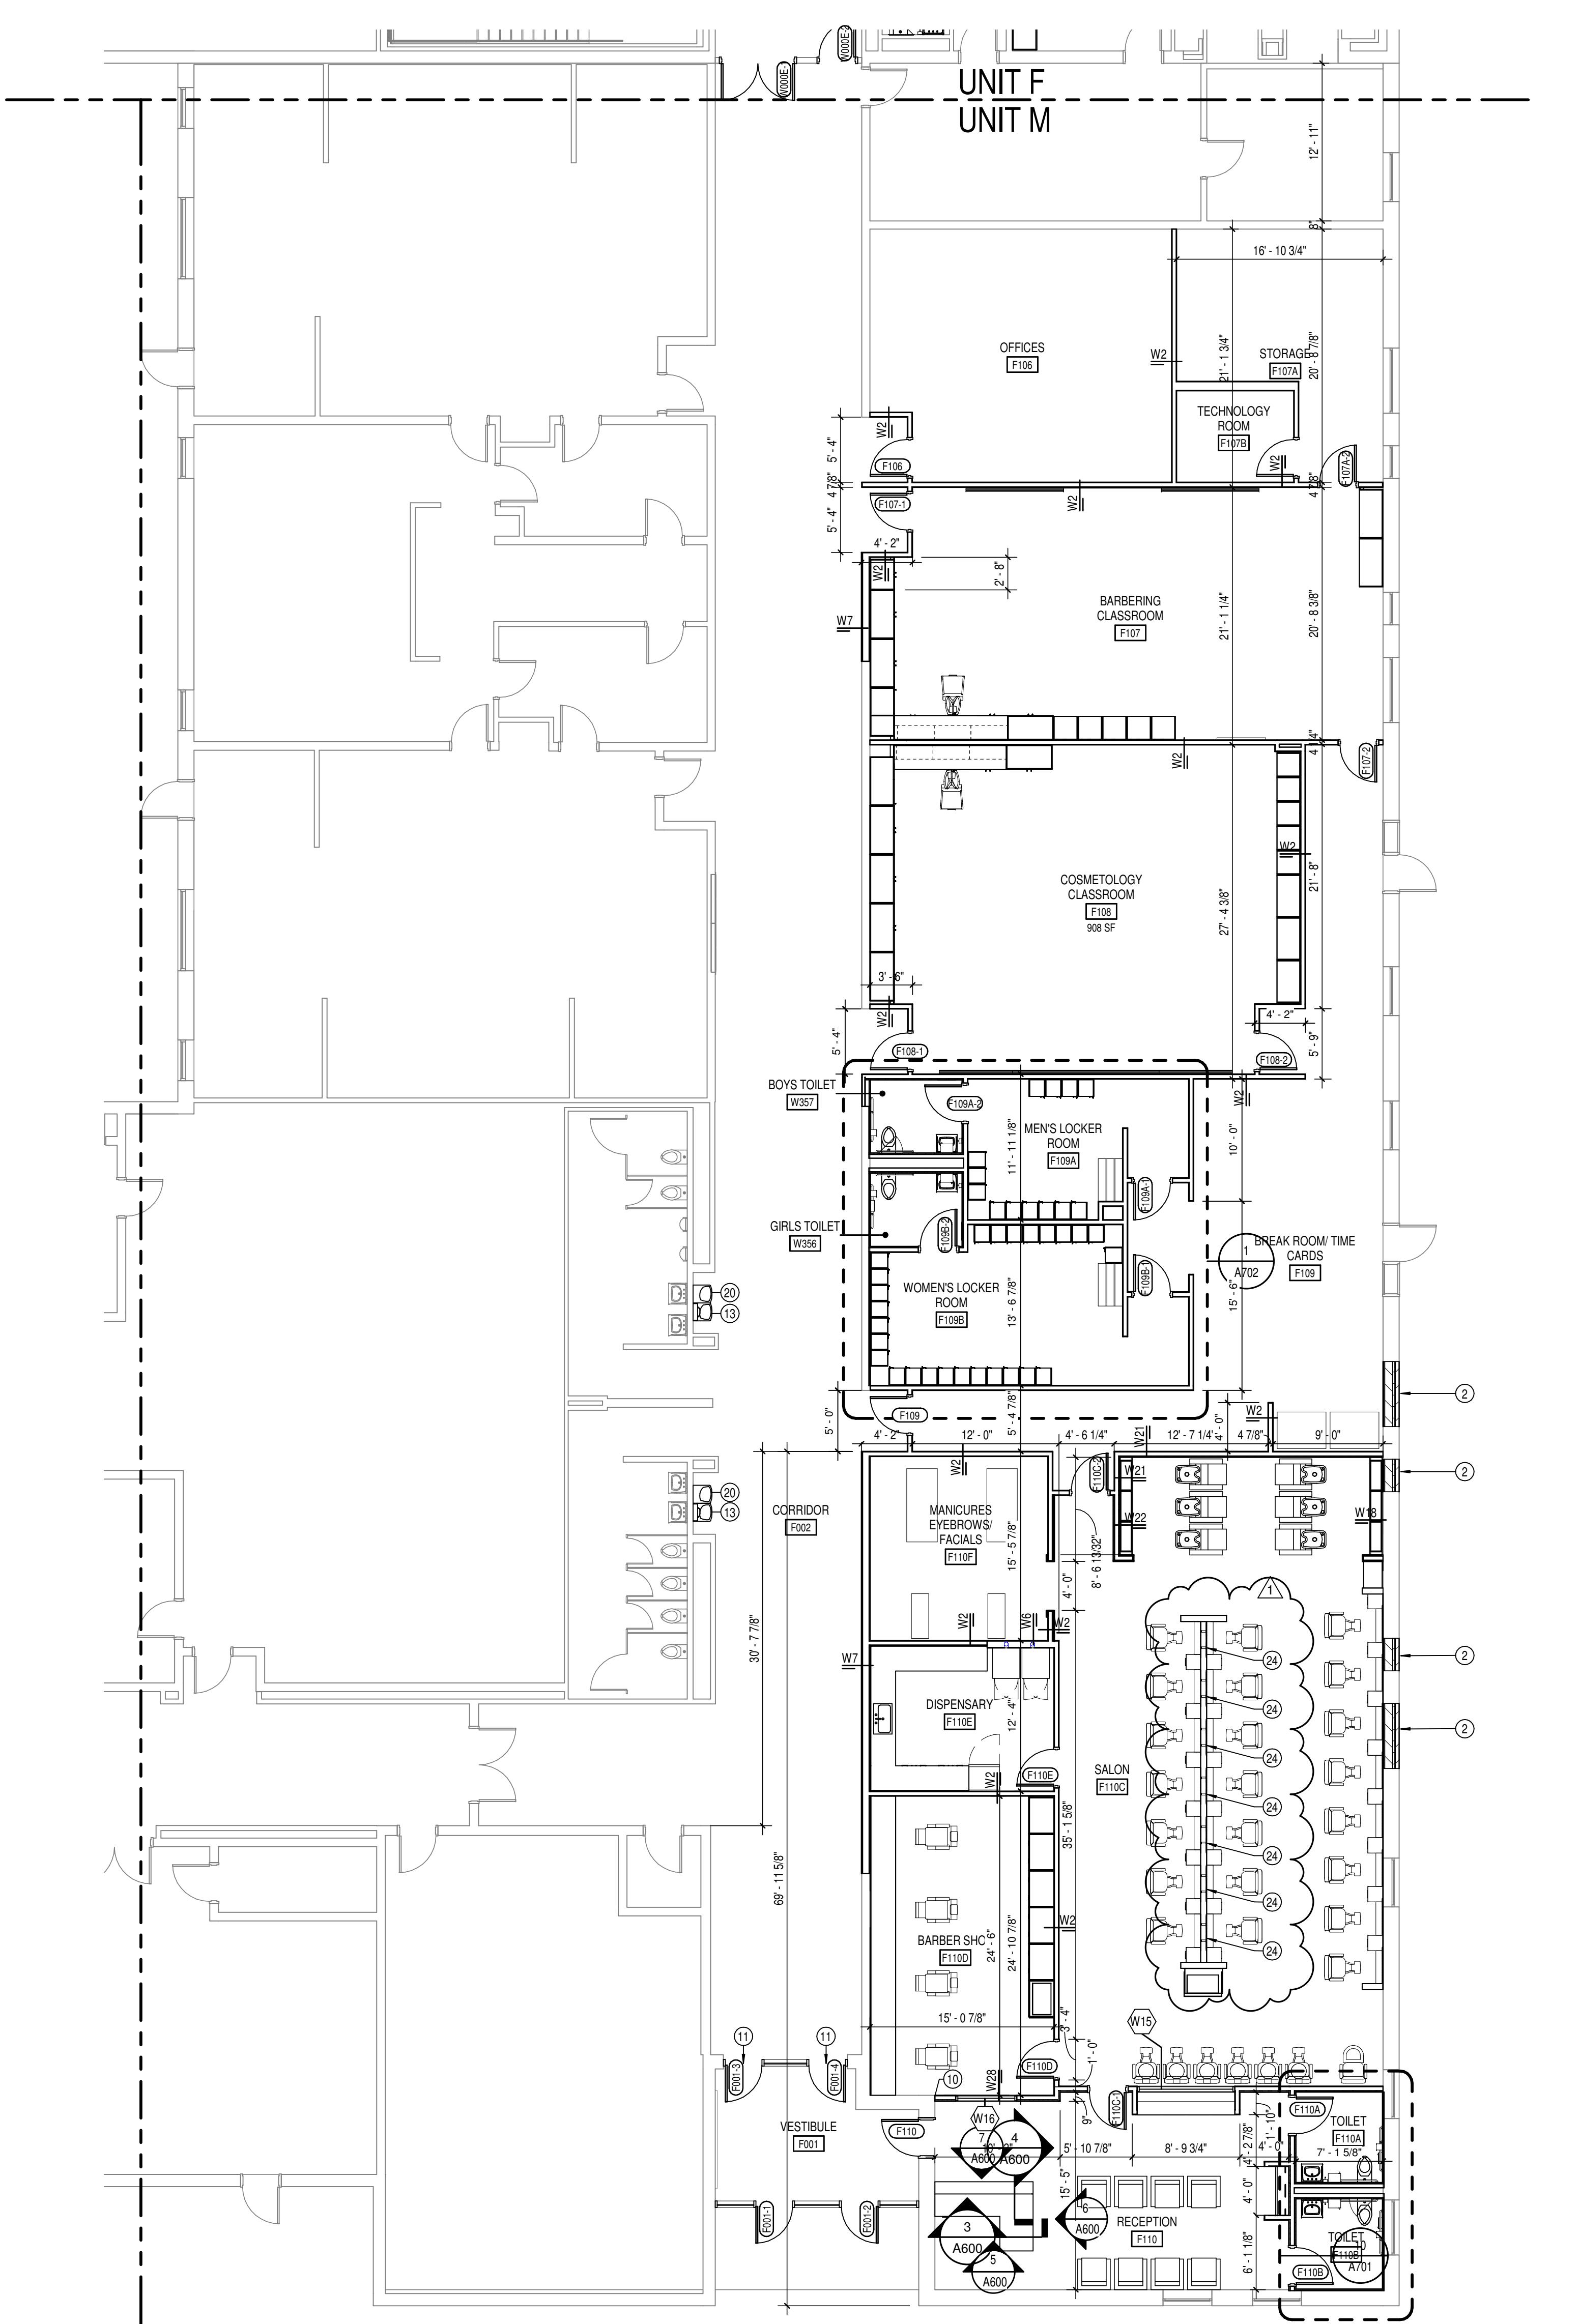

1 FIRST FLOOR PLAN - UNIT M  
A201M  
SCALE: 1/8" x 1'-0"

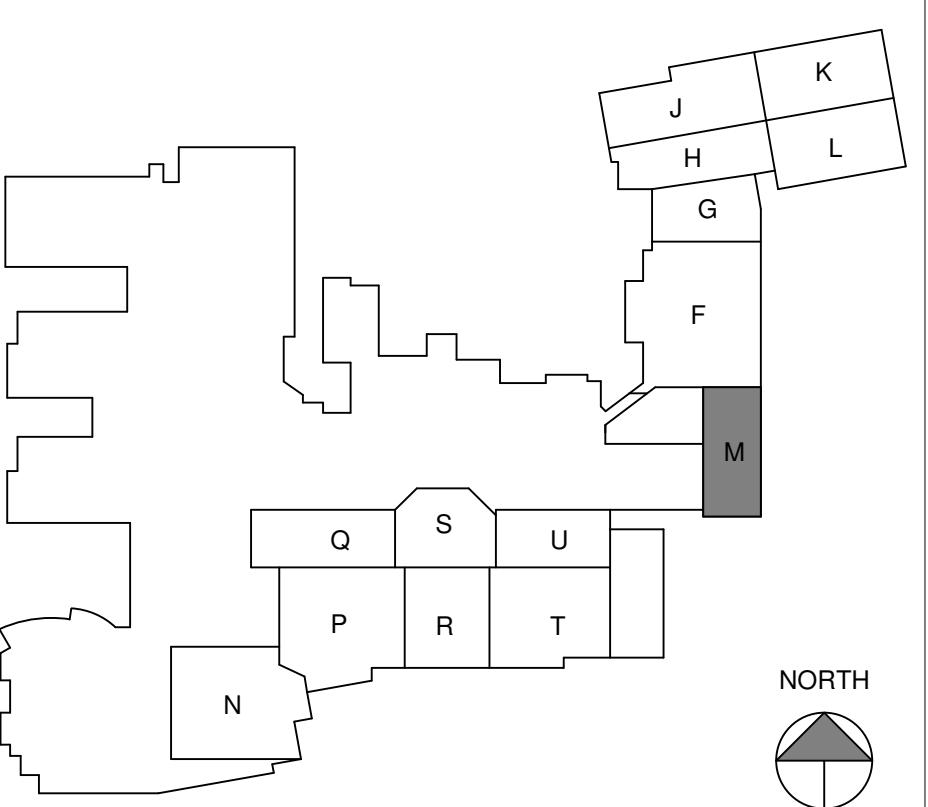

DRAWING NUMBER  
A201M  
PROJECT NUMBER  
2021056



SCSO

8831 Keystone Crossing, Indianapolis, IN 46240  
317.648.7800 | [www.scsolife.com](http://www.scsolife.com)

© 2020 SCSO Architects, Inc. All rights reserved.

## GENERAL NOTES

- A. COORDINATE THE WORK OF EACH TRADE WITH THE WORK OF OTHER TRADES.
- B. ALL WORK IS TO BE COMPLETED IN STRICT ACCORDANCE WITH ALL APPLICABLE CODES, ORDINANCES, RULES, REGULATIONS AND STANDARDS INCLUDING, BUT NOT LIMITED TO THOSE LISTED ON THE COVER SHEET. ALL TRADES, CONTRACTORS AND REGULATIONS ARE TO BE MOVED AND ADAPTED AS NEEDED.
- C. FIELD VERIFY EXISTING CONDITIONS AND DIMENSIONS PRIOR TO THE COMMENCEMENT OF WORK. DISCREPANCIES BETWEEN THE DOCUMENTS AND THE ACTUAL CONDITIONS SHALL BE BROUGHT TO THE ATTENTION OF THE ARCHITECT PRIOR TO THE COMMENCEMENT OF WORK.
- D. ALL DIMENSIONS ARE FROM CENTERLINE OF STRUCTURE, FINISH FACE OF WALL, FACE OF MASONRY, OR FACE OF EXISTING WALL.
- E. ANNOTATIONS AND SHOWS WHICH ARE UNLISTED ARE TO BE VERIFIED BY ARCHITECT. DO NOT SCALE DRAWINGS.
- F. REFER TO WALL TYPE SCHEDULE SHEET A201 TO DETERMINE WHICH WALLS EXTEND TO DECK. SEE STRUCTURAL FOR SUPPORT DETAIL. WHERE NOT STATED, EXTEND TO DECK. PROVIDE SUP CONNECTIONS FOR ROOF FLOOR DEFLECTION.
- G. ALL STEEL STUDS ARE TO BE BRACED ACCORDING TO MANUFACTURER LUMINAR HEIGHT (L240).
- H. WHERE EXPOSED, SOUND WALLS EXTEND TO DECK. FILL DECK FULVES WITH INSULATION. SOUND ATTENUATION.
- I. REFER TO PLUMBING PLANS FOR LOCATION OF FLOOR DRAINS.
- J. WHERE ACCESS PANELS ARE SHOWN IN TOILET ROOM CHASES, FINAL LOCATION SHALL BE COORDINATED WITH OTHER TRADES PRIOR TO INSTALLATION.
- K. ALL CONCRETE MASONRY UNITS (CMU) SHALL BE LAYING BOND UNLESS OTHERWISE SHOWN. CMU WALLS THAT DO NOT LAY OUT IN FULL OR HALF LENGTHS SHALL BE CUT TO LENGTH AS NOT TO HAVE ANY PIECES LESS THAN 4" IN SIZE EXPOSED TO VIEW.
- L. ALL INTERIOR MASONRY WALLS THAT RUN TO UNDERSIDE OF DECK ABOVE SHALL HAVE A 2" JOINT (U.O.) AT THE DECK TO BE FILLED WITH FIBERGLASS INSULATION. DO NOT USE POLYESTER FIBER OR MINERAL WOOL AT THE NON-RATED WALLS TO ALLOW FOR DEFLECTION.
- M. THERE SHALL BE PERIMETER INSULATION CONTINUOUS AROUND THE ENTIRE PERIMETER OF THE BUILDING EXTENDING 2'-0" MINIMUM (R-15 MIN. HORIZONTAL).
- N. PROVIDE MISCELLANEOUS SUPPORT FOR ALL CEILING SUSPENDED ITEMS.
- O. DOOR AND FRAME NUMBERS CORRESPOND TO ROOM NUMBERS. WHERE MORE THAN ONE DOOR OCCURS IN A ROOM, A SUFFIX HAS BEEN ADDED (E.G. A10-1). SEE A500 SERIES DRAWINGS FOR DOOR SCHEDULE AND DETAILS.
- P. ALL DOOR FRAMES SHALL BE LOCATED 4" OFF FINISH WALLS OR 4" OFF MASONRY UNLESS OTHERWISE SHOWN.
- Q. ALL GLASS AT INTERIOR DOOR FRAMES, DOOR LITES AND WINDOW FRAMES IS TO BE 1/4" CLEAR TEMPERED GLASS UNLESS NOTED OTHERWISE.
- R. AT EXPANSION JOINTS, ALL PARTITIONS, CEILINGS, FLOORS AND ALL WALL, FLOOR OR CEILING MOUNTED ITEMS SHALL BE ANCHORED TO THE BUILDING STRUCTURE ONLY ON ONE SIDE OF THE EXPANSION JOINTS. CONTRACTOR SHALL COORDINATE CONSTRUCTION OR INSTALLATION OF ALL ITEMS NOTED TO ASSURE THAT NO SUCH ITEMS BRIDGE THE EXPANSION JOINTS.
- S. ALL SLAB-ON-GRADE CONTROL JOINTS TO BE CLEARED AND CAULKED PRIOR TO PLACEMENT OF FLOOR FINISH.
- T. SEE REFLECTED CEILING PLANS FOR BULKHEAD LOCATIONS AND DETAILS.
- U. REFER TO MECHANICAL DRAWINGS FOR WALL LOUVER LOCATIONS, SIZES AND QUANTITIES.
- V. SEE A500 SERIES DRAWINGS FOR FINISH SCHEDULE AND PLANS.
- W. SEE A500 SERIES DRAWINGS FOR EQUIPMENT SCHEDULE AND PLANS. PROVIDE BLOCKING IN STUD WALLS AND/OR GROUTED MASONRY CORES AS REQUIRED TO SUPPORT EQUIPMENT.
- X. PROVIDE REINFORCED WOOD BLOCKING SUPPORTS AS REQUIRED FOR ALL SHELVING UNITS. WHERE SHELVING IS EXPOSED IN THE FINISH WORK, MATCH EXISTING BRICK OR BLOCK AS REQUIRED. PREPARE SURFACES FOR INSTALLATION OF NEW FINISH WHERE APPLICABLE.
- Y. WHERE DISIMILAR FLOOR MATERIALS MEET, THEY SHALL DO SO UNDER THE CENTERLINE OF THE DOOR UNLESS NOTED OTHERWISE.
- Z. APPLY SEALANT AT ALL JUNCTURES BETWEEN DIFFERENT MATERIALS (E.G. METAL TO CONCRETE). USE THE TYPE OF SEALANT AND THE APPROPRIATE TYPE PER SPECIFICATION. COLOR TO BE SELECTED BY ARCHITECT. APPLY SEALANT AT ALL COUNTERTOP AND BLACK SPLASHES AT JUNCTURE WITH WALL.
- AA. ALL DOORS SHALL BE INSTALLED WITH AT LEAST THE MINIMUM MANUFACTURING CLEARANCE AT THE DOOR APPROACH PER THE MOST CURRENT AMERICANS WITH DISABILITIES ACT.
- BB. BASE FLOOR ELEVATION INDICATED FOR THIS PROJECT IS 100'. REFER TO A101 FOR FLOOR ELEVATION TO DATUM.
- CC. AT ALL NEW OR MODIFIED OPENINGS IN EXISTING MASONRY WALLS, REMOVE ADDITIONAL WALL ABOVE OPENING AND INSTALL A NEW LINTEL SIMILAR TO THE REQUIREMENTS FOR A NEW MASONRY WALL. REFER TO THE STRUCTURAL DRAWINGS FOR ADDITIONAL INFORMATION. MASONRY INFILL SHALL MATCH ADJACENT CONSTRUCTION.

## KEYED PLAN NOTES

- 1 LINE OF CANOPY ABOVE
- 2 INFILL EXISTING OPENING AS REQUIRED TO MATCH EXISTING WALL CONSTRUCTION. EXPOSED WALL IS EXPOSED IN THE FINISH WORK. MATCH EXISTING BRICK OR BLOCK AS REQUIRED. PREPARE SURFACES FOR INSTALLATION OF NEW FINISH WHERE APPLICABLE
- 3 VISUAL DISPLAY BOARD. REFER TO INTERIOR ELEVATION AND EQUIPMENT SCHEDULE (A600 SERIES SHEETS) FOR ADDITIONAL INFORMATION.
- 4 CORNER GUARD
- 5 18" DIA. COLD RIVETIZED ALUMINUM COMPOSITE METAL PANEL COLUMN COVER
- 6 REINFORCED FOR OWNER-PROVIDED AIRLINE
- 7 ROUGH-IN FOR OWNER-PROVIDED CARD READER
- 8 AUTO OPERATOR PUSH BUTTON
- 9 THIS DIMENSION SHALL BE +/- AND V.I.F. COORDINATE WITH EXISTING STRUCTURE. NOTIFY ARCHITECT OF ANY DISCREPANCY
- 10 ALIGN FINISH FACES
- 11 ALUMINUM ENTRANCE DOOR
- 12 PATCH AND REPAIR EXISTING DOOR
- 13 RE-INSTALL EQUIPMENT IN ORIGINAL LOCATION AND IN ACCORDANCE WITH MANUFACTURER'S RECOMMENDATIONS
- 14 RE-INSTALL EQUIPMENT IN NEW LOCATION AS DIRECTED BY THE CONSTRUCTION MANAGER. INSTALLATION SHALL BE IN ACCORDANCE WITH OEM RECOMMENDATIONS
- 15 PATCH AND REPAIR WALL WHERE INTERSECTING WALL HAS BEEN REMOVED.
- 16 RE-INSTALL STORED TIME PUNCH MACHINE AND CARD HOLDERS
- 17 RE-INSTALL STORED TIME PUNCH MACHINE AND CARD HOLDERS
- 18 INSTALL GLASS FILM AT ALL GLASS SURFACES OF EXISTING WINDOW. REFER TO A600 SERIES SHEETS FOR ADDITIONAL INFORMATION.
- 19 RE-INSTALL STORED MEDICAL EQUIPMENT IN PREVIOUS LOCATION. REFER TO A620 SERIES SHEETS FOR ADDITIONAL INFORMATION.
- 20 INSTALL NEW ELECTRIC WATER COOLER WITH EXISTING ROUGH-IN AT THIS LOCATION
- 21 REFER TO 1/A403 & 4/A404 FOR INFORMATION REGARDING NEW FOUNDATION WALL ADDED ON TOP OF EXISTING FOOTING
- 22 MATCH ADJACENT WALL CONSTRUCTION AND ALIGN FINISH FACES
- 23 TUCKPOINT, CLEAN AND SEAL LIMESTONE VENEER. REFER TO MAINTENANCE OF UNIT MASONRY SPECIFICATION
- 24 PAIR OF 3/4" x 4" x 18" CLEAR ANODIZED ALUMINUM TUBES WITH A CROSS RAIL. PROVIDE COOLED MOUNTING TO TOP OF PALL AND BOTTOM OF BULKHEAD.

PROJECT:

MSD OF WARREN TOWNSHIP

WARREN CENTRAL HIGH SCHOOL  
PHASE 3 ADDITION & RENOVATION  
9500 E. 6th STREET, INDIANAPOLIS, IN 46229

SCOPE DRAWINGS:  
These drawings are a part of the project. In terms of the architectural design concept, the dimensions of the building, structural, mechanical and electrical systems, the location of equipment, and other details described all the requirements of the Contract. The drawings are to be used in conjunction with the scope indicated or the trade contractors shall furnish all items required for the proper execution and completion of the work.

REVISIONS:

1 ADDENDUM #2 03-13-2023


ISSUE DATE DRAWN BY CHECKED BY

DRAWING TITLE:  
FIRST FLOOR  
PLAN - UNIT N

CERTIFIED BY:  
JAMES ROBERT PINK  
REGISTERED ARCHITECT  
No. AR00900003  
STATE OF INDIANA  
J.R.P.

DRAWING NUMBER  
A201N

PROJECT NUMBER  
2021056

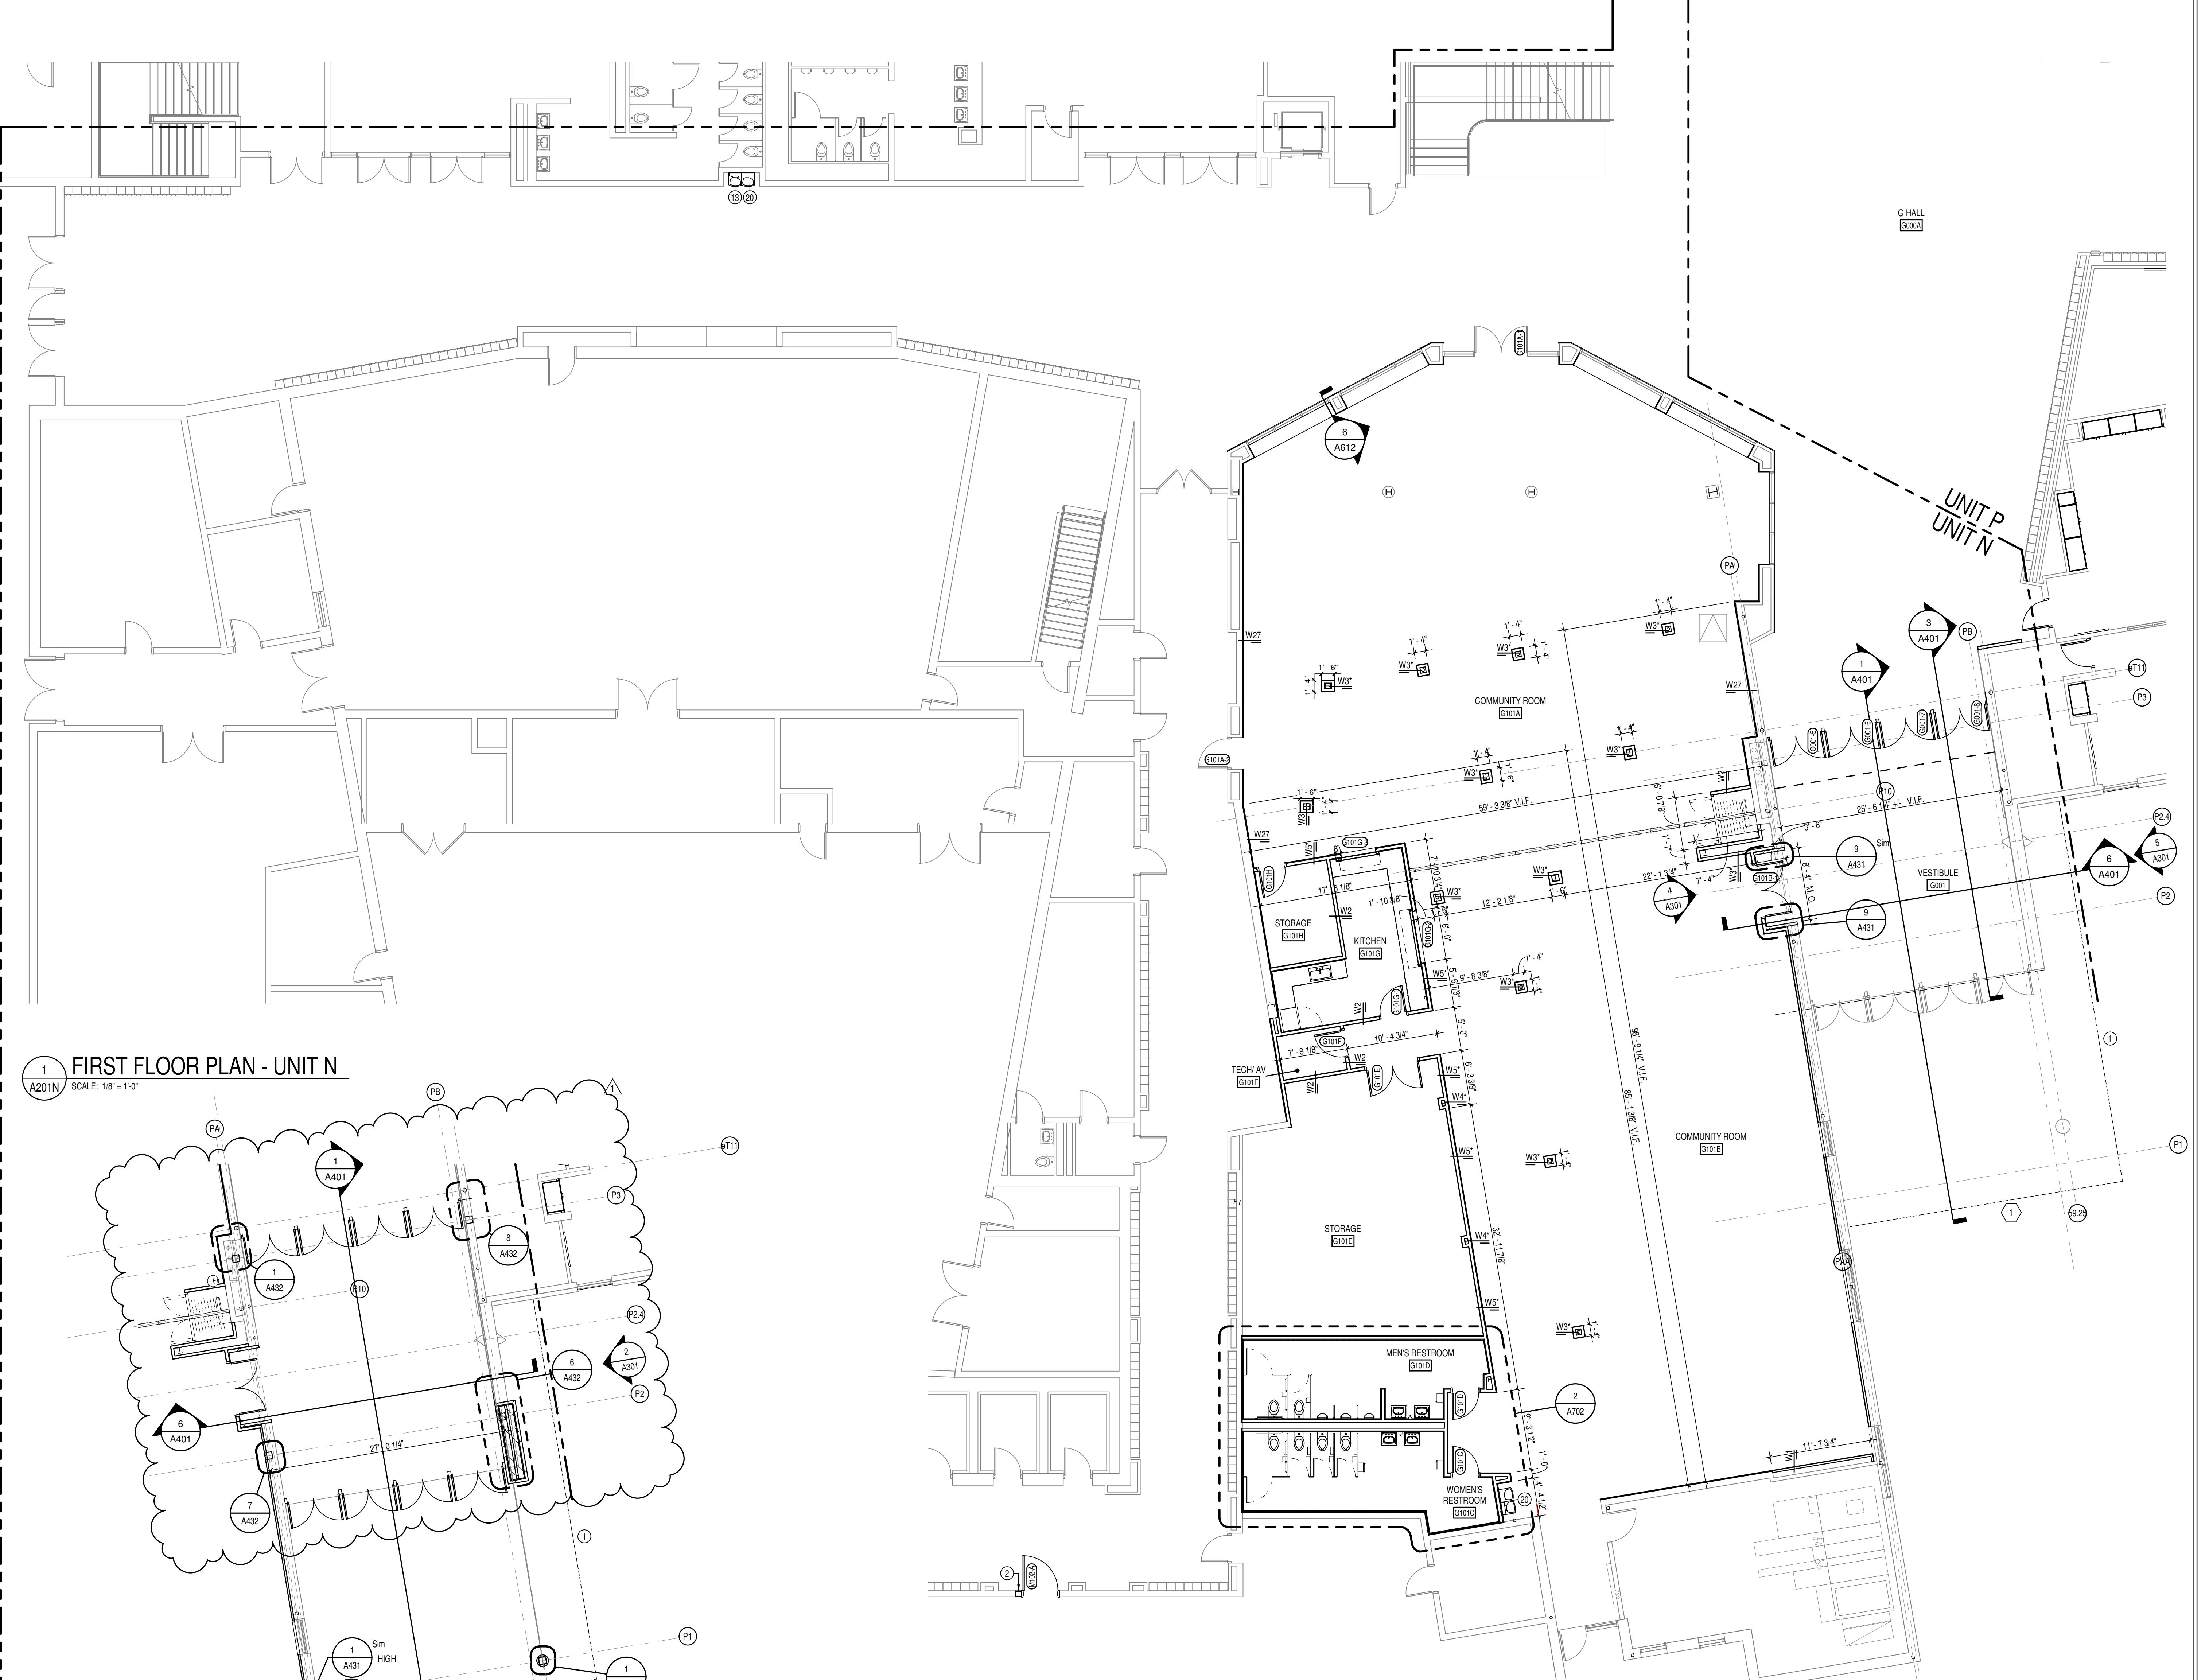



SCCSO  
3831 Keystone Crossing, Indianapolis, IN 46240  
317.448.7800 | csoarchitects.com

© 2020 CCSO Architects, Inc. All rights reserved.

## GENERAL NOTES

- A. COORDINATE THE WORK OF EACH TRADE WITH THE WORK OF OTHER TRADES.
- B. ALL WORK IS TO BE COMPLETED IN STRICT ACCORDANCE WITH ALL APPLICABLE CODES, ORDINANCES, RULES, REGULATIONS AND STANDARDS INCLUDING, BUT NOT LIMITED TO THOSE LISTED ON THE COVER SHEET. ALL TRADES AND TRADES REGULATIONS ARE TO BE THE MOST RECENTLY ADOPTED EDITIONS.
- C. FIELD VERIFY EXISTING CONDITIONS AND DIMENSIONS PRIOR TO THE COMMENCEMENT OF WORK. DISCREPANCIES BETWEEN THE DOCUMENTS AND THE ACTUAL CONDITIONS SHALL BE BROUGHT TO THE ATTENTION OF THE ARCHITECT PRIOR TO THE COMMENCEMENT OF WORK.
- D. ALL DIMENSIONS ARE FROM CENTERLINE OF STRUCTURE, FINISH FACE OF WALL, FACE OF MASONRY, OR FACE OF EXISTING CONSTRUCTION.
- E. ANNOTATIONS AND SHOWS WHICH ARE UNLISTED ARE TO BE VERIFIED BY WALL ARCHITECT. DO NOT SCALE DRAWINGS.
- F. REFER TO WALL TYPE SCHEDULE SHEET A202A TO DETERMINE WHICH WALLS EXTEND TO DECK. SEE STRUCTURAL FOR TOP SUPPORT DETAIL. WHERE A WALL IS NOT EXTENDED TO DECK, PROVIDE SUPP CONNECTIONS FOR ROOF DECK DEFLECTION.
- G. ALL STEEL STUDS ARE TO BE BRACED ACCORDING TO MANUFACTURER LUM. HEIGHT (L240).
- H. WHERE EXISTING OR SOUND WALLS EXTEND TO DECK, FILL DECK FULVES WITH INSULATION. SOUND ATTENUATION.
- I. REFER TO PLUMBING PLANS FOR LOCATION OF FLOOR DRAINS.
- J. WHERE ACCESS PANELS ARE SHOWN IN TOILET ROOM CHASES, FINAL LOCATION SHALL BE COORDINATED WITH OTHER TRADES PRIOR TO INSTALLATION.
- K. ALL CONCRETE MASONRY UNITS (CMU) SHALL BE LAID RUNNING BOND UNLESS OTHERWISE SHOWN. CMU WALLS THAT DO NOT LAY OUT IN FULL OR HALF LENGTHS SHALL BE CUT TO LENGTHS AS NOT TO HAVE ANY PIECES LESS THAN 4" IN SIZE EXPOSED TO VIEW.
- L. ALL INTERIOR MASONRY WALLS THAT RUN TO UNDERSIDE OF DECK ABOVE SHALL HAVE A 2" JOINT (U.N.O.) AT THE DECK TO BE FILLED WITH FIBERGLASS INSULATION. EXPOSED MASONRY SHALL BE COATED WITH MINERAL WOOL AT THE NON-RATED WALLS TO ALLOW FOR DEFLECTION.
- M. THERE SHALL BE PERIMETER INSULATION CONTINUOUS AROUND THE ENTIRE PERIMETER OF THE BUILDING EXTENDING 2'-0" MINIMUM (R-15 MIN. HORIZONTAL).
- N. PROVIDE MISCELLANEOUS SUPPORT FOR ALL CEILING SUSPENDED ITEMS.
- O. DOOR AND FRAME NUMBERS CORRESPOND TO ROOM NUMBERS. WHERE MORE THAN ONE DOOR OCCURS IN A ROOM, A SUFFIX HAS BEEN ADDED (E.G. A101-1). SEE A500 SERIES DRAWINGS FOR DOOR SCHEDULE AND DETAILS.
- P. ALL DOOR FRAMES SHALL BE LOCATED 1" OFF FINISH WALLS OR 4" OFF MASONRY UNLESS OTHERWISE SHOWN.
- Q. ALL GLASS AT INTERIOR DOOR FRAMES, DOOR LITES AND WINDOW FRAMES IS TO BE 1/4" CLEAR TEMPERED GLASS UNLESS NOTED OTHERWISE.
- R. AT EXISTING EXPANSION JOINTS, ALL PARTITIONS, CEILINGS, FLOORS AND ALL WALL, FLOOR OR CEILING MOUNTED ITEMS SHALL BE ANCHORED TO THE BUILDING STRUCTURE ONLY ON ONE SIDE OF THE EXPANSION JOINTS. CONTRACTOR SHALL COORDINATE CONSTRUCTION OR INSTALLATION OF ALL ITEMS NOTED TO ASSURE THAT NO SUCH ITEMS ARE PLACED ON THE EXPANSION JOINTS.
- S. ALL SLAB-ON-GRADE CONTROL JOINTS TO BE CLEARED AND CAULKED PRIOR TO PLACEMENT OF FLOOR FINISH.
- T. SEE REFLECTED CEILING PLANS FOR BULKHEAD LOCATIONS AND DETAILS.
- U. REFER TO MECHANICAL DRAWINGS FOR WALL LOUVER LOCATIONS, SIZES AND QUANTITIES.
- V. SEE A500 SERIES DRAWINGS FOR FINISH SCHEDULE AND PLANS.
- W. SEE A500 SERIES DRAWINGS FOR EQUIPMENT SCHEDULE AND PLANS. PROVIDE BLOCKING IN STUD WALLS AND/OR GROUTED MASONRY CORES AS REQUIRED TO SUPPORT EQUIPMENT.
- X. PROVIDE ELEVATED AND TREATED WOOD BLOCKING SUPPORTS AS REQUIRED FOR ALL SUPPORTS THAT ARE EXPOSED IN THE FINISH WALL.
- Y. WHERE DISIMILAR FLOOR MATERIALS MEET, THEY SHALL DO SO UNDER THE CENTERLINE OF THE DOOR UNLESS NOTED OTHERWISE.
- Z. APPLY SEALANT AT ALL JUNCTURES BETWEEN DIFFERENT MATERIALS (E.G. METAL TO CONCRETE). USE THE APPROPRIATE TYPE, COLOR AND QUANTITY AS NOTED ON THE DRAWING. USE THE APPROPRIATE COLOR TO BE SELECTED BY ARCHITECT. APPLY SEALANT AT ALL COUNTERTOPS AND BLACK SPLASHES AT JUNCTURE WITH WALL.
- AA. ALL EXISTING DOORS INSTALLED WITH AT LEAST THE MINIMUM MANUFACTURING CLEARANCE AT THE DOOR APPROACH PER THE MOST CURRENT AMERICANS WITH DISABILITIES ACT.
- BB. BASE FLOOR ELEVATION INDICATED FOR THIS PROJECT IS 100' 0". REFER TO A500 SERIES DRAWINGS FOR FLOOR DATUM.
- CC. AT ALL NEW OR MODIFIED OPENINGS IN EXISTING MASONRY WALLS, REMOVE ADDITIONAL WALL ABOVE OPENING AND INSTALL A NEW LINTEL SIMILAR TO THE REQUIREMENTS FOR A NEW MASONRY WALL. REFER TO THE STRUCTURAL DRAWINGS FOR ADDITIONAL INFORMATION. MASONRY INFILL SHALL MATCH ADJACENT CONSTRUCTION.

## KEYED PLAN NOTES

- 1 LINE OF CANOPY ABOVE
- 2 INFILL EXISTING OPENING AS REQUIRED TO MATCH EXISTING WALL CONSTRUCTION. EXISTING WALL IS EXPOSED IN THE FINISH WORK. MATCH EXISTING BRICK OR BLOCK AS REQUIRED. PREPARE SURFACES FOR INSTALLATION OF NEW FINISH WHERE APPLICABLE
- 3 VISUAL DISPLAY BOARD. REFER TO INTERIOR ELEVATION AND EQUIPMENT SCHEDULE (A600 SERIES SHEETS) FOR ADDITIONAL INFORMATION.
- 4 CORNER GUARD
- 5 18" DIA. COLD RIVETIZED ALUMINUM COMPOSITE METAL PANEL COLUMN COVER
- 6 ROUGH-IN FOR OWNER-PROVIDED AIR/PIPE
- 7 ROUGH-IN FOR OWNER-PROVIDED CARD READER
- 8 AUTO OPERATOR PUSH BUTTON
- 9 THIS DIMENSION SHALL BE +/- AND V.I.F. COORDINATE WITH EXISTING STRUCTURE. NOTIFY ARCHITECT OF ANY DISCREPANCY
- 10 ALIGN FINISH FACES
- 11 ALUMINUM ENTRANCE DOOR
- 12 PATCH AND REPAIR EXISTING DOOR
- 13 RE-INSTALL TIME PUNCH MACHINE IN ORIGINAL LOCATION AND IN ACCORDANCE WITH MANUFACTURER'S RECOMMENDATIONS
- 14 REINSTALL EQUIPMENT IN NEW LOCATION AS DIRECTED BY THE CONSTRUCTION MANAGER. INSTALLATION SHALL BE IN ACCORDANCE WITH OEM RECOMMENDATIONS.
- 15 PATCH AND REPAIR WALL WHERE INTERSECTING WALL HAS BEEN REMOVED.
- 16 RE-INSTALL SPECIALTY SIGHTING PREVIOUSLY REMOVED AT EACH LAB.
- 17 RE-INSTALL STORED TIME PUNCH MACHINE AND CARD HOLDERS
- 18 INSTALL GLASS FILM AT ALL GLASS SURFACES OF EXISTING WINDOW. REFER TO A600 SERIES SHEETS FOR ADDITIONAL INFORMATION.
- 19 RE-INSTALL STORED MEDICAL EQUIPMENT IN PREVIOUS LOCATION. REFER TO A600 SERIES SHEETS FOR ADDITIONAL INFORMATION.
- 20 INSTALL NEW ELECTRIC WATER COOLER WITH EXISTING ROUGH-IN AT THIS LOCATION
- 21 REFER TO 1/A403 & 4/A404 FOR INFORMATION REGARDING NEW FOUNDATION WALL ADDED ON TOP OF EXISTING FOOTING
- 22 MATCH ADJACENT WALL CONSTRUCTION AND ALIGN FINISH FACES
- 23 TUCKPOINT, CLEAN, AND SEAL LIMESTONE VENEER. REFER TO MAINTENANCE OF UNIT MASONRY SPECIFICATION
- 24 PAIR OF 3/4" x 4" x 18" CLEAR ANODIZED ALUMINUM TUBES WITH A CROSS RAIL. PROVIDE COOLED MOUNTING TO TOP OF PALL AND BOTTOM OF BULKHEAD.

PROJECT:  
MSD OF WARREN TOWNSHIP

WARREN CENTRAL HIGH SCHOOL  
PHASE 3 ADDITION & RENOVATION  
9500 E. 16th STREET, INDIANAPOLIS, IN 46229


SCOPE DRAWINGS:  
These drawings represent a portion of the project in terms of architectural design concept, the dimensions of the structure, and the location of structural, mechanical and electrical systems. They are not to be construed as being complete or describing all the requirements of the Contract.

REVISIONS:

- 1 ADDENDUM #2 03-13-2023

ISSUE DATE DRAWN BY CHECKED BY  
02-21-2023 Author Checker


DRAWING TITLE:  
SECOND FLOOR  
PLAN - UNIT N

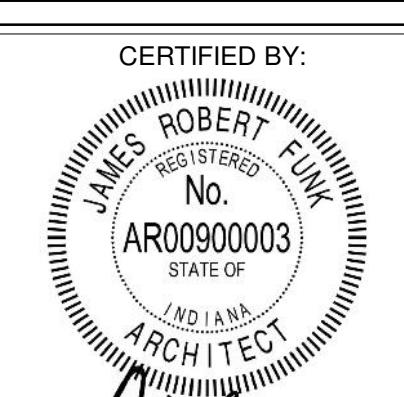


CERTIFIED BY:  
JAMES ROBERT FINK  
REGISTERED ARCHITECT  
No. AR00900003  
STATE OF INDIANA  
ARCHITECT  
*J.R.F.*

DRAWING NUMBER  
A202N


PROJECT NUMBER  
2021056

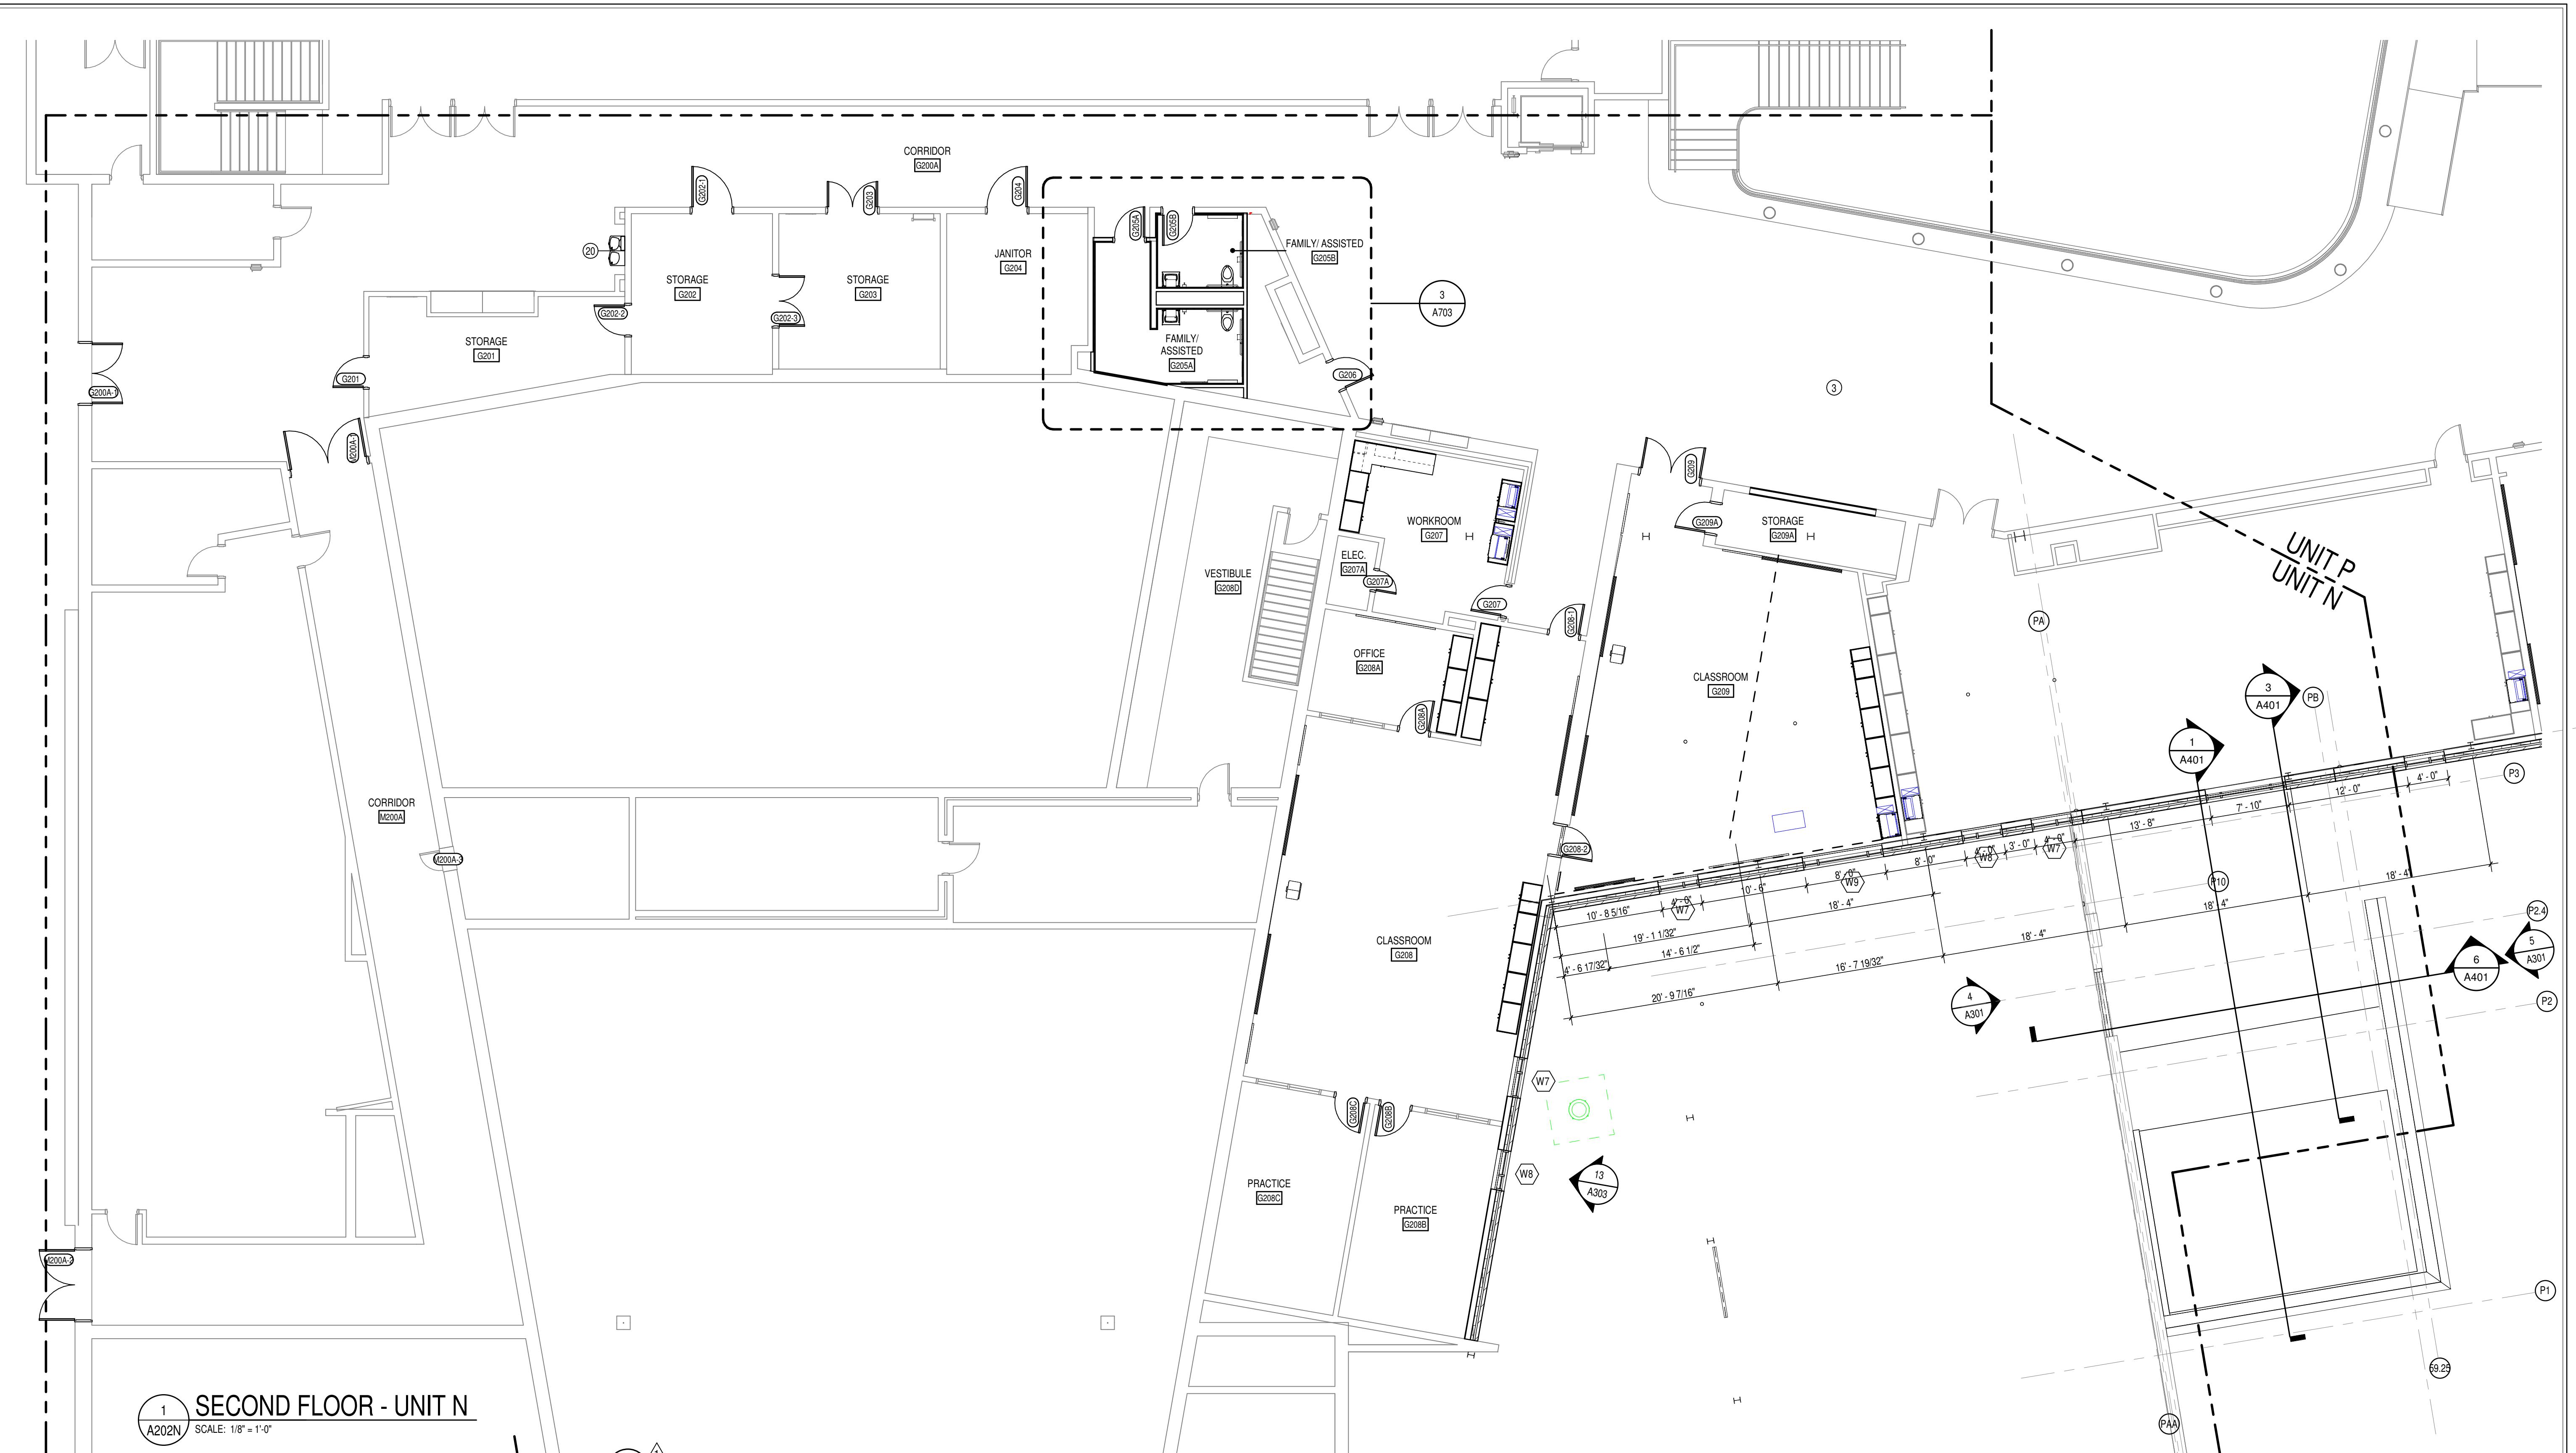


SECOND FLOOR - UNIT N  
1 A202N SCALE: 1/8" = 1'-0"

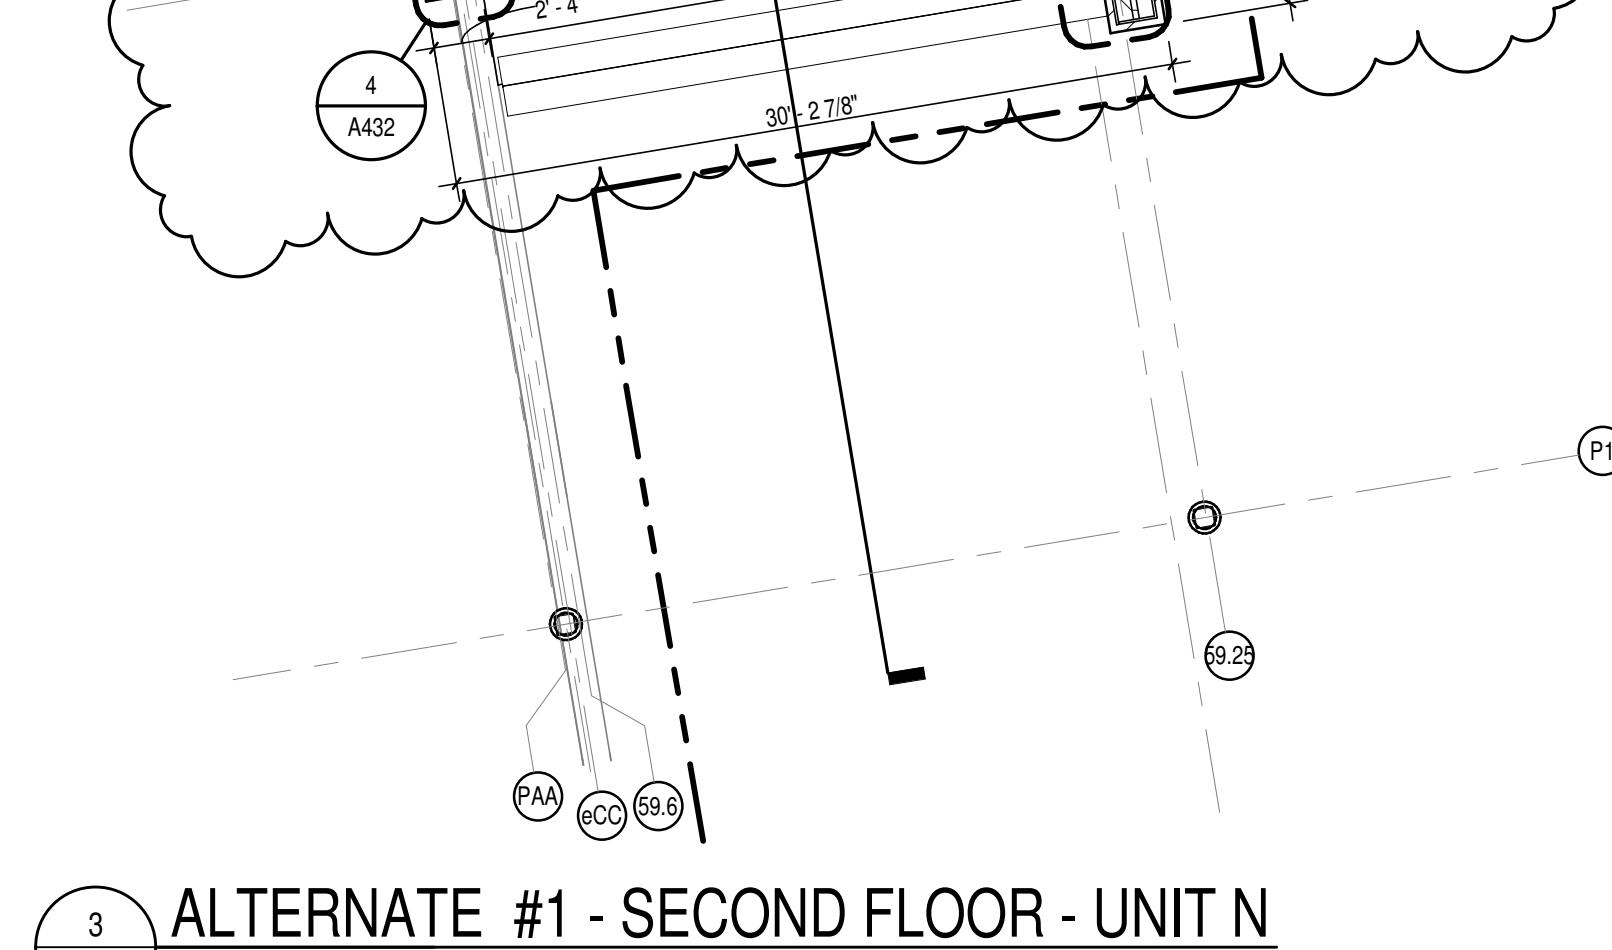


ALTERNATE #1 - SECOND FLOOR - UNIT N  
3 A202N SCALE: 1/8" = 1'-0"

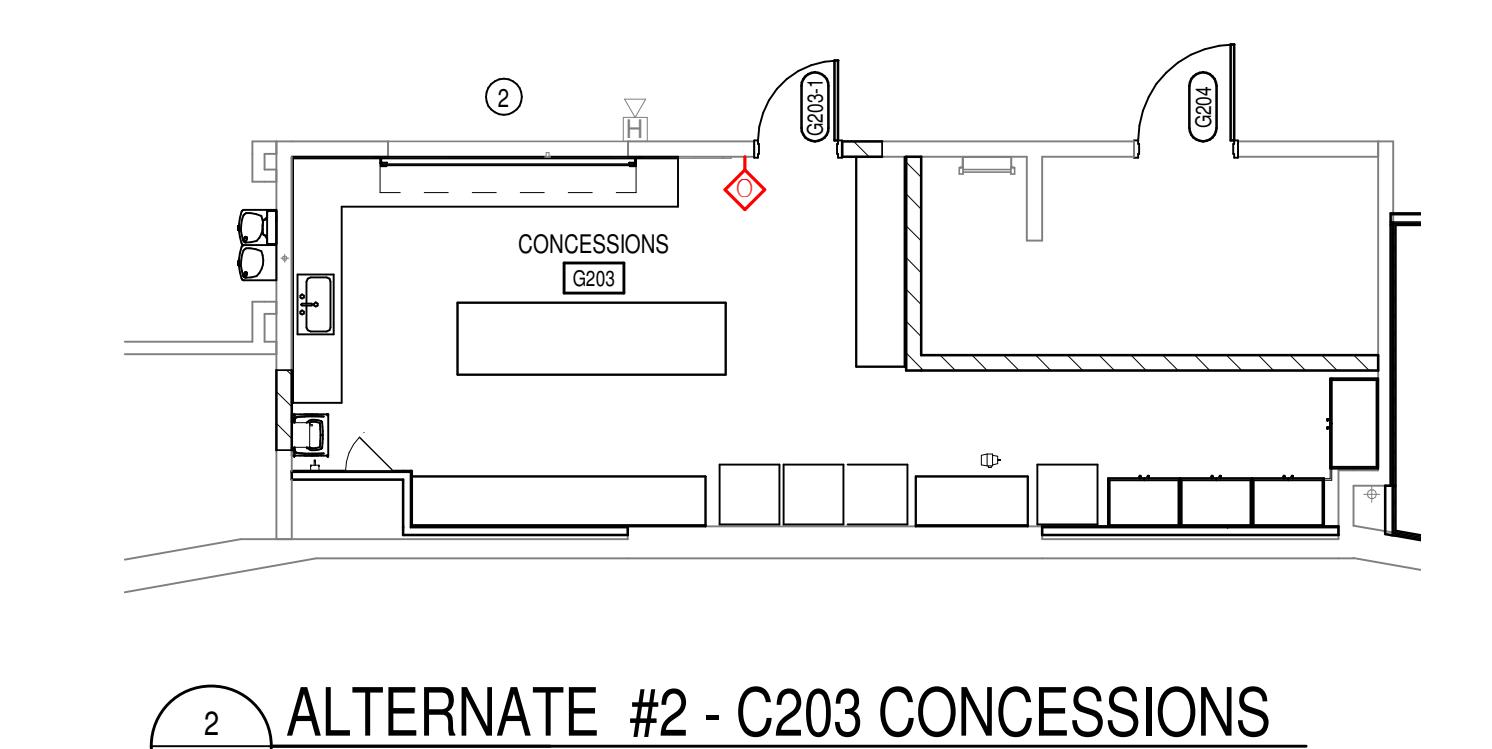

ALTERNATE #2 - C203 CONCESSIONS  
2 A202N SCALE: 1/8" = 1'-0"

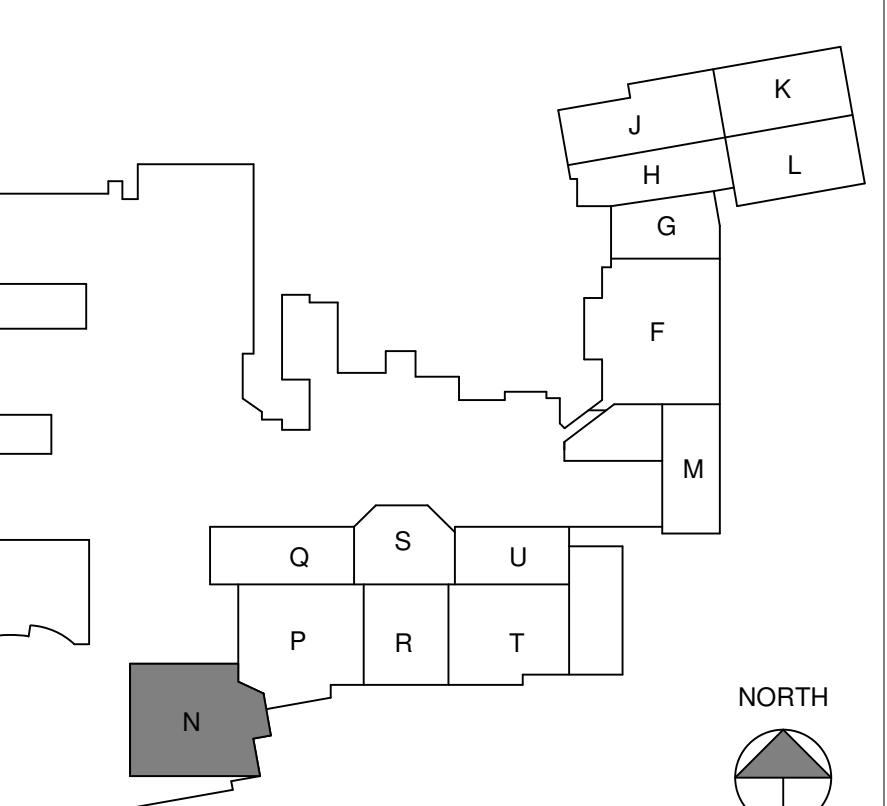

NORTH

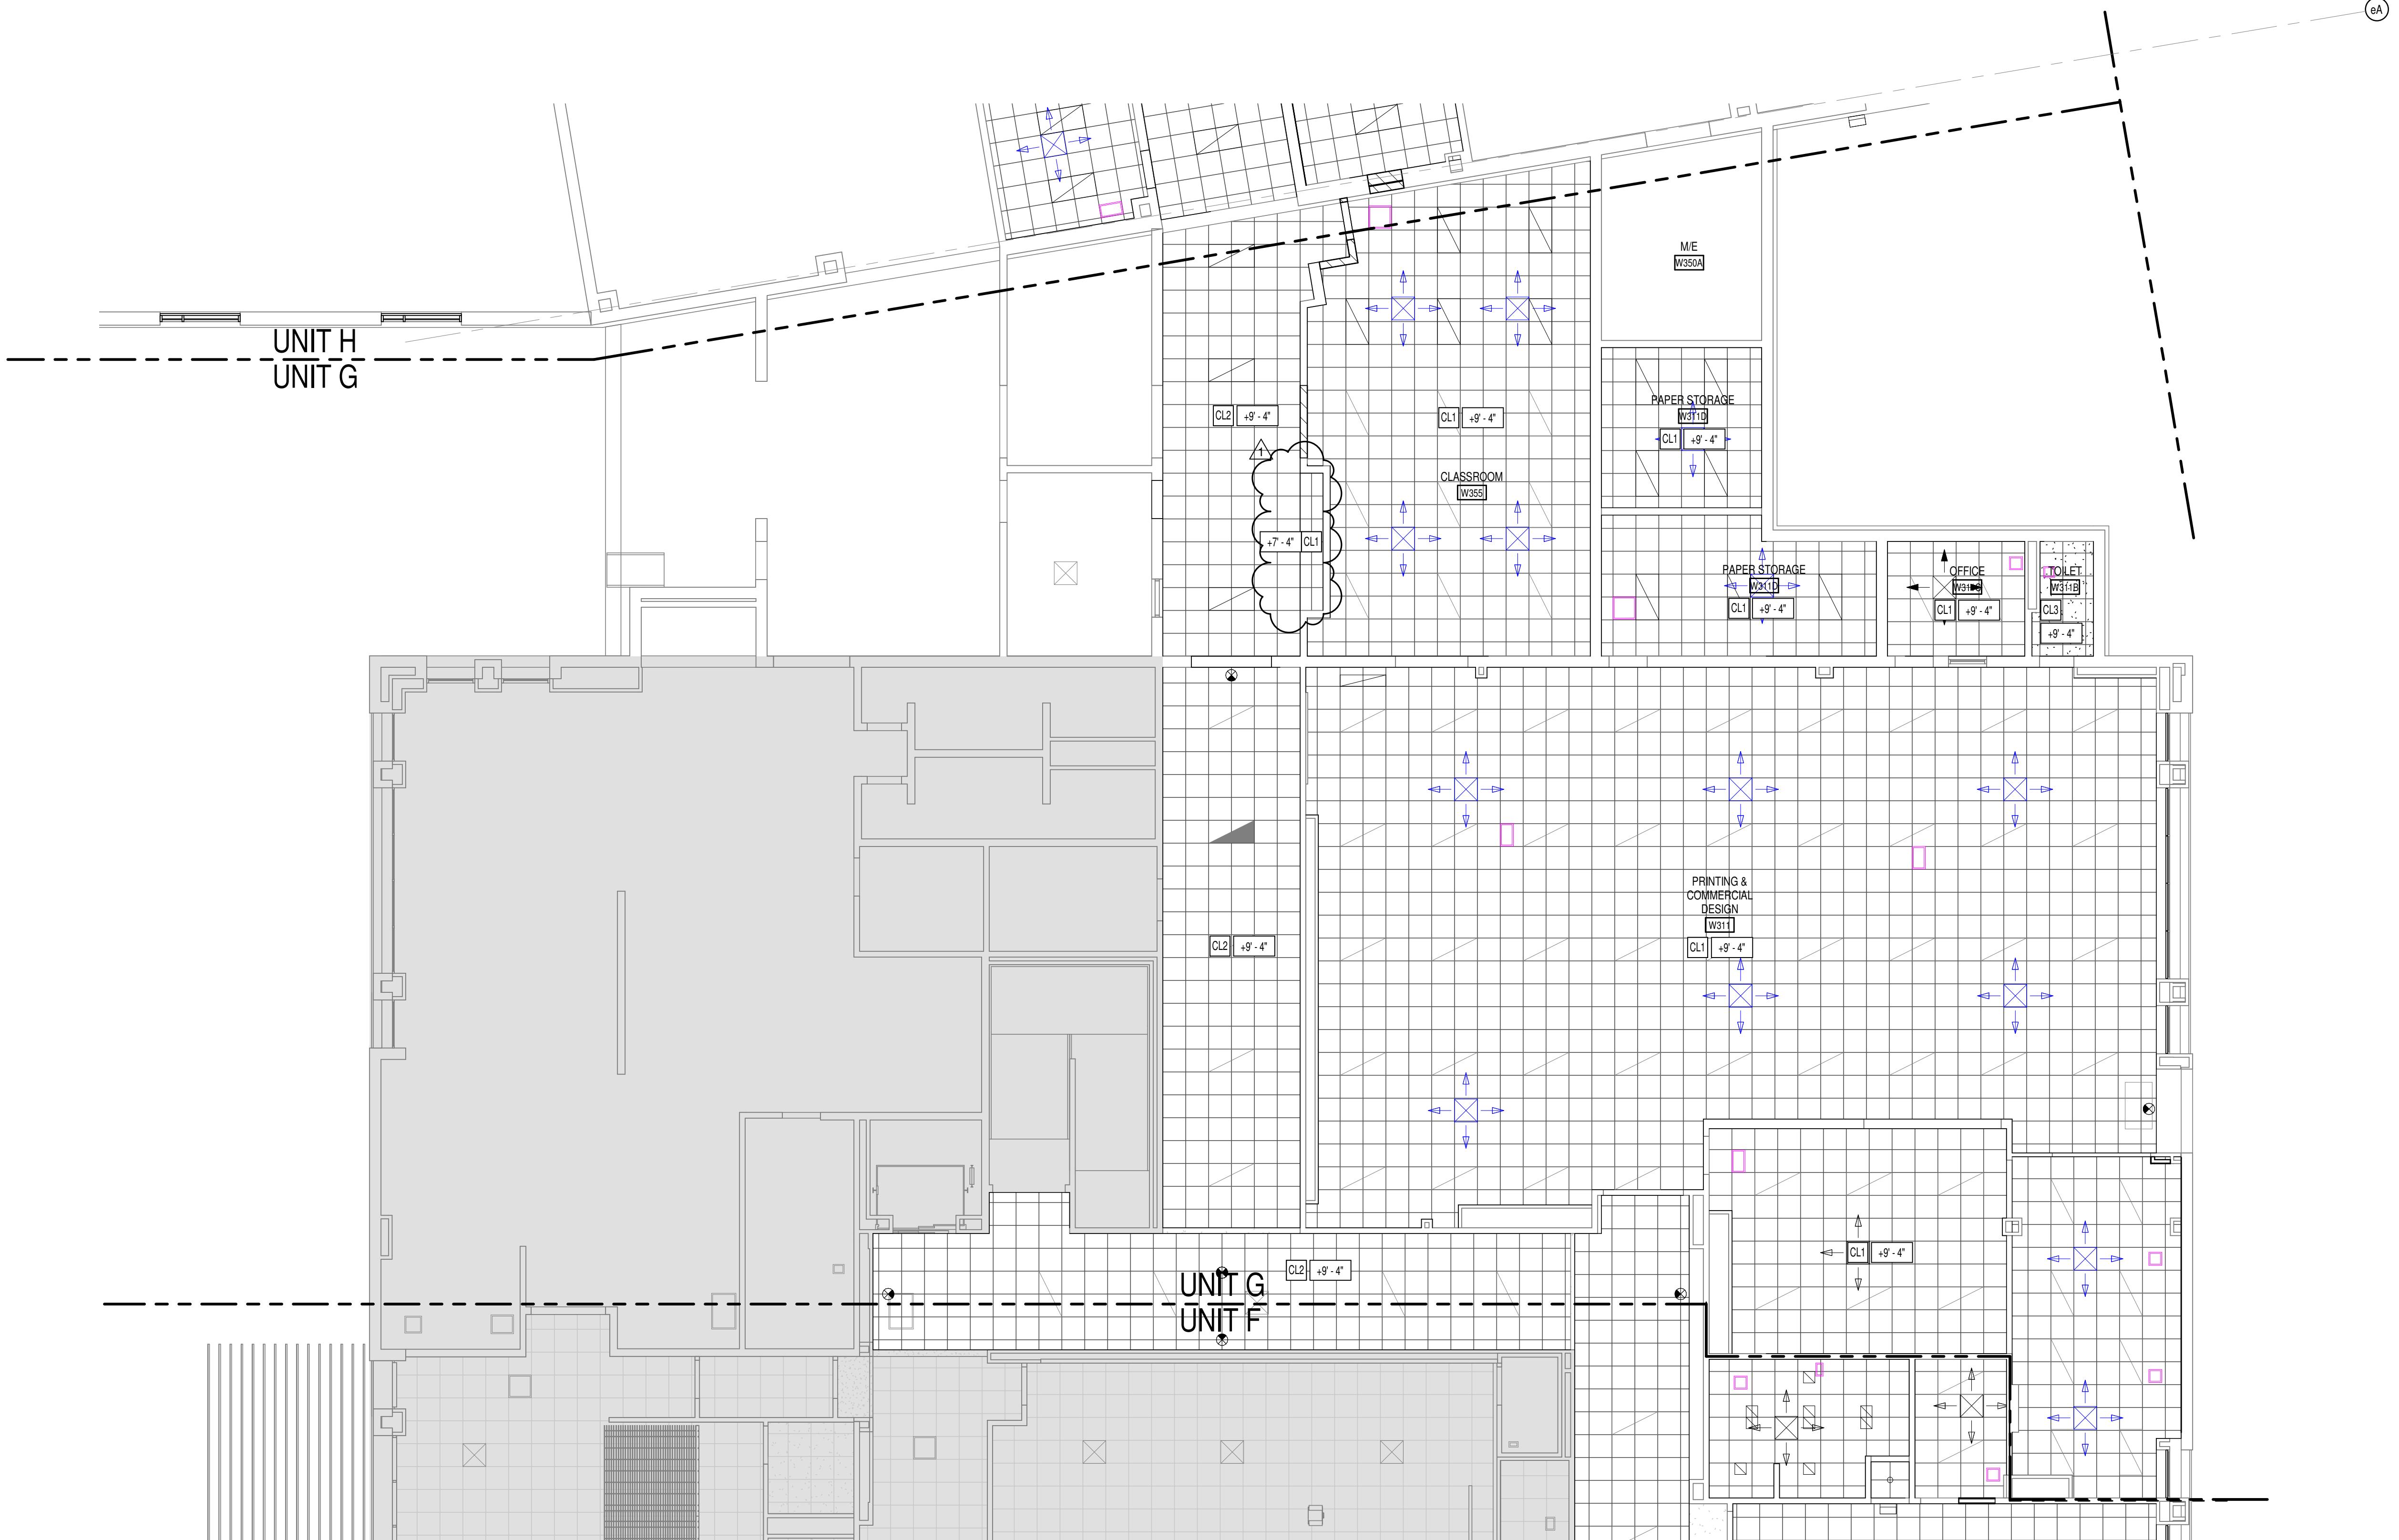

1 REFLECTED CEILING PLAN - FIRST FLOOR - UNIT G  
A211G SCALE: 1'0" = 1'-0"

REFLECTED CEILING LEGEND	
	FLUORESCENT LIGHT FIXTURES, RECESSED OR SURFACE-MOUNTED. SEE ELECTRICAL DRAWINGS.
	DOWNLIGHT/HIGH BAY LIGHT FIXTURE; SEE ELECTRICAL DRAWINGS.
	CEILING MOUNTED PROJECTOR; SEE TECHNOLOGY DRAWINGS.
	RETURN/EXHAUST GRILL; SEE MECHANICAL DRAWINGS.
	SUPPLY AIR GRILL; SEE MECHANICAL DRAWINGS.
	LINEAR SLOT SUPPLY AIR GRILL; SEE MECHANICAL DRAWINGS.
	SUSPENDED ACOUSTIC LAY-IN CEILING MFG: ARMSTRONG MODEL #3354
	STYLE: OPTIMA DESCRIPTION: SQUARE REGULAR EDGE COLOR: WHITE SIZE: 2' x 2' x 1"
	LOCATION: CLASSROOMS
	MFG: ARMSTRONG MODEL #1941
	STYLE: ULTRA DESCRIPTION: RECTANGULAR REGULAR EDGE COLOR: WHITE SIZE: 2' x 4' x 1"
	LOCATION: CORRIDORS
	SUSPENDED ACOUSTIC LAY-IN CEILING MFG: ARMSTRONG MODEL #1447
	STYLE: ULTRA HEALTH ZONE DESCRIPTION: RECTANGULAR REGULAR EDGE COLOR: WHITE SIZE: 2' x 2' x 1"
	LOCATION: RESTROOMS/KITCHENS
	SUSPENDED GYPSUM WALLBOARD CEILING SYSTEM USE 5/8" WALLBOARD PAINT: P8 CEILING BRIGHT WHITE UNLESS NOTED OTHERWISE.
	GYPSUM WALLBOARD BULKHEAD PAINT: SEE A800 SERIES FINISH PLANS.
	EXPOSED STRUCTURE - PAINTED SEE FINISH PLANS
	DAFS SOFFIT
	4'-0" CEILING ELEVATION MARK ABOVE FINISHED FLOOR (AT THAT LOCATION IF MULTIPLE FLOOR LEVELS ARE PRESENT)
	ME MATCH EXISTING CEILING ELEVATION

### GENERAL REFLECTED CEILING PLAN NOTES

- SEE THE ELECTRICAL DRAWINGS FOR SIZES, TYPES, AND QUANTITIES OF LIGHT FIXTURES, SPEAKERS, SMOKE DETECTORS, AND OTHER CEILING MOUNTED ELECTRICAL AND DEVICES.
- SEE THE MECHANICAL DRAWINGS FOR SIZES, TYPES, AND QUANTITIES OF DIFFUSERS, GRILLES, AND OTHER MECHANICAL CEILING MOUNTED DEVICES.
- PROVIDE, FIELD LOCATE AND INSTALL 12x16" FLUSH ACCESS AND 12x16" CEILING GRID AND PLUMBING PIPING VALVE LOCATIONS ABOVE SUSPENDED GYPSUM BOARD CEILINGS. SEE THE MECHANICAL AND PLUMBING DRAWINGS FOR LOCATIONS.
- SEE THE STRUCTURAL DRAWINGS FOR SHEAR WALLS USED FOR SHEAR WALLS THAT ARE REQUIRED TO EXTEND TO DECK/STRUCTURE ABOVE. PROVIDE BRACING FOR ALL MASONRY WALLS NOT EXTENDING TO THE DECK/STRUCTURE AS DETAILED ON STRUCTURAL DRAWINGS.
- METAL STUD BRACERS SHALL BE ATTACHED TO THE STRUCTURE ABOVE WITH SLIP CONNECTORS. STUD WALLS NOT EXTENDING TO THE STRUCTURE/DECK ABOVE SHALL RECEIVE DIAGONAL METAL STUD BRACERS AT MAXIMUM 4'-0" C.O. STUD WALLS USED FOR SHEAR WALLS THAT ARE REQUIRED TO EXTEND TO DECK/STRUCTURE ABOVE. PROVIDE BRACING FOR ALL MASONRY WALLS NOT EXTENDING TO THE DECK/STRUCTURE AS DETAILED ON STRUCTURAL DRAWINGS.
- THE CEILING GRID IS TO BE P-CEILING BRIGHT WHITE. THE CEILING GRID AS SHOWN ON THESE DRAWINGS IS REPRESENTATIONAL. THE CEILING GRID IS TO BE BROKEN AS REQUIRED AT LIGHT FIXTURES, PROJECTION SCREENS, ETC.
- ALL EXISTING GYPSUM OR PLASTER CEILINGS AND BULKHEADS TO REMAIN ARE TO BE PAINTED P-CEILING BRIGHT WHITE UNLESS NOTED OTHERWISE (SEE A800 SERIES DRAWINGS).
- SEE MECHANICAL, PLUMBING AND ELECTRICAL DOCUMENTS FOR ADDITIONAL CEILING WORK REQUIRED BY NEW M/P WORK.

### CEILING PLAN NOTES ①

- RE-INSTALL STORED CUBICLE CURTAIN TRACKS IN PREVIOUS LOCATIONS. REFER TO A800 SERIES SHEETS FOR ADDITIONAL INFORMATION.
- 
- 
SCOPE DRAWINGS:  
These drawings are a part of the project. In terms of the architectural design concept, the dimensions of the structure, mechanical and electrical systems, the location of the rooms, and other features are described all the way. The drawings are to be used to describe all the requirements of the Contract.

REVISIONS:

- ADDENDUM #2 03-13-2023

ISSUE DATE DRAWN BY CHECKED BY  
02-21-2023 Author Checker

DRAWING TITLE:  
FIRST FLOOR  
REFLECTED  
CEILING PLAN -  
UNIT G


CERTIFIED BY:  
JAMES ROBERT PINK  
REGISTERED ARCHITECT  
No. AR00900003  
STATE OF INDIANA  
ARCHITECT


DRAWING NUMBER  
A211G

PROJECT NUMBER  
2021056

SSCSO  
Keystone Crossing, Indianapolis, IN 46240  
317.448.7800 | [www.scsolinc.com](http://www.scsolinc.com)  
© 2020 SCSO Architects, Inc. All Rights Reserved

PROJECT:  
MSD OF WARREN TOWNSHIP  
WARREN CENTRAL HIGH SCHOOL  
PHASE 3 ADDITION & RENOVATION  
9500 E. 16th STREET, INDIANAPOLIS, IN 46229

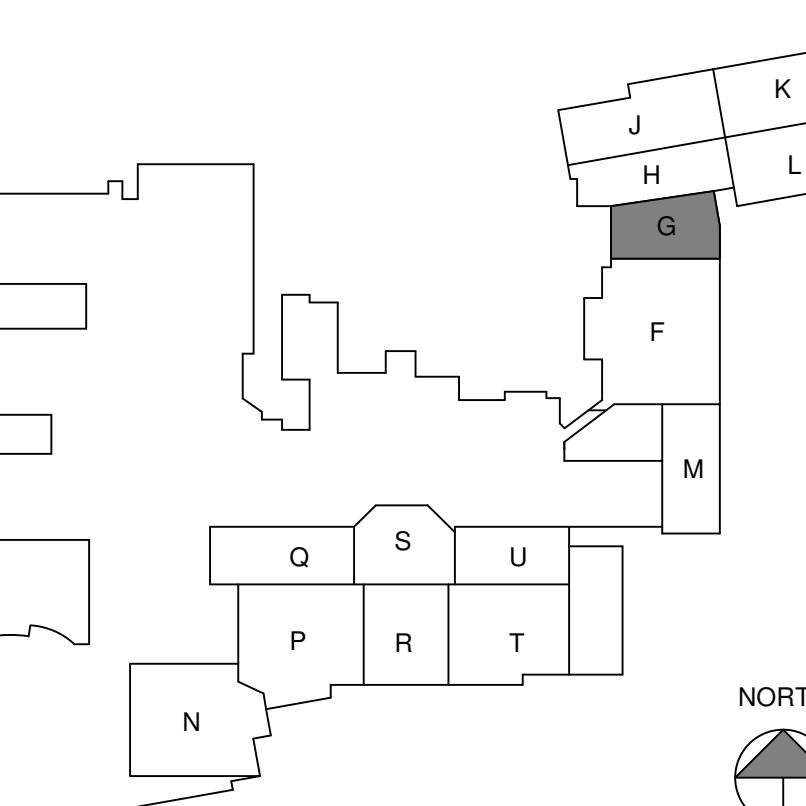

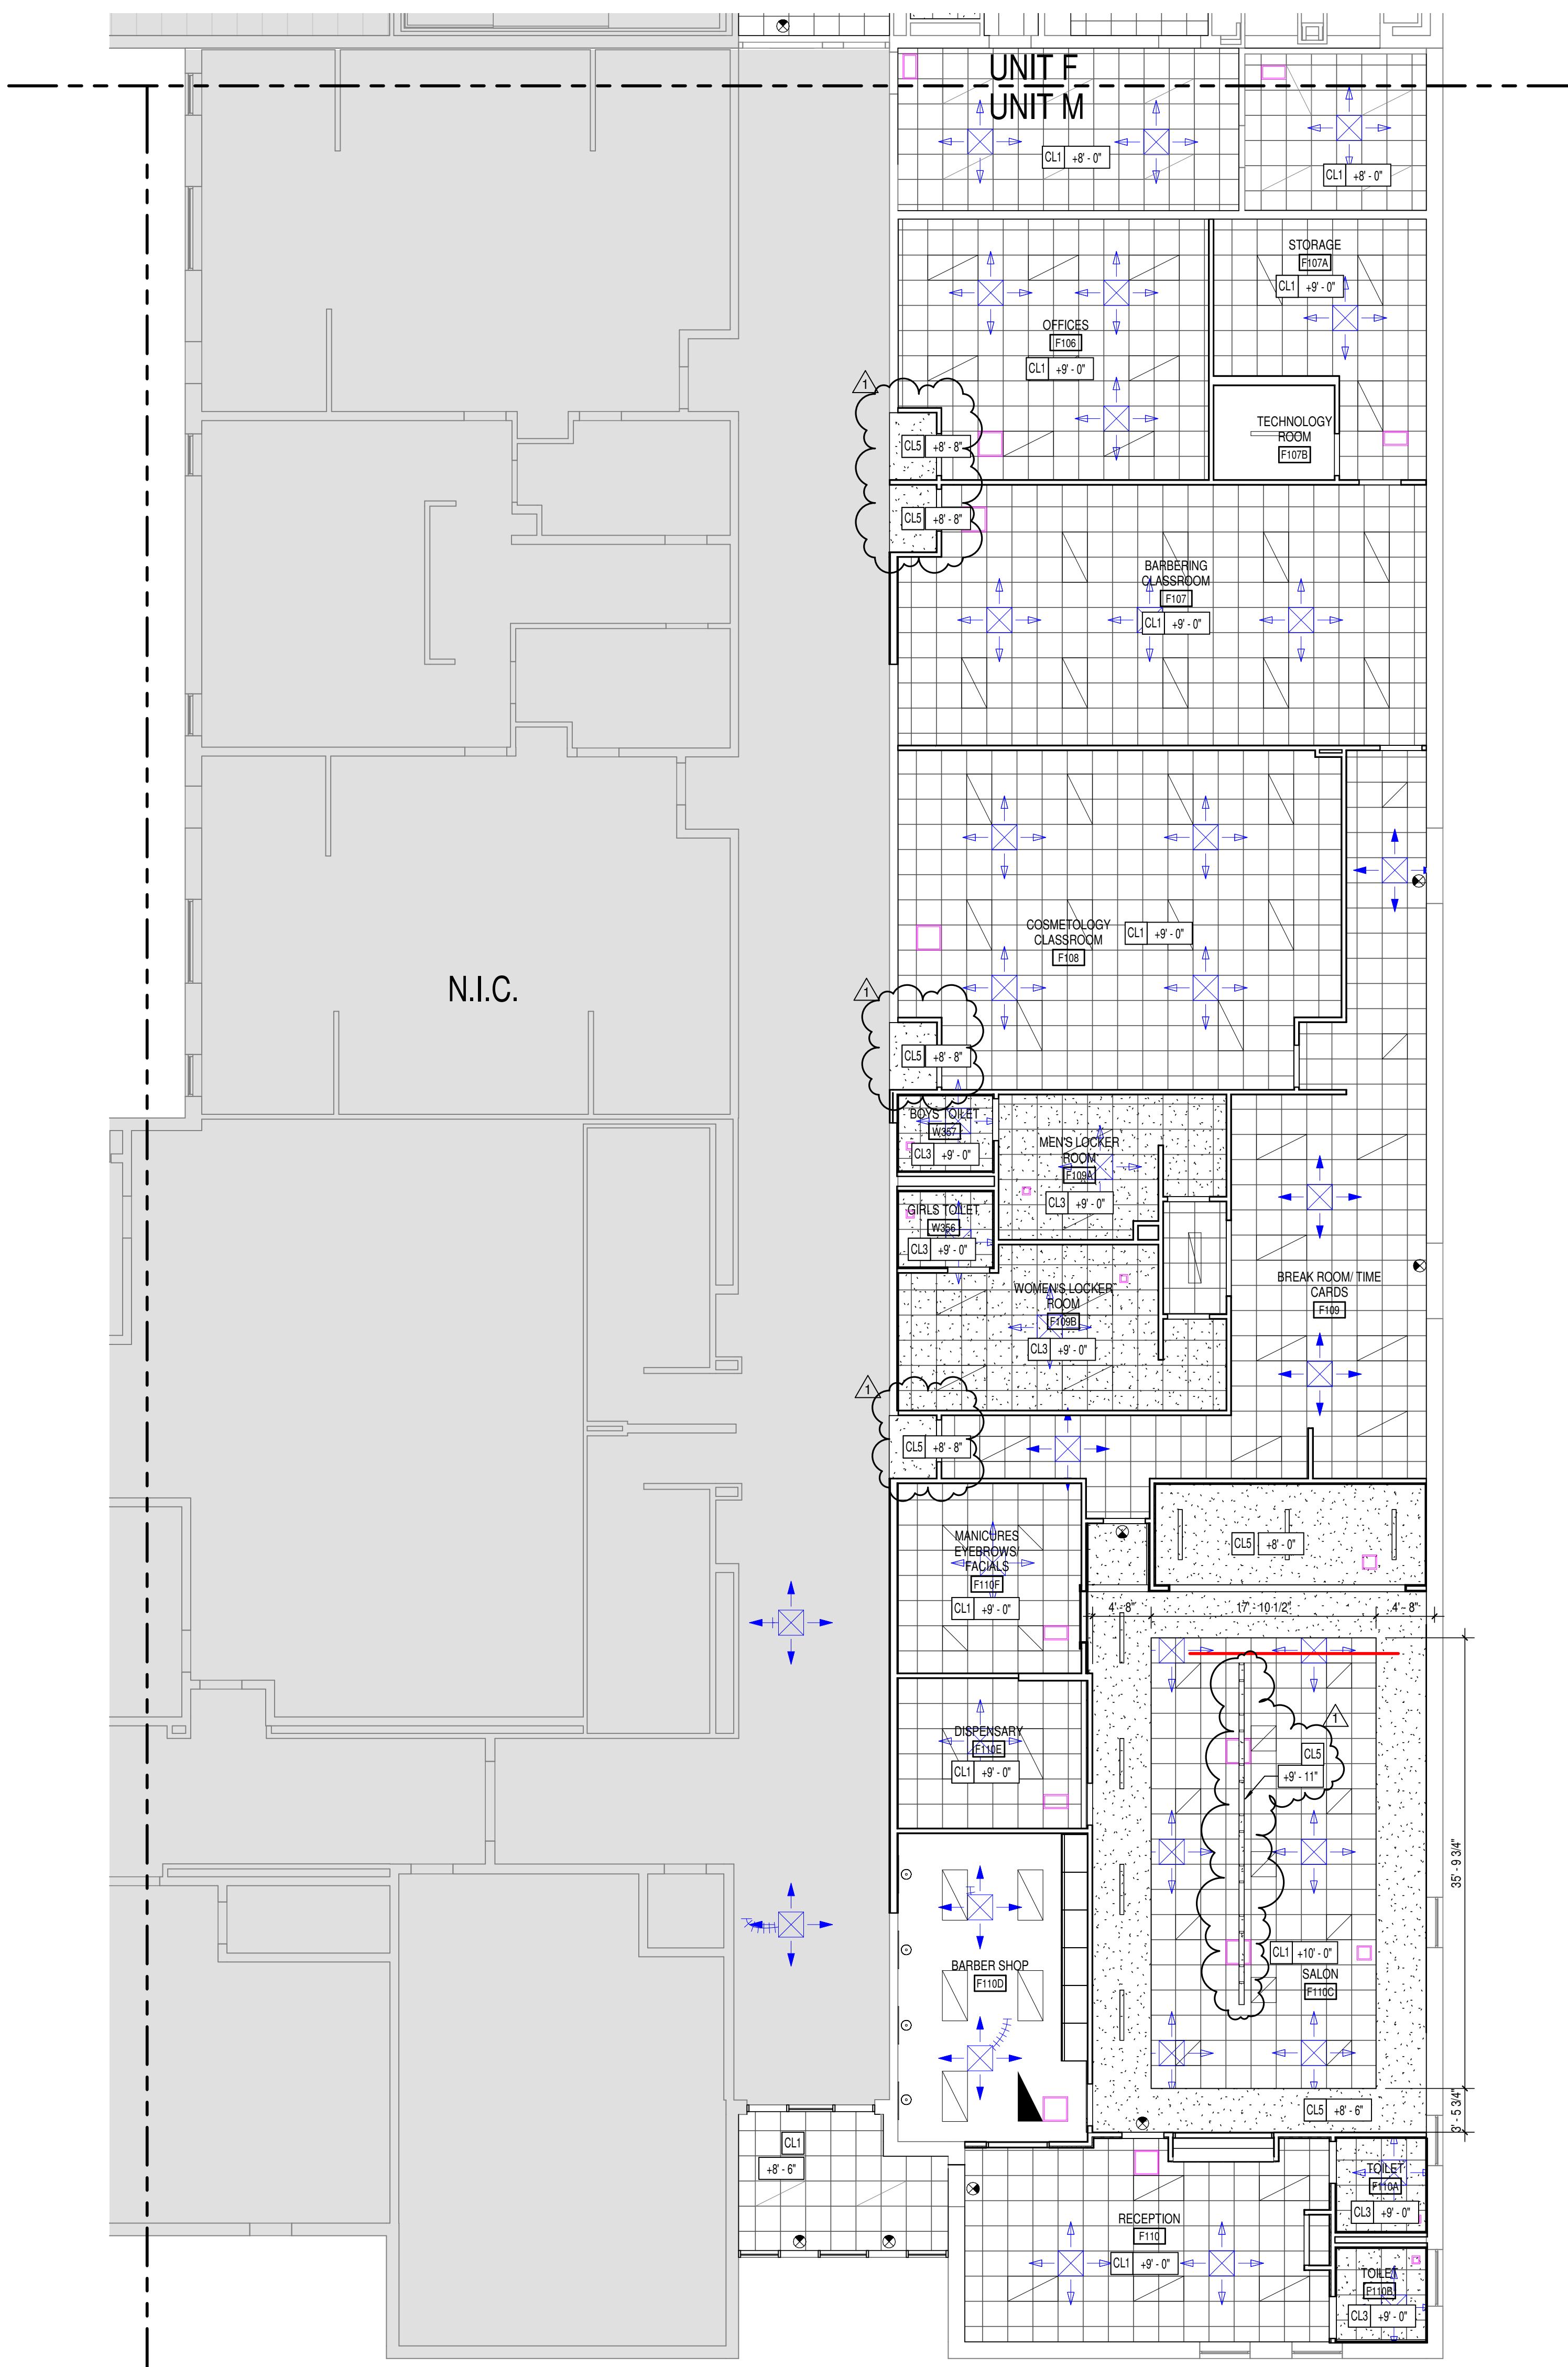

REFLECTED CEILING PLAN - FIRST FLOOR - UNIT M  
A211M  
1  
SCALE: 1/8" = 1'-0"

REFLECTED CEILING LEGEND	
	FLUORESCENT LIGHT FIXTURES, RECESSED OR SURFACE-MOUNTED. SEE ELECTRICAL DRAWINGS.
	DOWNLIGHT/HIGH BAY LIGHT FIXTURE; SEE ELECTRICAL DRAWINGS
	CEILING MOUNTED PROJECTOR, SEE TECHNOLOGY DRAWINGS
	RETURN/EXHAUST GRILL; SEE MECHANICAL DRAWINGS
	SUPPLY AIR GRILL; SEE MECHANICAL DRAWINGS
	LINEAR SLOT SUPPLY AIR GRILL; SEE MECHANICAL DRAWINGS
	SUSPENDED ACOUSTIC LAY-IN CEILING MFG: ARMSTRONG MODEL #3354
	CL1 STYLE: OPTIMA DESCRIPTION: SQUARE REGULAR EDGE COLOR: WHITE SIZE: 2' x 2' x 1"
	CL2 DESCRIPTION: RECTANGULAR REGULAR EDGE COLOR: WHITE SIZE: 2' x 4' x 1"
	SUSPENDED ACOUSTIC LAY-IN CEILING MFG: ARMSTRONG MODEL #1941 STYLE: ULTIMA DESCRIPTION: RECTANGULAR REGULAR EDGE COLOR: WHITE SIZE: 2' x 2' x 1"
	SUSPENDED GYPSUM WALLBOARD CEILING SYSTEM USE 5/8" WALLBOARD PAINT: P8 CEILING BRIGHT WHITE UNLESS NOTED OTHERWISE
	CL4 GYPSUM WALLBOARD BULKHEAD PAINT: SEE A800 SERIES FINISH PLANS.
	CL5 EXPOSED STRUCTURE - PAINTED SEE FINISH PLANS
	CL6 DAFS SOFFIT
	CL7 4'-0" CEILING ELEVATION MARK ABOVE FINISHED FLOOR (AT THAT LOCATION IF MULTIPLE FLOOR LEVELS ARE PRESENT)
	ME MATCH EXISTING CEILING ELEVATION

### GENERAL REFLECTED CEILING PLAN NOTES

- SEE THE ELECTRICAL DRAWINGS FOR SIZES, TYPES, AND QUANTITIES OF LIGHT FIXTURES, SPEAKERS, SMOKE DETECTORS, AND OTHER CEILING MOUNTED ELECTRICAL AND DEVICES. SEE THE MECHANICAL DRAWINGS FOR SIZES, TYPES, AND QUANTITIES OF DIFFUSERS, GRILLES, AND OTHER MECHANICAL CEILING MOUNTED DEVICES.
- PROVIDE, FIELD LOCATE AND INSTALL 12X16" FLUSH ACCESS PANELS FOR CEILING GRID, AIR, AND PLUMBING PIPING VALVE LOCATIONS ABOVE SUSPENDED GYPSUM CEILINGS. SEE THE MECHANICAL AND PLUMBING DRAWINGS FOR LOCATIONS.
- SEE THE STRUCTURAL DRAWINGS FOR STUD WALLS USED FOR SHEARWALLS THAT ARE REQUIRED TO EXTEND TO DECK/STRUCTURE ABOVE. PROVIDE BRACING FOR ALL MASONRY WALLS NOT EXTENDING TO THE DECK/STRUCTURE AS DETAILED ON STRUCTURAL DRAWINGS.
- METAL STUD BRACERS SHALL BE ATTACHED TO THE STRUCTURE ABOVE WITH SLIP CONNECTORS. STUD WALLS NOT EXTENDING TO THE STRUCTURE/DECK ABOVE SHALL RECEIVE DIAGONAL METAL STUD BRACERS AT MAXIMUM 4'-0" C.O. SPACING.
- THE CEILING GRID IS TO BE P-CEILING BRIGHT WHITE. THESE DRAWINGS IS REPRESENTATIONAL. THE CEILING GRID IS TO BE BROKEN AS REQUIRED AT LIGHT FIXTURES, PROJECTION SCREENS, ETC.
- ALL EXISTING GYPSUM OR PLASTER CEILINGS AND BULKHEADS TO REMAIN ARE TO BE PAINTED P-CEILING BRIGHT WHITE UNLESS NOTED OTHERWISE (SEE A800 SERIES DRAWINGS).
- SEE MECHANICAL, PLUMBING AND ELECTRICAL DOCUMENTS FOR ADDITIONAL CEILING WORK REQUIRED BY NEW M/P WORK.

### CEILING PLAN NOTES ①

- RE-INSTALL STORED CUBICLE CURTAIN TRACKS IN PREVIOUS LOCATIONS. REFER TO A800 SERIES SHEETS FOR ADDITIONAL INFORMATION.
- 
- 
- 10

PROJECT:  
WARREN CENTRAL HIGH SCHOOL  
PHASE 3 ADDITION & RENOVATION  
9500 E. 16th STREET, INDIANAPOLIS, IN 46229

SCOPE DRAWINGS:  
These drawings are a representation of the project in terms of the architectural design concept, the dimensions of the structure, and the location of the various parts of the structure, mechanical and electrical systems. They are not to be used for construction, but to describe all the requirements of the Contract. The drawings shall be used in conjunction with the requirements of the Contract.

REVISIONS:  
1 ADDENDUM #2 03-13-2023

ISSUE DATE DRAWN BY CHECKED BY  
02-21-2023 Author Checker

DRAWING TITLE:  
FIRST FLOOR  
REFLECTED  
CEILING PLAN -  
UNIT M

CERTIFIED BY:  
JAMES ROBERT PEER  
No. AR00900003  
REGISTERED ARCHITECT  
STATE OF INDIANA  
Signature

DRAWING NUMBER  
A211M

PROJECT NUMBER  
2021056

SCCSO  
3831 Keystone Crossing, Indianapolis, IN 46240  
©2020 CCSO Architects, Inc. All Rights Reserved

317.648.7800



SCCSO  
8831 Keystone Crossing, Indianapolis, IN 46240

©2020 CCSO Architects, Inc. All Rights Reserved





**SCSO**

3831 Keystone Crossing, Indianapolis, IN 46240

© 2020 SCSO Architects, Inc. All Rights Reserved

PROJECT:  
WARREN CENTRAL HIGH SCHOOL  
PHASE 3 ADDITION & RENOVATION  
9500 E. 16th STREET, INDIANAPOLIS, IN 46229


SCOPE DRAWINGS:  
These drawings illustrate the scope of the project in terms of architectural design concept, the dimensions of the building, and the location of the structural, mechanical and electrical systems. They are intended to provide a general description of the requirements of the Contract.

REVISIONS:

1 ADDENDUM #2 03-13-2023


ISSUE DATE: 02-21-2023 DRAWN BY: XXX CHECKED BY: XXX

DRAWING TITLE:  
PARTIAL  
BUILDING  
SECTIONS

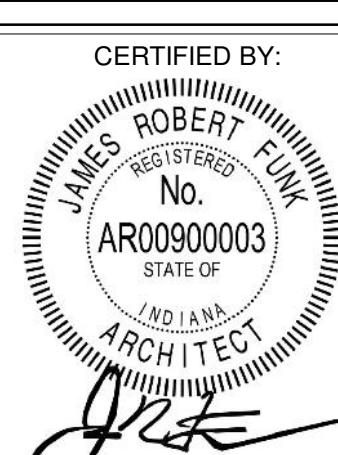


DRAWING NUMBER  
**A401**


PROJECT NUMBER  
2021056

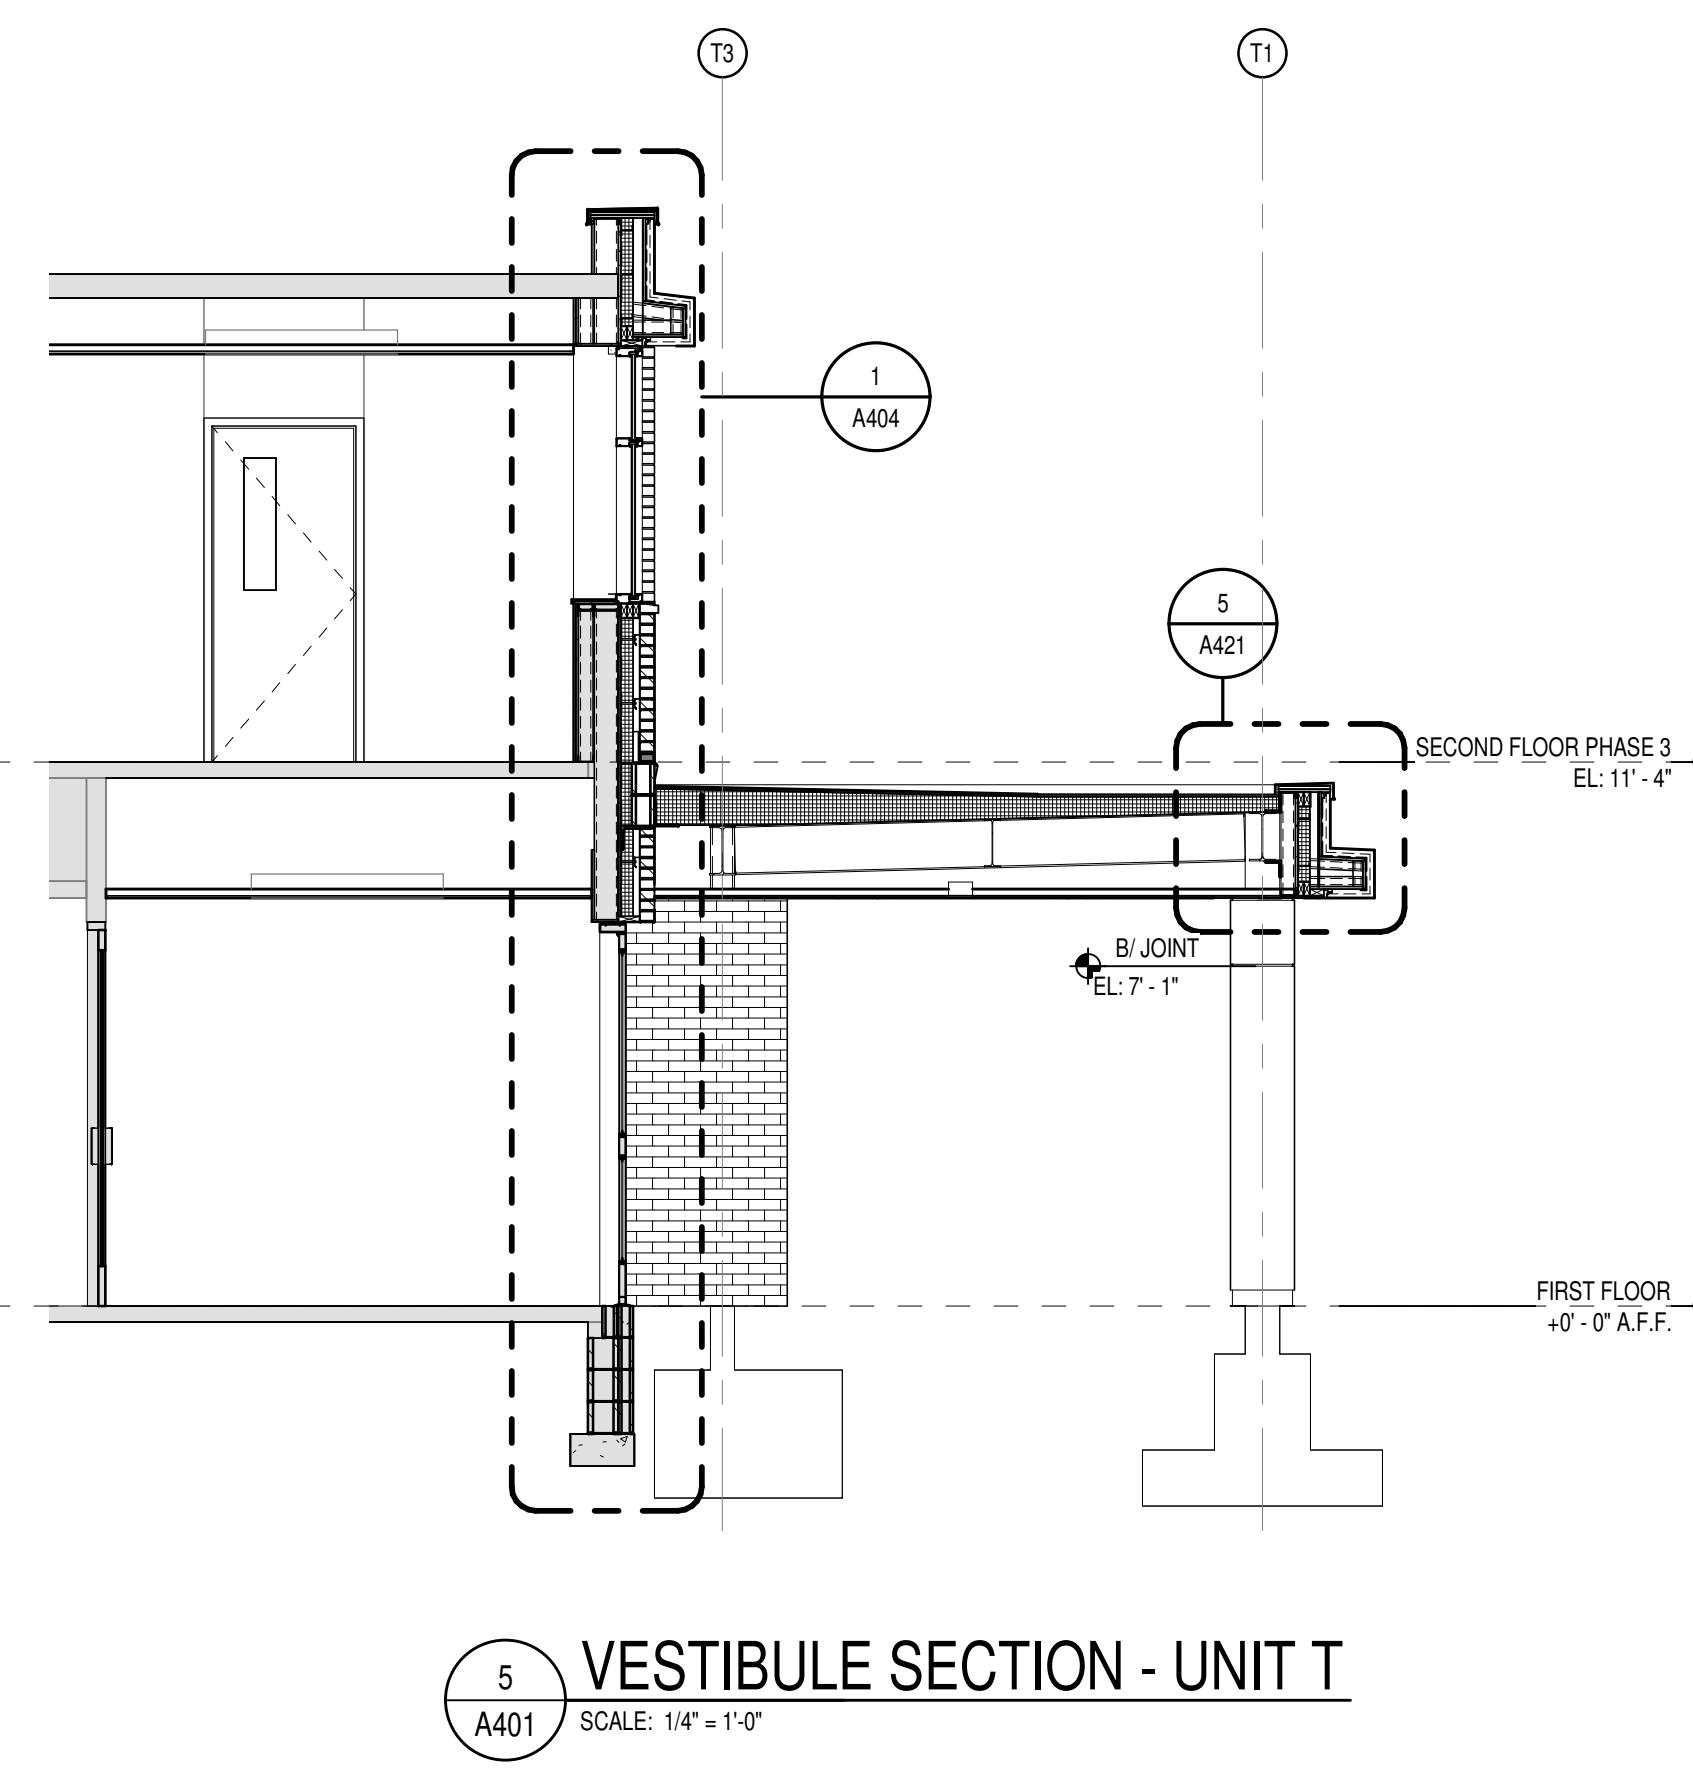


5 VESTIBULE SECTION - UNIT T  
A401 SCALE: 1/4" = 1'-0"

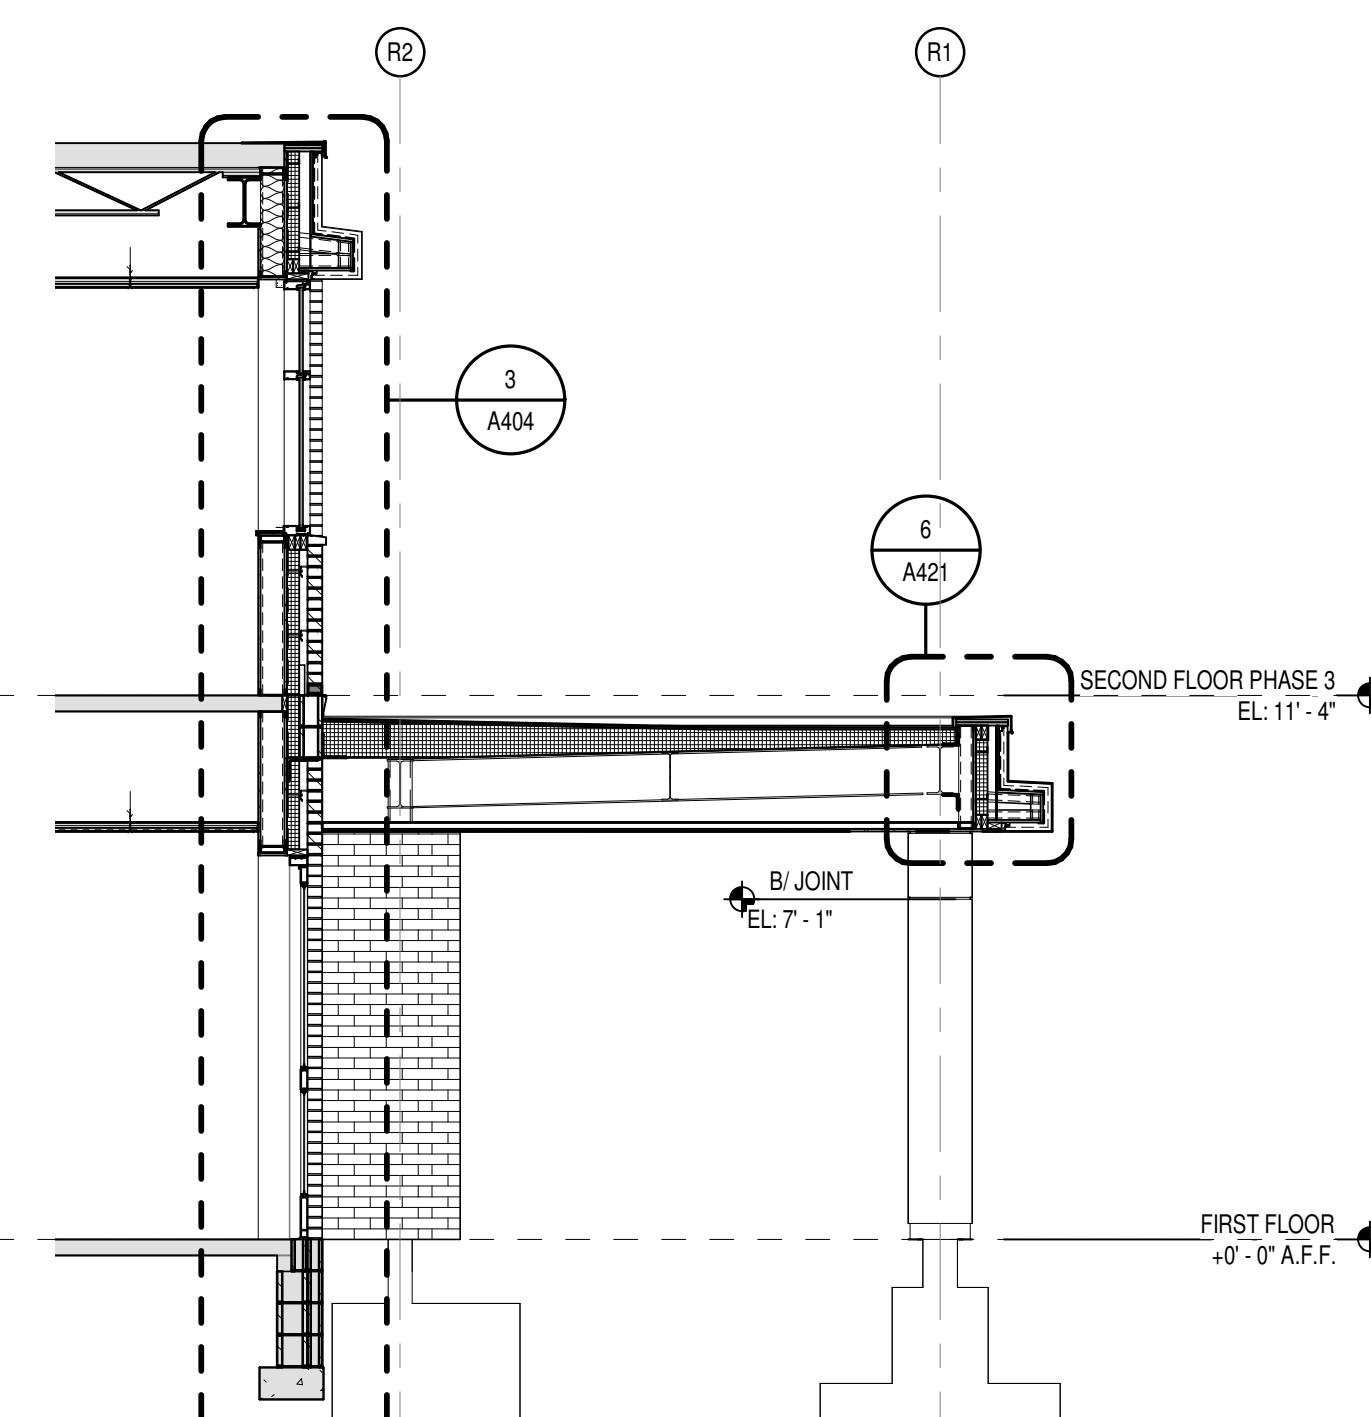


4 VESTIBULE SECTION - UNIT R  
A401 SCALE: 1/4" = 1'-0"

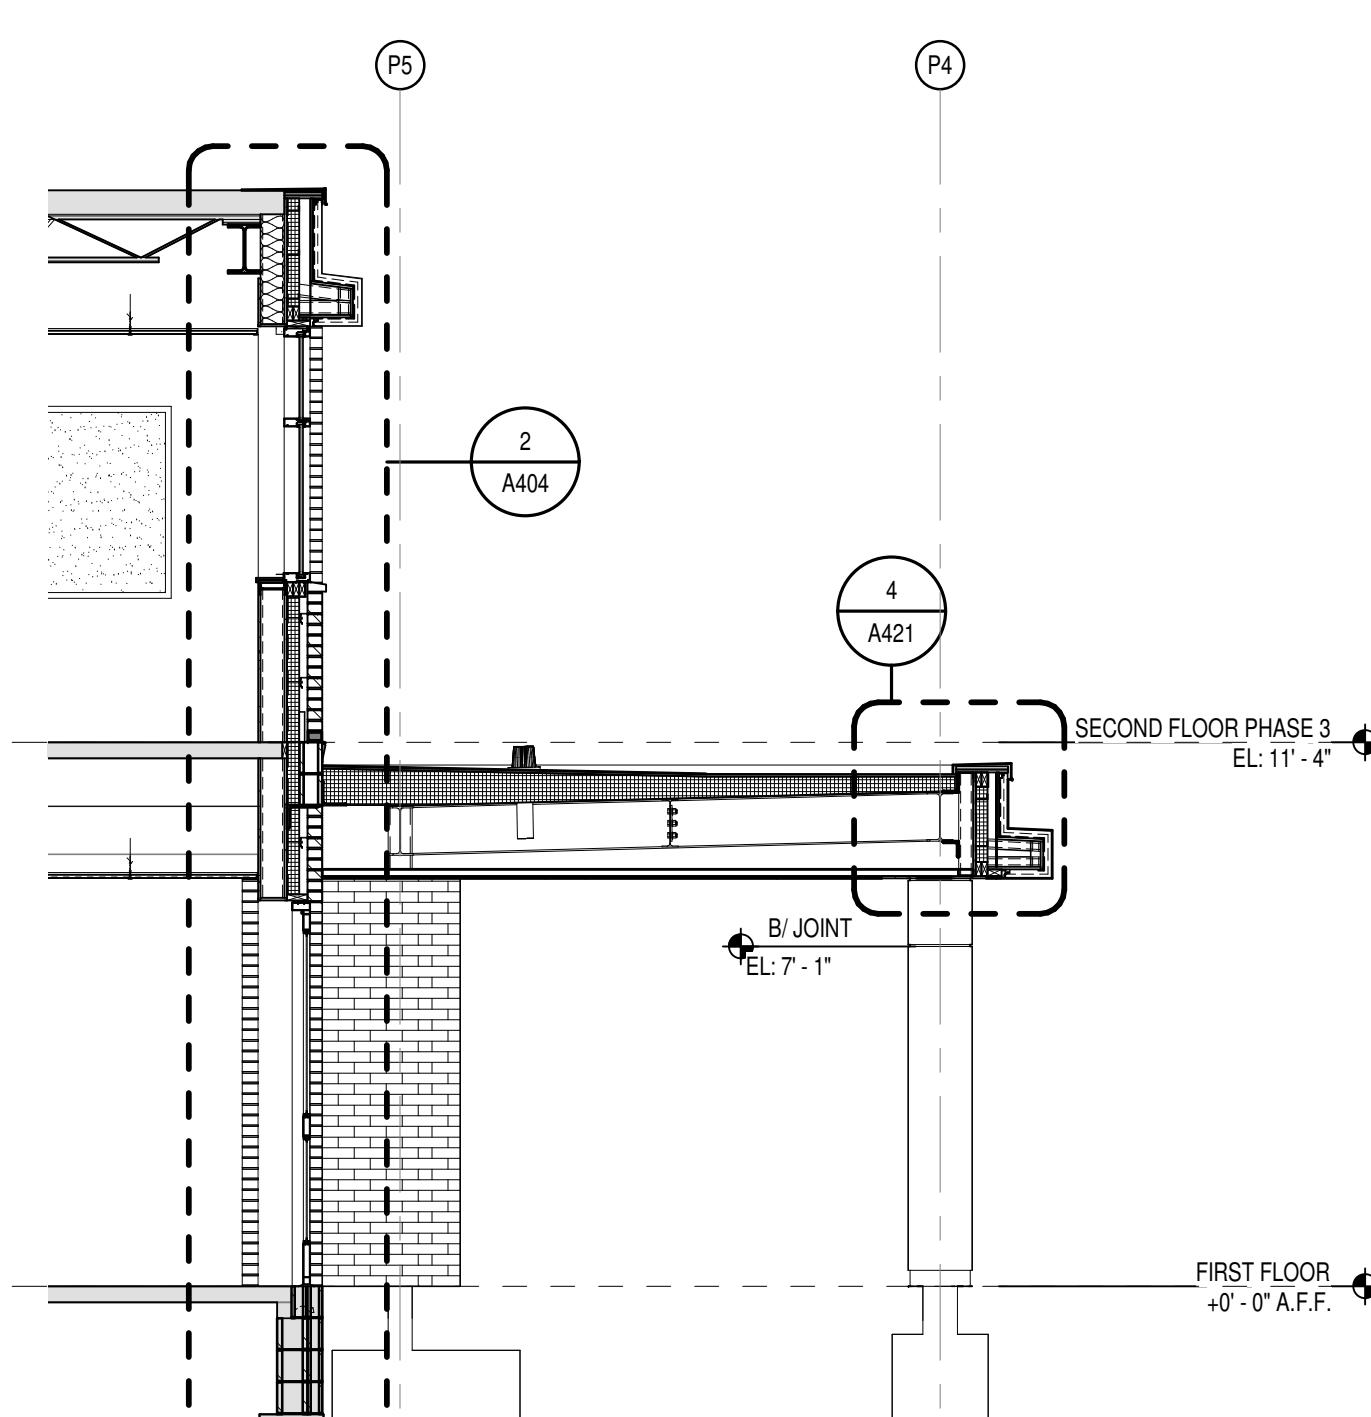


2 VESTIBULE SECTION - UNIT P  
A401 SCALE: 1/4" = 1'-0"

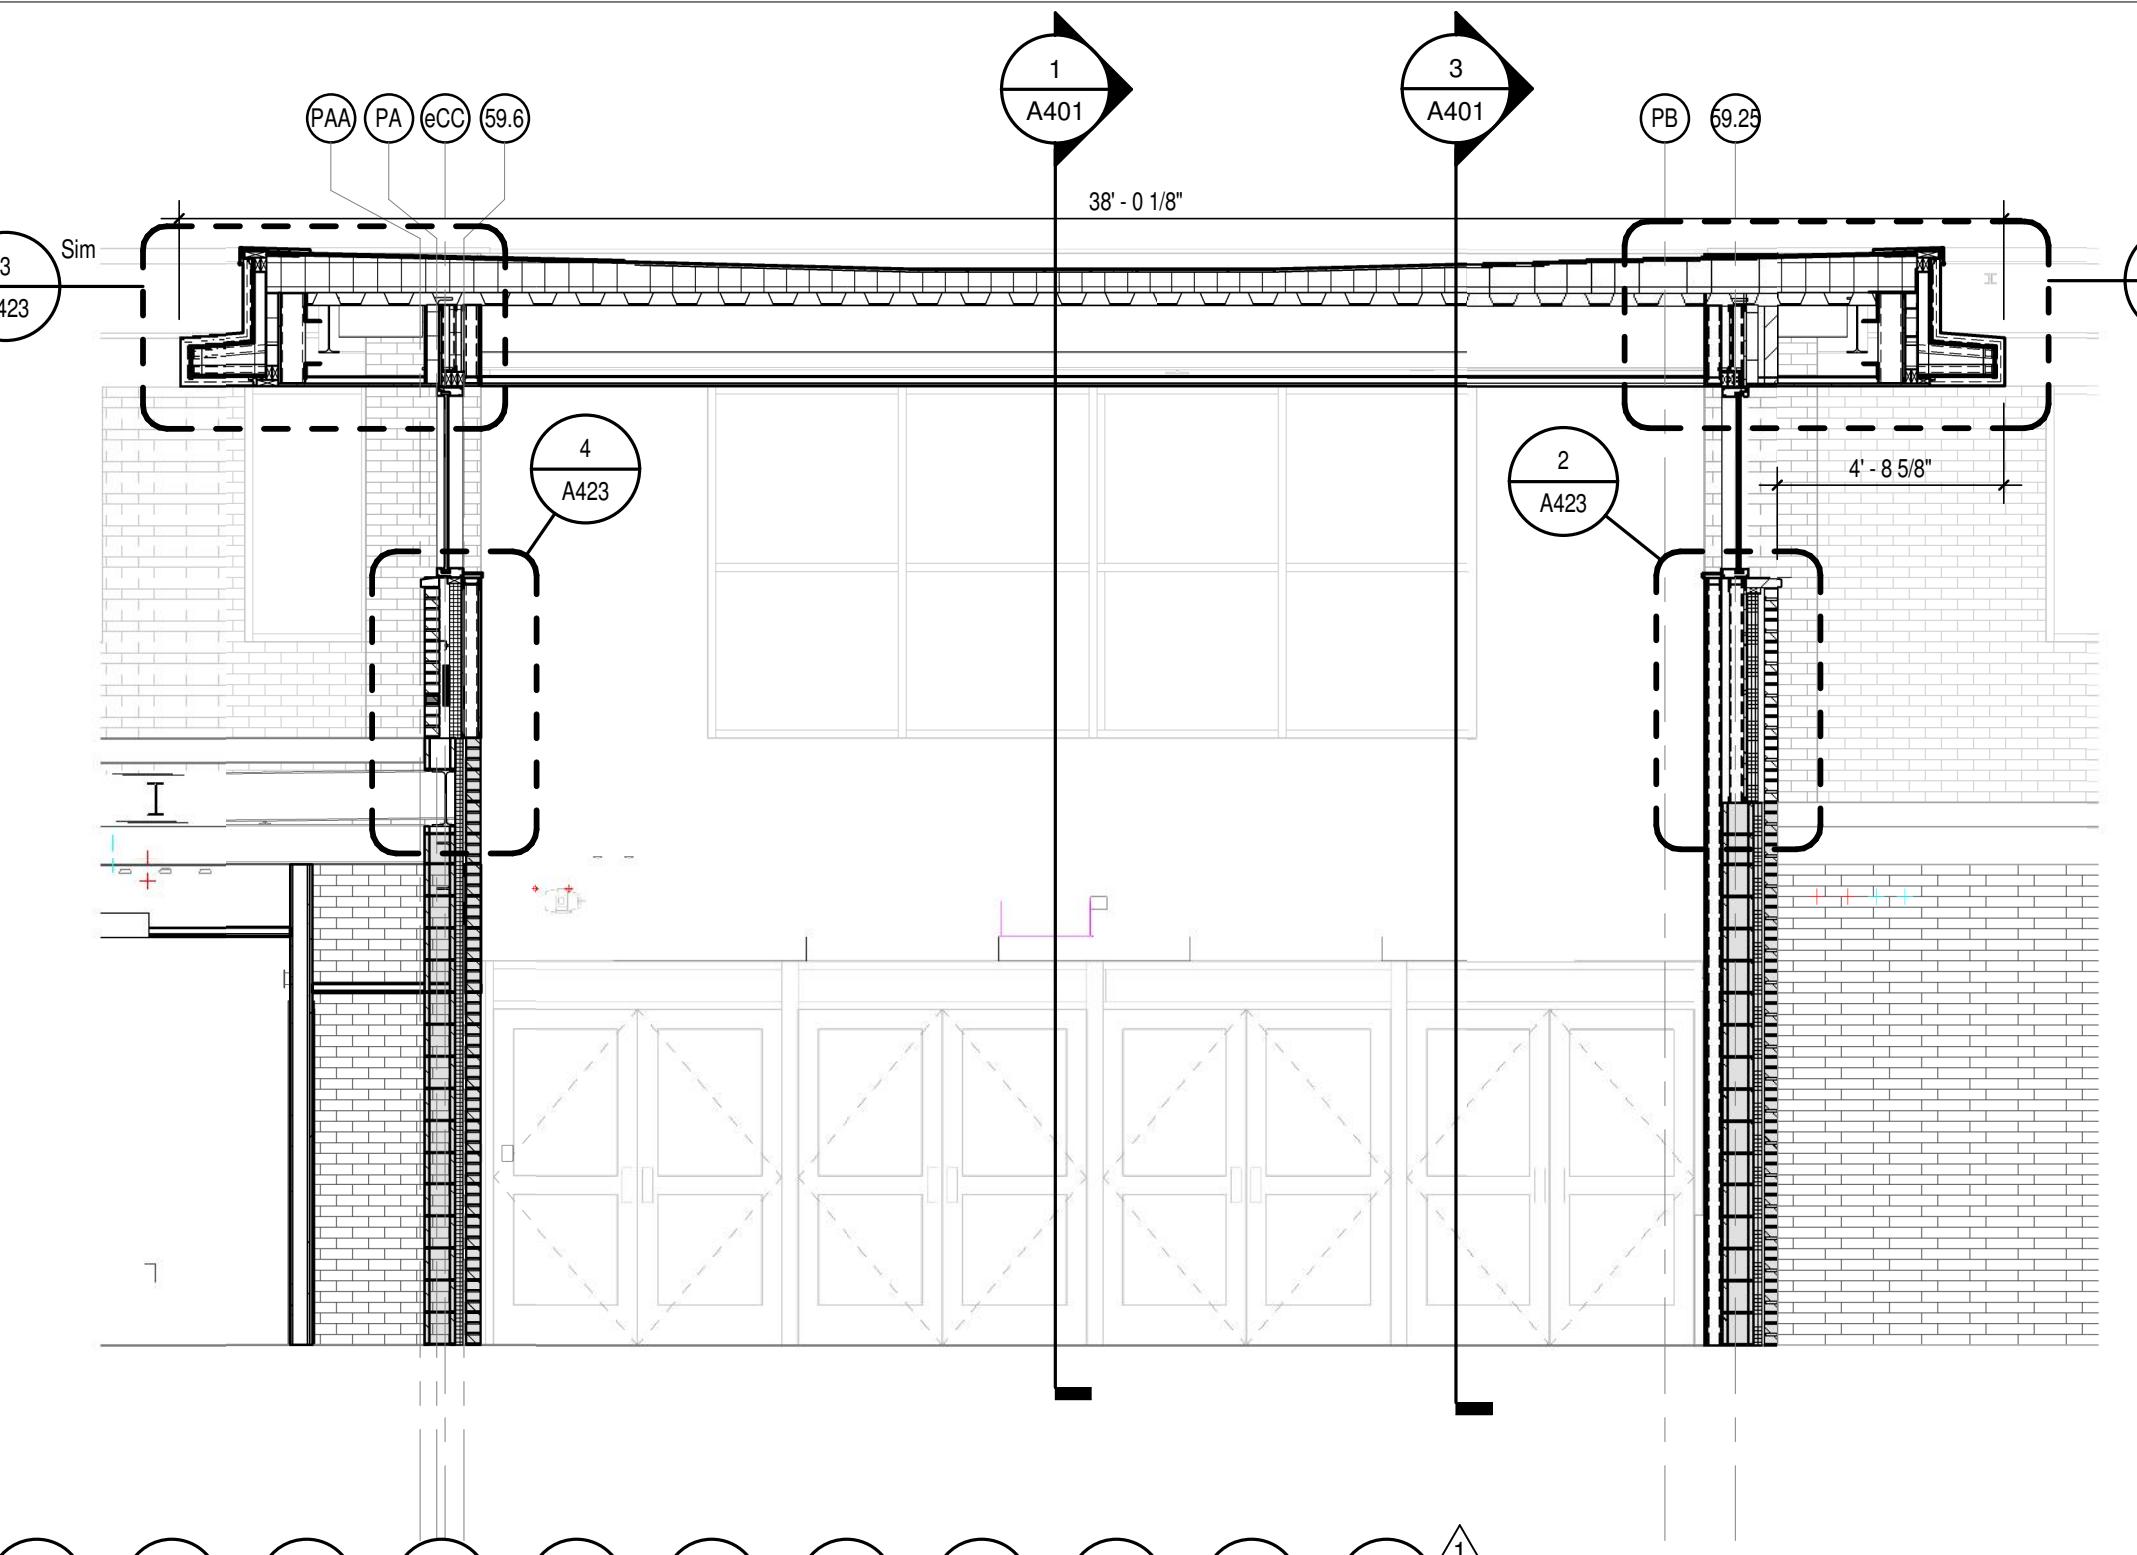

6 ALTERNATE #1 - VESTIBULE SECTION - UNIT N  
A401 SCALE: 1/4" = 1'-0"

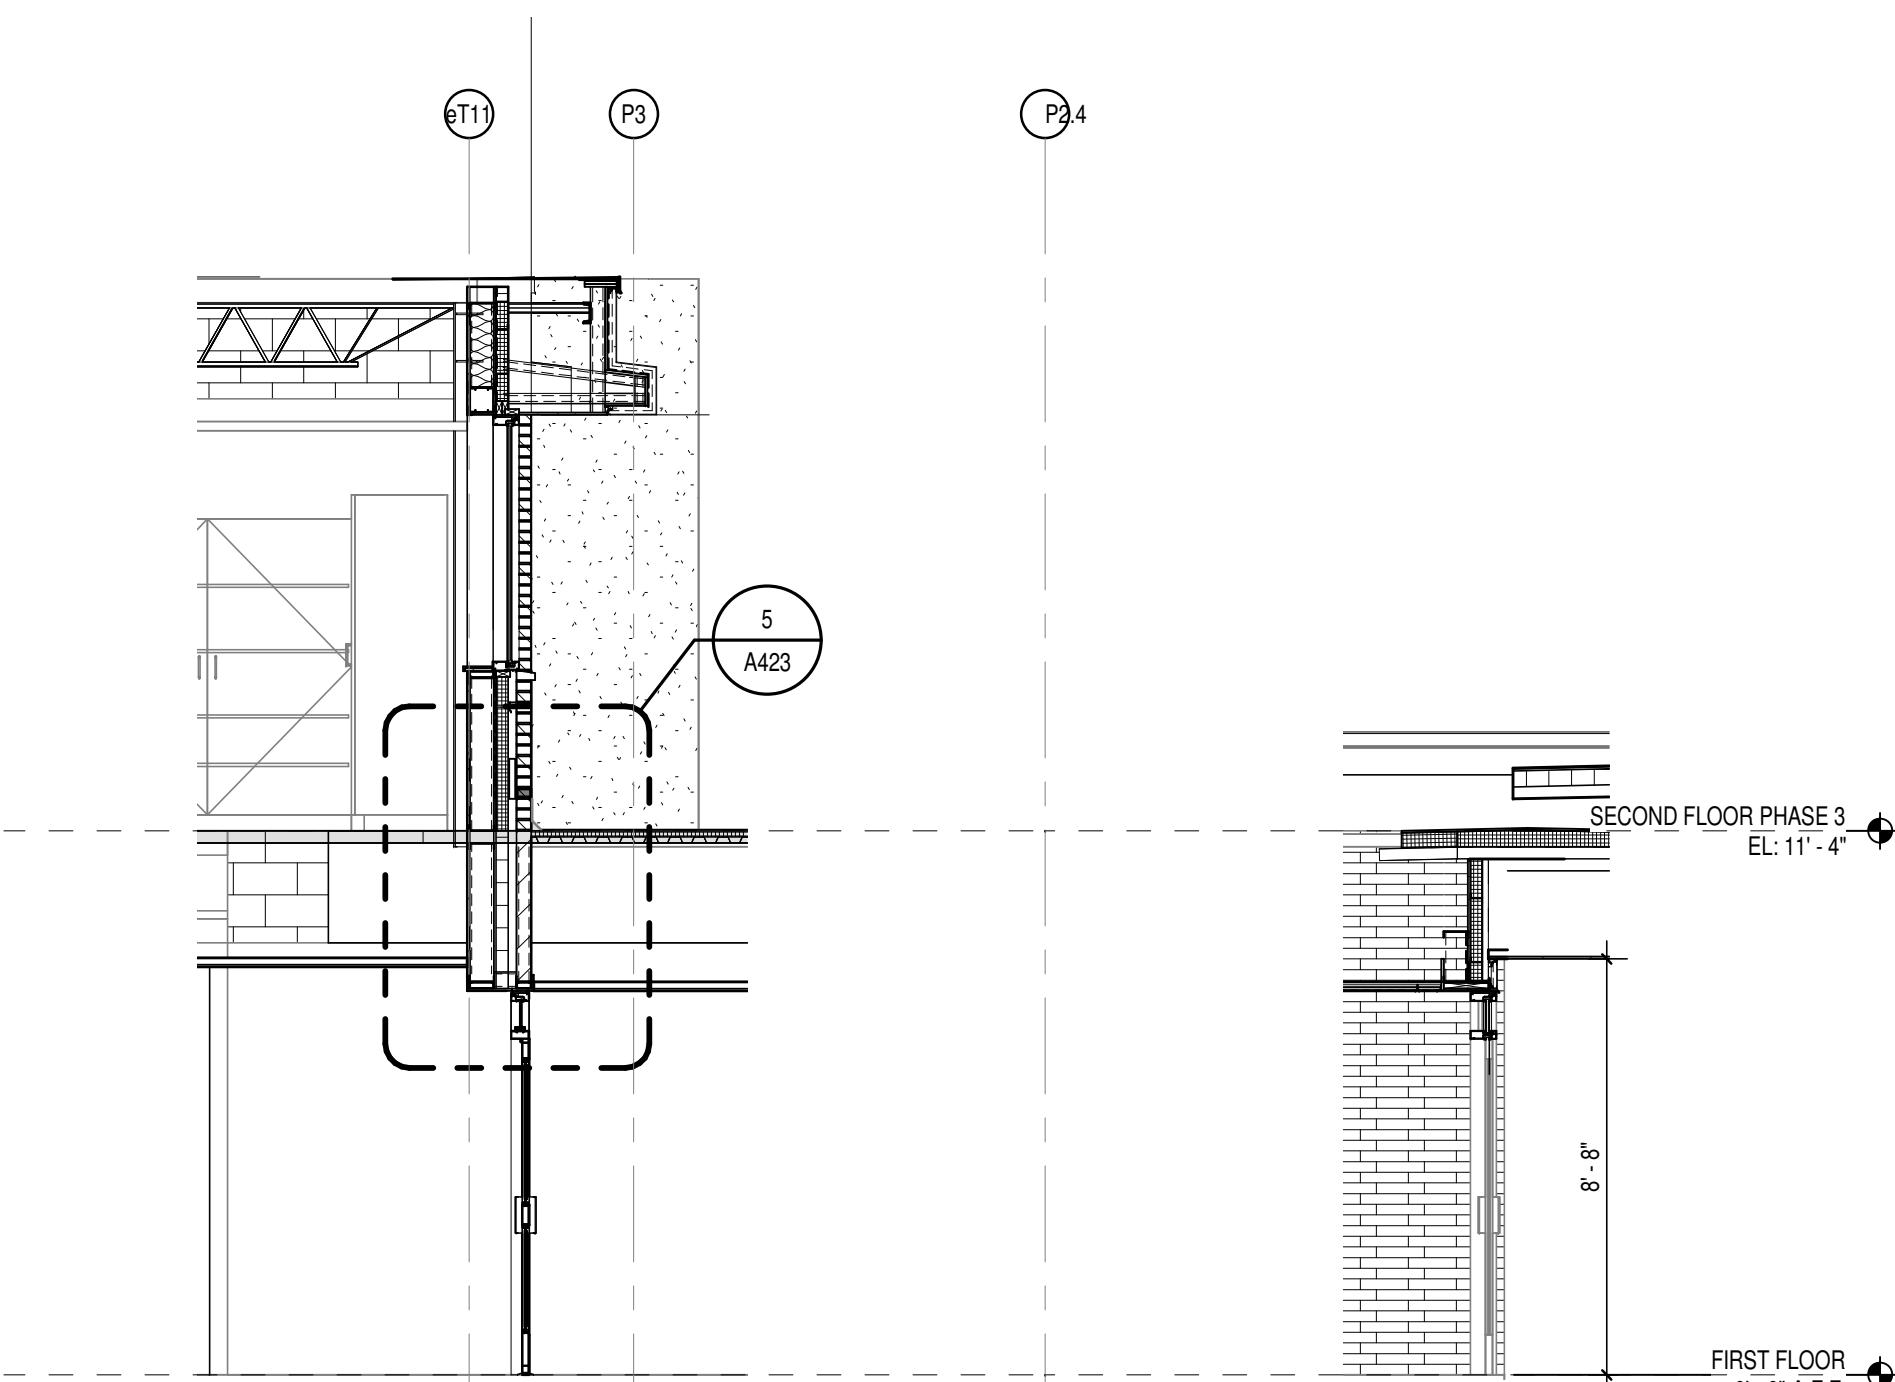

3 VESTIBULE SECTION - UNIT N  
A401 SCALE: 1/4" = 1'-0"

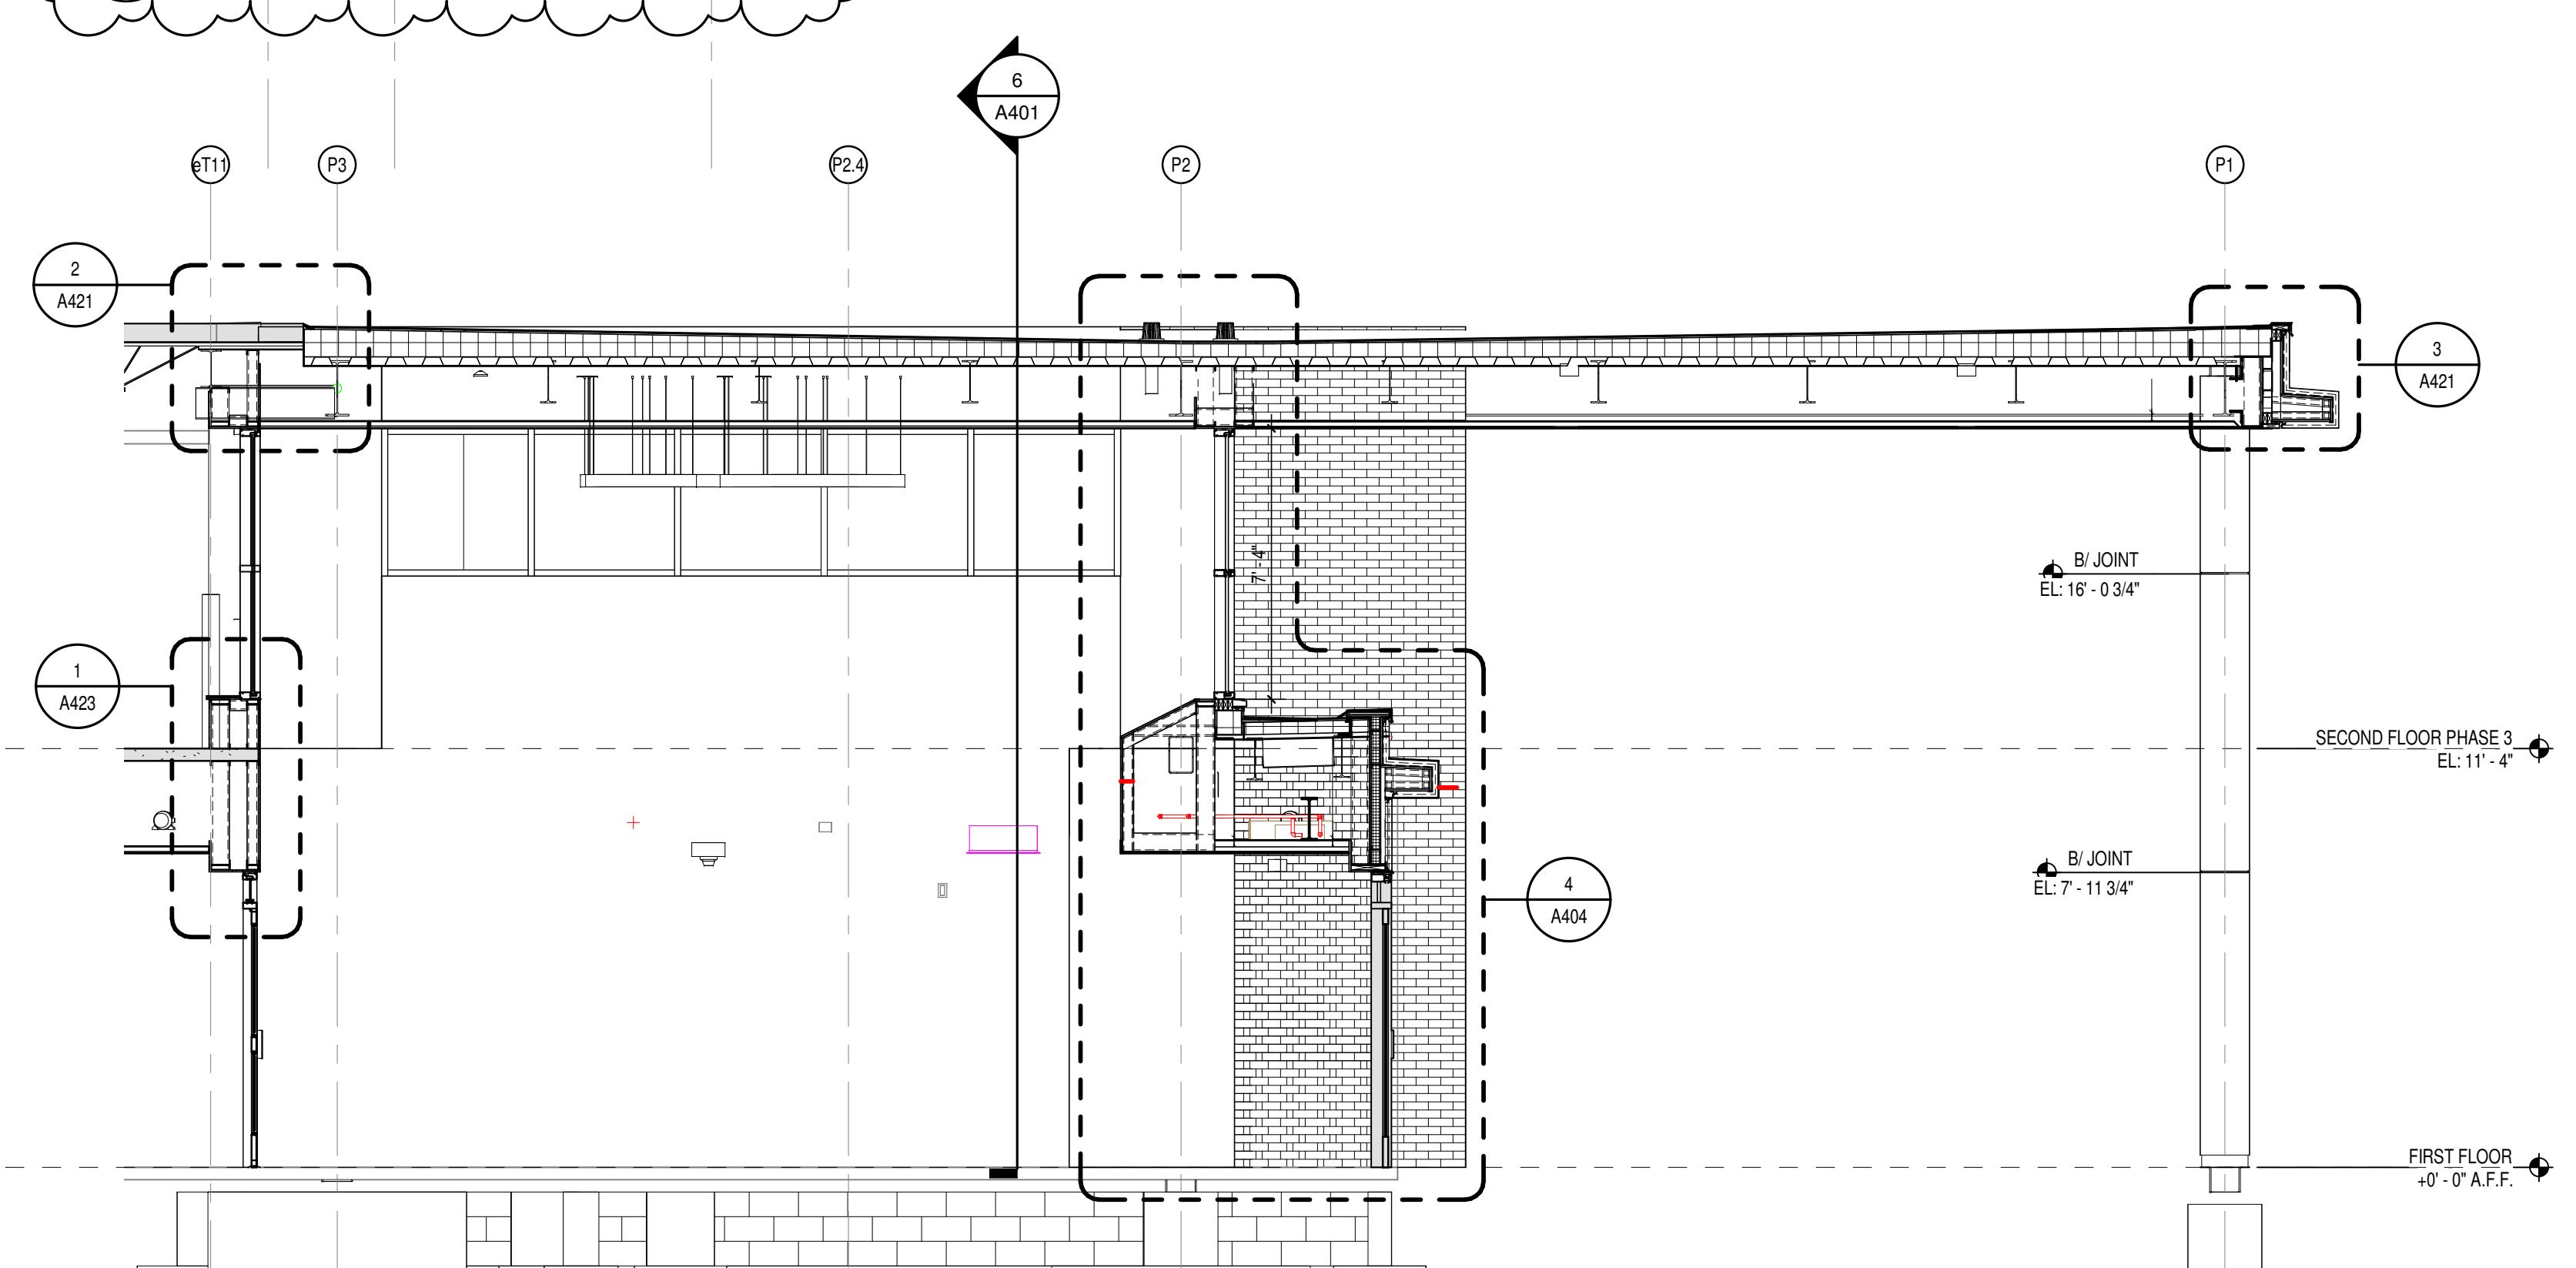

1 ALTERNATE #1 - VESTIBULE SECTION - UNIT N  
A401 SCALE: 1/4" = 1'-0"



○  
S  
C  
S

8831 Keystone Crossing, Indianapolis, IN 46240  
317.848.7800 | [csoinc.net](http://csoinc.net)

317.848.7800 | csoinc.net



MSD OF WARREN TOWNSHIP

**WARREN CENTRAL HIGH SCHOOL**  
**PHASE 3 ADDITION & RENOVATION**

9500 E 16<sup>th</sup> STREET INDIANAPOLIS IN 46220


**6:**  
be of the pr  
dimensions  
s and the typ  
ms.  
or describe  
letion of the  
ed or descri

SUE DATE DRAWN BY CHECKED


**DRAWING TITLE:**  
**WALL SECTIONS  
AND DETAILS**

DRAWING NUMBER  
**A404**

PROJECT NUMBER  
**2021056**

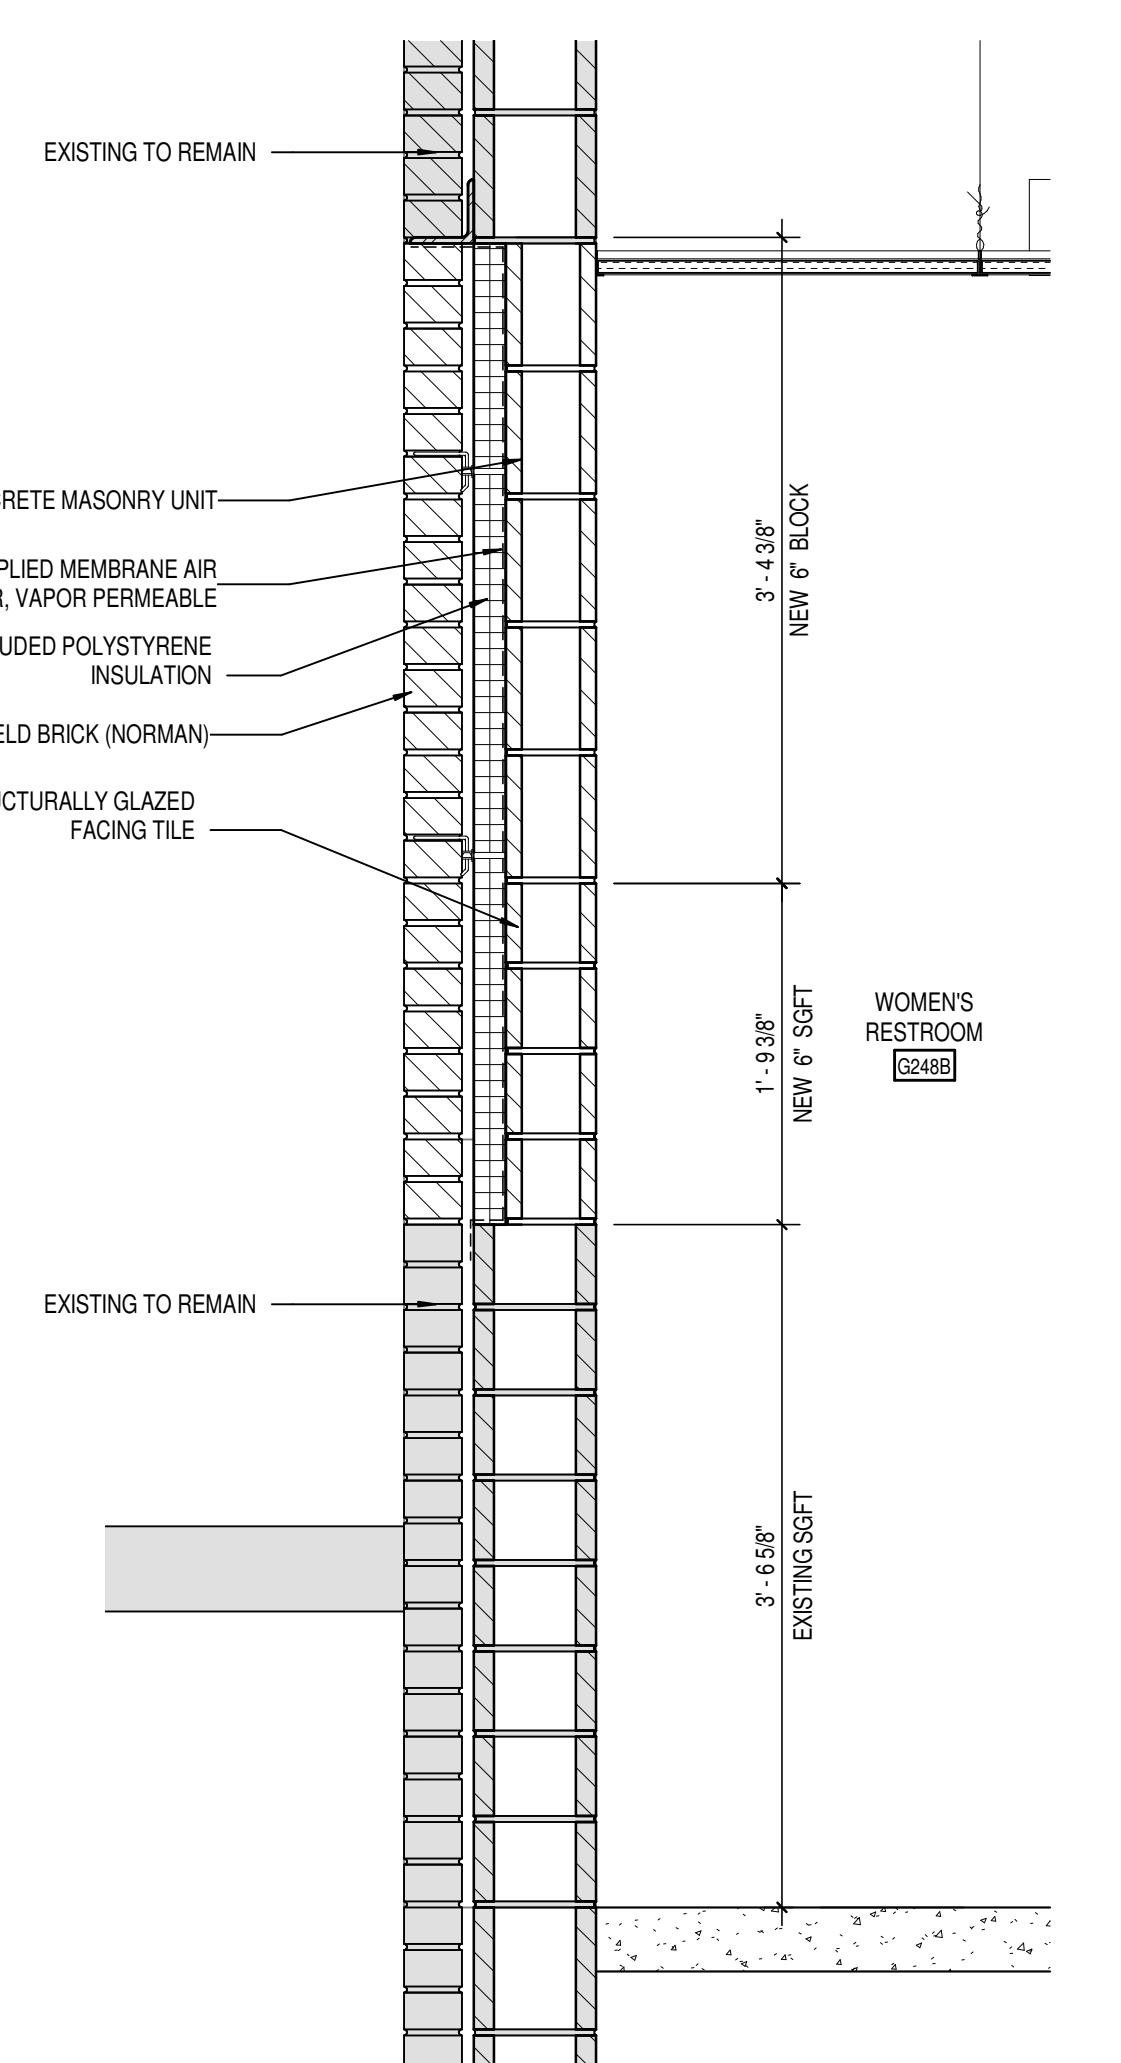


6  
A404 WALL SECTION  
SCALE: 1" = 1'-0"

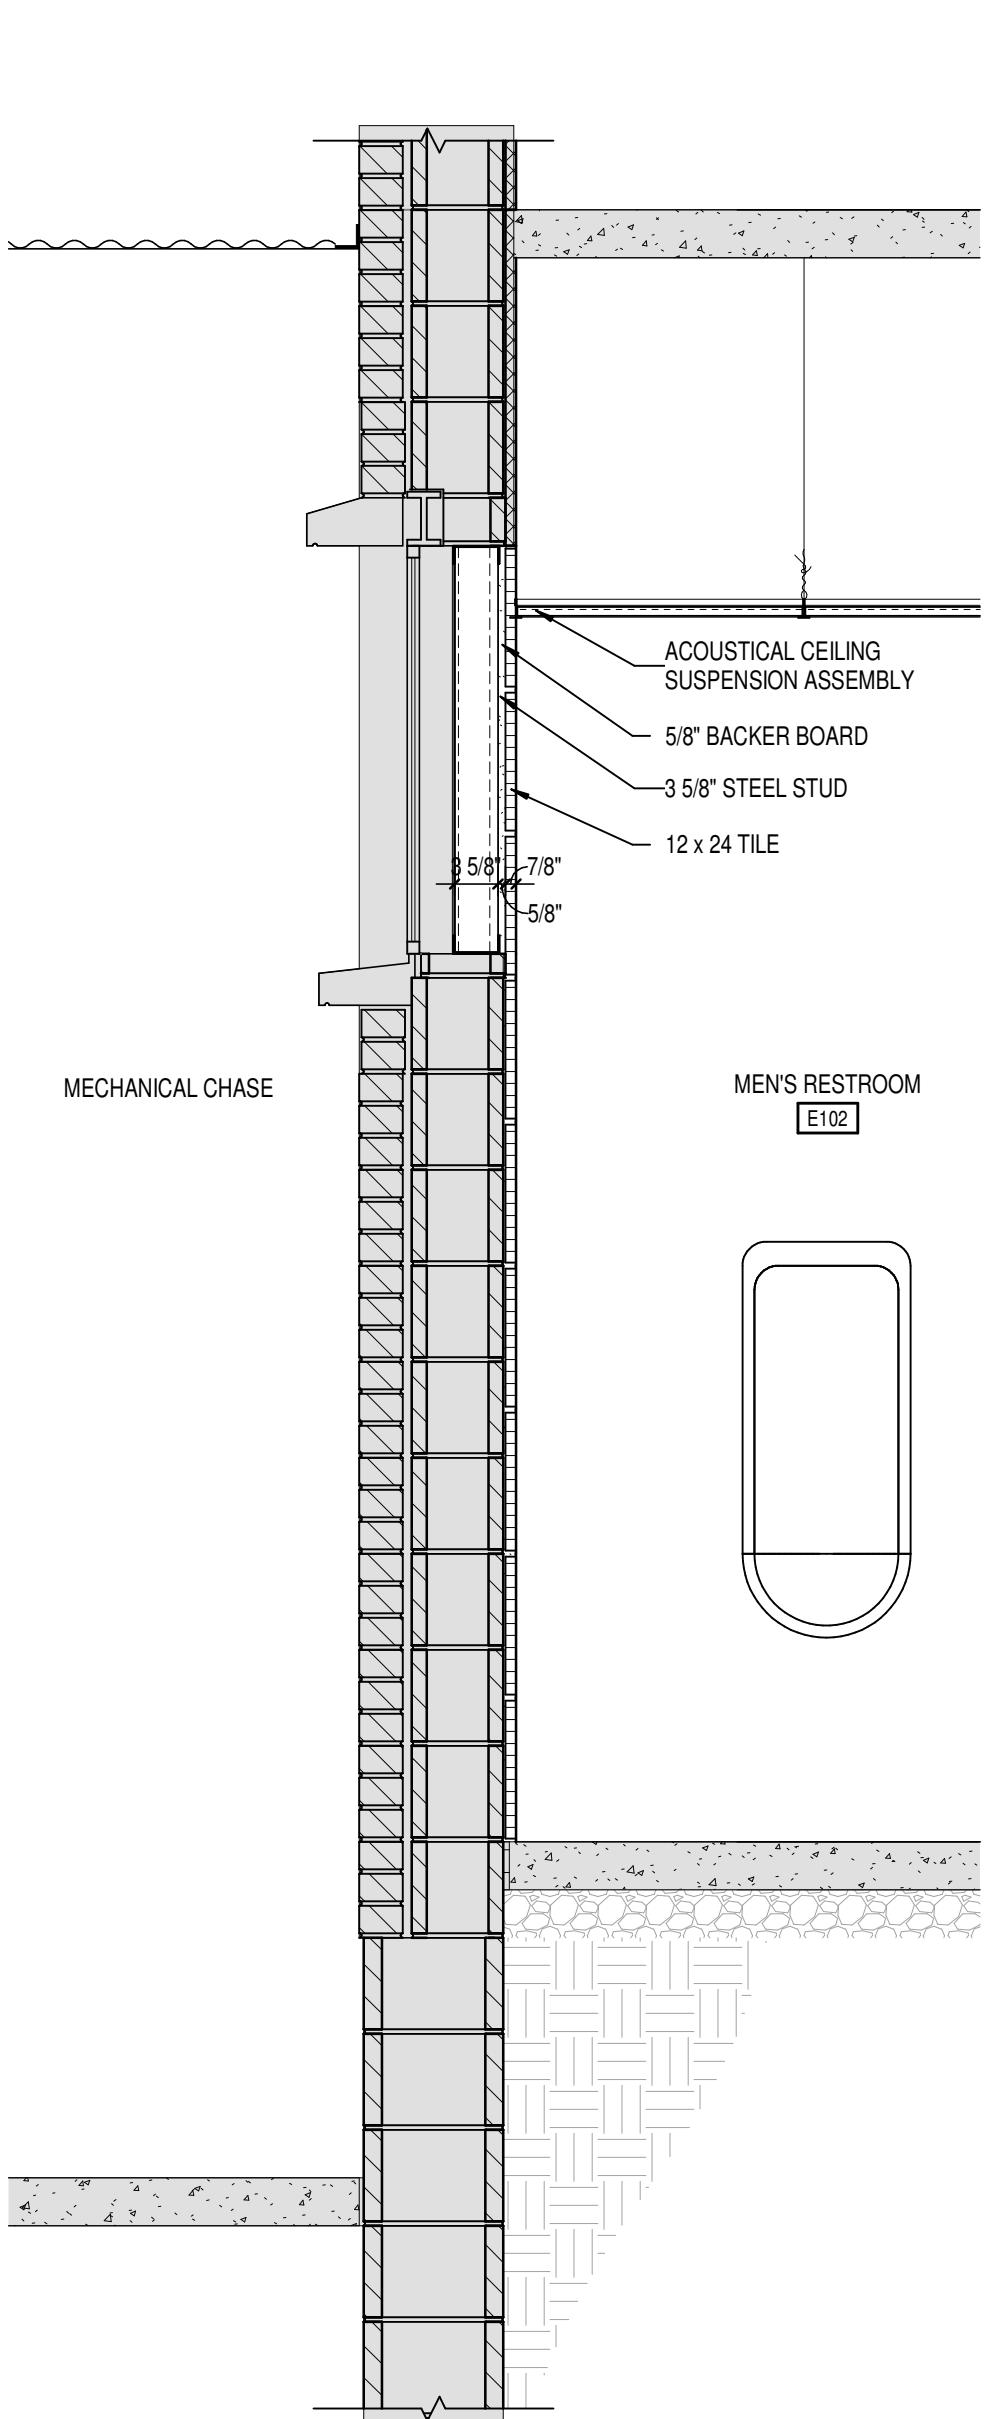


5  
A404

# WALL SECTION


SCALE: 3/4" = 1'-0"

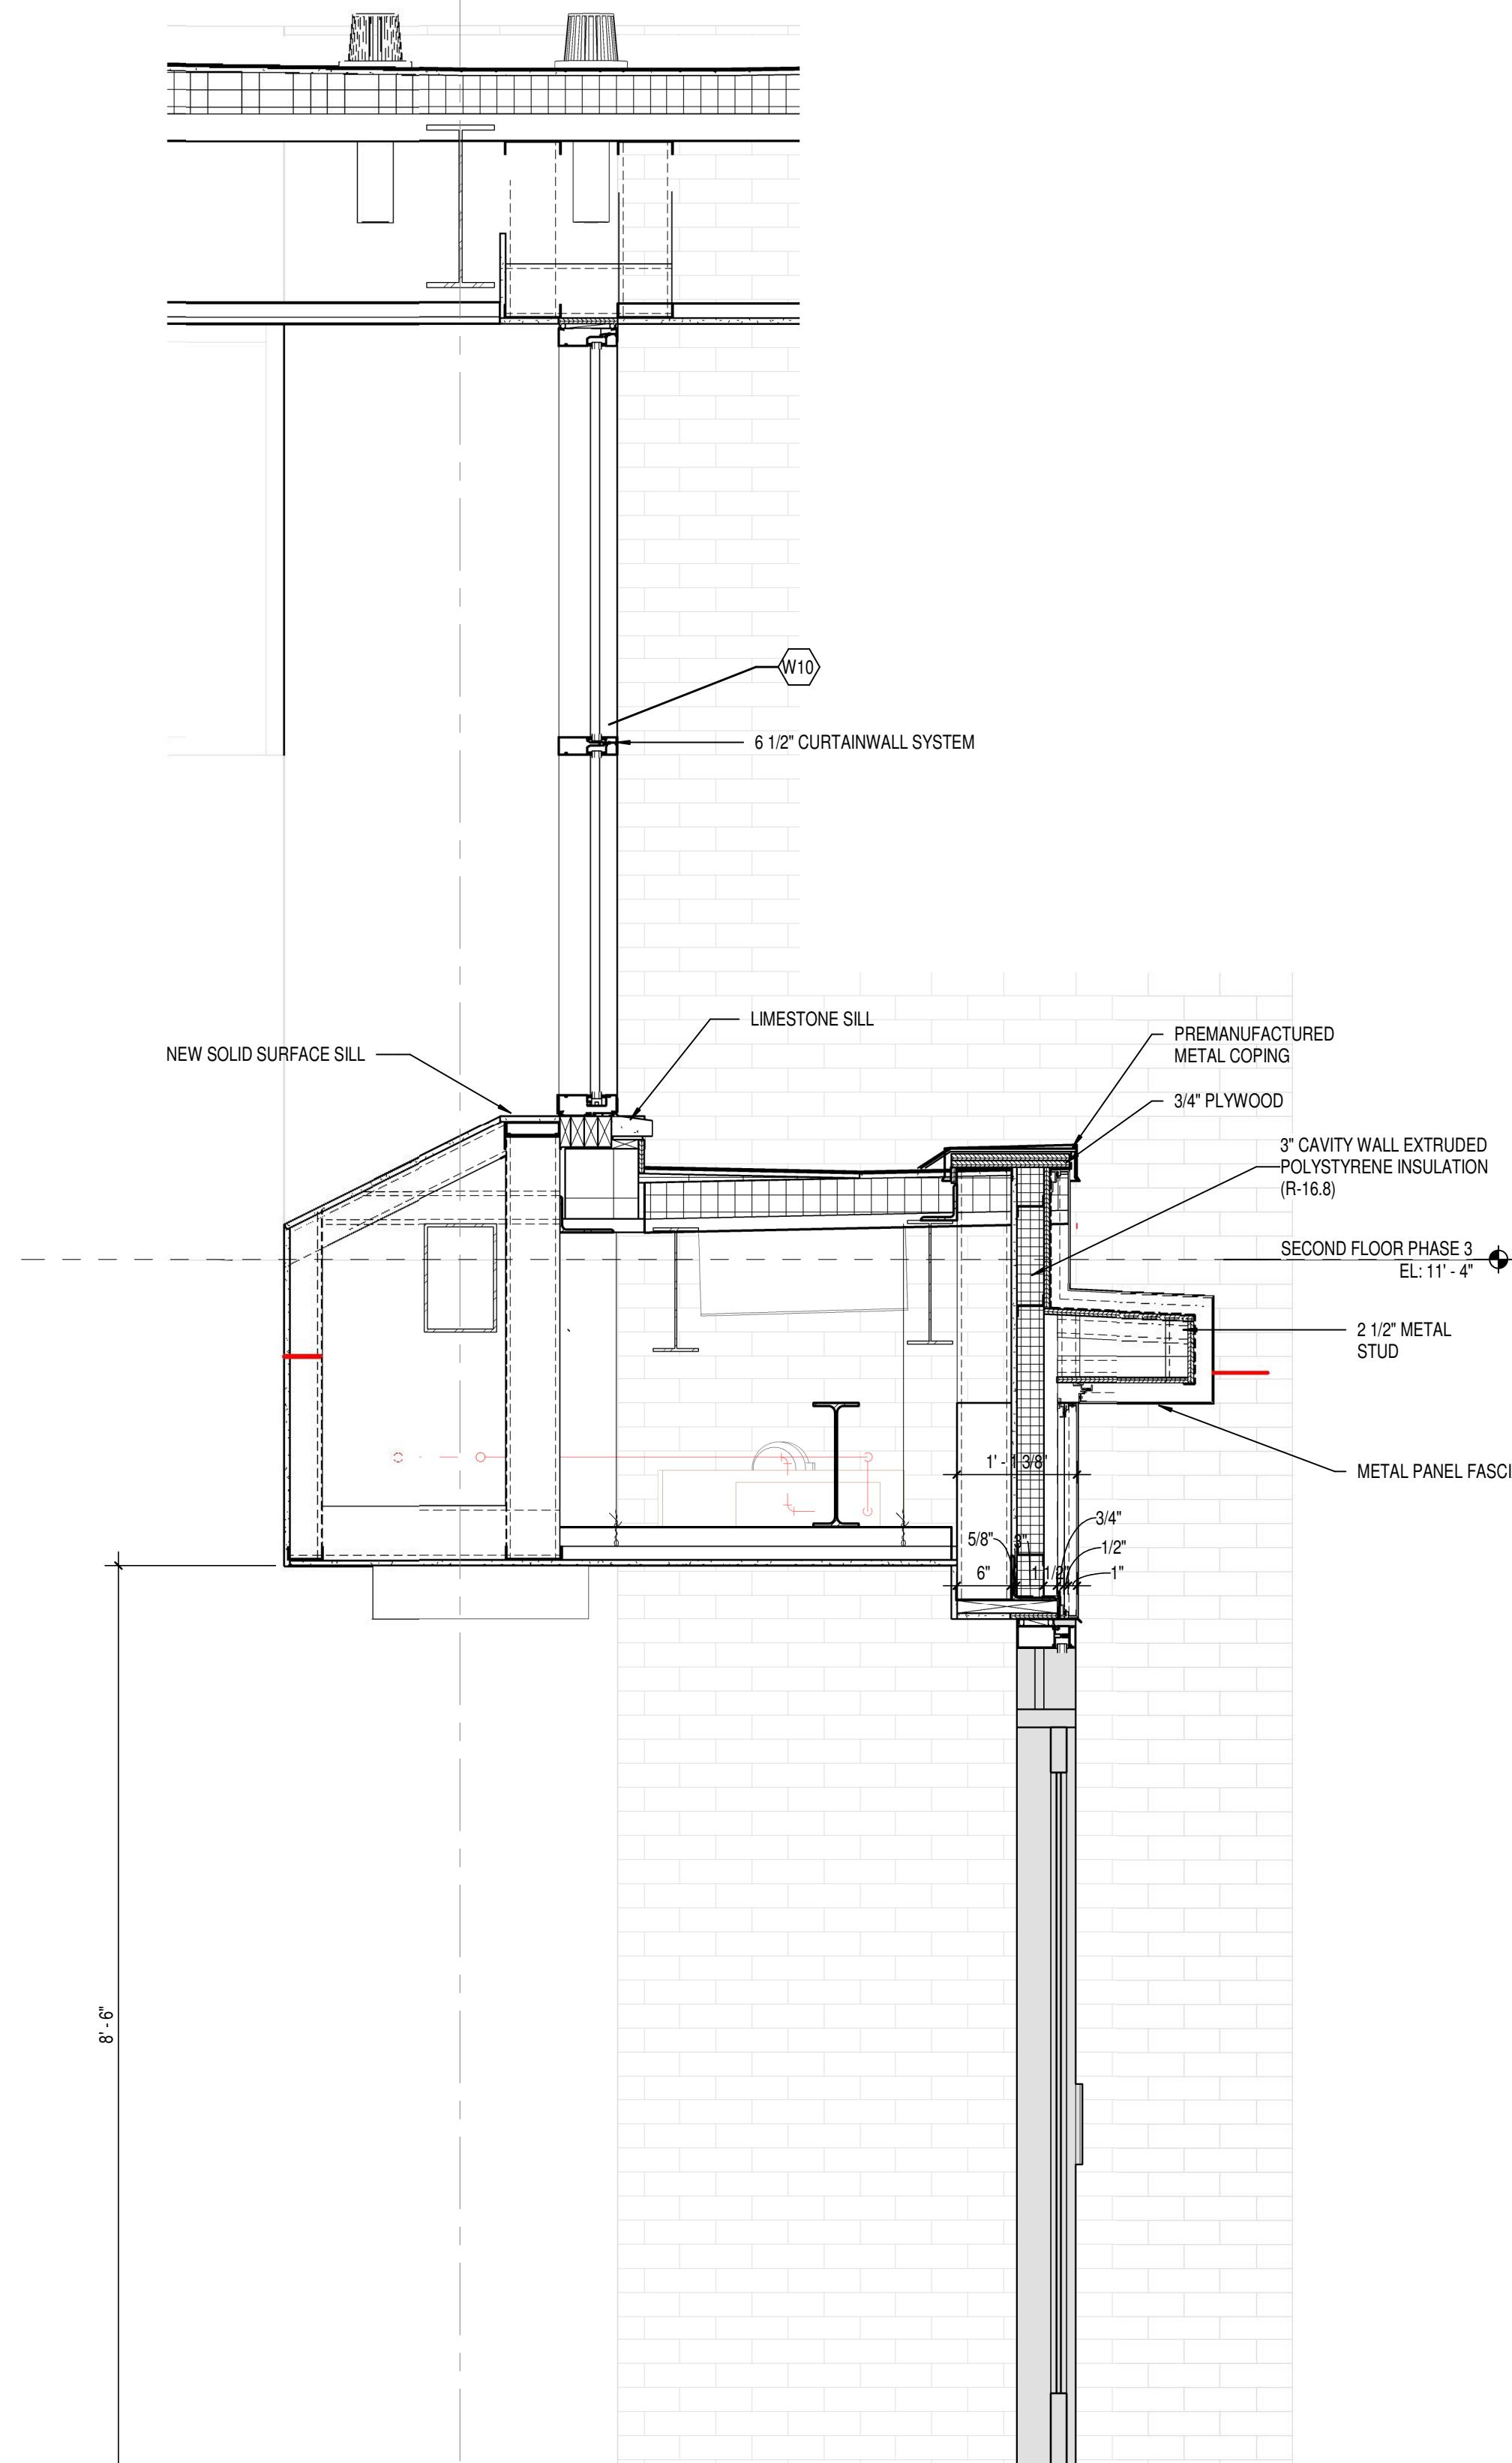


4  
A404 ALTERNATE VESTIBULE WALL SECT  
SCALE: 3/4" = 1'-0"

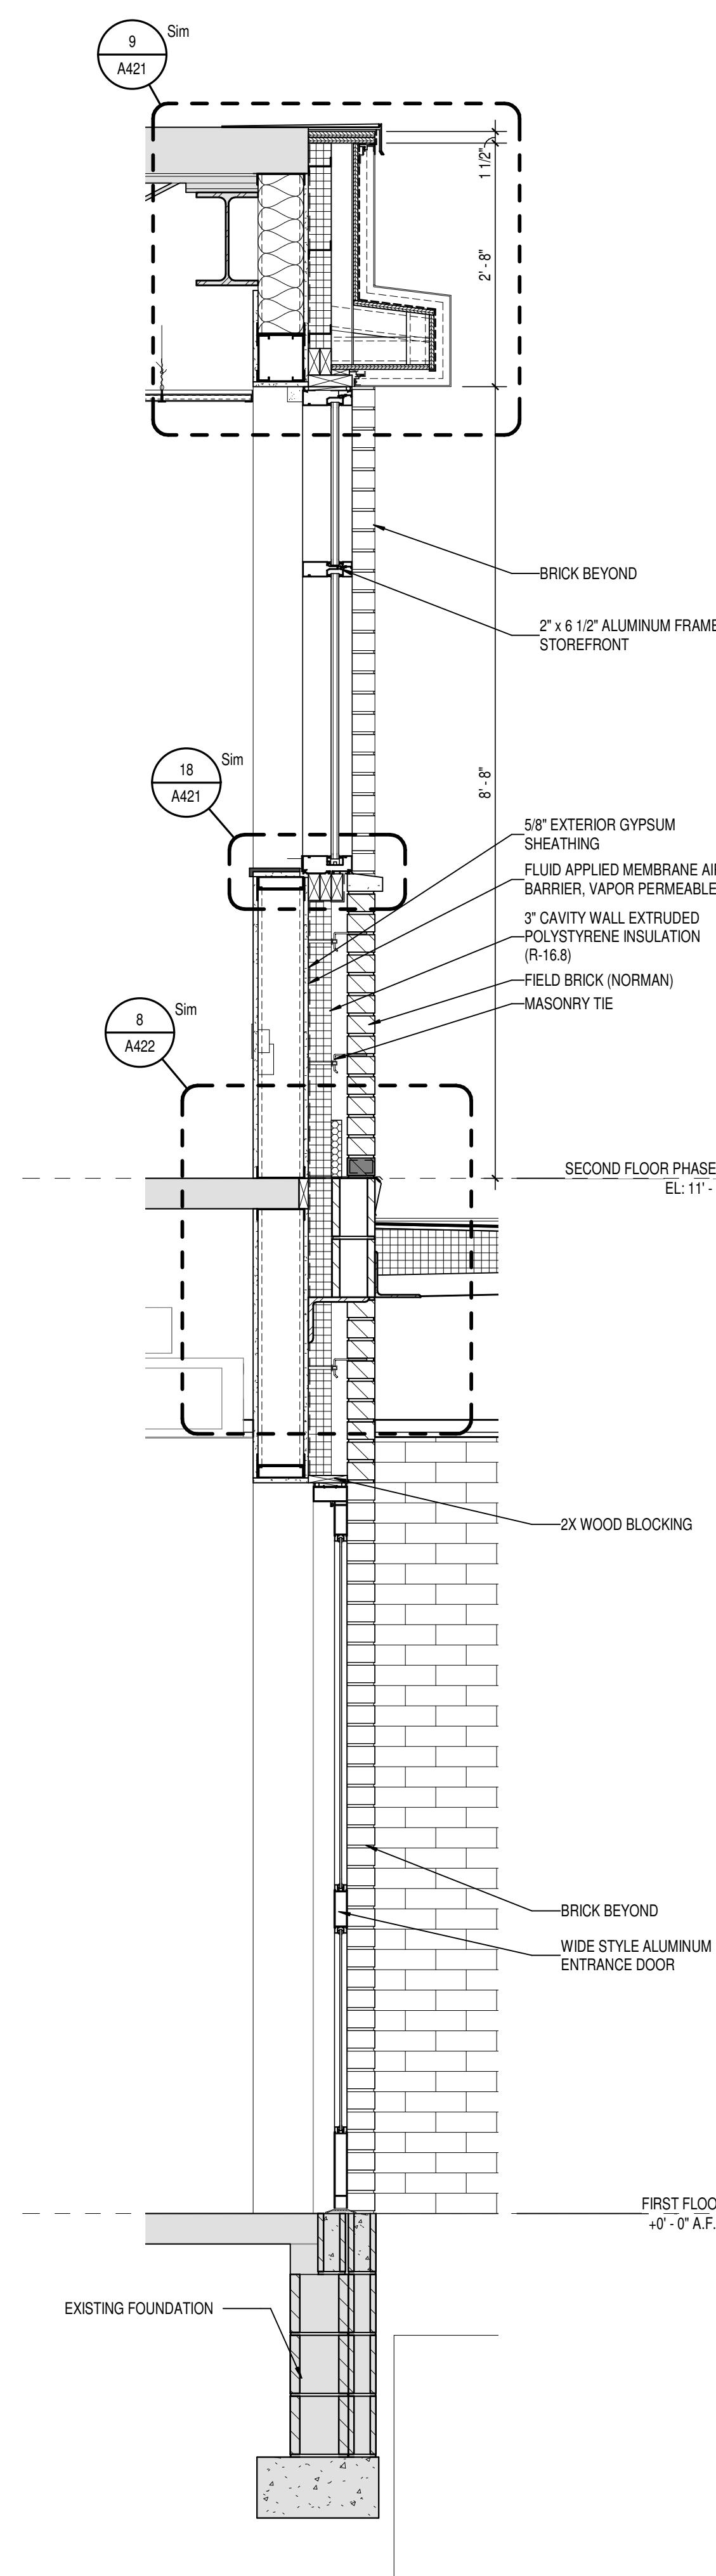

3  
A404 WALL SECTION  
SCALE: 3/4" = 1'-0"

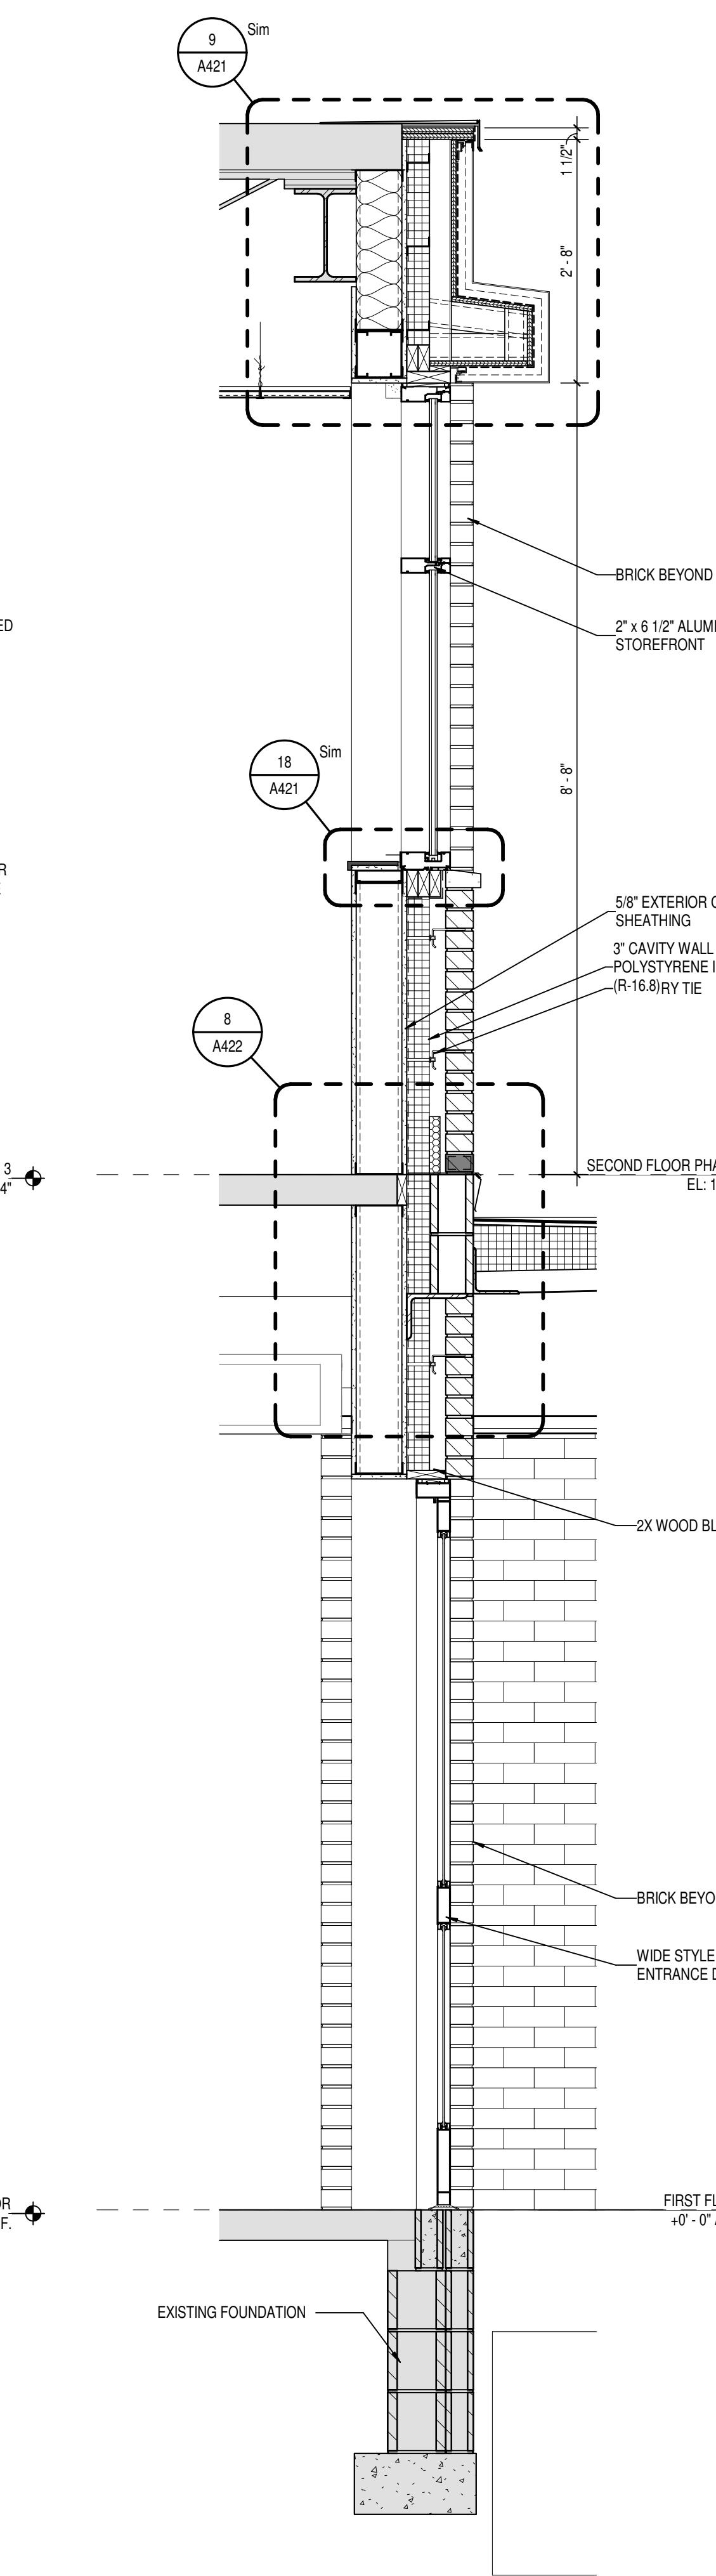

2  
A404  
WALL SECTION  
SCALE: 3/4" = 1'-0"

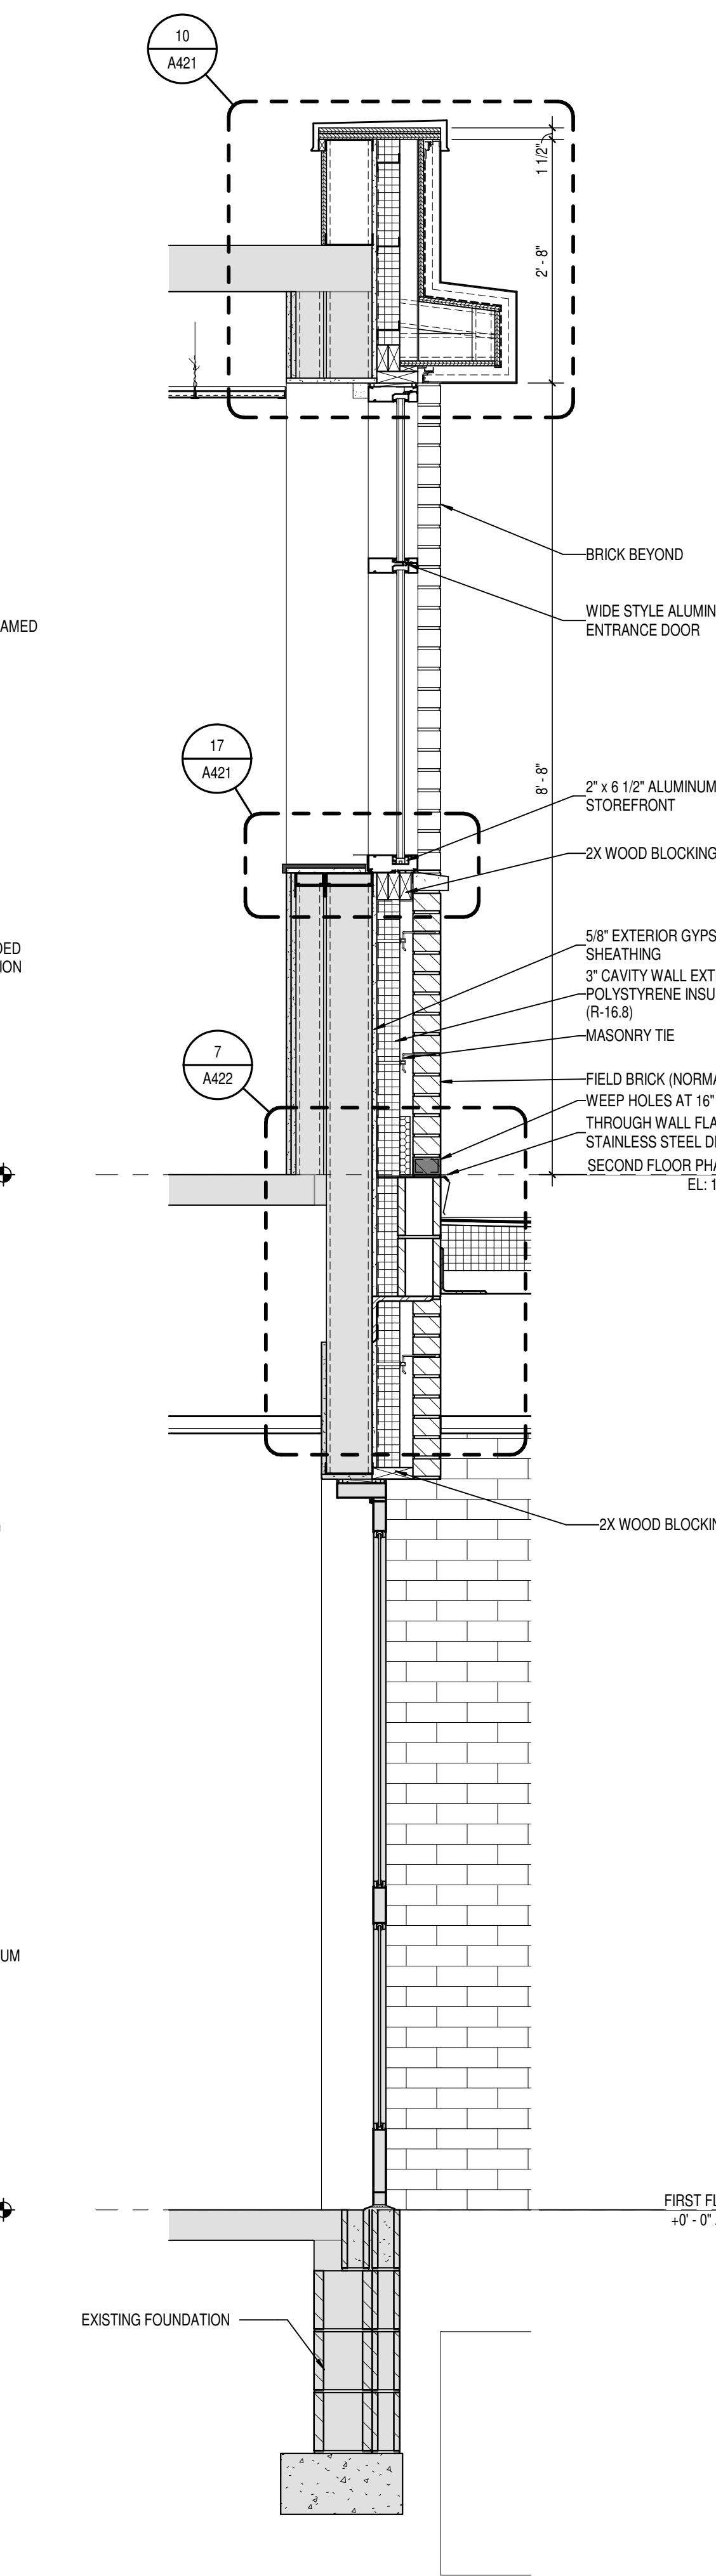

1  
A404

# WALL SECTION

SCALE: 3/4" = 1'-0"



WCSO

317-648-7800 | cso.net

© 2020 WCSO Architects, Inc. All Rights Reserved

PROJECT:  
WARREN CENTRAL HIGH SCHOOL  
PHASE 3 ADDITION & RENOVATION  
9500 E. 16th STREET, INDIANAPOLIS, IN 46229

SCOPE DRAWINGS:


REVISIONS:

DRAWING TITLE:  
ENLARGED  
SECTION  
DETAILS


CERTIFIED BY:  
JAMES ROBERT PANK  
REGISTERED FIRM  
No. AR00900003  
STATE OF  
INDIANA  
ARCHITECT

DRAWING NUMBER  
A423


PROJECT NUMBER  
2021056

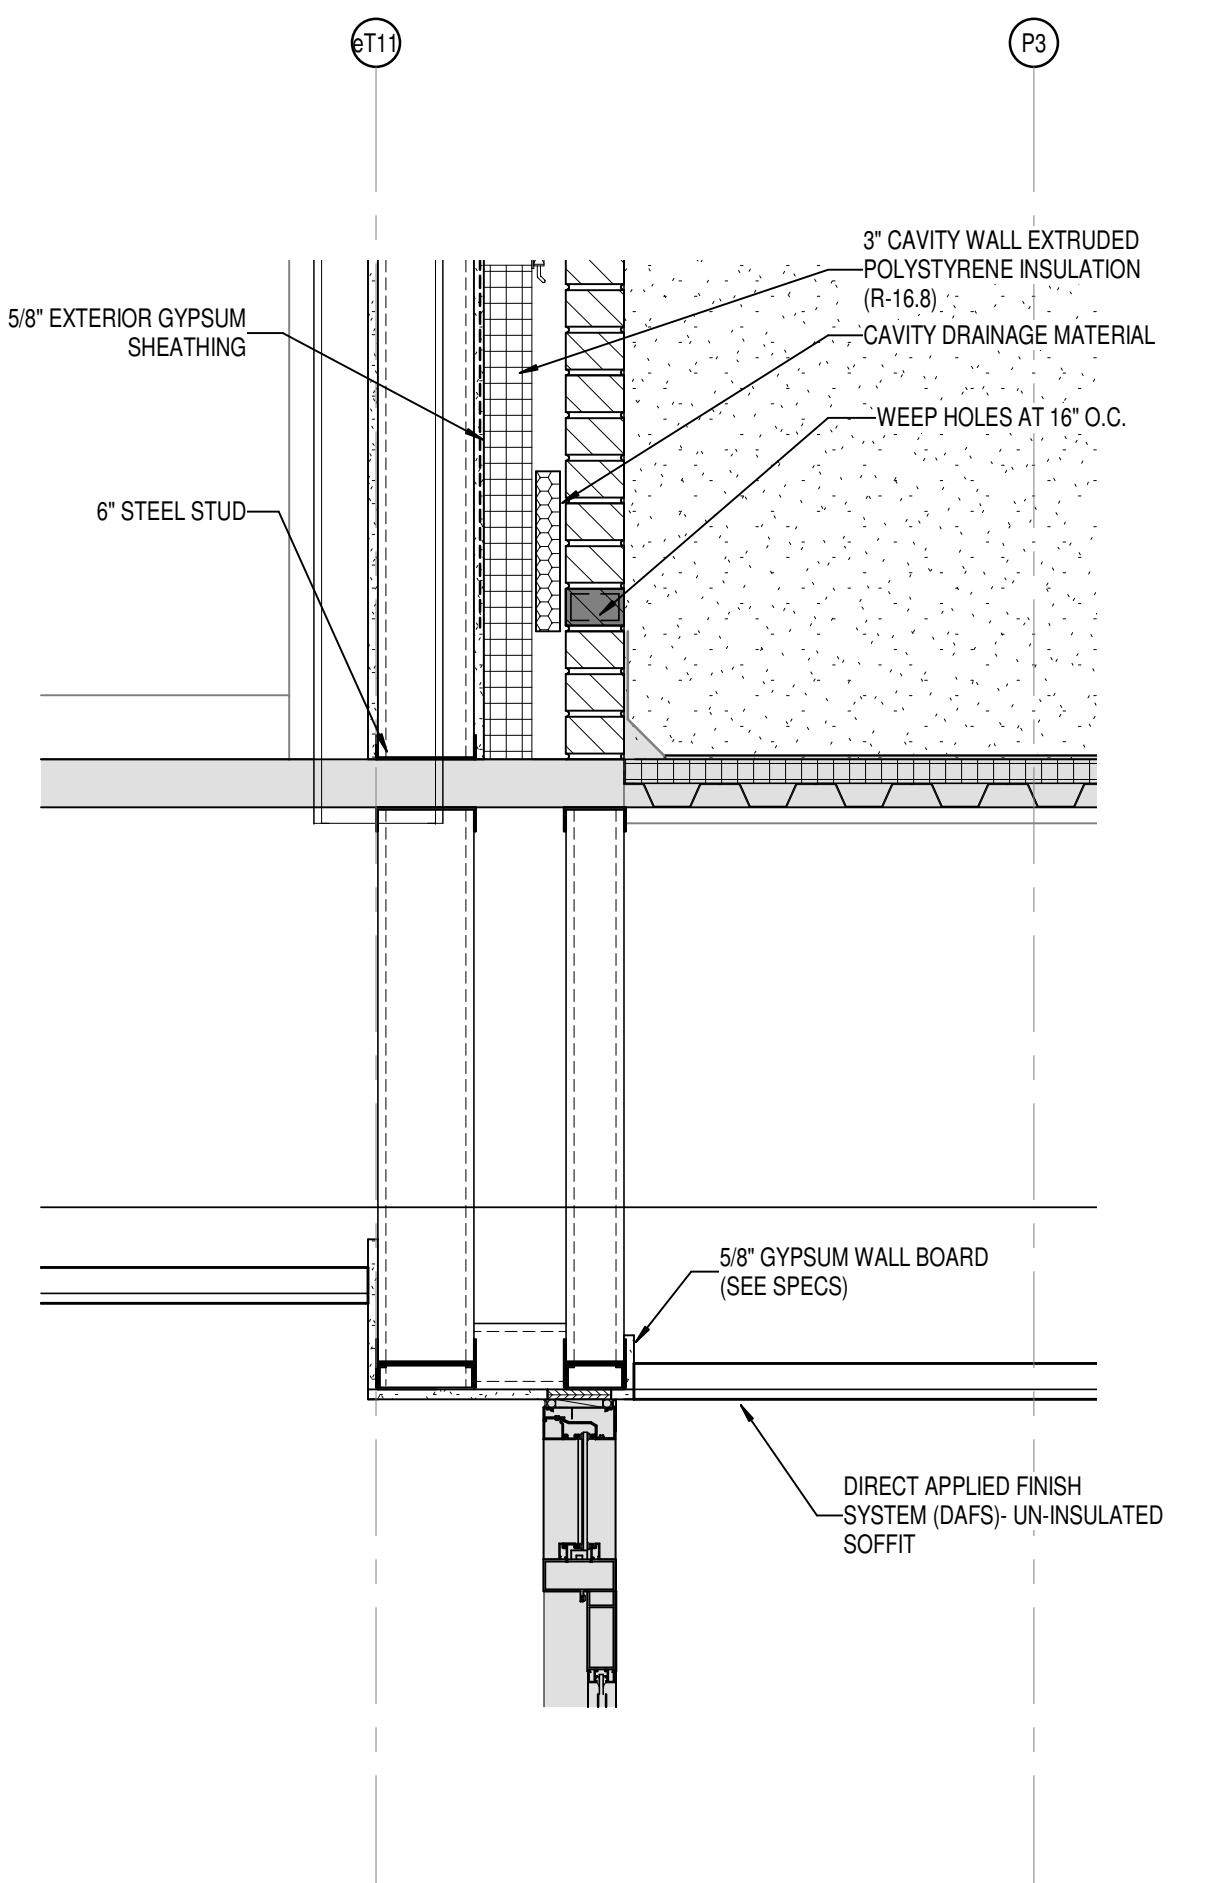


5  
A423  
ENLARGED SECTION DETAIL  
SCALE: 1" = 1'-0"

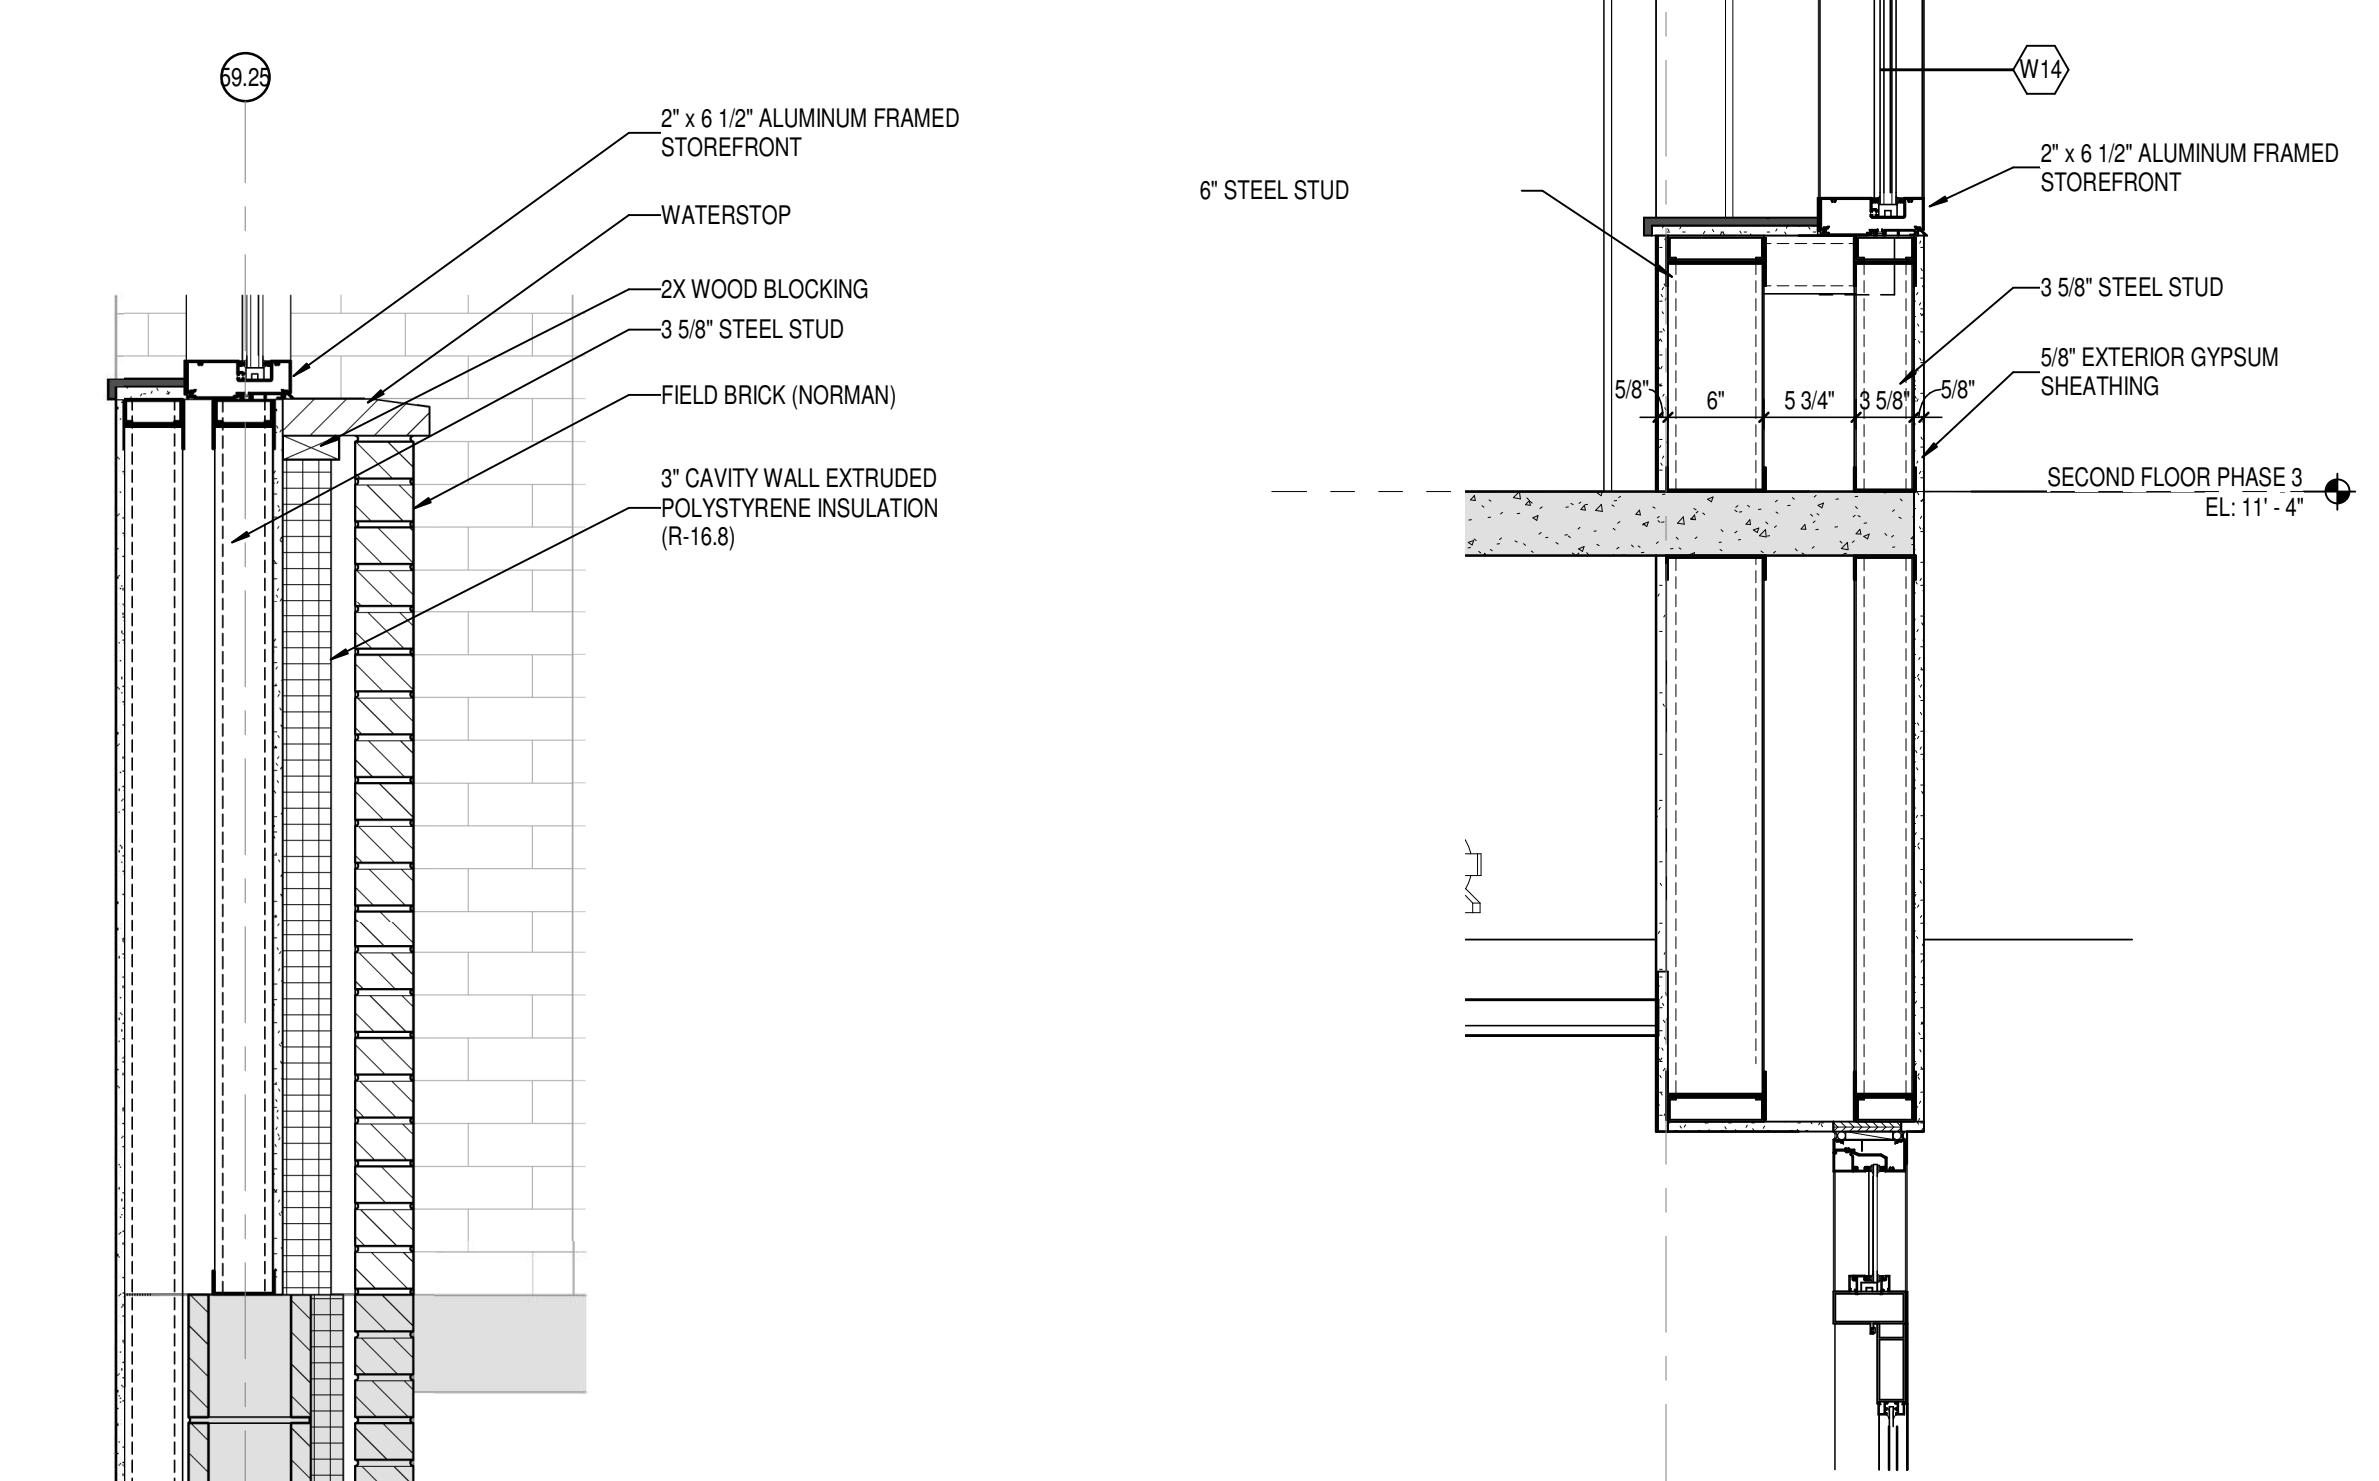

1  
A423  
ENLARGED SECTION DETAIL  
SCALE: 1" = 1'-0"

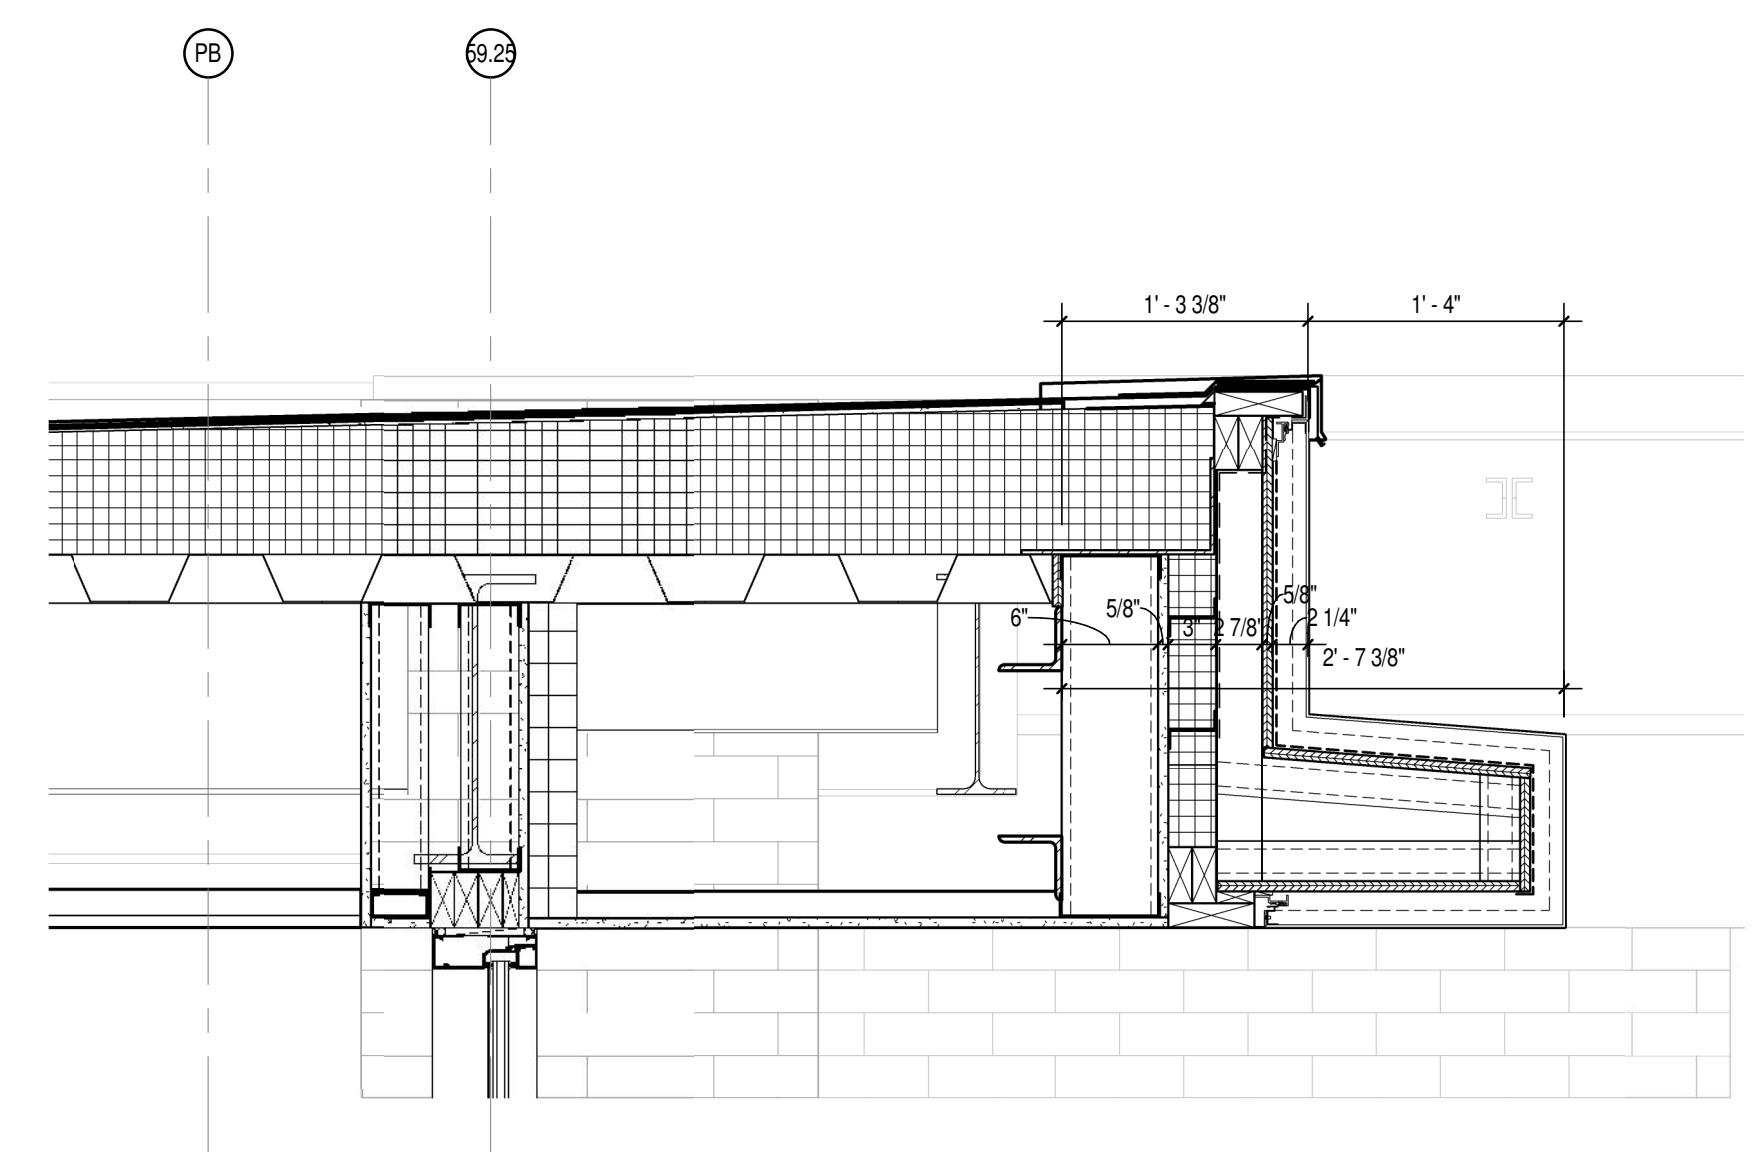

3  
A423  
ENLARGED SECTION DETAIL  
SCALE: 1" = 1'-0"

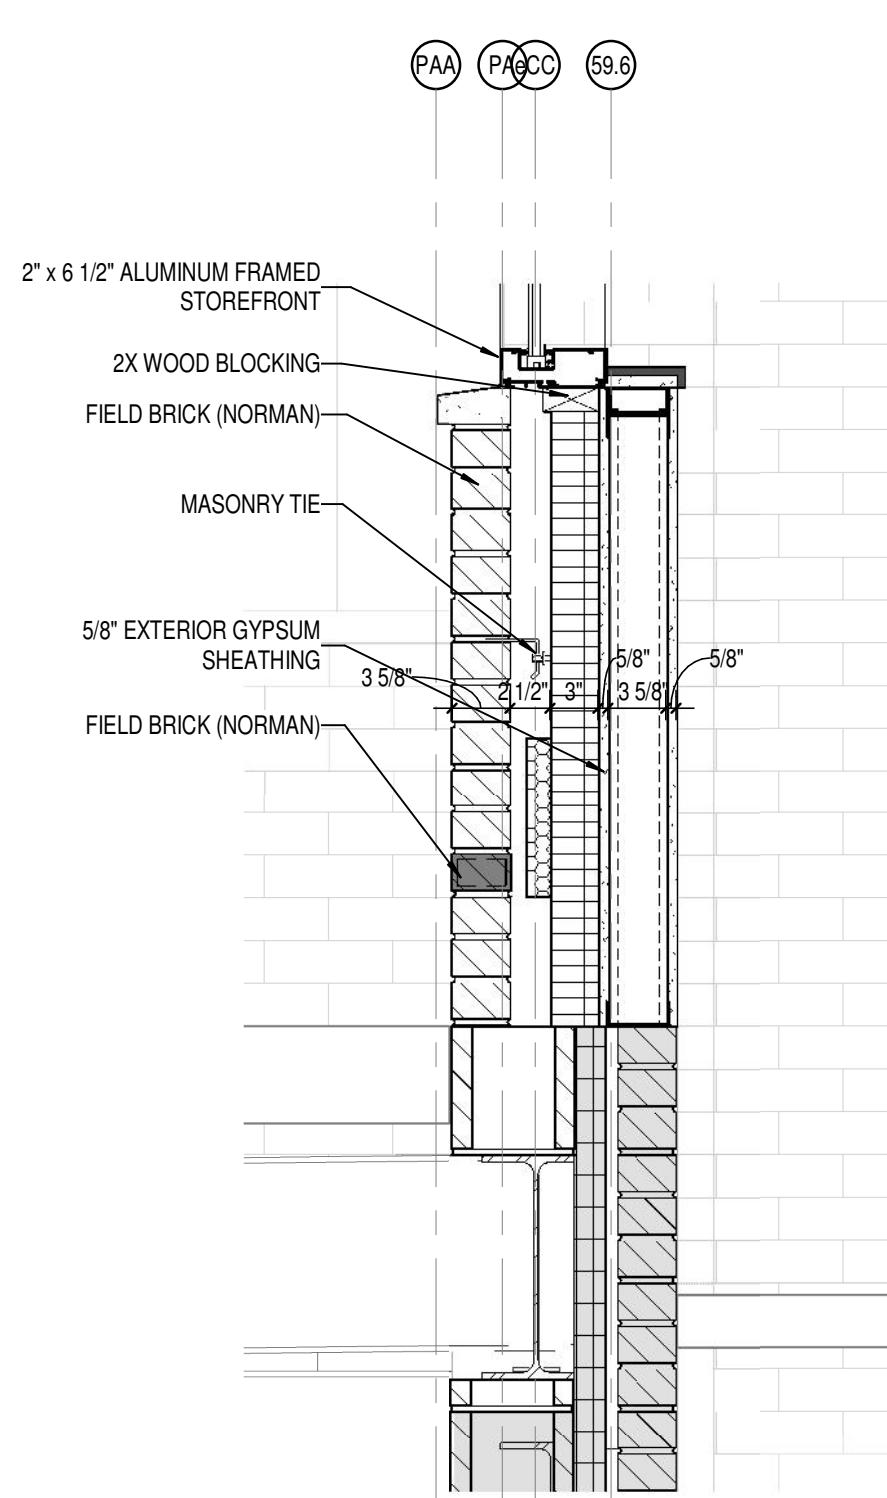

4  
A423  
ENLARGED SECTION DETAIL  
SCALE: 1" = 1'-0"



SSCSO

8831 Keystone Crossing, Indianapolis, IN 46240

317.648.7800 | cso.com

© 2020 CSO Architects, Inc. All Rights Reserved


PROJECT:  
WARREN CENTRAL HIGH SCHOOL  
PHASE 3 ADDITION & RENOVATION  
9500 E. 6th STREET, INDIANAPOLIS, IN 46229

SCOPE DRAWINGS:  
These drawings contain the detailed description of the project in terms of architectural design concept, the dimensions of the structures, mechanical and electrical systems. All the drawings shall be read in conjunction with the requirements of the Contract.  
The drawings and specifications included or referred to in the trade contractors shall furnish all items required for the proper execution and completion of the work.

REVISIONS:  
1 ADDENDUM #2 03-13-2023


ISSUE DATE: 02-21-2023 DRAWN BY: Author CHECKED BY: Checker

DRAWING TITLE:  
ENLARGED  
PLAN DETAILS

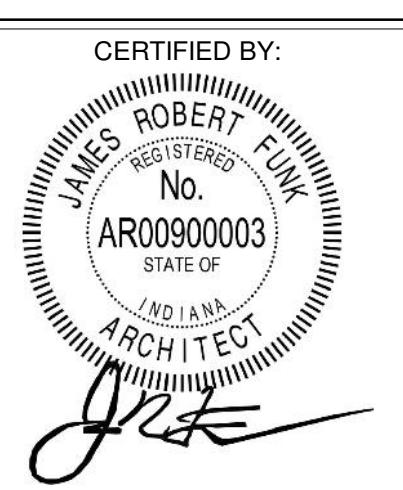


DRAWING NUMBER  
A431


PROJECT NUMBER  
2021056

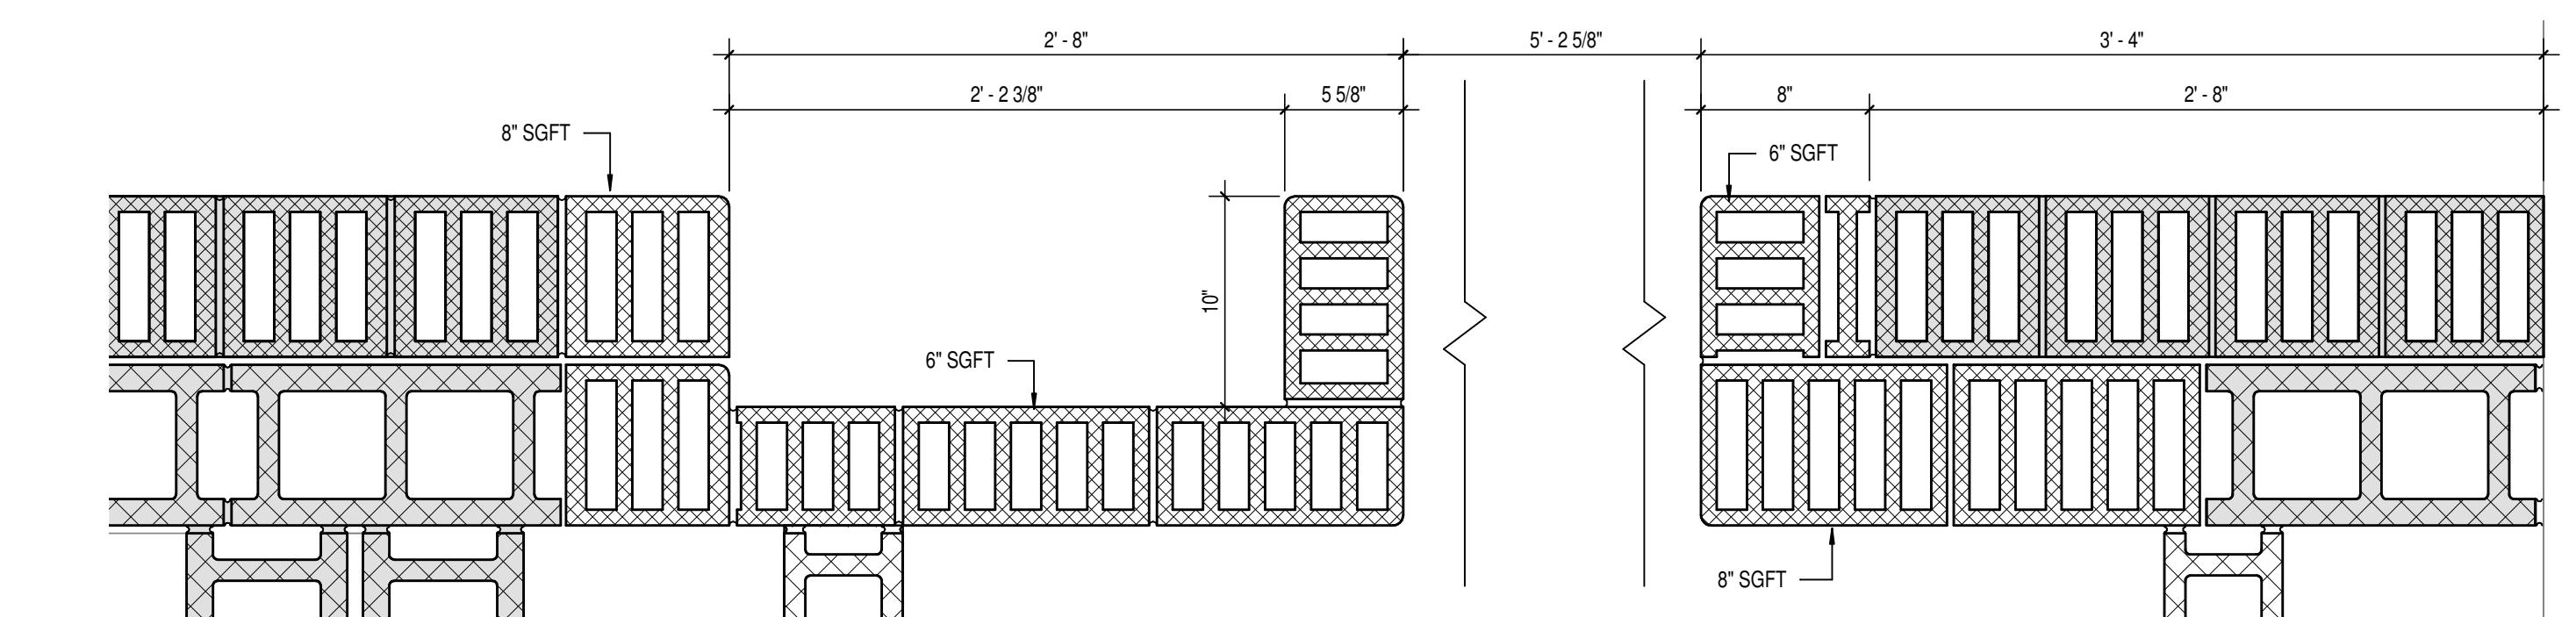

7 LOW - G248C MEN'S RESTROOM  
A431 SCALE: 1 1/2" = 1'-0"

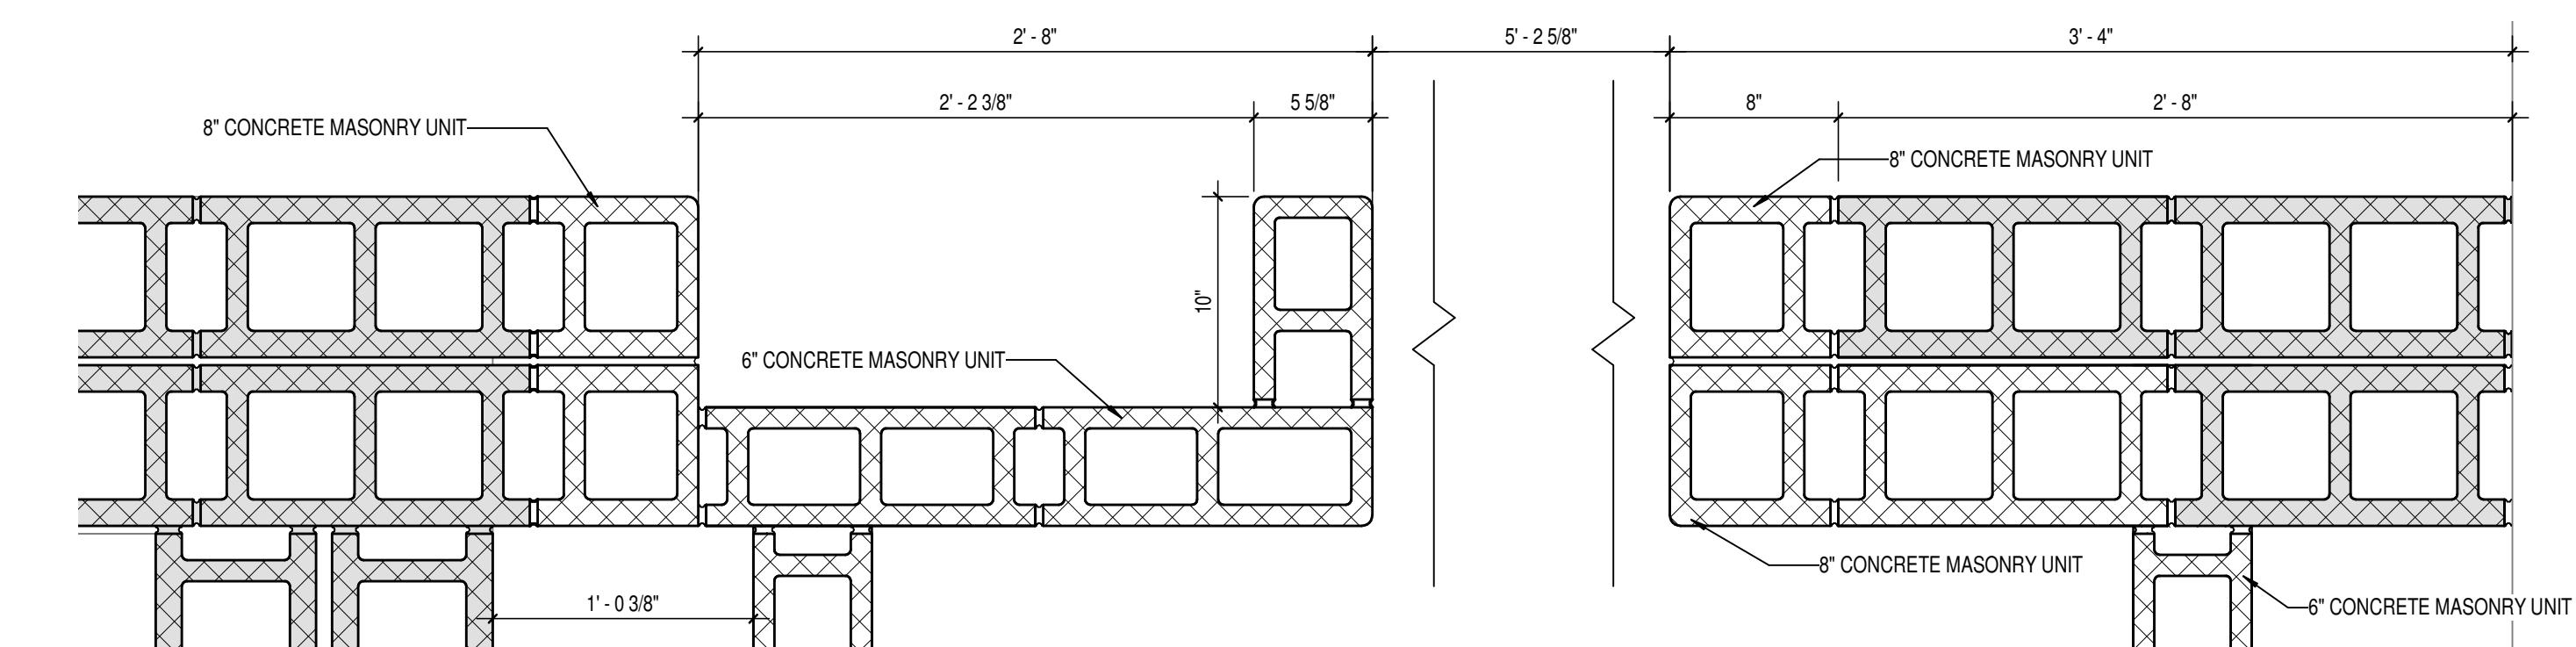


8 HIGH - G248C MEN'S RESTROOM  
A431 SCALE: 1 1/2" = 1'-0"

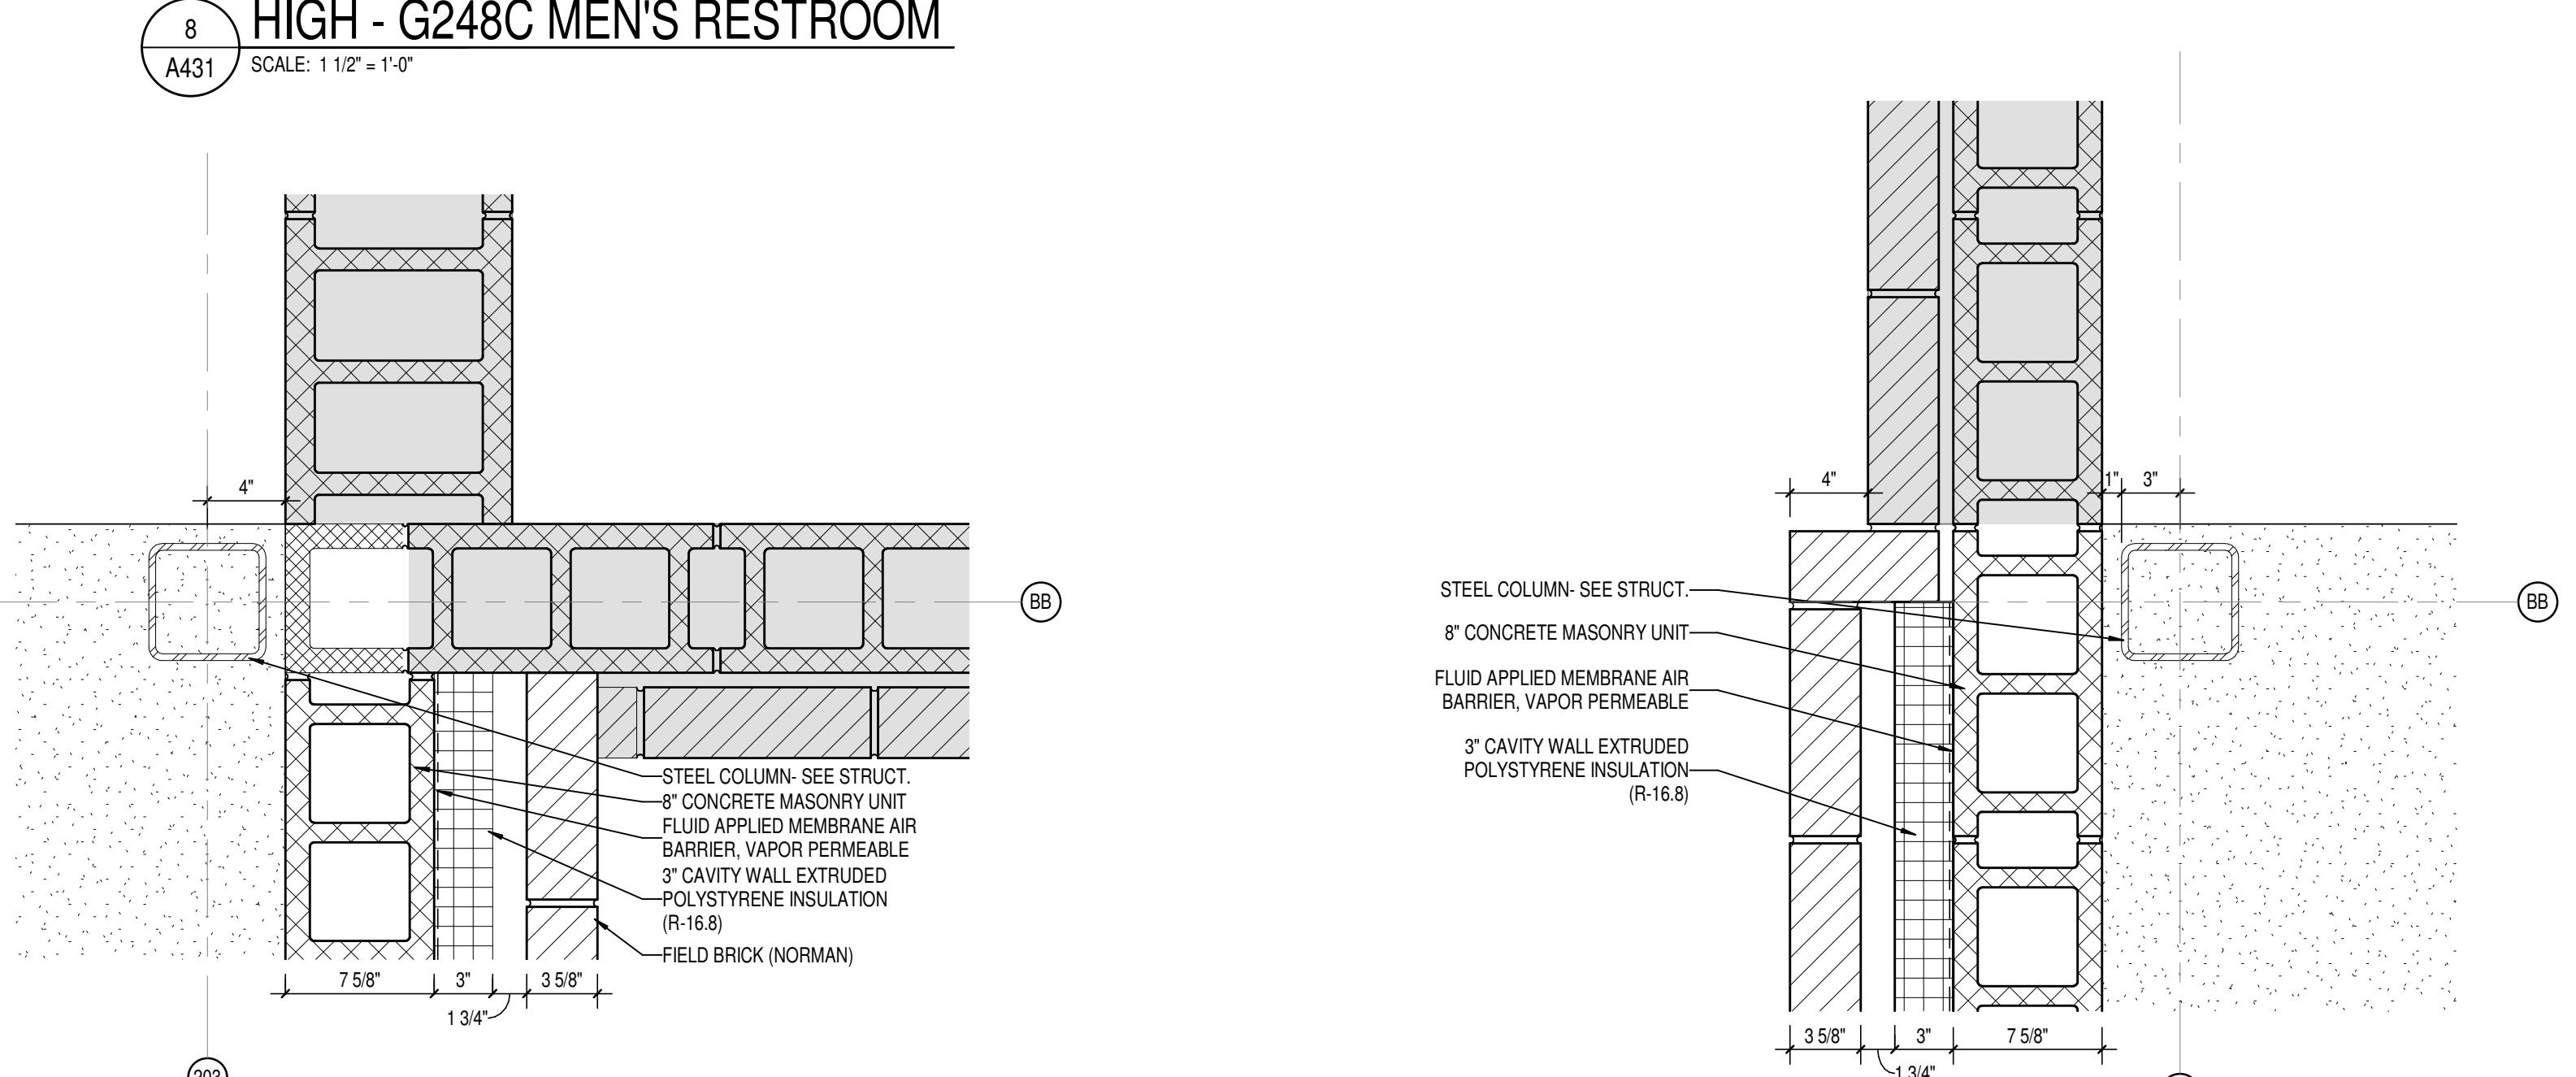


4 PLAN DETAIL  
A431 SCALE: 1 1/2" = 1'-0"


3 PLAN DETAIL  
A431 SCALE: 1 1/2" = 1'-0"

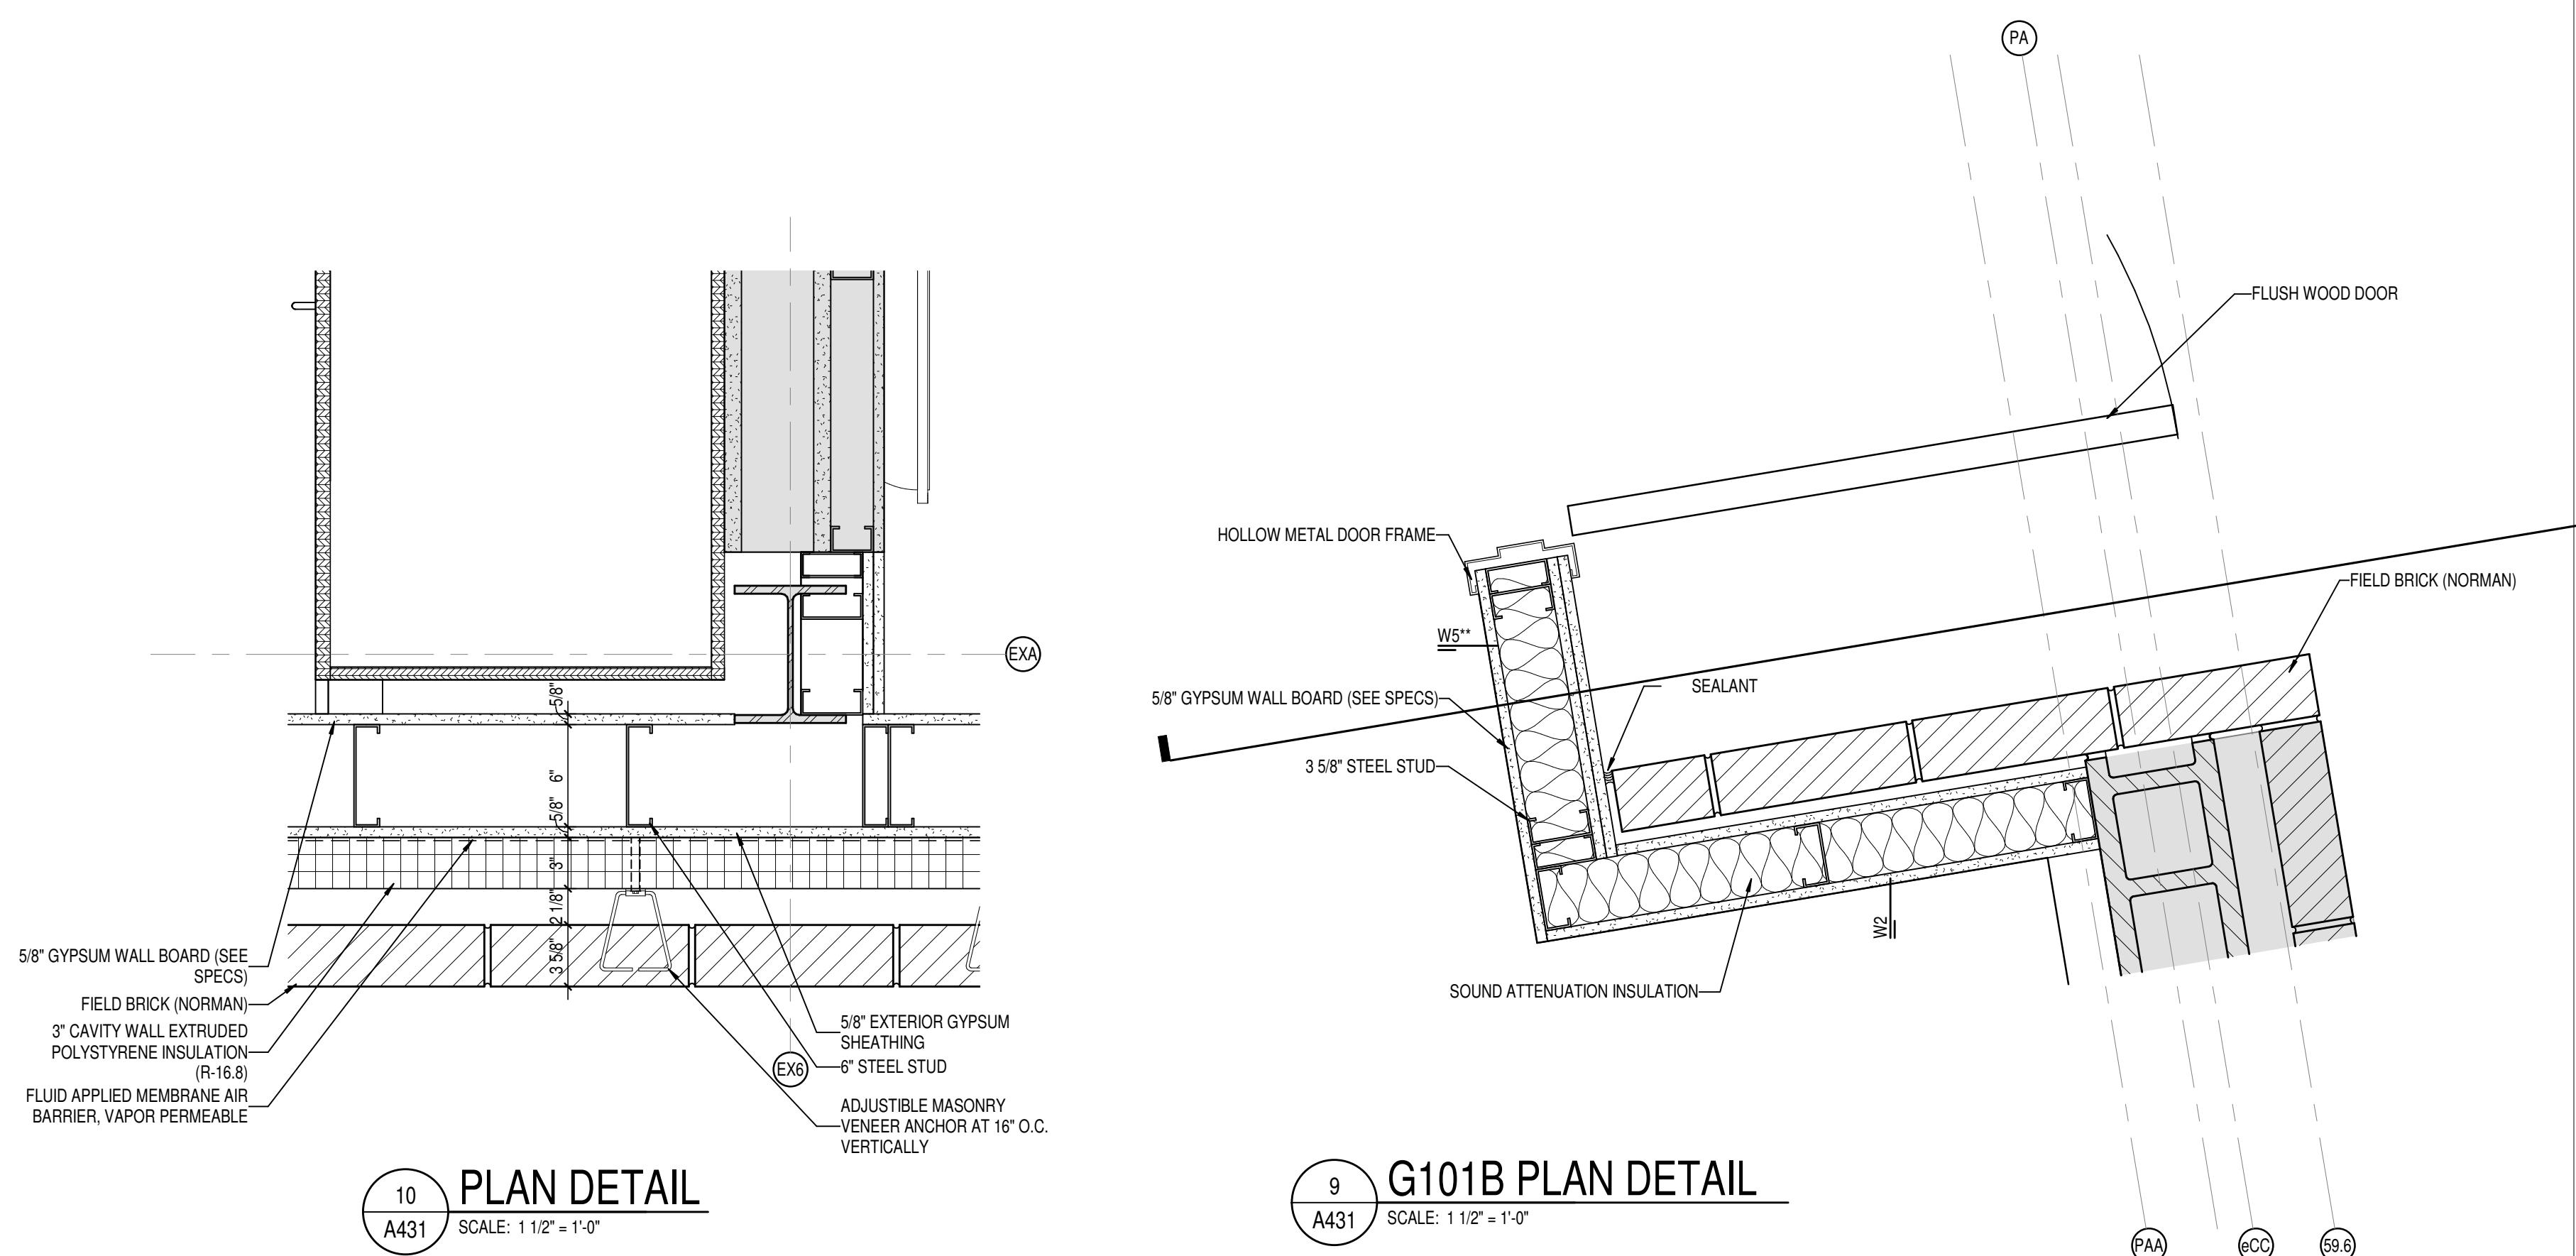


10 PLAN DETAIL  
A431 SCALE: 1 1/2" = 1'-0"

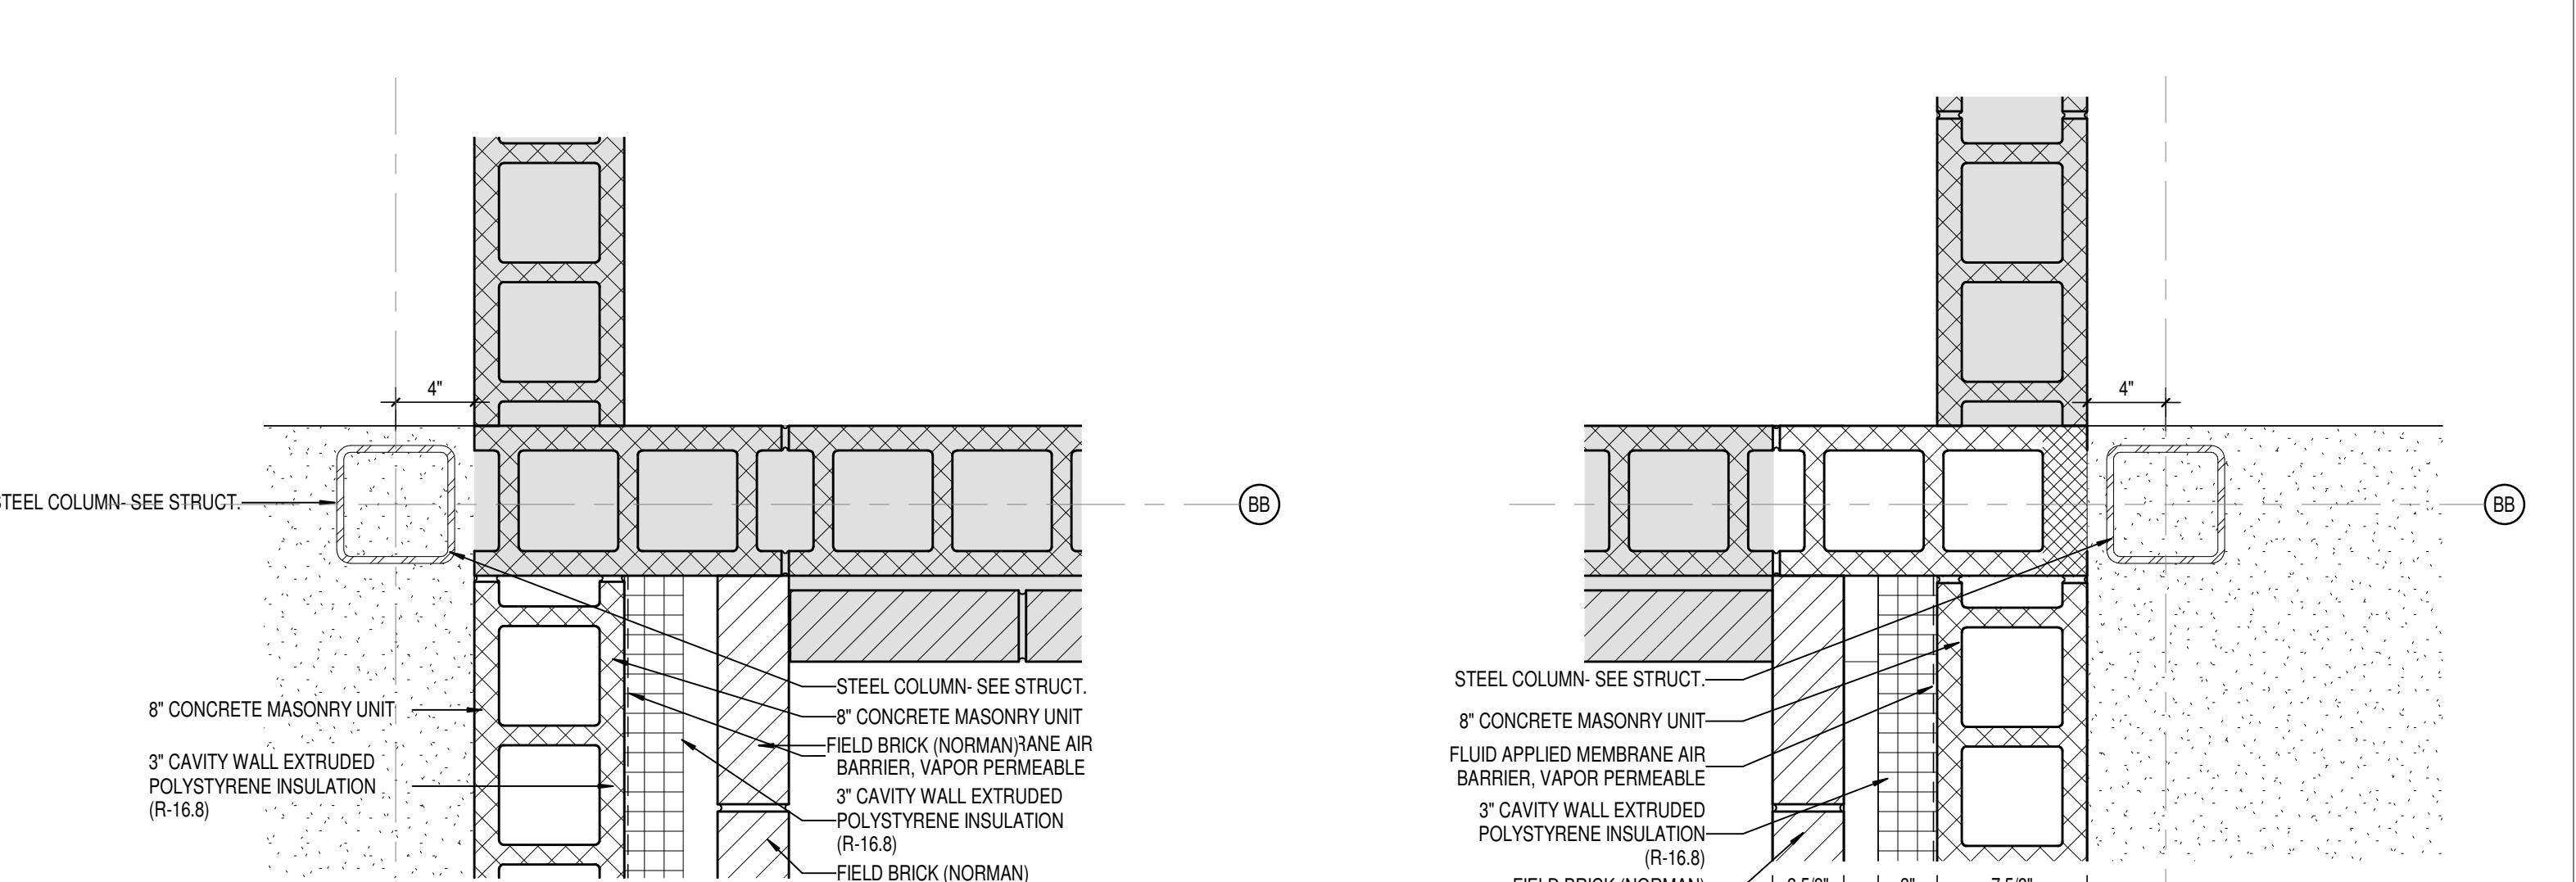


9 G101B PLAN DETAIL  
A431 SCALE: 1 1/2" = 1'-0"

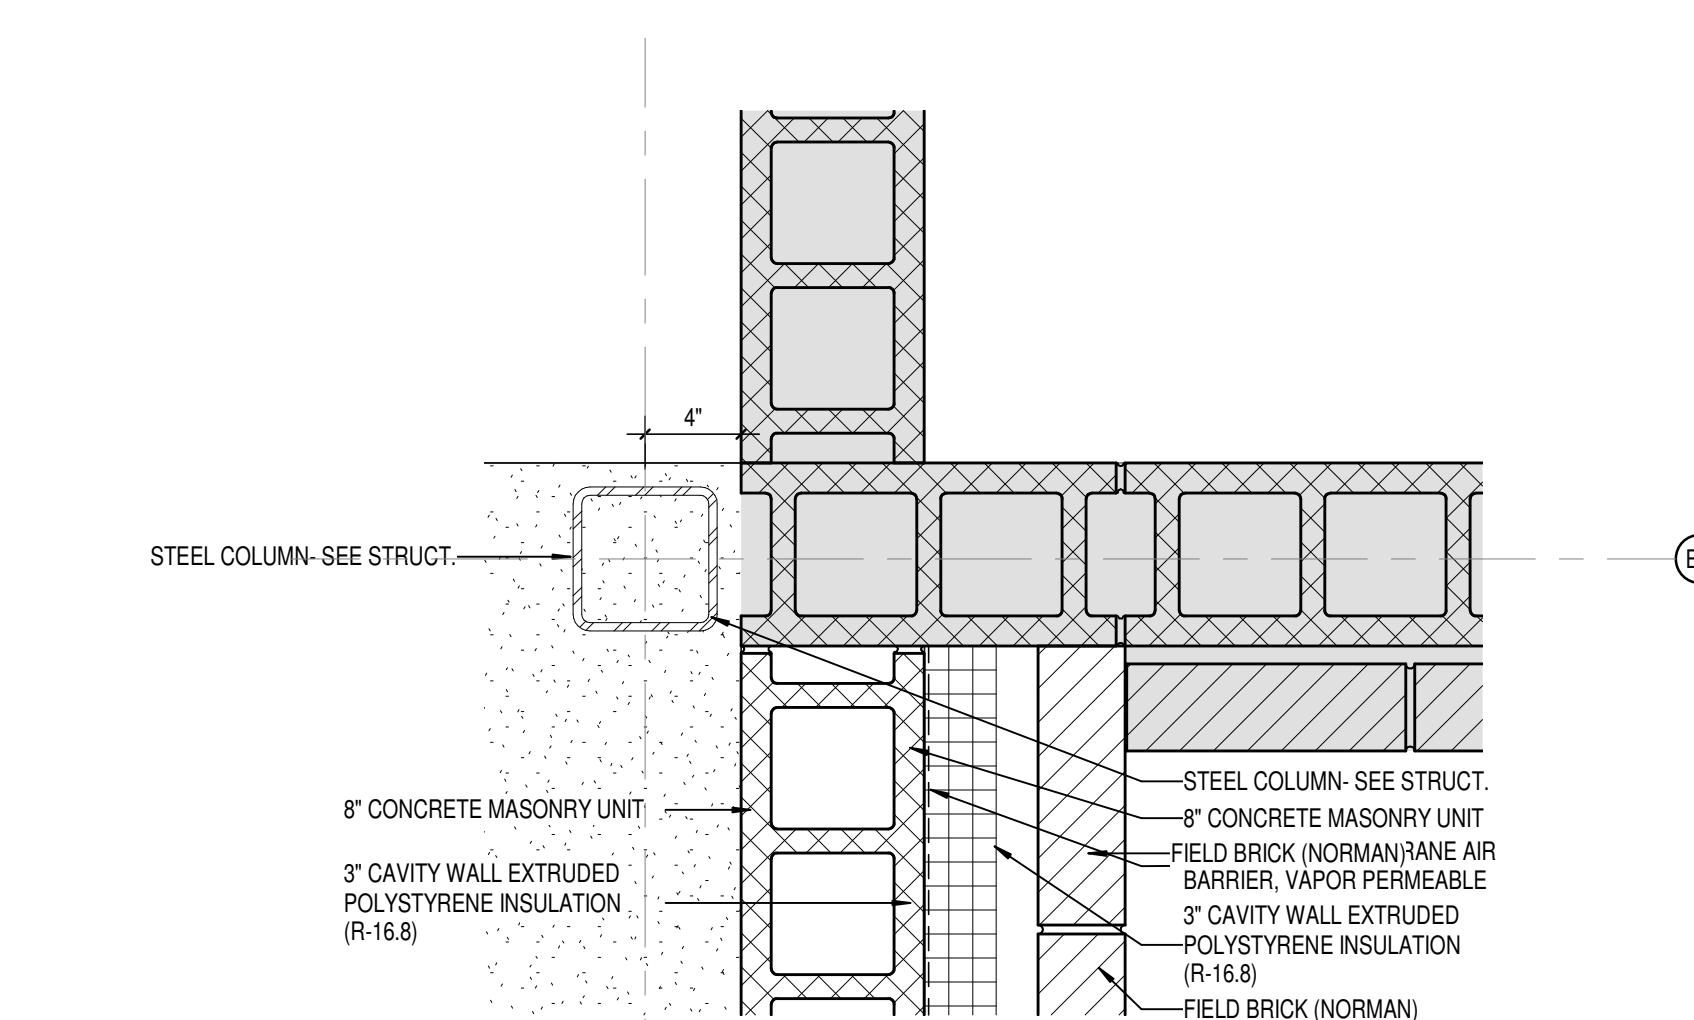


6 PLAN DETAIL  
A431 SCALE: 1 1/2" = 1'-0"

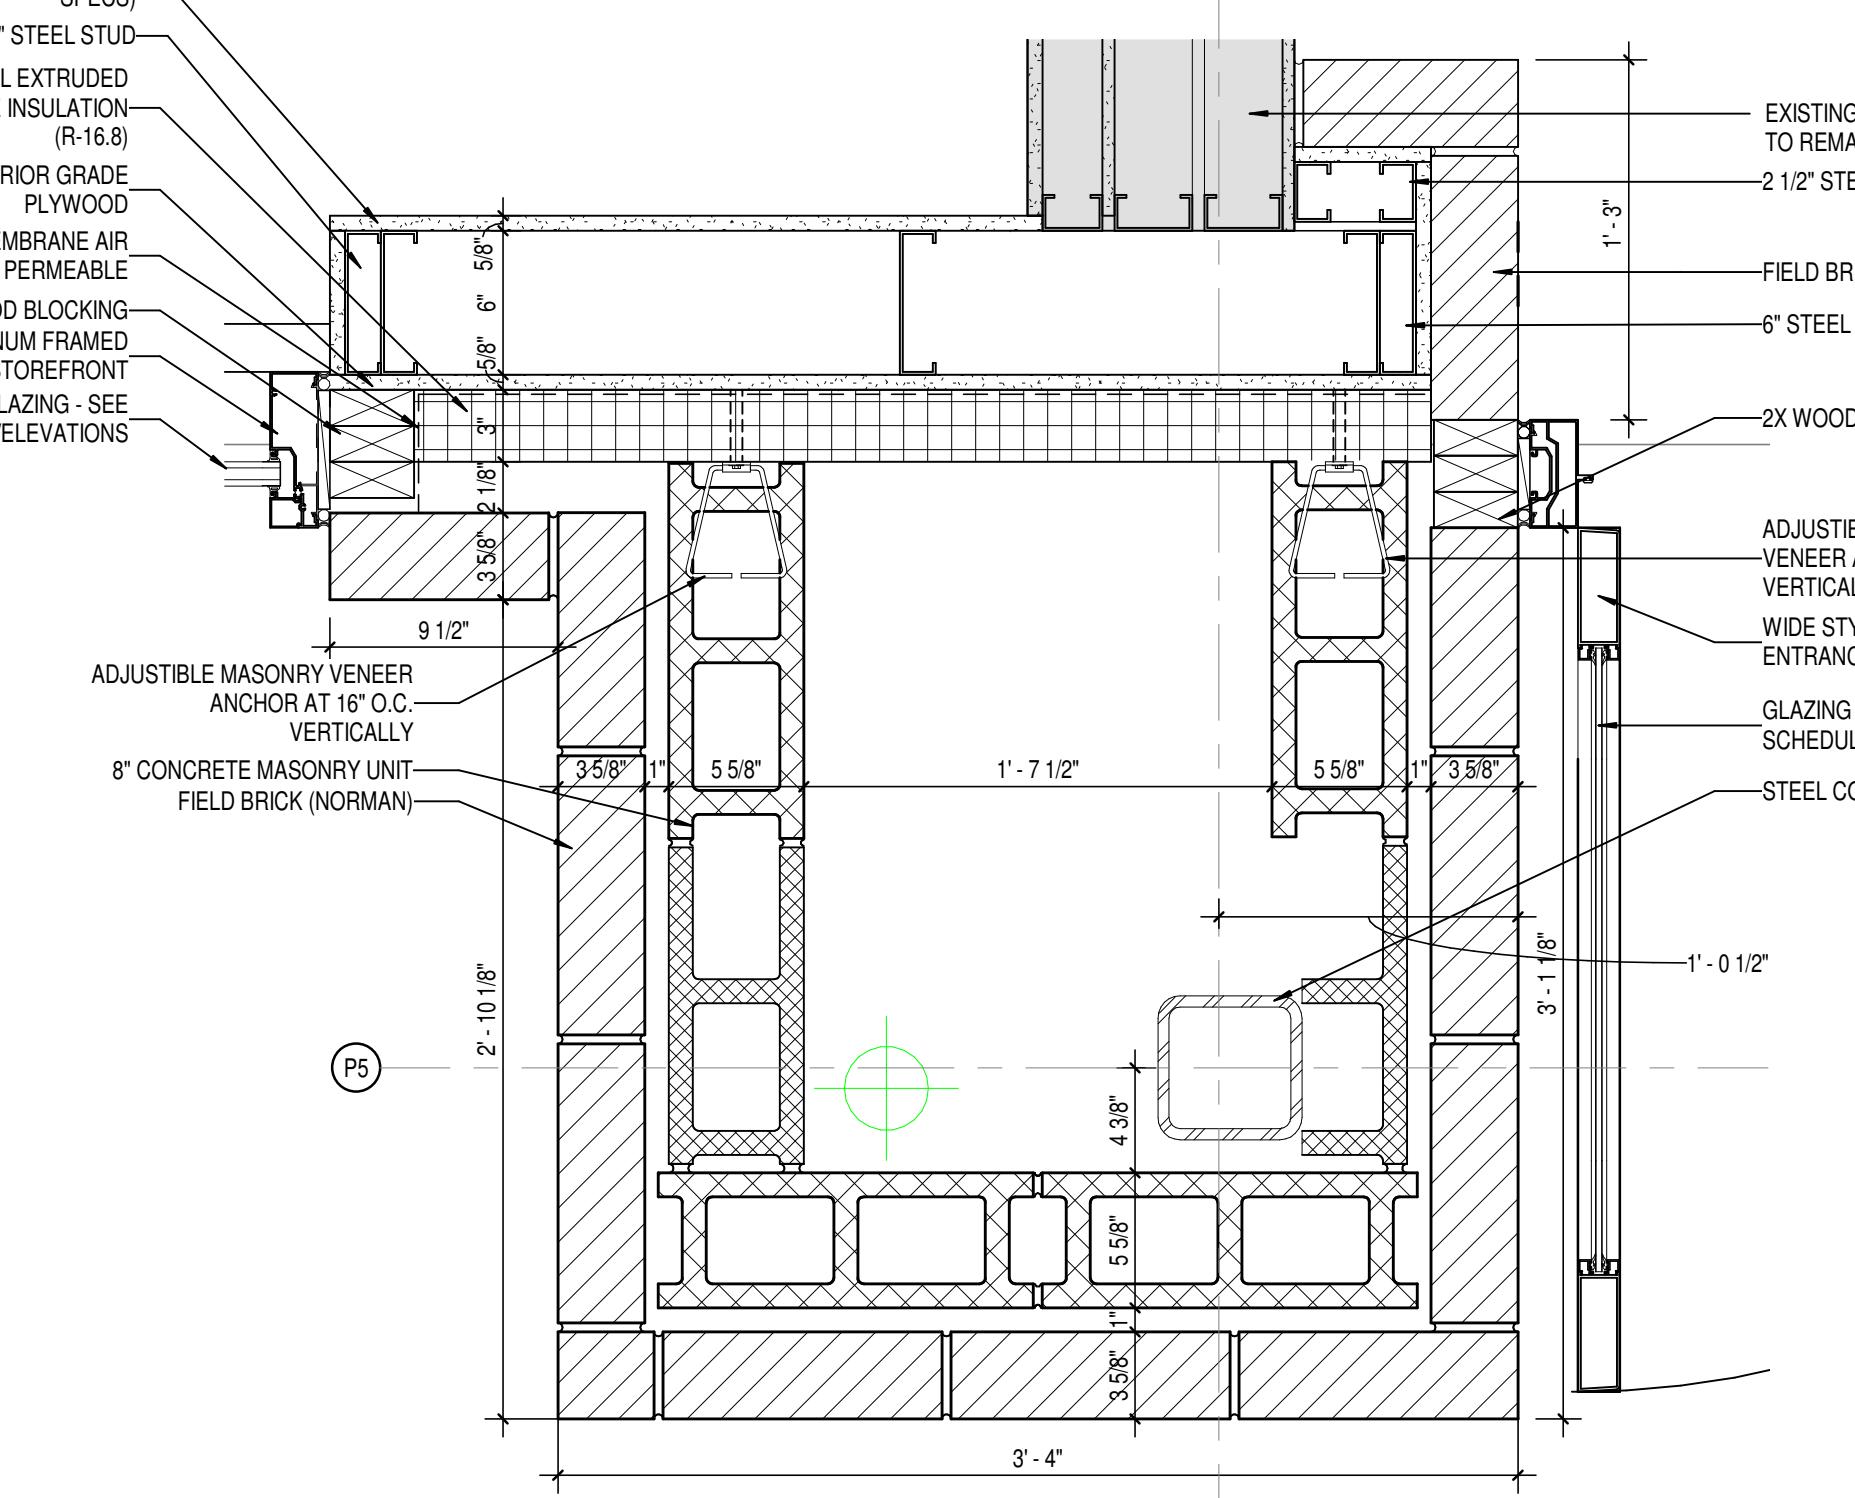


2 CANOPY COLUMN DETAIL  
A431 SCALE: 1 1/2" = 1'-0"

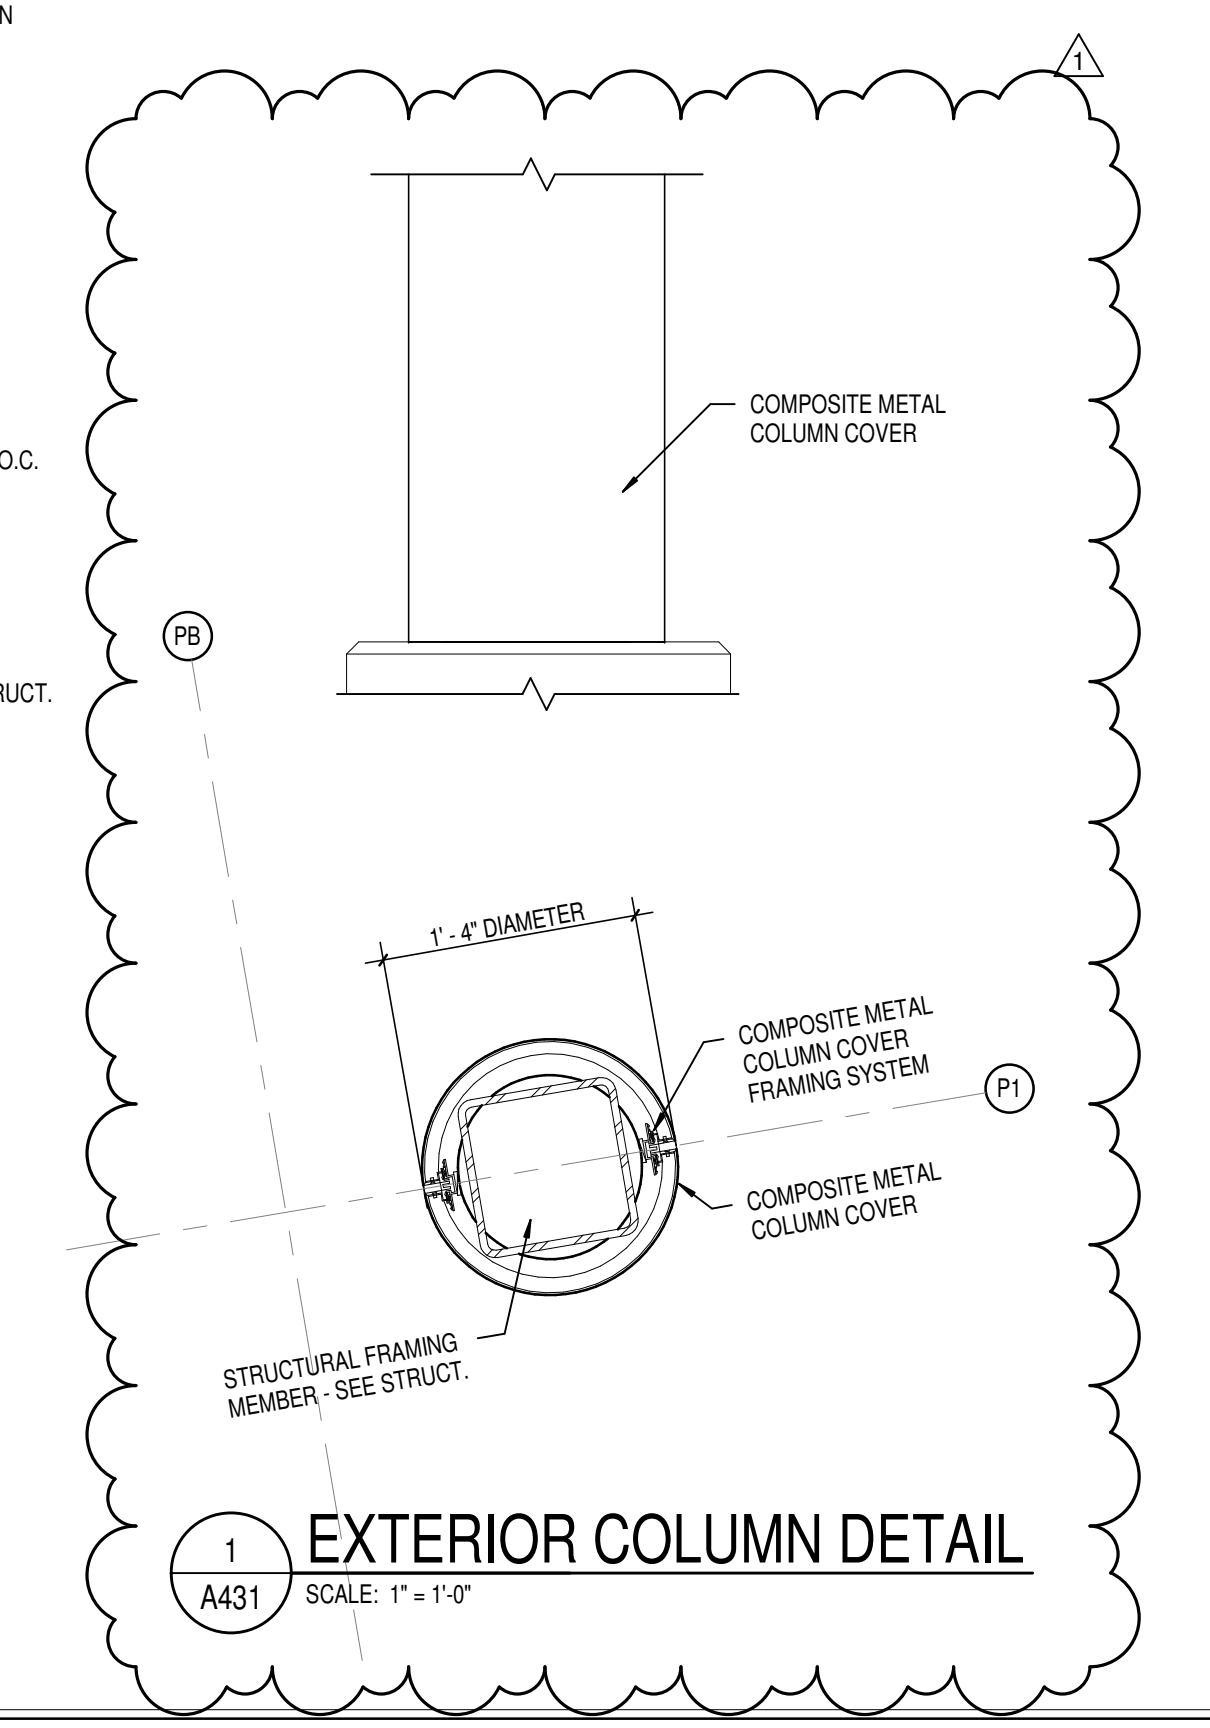


1 EXTERIOR COLUMN DETAIL  
A431 SCALE: 1" = 1'-0"

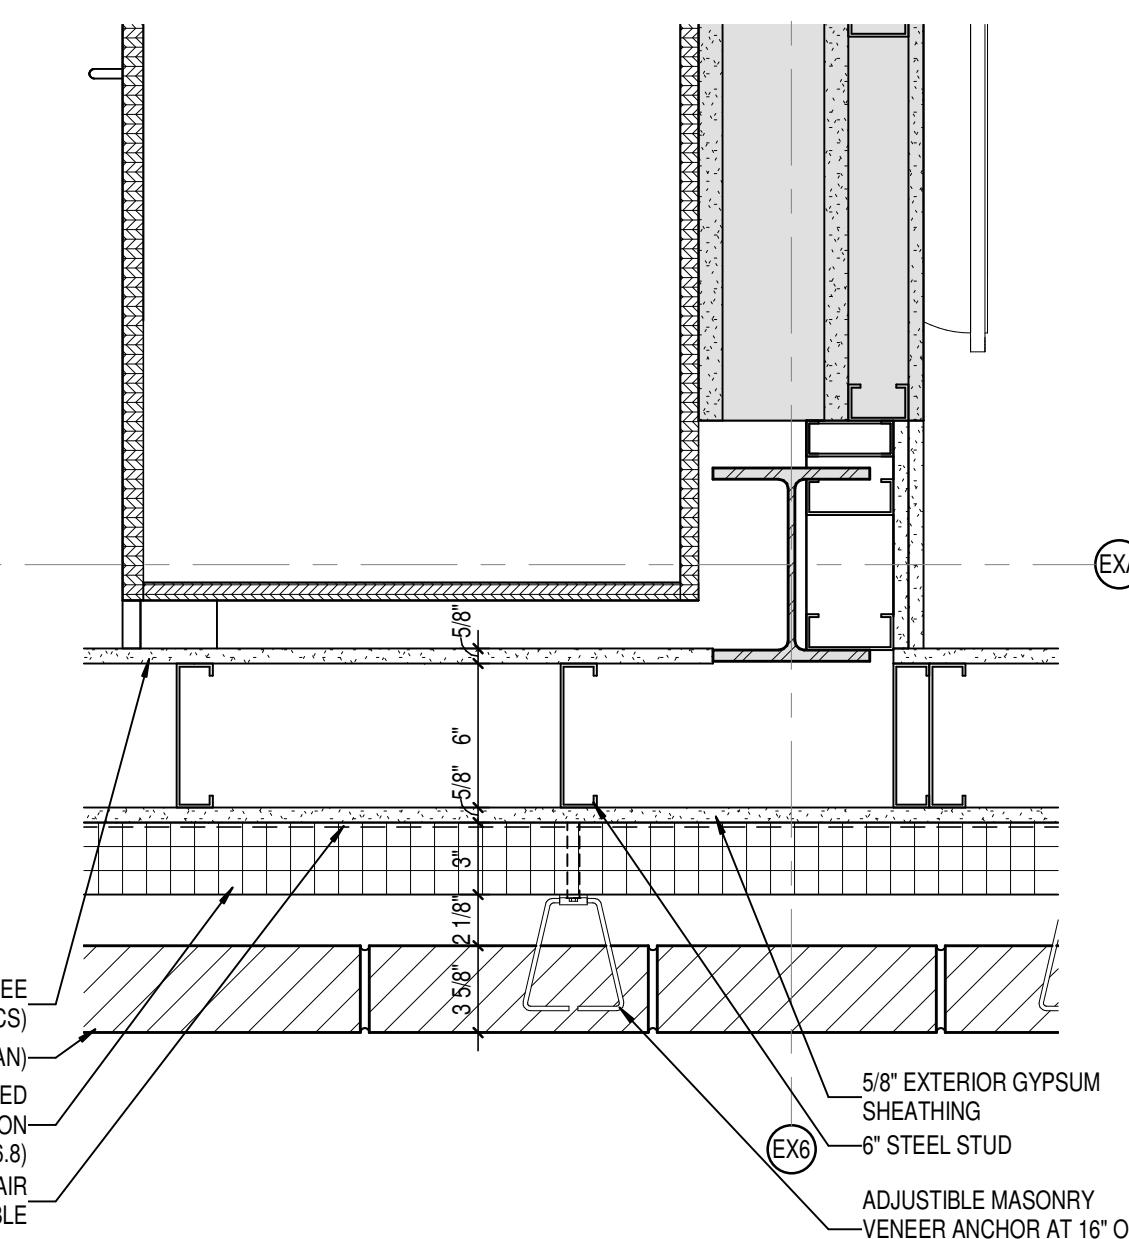

10 PLAN DETAIL  
A431 SCALE: 1 1/2" = 1'-0"

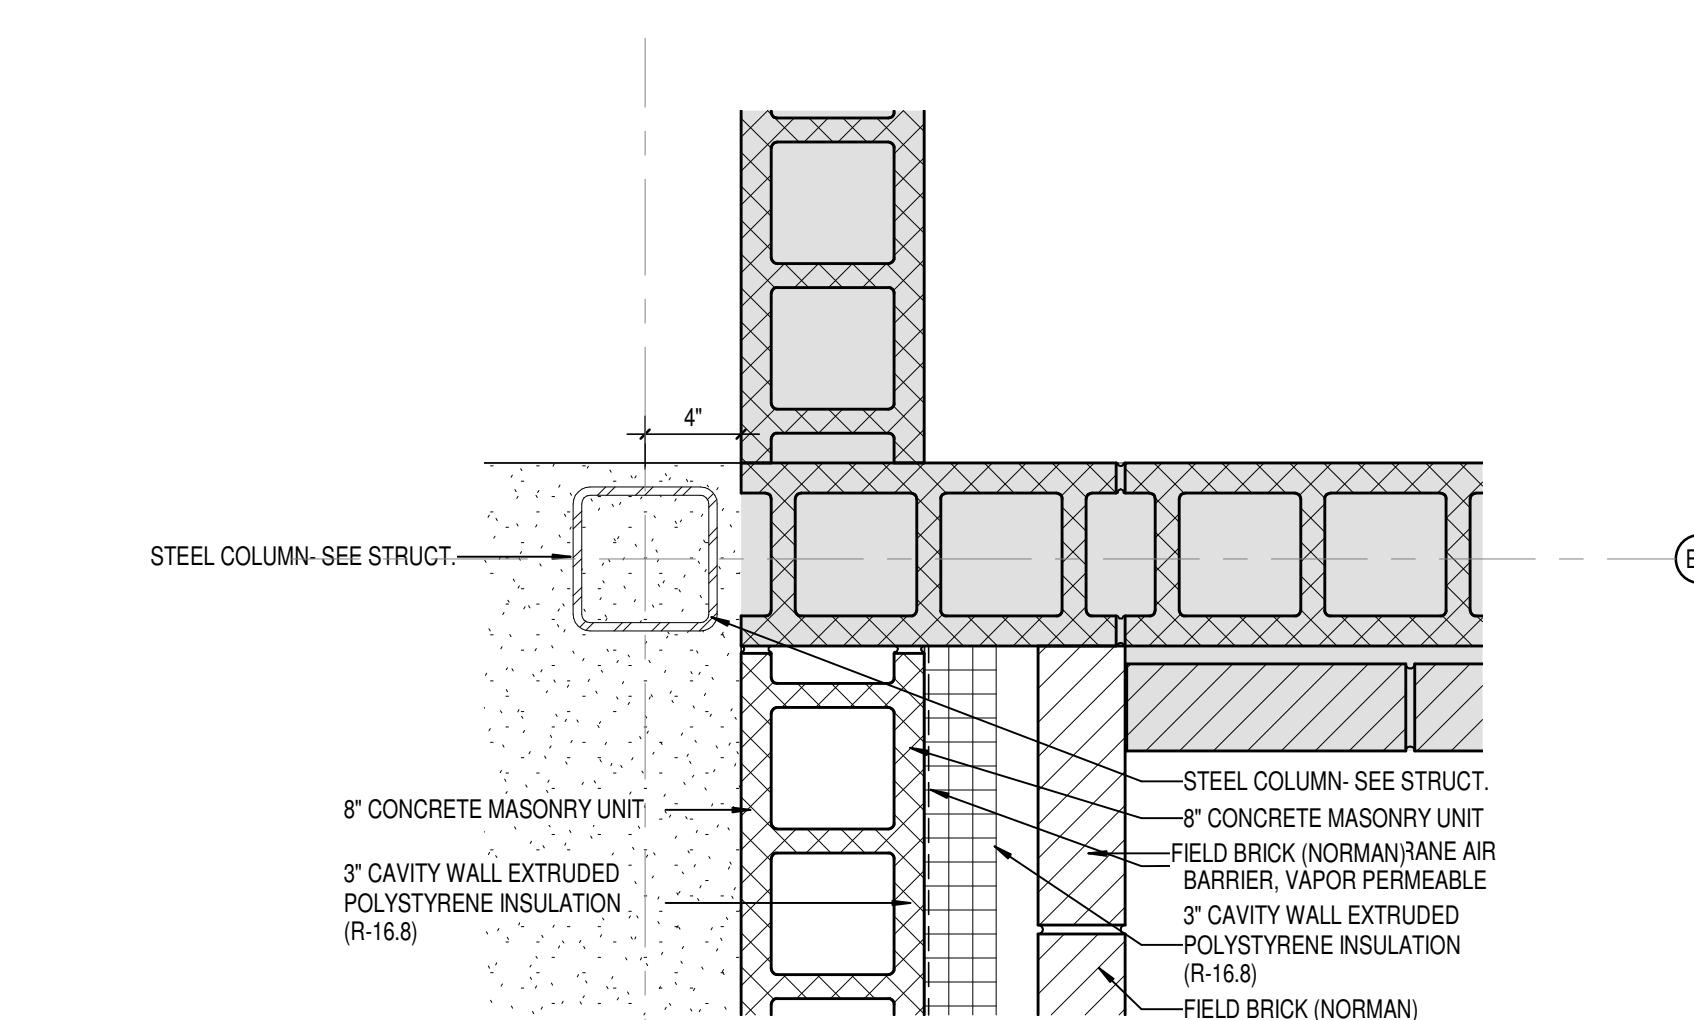

5 PLAN DETAIL  
A431 SCALE: 1 1/2" = 1'-0"

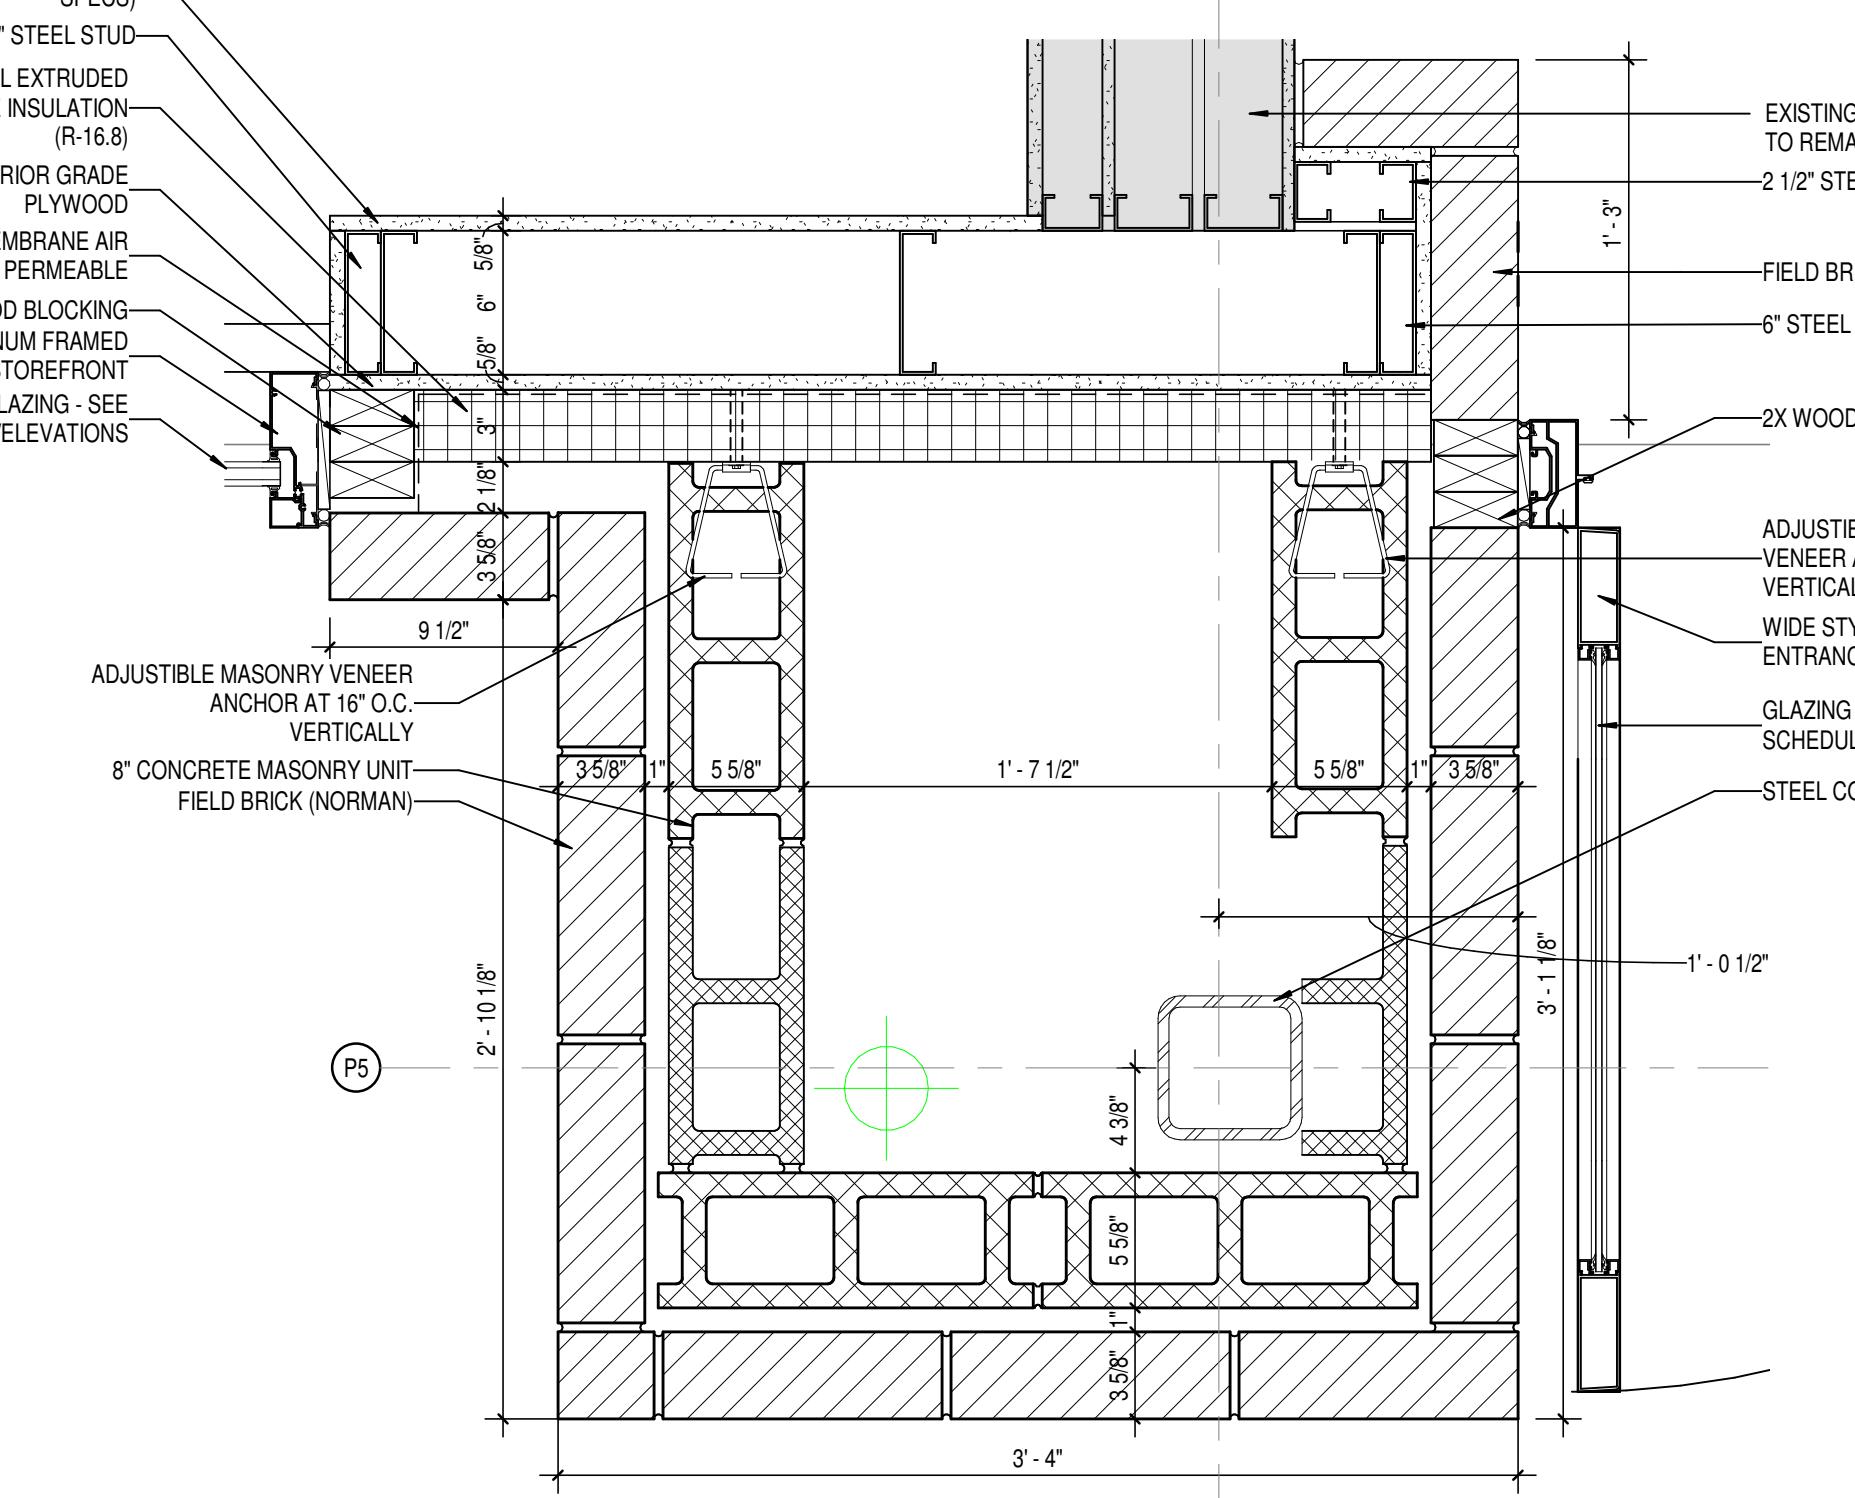

2 CANOPY COLUMN DETAIL  
A431 SCALE: 1 1/2" = 1'-0"



○  
S  
C  
S

8831 Keystone Crossing, Indianapolis, IN 46240  
317.848.7800 | [csoinc.net](http://csoinc.net)



MSD OF WARREN TOWNSHIP

**WARREN CENTRAL HIGH SCHOOL**  
**PHASE 3 ADDITION & RENOVATION**

9500 E. 16th STREET, INDIANAPOLIS, IN 46229

**SCOPE DRAWINGS:**  
These drawings indicate the general scope of the project in terms of architectural design concept, the dimensions of the building, the major architectural elements and the type of structural, mechanical and electrical systems. The drawings do not necessarily indicate or describe all requirements required for full performance and completion of the requirements of the Contract. On the basis of the general scope indicated or described, trade contractors shall furnish all items required for the proper execution and completion of the work.

---


## REVISIONS:

DATE DRAWN BY CHECKED BY  
21-2023 Author Checker


DRAWING TITLE:  
**ENLARGED  
PLAN DETAILS**

DRAWING NUMBER  
**A432**

PROJECT NUMBER  
**2021056**

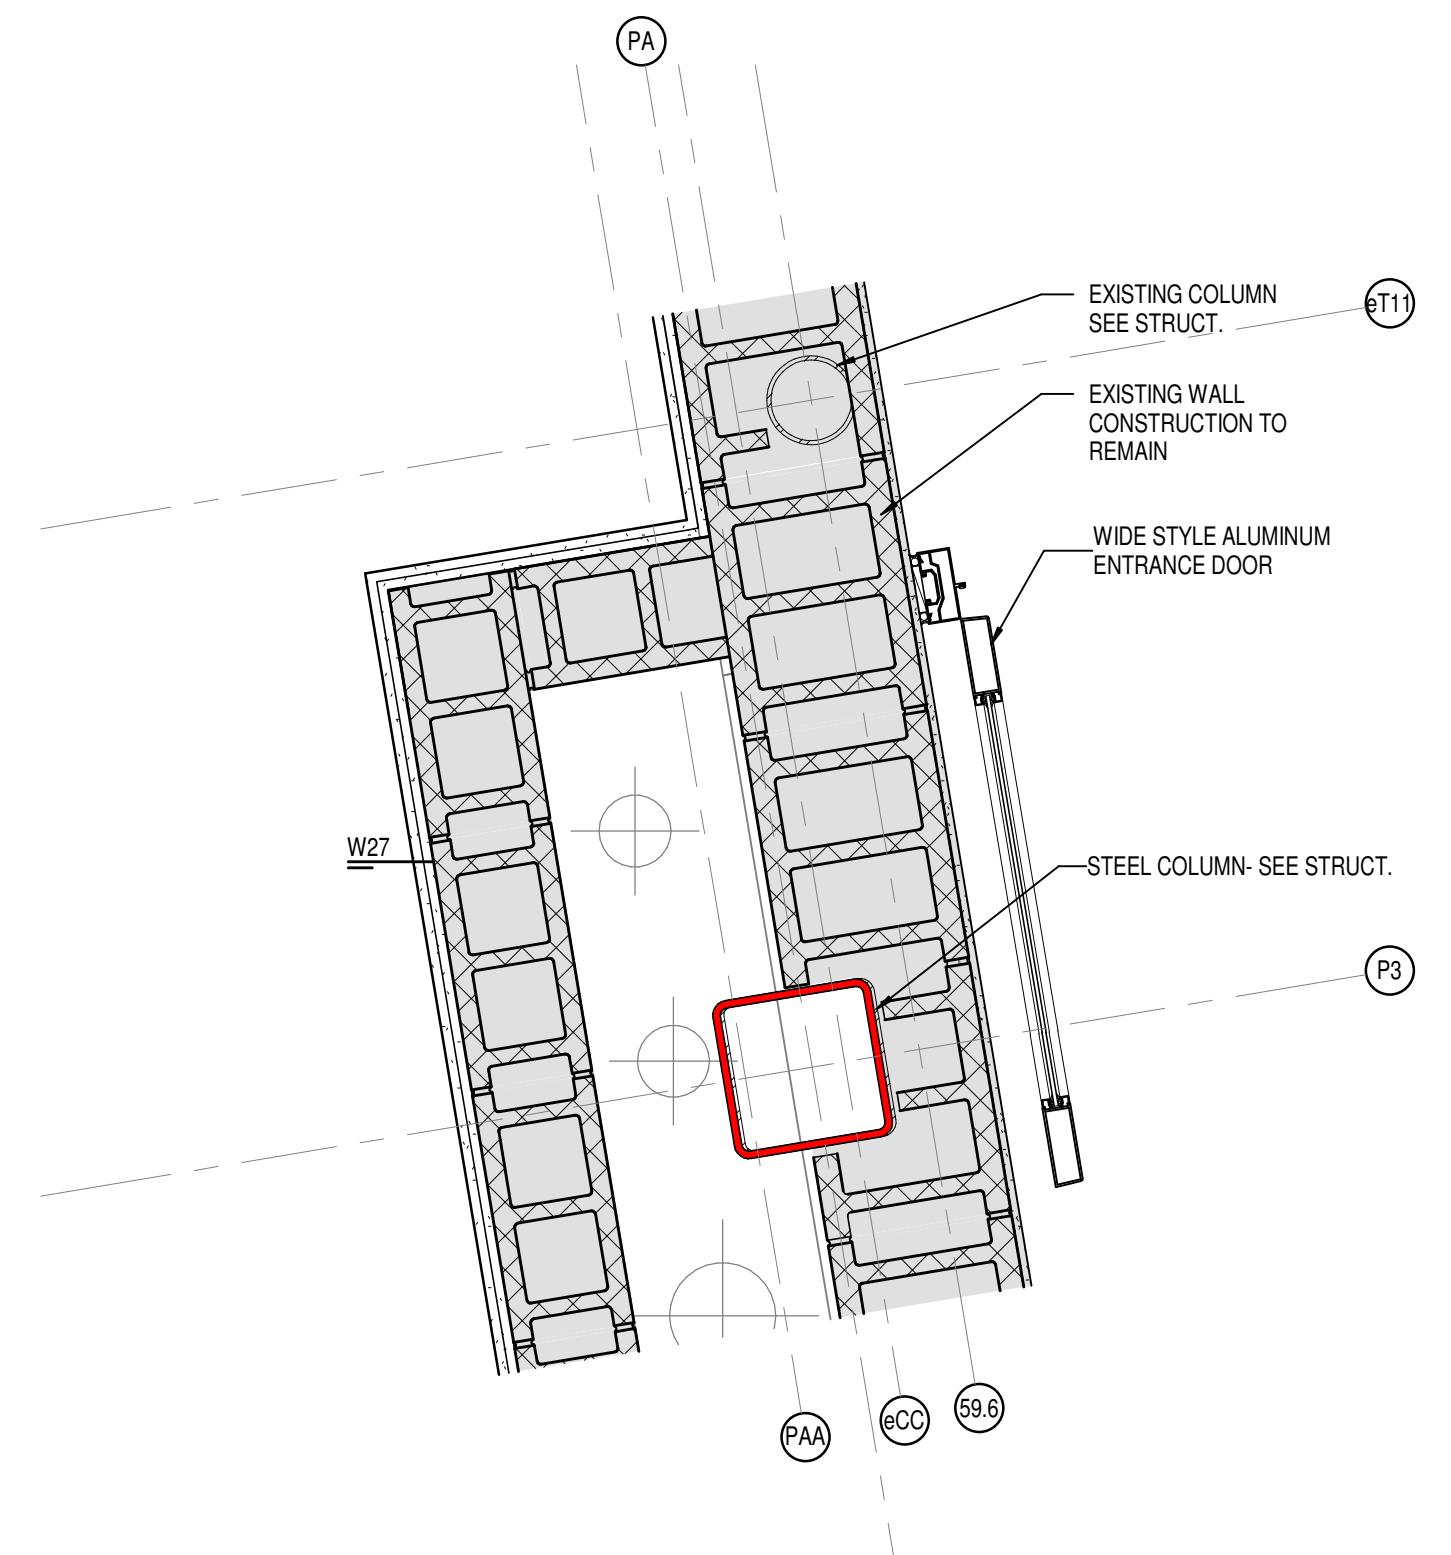


1 ALTERNATE # 1 - PLAN DETAIL

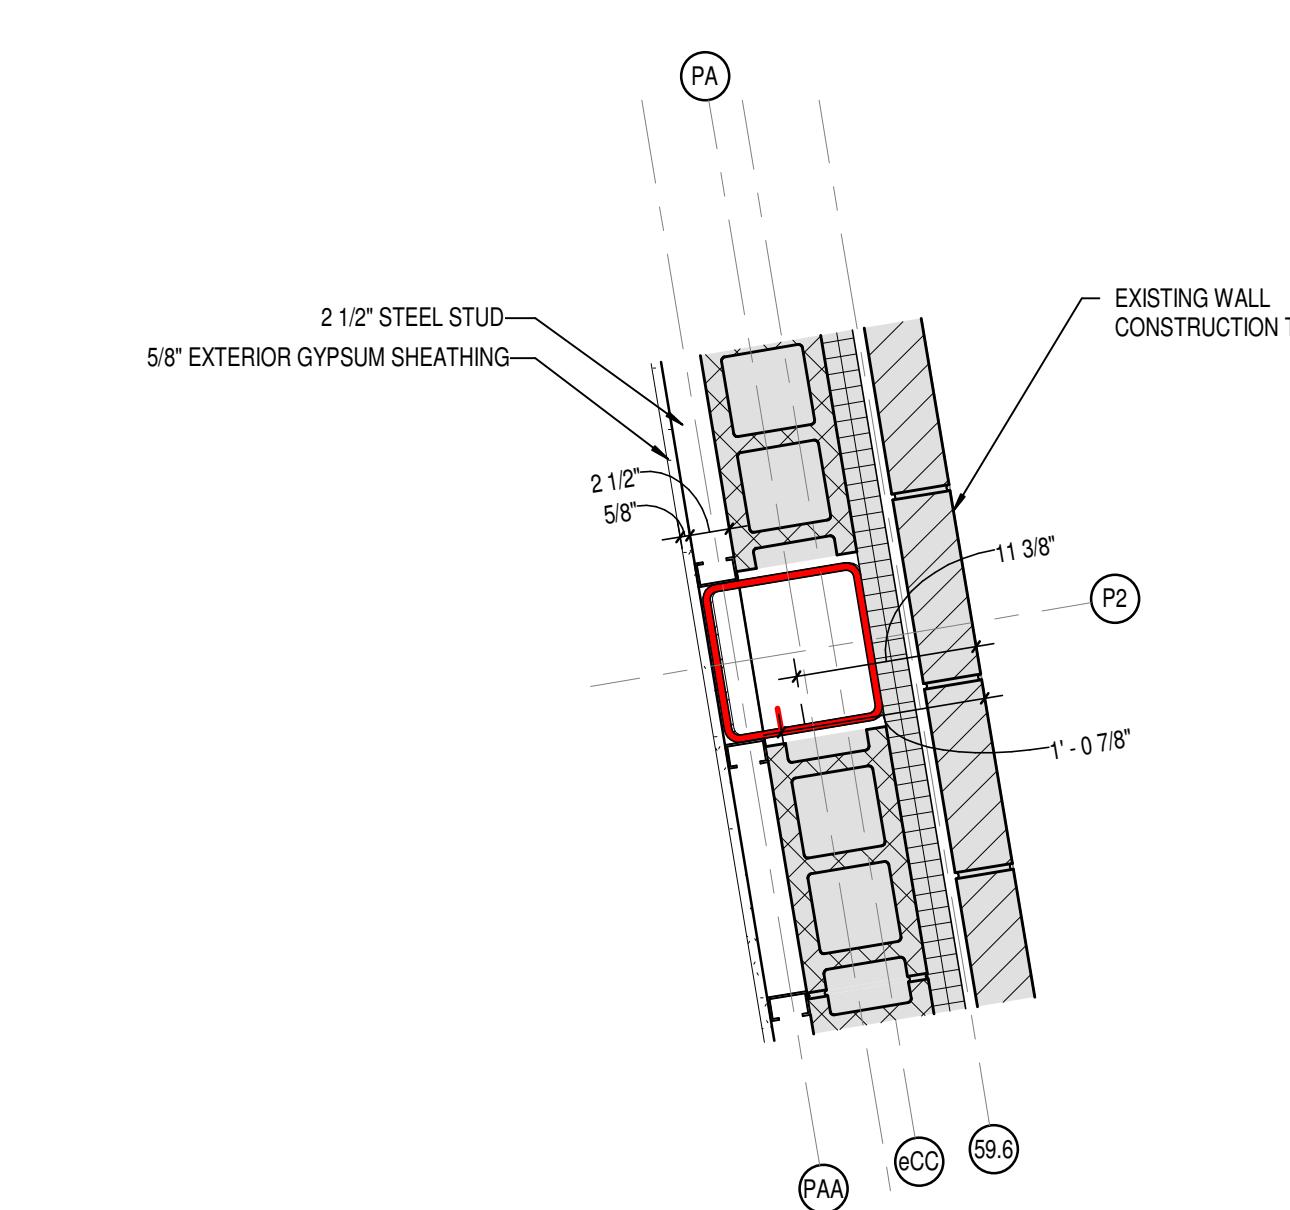


7 ALTERNATE # 1 - PLAN DETAIL

---

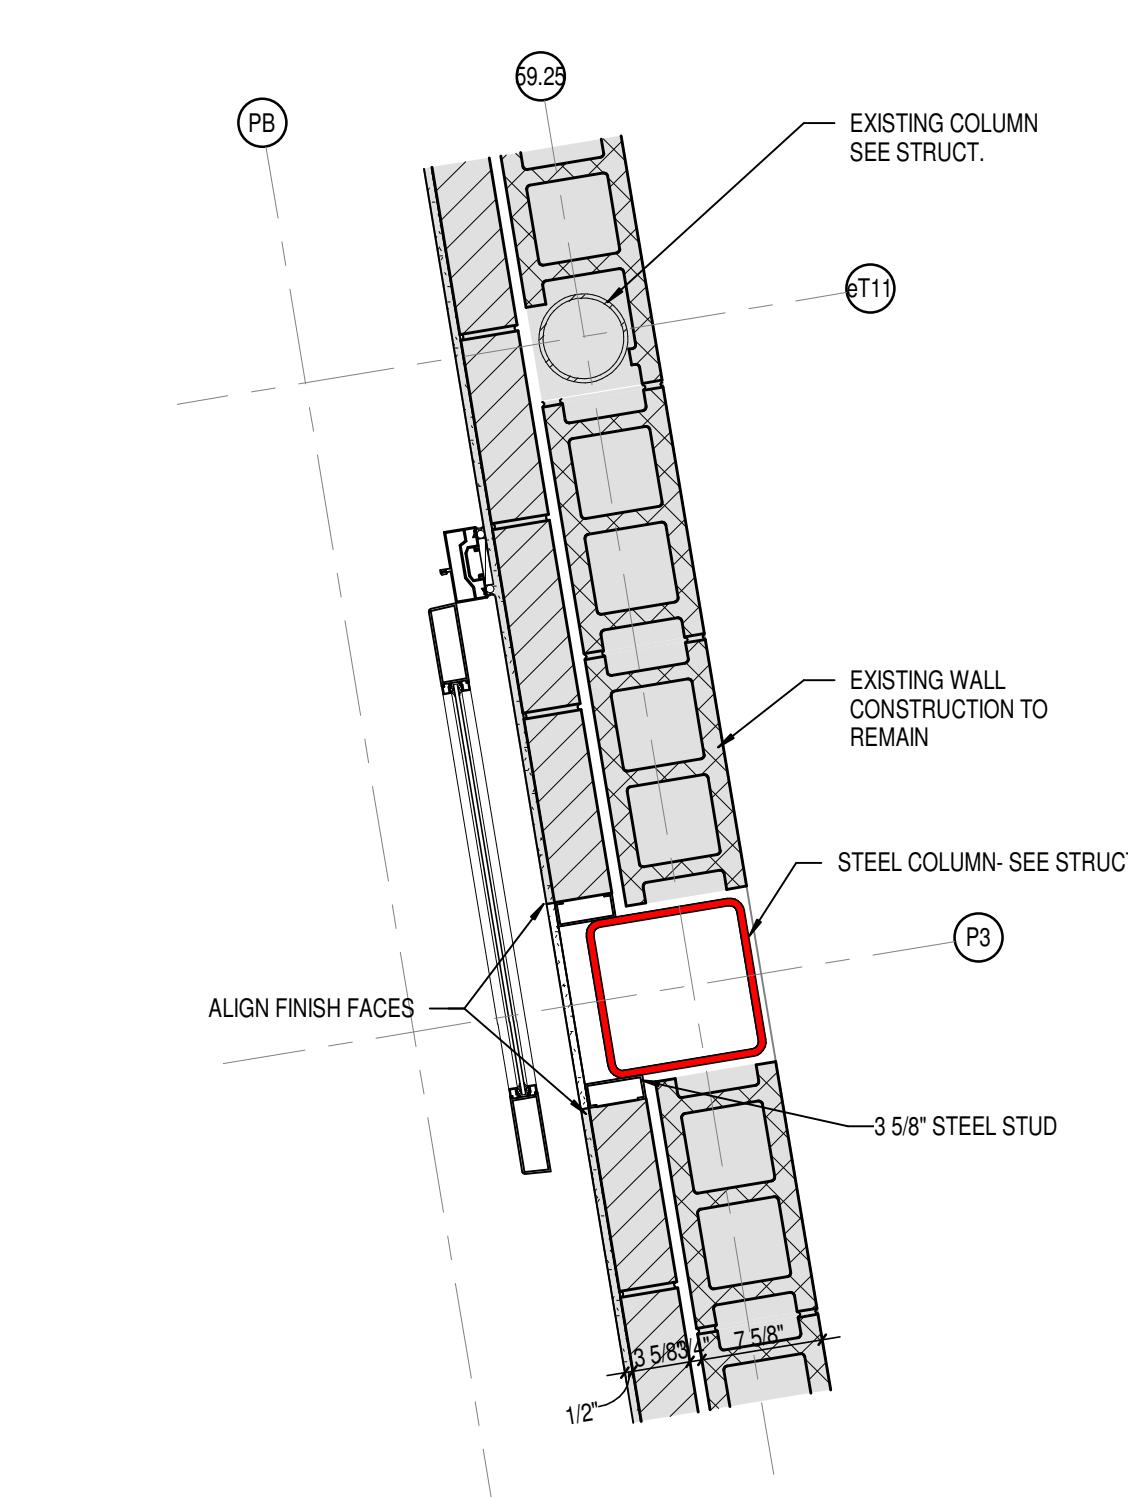


# 8 ALTERNATE # 1 - PLAN DETAIL

A432 SCALE: 1" = 1'-0"

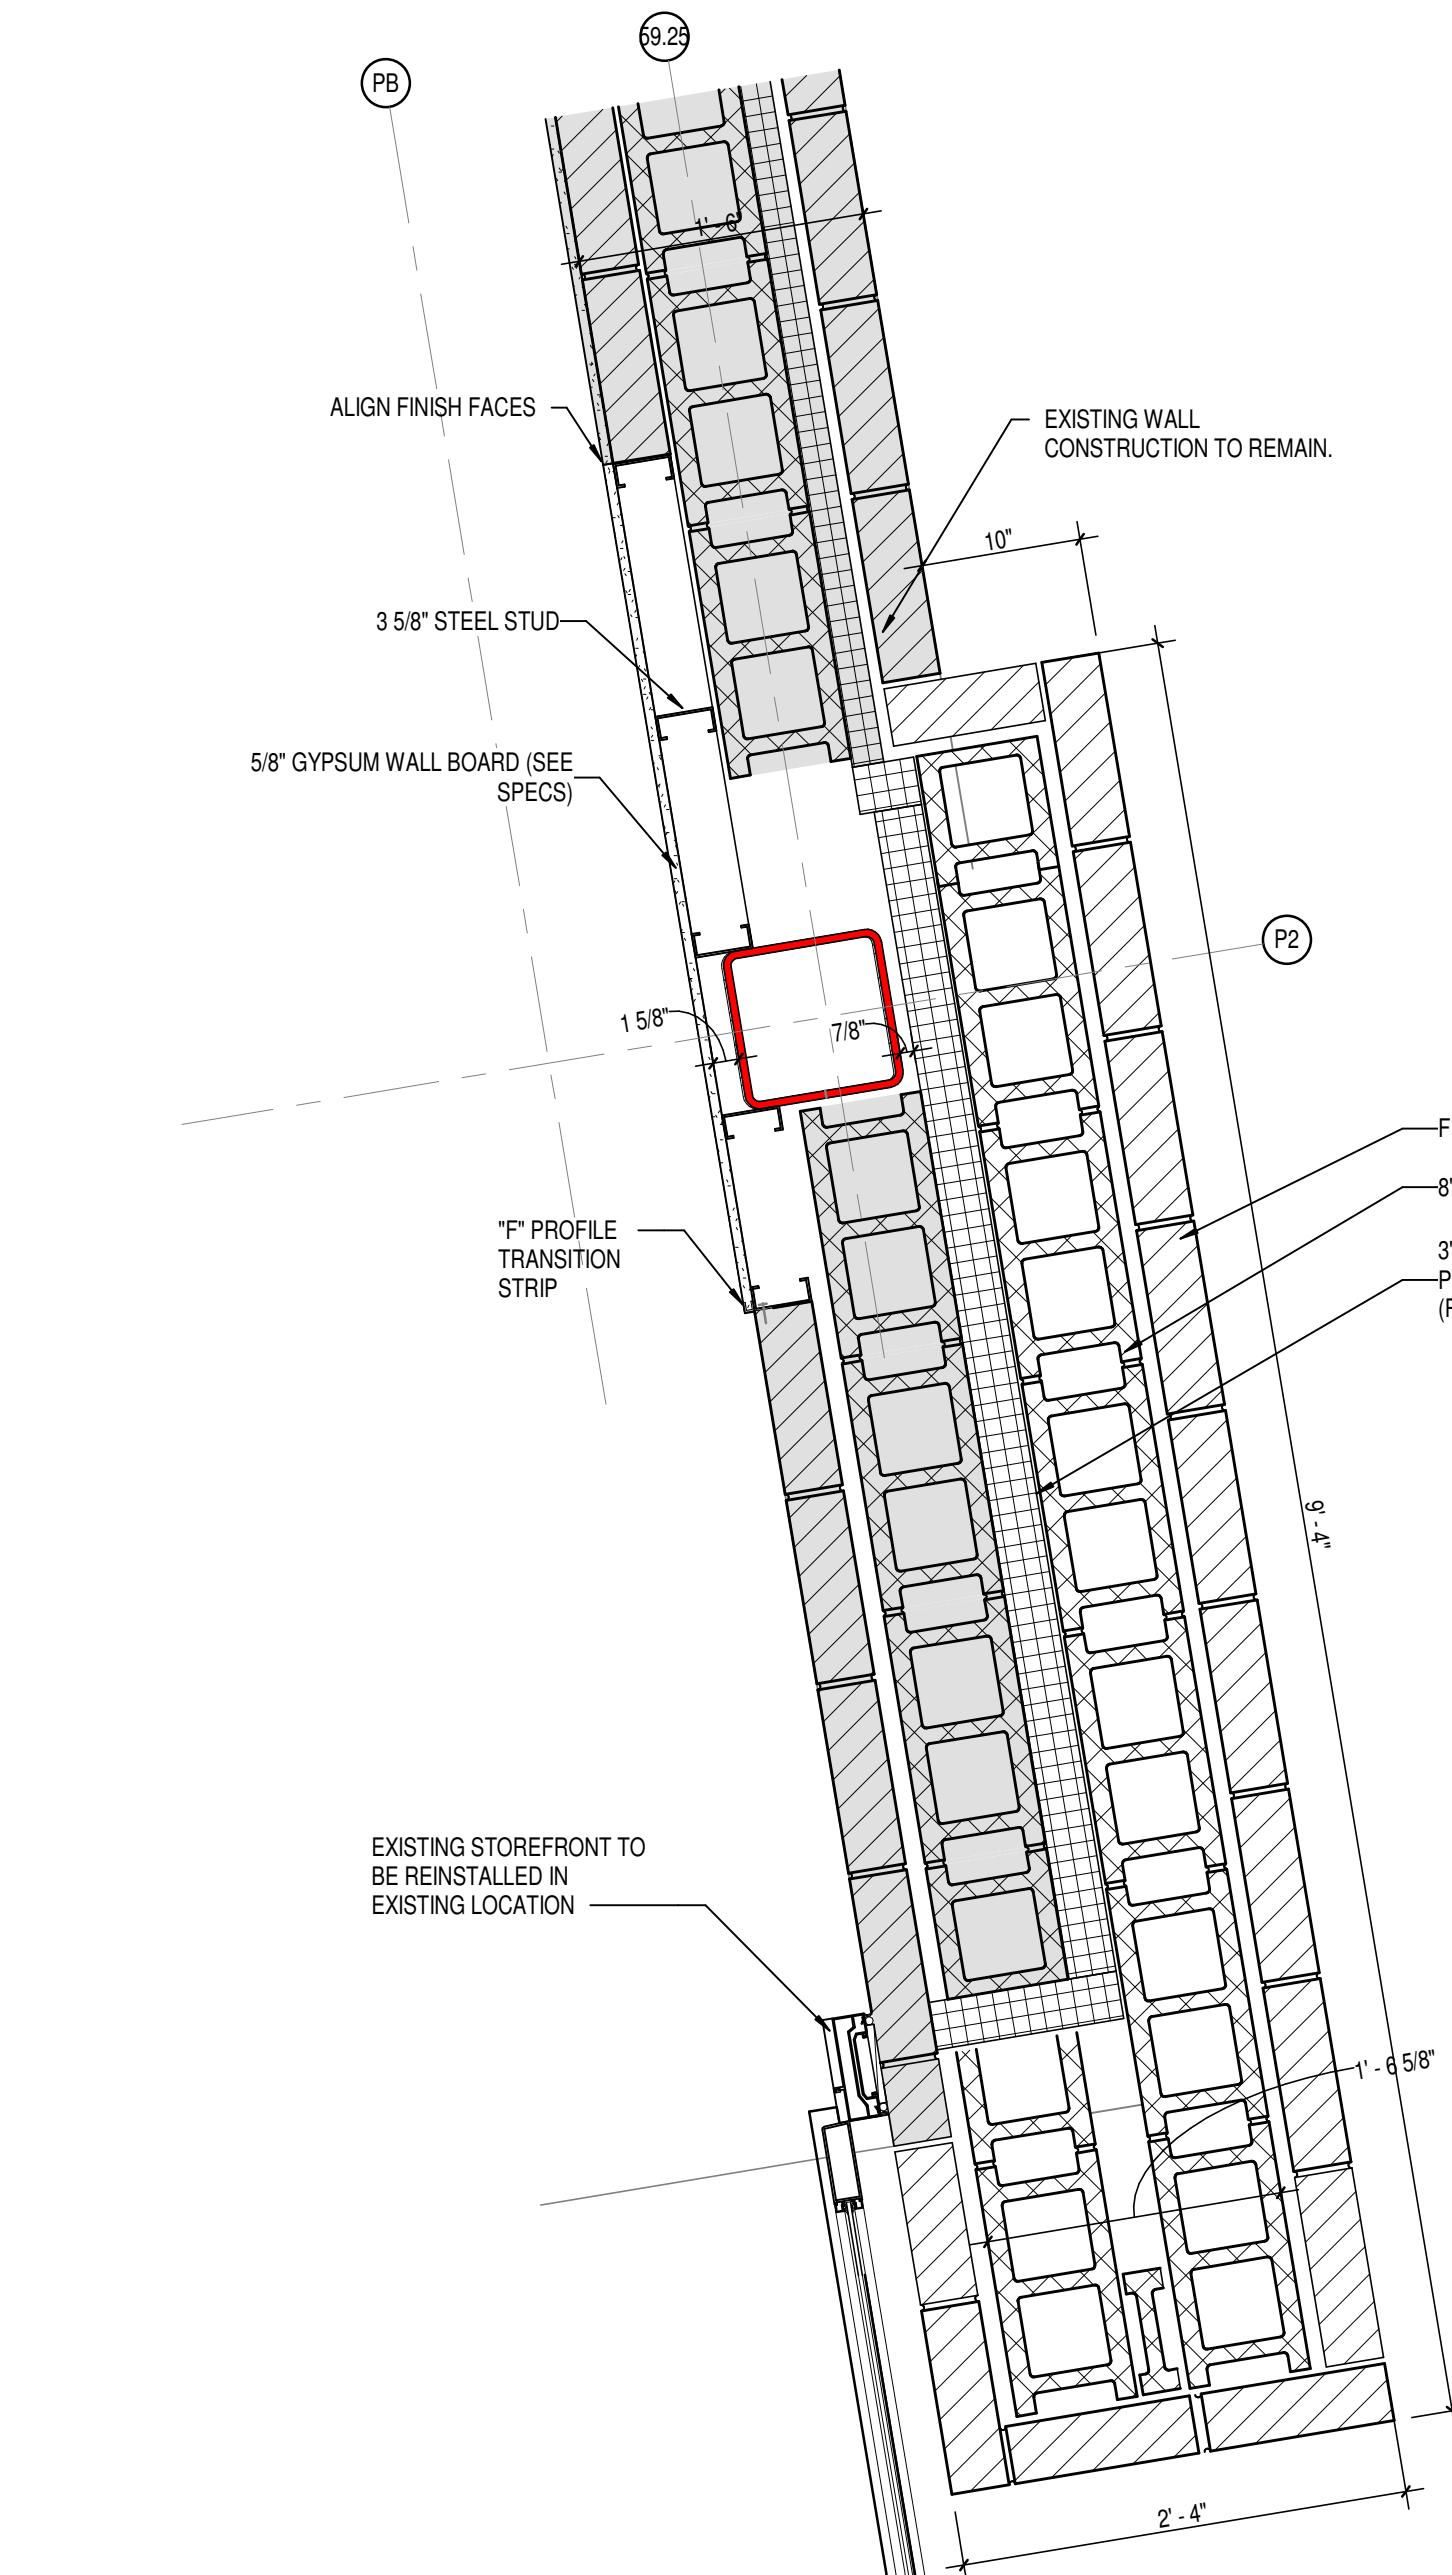


# ALTERNATE # 1 - PLAN DETAIL

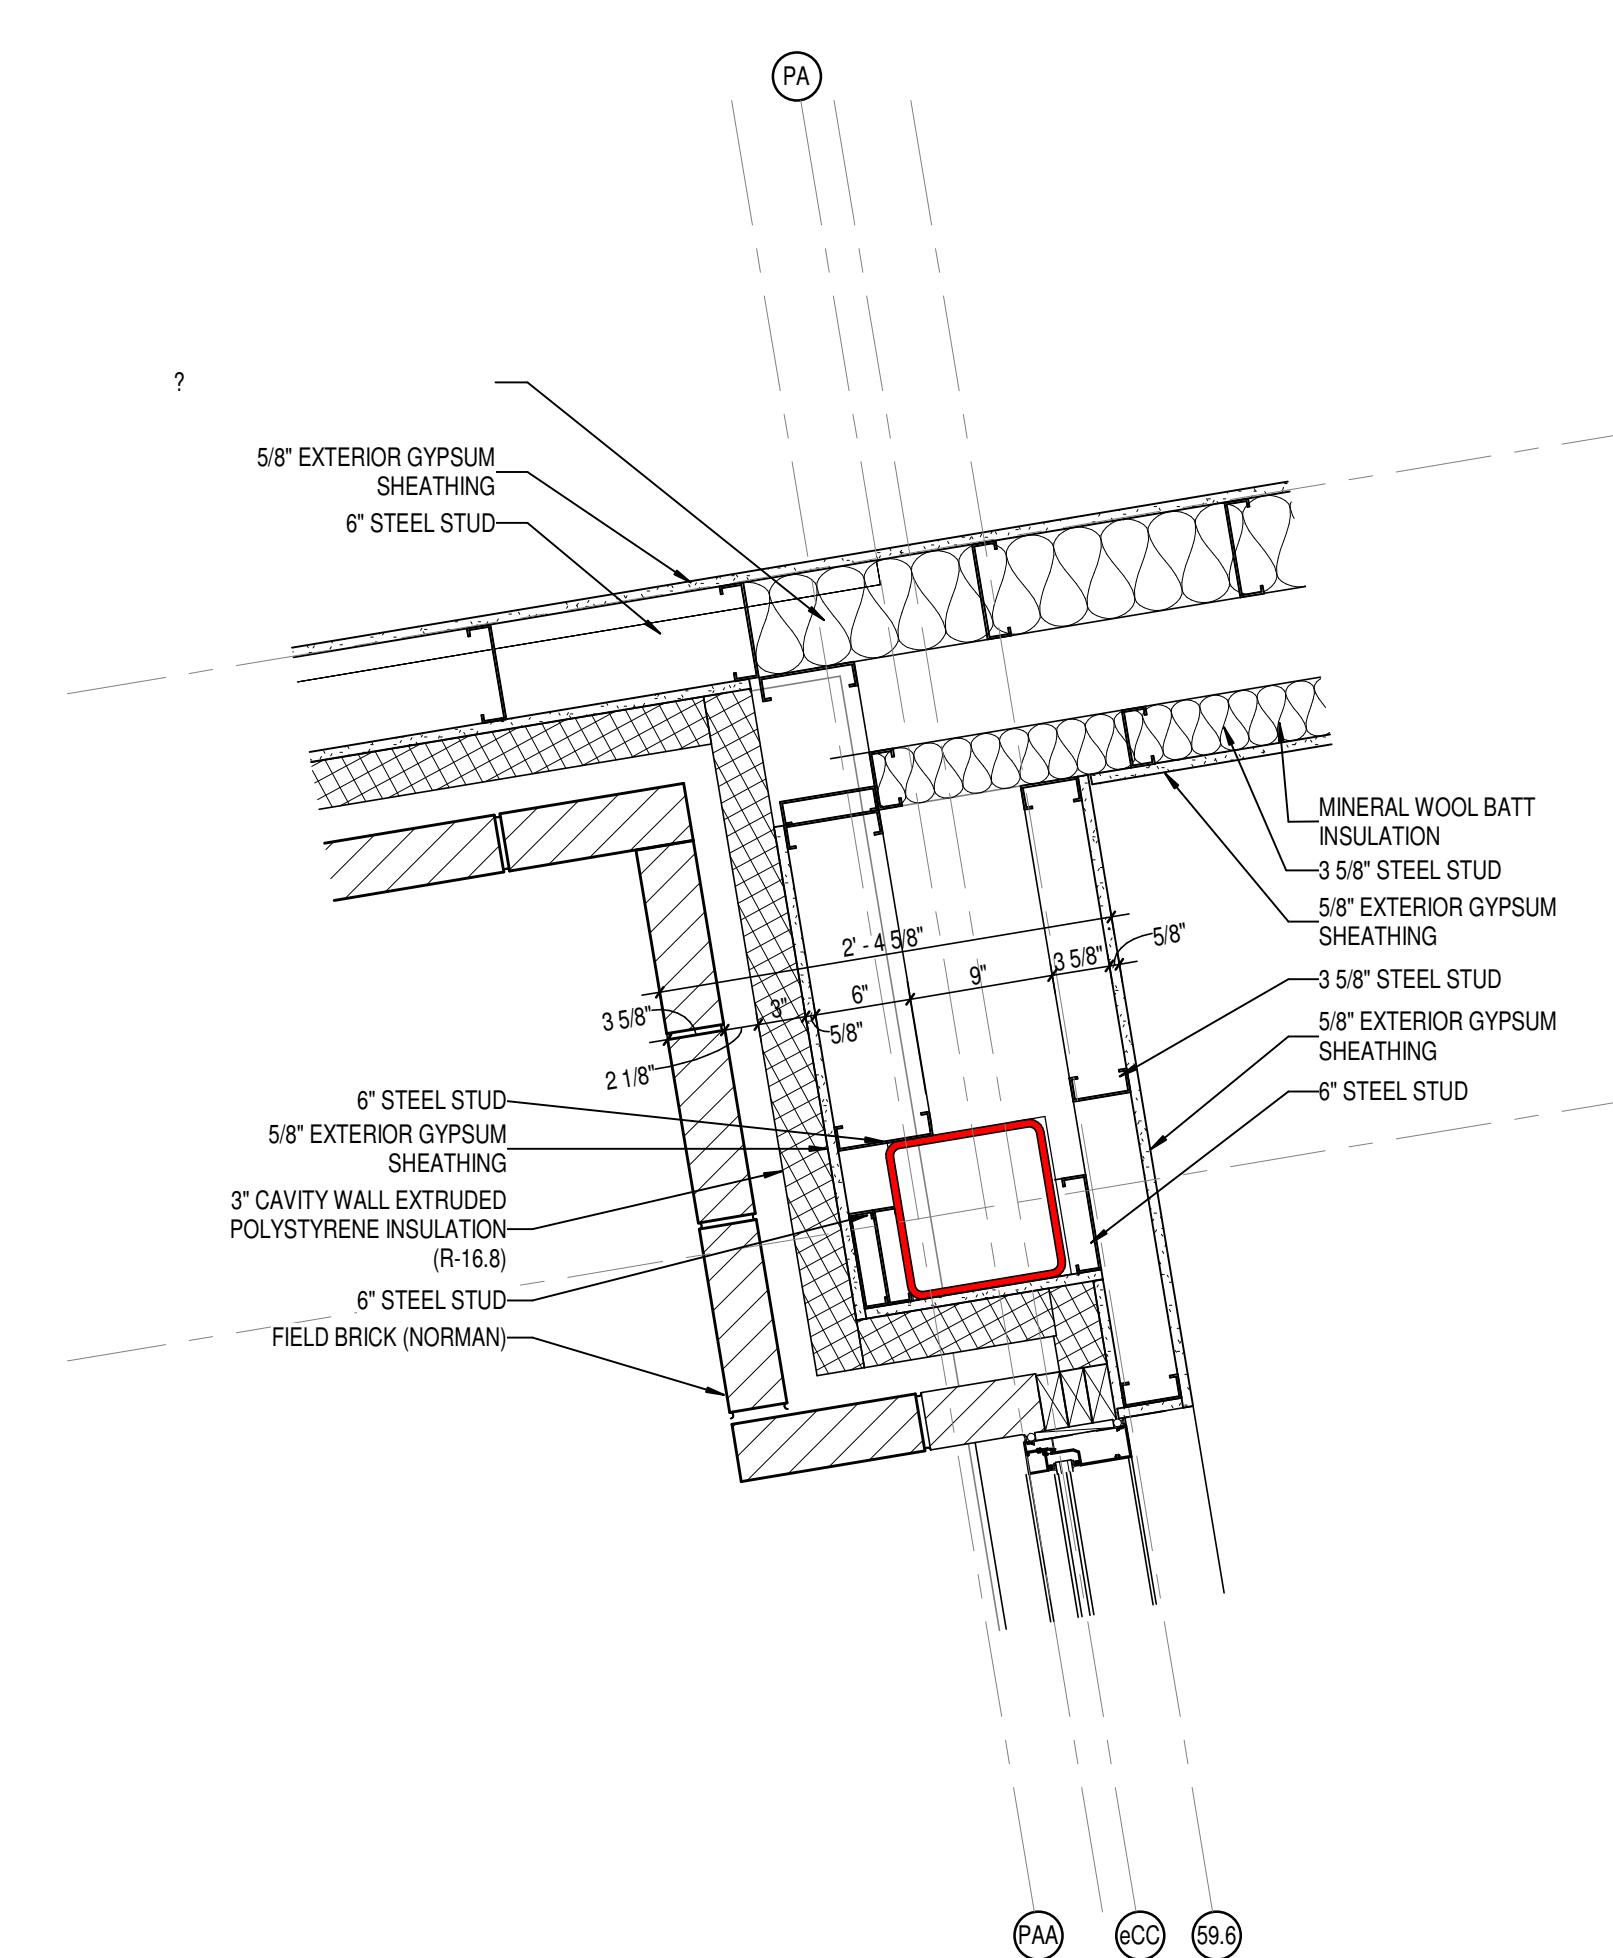


# 5 ALTERNATE # 1 - PLAN DETAIL

A432 SCALE: 1" = 1'-0"

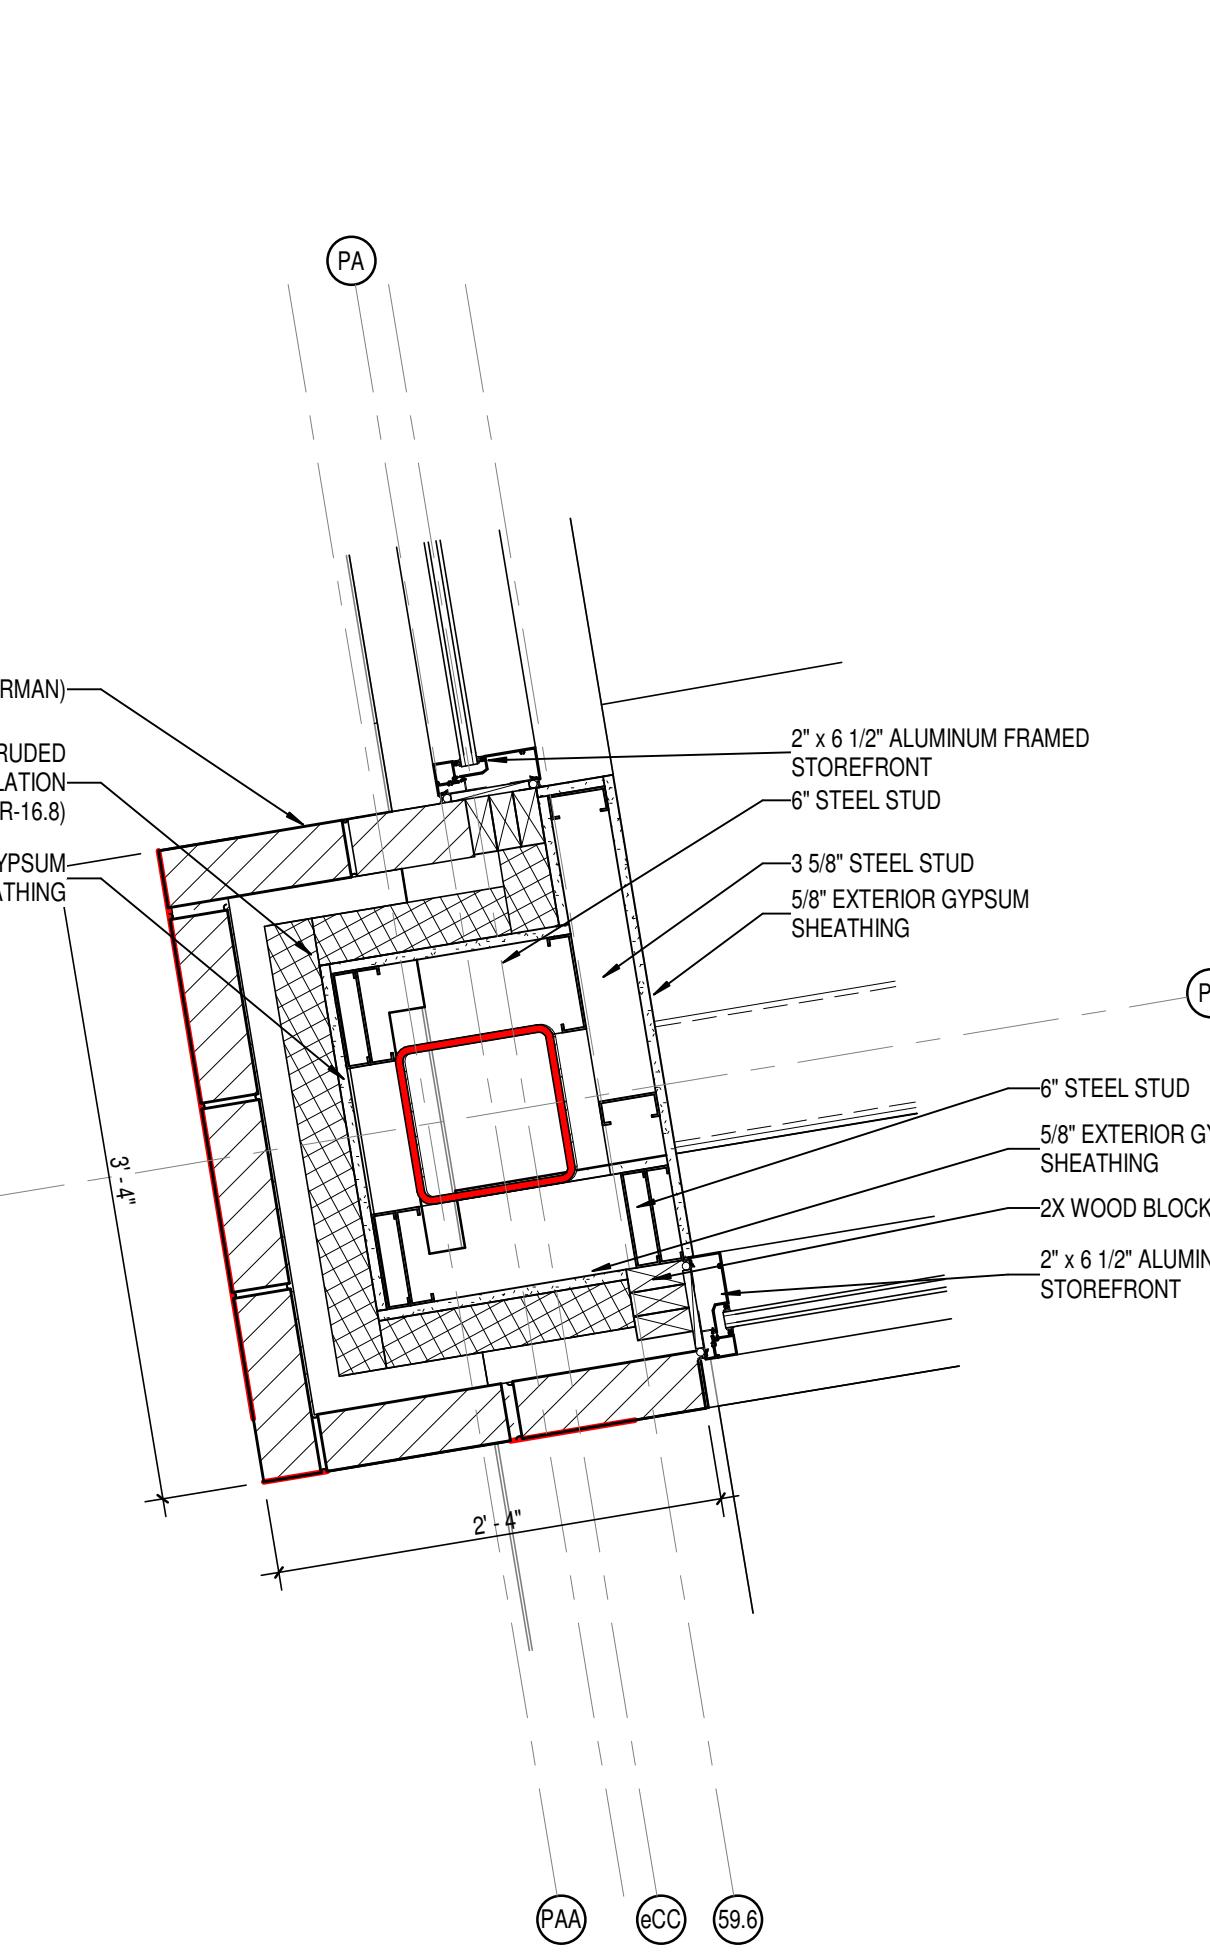


4 ALTERNATE # 1 - PLAN DETAIL

---

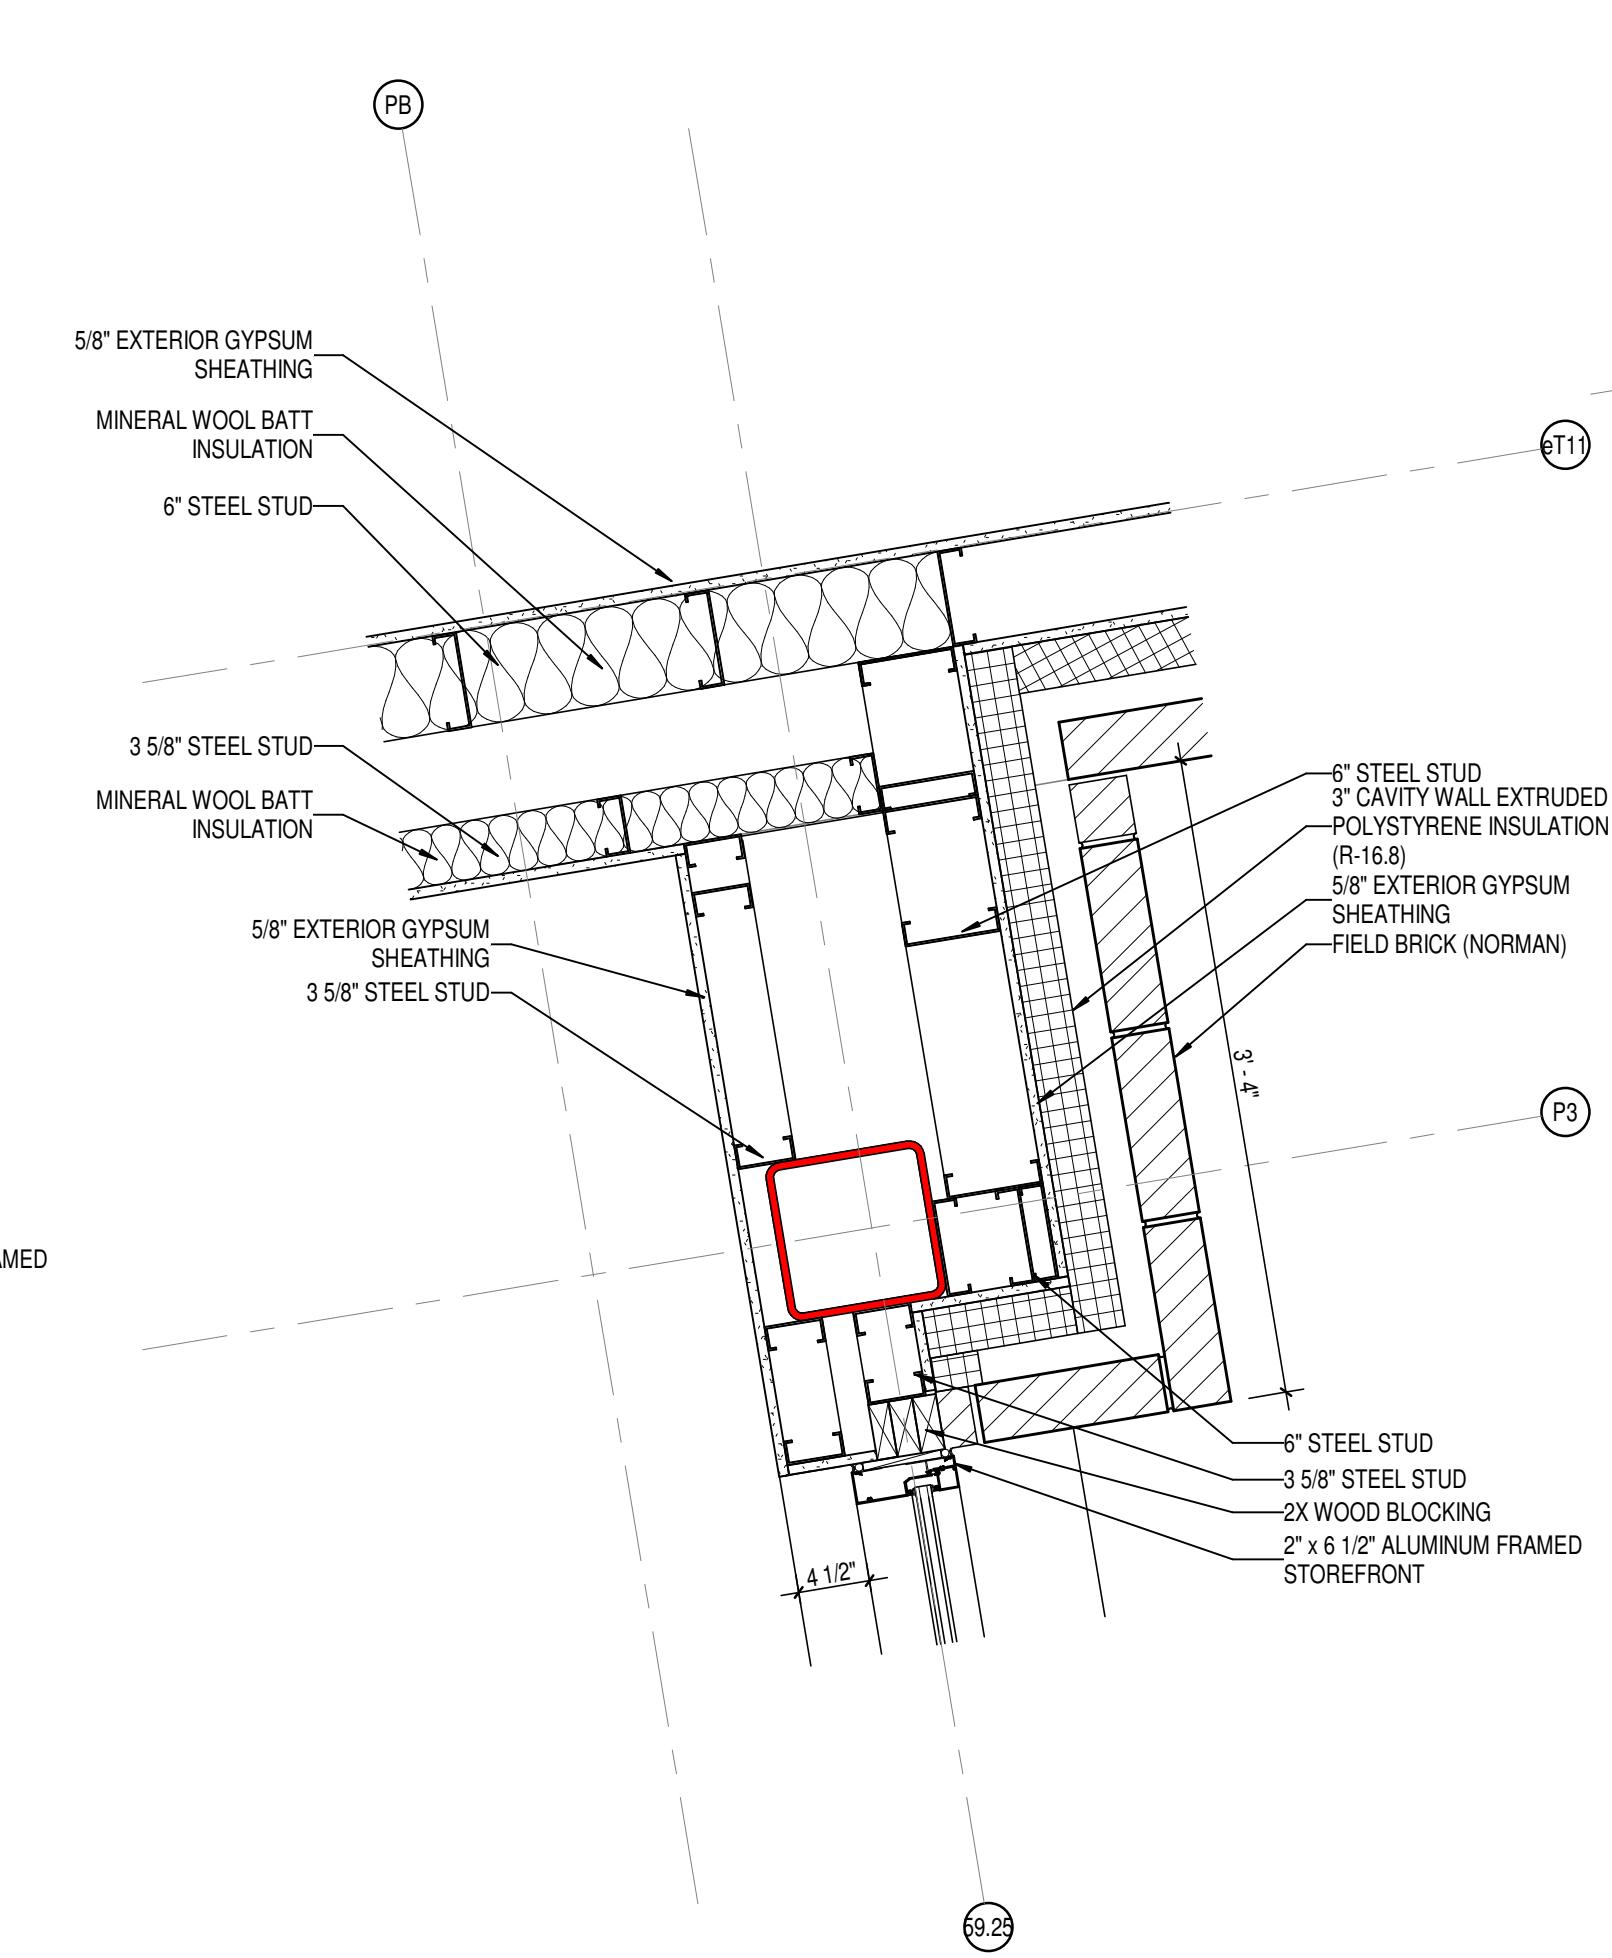

# 3 ALTERNATE # 1 - PLAN DETAIL

A432 SCALE: 1" = 1'-0"

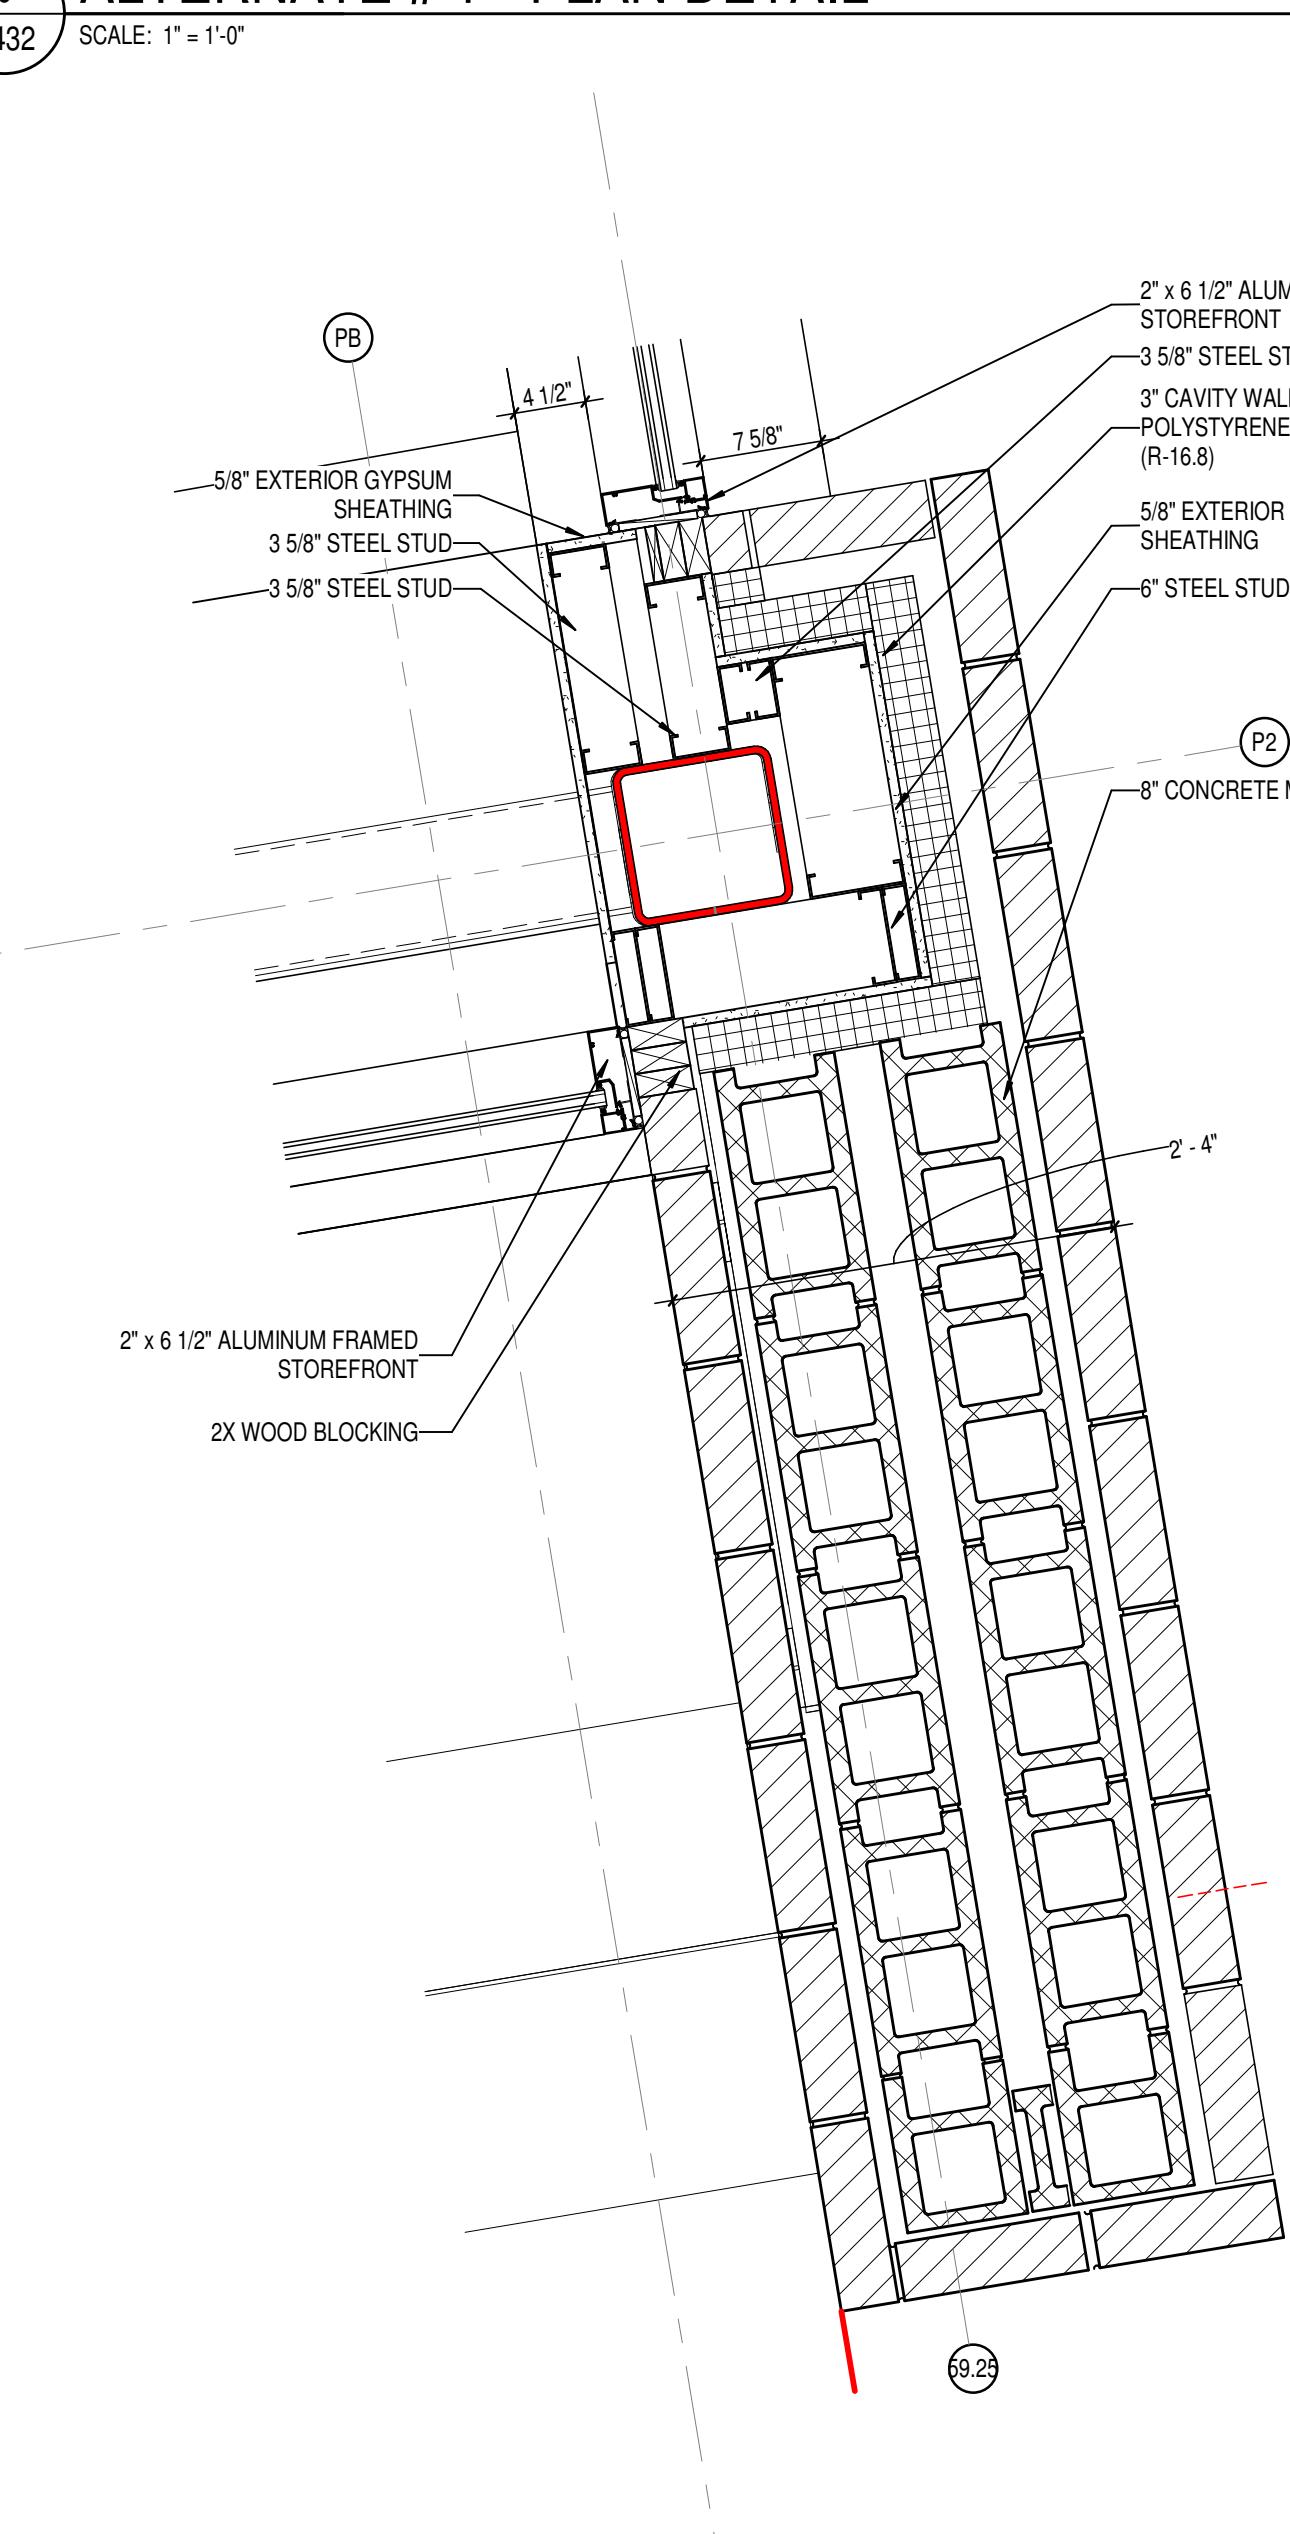

# ALTERNATE # 1 - PLAN DETAIL






**SCCSO**


8831 Keystone Crossing, Indianapolis, IN 46240

317.648.7800 | cso.net


© 2020 CCSO Architects, Inc. All Rights Reserved

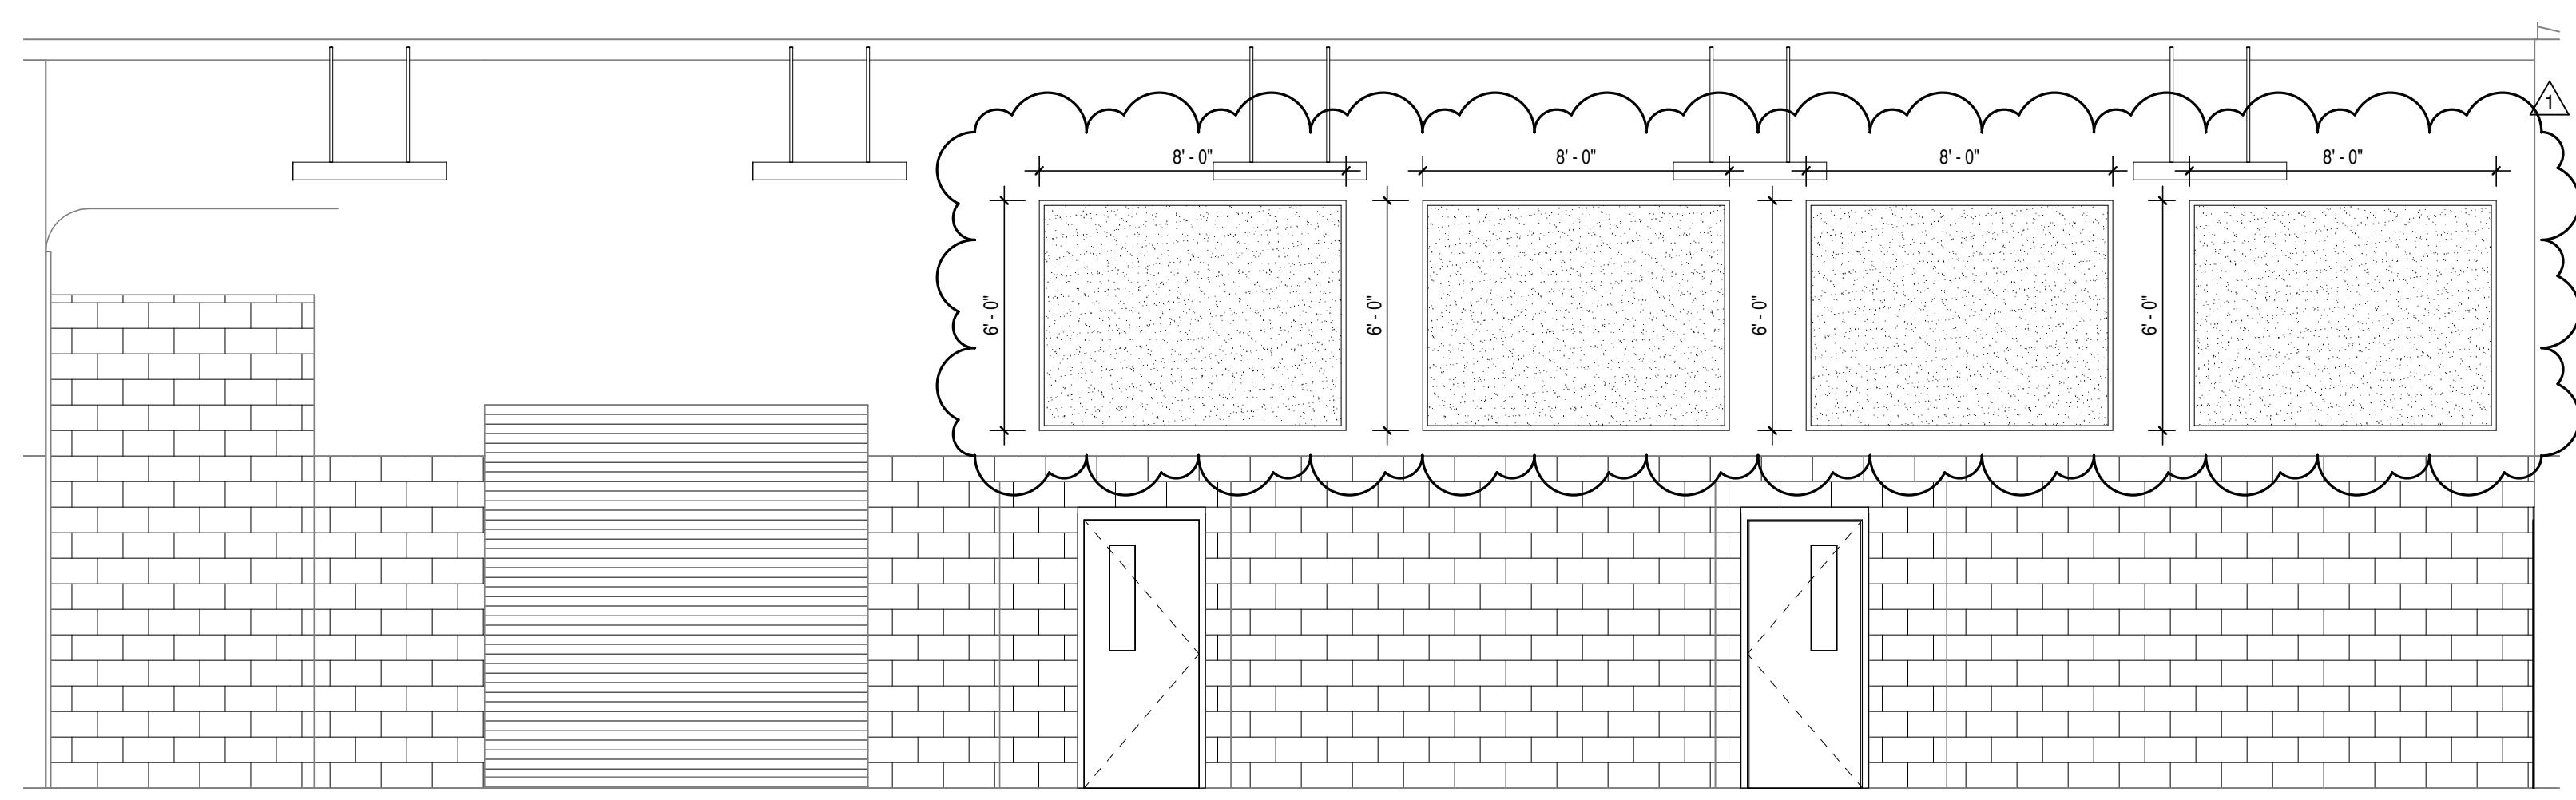

1 INTERIOR ELEVATION  
A601 SCALE: 1/4" = 1'-0"

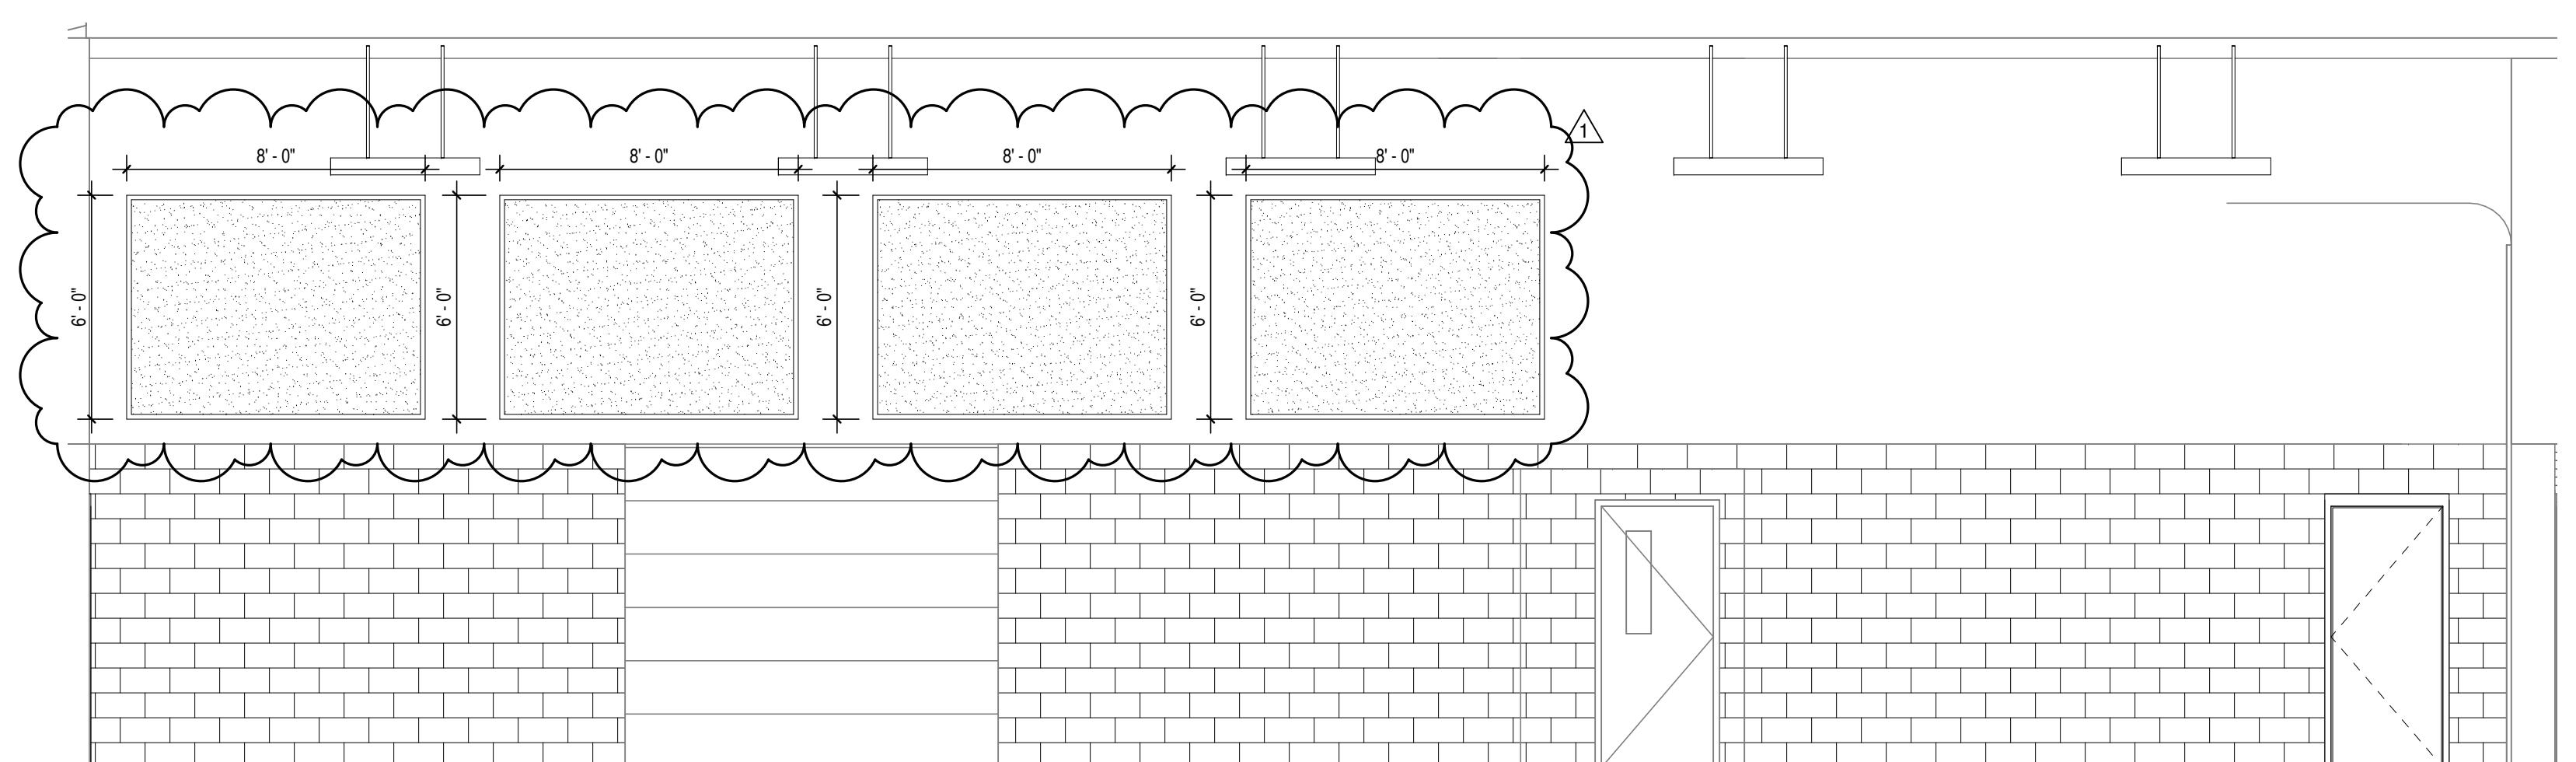

2 INTERIOR ELEVATION  
A601 SCALE: 1/4" = 1'-0"

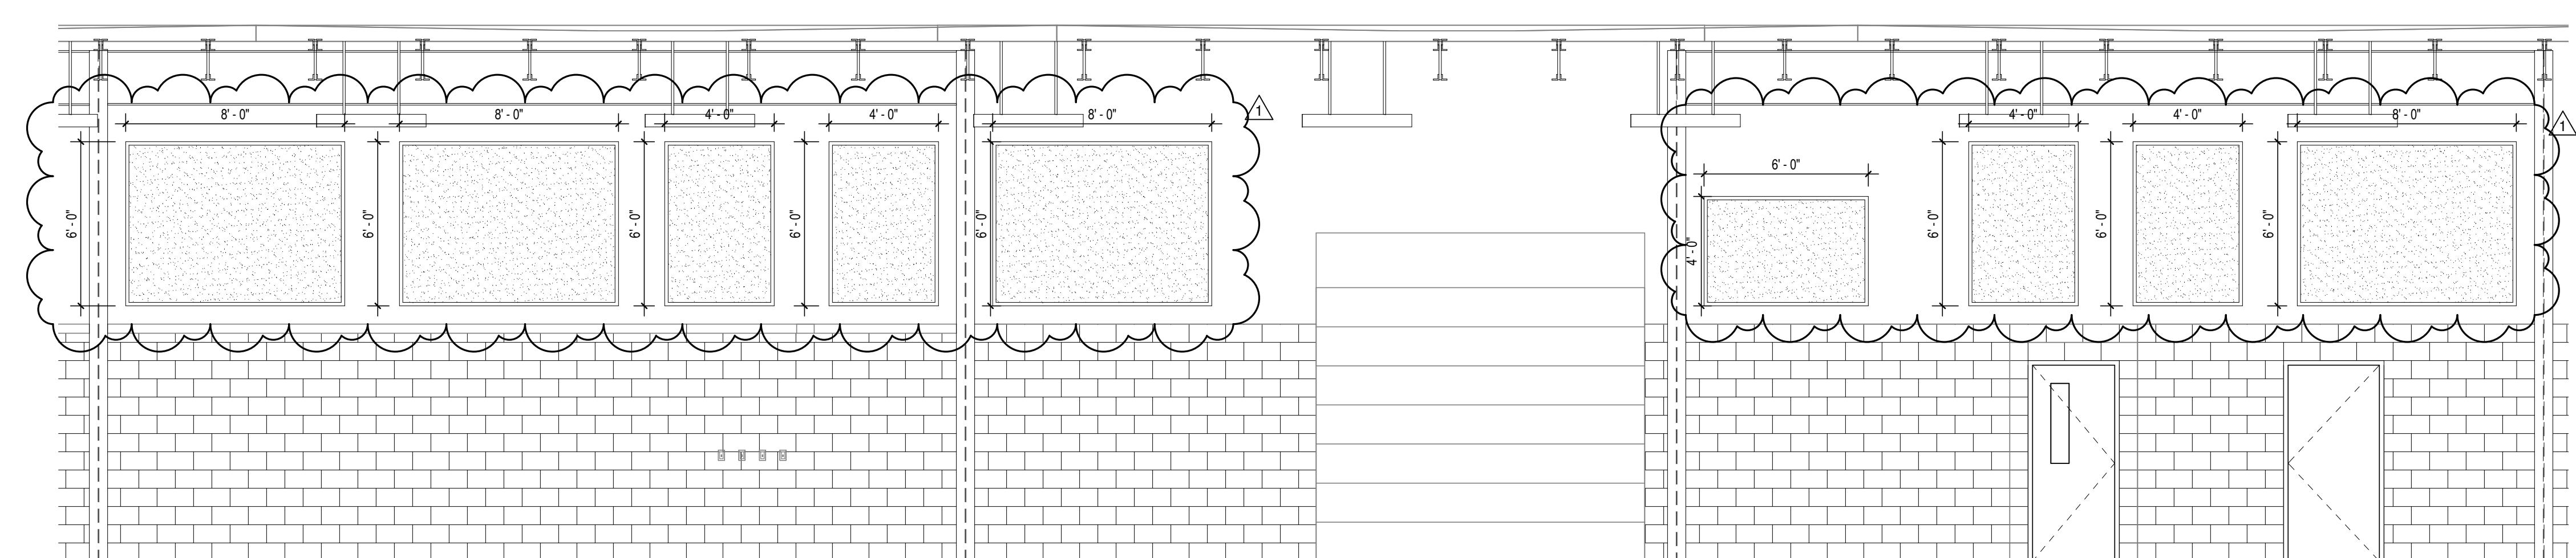

3 INTERIOR ELEVATION  
A601 SCALE: 1/4" = 1'-0"

PROJECT:  
MSD OF WARREN TOWNSHIP  
WARREN CENTRAL HIGH SCHOOL  
PHASE 3 ADDITION & RENOVATION  
9500 E. 16th STREET, INDIANAPOLIS, IN 46229

SCOPE DRAWINGS:  
These drawings show the scope of the project in terms of architectural design concept, the dimensions of the structure, and the location of the building on the site. They also describe the structural, mechanical and electrical systems and the materials to be used. They are intended to describe all the requirements of the Contract.

The drawings in this scope indicate or describe the trade contractors shall furnish all items required for the proper execution and completion of the work.

REVISIONS:

1 ADDENDUM #2 03-13-2023

ISSUE DATE DRAWN BY CHECKED BY  
02-21-2023 Author Checker

DRAWING TITLE:  
INTERIOR ELEVATIONS

CERTIFIED BY:  
JAMES ROBERT PINK  
REGISTERED FINK  
No. AR00900003  
STATE OF  
INDIANA  
ARCHITECT

DRAWING NUMBER  
A601


PROJECT NUMBER  
2021056




**SCCSO**

Keystone Crossing, Indianapolis, IN 46240  
317.648.7800 ccsco.net


© 2020 CCSO Architects, Inc. All Rights Reserved

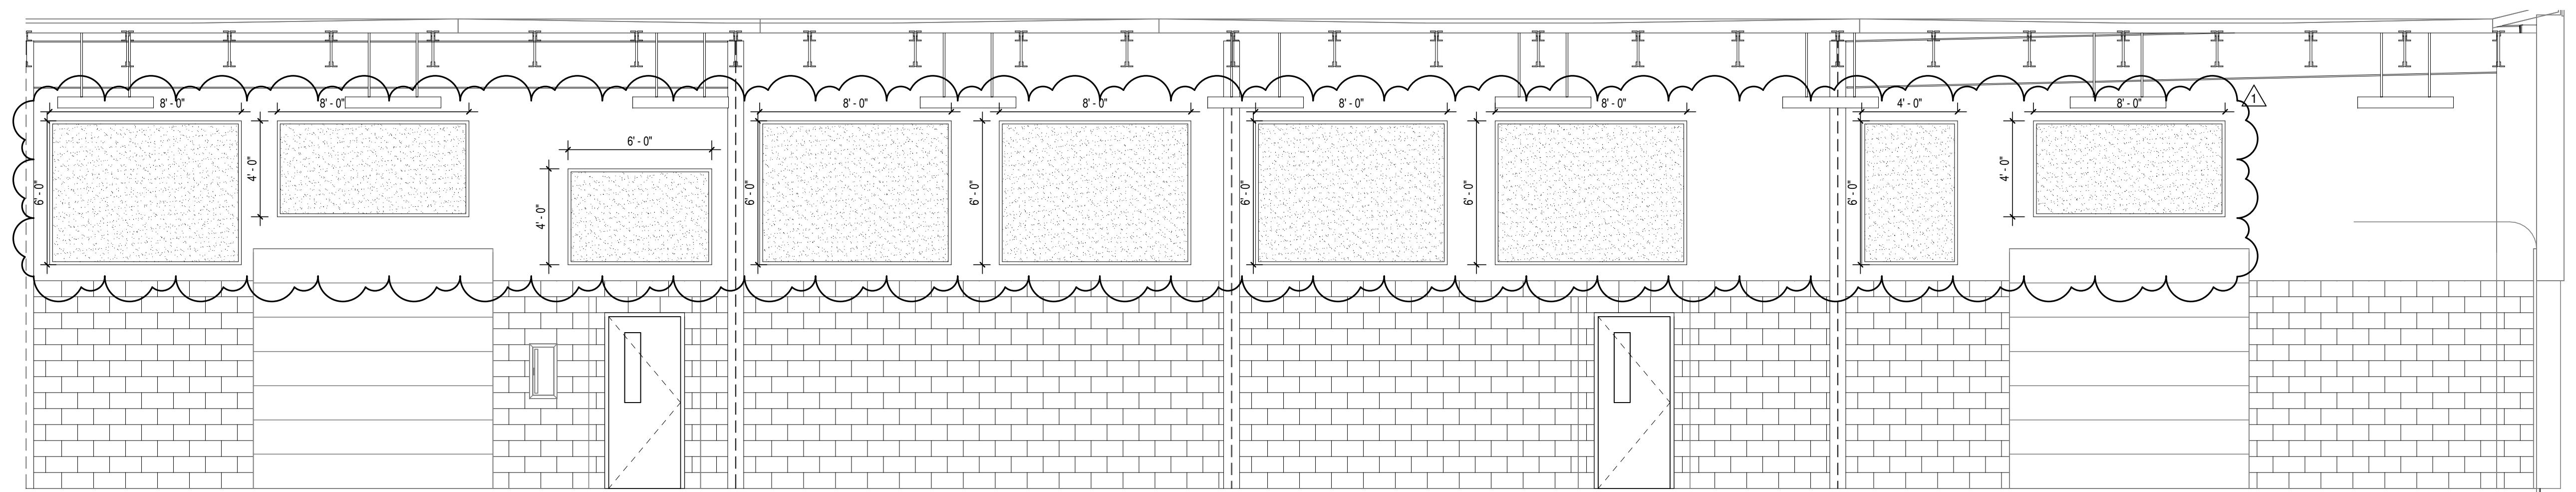

1 INTERIOR ELEVATION  
A602 SCALE: 1/4" = 1'-0"

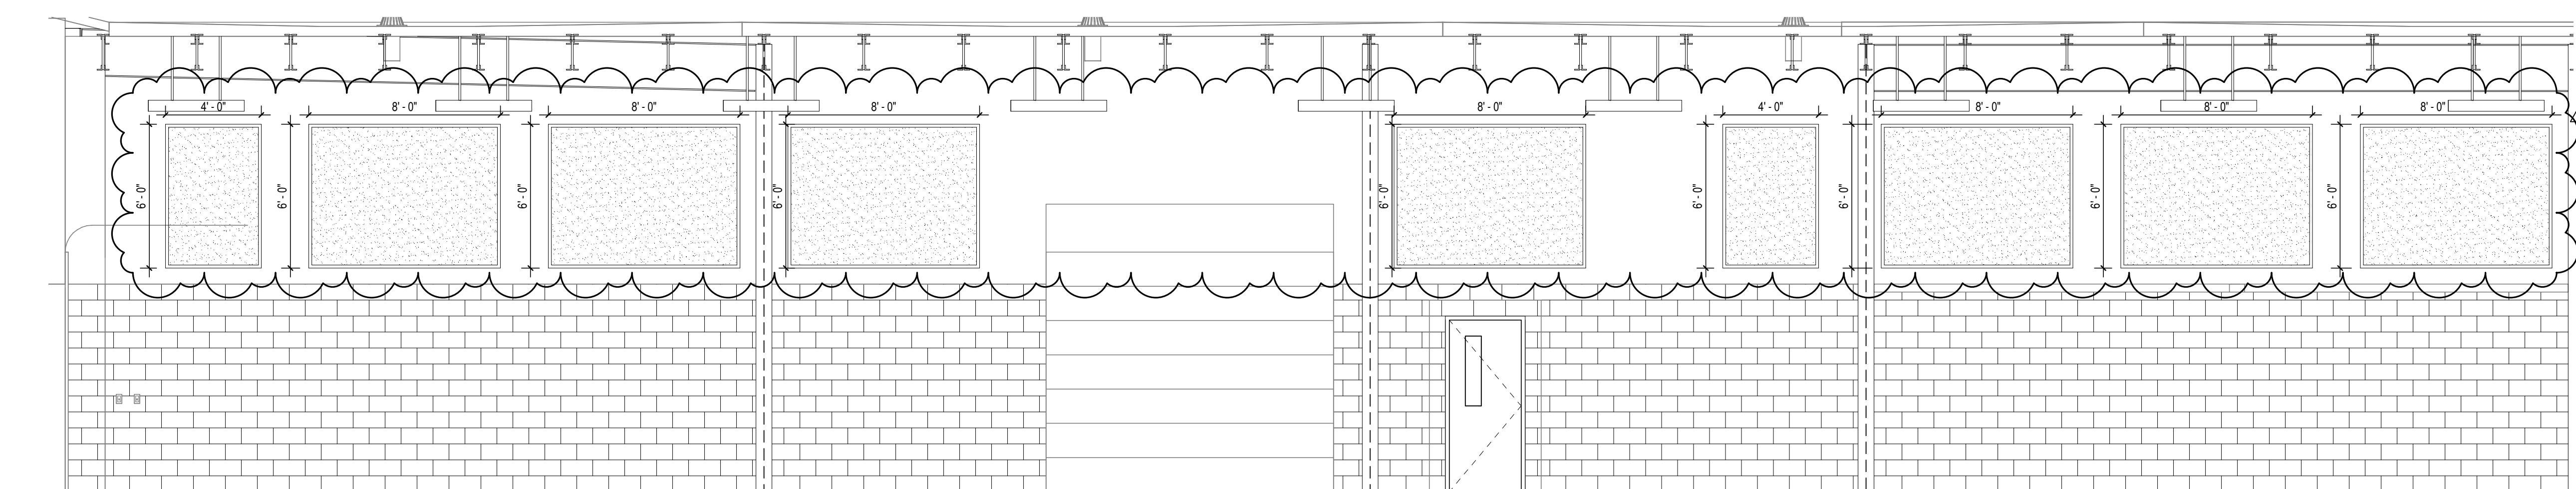

2 INTERIOR ELEVATION  
A602 SCALE: 1/4" = 1'-0"

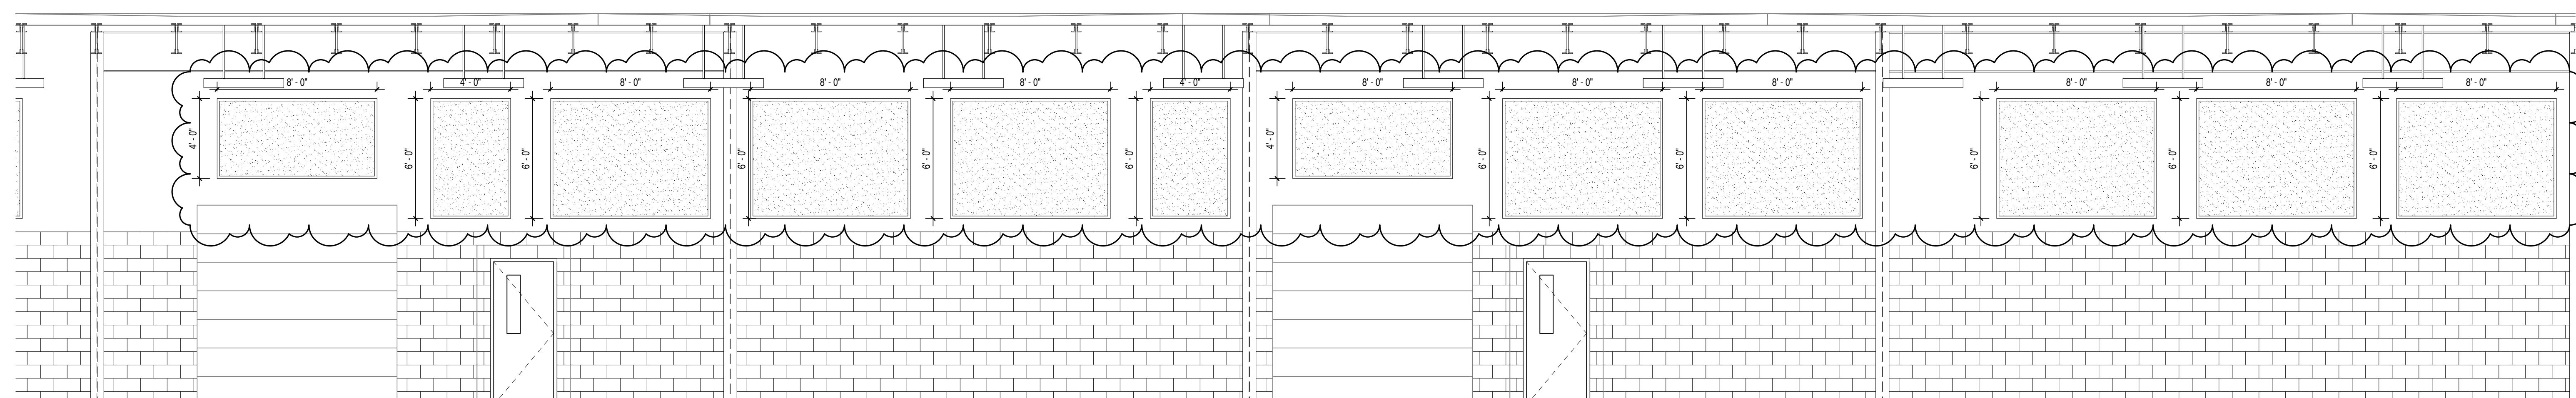

3 INTERIOR ELEVATION  
A602 SCALE: 1/4" = 1'-0"

**PROJECT:**  
WARREN CENTRAL HIGH SCHOOL  
PHASE 3 ADDITION & RENOVATION  
9500 E. 16th STREET, INDIANAPOLIS, IN 46229

**SCOPE DRAWINGS:**  
These drawings are a part of the scope of the project in terms of the architectural design concept, the dimensions of the structure, and the structural, mechanical and electrical systems. They are intended to provide the information required to describe all the work to be performed under the contract and to meet the requirements of the Contract.


The drawings and scope indicated or proposed by the trade contractors shall fulfill all items required for the proper execution and completion of the work.

**REVISIONS:**

1 ADDENDUM #2 03-13-2023

**ISSUE DATE:** 02-21-2023 **DRAWN BY:** Author **CHECKED BY:** Checker

**DRAWING TITLE:**  
INTERIOR ELEVATIONS

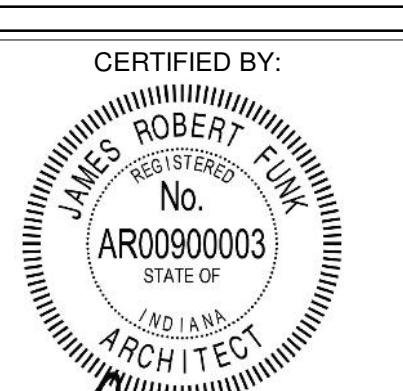

**DRAWING NUMBER:**  
**A602**

**PROJECT NUMBER:**  
**2021056**




**SCCSO**


Keystone Crossing, Indianapolis, IN 46240

317.648.7800 | cso.net

© 2020 CCSO Architects, Inc. All Rights Reserved

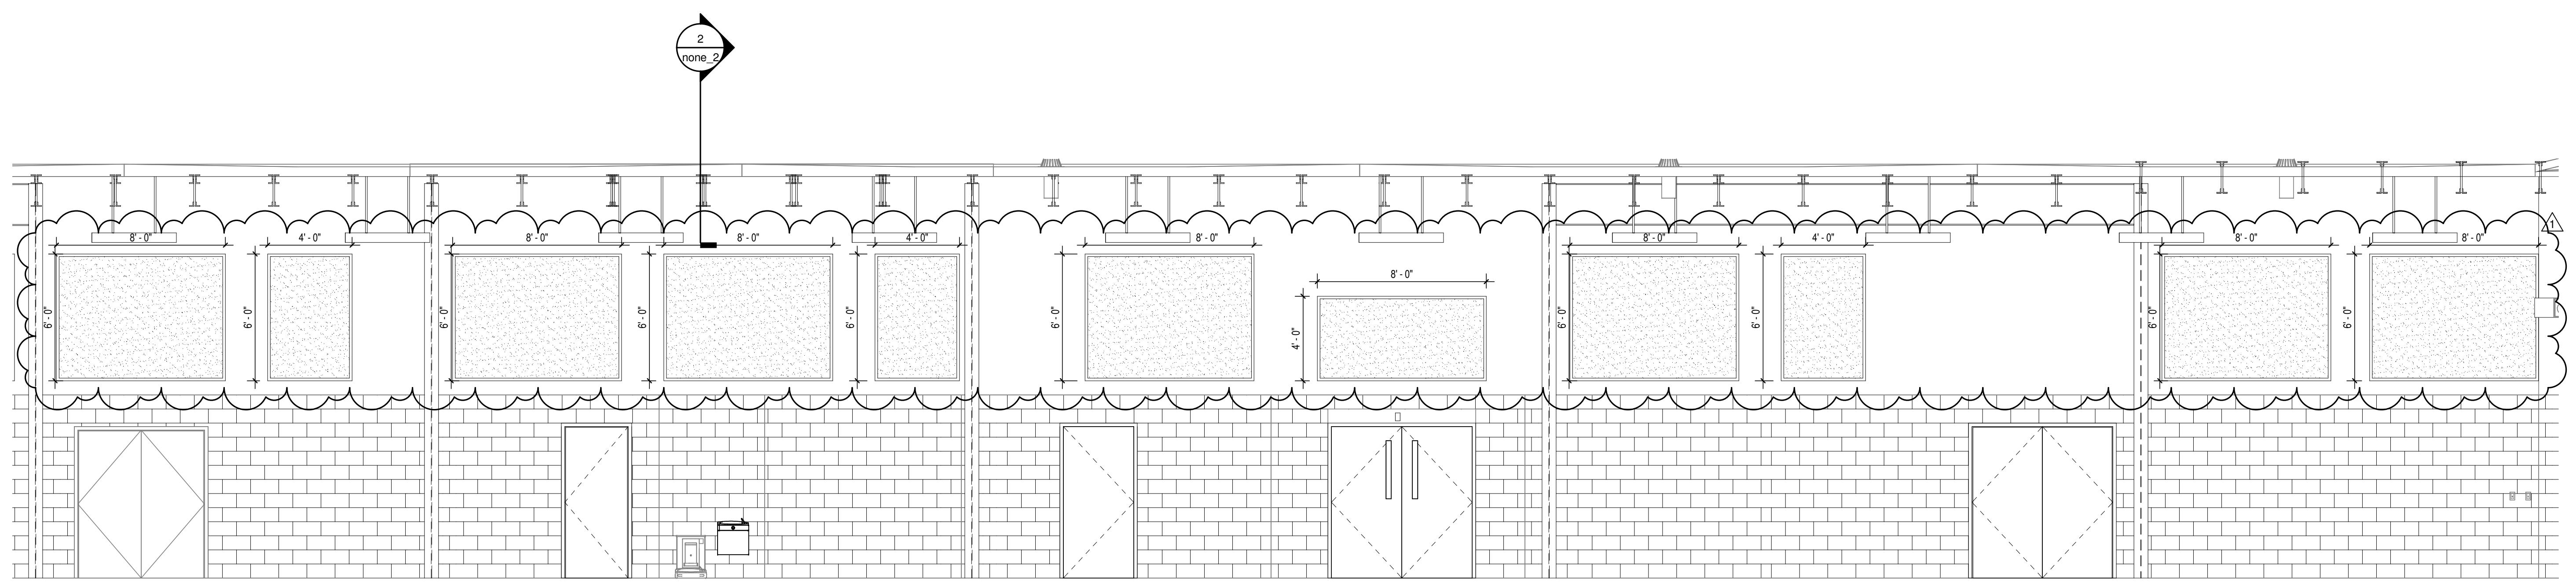

**1** INTERIOR ELEVATION  
A603 SCALE: 1/4" = 1'-0"

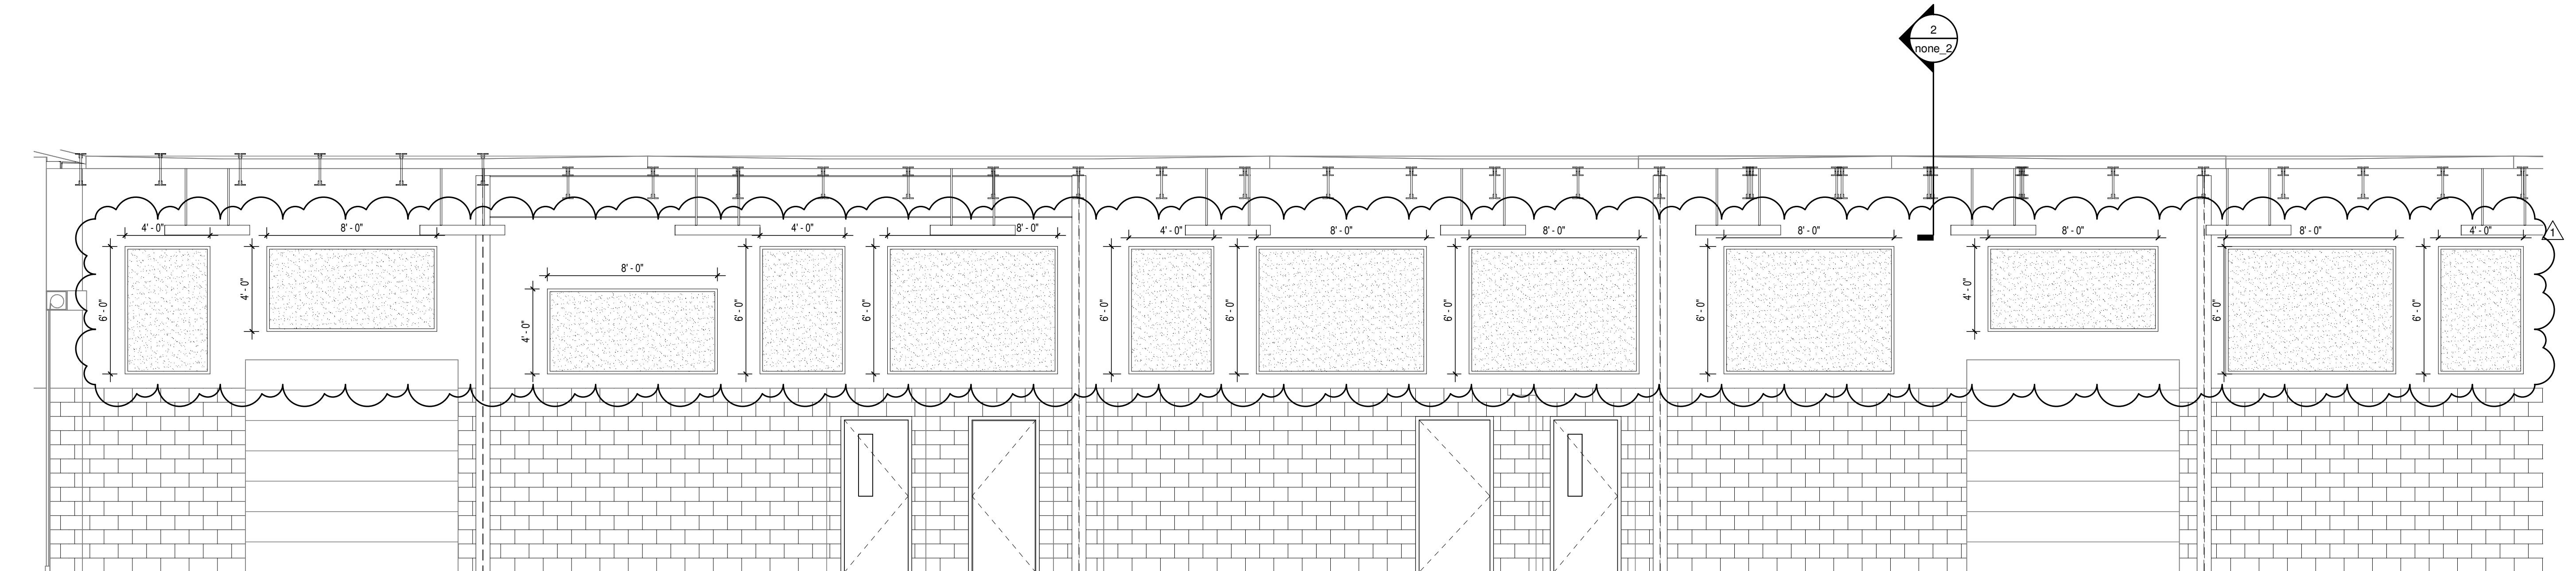

**2** INTERIOR ELEVATION  
A603 SCALE: 1/4" = 1'-0"

PROJECT:  
MSD OF WARREN TOWNSHIP  
WARREN CENTRAL HIGH SCHOOL  
PHASE 3 ADDITION & RENOVATION  
9500 E. 16th STREET, INDIANAPOLIS, IN 46229


SCOPE DRAWINGS:  
These drawings are a part of the scope of the project in terms of architectural design concept, the dimensions of the structure, and the structural, mechanical and electrical systems. They are intended to describe all the requirements of the project. The trade contractors shall furnish all items required for the proper execution and completion of the work.

REVISIONS:

1 ADDENDUM #2 03-13-2023

ISSUE DATE DRAWN BY CHECKED BY  
02-21-2023 Author Checker

DRAWING TITLE:  
INTERIOR  
ELEVATIONS

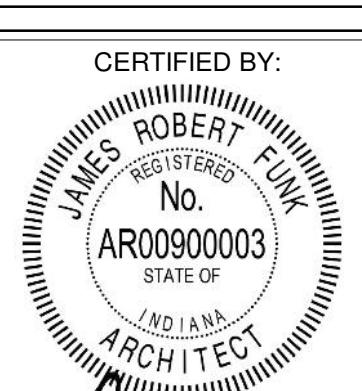

DRAWING NUMBER  
**A603**

PROJECT NUMBER  
2021056



SCCSO

8831 Keystone Crossing, Indianapolis, IN 46240

© 2020 CCSO Architects, Inc. All Rights Reserved

PROJECT:  
MSD OF WARREN TOWNSHIP  
WARREN CENTRAL HIGH SCHOOL  
PHASE 3 ADDITION & RENOVATION  
9500 E. 16th STREET, INDIANAPOLIS, IN 46229

SCOPE DRAWINGS:  
These drawings are a part of the scope of the project in terms of architectural design concept, the dimensions of structural, mechanical and electrical systems and the requirements of the Contract. They shall describe all the work required to be performed to complete the requirements of the Contract.

REVISIONS:

1 ADDENDUM #2 03-13-2023












ISSUE DATE DRAWN BY CHECKED BY  
02-21-2023 Author Checker

DRAWING TITLE:  
INTERIOR  
FINISH  
ELEVATIONS &  
DETAILS

CERTIFIED BY:  
ROBERT JAMES PINK  
REGISTERED ARCHITECT  
No. AR0090003  
STATE OF INDIANA

DRAWING NUMBER  
A611

PROJECT NUMBER  
2021056

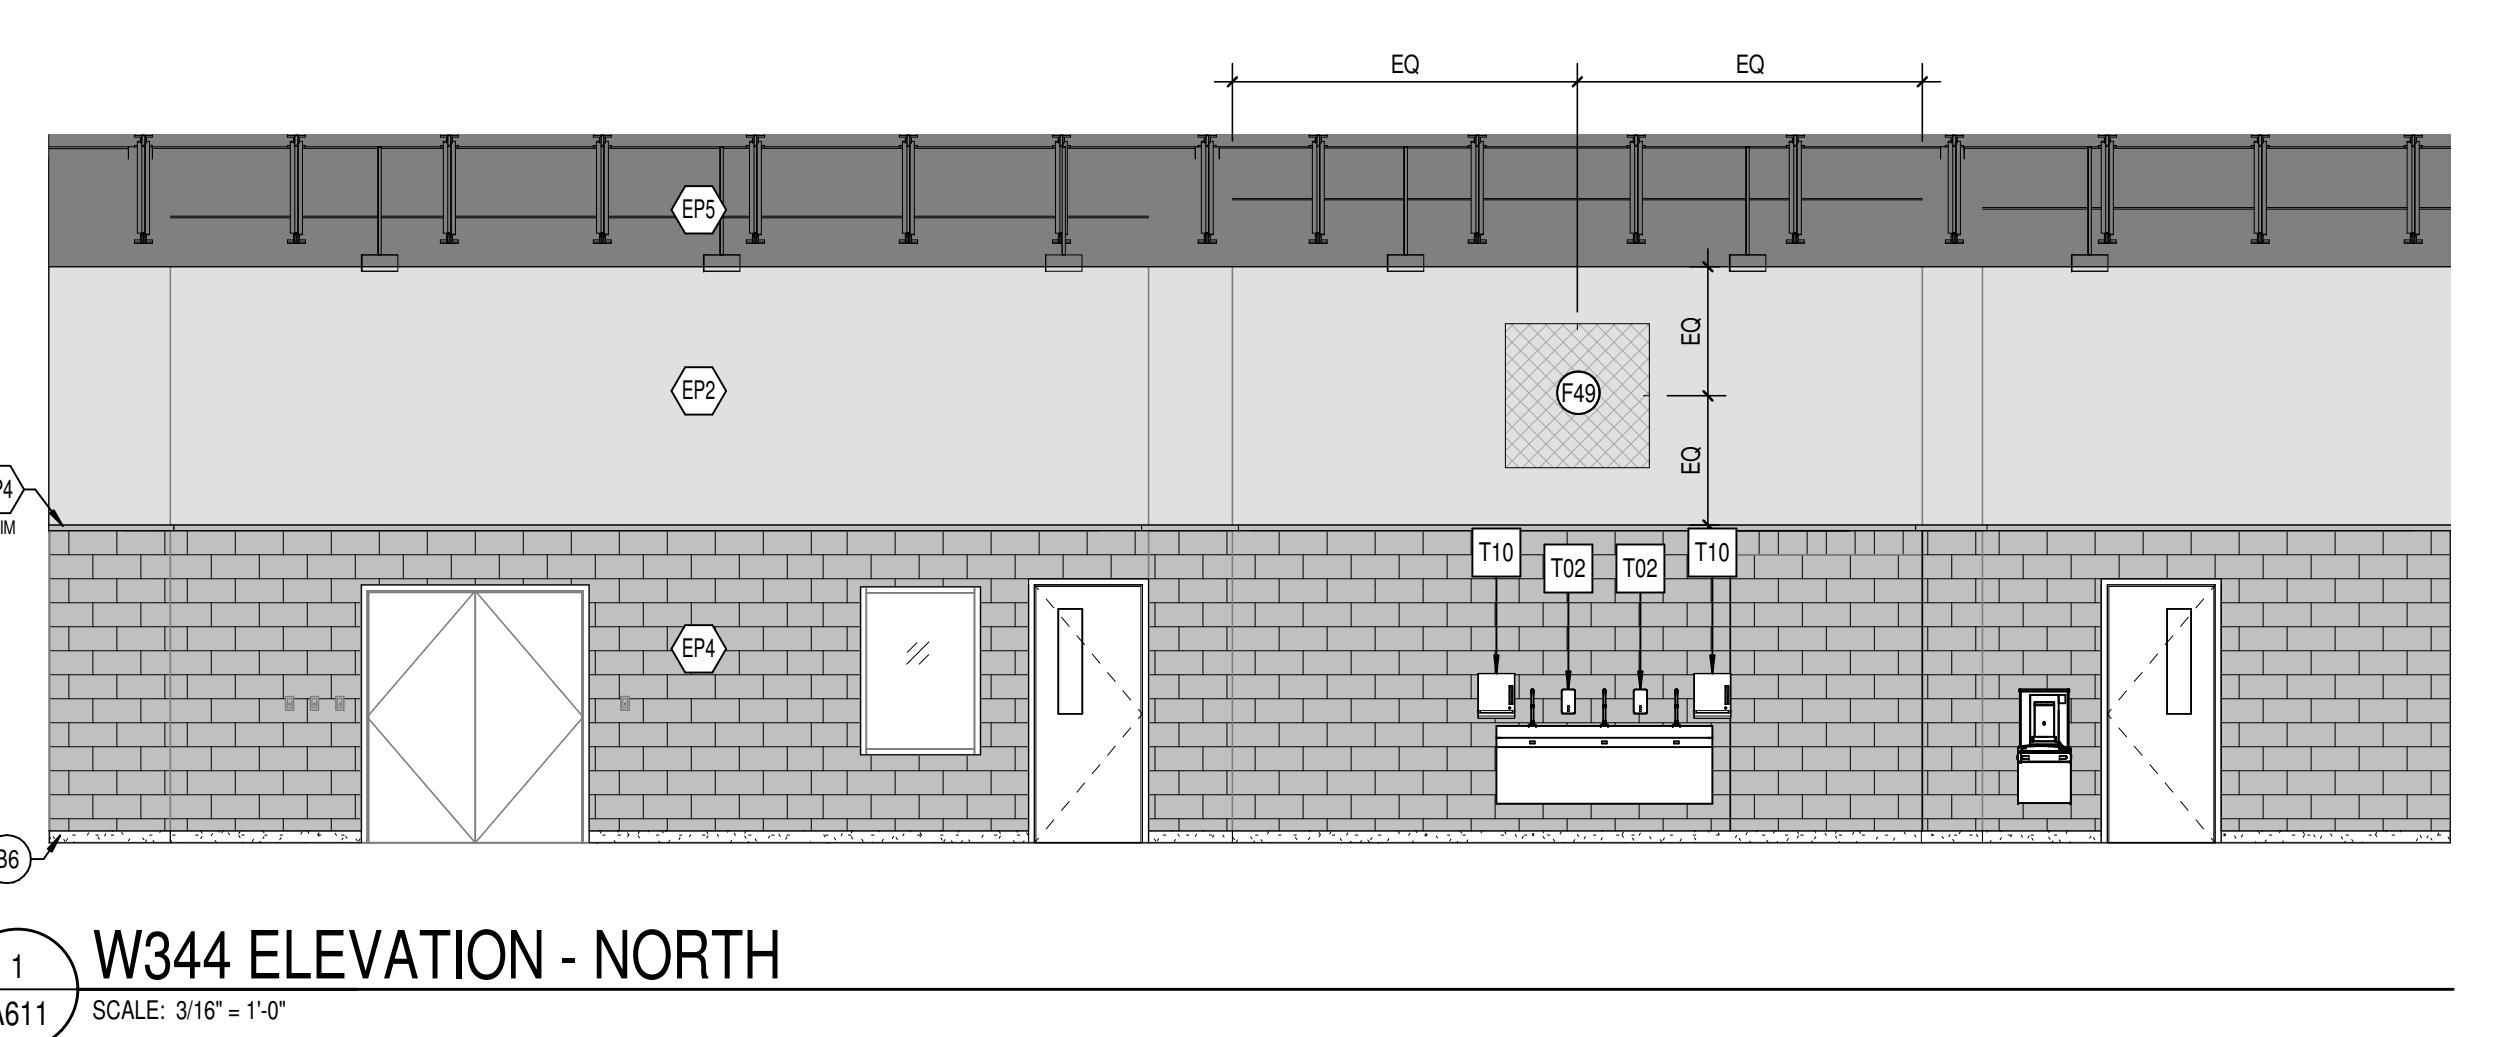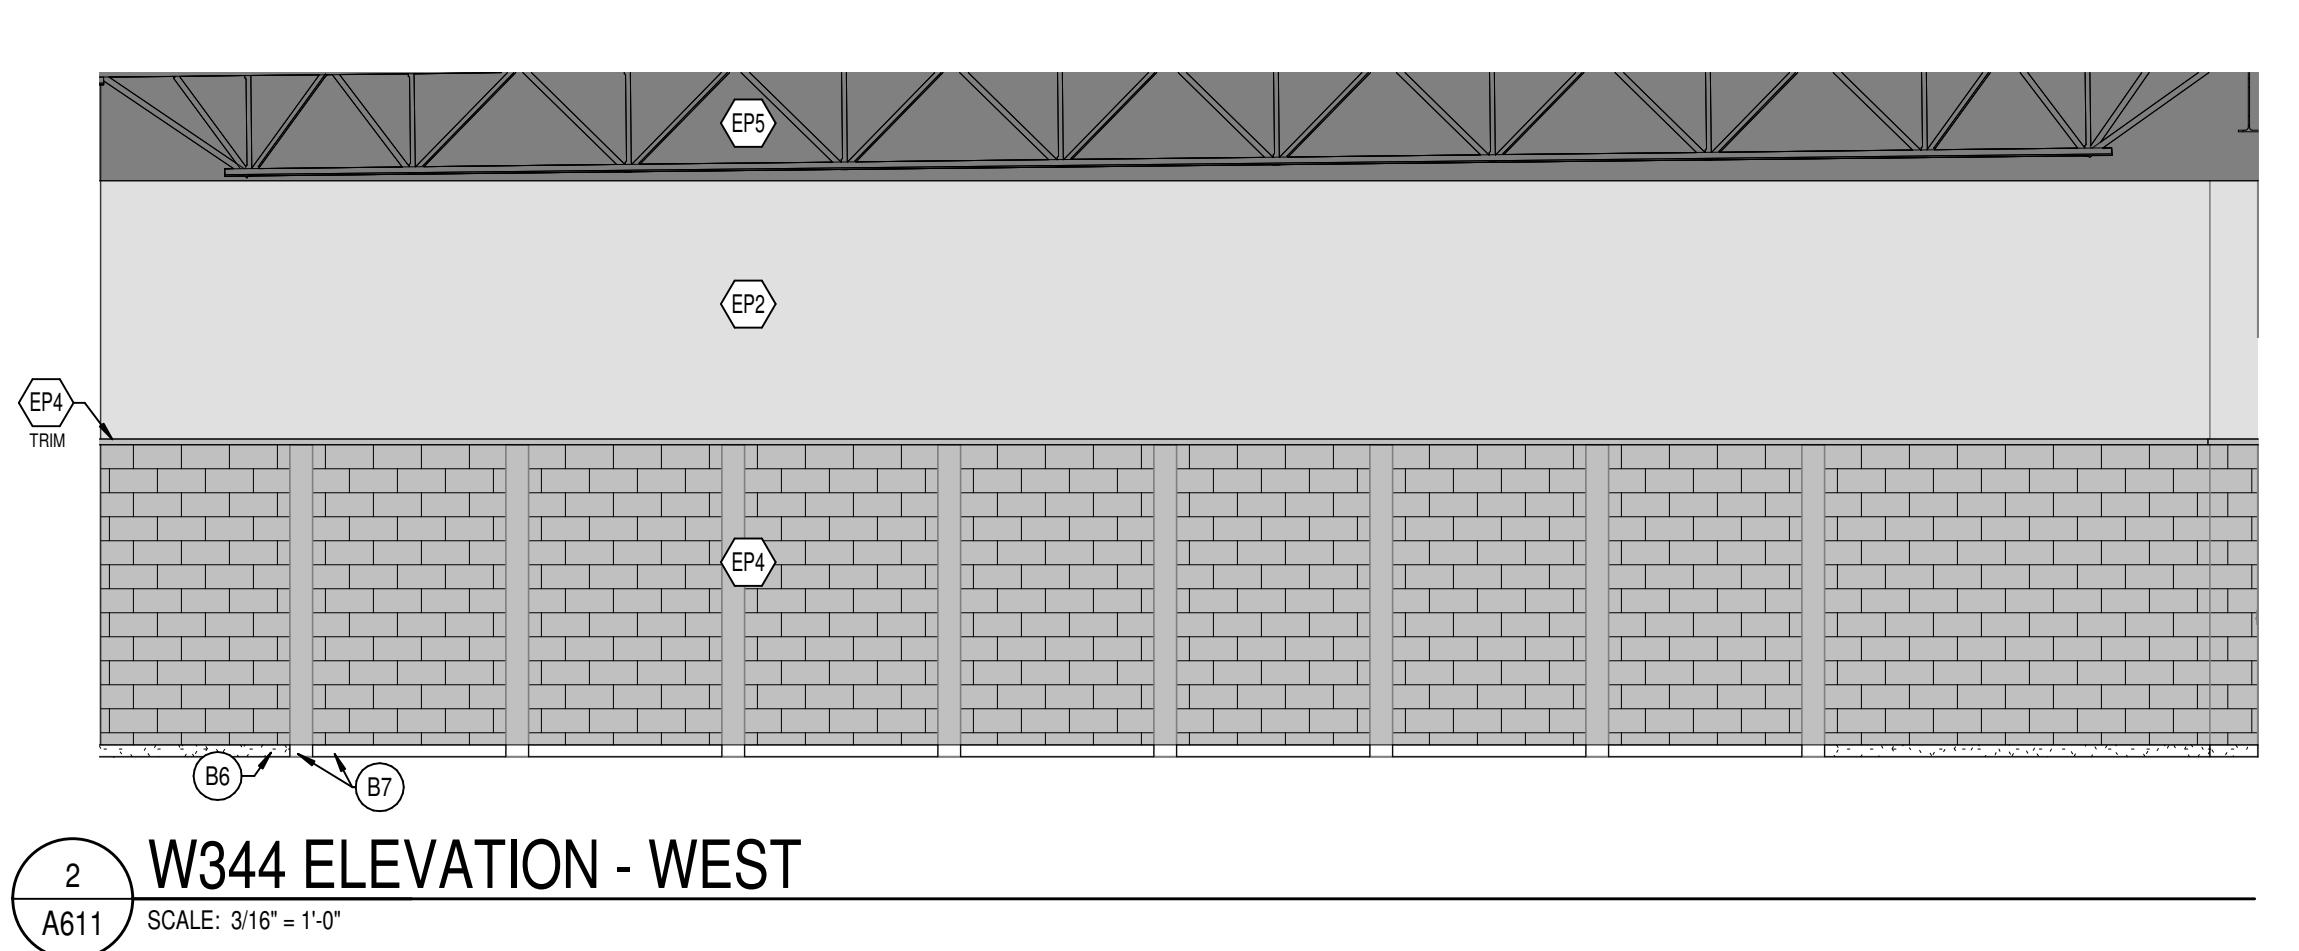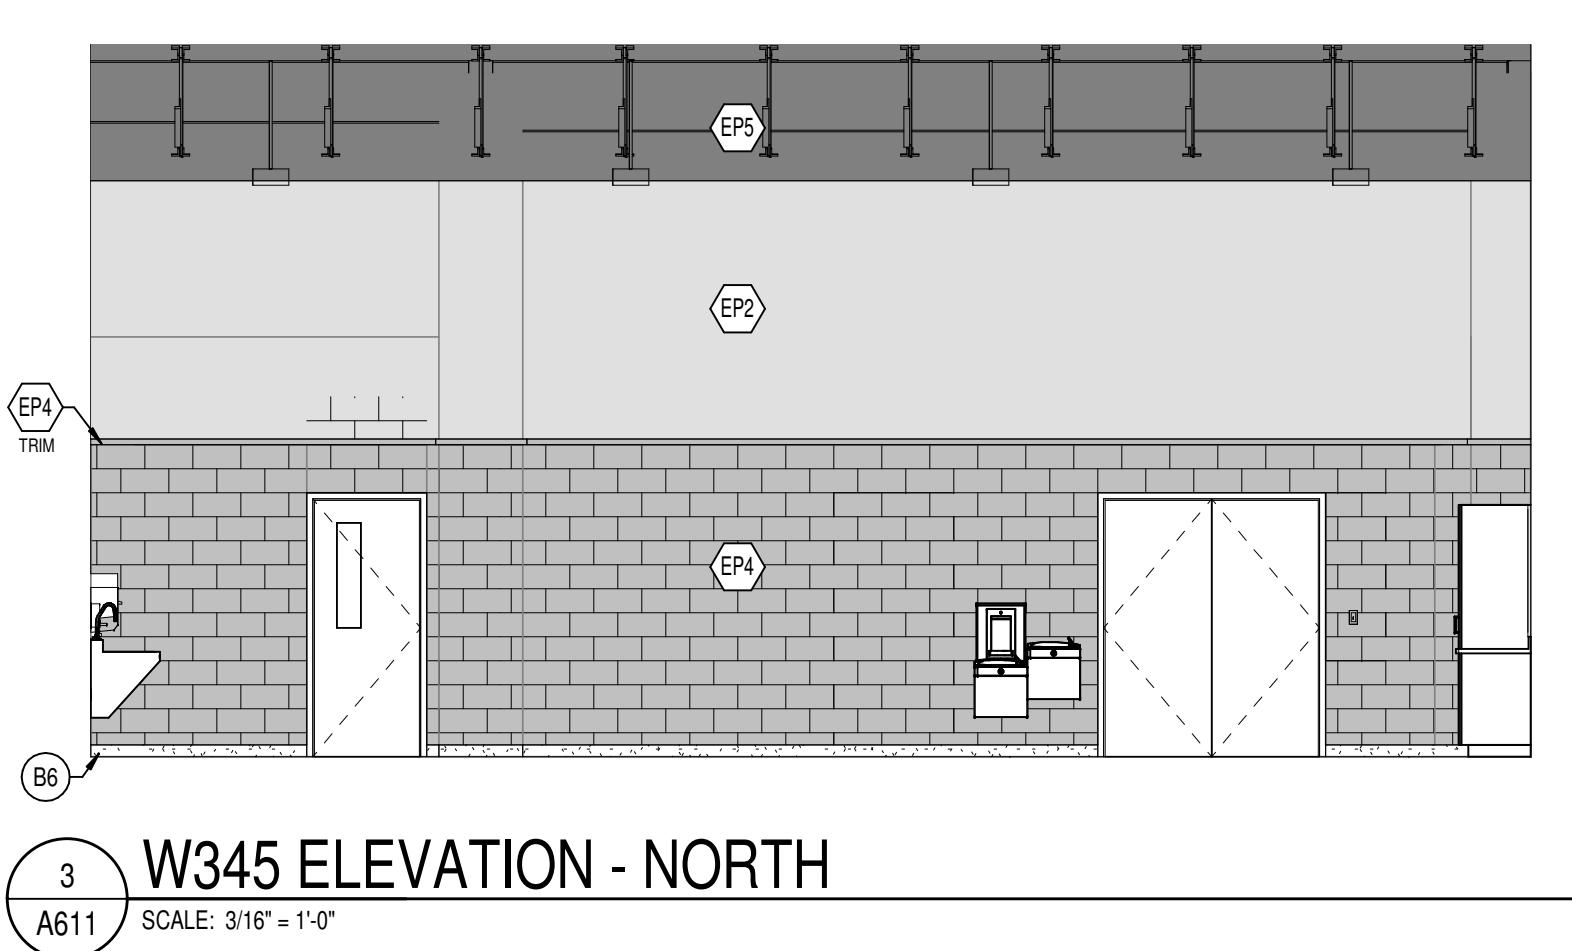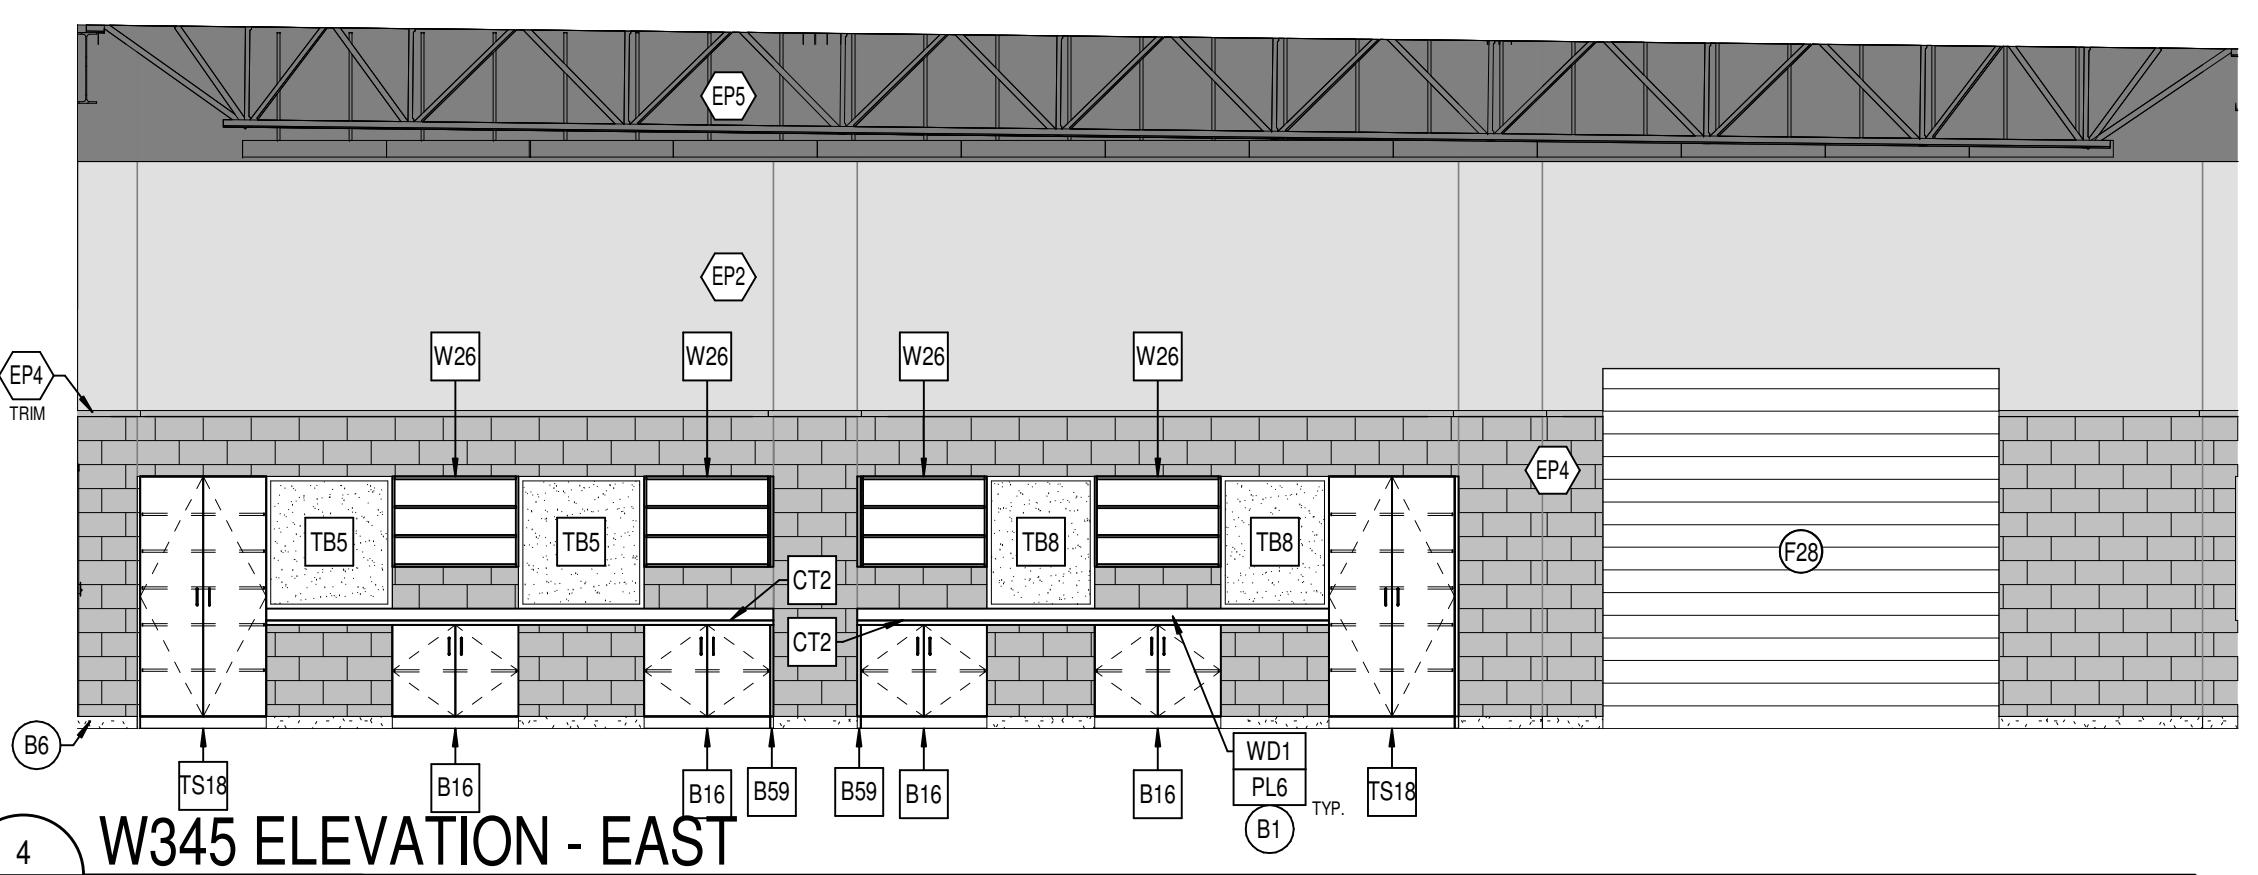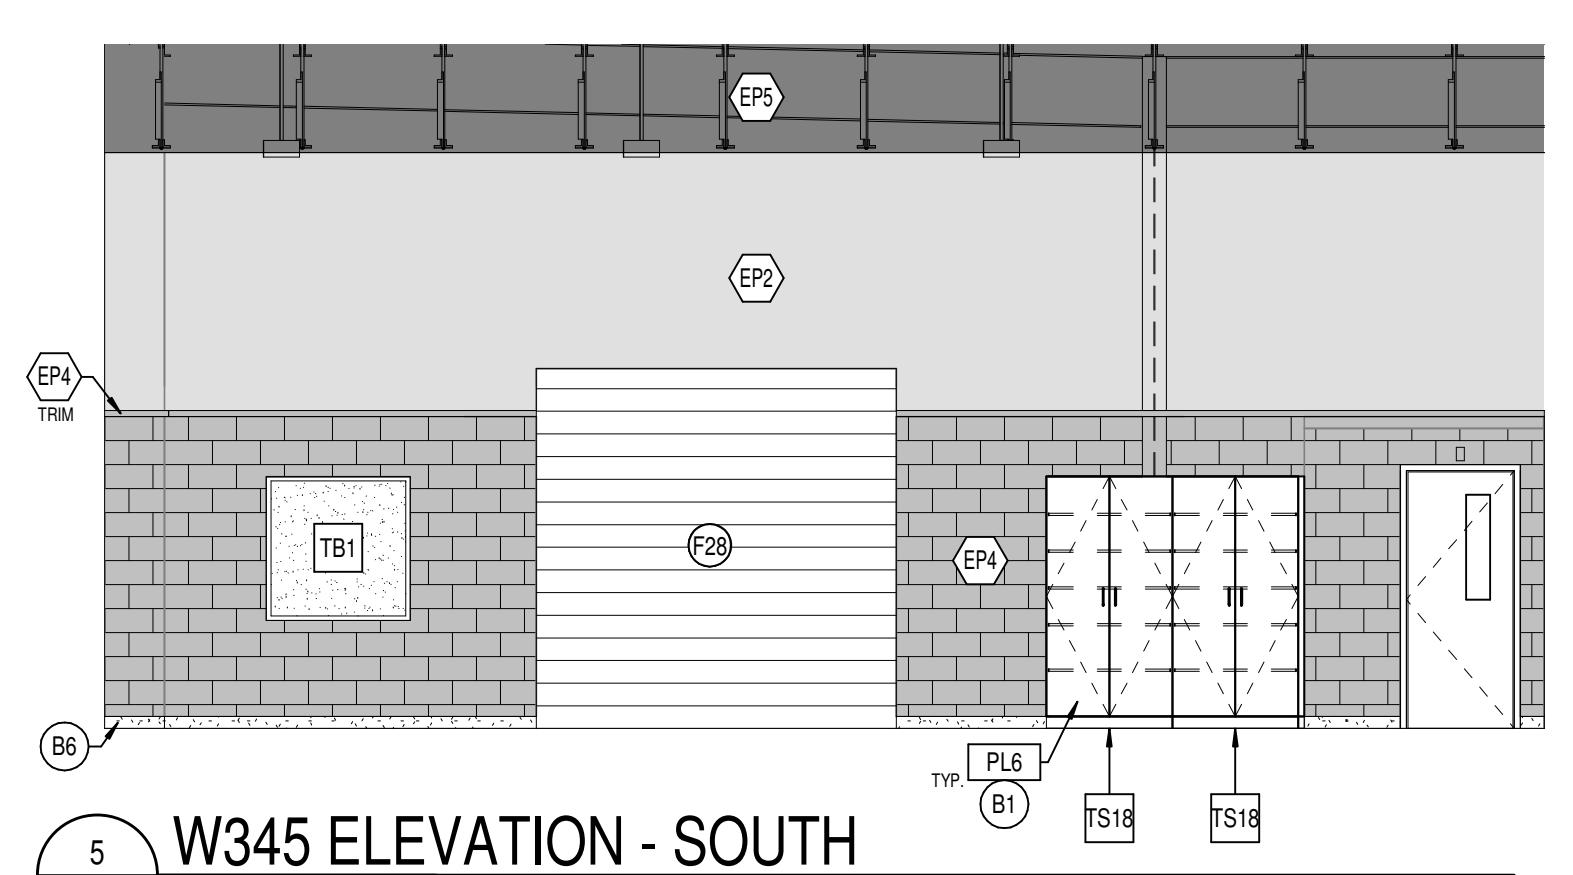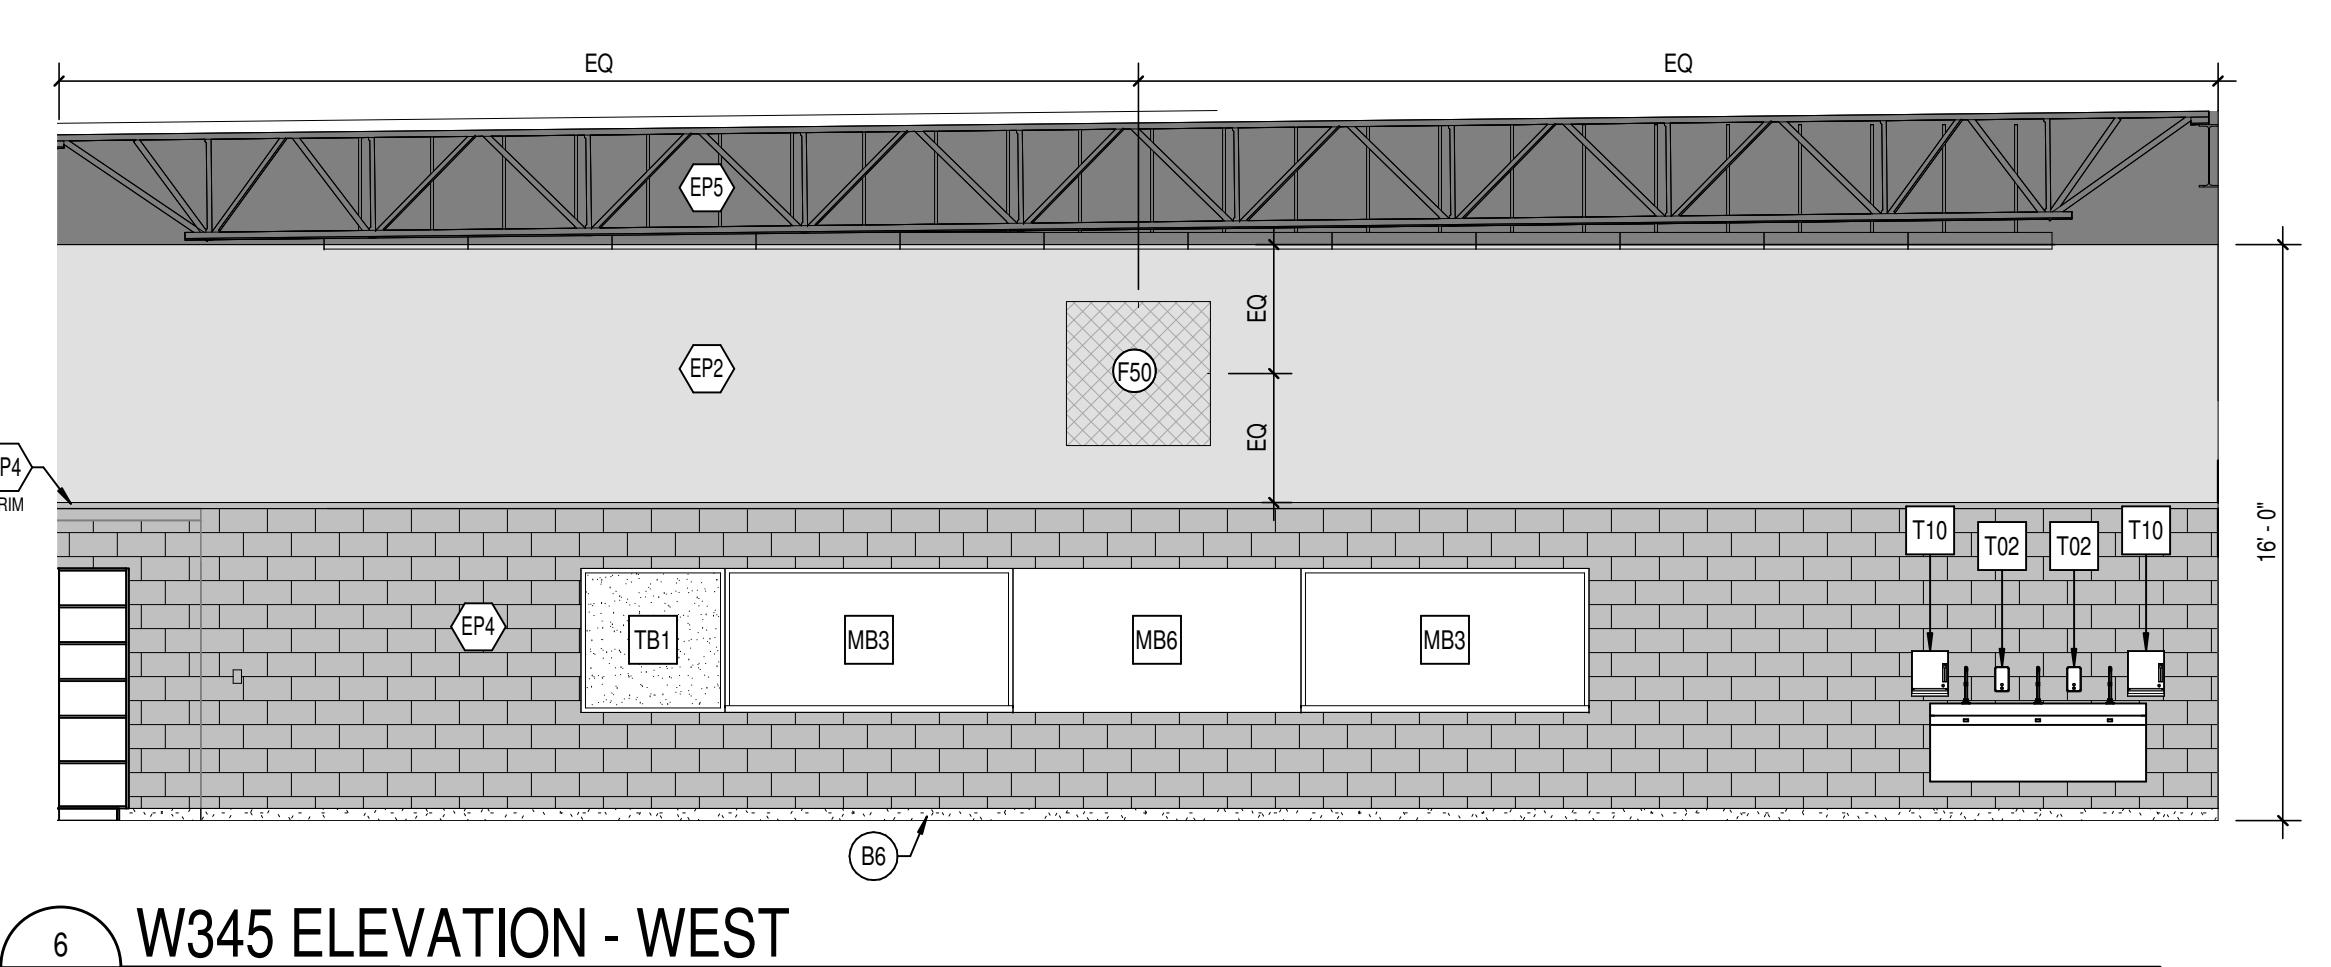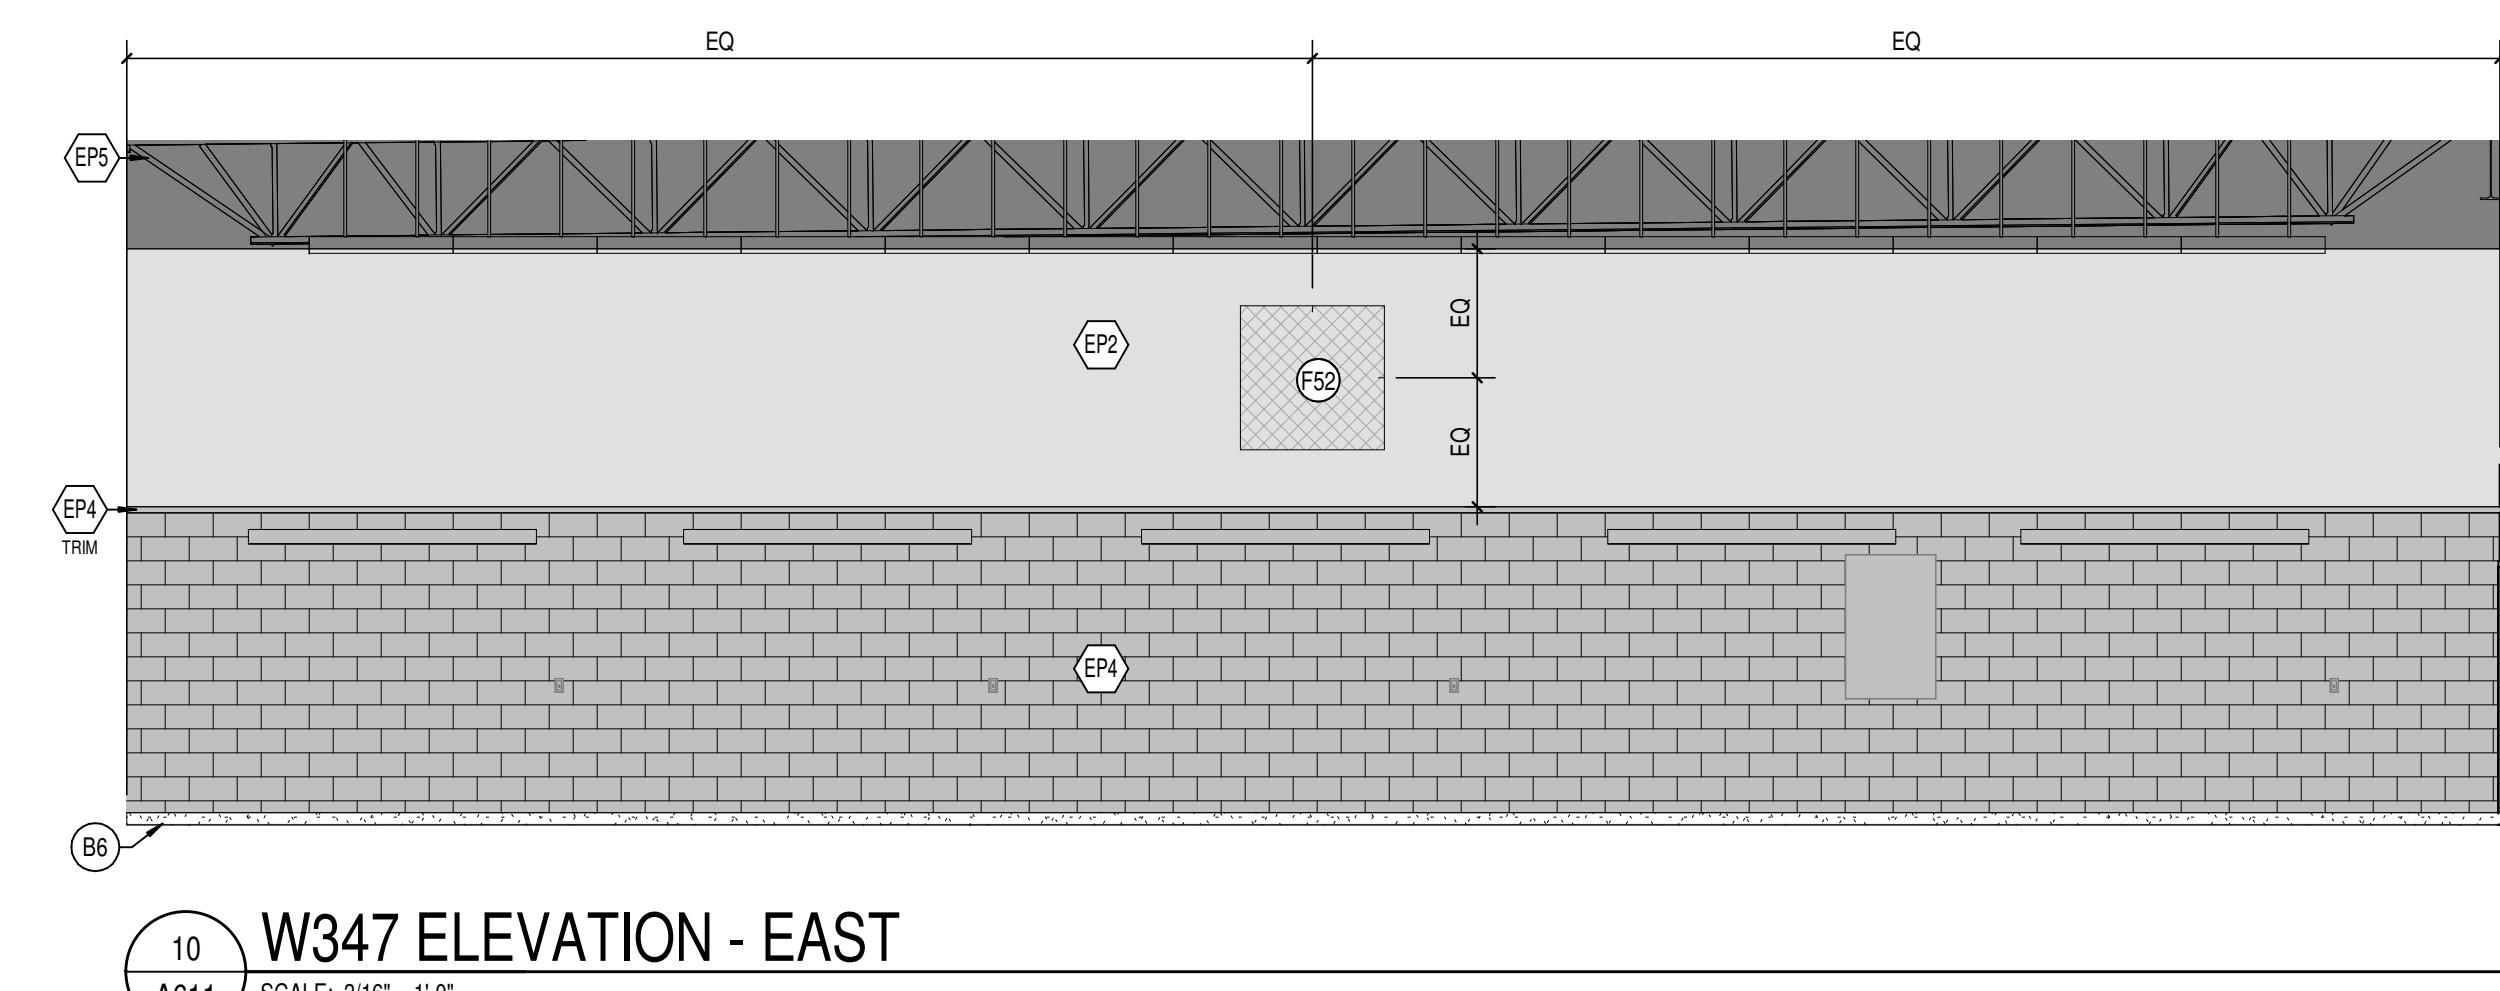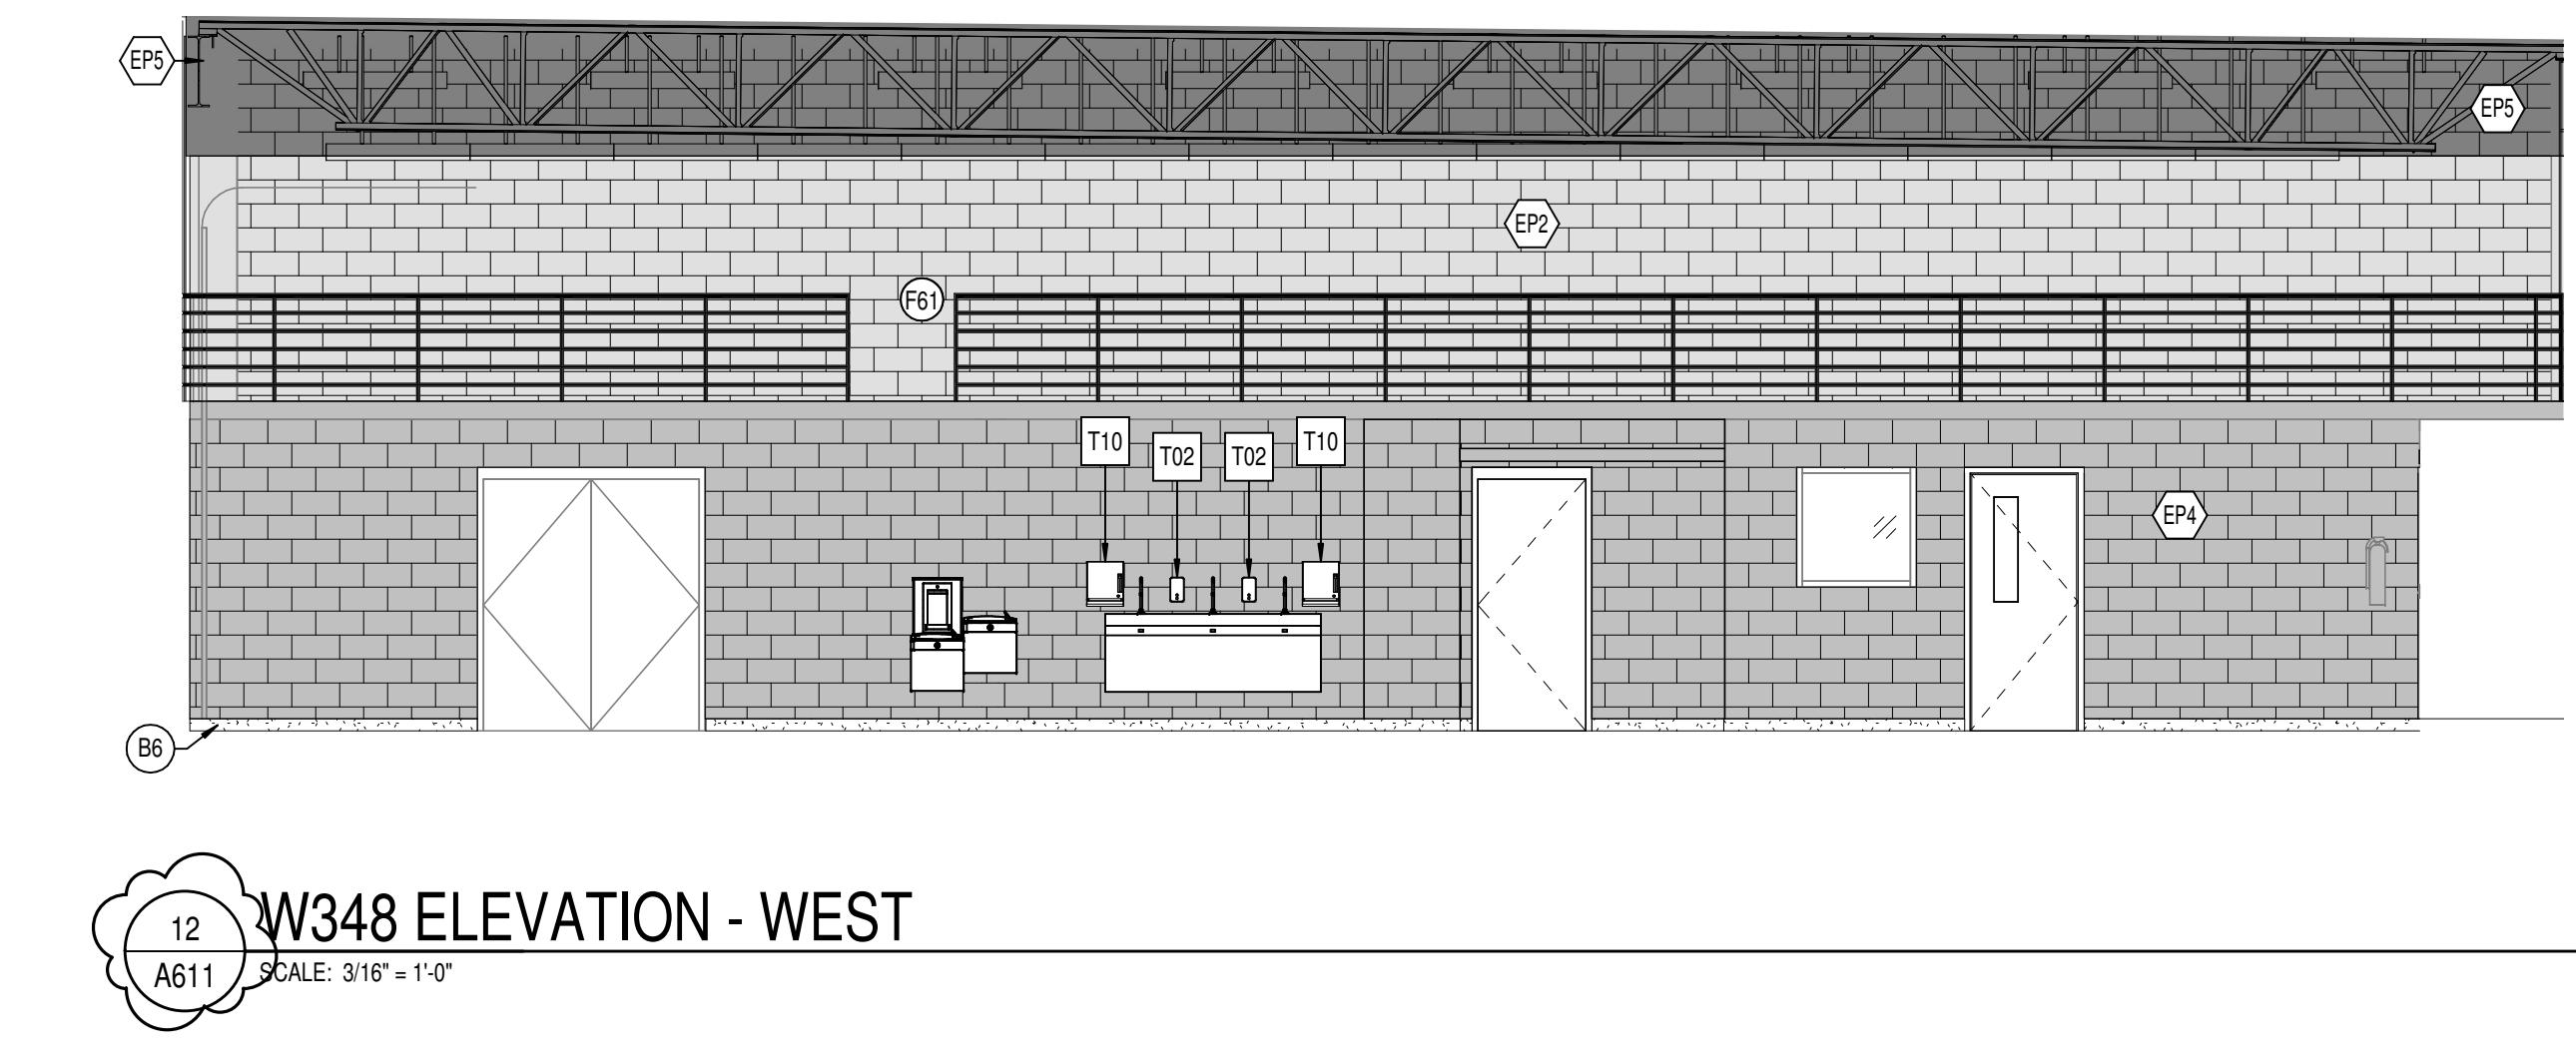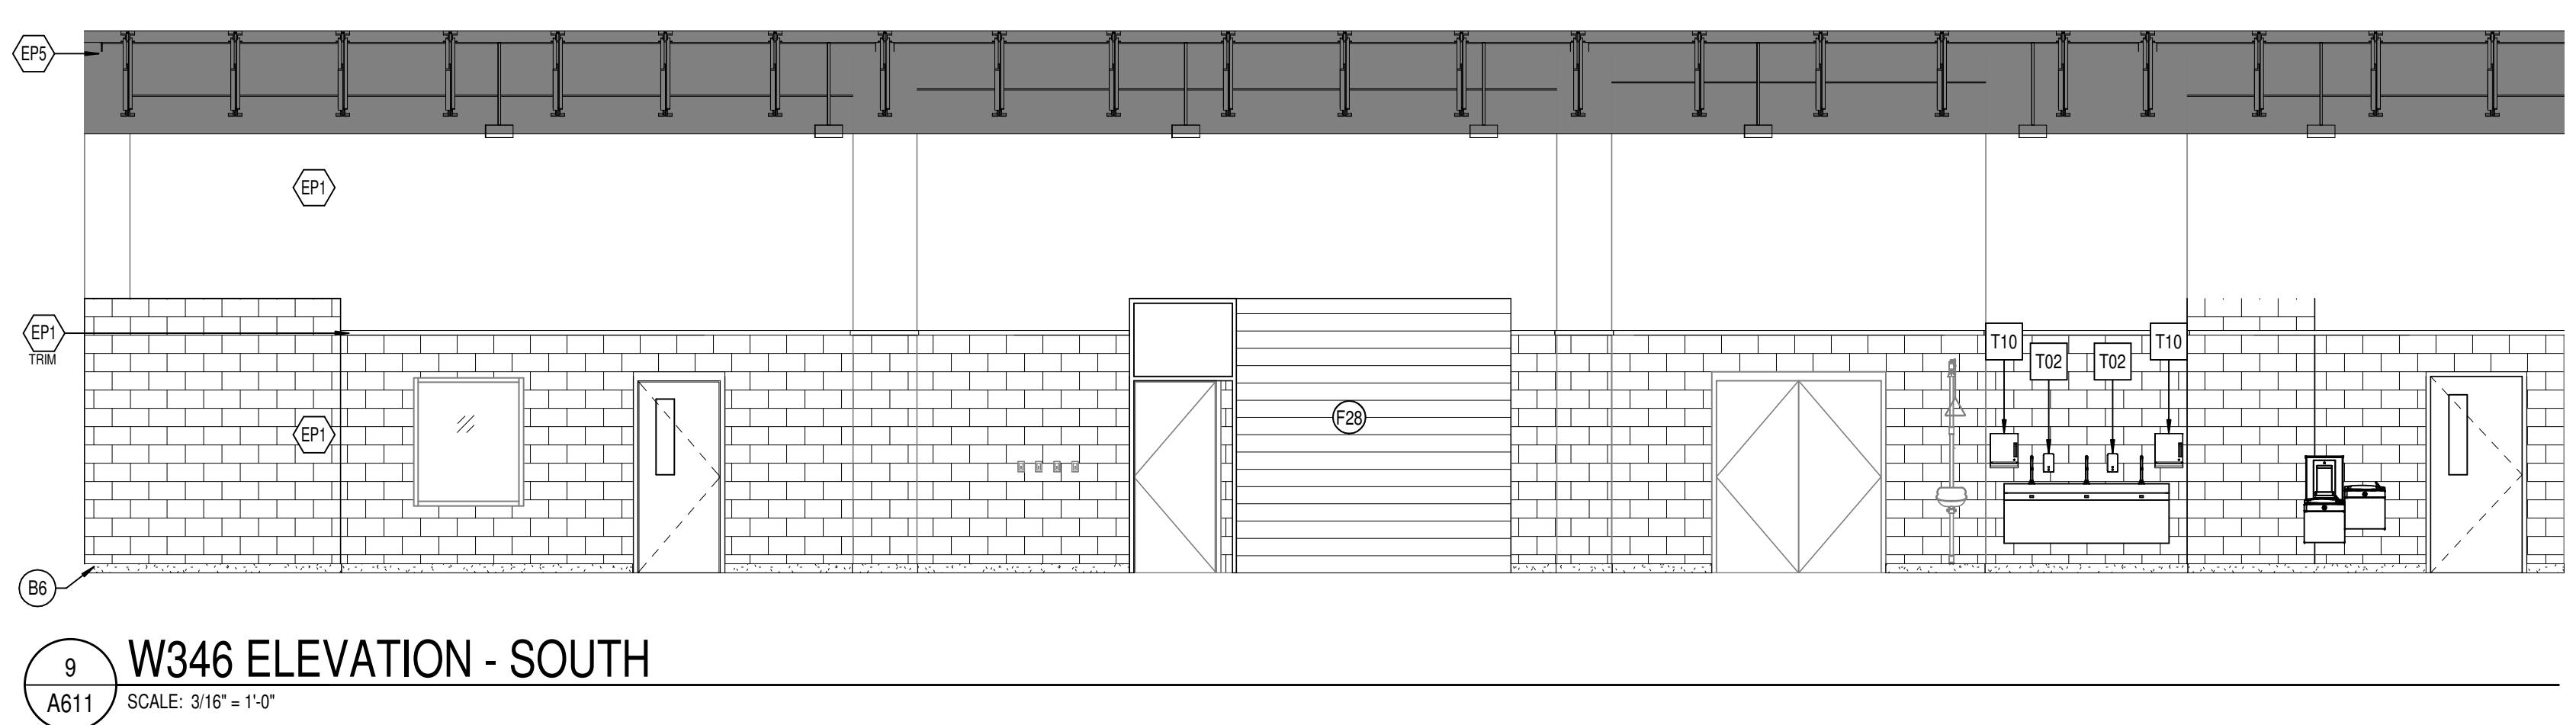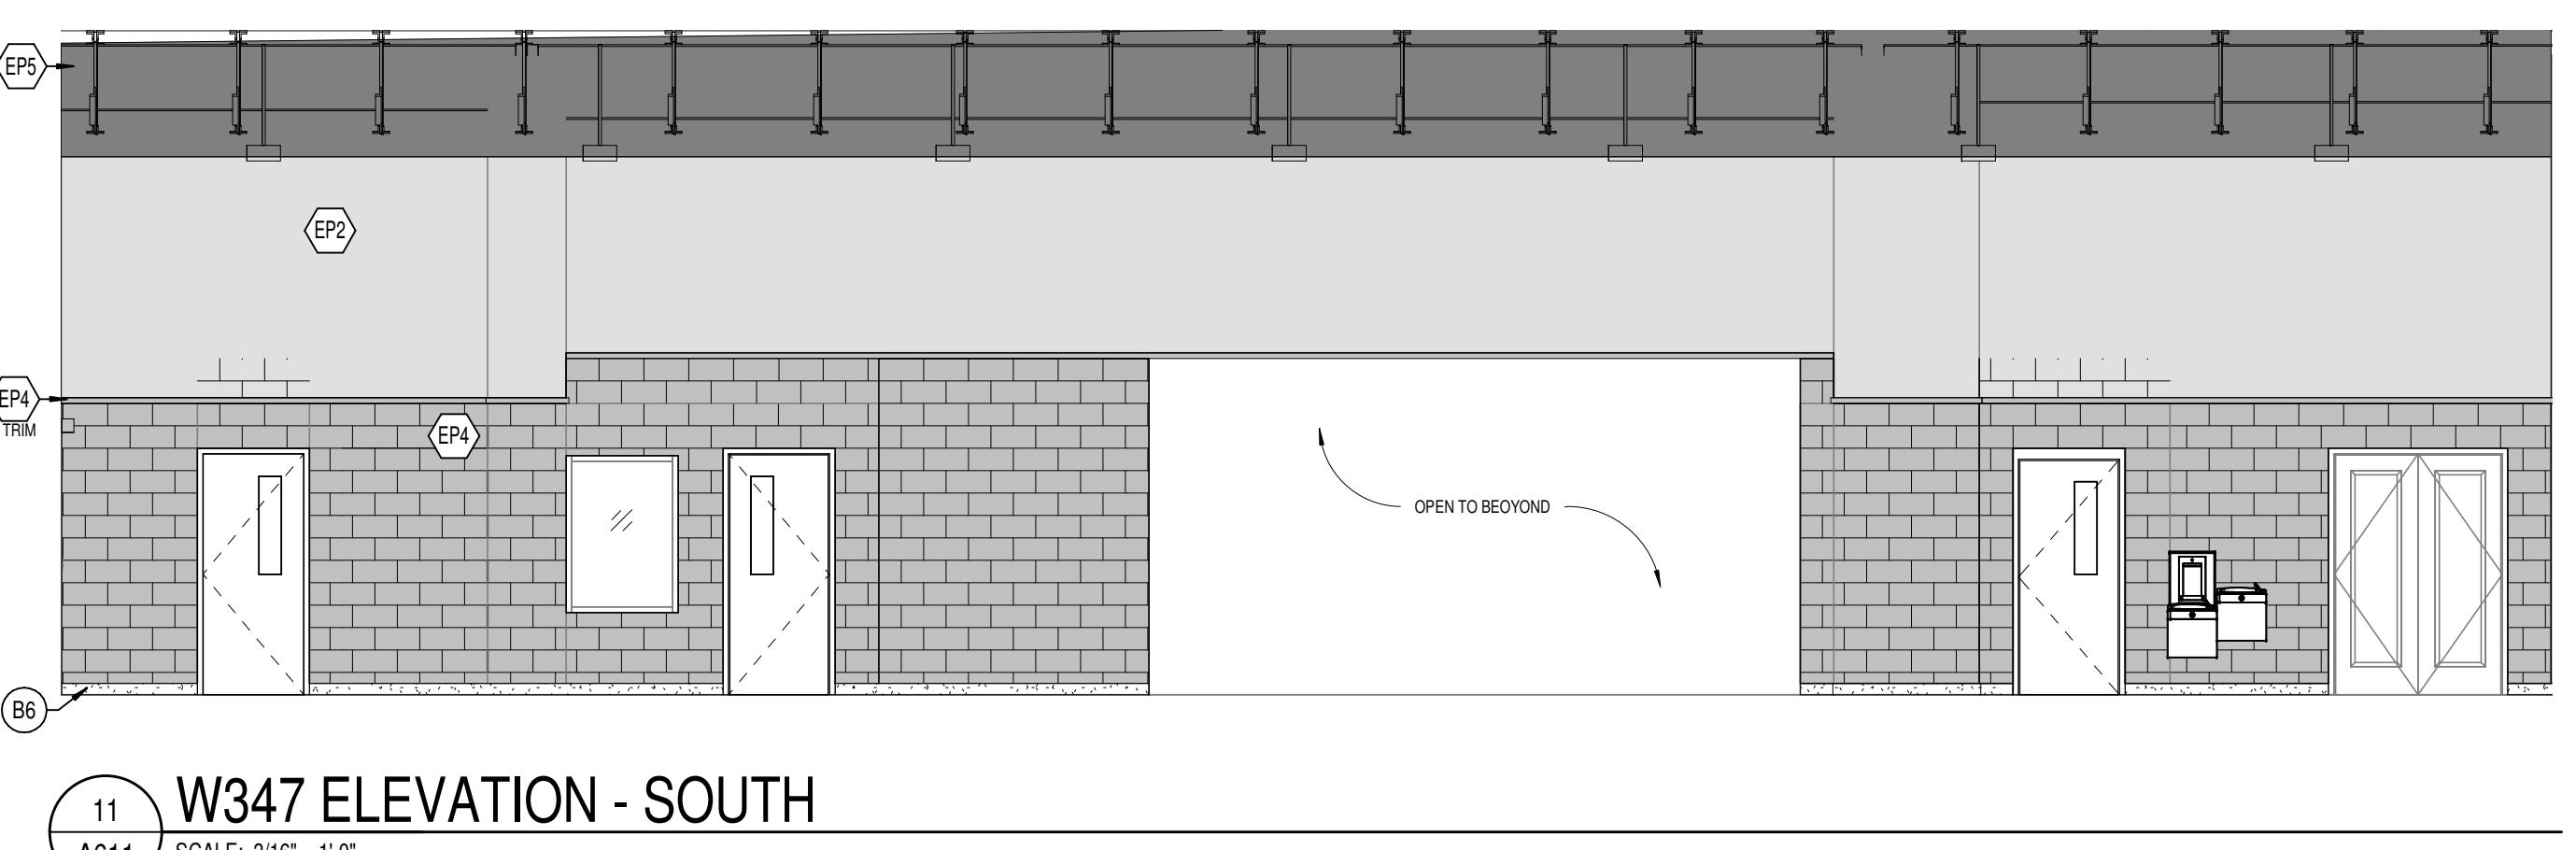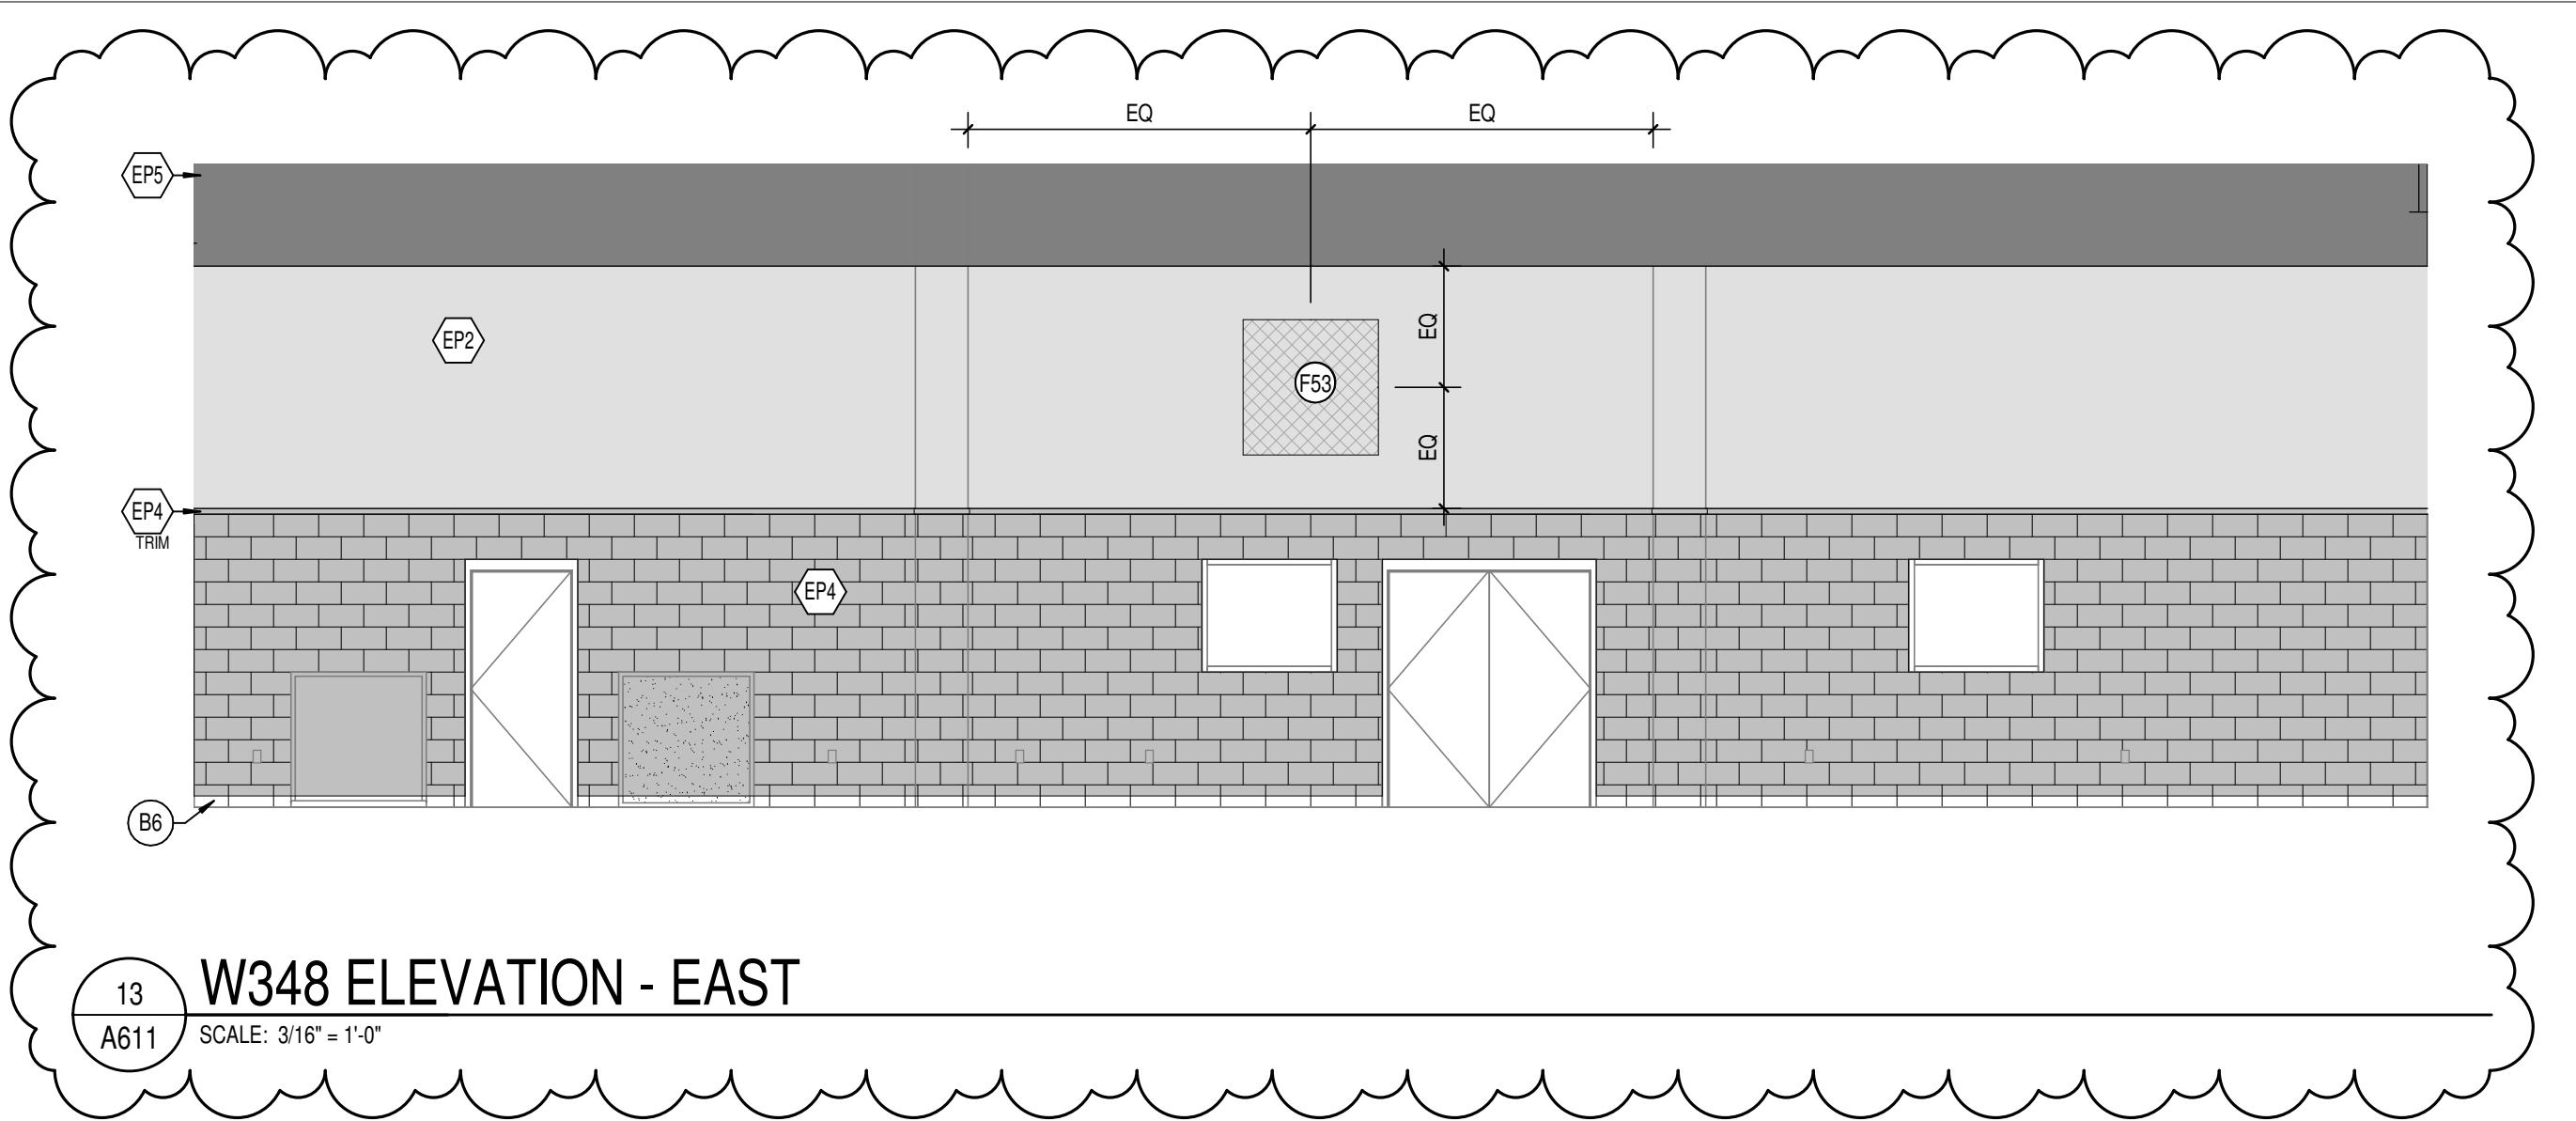







SCCSO  
SCCSO Architects, Inc. All Rights Reserved

8831 Keystone Crossing, Indianapolis, IN 46240  
317.648.7800 | cso.com

PROJECT:  
WARREN CENTRAL HIGH SCHOOL  
PHASE 3 ADDITION & RENOVATION  
9500 E. 16th STREET, INDIANAPOLIS, IN 46229

SCOPE DRAWINGS:  
These drawings contain the scope of the project in terms of architectural and design concept, the dimensions of structural, mechanical and electrical systems. The drawings are to be used for construction and to describe all the requirements of the Contract.

REVISIONS:  
1 ADDENDUM #2 03-13-2023

ISSUE DATE DRAWN BY CHECKED BY  
02-21-2023 Author Checker

DRAWING TITLE:  
ENLARGED RESTROOM PLANS

CERTIFIED BY:  
JAMES ROBERT FINK  
REGISTERED ARCHITECT  
No. AR00900003  
STATE OF INDIANA  
Signature

DRAWING NUMBER  
A702

PROJECT NUMBER  
2021056

## GENERAL NOTES

- A. COORDINATE THE WORK OF EACH TRADE WITH THE WORK OF OTHER TRADES.
- B. ALL WORK IS TO BE COMPLETED IN STRICT ACCORDANCE WITH ALL APPLICABLE CODES, ORDINANCES, RULES, REGULATIONS AND STANDARDS INCLUDING, BUT NOT LIMITED TO THOSE LISTED ON THE COVER SHEET. ALL APPLICABLE CODES & REGULATIONS ARE TO BE THE MOST CURRENT EDITION. ADDITIONAL CODES & REGULATIONS ARE TO BE VERIFIED BY THE CONTRACTOR.
- C. FIELD VERIFY EXISTING CONDITIONS AND DIMENSIONS PRIOR TO COMMENCEMENT OF WORK. DISCREPANCIES BETWEEN THE DOCUMENTS AND THE ACTUAL CONDITIONS SHALL BE BROUGHT TO THE ATTENTION OF THE ARCHITECT PRIOR TO THE COMMENCEMENT OF WORK.
- D. ALL DIMENSIONS ARE FROM CENTERLINE OF STRUCTURE, FINISH FACE OF WALL, FACE OF TOILET, OR FACE OF SINK.
- E. ANY DIMENSIONS NOT SHOWN OR NOT SHOWN AS EXACTABLE ARE TO BE VERIFIED BY ARCHITECT. DO NOT SCALE DRAWINGS.
- F. REFER TO WALL TO DECK SCHEDULE SHEET #2000, TO DETERMINE WHICH WALLS EXPOSED TO DECK SEE STRUCTURAL FLOOR SUPPORT DETAIL. WHERE APPROPRIATE, REFER TO DECK PROVIDE SUP CONNECTIONS FOR ROOF FLOOR DEFLECTION.
- G. ALL STEEL STUDS ARE TO BE BRACED ACCORDING TO MANUFACTURER LIMIT HEIGHT (1240).
- H. WHERE APPLICABLE, SOUND WALLS EXTEND TO DECK. FILL DECK FULFILS WITH INSULATION. SOUND ATTENUATION.
- I. REFER TO PLUMBING PLANS FOR LOCATION OF TOILET ROOM CHASES. FINAL LOCATIONS SHALL BE COORDINATED WITH OTHER TRADES PRIOR TO INSTALLATION.
- K. ALL CONCRETE MASONRY UNITS (CMU) SHALL BE LAID RUNNING BOND U.N.O. CMU WALLS THAT DO NOT LAY OUT IN FULL OR HALF LENGTHS SHOULD NOT EXCEED 12' IN LENGTH AND DO NOT HAVE ANY PIECES LESS THAN 4" IN SIZE EXPOSED TO VIEW.
- L. ALL INTERIOR MASONRY WALLS SHALL HAVE A 2" JAMB (U.N.O.) AT THE DECK TO BE FILLED WITH FIBERGLASS INSULATION. EXPOSED MASONRY WALLS SHALL BE COVERED WITH MINERAL WOOL AT THE NON-RATED WALLS TO ALLOW FOR DEFLECTION.
- M. THERE SHALL BE PERIMETER INSULATION CONTINUOUS AROUND THE ENTIRE PERIMETER OF THE BUILDING EXCLUDING 2'-0" MINUS 15 MIN. HORIZONTAL.
- N. PROVIDE MISCELLANEOUS SUPPORT FOR ALL CEILING SUSPENDED ITEMS.
- O. DOOR AND FRAME NUMBERS CORRESPOND TO ROOM NUMBERS. WHERE MORE THAN ONE DOOR OCCURS IN A ROOM A SUFFIX HAS BEEN ADDED (E.G. A10-1). SEE A500 SERIES DRAWINGS FOR DOOR SCHEDULE AND DETAILS.
- P. ALL DOOR FRAMES SHALL BE LOCATED 4" OFF FINISH WALLS OR OFF MASONRY WALLS. DOOR FRAMES ARE TO BE PLUMB.
- Q. ALL GLASS AT INTERIOR DOOR FRAMES, DOOR LITES AND WINDOW FRAMES IS TO BE 1/4" CLEAR TEMPERED GLASS UNLESS NOTED OTHERWISE.
- R. AT BULKHEAD EXPANSION JOINTS, ALL PARTITIONS, CEILINGS, FLOORS AND ALL WALL, FLOOR OR CEILING MOUNTED ITEMS SHALL BE ANCHORED TO THE BUILDING STRUCTURE ON ONLY ONE SIDE OF THE EXPANSION JOINTS. CONTRACTOR SHALL COORDINATE CONSTRUCTION OF INSTALLATION OF ALL ITEMS NOTED TO ASSURE THAT NO SUCH ITEMS BURDEN THE EXPANSION JOINTS.
- S. ALL SLAB-ON-GRADE CONTROL JOINTS TO BE CLEARED AND CAULKED PRIOR TO PLACEMENT OF FLOOR FINISH.
- T. SEE REFLECTED CEILING PLANS FOR BULKHEAD LOCATIONS AND DETAILS.
- U. REFER TO MECHANICAL DRAWINGS FOR WALL LOUVER LOCATIONS, SIZES AND QUANTITIES.
- V. SEE A800 SERIES DRAWINGS FOR FINISH SCHEDULE AND PLANS.
- W. SEE A900 SERIES DRAWINGS FOR EQUIPMENT SCHEDULE AND PLANS. PROVIDE BLOCKING IN STUD WALLS AND/OR GROUTED MASONRY CORES AS REQUIRED TO SUPPORT EQUIPMENT.
- X. PROVIDE FIRE RESISTANT HEAVY WOOD BLOCKING SUPPORTS AS REQUIRED BY THE LOCAL BUILDING CODE.
- Y. WHERE DISMILAR FLOOR MATERIALS MEET, THEY SHALL DO SO UNDER THE CENTERLINE OF THE DOOR UNLESS NOTED OTHERWISE.
- Z. APPLY SEALANT AT ALL JUNCTURES BETWEEN DIFFERENT MATERIALS (E.G. MASONRY, CONCRETE, METAL, ETC.). USE THE APPROPRIATE TYPE FOR SPECIFICATIONS. COLOR TO BE SELECTED BY ARCHITECT. APPLY SEALANT AT ALL COUNTERTOPS AND BLACKSPASHES AT JUNCTURE WITH WALL.
- AA. ALL EXISTING DOORS TO BE INSTALLED AT LEAST THE MINIMUM MANEUVERING CLEARANCE AT THE DOOR APPROACH PER THE MOST CURRENT AMERICANS WITH DISABILITIES ACT.
- BB. BASE FLOOR ELEVATION INDICATED FOR THIS PROJECT IS 100'-0". REFER TO A1000 SERIES DRAWINGS FOR FLOOR ELEVATION.
- CC. AT ALL NEW OR WIDENED OPENINGS IN EXISTING MASONRY WALLS, REMOVE ADDITIONAL WALL ABOVE OPENING AND INSTALL A NEW LINTEL SIMILAR TO THE REQUIREMENTS FOR A NEW MASONRY WALL. REFER TO THE STRUCTURAL DRAWINGS FOR ADDITIONAL INFORMATION. MASONRY INFILL SHALL MATCH ADJACENT CONSTRUCTION.

## GENERAL FINISH NOTES


1. ANY DISCREPANCIES WITHIN THE DOCUMENTS SHOULD BE BROUGHT TO THE ATTENTION OF CSO ARCHITECTS PRIOR TO INSTALLATION. THESE DOCUMENTS WILL GOVERN OVER PREVIOUS SUPPLEMENTAL DRAWINGS.
2. THE SCHEDULED MATERIALS SHALL NOT BE INSTALLED BEFORE THE CONTRACTORS ACTUAL COLOR SUBMITTALS HAVE BEEN APPROVED AS CALLED FOR IN THE SPECIFICATIONS. IF ANY MATERIAL IS INSTALLED BEFORE APPROVAL, THE CONTRACTOR WILL BE RESPONSIBLE FOR ALL ERRONEOUS SPECIFICATIONS.
3. ALL SURFACES RECEIVING FINISHES SHALL BE PROPERLY PREPARED PER MFR'S SPECIFICATIONS PRIOR TO INSTALLATION. CONTRACTOR RESPONSIBLE FOR FIELD VERIFYING CONDITIONS.
4. WHERE DEMOLITION OCCURS, SURFACE IS TO BE PROPERLY PATCHED AND REPAIRED TO MATCH SURROUNDING SURFACES BEFORE FINISH IS APPLIED.
5. CONTRACTOR RESPONSIBLE FOR PROTECTING EXISTING FINISHES TO REMAIN DURING CONSTRUCTION. ALL SURFACES TO REMAIN SHALL BE PROPERLY CLEANED.
6. WHEN FLOOR FINISHES TRANSITION AT DOOR OPENING, TRANSITION IS TO OCCUR AT CENTER OF THE DOOR PANEL, U.N.O.
7. FOR CHANGE IN FLOOR FINISH MATERIAL TYPE, PROVIDE TRANSITION STRIP. CONTRACTOR TO SUBMIT COLOR SAMPLES FROM MFR'S FULL LINE OF RUBBER TRANSITION STRIPS TO DESIGNER FOR SELECTION. TRANSITION TO BE NARROWEST PROFILE AVAILABLE THAT MEETS CODE/ADA COMPLIANCE, U.N.O.
8. SEE INTERIOR PAINT SPECIFICATIONS FOR COATING SCHEDULE PER SUBSTRATE.
9. PAINT WALLS BEFORE INSTALLING ANY WALL-MOUNTED EQUIPMENT.
10. ANY LOCATION RECEIVING A VINYL WALLCOVERING MUST HAVE A LEVEL 5 FINISH PRIOR TO INSTALLATION OF WALLCOVERING.
11. ALL OUTSIDE GWT CORNERS TO RECEIVE SURFACE-MOUNTED CORNER GUARDS FROM TOP OF BASE TO 7'-0" AFF. U.N.O. COLOR SELECTED FROM MFR'S FULL RANGE.
12. ALL WALL MOUNTED GRILLES, METAL PANELS, MISC. METALS, ETC ARE TO BE PAINTED TO MATCH THE ADJACENT WALL FINISH, U.N.O.
13. ALL HOLLOW METALS DOORS & WINDOW, DOOR, & APPLICABLE DISPLAY CASE FRAMES TO RECEIVE FINISH TO MATCH PG. BOTH SIDES. SEE SPECIFICATIONS FOR PAINT TYPE & SHEEN.
14. WOOD DOORS TO BE PLAIN-SLICED WHITE BIRCH, STAINED TO MATCH NEW DOORS FROM PHASE 1 & 2 MATCHING 9TH GRADE ACADEMY. CONTRACTOR TO SUBMIT SAMPLES FOR APPROVAL. SEE SPECIFICATIONS FOR ADDITIONAL INFO.
15. ALL WINDOW STOOLS ARE TO BE SSA.
16. WHERE WALL TILE OCCURS, ALL OUTSIDE CORNERS RECEIVE SCHLUTER FINES IN SATIN ANODIZED ALUMINUM & ALL EXPOSED EDGES RECEIVE SCHLUTER SCHEMATICALLY IN SATIN ANODIZED ALUMINUM. U.N.O. WALL TILE TO BE INSTALLED WITH MINIMUM RECOMMENDED GROUT THICKNESS PER TILE MFR.
17. ALL GWT CEILINGS/SOFTS/BULKHEADS TO HAVE FACES PAINTED TO MATCH ADJACENT WALLS & UNDERSIDE TO BE PAINTED P.T. U.N.O.
18. NO PAINT IS TO BE INSTALLED ON EXISTING ARCHITECTURAL FINISHES (BRICK, CONCRETE, METAL, ETC.). EXCEPION TO THIS IS EXISTING METAL GLAZED TILE. SST TO BE PAINTED OR REPAINTED. REFER TO THE CONTRACTOR'S RECOMMENDATIONS OF COATING MFR. GC TO VERIFY WITH ARCHITECT PRIOR TO WORK IF THERE IS AN AREA IN QUESTION.
19. AT CEILING LOCATIONS INDICATED ON RCP TO BE EXPOSED & PAINTED, ALL CONSTRUCTION SHALL BE PAINTED INCLUDING STRUCTURE, DUCT WORK, CONDUIT, DECK, PIPING, HANGERS, ETC. ITEMS WITH SPECIFIC PAINT REQUIREMENTS DETAILED IN OTHER SPECIFICATIONS ARE TO BE PAINTED OR NOT ACCORDINGLY. DO NOT PAINT ANY DATA CABLE LOW VOLTAGE WIRING.
20. ALL WALL-MOUNTED CONDUIT, PIPE, ETC TO BE PAINTED TO MATCH WALL. ITEMS WITH SPECIFIC PAINT REQUIREMENTS DETAILED IN OTHER SPECIFICATIONS SHALL BE PAINTED OR NOT ACCORDINGLY. DO NOT PAINT ANY DATA OR LOW VOLTAGE WIRING.
21. CORNER GUARD COLORS TO BE SELECTED FROM MFR'S FULL RANGE UNLESS SPECIFIED OTHERWISE IN DRAWINGS. SEE 900 SERIES AND SPECIFICATION FOR ADDITIONAL INFORMATION AND LOCATIONS.

## ENLARGED RESTROOM PLAN

7 A702 SCALE: 1/4" = 1'-0"


## ENLARGED RESTROOM PLAN

7 A702 SCALE: 1/4" = 1'-0"

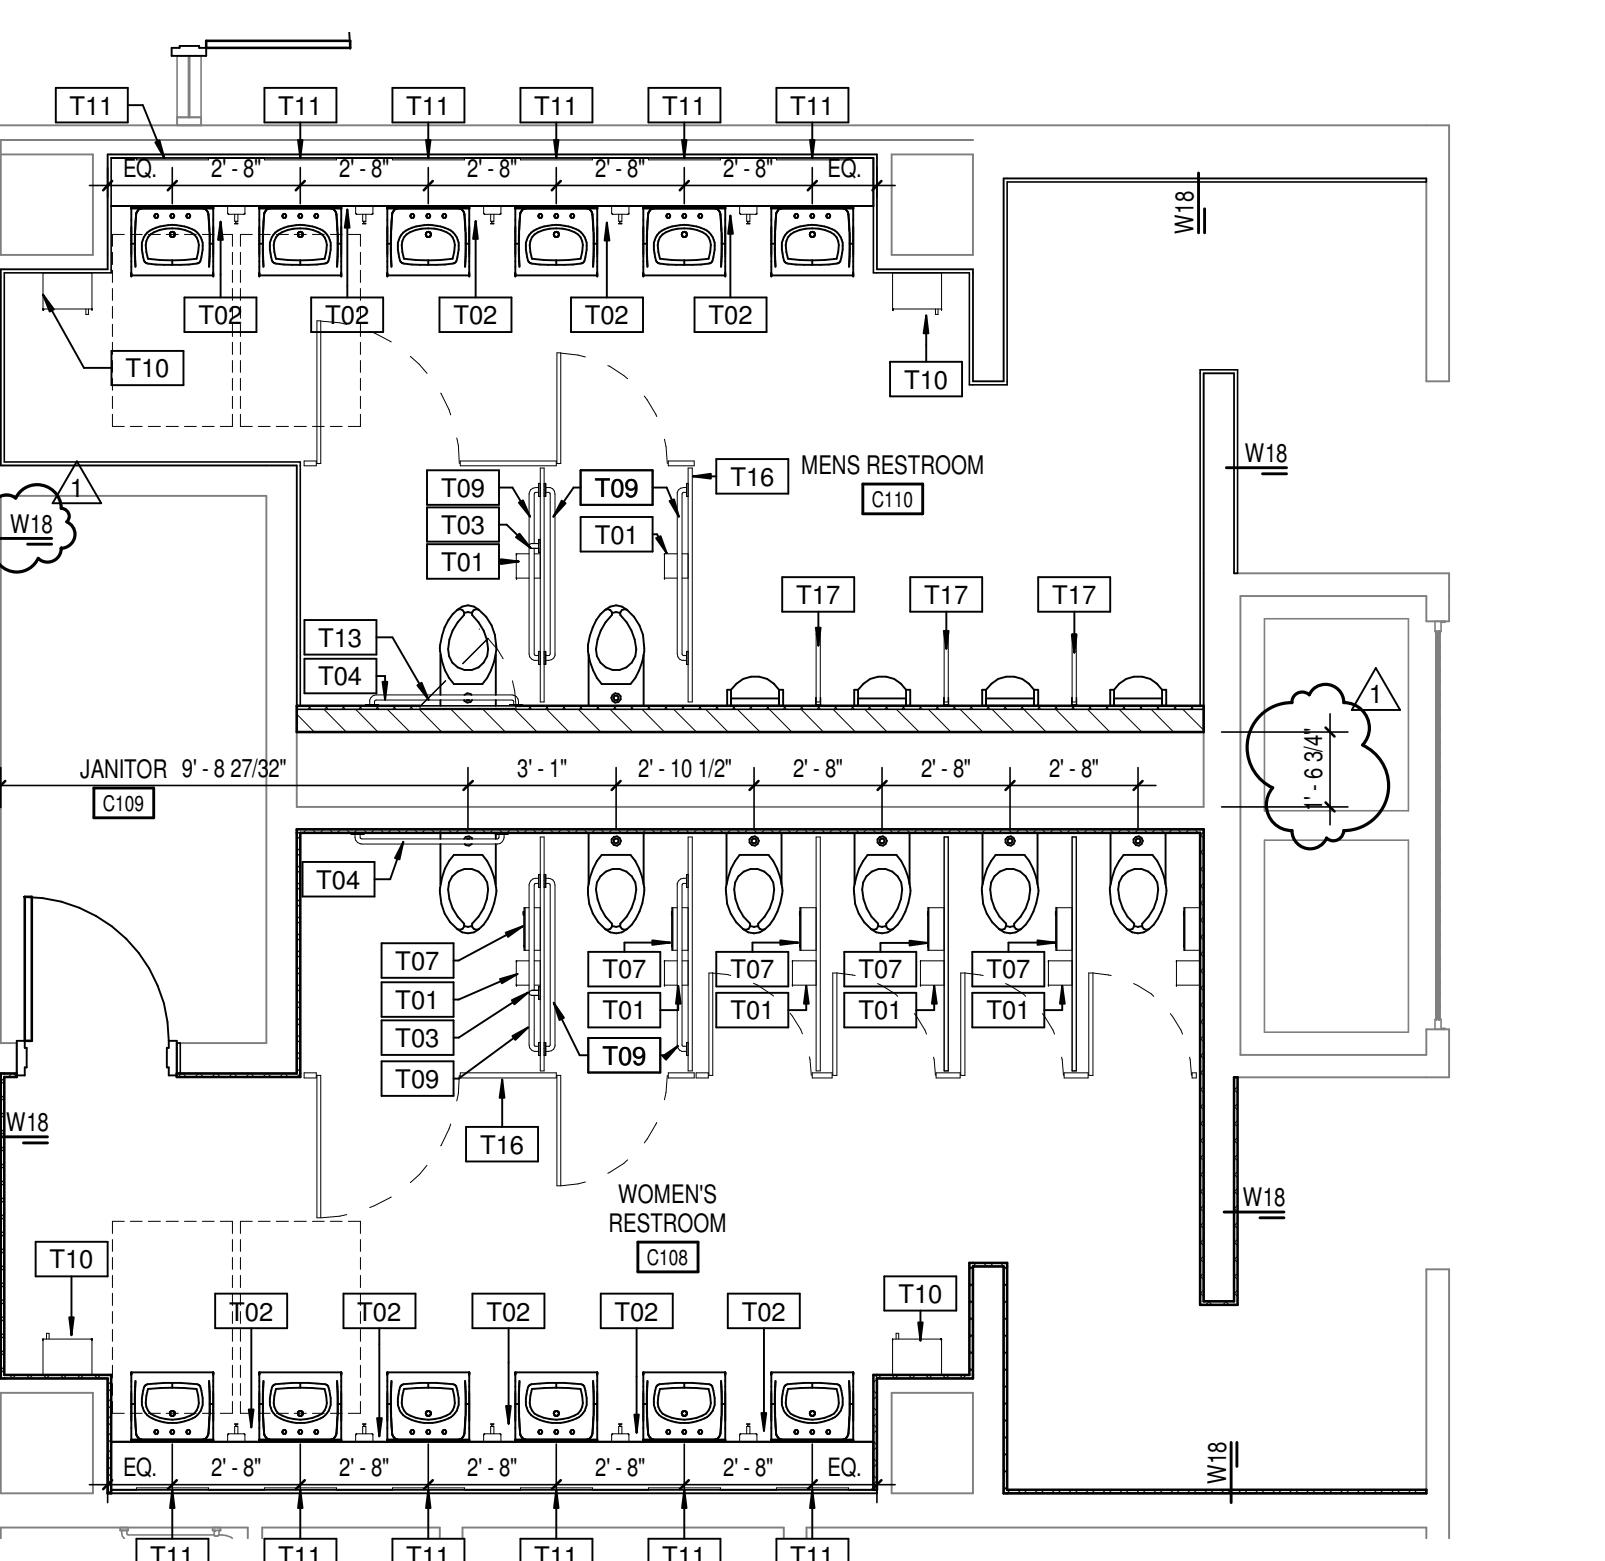


## ENLARGED RESTROOM PLAN

4 A702 SCALE: 1/4" = 1'-0"

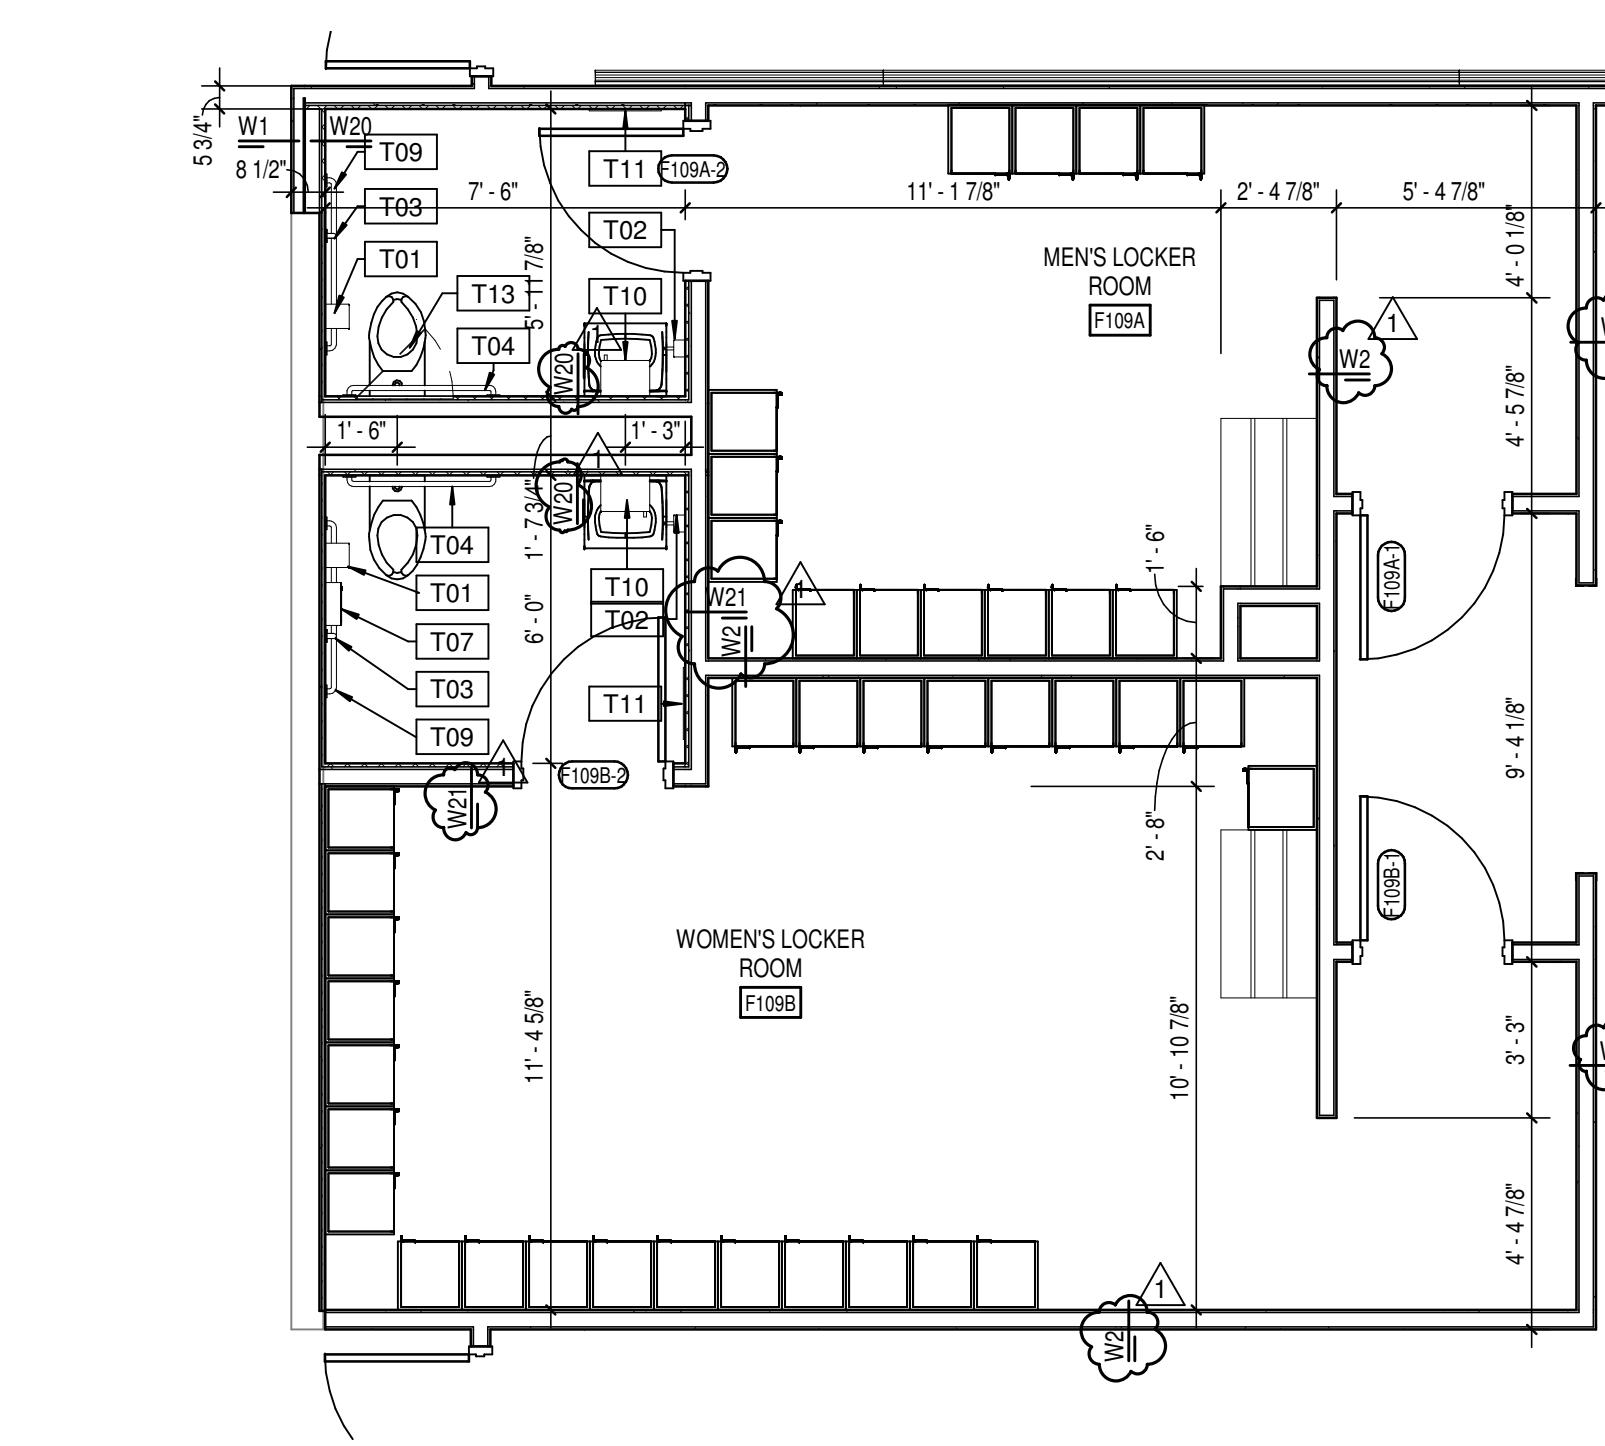


## ENLARGED LOCKER/ RESTROOM PLAN

1 A702 SCALE: 1/4" = 1'-0"

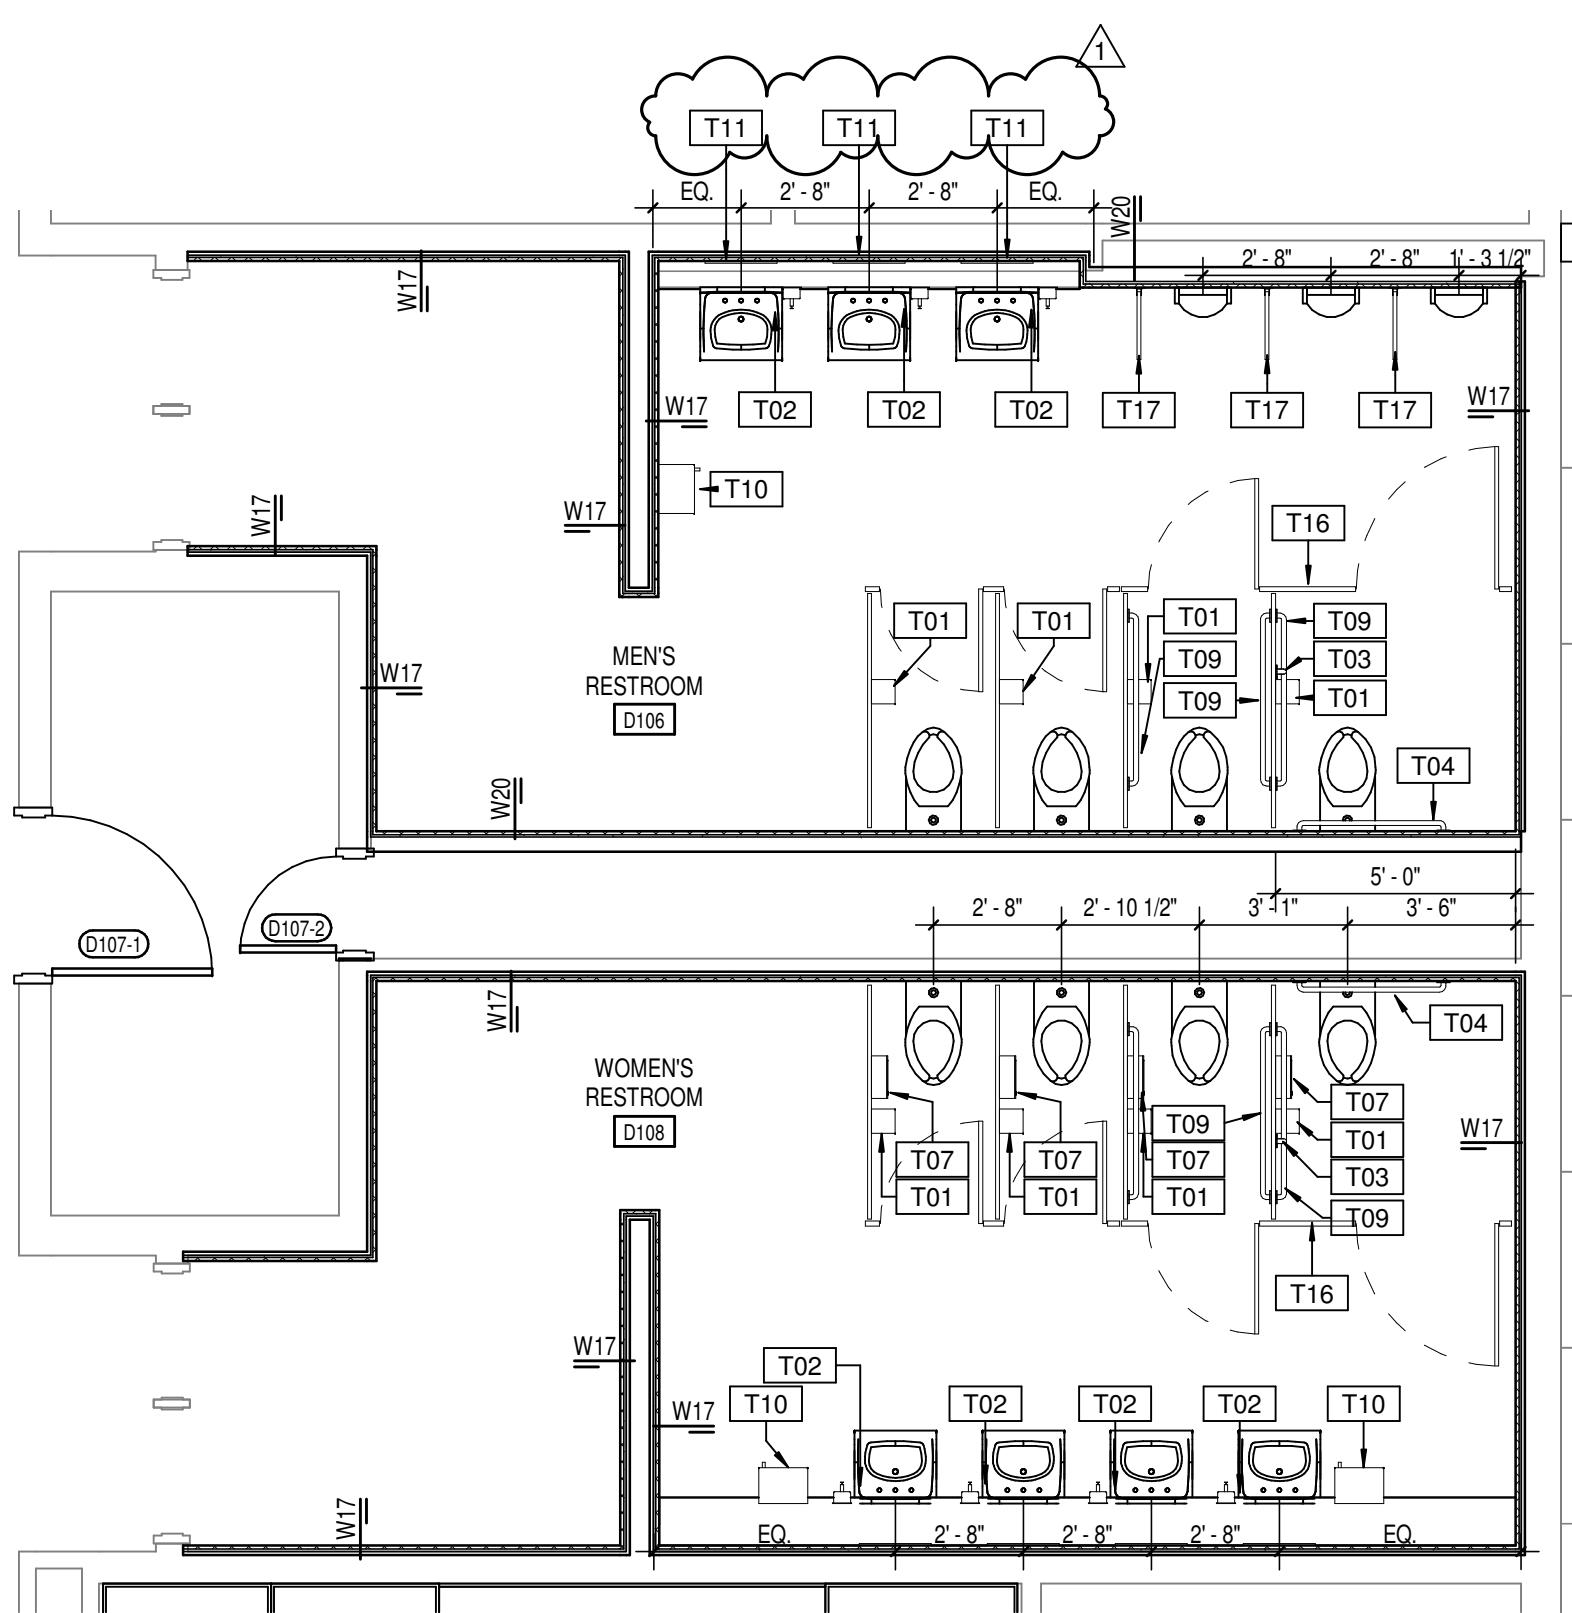


## ENLARGED RESTROOM PLAN

9 A702 SCALE: 1/4" = 1'-0"

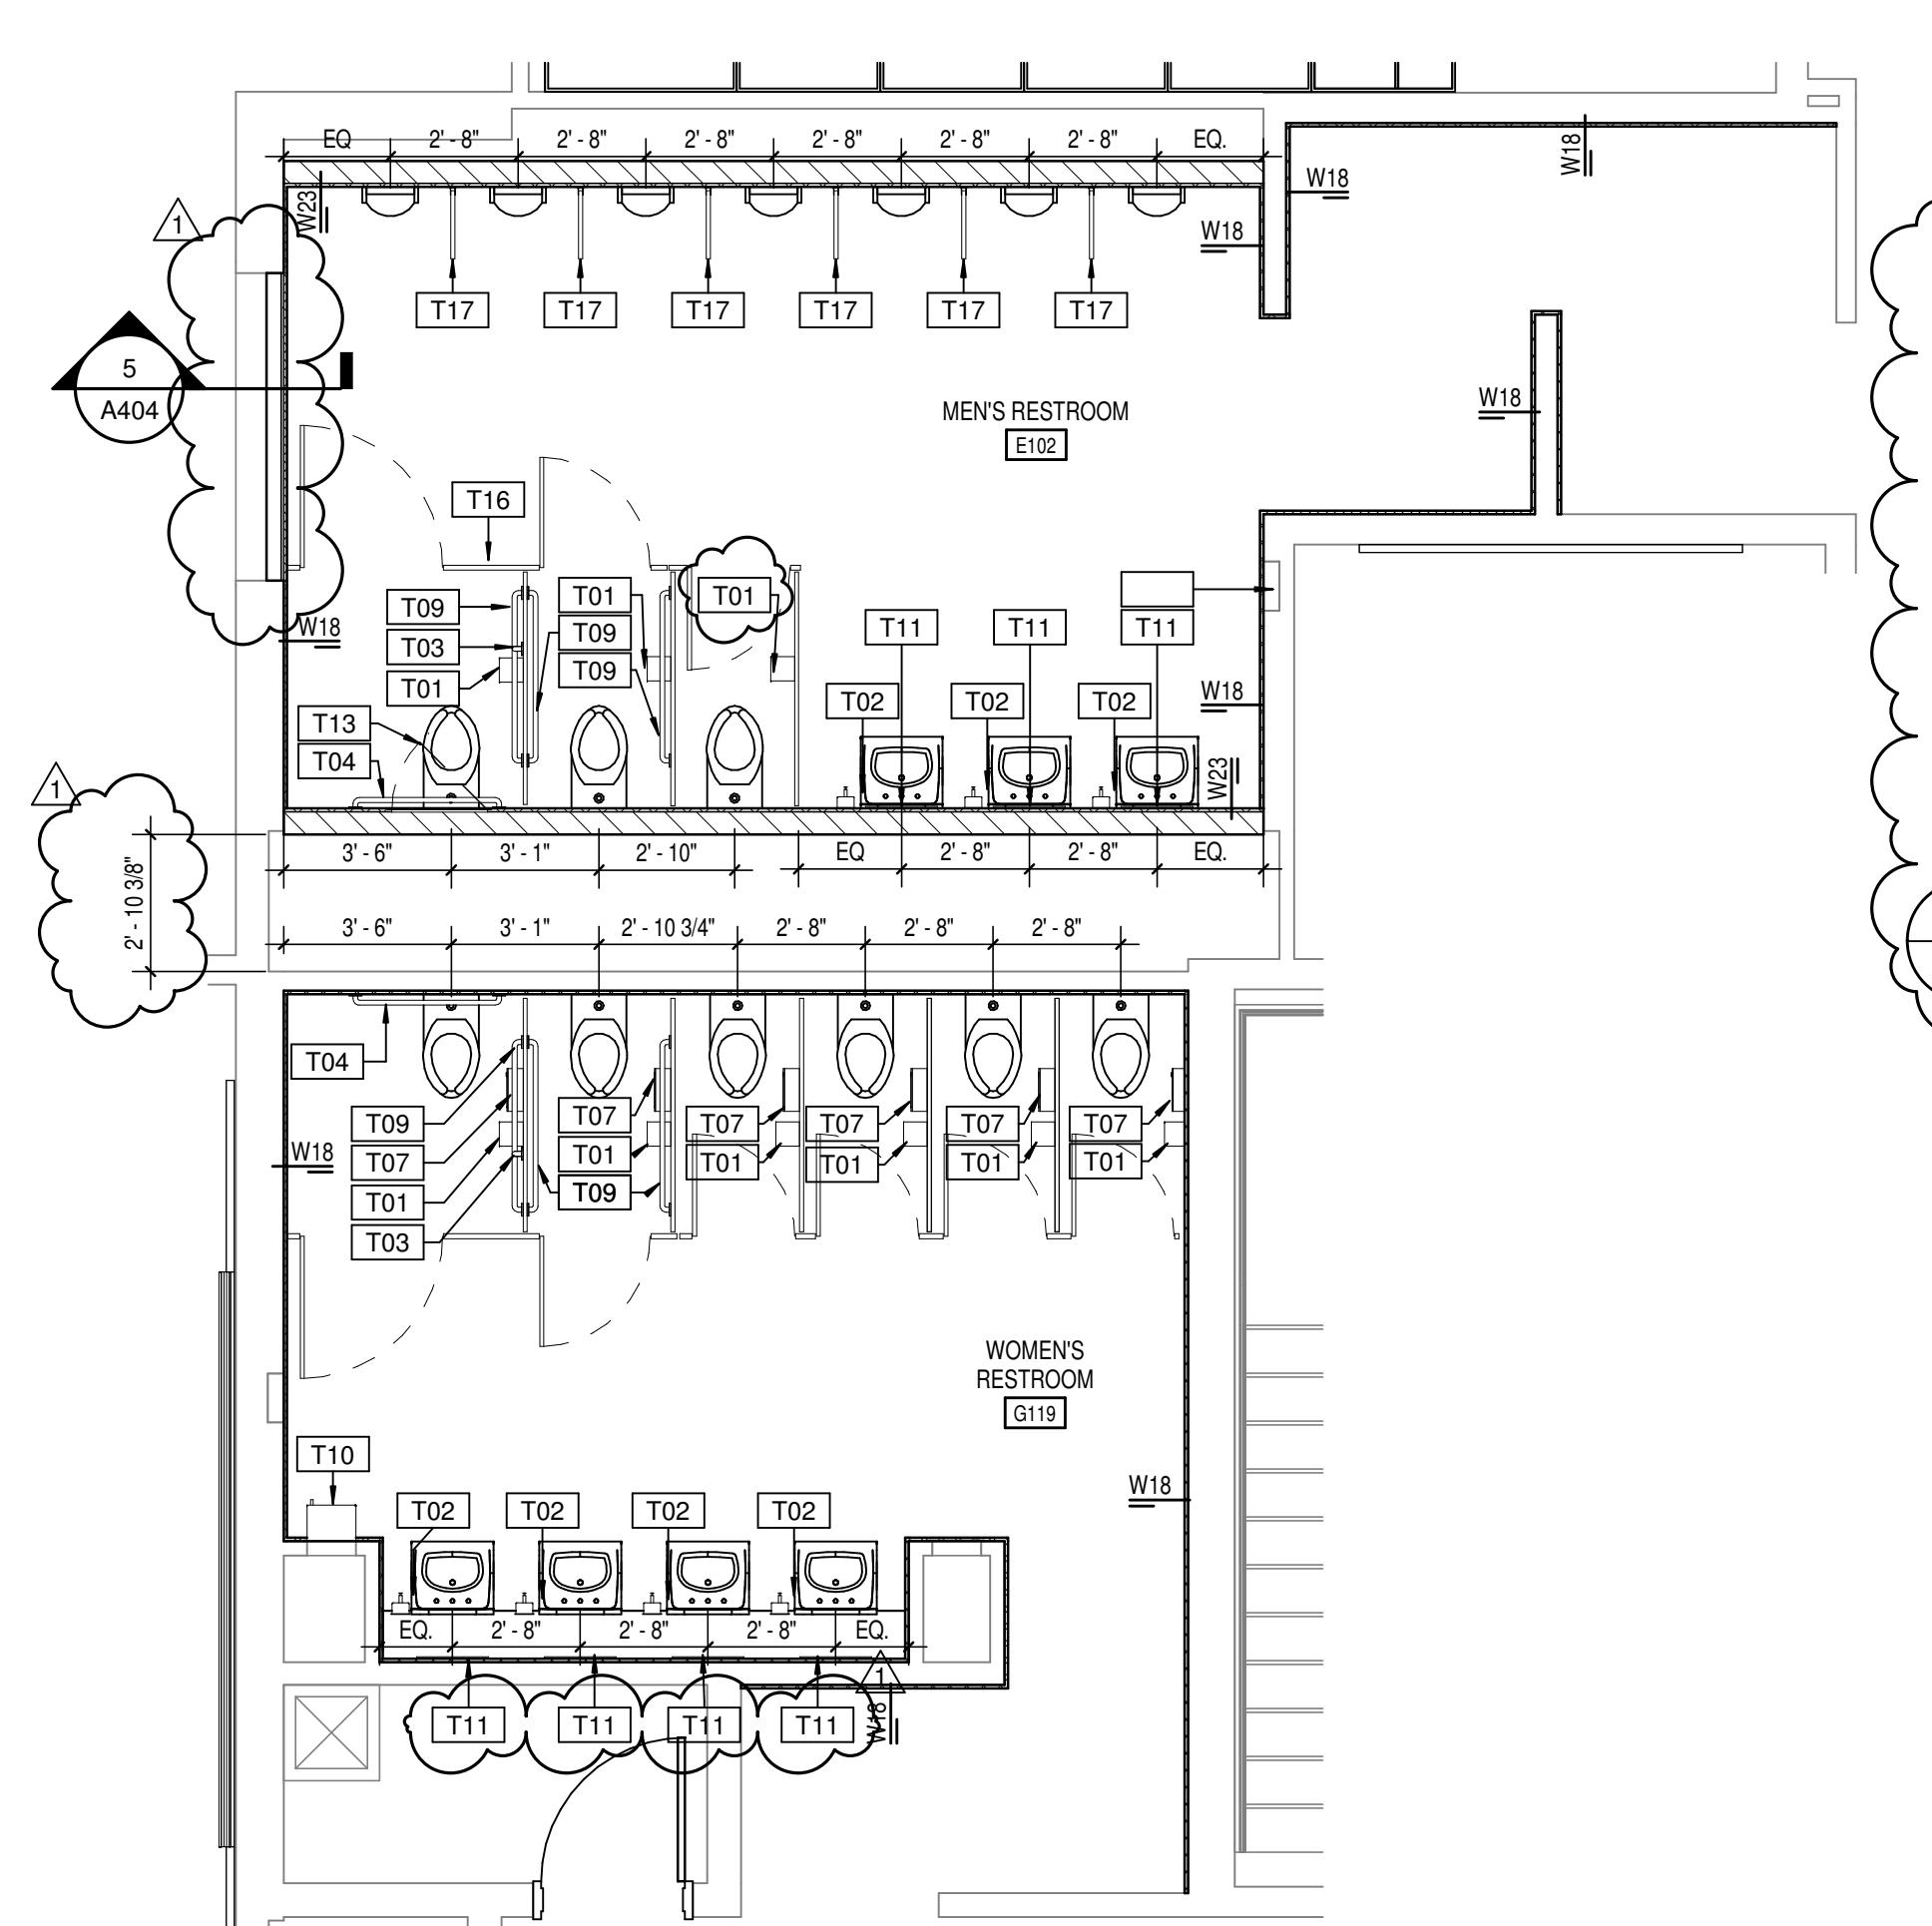


## ENLARGED RESTROOM PLAN

8 A702 SCALE: 1/4" = 1'-0"

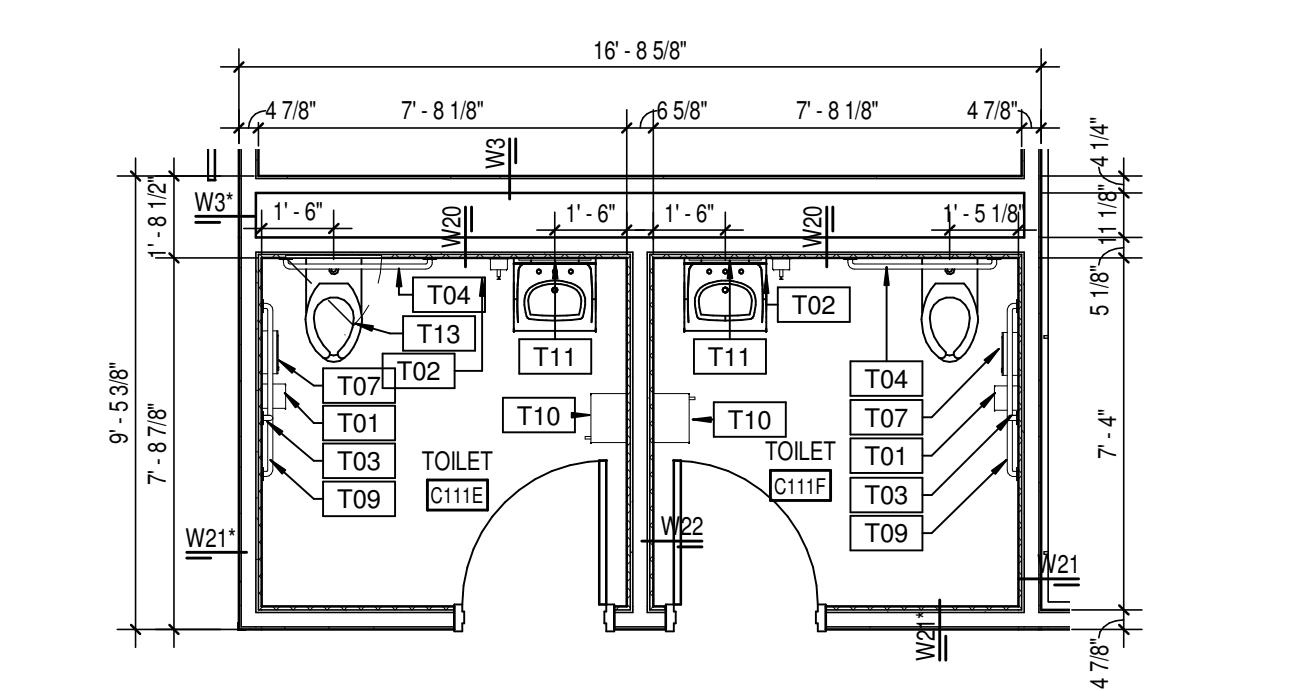


## ENLARGED RESTROOM PLAN

5 A702 SCALE: 1/4" = 1'-0"

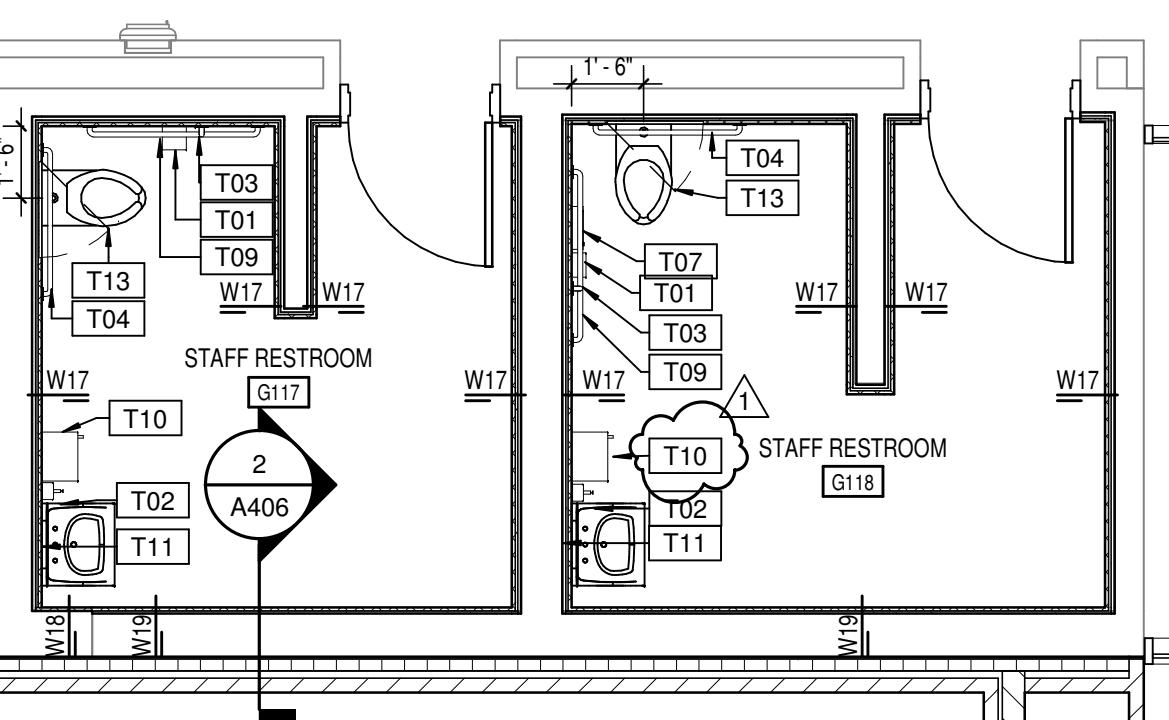


## ENLARGED RESTROOM PLAN

6 A702 SCALE: 1/4" = 1'-0"

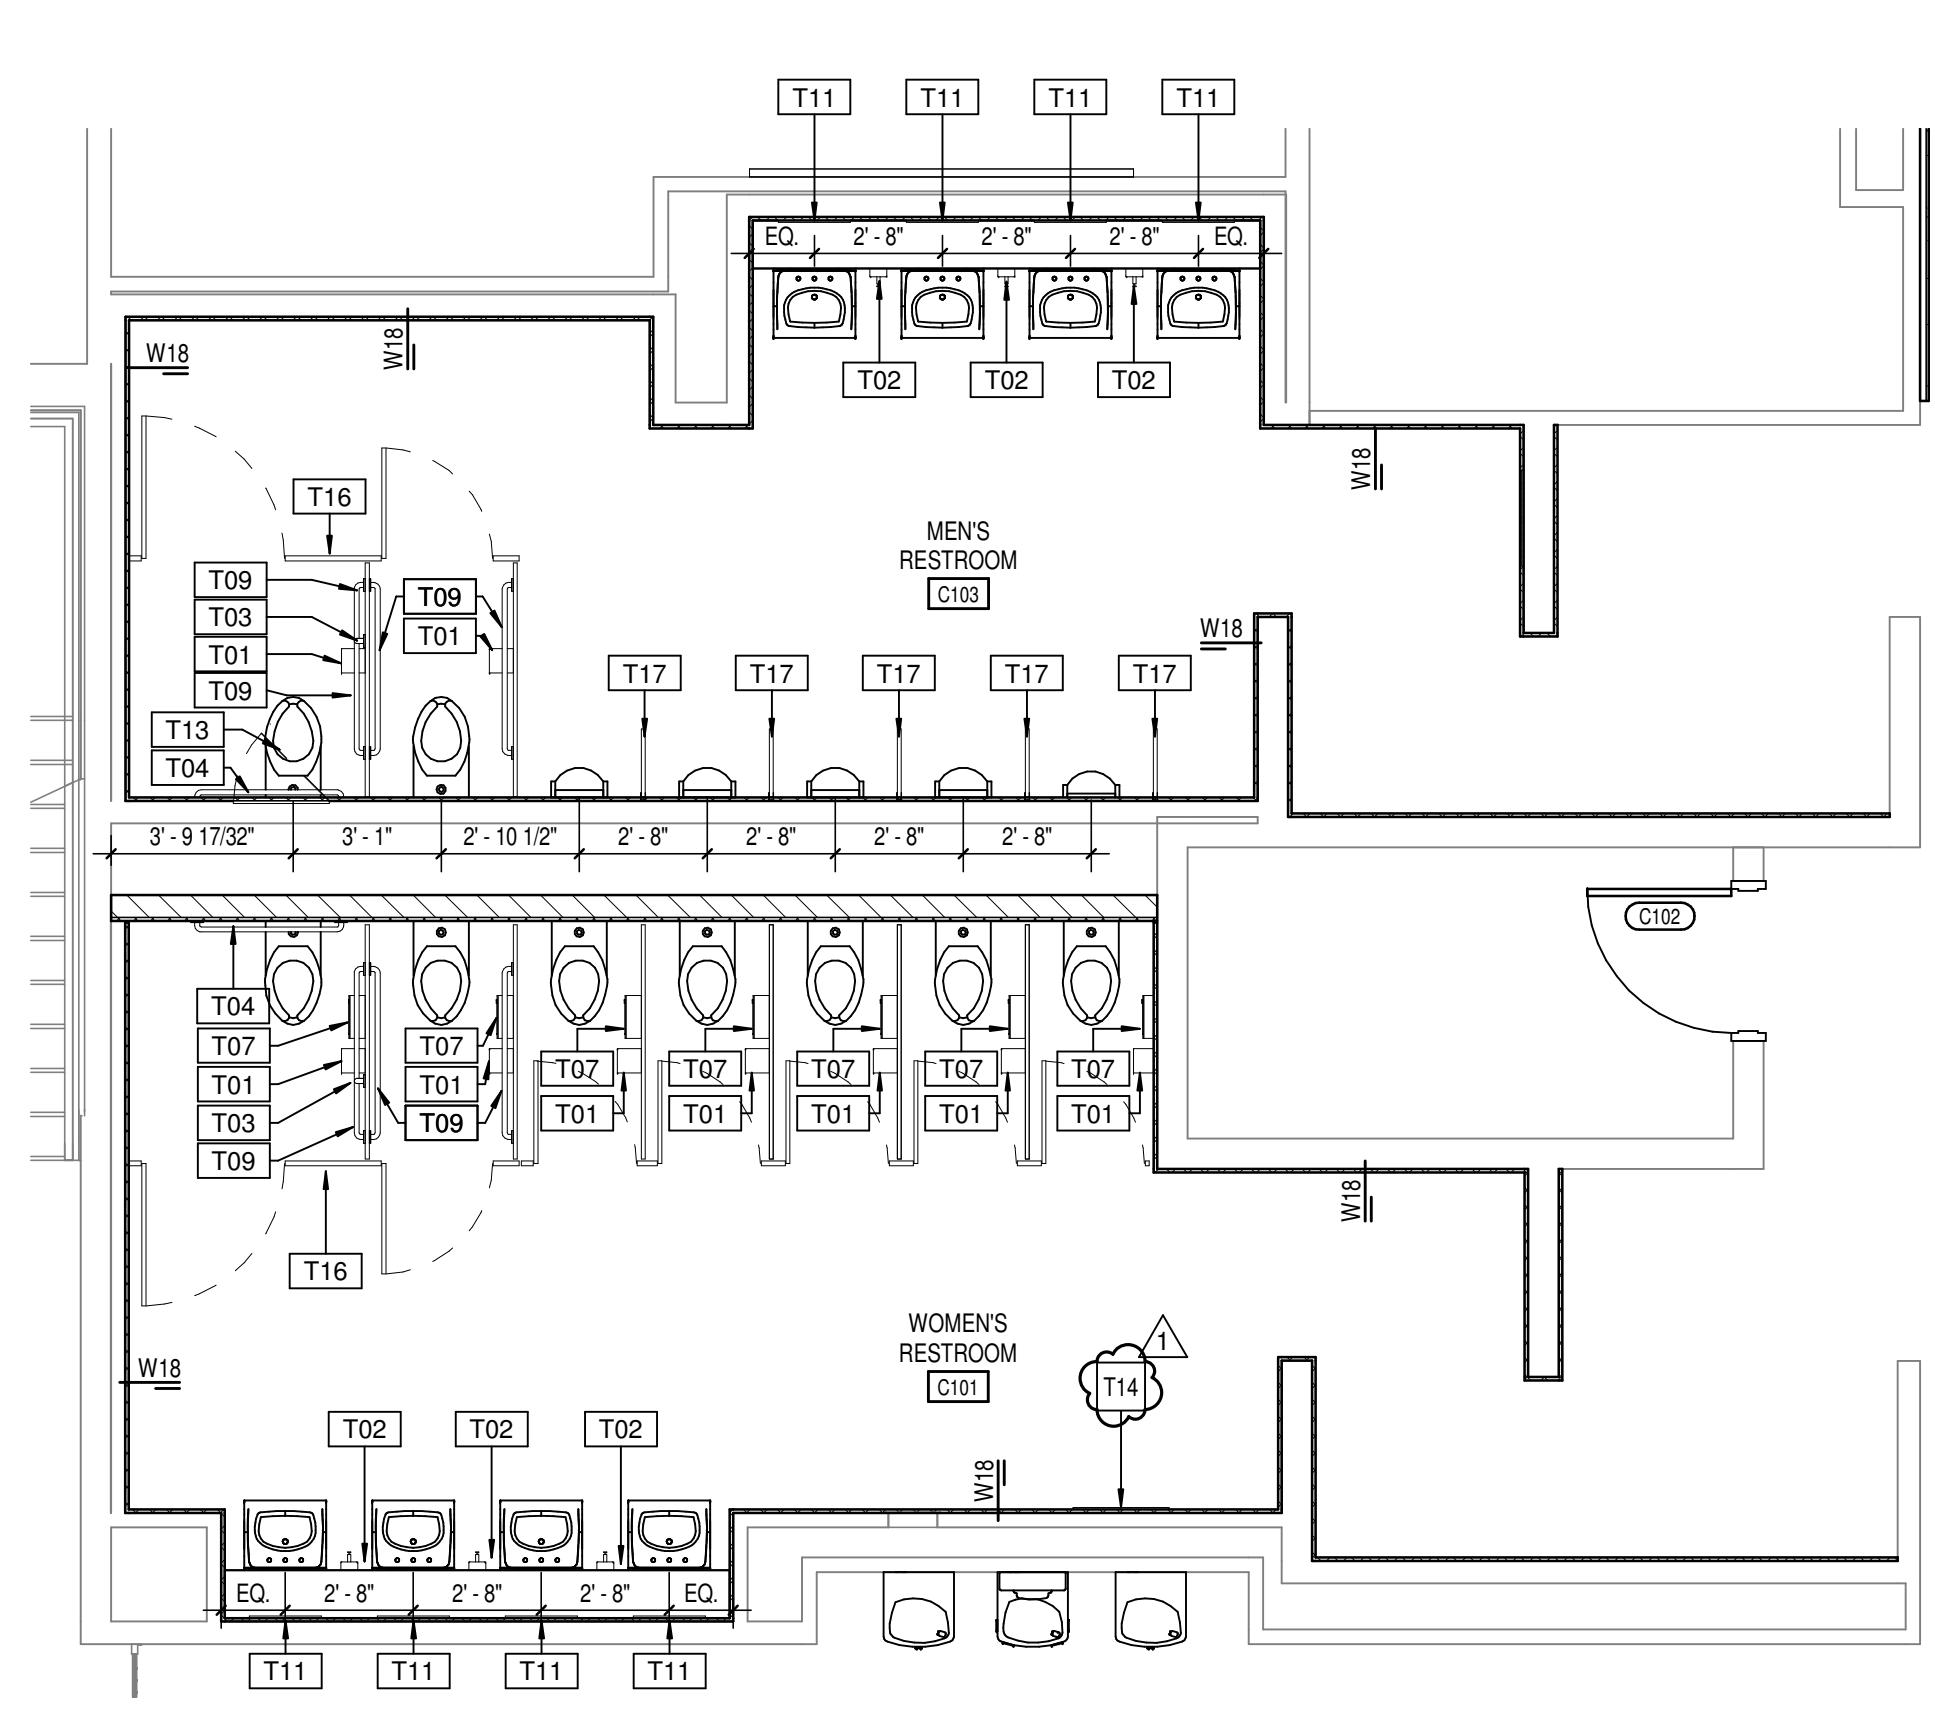

## ENLARGED RESTROOM PLAN

3 A702 SCALE: 1/4" = 1'-0"

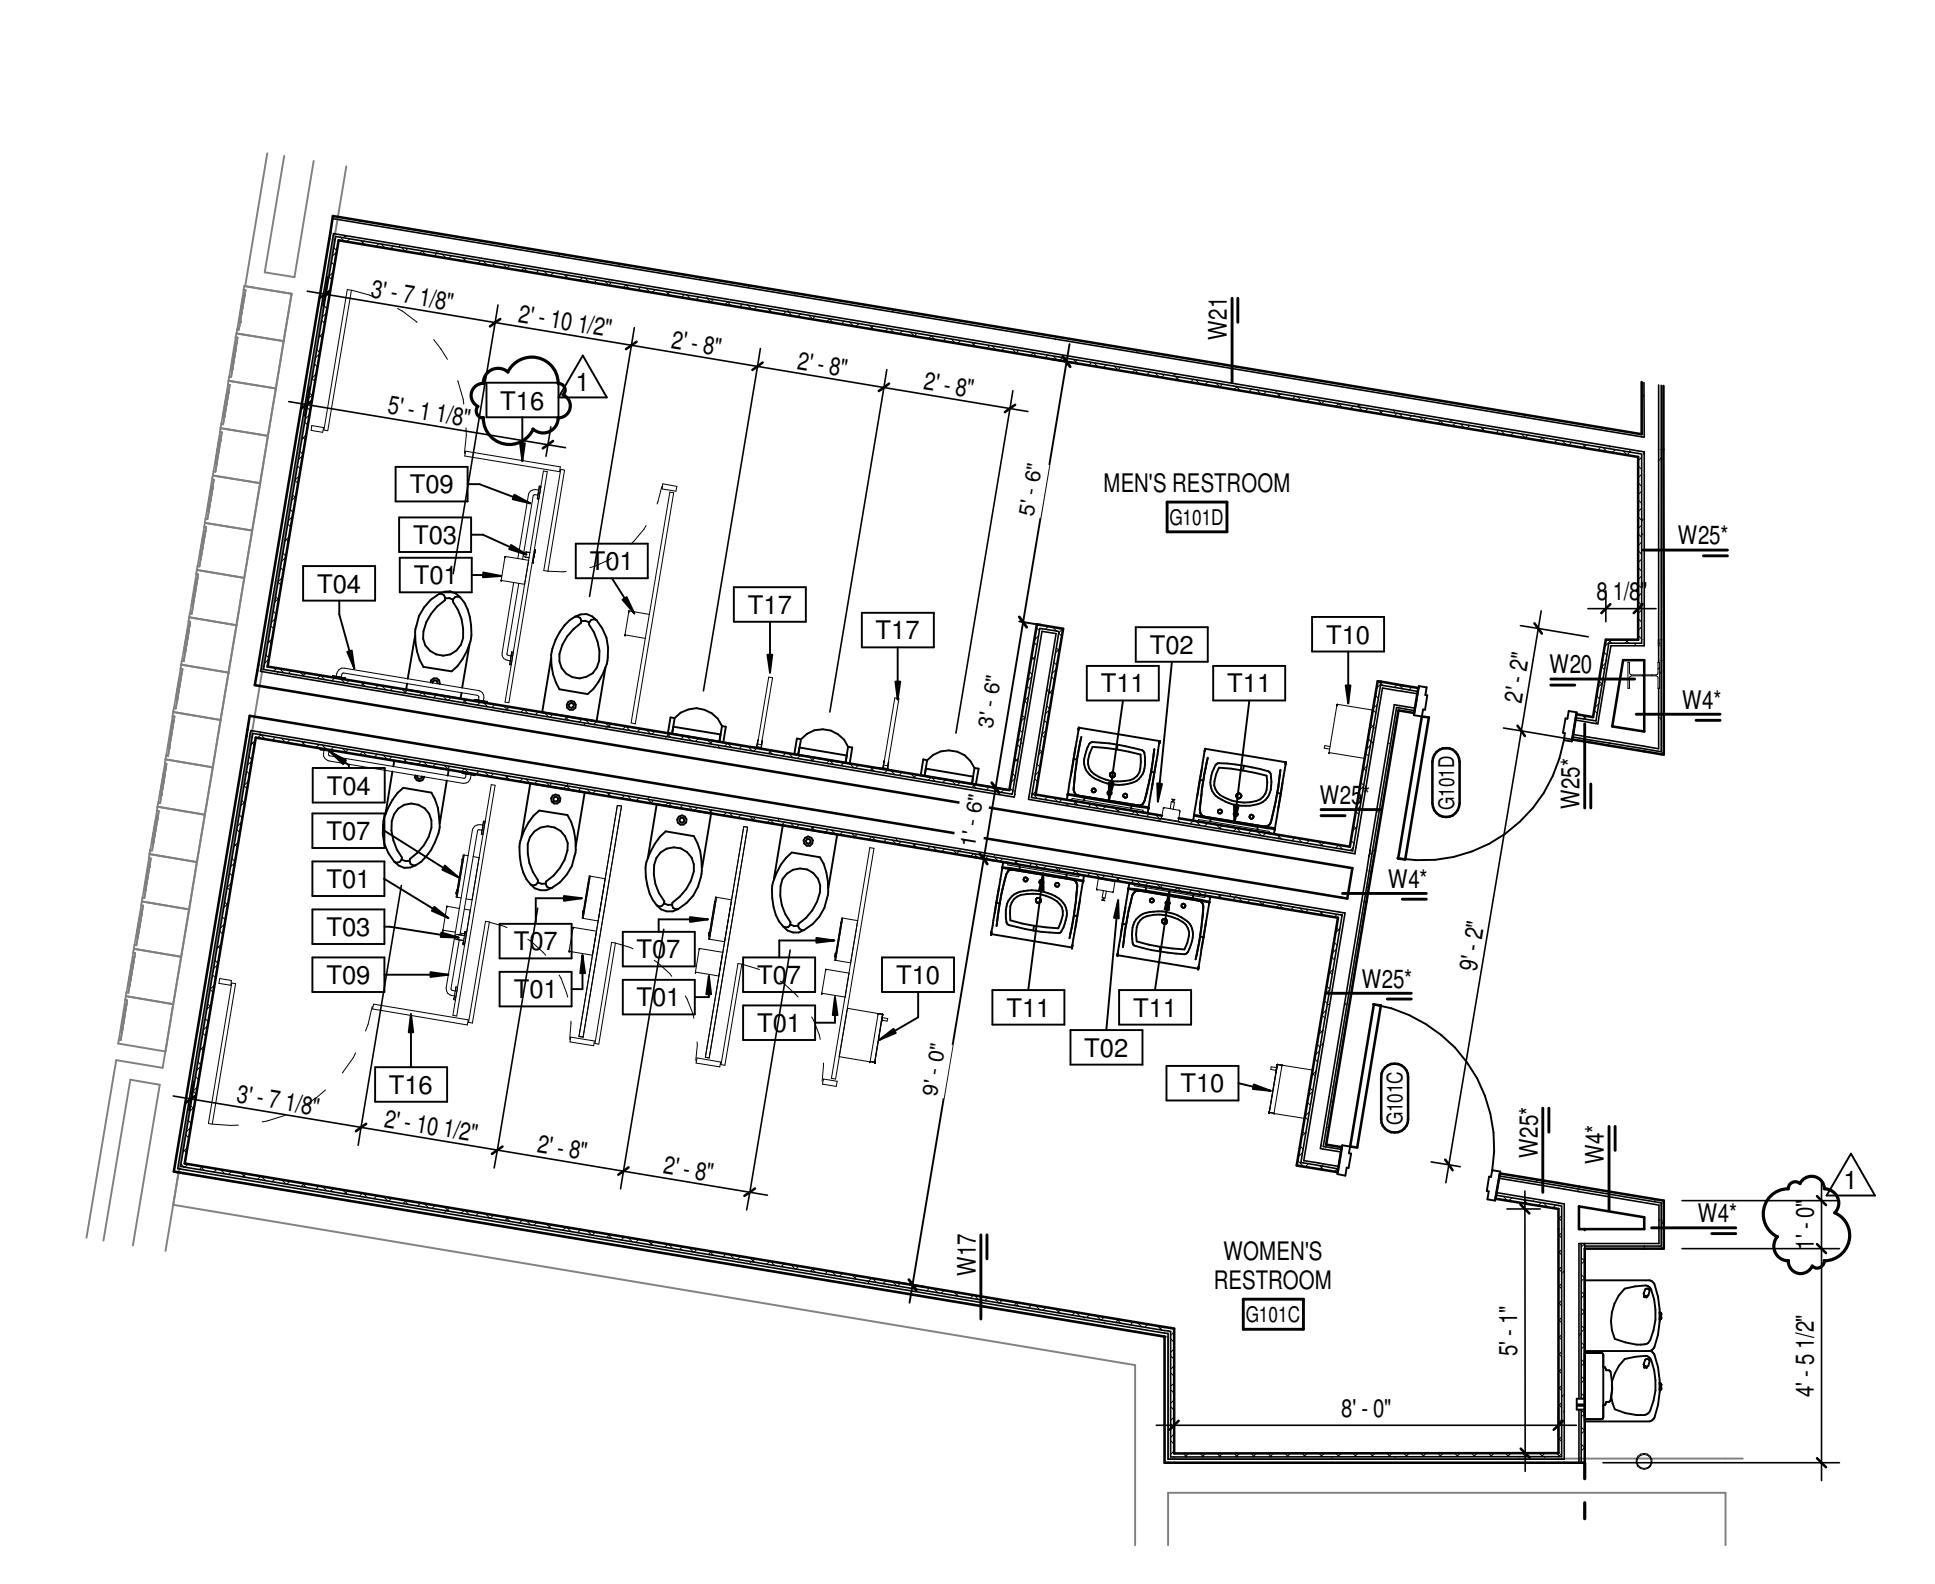

## ENLARGED RESTROOM PLAN

2 A702 SCALE: 1/4" = 1'-0"



SCCSO  
3831 Keystone Crossing, Indianapolis, IN 46240

© 2020 CCSO Architects, Inc. All Rights Reserved

## GENERAL NOTES

- A. COORDINATE THE WORK OF EACH TRADE WITH THE WORK OF OTHER TRADES.
- B. ALL WORK IS TO BE COMPLETED IN STRICT ACCORDANCE WITH ALL APPLICABLE CODES, ORDINANCES, RULES, REGULATIONS AND STANDARDS INCLUDING, BUT NOT LIMITED TO THOSE LISTED ON THE COVER SHEET. ALL APPLICABLE CODES & REGULATIONS ARE TO BE THE MOST CURRENT EDITION. ADDITIONAL CODES & REGULATIONS ARE TO BE THE ATTENTION OF THE ARCHITECT PRIOR TO THE COMMENCEMENT OF WORK.
- C. FIELD VERIFY EXISTING CONDITIONS AND DIMENSIONS PRIOR TO COMMENCEMENT OF WORK. DISCREPANCIES BETWEEN THE DOCUMENTS AND THE ACTUAL CONDITIONS SHALL BE BROUGHT TO THE ATTENTION OF THE ARCHITECT PRIOR TO THE COMMENCEMENT OF WORK.
- D. ALL DIMENSIONS ARE FROM CENTERLINE OF STRUCTURE, FINISH FACE OF WALL, FACE OF DRAINS, OR FACE OF FLOOR.
- E. ANY DIMENSIONS NOT PROVIDED OUTSIDE ARE TO BE VERIFIED BY ARCHITECT. DO NOT SCALE DRAWINGS.
- F. REFER TO WALL TYPE SCHEDULE SHEET A200, TO DETERMINE WHICH WALLS EXTEND TO DECK. SEE STRUCTURAL FOR SUPPORT DETAIL. WHERE NOT EXTENDED TO DECK, PROVIDE SUP CONNECTIONS FOR ROOF FLOOR DEFLECTION.
- G. ALL STEEL STUDS ARE TO BE BRACED ACCORDING TO MANUFACTURER LIMIT HEIGHT (244).
- H. WHERE APPLICABLE, ALL FLOOR AND CEILINGS SHALL BE BRACED. ALL FLOOR FRAMES SHALL BE BRACED ACCORDING TO MANUFACTURER LIMIT HEIGHT (244).
- I. REFER TO PLUMBING PLANS FOR LOCATION OF FLOOR DRAINS.
- J. WHERE ACCESS PANELS ARE SHOWN IN TOILET ROOM CHASES, FINAL LOCATIONS SHALL BE COORDINATED WITH OTHER TRADES PRIOR TO INSTALLATION.
- K. ALL CONCRETE MASONRY UNITS (CMU) SHALL BE LAID RUNNING BOND U.N.O. CMU WALLS THAT DO NOT LAY OUT IN FULL OR HALF LENGTHS SHOULD NOT EXCEED 12" IN LENGTH, SO AS NOT TO HAVE ANY PIECES LESS THAN 4" IN SIZE EXPOSED TO VIEW.
- L. ALL INTERIOR MASONRY WALLS RUN TO UNDERSIDE OF DECK ABOVE SHALL HAVE A 2" JAMB (U.N.O.) AT THE DECK TO BE FILLED WITH FIRE STOPPING. ALL MASONRY WALLS SHALL BE BRACED WITH MINERAL WOOL AT THE NON-FRAMED WALLS TO ALLOW FOR DEFLECTION.
- M. THERE SHALL BE PERIMETER INSULATION CONTINUOUS AROUND THE ENTIRE PERIMETER OF THE BUILDING EXCLUDING 2'-0" MINUS 15 MIN. HORIZONTAL.
- N. PROVIDE MISCELLANEOUS SUPPORT FOR ALL CEILING SUSPENDED ITEMS.
- O. DOOR AND FRAME NUMBERS CORRESPOND TO ROOM NUMBERS. WHERE MORE THAN ONE DOOR OCCURS IN A ROOM, A ROOM HAS BEEN ADDED (E.G. A10-1). SEE A500 SERIES DRAWINGS FOR DOOR SCHEDULE AND DETAILS.
- P. ALL DOOR FRAMES SHALL BE LOCATED 4' OFF FINISH WALLS OR 4' OFF MASONRY WALLS, UNLESS NOTED OTHERWISE.
- Q. ALL GLASS AT INTERIOR DOOR FRAMES, DOOR LITES AND WINDOW FRAMES IS TO BE 1/4" CLEAR TEMPERED GLASS UNLESS NOTED OTHERWISE.
- R. AT BULKHEAD EXPANSION JOINTS, ALL PARTITIONS, CEILINGS, FLOORS AND ALL WALL, FLOOR OR CEILING MOUNTED ITEMS SHALL BE ANCHORED TO THE BUILDING STRUCTURE ON ONLY ONE SIDE OF THE EXPANSION JOINTS. CONTRACTOR SHALL COORDINATE CONSTRUCTION OF INSTALLATION OF ALL ITEMS NOTED TO ASSURE THAT NO SUCH ITEMS BOND WITH THE EXPANSION JOINT.
- S. ALL SLAB-ON-GRADE CONTROL JOINTS TO BE CLEARED AND CAULKED PRIOR TO PLACEMENT OF FLOOR FINISH.
- T. SEE REFLECTED CEILING PLANS FOR BULKHEAD LOCATIONS AND DETAILS.
- U. REFER TO MECHANICAL DRAWINGS FOR WALL LOUVER LOCATIONS, SIZES AND QUANTITIES.
- V. SEE A800 SERIES DRAWINGS FOR FINISH SCHEDULE AND PLANS.
- W. SEE A800 SERIES DRAWINGS FOR EQUIPMENT SCHEDULE AND PLANS. PROVIDE BLOCKING IN STUD WALLS AND/OR GROUTED MASONRY CORES AS REQUIRED TO SUPPORT EQUIPMENT.
- X. PROVIDE FIRE RESISTANT CREATIV WOOD BLOCKERS AS REQUIRED BY THE LOCAL BUILDING CODE.
- Y. WHERE DISMANTLED FLOOR MATERIALS MEET, THEY SHALL DO SO UNDER THE CENTERLINE OF THE DOOR UNLESS NOTED OTHERWISE.
- Z. APPLY SEALANT AT ALL JUNCTURES BETWEEN DIFFERENT MATERIALS (E.G. MASONRY, CONCRETE, METAL, ETC.). COLOR OF SEALANT AND TYPE OF SPECIFICATION COLOR TO BE SELECTED BY ARCHITECT. APPLY SEALANT AT ALL COUNTERTOPS AND BLACK SPLASHES AT JUNCTURE WITH WALL.
- AA. ALL DOORS SHALL BE INSTALLED AT LEAST THE MINIMUM MANEUVERING CLEARANCE AT THE DOOR APPROACH PER THE MOST CURRENT AMERICANS WITH DISABILITIES ACT.
- BB. BASE FLOOR ELEVATION INDICATED FOR THIS PROJECT IS 100'-0". REFER TO A100 FOR FLOOR ELEVATION.
- CC. AT ALL NEW OR WIDENED OPENINGS IN EXISTING MASONRY WALLS, REMOVE ADDITIONAL WALL ABOVE OPENING AND INSTALL A NEW LINTEL SIMILAR TO THE REQUIREMENTS FOR A NEW MASONRY WALL. REFER TO THE STRUCTURAL DRAWINGS FOR ADDITIONAL INFORMATION. MASONRY INFILL SHALL MATCH ADJACENT CONSTRUCTION.

PROJECT:  
WARREN CENTRAL HIGH SCHOOL  
PHASE 3 ADDITION & RENOVATION  
9500 E. 16th STREET, INDIANAPOLIS, IN 46229


SCOPE DRAWINGS:  
These drawings are a part of the project. In terms of the architectural design concept, the dimensions of structural, mechanical and electrical systems are to be determined by the architect. The drawings describe all the requirements of the Contract.

REVISIONS:

1 ADDENDUM #2 03-13-2023









ISSUE DATE DRAWN BY CHECKED BY  
02/21/2023 Author Checker

DRAWING TITLE:  
ENLARGED RESTROOM PLANS

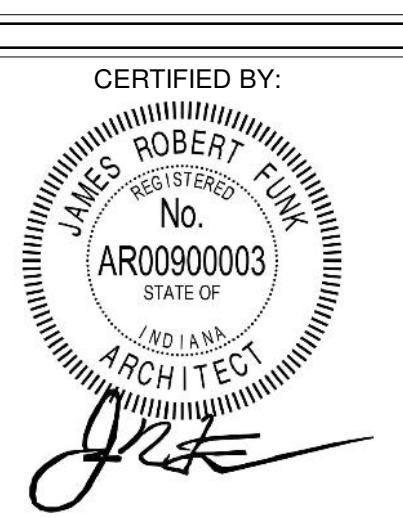

DRAWING NUMBER  
A703

PROJECT NUMBER  
2021056

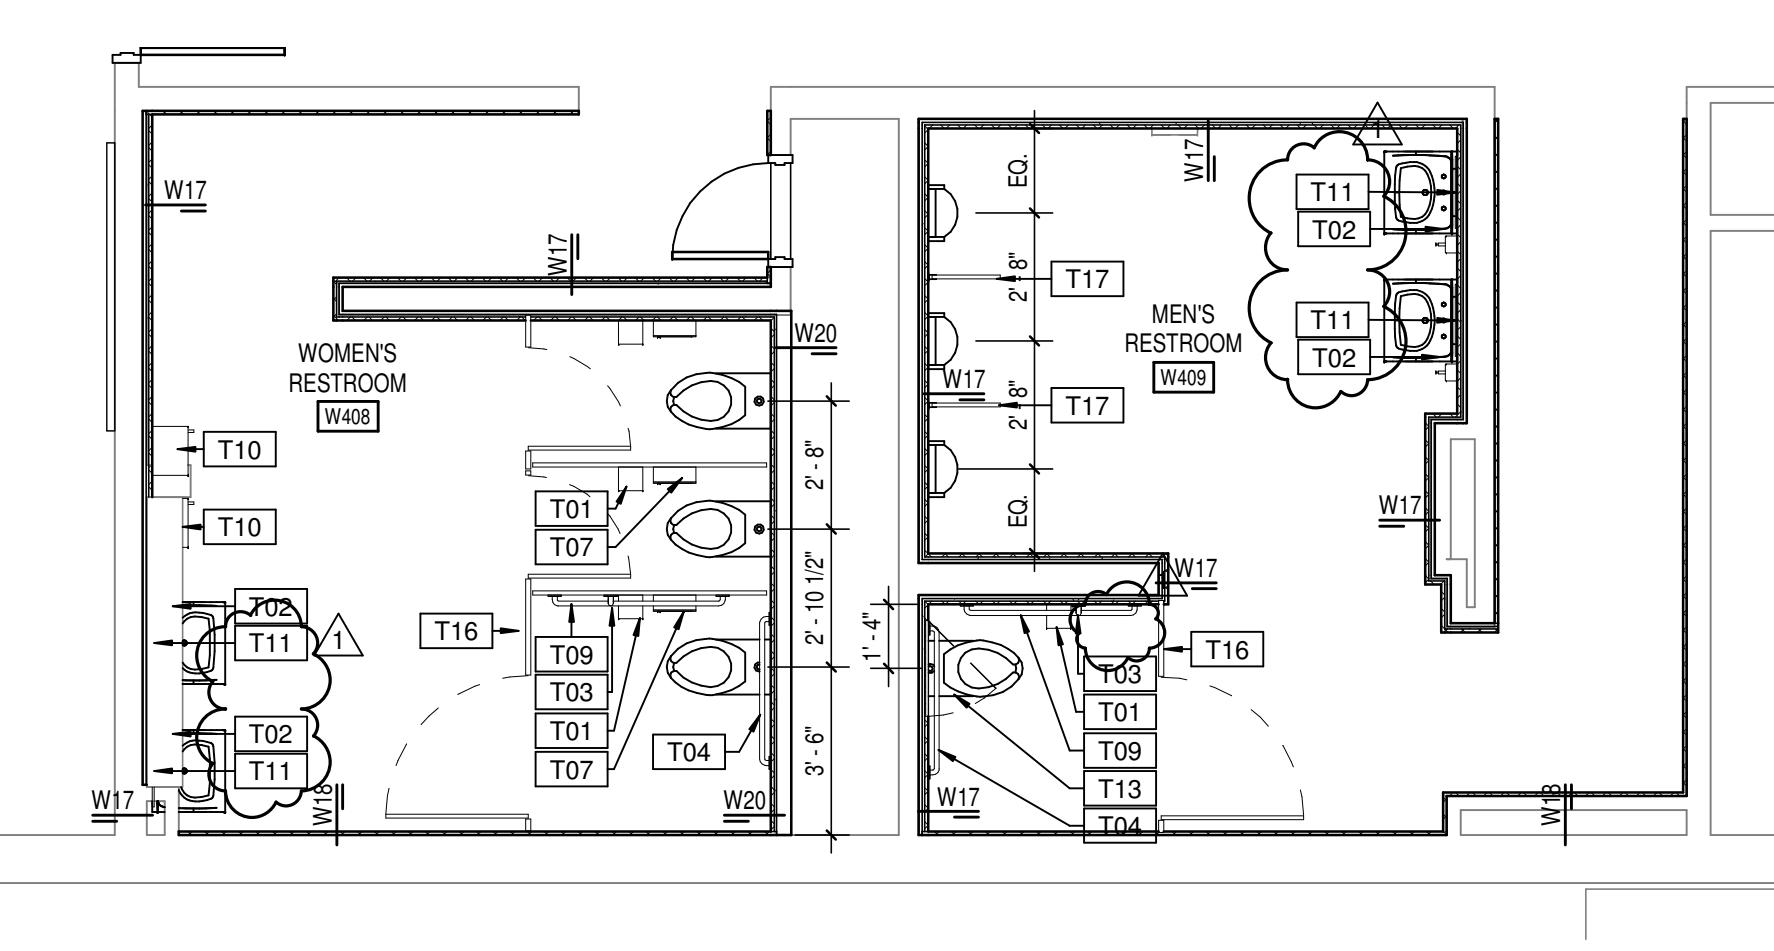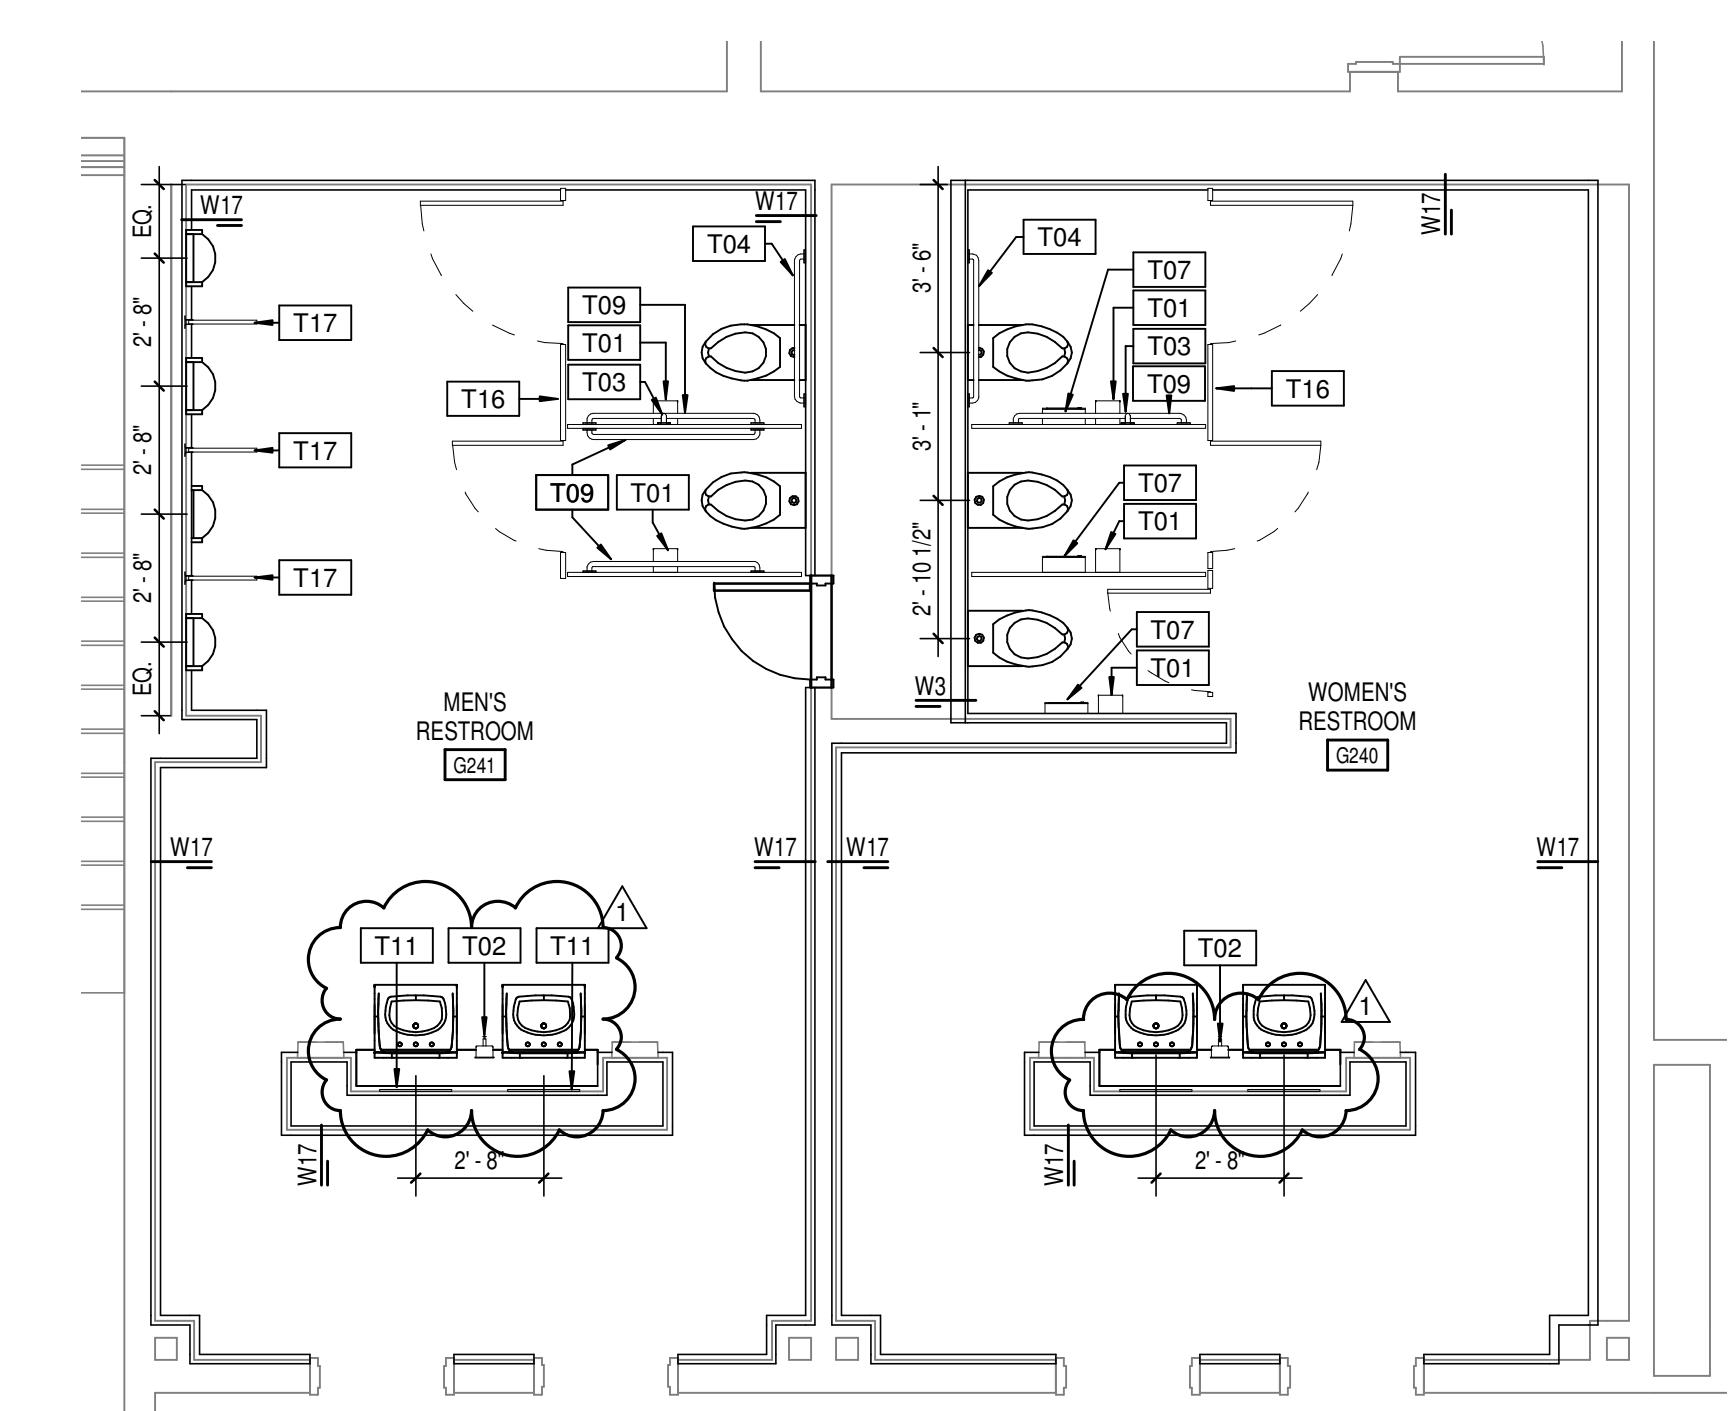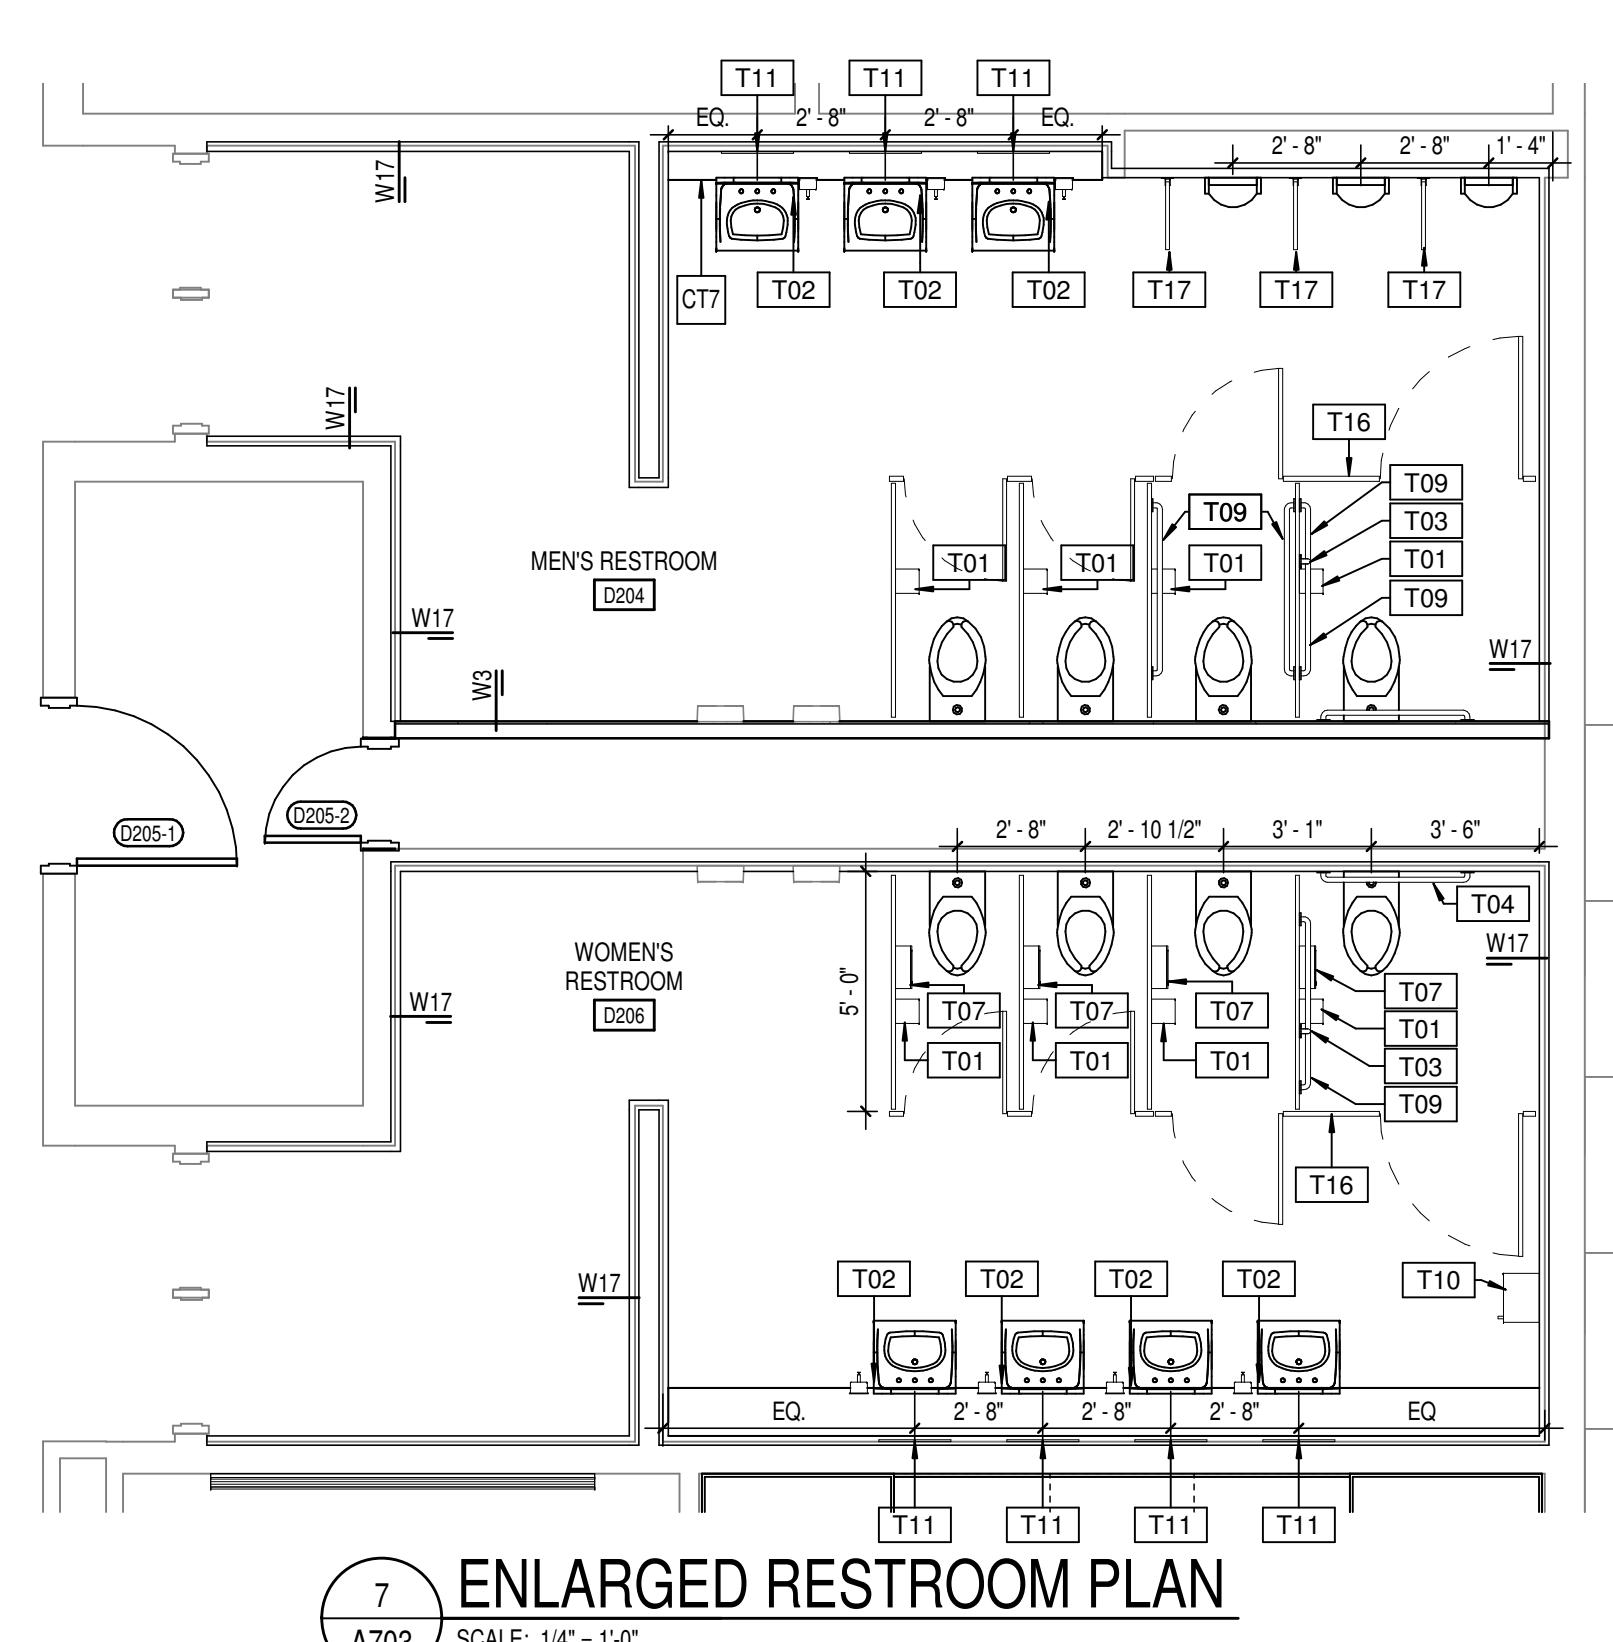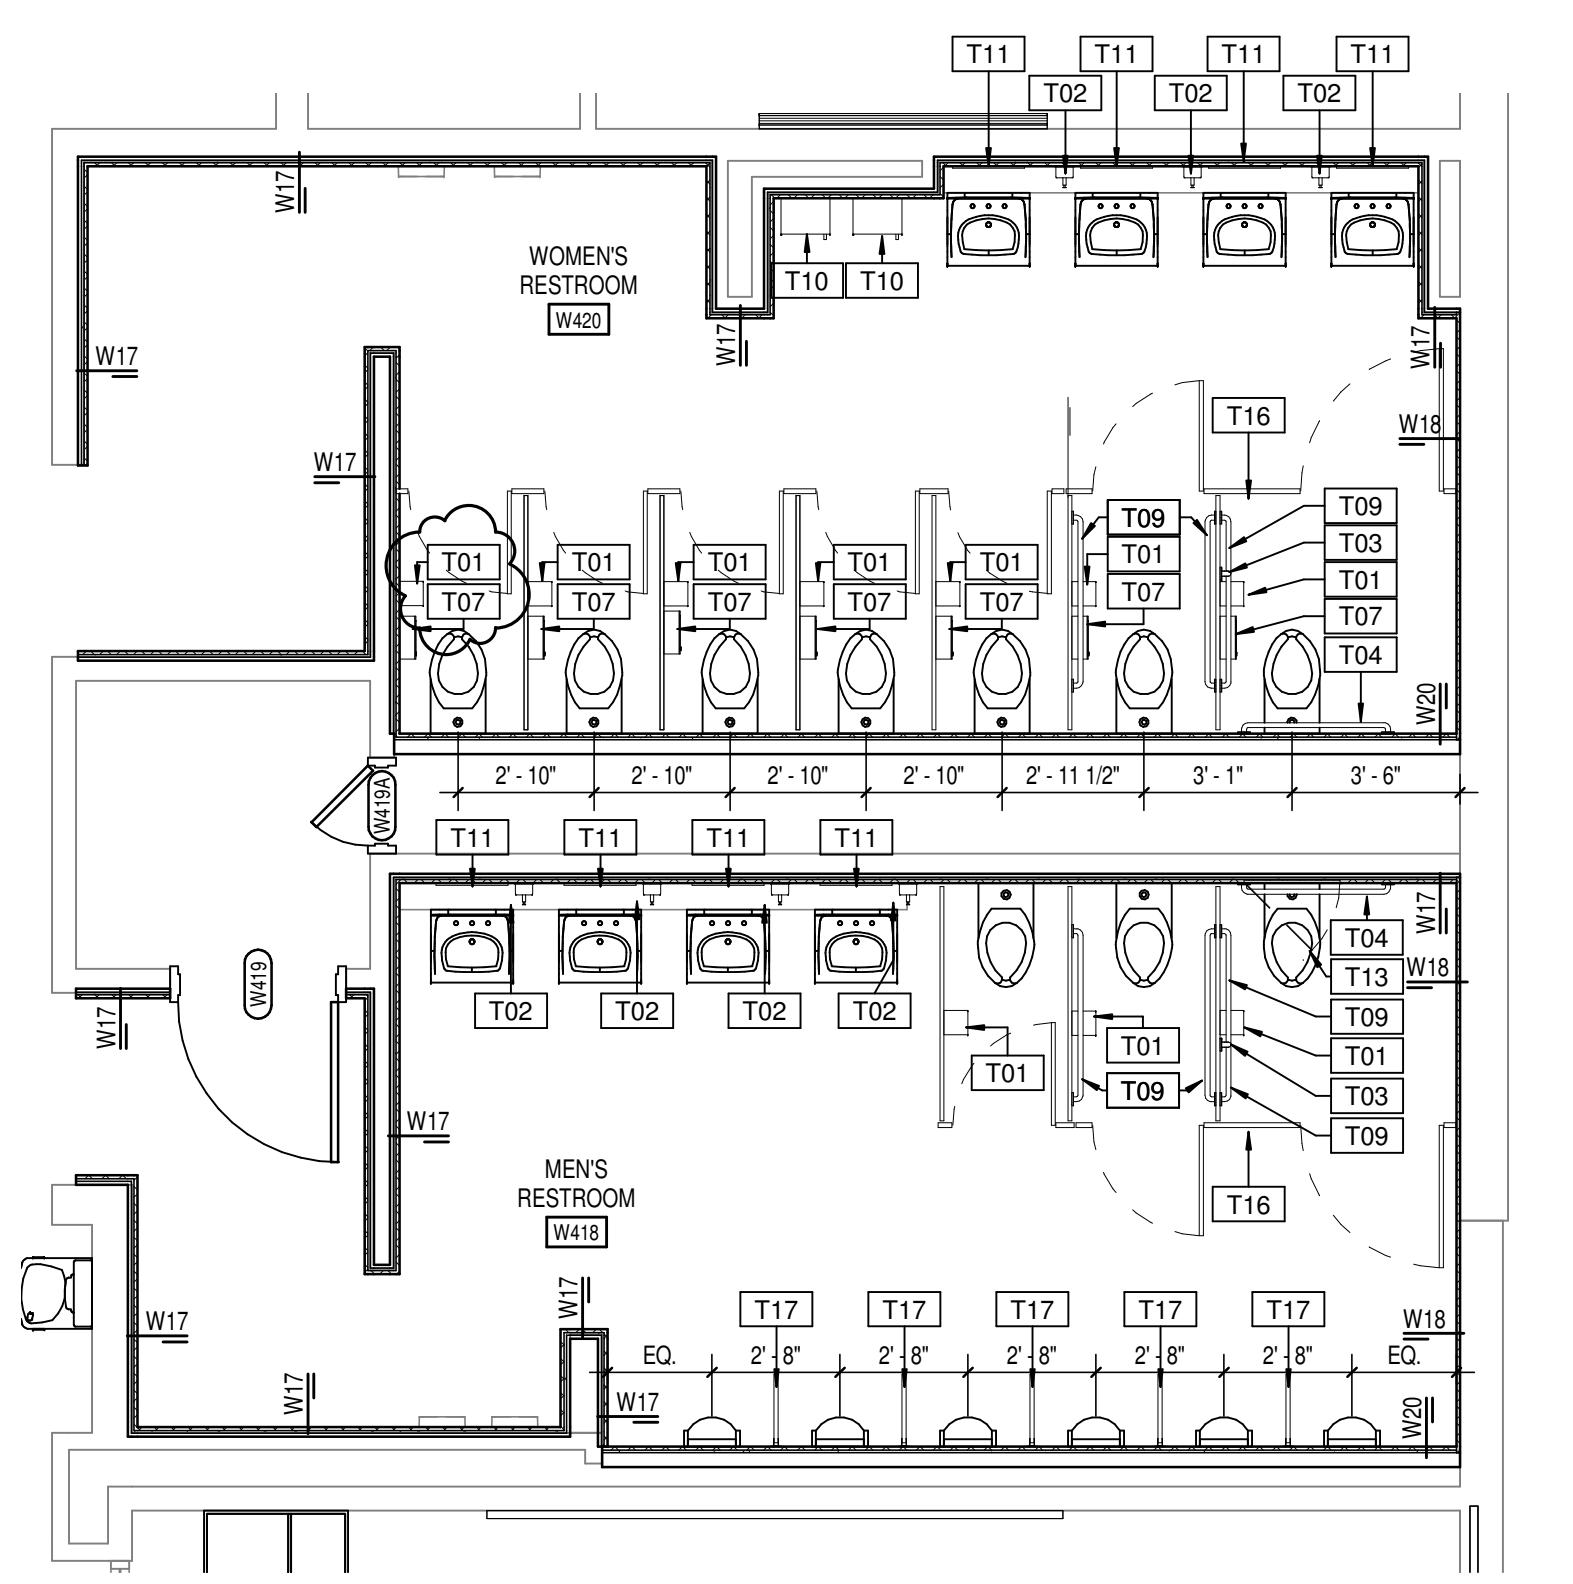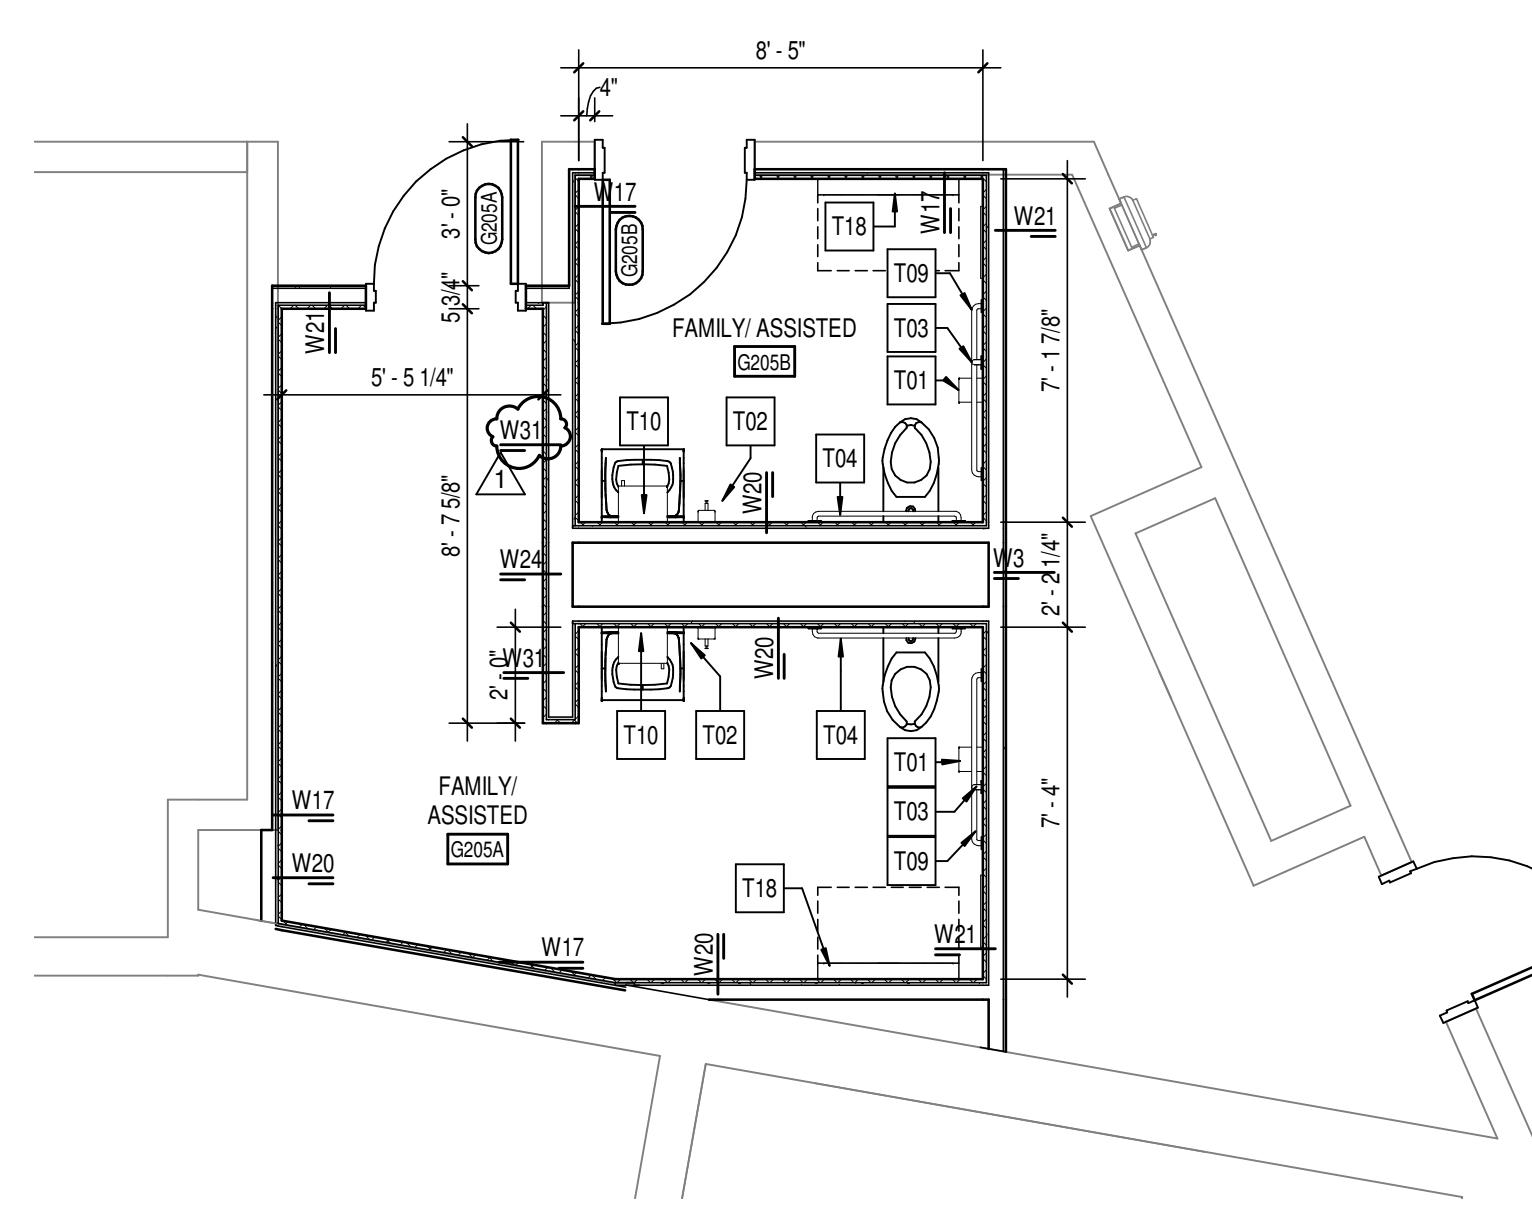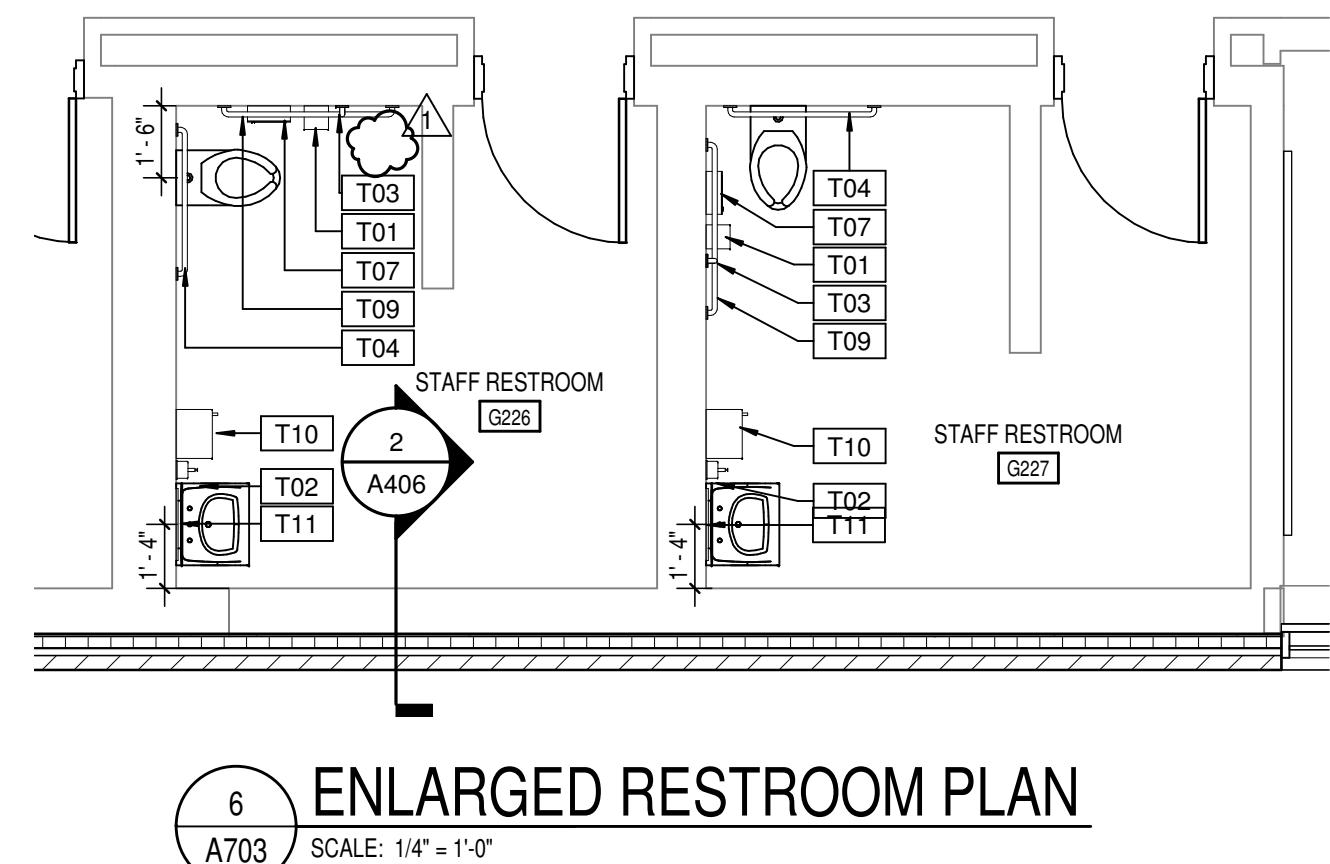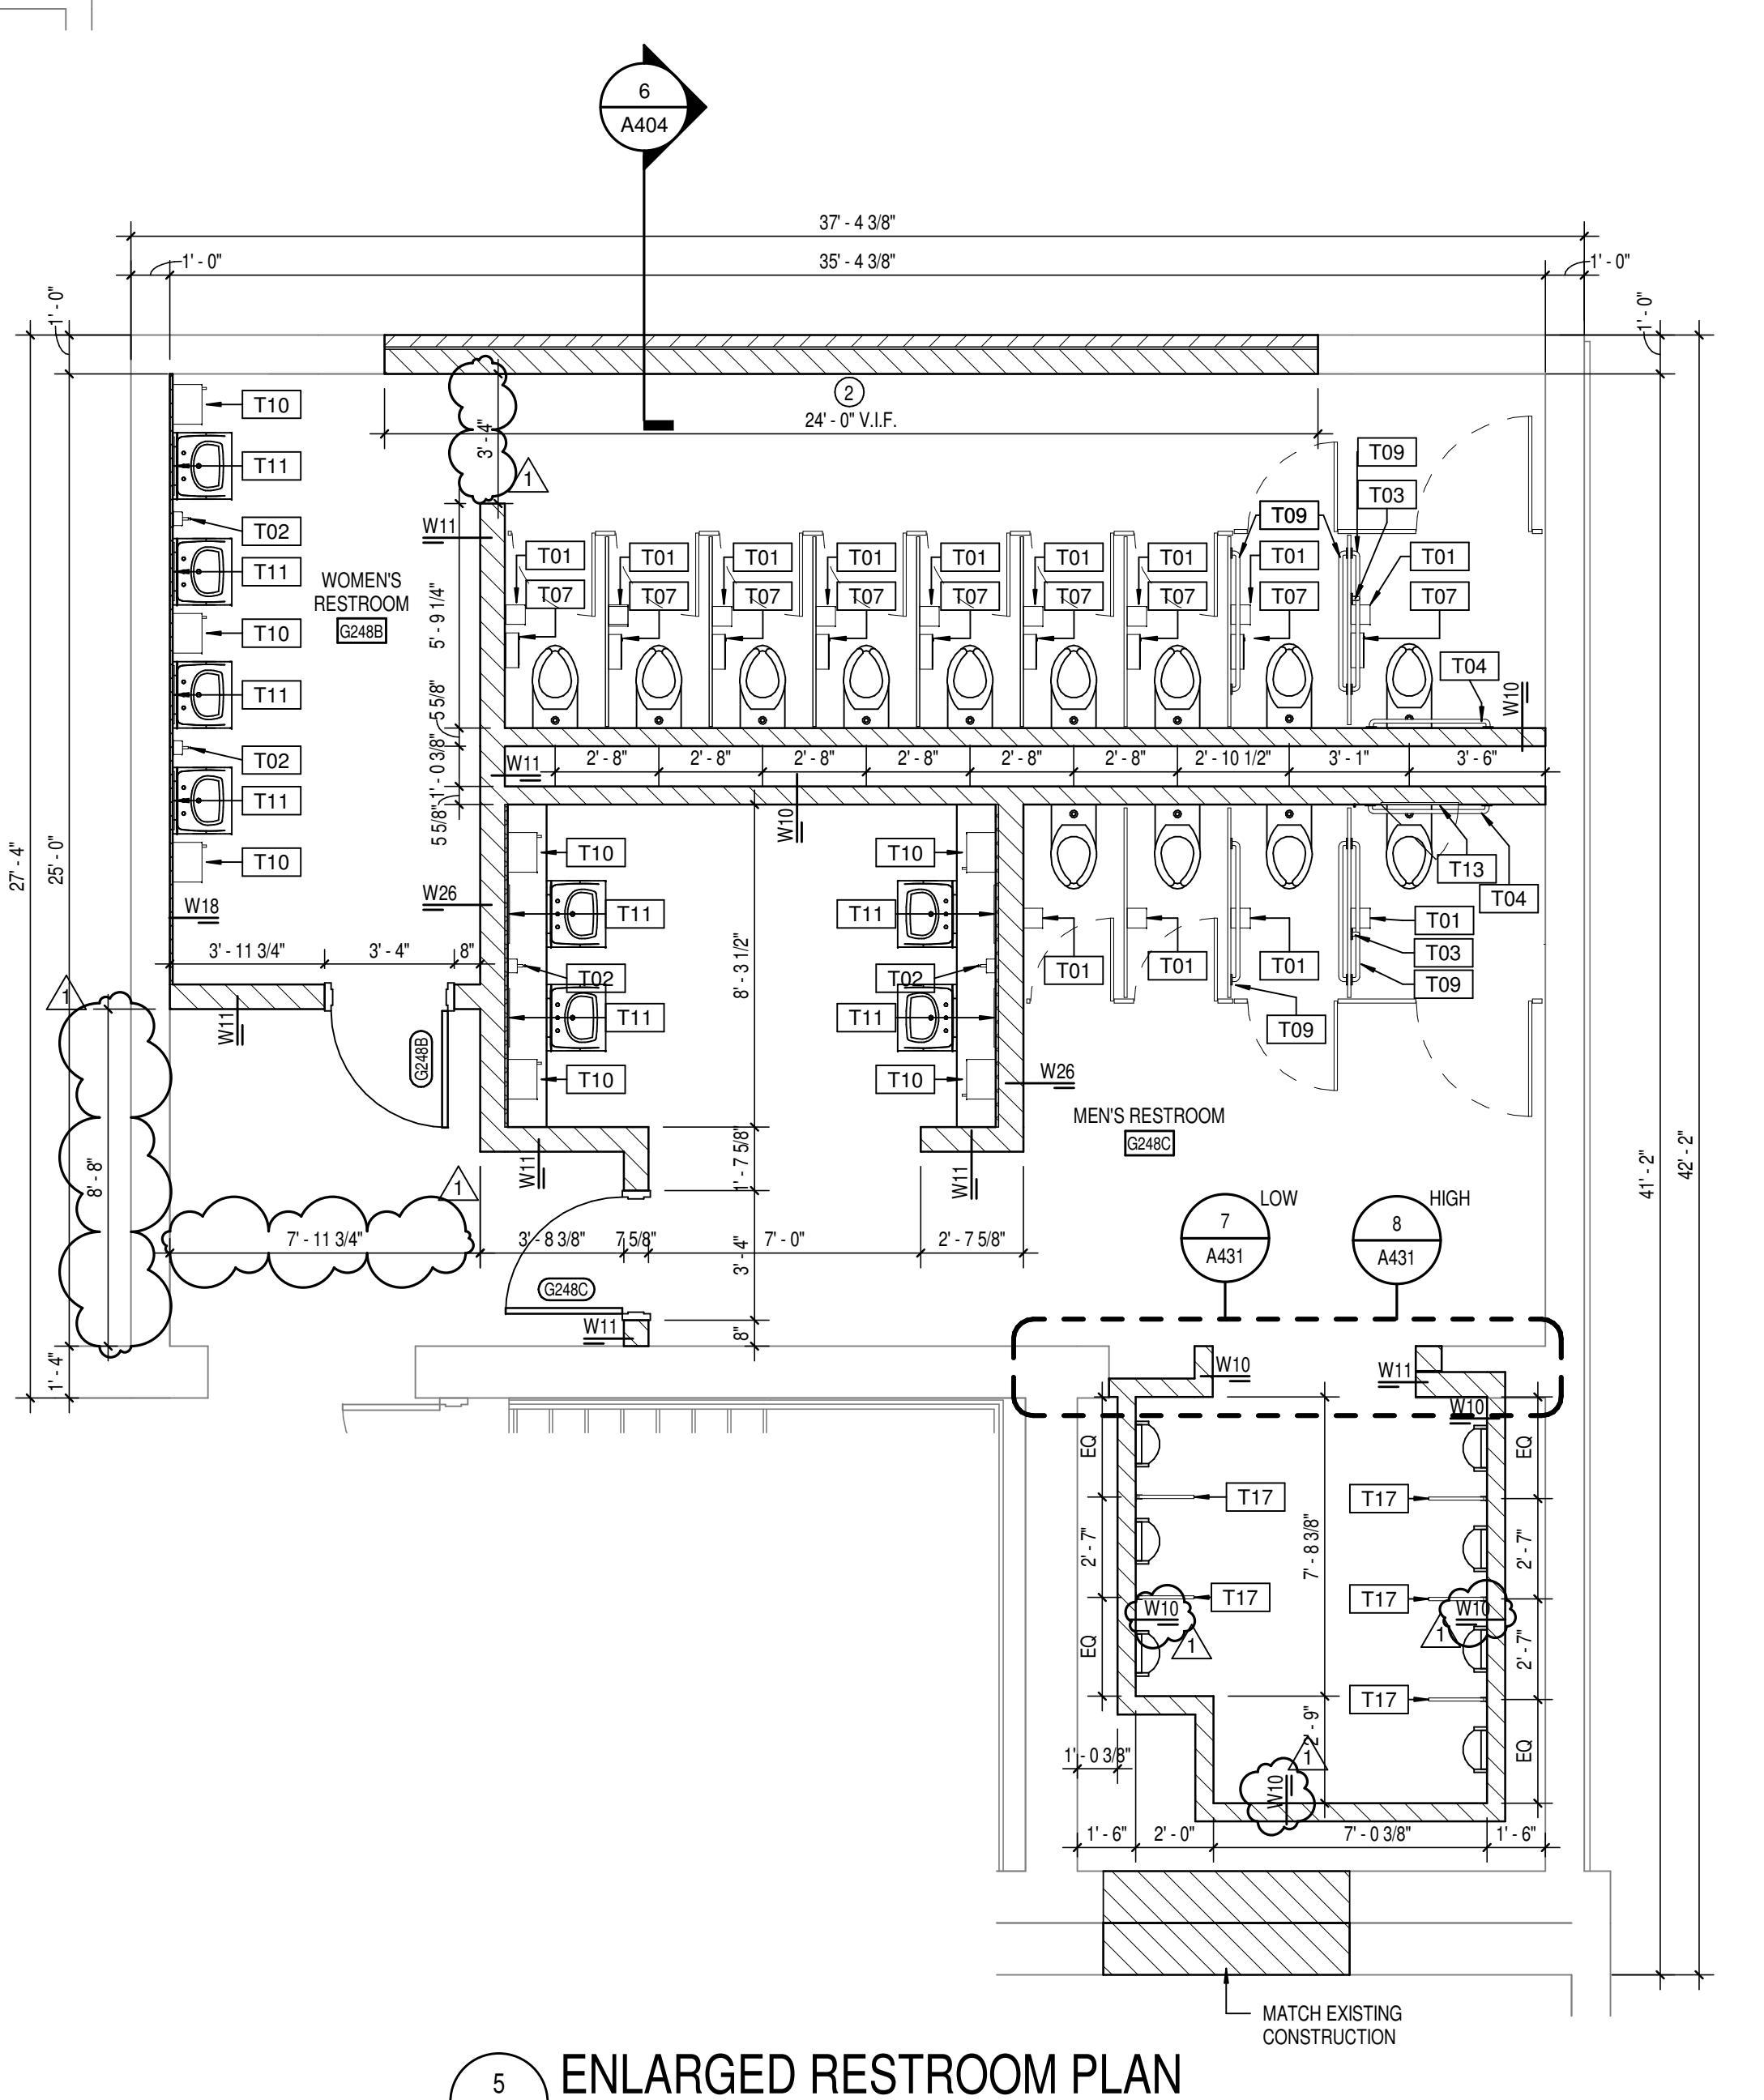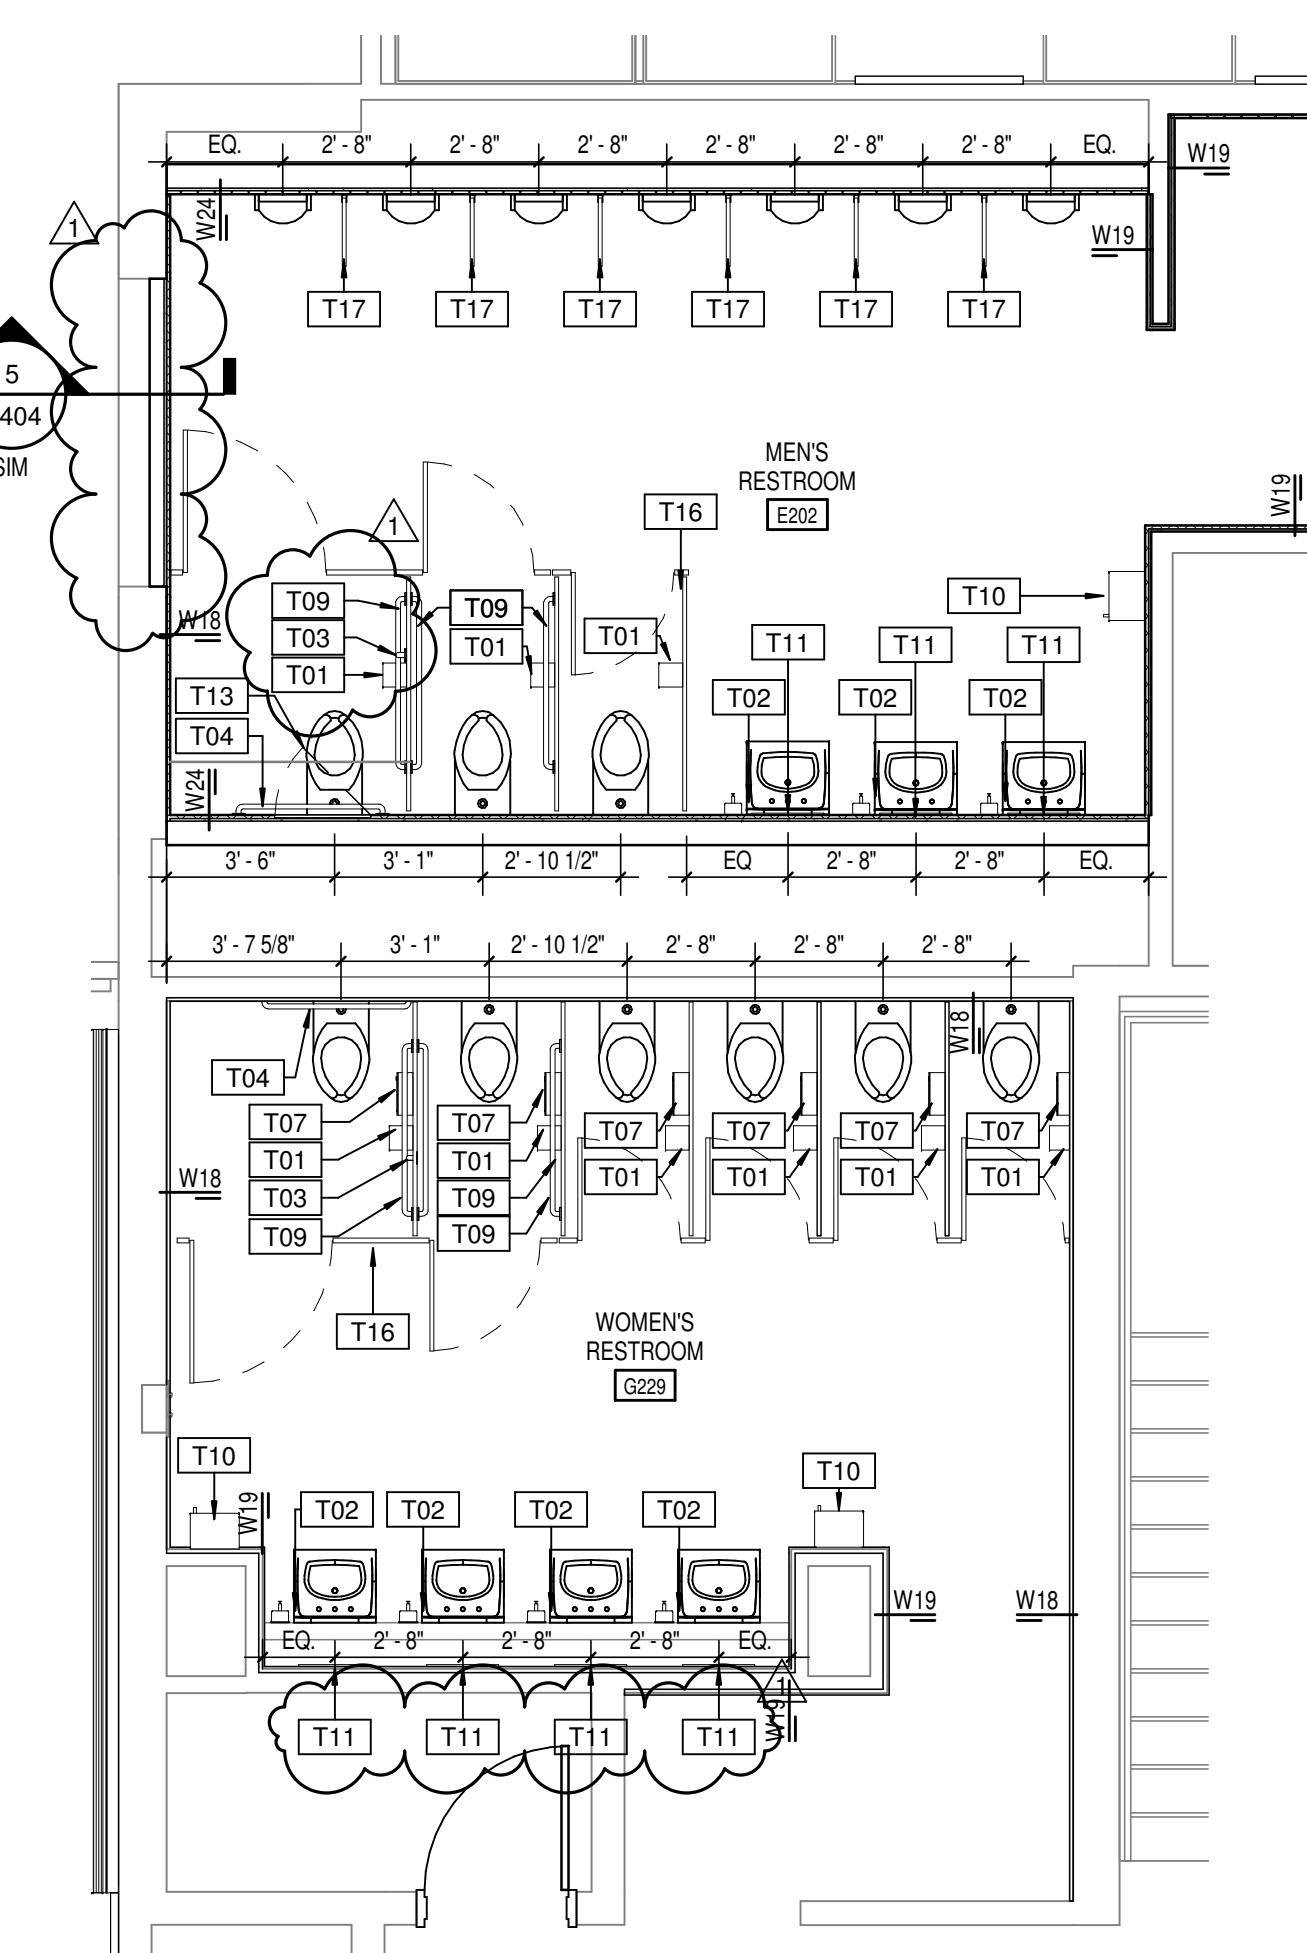







SCCSO  
Keystone Crossing, Indianapolis, IN 46240

317-648-7800 | cso.net

PROJECT:  
WARREN CENTRAL HIGH SCHOOL  
PHASE 3 ADDITION & RENOVATION  
9500 E. 16th STREET, INDIANAPOLIS, IN 46229


SCOPE DRAWINGS:  
These drawings represent the scope of the project in terms of architectural design concept, the dimensions of the structure, mechanical and electrical systems. The drawings are intended to describe all the requirements of the Contract.

REVISIONS:

1 ADDENDUM #2 03-13-2023

ISSUE DATE | DRAWN BY | CHECKED BY  
02-21-2023 | Author | Checker

DRAWING TITLE:  
FIRST FLOOR  
FINISH PLAN -  
UNIT J

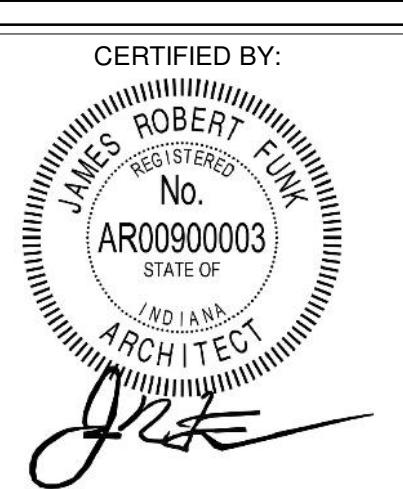

DRAWING NUMBER  
A801J

PROJECT NUMBER  
2021056

KEYED FINISH NOTES

F1 NO WORK IN THIS AREA, UNO.  
F2 NO PAINT TO BE APPLIED TO ANY BRICK SURFACE OR NEW ACM COLUMN WRAPS.  
F3 OPERABLE WALL PANEL FINISH TO BE AFR1 & DRY ERASE, BOTH SIDES.  
F4 WTS TO BE INSTALLED VERTICALLY, STACK-BOND FROM TOP OF BASE TO CEILING. WT4 TO BE INSTALLED VERTICALLY, STACK-BOND FROM TOP OF BASE TO CEILING. SEE ELEVATION 1/2400 FOR ADDITIONAL TILE INSTALL INFORMATION, ANY HVAC GRILLES, ETC TO BE PAINTED TO MATCH EP1.  
F5 EP5 TO BE APPLIED FULL HEIGHT OF EXISTING STRUCTURAL GLAZED TILE (SEE SPECS FOR ADDITIONAL APPLICATION PREP & APPLICATION INFORMATION, & P1 TO BE APPLIED FROM TOP OF STRUCTURAL GLAZED TILE).  
F6 LVT1 TO BE INSTALLED TO EXTENT OF REMOVED VCT OR CARPET, TRIM AT BOTH ENDS TO BE SCHLUTER VINPRO-A/CGB. CONTRACTOR RESPONSIBLE FOR PATCHING & LEVELING OF EXISTING FLOOR SURFACE. LVT1 TO BE APPLIED TO EXISTING LVT, NO WALL BASE TO BE APPLIED TO BRICK OR STRUCTURAL COVE. LVT TO BE CLEANED AND TIGHTLY SCRIBED TO EXISTING BRICK OR STRUCTURAL GLAZED COVE.  
F7 NOT USED.  
F8 WALL TO RECEIVE FINISH WHT, WHT2, WHT3; SEE ELEVATION 5/4800 FOR MORE INFORMATION ON THIS LOCATION TO RECEIVE SCHLUTER JOLLY TRIM IN FINISH BRUSHED GRAPHITE ANODIZED ALUMINUM.  
F9 TERRAZZO PATCH TO MATCH EXISTING IN COLOR, AGGREGATE, AND ZINC STRIP PLACEMENT AND COLOR. CONTRACTOR RESPONSIBLE FOR SUBMITTING SAMPLES OF EVERY TERRAZZO MATCH FOR APPROVAL. PATCH TO TERMINATE AT EXISTING ZINC STRIP.  
F10 ELEVATOR DOORS & FRAMES TO BE PREPARED AND PAINTED TO MATCH P6.  
F11 WTS TO BE INSTALLED 50% OFFSET HORIZONTAL FROM TOP OF BASE TO CEILING ON SINK WALL ONLY. WTS TO BE INSTALLED VERTICAL STACK-BOND 2.5 COURSINGS, WITH PAINT EP1 ABOVE ON REMAINING NON-WET WALLS. SEE ELEVATION 4/4800.  
F12 CHANGE IN FLOORING FINISH TO OCCUR AT CORNER OF WALL INDICATED IN ROOM CORRIDOR.  
F13 NOT USED.  
F14 NO RUBBER WALL BASE TO BE APPLIED TO STRUCTURAL GLAZED COVE.  
F15 WIRE BRUSH/REPAIR WIRE PARTITIONS. CONTRACTOR TO PROTECT HARDWARE.  
F16 FLOORING FINISH INSTALLATION SHALL ACCOMMODATE EXISTING POWER DATA DEVICES.  
F21 MOVEABLE WALLS AND OR WALLS INDICATED TO RECEIVE FRP FROM FLOOR TO HEIGHT OF CEIL. COLOR TO BE CHOSEN FROM MFR'S FULL RANGE.  
F22 MAIL LOCKERS TO HAVE FINISH TO MATCH P6.  
F23 WALL-MOUNTED GRILLE OR OTHER HVAC EQUIPMENT TO BE PAINTED TO MATCH ADJACENT WALL FOLLOW ALL PREP RECOMMENDED BY MFR.  
F24 INSTALL SOLID SURFACE WINDOW STOOLS, TYP. AT ALL APPLICABLE WINDOW LOCATIONS. FINISH TO MATCH P6.  
F25 WTS TO BE INSTALLED VERTICAL STACK-BOND 2.5 COURSINGS, WITH PAINT EP1 ABOVE. SEE ELEVATION 4/4800. WT4 TO BE INSTALLED 50% OFFSET HORIZONTAL FROM TOP OF BASE TO CEILING. SEE ELEVATION 3/4800. ANY HVAC GRILLES, ETC TO BE PAINTED TO MATCH EP1.  
F26 LEAD COATING REMOVAL STEPS TO RECEIVE FINISH LVT3 ON TREADS & RISERS, NOSING TO BE SCHLUTER VINPRO-STEP-R ACGB.  
F27 STEPS TO RECEIVE FINISH LVT1 ON TREADS AND RISERS, NOSING TO BE SCHLUTER VINPRO-STEP-R A/CGB.  
F28 OVERHEAD COILING DOOR TO BE PAINTED TO MATCH P6 IN ITS ENTIRETY. CONTRACTOR TO FOLLOW ALL PREP RECOMMENDED FOR AND FOR ENSURING DOOR IS FULLY OPERATIONAL AFTER RECEIVING FINISH.  
F29 PAINT EXISTING MOSAIC TILE TO MATCH P1. FOLLOW MANUFACTURER'S RECOMMENDATIONS & SPECS FOR TILE PREP AND PAINT APPLICATION.  
F30 NOT USED.  
F31 WINDOW FRAMES TO BE PAINTED TO MATCH P6.  
F32 NOT USED.  
F33 NEW RUBBER STRINGER, TARGET COLOR BLACK 40.  
F34 FLOOR PATCH WITH TERRAZZO TO MATCH EXISTING ADJACENT TERRAZZO IN TYPE, COLOR & FINISH AND SHOULD BE PATCHED IN FULL TO THE NEAREST SPIDER STRIP. ANY NEW DIVIDER STRIPS TO MATCH EXISTING STRIPS IN MATERIAL, SIZE, AND FINISH. SAMPLES TO BE SUBMITTED FOR APPROVAL PRIOR TO ANY PATCHING.  
F35 NOT USED.  
F36 STAINLESS STEEL WALL PANELS TO BE INSTALLED AT SINK AREA, SINK EXISTING TO BE REMOVED.  
F37 SHOWER TO RECEIVE FLOOR FINISH EPX5. WALLS TO BE WTS, VERTICAL STACK BOND, FROM TOP OF BASE TO CEILING.  
F38 TECTUM PANELS ON WALLS TO BE PAINTED TO MATCH P2; FRAMES PAINTED TO MATCH P6.  
F39 PAINT TO BE APPLIED UP TO TOP OF DOOR FRAME, P7 APPLIED FROM TOP OF DOOR FRAME TO DECK.  
F40 CEILING BULKHEAD ABOVE TO BE PAINTED P5.  
F41 EXISTING WOOD TRIM TO BE PAINTED TO MATCH P6.  
F42 ALL EXISTING TACK TRIM TO BE REPLACED WITH K13.  
F43 COLUMN TO RECEIVE FINISHES EP1 & B1, TYP.  
F44 COMPUTER NETWORKING LOGO -4X4 TO BE PAINTED IN GRAYSCALE USING EP3 & EP4. CENTERED ON WALL INDICATED. PAINT TRANSITIONS TO BE CRISP AND CLEAN. GRAPHIC FILE PROVIDED BY OWNER.  
F45 CONSTRUCTION LOGO -4X4 TO BE PAINTED IN GRAYSCALE USING EP3 & EP4. CENTERED ON WALL INDICATED. PAINT TRANSITIONS TO BE CRISP AND CLEAN. GRAPHIC FILE PROVIDED BY OWNER.  
F46 MFR TRANSPOSITION LOGO -4X4 TO BE PAINTED IN GRAYSCALE USING EP3 & EP4. CENTERED ON WALL INDICATED. PAINT TRANSITIONS TO BE CRISP AND CLEAN. GRAPHIC FILE PROVIDED BY OWNER.  
F47 CRIMINAL JUSTICE LOGO -4X4 TO BE PAINTED IN GRAYSCALE USING EP3 & EP4. CENTERED ON WALL INDICATED. PAINT TRANSITIONS TO BE CRISP AND CLEAN. GRAPHIC FILE PROVIDED BY OWNER.  
F48 LOGISTICS LOGO -4X4 TO BE PAINTED IN GRAYSCALE USING EP3 & EP4. CENTERED ON WALL INDICATED. PAINT TRANSITIONS TO BE CRISP AND CLEAN. GRAPHIC FILE PROVIDED BY OWNER.  
F49 WELDING LOGO -4X4 TO BE PAINTED IN GRAYSCALE USING EP3 & EP4. CENTERED ON WALL INDICATED. PAINT TRANSITIONS TO BE CRISP AND CLEAN. GRAPHIC FILE PROVIDED BY OWNER.  
F50 ROBOTICS LOGO -4X4 TO BE PAINTED IN GRAYSCALE USING EP3 & EP4. CENTERED ON WALL INDICATED. PAINT TRANSITIONS TO BE CRISP AND CLEAN. GRAPHIC FILE PROVIDED BY OWNER.  
F51 AUTO COLLISION LOGO -4X4 TO BE PAINTED IN GRAYSCALE USING EP2 & EP3. CENTERED ON WALL INDICATED. PAINT TRANSITIONS TO BE CRISP AND CLEAN. GRAPHIC FILE PROVIDED BY OWNER.  
F52 AUTO SERVICE LOGO -4X4 TO BE PAINTED IN GRAYSCALE USING EP3 & EP4. CENTERED ON WALL INDICATED. PAINT TRANSITIONS TO BE CRISP AND CLEAN. GRAPHIC FILE PROVIDED BY OWNER.  
F53 ENGINEERING LOGO -4X4 TO BE PAINTED IN GRAYSCALE USING EP3 & EP4. CENTERED ON WALL INDICATED. PAINT TRANSITIONS TO BE CRISP AND CLEAN. GRAPHIC FILE PROVIDED BY OWNER.  
F54 SCHLUTER COVE DILEX-AHKA IN DARK ANTHRACITE TO BE USED AT ALL WALLS BETWEEN NEW WALL AND EXISTING TERRAZZO FLOORING.  
F55 FINISH PATCHING DUE TO DEMO AND/OR NEW CONSTRUCTION MUST MATCH EXISTING IN TYPE, COLOR & FINISH. CONTRACTOR MUST SUBMIT INFORMATION AND SAMPLES FOR THESE LOCATIONS.  
F56 CASEWORK IN ROOMS RECEIVING EPOXY RESINOUS FLOORING TO HAVE RUBBER BASE, NO EPOXY BASE TO BE APPLIED TO CASEWORK.  
F57 FACES OF BULKHEAD ABOVE TO RECEIVE FINISH WTS.  
F58 SEE ELEVATION 15/4800 FOR TYPICAL STRUCTURAL GLAZED TILE & GYP PAINT APPLICATION.  
F59 AT CORRIDOR DOOR NICHES, EP2 TO BE APPLIED FULL HEIGHT OF EXISTING STRUCTURAL GLAZED TILE (SEE SPECS FOR ADDITIONAL APPLICATION PREP & APPLICATION INFORMATION, & P2 TO BE APPLIED FROM TOP OF STRUCTURAL GLAZED TILE).  
F60 ALL SALON EQUIPMENT TO HAVE FINISHED PL5 & S33 WHERE APPLICABLE.  
F61 ALL FINISHES TO EXTEND TO LOFT AREA, RAILING TO BE PAINTED TO MATCH P6.  
F62 THIN BRICK ON WALLS INDICATED TO BE BELDEN SIENA BLEND VELVET. NO PAINT TO BE APPLIED TO ANY BRICK SURFACE.  
F63 ACCENT PENDANT LIGHT TO BE KUZO LIGHTING CHROMA PD1708 BK. CONTACT TRACI ASHCRAFT, TASHCRAFT@SLSiNDIANA.COM






SCSO


3831 Keystone Crossing, Indianapolis, IN 46240  
©2020 SCSO Architects, Inc. All Rights Reserved

### KEYED FINISH NOTES

F1 NO WORK IN THIS AREA, U.N.O.  
F2 NO PAINT TO BE APPLIED TO ANY BRICK SURFACE OR NEW ACM COLUMN WRAPS.  
F3 OPERABLE DOORS & FRAMES TO BE PAINTED & DRIED BASE BOTH SIDES.  
F4 TO BE INSTALLED VERTICAL STACK-BOND FROM TOP OF BASE B3 TO CEILING WITH 5% OFFSET HORIZONTAL. FROM TOP OF BASE B3 TO CEILING SEE ELEVATION 1/24800 FOR ADDITIONAL TILE INSTALL INFORMATION. ANY HVAC GRILLES, TIC & TIC PAINTED TO MATCH EPIC.  
F5 EPIC TO BE APPLIED FULL HEIGHT OF EXISTING STRUCTURAL GLAZED TILE (SEE SPECS FOR COLOR & FINISH). CONTRACTOR TO PREP & APPLY INFORMATION, & PAINT TO BE APPLIED FROM TOP OF STRUCTURAL GLAZED TILE TO CEILING. SEE ELEVATION 11/4800.  
F6 LVT TO BE INSTALLED TO LENGTH OF REMOVED VGT OR CARRIER TRIM AT BOTH ENDS TO BE INSTALLED UNPROFS AGES CONTRACTOR RESPONSIBLE FOR PAINTING & LEVELING CONCRETE TO AVOID TELEGRAPHING THROUGH NEW LVT. NO WALL BASE TO BE APPLIED TO BRICK OR STRUCTURAL GLAZED COVE. LVT TO BE CLEANLY AND TIGHTLY SCRIBED TO EXISTING BRICK OR STRUCTURAL GLAZED COVE.  
F7 NOT USED.  
F8 WALL TO RECEIVE FINISH M1, W1, M2, W2. SEE ELEVATION 5/4800 FOR MORE INFORMATION. THIS LOCATION TO RECEIVE SCHLUTER JOLLY TRIM IN FINISH BRUSHED GRAPHITE ANODIZED ALUMINUM.  
F9 TERRAZZO PATCH TO MATCH EXISTING COLOR, AGGREGATE, AND ZINC STRIP PLACEMENT AND COLOR. CONTRACTOR RESPONSIBLE FOR SUBMITTING SAMPLES OF EVERY TERRAZZO PATCH FOR APPROVAL. PATCH TO TERMINATE AT EXISTING ZINC STRIP.  
F10 ELEVATOR DOORS & FRAMES TO BE PREPPED AND PAINTED TO MATCH P6.  
F11 WTS TO BE INSTALLED 5% OFFSET HORIZONTAL FROM TOP OF BASE TO CEILING ON SINK WALL ONLY. WTS TO BE INSTALLED VERTICAL STACK-BOND 2.5 COURSINGS, WITH PAINT TO BE ABOVE ON REMAINING NON-WET WALLS; SEE ELEVATION 4/4800.  
F12 PAINT IN FLOORING FINISH TO OCCUR AT CORNER OF WALL INDICATED.  
F13 COLUMN IN AREA INDICATED TO BE PAINTED TO MATCH WALL COLOR IN ROOM CORRIDOR.  
F14 NOT USED.  
F15 NO RUBBER WALL BASE TO BE APPLIED TO STRUCTURAL GLAZED COVE.  
F16 WIRE BRUSH/PREPARE WIRE PARTITIONS. CONTRACTOR TO PROTECT PVC SCAFFOLDING.  
F17 PARTITION TO BE PAINTED TO MATCH P1. CONTRACTOR TO PROTECT PVC SCAFFOLDING. CONTRACTOR TO PROTECT PVC SCAFFOLDING. CONTRACTOR TO PROTECT PVC SCAFFOLDING.  
F18 LOCKERS TO BE PAINTED TO MATCH P6. SEE SPECIFICATIONS FOR PAINT TYPE & SHEEN.  
F19 WIRE BRUSH/PREPARE WIRE PARTITIONS. CONTRACTOR TO PROTECT HARDWARE. FLOORING FINISH INSTALLATION SHALL ACCOMMODATE EXISTING POWER DATA DEVICE.  
F20 PAINT SINK WALLS AND/OR WALLS INDICATED TO RECEIVE FRP FROM FLOOR TO HEIGHT OF 8' 9" RAFF. COLOR TO BE CHOSEN FROM MFR'S FULL RANGE.  
F21 MAIL LOCKERS TO HAVE FINISH TO MATCH P6.  
F22 WALL-MOUNTED GRILLE OR OTHER HVAC EQUIPMENT TO BE PAINTED TO MATCH ADJACENT WALL. FOLLOW ALL PREP RECOMMENDED BY MFR.  
F23 INSIDE SCAFFOLDING BLOW STOOLS, TYP. AT ALL APPLICABLE WINDOW LOCATIONS. FINISH TO SSS.  
F24 WTS TO BE INSTALLED VERTICAL STACK-BOND 2.5 COURSINGS, WITH PAINT EPIC ABOVE. SEE ELEVATION 4/4800. WTS TO BE INSTALLED 5% OFFSET HORIZONTAL FROM TOP OF BASE B3 TO CEILING. SEE ELEVATION 3/4800. ANY HVAC GRILLES, ETC TO BE PAINTED TO MATCH P6.  
F25 LECTURE PLATFORM STEPS TO RECEIVE FINISH LVT3 ON TREADS & RISERS. NOSING TO BE SCHLUTER VINPRO-STEP-P ACGB.  
F26 STEPS TO RECEIVE FINISH LVT3 ON TREADS AND RISERS. NOSING TO BE SCHLUTER VINPRO-STEP-P ACGB.  
F27 OVERHEAD COLUMNS DOOR TO BE PAINTED TO MATCH P6 IN ITS ENTIRETY. CONTRACTOR RESPONSIBLE FOR PROPER PREP AND FOR ENSURING DOOR IS FULLY OPERATIONAL AFTER RECEIVING FINISH.  
F28 PAINT EXISTING MOSAIC TILE TO MATCH P1. FOLLOW MANUFACTURER'S RECOMMENDATIONS & SPECS FOR TILE PREP AND PAINT APPLICATION.  
F30 NOT USED.  
F31 WINDOW FRAMES TO BE PAINTED TO MATCH P6.  
F32 NEW EXTERIOR STRINGER, TARTETT COLOR BLACK 40.  
F33 NEW EXTERIOR STRINGER, TARTETT COLOR BLACK 40.  
F34 DOOR PATCH WITH TERRAZZO TO MATCH EXISTING ADJACENT TERRAZZO IN TYPE, FORMULA & FINISH AND SHOULD BE INSTALLED IN FULL TO THE NEAREST DIVIDER STRIP. ANY NEW DIVIDER STRIPS TO MATCH EXISTING STRIPS IN MATERIAL SIZE, AND FINISH. SAMPLES TO BE SUBMITTED FOR APPROVAL PRIOR TO ANY PATCHING.  
F35 NOT USED.  
F36 NEWLESS STEEL WALL PANELS TO BE INSTALLED AT SINK AREA. SINK EXISTING TO REMAIN.  
F37 SHOWER TO RECEIVE FLOOR FINISH EPX. WALLS TO BE WTS, VERTICAL STACK BOND, FROM TOP OF BASE TO CEILING.  
F38 TECTUM PANELS ON WALLS TO BE PAINTED TO MATCH P2. FRAMES PAINTED TO MATCH P6.  
F39 FRAMES TO BE APPLIED UP TO TOP OF DOOR FRAME, P7 APPLIED FROM TOP OF DOOR FRAME TO DECK.  
F40 CEILING BULKHEAD ABOVE TO BE PAINTED P5.  
F41 EXISTING WOOD TRIM TO BE PAINTED TO MATCH P6.  
F42 ALL EXISTING TACK TO BE REPLACED WITH K13.  
F43 COLUMN TO RECEIVE FINISHES EPX & B1, TYP.  
F44 COMPUTER NETWORKING LOGO -4X4 TO BE PAINTED IN GRayscale USING EP3 & EP4. CENTERED ON WALL INDICATED. PAINT TRANSITIONS TO BE CRISP AND CLEAN. GRAPHIC FILE PROVIDED BY OWNER.  
F45 CONSTRUCTION LOGO -4X4 TO BE PAINTED IN GRayscale USING EP3 & EP4. CENTERED ON WALL INDICATED. PAINT TRANSITIONS TO BE CRISP AND CLEAN. GRAPHIC FILE PROVIDED BY OWNER.  
F46 MTS TRANSPORTATION LOGO -4X4 TO BE PAINTED IN GRayscale USING EP3 & EP4. CENTERED ON WALL INDICATED. PAINT TRANSITIONS TO BE CRISP AND CLEAN. GRAPHIC FILE PROVIDED BY OWNER.  
F47 CRIMINAL JUSTICE LOGO -4X4 TO BE PAINTED IN GRayscale USING EP3 & EP4. CENTERED ON WALL INDICATED. PAINT TRANSITIONS TO BE CRISP AND CLEAN. GRAPHIC FILE PROVIDED BY OWNER.  
F48 LOGISTICS LOGO -4X4 TO BE PAINTED IN GRayscale USING EP3 & EP4. CENTERED ON WALL INDICATED. PAINT TRANSITIONS TO BE CRISP AND CLEAN. GRAPHIC FILE PROVIDED BY OWNER.  
F49 WELDING LOGO -4X4 TO BE PAINTED IN GRayscale USING EP3 & EP4. CENTERED ON WALL INDICATED. PAINT TRANSITIONS TO BE CRISP AND CLEAN. GRAPHIC FILE PROVIDED BY OWNER.  
F50 ROBOTICS LOGO -4X4 TO BE PAINTED IN GRayscale USING EP3 & EP4. CENTERED ON WALL INDICATED. PAINT TRANSITIONS TO BE CRISP AND CLEAN. GRAPHIC FILE PROVIDED BY OWNER.  
F51 AUTO COLLISION LOGO -4X4 TO BE PAINTED IN GRayscale USING EP2 & EP3. CENTERED ON WALL INDICATED. PAINT TRANSITIONS TO BE CRISP AND CLEAN. GRAPHIC FILE PROVIDED BY OWNER.  
F52 AUTO SERVICE LOGO -4X4 TO BE PAINTED IN GRayscale USING EP3 & EP4. CENTERED ON WALL INDICATED. PAINT TRANSITIONS TO BE CRISP AND CLEAN. GRAPHIC FILE PROVIDED BY OWNER.  
F53 FINANCIAL LOGO -4X4 TO BE PAINTED IN GRayscale USING EP3 & EP4. CENTERED ON WALL INDICATED. PAINT TRANSITIONS TO BE CRISP AND CLEAN. GRAPHIC FILE PROVIDED BY OWNER.  
F54 SCHLUTER COVE DILEX-AHKA IN DARK ANTHRACITE TO BE USED AT ALL WALLS BETWEEN NEW CONCRETE TILE AND EXISTING TERRAZZO FLOORING.  
F55 PAINT PATCHING DUE TO DEMO AND/OR NEW CONSTRUCTION MUST MATCH EXISTING IN FINISH TYPE & COLOR. CONTRACTOR MUST SUBMIT INFORMATION AND SAMPLES FOR THESE LOCATIONS.  
F56 CASEWORK IN ROOMS RECEIVING EPOXY RESINOUS FLOORING TO HAVE RUBBER BASE B1. NO EPOXY BASE TO BE APPLIED TO CASEWORK.  
F57 FACES OF CASEWORK ABOVE TO RECEIVE FINISH WTS.  
F58 ELEVATION 1/24800 FOR TYPICAL STRUCTURAL GLAZED TILE & GYP PAINT APPLICATION ON STAIRS.  
F59 AT CORRIDOR DOOR NICHES, EP3 TO BE APPLIED FULL HEIGHT OF EXISTING STRUCTURAL GLAZED TILE (SEE SPECS FOR ADDITIONAL APPLICATION PREP & APPLICATION). CONTRACTOR TO PREP & PAINT FROM TOP OF STRUCTURAL GLAZED TILE TO CEILING. SEE ELEVATION 1/24800.  
F60 ALL SALON EQUIPMENT TO HAVE FINISHES PL5 & SS3 WHERE APPLICABLE.  
F61 ALL FINISHES TO EXTEND TO LOFT AREA RAILING TO BE PAINTED TO MATCH P6.  
F62 THIN BRICK ON WALLS INDICATED TO BE BELDEN SIENNA BLEND VELVET. NO PAINT TO BE APPLIED TO ANY BRICK SURFACE.  
F63 ACCENT PENDANT LIGHT TO BE KUZZO LIGHTING CHROMA PD1706 BK. CONTACT TRACIASHCRAFT, TASHCRAFT@SLSLINDIANA.COM

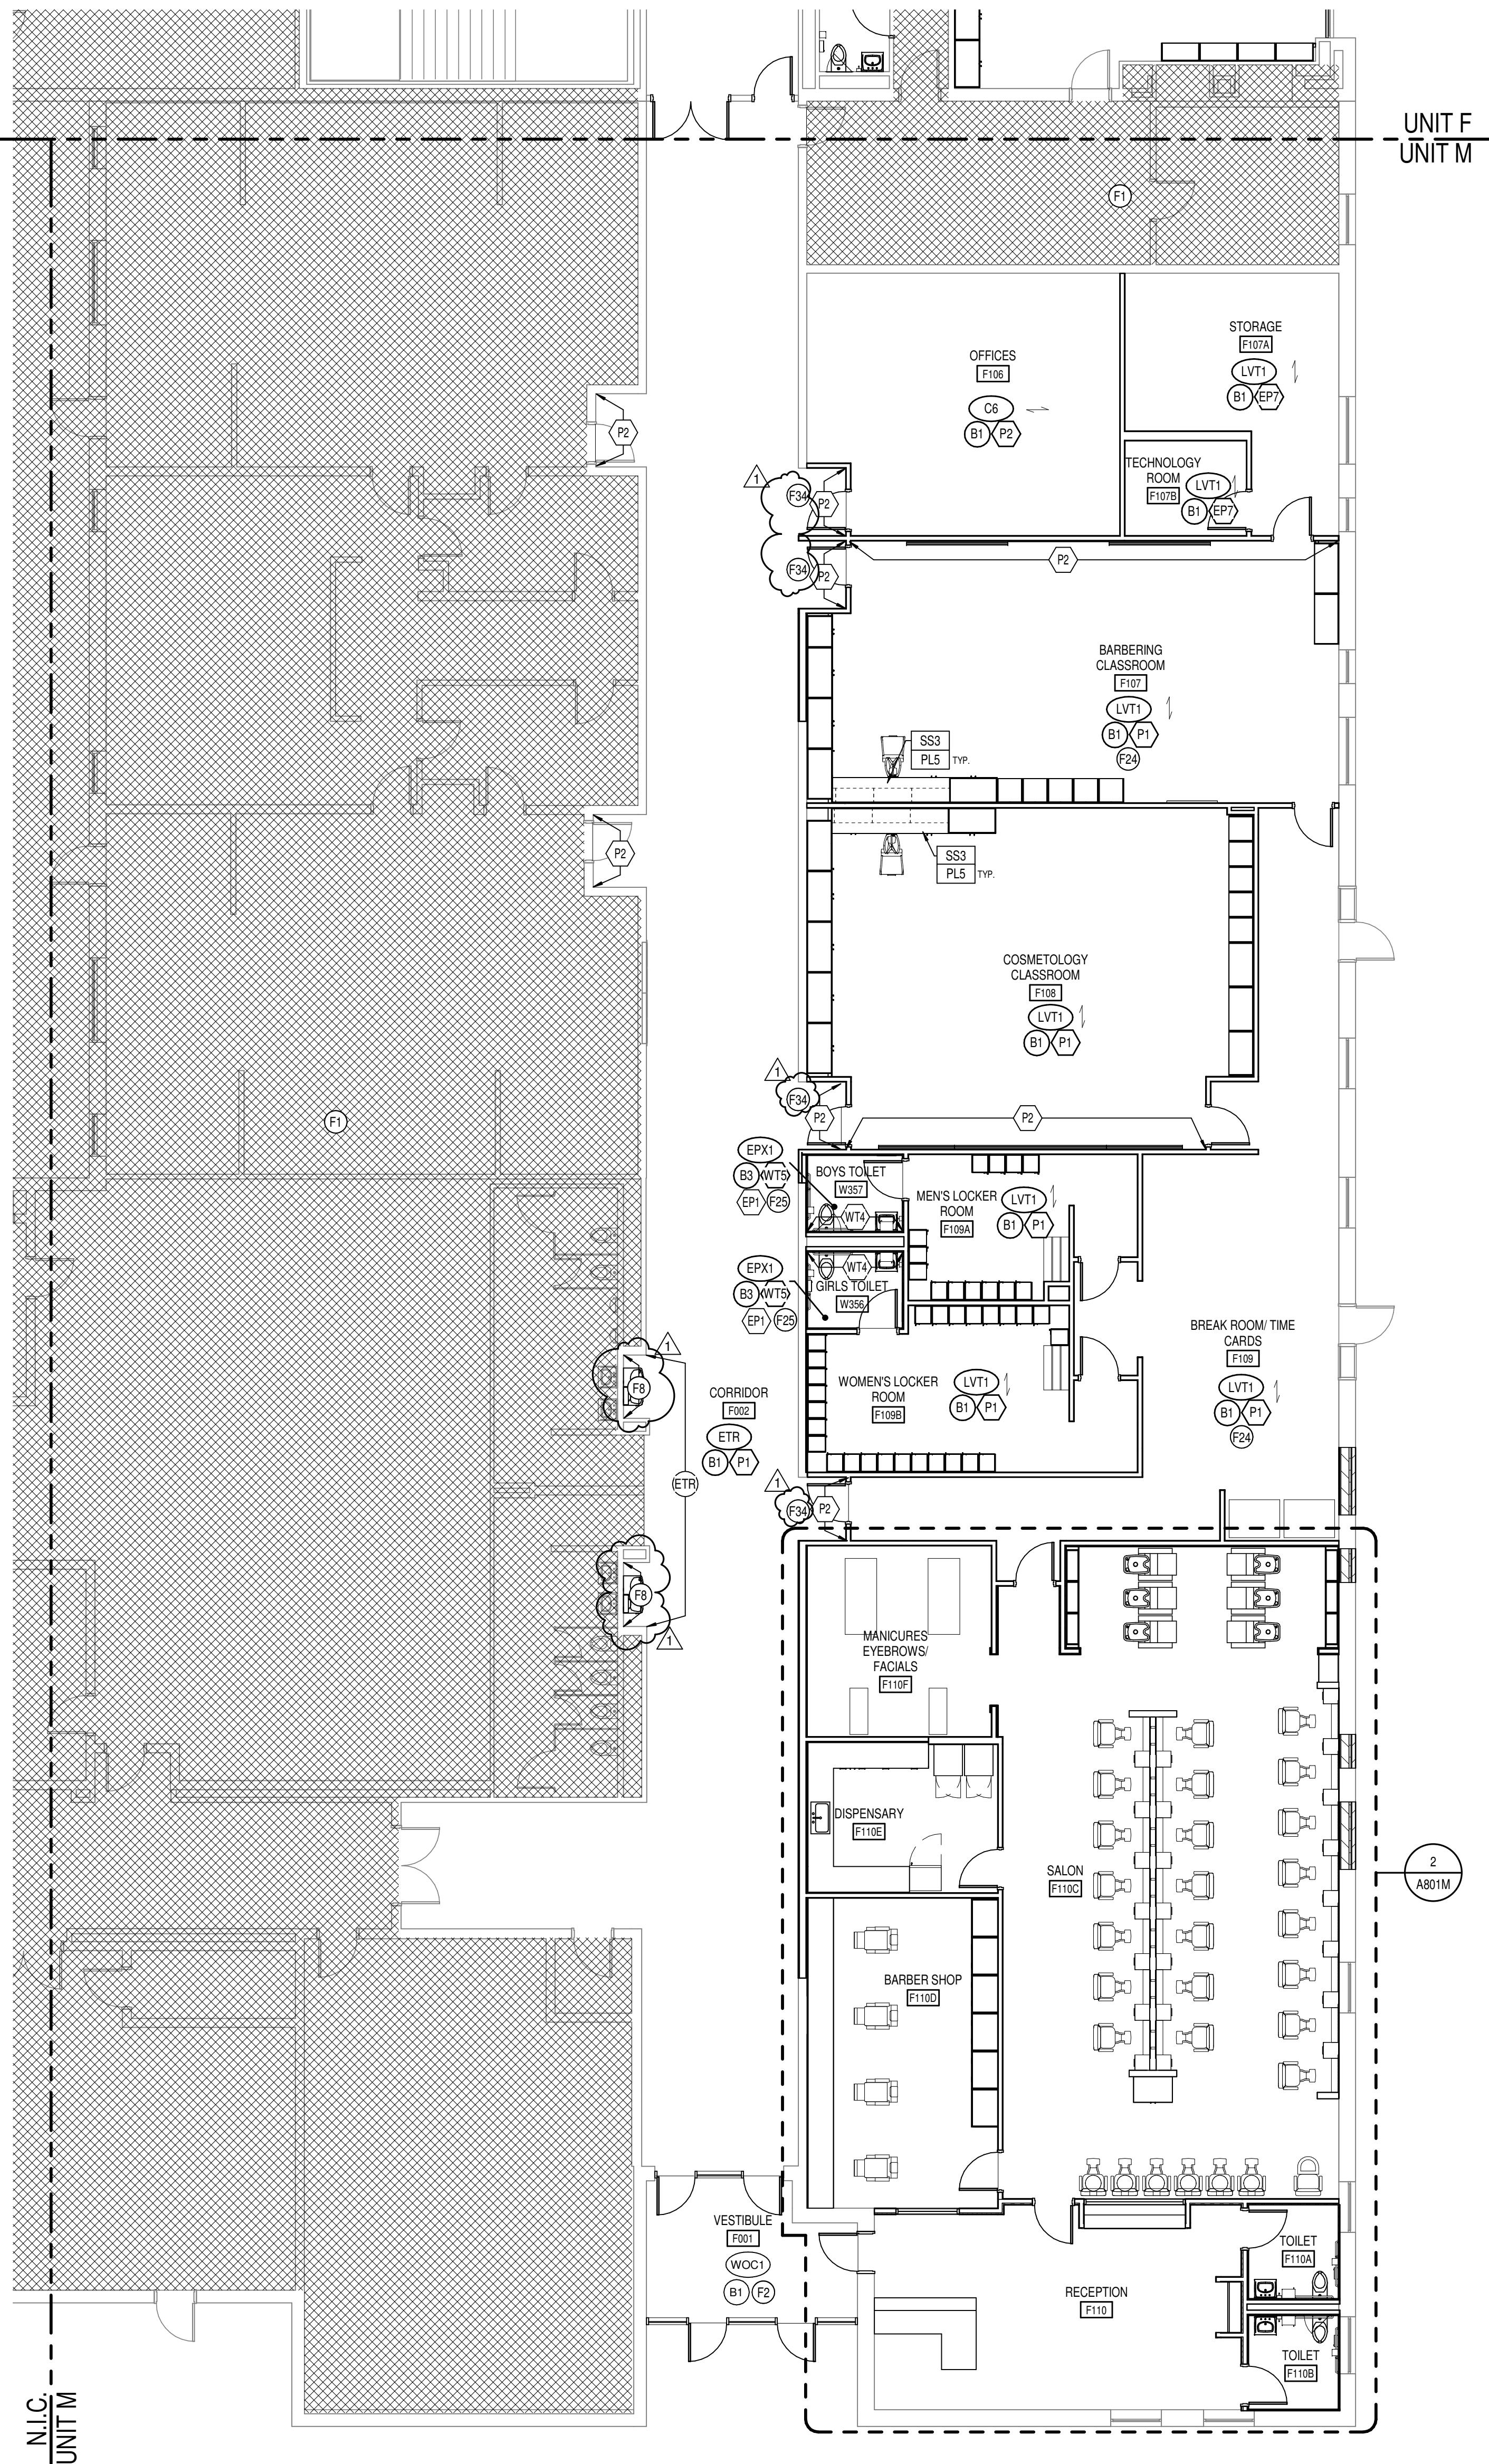

1 FIRST FLOOR FINISH PLAN - UNIT M  
A801M SCALE: 1/8" = 1'-0"

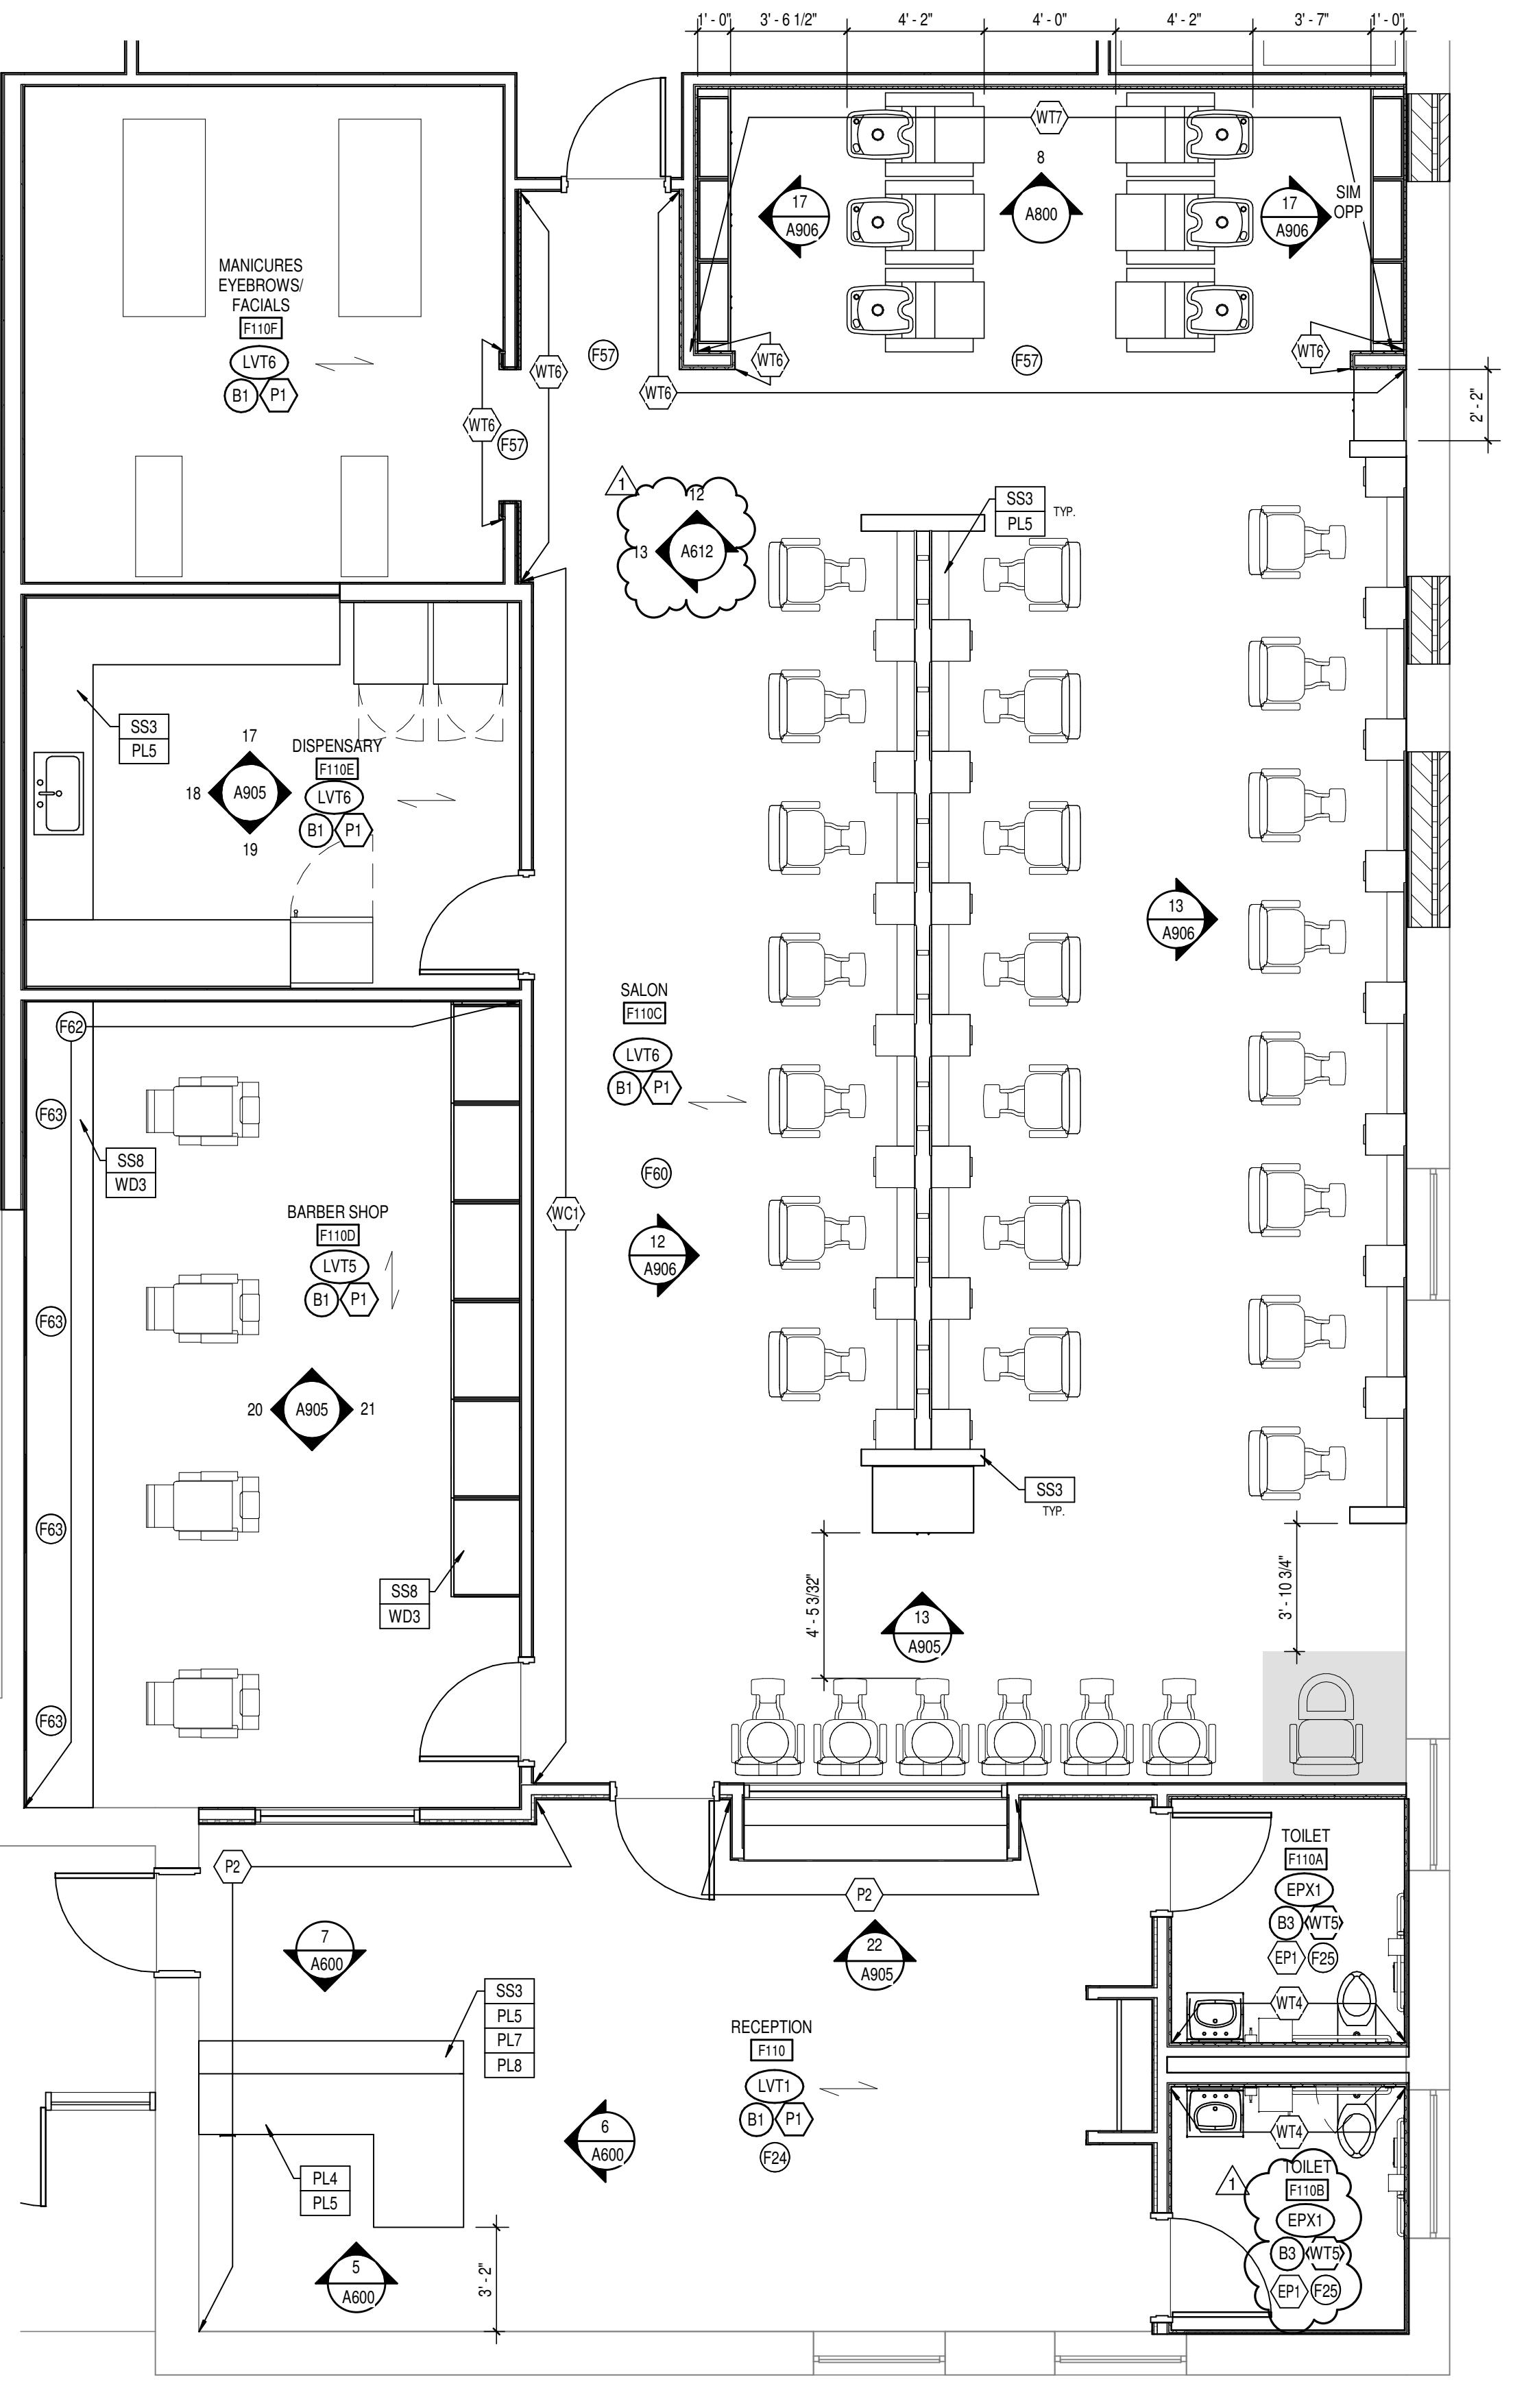

2 SALON/BARBER ENLARGED FINISH PLAN  
A801M SCALE: 1/4" = 1'-0"

PROJECT:  
MSD OF WARREN TOWNSHIP  
WARREN CENTRAL HIGH SCHOOL  
PHASE 3 ADDITION & RENOVATION  
9500 E. 16th STREET, INDIANAPOLIS, IN 46229

SCOPE DRAWINGS:  
These drawings represent the scope of the project in terms of architectural and design concept, the dimensions of structural, mechanical and electrical systems. They are not to be construed as a contract document and do not describe all the requirements of the Contract.  
The drawings and the scope indicated on the drawings are intended to be used by the trade contractors shall furnish all items required for the proper execution and completion of the work.

REVISIONS:  
1 ADDENDUM #2 03-13-2023


ISSUE DATE DRAWN BY CHECKED BY  
02/21/2023 Author Checker

DRAWING TITLE:  
FIRST FLOOR  
FINISH PLAN -  
UNIT M

CERTIFIED BY:  
JAMES ROBERT PEER  
REGISTERED ARCHITECT  
No. AR00900003  
STATE OF INDIANA  
Signature

DRAWING NUMBER  
A801M

PROJECT NUMBER  
2021056

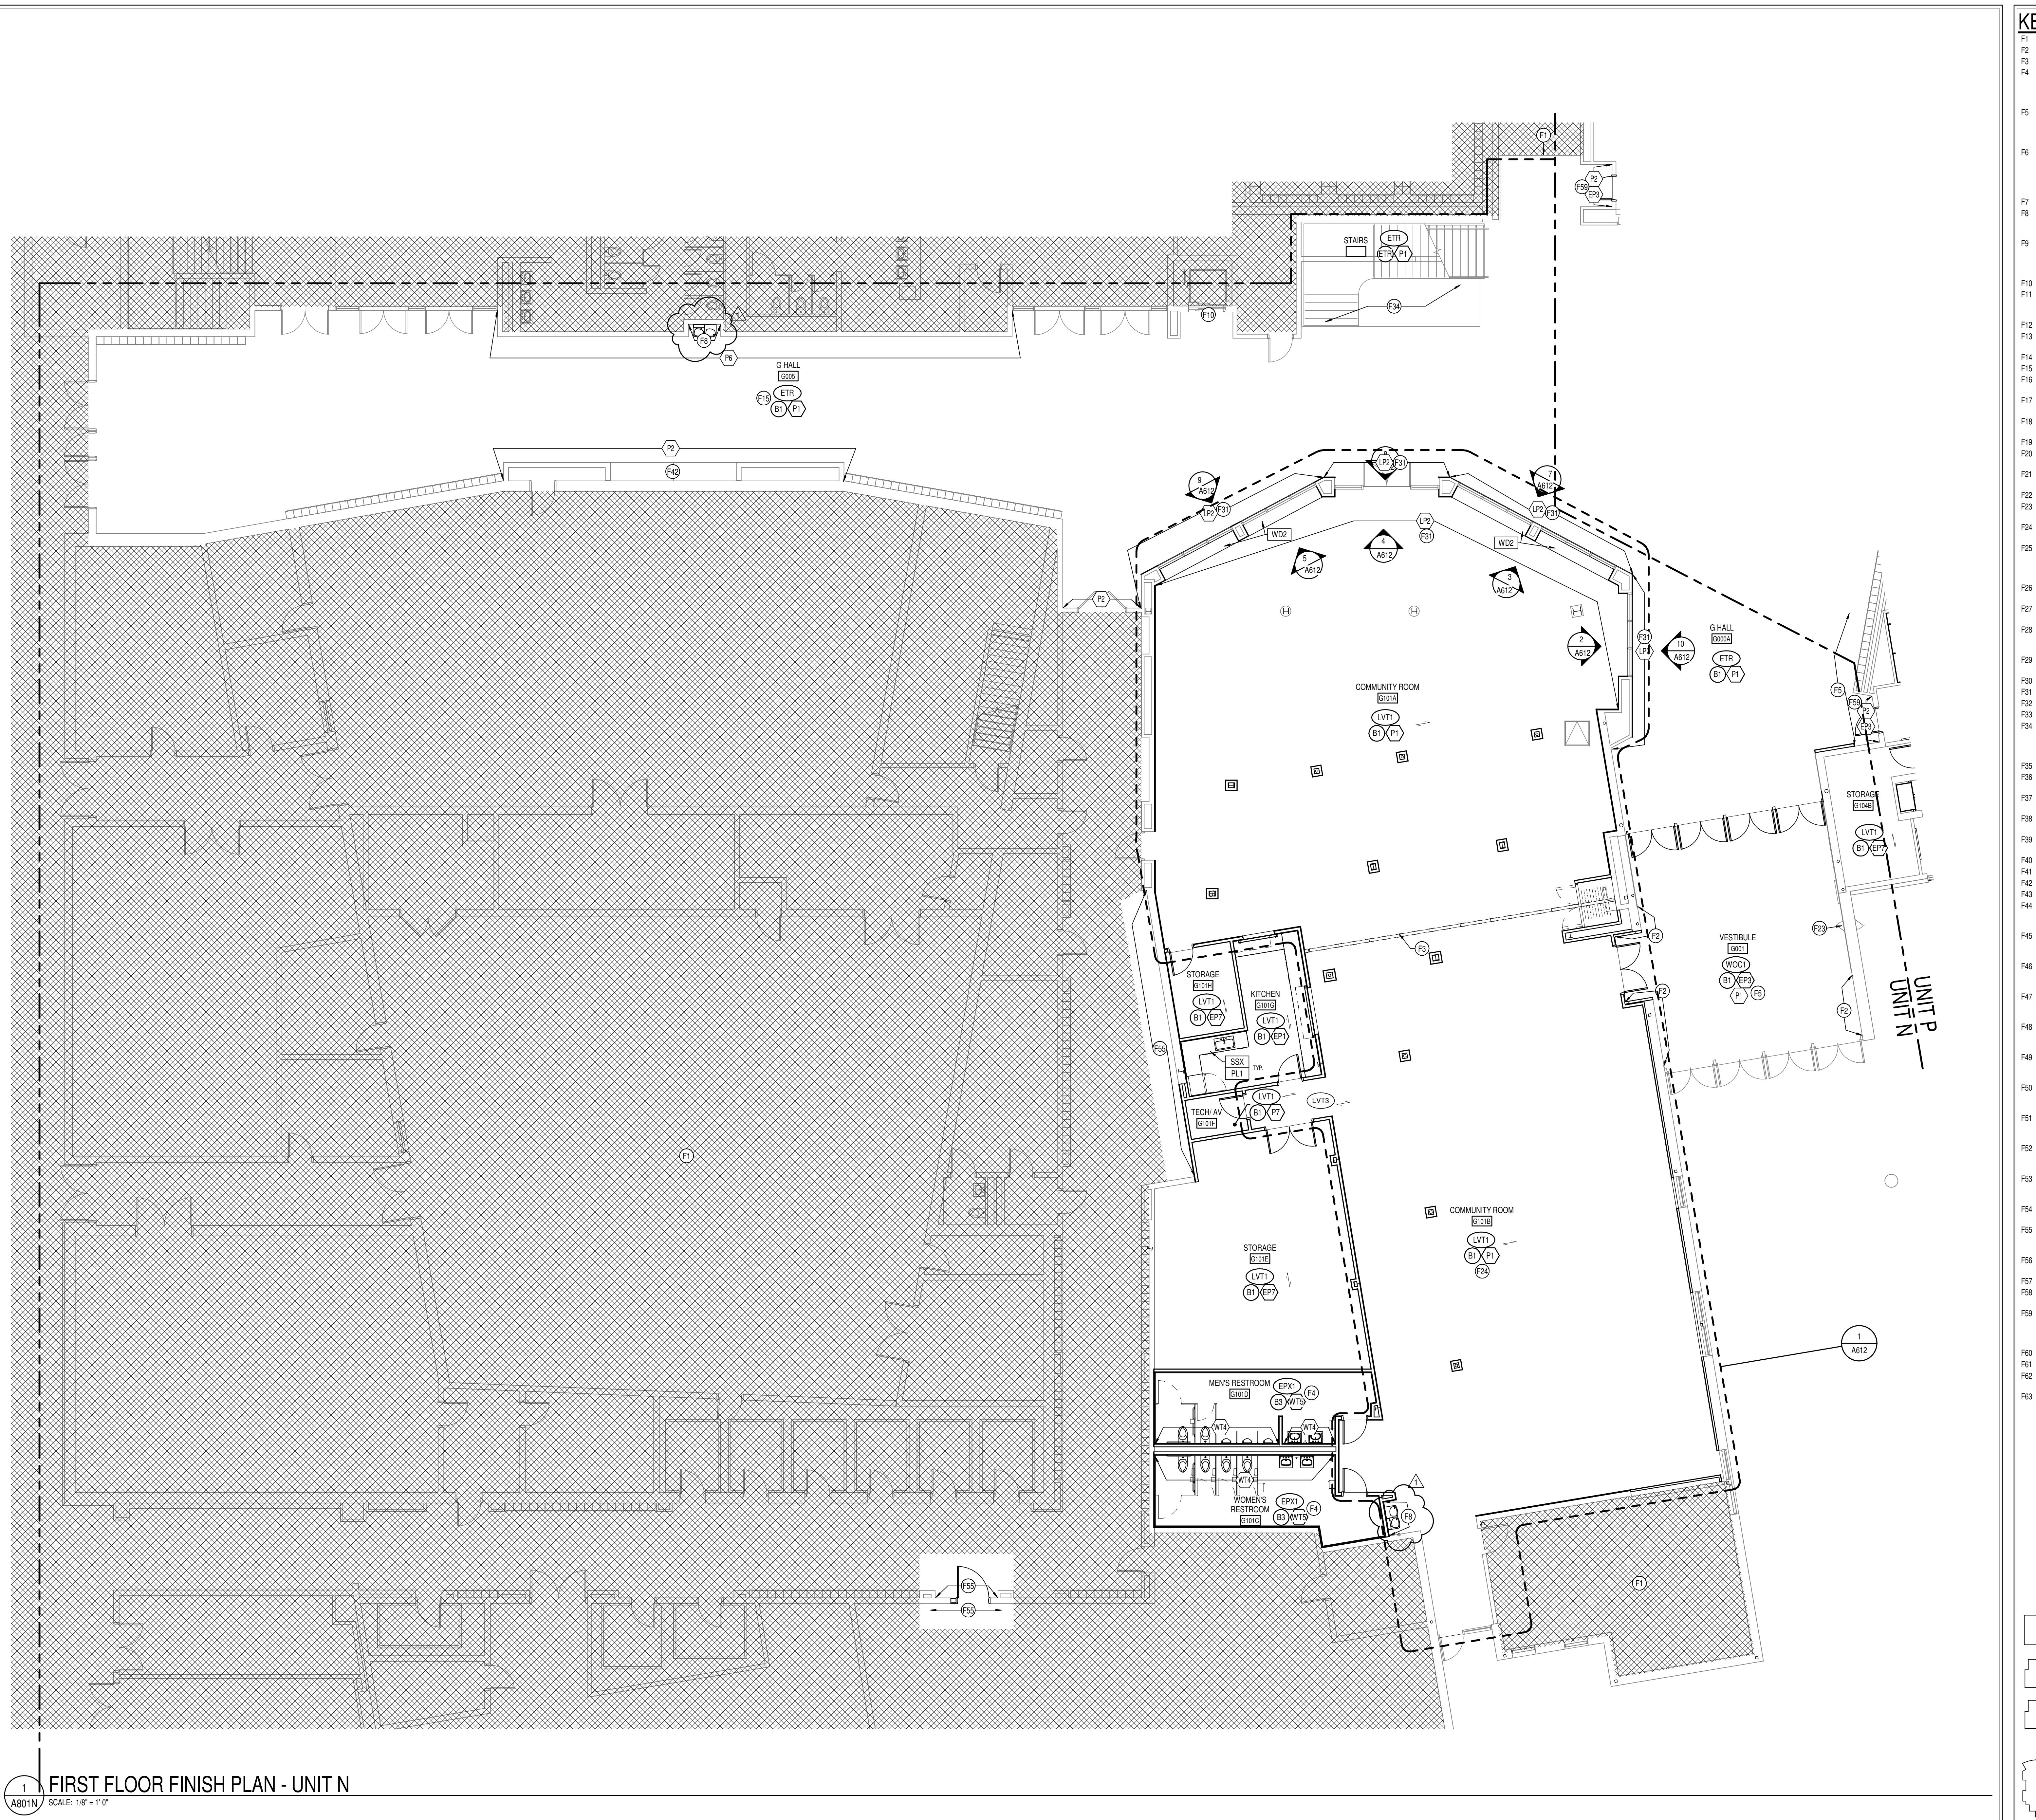

### KEYED FINISH NOTES

F1. NO WORK THIS AREA, UND.

F2. NO PAINT TO BE APPLIED TO ANY BRICK SURFACE OR NEW ACM COLUMN WRAPS.

F3. OPERABLE WALL PANEL FINISH TO BE APRT & DRY ERASE, BOTH SIDES.

F4. WTS TO BE INSTALLED VERTICAL STACK BOND FROM TOP OF BASE TO CEILING WTA TO BE INSTALLED 50% OFFSET HORIZONTAL FROM TOP OF BASE B3 TO CEILING. SEE ELEVATION 1/24800 FOR ADDITIONAL TILE INSTALL INFORMATION. ANY HVAC GRILLE TO BE REMOVED.

F5. EPI TO BE APPLIED FULL HEIGHT OF EXISTING STRUCTURAL GLAZED TILE (SEE SPECS FOR ADDITIONAL APPLICATION PREP & APPLICATION INFORMATION, & P1 TO BE APPLIED FROM TOP OF STRUCTURAL GLAZED TILE TO CEILING. SEE ELEVATION 11/14800).

F6. UNIT TO BE INSTALLED TO EXTENT OF REMOVED VCT OR CARPET TRIM AT BOTH ENDS TO BE SCHULTER UNIPRO & ACG CONTRACTOR RESPONSIBLE FOR PATCHING & LEVELING CONCRETE TO AVOID TELEGRAPHING THROUGH NEW LVT. NO WALL BASE TO BE APPLIED TO BRICK OR STRUCTURAL GLAZED COVE.

F7. NOT USED.

F8. WALL TO RECEIVE FINISH W1, W2, W3; SEE ELEVATION 5/4800 FOR MORE INFORMATION. THIS LOCATION TO RECEIVE SCHULTER JOLLY TRIM IN FINISH BRUSHED GRAPHITE ANODIZED ALUMINUM.

F9. TERRAZZO PATCH TO MATCH EXISTING IN COLOR, AGGREGATE, AND ZINC STRIP ELEVATOR AND COLOR. CONTRACTOR RESPONSIBLE FOR SUBMITTING SAMPLES OF ELEVATOR AND COLOR. TERRAZZO MATCH FOR APPROVAL. PATCH TO TERMINATE AT EXISTING ZINC STRIP.

F10. ELEVATOR DOORS & FRAMES TO BE PREPPED AND PAINTED TO MATCH P6.

F11. WTS TO BE INSTALLED 50% OFFSET HORIZONTAL FROM TOP OF BASE TO CEILING ON SIDE OF WALL ONLY. NO VERTICAL STACK BOND. 2.5 COURSINGS, WITH PAINT EPI. SEE ELEVATION 1/24800 FOR ADDITIONAL TILE INSTALLATION.

F12. CHANGE IN FLOORING FINISH TO OCCUR AT CORNER OF WALL INDICATED.

F13. COLUMNS IN AREA INDICATED TO BE PAINTED TO MATCH WALL COLOR IN ROOM/CORRIDOR.

F14. NOT USED.

F15. NO RUBBER WALL BASE TO BE APPLIED TO STRUCTURAL GLAZED COVE.

F16. MOP SINK WALLS AND/OR WALLS INDICATED TO RECEIVE FRP FROM FLOOR TO HEIGHT OF 8'0". COLOR TO BE CHOSEN FROM MFR'S COLOR RANGE.

F17. MAIL LOCKERS TO HAVE FINISH TO MATCH P6.

F18. WALL-MOUNTED GRILLE OR OTHER HVAC EQUIPMENT TO BE PAINTED TO MATCH ADJACENT WALL FINISH. PREP RECOMMENDED BY MFR.

F19. INSTALL SOLID SURFACE WINDOW STOOLS, TYP. AT ALL APPLICABLE WINDOW LOCATIONS. FINISH TO BE SSS.

F20. FLOORING FINISH INSTALLATION SHALL ACCOMMODATE EXISTING POWER/DATA DEVICES.

F21. MOP SINK WALLS AND/OR WALLS INDICATED TO RECEIVE FRP FROM FLOOR TO HEIGHT OF 8'0". COLOR TO BE CHOSEN FROM MFR'S COLOR RANGE.

F22. MAIL LOCKERS TO HAVE FINISH TO MATCH P6.

F23. WALL-MOUNTED GRILLE OR OTHER HVAC EQUIPMENT TO BE PAINTED TO MATCH ADJACENT WALL FINISH. PREP RECOMMENDED BY MFR.

F24. INSTALL SOLID SURFACE WINDOW STOOLS, TYP. AT ALL APPLICABLE WINDOW LOCATIONS. FINISH TO BE SSS.

F25. WTS TO BE INSTALLED VERTICAL STACK BOND 2.5 COURSINGS, WITH PAINT EPI ABOVE. SEE ELEVATION 4/4800. WTA TO BE INSTALLED 50% OFFSET HORIZONTAL FROM TOP OF BASE TO CEILING. SEE ELEVATION 3/4800. ANY HVAC GRILLES, ETC TO BE PAINTED TO MATCH P10.

F26. LECTURE INSTRUCTION STEPS TO RECEIVE FINISH LVT3 ON TREADS & RISERS. NOSING TO BE SCHULTER UNIPRO STEP-R ACC.

F27. STEPS TO RECEIVE FINISH LVT3 ON TREADS & RISERS. NOSING TO BE SCHULTER UNIPRO STEP-R ACC.

F28. OVERHEAD COILED DOOR TO BE PAINTED TO MATCH P6 IN ITS ENTIRETY. CONTRACTOR RESPONSIBLE FOR PROPER PREP AND FOR ENSURING DOOR IS FULLY OPERATIONAL AFTER RECEIVING FINISH.

F29. PAINT EXISTING MOSAIC TILE TO MATCH P1. FOLLOW MANUFACTURER'S RECOMMENDATIONS & SPECS FOR TILE PREP AND PAINT APPLICATION.

F30. NOT USED.

F31. WINDOW FRAMES TO BE PAINTED TO MATCH P6.

F32. NOT USED.

F33. NEW RUBBER STRINGER, TARKETT COLOR BLACK 40.

F34. FLOOR PATCH WITH TERRAZZO TO MATCH EXISTING ADJACENT TERRAZZO IN TYPE, FORMULA, & FINISH AND SHOULD BE PATCHED IN FULL TO THE NEAREST DIVIDER STRIP. NEW DIVIDER STRIPS TO MATCH EXISTING STRIPS IN THE NEAREST SIZE, AND FINISH. SAMPLES TO BE SUBMITTED FOR APPROVAL PRIOR TO ANY PATCHING.

F35. NOT USED.

F36. STAINLESS STEEL WALL PANELS TO BE INSTALLED AT SINK AREA. SINK EXISTING TO REMAIN.

F37. SHOWER TO RECEIVE FLOOR FINISH EPI. WALLS TO BE WTS. VERTICAL STACK BOND, FROM TOP OF BASE TO CEILING.

F38. TECH AV PANELS ON WALLS TO BE PAINTED TO MATCH P2; FRAMES PAINTED TO MATCH P6.

F39. FINISH EPI TO BE APPLIED UP TO TOP OF DOOR FRAME. P7 APPLIED FROM TOP OF DOOR FRAME TO DECK.

F40. CEILING/BULKHEAD ABOVE TO BE PAINTED P5.

F41. EXISTING WOOD TRIM TO BE PAINTED TO MATCH P6.

F42. ALL EXISTING TACK TO BE REPLACED WITH MATCH P6.

F43. CONCRETE TO RECEIVE FINISH EPI, TYP.

F44. COMPUTER NETWORK LOGO - 4X4 TO BE PAINTED IN GRAYSCALE USING EPI3 & EPI4. CENTERED ON WALL INDICATED. PAINT TRANSITIONS TO BE CRISP AND CLEAN. GRAPHIC FILE PROVIDED BY OWNER.

F45. CONSTRUCTION LOGO - 4X4 TO BE PAINTED IN GRAYSCALE USING EPI3 & EPI4. CENTERED ON WALL INDICATED. PAINT TRANSITIONS TO BE CRISP AND CLEAN. GRAPHIC FILE PROVIDED BY OWNER.

F46. MFR TRANSPORTATION LOGO - 4X4 TO BE PAINTED IN GRAYSCALE USING EPI3 & EPI4. CENTERED ON WALL INDICATED. PAINT TRANSITIONS TO BE CRISP AND CLEAN. GRAPHIC FILE PROVIDED BY OWNER.

F47. CRIMINAL JUSTICE LOGO - 4X4 TO BE PAINTED IN GRAYSCALE USING EPI3 & EPI4. CENTERED ON WALL INDICATED. PAINT TRANSITIONS TO BE CRISP AND CLEAN. GRAPHIC FILE PROVIDED BY OWNER.

F48. LOGISTICS LOGO - 4X4 TO BE PAINTED IN GRAYSCALE USING EPI3 & EPI4. CENTERED ON WALL INDICATED. PAINT TRANSITIONS TO BE CRISP AND CLEAN. GRAPHIC FILE PROVIDED BY OWNER.

F49. INDUSTRIAL LOGO - 4X4 TO BE PAINTED IN GRAYSCALE USING EPI3 & EPI4. CENTERED ON WALL INDICATED. PAINT TRANSITIONS TO BE CRISP AND CLEAN. GRAPHIC FILE PROVIDED BY OWNER.

F50. ROBOTICS LOGO - 4X4 TO BE PAINTED IN GRAYSCALE USING EPI3 & EPI4. CENTERED ON WALL INDICATED. PAINT TRANSITIONS TO BE CRISP AND CLEAN. GRAPHIC FILE PROVIDED BY OWNER.

F51. AUTO COLLISION LOGO - 4X4 TO BE PAINTED IN GRAYSCALE USING EPI3 & EPI4. CENTERED ON WALL INDICATED. PAINT TRANSITIONS TO BE CRISP AND CLEAN. GRAPHIC FILE PROVIDED BY OWNER.

F52. AUTO SERVICE LOGO - 4X4 TO BE PAINTED IN GRAYSCALE USING EPI3 & EPI4. CENTERED ON WALL INDICATED. PAINT TRANSITIONS TO BE CRISP AND CLEAN. GRAPHIC FILE PROVIDED BY OWNER.

F53. ENGINEERING LOGO - 4X4 TO BE PAINTED IN GRAYSCALE USING EPI3 & EPI4. CENTERED ON WALL INDICATED. PAINT TRANSITIONS TO BE CRISP AND CLEAN. GRAPHIC FILE PROVIDED BY OWNER.

F54. SCIENTIFIC LOGO - 4X4 TO BE PAINTED IN GRAYSCALE USING EPI3 & EPI4. CENTERED ON WALL INDICATED. PAINT TRANSITIONS TO BE CRISP AND CLEAN. GRAPHIC FILE PROVIDED BY OWNER.

F55. FINISH PATCHING DUE TO DEMO AND/OR NEW CONSTRUCTION MUST MATCH EXISTING IN FINISH TYPE & COLOR. CONTRACTOR MUST SUBMIT INFORMATION AND SAMPLES FOR THESE LOCATIONS.

F56. CASEWORK TO BE RECEIVING EPOXY RESINS FLOORING TO HAVE RUBBER BASE. NO FLOOR BASE TO BE APPLIED TO CASEWORK.

F57. FACES OF BULKHEAD ABOVE TO RECEIVE FINISH W1.

F58. SEE ELEVATION 15/4800 FOR TYPICAL STRUCTURAL GLAZED TILE & EPI PAINT APPLICATION AT STAIRS.

F59. AT CORRIDOR DOOR NICHES, EPI3 TO BE APPLIED FULL HEIGHT OF EXISTING STRUCTURAL GLAZED TILE (SEE EPI4 FOR ADDITIONAL TILE INSTALLATION). EPI4 TO BE APPLIED FROM TOP OF STRUCTURAL GLAZED TILE TO CEILING. SEE ELEVATION 10/4800.

F60. ALL SALON EQUIPMENT TO HAVE FINISHES P1 & SSS WHERE APPLICABLE.

F61. ALL FINISHES TO EXTEND TO LOFT AREA; RAILING TO BE PAINTED TO MATCH P6.

F62. THIN BRICK ON WALLS INDICATED TO BE BELDEN SIENNA BLEND VELVET. NO PAINT TO BE APPLIED TO ANY BRICK SURFACE.

F63. ACCENT PENDANT LIGHT TO BE KUZO LIGHTING CHROMA PD1706 BK. CONTACT TRACI ASHCRAFT, TASHCRAFT@SLSLINDIANA.COM

SCCSO

3831 Keystone Crossing, Indianapolis, IN 46240  
©2020 CCSO Architects, Inc. All rights reserved.

PROJECT:  
MSD OF WARREN TOWNSHIP  
WARREN CENTRAL HIGH SCHOOL  
PHASE 3 ADDITION & RENOVATION  
9500 E. 16th STREET, INDIANAPOLIS, IN 46229

SCOPE DRAWINGS:  
These drawings represent the scope of the project in terms of architectural design concept, the dimensions of the building, and the location of structural, mechanical and electrical systems. They are not to be construed as a contract. The requirements of the Contract, including the scope indicated or implied, the trade contractors shall furnish all items required for the proper execution and completion of the work.


REVISIONS:  
1 ADDENDUM #2 03-13-2023

ISSUE DATE DRAWN BY CHECKED BY  
02/21/2023 Author Checker

DRAWING TITLE:  
FIRST FLOOR  
FINISH PLAN -  
UNIT N

CERTIFIED BY:  
JAMES ROBERT PEPPER  
No. AR00900003  
REGISTERED ARCHITECT  
STATE OF INDIANA  
Signature

DRAWING NUMBER  
A801N  
PROJECT NUMBER  
2021056

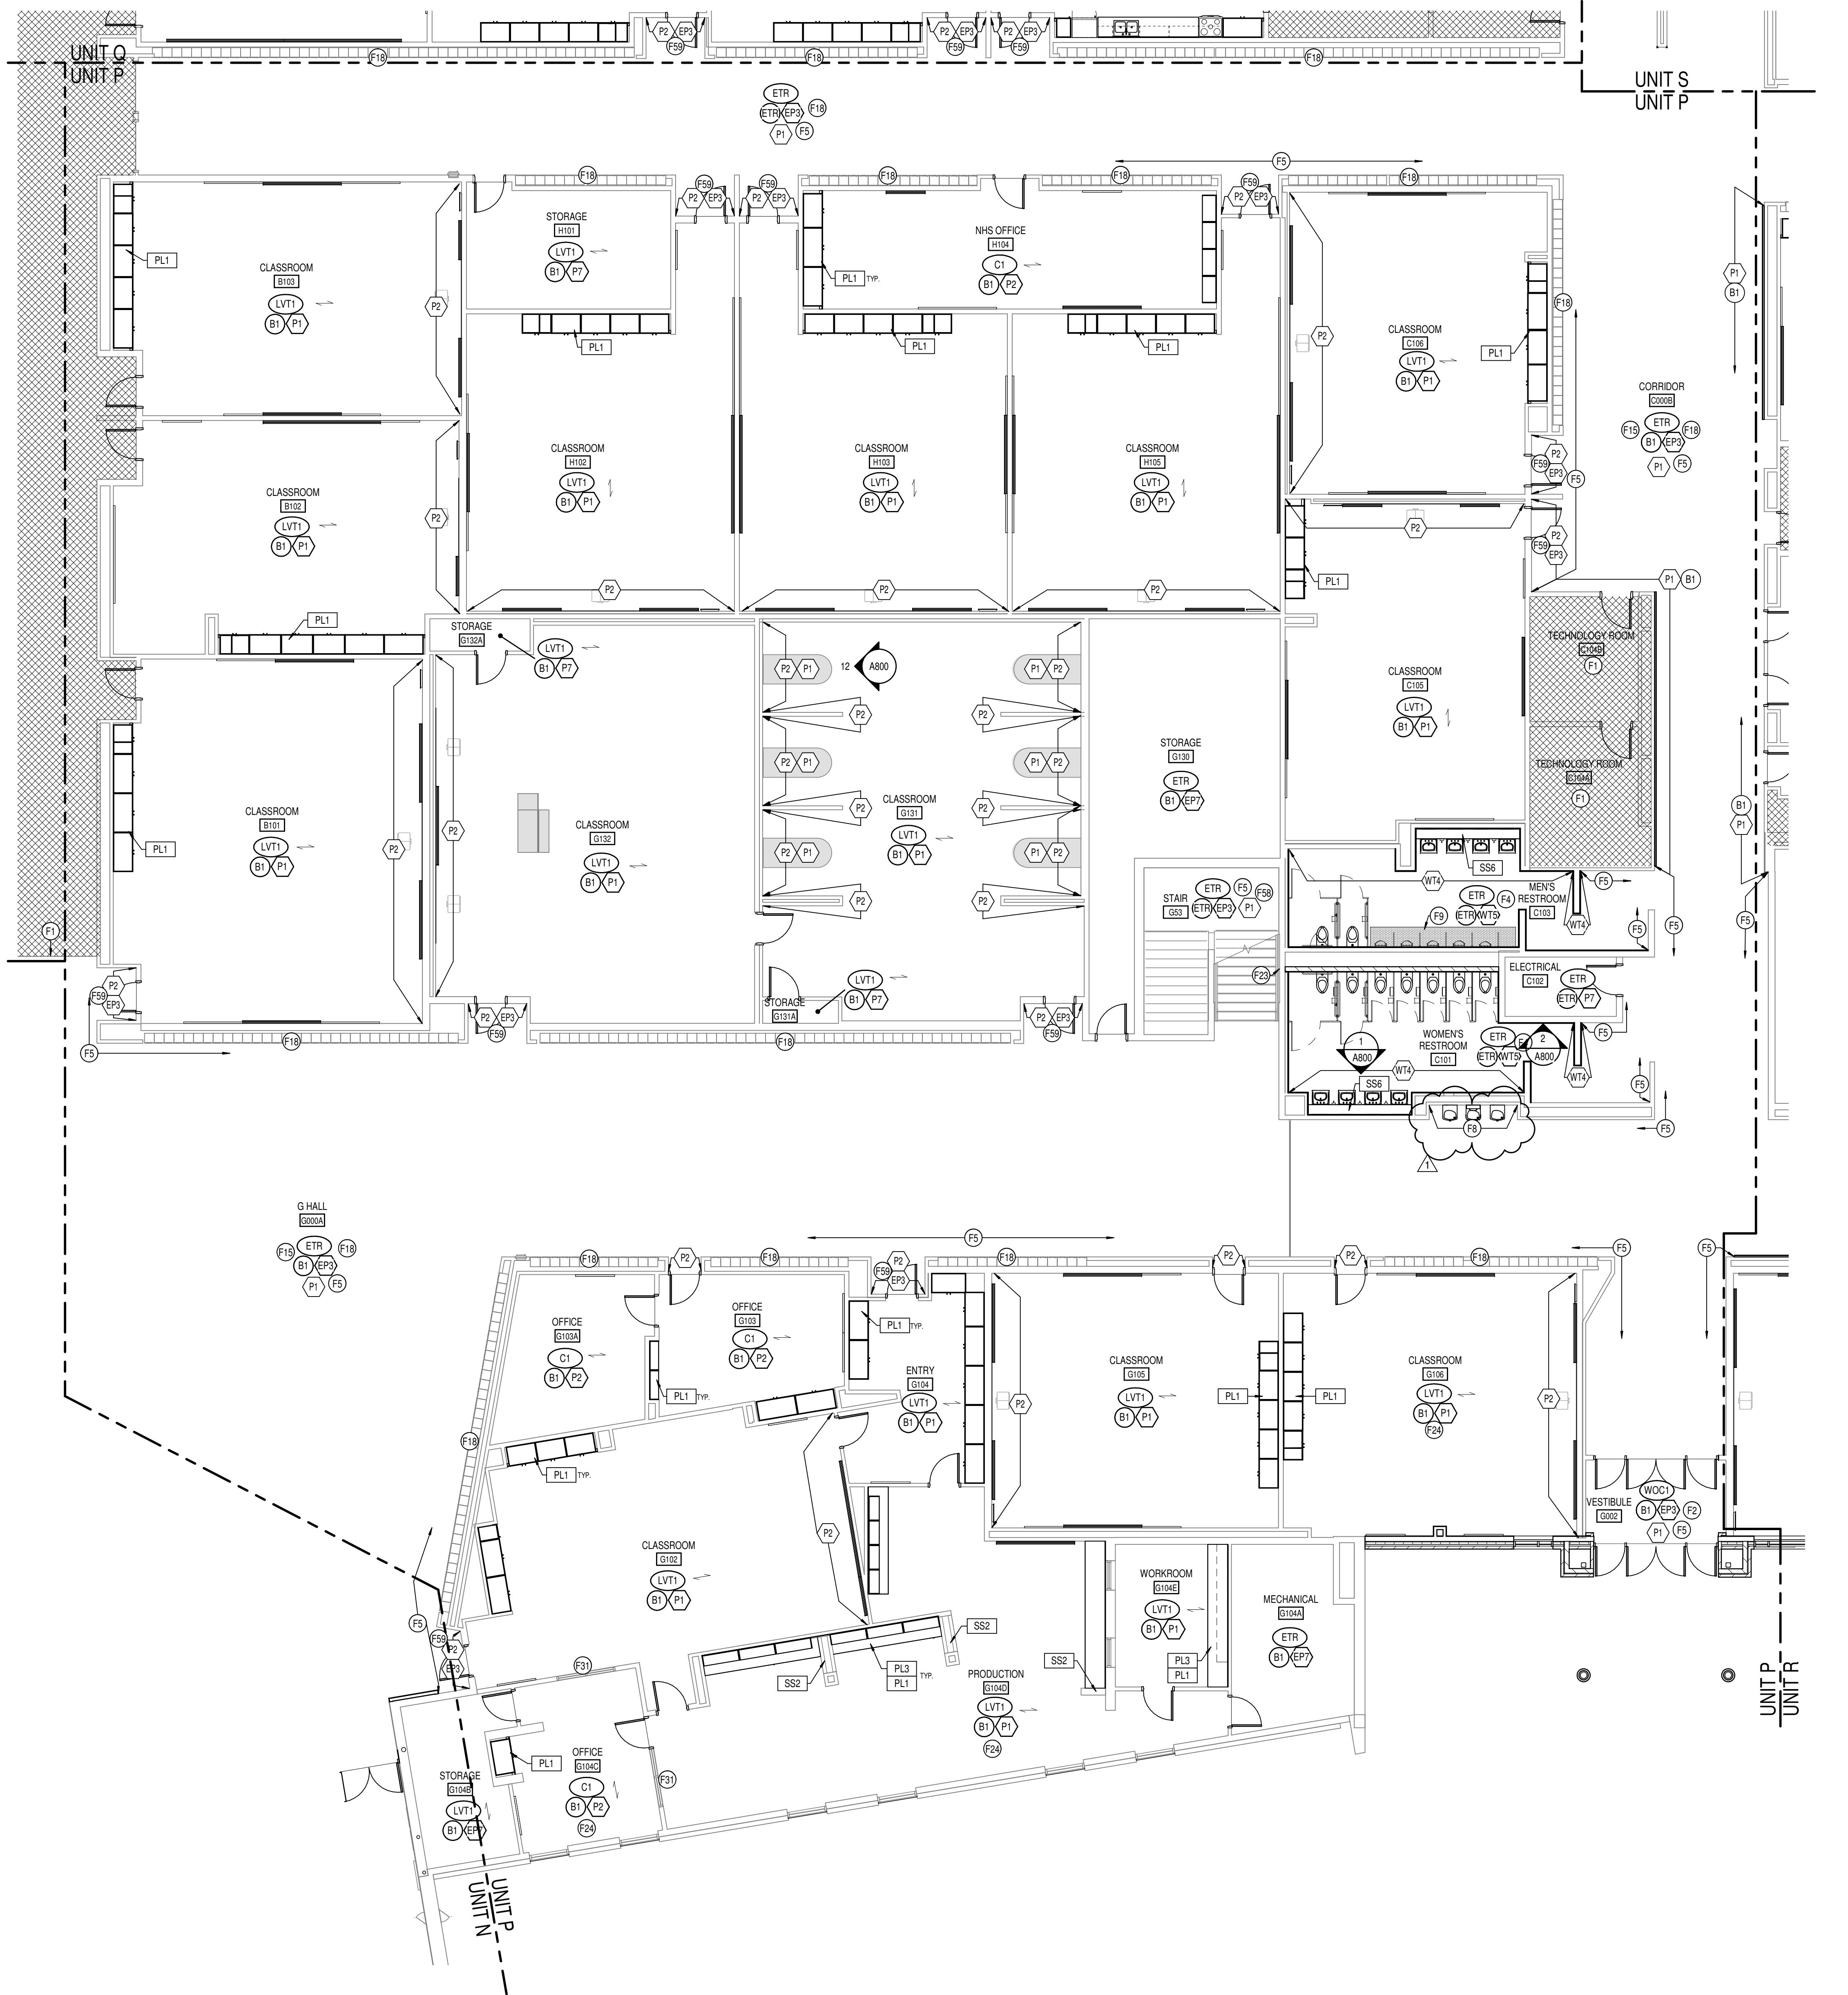

1 FIRST FLOOR FINISH PLAN - UNIT P  
A801P  
SCALE: 1/8" = 1'-0"

### KEYED FINISH NOTES

F1 NO WORKERS AREA UNLESS  
F2 NOT TO BE APPLIED TO ANY BRICK SURFACE OR NEW ACM COLUMN WRAPS.  
F3 INTELLIGIBLE WALL PANEL FINISH TO BE APPLIED & DRY ERASE, BOTH SIDES.  
F4 WT4 TO BE INSTALLED 50% OFFSET HORIZONTAL FROM TOP OF BASE B3 TO CEILING. SEE ELEVATION 1-2400 FOR ADDITIONAL TILE INSTALATION INFORMATION. ANY HVAC GRILLE, ETC. TO BE PAINTED TO MATCH EPI.  
F5 F1 TO BE APPLIED FULL HEIGHT OF EXISTING STRUCTURAL GLAZED TILE (SEE SPEC FOR ADDITIONAL APPLICATION PREP & APPLICATION INFORMATION), & F1 TO BE APPLIED FROM TOP OF STRUCTURAL GLAZED TILE TO CEILING. SEE ELEVATION 11A800.  
F6 LVT4 TO BE INSTALLED TO EXENT OF REMOVED VGT OR CHAPER TRIM AT BOTH ENDS TO BE SCHLUTER UNITS. SCHLUTER CONTRACTOR RESPONSIBLE FOR PATCHING & LEVELING CONCRETE TO AVOID TELEGRAPHING THROUGH NEW LVT. NO WALL BASE TO BE APPLIED TO BRICK OR STRUCTURAL COVE. LVT TO BE CLEANLY AND TIGHTLY SCRIBED TO EXISTING BRICK OR STRUCTURAL COVE.  
F7 NOT USED.  
F8 VGT TO RECEIVE FINISH WT1, WT2, WT3. SEE ELEVATION 5A800 FOR MORE INFORMATION. THIS LOCATION TO RECEIVE SCHLUTER JOLLY TRIM IN FINISH BRUSHED GRAPHITE ANODIZED ALUMINUM.  
F9 TERRAZZO PATCH TO MATCH EXISTING IN COLOR, AGGREGATE, AND ZINC STRIP PLACEMENT AND COLOR. CONTRACTOR RESPONSIBLE FOR SUBMITTING SAMPLES OF EVERY TERRAZZO MATCH FOR APPROVAL. PATCH TO TERMINATE AT EXISTING ZINC STRIP.  
F10 ELEVATOR DOORS & FRAMES TO BE PREPARED AND PAINTED TO MATCH P6.  
F11 WTS TO BE INSTALLED 50% OFFSET HORIZONTAL FROM TOP OF BASE TO CEILING ON SINK WALL ONLY. WTS TO BE INSTALLED VERTICAL STACK-BOND 2.5 COURSINGS, WITH PAINT P6 APPLIED TO REMAINING NON-WET WALLS. SEE ELEVATION 4A800.  
F12 CHANGE IN FLOORING FINISH TO OCCUR AT CORNER OF WALL INDICATED.  
F13 COLUMNS IN AREA INDICATED TO BE PAINTED TO MATCH WALL COLOR IN ROOM/CORRIDOR.  
F14 NOT USED.  
F15 NO RUBBER WALL BASE TO BE APPLIED TO STRUCTURAL GLAZED COVE.  
F16 WIRE BRUSH/PREPARE WIRE PARTITIONS. CONTRACTOR TO PROTECT HARDWARE. FLOORING FINISH INSTALLATION SHALL ACCOMMODATE EXISTING POWER/DATA CABLES.  
F17 NO SINK WALLS AND/OR WALLS INDICATED TO RECEIVE FRR FROM FLOOR TO HEIGHT OF 8' 0". COLOR TO BE CHOSEN FROM MFR'S FULL RANGE.  
F18 MAIL LOCKERS TO HAVE FINISH TO MATCH P6.  
F19 WALL-MOUNTED DRILL OR OTHER HVAC EQUIPMENT TO BE PAINTED TO MATCH ADJACENT WALL. PAINT P6 FOR ALL PREP RECOMMENDED BY MFR.  
F20 INTEGRAL SOLID SURFACE SHOW STOOLS, TYP. AT ALL APPLICABLE WINDOW LOCATIONS. FINISH TO BE SSS.  
F21 WTS TO BE INSTALLED VERTICAL STACK-BOND 2.5 COURSINGS, WITH PAINT EPI ABOVE. SEE ELEVATION 4A800. WT4 TO BE INSTALLED 50% OFFSET HORIZONTAL FROM TOP OF BASE B3 TO CEILING. SEE ELEVATION 3A800. ANY HVAC GRILLES, ETC. TO BE PAINTED TO MATCH P6.  
F22 LECTURE INSTRUCTION STEPS TO RECEIVE FINISH LVT3 ON TREADS & RISERS. NOSING TO BE SCHLUTER VINPRO-STEP P6 ACGB.  
F23 STEPS TO RECEIVE FINISH LVT3 ON TREADS AND RISERS. NOSING TO BE SCHLUTER VINPRO-STEP P6 ACGB.  
F24 OVERHEAD CONG DOOR TO BE PAINTED TO MATCH P6 IN ITS ENTIRETY. CONTRACTOR RESPONSIBLE FOR PROPER PREP AND FOR ENSURING DOOR IS FULLY OPERATIONAL AFTER RECEIVING FINISH.  
F25 PAINT EXISTING MOSAIC TILE TO MATCH P1. FOLLOW MANUFACTURER'S RECOMMENDATIONS & SPEC'S FOR TILE PREP AND PAINT APPLICATION.  
F26 NOT USED.  
F27 WINDOW FRAMES TO BE PAINTED TO MATCH P6.  
F28 NOT USED.  
F29 NEW RUBBER STRINGER, TARTETT COLOR BLACK 40.  
F30 FLOOR PATCH WITH TERRAZZO TO MATCH EXISTING ADJACENT TERRAZZO IN TYPE, FORMULA, & FINISH AND SHOULD BE PATCHED IN FULL TO THE NEAREST DIVIDER STRIP. ANY NEW DIVIDER STRIPS TO MATCH EXISTING STRIPS IN MATERIAL, SIZE, AND FINISH. SAMPLES TO BE SUBMITTED FOR APPROVAL PRIOR TO ANY PATCHING.  
F31 NOT USED.  
F32 NOT USED.  
F33 NEW RUBBER STRINGER, TARTETT COLOR BLACK 40.  
F34 FLOOR PATCH WITH TERRAZZO TO MATCH EXISTING ADJACENT TERRAZZO IN TYPE, FORMULA, & FINISH AND SHOULD BE PATCHED IN FULL TO THE NEAREST DIVIDER STRIP. ANY NEW DIVIDER STRIPS TO MATCH EXISTING STRIPS IN MATERIAL, SIZE, AND FINISH. SAMPLES TO BE SUBMITTED FOR APPROVAL PRIOR TO ANY PATCHING.  
F35 NOT USED.  
F36 STAINLESS STEEL WALL PANELS TO BE INSTALLED AT SINK AREA. SINK EXISTING TO REMAIN.  
F37 SHOWER TO RECEIVE FLOOR FINISH EPI. WALLS TO BE WTS, VERTICAL STACK BOND, FROM TOP OF BASE TO CEILING.  
F38 TECTUM PANELS ON WALLS TO BE PAINTED TO MATCH P2. FRAMES PAINTED TO MATCH P6.  
F39 FINISH EPI TO BE APPLIED UP TO TOP OF DOOR FRAME. P7 APPLIED FROM TOP OF DOOR FRAME TO DECK.  
F40 CEILING BULLHEAD ABOVE TO BE PAINTED P5.  
F41 EXISTING WOOD TRIM TO BE PAINTED TO MATCH P6.  
F42 ALL EXISTING TACK TO BE REPLACED WITH K3.  
F43 COLUMN TO RECEIVE FINISHES EPI & B1, TYP.  
F44 CONSTRUCTION NEUTRONIC LOGO - 4X4 TO BE PAINTED IN GRAYSCALE USING EPI & EPI, CENTERED ON WALL INDICATED. PAINT TRANSITIONS TO BE CRISP AND CLEAN. GRAPHIC FILE PROVIDED BY OWNER.  
F45 CONSTRUCTION JUSTICE LOGO - 4X4 TO BE PAINTED IN GRAYSCALE USING EPI & EPI, CENTERED ON WALL INDICATED. PAINT TRANSITIONS TO BE CRISP AND CLEAN. GRAPHIC FILE PROVIDED BY OWNER.  
F46 MFR TRANSPORTATION LOGO - 4X4 TO BE PAINTED IN GRAYSCALE USING EPI & EPI, CENTERED ON WALL INDICATED. PAINT TRANSITIONS TO BE CRISP AND CLEAN. GRAPHIC FILE PROVIDED BY OWNER.  
F47 CRIMINAL JUSTICE LOGO - 4X4 TO BE PAINTED IN GRAYSCALE USING EPI & EPI, CENTERED ON WALL INDICATED. PAINT TRANSITIONS TO BE CRISP AND CLEAN. GRAPHIC FILE PROVIDED BY OWNER.  
F48 LOGISTICS LOGO - 4X4 TO BE PAINTED IN GRAYSCALE USING EPI & EPI, CENTERED ON WALL INDICATED. PAINT TRANSITIONS TO BE CRISP AND CLEAN. GRAPHIC FILE PROVIDED BY OWNER.  
F49 WELDING LOGO - 4X4 TO BE PAINTED IN GRAYSCALE USING EPI & EPI, CENTERED ON WALL INDICATED. PAINT TRANSITIONS TO BE CRISP AND CLEAN. GRAPHIC FILE PROVIDED BY OWNER.  
F50 ROBOTICS LOGO - 4X4 TO BE PAINTED IN GRAYSCALE USING EPI & EPI, CENTERED ON WALL INDICATED. PAINT TRANSITIONS TO BE CRISP AND CLEAN. GRAPHIC FILE PROVIDED BY OWNER.  
F51 MFR LOGISTICS LOGO - 4X4 TO BE PAINTED IN GRAYSCALE USING EPI & EPI, CENTERED ON WALL INDICATED. PAINT TRANSITIONS TO BE CRISP AND CLEAN. GRAPHIC FILE PROVIDED BY OWNER.  
F52 AUTO SERVICE LOGO - 4X4 TO BE PAINTED IN GRAYSCALE USING EPI & EPI, CENTERED ON WALL INDICATED. PAINT TRANSITIONS TO BE CRISP AND CLEAN. GRAPHIC FILE PROVIDED BY OWNER.  
F53 ENGINEERING LOGO - 4X4 TO BE PAINTED IN GRAYSCALE USING EPI & EPI, CENTERED ON WALL INDICATED. PAINT TRANSITIONS TO BE CRISP AND CLEAN. GRAPHIC FILE PROVIDED BY OWNER.  
F54 SCHLUTER COVE DILEX-AKHA IN DARK ANTHRACITE TO BE USED AT ALL WALLS BETWEEN EXISTING TILE AND EXISTING TERRAZZO FLOORING.  
F55 PAINT PATCHING DUE TO EXISTING AND/OR NEW CONSTRUCTION MUST MATCH EXISTING IN FINISH TYPE & COLOR. CONTRACTOR MUST SUBMIT INFORMATION AND SAMPLES FOR THESE LOCATIONS.  
F56 CASEWORK IN ROOMS RECEIVING EPOXY RESINOUS FLOORING TO HAVE RUBBER BASE B1. NO EPOXY BASE TO BE APPLIED TO CASEWORK.  
F57 FAUCET TO RECEIVE FINISH WTS.  
F58 ELEVATION 10A800 FOR TYPICAL STRUCTURAL GLAZED TILE & GYP PAINT APPLICATION AT STAIRS.  
F59 AT CORRIDOR DOOR NICHES, EPI TO BE APPLIED FULL HEIGHT OF EXISTING STRUCTURAL GLAZED TILE (SEE SPEC FOR ADDITIONAL APPLICATION PREP & APPLICATION INFORMATION). EPI TO BE APPLIED FROM TOP OF STRUCTURAL GLAZED TILE TO CEILING. SEE ELEVATION 10A800.  
F60 ALL SALON EQUIPMENT TO HAVE FINISHES P1 & SSS WHERE APPLICABLE.  
F61 ALL FINISHES TO EXTEND TO LOFT AREA. RAILING TO BE PAINTED TO MATCH P6.  
F62 THIN BRICK ON WALLS INDICATED TO BE BELDEN SIENNA BLEND VELVET NO PAINT TO BE APPLIED TO ANY BRICK SURFACE.  
F63 ACCENT PENDANT LIGHT TO BE KUZO LIGHTING CHROMA PD1706 BK. CONTACT TRACI ASHCRAFT, TASHCRAFT@SLISINDIANA.COM

SCCSO  
3831 Keystone Crossing, Indianapolis, IN 46240

PROJECT:  
MSD OF WARREN TOWNSHIP

WARREN CENTRAL HIGH SCHOOL  
PHASE 3 ADDITION & RENOVATION  
9500 E. 6th STREET, INDIANAPOLIS, IN 46229

SCOPE DRAWINGS:  
These drawings are a portion of the project. The dimensions of the drawings are in inches. The drawings show the structural, mechanical and electrical systems. The drawings are not to be used for construction without the complete set of drawings and the requirements of the Contract.  
The drawings show the scope indicated or described by the trade contractors shall furnish all items required for the proper execution and completion of the work.

REVISIONS:  
1 ADDENDUM #2 03-13-2023


ISSUE DATE DRAWN BY CHECKED BY  
02-21-2023 Author Checker

DRAWING TITLE:  
FIRST FLOOR  
FINISH PLAN -  
UNIT P

CERTIFIED BY:  
JAMES ROBERT PEER  
REGISTERED ARCHITECT  
No. AR00900003  
STATE OF INDIANA  
J.R.P.

DRAWING NUMBER  
A801P

PROJECT NUMBER  
2021056

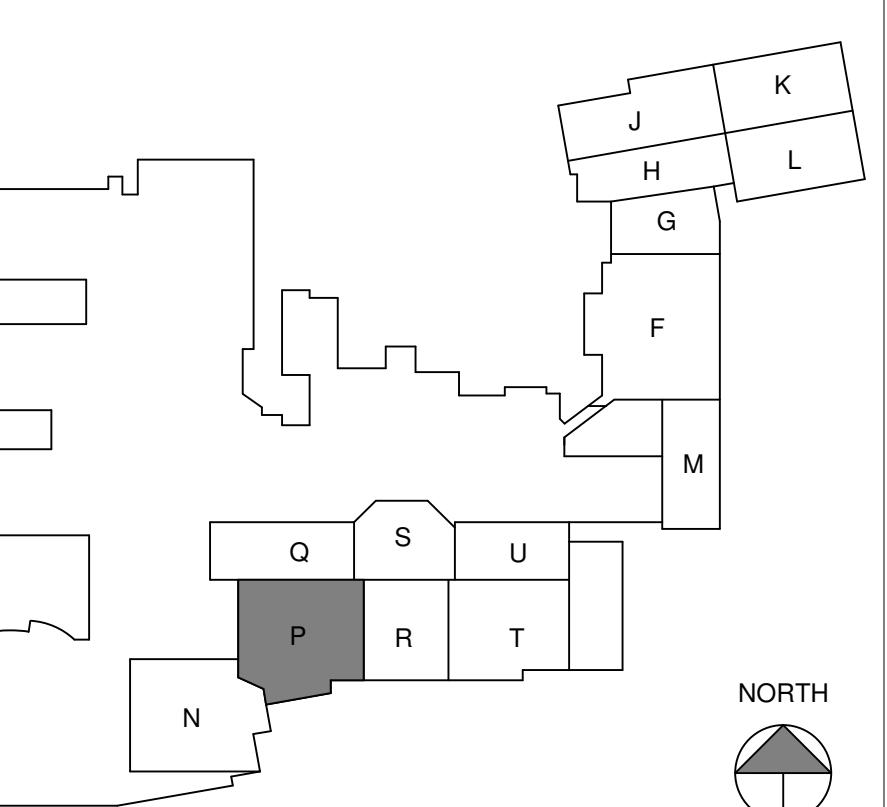





SCSO  
Keystone Crossing, Indianapolis, IN 46240

©2020 SCSO Architects, Inc. All rights reserved.  
317.448.7800 | csconet


PROJECT:  
WARREN CENTRAL HIGH SCHOOL  
PHASE 3 ADDITION & RENOVATION  
9500 E. 16th STREET, INDIANAPOLIS, IN 46229

SCOPE DRAWINGS:  
These drawings, in terms of the structural and electrical design concept, the dimensions of the building, the structural, mechanical and electrical systems, the fixtures, equipment and all other requirements of the Contract.

REVISIONS:  
1 ADDENDUM #2 03-13-2023

ISSUE DATE | DRAWN BY | CHECKED BY  
02-21-2023 | Author | Checker

DRAWING TITLE:  
FIRST FLOOR  
FINISH PLAN -  
UNIT T

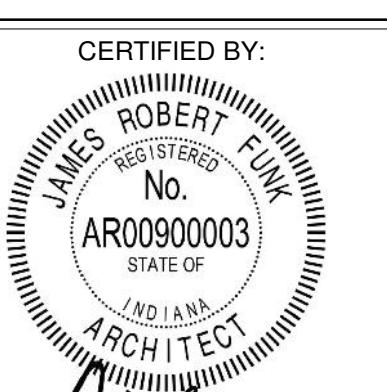



DRAWING NUMBER  
A801T

PROJECT NUMBER  
2021056

KEYED FINISH NOTES

F1 NO WORK IN THIS AREA, UNO.  
F2 NO PAINT TO BE APPLIED TO ANY BRICK SURFACE OR NEW ACM COLUMN WRAPS.  
F3 OPERABLE WALL PANEL FINISH TO BE A/P1 & DRY ERASE, BOTH SIDES.  
F4 WTS TO BE INSTALLED VERTICAL STACK-BOND FROM TOP OF BASE TO CEILING. WTA TO BE INSTALLED VERTICAL STACK-BOND 2.5 COURSING. SEE ELEVATION 1/2400 FOR ADDITIONAL TILE INSTALL INFORMATION. ANY HVAC GRILLES, ETC TO BE PAINTED TO MATCH EP1.  
F5 EP5 TO BE APPLIED FULL HEIGHT OF EXISTING STRUCTURAL GLAZED TILE (SEE SPECS FOR ADDITIONAL APPLICATION PREP & APPLICATION INFORMATION, & P1 TO BE APPLIED FROM TOP OF STRUCTURAL GLAZED TILE). LVT1 TO BE PAINTED TO MATCH.  
F6 LVT1 TO BE INSTALLED TO EXTENT OF REMOVED VCT OR CARPET. TRIM AT BOTH ENDS TO BE SCHLUTER VINPRO-S-CGB. CONTRACTOR RESPONSIBLE FOR PATCHING & LEVELING. CONTRACTOR TO RECEIVE SCHLUTER JOLLY TRIM IN THIS LOCATION TO RECEIVE SCHLUTER JOLLY TRIM IN FINISH BRUSHED GRAPHITE ANODIZED ALUMINUM.  
F7 NOT USED.  
F8 WALL TO RECEIVE FINISH WTR. WTR2: SEE ELEVATION 5/4800 FOR MORE INFORMATION. CONTRACTOR TO RECEIVE SCHLUTER JOLLY TRIM IN FINISH BRUSHED GRAPHITE ANODIZED ALUMINUM.  
F9 TERRAZZO PATCH TO MATCH EXISTING IN COLOR, AGGREGATE, AND ZINC STRIP PLACEMENT. CONTRACTOR RESPONSIBLE FOR SUBMITTING SAMPLES OF EVERY TERRAZZO MATCH FOR APPROVAL. PATCH TO TERMINATE AT EXISTING ZINC STRIP.  
F10 ELEVATOR DOORS & FRAMES TO BE PREPARED AND PAINTED TO MATCH P6.  
F11 WTS TO BE INSTALLED 50% OFFSET HORIZONTAL FROM TOP OF BASE TO CEILING ON SINK WALL ONLY. WTS TO BE INSTALLED VERTICAL STACK-BOND 2.5 COURSING, WITH PAINT EP1 ABOVE ON REMAINING NON-WET WALLS. SEE ELEVATION 4/4800.  
F12 CHANGE IN FLOORING FINISH TO OCCUR AT CORNER OF WALL INDICATED.  
F13 COLOR IN AREA INDICATED TO BE PAINTED TO MATCH WALL COLOR IN CORRIDOR.  
F14 NOT USED.  
F15 NO RUBBER WALL BASE TO BE APPLIED TO STRUCTURAL GLAZED COVE.  
F16 WIRE BRUSH/PREPARE WELDING CURTAIN HEADERS AND ROD & PAINT TO MATCH P6. CONTRACTOR TO PROTECT PVC STRIPS.  
F17 PARTIAL-HEIGHT STRUCTURAL GLAZED TILE IN CLASSROOM TO BE PAINTED TO MATCH P1 (SEE SPECIFICATIONS FOR MORE INFORMATION ON PREP & APPLICATIONS.)  
F18 LOCKERS TO BE PAINTED TO MATCH P6. SEE SPECIFICATIONS FOR PAINT TYPE & SHEEN.  
F19 WIRE BRUSH/PREPARE WIRE PARTITIONS. CONTRACTOR TO PROTECT HARDWARE.  
F20 FLOORING FINISH INSTALLATION SHALL ACCOMMODATE EXISTING POWER/DATA DEVICES.  
F21 MOULDING TO BE PAINTED TO RECEIVE FRP FROM FLOOR TO HEIGHT OF PAP. COLOR TO BE CHOSEN FROM PAP'S FULL RANGE.  
F22 MAIL LOCKERS TO HAVE FINISH TO MATCH P6.  
F23 WALL-MOUNTED GRILLE OR OTHER HVAC EQUIPMENT TO BE PAINTED TO MATCH ADJACENT WALL. FOLLOW ALL PREP RECOMMENDED BY MFR.  
F24 INSTALL SOLID SURFACE WINDOW STOOLS, TYP. AT ALL APPLICABLE WINDOW LOCATIONS. FINISH TO MATCH P6.  
F25 WTR TO BE INSTALLED VERTICAL STACK-BOND 2.5 COURSING, WITH PAINT EP1 ABOVE. SEE ELEVATION 4/4800. WTA TO BE INSTALLED 50% OFFSET HORIZONTAL FROM TOP OF BASE TO CEILING. SEE ELEVATION 3/4800. ANY HVAC GRILLES, ETC TO BE PAINTED TO MATCH P6.  
F26 LEGACY CONSTRUCTION STEPS TO RECEIVE FINISH LVT3 ON TREADS & RISERS. NOSING TO BE SCHLUTER VINPRO-STEP-R-ACB.  
F27 STEPS TO RECEIVE FINISH LVT1 ON TREADS AND RISERS. NOSING TO BE SCHLUTER VINPRO-STEP-R-ACB.  
F28 OVERHEAD COILING DOOR TO BE PAINTED TO MATCH P6 IN ITS ENTIRETY. CONTRACTOR RESPONSIBLE FOR PROPER PREP AND FOR ENSURING DOOR IS FULLY OPERATIONAL AFTER PAINTING.  
F29 PAINT EXISTING MOSAIC TILE TO MATCH P1. FOLLOW MANUFACTURER'S RECOMMENDATIONS & SPEC FOR TILE PREP AND PAINT APPLICATION.  
F30 NOT USED.  
F31 WINDOW FRAMES TO BE PAINTED TO MATCH P6.  
F32 NOT USED.  
F33 NEW RUBBER STRINGER. TARGET COLOR BLACK 40.  
F34 FLOOR PATCH WITH TERRAZZO TO MATCH EXISTING ADJACENT TERRAZZO IN TYPE, COLOR & FINISH AND SHOULD BE PATCHED IN FULL TO THE NEAREST GINGER STRIP. ANY NEW DIVIDER STRIPS TO MATCH EXISTING STRIPS IN MATERIAL, SIZE, AND FINISH. SAMPLES TO BE SUBMITTED FOR APPROVAL PRIOR TO ANY PATCHING.  
F35 NOT USED.  
F36 STAINLESS STEEL WALL PANELS TO BE INSTALLED AT SINK AREA, SINK EXISTING TO PAP. CONTRACTOR TO PAINT TO MATCH P6.  
F37 SHOWER TO RECEIVE FLOOR FINISH EP5. WALLS TO BE WTS, VERTICAL STACK BOND, FROM TOP OF BASE TO CEILING.  
F38 TECTUM PANELS ON WALLS TO BE PAINTED TO MATCH P2: FRAMES PAINTED TO MATCH P6.  
F39 FINISH EP7 TO BE APPLIED UP TO TOP OF DOOR FRAME. P7 APPLIED FROM TOP OF DOOR FRAME TO DECK.  
F40 CEILING BULLHEAD ABOVE TO BE PAINTED P5.  
F41 EXISTING WOOD TRIM TO BE PAINTED TO MATCH P6.  
F42 ALL EXISTING TACK TRIM TO BE REPLACED WITH K3.  
F43 COLUMN TO RECEIVE FINISHES EP5 & B1, TYP.  
F44 COMPUTER NETWORKING LOGO -4X4 TO BE PAINTED IN GRAYSCALE USING EP3 & EP4. CENTERED ON WALL INDICATED. PAINT TRANSITIONS TO BE CRISP AND CLEAN. GRAPHIC FILE PROVIDED BY OWNER.  
F45 CONSTRUCTION LOGO -4X4 TO BE PAINTED IN GRAYSCALE USING EP3 & EP4. CENTERED ON WALL INDICATED. PAINT TRANSITIONS TO BE CRISP AND CLEAN. GRAPHIC FILE PROVIDED BY OWNER.  
F46 MFR TRANSPORTATION LOGO -4X4 TO BE PAINTED IN GRAYSCALE USING EP3 & EP4. CENTERED ON WALL INDICATED. PAINT TRANSITIONS TO BE CRISP AND CLEAN. GRAPHIC FILE PROVIDED BY OWNER.  
F47 CRIMINAL JUSTICE LOGO -4X4 TO BE PAINTED IN GRAYSCALE USING EP3 & EP4. CENTERED ON WALL INDICATED. PAINT TRANSITIONS TO BE CRISP AND CLEAN. GRAPHIC FILE PROVIDED BY OWNER.  
F48 LIBRARY LOGO -4X4 TO BE PAINTED IN GRAYSCALE USING EP3 & EP4. CENTERED ON WALL INDICATED. PAINT TRANSITIONS TO BE CRISP AND CLEAN. GRAPHIC FILE PROVIDED BY OWNER.  
F49 WELDING LOGO -4X4 TO BE PAINTED IN GRAYSCALE USING EP3 & EP4. CENTERED ON WALL INDICATED. PAINT TRANSITIONS TO BE CRISP AND CLEAN. GRAPHIC FILE PROVIDED BY OWNER.  
F50 ROBOTICS LOGO -4X4 TO BE PAINTED IN GRAYSCALE USING EP3 & EP4. CENTERED ON WALL INDICATED. PAINT TRANSITIONS TO BE CRISP AND CLEAN. GRAPHIC FILE PROVIDED BY OWNER.  
F51 AUTO COLLISION LOGO -4X4 TO BE PAINTED IN GRAYSCALE USING EP2 & EP3. CENTERED ON WALL INDICATED. PAINT TRANSITIONS TO BE CRISP AND CLEAN. GRAPHIC FILE PROVIDED BY OWNER.  
F52 AUTO SERVICE LOGO -4X4 TO BE PAINTED IN GRAYSCALE USING EP3 & EP4. CENTERED ON WALL INDICATED. PAINT TRANSITIONS TO BE CRISP AND CLEAN. GRAPHIC FILE PROVIDED BY OWNER.  
F53 ENGINEERING LOGO -4X4 TO BE PAINTED IN GRAYSCALE USING EP3 & EP4. CENTERED ON WALL INDICATED. PAINT TRANSITIONS TO BE CRISP AND CLEAN. GRAPHIC FILE PROVIDED BY OWNER.  
F54 SCHLUTER COVE DILEX-AHKA IN DARK ANTHRACITE TO BE USED AT ALL WALLS BETWEEN NEW WALL AND EXISTING TERRAZZO FLOORING.  
F55 FINISH PATCHING DUE TO DEMO AND/OR NEW CONSTRUCTION MUST MATCH EXISTING INTERIOR FINISHES. CONTRACTOR MUST SUBMIT INFORMATION AND SAMPLES FOR THESE LOCATIONS.  
F56 CASEWORK IN ROOMS RECEIVING EPOXY RESINOUS FLOORING TO HAVE RUBBER BASE, B1, NO EPOXY BASE TO BE APPLIED TO CASEWORK.  
F57 FACES OF BULKHEAD ABOVE TO RECEIVE FINISH WTR.  
F58 SEE ELEVATION 15/4800 FOR TYPICAL STRUCTURAL GLAZED TILE & GYP PAINT APPLICATION.  
F59 AT CORRIDOR DOOR NICHES, EP2 TO BE APPLIED FULL HEIGHT OF EXISTING STRUCTURAL GLAZED TILE (SEE SPECS FOR ADDITIONAL APPLICATION PREP & APPLICATION INFORMATION, & P2 TO BE APPLIED FROM TOP OF STRUCTURAL GLAZED TILE).  
F60 ALL SALON EQUIPMENT TO HAVE FINISHED PL5 & S3 WHERE APPLICABLE.  
F61 ALL FINISHES TO EXTEND TO LOFT AREA. PAILING TO BE PAINTED TO MATCH P6.  
F62 THIN BRICK ON WALLS INDICATED TO BE BELDEN SIENA BLEND VELOUR. NO PAINT TO BE APPLIED TO ANY BRICK SURFACE.  
F63 ACCENT PENDANT LIGHT TO BE KUZO LIGHTING CHROMA PD1706 BK. CONTACT TRACI ASHCRAFT, TASHCRAFT@SLSiNDIANA.COM

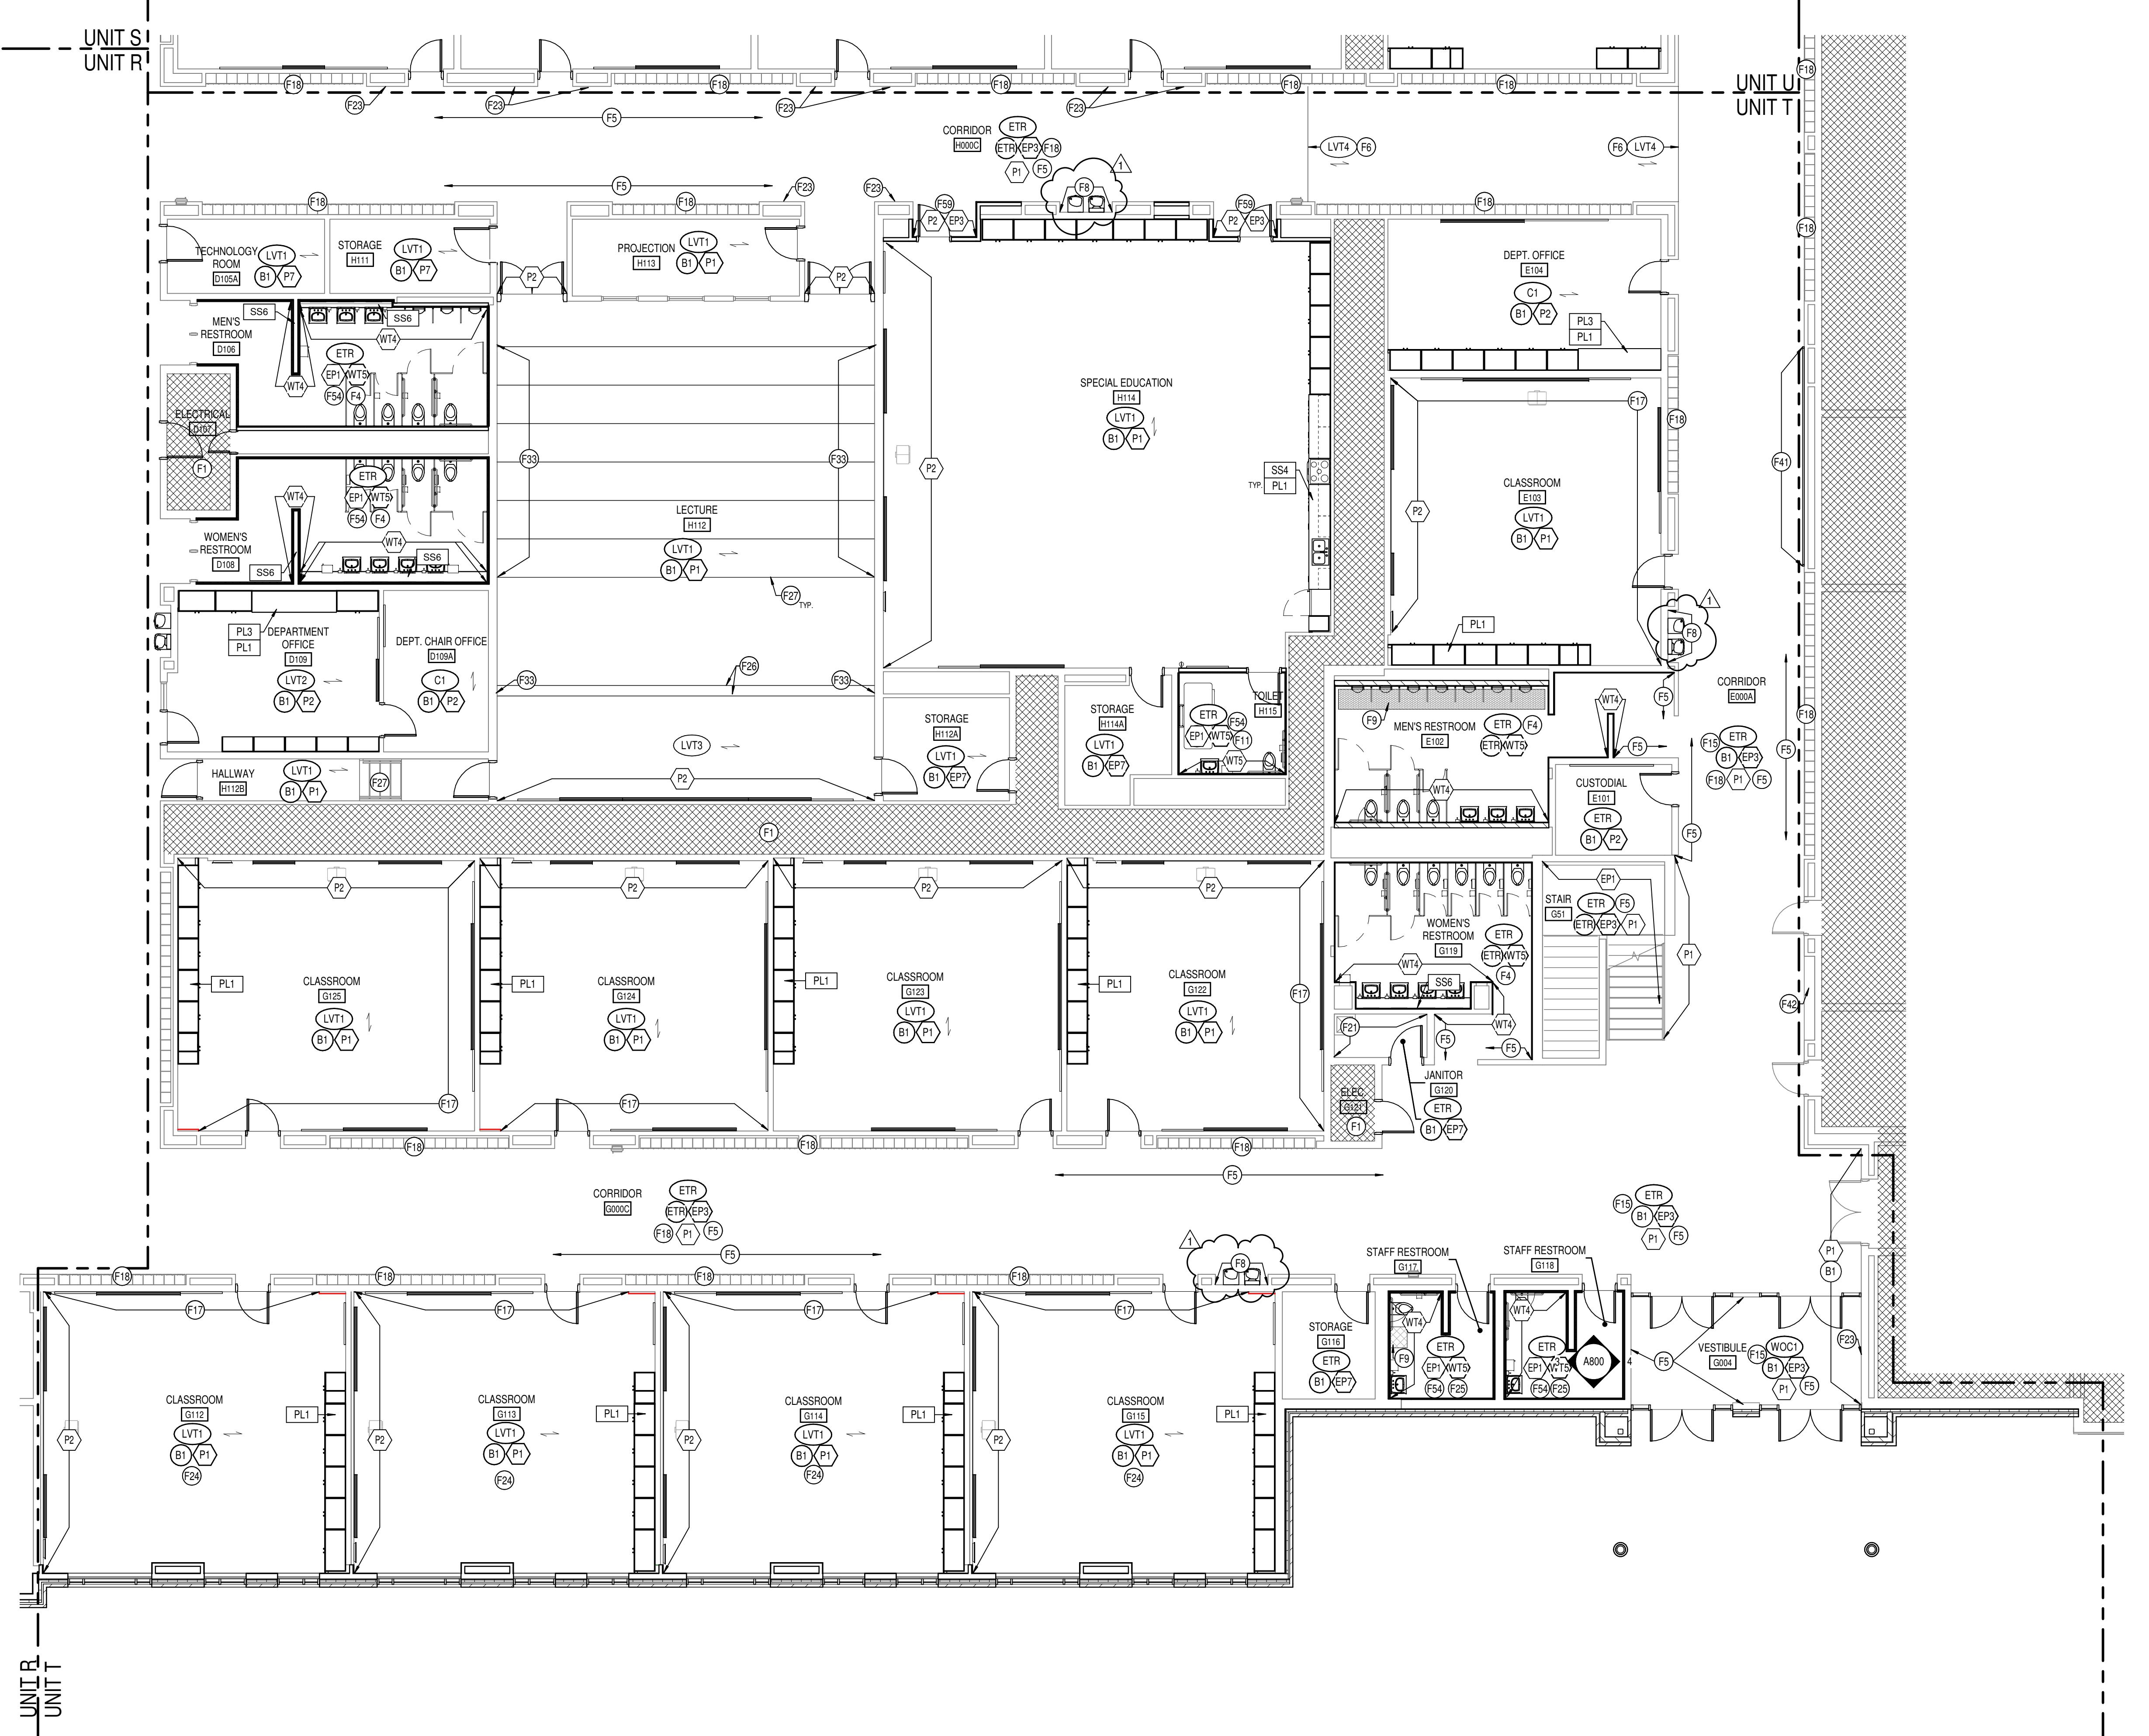

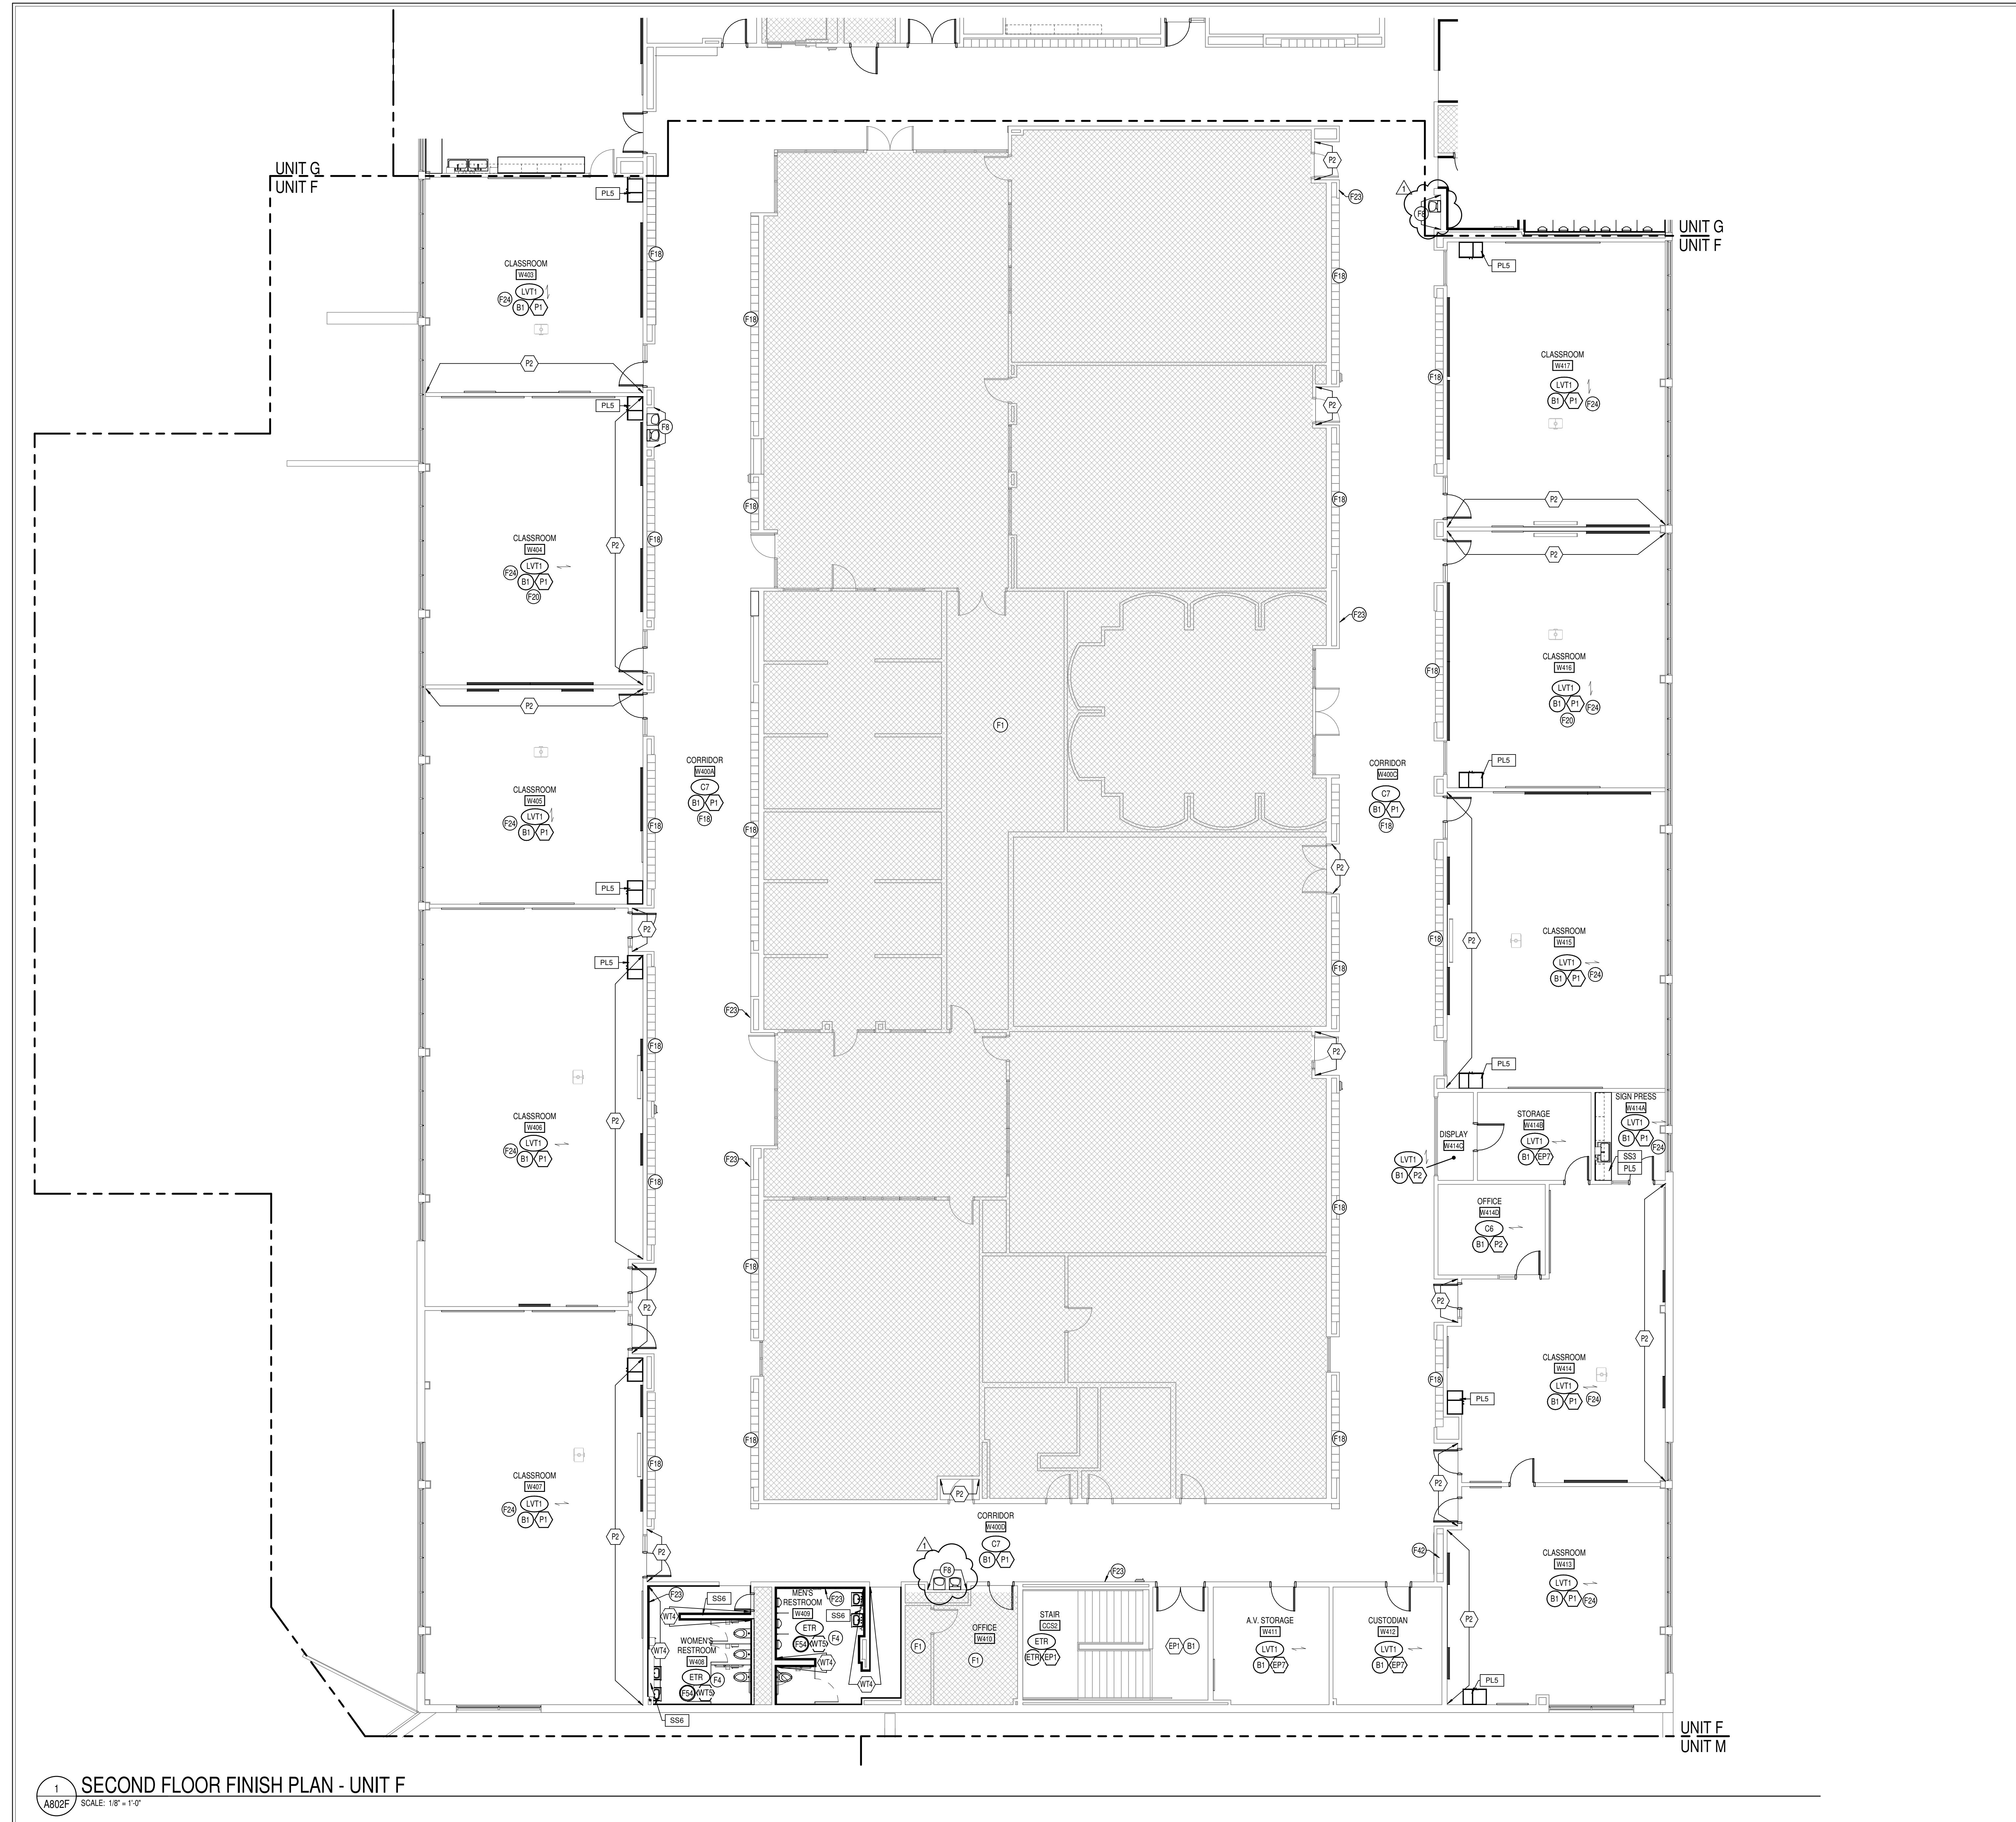

### KEYED FINISH NOTES

F1 NO PAINT TO BE APPLIED TO ANY BRICK SURFACE OR NEW ACM COLUMN WRAPS.  
 F2 NO PAINT TO BE APPLIED TO ANY BRICK SURFACE OR NEW ACM COLUMN WRAPS.  
 F3 EXTERIOR WALL PANEL FINISH TO BE ACRYLIC DRY ERASE, BOTH SIDES.  
 F4 WTS TO BE INSTALLED VERTICAL STACK BOND FROM TOP OF BASE TO CEILING. WTA TO BE INSTALLED 50% OFFSET HORIZONTAL FROM TOP OF BASE B3 TO CEILING. WTA ELEVATIONS 1-2/4" FOR ADDITIONAL TILE INSTALL INFORMATION, ANY HVAC GRILLES, ETC. TO BE APPLIED TO MATCH EPI.  
 F5 F1 TO APPLY FULL HEIGHT OF EXISTING STRUCTURAL GLAZED TILE (SEE SPECS FOR ADDITIONAL APPLICATION PREP & APPLICATION INFORMATION), & P1 TO BE APPLIED FROM TOP OF STRUCTURAL GLAZED TILE TO CEILING. SEE ELEVATION 11/14/00.  
 F6 LVT TO BE INSTALLED TO EXTENT OF REMOVED VOT OR CARPET TRIM AT BOTH ENDS TO TOP OF SCHLUTER UNIPRO AGER. CONTRACTOR RESPONSIBLE FOR PATCHING & LEVELING CONCRETE TO AVOID TELEGRAPHING THROUGH NEW LVT. NO WALL BASE TO BE APPLIED TO BRICK OR STRUCTURAL COVE. LVT TO BE CLEANLY AND TIGHTLY SCRIBED TO EXISTING BRICK OR STRUCTURAL GLAZED COVE.  
 F7 NOT USED.  
 F8 W1 TO RECEIVE FINISH W1, W2, W3; SEE ELEVATION 5/4/00 FOR MORE INFORMATION. THIS LOCATION TO RECEIVE SCHLUTER JOLLY TRIM IN FINISH BRUSHED GRAPHITE ANODIZED ALUMINUM.  
 F9 TERRAZZO PATCH TO MATCH EXISTING IN COLOR, AGGREGATE, AND ZINC STRIP PLACEMENT AND COLOR. CONTRACTOR RESPONSIBLE FOR SUBMITTING SAMPLES OF EPI. TERRAZZO PATCH FOR APPROVAL. PATCH TO TERMINATE AT EXISTING ZINC STRIP.  
 F10 ELEVATOR DOORS & FRAMES TO BE PREPPED AND PAINTED TO MATCH P6.  
 F11 WTS TO BE INSTALLED 50% OFFSET HORIZONTAL FROM TOP OF BASE TO CEILING ON SINK WALL ONLY. WTS TO BE INSTALLED VERTICAL STACK BOND 2.5 COURSINGS, WITH PAINT P1 TO BE APPLIED ON REMAINING NON-WET WALLS. SEE ELEVATION 4/4/00.  
 F12 CHANGE IN FLOORING FINISH TO OCCUR AT CORNER OF WALL INDICATED.  
 F13 COLUMNS IN AREA INDICATED TO BE PAINTED TO MATCH WALL COLOR IN ROOM/CORRIDOR.  
 F14 NOT USED.  
 F15 NO RUBBER WALL BASE TO BE APPLIED TO STRUCTURAL GLAZED COVE.  
 F16 WIRE BRUSH/PREPARE WELDING CURTAIN HEADERS AND ROD & PAINT TO MATCH P6. CONTRACTOR TO PROTECT PREP.  
 F17 PARTIAL HEIGHT OF EXISTING GLAZED TILE IN CLASSROOMS TO BE PAINTED TO MATCH P1 (SEE SPECIFICATIONS FOR MORE INFORMATION ON PREP & APPLICATIONS).  
 F18 LOCKERS TO BE PAINTED TO MATCH P6. SEE SPECIFICATIONS FOR PAINT TYPE & SHEEN.  
 F19 WIRE BRUSH/PREPARE WIRE PARTITIONS. CONTRACTOR TO PROTECT HARDWARE.  
 F20 FLOORING FINISH INSTALLATION SHALL ACCOMMODATE EXISTING POWERDATA DUCTWORK.  
 F21 MCR SINK WALLS AND/OR WALLS INDICATED TO RECEIVE FRP FROM FLOOR TO HEIGHT OF 8'0". COLOR TO BE CHOSEN FROM MFR'S FULL RANGE.  
 F22 MAIL LOCKERS TO HAVE FINISH TO MATCH P6.  
 F23 WALL-MOUNTED GRILLE OR OTHER HVAC EQUIPMENT TO BE PAINTED TO MATCH ADJACENT WALLS. ADJACENT WALL PREP RECOMMENDED BY MFR.  
 F24 INDOOR SOLID SURFACE SHOW STOOLS, TYP. AT ALL APPLICABLE WINDOW LOCATIONS. FINISH TO BE SSS.  
 F25 WTS TO BE INSTALLED VERTICAL STACK BOND 2.5 COURSINGS, WITH PAINT EPI ABOVE. SEE ELEVATION 4/4/00. WTA TO BE INSTALLED 50% OFFSET HORIZONTAL FROM TOP OF BASE B3 TO CEILING. SEE ELEVATION 3/4/00. ANY HVAC GRILLES, ETC. TO BE PAINTED TO MATCH P6.  
 F26 LECTURE INSTRUCTION STEPS TO RECEIVE FINISH LVT3 ON TREADS & RISERS. NOSING TO BE SCHLUTER VINPRO-STEP R ACGB.  
 F27 STEPS TO RECEIVE FINISH LVT3 ON TREADS AND RISERS. NOSING TO BE SCHLUTER VINPRO-STEP R ACGB.  
 F28 OVERHEAD CLOSET DOOR TO BE PAINTED TO MATCH P6 IN ITS ENTIRETY. CONTRACTOR RESPONSIBLE FOR PROPER PREP AND FOR ENSURING DOOR IS FULLY OPERATIONAL AFTER RECEIVING FINISH.  
 F29 PAINT EXISTING MOSAIC TILE TO MATCH P1. FOLLOW MANUFACTURER'S RECOMMENDATIONS & SPECS FOR TILE PREP AND PAINT APPLICATION.  
 F30 NOT USED.  
 F31 WINCOP FRAMES TO BE PAINTED TO MATCH P6.  
 F32 NOT USED.  
 F33 NEW RUBBER STRINGER, TARTETT COLOR BLACK 40.  
 F34 FLOOR PATCH WITH TERRAZZO TO MATCH EXISTING ADJACENT TERRAZZO IN TYPE, FORMULA, & FINISH AND SHOULD BE PATCHED IN FULL TO THE NEAREST DIVIDER STRIP. ANY NEW DIVIDER STRIPS TO MATCH EXISTING STRIPS IN MATERIAL, SIZE, AND FINISH. SAMPLES TO BE SUBMITTED FOR APPROVAL PRIOR TO ANY PATCHING.  
 F35 NOT USED.  
 F36 STAINLESS STEEL WALL PANELS TO BE INSTALLED AT SINK AREA. SINK EXISTING TO REMAIN.  
 F37 SHOWER TO RECEIVE FLOOR FINISH EPI. WALLS TO BE WTS, VERTICAL STACK BOND, FROM TOP OF BASE TO CEILING.  
 F38 TECTUM PANELS ON WALLS TO BE PAINTED TO MATCH P2. FRAMES PAINTED TO MATCH P6.  
 F39 FINISH EPI TO BE APPLIED UP TO TOP OF DOOR FRAME. P7 APPLIED FROM TOP OF DOOR FRAME TO DECK.  
 F40 CEILING/BULKEAD ABOVE TO BE PAINTED P5.  
 F41 EXISTING WOOD TRIM TO BE PAINTED TO MATCH P6.  
 F42 ALL EXISTING TACK TO BE REPLACED WITH T3.  
 F43 COLUMN TO RECEIVE FINISHES EPI & B1, TYP.  
 F44 CONSTRUCTION NEUTRALIZING LOGO - 4X4 TO BE PAINTED IN GRAYSCALE USING EPI & EPI, CENTERED ON WALL INDICATED. PAINT TRANSITIONS TO BE CRISP AND CLEAN. GRAPHIC FILE PROVIDED BY OWNER.  
 F45 MFR TRANSPORTATION LOGO - 4X4 TO BE PAINTED IN GRAYSCALE USING EPI & EPI, CENTERED ON WALL INDICATED. PAINT TRANSITIONS TO BE CRISP AND CLEAN. GRAPHIC FILE PROVIDED BY OWNER.  
 F46 CRIMINAL JUSTICE LOGO - 4X4 TO BE PAINTED IN GRAYSCALE USING EPI & EPI, CENTERED ON WALL INDICATED. PAINT TRANSITIONS TO BE CRISP AND CLEAN. GRAPHIC FILE PROVIDED BY OWNER.  
 F47 LOGISTICS LOGO - 4X4 TO BE PAINTED IN GRAYSCALE USING EPI & EPI, CENTERED ON WALL INDICATED. PAINT TRANSITIONS TO BE CRISP AND CLEAN. GRAPHIC FILE PROVIDED BY OWNER.  
 F48 WELDING LOGO - 4X4 TO BE PAINTED IN GRAYSCALE USING EPI & EPI, CENTERED ON WALL INDICATED. PAINT TRANSITIONS TO BE CRISP AND CLEAN. GRAPHIC FILE PROVIDED BY OWNER.  
 F49 AUTO SERVICE LOGO - 4X4 TO BE PAINTED IN GRAYSCALE USING EPI & EPI, CENTERED ON WALL INDICATED. PAINT TRANSITIONS TO BE CRISP AND CLEAN. GRAPHIC FILE PROVIDED BY OWNER.  
 F50 ROBOTICS LOGO - 4X4 TO BE PAINTED IN GRAYSCALE USING EPI & EPI, CENTERED ON WALL INDICATED. PAINT TRANSITIONS TO BE CRISP AND CLEAN. GRAPHIC FILE PROVIDED BY OWNER.  
 F51 MURKIN LOGO - 4X4 TO BE PAINTED IN GRAYSCALE USING EPI & EPI, CENTERED ON WALL INDICATED. PAINT TRANSITIONS TO BE CRISP AND CLEAN. GRAPHIC FILE PROVIDED BY OWNER.  
 F52 ENGINEERING LOGO - 4X4 TO BE PAINTED IN GRAYSCALE USING EPI & EPI, CENTERED ON WALL INDICATED. PAINT TRANSITIONS TO BE CRISP AND CLEAN. GRAPHIC FILE PROVIDED BY OWNER.  
 F53 SCHLUTER COVE DILEX-AHK IN DILEX-ANTHRAZITE TO BE USED AT ALL WALLS BETWEEN EXISTING TILE AND EXISTING TERRAZZO FLOORING.  
 F54 FINISH PATCHING OVER EXISTING AND/OR NEW CONSTRUCTION MUST MATCH EXISTING IN FINISH TYPE & COLOR. CONTRACTOR MUST SUBMIT INFORMATION AND SAMPLES FOR THESE LOCATIONS.  
 F55 CASEWORK IN ROOMS RECEIVING EPOXY RESINOUS FLOORING TO HAVE RUBBER BASE B1. NO EPOXY BASE CAN BE USED ON CASEWORK.  
 F56 CEILINGS TO RECEIVE FINISH WTS.  
 F57 CEILINGS TO RECEIVE FINISH WTS.  
 F58 SEE ELEVATION 15/4/00 FOR TYPICAL STRUCTURAL GLAZED TILE & GYP PAINT APPLICATION ON STAIRS.  
 F59 AT CORRIDOR DOOR NICHES, EPI TO BE APPLIED FULL HEIGHT OF EXISTING STRUCTURAL GLAZED TILE (SEE SPECS FOR ADDITIONAL APPLICATION PREP & APPLICATION). EPI TO BE APPLIED FROM TOP OF STRUCTURAL GLAZED TILE TO CEILING. SEE ELEVATION 10/4/00.  
 F60 ALL SALON EQUIPMENT TO HAVE FINISHES P6 & SSS WHERE APPLICABLE.  
 F61 ALL FINISHES TO EXTEND TO LOFT AREA. FAILING TO BE PAINTED TO MATCH P6.  
 F62 THIN BRICK ON WALLS INDICATED TO BE BELDEN SIENNA BLEND VELOUR. NO PAINT TO BE APPLIED TO ANY BRICK SURFACE.  
 F63 ACCENT PENDANT LIGHT TO BE KUZZO LIGHTING CHROMA PD1706 BK. CONTACT TRACI ASHCRAFT, TASHCRAFT@SLSIINDIANA.COM

SCCSO

8831 Keystone Crossing, Indianapolis, IN 46240

© 2020 CCSO Architects, Inc. All Rights Reserved

PROJECT:  
MSD OF WARREN TOWNSHIP  
WARREN CENTRAL HIGH SCHOOL  
PHASE 3 ADDITION & RENOVATION  
9500 E. 16th STREET, INDIANAPOLIS, IN 46229


SCOPE DRAWINGS:  
These drawings represent the scope of the project in terms of architectural design concept, the dimensions of the structure, and the details of the structural, mechanical and electrical systems. They are intended to describe all the requirements of the Contract.

REVISIONS:

1 ADDENDUM #2 03-13-2023


ISSUE DATE 02-21-2023 DRAWN BY Author CHECKED BY Checker

DRAWING TITLE:  
SECOND FLOOR  
FINISH PLAN -  
UNIT F

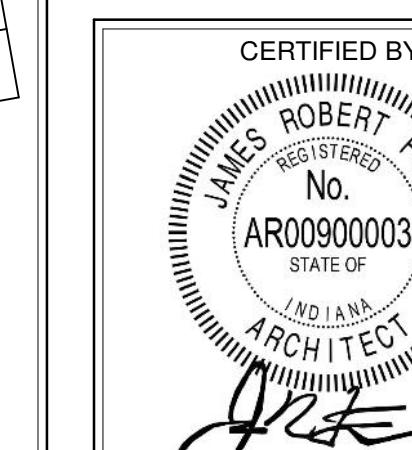

DRAWING NUMBER  
A802F

PROJECT NUMBER  
2021056

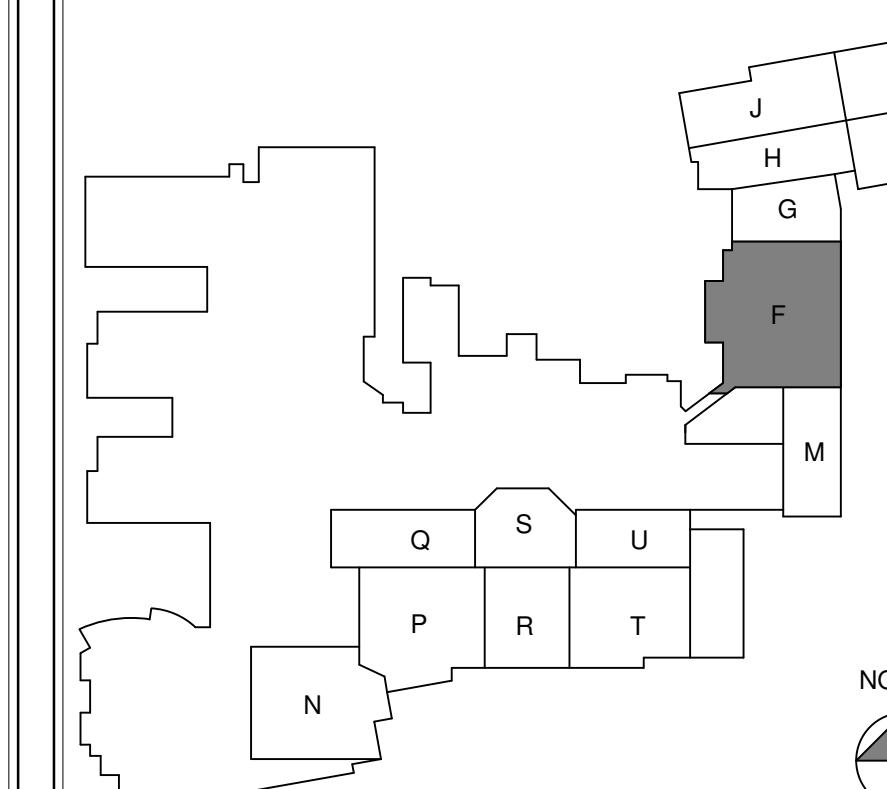



SCCSO  
3831 Keystone Crossing, Indianapolis, IN 46240

©2020 CCSO Architects, Inc. All rights reserved.

PROJECT:  
WARREN CENTRAL HIGH SCHOOL  
PHASE 3 ADDITION & RENOVATION  
9500 E. 6th STREET, INDIANAPOLIS, IN 46229


SCOPE DRAWINGS:  
These drawings represent the scope of the project in terms of the structural, mechanical and electrical systems. The drawings and specifications shall describe all the requirements of the Contract.

REVISIONS:

1 ADDENDUM #2 03-13-2023

ISSUE DATE 02-21-2023 DRAWN BY Author CHECKED BY Checker

DRAWING TITLE:  
SECOND FLOOR  
FINISH PLAN -  
UNIT N

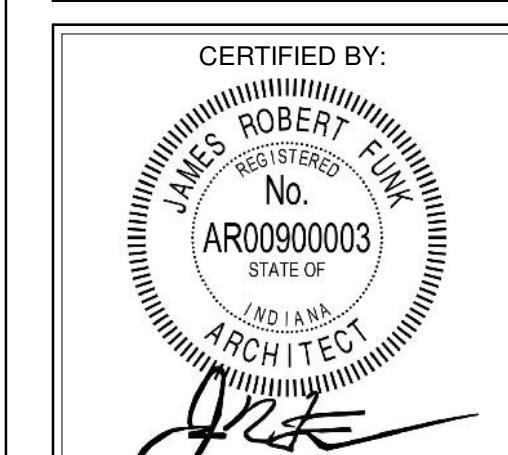

DRAWING NUMBER  
A802N

PROJECT NUMBER  
2021056

KEYED FINISH NOTES

F1 NO WORK IN THIS AREA, UND.

F2 NO PAINT TO BE APPLIED TO ANY BRICK SURFACE OR NEW ACM COLUMN WRAPS.

F3 OPERABLE WALL PANEL FINISH TO BE API & DRY ERASE, BOTH SIDES.

F4 TO BE APPLIED FULL HEIGHT OF EXISTING STRUCTURAL GLAZED TILE TO CEILING WITH 50% OFFSET HORIZONTAL FROM TOP OF BASE B3 TO CEILING. SEE ELEVATION 1-2/4800 FOR ADDITIONAL TILE INSTALL INFORMATION, ANY HVAC GRILLES, ETC. TO BE PAINTED TO MATCH EP1.

F5 EP1 TO BE APPLIED FULL HEIGHT OF EXISTING STRUCTURAL GLAZED TILE (SEE SPECS FOR ADDITIONAL APPLICATION INFORMATION), P6 TO BE APPLIED FROM TOP OF STRUCTURAL GLAZED TILE TO CEILING. SEE ELEVATION 11/4800.

F6 LV1 TO BE INSTALLED TO EXTENT OF REMOVED VCT OR CARPET, TRIM AT BOTH ENDS TO BE SMOOTH. CONTRACTOR TO PREP AND PAINT. CONTRACTOR TO PATCH CONCRETE TO AVOID TELEGRAMS. THROU NEW LV1 TO BE APPLIED TO EXISTING BRICK OR STRUCTURAL COVE. LV1 TO BE CLEANLY AND TIGHTLY SCRIBED TO EXISTING BRICK OR STRUCTURAL GLAZED COVE.

F7 NOT USED.

F8 WALL TO RECEIVE FINISH WT1, WT2, WT3; SEE ELEVATION 5/4800 FOR MORE INFORMATION. THIS LOCATION TO RECEIVE SCHULTER. ONLY TRIM IN FINISH BRUSHED GRAPHITE ANODIZED ALUMINUM.

F9 TERRAZZO PATCH TO MATCH EXISTING COLOR, AGGREGATE, AND ZINC STRIP PLACEMENT AND COLOR. CONTRACTOR RESPONSIBLE FOR SUBMITTING SAMPLES OF EVERY TERRAZZO MATCH FOR APPROVAL. PATCH TO TERMINATE AT EXISTING ZINC STRIP.

F10 ELEVATOR DOORS & FRAMES TO BE PREPARED AND PAINTED TO MATCH P6.

F11 WT5 TO BE INSTALLED 50% OFFSET HORIZONTAL FROM TOP OF BASE TO CEILING ON SINK WALL ONLY. WT5 TO BE INSTALLED VERTICAL STACK BOND 2.5 COURSINGS, WITH PAINT EP1 ABOVE ON REMAINING NON-WET WALLS; SEE ELEVATION 4/4800.

F12 CHALK IN FLOORING FINISH TO OCCUR AT CORNER OF WALL INDICATED.

F13 COLUMN IN FLOORING AREA INDICATED TO BE PAINTED TO MATCH WALL COLOR IN ROOM CORRIDOR.

F14 NOT USED.

F15 NO RUBBER WALL BASE TO BE APPLIED TO STRUCTURAL GLAZED COVE.

F16 WIRE BRUSH/PREPARE WELDING CURTAIN HEADERS AND ROD & PAINT TO MATCH P6. CONTRACTOR TO PROTECT PVC STRINGS.

F17 50% OFFSET HORIZONTAL STRUCTURAL GLAZED TILE IN CLASSROOMS TO BE PAINTED TO MATCH P6. SEE SPECIFICATIONS FOR MORE INFORMATION ON PREP & APPLICATIONS.

F18 LOCKERS TO BE PAINTED TO MATCH P6. SEE SPECIFICATIONS FOR PAINT TYPE & SHEEN.

F19 WIRE BRUSH/PREPARE WIRE PARTITIONS. CONTRACTOR TO PROTECT HARDWARE.

F20 FLOORING FINISH INSTALLATION SHALL ACCOMMODATE EXISTING POWERDATA DEVICE.

F21 20% WALKS AND/OR WALLS INDICATED TO RECEIVE FRP FROM FLOOR TO HEIGHT OF 8'7" AFF. COLOR TO BE CHOSEN FROM MFR'S FULL RANGE.

F22 MAIL LOCKERS TO HAVE FINISH TO MATCH P6.

F23 WALL-MOUNTED GRILLE OR OTHER HVAC EQUIPMENT TO BE PAINTED TO MATCH ADJACENT WALL. FOLLOW ALL PREP RECOMMENDED BY MFR.

F24 INSTALL SCAFFOLDING, SWING STOOLS, TYP. AT ALL APPLICABLE WINDOW LOCATIONS. FINISH TO PSS.

F25 WT5 TO BE INSTALLED VERTICAL STACK BOND 2.5 COURSINGS, WITH PAINT EP1 ABOVE. SEE ELEVATION 4/4800. WT4 TO BE INSTALLED 50% OFFSET HORIZONTAL FROM TOP OF BASE TO CEILING. SEE ELEVATION 3/4800. ANY HVAC GRILLES, ETC. TO BE PAINTED TO MATCH EP1.

F26 LECTURE INSTRUCTION STEPS TO RECEIVE FINISH LV3 ON TREADS & RISERS. NOSING TO BE SCHULTER. VINPRO-STEP P4 ACGB.

F27 STEPS TO RECEIVE FINISH LV1 ON TREADS AND RISERS. NOSING TO BE SCHULTER. VINPRO-STEP P4 ACGB.

F28 OVERHEAD COILING DOOR TO BE PAINTED TO MATCH P6 IN ITS ENTIRETY. CONTRACTOR TO PROTECT PVC STRINGS FOR PROPER PREP AND FOR ENSURING DOOR IS FULLY OPERATIONAL AFTER RECEIVING FINISH.

F29 PAINT EXISTING MOSAIC TILE TO MATCH P1. FOLLOW MANUFACTURER'S RECOMMENDATIONS & SPECS FOR TILE PREP AND PAINT APPLICATION.

F30 NOT USED.

F31 WINDOW FRAMES TO BE PAINTED TO MATCH P6.

F32 NEW RAILER STRINGER. TARGET COLOR BLACK 40.

F33 TERRAZZO PATCH WITH TERRAZZO TO MATCH EXISTING ADJACENT TERRAZZO IN TYPE, FORMULA & FINISH AND SHOULD BE PATCHED IN FULL TO THE NEAREST DIVIDER STRIP. ANY NEW DIVIDER STRIPS TO MATCH EXISTING STRIPS IN THE MATERIAL, SIZE, AND FINISH. SAMPLES TO BE SUBMITTED FOR APPROVAL PRIOR TO ANY PATCHING.

F35 NOT USED.

F36 PRE-LESS STEEL WALL PANELS TO BE INSTALLED AT SINK AREA, SINK EXISTING TO REMAIN.

F37 SHOWER TO RECEIVE FLOOR FINISH EP5. WALLS TO BE WT5, VERTICAL STACK BOND, FROM TOP OF BASE TO CEILING.

F38 TECTUM PANELS ON WALLS TO BE PAINTED TO MATCH P2. FRAMES PAINTED TO MATCH P6.

F39 PAINT TO BE APPLIED UP TO TOP OF DOOR FRAME, P7 APPLIED FROM TOP OF DOOR FRAME TO DECK.

F40 CEILING/BLIND AHEAD TO BE PAINTED P5.

F41 EXISTING WOOD TRIM TO BE PAINTED TO MATCH P6.

F42 ALL EXISTING TACK TO BE REPLACED WITH K13.

F43 COLUMN TO RECEIVE FINISHES EP5 & B1, TYP.

F44 COMPUTER NETWORKING LOGO - 4X4 TO BE PAINTED IN GRayscale USING EP3 & EP4. CENTERED ON WALL INDICATED. PAINT TRANSITIONS TO BE CRISP AND CLEAN. GRAPHIC FILE PROVIDED BY OWNER.

F45 CONSTRUCTION LOGO - 4X4 TO BE PAINTED IN GRayscale USING EP3 & EP4. CENTERED ON WALL INDICATED. PAINT TRANSITIONS TO BE CRISP AND CLEAN. GRAPHIC FILE PROVIDED BY OWNER.

F46 INDUSTRIAL EQUIPMENT LOGO - 4X4 TO BE PAINTED IN GRayscale USING EP3 & EP4. CENTERED ON WALL INDICATED. PAINT TRANSITIONS TO BE CRISP AND CLEAN. GRAPHIC FILE PROVIDED BY OWNER.

F47 CRIMINAL JUSTICE LOGO - 4X4 TO BE PAINTED IN GRayscale USING EP3 & EP4. CENTERED ON WALL INDICATED. PAINT TRANSITIONS TO BE CRISP AND CLEAN. GRAPHIC FILE PROVIDED BY OWNER.

F48 LOGISTICS LOGO - 4X4 TO BE PAINTED IN GRayscale USING EP3 & EP4. CENTERED ON WALL INDICATED. PAINT TRANSITIONS TO BE CRISP AND CLEAN. GRAPHIC FILE PROVIDED BY OWNER.

F49 WELDING LOGO - 4X4 TO BE PAINTED IN GRayscale USING EP3 & EP4. CENTERED ON WALL INDICATED. PAINT TRANSITIONS TO BE CRISP AND CLEAN. GRAPHIC FILE PROVIDED BY OWNER.

F50 ROBOTICS LOGO - 4X4 TO BE PAINTED IN GRayscale USING EP3 & EP4. CENTERED ON WALL INDICATED. PAINT TRANSITIONS TO BE CRISP AND CLEAN. GRAPHIC FILE PROVIDED BY OWNER.

F51 AUTO COLL. LOGO - 4X4 TO BE PAINTED IN GRayscale USING EP2 & P3. CENTERED ON WALL INDICATED. PAINT TRANSITIONS TO BE CRISP AND CLEAN. GRAPHIC FILE PROVIDED BY OWNER.

F52 AUTO SERVICE LOGO - 4X4 TO BE PAINTED IN GRayscale USING EP3 & EP4. CENTERED ON WALL INDICATED. PAINT TRANSITIONS TO BE CRISP AND CLEAN. GRAPHIC FILE PROVIDED BY OWNER.

F53 PAINT TO BE APPLIED IN GRayscale USING EP3 & EP4. CENTERED ON WALL INDICATED. PAINT TRANSITIONS TO BE CRISP AND CLEAN. GRAPHIC FILE PROVIDED BY OWNER.

F54 SCHULTER COVE DILEX-AHKA IN DARK ANTHRACITE TO BE USED AT ALL WALLS BETWEEN NEW WALL AND EXISTING TERRAZZO FLOORING.

F55 PAINT TO BE APPLIED TO DEMO AND/OR NEW CONSTRUCTION MUST MATCH EXISTING IN FINISH TYPE & COLOR. CONTRACTOR MUST SUBMIT INFORMATION AND SAMPLES FOR THESE LOCATIONS.

F56 CASEWORK IN ROOMS RECEIVING EPOXY RESINOUS FLOORING TO HAVE RUBBER BASE, B1, NO EPOXY BASE TO BE APPLIED TO CASEWORK.

F57 FACES OF BUILDERS ABOVE TO RECEIVE FINISH WT5.

F58 PAINT TO BE APPLIED IN GRayscale USING EP3 & EP4. CENTERED ON WALL INDICATED. PAINT FOR TYPICAL STRUCTURAL GLAZED TILE & GYP PAINT APPLICATION ON STAIRS.


F59 AT CORRIDOR DOOR NICHES, EP3 TO BE APPLIED FULL HEIGHT OF EXISTING STRUCTURAL GLAZED TILE (SEE SPECS FOR ADDITIONAL APPLICATION PREP & APPLICATION INFORMATION). P2 TO BE APPLIED FROM TOP OF STRUCTURAL GLAZED TILE TO CEILING. SEE ELEVATION 1-2/4800.

F60 ALL SALON EQUIPMENT TO HAVE FINISHES P5 & SS3 WHERE APPLICABLE.

F61 ALL FINISHES TO EXTEND TO LOFT AREA. RAILING TO BE PAINTED TO MATCH P6.


F62 THIN BRICK ON WALLS INDICATED TO BE BELDEN SIENNA BLEND VELVET. NO PAINT TO BE APPLIED TO ANY BRICK SURFACE.

F63 ACCENT PENDANT LIGHT TO BE KUZO LIGHTING CHROMA PD1706 BK. CONTACT TRACI ASHCRAFT, TASHCRAFT@SLSLINDIANA.COM

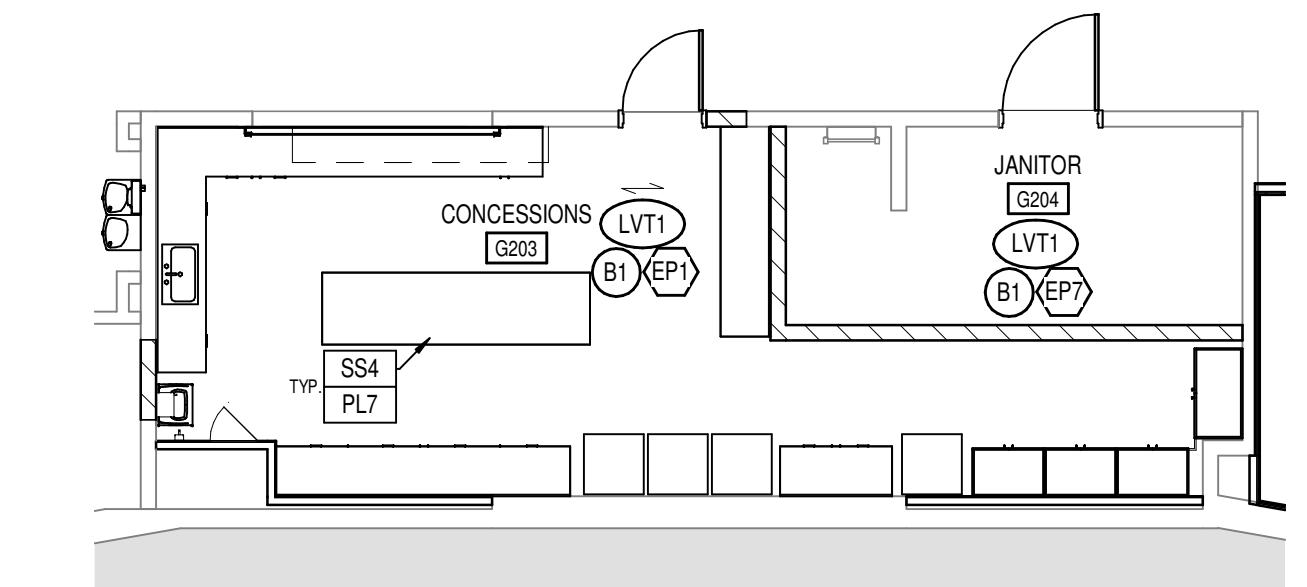

2 ALTERNATE C203 CONCESSIONS FINISH  
A802N

SCALE: 1/8" = 1'-0"

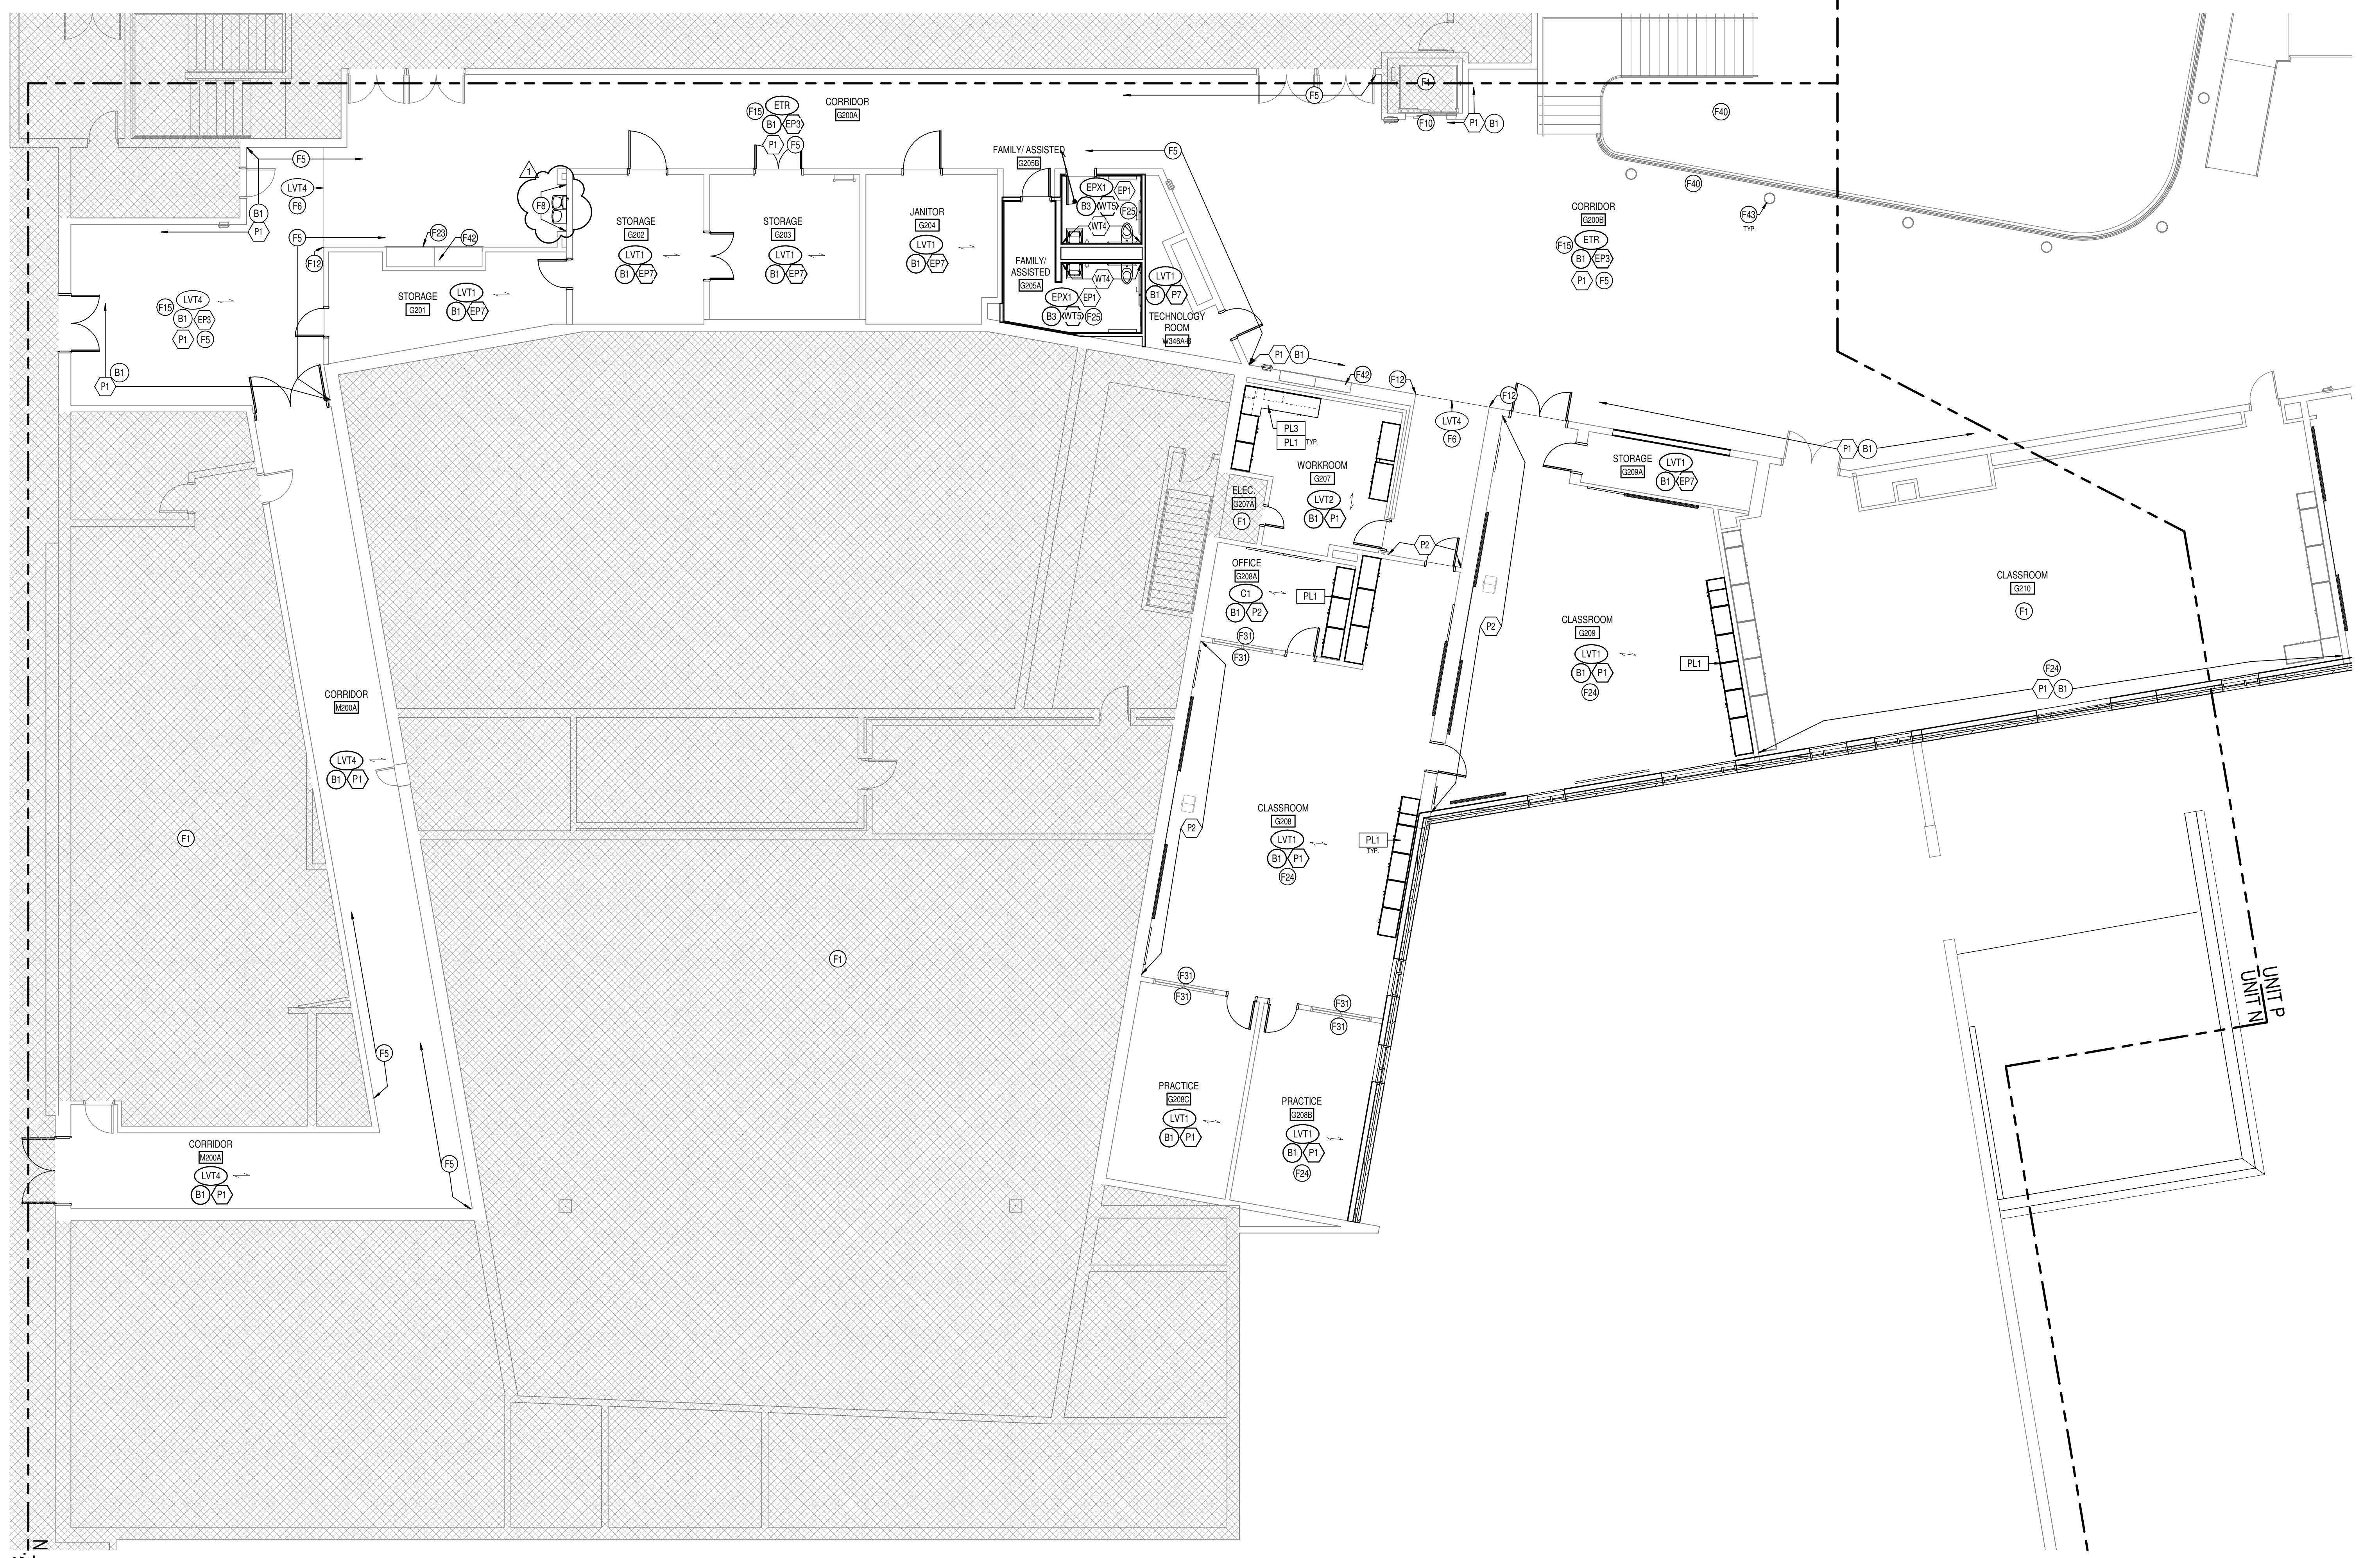

SECOND FLOOR FINISH PLAN - UNIT N

A802N

SCALE: 1/8" = 1'-0"

1



DRAWING NUMBER  
A802N

PROJECT NUMBER  
2021056



SCCSO  
317.448.7800 [www.csoso.com](http://www.csoso.com)

317.448.7800 ©2020 CSO Architects, Inc. All Rights Reserved

PROJECT:  
WARREN CENTRAL HIGH SCHOOL  
PHASE 3 ADDITION & RENOVATION  
9500 E. 16th STREET, INDIANAPOLIS, IN 46229

SCOPE DRAWINGS:  
These drawings represent the current design concept of the project in terms of architectural and structural design. The dimensions shown are not to be taken as final. The drawings are for the use of structural, mechanical and electrical systems. The drawings are not to be distributed outside the project team without the express written consent of the architect.

REVISIONS:  
1 ADDENDUM #2 03-13-2023

ISSUE DATE DRAWN BY CHECKED BY  
02-21-2023 Author Checker

DRAWING TITLE:  
SECOND FLOOR  
FINISH PLAN -  
UNITS P & Q




DRAWING NUMBER  
A802P


PROJECT NUMBER  
2021056

KEYED FINISH NOTES

F1 NO WORK THIS FLOOR.  
F2 NO PAINT TO BE APPLIED TO ANY BRICK SURFACE OR NEW ACM COLUMN WRAPS.  
F3 APPLIABLE WALL PANEL FINISH TO BE APPLIED & DRY ERASE, BOTH SIDES.  
F4 WTS TO BE INSTALLED VERTICAL STACK BOND FROM TOP OF BASE B3 TO CEILING. WT4 TO BE INSTALLED 50% OFFSET HORIZONTAL FROM TOP OF BASE B3 TO CEILING. SEE ELEVATION 1-2400 FOR ADDITIONAL TILE INSTALL INFORMATION ANY HVAC GRILLE, ETC. TO BE PAINTED TO MATCH EPI.  
F5 EPI TO BE APPLIED TO ALL HEAVY DUTY STRUCTURAL GLAZED TILE (SEE SPECS FOR ADDITIONAL APPLICATION PREP & APPLICATION INFORMATION), & P6 TO BE APPLIED FROM TOP OF STRUCTURAL GLAZED TILE TO CEILING. SEE ELEVATION 11-4800.  
F6 LVT4 TO BE INSTALLED TO EXENT OF REMOVED VOT OR CARPET TRIM AT BOTH ENDS TO BE SCHLUTER VINPRO ACG. CONTRACTOR RESPONSIBLE FOR PATCHING & LEVELING CONCRETE TO AVOID TELEGRAPHING THROUGH NEW LVT. NO WALL BASE TO BE APPLIED TO BRICK OR STRUCTURAL GLAZED COVE. LVT TO BE CLEANLY AND TIGHTLY SCRIBED TO EXISTING BRICK OR STRUCTURAL GLAZED COVE.  
F7 NOT USED.  
F8 WALL TO RECEIVE FINISH WTS, WT2, WT3 SEE ELEVATION 5-4800 FOR MORE INFORMATION. THIS LOCATION TO RECEIVE SCHLUTER JOLLY TRIM IN FINISH BRUSHED GRAPHITE ANODIZED ALUMINUM.  
F9 TERRAZZO PATCH TO MATCH EXISTING CO. AGGREGATE, AND ZINC STRIP EPI. CONTRACTOR AND COLOR CONTRACTOR RESPONSIBLE FOR SUBMITTING SAMPLES OF EPI AND TERRAZZO PATCH FOR APPROVAL. PATCH TO TERMINATE AT EXISTING ZINC STRIP.  
F10 ELEVATOR DOORS & FRAMES TO BE PREPARED AND PAINTED TO MATCH P6.  
F11 WTS TO BE INSTALLED 50% OFFSET HORIZONTAL FROM TOP OF BASE TO CEILING ON SINK WALL ONLY. WTS TO BE INSTALLED VERTICAL STACK-BOND 2.5 COURSINGS, WITH PAINT P6 TO MATCH P6 ON REMAINING NON-WET WALLS. SEE ELEVATION 4-4800.  
F12 CHANGE IN FLOORING FINISH TO OCCUR AT CORNER OF WALL INDICATED.  
F13 COLUMNS IN AREA INDICATED TO BE PAINTED TO MATCH WALL COLOR IN ROOM CORRIDOR.  
F14 NOT USED.  
F15 NO RUBBER WALL BASE TO BE APPLIED TO STRUCTURAL GLAZED COVE.  
F16 WIRE BRUSH/REPAIR WELDING CURTAIN HEADERS AND ROD & PAINT TO MATCH P6. CONTRACTOR TO PROTECT HARDWARE.  
F17 PARTIAL HEIGHT STRIPS OF GLAZED TILE IN CLASSROOMS TO BE PAINTED TO MATCH P1 (SEE SPECIFICATIONS FOR MORE INFORMATION ON PREP & APPLICATIONS).  
F18 LOCKERS TO BE PAINTED TO MATCH P6. SEE SPECIFICATIONS FOR PAINT TYPE & SHEEN.  
F19 WIRE BRUSH/REPAIR WIRE PARTITIONS. CONTRACTOR TO PROTECT HARDWARE.  
F20 FLOORING FINISH INSTALLATION SHALL ACCOMMODATE EXISTING POWERDATA DEVICE.  
F21 MOP SINK WALLS AND/OR WALLS INDICATED TO RECEIVE FRP FROM FLOOR TO HEIGHT OF 8'-0". COLOR TO BE CHOSEN FROM MFR'S FULL RANGE.  
F22 MAIL LOCKERS TO HAVE FINISH TO MATCH P6.  
F23 WALL-MOUNTED GRILLE OR OTHER HVAC EQUIPMENT TO BE PAINTED TO MATCH ADJACENT WALL. PAINT TO MATCH P6. CONTRACTOR TO PROTECT HARDWARE.  
F24 IND. SOLID SURFACE SHOW STOOLS, TYP. AT ALL APPLICABLE WINDOW LOCATIONS. FINISH TO BE SSS.  
F25 WTS TO BE INSTALLED VERTICAL STACK-BOND 2.5 COURSINGS, WITH PAINT EPI ABOVE. SEE ELEVATION 4-4800. WT4 TO BE INSTALLED 50% OFFSET HORIZONTAL FROM TOP OF BASE B3 TO CEILING. SEE ELEVATION 3-4800. ANY HVAC GRILLES, ETC. TO BE PAINTED TO MATCH P6.  
F26 LECTURE INSTRUCTION STEPS TO RECEIVE FINISH LVT3 ON TREADS & RISERS. NOSING TO BE SCHLUTER VINPRO-STEP ACG.  
F27 STEPS TO RECEIVE FINISH LVT1 ON TREADS & RISERS. NOSING TO BE SCHLUTER VINPRO-STEP ACG.  
F28 OVERHEAD COILING DOOR TO BE PAINTED TO MATCH P6 IN ITS ENTIRETY. CONTRACTOR RESPONSIBLE FOR PROPER PREP AND FOR ENSURING DOOR IS FULLY OPERATIONAL AFTER RECEIVING FINISH.  
F29 PAINT EXISTING MOSAIC TILE TO MATCH P1. FOLLOW MANUFACTURER'S RECOMMENDATIONS & SPECS FOR TILE PREP AND PAINT APPLICATION.  
F30 NOT USED.  
F31 MUDJOKE FRAMES TO BE PAINTED TO MATCH P6.  
F32 NOT USED.  
F33 NEW RUBBER STRINGER, TARTNETT COLOR BLACK 40.  
F34 FLOOR PATCH WITH TERRAZZO TO MATCH EXISTING ADJACENT TERRAZZO IN TYPE, FORMULA & FINISH AND SHOULD BE PATCHED IN FULL TO THE NEAREST DIVIDER STRIP. ANY NEW DIVIDER STRIPS TO MATCH EXISTING STRIPS TO THE NEAREST SIZE, AND FINISH SAMPLES TO BE SUBMITTED FOR APPROVAL PRIOR TO ANY PATCHING.  
F35 NOT USED.  
F36 STAINLESS STEEL WALL PANELS TO BE INSTALLED AT SINK AREA. SINK EXISTING TO REMAIN.  
F37 SHOWER TO RECEIVE FLOOR FINISH EPI. WALLS TO BE WTS, VERTICAL STACK BOND, FROM TOP OF BASE TO CEILING.  
F38 TECTUM PANELS ON WALLS TO BE PAINTED TO MATCH P2. FRAMES PAINTED TO MATCH P6.  
F39 FINISH EPI TO BE APPLIED UP TO TOP OF DOOR FRAME, P7 APPLIED FROM TOP OF DOOR FRAME TO DECK.  
F40 CEILING/GULLEAD ABOVE TO BE PAINTED P5.  
F41 EXISTING WOOD TRIM TO BE PAINTED TO MATCH P6.  
F42 ALL EXISTING TACK TRIM TO BE REPLACED WITH TK3.  
F43 COLUMN TO RECEIVE FINISHES EPI & B1, TYP.  
F44 COMPUTER NETWORK LOGO - 4X4 TO BE PAINTED IN GRAYSCALE USING EPI & EPI. CENTERED ON WALL INDICATED. PAINT TRANSITIONS TO BE CRISP AND CLEAN. GRAPHIC FILE PROVIDED BY OWNER.  
F45 CONSTRUCTION LOGO - 4X4 TO BE PAINTED IN GRAYSCALE USING EPI & EPI. CENTERED ON WALL INDICATED. PAINT TRANSITIONS TO BE CRISP AND CLEAN. GRAPHIC FILE PROVIDED BY OWNER.  
F46 MTP TRANSPORTATION LOGO - 4X4 TO BE PAINTED IN GRAYSCALE USING EPI & EPI. CENTERED ON WALL INDICATED. PAINT TRANSITIONS TO BE CRISP AND CLEAN. GRAPHIC FILE PROVIDED BY OWNER.  
F47 CRIMINAL JUSTICE LOGO - 4X4 TO BE PAINTED IN GRAYSCALE USING EPI & EPI. CENTERED ON WALL INDICATED. PAINT TRANSITIONS TO BE CRISP AND CLEAN. GRAPHIC FILE PROVIDED BY OWNER.  
F48 LOGISTICS LOGO - 4X4 TO BE PAINTED IN GRAYSCALE USING EPI & EPI. CENTERED ON WALL INDICATED. PAINT TRANSITIONS TO BE CRISP AND CLEAN. GRAPHIC FILE PROVIDED BY OWNER.  
F49 WELDING LOGO - 4X4 TO BE PAINTED IN GRAYSCALE USING EPI & EPI. CENTERED ON WALL INDICATED. PAINT TRANSITIONS TO BE CRISP AND CLEAN. GRAPHIC FILE PROVIDED BY OWNER.  
F50 ROBOTICS LOGO - 4X4 TO BE PAINTED IN GRAYSCALE USING EPI & EPI. CENTERED ON WALL INDICATED. PAINT TRANSITIONS TO BE CRISP AND CLEAN. GRAPHIC FILE PROVIDED BY OWNER.  
F51 AUTO DESIGN LOGO - 4X4 TO BE PAINTED IN GRAYSCALE USING EPI & EPI. CENTERED ON WALL INDICATED. PAINT TRANSITIONS TO BE CRISP AND CLEAN. GRAPHIC FILE PROVIDED BY OWNER.  
F52 AUTO SERVICE LOGO - 4X4 TO BE PAINTED IN GRAYSCALE USING EPI & EPI. CENTERED ON WALL INDICATED. PAINT TRANSITIONS TO BE CRISP AND CLEAN. GRAPHIC FILE PROVIDED BY OWNER.  
F53 ENGINEERING LOGO - 4X4 TO BE PAINTED IN GRAYSCALE USING EPI & EPI. CENTERED ON WALL INDICATED. PAINT TRANSITIONS TO BE CRISP AND CLEAN. GRAPHIC FILE PROVIDED BY OWNER.  
F54 SCHLUTER COVE DILEX-AHK4 IN DILEX-AHK4 TO BE USED AT ALL WALLS BETWEEN EXISTING TILE AND EXISTING TERRAZZO FLOOR.  
F55 FINISH PATCHING DUE TO EXISTING AND/OR NEW CONSTRUCTION MUST MATCH EXISTING IN FINISH TYPE & COLOR. CONTRACTOR MUST SUBMIT INFORMATION AND SAMPLES FOR THESE LOCATIONS.  
F56 CASEWORK IN ROOMS RECEIVING EPOXY RESINOUS FLOORING TO HAVE RUBBER BASE. B1, NO EPOXY BASE TO BE APPLIED TO CASEWORK.  
F57 CEILING OF LOFT AREA ABOVE TO RECEIVE FINISH WTS.  
F58 SEE ELEVATION 15-4800 FOR TYPICAL STRUCTURAL GLAZED TILE & GYP PAINT APPLICATION ON STAIRS.  
F59 AT CORRIDOR DOOR NICHES, EPI TO BE APPLIED FULL HEIGHT OF EXISTING STRUCTURAL GLAZED TILE (SEE SPECS FOR ADDITIONAL APPLICATION PREP & APPLICATION). CONTRACTOR TO PAINT EPI TO TOP OF STRUCTURAL GLAZED TILE TO CEILING. SEE ELEVATION 10-4800.  
F60 ALL SALON EQUIPMENT TO HAVE FINISHES PL5 & S33 WHERE APPROPRIATE.  
F61 ALL FINISHES TO EXTEEND TO LOFT AREA. RAILING TO BE PAINTED TO MATCH P6.  
F62 THIN BRICK ON WALLS INDICATED TO BE BELDEN SIENNA BLEND VELVET. NO PAINT TO BE APPLIED TO ANY BRICK SURFACE.  
F63 ACCENT PENDANT LIGHT TO BE KUZO LIGHTING CHROMA PD1708 BK. CONTACT TRACI ASHCRAFT, TASHCRAFT@SLSIINDIANA.COM

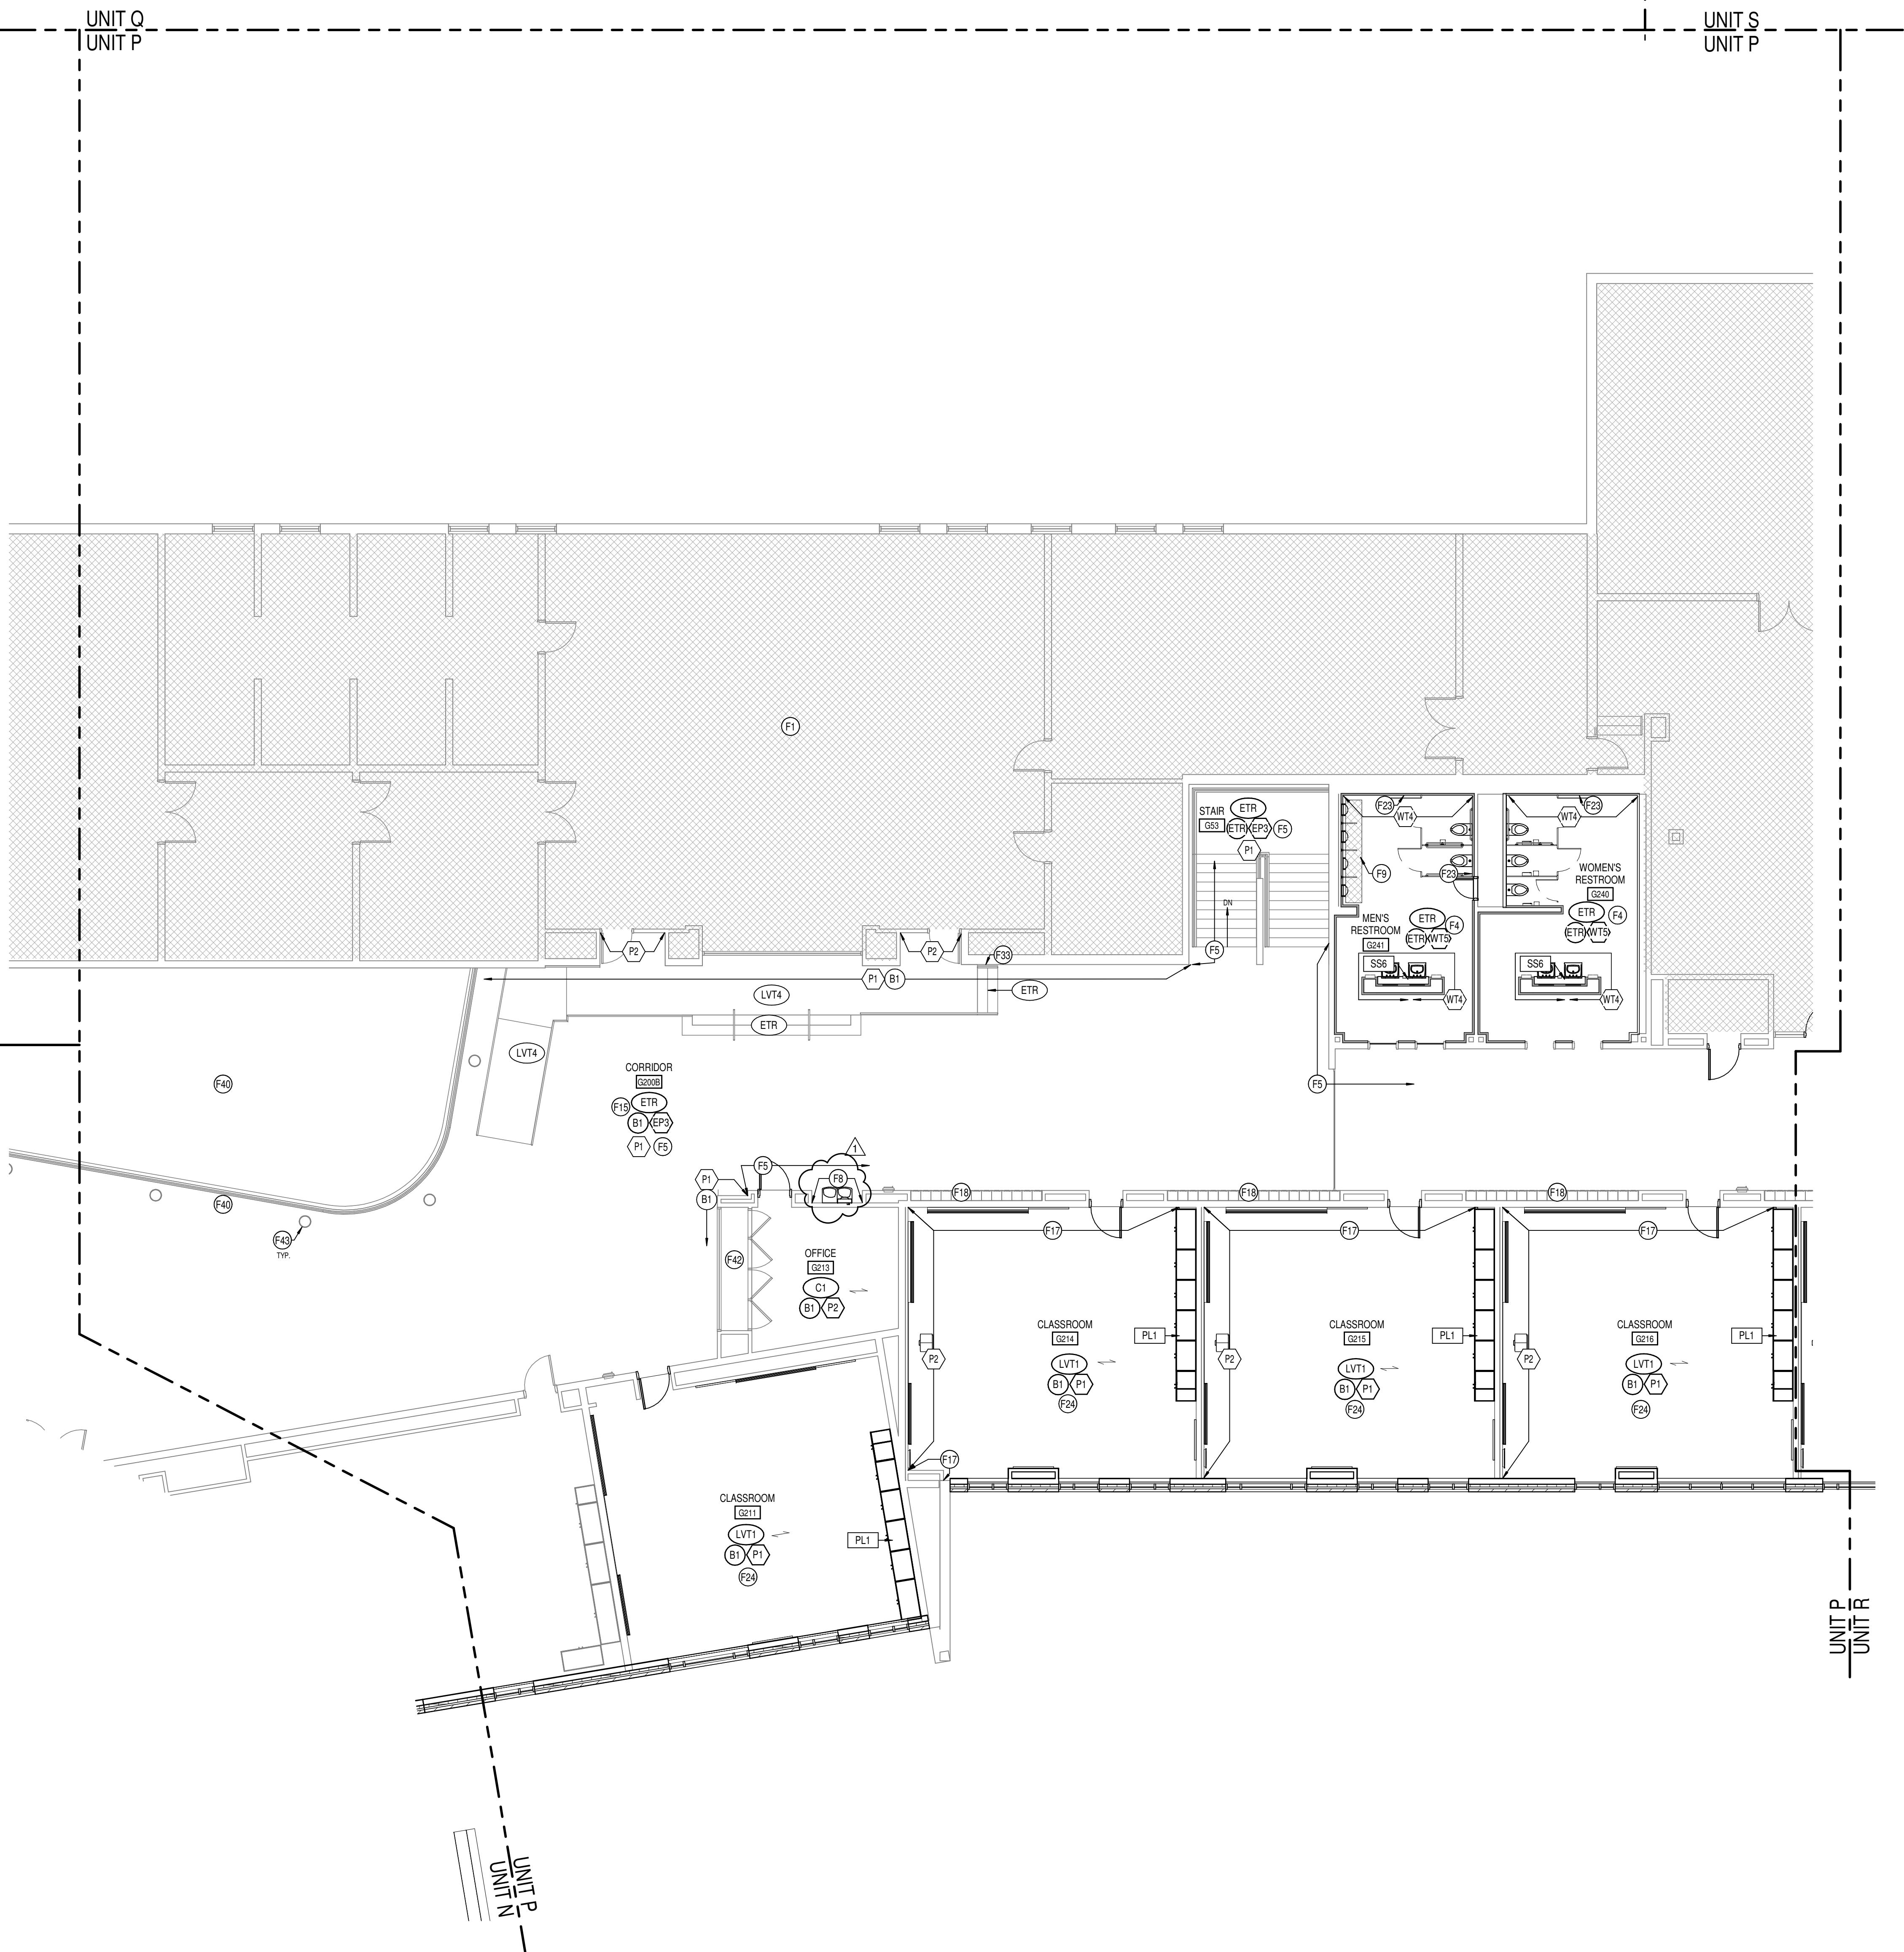

1 SECOND FLOOR FINISH PLAN - UNIT P  
A802P SCALE: 1/8" = 1'-0"

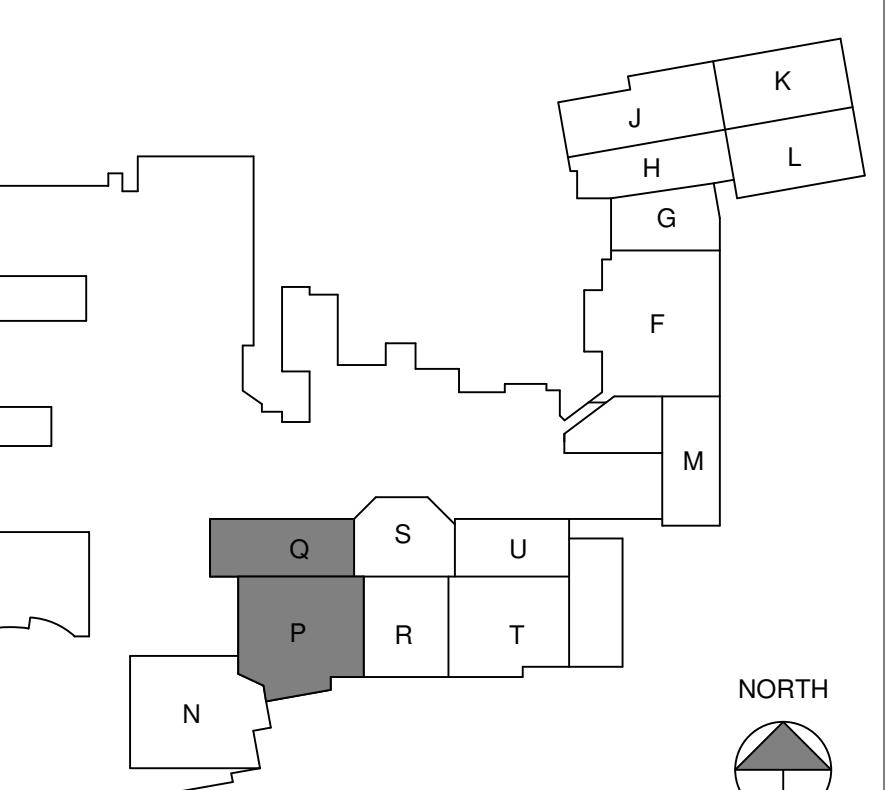

DRAWING NUMBER  
A802P  
PROJECT NUMBER  
2021056



SCCSO  
Keystone Crossing, Indianapolis, IN 46240

317.448.7800 | cscosnet  
©2020 CCSO Architects, Inc. All rights reserved.

PROJECT:  
WARREN CENTRAL HIGH SCHOOL  
PHASE 3 ADDITION & RENOVATION  
9500 E. 16th STREET, INDIANAPOLIS, IN 46229


SCOPE DRAWINGS:  
These drawings are a part of the project. In terms of the architectural design concept, the dimensions of the structures, mechanical and electrical systems, the location of the building, and the requirements of the Contract.

REVISIONS:

1 ADDENDUM #2 03-13-2023

ISSUE DATE DRAWN BY CHECKED BY  
02-21-2023 Author Checker

DRAWING TITLE:  
SECOND FLOOR  
FINISH PLAN -  
UNIT R

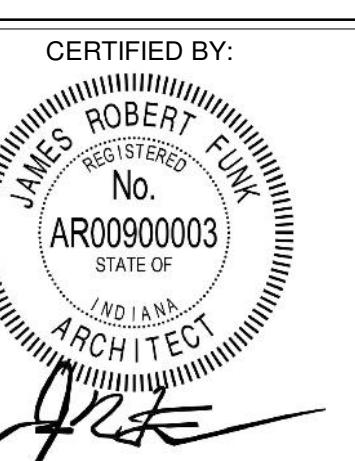


DRAWING NUMBER  
A802R

PROJECT NUMBER  
2021056

KEYED FINISH NOTES

F1 NO WORK IN THIS AREA, UND.  
F2 NO PAINT TO BE APPLIED TO ANY BRICK SURFACE OR NEW ACM COLUMN WRAPS.  
F3 OPERABLE WALL PANEL FINISH TO BE A/P1 & DRY ERASE, BOTH SIDES.  
F4 WTS TO BE INSTALLED VERTICAL STACK-BOND FROM TOP OF BASE TO CEILING. WTA TO BE APPLIED FULL HEIGHT OF EXISTING STRUCTURAL GLAZED TILE & GYP PAINT. SEE ELEVATIONS 1-2/4800 FOR ADDITIONAL TILE INSTALL INFORMATION. ANY HVAC GRILLES, ETC TO BE PAINTED TO MATCH EP1.  
F5 EP5 TO BE APPLIED FULL HEIGHT OF EXISTING STRUCTURAL GLAZED TILE (SEE SPEC FOR ADDITIONAL APPLICATION PREP & APPLICATION INFORMATION, & P1 TO BE APPLIED FROM TOP OF STRUCTURAL GLAZED TILE TO CEILING). NO WALL BASE TO BE APPLIED TO BRICK OR STRUCTURAL COVE. LVT TO BE CLEANLY AND TIGHTLY SCRIBED TO EXISTING BRICK OR STRUCTURAL GLAZED COVE.  
F7 NOT USED.  
F8 WALL TO RECEIVE FINISH WHT, WHT2, WHT3; SEE ELEVATION 5/4800 FOR MORE INFORMATION. THIS LOCATION TO RECEIVE SCHLUTER JOLLY TRIM IN FINISH BRUSHED GRAPHITE ANODIZED ALUMINUM.  
F9 TERRAZZO PATCH TO MATCH EXISTING IN COLOR, AGGREGATE, AND ZINC STRIP PLACEMENT. CONTRACTOR RESPONSIBLE FOR SUBMITTING SAMPLES OF EVERY TERRAZZO MATCH FOR APPROVAL. PATCH TO TERMINATE AT EXISTING ZINC STRIP.  
F10 ELEVATOR DOORS & FRAMES TO BE PREPARED AND PAINTED TO MATCH P6.  
F11 WTS TO BE INSTALLED 50% OFFSET HORIZONTAL FROM TOP OF BASE TO CEILING ON SINK WALL ONLY. WTS TO BE INSTALLED VERTICAL STACK-BOND 2.5 COURSINGS, WITH PAINT EP1 ABOVE ON REMAINING NON-WET WALLS. SEE ELEVATION 4/4800.  
F12 CHANGE IN FLOORING FINISH TO OCCUR AT CORNER OF WALL INDICATED.  
F13 COLUMNS IN AREA INDICATED TO BE PAINTED TO MATCH WALL COLOR IN DOCUMENTED CORRIDOR.  
F14 NOT USED.  
F15 NO RUBBER WALL BASE TO BE APPLIED TO STRUCTURAL GLAZED COVE.  
F16 WIRE BRUSH/PREPARE WELDING CURTAIN HEADERS AND ROD & PAINT TO MATCH P6. CONTRACTOR TO PROTECT PVC STRIPS.  
F17 PARTIAL-HEIGHT STRUCTURAL GLAZED TILE IN CLASSROOMS TO BE PAINTED TO MATCH P1 (SEE SPECIFICATIONS FOR MORE INFORMATION ON PREP & APPLICATIONS.)  
F18 LOCKERS TO BE PAINTED TO MATCH P6. SEE SPECIFICATIONS FOR PAINT TYPE & SHEEN.  
F19 WIRE BRUSH/PREPARE WIRE PARTITIONS. CONTRACTOR TO PROTECT HARDWARE.  
F20 FLOORING FINISH INSTALLATION SHALL ACCOMMODATE EXISTING POWER/DATA DEVICES.  
F21 MOULDING TO BE PAINTED TO MATCH P6. COLOR TO BE CHOSEN FROM MTR'S FULL RANGE.  
F22 MAIL LOCKERS TO HAVE FINISH TO MATCH P6.  
F23 WALL-MOUNTED GRILLE OR OTHER HVAC EQUIPMENT TO BE PAINTED TO MATCH ADJACENT WALL. FOLLOW ALL PREP RECOMMENDED BY MFR.  
F24 INSTALL SOLID SURFACE WINDOW STOOLS, TYP. AT ALL APPLICABLE WINDOW LOCATIONS. FINISH TO MATCH P6.  
F25 WTS TO BE INSTALLED VERTICAL STACK-BOND 2.5 COURSINGS, WITH PAINT EP1 ABOVE. SEE ELEVATION 4/4800. WTA TO BE INSTALLED 50% OFFSET HORIZONTAL FROM TOP OF BASE TO CEILING. SEE ELEVATION 3/4800. ANY HVAC GRILLES, ETC TO BE PAINTED TO MATCH EP1.  
F26 LEGACY CONSTRUCTION STEPS TO RECEIVE FINISH LVT3 ON TREADS & RISERS. NOSING TO BE SCHLUTER VINPRO-STEP3-RAGB.  
F27 STEPS TO RECEIVE FINISH LVT1 ON TREADS AND RISERS. NOSING TO BE SCHLUTER VINPRO-STEP3-RAGB.  
F28 OVERHEAD DOOR TO BE PAINTED TO MATCH P6 IN ITS ENTIRETY. CONTRACTOR RESPONSIBLE FOR PROPER PREP AND FOR ENSURING DOOR IS FULLY OPERATIONAL AFTER PAINTING.  
F29 PAINT EXISTING MOSAIC TILE TO MATCH P1. FOLLOW MANUFACTURER'S RECOMMENDATIONS & SPECIFICATIONS FOR TILE PREP AND PAINT APPLICATION.  
F30 NOT USED.  
F31 WINDOW FRAMES TO BE PAINTED TO MATCH P6.  
F32 NOT USED.  
F33 NEW RUBBER STRINGER TARGETT COLOR BLACK 40.  
F34 FLOOR PATCH WITH TERRAZZO TO MATCH EXISTING ADJACENT TERRAZZO IN TYPE, COLOR & FINISH AND SHOULD BE PATCHED IN FULL TO THE NEAREST GINGER STRIP. ANY NEW DIVIDER STRIPS TO MATCH EXISTING STRIPS IN MATERIAL, SIZE, AND FINISH. SAMPLES TO BE SUBMITTED FOR APPROVAL PRIOR TO ANY PATCHING.  
F35 NOT USED.  
F36 STAINLESS STEEL WALL PANELS TO BE INSTALLED AT SINK AREA. SINK EXISTING TO BE REMOVED.  
F37 SHOWER TO RECEIVE FLOOR FINISH EP5. WALLS TO BE WHT, VERTICAL STACK BOND, FROM TOP OF BASE TO CEILING.  
F38 TECTUM PANELS ON WALLS TO BE PAINTED TO MATCH P2; FRAMES PAINTED TO MATCH P6.  
F39 FINISH EP7 TO BE APPLIED UP TO TOP OF DOOR FRAME. P7 APPLIED FROM TOP OF DOOR FRAME TO DECK.  
F40 CEILING BULKHEAD ABOVE TO BE PAINTED P5.  
F41 EXISTING WOOD TRIM TO BE PAINTED TO MATCH P6.  
F42 ALL EXISTING TRIM TO BE PAINTED WITH T3.  
F43 COLUMN TO RECEIVE FINISHES EP5 & B1, TYP.  
F44 COMPUTER NETWORKING LOGO -4X4 TO BE PAINTED IN GRAYSCALE USING EP3 & EP4. CENTERED ON WALL INDICATED. PAINT TRANSITIONS TO BE CRISP AND CLEAN. GRAPHIC FILE PROVIDED BY OWNER.  
F45 CONSTRUCTION LOGO -4X4 TO BE PAINTED IN GRAYSCALE USING EP3 & EP4. CENTERED ON WALL INDICATED. PAINT TRANSITIONS TO BE CRISP AND CLEAN. GRAPHIC FILE PROVIDED BY OWNER.  
F46 MFR TRANSFORMATION LOGO -4X4 TO BE PAINTED IN GRAYSCALE USING EP3 & EP4. CENTERED ON WALL INDICATED. PAINT TRANSITIONS TO BE CRISP AND CLEAN. GRAPHIC FILE PROVIDED BY OWNER.  
F47 CRIMINAL JUSTICE LOGO -4X4 TO BE PAINTED IN GRAYSCALE USING EP3 & EP4. CENTERED ON WALL INDICATED. PAINT TRANSITIONS TO BE CRISP AND CLEAN. GRAPHIC FILE PROVIDED BY OWNER.  
F48 ROBOTICS LOGO -4X4 TO BE PAINTED IN GRAYSCALE USING EP3 & EP4. CENTERED ON WALL INDICATED. PAINT TRANSITIONS TO BE CRISP AND CLEAN. GRAPHIC FILE PROVIDED BY OWNER.  
F49 WELDING LOGO -4X4 TO BE PAINTED IN GRAYSCALE USING EP3 & EP4. CENTERED ON WALL INDICATED. PAINT TRANSITIONS TO BE CRISP AND CLEAN. GRAPHIC FILE PROVIDED BY OWNER.  
F50 ROBOTICS LOGO -4X4 TO BE PAINTED IN GRAYSCALE USING EP3 & EP4. CENTERED ON WALL INDICATED. PAINT TRANSITIONS TO BE CRISP AND CLEAN. GRAPHIC FILE PROVIDED BY OWNER.  
F51 AUTO COLLISION LOGO -4X4 TO BE PAINTED IN GRAYSCALE USING EP2 & EP3. CENTERED ON WALL INDICATED. PAINT TRANSITIONS TO BE CRISP AND CLEAN. GRAPHIC FILE PROVIDED BY OWNER.  
F52 AUTO SERVICE LOGO -4X4 TO BE PAINTED IN GRAYSCALE USING EP3 & EP4. CENTERED ON WALL INDICATED. PAINT TRANSITIONS TO BE CRISP AND CLEAN. GRAPHIC FILE PROVIDED BY OWNER.  
F53 ENGINEERING LOGO -4X4 TO BE PAINTED IN GRAYSCALE USING EP3 & EP4. CENTERED ON WALL INDICATED. PAINT TRANSITIONS TO BE CRISP AND CLEAN. GRAPHIC FILE PROVIDED BY OWNER.  
F54 SCHLUTER COVE DILEX-AHKA IN DARK ANTHRACITE TO BE USED AT ALL WALLS BETWEEN NEW WALL AND EXISTING TERRAZZO FLOORING.  
F55 FINISH PATCHING DUE TO DEMO AND/OR NEW CONSTRUCTION MUST MATCH EXISTING INT'L. FINISHES. CONTRACTOR MUST SUBMIT INFORMATION AND SAMPLES FOR THESE LOCATIONS.  
F56 CASEWORK IN ROOMS RECEIVING EPOXY RESINOUS FLOORING TO HAVE RUBBER BASE, NO EPOXY BASE TO BE APPLIED TO CASEWORK.  
F57 FACES OF BULKHEAD ABOVE TO RECEIVE FINISH WTR.  
F58 SEE ELEVATION 15/4800 FOR TYPICAL STRUCTURAL GLAZED TILE & GYP PAINT APPLICATION.  
F59 AT CORRIDOR DOOR NICHES, EP2 TO BE APPLIED FULL HEIGHT OF EXISTING STRUCTURAL GLAZED TILE (SEE SPEC FOR ADDITIONAL APPLICATION PREP & APPLICATION INFORMATION, & P2 TO BE APPLIED FROM TOP OF STRUCTURAL GLAZED TILE TO CEILING). NO WALL BASE TO BE APPLIED TO BRICK SURFACE.  
F60 ALL SALON EQUIPMENT TO HAVE FINISHED PL5 & S33 WHERE APPLICABLE.  
F61 ALL FINISHES TO EXTEND TO LOFT AREA. RAILING TO BE PAINTED TO MATCH P6.  
F62 THIN BRICK ON WALLS INDICATED TO BE BELDEN SIENNA BLEND VELVUT. NO PAINT TO BE APPLIED TO ANY BRICK SURFACE.  
F63 ACCENT PENDANT LIGHT TO BE KUZO LIGHTING CHROMA PD1708 BK. CONTACT TRACI ASHCRAFT, TASHCRAFT@SLSIINDIANA.COM

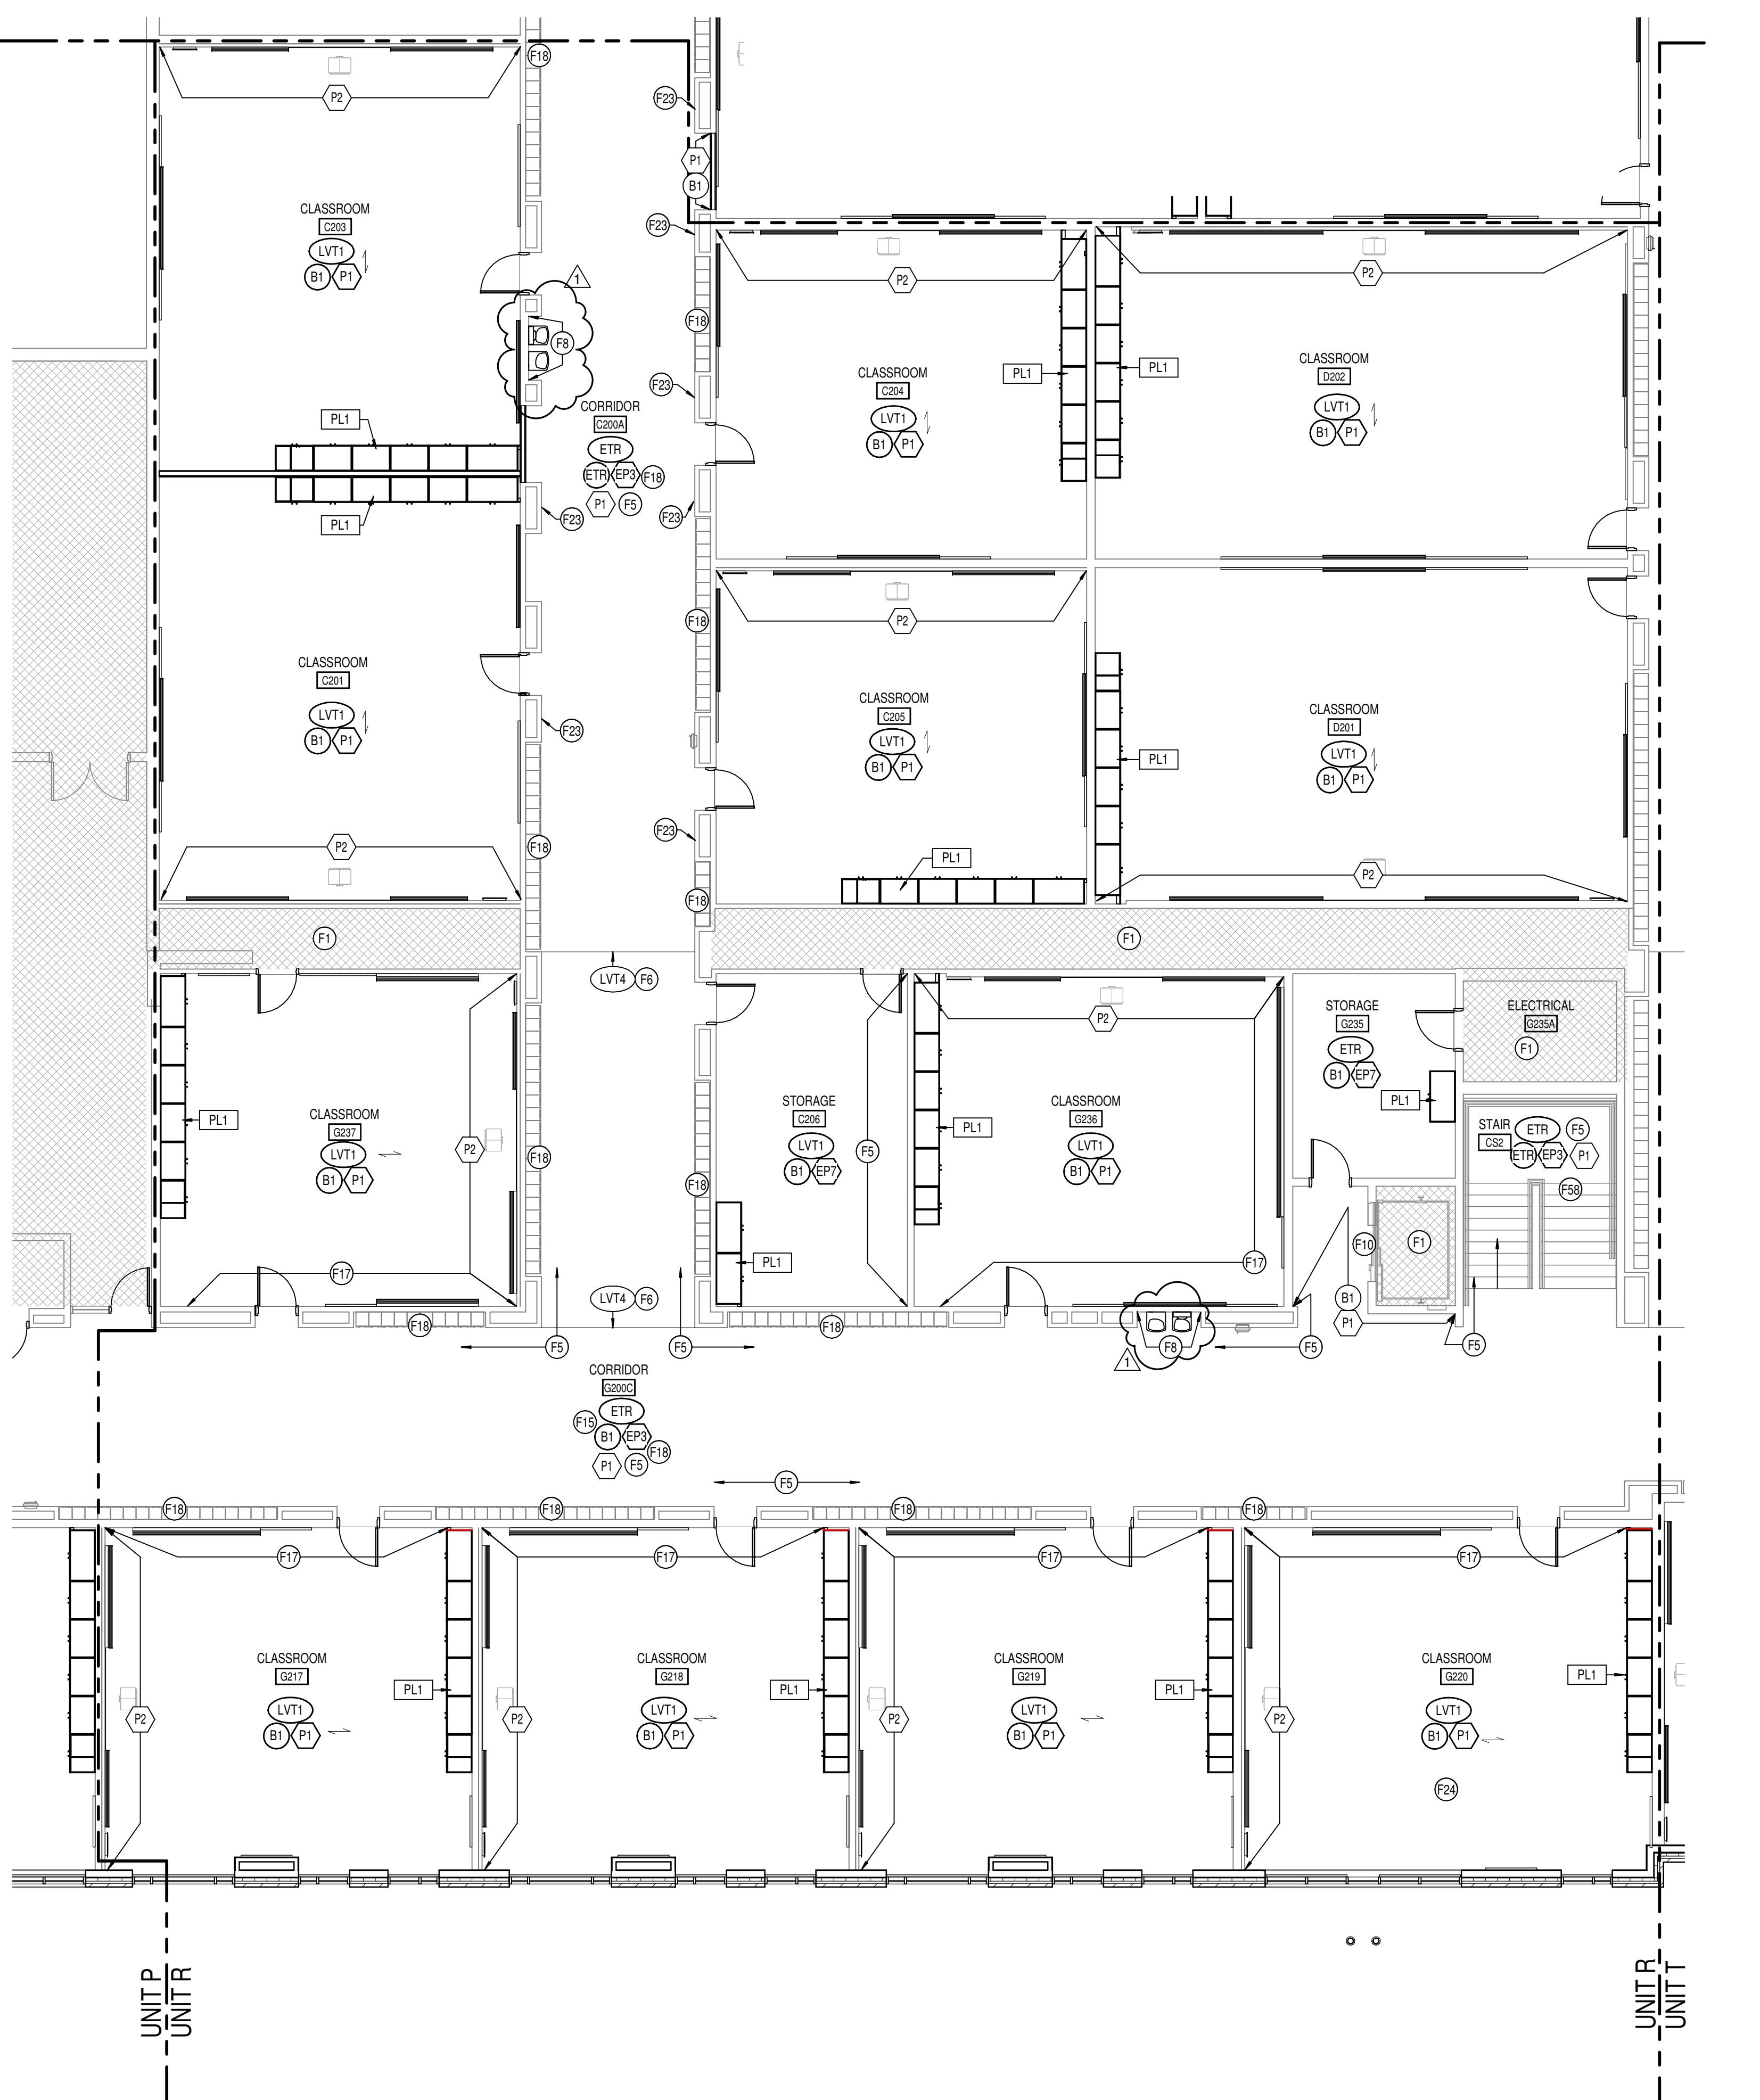



SCSO  
Keystone Crossing, Indianapolis, IN 46240

317.448.7800 | csonet  
© 2020 SCSO Architects, Inc. All Rights Reserved


PROJECT:  
WARREN CENTRAL HIGH SCHOOL  
PHASE 3 ADDITION & RENOVATION  
9500 E. 6th STREET, INDIANAPOLIS, IN 46229

SCOPE DRAWINGS:  
These drawings define the scope of the project in terms of the structural and architectural design concept, the dimensions of the building, and the location of structural, mechanical and electrical systems. They are intended to provide a clear description of the requirements of the Contract.

REVISIONS:  
1 ADDENDUM #2 03-13-2023

ISSUE DATE | DRAWN BY | CHECKED BY  
02-21-2023 | Author | Checker

DRAWING TITLE:  
SECOND FLOOR  
FINISH PLAN -  
UNIT T

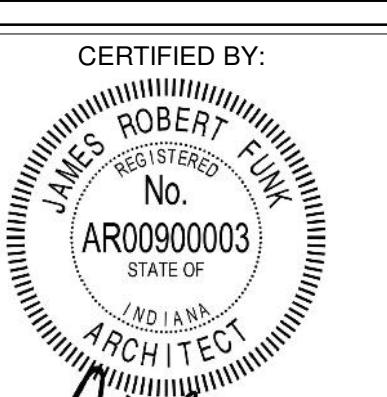

DRAWING NUMBER  
A802T

PROJECT NUMBER  
2021056

KEYED FINISH NOTES

F1 NO WORK IN THIS AREA, UND.

F2 NO PAINT TO BE APPLIED TO ANY BRICK SURFACE OR NEW ACM COLUMN WRAPS.

F3 OPERABLE WALL PANEL FINISH TO BE A/P1 & DRY ERASE, BOTH SIDES.

F4 WTS TO BE INSTALLED VERTICAL STACK-BOND FROM TOP OF BASE TO CEILING. WT TO BE APPLIED FULL HEIGHT OF EXISTING STRUCTURAL GLAZED TILE. SEE ELEVATION 1/2A800 FOR ADDITIONAL TILE INSTALL INFORMATION. ANY HVAC GRILLES, ETC TO BE PAINTED TO MATCH EP1.

F5 EP5 TO BE APPLIED FULL HEIGHT OF EXISTING STRUCTURAL GLAZED TILE (SEE SPECS FOR ADDITIONAL APPLICATION PREP & APPLICATION INFORMATION, & P1 TO BE APPLIED FROM TOP OF STRUCTURAL GLAZED TILE). LVT TO BE PAINTED TO MATCH EP1.

F6 LVT TO BE INSTALLED TO EXTENT OF REMOVED VCT OR CARPET. TRIM AT BOTH ENDS TO BE SCHLUTER VINPRO-A/CGB. CONTRACTOR RESPONSIBLE FOR PATCHING & LEVELING OF EXISTING FLOOR SURFACE. NO WALL BASE TO BE APPLIED TO BRICK OR STRUCTURAL COVE. LVT TO BE CLEANLY AND TIGHTLY SCRIBED TO EXISTING BRICK OR STRUCTURAL GLAZED COVE.

F7 NOT USED.

F8 WALL TO RECEIVE FINISH WHT, WHT2, WHT3; SEE ELEVATION 5/4A800 FOR MORE INFORMATION. THIS LOCATION TO RECEIVE SCHLUTER JOLLY TRIM IN FINISH BRUSHED GRAPHITE ANODIZED ALUMINUM.

F9 TERRAZZO PATCH TO MATCH EXISTING IN COLOR, AGGREGATE, AND ZINC STRIP PLACEMENT. CONTRACTOR RESPONSIBLE FOR SUBMITTING SAMPLES OF EVERY TERRAZZO MATCH FOR APPROVAL. PATCH TO TERMINATE AT EXISTING ZINC STRIP.

F10 ELEVATOR DOORS & FRAMES TO BE PREPARED AND PAINTED TO MATCH P6.

F11 WTS TO BE INSTALLED 50% OFFSET HORIZONTAL FROM TOP OF BASE TO CEILING ON SINK WALL ONLY. WTS TO BE INSTALLED VERTICAL STACK-BOND 2.5 COURSINGS, WITH PAINT EP1 ABOVE ON REMAINING NON-WET WALLS. SEE ELEVATION 4/4B800.

F12 CHANGE IN FLOORING FINISH TO OCCUR AT CORNER OF WALL INDICATED.

F13 COLOR OF WALL IN AREA INDICATED TO BE PAINTED TO MATCH WALL COLOR IN ROOM CORRIDOR.

F14 NOT USED.

F15 NO RUBBER WALL BASE TO BE APPLIED TO STRUCTURAL GLAZED COVE.

F16 WIRE BRUSH/PREPARE WELDING CURTAIN HEADERS AND ROD & PAINT TO MATCH P6. CONTRACTOR TO PROTECT PVC STRIPS.

F17 PARTIAL-HEIGHT STRUCTURAL GLAZED TILE IN CLASSROOMS TO BE PAINTED TO MATCH P1 (SEE SPECIFICATIONS FOR MORE INFORMATION ON PREP & APPLICATIONS.)

F18 LOCKERS TO BE PAINTED TO MATCH P5. SEE SPECIFICATIONS FOR PAINT TYPE & SHEEN.

F19 WIRE BRUSH/PREPARE WIRE PARTITIONS. CONTRACTOR TO PROTECT HARDWARE.

F20 FLOORING FINISH INSTALLATION SHALL ACCOMMODATE EXISTING POWER/DATA DEVICES.

F21 MOLDING TO BE PAINTED TO MATCH P6. COLOR TO BE CHOSEN FROM MTR'S FULL RANGE.

F22 MAIL LOCKERS TO HAVE FINISH TO MATCH P6.

F23 WALL-MOUNTED GRILLE OR OTHER HVAC EQUIPMENT TO BE PAINTED TO MATCH ADJACENT WALL. FOLLOW ALL PREP RECOMMENDED BY MFR.

F24 INSTALL SOLID SURFACE WINDOW STOOLS, TYP. AT ALL APPLICABLE WINDOW LOCATIONS. FINISH TO MATCH P6.

F25 WTS TO BE INSTALLED VERTICAL STACK-BOND 2.5 COURSINGS, WITH PAINT EP1 ABOVE. SEE ELEVATION 4/4B800. WTS TO BE INSTALLED 50% OFFSET HORIZONTAL FROM TOP OF BASE TO CEILING. SEE ELEVATION 3/4A800. ANY HVAC GRILLES, ETC TO BE PAINTED TO MATCH EP1.

F26 LEOPARD TERRAZZO STEP-UP R-ACGB. CONTRACTOR RESPONSIBLE FOR PROPER PREP AND FOR ENSURING DOOR IS FULLY OPENED AFTER PAINTING TERRAZZO.

F27 STEPS TO RECEIVE FINISH LVT3 ON TREADS AND RISERS. NOSING TO BE SCHLUTER VINPRO-STEP-R-ACGB.

F28 OVERHEAD COILING DOOR TO BE PAINTED TO MATCH P6 IN ITS ENTIRETY. CONTRACTOR RESPONSIBLE FOR PROPER PREP AND FOR ENSURING DOOR IS FULLY OPENED AFTER PAINTING COILING DOOR.

F29 PAINT EXISTING MOSAIC TILE TO MATCH P1. FOLLOW MANUFACTURER'S RECOMMENDATIONS & SPECS FOR TILE PREP AND PAINT APPLICATION.

F30 NOT USED.

F31 WINDOW FRAMES TO BE PAINTED TO MATCH P6.

F32 NOT USED.

F33 NEW RUBBER STRINGER. TARGETT COLOR BLACK 40.

F34 FLOOR PATCH WITH TERRAZZO TO MATCH EXISTING ADJACENT TERRAZZO IN TYPE, COLOR & FINISH AND SHOULD BE PATCHED IN FULL TO THE NEAREST GINGER STRIP. ANY NEW DIVIDER STRIPS TO MATCH EXISTING STRIPS IN MATERIAL, SIZE, AND FINISH. SAMPLES TO BE SUBMITTED FOR APPROVAL PRIOR TO ANY PATCHING.

F35 NOT USED.

F36 STAINLESS STEEL WALL PANELS TO BE INSTALLED AT SINK AREA, SINK EXISTING TO THE LEFT.

F37 SHOWER TO RECEIVE FLOOR FINISH EP5. WALLS TO BE WHT5, VERTICAL STACK BOND, FROM TOP OF BASE TO CEILING.

F38 TECTON PANELS ON WALLS TO BE PAINTED TO MATCH P2; FRAMES PAINTED TO MATCH P6.

F39 PL1/EP7 TO BE APPLIED UP TO TOP OF DOOR FRAME. P7 APPLIED FROM TOP OF DOOR FRAME TO DECK.

F40 CEILING BULLHEAD ABOVE TO BE PAINTED P5.

F41 EXISTING WOOD TRIM TO BE PAINTED TO MATCH P6.

F42 ALL EXISTING TACK TRIM TO BE REPLACED WITH K3.

F43 COLUMN TO RECEIVE FINISHES EP5 & B1, TYP.

F44 COMPUTER NETWORKING LOGO -4X4 TO BE PAINTED IN GRAYSCALE USING EP3 & EPA. CENTERED ON WALL INDICATED. PAINT TRANSITIONS TO BE CRISP AND CLEAN. GRAPHIC FILE PROVIDED BY OWNER.

F45 CONSTRUCTION LOGO -4X4 TO BE PAINTED IN GRAYSCALE USING EP3 & EP4. CENTERED ON WALL INDICATED. PAINT TRANSITIONS TO BE CRISP AND CLEAN. GRAPHIC FILE PROVIDED BY OWNER.

F46 MFR TRANSFORMATION LOGO -4X4 TO BE PAINTED IN GRAYSCALE USING EP3 & EP4. CENTERED ON WALL INDICATED. PAINT TRANSITIONS TO BE CRISP AND CLEAN. GRAPHIC FILE PROVIDED BY OWNER.

F47 CRIMINAL JUSTICE LOGO -4X4 TO BE PAINTED IN GRAYSCALE USING EP3 & EP4. CENTERED ON WALL INDICATED. PAINT TRANSITIONS TO BE CRISP AND CLEAN. GRAPHIC FILE PROVIDED BY OWNER.

F48 CRISTIS LOGO -4X4 TO BE PAINTED IN GRAYSCALE USING EP3 & EP4. CENTERED ON WALL INDICATED. PAINT TRANSITIONS TO BE CRISP AND CLEAN. GRAPHIC FILE PROVIDED BY OWNER.

F49 WELDING LOGO -4X4 TO BE PAINTED IN GRAYSCALE USING EP3 & EP4. CENTERED ON WALL INDICATED. PAINT TRANSITIONS TO BE CRISP AND CLEAN. GRAPHIC FILE PROVIDED BY OWNER.

F50 ROBOTICS LOGO -4X4 TO BE PAINTED IN GRAYSCALE USING EP3 & EP4. CENTERED ON WALL INDICATED. PAINT TRANSITIONS TO BE CRISP AND CLEAN. GRAPHIC FILE PROVIDED BY OWNER.

F51 AUTO COLLISION LOGO -4X4 TO BE PAINTED IN GRAYSCALE USING EP2 & EP3. CENTERED ON WALL INDICATED. PAINT TRANSITIONS TO BE CRISP AND CLEAN. GRAPHIC FILE PROVIDED BY OWNER.

F52 AUTO SERVICE LOGO -4X4 TO BE PAINTED IN GRAYSCALE USING EP3 & EP4. CENTERED ON WALL INDICATED. PAINT TRANSITIONS TO BE CRISP AND CLEAN. GRAPHIC FILE PROVIDED BY OWNER.

F53 ENGINEERING LOGO -4X4 TO BE PAINTED IN GRAYSCALE USING EP3 & EP4. CENTERED ON WALL INDICATED. PAINT TRANSITIONS TO BE CRISP AND CLEAN. GRAPHIC FILE PROVIDED BY OWNER.

F54 SCHLUTER COVE DILEX-AHKA IN DARK ANTHRACITE TO BE USED AT ALL WALLS BETWEEN NEW WALL AND EXISTING TERRAZZO FLOORING.

F55 FINISH PATCHING DUE TO DEMO AND/OR NEW CONSTRUCTION MUST MATCH EXISTING WALL FINISHES. CONTRACTOR MUST SUBMIT INFORMATION AND SAMPLES FOR THESE LOCATIONS.

F56 CASEWORK IN ROOMS RECEIVING EPOXY RESINOUS FLOORING TO HAVE RUBBER BASE. B1, NO EPOXY BASE TO BE APPLIED TO CASEWORK.

F57 FACES OF BULKHEAD ABOVE TO RECEIVE FINISH WTR.

F58 SEE ELEVATION 15/4A800 FOR TYPICAL STRUCTURAL GLAZED TILE & GYP PAINT APP.


F59 AT CORRIDOR DOOR NICHES. EP2 TO BE APPLIED FULL HEIGHT OF EXISTING STRUCTURAL GLAZED TILE (SEE SPECS FOR ADDITIONAL APPLICATION PREP & APPLICATION INFORMATION). P2 TO BE APPLIED FROM TOP OF STRUCTURAL GLAZED TILE TO THE CEILING.

F60 ALL SATELLITE EQUIPMENT TO HAVE FINISHED PL5 & S31 WHERE APPLICABLE.

F61 ALL FINISHES TO EXTEND TO LOFT AREA. RAILING TO BE PAINTED TO MATCH P6.

F62 THIN BRICK ON WALLS INDICATED TO BE BELDEN SIENNA BLEND VELVUT. NO PAINT TO BE APPLIED TO ANY BRICK SURFACE.

F63 ACCENT PENDANT LIGHT TO BE KUZO LIGHTING CHROMA PD1708 BK. CONTACT TRACI ASHCRAFT, TASHCRAFT@SLSINDIANA.COM

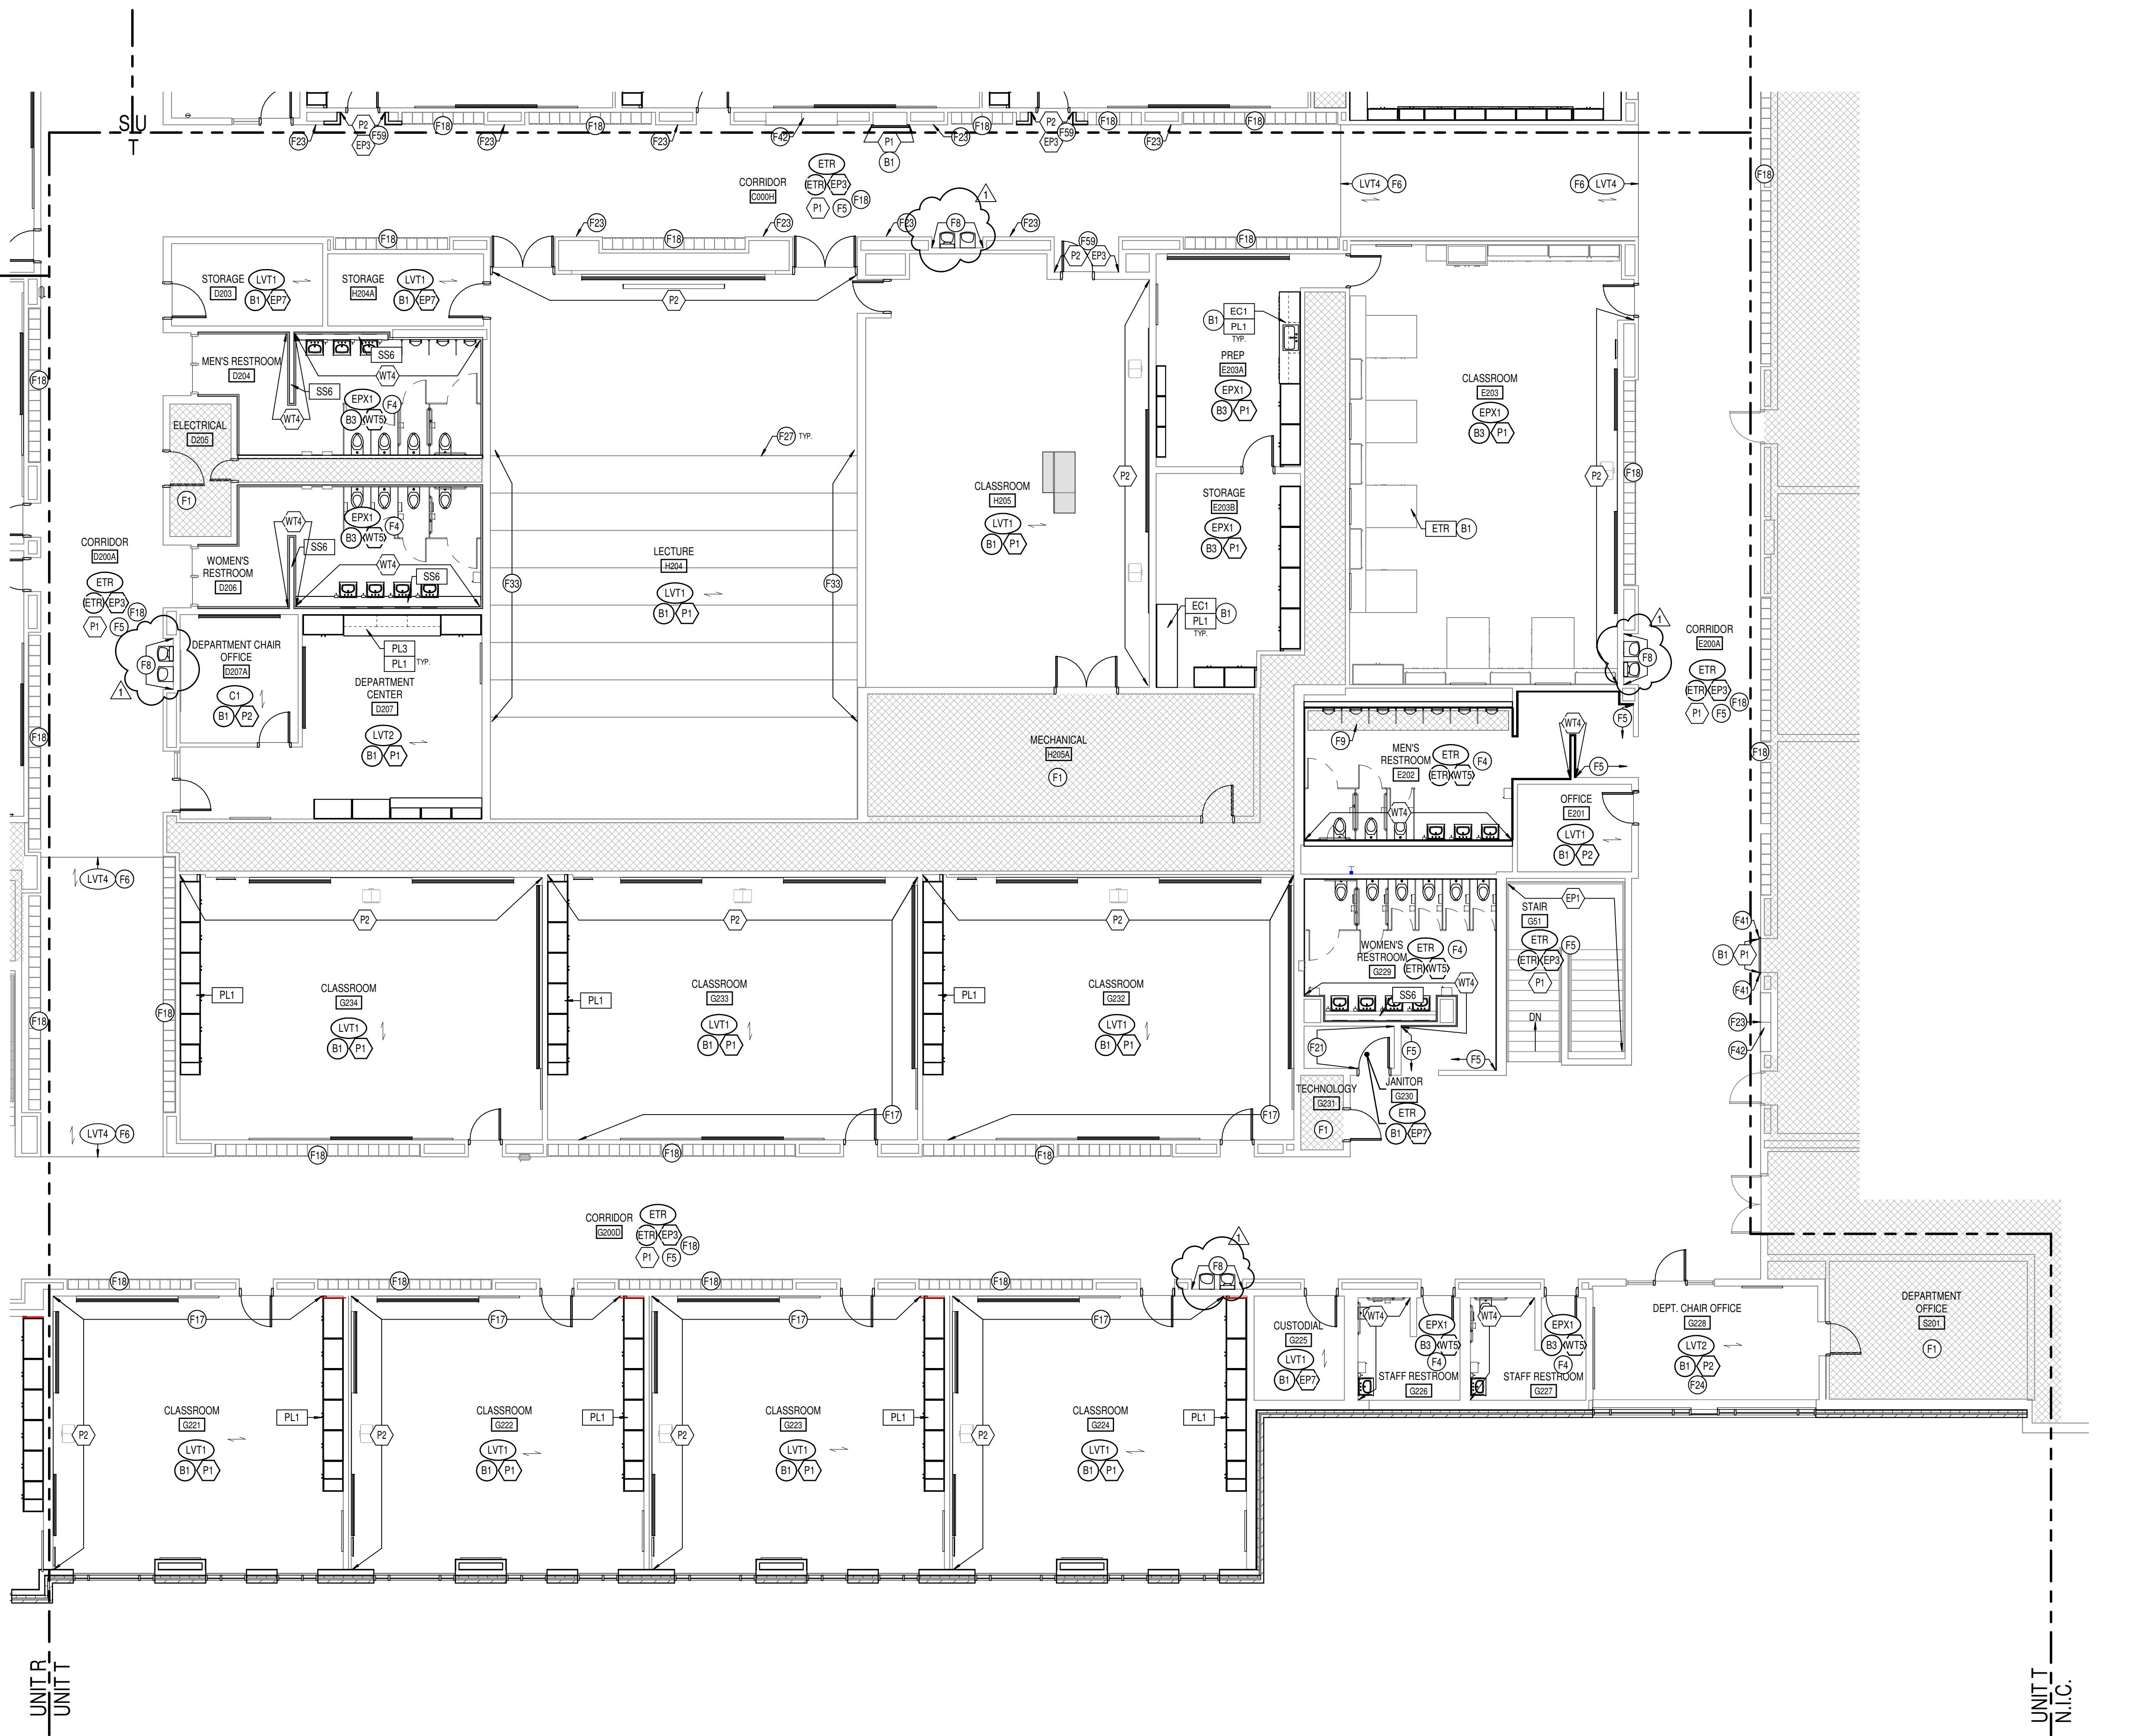

SECOND FLOOR FINISH PLAN - UNIT T

A802T

SCALE: 1/8" = 1'-0"



DRAWING NUMBER  
A802T

PROJECT NUMBER  
2021056

BASE CABINET SCHEDULE							
Type	Mark	Description	Spec. Section	Manufacturer	Model	Size	Type Comments
B1		BASE CASEWORK	12 32 16	STEVENS INDUSTRIES	10120	12" W x 34 1/2" H x 24" D	
B2		BASE CASEWORK	12 32 16	STEVENS INDUSTRIES	10120	27" W x 32 1/2" H x 24" D	
B3		BASE CABINET - 1 DOOR	12 32 16	STEVENS INDUSTRIES	10120	24" W x 28 1/2" H x 24" D	
B4		BASE CABINET - 1 DOOR	12 32 16	STEVENS INDUSTRIES	10120	24" W x 32 1/2" H x 24" D	
B5		BASE CABINET - 1 DOOR	12 32 16	STEVENS INDUSTRIES	10121	24" W x 28 1/2" H x 24" D	
B6		BASE CABINET - 1 DOOR	12 32 16	STEVENS INDUSTRIES	10121	24" W x 34 1/2" H x 24" D	
B7		BASE CABINET - 1 DOOR	12 32 16	STEVENS INDUSTRIES	10121	24" W x 34 1/2" H x 24" D	
B8		BASE CABINET - OPEN SHELVING	12 32 16	STEVENS INDUSTRIES	10129	12" W x 34 1/2" H x 24" D	
B9		BASE CABINET - 2 DOOR	12 32 16	STEVENS INDUSTRIES	10129	24" W x 34 1/2" H x 24" D	
B10		BASE CABINET - 2 DOOR	12 32 16	STEVENS INDUSTRIES	10129	30" W x 32 1/2" H x 24" D	
B21		BASE CABINET - 2 DOOR	12 32 16	STEVENS INDUSTRIES	10129	48" W x 34 1/2" H x 24" D	
B22		BASE CASEWORK	12 32 16	STEVENS INDUSTRIES	10181	30" W x 32 1/2" H x 11" D	
B23		BASE CABINET - 2 DRAWER	12 32 16	STEVENS INDUSTRIES	10315	18" W x 28 1/2" H x 24" D	
B24		BASE CABINET - 2 FILE DRAWERS	12 32 16	STEVENS INDUSTRIES	10318	36" W x 34 1/2" H x 24" D	
B25		BASE CASEWORK	12 32 16	STEVENS INDUSTRIES	10332	18" W x 32 1/2" H x 24" D	
B26		BASE CABINET - 3 EQUAL DRAWERS	12 32 16	STEVENS INDUSTRIES	10332	21" W x 34 1/2" H x 24" D	
B27		BASE CABINET - 3 EQUAL DRAWERS	12 32 16	STEVENS INDUSTRIES	10332	24" W x 34 1/2" H x 24" D	
B28		BASE CABINET - 3 EQUAL DRAWERS	12 32 16	STEVENS INDUSTRIES	10332	24" W x 34 1/2" H x 24" D	
B29		BASE CABINET - 3 EQUAL DRAWERS	12 32 16	STEVENS INDUSTRIES	10332	36" W x 32 1/2" H x 24" D	
B30		BASE CABINET - 3 EQUAL DRAWERS	12 32 16	STEVENS INDUSTRIES	10332	39" W x 32 1/2" H x 24" D	
B31		BASE CABINET - 5 EQUAL DRAWERS	12 32 16	STEVENS INDUSTRIES	10370	18" W x 34 1/2" H x 24" D	
B32		BASE CABINET - 4 EQUAL DRAWERS	12 32 16	STEVENS INDUSTRIES	10370	24" W x 32 1/2" H x 24" D	
B33		BASE CABINET - 4 EQUAL DRAWERS	12 32 16	STEVENS INDUSTRIES	10370	24" W x 34 1/2" H x 24" D	
B34		BASE CABINET - 4 EQUAL DRAWERS	12 32 16	STEVENS INDUSTRIES	10370	27" W x 32 1/2" H x 24" D	
B35		BASE CABINET - 5 EQUAL DRAWERS	12 32 16	STEVENS INDUSTRIES	10392	18" W x 34 1/2" H x 24" D	
B36		BASE CASEWORK - 8 EQUAL DRAWERS	12 32 16	STEVENS INDUSTRIES	10406	29" W x 34 1/2" H x 24" D	
B37		BASE CASEWORK	12 32 16	STEVENS INDUSTRIES	10421	24" W x 34 1/2" H x 24" D	
B38		BASE CASEWORK	12 32 16	STEVENS INDUSTRIES	10421	12" W x 32 1/2" H x 24" D	
B58		BASE CASEWORK - 2 DOOR OPEN BOTTOM	12 32 16	STEVENS INDUSTRIES	10702	36" W x 32 1/2" H x 24" D	
B59		FILLER PANEL	12 32 16	STEVENS INDUSTRIES	10843	SEE ELEVATION	
B60		BASE CABINET - 4 EQUAL DRAWERS	12 32 16	STEVENS INDUSTRIES	10370	30" W x 35" H x 14" D	
B61		BASE CABINET - 2 DOOR	12 32 16	STEVENS INDUSTRIES	10129	36" W x 34 1/2" H x 14" D	
B62		BASE CABINET - 4 EQUAL DRAWERS	12 32 16	STEVENS INDUSTRIES	10370	24" W x 35" H x 19" D	
B63		BASE CABINET - 1 DOOR	12 32 16	STEVENS INDUSTRIES	10120	24" W x 34 1/2" H x 19" D	
B64		BASE CABINET - 1 DOOR	12 32 16	STEVENS INDUSTRIES	10200	36" W x 35" H x 19" D	
B65		BASE CABINET - 2 DOOR	12 32 16	STEVENS INDUSTRIES	10488	45" W x 35" H x 32" D	
B66		BASE CABINET - 1 DOOR	12 32 16	STEVENS INDUSTRIES	10201	36" W x 35" H x 19" D	
B67		BASE CABINET - 4 EQUAL DRAWERS	12 32 16	STEVENS INDUSTRIES	10370	24" W x 35" H x 21" D	
B68		BASE CABINET - 2 DOOR	12 32 16	STEVENS INDUSTRIES	10129	36" W x 34 1/2" H x 21" D	
B69		BASE CABINET - 4 EQUAL DRAWERS	12 32 16	STEVENS INDUSTRIES	10370	15" W x 35" H x 22" W	
B70		BASE CABINET - 1 DOOR	12 32 16	STEVENS INDUSTRIES	10201	42" W x 35" H x 12" D	
B71		BASE CABINET - 2 DOOR	12 32 16	STEVENS INDUSTRIES	10129	36" W x 34 1/2" H x 22" D	
B72		BASE CABINET - 1 DOOR	12 32 16	STEVENS INDUSTRIES	10200	42" W x 35" H x 12" D	
B73		BASE CABINET - 4 EQUAL DRAWERS	12 32 16	STEVENS INDUSTRIES	10370	12" W x 35" H x 19" D	
B74		BASE CABINET - 2 DOOR	12 32 16	STEVENS INDUSTRIES	10129	45" W x 34 1/2" x 12" D	
B75		BASE CASEWORK - 2 DOOR OPEN BOTTOM	12 32 16	STEVENS INDUSTRIES	10702	36" W x 32 1/2" H x 24" D	
B76		BASE CASEWORK	12 32 16	STEVENS INDUSTRIES	10129	SEWING MACHINE CABINET	
B77		BASE CABINET - 1 DRAWER, 1 DOOR	12 32 16	STEVENS INDUSTRIES	10370	12" W x 32 1/2" H x 24" D	
B78		BASE CABINET - HOOK PANEL	12 32 16	STEVENS INDUSTRIES	10370	48" W x 5" H x 24" D	
B79		BASE CABINET - 1 DRAWER, 1 DOOR	12 32 16	STEVENS INDUSTRIES	10370	24" W x 32 1/2" H x 24" D	
B8							

TALL CABINET SCHEDULE							
Type	Mark	Description	Spec. Section	Manufacturer	Model	Size	Type Comments




<tbl\_r cells="

MISC. CASEWORK SCHEDULE							
TYPE MARK	DESCRIPTION	SPEC. SECTION	MANUFACTURER	MODEL	SIZE	TYPE COMMENTS	
		12 32 16			36" W x 32 1/2" H x 24" D		
Accessories		Stevens Industries	10870				
Base Cabinet - Filler Panel		Stevens Industries	10805				
Base Casework		Stevens Industries					
PLASTIC LAMINATE COUNTER TOP 24" DEPTH W/ SPLASH					1 1/2" THICK		
PLASTIC LAMINATE COUNTER TOPS WITH 3MM PVC EDGES/NO SPLASH							
CT1 PLASTIC LAMINATE COUNTER TOP 18" DEPTH W/ SPLASH					1 1/2" THICK		
CT2 PLASTIC LAMINATE COUNTER TOP 24" DEPTH W/ SPLASH					1 1/2" THICK		
CT3 PLASTIC LAMINATE COUNTER TOP 30" DEPTH W/ SPLASH					1 1/2" THICK		
CT4 PLASTIC LAMINATE COUNTER TOP 48" DEPTH, NO SPLASH					1 1/2" THICK		
CT5 PLASTIC LAMINATE COUNTER TOP 14" DEPTH W/ SPLASH					1 1/2" THICK		
CT6 SOLID SURFACE COUNTER TOP 7" DEPTH, NO SPLASH					1/2" THICK		
CT7 SOLID SURFACE COUNTER TOP 9" DEPTH, NO SPLASH					1/2" THICK		
CT8 SOLID SURFACE COUNTER TOP 12" DEPTH, NO SPLASH					1/2" THICK		
CT9 PLASTIC LAMINATE COUNTER TOP 24" DEPTH NO SPLASH					1 1/2" THICK		
CT11 PLASTIC LAMINATE COUNTER TOP 12" DEPTH, NO SPLASH					1 1/2" THICK		
CT12 SOLID SURFACE COUNTER TOP 6" DEPTH, NO SPLASH					1/2" THICK		
L1 LOCKER				63271	16" W x 72" H x 18" D		
L2 LOCKER				63291	16" W x 84" H x 18" D		
L3 LOCKER				63271	16" W x 72" H x 18" D		

EQUIPMENT SCHEDULE							
TYPE MARK	DESCRIPTION	SPEC. SECTION	MANUFACTURER	MODEL	SIZE	TYPE COMMENTS	FURNISHED BY
EXISTING	MASSAGE TABLE, EXISTING	BY OWNER					
AP1	OVER-AND-UNDER REFRIGERATOR						
AP2	FRONT LOAD DRYER						
AP4	VENDING MACHINE						
AP5	ELECTRIC RANGE	EXISTING					
CG1	SURFACE MOUNTED CORNER GUARD - LENGTH VARIES	10 26 00	ACROVYN	SEE SPECS	LENGTH FROM TOP OF VINYL WALL BASE TO FINISHED CEILING HEIGHT		
D1	DISPLAY CASE						
F1							
F2							
GM1	GLASS MIRROR - STAINLESS STEEL ANGLE FRAME		BOBRICK	B-165	3'-0" W x 4'-0" H		
LB1	LOUVER BLIND				4'-0" W x 6'-6" H		CONTRACTOR
LB2	LOUVER BLIND				4'-2" W x 6'-6" H		CONTRACTOR
LB3	LOUVER BLIND				4'-6" W x 6'-6" H		CONTRACTOR
LB4	LOUVER BLIND				4'-10" W x 6'-6" H		CONTRACTOR
LB5	LOUVER BLIND				4'-4" W x 6'-6" H		CONTRACTOR
LB6	LOUVER BLIND				5'-4" W x 6'-6" H		CONTRACTOR
LB7	LOUVER BLIND				4'-0" W x 5'-2" H		CONTRACTOR
LB8	LOUVER BLIND				8'-0" W x 5'-2" H		CONTRACTOR
LB9	LOUVER BLIND				4'-0" W x 6'-0" H		CONTRACTOR
LB10	LOUVER BLIND				7'-0" W x 7'-4" H		CONTRACTOR
LB11	LOUVER BLIND				6'-4" W x 5'-8" H		CONTRACTOR
LB12	LOUVER BLIND				6'-4" W x 5'-4" H		CONTRACTOR
LB13	LOUVER BLIND				9'-8" W x 5'-4" H		CONTRACTOR
MAIL	Horizontal Front-Load Private Distribution Mailbox		Florence Manufacturing Company	1600 10x3			
MB1	4'-0" High Fixed Marker Board	10 11 00	CLARIDGE	SERIES 1	MOUNT TOP @ +(7'-0")		CONTRACTOR
MB2	MARKER BOARD 4'-0" W x 4'-0" H	10 11 00	CLARIDGE	SERIES 1	MOUNT TOP @ +(7'-0")		CONTRACTOR
MB3	MARKER BOARD 8'-0" W x 4'-0" H	10 11 00	CLARIDGE	SERIES 1	MOUNT TOP @ +(7'-0")		CONTRACTOR
MB4	4'-0" High Fixed Marker Board	10 11 00	CLARIDGE	SERIES 1	MOUNT TOP @ +(7'-0")		CONTRACTOR
MB5	4'-0" High Fixed Marker Board	10 11 00	CLARIDGE	SERIES 1	MOUNT TOP @ +(7'-0")		CONTRACTOR
MB6	FRAMELESS PORCELAIN MARKER BOARD 8'-0" W x 4'-0" H	10 11 00	LCS ELITE	---	MOUNT TOP @ +(7'-0")		CONTRACTOR
MB7	MARKER BOARD 8'-0" H x 4'-0" W	10 11 00	CLARIDGE	SERIES 1	MOUNT TOP @ +(7'-0")		CONTRACTOR
MB8	MARKERBOARD 12'-0" W x 4'-0" H	10 11 00	CLARIDGE	SERIES 1	MOUNT TOP @ +(7'-0")		CONTRACTOR
MB9	4'-0" High Fixed Marker Board	10 11 00	CLARIDGE	SERIES 1	MOUNT TOP @ +(7'-0")		CONTRACTOR
MB10	MARKER BOARD 10'-0" H x 4'-0" W	10 11 00	CLARIDGE	SERIES 1	MOUNT TOP @ +(7'-0")		CONTRACTOR
PD1							
PJ1	POLE MOUNTED CEILING MOUNTED PROJECTOR	-	EPSON	980W	SEE TECHNOLOGY DRAWINGS FOR MOUNTING HTS.		CONTRACTOR
PJ2	POLE MOUNTED CEILING MOUNTED PROJECTOR	-	EPSON	980W	SEE TECHNOLOGY DRAWINGS FOR MOUNTING HTS.		CONTRACTOR
PT1	Operable Partition		Hufcor, Inc.	643			
S1	Projection Screen		Draper Inc.	Targa			
T20	GRAB BAR - 18"		BOBRICK	B-5806	MOUNT @ 34" ADA HEIGHT		
T21	GRAB BAR - 42"		BOBRICK	B-5806	MOUNT @ 34" ADA HEIGHT		
TB1	TACKBOARD 4'-0" W x 4'-0" H	10 11 00	CLARIDGE	SEE SPECS	MOUNT TOP @ +(7'-0")		CONTRACTOR
TB2	TACKBOARD 8'-0" W x 4'-0" H	10 11 00	CLARIDGE	SEE SPECS	MOUNT TOP @ +(7'-0")		CONTRACTOR
TB3	TACKBOARD 6'-0" W x 4'-0" H	10 11 00	CLARIDGE	SEE SPECS	MOUNT TOP @ +(7'-0")		CONTRACTOR
TB4	TACKBOARD 10'-0" W x 4'-0" H	10 11 00	CLARIDGE	SEE SPECS	MOUNT TOP @ +(7'-0")		CONTRACTOR
TB5	TACKBOARD 3'-6" W x 3'-8" H	10 11 00	CLARIDGE	SEE SPECS	MOUNT TOP @ +(7'-0")		CONTRACTOR
TB6	TACKBOARD 10'-6" W x 2' H	10 11 00	CLARIDGE	SEE SPECS	MOUNT TOP @ +(7'-0")		CONTRACTOR
TB7	TACKBOARD 12'-0" W x 4'-0" H	10 11 00	CLARIDGE	SEE SPECS	MOUNT TOP @ +(7'-0")		CONTRACTOR
TB8	TACKBOARD 3'-0" W x 3'-8" H	10 11 00	CLARIDGE	SEE SPECS	MOUNT TOP @ +(7'-0")		CONTRACTOR

## GENERAL EQUIPMENT NOTES

1. REFER TO A900 FOR EQUIPMENT SCHEDULES
2. REFER TO A700 SERIES SHEETS FOR TOILET ACCESSORY PLANS AND SCHEDULES.

## GENERAL CASEWORK NOTES

- A. PROVIDE FILLER PANELS AT ALL LOCATIONS WHERE CASEWORK IS FLANKED BY WALLS AS REQUIRED TO CLOSE OFF SPACE AND PROVIDE A NEAT FINISHED INSTALLATION. PROVIDE EQUAL FILLER PANELS AT EITHER SIDE OF CASEWORK TO BALANCE APPEARANCE.
- B. PROVIDE FINISHED ENDS AT ALL CABINET SIDES PARTIALLY OR FULLY EXPOSED TO VIEW.
- C. SEE INTERIOR CASEWORK ELEVATIONS FOR DOOR SWING.
- D. PROVIDE COUNTER GROMMETS FOR ALL OPEN KNEE-SPACE COUNTERTOP INSTALLATIONS.
- E. REFER TO A600 SERIES DRAWINGS FOR FINISHES NOT NOTED ON EQUIPMENT PLANS AND CASEWORK ELEVATIONS.
- F. REFER TO REFLECTED CEILING PLANS FOR CEILING MOUNTED PROJECTORS

SSCSO

8831 Keystone Crossing, Indianapolis, IN 46240  
317.448.7800 | cso.net

PROJECT: MSD OF WARREN TOWNSHIP  
WARREN CENTRAL HIGH SCHOOL  
PHASE 3 ADDITION & RENOVATION  
9500 E. 16th STREET, INDIANAPOLIS, IN 46229

REVISIONS:  
1 ADDENDUM #2 03-13-2023


ISSUE DATE: 02-21-2023 DRAWN BY: Author CHECKED BY: Checker

DRAWING TITLE: EQUIPMENT & CASEWORK SCHEDULE  
CERTIFIED BY: JAMES ROBERT PE, P.E.  
REGISTERED ARCHITECT  
No. AR00900003  
STATE OF INDIANA  
ARCHITECT  
Signature

DRAWING NUMBER: A900B

PROJECT NUMBER: 2021056



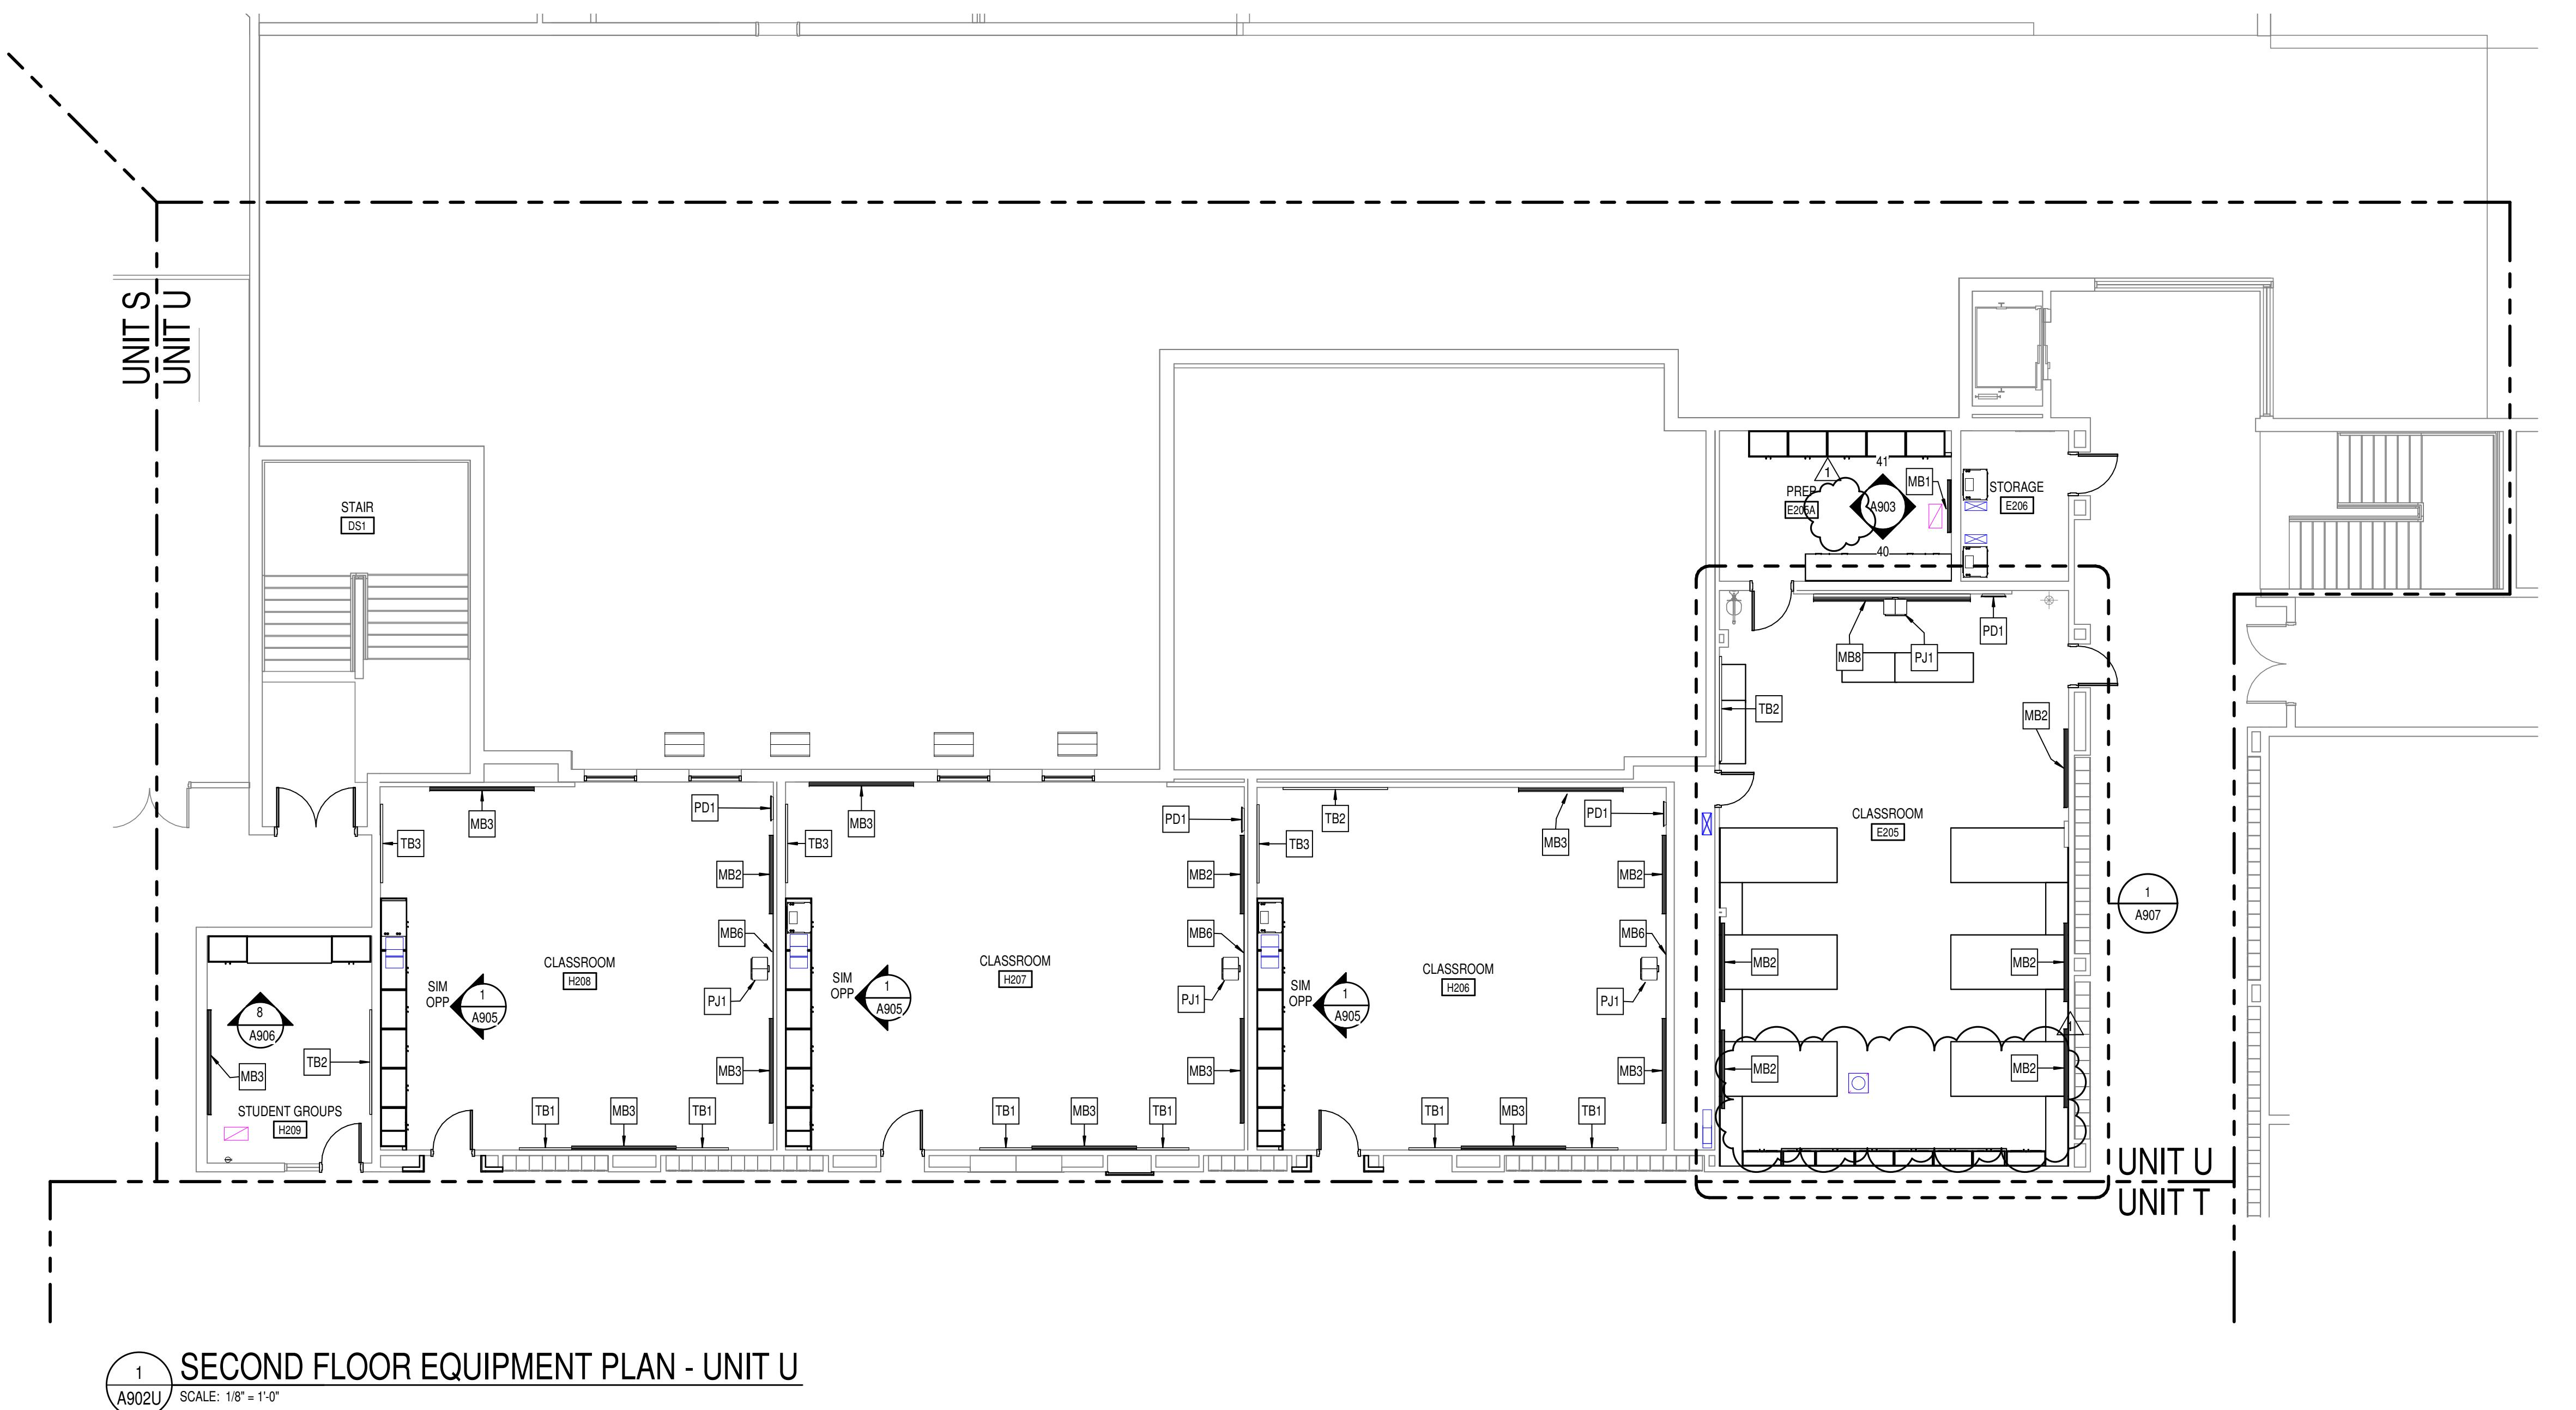

## GENERAL EQUIPMENT NOTES

REFER TO A900 FOR EQUIPMENT SCHEDULES.

REFER TO A700 SERIES SHEETS FOR TOILET ACCESSORY PLANS AND SCHEDULES.

## **GENERAL CASEWORK NOTES**

- PROVIDE FILLER PANELS AT ALL LOCATIONS WHERE CASEWORK IS FLANKED BY WALLS AS REQUIRED TO CLOSE OFF SPACE AND PROVIDE A NEAT, FINISHED INSTALLATION. PROVIDE EQUAL FILLER PANELS AT EITHER SIDE OF CASEWORK TO BALANCE APPEARANCE.
- PROVIDE FINISHED ENDS AT ALL CABINET SIDES PARTIALLY OR FULLY EXPOSED TO VIEW.
- SEE INTERIOR CASEWORK ELEVATIONS FOR DOOR SWING.
- PROVIDE COUNTER GROMMETS FOR ALL OPEN KNEE-SPACE COUNTERTOP INSTALLATIONS.
- REFER TO A800 SERIES DRAWINGS FOR FINISHES NOT NOTED ON EQUIPMENT PLANS AND CASEWORK ELEVATIONS.
- REFER TO REFLECTED CEILING PLANS FOR CEILING MOUNTED PROJECTORS



○ S C S

8831 Keystone Crossing, Indianapolis, IN 46240  
317.848.7800 | csoinc.net

MSD OF WARREN TOWNSHIP


**WARREN CENTRAL HIGH SCHOOL**  
**PHASE 3 ADDITION & RENOVATION**

9500 E 16th STREET INDIANAPOLIS IN 46220

**SCOPE DRAWINGS:**  
These drawings indicate the general scope of the project, the forms of architectural design concept, the dimensions of the building, the major architectural elements and the typical structural, mechanical and electrical systems.  
The drawings do not necessarily indicate or describe the work required for full performance and completion of the requirements of the Contract.  
On the basis of the general scope indicated or described, trade contractors shall furnish all items required for the execution and completion of the work.

REVISIONS.  
ADDENDUM #2 03-13-2022

DRAWING TITLE:  
**SECOND FLOOR  
EQUIPMENT  
PLAN - UNIT U**

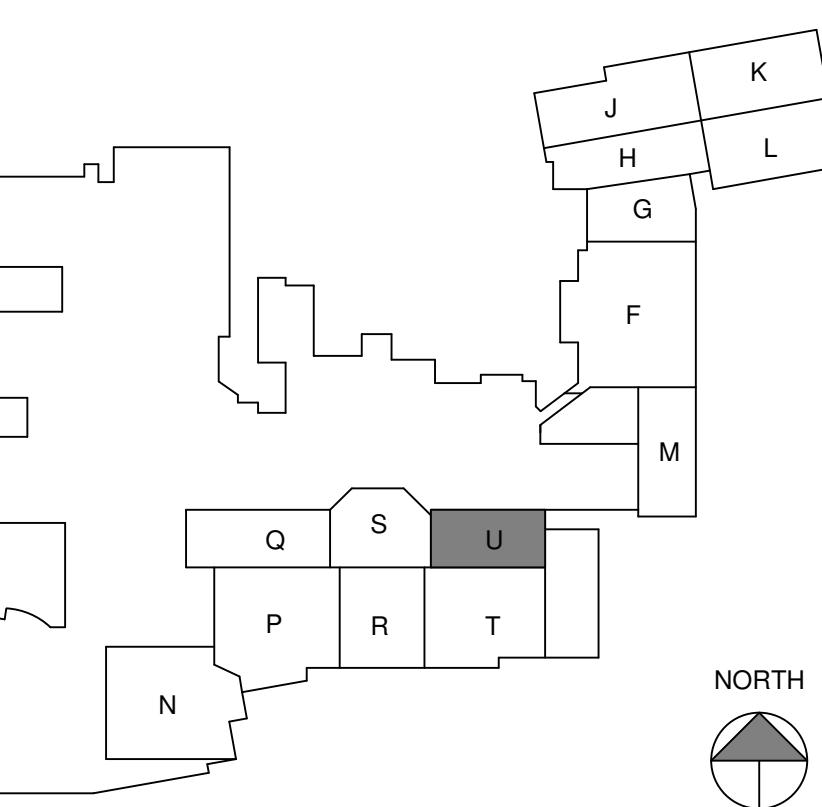

DRAWING NUMBER  
**A902U**

PROJECT NUMBER  
**2021056**



SCCSO  
8831 Keystone Crossing, Indianapolis, IN 46240  
317.648.7800 | csoarchitects.com


PROJECT:  
MSD OF WARREN TOWNSHIP  
WARREN CENTRAL HIGH SCHOOL  
PHASE 3 ADDITION & RENOVATION  
9500 E. 16th STREET, INDIANAPOLIS, IN 46229

SCOPE DRAWINGS:  
These drawings, in terms of the architectural design concept, the dimensions of the building, and the location of the structural, mechanical and electrical systems, are intended to provide the information required to describe all the work to be performed. The drawings do not contain all the requirements of the Contract.  
The trade contractors shall furnish all items required for the proper execution and completion of the work.

REVISIONS:  
1 ADDENDUM #2 03-13-2023

ISSUE DATE DRAWN BY CHECKED BY  
02-21-2023 Author Checker

DRAWING TITLE:  
CASEWORK ELEVATIONS

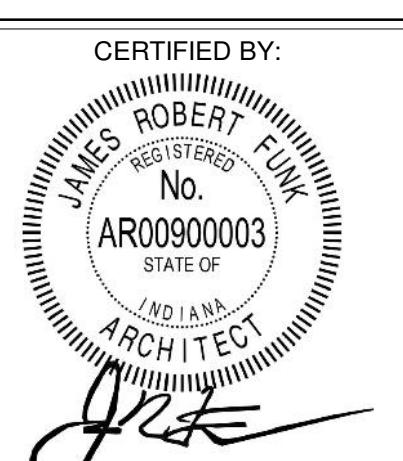

DRAWING NUMBER  
A903


PROJECT NUMBER  
2021056

## GENERAL EQUIPMENT NOTES

1. REFER TO A900 FOR EQUIPMENT SCHEDULES.
2. REFER TO A700 SERIES SHEETS FOR TOILET ACCESSORY PLANS AND SCHEDULES.

## GENERAL CASEWORK NOTES

- A. PROVIDE FILLER PANELS AT ALL LOCATIONS WHERE CASEWORK IS FLANKED BY WALLS AS REQUIRED TO CLOSE OFF SPACE AND PROVIDE A NEAT FINISHED INSTALLATION. PROVIDE EQUAL FILLER PANELS AT EITHER SIDE OF CASEWORK TO BALANCE APPEARANCE.
- B. PROVIDE FINISHED ENDS AT ALL CABINET SIDES PARTIALLY OR FULLY EXPOSED TO VIEW.
- C. SEE INTERIOR CASEWORK ELEVATIONS FOR DOOR SWING.
- D. PROVIDE COUNTER GROMMETS FOR ALL OPEN KNEE-SPACE COUNTERTOP INSTALLATIONS.
- E. REFER TO A600 SERIES DRAWINGS FOR FINISHES NOT NOTED ON EQUIPMENT PLANS AND CASEWORK ELEVATIONS.
- F. REFER TO REFLECTED CEILING PLANS FOR CEILING MOUNTED PROJECTORS.

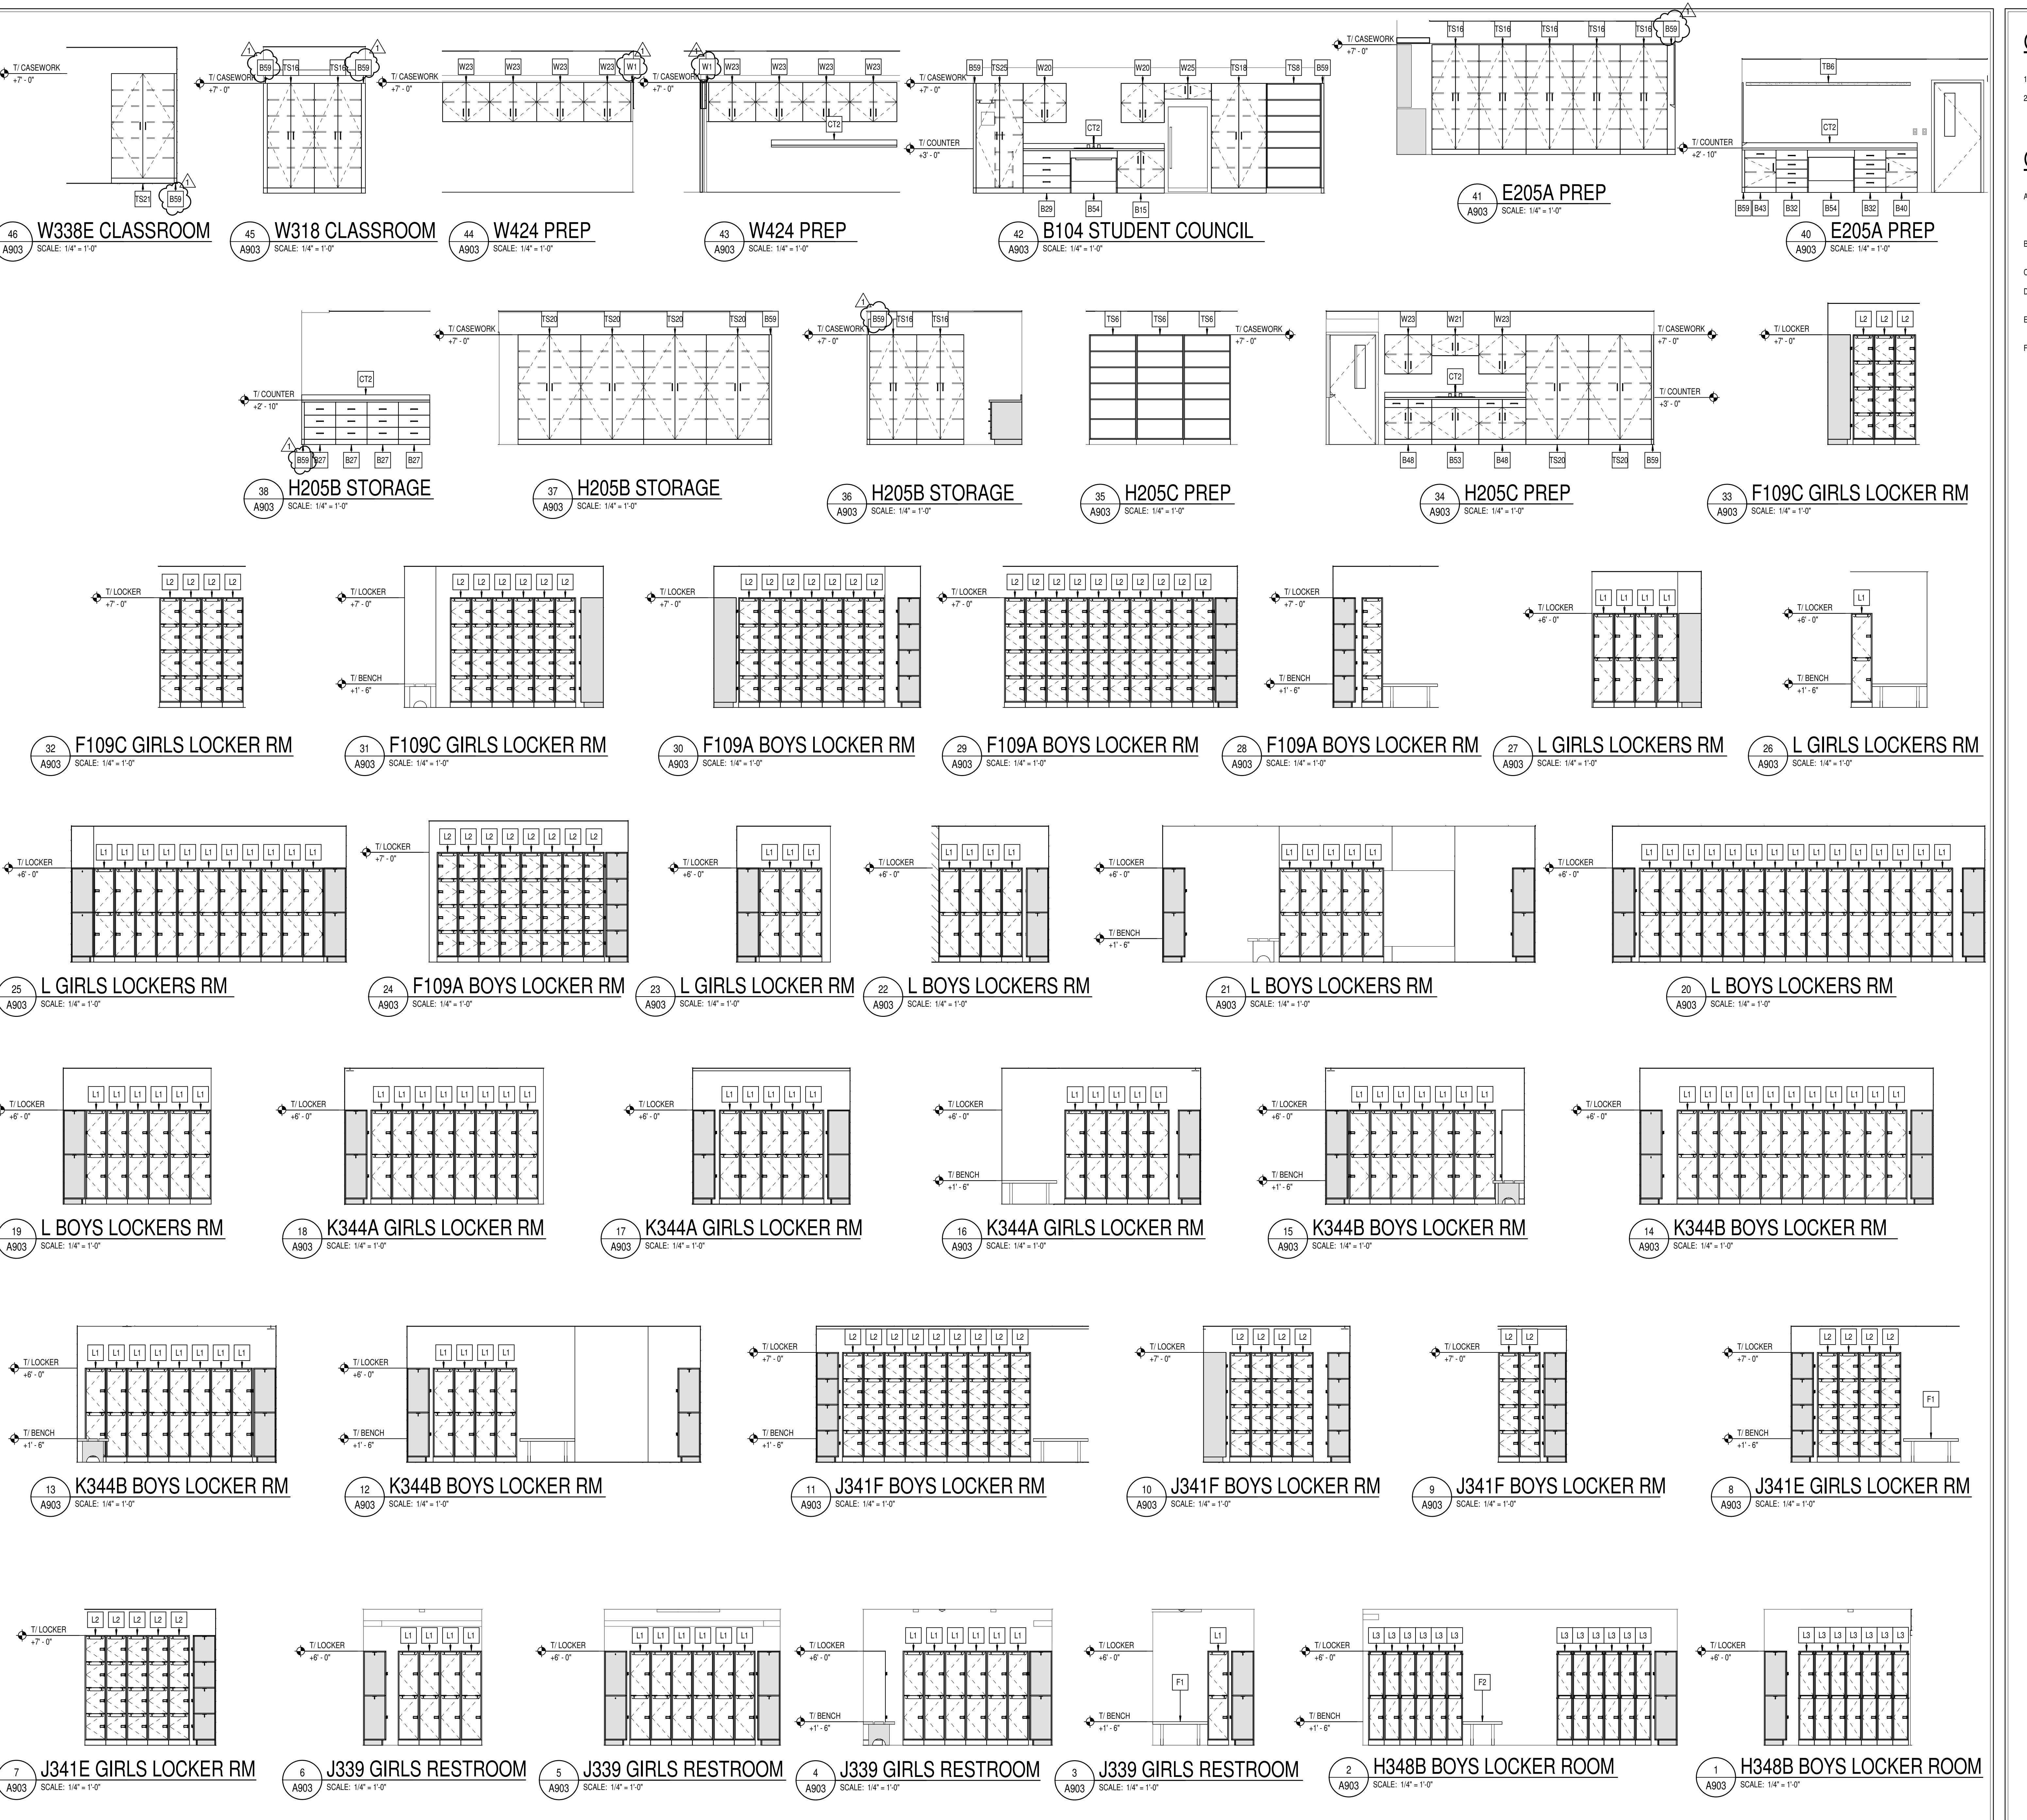



SCCSO

8831 Keystone Crossing, Indianapolis, IN 46240  
317.648.7800  
© 2020 CCSO Architects, Inc. All Rights Reserved

PROJECT:  
WARREN CENTRAL HIGH SCHOOL  
PHASE 3 ADDITION & RENOVATION  
9500 E. 16th STREET, INDIANAPOLIS, IN 46229

SCOPE DRAWINGS:  
These drawings illustrate the scope of the project in terms of architectural and design concept, the dimensions of the structures, and the location of the structural, mechanical and electrical systems. The drawings are intended to describe all the requirements of the Contract.

REVISIONS:

1 ADDENDUM #2 03-13-2023


ISSUE DATE DRAWN BY CHECKED BY  
02-21-2023 Author Checker

DRAWING TITLE:  
CASEWORK  
ELEVATIONS

CERTIFIED BY:  
ROBERT JAMES PINK  
REGISTERED ARCHITECT  
No. AR0090003  
STATE OF INDIANA

DRAWING NUMBER  
A904


PROJECT NUMBER  
2021056

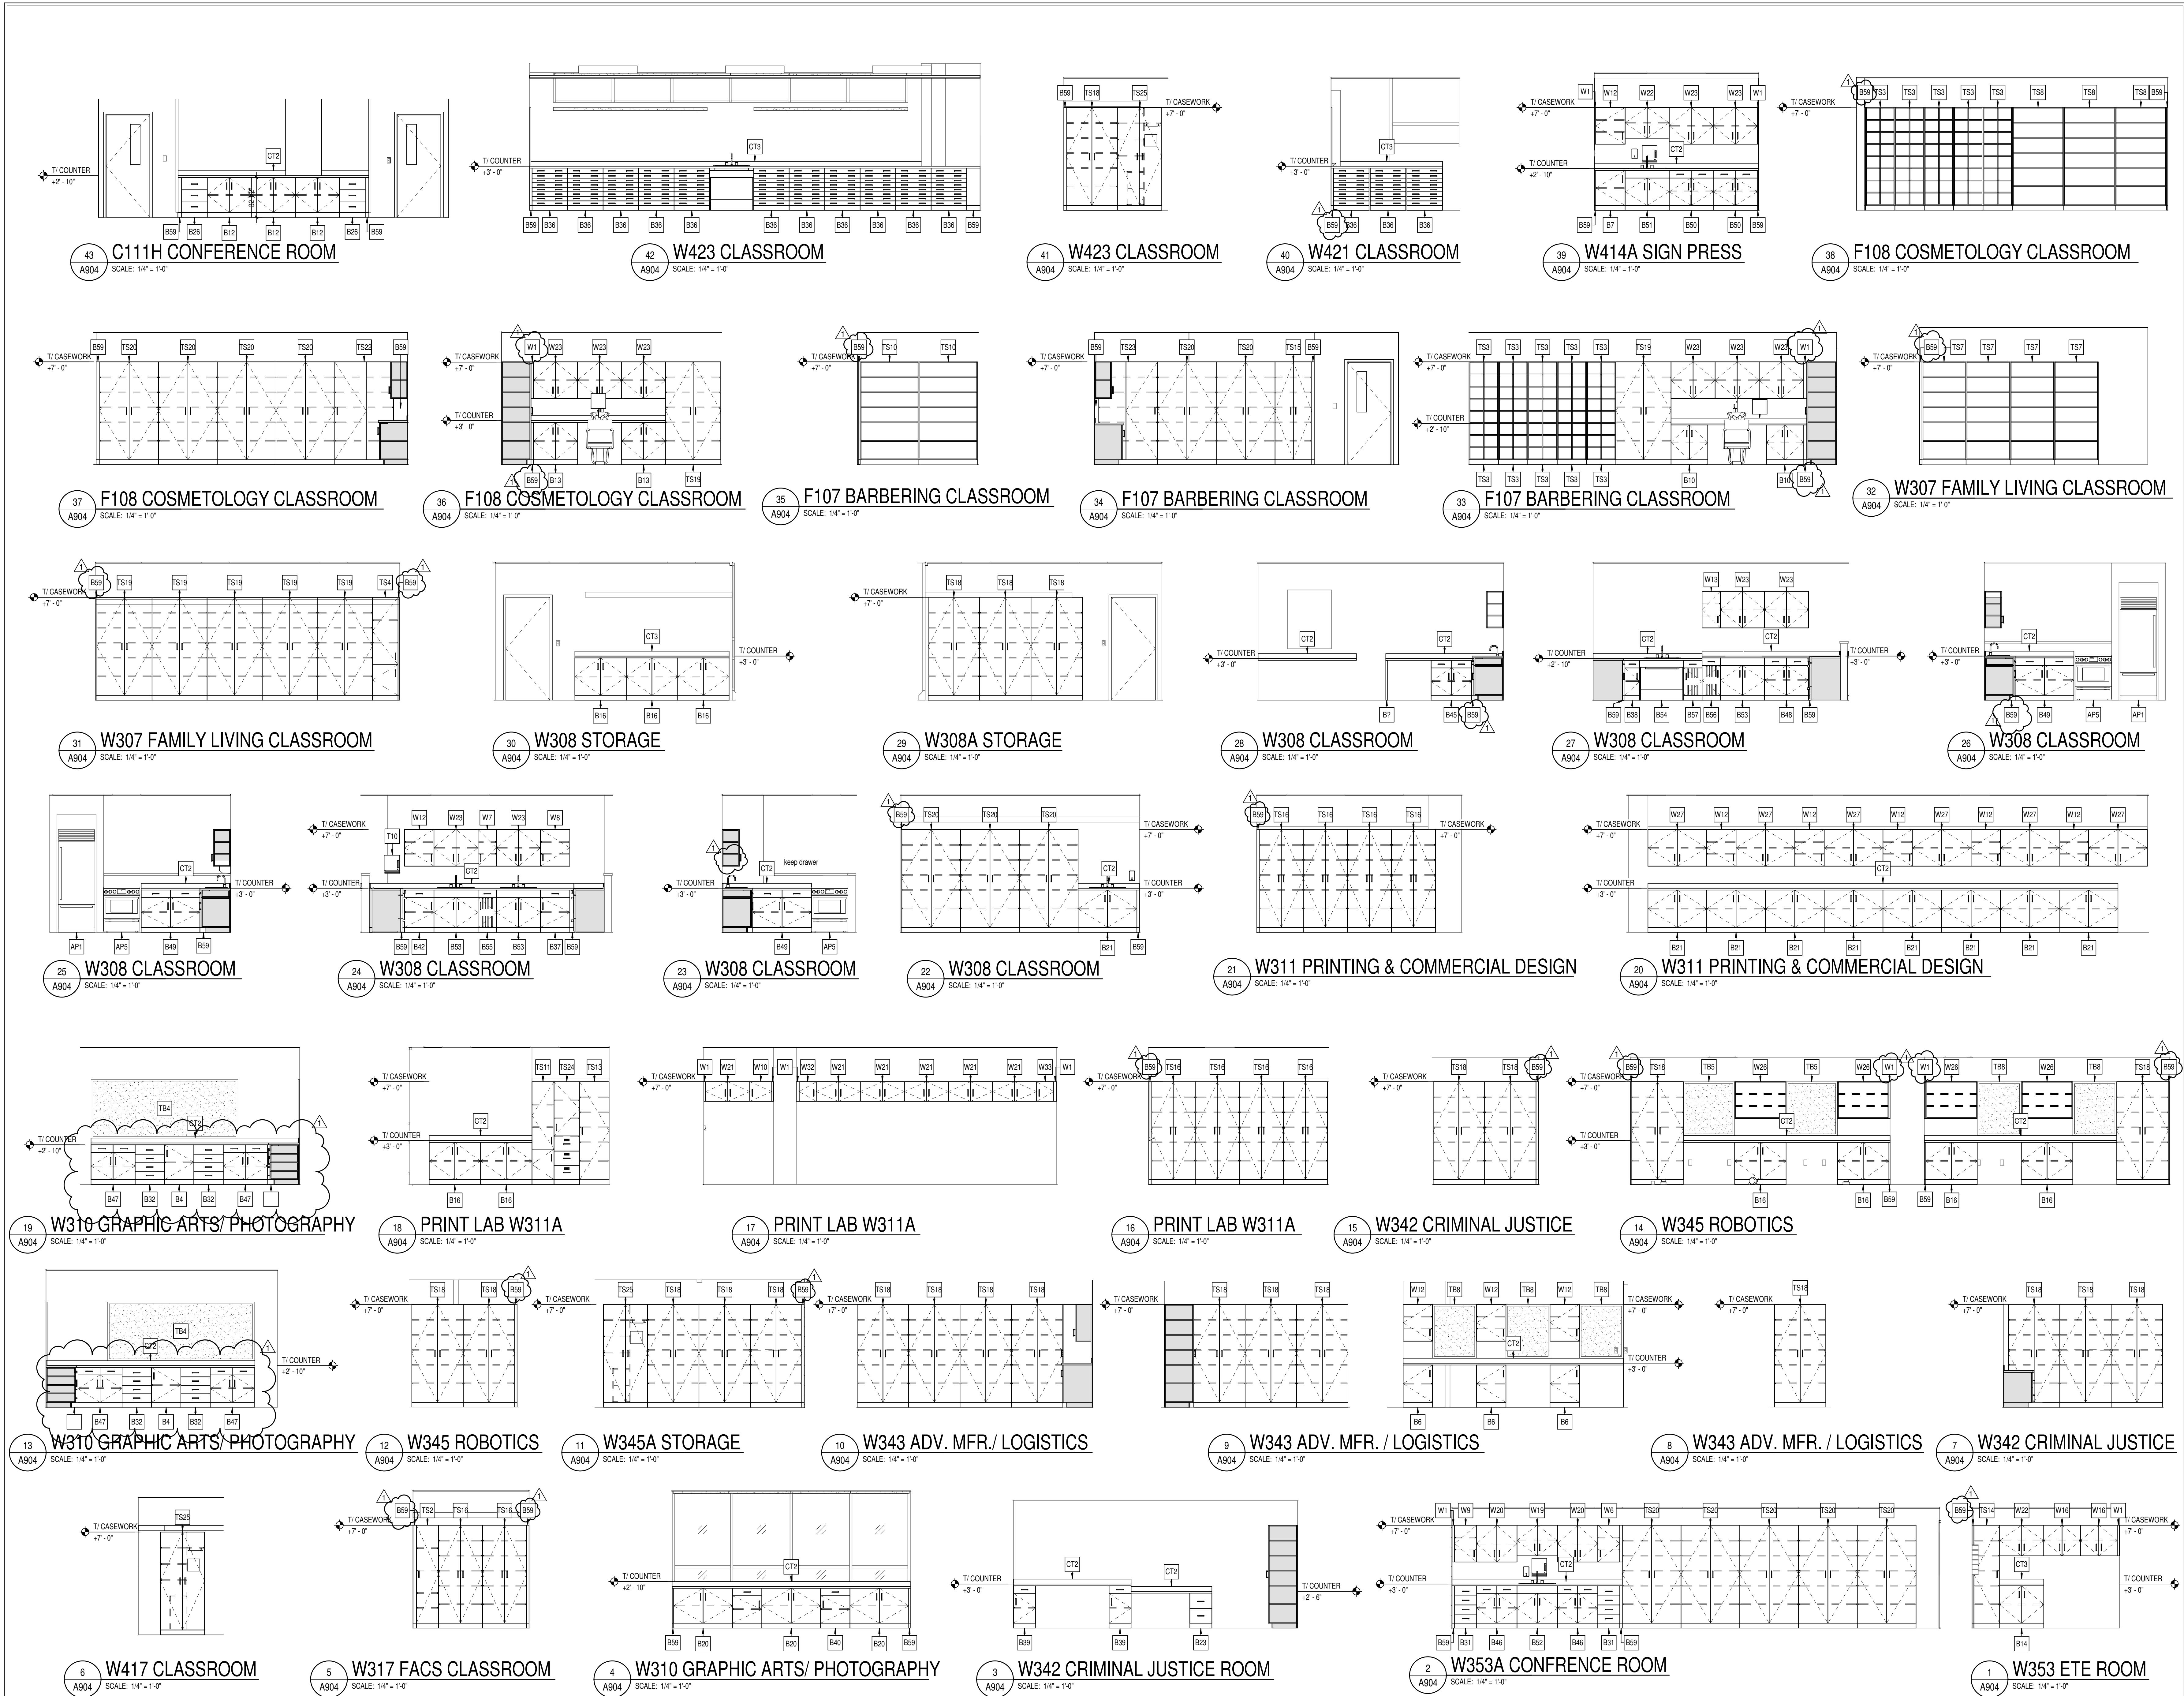



○  
S  
C  
S

317.848.7800 | csoinc.net

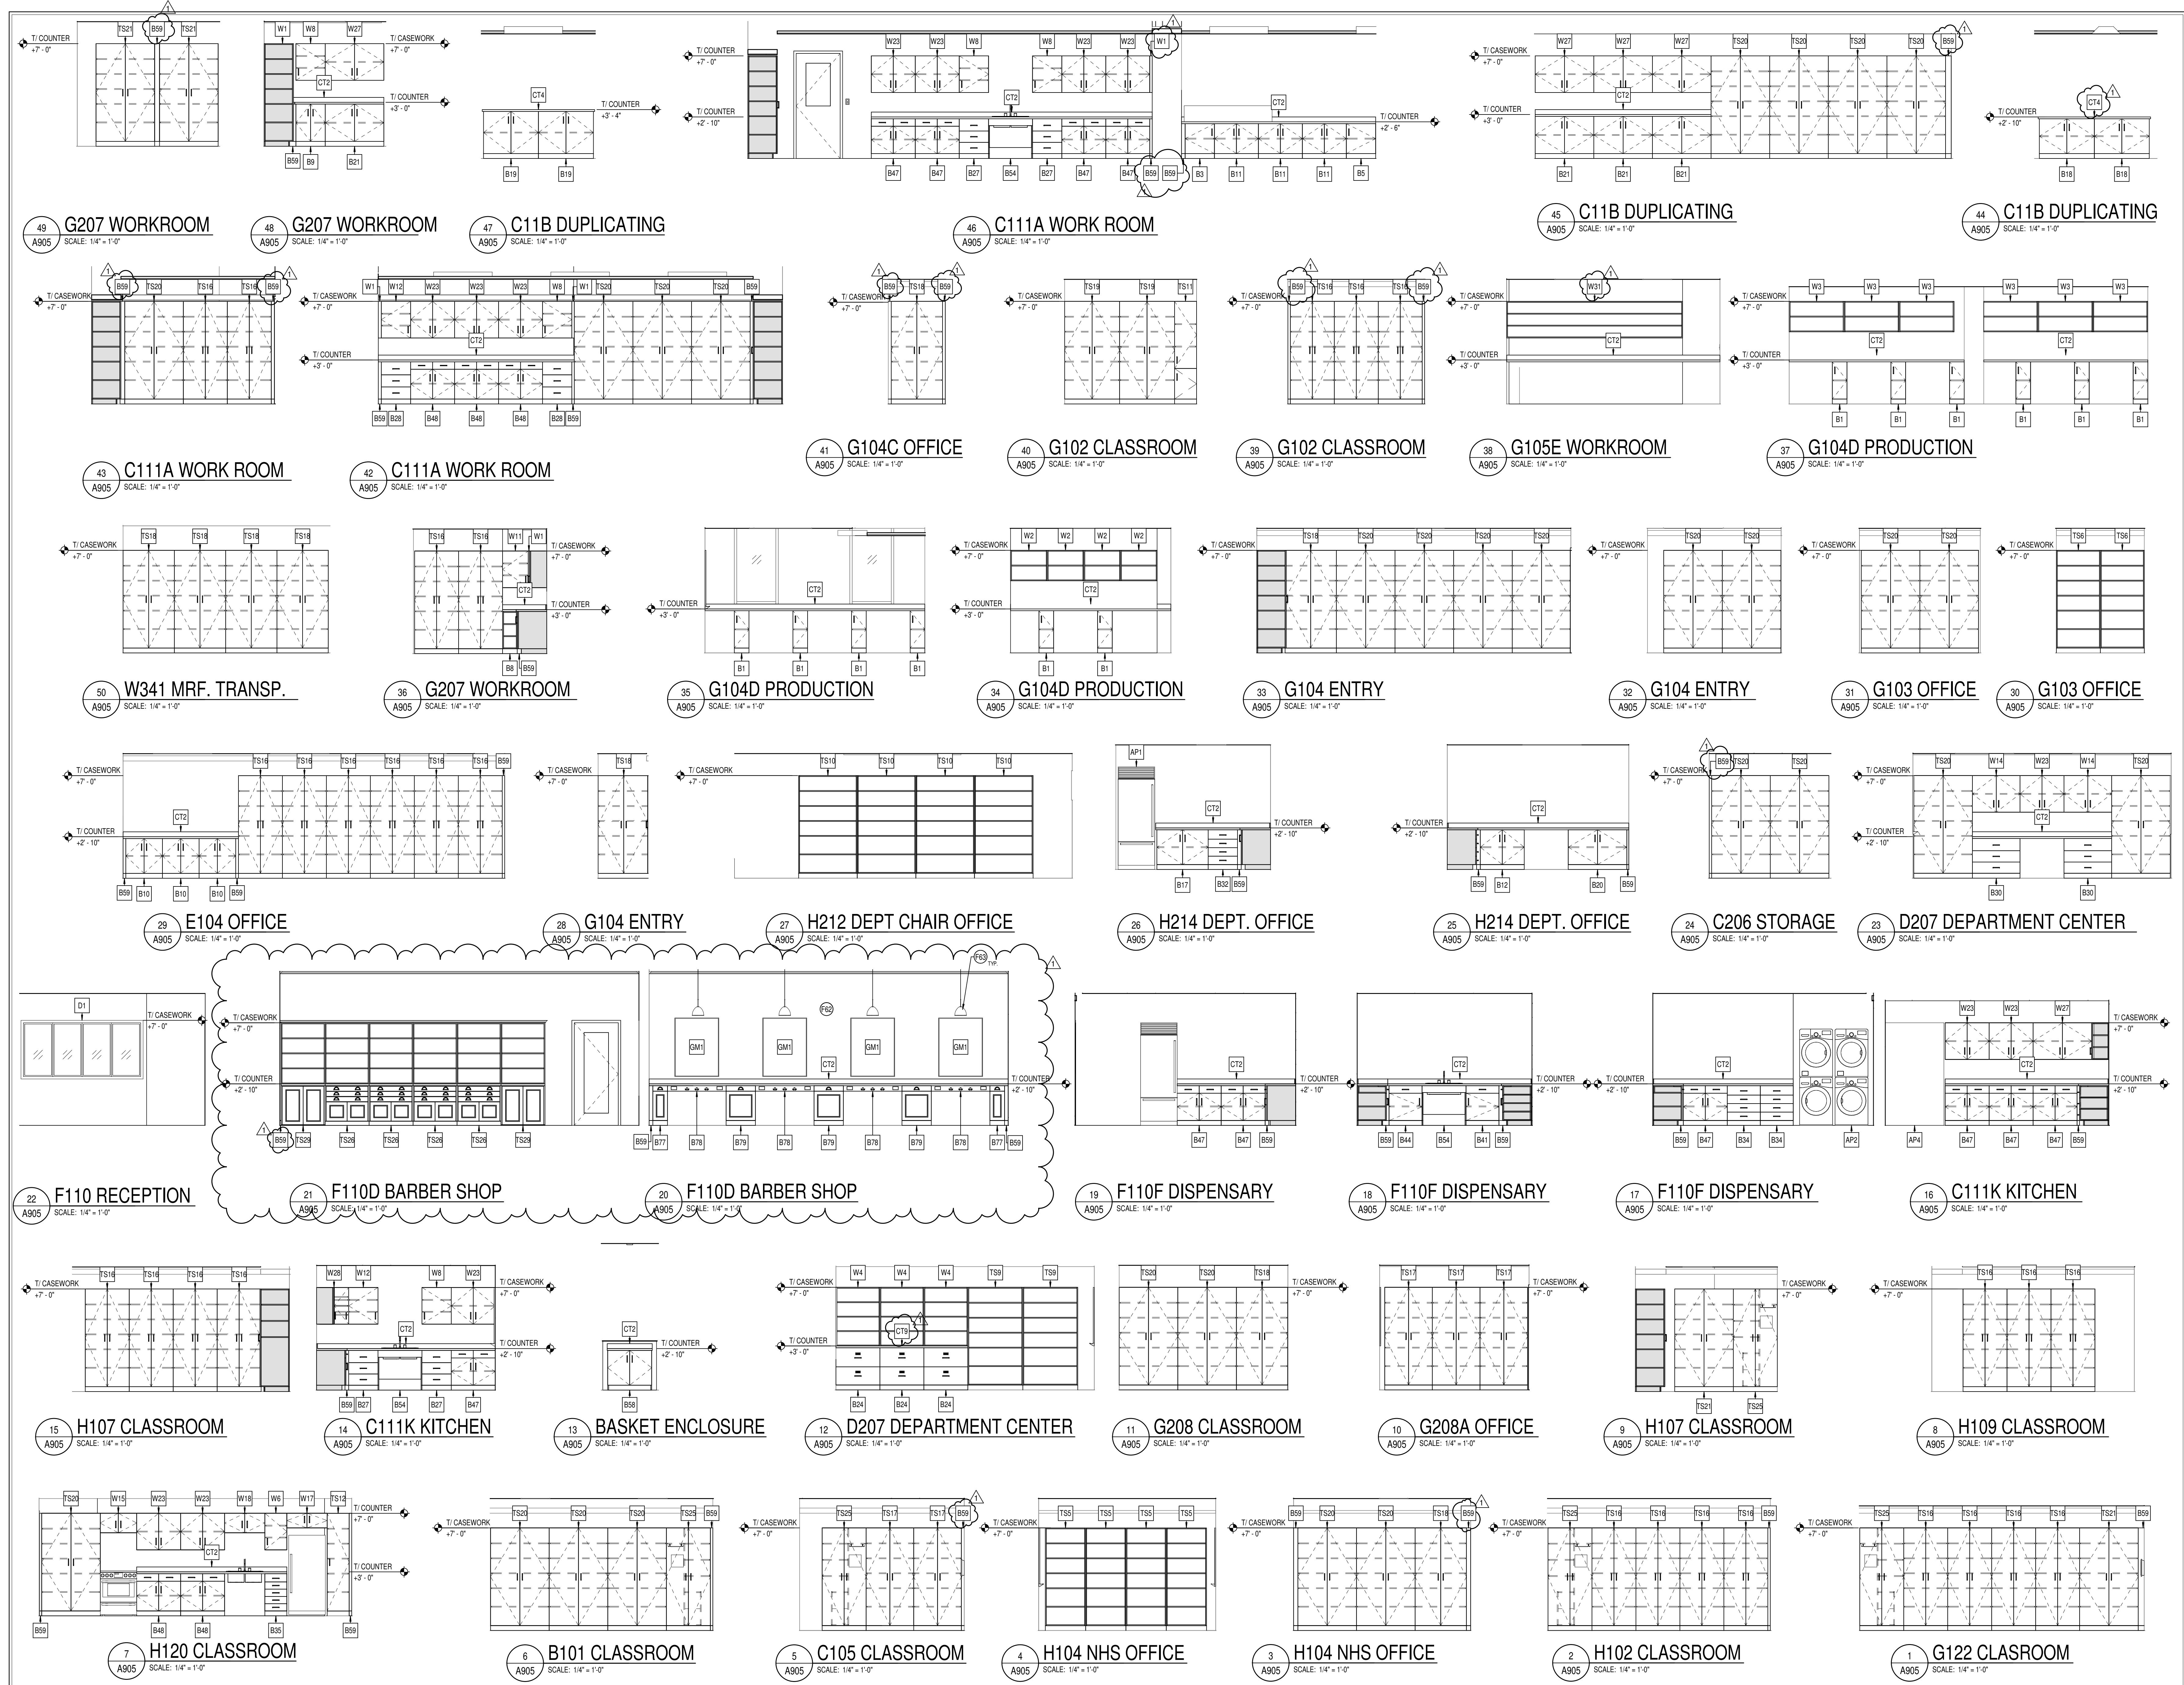

MSD OF WARREN TOWNSHIP

**WARREN CENTRAL HIGH SCHOOL**

**PHASE 3 ADDITION & RENOVATION**

9500 E. 16th STREET INDIANAPOLIS IN 46220

**SCOPE DRAWINGS:**  
These drawings indicate the general scope of the project in terms of architectural design concept, the dimensions of the building, the major architectural elements and the typical structural, mechanical and electrical systems. The drawings do not necessarily indicate or describe all the work required for full performance and completion of the requirements of the Contract. On the basis of the general scope indicated or described, trade contractors shall furnish all items required for the execution and completion of the work.

## REVISIONS:

ISSUE DATE DRAWN BY CHECKED

DRAWING TITLE:  
**CASEWORK**

DRAWING TITLE:  
**CASEWORK  
ELEVATIONS**

DRAWING NUMBER  
**A905**

PROJECT NUMBER  
**2021056**



○  
S  
C  
S

8831 Keystone Crossing, Indianapolis, IN 46240

317.848.7800 | csoinc.net

# WARREN CENTRAL HIGH SCHOOL

## PHASE 3 ADDITION & RENOVATION

MSD OF WARREN TOWNSHIP

**SCOPE DRAWINGS:**  
These drawings indicate the general scope of the project, the terms of architectural design concept, the dimensions of building, the major architectural elements and the type of structural, mechanical and electrical systems. The drawings do not necessarily indicate or describe all that is required for full performance and completion of the requirements of the Contract. On the basis of the general scope indicated or described, trade contractors shall furnish all items required for the proper execution and completion of the work.

---

## REVISIONS:


---


ISSUE DATE      DRAWN BY      CHECKED BY

DRAWING TITLE:  
**CASEWORK  
ELEVATIONS**

DRAWING NUMBER  
**A906**

PROJECT NUMBER  
**2021056**

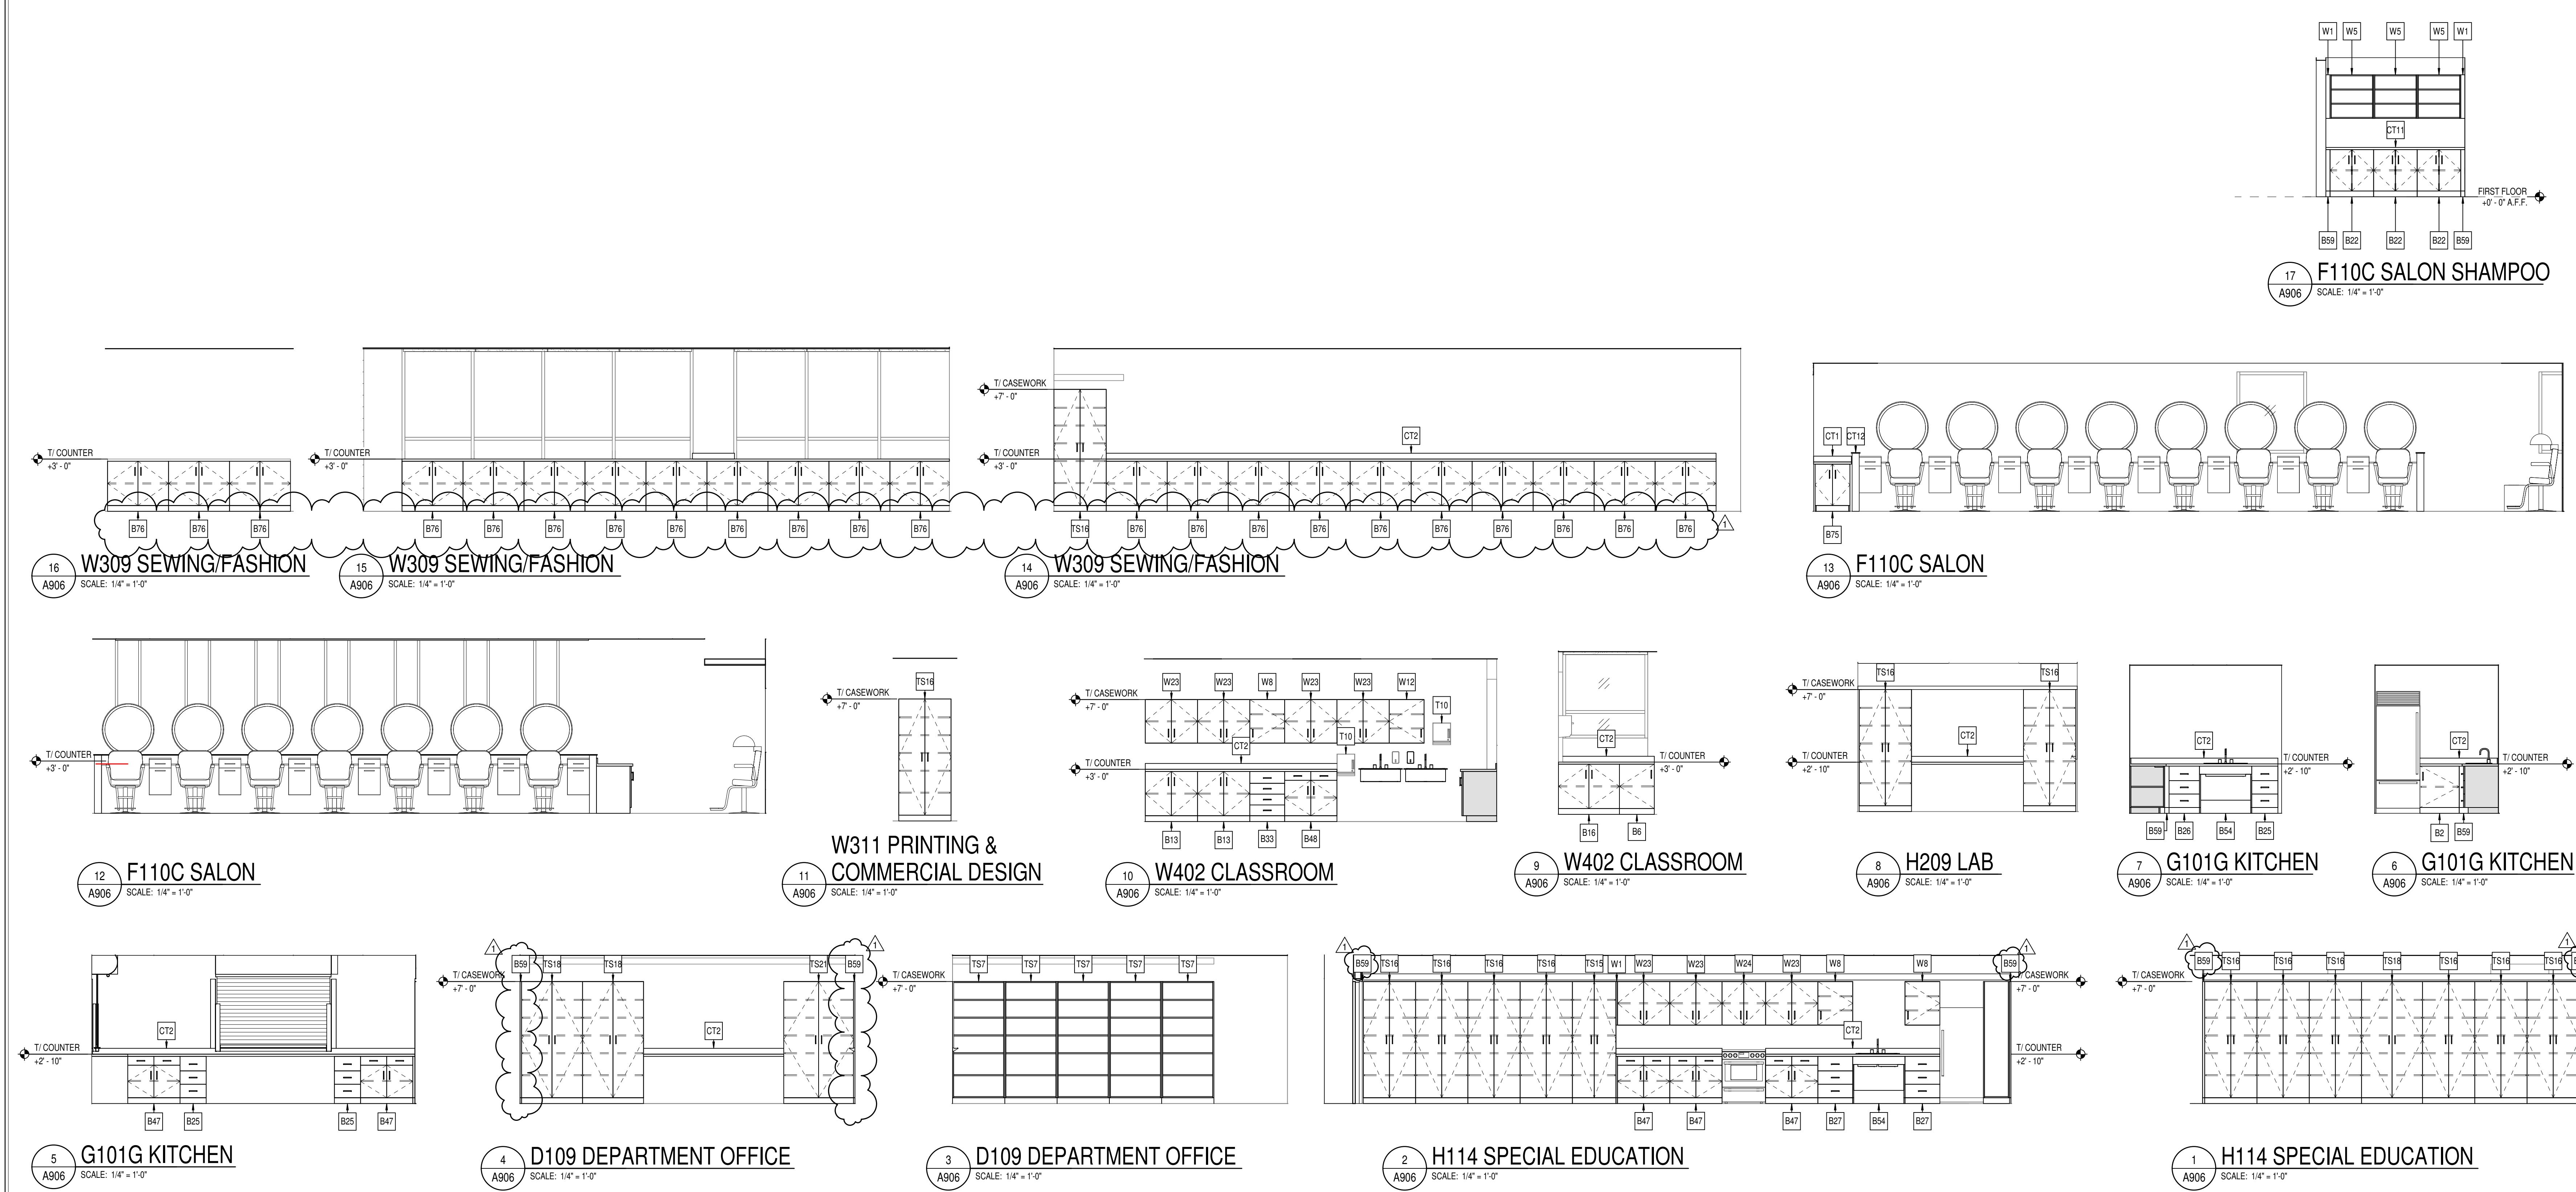

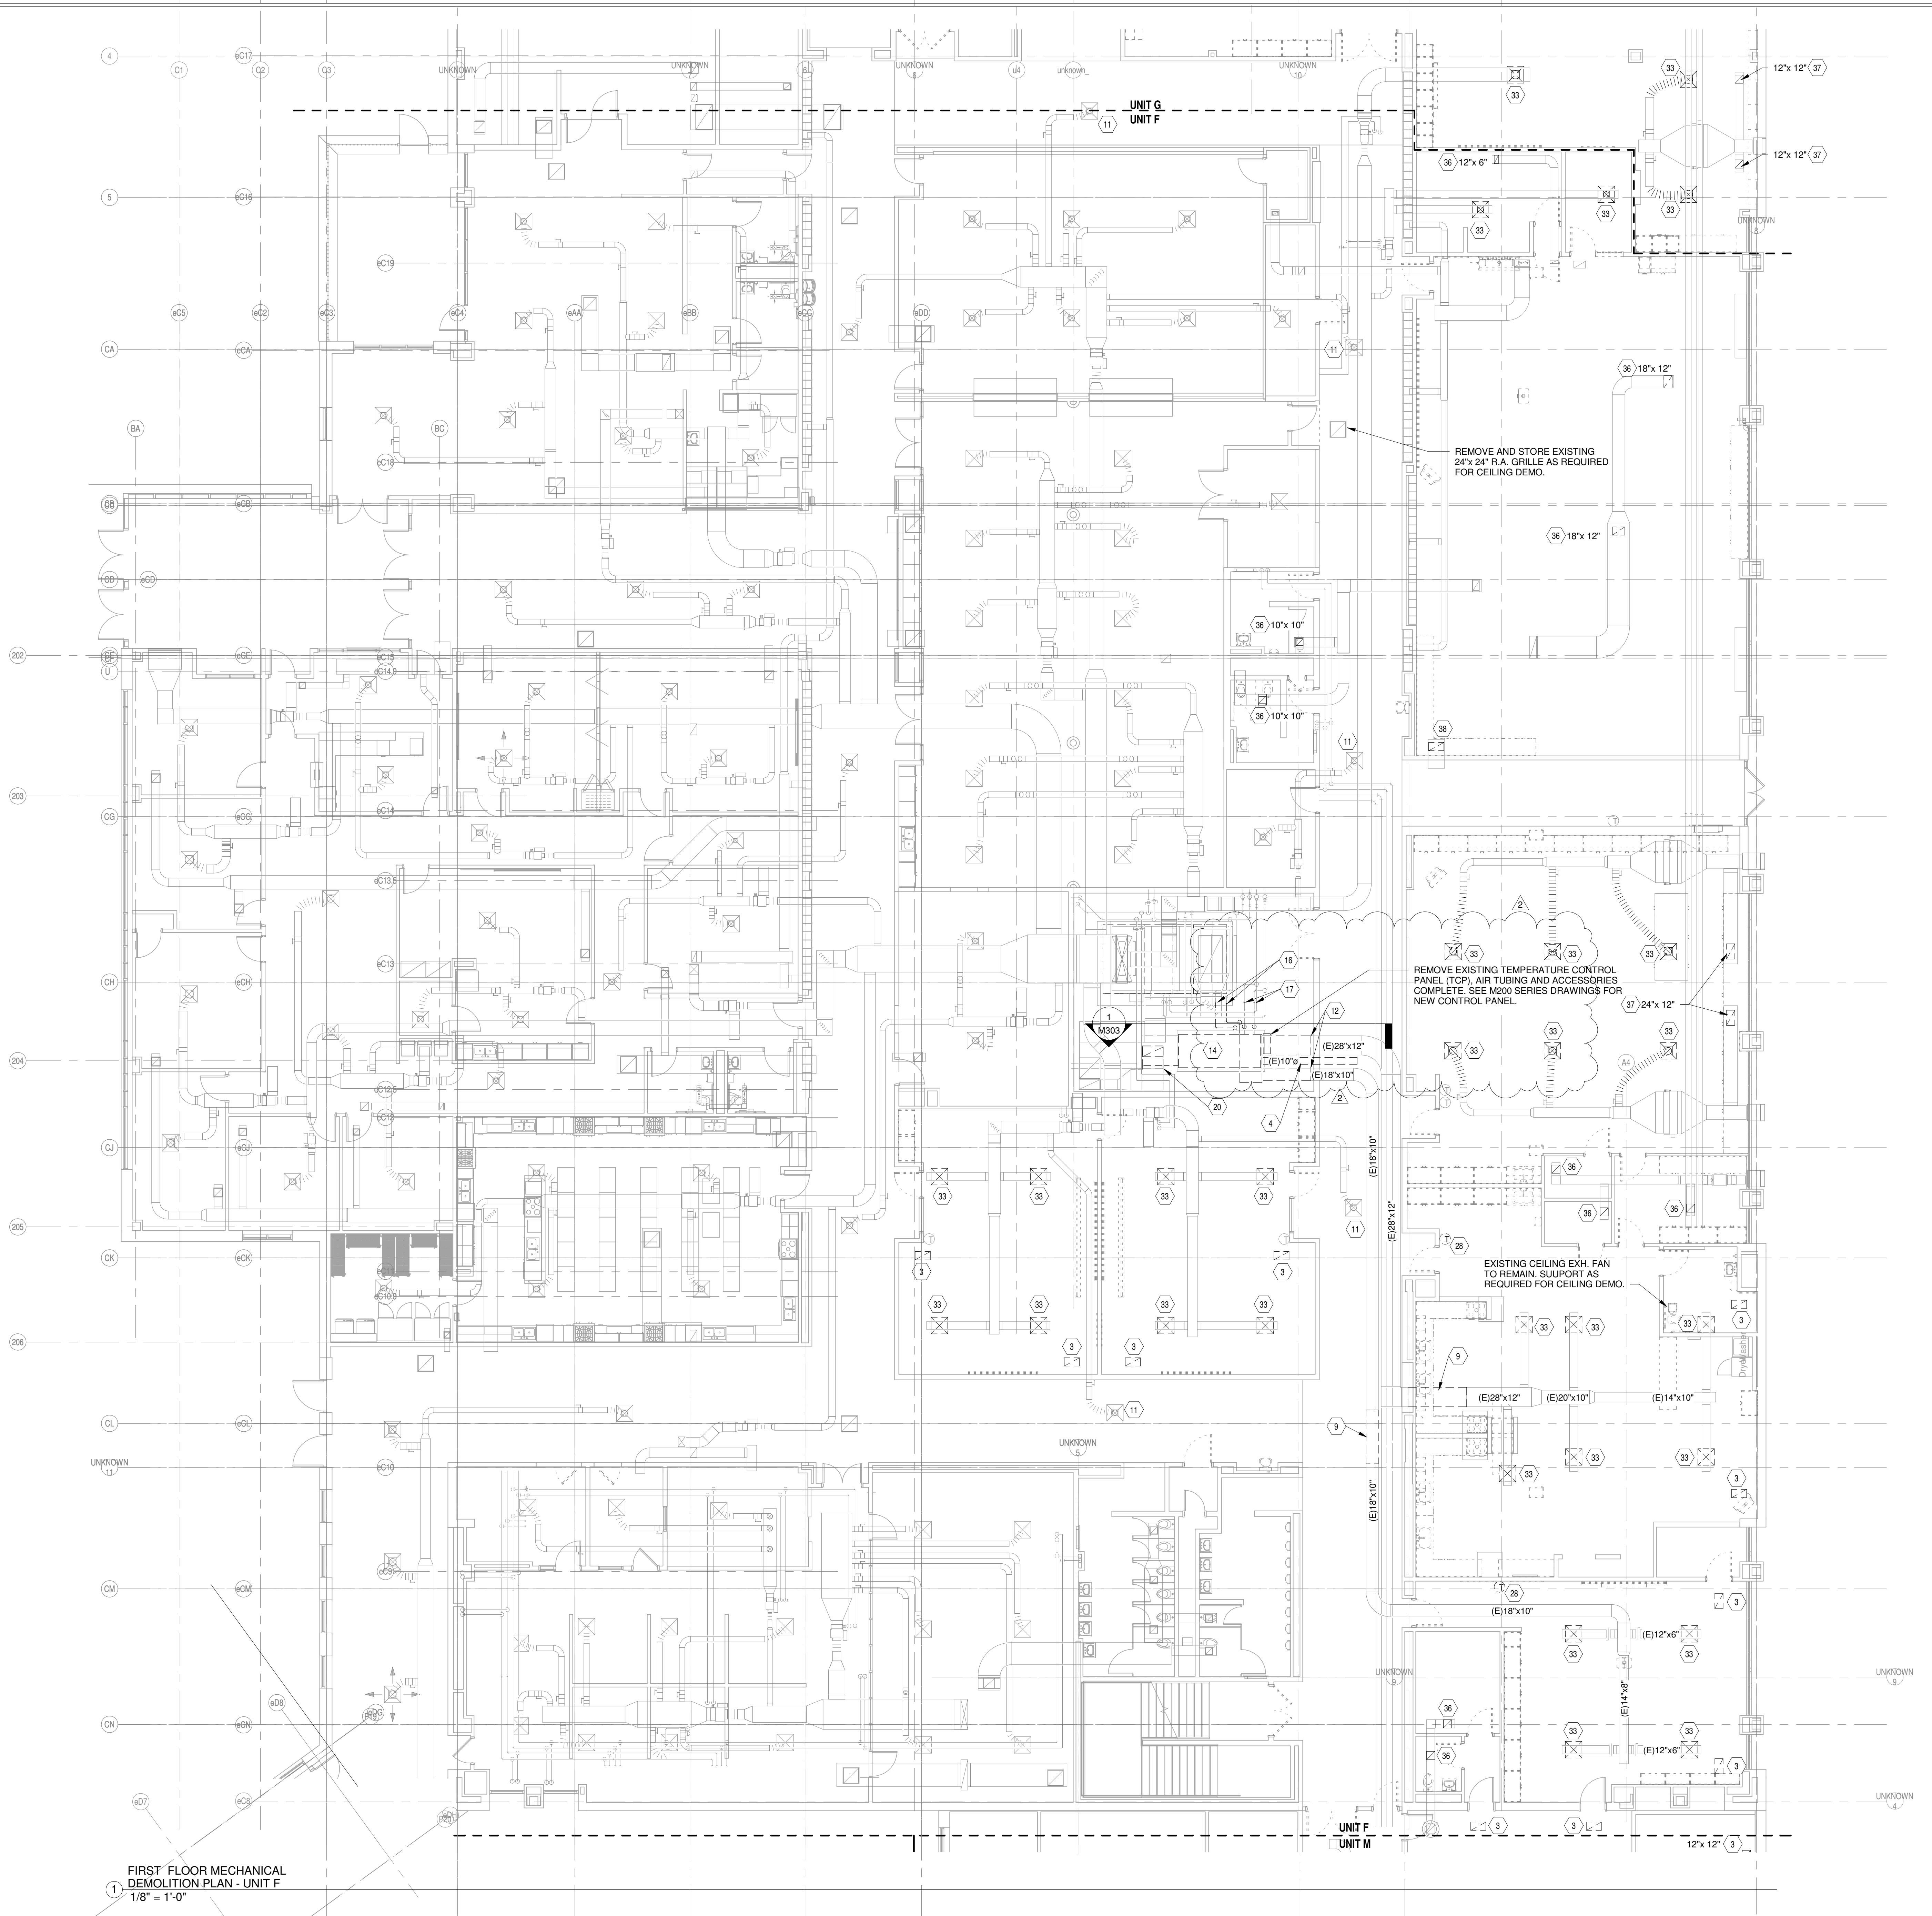

## MECHANICAL DEMOLITION PLAN NOTES

- 1 REMOVE EXISTING SUPPLY AIR SLOT DIFFUSER AND RELATED DUCTWORK COMPLETE.
- 2 REMOVE EXISTING SUPPLY AIR DIFFUSER (U.N.O.), DUCTWORK AND ACCESSORIES COMPLETE. WHERE (E) MAIN DUCT IS TO REMAIN, CAP DUCT AIRTIGHT AS REQUIRED.
- 3 REMOVE EXISTING 24x12" (U.N.O.) RETURN AIR GRILLE.
- 4 REMOVE EXISTING SUPPLY AIR DUCTWORK COMPLETE.
- 5 REMOVE EXISTING DDC TEMPERATURE SENSOR AND RELATED CONTROL WIRING COMPLETE. PREPARE EXISTING OPENING FOR NEW SENSOR. SEE M200 SERIES DRAWINGS FOR NEW WORK.
- 6 REMOVE EXISTING PNEUMATIC THERMOSTAT AND AIR TUBING COMPLETE. WHERE EXISTING WALLS ARE TO REMAIN, PROVIDE STAINLESS STEEL BLANK COVER PLATE.
- 7 REMOVE EXISTING UNIT VENTILATOR, HEATING WATER LINES, CHILLED WATER LINES, CONDENSATE DRAIN LINE, CONTROLS AND ACCESSORIES COMPLETE.
- 8 REMOVE EXISTING CABINET UNIT HEATER, HEATING WATER LINES, CONTROLS AND ACCESSORIES COMPLETE.
- 9 REMOVE SECTION OF EXISTING SUPPLY AIR DUCT AS REQUIRED TO INSTALL NEW VAV BOX. SEE M200 SERIES DRAWINGS FOR NEW WORK.
- 10 REMOVE EXISTING EXHAUST GRILLE/ REGISTER AND RELATED EXHAUST DUCT COMPLETE.
- 11 MECHANICAL CONTRACTOR TO SUPPORT EXISTING SUPPLY AIR DIFFUSER AS REQUIRED FOR DEMO OF EXISTING CEILING. SEE M200 SERIES DRAWINGS FOR NEW WORK.
- 12 REMOVE EXISTING SUPPLY AIR DUCT TO THIS POINT COMPLETE. PREPARE EXISTING SUPPLY AIR DUCT FOR RECONNECTION. SEE M200 SERIES DRAWINGS FOR NEW WORK.
- 13 REMOVE EXISTING RETURN AIR DUCT TO THIS POINT COMPLETE. PREPARE EXISTING RETURN AIR DUCT FOR RECONNECTION. SEE M200 SERIES DRAWINGS FOR NEW WORK. IF RETURN AIR IS NOT BEING RECONNECTED CAP AIRTIGHT AS REQUIRED.
- 14 REMOVE EXISTING AIR HANDLING UNIT, SUPPLY, RETURN & OUTSIDE AIR DUCTWORK, HEATING WATER PIPING, CHILLED WATER PIPING, CONDENSATE DRAIN LINE, CONTROLS AND ACCESSORIES COMPLETE. EXISTING CONCRETE PAD TO REMAIN.
- 15 REMOVE EXISTING FAN COIL UNIT, HEATING WATER LINES, CHILLED WATER LINES, CONDENSATE DRAIN LINE CONTROLS AND ACCESSORIES COMPLETE. WHERE FAN COIL UNIT IS BEING REPLACE PREPARE EXISTING SUPPLY FOR RECONNECTION. SEE M200 SERIES DRAWINGS FOR NEW WORK.
- 16 REMOVE EXISTING HEATING WATER SUPPLY AND RETURN LINES TO THIS POINT COMPLETE. PREPARE HEATING LINE FOR RECONNECTION AS REQUIRED. SEE M200 SERIES DRAWINGS FOR NEW WORK.
- 17 REMOVE EXISTING CHILLED WATER SUPPLY AND RETURN LINES TO THIS POINT COMPLETE. PREARE EXISTING CHILLED WATER LINES FOR RECONNECTION AS REQUIRED. SEE M200 SERIES DRAWINGS FOR NEW WORK.
- 18 REMOVE EXISTING CONVECTOR AND HEATING WATER SUPPLY AND RETURN LINES COMPLETE. PREPARE EXISTING HEATING WATER LINES AS REQUIRED FOR RECONNECTION IF CONVECTOR IS BEING REPLACED. SEE M200 SERIES DRAWINGS FOR WORK.
- 19 REMOVE EXISTING FAN POWERED VAV BOX, HEATING WATER LINES, CONTROLS AND ACCESSORIES COMPLETE. WHERE EXISTING HEATING WATER MAINS ARE TO REMAIN, CAP LINES WATERTIGHT AS REQUIRED.
- 20 REMOVE EXISTING OUTSIDE AIR DUCT TO THIS POINT COMPLETE. PREPARE EXISTING OUTSIDE AIR DUCT FOR RECONNECTION. SEE M200 SERIES DRAWINGS FOR NEW WORK.
- 21 REMOVE EXHAUST FAN, EXISTING DUCTWORK AND CURB TO REMAIN. PREPARE DUCTWORK AND CURB FOR RECONNECTION. SEE M200 SERIES DRAWINGS FOR NEW WORK.
- 22 REMOVE AND RELOCATE EXISTING DDC TEMPERATURE SENSOR. REWORK/ EXTEND CONTROL WIRING TO NEW LOCATION.
- 23 REMOVE EXISTING EXHAUST FAN, DUCTWORK, CONTROLS AND ACCESSORIES COMPLETE. EXISTING ROOF CURB TO REMAIN. CAP WITH CURB CAP. SEE DETAIL SHEET M301.
- 24 REMOVE EXISTING SUPPLY AIR DUCTWORK COMPLETE. CAP DUCT AT MAIN WHERE REQUIRED.
- 25 REMOVE EXISTING HEATING WATER SUPPLY & RETURN LINES COMPLETE. WHERE EXISTING MAIN LINES ARE TO REMAIN, CAP WATERTIGHT AS REQUIRED.
- 26 REMOVE EXISTING CHILLED WATER SUPPLY & RETURN LINES COMPLETE.
- 27 REMOVE EXISTING EXHAUST DUCT TO THIS POINT COMPLETE. PREPARE EXISTING EXHAUST DUCT FOR RECONNECTION AS REQUIRED. SEE M200 SERIES DRAWINGS FOR NEW WORK.
- 28 REMOVE EXISTING PNEUMATIC THERMOSTAT AND AIR TUBING COMPLETE. PREPARE EXISTING OPENING AS REQUIRED FOR NEW SENSOR. SEE M200 SERIES DRAWINGS FOR NEW WORK.
- 29 REMOVE EXISTING EXHAUST DUCT TO THIS POINT COMPLETE AND CAP AIRTIGHT AS REQUIRED.
- 30 REMOVE EXISTING EXHAUST DUCT COMPLETE.
- 31 REMOVE EXISTING DDC TEMPERATURE SENSOR AND CONTROL WIRING COMPLETE.
- 32 REMOVE EXISTING OUTDOOR AIR DUCTWORK COMPLETE.
- 33 REMOVE EXISTING SUPPLY AIR DIFFUSER, FLEXIBLE DUCT COMPLETE. EXISTING RIGID DUCTWORK TO REMAIN. PREPARE EXISTING RIGID DUCT FOR RECONNECTION. SEE M200 SERIES DRAWINGS FOR NEW WORK.
- 34 REMOVE EXISTING DDC TEMPERATURE SENSOR AND CONTROL WIRING COMPLETE. WHERE WALLS ARE TO REMAIN, PROVIDE STAINLESS STEEL BLANK COVER PLATE.
- 35 REMOVE EXISTING RETURN AIR TRANSFER DUCT COMPLETE.
- 36 REMOVE EXISTING EXHAUST GRILLE 12x12" (U.N.O.). PREPARE EXISTING EXHAUST DUCT FOR RECONNECTION. SEE M200 SERIES DRAWINGS FOR NEW WORK.
- 37 REMOVE EXISTING RETURN AIR GRILLE 12x12" (U.N.O.), PREPARE EXISTING RETURN DUCT FOR RECONNECTION. SEE M200 SERIES DRAWINGS FOR NEW WORK.
- 38 REMOVE EXISTING REMOVE EXISTING RETURN AIR GRILLE 24x12" (U.N.O.). EXISTING DUCTWORK TO REMAIN, LEAVING OPENING IN TRANSFER DUCT.
- 39 REMOVE EXISTING OUTDOOR AIR DUCTWORK TO THIS POINT COMPLETE AND CAP AIRTIGHT AS REQUIRED.
- 40 REMOVE EXISTING OUTDOOR AIR HOOD COMPLETE. EXISTING CURB TO REMAIN. CAP WITH CURB CAP. SEE DETAIL SHEET M301.
- 41 REMOVE EXISTING UNIT HEATER, HEATING WATER LINES, VALVES, CONTROLS AND ACCESSORIES COMPLETE. PREPARE EXISTING HEATING WATER LINES FOR RECONNECTION. WHERE UNIT HEATERS ARE NOT BEING REPLACED REMOVE HEATING WATER LINES TO MAINS AND CAP WATERTIGHT AS REQUIRED.

SCCSO  
8831 Keystone Crossing, Indianapolis, IN 46240  
© 2020 CCSO Architects, Inc. All rights reserved

STAIRS  
ASSOCIATES INC.  
MECHANICAL / ELECTRICAL ENGINEERS  
9611 Commerce Drive, Indianapolis, IN 46240

PROJECT:  
WARREN CENTRAL HIGH SCHOOL  
PHASE 3 ADDITION & RENOVATION  
9500 E. 16th STREET, INDIANAPOLIS, IN 46229

SCOPE DRAWINGS:  
These drawings define the scope of the project in terms of architectural design concept, the dimensions of the structure, mechanical and electrical systems. The drawings shall be used to describe all the requirements of the Contract. The drawings shall be used to describe the scope indicated or implied by the trade contractors shall furnish all items required for the proper execution and completion of the work.

REVISIONS:  
2 ADDENDUM #2 03/13/2023

ISSUE DATE: 02/20/23 DRAWN BY: RWT CHECKED BY: WWH

DRAWING TITLE:  
FIRST FLOOR  
MECHANICAL  
DEMOLITION  
PLAN - UNIT F

CERTIFIED BY:  
WARD  
NO. PE6002456  
STATE OF INDIANA  
REGISTERED PROFESSIONAL ENGINEER  
Signature

DRAWING NUMBER  
MD201F

PROJECT NUMBER  
2021056/1407



**SCCSO**  
3831 Keystone Crossing, Indianapolis, IN 46240

© 2020 CCSO Architects, Inc. All rights reserved.

**STAIRS ASSOCIATES INC.**  
Mechanical / Electrical Engineers

PROJECT:  
WARREN CENTRAL HIGH SCHOOL  
PHASE 3 ADDITION & RENOVATION  
9500 E. 16th STREET, INDIANAPOLIS, IN 46229

SCOPE DRAWINGS:  
These drawings show the scope of the project in terms of architectural design concept, the dimensions of the structure, mechanical and electrical systems. The drawings are intended to provide a general description of the requirements of the Contract.

The drawings do not show the scope indicated or implied by the trade contractors shall furnish all items required for the proper execution and completion of the work.

REVISIONS:

2 ADDENDUM #2 03/13/2023

ISSUE DATE: 02/20/23 DRAWN BY: RWT CHECKED BY: WWH

DRAWING TITLE:  
FIRST FLOOR  
MECHANICAL  
DEMOLITION  
PLAN - UNIT H


CERTIFIED BY:  
WARD  
PE6002456  
No.  
STATE OF  
INDIANA  
REGISTERED  
PROFESSIONAL  
ENGINEER

DRAWING NUMBER  
MD201H

PROJECT NUMBER  
2021056/1407

## MECHANICAL DEMOLITION PLAN NOTES

- 1 REMOVE EXISTING SUPPLY AIR SLOT DIFFUSER AND RELATED DUCTWORK COMPLETE.
- 2 REMOVE EXISTING SUPPLY AIR DIFFUSER (U.N.O.), DUCTWORK AND ACCESSORIES COMPLETE. WHERE (E) MAIN DUCT IS TO REMAIN, CAP DUCT AIRTIGHT AS REQUIRED.
- 3 REMOVE EXISTING 24"x 12" (U.N.O.) RETURN AIR GRILLE.
- 4 REMOVE EXISTING SUPPLY AIR DUCTWORK COMPLETE.
- 5 REMOVE EXISTING DDC TEMPERATURE SENSOR AND RELATED CONTROL WIRING COMPLETE. PREPARE EXISTING OPENING FOR NEW SENSOR. SEE M200 SERIES DRAWINGS FOR NEW WORK.
- 6 REMOVE EXISTING PNEUMATIC THERMOSTAT AND AIR TUBING COMPLETE. WHERE EXISTING WALLS ARE TO REMAIN, PROVIDE STAINLESS STEEL BLANK COVER PLATE.
- 7 REMOVE EXISTING UNIT VENTILATOR, HEATING WATER LINES, CHILLED WATER LINES, CONDENSATE DRAIN LINE, CONTROLS AND ACCESSORIES COMPLETE.
- 8 REMOVE EXISTING CABINET UNIT HEATER, HEATING WATER LINES, CONTROLS AND ACCESSORIES COMPLETE.
- 9 REMOVE SECTION OF EXISTING SUPPLY AIR DUCT AS REQUIRED TO INSTALL NEW VAV BOX. SEE M200 SERIES DRAWINGS FOR NEW WORK.
- 10 REMOVE EXISTING EXHAUST GRILLE/ REGISTER AND RELATED EXHAUST DUCT COMPLETE.
- 11 MECHANICAL CONTRACTOR TO SUPPORT EXISTING SUPPLY AIR DIFFUSER AS REQUIRED FOR DEMO OF EXISTING CEILING. SEE M200 SERIES DRAWINGS FOR NEW WORK.
- 12 REMOVE EXISTING SUPPLY AIR DUCT TO THIS POINT COMPLETE. PREPARE EXISTING SUPPLY AIR DUCT FOR RECONNECTION. SEE M200 SERIES DRAWINGS FOR NEW WORK.
- 13 REMOVE EXISTING RETURN AIR DUCT TO THIS POINT COMPLETE. PREPARE EXISTING RETURN AIR DUCT FOR RECONNECTION. SEE M200 SERIES DRAWINGS FOR NEW WORK. IF RETURN AIR IS NOT BEING RECONNECTED CAP AIRTIGHT AS REQUIRED.
- 14 REMOVE EXISTING AIR HANDLING UNIT, SUPPLY, RETURN & OUTSIDE AIR DUCTWORK, HEATING WATER PIPING, CHILLED WATER PIPING, CONDENSATE DRAIN LINE, CONTROLS AND ACCESSORIES COMPLETE. EXISTING CONCRETE PAD TO REMAIN.
- 15 REMOVE EXISTING FAN COIL UNIT, HEATING WATER LINES, CHILLED WATER LINES, CONDENSATE DRAIN LINE CONTROLS AND ACCESSORIES COMPLETE. WHERE FAN COIL UNIT IS BEING REPLACE PREPARE EXISTING SUPPLY FOR RECONNECTION. SEE M200 SERIES DRAWINGS FOR NEW WORK.
- 16 REMOVE EXISTING HEATING WATER SUPPLY AND RETURN LINES TO THIS POINT COMPLETE. PREPARE HEATING LINE FOR RECONNECTION AS REQUIRED. SEE M200 SERIES DRAWINGS FOR NEW WORK.
- 17 REMOVE EXISTING CHILLED WATER SUPPLY AND RETURN LINES TO THIS POINT COMPLETE. PREPARE EXISTING CHILLED WATER LINES FOR RECONNECTION AS REQUIRED. SEE M200 SERIES DRAWINGS FOR NEW WORK.
- 18 REMOVE EXISTING CONVECTOR AND HEATING WATER SUPPLY AND RETURN LINES COMPLETE. PREPARE EXISTING HEATING WATER LINES AS REQUIRED FOR RECONNECTION IF CONVECTOR IS BEING REPLACED. SEE M200 SERIES DRAWINGS FOR WORK.
- 19 REMOVE EXISTING FAN POWERED VAV BOX, HEATING WATER LINES, CONTROLS AND ACCESSORIES COMPLETE. WHERE EXISTING HEATING WATER MAINS ARE TO REMAIN, CAP LINES WATERTIGHT AS REQUIRED.
- 20 REMOVE EXISTING OUTSIDE AIR DUCT TO THIS POINT COMPLETE. PREPARE EXISTING OUTSIDE AIR DUCT FOR RECONNECTION. SEE M200 SERIES DRAWINGS FOR NEW WORK.
- 21 REMOVE EXHAUST FAN, EXISTING DUCTWORK AND CURB TO REMAIN. PREPARE DUCTWORK AND CURB FOR RECONNECTION. SEE M200 SERIES DRAWINGS FOR NEW WORK.
- 22 REMOVE AND RELOCATE EXISTING DDC TEMPERATURE SENSOR. REWORK/ EXTEND CONTROL WIRING TO NEW LOCATION.
- 23 REMOVE EXISTING EXHAUST FAN, DUCTWORK, CONTROLS AND ACCESSORIES COMPLETE. EXISTING ROOF CURB TO REMAIN. CAP WITH CURB CAP. SEE DETAIL SHEET M301.
- 24 REMOVE EXISTING SUPPLY AIR DUCTWORK COMPLETE. CAP DUCT AT MAIN WHERE REQUIRED.
- 25 REMOVE EXISTING HEATING WATER SUPPLY & RETURN LINES COMPLETE. WHERE EXISTING MAIN LINES ARE TO REMAIN, CAP WATERTIGHT AS REQUIRED.
- 26 REMOVE EXISTING CHILLED WATER SUPPLY & RETURN LINES COMPLETE.
- 27 REMOVE EXISTING EXHAUST DUCT TO THIS POINT COMPLETE. PREPARE EXISTING EXHAUST DUCT FOR RECONNECTION AS REQUIRED. SEE M200 SERIES DRAWINGS FOR NEW WORK.
- 28 REMOVE EXISTING PNEUMATIC THERMOSTAT AND AIR TUBING COMPLETE. PREPARE EXISTING OPENING AS REQUIRED FOR NEW SENSOR. SEE M200 SERIES DRAWINGS FOR NEW WORK.
- 29 REMOVE EXISTING EXHAUST DUCT TO THIS POINT COMPLETE AND CAP AIRTIGHT AS REQUIRED.
- 30 REMOVE EXISTING EXHAUST DUCT COMPLETE.
- 31 REMOVE EXISTING DDC TEMPERATURE SENSOR AND CONTROL WIRING COMPLETE.
- 32 REMOVE EXISTING OUTDOOR AIR DUCTWORK COMPLETE.
- 33 REMOVE EXISTING SUPPLY AIR DIFFUSER, FLEXIBLE DUCT COMPLETE. EXISTING RIGID DUCTWORK TO REMAIN. PREPARE EXISTING RIGID DUCT FOR RECONNECTION. SEE M202 SERIES DRAWINGS FOR NEW WORK.
- 34 REMOVE EXISTING DDC TEMPERATURE SENSOR AND CONTROL WIRING COMPLETE. WHERE WALLS ARE TO REMAIN, PROVIDE STAINLESS STEEL BLANK COVER PLATE.
- 35 REMOVE EXISTING RETURN AIR TRANSFER DUCT COMPLETE.
- 36 REMOVE EXISTING EXHAUST GRILLE 12"x 12" (U.N.O.). PREPARE EXISTING EXHAUST DUCT FOR RECONNECTION. SEE M202 SERIES DRAWINGS FOR NEW WORK.
- 37 REMOVE EXISTING RETURN AIR GRILLE 12"x 12" (U.N.O.). PREPARE EXISTING RETURN AIR DUCT FOR RECONNECTION. SEE M202 SERIES DRAWINGS FOR NEW WORK.
- 38 REMOVE EXISTING REMOVE EXISTING RETURN AIR GRILLE 24"x 12" (U.N.O.). EXISTING DUCTWORK TO REMAIN, LEAVING OPENING IN TRANSFER DUCT.
- 39 REMOVE EXISTING OUTDOOR AIR DUCTWORK TO THIS POINT COMPLETE AND CAP AIRTIGHT AS REQUIRED.
- 40 REMOVE EXISTING OUTDOOR AIR HOOD COMPLETE. EXISTING CURB TO REMAIN. CAP WITH CURB CAP. SEE DETAIL SHEET M301.
- 41 REMOVE EXISTING UNIT HEATER, HEATING WATER LINES, VALVES, CONTROLS AND ACCESSORIES COMPLETE. PREPARE EXISTING HEATING WATER LINES FOR RECONNECTION. WHERE UNIT HEATERS ARE NOT BEING REPLACED REMOVE HEATING WATER LINES TO MAINS AND CAP WATERTIGHT AS REQUIRED.

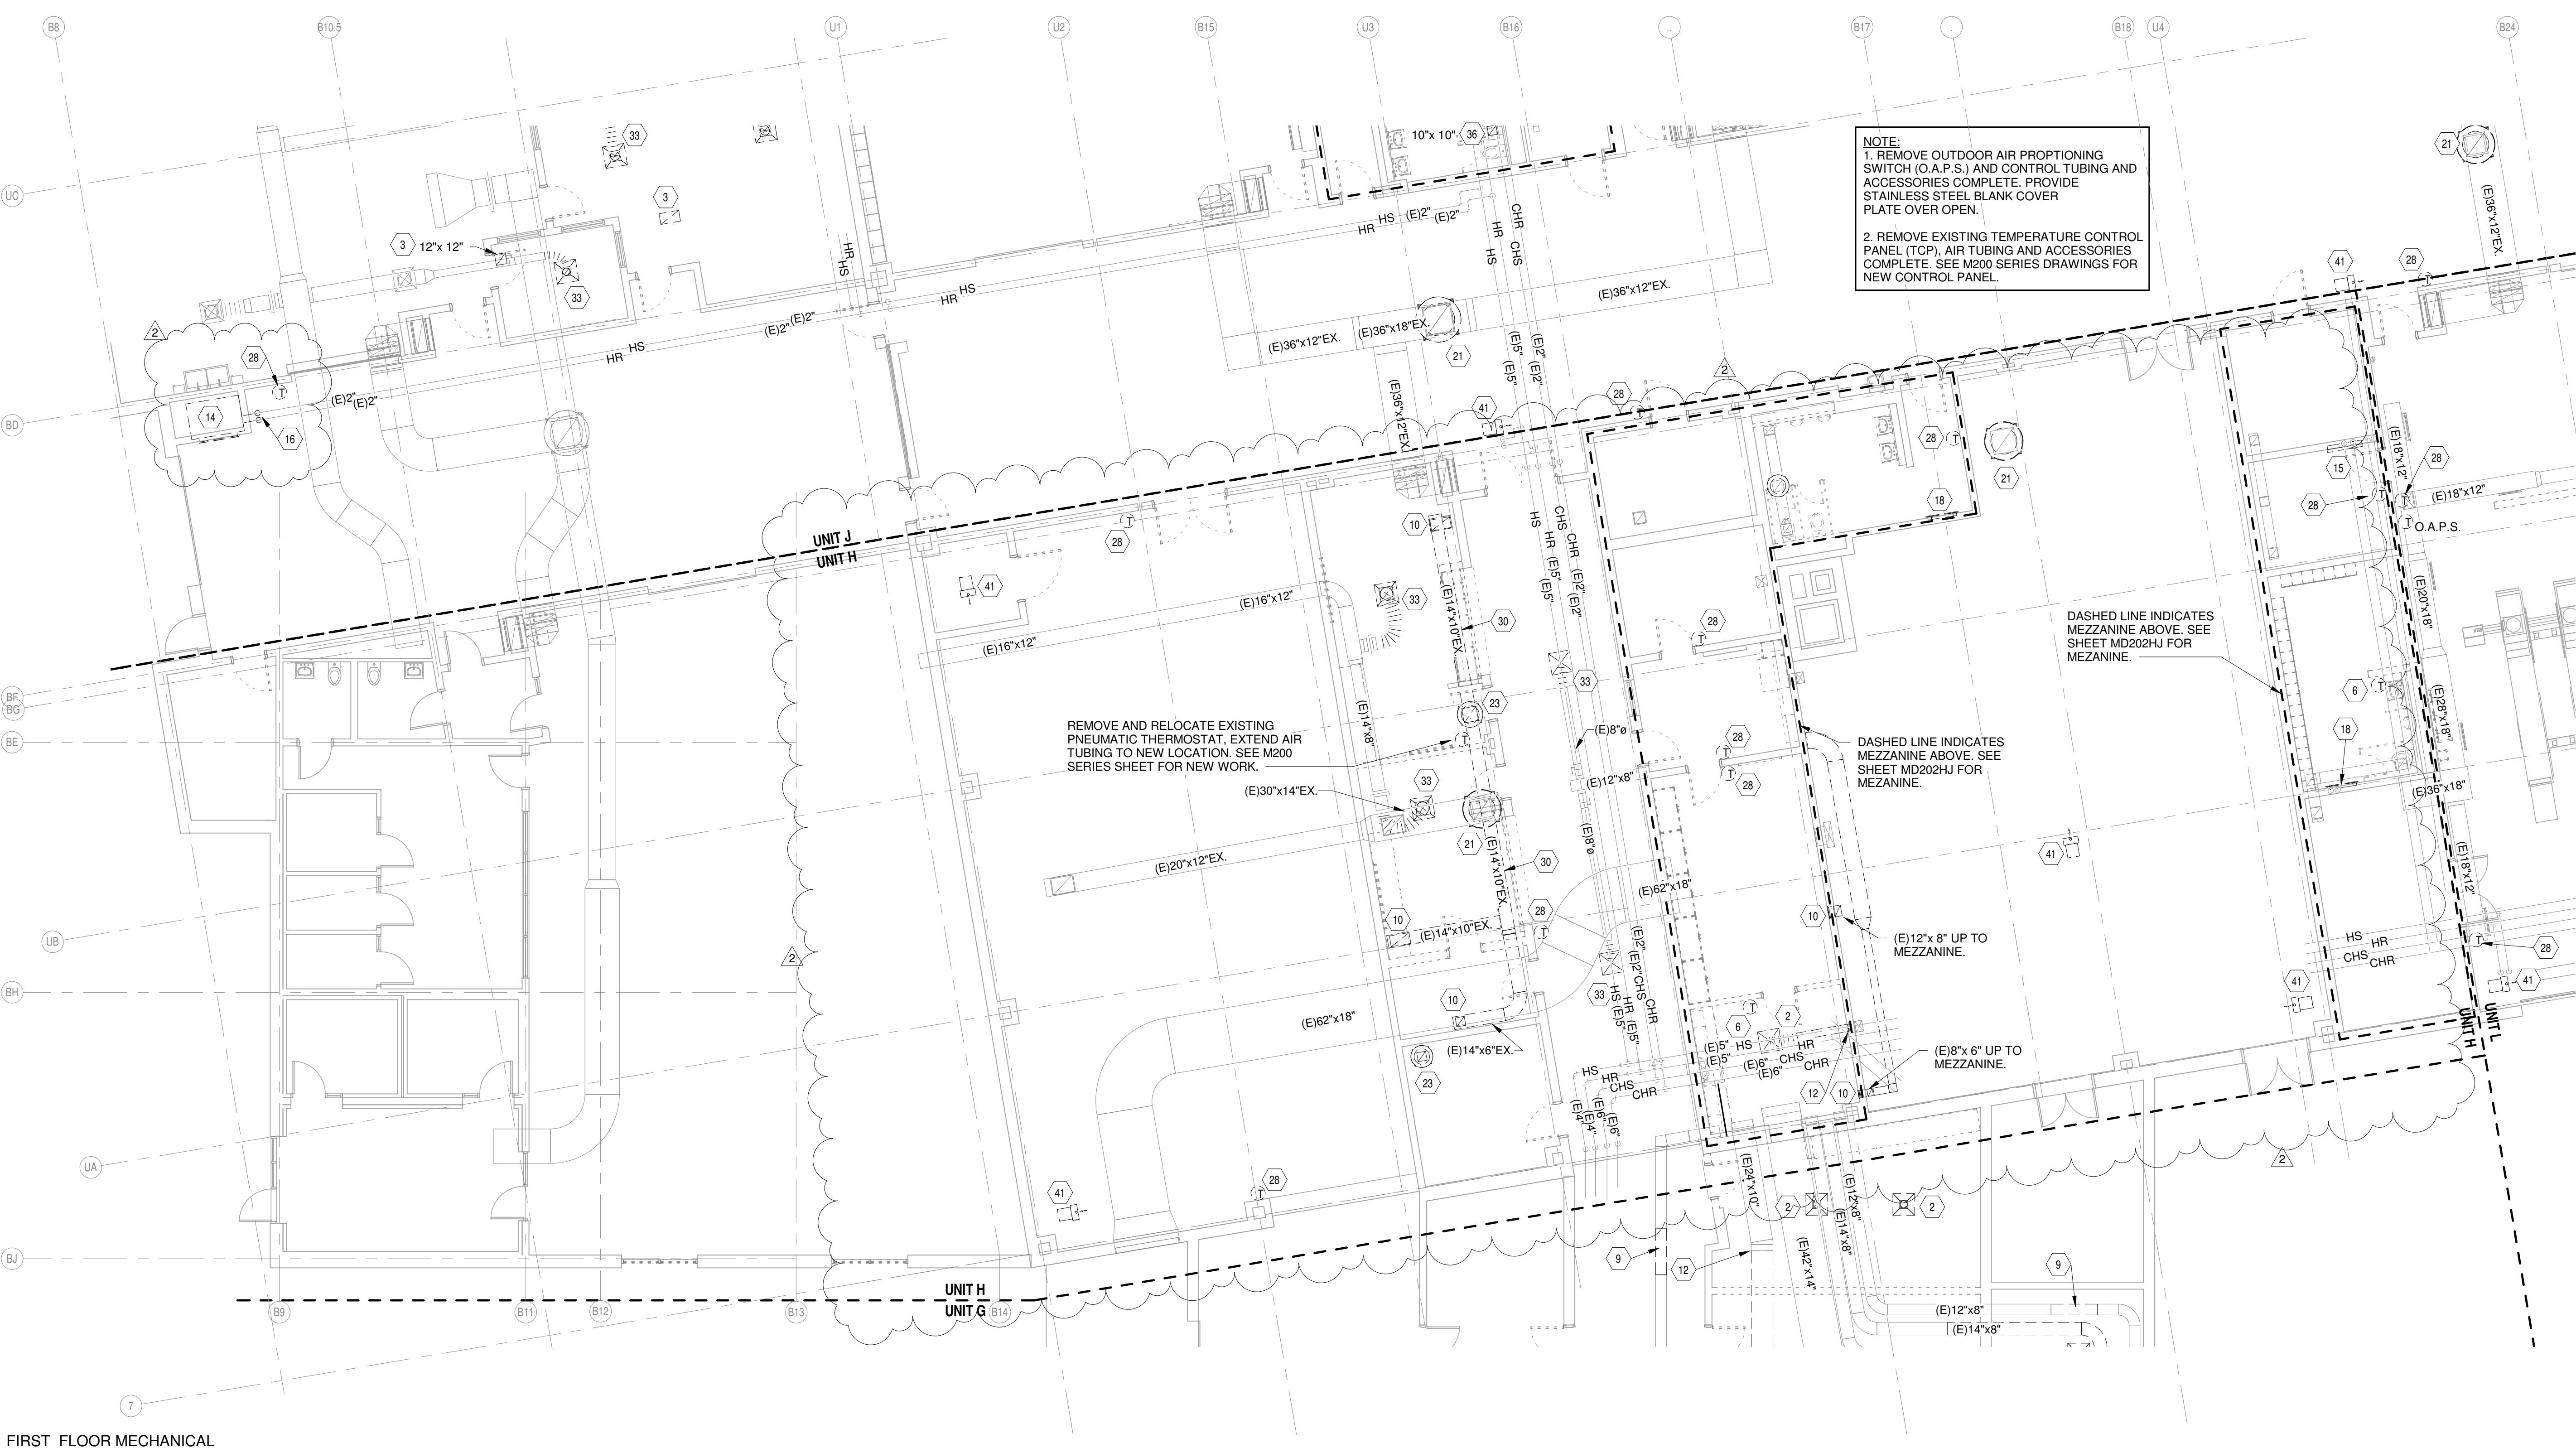

## MECHANICAL DEMOLITION PLAN NOTES

- 1 REMOVE EXISTING SUPPLY AIR SLOT DIFFUSER AND RELATED DUCTWORK COMPLETE.
- 2 REMOVE EXISTING SUPPLY AIR DIFFUSER (U.N.O.), DUCTWORK AND ACCESSORIES COMPLETE. WHERE (E) MAIN DUCT IS TO REMAIN, CAP DUCT AIRTIGHT AS REQUIRED.
- 3 REMOVE EXISTING 24"x 12" (U.N.O.) RETURN AIR GRILLE.
- 4 REMOVE EXISTING SUPPLY AIR DUCTWORK COMPLETE.
- 5 REMOVE EXISTING DDC TEMPERATURE SENSOR AND RELATED CONTROL WIRING COMPLETE. PREPARE EXISTING OPENING FOR NEW SENSOR. SEE M200 SERIES DRAWINGS FOR NEW WORK.
- 6 REMOVE EXISTING PNEUMATIC THERMOSTAT AND AIR TUBING COMPLETE. WHERE EXISTING WALLS ARE TO REMAIN, PROVIDE STAINLESS STEEL BLANK COVER PLATE.
- 7 REMOVE EXISTING UNIT VENTILATOR, HEATING WATER LINES, CHILLED WATER LINES, CONDENSATE DRAIN LINE, CONTROLS AND ACCESSORIES COMPLETE.
- 8 REMOVE EXISTING CABINET UNIT HEATER, HEATING WATER LINES, CONTROLS AND ACCESSORIES COMPLETE.
- 9 REMOVE SECTION OF EXISTING SUPPLY AIR DUCT AS REQUIRED TO INSTALL NEW VAV BOX. SEE M200 SERIES DRAWINGS FOR NEW WORK.
- 10 REMOVE EXISTING EXHAUST GRILLE/ REGISTER AND RELATED EXHAUST DUCT COMPLETE.
- 11 MECHANICAL CONTRACTOR TO SUPPORT EXISTING SUPPLY AIR DIFFUSER AS REQUIRED FOR DEMO OF EXISTING CEILING. SEE M200 SERIES DRAWINGS FOR NEW WORK.
- 12 REMOVE EXISTING SUPPLY AIR DUCT TO THIS POINT COMPLETE. PREPARE EXISTING SUPPLY AIR DUCT FOR RECONNECTION. SEE M200 SERIES DRAWINGS FOR NEW WORK.
- 13 REMOVE EXISTING RETURN AIR DUCT TO THIS POINT COMPLETE. PREPARE EXISTING RETURN AIR DUCT FOR RECONNECTION. SEE M200 SERIES DRAWINGS FOR NEW WORK. IF RETURN AIR IS NOT BEING RECONNECTED CAP AIRTIGHT AS REQUIRED.
- 14 REMOVE EXISTING AIR HANDLING UNIT, SUPPLY, RETURN & OUTSIDE AIR DUCTWORK, HEATING WATER PIPING, CHILLED WATER PIPING, CONDENSATE DRAIN LINE, CONTROLS AND ACCESSORIES COMPLETE. EXISTING CONCRETE PAD TO REMAIN.
- 15 REMOVE EXISTING FAN COIL UNIT, HEATING WATER LINES, CHILLED WATER LINES, CONDENSATE DRAIN LINE CONTROLS AND ACCESSORIES COMPLETE. WHERE FAN COIL UNIT IS BEING REPLACE PREPARE EXISTING SUPPLY FOR RECONNECTION. SEE M200 SERIES DRAWINGS FOR NEW WORK.
- 16 REMOVE EXISTING HEATING WATER SUPPLY AND RETURN LINES TO THIS POINT COMPLETE. PREPARE HEATING LINE FOR RECONNECTION AS REQUIRED. SEE M200 SERIES DRAWINGS FOR NEW WORK.
- 17 REMOVE EXISTING CHILLED WATER SUPPLY AND RETURN LINES TO THIS POINT COMPLETE. PREPARE EXISTING CHILLED WATER LINES FOR RECONNECTION AS REQUIRED. SEE M200 SERIES DRAWINGS FOR NEW WORK.
- 18 REMOVE EXISTING CONVECTOR AND HEATING WATER SUPPLY AND RETURN LINES COMPLETE. PREPARE EXISTING HEATING WATER LINES AS REQUIRED FOR RECONNECTION IF CONVECTOR IS BEING REPLACED. SEE M200 SERIES DRAWINGS FOR WORK.
- 19 REMOVE EXISTING FAN POWERED VAV BOX, HEATING WATER LINES, CONTROLS AND ACCESSORIES COMPLETE. WHERE EXISTING HEATING WATER MAINS ARE TO REMAIN, CAP LINES WATERTIGHT AS REQUIRED.
- 20 REMOVE EXISTING OUTSIDE AIR DUCT TO THIS POINT COMPLETE. PREPARE EXISTING OUTSIDE AIR DUCT FOR RECONNECTION. SEE M200 SERIES DRAWINGS FOR NEW WORK.
- 21 REMOVE EXHAUST FAN, EXISTING DUCTWORK AND CURB TO REMAIN. PREPARE DUCTWORK AND CURB FOR RECONNECTION. SEE M200 SERIES DRAWINGS FOR NEW WORK.
- 22 REMOVE AND RELOCATE EXISTING DDC TEMPERATURE SENSOR. REWORK/ EXTEND CONTROL WIRING TO NEW LOCATION.
- 23 REMOVE EXISTING EXHAUST FAN, DUCTWORK, CONTROLS AND ACCESSORIES COMPLETE. EXISTING ROOF CURB TO REMAIN. CAP WITH CURB CAP. SEE DETAIL SHEET M301.
- 24 REMOVE EXISTING SUPPLY AIR DUCTWORK COMPLETE. CAP DUCT AT MAIN WHERE REQUIRED.
- 25 REMOVE EXISTING HEATING WATER SUPPLY & RETURN LINES COMPLETE. WHERE EXISTING MAIN LINES ARE TO REMAIN, CAP WATERTIGHT AS REQUIRED.
- 26 REMOVE EXISTING CHILLED WATER SUPPLY & RETURN LINES COMPLETE.
- 27 REMOVE EXISTING EXHAUST DUCT TO THIS POINT COMPLETE. PREPARE EXISTING EXHAUST DUCT FOR RECONNECTION AS REQUIRED. SEE M200 SERIES DRAWINGS FOR NEW WORK.
- 28 REMOVE EXISTING PNEUMATIC THERMOSTAT AND AIR TUBING COMPLETE. PREPARE EXISTING OPENING AS REQUIRED FOR NEW SENSOR. SEE M200 SERIES DRAWINGS FOR NEW WORK.
- 29 REMOVE EXISTING EXHAUST DUCT TO THIS POINT COMPLETE AND CAP AIRTIGHT AS REQUIRED.
- 30 REMOVE EXISTING EXHAUST DUCT COMPLETE.
- 31 REMOVE EXISTING DDC TEMPERATURE SENSOR AND CONTROL WIRING COMPLETE.
- 32 REMOVE EXISTING OUTDOOR AIR DUCTWORK COMPLETE.
- 33 REMOVE EXISTING SUPPLY AIR DIFFUSER, FLEXIBLE DUCT COMPLETE. EXISTING RIGID DUCTWORK TO REMAIN. PREPARE EXISTING RIGID DUCT FOR RECONNECTION. SEE M200 SERIES DRAWINGS FOR NEW WORK.
- 34 REMOVE EXISTING DDC TEMPERATURE SENSOR AND CONTROL WIRING COMPLETE. WHERE WALLS ARE TO REMAIN, PROVIDE STAINLESS STEEL BLANK COVER PLATE.
- 35 REMOVE EXISTING RETURN AIR TRANSFER DUCT COMPLETE.
- 36 REMOVE EXISTING EXHAUST GRILLE 12"x 12" (U.N.O.). PREPARE EXISTING EXHAUST DUCT FOR RECONNECTION. SEE M200 SERIES DRAWINGS FOR NEW WORK.
- 37 REMOVE EXISTING RETURN AIR GRILLE 12"x 12" (U.N.O.). PREPARE EXISTING RETURN DUCT FOR RECONNECTION. SEE M200 SERIES DRAWINGS FOR NEW WORK.
- 38 REMOVE EXISTING REMOVE EXISTING RETURN AIR GRILLE 24"x 12" (U.N.O.). EXISTING DUCTWORK TO REMAIN, LEAVING OPENING IN TRANSFER DUCT.
- 39 REMOVE EXISTING OUTDOOR AIR DUCTWORK TO THIS POINT COMPLETE AND CAP AIRTIGHT AS REQUIRED.
- 40 REMOVE EXISTING OUTDOOR AIR HOOD COMPLETE. EXISTING CURB TO REMAIN. CAP WITH CURB CAP. SEE DETAIL SHEET M301.
- 41 REMOVE EXISTING UNIT HEATER, HEATING WATER LINES, VALVES, CONTROLS AND ACCESSORIES COMPLETE. PREPARE EXISTING HEATING WATER LINES FOR RECONNECTION. WHERE UNIT HEATERS ARE NOT BEING REPLACED REMOVE HEATING WATER LINES TO MAINS AND CAP WATERTIGHT AS REQUIRED.



SCCSO  
8831 Keystone Crossing, Indianapolis, IN 46240

©2020 CCSO Architects, Inc. All Rights Reserved

STAIRS  
ASSOCIATES INC.  
MECHANICAL / ELECTRICAL ENGINEERS

PROJECT:  
WARREN CENTRAL HIGH SCHOOL  
PHASE 3 ADDITION & RENOVATION  
9500 E. 6th STREET, INDIANAPOLIS, IN 46229

SCOPE DRAWINGS:  
These drawings describe the scope of the project in terms of architectural design concept, the structural, mechanical and electrical systems. The drawings and specifications shall describe all the work required to be performed in accordance with the requirements of the Contract.  
The drawings and specifications shall describe the scope indicated or implied by the trade contractors shall furnish all items required for the proper execution and completion of the work.

REVISIONS:  
2 ADDENDUM #2 03/13/2023

ISSUE DATE DRAWN BY CHECKED BY  
02/20/23 RWT WWH

DRAWING TITLE:  
FIRST FLOOR  
MECHANICAL  
DEMOLITION  
PLAN - UNIT J

CERTIFIED BY:  
WARD  
NO. PE6002456  
STATE OF INDIANA  
REGISTERED PROFESSIONAL ENGINEER

DRAWING NUMBER  
MD201J

PROJECT NUMBER  
2021056/1407





SCCSO  
SCCSO

8831 Keystone Crossing, Indianapolis, IN 46240  
317.448.7800 | [scso.net](http://scso.net)

STAIR   
ASSOCIATES INC.  
MECHANICAL / ELECTRICAL ENGINEERS

PROJECT:  
WARREN CENTRAL HIGH SCHOOL  
PHASE 3 ADDITION & RENOVATION  
9500 E. 16th STREET, INDIANAPOLIS, IN 46229

## MECHANICAL DEMOLITION PLAN NOTES

- 1 REMOVE EXISTING SUPPLY AIR SLOT DIFFUSER AND RELATED DUCTWORK COMPLETE.
- 2 REMOVE EXISTING SUPPLY AIR DIFFUSER (U.N.O.), DUCTWORK AND ACCESSORIES COMPLETE. WHERE (E) MAIN DUCT IS TO REMAIN, CAP DUCT AIRTIGHT AS REQUIRED.
- 3 REMOVE EXISTING 24" x 12" (U.N.O.) RETURN AIR GRILLE.
- 4 REMOVE EXISTING SUPPLY AIR DUCTWORK COMPLETE.
- 5 REMOVE EXISTING DDC TEMPERATURE SENSOR AND RELATED CONTROL WIRING COMPLETE. PREPARE EXISTING OPENING FOR NEW SENSOR. SEE M200 SERIES DRAWINGS FOR NEW WORK.
- 6 REMOVE EXISTING PNEUMATIC THERMOSTAT AND AIR TUBING COMPLETE. WHERE EXISTING WALLS ARE TO REMAIN, PROVIDE STAINLESS STEEL BLANK COVER PLATE.
- 7 REMOVE EXISTING UNIT VENTILATOR, HEATING WATER LINES, CHILLED WATER LINES, CONDENSATE DRAIN LINE, CONTROLS AND ACCESSORIES COMPLETE.
- 8 REMOVE EXISTING CABINET UNIT HEATER, HEATING WATER LINES, CONTROLS AND ACCESSORIES COMPLETE.
- 9 REMOVE SECTION OF EXISTING SUPPLY AIR DUCT AS REQUIRED TO INSTALL NEW VAV BOX. SEE M200 SERIES DRAWINGS FOR NEW WORK.
- 10 REMOVE EXISTING EXHAUST GRILLE/ REGISTER AND RELATED EXHAUST DUCT COMPLETE.
- 11 MECHANICAL CONTRACTOR TO SUPPORT EXISTING SUPPLY AIR DIFFUSER AS REQUIRED FOR DEMO OF EXISTING CEILING. SEE M200 SERIES DRAWINGS FOR NEW WORK.
- 12 REMOVE EXISTING SUPPLY AIR DUCT TO THIS POINT COMPLETE. PREPARE EXISTING SUPPLY AIR DUCT FOR RECONNECTION. SEE M200 SERIES DRAWINGS FOR NEW WORK.
- 13 REMOVE EXISTING RETURN AIR DUCT TO THIS POINT COMPLETE. PREPARE EXISTING RETURN AIR DUCT FOR RECONNECTION. SEE M200 SERIES DRAWINGS FOR NEW WORK. IF RETURN AIR IS NOT BEING RECONNECTED CAP AIRTIGHT AS REQUIRED.
- 14 REMOVE EXISTING AIR HANDLING UNIT, SUPPLY, RETURN & OUTSIDE AIR DUCTWORK, HEATING WATER PIPING, CHILLED WATER PIPING, CONDENSATE DRAIN LINE, CONTROLS AND ACCESSORIES COMPLETE. EXISTING CONCRETE PAD TO REMAIN.
- 15 REMOVE EXISTING FAN COIL UNIT, HEATING WATER LINES, CHILLED WATER LINES, CONDENSATE DRAIN LINE CONTROLS AND ACCESSORIES COMPLETE. WHERE FAN COIL UNIT IS BEING REPLACE PREPARE EXISTING SUPPLY FOR RECONNECTION. SEE M200 SERIES DRAWINGS FOR NEW WORK.
- 16 REMOVE EXISTING HEATING WATER SUPPLY AND RETURN LINES TO THIS POINT COMPLETE. PREPARE HEATING LINE FOR RECONNECTION AS REQUIRED. SEE M200 SERIES DRAWINGS FOR NEW WORK.
- 17 REMOVE EXISTING CHILLED WATER SUPPLY AND RETURN LINES TO THIS POINT COMPLETE. PREPARE EXISTING CHILLED WATER LINES FOR RECONNECTION AS REQUIRED. SEE M200 SERIES DRAWINGS FOR NEW WORK.
- 18 REMOVE EXISTING CONVECTOR AND HEATING WATER SUPPLY AND RETURN LINES COMPLETE. PREPARE EXISTING HEATING WATER LINES AS REQUIRED FOR RECONNECTION IF CONVECTOR IS BEING REPLACED. SEE M200 SERIES DRAWINGS FOR WORK.
- 19 REMOVE EXISTING FAN POWERED VAV BOX, HEATING WATER LINES, CONTROLS AND ACCESSORIES COMPLETE. WHERE EXISTING HEATING WATER MAINS ARE TO REMAIN, CAP LINES WATERTIGHT AS REQUIRED.
- 20 REMOVE EXISTING OUTSIDE AIR DUCT TO THIS POINT COMPLETE. PREPARE EXISTING OUTSIDE AIR DUCT FOR RECONNECTION. SEE M200 SERIES DRAWINGS FOR NEW WORK.
- 21 REMOVE EXHAUST FAN, EXISTING DUCTWORK AND CURB TO REMAIN. PREPARE DUCTWORK AND CURB FOR RECONNECTION. SEE M200 SERIES DRAWINGS FOR NEW WORK.
- 22 REMOVE AND RELOCATE EXISTING DDC TEMPERATURE SENSOR. REWORK/ EXTEND CONTROL WIRING TO NEW LOCATION.
- 23 REMOVE EXISTING EXHAUST FAN, DUCTWORK, CONTROLS AND ACCESSORIES COMPLETE. EXISTING ROOF CURB TO REMAIN. CAP WITH CURB CAP. SEE DETAIL SHEET M301.
- 24 REMOVE EXISTING SUPPLY AIR DUCTWORK COMPLETE. CAP DUCT AT MAIN WHERE REQUIRED.
- 25 REMOVE EXISTING HEATING WATER SUPPLY & RETURN LINES COMPLETE. WHERE EXISTING MAIN LINES ARE TO REMAIN, CAP WATERTIGHT AS REQUIRED.
- 26 REMOVE EXISTING CHILLED WATER SUPPLY & RETURN LINES COMPLETE.
- 27 REMOVE EXISTING EXHAUST DUCT TO THIS POINT COMPLETE. PREPARE EXISTING EXHAUST DUCT FOR RECONNECTION AS REQUIRED. SEE M200 SERIES DRAWINGS FOR NEW WORK.
- 28 REMOVE EXISTING PNEUMATIC THERMOSTAT AND AIR TUBING COMPLETE. PREPARE EXISTING OPENING AS REQUIRED FOR NEW SENSOR. SEE M200 SERIES DRAWINGS FOR NEW WORK.
- 29 REMOVE EXISTING EXHAUST DUCT TO THIS POINT COMPLETE AND CAP AIRTIGHT AS REQUIRED.
- 30 REMOVE EXISTING EXHAUST DUCT COMPLETE.
- 31 REMOVE EXISTING DDC TEMPERATURE SENSOR AND CONTROL WIRING COMPLETE.
- 32 REMOVE EXISTING OUTDOOR AIR DUCTWORK COMPLETE.
- 33 REMOVE EXISTING SUPPLY AIR DIFFUSER, FLEXIBLE DUCT COMPLETE. EXISTING RIGID DUCTWORK TO REMAIN. PREPARE EXISTING RIGID DUCT FOR RECONNECTION. SEE M200 SERIES DRAWINGS FOR NEW WORK.
- 34 REMOVE EXISTING DDC TEMPERATURE SENSOR AND CONTROL WIRING COMPLETE. WHERE WALLS ARE TO REMAIN, PROVIDE STAINLESS STEEL BLANK COVER PLATE.
- 35 REMOVE EXISTING RETURN AIR TRANSFER DUCT COMPLETE.
- 36 REMOVE EXISTING EXHAUST GRILLE 12" x 12" (U.N.O.). PREPARE EXISTING EXHAUST DUCT FOR RECONNECTION. SEE M200 SERIES DRAWINGS FOR NEW WORK.
- 37 REMOVE EXISTING RETURN AIR GRILLE 12" x 12" (U.N.O.). PREPARE EXISTING RETURN AIR DUCT FOR RECONNECTION. SEE M200 SERIES DRAWINGS FOR NEW WORK.
- 38 REMOVE EXISTING EXHAUST DUCT TO THIS POINT COMPLETE. PREPARE EXISTING EXHAUST DUCT FOR RECONNECTION AS REQUIRED. SEE M200 SERIES DRAWINGS FOR NEW WORK.
- 39 REMOVE EXISTING OUTDOOR AIR DUCTWORK TO THIS POINT COMPLETE AND CAP AIRTIGHT AS REQUIRED.
- 40 REMOVE EXISTING OUTDOOR AIR HOOD COMPLETE. EXISTING CURB TO REMAIN. CAP WITH CURB CAP. SEE DETAIL SHEET M301.
- 41 REMOVE EXISTING UNIT HEATER, HEATING WATER LINES, VALVES, CONTROLS AND ACCESSORIES COMPLETE. PREPARE EXISTING HEATING WATER LINES FOR RECONNECTION. WHERE UNIT HEATERS ARE NOT BEING REPLACED REMOVE HEATING WATER LINES TO MAINS AND CAP WATERTIGHT AS REQUIRED.



SCOPE DRAWINGS:  
These drawings define the scope of the project in terms of architectural design concept, the dimensions of the structure, mechanical and electrical systems. The drawings shall be used to describe all the requirements of the Contract.  
The drawings shall be used to determine the scope indicated or implied. The trade contractors shall furnish all items required for the proper execution and completion of the work.

REVISIONS:  
2 ADDENDUM #2 03/13/2023

ISSUE DATE: 02/20/23 DRAWN BY: RWT CHECKED BY: WWH

DRAWING TITLE:  
FIRST FLOOR  
MECHANICAL  
DEMOLITION  
PLAN - UNIT K

CERTIFIED BY:  
WARD  
NO. PE60021458  
STATE OF INDIANA  
REGISTERED PROFESSIONAL ENGINEER

DRAWING NUMBER  
MD201K

PROJECT NUMBER  
2021056/1407





SCCSO  
SCCSO

8831 Keystone Crossing, Indianapolis, IN 46240  
317.448.7800 | cscso.com

STAIRS ASSOCIATES INC.  
MECHANICAL / ELECTRICAL ENGINEERS

PROJECT: WARREN CENTRAL HIGH SCHOOL  
PHASE 3 ADDITION & RENOVATION  
9500 E. 16th STREET, INDIANAPOLIS, IN 46229

SCOPE DRAWINGS:  
These drawings provide a detailed description of the project in terms of architectural design concept, the dimensions of the structures, mechanical and electrical systems, and the required work. They are intended to describe all the work required to be performed and to establish the requirements of the Contract.

The contractor shall furnish all items required for the proper execution and completion of the work.

REVISIONS:

2 ADDENDUM #2	03/13/2023
---------------	------------

ISSUE DATE: 02/20/23

DRAWN BY: RWT

CHECKED BY: WWH


CERTIFIED BY:  
WARD  
REG. PROFESSIONAL ENGINEER  
No. PE6002456  
STATE OF INDIANA  
DRAFTING AND DESIGN  
PROFESSIONAL ENGINEER

DRAWING NUMBER  
MD202HJ

PROJECT NUMBER  
2021056/1407

## MECHANICAL DEMOLITION PLAN NOTES

- 1 REMOVE EXISTING SUPPLY AIR SLOT DIFFUSER AND RELATED DUCTWORK COMPLETE.
- 2 REMOVE EXISTING SUPPLY AIR DIFFUSER (U.N.O.), DUCTWORK AND ACCESSORIES COMPLETE. WHERE (E)MAIN DUCT IS TO REMAIN, CAP DUCT AIRTIGHT AS REQUIRED.
- 3 REMOVE EXISTING 24"x 12" (U.N.O.) RETURN AIR GRILLE.
- 4 REMOVE EXISTING DDC TEMPERATURE SENSOR AND RELATED CONTROL WIRING COMPLETE. PREPARE EXISTING OPENING FOR NEW SENSOR. SEE M200 SERIES DRAWINGS FOR NEW WORK.
- 5 REMOVE EXISTING PNEUMATIC THERMOSTAT AND AIR TUBING COMPLETE. WHERE EXISTING WALLS ARE TO REMAIN, PROVIDE STAINLESS STEEL BLANK COVER PLATE.
- 6 REMOVE EXISTING UNIT VENTILATOR, HEATING WATER LINES, CHILLED WATER LINES, CONDENSATE DRAIN LINE, CONTROLS AND ACCESSORIES COMPLETE.
- 7 REMOVE EXISTING CABINET UNIT HEATER, HEATING WATER LINES, CONTROLS AND ACCESSORIES COMPLETE.
- 8 REMOVE SECTION OF EXISTING AIR DUCT AS REQUIRED TO INSTALL NEW VAV BOX. SEE M200 SERIES DRAWINGS FOR NEW WORK.
- 10 REMOVE EXISTING EXHAUST GRILLE/ REGISTER AND RELATED EXHAUST DUCT COMPLETE.
- 11 MECHANICAL CONTRACTOR TO SUPPORT EXISTING SUPPLY AIR DIFFUSER AS REQUIRED FOR DEMO OF EXISTING CEILING. SEE M200 SERIES DRAWINGS FOR NEW WORK.
- 12 REMOVE EXISTING SUPPLY AIR DUCT TO THIS POINT COMPLETE. PREPARE EXISTING SUPPLY AIR DUCT FOR RECONNECTION. SEE M200 SERIES DRAWINGS FOR NEW WORK.
- 13 REMOVE EXISTING RETURN AIR DUCT TO THIS POINT COMPLETE. PREPARE EXISTING RETURN AIR DUCT FOR RECONNECTION. SEE M200 SERIES DRAWINGS FOR NEW WORK. IF RETURN AIR IS NOT BEING RECONNECTED CAP AIRTIGHT AS REQUIRED.
- 14 REMOVE EXISTING AIR HANDLING UNIT, SUPPLY, RETURN & OUTSIDE AIR DUCTWORK, HEATING WATER PIPING, CHILLED WATER PIPING, CONDENSATE DRAIN LINE, CONTROLS AND ACCESSORIES COMPLETE. EXISTING CONCRETE PAD TO REMAIN.
- 15 REMOVE EXISTING FAN COIL UNIT, HEATING WATER LINES, CHILLED WATER LINES, CONDENSATE DRAIN LINE, CONTROLS AND ACCESSORIES COMPLETE. WHERE FAN COIL UNIT IS BEING REPLACE PREPARE EXISTING SUPPLY FOR RECONNECTION. SEE M200 SERIES DRAWINGS FOR NEW WORK.
- 16 REMOVE EXISTING HEATING WATER SUPPLY AND RETURN LINES TO THIS POINT COMPLETE. PREPARE HEATING LINE FOR RECONNECTION AS REQUIRED. SEE M200 SERIES DRAWINGS FOR NEW WORK.
- 17 REMOVE EXISTING CHILLED WATER SUPPLY AND RETURN LINES TO THIS POINT COMPLETE. PREPARE EXISTING CHILLED WATER LINES FOR RECONNECTION AS REQUIRED. SEE M200 SERIES DRAWINGS FOR NEW WORK.
- 18 REMOVE EXISTING CONVECTOR AND HEATING WATER SUPPLY AND RETURN LINES COMPLETE. PREPARE EXISTING HEATING WATER LINES AS REQUIRED FOR RECONNECTION IF CONVECTOR IS BEING REPLACED. SEE M200 SERIES DRAWINGS FOR WORK.
- 19 REMOVE EXISTING FAN POWERED VAV BOX, HEATING WATER LINES, CONTROLS AND ACCESSORIES COMPLETE. WHERE EXISTING HEATING WATER MAINS ARE TO REMAIN, CAP LINES WATERTIGHT AS REQUIRED.
- 20 REMOVE EXISTING OUTSIDE AIR DUCT TO THIS POINT COMPLETE. PREPARE EXISTING OUTSIDE AIR DUCT FOR RECONNECTION. SEE M200 SERIES DRAWINGS FOR NEW WORK.
- 21 REMOVE EXHAUST FAN, EXISTING DUCTWORK AND CURB TO REMAIN. PREPARE DUCTWORK AND CURB FOR RECONNECTION. SEE M200 SERIES DRAWINGS FOR NEW WORK.
- 22 REMOVE AND RELOCATE EXISTING DDC TEMPERATURE SENSOR. REWORK EXTEND CONTROL WIRING TO NEW LOCATION.
- 23 REMOVE EXISTING EXHAUST FAN, DUCTWORK, CONTROLS AND ACCESSORIES COMPLETE. EXISTING ROOF CURB TO REMAIN. CAP WITH CURB CAP. SEE DETAIL SHEET M301.
- 24 REMOVE EXISTING SUPPLY AIR DUCTWORK COMPLETE. CAP DUCT AT MAIN WHERE REQUIRED.
- 25 REMOVE EXISTING HEATING WATER SUPPLY & RETURN LINES COMPLETE. WHERE EXISTING MAIN LINES ARE TO REMAIN, CAP WATERTIGHT AS REQUIRED.
- 26 REMOVE EXISTING CHILLED WATER SUPPLY & RETURN LINES COMPLETE.
- 27 REMOVE EXISTING EXHAUST DUCT TO THIS POINT COMPLETE. PREPARE EXISTING EXHAUST DUCT FOR RECONNECTION AS REQUIRED. SEE M200 SERIES DRAWINGS FOR NEW WORK.
- 28 REMOVE EXISTING PNEUMATIC THERMOSTAT AND AIR TUBING COMPLETE. PREPARE EXISTING OPENING AS REQUIRED FOR NEW SENSOR. SEE M200 SERIES DRAWINGS FOR NEW WORK.
- 29 REMOVE EXISTING EXHAUST DUCT TO THIS POINT COMPLETE AND CAP AIRTIGHT AS REQUIRED.
- 30 REMOVE EXISTING EXHAUST DUCT COMPLETE.
- 31 REMOVE EXISTING DDC TEMPERATURE SENSOR AND CONTROL WIRING COMPLETE.
- 32 REMOVE EXISTING OUTDOOR AIR DUCTWORK COMPLETE.
- 33 REMOVE EXISTING SUPPLY AIR DIFFUSER. FLEXIBLE DUCT COMPLETE. EXISTING RIGID DUCTWORK TO REMAIN. PREPARE EXISTING RIGID DUCT FOR RECONNECTION. SEE M202 SERIES DRAWINGS FOR NEW WORK.
- 34 REMOVE EXISTING DDC TEMPERATURE SENSOR AND CONTROL WIRING COMPLETE. WHERE WALLS ARE TO REMAIN, PROVIDE STAINLESS STEEL BLANK COVER PLATE.
- 35 REMOVE EXISTING RETURN AIR TRANSFER DUCT COMPLETE.
- 36 REMOVE EXHAUST GRILLE 12"x 12" (U.N.O.), PREPARE EXISTING EXHAUST DUCT FOR RECONNECTION. SEE M202 SERIES DRAWINGS FOR NEW WORK.
- 37 REMOVE EXISTING RETURN AIR GRILLE 12"x 12" (U.N.O.), PREPARE EXISTING RETURN DUCT FOR RECONNECTION. SEE M202 SERIES DRAWINGS FOR NEW WORK.
- 38 REMOVE EXISTING REMOVE EXISTING RETURN AIR GRILLE 24"x 12" (U.N.O.). EXISTING DUCTWORK TO REMAIN. LEAVING OPENING IN TRANSFER DUCT.
- 39 REMOVE EXISTING OUTDOOR AIR DUCTWORK TO THIS POINT COMPLETE AND CAP AIRTIGHT AS REQUIRED.
- 40 REMOVE EXISTING OUTDOOR AIR HOOD COMPLETE. EXISTING CURB TO REMAIN, CAP WITH CURB CAP. SEE DETAIL SHEET M301.
- 41 REMOVE EXISTING UNIT HEATER, HEATING WATER LINES, VALVES, CONTROLS AND ACCESSORIES COMPLETE. PREPARE EXISTING HEATING WATER LINES FOR RECONNECTION. WHERE UNIT HEATERS ARE NOT BEING REPLACED REMOVE HEATING WATER LINES TO MAINS AND CAP WATERTIGHT AS REQUIRED.

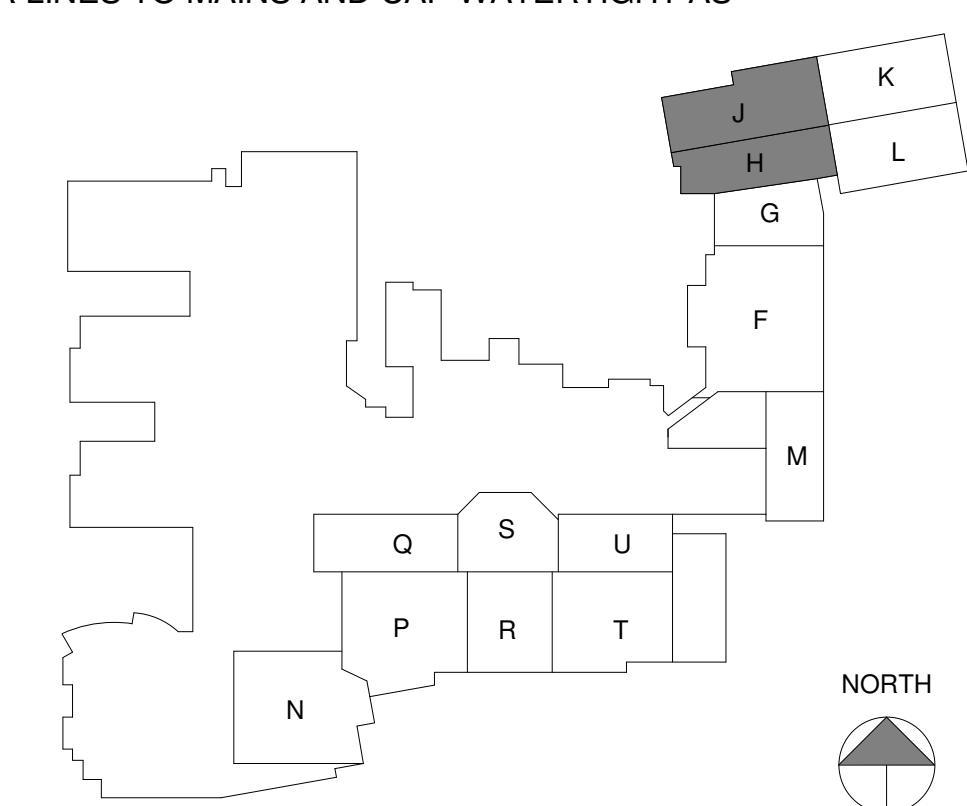

PROJECT NUMBER  
2021056/1407



SCCSO  
S C S O

8831 Keystone Crossing, Indianapolis, IN 46240  
© 2020 CCSO Architects, Inc. All rights reserved

STAIRS ASSOCIATES INC.  
MECHANICAL / ELECTRICAL ENGINEERS

PROJECT:  
WARREN CENTRAL HIGH SCHOOL  
PHASE 3 ADDITION & RENOVATION  
9500 E. 6th STREET, INDIANAPOLIS, IN 46229

SCOPE DRAWINGS:  
These drawings show the scope of the project in terms of architectural design concept, the dimensions of the structure, mechanical and electrical systems. They are intended to provide a clear description of the requirements of the Contract.  
The drawings and the scope indicated or implied by the trade contractors shall furnish all items required for the proper execution and completion of the work.

REVISIONS:  
2 ADDENDUM #2 03/13/2023

ISSUE DATE: 02/20/23 DRAWN BY: RWT CHECKED BY: WWH

DRAWING TITLE:  
SECOND FLOOR  
MECHANICAL  
DEMOLITION  
PLAN - UNIT N



CERTIFIED BY:  
WARD  
REG. PROFESSIONAL ENGINEER  
No. PE60021456  
STATE OF INDIANA  
DODGE & WARD  
PROFESSIONAL ENGINEERS

DRAWING NUMBER  
MD202N


PROJECT NUMBER  
2021056/1407

## MECHANICAL DEMOLITION PLAN NOTES

- 1 REMOVE EXISTING SUPPLY AIR SLOT DIFFUSER AND RELATED DUCTWORK COMPLETE.
- 2 REMOVE EXISTING SUPPLY AIR DIFFUSER (U.N.O.), DUCTWORK AND ACCESSORIES COMPLETE. WHERE (E) MAIN DUCT IS TO REMAIN, CAP DUCT AIRTIGHT AS REQUIRED.
- 3 REMOVE EXISTING 24"x 12" (U.N.O.) RETURN AIR GRILLE.
- 4 REMOVE EXISTING SUPPLY AIR DUCTWORK COMPLETE.
- 5 REMOVE EXISTING DDC TEMPERATURE SENSOR AND RELATED CONTROL WIRING COMPLETE. PREPARE EXISTING OPENING FOR NEW SENSOR. SEE M200 SERIES DRAWINGS FOR NEW WORK.
- 6 REMOVE EXISTING PNEUMATIC THERMOSTAT AND AIR TUBING COMPLETE. WHERE EXISTING WALLS ARE TO REMAIN, PROVIDE STAINLESS STEEL BLANK COVER PLATE.
- 7 REMOVE EXISTING UNIT VENTILATOR, HEATING WATER LINES, CHILLED WATER LINES, CONDENSATE DRAIN LINE, CONTROLS AND ACCESSORIES COMPLETE.
- 8 REMOVE EXISTING CABINET UNIT HEATER, HEATING WATER LINES, CONTROLS AND ACCESSORIES COMPLETE.
- 9 REMOVE SECTION OF EXISTING SUPPLY AIR DUCT AS REQUIRED TO INSTALL NEW VAV BOX. SEE M200 SERIES DRAWINGS FOR NEW WORK.
- 10 REMOVE EXISTING EXHAUST GRILLE/ REGISTER AND RELATED EXHAUST DUCT COMPLETE.
- 11 MECHANICAL CONTRACTOR TO SUPPORT EXISTING SUPPLY AIR DIFFUSER AS REQUIRED FOR DEMO OF EXISTING CEILING. SEE M200 SERIES DRAWINGS FOR NEW WORK.
- 12 REMOVE EXISTING SUPPLY AIR DUCT TO THIS POINT COMPLETE. PREPARE EXISTING SUPPLY AIR DUCT FOR RECONNECTION. SEE M200 SERIES DRAWINGS FOR NEW WORK.
- 13 REMOVE EXISTING RETURN AIR DUCT TO THIS POINT COMPLETE. PREPARE EXISTING RETURN AIR DUCT FOR RECONNECTION. SEE M200 SERIES DRAWINGS FOR NEW WORK. IF RETURN AIR IS NOT BEING RECONNECTED CAP AIRTIGHT AS REQUIRED.
- 14 REMOVE EXISTING AIR HANDLING UNIT, SUPPLY, RETURN & OUTSIDE AIR DUCTWORK, HEATING WATER PIPING, CHILLED WATER PIPING, CONDENSATE DRAIN LINE, CONTROLS AND ACCESSORIES COMPLETE. EXISTING CONCRETE PAD TO REMAIN.
- 15 REMOVE EXISTING FAN COIL UNIT, HEATING WATER LINES, CHILLED WATER LINES, CONDENSATE DRAIN LINE CONTROLS AND ACCESSORIES COMPLETE. WHERE FAN COIL UNIT IS BEING REPLACE PREPARE EXISTING SUPPLY FOR RECONNECTION. SEE M200 SERIES DRAWINGS FOR NEW WORK.
- 16 REMOVE EXISTING HEATING WATER SUPPLY AND RETURN LINES TO THIS POINT COMPLETE. PREPARE HEATING LINE FOR RECONNECTION AS REQUIRED. SEE M200 SERIES DRAWINGS FOR NEW WORK.
- 17 REMOVE EXISTING CHILLED WATER SUPPLY AND RETURN LINES TO THIS POINT COMPLETE. PREPARE EXISTING CHILLED WATER LINES FOR RECONNECTION AS REQUIRED. SEE M200 SERIES DRAWINGS FOR NEW WORK.<sup>33</sup>
- 18 REMOVE EXISTING CONVECTOR AND HEATING WATER SUPPLY AND RETURN LINES COMPLETE. PREPARE EXISTING HEATING WATER LINES AS REQUIRED FOR RECONNECTION IF CONVECTOR IS BEING REPLACED. SEE M200 SERIES DRAWINGS FOR WORK.
- 19 REMOVE EXISTING FAN POWERED VAV BOX, HEATING WATER LINES, CONTROLS AND ACCESSORIES COMPLETE. WHERE EXISTING HEATING WATER MAINS ARE TO REMAIN, CAP LINES WATERTIGHT AS REQUIRED.
- 20 REMOVE EXISTING OUTSIDE AIR DUCT TO THIS POINT COMPLETE. PREPARE EXISTING OUTSIDE AIR DUCT FOR RECONNECTION. SEE M200 SERIES DRAWINGS FOR NEW WORK.
- 21 REMOVE EXHAUST FAN, EXISTING DUCTWORK AND CURB TO REMAIN. PREPARE DUCTWORK AND CURB FOR RECONNECTION. SEE M200 SERIES DRAWINGS FOR NEW WORK.
- 22 REMOVE AND RELOCATE EXISTING DDC TEMPERATURE SENSOR. REWORK/ EXTEND CONTROL WIRING TO NEW LOCATION.
- 23 REMOVE EXISTING EXHAUST FAN, DUCTWORK, CONTROLS AND ACCESSORIES COMPLETE. EXISTING ROOF CURB TO REMAIN. CAP WITH CURB CAP. SEE DETAIL SHEET M301.
- 24 REMOVE EXISTING SUPPLY AIR DUCTWORK COMPLETE. CAP DUCT AT MAIN WHERE REQUIRED.
- 25 REMOVE EXISTING HEATING WATER SUPPLY & RETURN LINES COMPLETE. WHERE EXISTING MAIN LINES ARE TO REMAIN, CAP WATERTIGHT AS REQUIRED.
- 26 REMOVE EXISTING CHILLED WATER SUPPLY & RETURN LINES COMPLETE.
- 27 REMOVE EXISTING EXHAUST DUCT TO THIS POINT COMPLETE. PREPARE EXISTING EXHAUST DUCT FOR RECONNECTION AS REQUIRED. SEE M200 SERIES DRAWINGS FOR NEW WORK.
- 28 REMOVE EXISTING PNEUMATIC THERMOSTAT AND AIR TUBING COMPLETE. PREPARE EXISTING OPENING AS REQUIRED FOR NEW SENSOR. SEE M200 SERIES DRAWINGS FOR NEW WORK.
- 29 REMOVE EXISTING EXHAUST DUCT TO THIS POINT COMPLETE AND CAP AIRTIGHT AS REQUIRED.
- 30 REMOVE EXISTING EXHAUST DUCT COMPLETE.
- 31 REMOVE EXISTING DDC TEMPERATURE SENSOR AND CONTROL WIRING COMPLETE.
- 32 REMOVE EXISTING OUTDOOR AIR DUCTWORK COMPLETE.
- 33 REMOVE EXISTING SUPPLY AIR DIFFUSER, FLEXIBLE DUCT COMPLETE. EXISTING RIGID DUCTWORK TO REMAIN. PREPARE EXISTING RIGID DUCT FOR RECONNECTION. SEE M202 SERIES DRAWINGS FOR NEW WORK.
- 34 REMOVE EXISTING DDC TEMPERATURE SENSOR AND CONTROL WIRING COMPLETE. WHERE WALLS ARE TO REMAIN, PROVIDE STAINLESS STEEL BLANK COVER PLATE.
- 35 REMOVE EXISTING RETURN AIR TRANSFER DUCT COMPLETE.
- 36 REMOVE EXISTING EXHAUST GRILLE 12"x 12" (U.N.O.). PREPARE EXISTING EXHAUST DUCT FOR RECONNECTION. SEE M202 SERIES DRAWINGS FOR NEW WORK.
- 37 REMOVE EXISTING RETURN AIR GRILLE 12"x 12" (U.N.O.). PREPARE EXISTING RETURN DUCT FOR RECONNECTION. SEE M202 SERIES DRAWINGS FOR NEW WORK.
- 38 REMOVE EXISTING REMOVE EXISTING RETURN AIR GRILLE 24"x 12" (U.N.O.). EXISTING DUCTWORK TO REMAIN, LEAVING OPENING IN TRANSFER DUCT.
- 39 REMOVE EXISTING OUTDOOR AIR DUCTWORK TO THIS POINT COMPLETE AND CAP AIRTIGHT AS REQUIRED.
- 40 REMOVE EXISTING OUTDOOR AIR HOOD COMPLETE. EXISTING CURB TO REMAIN. CAP WITH CURB CAP. SEE DETAIL SHEET M301.
- 41 REMOVE EXISTING UNIT HEATER, HEATING WATER LINES, VALVES, CONTROLS AND ACCESSORIES COMPLETE. PREPARE EXISTING HEATING WATER LINES FOR RECONNECTION. WHERE UNIT HEATERS ARE NOT BEING REPLACED REMOVE HEATING WATER LINES TO MAINS AND CAP WATERTIGHT AS REQUIRED.

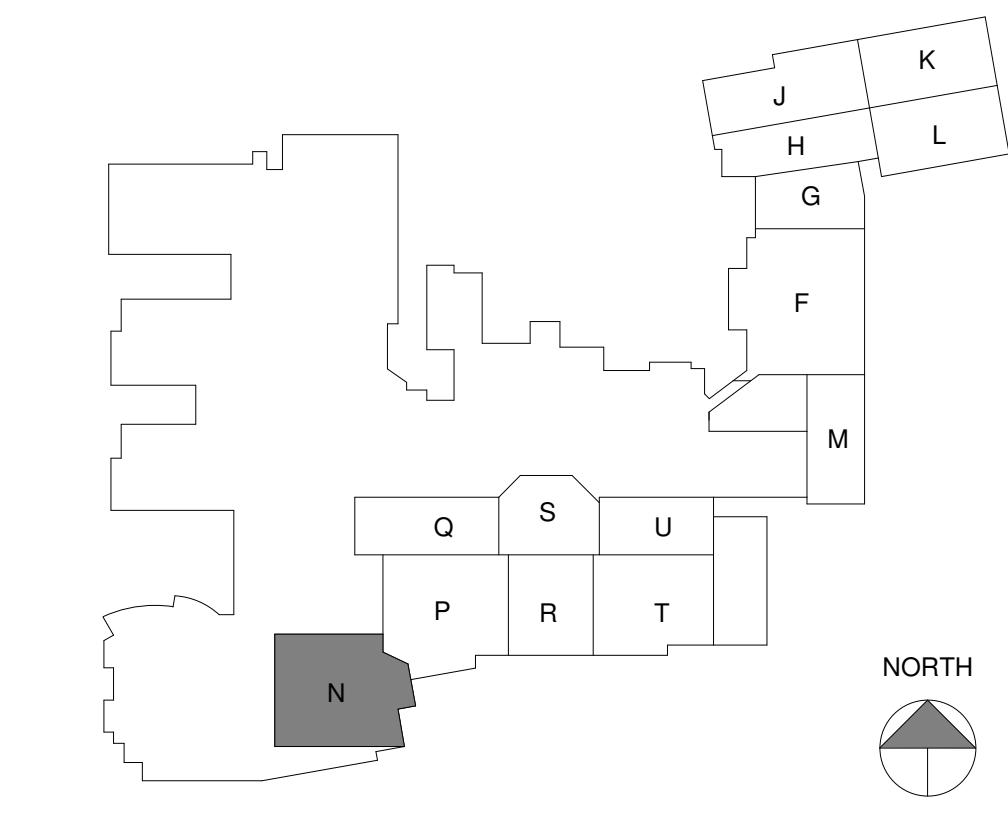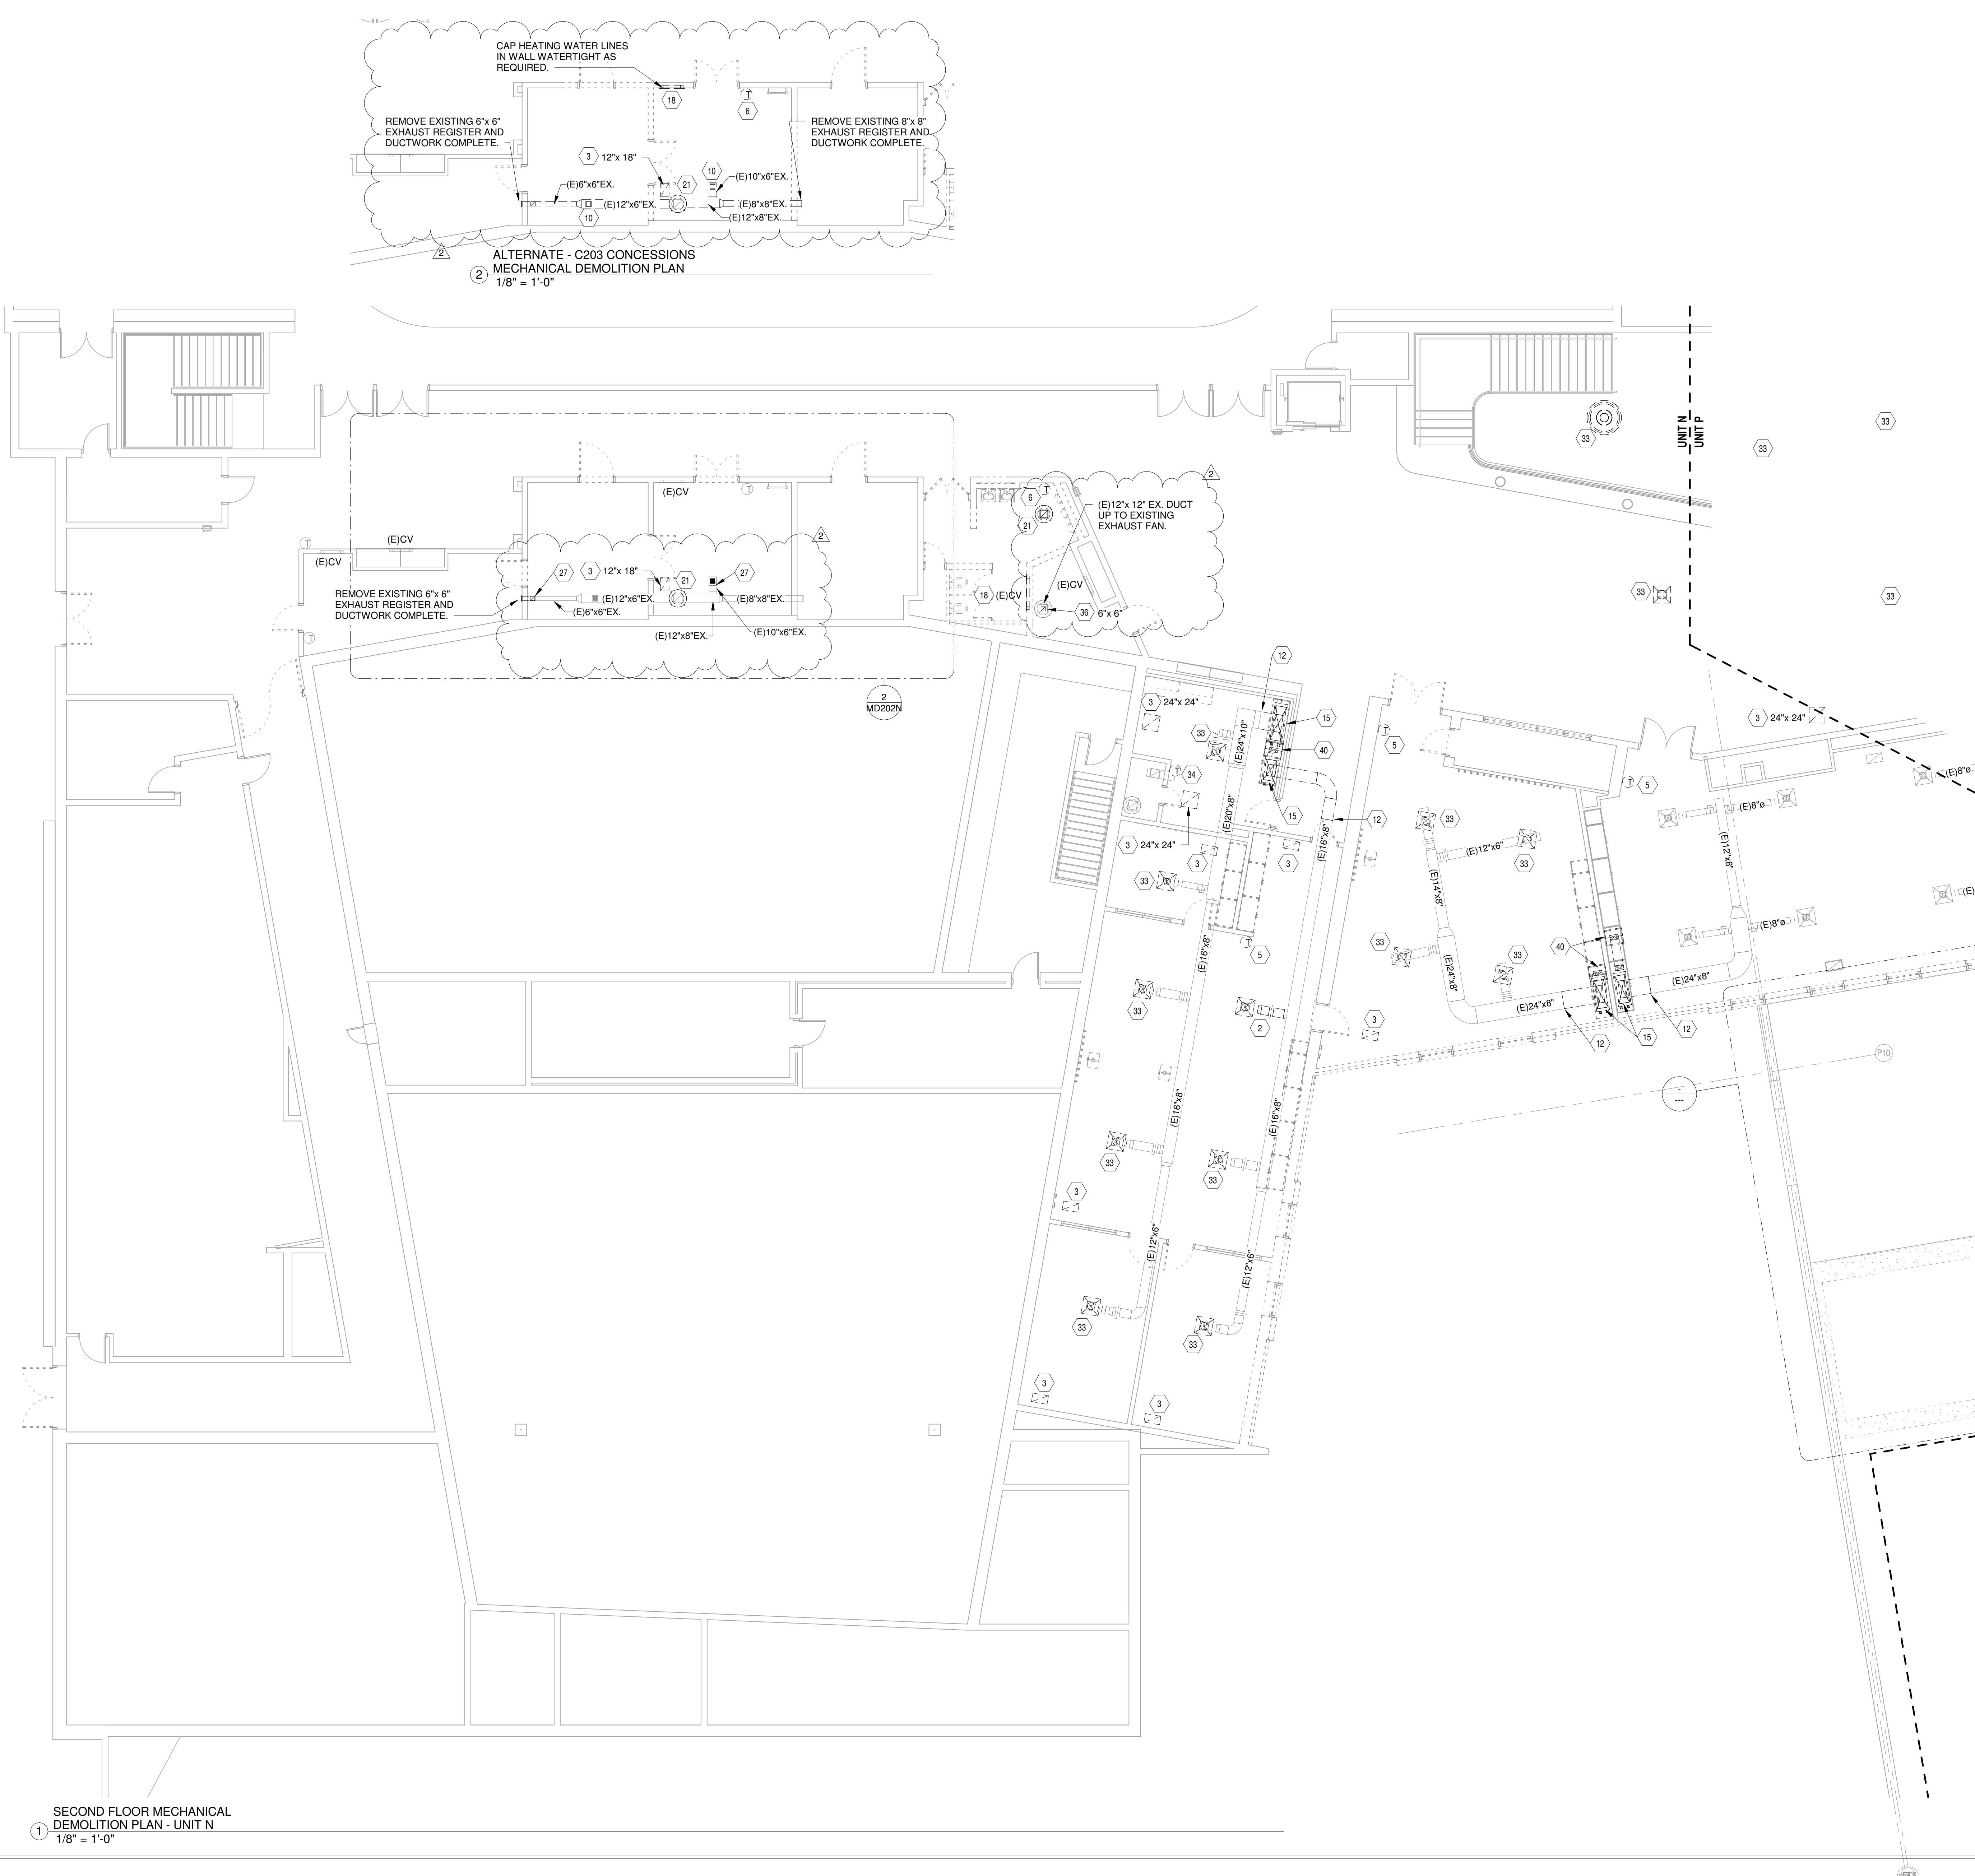

65833

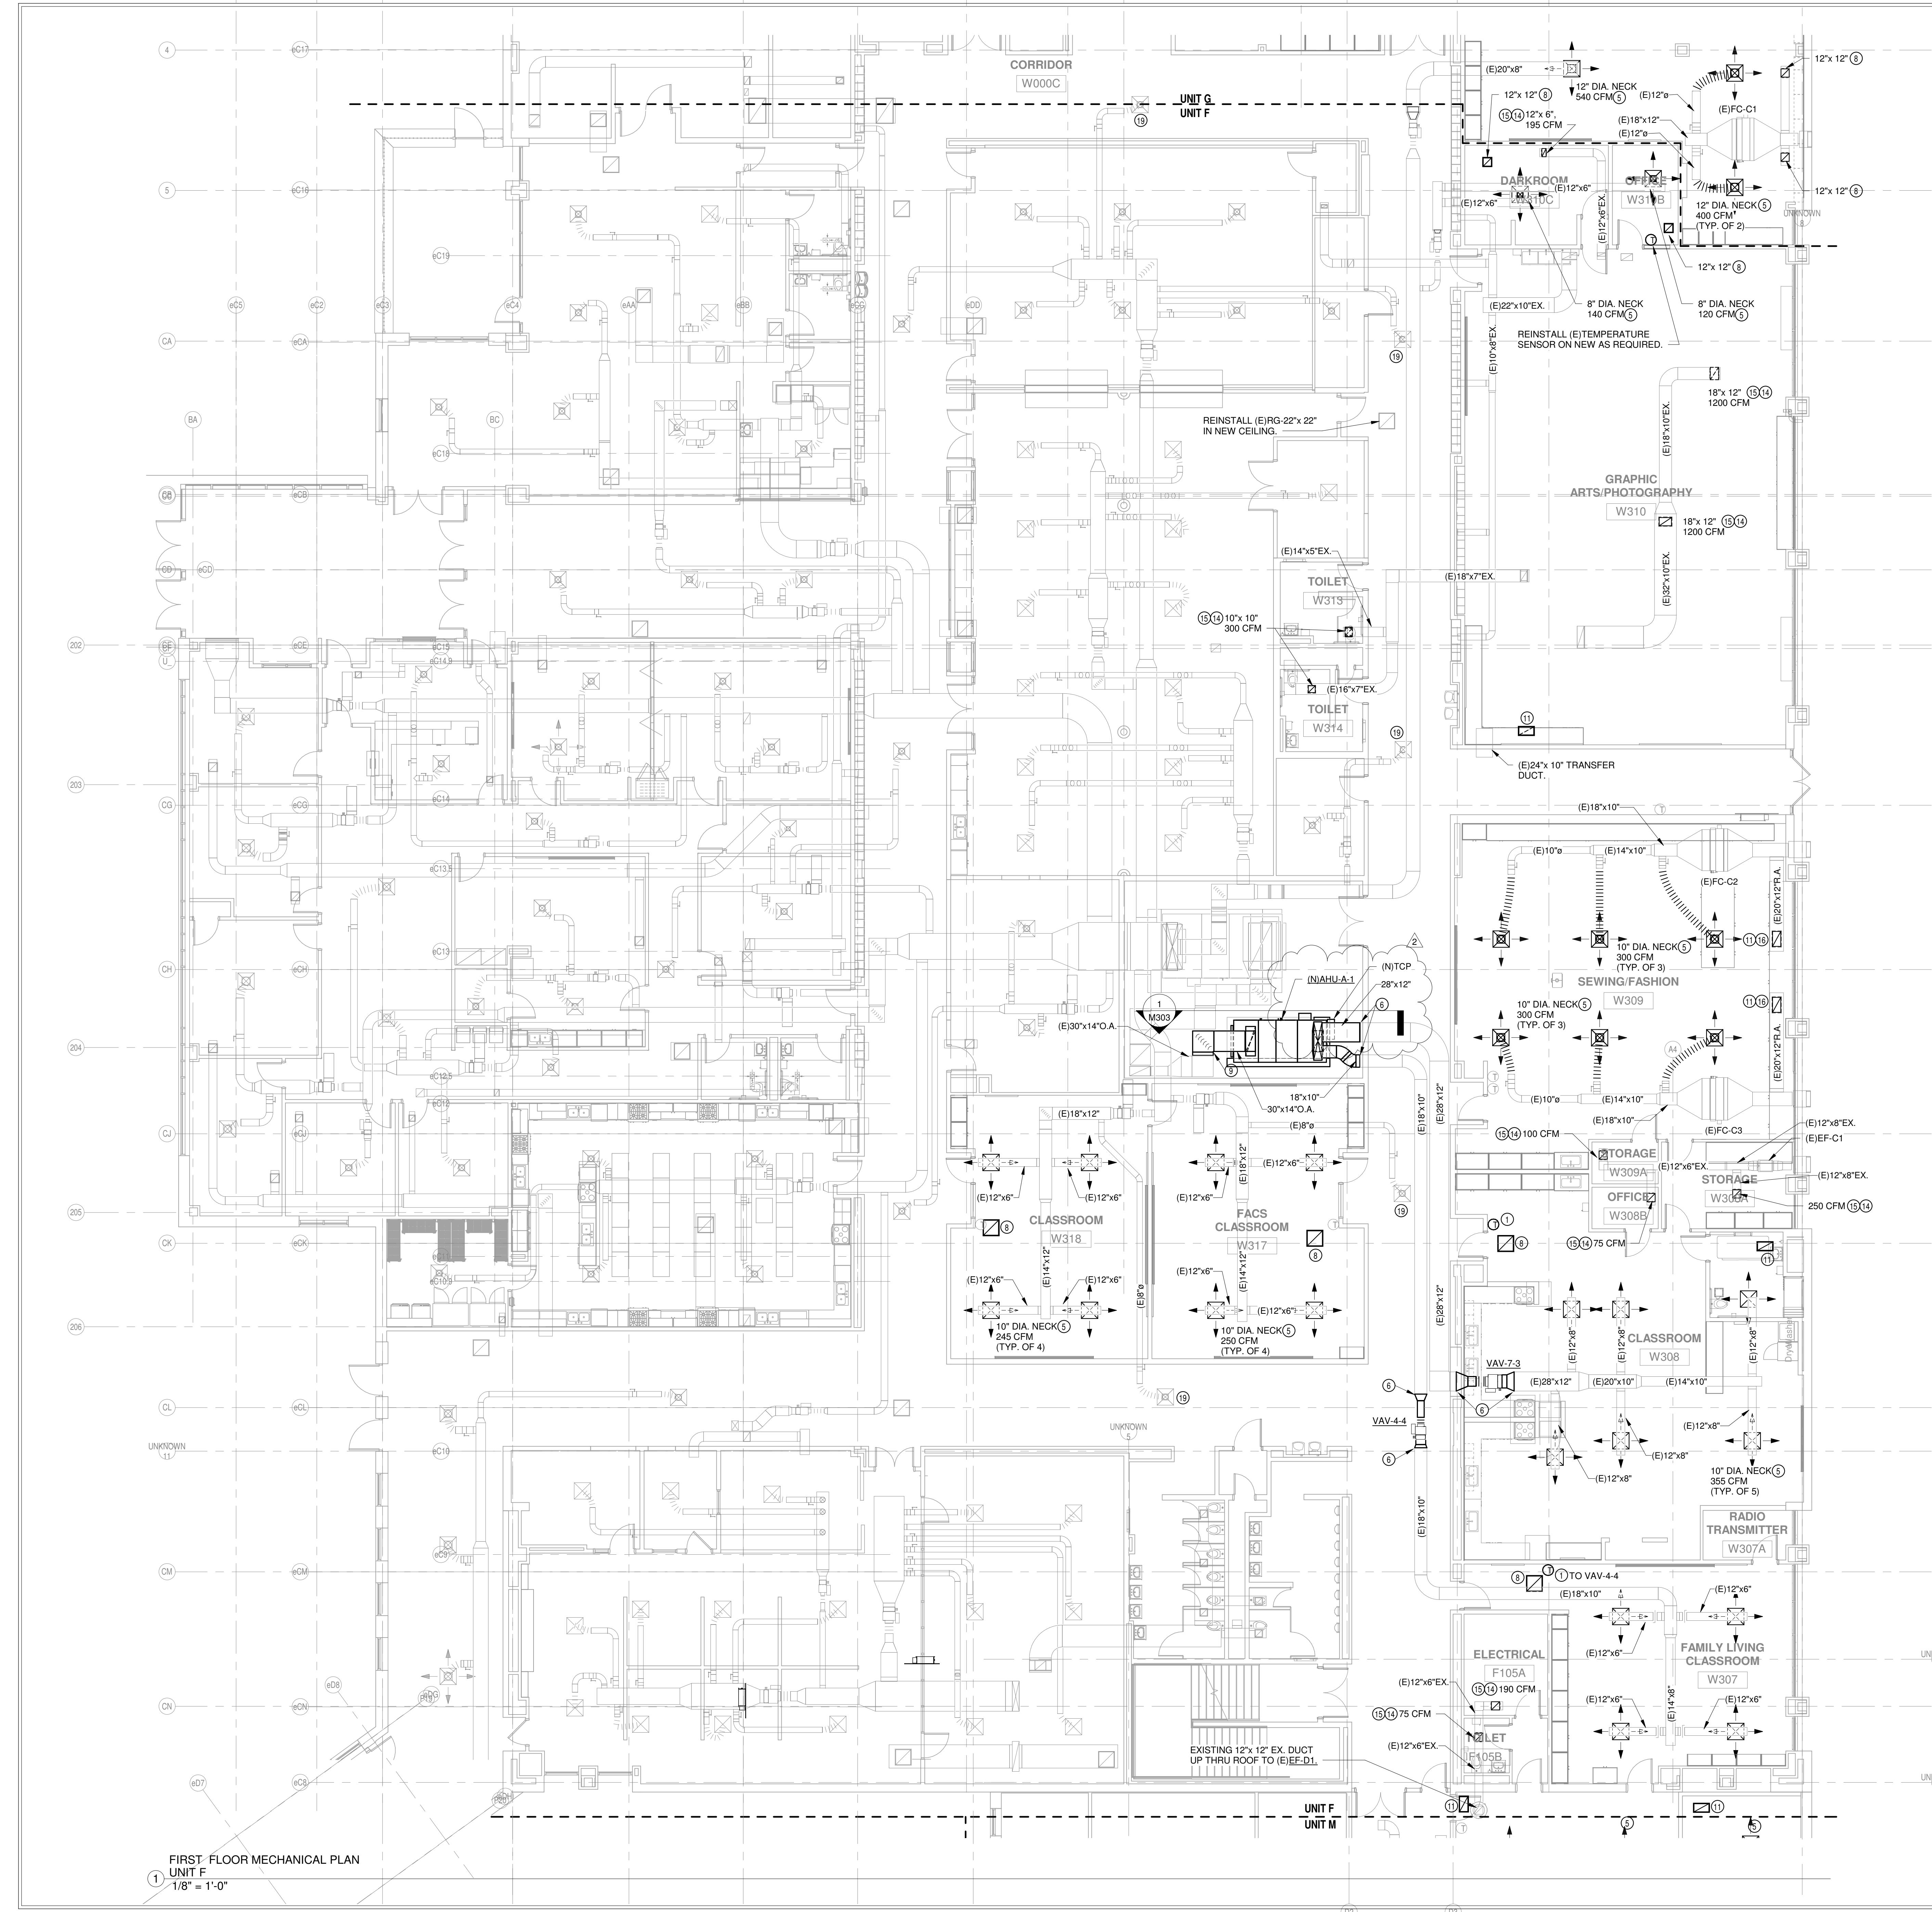

## MECHANICAL PLAN NOTES

- 1 NEW DDC TEMPERATURE SENSOR, INSTALLED AT EXISTING SENSOR LOCATION ON EXISTING WALL. SEE SPECIFICATIONS SECTION 230900.
- 2 NEW DDC CARBON DIOXIDE SENSOR NEXT TO EXISTING TEMPERATURE SENSOR. INSTALL CONTROL WIRING IN EXISTING WALL AS REQUIRED TO CONCEAL FROM VIEW. SEE SPECIFICATIONS SECTION 230900.
- 3 NEW DDC TEMPERATURE SENSOR ON NEW WALL. SEE ARCHITECTURAL DRAWINGS FOR WALL CONSTRUCTION. SEE SPECIFICATIONS SECTION 230900.
- 4 NEW DDC HUMIDITY SENSOR ON NEW WALL. SEE ARCHITECTURAL DRAWINGS FOR WALL CONSTRUCTION. SEE SPECIFICATIONS SECTION 230900.
- 5 CONNECT NEW FLEXIBLE DUCT FROM NEW SUPPLY AIR DIFFUSER TO EXISTING RIGID SUPPLY AIR DUCT AS REQUIRED.
- 6 CONNECT NEW SUPPLY AIR DUCT TO EXISTING SUPPLY AIR DUCT AS REQUIRED.
- 7 CONNECT NEW EXHAUST DUCT TO EXISTING EXHAUST DUCT AS REQUIRED.
- 8 NEW RETURN/RELIEF GRILLE RG-24" x 24" (U.N.O.).
- 9 CONNECT NEW OUTSIDE AIR DUCT TO EXISTING OUTSIDE AIR DUCT AS REQUIRED.
- 10 CLEAN AND RELOCATE EXISTING SUPPLY AIR DIFFUSER TO NEW CEILING GRID.
- 11 NEW RETURN/RELIEF GRILLE RG-24" x 12".
- 12 PROVIDE GRILLE WITH DRYWALL FRAME.
- 13 CONNECT NEW SUPPLY AIR DIFFUSER TO EXISTING DUCTWORK AS REQUIRED.
- 14 NEW EXHAUST GRILLE EG-12" x 12" (U.N.O.), FIELD VERIFY EXISTING EXHAUST GRILLE SIZE.
- 15 CONNECT NEW EXHAUST GRILLE TO EXISTING DUCTWORK AS REQUIRED.
- 16 CONNECT NEW RETURN AIR GRILLE TO EXISTING RETURN AIR DUCTWORK AS REQUIRED.
- 17 EXISTING 16" x 8" (U.N.O.) RELIEF AIR TRANSFER DUCT.
- 18 NEW 20" x 10" (U.N.O.) RELIEF AIR TRANSFER DUCTWORK.
- 19 REINSTALL EXISTING SUPPLY AIR DIFFUSER IN NEW CEILING GRID.
- 20 NEW DDC TEMPERATURE SENSOR, INSTALLED ON EXISTING WALL, CONCEAL CONTROL WIRING IN WALL AS REQUIRED.
- 21 PROVIDE NEW NETWORKED DIGITAL CONTROLLER, LOW LIMIT PROTECTION, WALL TEMPERATURE AND CO2 SENSOR AND ACTUATORS. EXISTING DAMPERS AND VALVES TO REMAIN. PROVIDE NEW SEQUENCE WITH CO2 OUTSIDE AIR CONTROL.
- 22 NEW LOCATION OF EXISTING TEMPERATURE SENSOR. REWORK/EXTEND CONTROL WIRING AS REQUIRED.
- 23 20' 8" (U.N.O.) OUTDOOR AIR DUCT DOWN TO VERTICAL UNIT VENTILATOR.
- 24 20' 8" (U.N.O.) OUTDOOR AIR DUCT UP TO SECOND FLOOR.
- 25 20' 8" (U.N.O.) OUTDOOR AIR DUCT UP THRU EXISTING ROOF TO NEW OUTDOOR AIR INTAKE HOOD. SEE SHEET M204 FOR CONTINUATION.
- 26 20' 20" (U.N.O.) OUTSIDE AIR DUCT UP THRU EXISTING ROOF TO NEW OUTDOOR AIR INTAKE HOOD. SEE SHEET M204 FOR CONTINUATION.
- 27 20' 8" (U.N.O.) OUTDOOR AIR DUCT UP FROM FIRST FLOOR.
- 28 20' 10" OUTDOOR AIR DUCT FROM VERTICAL UNIT VENTILATOR UP THRU EXISTING ROOF TO NEW 14" x 18" THROAT OUTDOOR AIR INTAKE HOOD. SEE SHEET M204 FOR CONTINUATION.
- 29 30' x 48" OUTDOOR AIR DUCT UP THRU EXISTING ROOF TO NEW 30' x 48" THROAT OUTDOOR AIR INTAKE HOOD. SEE SHEET M204 FOR CONTINUATION.
- 30 OUTDOOR AIR LOUVER PROVIDED BY THE ARCHITECT. MECHANICAL CONTRACTOR TO PROVIDE SHEET METAL SLEEVE FROM VERTICAL UNIT VENTILATOR TO LOUVER AS REQUIRED.
- 31 4" DIA. GALVANIZED DUCT WITH TAPED JOINTS FROM DRYER UP THRU EXISTING ROOF. TERMINATE WITH GOOSENECK AS REQUIRED.
- 32 20' 8" OUTSIDE AIR DUCT FROM 44" x 29" PLENUM AT LOUVER (BY THE ARCHITECT) TO VERTICAL UNIT VENTILATOR CONNECTION. VERIFY LOUVER SIZE WITH THE GENERAL CONTRACTOR FOR PLENUM SIZE.

**SCCSO**

3831 Keystone Crossing, Indianapolis, IN 46240

© 2020 CCSO Architects, Inc. All rights reserved.

**STAIR**  
ASSOCIATES INC.

MECHANICAL / ELECTRICAL ENGINEERS

**WARREN CENTRAL HIGH SCHOOL  
PHASE 3 ADDITION & RENOVATION**  
9500 E. 6th STREET, INDIANAPOLIS, IN 46229

**SCOPE DRAWINGS:**  
These drawings are a part of the scope of the project. In terms of the architectural design concept, the dimensions of the building, its exterior and interior spaces, the structure, mechanical and electrical systems, and other features are described. All the drawings and specifications contained in this scope of the project are the responsibility of the architect.

The architect shall be responsible for the scope indicated and the trade contractors shall furnish all items required for the proper execution and completion of the work.

**REVISIONS:**

2 ADDENDUM #2 03/13/2023

**ISSUE DATE**

02/20/23

**DRAWN BY**

RWT

**CHECKED BY**

WWH



SCCSO  
S C S O

38331 Keystone Crossing, Indianapolis, IN 46240  
© 2020 CCSO Architects, Inc. All rights reserved.

STAIR  
ASSOCIATES INC.  
MECHANICAL / ELECTRICAL ENGINEERS

PROJECT:  
WARREN CENTRAL HIGH SCHOOL  
PHASE 3 ADDITION & RENOVATION  
9500 E. 6th STREET, INDIANAPOLIS, IN 46229

SCOPE DRAWINGS:  
These drawings illustrate the scope of the project in terms of architectural design concept, the dimensions of structures, mechanical and electrical systems, and the location of equipment. They are intended to describe all the work to be performed under the contract, including the requirements of the Contract.  
The drawings and specifications describe the scope indicated and the trade contractors shall furnish all items required for the proper execution and completion of the work.

REVISIONS:  
2 ADDENDUM #2 03/13/2023

ISSUE DATE DRAWN BY CHECKED BY  
02/20/23 RWT WWH

DRAWING TITLE:  
FIRST FLOOR  
MECHANICAL  
PLAN - UNIT J

CERTIFIED BY:  
WARD  
REGISTERED  
PROFESSIONAL  
ENGINEER  
No. PE60021456  
State of Indiana  
Drawing Number M201J

PROJECT NUMBER  
2021056/1407

## MECHANICAL PLAN NOTES

- 1 NEW DDC TEMPERATURE SENSOR, INSTALLED AT EXISTING SENSOR LOCATION ON EXISTING WALL. SEE SPECIFICATIONS SECTION 230900.
- 2 NEW DDC CARBON DIOXIDE SENSOR NEXT TO EXISTING TEMPERATURE SENSOR. INSTALL CONTROL WIRING IN EXISTING WALL AS REQUIRED TO CONCEAL FROM VIEW. SEE SPECIFICATIONS SECTION 230900.
- 3 NEW DDC TEMPERATURE SENSOR ON NEW WALL. SEE ARCHITECTURAL DRAWINGS FOR WALL CONSTRUCTION. SEE SPECIFICATIONS SECTION 230900.
- 4 NEW DDC HUMIDITY SENSOR ON NEW WALL. SEE ARCHITECTURAL DRAWINGS FOR WALL CONSTRUCTION. SEE SPECIFICATIONS SECTION 230900.
- 5 CONNECT NEW FLEXIBLE DUCT FROM NEW SUPPLY AIR DIFFUSER TO EXISTING RIGID SUPPLY AIR DUCT AS REQUIRED.
- 6 CONNECT NEW SUPPLY AIR DUCT TO EXISTING SUPPLY AIR DUCT AS REQUIRED.
- 7 CONNECT NEW EXHAUST DUCT TO EXISTING EXHAUST DUCT AS REQUIRED.
- 8 NEW RETURN RELIEF GRILLE RG-24"x 24" (U.N.O.).
- 9 CONNECT NEW OUTSIDE AIR DUCT TO EXISTING OUTSIDE AIR DUCT AS REQUIRED.
- 10 CLEAN AND RELOCATE EXISTING SUPPLY AIR DIFFUSER TO NEW CEILING GRID.
- 11 NEW RETURN RELIEF GRILLE RG-24"x 12".
- 12 PROVIDE GRILLE WITH DRYWALL FRAME.
- 13 CONNECT NEW SUPPLY AIR DIFFUSER TO EXISTING DUCTWORK AS REQUIRED.
- 14 NEW EXHAUST GRILLE EG-12"x 12" (U.N.O.), FIELD VERIFY EXISTING EXHAUST GRILLE SIZE.
- 15 CONNECT NEW EXHAUST GRILLE TO EXISTING DUCTWORK AS REQUIRED.
- 16 CONNECT NEW RETURN AIR GRILLE TO EXISTING RETURN AIR DUCTWORK AS REQUIRED.
- 17 EXISTING 16"x 8" (U.N.O.) RELIEF AIR TRANSFER DUCT.
- 18 NEW 20"x 10" (U.N.O.) RELIEF AIR TRANSFER DUCTWORK.
- 19 REINSTALL EXISTING SUPPLY AIR DIFFUSER IN NEW CEILING GRID.
- 20 NEW DDC TEMPERATURE SENSOR, INSTALLED ON EXISTING WALL, CONCEAL CONTROL WIRING IN WALL AS REQUIRED.
- 21 PROVIDE NEW NETWORKED DIGITAL CONTROLLER, LOW LIMIT PROTECTION, WALL TEMPERATURE AND CO2 SENSOR AND ACTUATORS. EXISTING DAMPERS AND VALVES TO REMAIN. PROVIDE NEW SEQUENCE WITH CO2 OUTSIDE AIR CONTROL.
- 22 NEW LOCATION OF EXISTING TEMPERATURE SENSOR. REWORK/EXTEND CONTROL WIRING AS REQUIRED.
- 23 20"x 8" (U.N.O.) OUTDOOR AIR DUCT DOWN TO VERTICAL UNIT VENTILATOR.
- 24 20"x 8" (U.N.O.) OUTDOOR AIR DUCT UP TO SECOND FLOOR.
- 25 20"x 8" (U.N.O.) OUTDOOR AIR DUCT UP THRU EXISTING ROOF TO NEW OUTDOOR AIR INTAKE HOOD. SEE SHEET M204 FOR CONTINUATION.
- 26 20"x 20" (U.N.O.) OUTDOOR AIR DUCT UP THRU EXISTING ROOF TO NEW OUTDOOR AIR INTAKE HOOD. SEE SHEET M204 FOR CONTINUATION.
- 27 20"x 8" (U.N.O.) OUTDOOR AIR DUCT UP FROM FIRST FLOOR.
- 28 20"x 10" OUTDOOR AIR DUCT FROM VERTICAL UNIT VENTILATOR UP THRU EXISTING ROOF TO NEW 14"x 18" THROAT OUTDOOR AIR INTAKE HOOD. SEE SHEET M204 FOR CONTINUATION.
- 29 30"x 48" OUTDOOR AIR DUCT UP THRU EXISTING ROOF TO NEW 30"x 48" THROAT OUTDOOR AIR INTAKE HOOD. SEE SHEET M204 FOR CONTINUATION.
- 30 OUTDOOR AIR LOUVER PROVIDED BY THE ARCHITECT, MECHANICAL CONTRACTOR TO PROVIDE SHEET METAL SLEEVE FROM VERTICAL UNIT VENTILATOR TO LOUVER AS REQUIRED.
- 31 4" DIA. GALVANIZED DUCT WITH TAPED JOINTS FROM DRYER TO UP THRU EXISTING ROOF. TERMINATE WITH GOOSENECK AS REQUIRED.
- 32 20"x 8" OUTSIDE AIR DUCT FROM 44"x 29" PLENUM AT LOUVER (BY THE ARCHITECT) TO VERTICAL UNIT VENTILATOR CONNECTION. VERIFY LOUVER SIZE WITH THE GENERAL CONTRACTOR FOR PLENUM SIZE.





**SCCSO**  
3831 Keystone Crossing, Indianapolis, IN 46240

© 2020 CCSO Architects, Inc. All rights reserved.

**STAIREE**  
ASSOCIATES INC.  
MECHANICAL / ELECTRICAL ENGINEERS

317.448.7800 | ccsocn.com

**WARREN CENTRAL HIGH SCHOOL**  
PROJECT:  
PHASE 3 ADDITION & RENOVATION  
9500 E. 6th STREET, INDIANAPOLIS, IN 46229

9500 E. 6th Street, Indianapolis, IN 46229

## MECHANICAL PLAN NOTES

- 1 NEW DDC TEMPERATURE SENSOR, INSTALLED AT EXISTING SENSOR LOCATION ON EXISTING WALL. SEE SPECIFICATIONS SECTION 230901.
- 2 NEW DDC CARBON DIOXIDE SENSOR NEXT TO EXISTING TEMPERATURE SENSOR. INSTALL CONTROL WIRING IN EXISTING WALL AS REQUIRED TO CONCEAL FROM VIEW. SEE SPECIFICATIONS SECTION 230901.
- 3 NEW DDC TEMPERATURE SENSOR ON NEW WALL. SEE ARCHITECTURAL DRAWINGS FOR WALL CONSTRUCTION. SEE SPECIFICATIONS SECTION 230901.
- 4 NEW DDC HUMIDITY SENSOR ON NEW WALL. SEE ARCHITECTURAL DRAWINGS FOR WALL CONSTRUCTION. SEE SPECIFICATIONS SECTION 230901.
- 5 CONNECT NEW FLEXIBLE DUCT FROM NEW SUPPLY AIR DIFFUSER TO EXISTING RIGID SUPPLY AIR DUCT AS REQUIRED.
- 6 CONNECT NEW SUPPLY AIR DUCT TO EXISTING SUPPLY AIR DUCT AS REQUIRED.
- 7 CONNECT NEW EXHAUST DUCT TO EXISTING EXHAUST DUCT AS REQUIRED.
- 8 NEW RETURN/RELIEF GRILLE RG-24" x 24" (U.N.O.).
- 9 CONNECT NEW OUTSIDE AIR DUCT TO EXISTING OUTSIDE AIR DUCT AS REQUIRED.
- 10 CLEAN AND RELOCATE EXISTING SUPPLY AIR DIFFUSER TO NEW CEILING GRID.
- 11 NEW RETURN/RELIEF GRILLE RG-24" x 12".
- 12 PROVIDE GRILLE WITH DRYWALL FRAME.
- 13 CONNECT NEW SUPPLY AIR DIFFUSER TO EXISTING DUCTWORK AS REQUIRED.
- 14 NEW EXHAUST GRILLE EG-12" x 12" (U.N.O.). FIELD VERIFY EXISTING EXHAUST GRILLE SIZE.
- 15 CONNECT NEW EXHAUST GRILLE TO EXISTING DUCTWORK AS REQUIRED.
- 16 CONNECT NEW RETURN AIR GRILLE TO EXISTING RETURN AIR DUCTWORK AS REQUIRED.
- 17 EXISTING 16" x 8" (U.N.O.) RELIEF AIR TRANSFER DUCT.
- 18 NEW 20" x 10" (U.N.O.) RELIEF AIR TRANSFER DUCTWORK.
- 19 REINSTALL EXISTING SUPPLY AIR DIFFUSER IN NEW CEILING GRID.
- 20 NEW DDC TEMPERATURE SENSOR, INSTALLED ON EXISTING WALL, CONCEAL CONTROL WIRING IN WALL AS REQUIRED.
- 21 PROVIDE NEW NETWORKED DIGITAL CONTROLLER, LOW LIMIT PROTECTION, WALL TEMPERATURE AND CO2 SENSOR AND ACTUATORS, EXISTING DAMPERS AND VALVES TO REMAIN. PROVIDE NEW SEQUENCE WITH CO2 OUTSIDE AIR CONTROL.
- 22 NEW LOCATION OF EXISTING TEMPERATURE SENSOR. REWORK/EXTEND CONTROL WIRING AS REQUIRED.
- 23 20" x 8" (U.N.O.) OUTDOOR AIR DUCT UP TO VERTICAL UNIT VENTILATOR.
- 24 20" x 8" (U.N.O.) OUTDOOR AIR DUCT UP TO SECOND FLOOR.
- 25 20" x 8" (U.N.O.) OUTDOOR AIR DUCT UP THRU EXISTING ROOF TO NEW OUTDOOR AIR INTAKE HOOD. SEE SHEET M204 FOR CONTINUATION.
- 26 20" x 20" (U.N.O.) OUTDOOR AIR DUCT UP THRU EXISTING ROOF TO NEW OUTDOOR AIR INTAKE HOOD. SEE SHEET M204 FOR CONTINUATION.
- 27 20" x 8" (U.N.O.) OUTDOOR AIR DUCT UP FROM FIRST FLOOR.
- 28 20" x 10" OUTDOOR AIR DUCT FROM VERTICAL UNIT VENTILATOR UP THRU EXISTING ROOF TO NEW 14" x 18" THROAT OUTDOOR AIR INTAKE HOOD. SEE SHEET M204 FOR CONTINUATION.
- 29 30" x 48" OUTDOOR AIR DUCT UP THRU EXISTING ROOF TO NEW 30" x 48" THROAT OUTDOOR AIR INTAKE HOOD. SEE SHEET M204 FOR CONTINUATION.
- 30 OUTDOOR AIR LOUVER PROVIDED BY THE ARCHITECT, MECHANICAL CONTRACTOR TO PROVIDE SHEET METAL SLEEVE FROM VERTICAL UNIT VENTILATOR TO LOUVER AS REQUIRED.
- 31 4" DIA. GALVANIZED DUCT WITH TAPED JOINTS FROM DRYER TO UP THRU EXISTING ROOF. TERMINATE WITH GOOSENECK AS REQUIRED.
- 32 20" x 8" OUTSIDE AIR DUCT FROM 44" x 29" PLENUM AT LOUVER (BY THE ARCHITECT) TO VERTICAL UNIT VENTILATOR CONNECTION. VERIFY LOUVER SIZE WITH THE GENERAL CONTRACTOR FOR PLENUM SIZE.

**SCOPE DRAWINGS:**  
These drawings are a part of the scope of the project. In terms of architectural design concept, the dimensions of the building, its rooms, and the location of the structural, mechanical and electrical systems. The drawings shall be used to describe all the requirements of the Contract.  
The drawings shall be used to describe all the requirements of the Contract.  
The drawings shall be used to describe all the requirements of the Contract.

**REVISIONS:**

2 ADDENDUM #2 03/13/2023


ISSUE DATE: 02/20/23 DRAWN BY: RWT CHECKED BY: WWH

**DRAWING TITLE:**  
**FIRST FLOOR**  
**MECHANICAL**  
**PLAN - UNIT K**

**CERTIFIED BY:**  
WARD  
NO. PE60021458  
STATE OF INDIANA  
REGISTERED PROFESSIONAL ENGINEER

**DRAWING NUMBER**  
**M201K**

**PROJECT NUMBER**  
**2021056/1407**

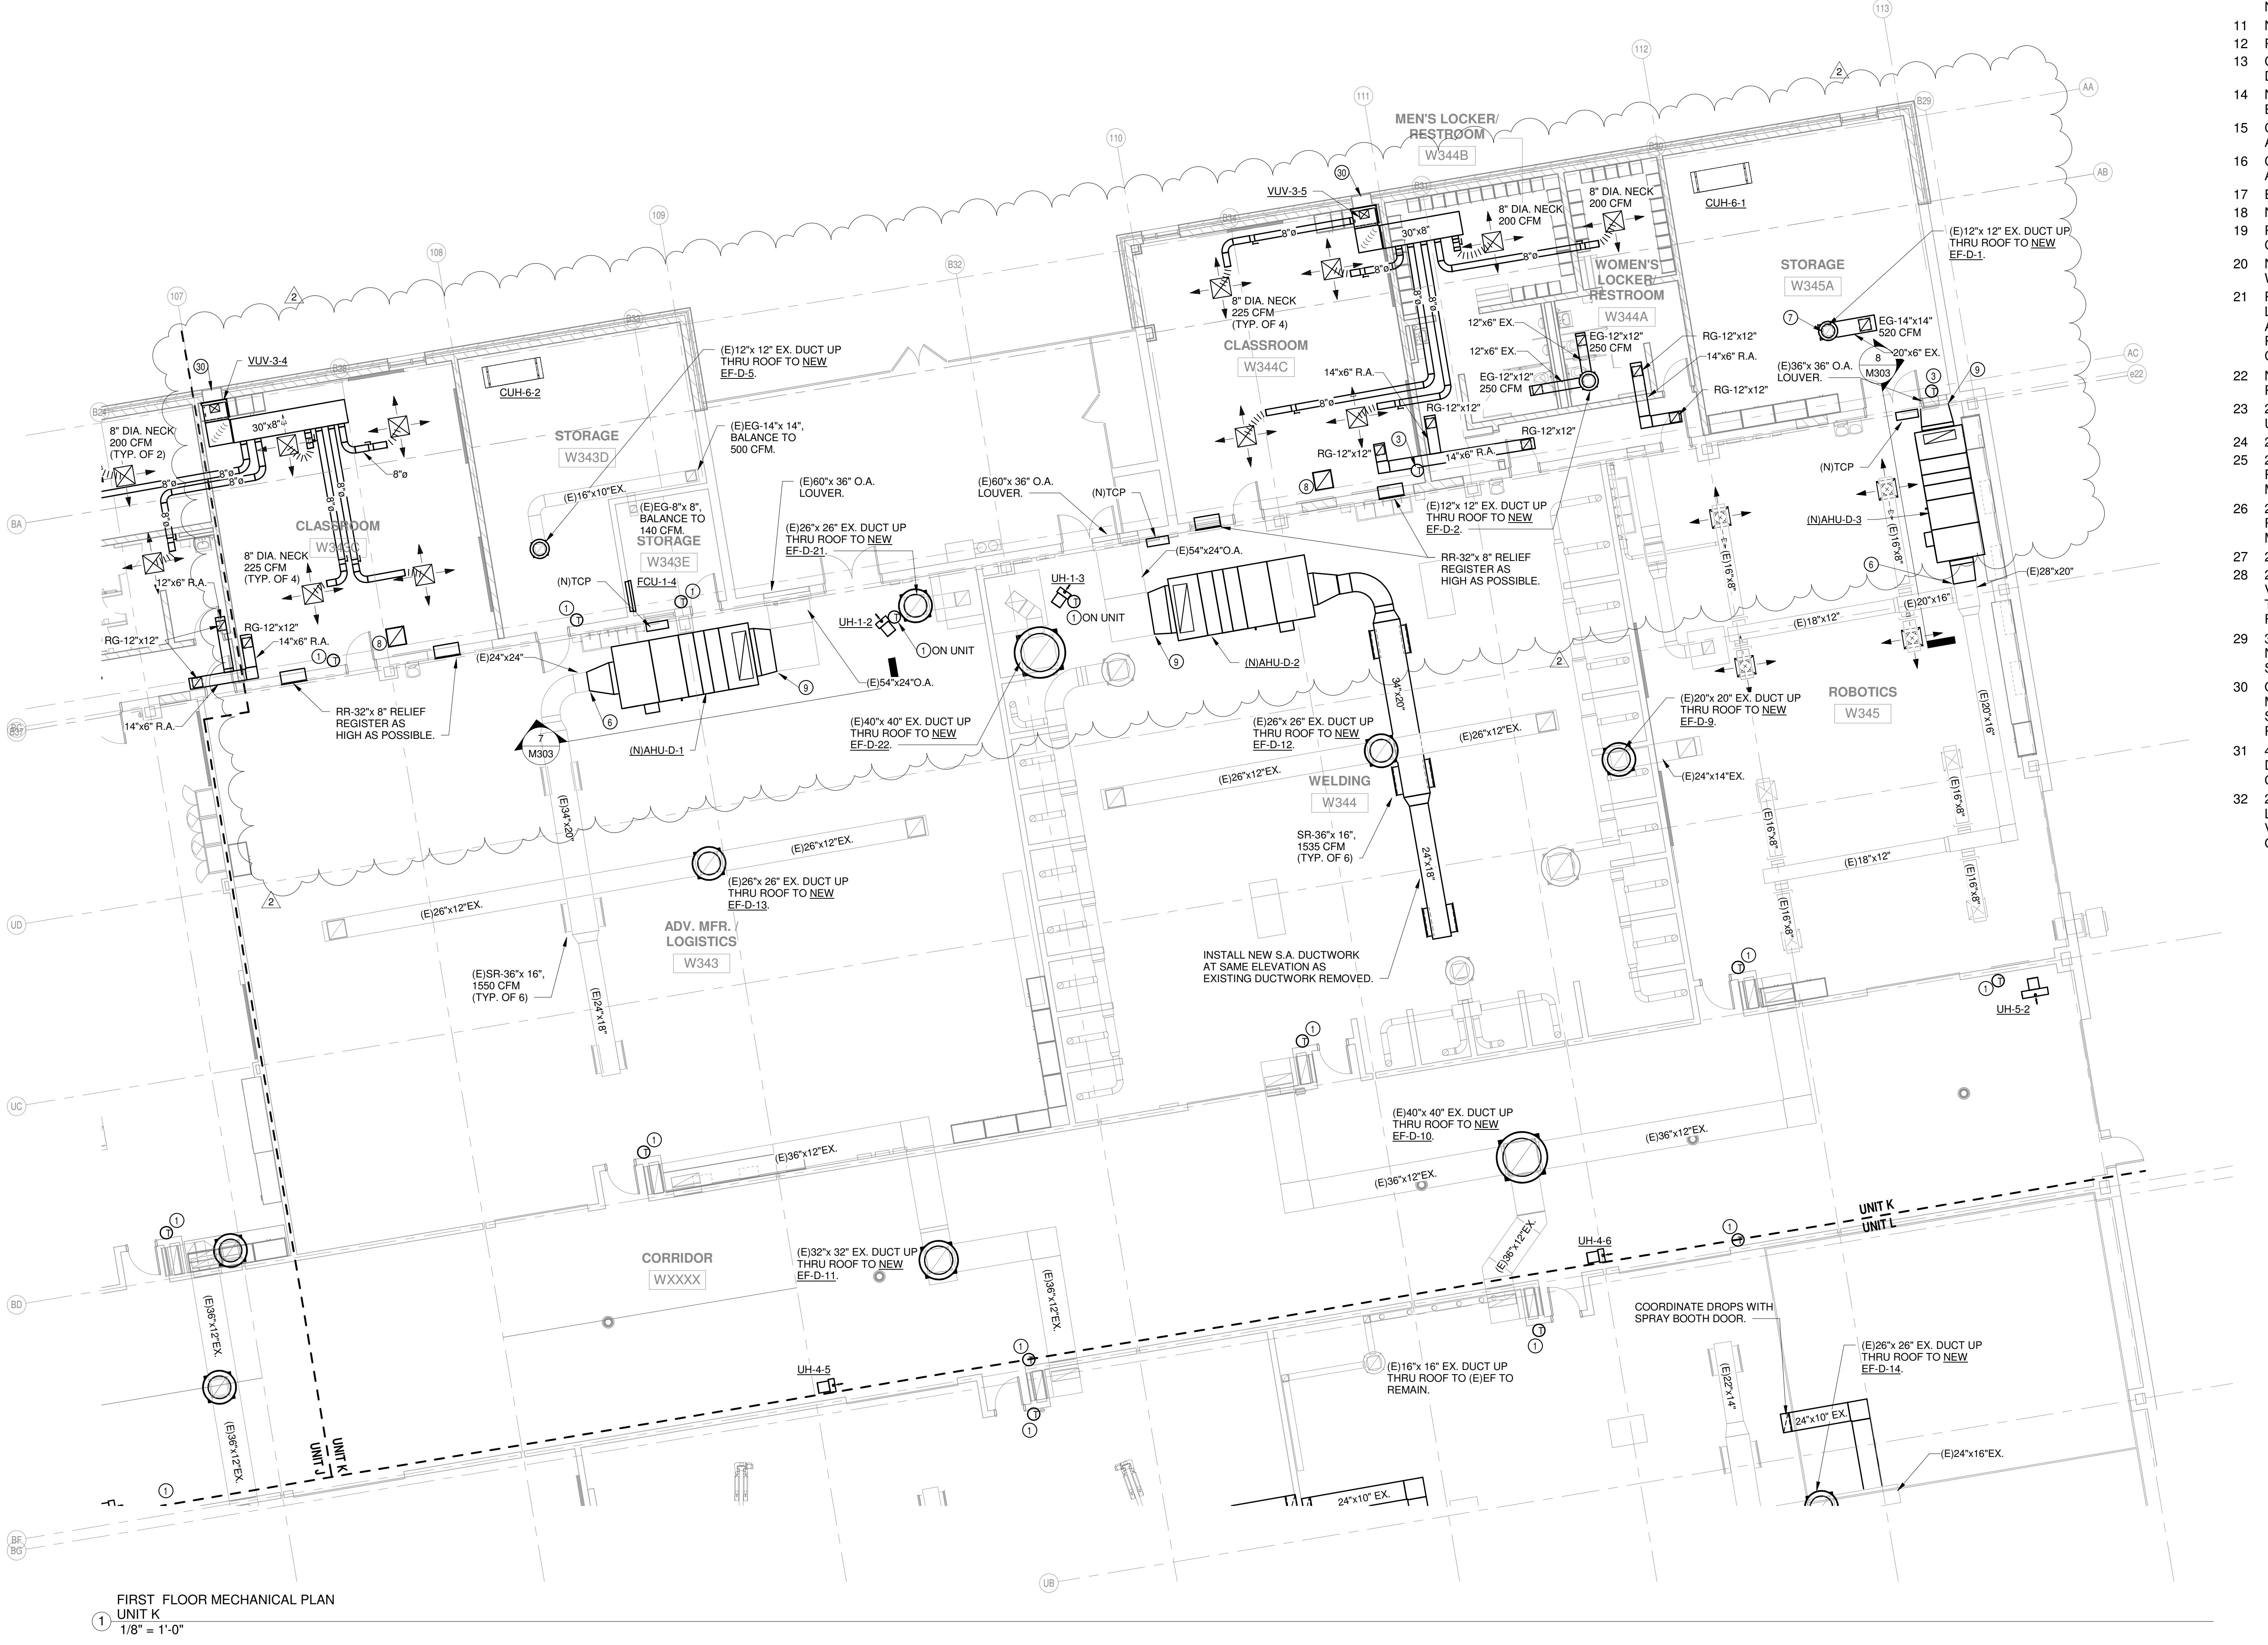



SCCSO  
SCHOLASTIC CLOUDS CONSULTING SERVICES, INC.

8831 Keystone Crossing, Indianapolis, IN 46240  
317.648.7800 | cscosnet.com



Stair Associates Inc.  
Mechanical / Electrical Engineers


PROJECT:  
WARREN CENTRAL HIGH SCHOOL  
PHASE 3 ADDITION & RENOVATION  
9500 E. 6th STREET, INDIANAPOLIS, IN 46229

SCOPE DRAWINGS:  
These drawings illustrate the mechanical system of the project in terms of the architectural design concept, the dimensions of the structures, mechanical and electrical systems, and the location of the equipment. They are intended to describe all the requirements of the Contract.  
The drawings and specifications shall be read in conjunction with the scope indicated or implied, the trade contractors shall furnish all items required for the proper execution and completion of the work.

REVISIONS:  
2 ADDENDUM #2 03/13/2023

ISSUE DATE: 02/20/23 DRAWN BY: RWT CHECKED BY: WWH

DRAWING TITLE:  
FIRST FLOOR  
MECHANICAL  
PLAN - UNIT L

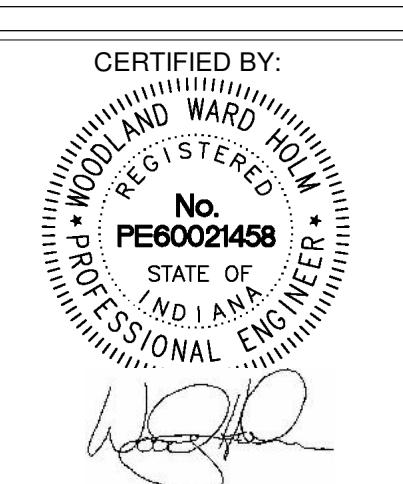


DRAWING NUMBER  
M201L

PROJECT NUMBER  
2021056/1407

## MECHANICAL PLAN NOTES

- 1 NEW DDC TEMPERATURE SENSOR, INSTALLED AT EXISTING SENSOR LOCATION ON EXISTING WALL. SEE SPECIFICATIONS SECTION 230900.
- 2 NEW DDC CARBON DIOXIDE SENSOR NEXT TO EXISTING TEMPERATURE SENSOR. INSTALL CONTROL WIRING IN EXISTING WALL AS REQUIRED TO CONCEAL FROM VIEW. SEE SPECIFICATIONS SECTION 230900.
- 3 NEW DDC TEMPERATURE SENSOR ON NEW WALL. SEE ARCHITECTURAL DRAWINGS FOR WALL CONSTRUCTION. SEE SPECIFICATIONS SECTION 230900.
- 4 NEW DDC HUMIDITY SENSOR ON NEW WALL. SEE ARCHITECTURAL DRAWINGS FOR WALL CONSTRUCTION. SEE SPECIFICATIONS SECTION 230900.
- 5 CONNECT NEW FLEXIBLE DUCT FROM NEW SUPPLY AIR DIFFUSER TO EXISTING RIGID SUPPLY AIR DUCT AS REQUIRED..
- 6 CONNECT NEW SUPPLY AIR DUCT TO EXISTING SUPPLY AIR DUCT AS REQUIRED.
- 7 CONNECT NEW EXHAUST DUCT TO EXISTING EXHAUST DUCT AS REQUIRED.
- 8 NEW RETURN/ RELIEF GRILLE RG-24" x 24" (U.N.O.).
- 9 CONNECT NEW OUTSIDE AIR DUCT TO EXISTING OUTSIDE AIR DUCT AS REQUIRED.
- 10 CLEAN AND RELOCATE EXISTING SUPPLY AIR DIFFUSER TO NEW CEILING GRID.
- 11 NEW RETURN/ RELIEF GRILLE RG-24" x 12".
- 12 PROVIDE GRILLE WITH DRYWALL FRAME.
- 13 CONNECT NEW SUPPLY AIR DIFFUSER TO EXISTING DUCTWORK AS REQUIRED.
- 14 NEW EXHAUST GRILLE EG-12" x 12" (U.N.O.). FIELD VERIFY EXISTING EXHAUST GRILLE SIZE.
- 15 CONNECT NEW EXHAUST GRILLE TO EXISTING DUCTWORK AS REQUIRED.
- 16 CONNECT NEW RETURN AIR GRILLE TO EXISTING RETURN AIR DUCTWORK AS REQUIRED.
- 17 EXISTING 16" x 8" (U.N.O.) RELIEF AIR TRANSFER DUCT.
- 18 NEW 20" x 10" (U.N.O.) RELIEF AIR TRANSFER DUCTWORK.
- 19 REINSTALL EXISTING SUPPLY AIR DIFFUSER IN NEW CEILING GRID.
- 20 NEW DDC TEMPERATURE SENSOR, INSTALLED ON EXISTING WALL. CONCEAL CONTROL WIRING IN WALL AS REQUIRED.
- 21 PROVIDE NEW NETWORKED DIGITAL CONTROLLER, LOW LIMIT PROTECTION, WALL TEMPERATURE AND CO2 SENSOR AND ACTUATORS. EXISTING DAMPERS AND VALVES TO REMAIN. PROVIDE NEW SEQUENCE WITH CO2 OUTSIDE AIR CONTROL.
- 22 NEW LOCATION OF EXISTING TEMPERATURE SENSOR. REWORK/ EXTEND CONTROL WIRING AS REQUIRED.
- 23 20" x 8" (U.N.O.) OUTDOOR AIR DUCT UP TO VERTICAL UNIT VENTILATOR.
- 24 20" x 8" (U.N.O.) OUTDOOR AIR DUCT UP TO SECOND FLOOR.
- 25 20" x 8" (U.N.O.) OUTDOOR AIR DUCT UP THRU EXISTING ROOF TO NEW OUTDOOR AIR INTAKE HOOD. SEE SHEET M204 FOR CONTINUATION.
- 26 20" x 20" (U.N.O.) OUTSIDE AIR DUCT UP THRU EXISTING ROOF TO NEW OUTDOOR AIR INTAKE HOOD. SEE SHEET M204 FOR CONTINUATION.
- 27 20" x 8" (U.N.O.) OUTDOOR AIR DUCT UP FROM FIRST FLOOR.
- 28 20" x 10" OUTDOOR AIR DUCT FROM VERTICAL UNIT VENTILATOR UP THRU EXISTING ROOF TO NEW 14" x 18" THROAT OUTDOOR AIR INTAKE HOOD. SEE SHEET M204 FOR CONTINUATION.
- 29 30" x 48" OUTDOOR AIR DUCT UP THRU EXISTING ROOF TO NEW 30" x 48" THROAT OUTDOOR AIR INTAKE HOOD. SEE SHEET M204 FOR CONTINUATION.
- 30 OUTDOOR AIR LOUVER PROVIDED BY THE ARCHITECT, MECHANICAL CONTRACTOR TO PROVIDE SHEET METAL SLEEVE FROM VERTICAL UNIT VENTILATOR TO LOUVER AS REQUIRED.
- 31 4" DIA. GALVANIZED DUCT WITH TAPED JOINTS FROM DRYER TO UP THRU EXISTING ROOF. TERMINATE WITH GOOSENECK AS REQUIRED.
- 32 20" x 8" OUTSIDE AIR DUCT FROM 44" x 29" PLENUM AT LOUVER (BY THE ARCHITECT) TO VERTICAL UNIT VENTILATOR CONNECTION. VERIFY LOUVER SIZE WITH THE GENERAL CONTRACTOR FOR PLENUM SIZE.



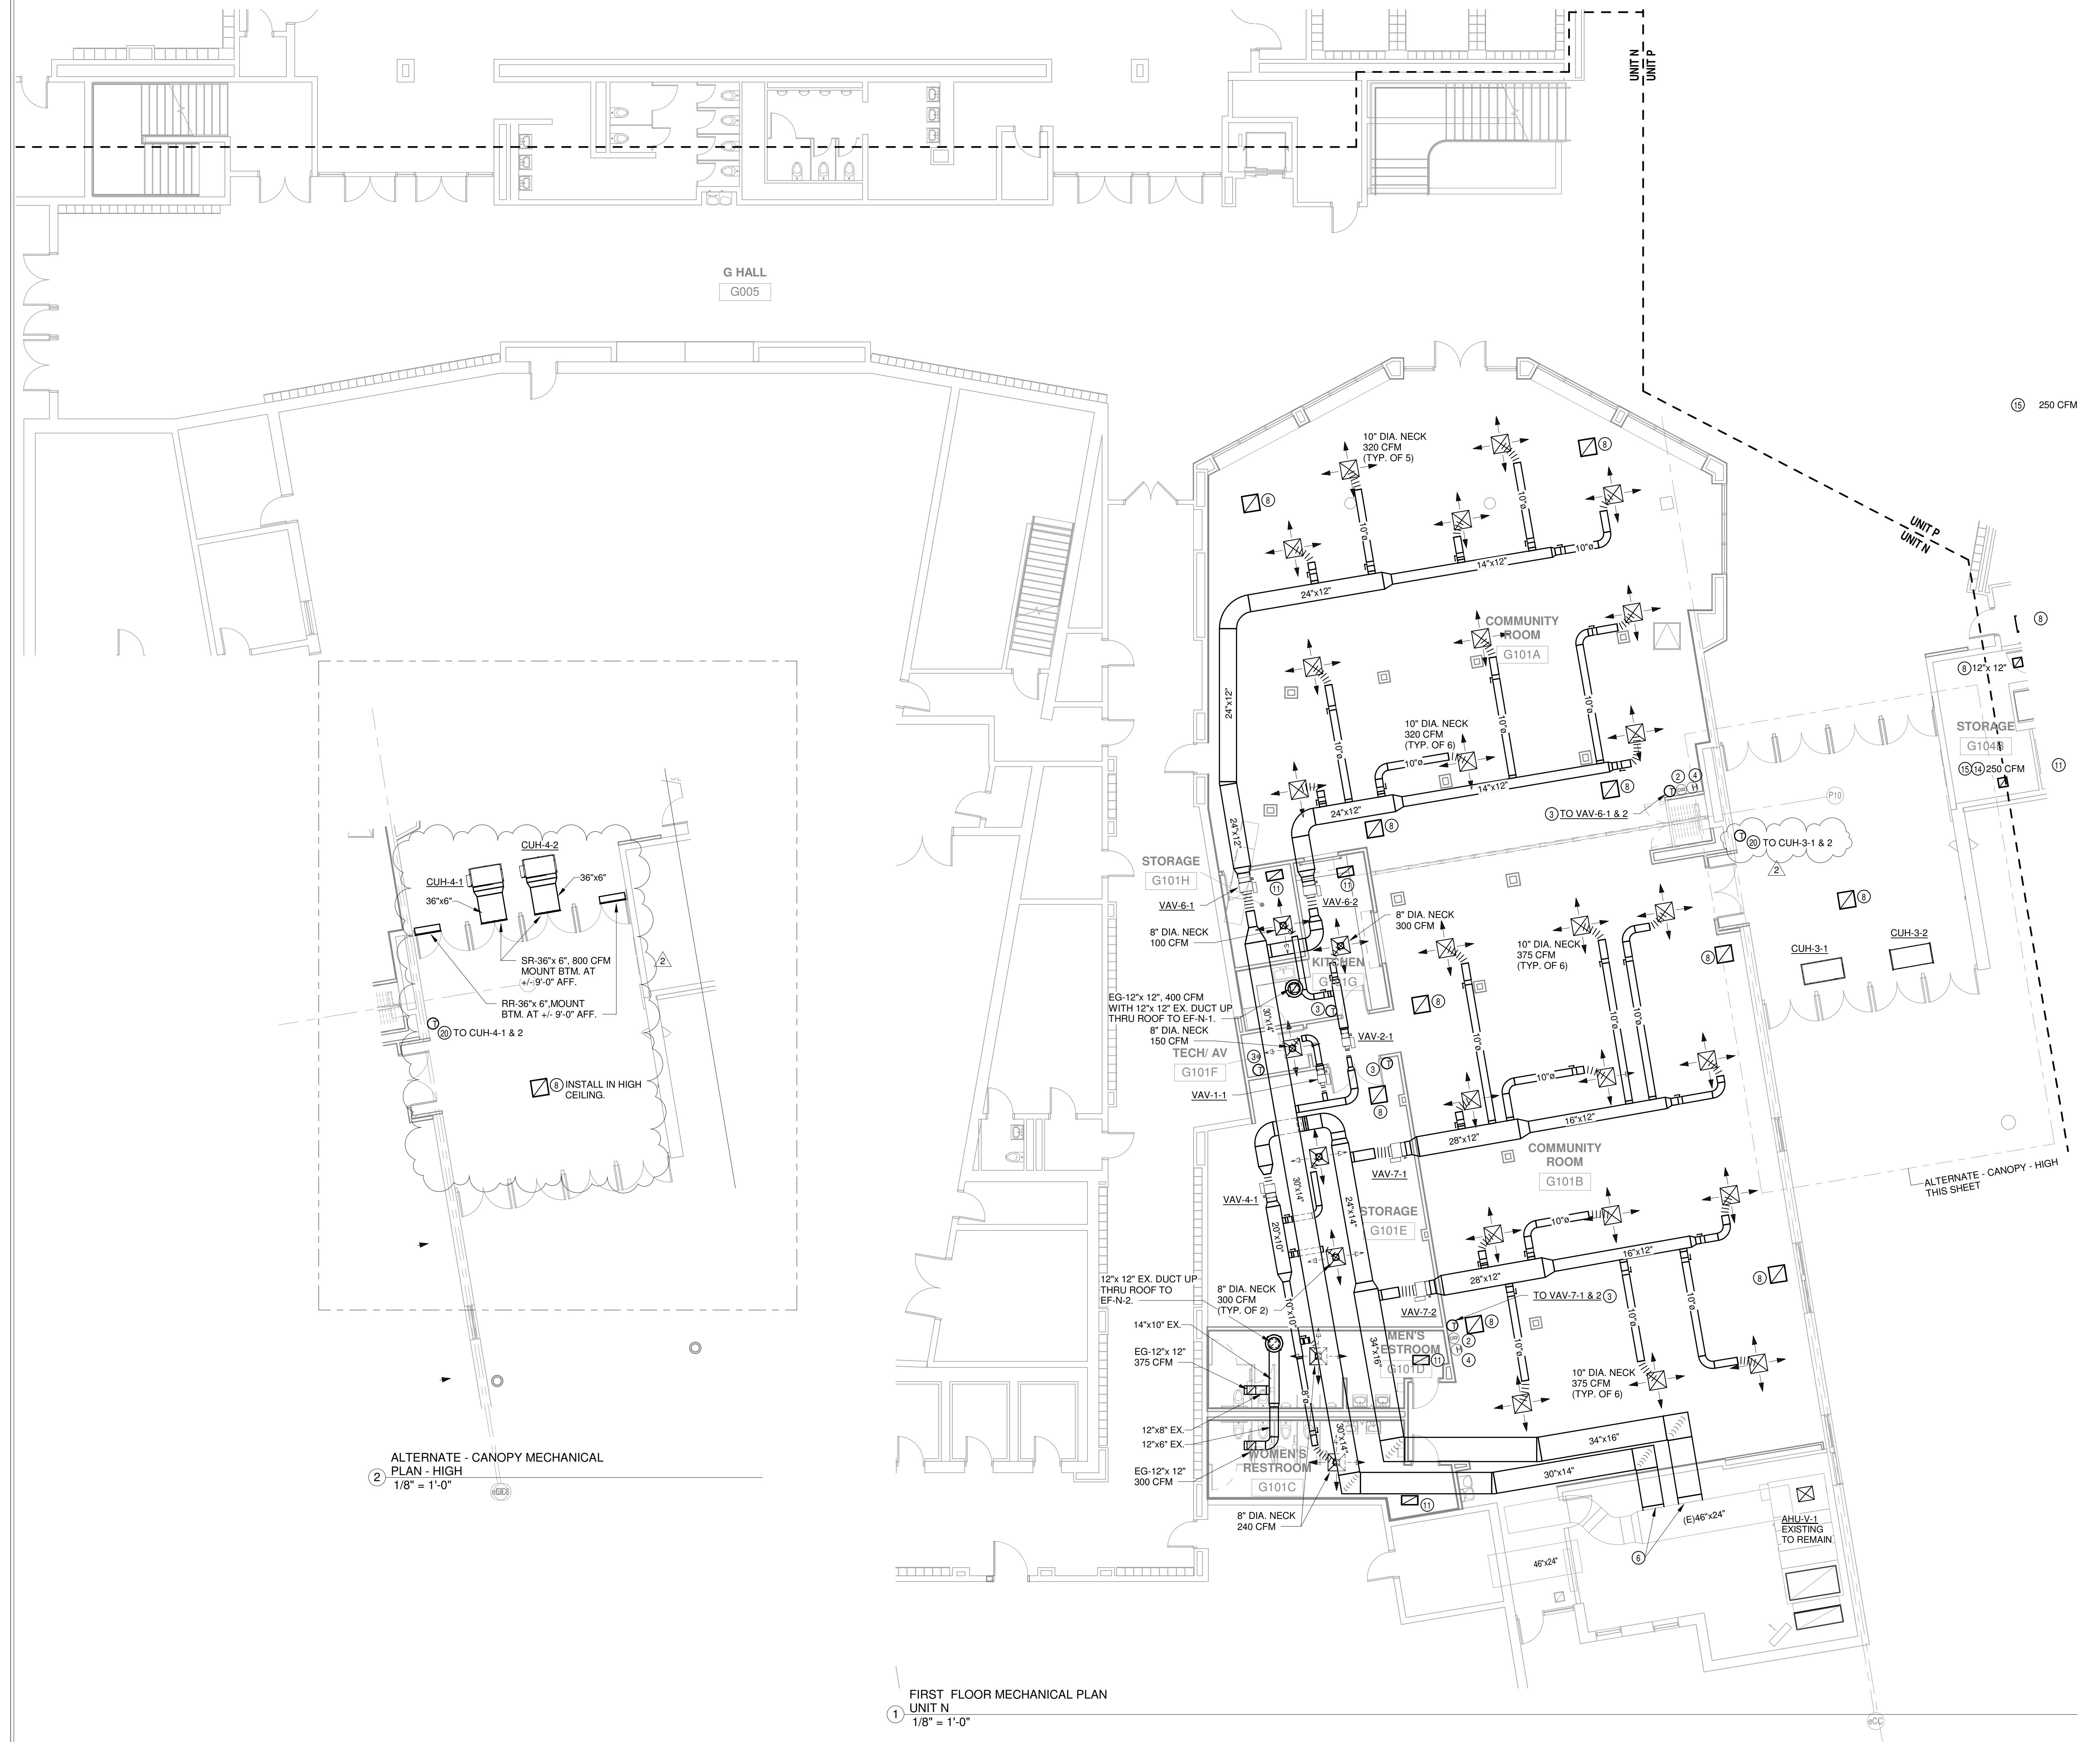

# MECHANICAL PLAN NOTES

NEW DDC TEMPERATURE SENSOR, INSTALLED AT EXISTING  
SENSOR LOCATION ON EXISTING WALL. SEE  
SPECIFICATIONS SECTION 230900

NEW DDC CARBON DIOXIDE SENSOR NEXT TO EXISTING  
TEMPERATURE SENSOR. INSTALL CONTROL WIRING IN  
EXISTING WALL AS REQUIRED TO CONCEAL FROM VIEW.  
SEE SPECIFICATIONS SECTION 230900.

NEW DDC TEMPERATURE SENSOR ON NEW WALL. SEE  
ARCHITECTURAL DRAWINGS FOR WALL CONSTRUCTION.  
SEE SPECIFICATIONS SECTION 230900.

NEW DDC HUMIDITY SENSOR ON NEW WALL. SEE  
ARCHITECTURAL DRAWINGS FOR WALL CONSTRUCTION.  
SEE SPECIFICATIONS SECTION 230900.

CONNECT NEW FLEXIBLE DUCT FROM NEW SUPPLY AIR  
DIFFUSER TO EXISTING RIGID SUPPLY AIR DUCT AS  
REQUIRED..

CONNECT NEW SUPPLY AIR DUCT TO EXISTING SUPPLY AIR  
DUCT AS REQUIRED.

CONNECT NEW EXHAUST DUCT TO EXISTING EXHAUST  
DUCT AS REQUIRED.

NEW RETURN/ RELIEF GRILLE RG-24"x 24" (U.N.O.).

CONNECT NEW OUTSIDE AIR DUCT TO EXISTING OUTSIDE  
DUCT AS REQUIRED.

LEAN AND RELOCATE EXISTING SUPPLY AIR DIFFUSER TO  
NEW CEILING GRID.

NEW RETURN/ RELIEF GRILLE RG-24"x 12".

PROVIDE GRILLE WITH DRYWALL FRAME.

CONNECT NEW SUPPLY AIR DIFFUSER TO EXISTING  
DUCTWORK AS REQUIRED.

NEW EXHAUST GRILLE EG-12"x 12" (U.N.O.). FIELD VERIFY  
EXISTING EXHAUST GRILLE SIZE.

CONNECT NEW EXHAUST GRILLE TO EXISTING DUCTWORK  
AS REQUIRED.

CONNECT NEW RETURN AIR GRILLE TO EXISTING RETURN  
DUCTWORK AS REQUIRED.

EXISTING 16"x 8" (U.N.O.) RELIEF AIR TRANSFER DUCT.

NEW 20"x 10" (U.N.O.) RELIEF AIR TRANSFER DUCTWORK.

INSTALL EXISTING SUPPLY AIR DIFFUSER IN NEW  
CEILING GRID.

NEW DDC TEMPERATURE SENSOR, INSTALLED ON EXISTING  
WALL, CONCEAL CONTROL WIRING IN WALL AS REQUIRED.

PROVIDE NEW NETWORKED DIGITAL CONTROLLER, LOW  
VOLT PROTECTION, WALL TEMPERATURE AND CO<sub>2</sub> SENSOR  
AND ACTUATORS. EXISTING DAMPERS AND VALVES TO  
REMAIN. PROVIDE NEW SEQUENCE WITH CO<sub>2</sub> OUTSIDE AIR  
CONTROL.

NEW LOCATION OF EXISTING TEMPERATURE SENSOR.  
REWORK/ EXTEND CONTROL WIRING AS REQUIRED.

"x 8" (U.N.O.) OUTDOOR AIR DUCT DOWN TO VERTICAL  
UNIT VENTILATOR.

"x 8" (U.N.O.) OUTDOOR AIR DUCT UP TO SECOND FLOOR.

"x 8" (U.N.O.) OUTDOOR AIR DUCT UP THRU EXISTING  
ROOF TO NEW OUTDOOR AIR INTAKE HOOD. SEE SHEET  
M204 FOR CONTINUATION.

"x 20" (U.N.O) OUTSIDE AIR DUCT UP THRU EXISTING  
ROOF TO NEW OUTDOOR AIR INTAKE HOOD. SEE SHEET  
M204 FOR CONTINUATION.

"x 8" (U.N.O.) OUTDOOR AIR DUCT UP FROM FIRST FLOOR.

"x 10" OUTDOOR AIR DUCT FROM VERTICAL UNIT  
VENTILATOR UP THRU EXISTING ROOF TO NEW 14"x 18"  
THROAT OUTDOOR AIR INTAKE HOOD. SEE SHEET M204  
FOR CONTINUATION.

"x 48" OUTDOOR AIR DUCT UP THRU EXISTING ROOF TO  
NEW 30"x 48" THROAT OUTDOOR AIR INTAKE HOOD. SEE  
SHEET M204 FOR CONTINUATION.

OUTDOOR AIR LOUVER PROVIDED BY THE ARCHITECT,  
MECHANICAL CONTRACTOR TO PROVIDE SHEET METAL  
SLEEVE FROM VERTICAL UNIT VENTILATOR TO LOUVER AS  
REQUIRED.

DIA. GALVANIZED DUCT WITH TAPED JOINTS FROM  
VENTILATOR TO UP THRU EXISTING ROOF. TERMINATE WITH  
SOSENECK AS REQUIRED.

"x 8" OUTSIDE AIR DUCT FROM 44"x 29" PLENUM AT  
LOUVER (BY THE ARCHITECT) TO VERTICAL UNIT  
VENTILATOR CONNECTION. VERIFY LOUVER SIZE WITH THE  
GENERAL CONTRACTOR FOR PLENUM SIZE.

**SCOPE DRAWINGS:**  
These drawings indicate the general scope of the project, the forms of architectural design concept, the dimensions of building, the major architectural elements and the type of structural, mechanical and electrical systems. The drawings do not necessarily indicate or describe all work required for full performance and completion of the requirements of the Contract. On the basis of the general scope indicated or described, trade contractors shall furnish all items required for the proper execution and completion of the work.

## REVISIONS:

ISSUE DATE	DRAWN BY	CHECKED BY
------------	----------	------------

DRAWING TITLE:  
**FIRST FLOOR  
MECHANICAL  
PLAN - UNIT N**

A circular stamp with a double concentric border. The outer border contains the text "WOODLAND WARD HOLM" at the top and "PROFESSIONAL ENGINEER" at the bottom, separated by a horizontal line. The inner border contains the text "REGISTERED" at the top and "STATE OF INDIANA" at the bottom, separated by a horizontal line. The center of the stamp contains the text "No. PE60021458" above "STATE OF INDIANA".

DRAWING NUMBER  
**M201N**  
PROJECT NUMBER  
**2021056/1407**

8831 Keystone Crossing, Indianapolis, IN 46240  
317.848.7800 | [csoinc.net](http://csoinc.net)

100



**SCSO**  
MECHANICAL / ELECTRICAL ENGINEERS

8831 Keystone Crossing, Indianapolis, IN 46240  
© 2020 SCSO Architects, Inc. All Rights Reserved

**STAIR**  
ASSOCIATES INC.  
MECHANICAL / ELECTRICAL ENGINEERS

317.448.7800 | csco.net

**WARREN CENTRAL HIGH SCHOOL**  
PROJECT:  
PHASE 3 ADDITION & RENOVATION  
9500 E. 16th STREET, INDIANAPOLIS, IN 46229

9601 Commerce Drive, Indianapolis, IN 46240

**SCOPE DRAWINGS:**  
These drawings are a part of the overall scope of the project.  
In terms of architectural design concept, the dimensions of the structure, mechanical and electrical systems, and the location of the equipment and piping shall be described all in accordance with the requirements of the Contract.  
The architect shall furnish all items indicated or required, the trade contractors shall furnish all items required for the proper execution and completion of the work.


**REVISIONS:**  
2 ADDENDUM #2 03/13/2023

ISSUE DATE: 02/20/23 DRAWN BY: RWT CHECKED BY: WWH

**DRAWING TITLE:**  
**SECOND FLOOR**  
**MECHANICAL**  
**PLAN - UNITS H&J**

**CERTIFIED BY:**  
WILLARD  
REGISTERED  
PROFESSIONAL  
ENGINEER  
No. PE6002456  
State of Indiana  
Drawing Number M202HJ

PROJECT NUMBER  
2021056/1407

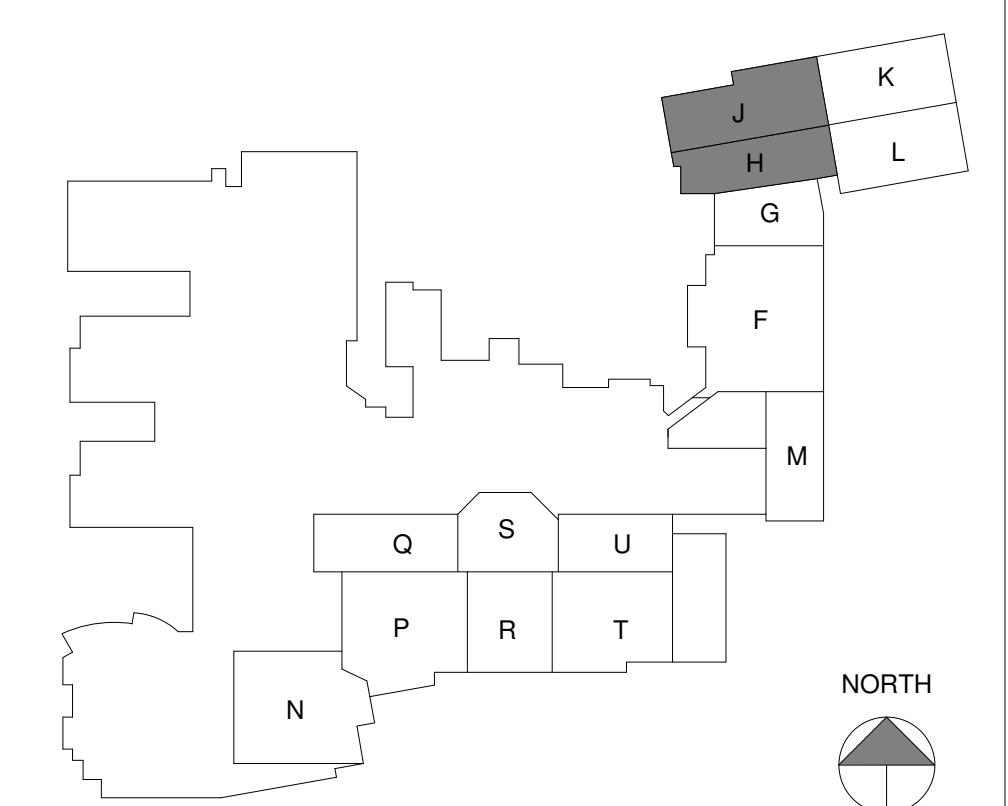



SCCSO  
SCCSO

8831 Keystone Crossing, Indianapolis, IN 46240  
© 2020 SCCSO Architects, Inc. All rights reserved.

STAIRS  
ASSOCIATES INC.  
MECHANICAL / ELECTRICAL ENGINEERS

PROJECT:  
WARREN CENTRAL HIGH SCHOOL  
PHASE 3 ADDITION & RENOVATION  
9500 E. 6th STREET, INDIANAPOLIS, IN 46229

## MECHANICAL PLAN NOTES

- 1 NEW DDC TEMPERATURE SENSOR, INSTALLED AT EXISTING SENSOR LOCATION ON EXISTING WALL. SEE SPECIFICATIONS SECTION 230900.
- 2 NEW DDC CARBON DIOXIDE SENSOR NEXT TO EXISTING TEMPERATURE SENSOR. INSTALL CONTROL WIRING IN EXISTING WALL AS REQUIRED TO CONCEAL FROM VIEW. SEE SPECIFICATIONS SECTION 230900.
- 3 NEW DDC TEMPERATURE SENSOR ON NEW WALL. SEE ARCHITECTURAL DRAWINGS FOR WALL CONSTRUCTION. SEE SPECIFICATIONS SECTION 230900.
- 4 NEW DDC HUMIDITY SENSOR ON NEW WALL. SEE ARCHITECTURAL DRAWINGS FOR WALL CONSTRUCTION. SEE SPECIFICATIONS SECTION 230900.
- 5 CONNECT NEW FLEXIBLE DUCT FROM NEW SUPPLY AIR DIFFUSER TO EXISTING RIGID SUPPLY AIR DUCT AS REQUIRED..
- 6 CONNECT NEW SUPPLY AIR DUCT TO EXISTING SUPPLY AIR DUCT AS REQUIRED.
- 7 CONNECT NEW EXHAUST DUCT TO EXISTING EXHAUST DUCT AS REQUIRED.
- 8 NEW RETURN/RELIEF GRILLE RG-24" x 24" (U.N.O.).
- 9 CONNECT NEW OUTSIDE AIR DUCT TO EXISTING OUTSIDE AIR DUCT AS REQUIRED.
- 10 CLEAN AND RELOCATE EXISTING SUPPLY AIR DIFFUSER TO NEW CEILING GRID.
- 11 NEW RETURN/RELIEF GRILLE RG-24" x 12".
- 12 PROVIDE GRILLE WITH DRYWALL FRAME.
- 13 CONNECT NEW SUPPLY AIR DIFFUSER TO EXISTING DUCTWORK AS REQUIRED.
- 14 NEW EXHAUST GRILLE EG-12" x 12" (U.N.O.). FIELD VERIFY EXISTING EXHAUST GRILLE SIZE.
- 15 CONNECT NEW EXHAUST GRILLE TO EXISTING DUCTWORK AS REQUIRED.
- 16 CONNECT NEW RETURN AIR GRILLE TO EXISTING RETURN AIR DUCTWORK AS REQUIRED.
- 17 EXISTING 16"x8" (U.N.O.) RELIEF AIR TRANSFER DUCT.
- 18 NEW 20"x10" (U.N.O.) RELIEF AIR TRANSFER DUCTWORK.
- 19 REINSTALL EXISTING SUPPLY AIR DIFFUSER IN NEW CEILING GRID.
- 20 NEW DDC TEMPERATURE SENSOR, INSTALLED ON EXISTING WALL. CONCEAL CONTROL WIRING IN WALL AS REQUIRED.
- 21 PROVIDE NEW NETWORKED DIGITAL CONTROLLER, LOW LIMIT PROTECTION, WALL TEMPERATURE AND CO2 SENSOR AND ACTUATORS. EXISTING DAMPERS AND VALVES TO REMAIN. PROVIDE NEW SEQUENCE WITH CO2 OUTSIDE AIR CONTROL.
- 22 NEW LOCATION OF EXISTING TEMPERATURE SENSOR. EXTEND CONTROL WIRING AS REQUIRED.
- 23 20"x8" (U.N.O.) OUTDOOR AIR DUCT DOWN TO VERTICAL UNIT VENTILATOR.
- 24 20"x10" (U.N.O.) OUTDOOR AIR DUCT UP TO SECOND FLOOR.
- 25 20"x8" (U.N.O.) OUTDOOR AIR DUCT UP THRU EXISTING ROOF TO NEW OUTDOOR AIR INTAKE HOOD. SEE SHEET M204 FOR CONTINUATION.
- 26 20"x20" (U.N.O.) OUTDOOR AIR DUCT UP THRU EXISTING ROOF TO NEW OUTDOOR AIR INTAKE HOOD. SEE SHEET M204 FOR CONTINUATION.
- 27 20"x8" (U.N.O.) OUTDOOR AIR DUCT UP FROM FIRST FLOOR.
- 28 20"x10" OUTDOOR AIR DUCT FROM VERTICAL UNIT VENTILATOR UP THRU EXISTING ROOF TO NEW 14"x18" THROAT OUTDOOR AIR INTAKE HOOD. SEE SHEET M204 FOR CONTINUATION.
- 29 30"x48" OUTDOOR AIR DUCT UP THRU EXISTING ROOF TO NEW 30"x48" THROAT OUTDOOR AIR INTAKE HOOD. SEE SHEET M204 FOR CONTINUATION.
- 30 OUTDOOR AIR LOUVER PROVIDED BY THE ARCHITECT, MECHANICAL CONTRACTOR TO PROVIDE SHEET METAL SLEEVE FROM VERTICAL UNIT VENTILATOR TO LOUVER AS REQUIRED.
- 31 4" DIA. GALVANIZED DUCT WITH TAPED JOINTS FROM DRYER TO UP THRU EXISTING ROOF. TERMINATE WITH GOOSENECK AS REQUIRED.
- 32 20"x8" OUTSIDE AIR DUCT FROM 44"x29" PLENUM AT LOUVER (BY THE ARCHITECT) TO VERTICAL UNIT VENTILATOR CONNECTION. VERIFY LOUVER SIZE WITH THE GENERAL CONTRACTOR FOR PLENUM SIZE.

SCOPE DRAWINGS:  
These drawings define the scope of the project in terms of the architectural design concept, the dimensions of the structure, and the location of the mechanical and electrical systems. They are intended to provide a clear description of all the requirements of the Contract.  
The drawings and specifications included in this scope indicate or describe the trade contractors shall furnish all items required for the proper execution and completion of the work.

REVISIONS:

2 ADDENDUM #2 03/13/2023


ISSUE DATE: 02/20/23 DRAWN BY: RWT CHECKED BY: WWH

DRAWING TITLE:  
SECOND FLOOR  
MECHANICAL  
PLAN - UNIT N

CERTIFIED BY:  
WARD  
NO. PE6002456  
STATE OF INDIANA  
PROFESSIONAL ENGINEER

DRAWING NUMBER  
M202N

PROJECT NUMBER  
2021056/1407

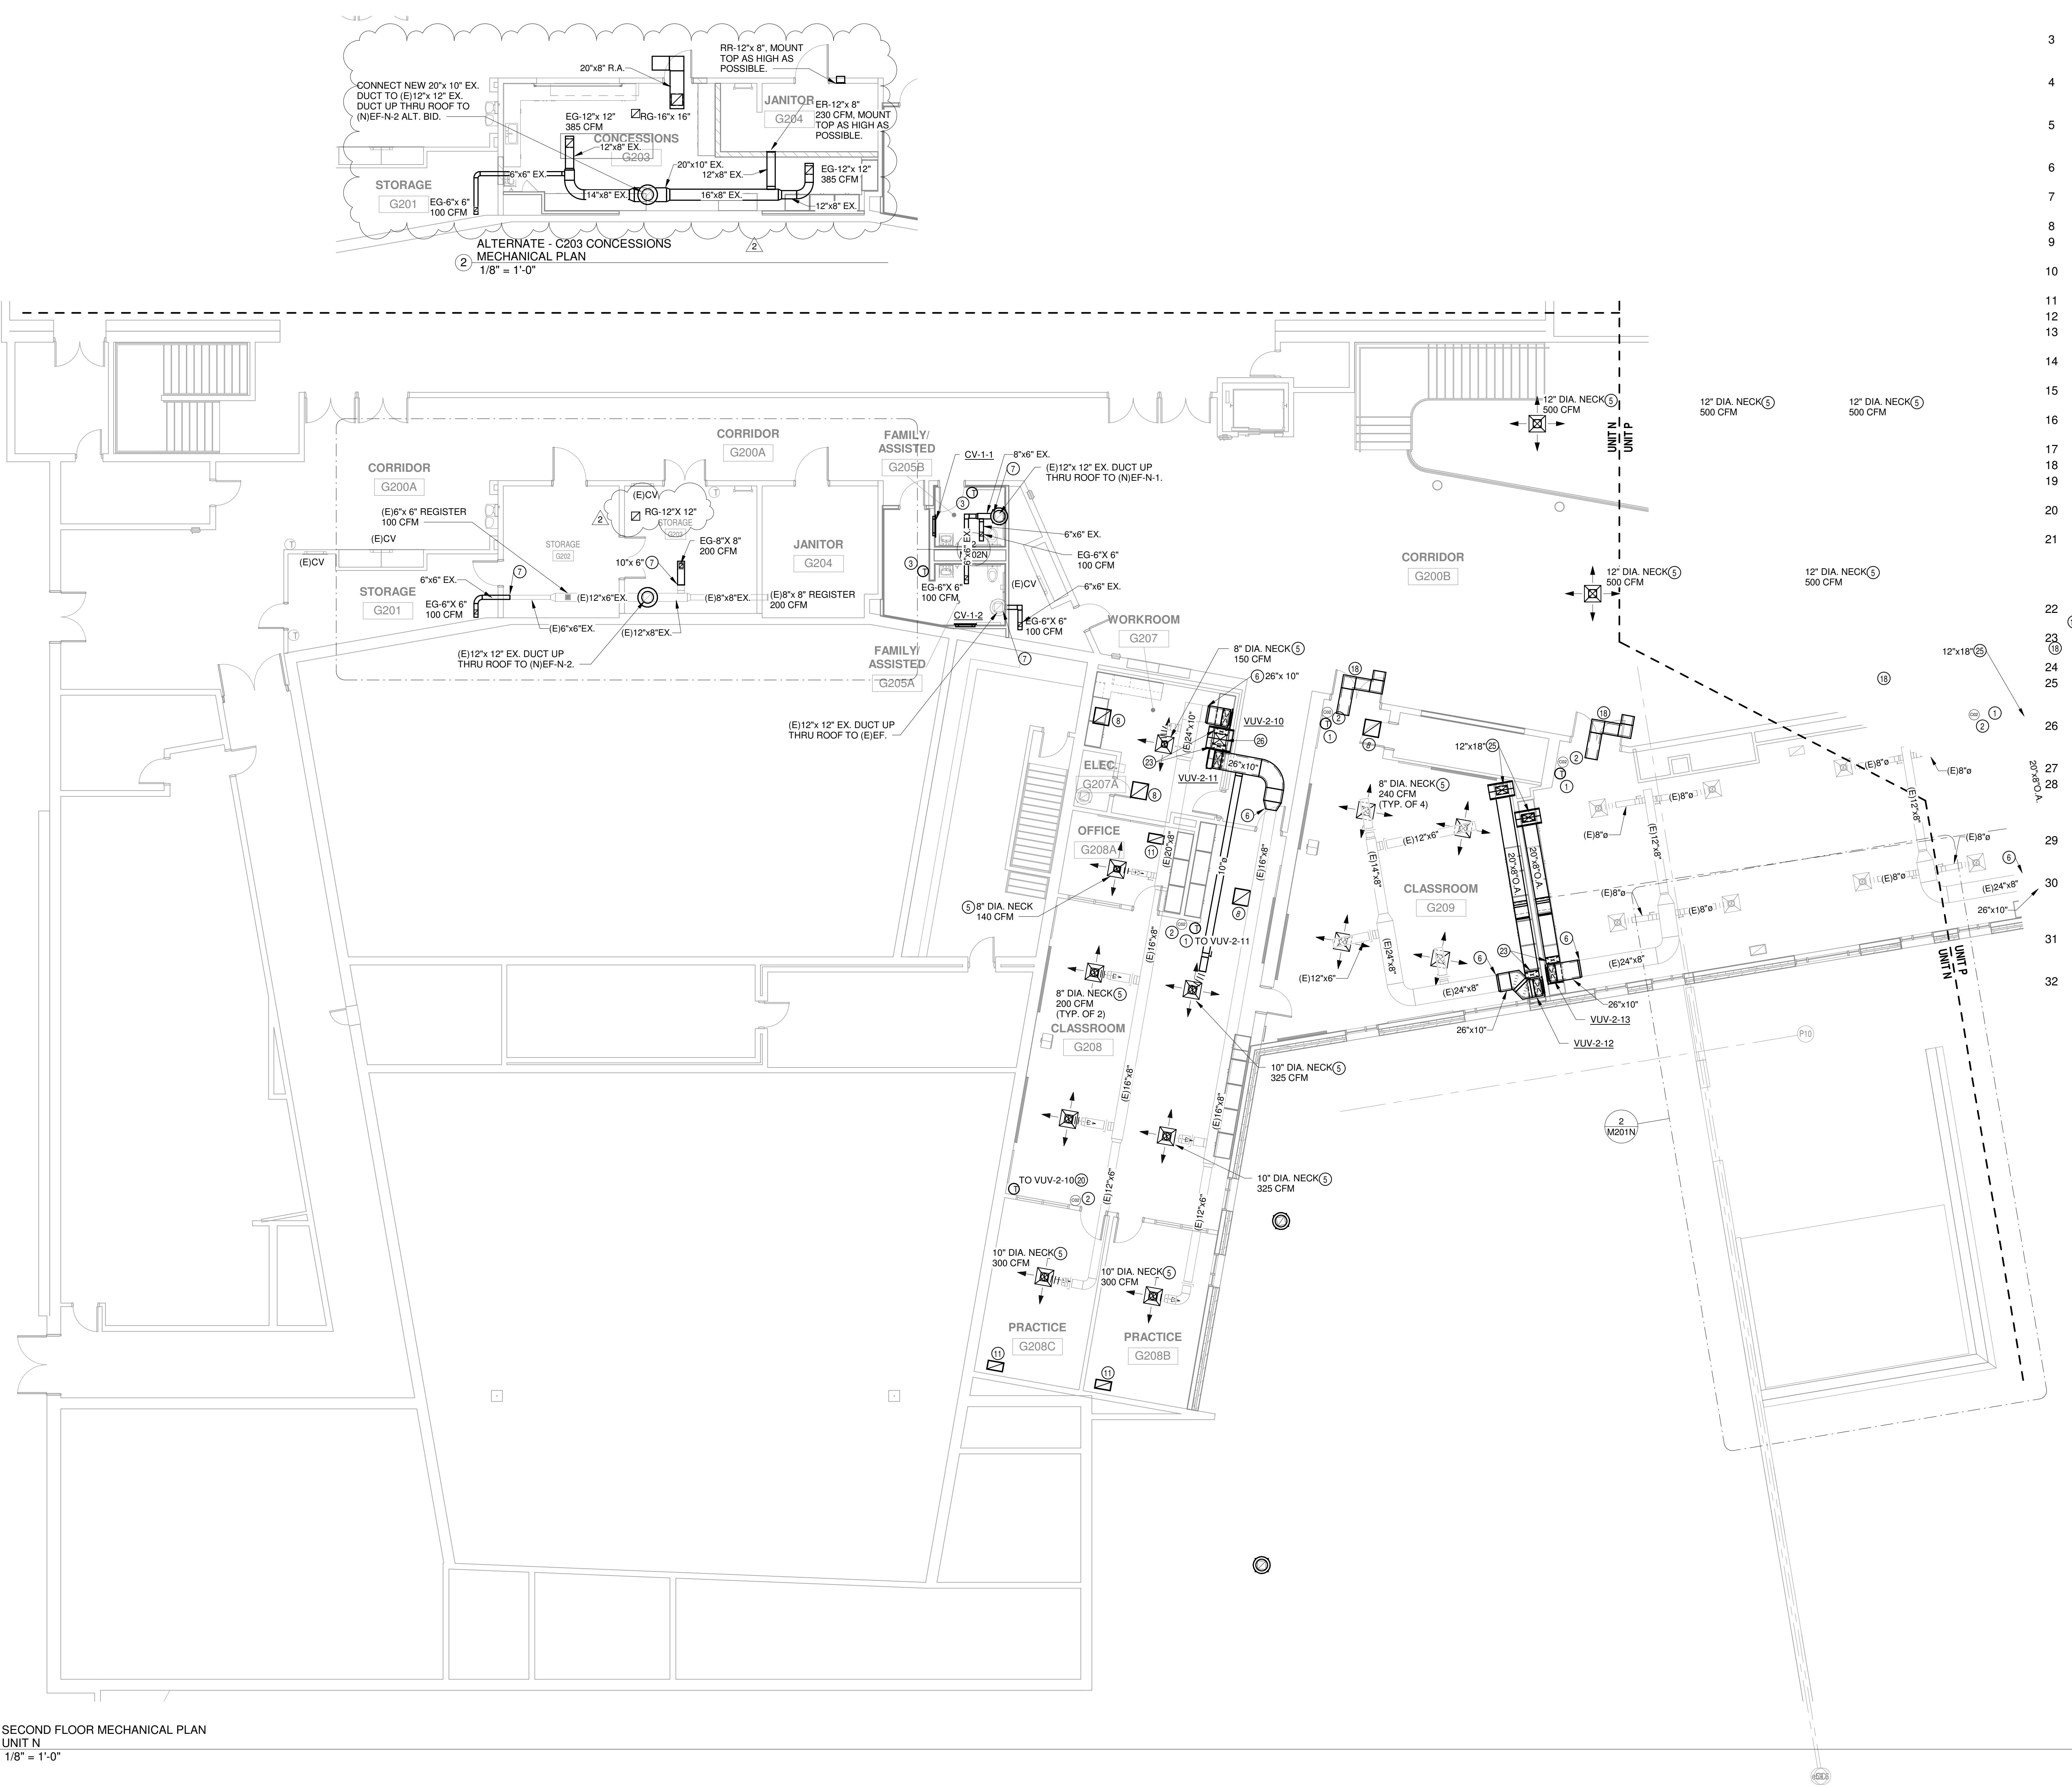



○  
S  
C  
S

8831 Keystone Crossing, Indianapolis, IN 46240  
317.848.7800 | [csoinc.net](http://csoinc.net)

www.csotech.com

# WARREN CENTRAL HIGH SCHOOL

## PHASE 3 ADDITION & RENOVATION

**SCOPE DRAWINGS:**  
These drawings indicate the general scope of the project, the general form of architectural design concept, the dimensions of the building, the major architectural elements and the type of structural, mechanical and electrical systems. The drawings do not necessarily indicate or describe all required for full performance and completion of the requirements of the Contract. On the basis of the general scope indicated or described, trade contractors shall furnish all items required for the proper execution and completion of the work.

## REVISIONS:

ISSUE DATE DRAWN BY CHECKED BY

DRAWING TITLE:  
**FIRST FLOOR  
MECHANICAL  
PIPING PLAN -  
UNIT F**

A circular engineering seal. The outer ring contains the text "CERTIFIED BY:" at the top and "PROFESSIONAL ENGINEER" at the bottom. Inside this is another ring with "WOODLAND WARD HOLM" at the top and "REGISTERED" at the bottom. The center of the seal contains "No. PE60021458" above "STATE OF INDIANA". Below the state text is a handwritten signature.

DRAWING NUMBER  
**M211F**

PROJECT NUMBER  
**2021056/1407**

1/8" = 1'-0"

FIRST FLOOR MECHANICAL PIPING PLAN - UNIT F

CONNECT NEW 1" HEATING AND 2" CHILLED WATER LINES TO (E1 1/4" HEATING AND (E2) CHILLED WATER LINES AS REQUIRED.

PROVIDE NEW CONCRETE PAD EXTENSION FOR NEW AHU ON FRONT AND LEFT SIDE OF UNIT. MATCH EXISTING PAD HEIGHT. NEW PADS APPROXIMATELY FRONT 2'x 5'x 4" THICK, LEFT 1x 12'6" x 4" THICK, 4000 PSI CONCRETE AND DOWELL TO EXISTING CONCRETE PADS.

CONNECT NEW HEATING WATER LINES TO (E) HEATING WATER LINES AS REQUIRED.

3/4" 3/4"

UNIT F UNIT M



○ S C S

8831 Keystone Crossing, Indianapolis, IN 46240  
317.848.7800 | csoinc.net

**STAIR**  
ASSOCIATES INC.

MECHANICAL / ELECTRICAL ENGINEERS

WARREN CENTRAL HIGH SCHOOL  
PHASE 3 ADDITION & RENOVATION  
9500 E. 16th STREET, INDIANAPOLIS, IN 46229

**SCOPE DRAWINGS:**  
These drawings indicate the general scope of the project in terms of architectural design concept, the dimensions of the building, the major architectural elements and the type of structural, mechanical and electrical systems. The drawings do not necessarily indicate or describe all work required for full performance and completion of the requirements of the Contract. On the basis of the general scope indicated or described, trade contractors shall furnish all items required for the execution and completion of the work.

REVISIONS:

DRAWING TITLE:  
**FIRST FLOOR  
MECHANICAL  
PIPING PLAN -  
UNIT H**

A circular registration stamp. The outer ring contains the text "WOODLAND WARD HOLM" at the top and "PROFESSIONAL ENGINEER" at the bottom, separated by a dotted line. The inner circle contains "No. PE60021458" in the center, "STATE OF" above it, and "INDIANA" below it. The word "REGISTERED" is positioned vertically along the inner dotted line. The entire stamp is enclosed in a circular border with a dotted pattern.

DRAWING NUMBER  
**M211H**

PROJECT NUMBER  
**2021056/1407**

**FIRST FLOOR MECHANICAL PIPING PLAN - UNIT H**

1 1/8" = 1'-0"

CONNECT NEW 1 1/2" HEATING WATER LINES TO EXISTING 2" HEATING WATER LINES AS REQUIRED.

CONNECT NEW UNIT HEATER TO EXISTING HEATING WATER LINES AS REQUIRED. SEE SHEET M302 FOR PIPING DETAIL.

CONNECT NEW UNIT HEATER TO EXISTING 1" HEATING WATER LINES AS REQUIRED. SEE SHEET M302 FOR PIPING DETAIL.

CONNECT NEW UNIT HEATER TO EXISTING HEATING WATER LINES AS REQUIRED. SEE SHEET M302 FOR PIPING DETAIL.

CONNECT NEW CONVECTOR TO EXISTING 3/4" HEATING WATER LINES AS REQUIRED. SEE SHEET M302 FOR PIPING DETAIL.

CONNECT NEW UNIT HEATER TO EXISTING HEATING WATER LINES AS REQUIRED. SEE SHEET M302 FOR PIPING DETAIL.

DASHED LINE INDICATES MEZZANINE ABOVE. SEE SHEET M212HJ FOR MEZZANINE.

DASHED LINE INDICATES MEZZANINE ABOVE. SEE SHEET M212HJ FOR MEZZANINE.

CONNECT NEW UNIT HEATER TO EXISTING HEATING WATER LINES AS REQUIRED. SEE SHEET M302 FOR PIPING DETAIL.

CONNECT NEW FAN COIL UNIT TO EXISTING 1" HEATING AND 1" CHILLED WATER LINES AS REQUIRED. SEE SHEET M302 FOR PIPING DETAIL.

CONNECT NEW UNIT HEATER TO EXISTING HEATING WATER LINES AS REQUIRED. SEE SHEET M302 FOR PIPING DETAIL.

CONNECT NEW 1 1/2" HEATING WATER LINES TO EXISTING 2" HEATING WATER LINES AS REQUIRED.

UNIT J  
UNIT H

OFFICE W336C

OFFICE W330

BUILDING STORAGE 333

PAPER STORAGE W331

ETE OFFICE W353

CONFERENCE W353A

CORRIDOR W000J

OFFICE W353B

OFFICE W351

CORRIDOR WXXXX

STORAGE W349

FCU-1-3

OFFICE W348D

MEN'S LOCKER RESTROOM W348B

STORAGE W348C

M/E W350A

VAV-1-2

VAV-1-3

VAV-3-2

VAV-4-5

3/4" 3/4"

3/4"

UNIT H  
UNIT G (B14)

UNIT J  
UNIT H

UNIT K

UH-5-1

UH-2-4

UH-3-1

UH-4-1

UH-4-2

UH-4-3

UH-4-4

UH-2-3

CV-1-3

CV-1-4

U1

U2

U3

U756


U757

U758

U759

U760

U7

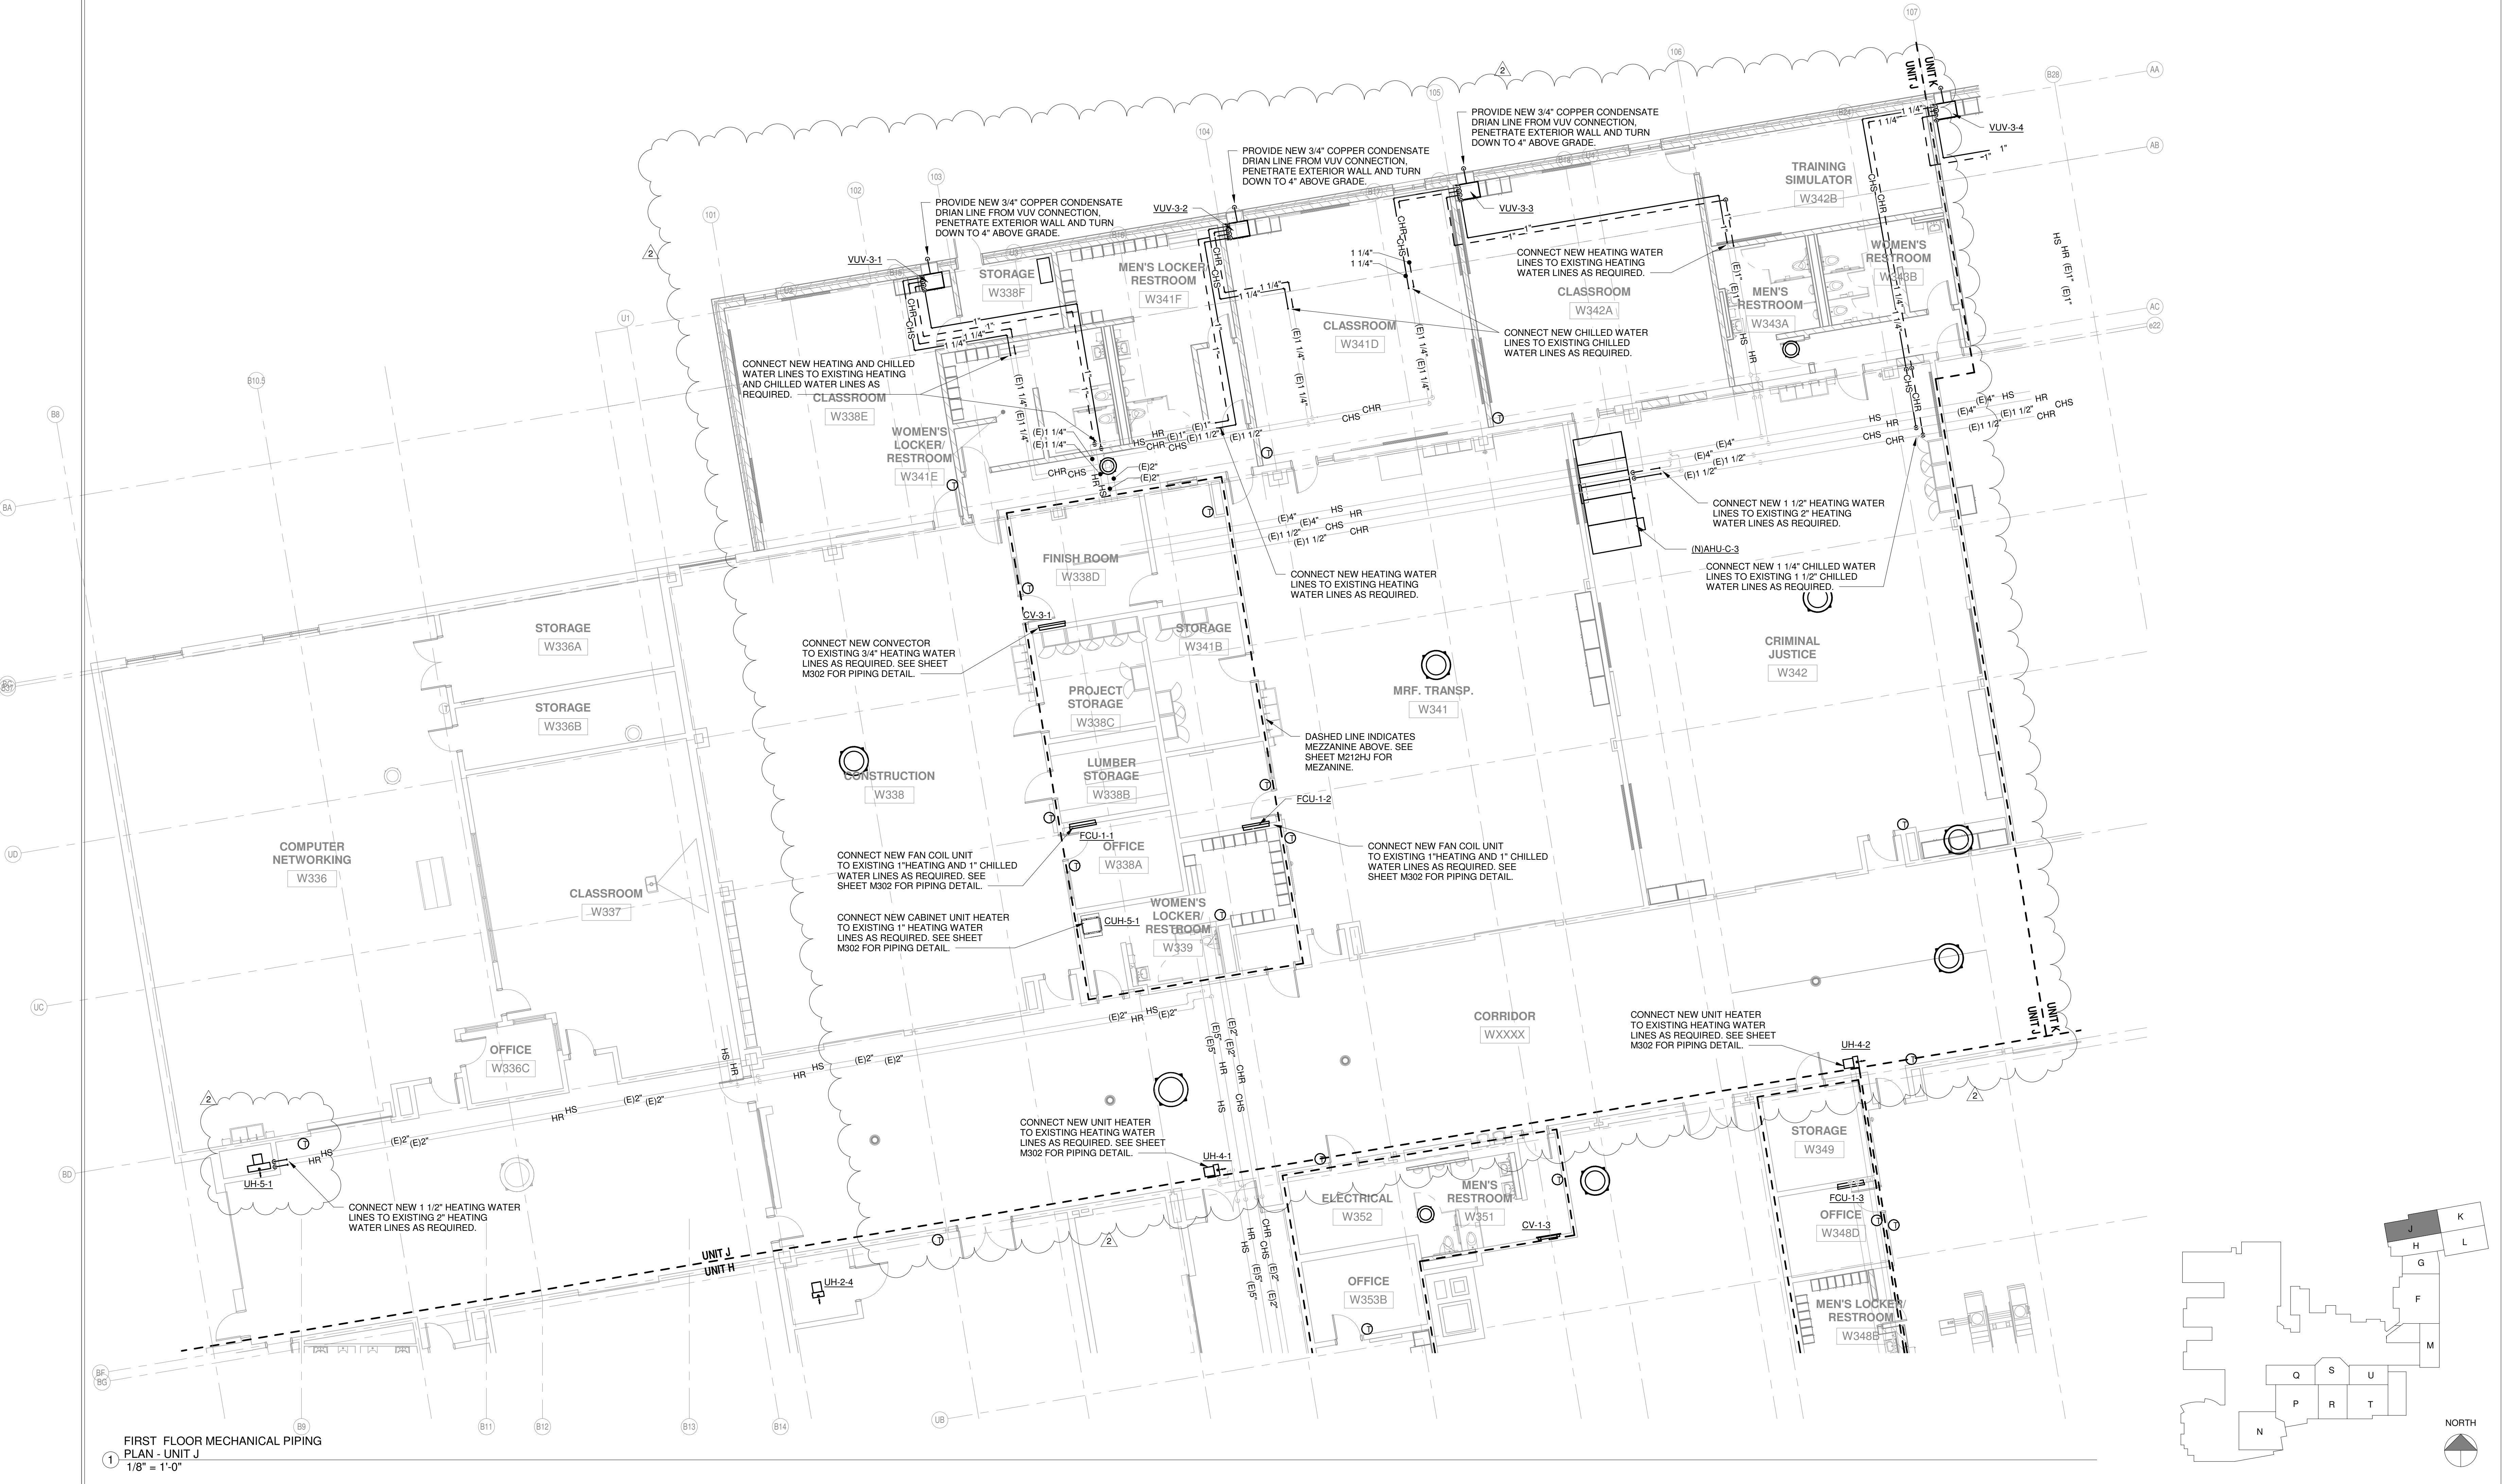



○ S C S

8831 Keystone Crossing, Indianapolis, IN 46240  
317.848.7800 | csoinc.net

# MECHANICAL / ELECTRICAL ENGINEERS

WARREN CENTRAL HIGH SCHOOL  
PHASE 3 ADDITION & RENOVATION  
9500 E. 16th STREET, INDIANAPOLIS, IN 46229

**SCOPE DRAWINGS:**  
These drawings indicate the general scope of the project, the forms of architectural design concept, the dimensions of the building, the major architectural elements and the type of structural, mechanical and electrical systems. The drawings do not necessarily indicate or describe all the work required for full performance and completion of the requirements of the Contract. On the basis of the general scope indicated or described, trade contractors shall furnish all items required for the proper execution and completion of the work.

ISSUE DATE DRAWN BY CHECKED BY

DRAWING TITLE:  
**FIRST FLOOR  
MECHANICAL  
PIPING PLAN -  
UNIT K**

CERTIFIED BY:  
WOODLAND WARD HOLM  
REGISTERED  
No. PE60021458  
STATE OF INDIANA  
PROFESSIONAL ENGINEER  
\* \* \*

Woodward Holm

DRAWING NUMBER  
**M211K**

PROJECT NUMBER  
**2021056/1407**



○ S C S

8831 Keystone Crossing, Indianapolis, IN 46240  
317.848.7800 | csoinc.net

卷之三

WARREN CENTRAL HIGH SCHOOL  
PHASE 3 ADDITION & RENOVATION  
9500 E. 16th STREET, INDIANAPOLIS, IN 46229

**SCOPE DRAWINGS:**  
These drawings indicate the general scope of the project, the forms of architectural design concept, the dimensions of the building, the major architectural elements and the type of structural, mechanical and electrical systems. The drawings do not necessarily indicate or describe all the work required for full performance and completion of the requirements of the Contract. On the basis of the general scope indicated or described, trade contractors shall furnish all items required for the proper execution and completion of the work.

## REVISIONS:

DRAWING TITLE:  
**FIRST FLOOR  
MECHANICAL  
PIPING PLAN -  
UNIT L**

The seal is circular with a double-lined outer border. The top half of the outer border contains the text "CERTIFIED BY:" and the bottom half contains "REGISTERED". The inner circle has a dotted border. The top half of the inner circle contains "WOODLAND WARD HOLM" and the bottom half contains "PROFESSIONAL ENGINEER". The center of the seal contains the text "No. PE60021458" above "STATE OF INDIANA".

DRAWING NUMBER  
**M211L**


PROJECT NUMBER  
**2021056/1407**



**SCSO**

Keystone Crossing, Indianapolis, IN 46240

© 2020 SCSO Architects, Inc. All Rights Reserved

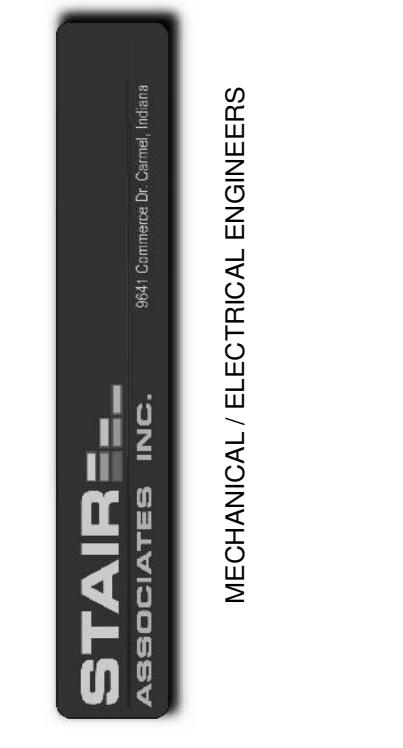

WARREN CENTRAL HIGH SCHOOL

PHASE 3 ADDITION & RENOVATION

9500 E. 6th STREET, INDIANAPOLIS, IN 46229


SCOPE DRAWINGS:  
These drawings are a scope of the project in terms of architectural design concept, the dimensions of structural, mechanical and electrical systems. The drawings are not intended to describe all the requirements of the Contract. The drawings and scope indicated or implied, the trade contractors shall furnish all items required for the proper execution and completion of the work.

REVISIONS:

2 ADDENDUM #2	03/13/2023
---------------	------------


ISSUE DATE: 02/20/23 DRAWN BY: RWT CHECKED BY: WWH

DRAWING TITLE:  
**FIRST FLOOR  
MECHANICAL  
PIPING PLAN -  
UNIT N**

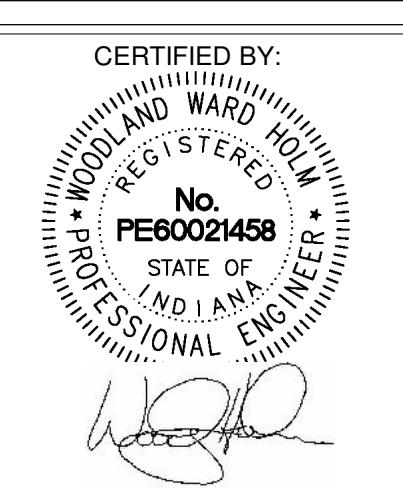

DRAWING NUMBER  
**M21N**

PROJECT NUMBER  
**2021056/1407**

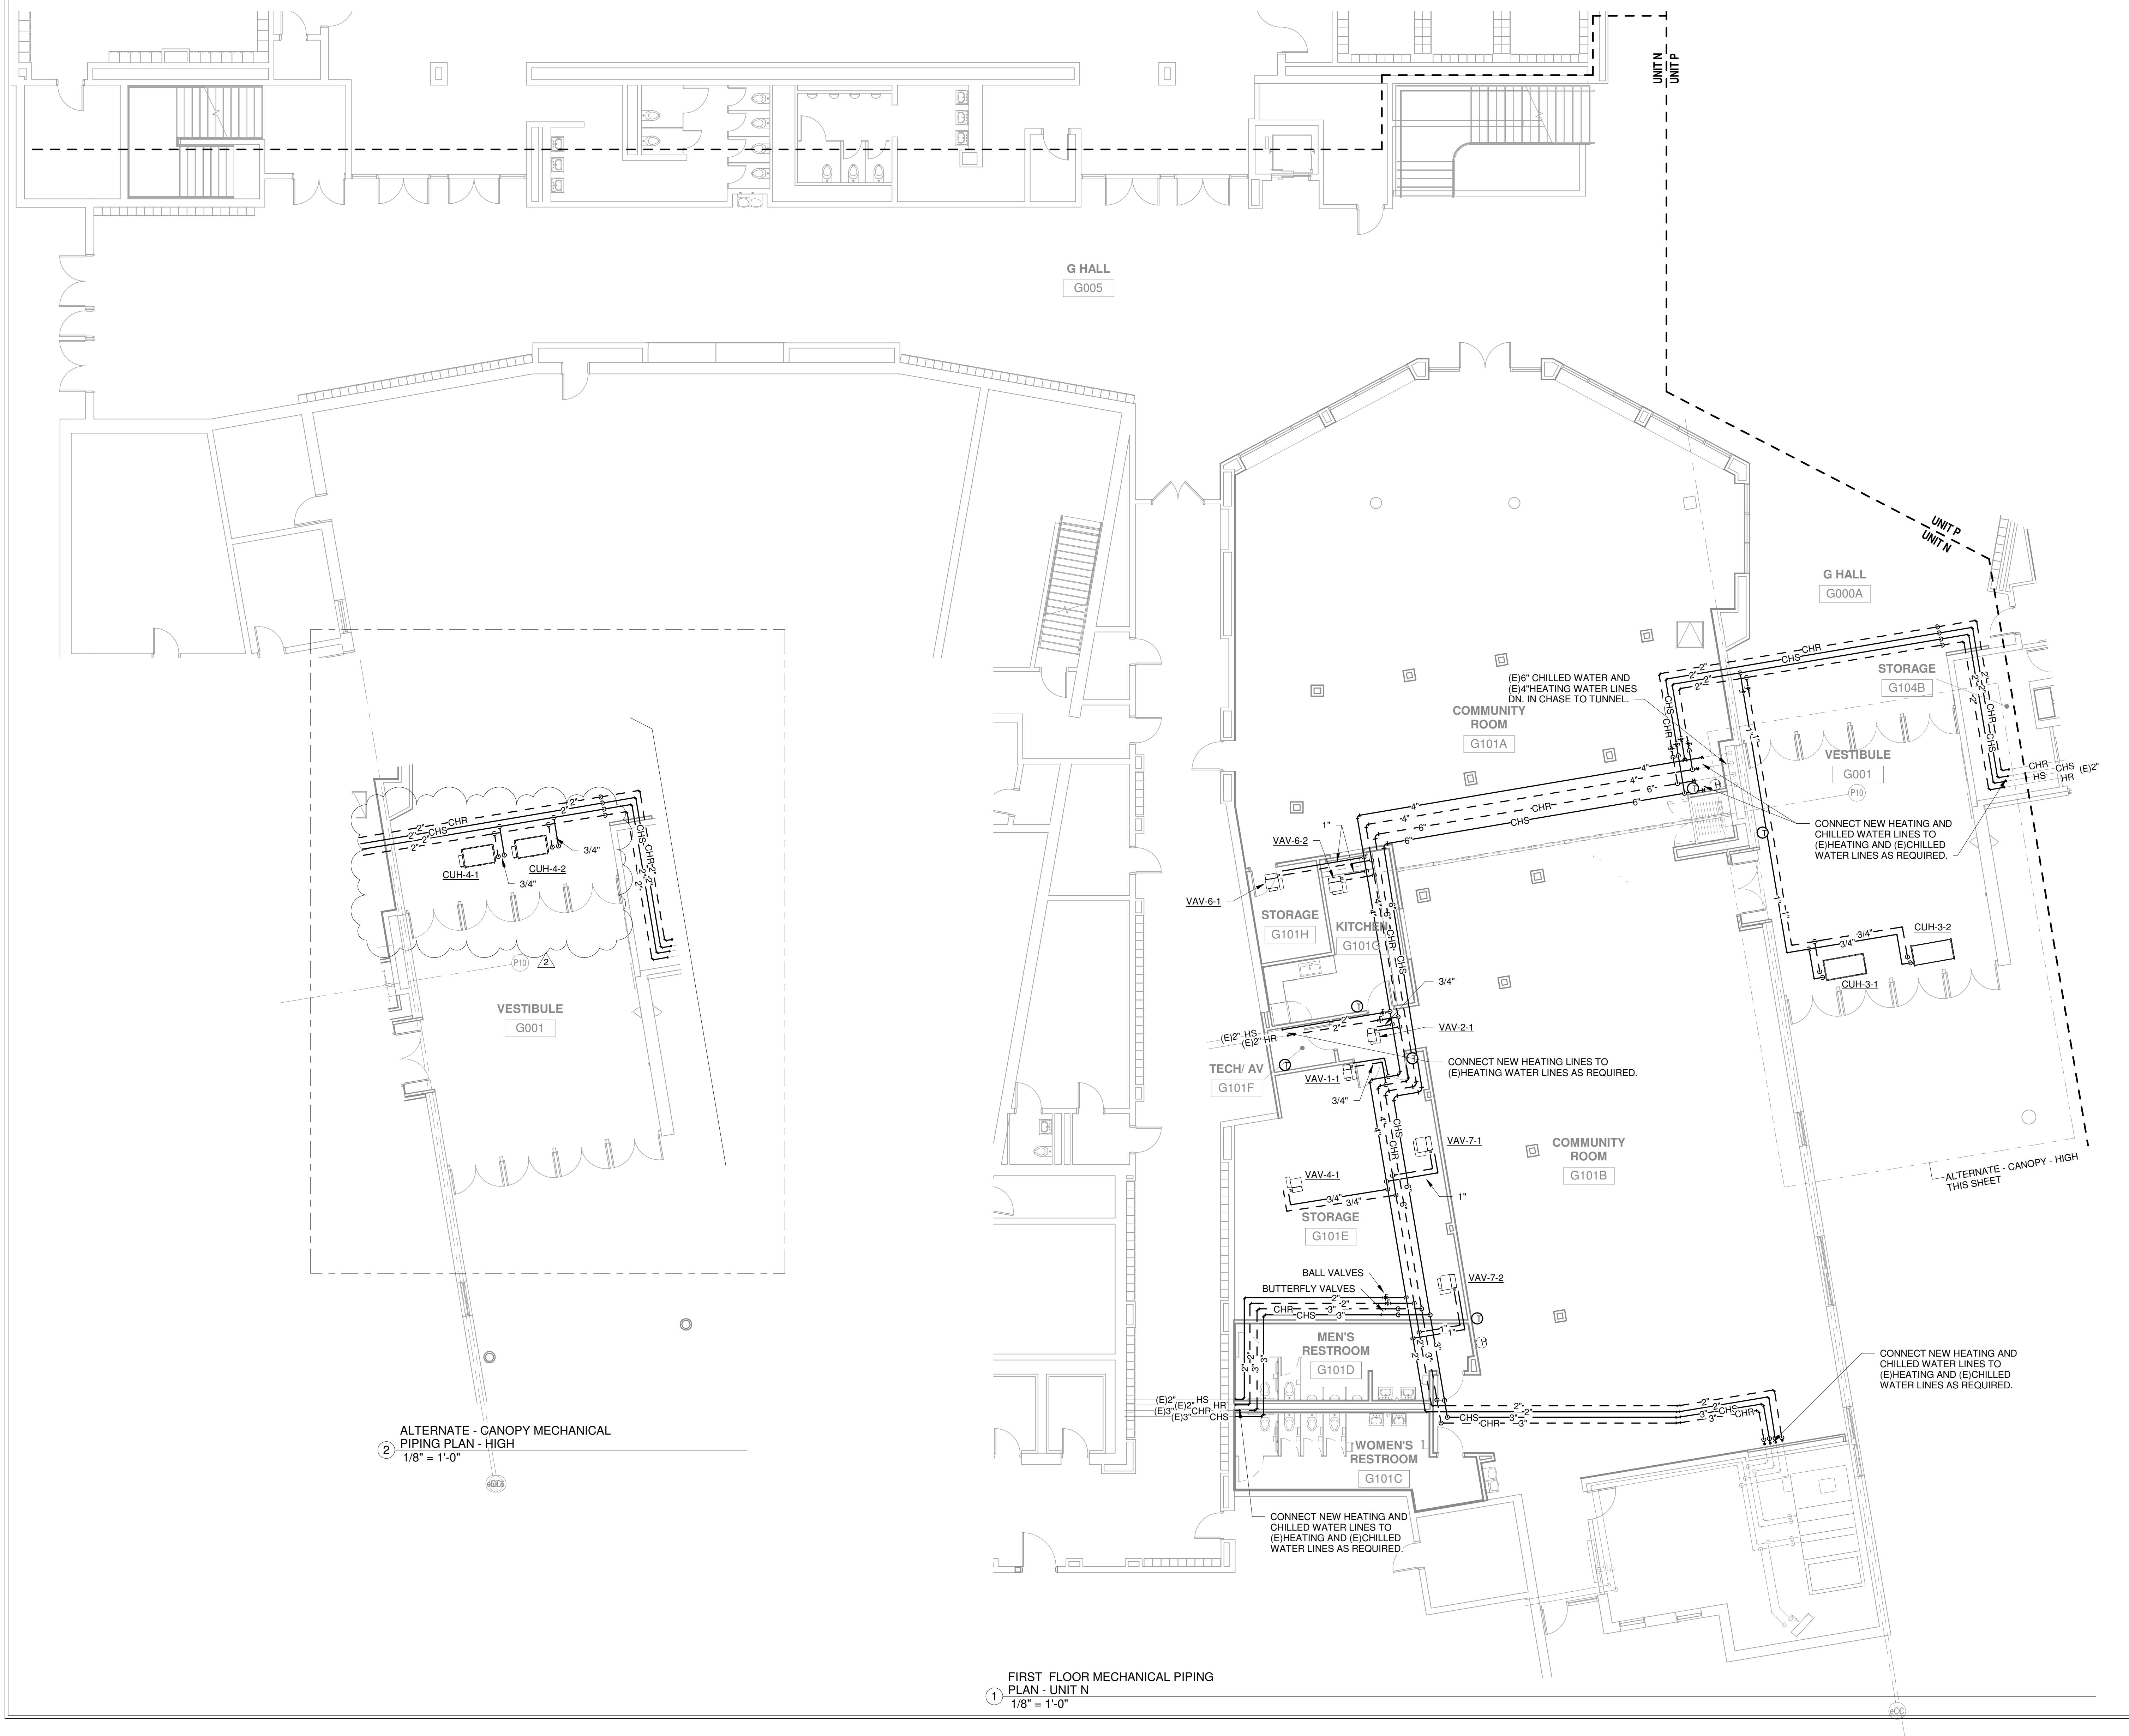



**SCCSO**

8831 Keystone Crossing, Indianapolis, IN 46240

317.448.7800 | cso.net

© 2020 CCSO Architects, Inc. All Rights Reserved

**STAIR**  
ASSOCIATES INC.

961 Commerce Drive, Carmel, Indiana

MECHANICAL / ELECTRICAL ENGINEERS

PROJECT:  
WARREN CENTRAL HIGH SCHOOL  
PHASE 3 ADDITION & RENOVATION  
9500 E. 6th STREET, INDIANAPOLIS, IN 46229

SCOPE DRAWINGS:  
These drawings are a part of the scope of the project in terms of the architectural design concept, the dimensions of the structure, mechanical and electrical systems, and the requirements of the Contract. They are intended to describe all the work required to be performed by the Contractor to meet the requirements of the Contract.  
The trade contractors shall furnish all items required for the proper execution and completion of the work.

REVISIONS:  
2 ADDENDUM #2 03/13/2023

ISSUE DATE: 02/20/23 DRAWN BY: RWT CHECKED BY: WWH

DRAWING TITLE:  
SECOND FLOOR  
MECHANICAL  
PIPEING PLAN -  
UNIT HJ

CERTIFIED BY:  
WARD  
REGISTERED  
PROFESSIONAL  
ENGINEER  
No. PE6002458  
State of Indiana  
Drawing Number  
M212HJ

PROJECT NUMBER  
2021056/1407





SCCSO

8831 Keystone Crossing, Indianapolis, IN 46240


© 2020 CCSO Architects, Inc. All Rights Reserved

STAIR-EE ASSOCIATES INC.

MECHANICAL / ELECTRICAL ENGINEERS


PROJECT: WARREN CENTRAL HIGH SCHOOL  
PHASE 3 ADDITION & RENOVATION  
9500 E. 6th STREET, INDIANAPOLIS, IN 46229SCOPE DRAWINGS:  
These drawings represent the scope of the project in terms of all architectural design concept, the dimensions of the building, and the location of all structural, mechanical and electrical systems. They are intended to describe all the work to be performed and to establish the scope of the requirements of the Contract.  
The architect shall furnish all scope indicated or implied, the trade contractors shall furnish all items required for the proper execution and completion of the work.REVISIONS:  
2 ADDENDUM #2 03/13/2023

ISSUE DATE: 02/20/23 DRAWN BY: RWT CHECKED BY: WWH

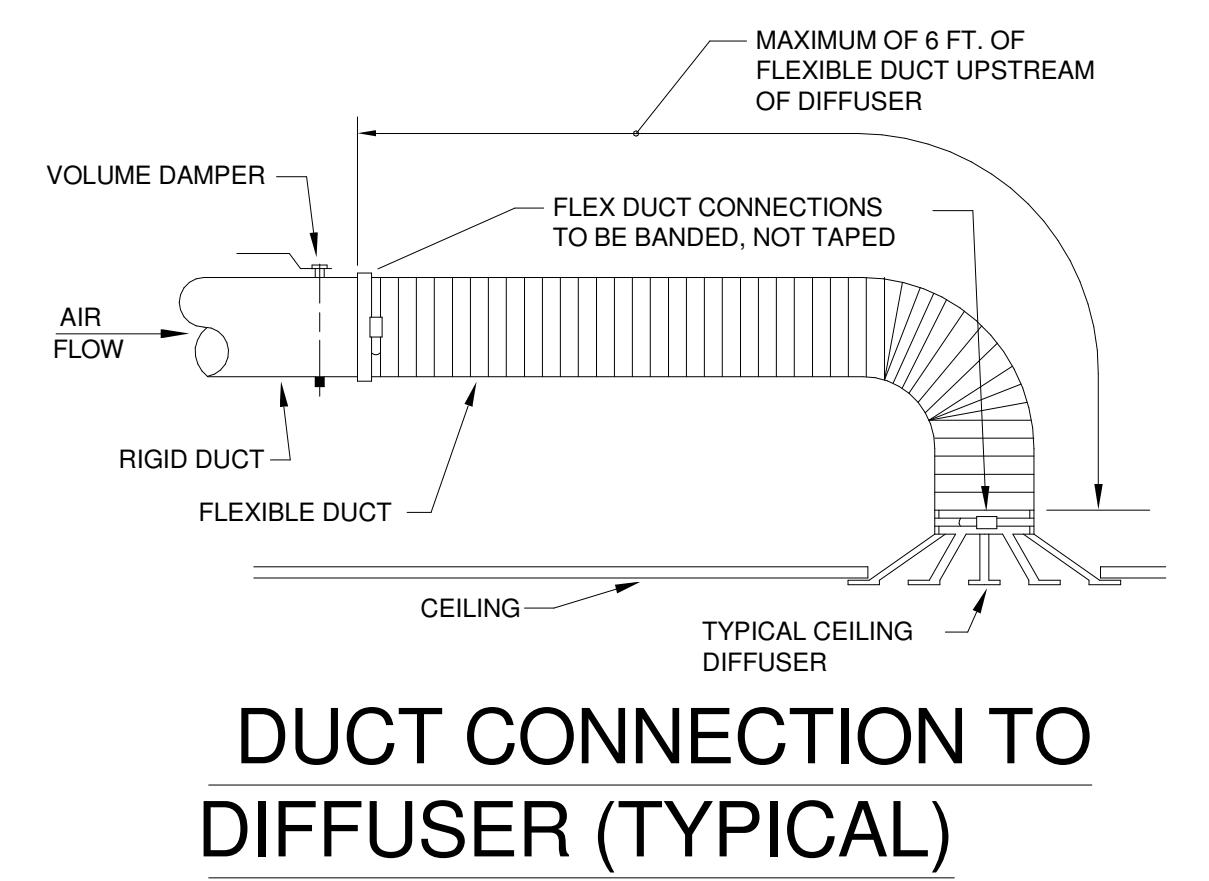DRAWING TITLE:  
MECHANICAL  
SCHEDULES  
AND DETAILSCERTIFIED BY:  
WILLIAM J. WARD  
NO. PE6002456  
STATE OF INDIANA  
PROFESSIONAL ENGINEERDRAWING NUMBER:  
M301PROJECT NUMBER:  
2021056/1407


DUCT CONNECTION TO DIFFUSER (TYPICAL)

NO SCALE

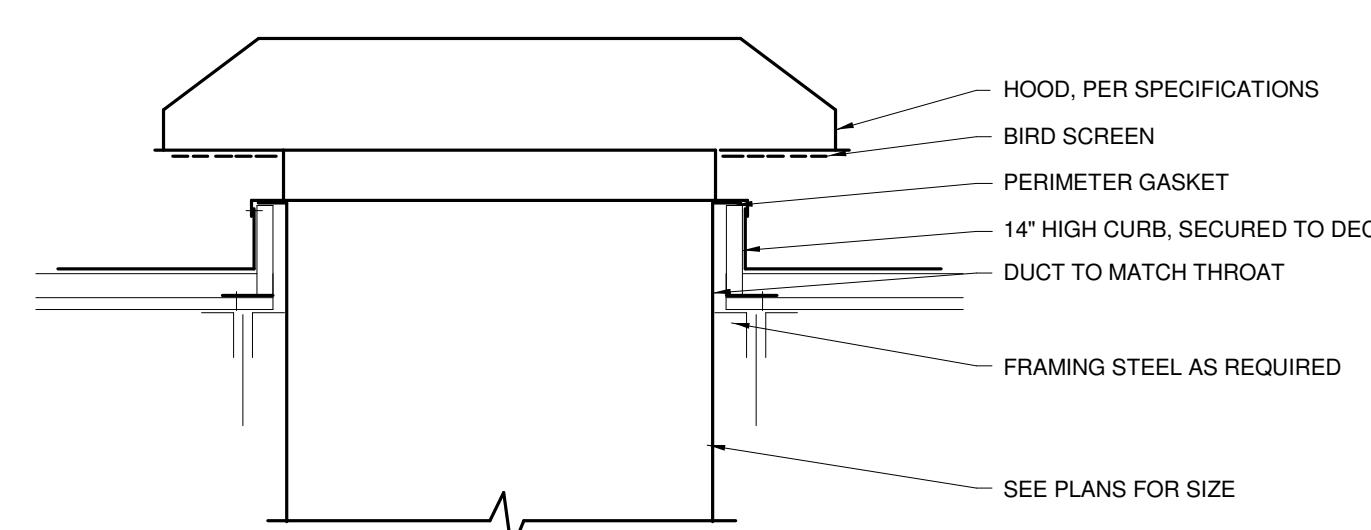


INTAKE HOOD DETAIL

NO SCALE

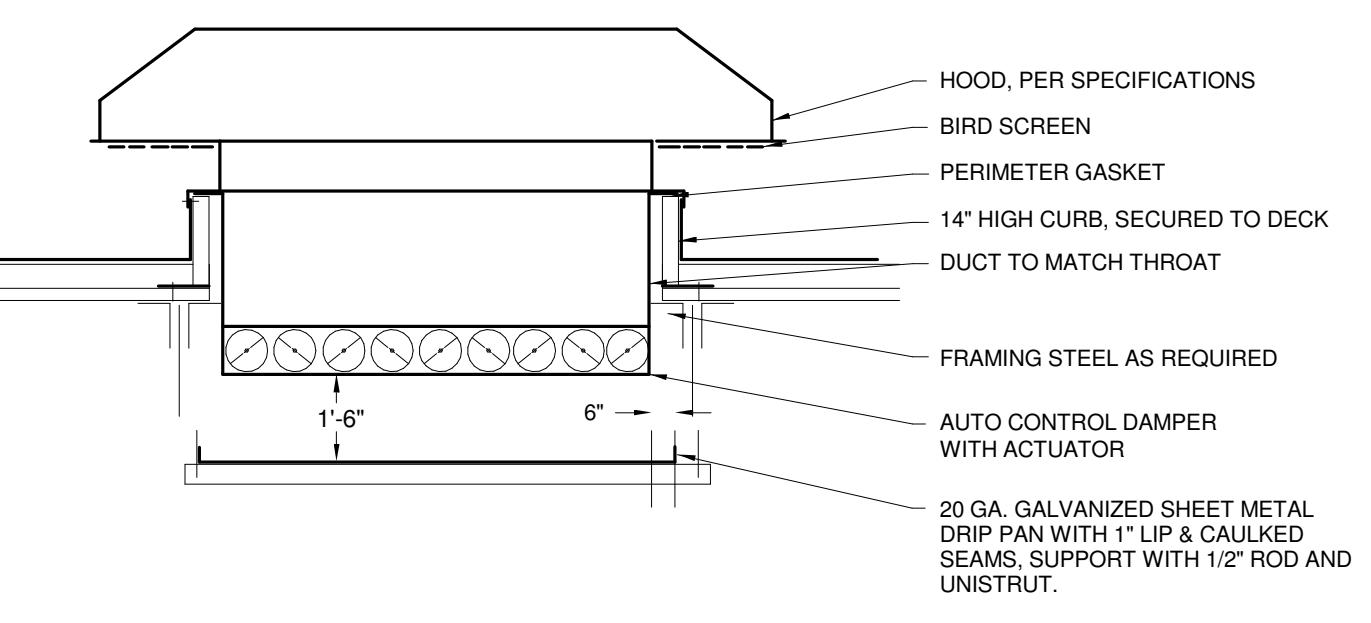


RELIEF HOOD DETAIL

NO SCALE

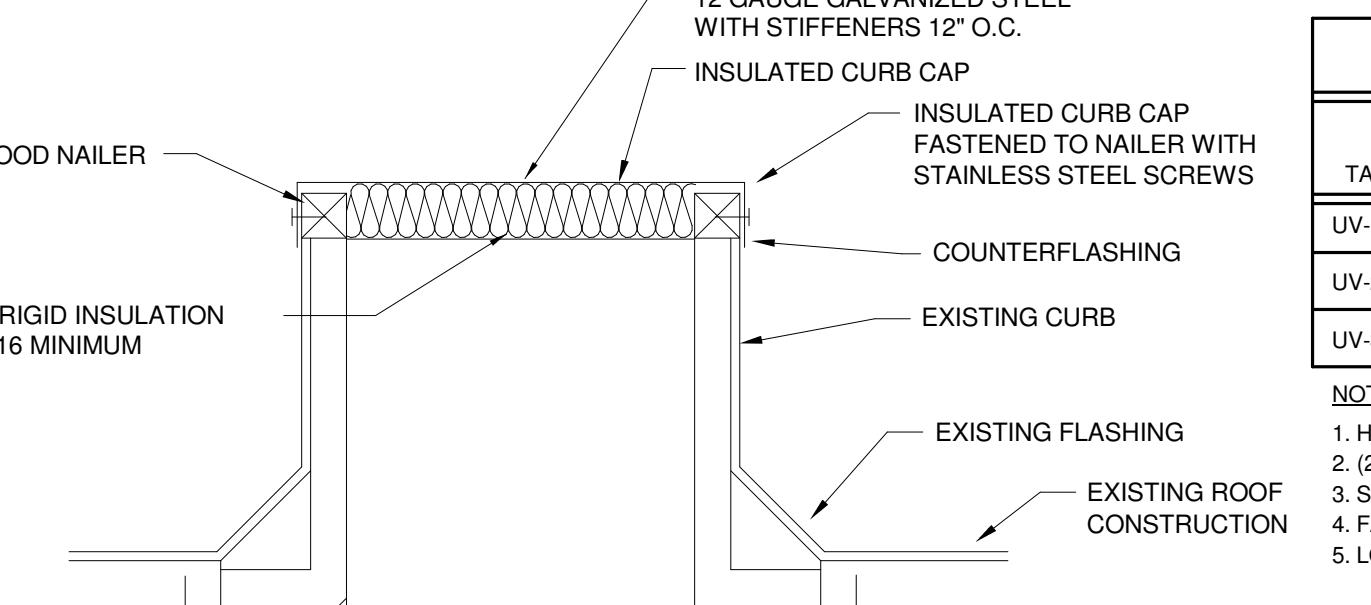

CURB CAP DETAIL


NO SCALE

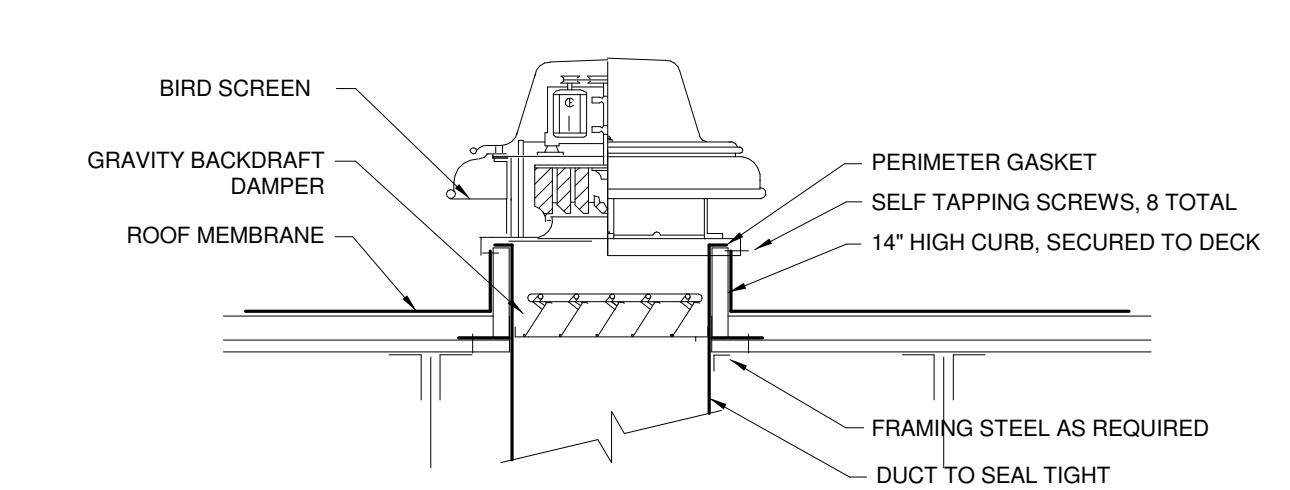

ROOF MOUNTED EXHAUST FAN

NO SCALE

TAG	TRANSMODEL	CFM	HEATING				COOLING				WPD	FILTERS													
			MOTOR	TYPE	WATTS	MCA	POWER	ENT	LVG	ENT	LVG	WATER	GPM												
FCU-1	FCHB0301	230	-	ECM	47	2.75	120V/1PH	70.0	103	160	143	1.0	8.42	1	2.2	8067	59.10/57.63	45	55	1.3	6.79	5.24	3	2.59	2" MERV8

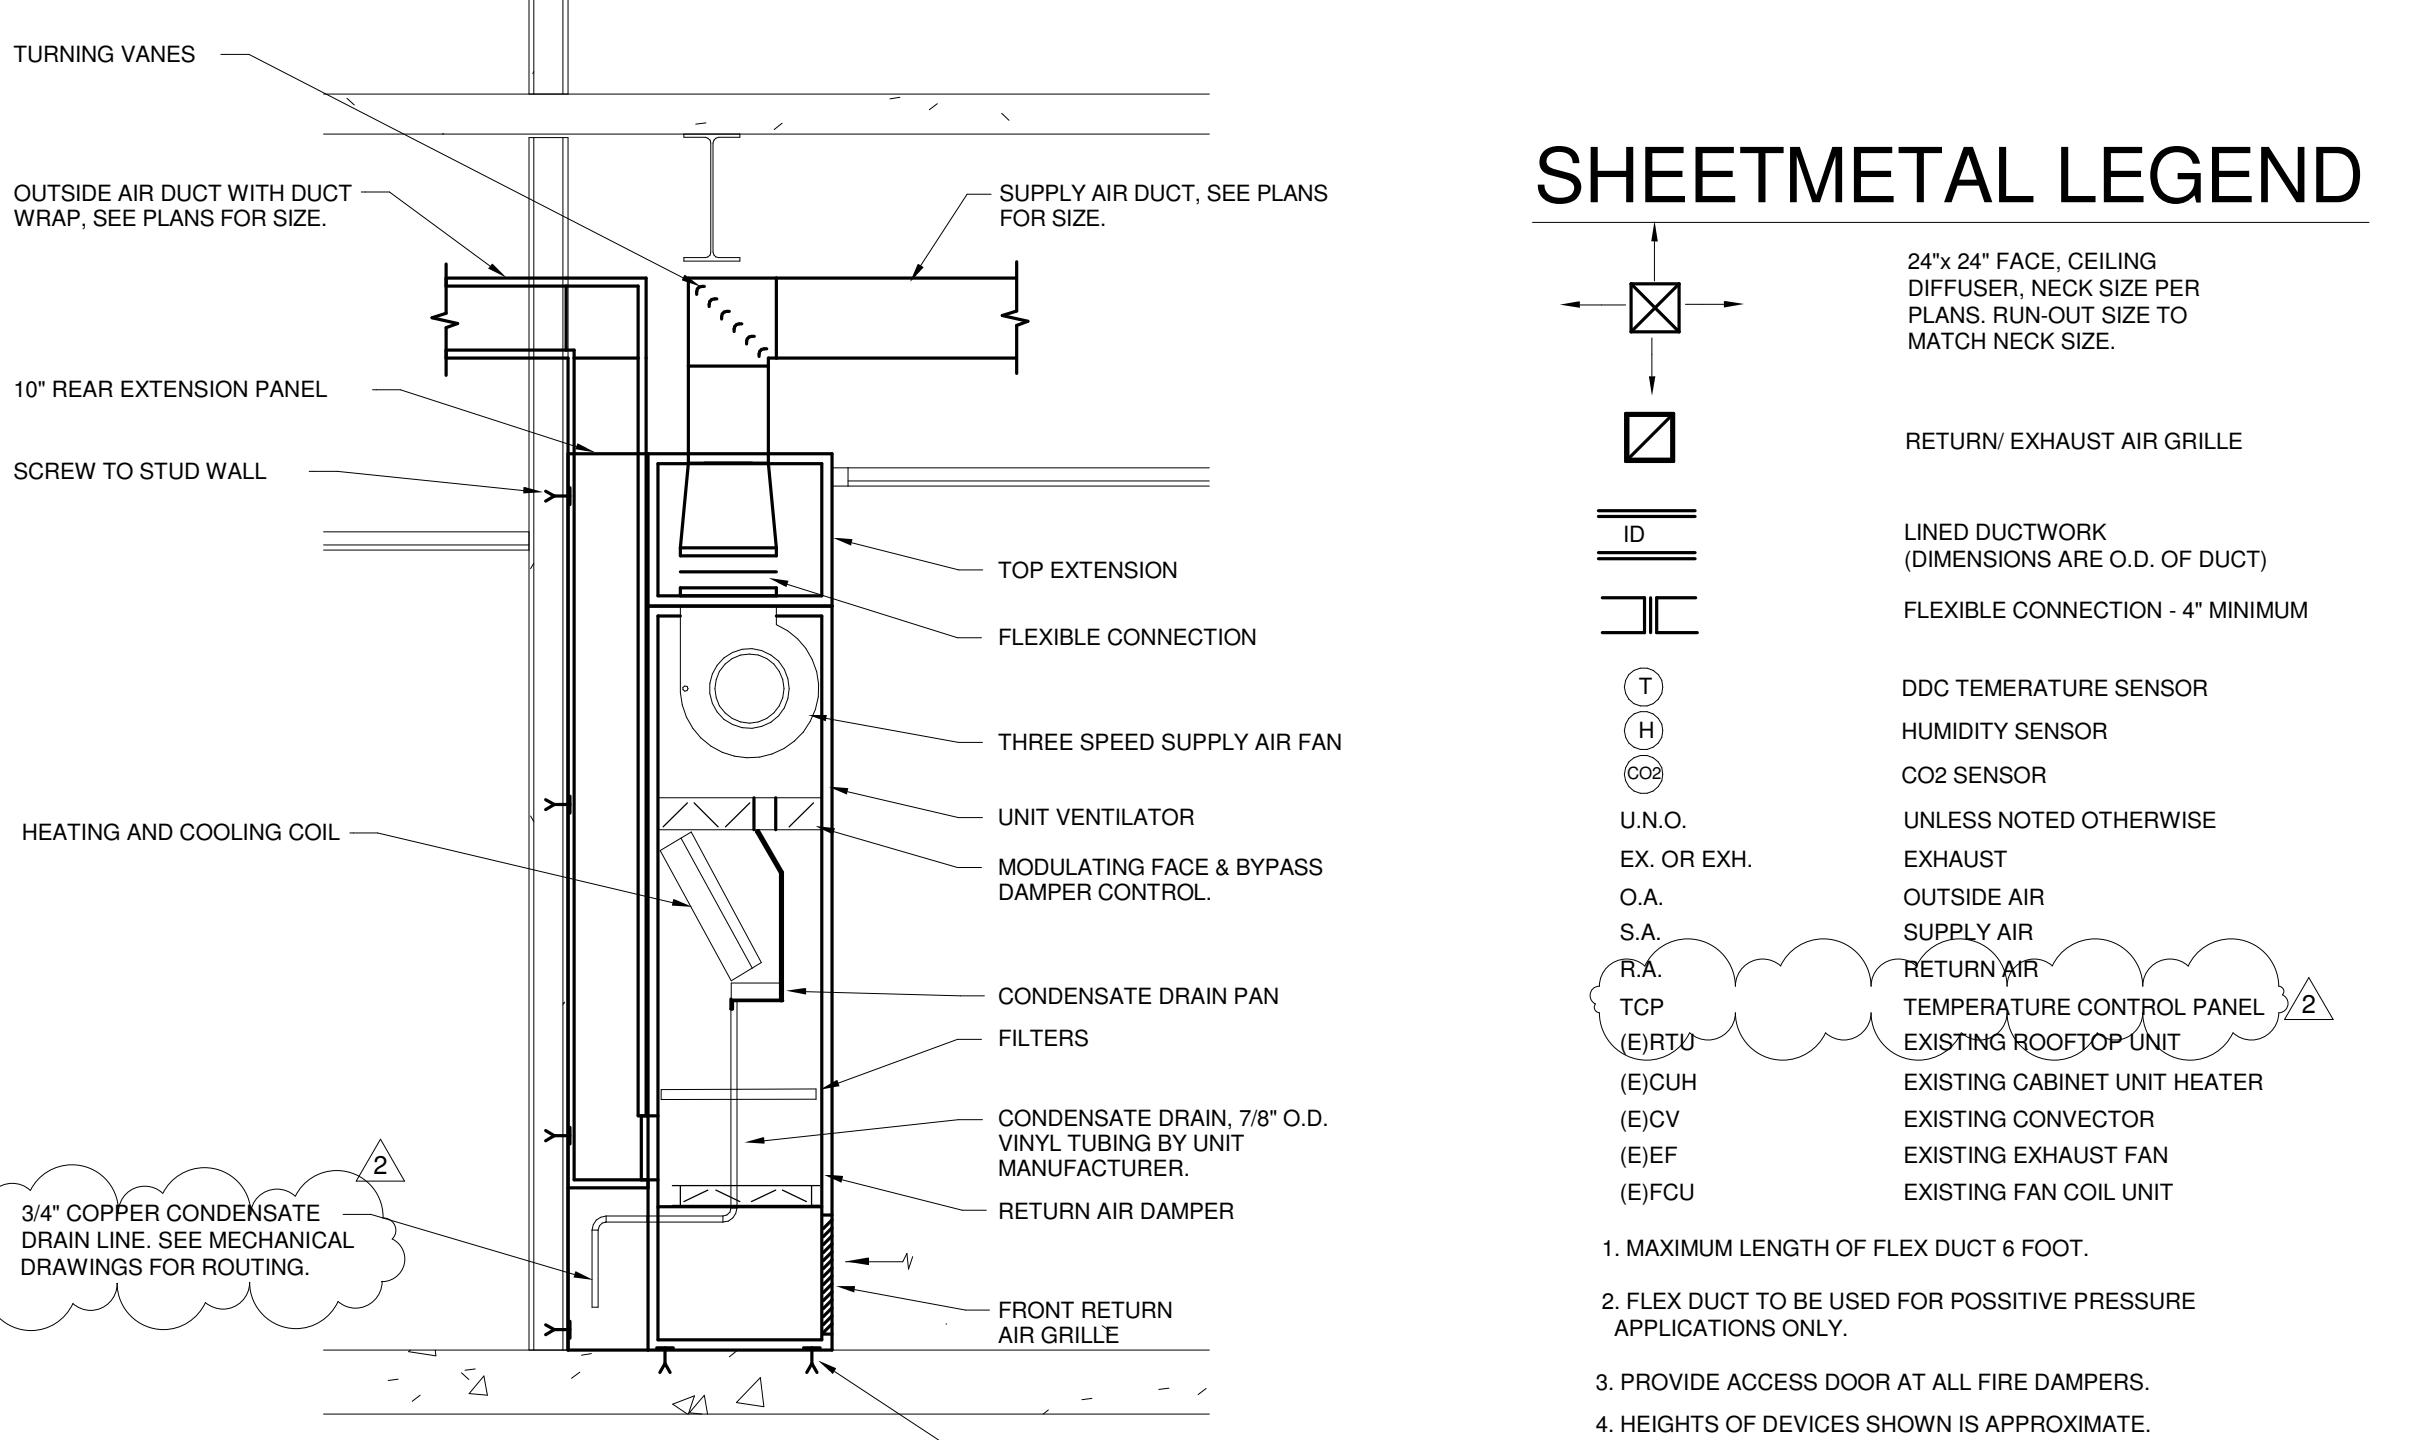NOTES:  
1. PROVIDE UNIT WITH PROJECTION KIT, FIELD VERIFY PROJECTION DIMENSION PRIOR TO ORDERING UNIT.

SECTION AT INTERIOR WALL

UNIT VENTILATOR

SCALE: 1/2"=1'-0"

1. SEE P. SERIES DRAWINGS FOR ADDITIONAL WORK.  
 2. SEE ARCHITECTURAL DRAWINGS FOR FIRE RATED CEILING AND WALL LOCATIONS. PROVIDE FIRE DAMPERS AT ALL PENETRATIONS. PROVIDE HINGED ACCESS DOOR WITH CAMLOCK HARDWARE AT EACH FIRE DAMPER ARRANGED FOR LINK REPLACEMENT AND INSPECTION.  
 3. SHEETMETAL ROUTING SHOWN IS SCHEMATIC IN NATURE AND AS SUCH MAY NOT ACCURATELY REQUIRED TRANSITIONS AND OFFSETS. FIELD VERIFY ACTUAL CONDITIONS AND PROVIDE ALL NECESSARY COMPONENTS FOR A COMPLETE SYSTEM.  
 4. DIFFUSER AND GRILLE LOCATIONS SHOWN ARE APPROXIMATE. COORDINATE FINAL LOCATION WITH CEILING AND LIGHTING GRID.  
 5. PROVIDE MANUAL VOLUME DAMPERS AT LOCATIONS SHOWN OR AS REQUIRED FOR AIR BALANCE OF EACH SUPPLY AND EXHAUST DEVICE.  
 6. DUCTWORK AND PIPING TO EACH VAV BOX SHALL BE ARRANGED TO ALLOW COMPLETE ACCESS TO ALL SERVICEABLE COMPONENTS AND TO ALLOW EASY REMOVAL OF ALL ENTIRE UNIT.  
 7. SEE ARCHITECTURAL DRAWINGS FOR LOUVER LOCATIONS AND ELEVATIONS.

AIR HANDLING UNIT SCHEDULE																																																																																																																																																																																																																																																																																																																																																																																																																																																																																																																																								
TAG	SERVING	TRANSMODEL	CFM	TYPE	TOTAL	O.A.	EXT	SP	FAN TYPE		BHP	HP	FAN RPM	POWER	ENT	LVG	ENT	LVG	WATER	GPM	MBH	ROW	FPI	APD	WPD	ENT	LVG	ENT	LVG	WATER	GPM	MBH	ROW	FPI	APD	WPD	ENT	LVG	ENT	LVG	WATER	GPM	MBH	ROW	FPI	APD	WPD</th



SCSO

8831 Keystone Crossing, Indianapolis, IN 46240

© 2020 SCSO Architects, Inc. All rights reserved.

STAIRS ASSOCIATES INC.

MECHANICAL / ELECTRICAL ENGINEERS

PROJECT:  
WARREN CENTRAL HIGH SCHOOL  
9500 E. 6th STREET, INDIANAPOLIS, IN 46229

SCOPE DRAWINGS:  
These drawings illustrate the scope of the project in terms of architectural design concept, the dimensions of the structure, and the location of the mechanical and electrical systems. They are intended to provide a general description of the requirements of the Contract.  
The scope of the work described in these drawings is limited to the scope indicated or implied. The trade contractors shall furnish all items required for the proper execution and completion of the work.

REVISIONS:  
2 ADDENDUM #2 03/13/2023

ISSUE DATE: 02/27/23 DRAWN BY: RWT CHECKED BY: WWH

DRAWING TITLE:  
MECHANICAL  
SECTIONS

CERTIFIED BY:  
WARD  
REGISTERED PROFESSIONAL ENGINEER  
No. PE6002456  
STATE OF INDIANA  
DRAFTING AND DESIGN  
PROJECT NUMBER  
2021056/1407

DRAWING NUMBER  
M303

PROJECT NUMBER  
2021056/1407

