ADDENDUM NO. 2

June 5, 2023

LAKE STREET ELEMENTARY SCHOOL ADDITIONS, RENOVATIONS, AND RELATED WORK

Crown Point, IN 46307

TO: ALL BIDDERS OF RECORD

This Addendum forms a part of and modifies the Bidding Requirements, Contract Forms, Contract Conditions, the Specifications, and the Drawings dated May 15, 2023 by Gibraltar Design. Acknowledge receipt of the Addendum in the space provided on the Bid Form. Failure to do so may subject the Bidder to disqualification.

This Addendum consists of Pages ADD 2-1 through ADD 2-2 and attached Addendum No. 2 from Gibraltar Design dated June 2, 2023 and consisting of 4 pages and 20 drawings.

A. SPECIFICATION SECTION 00 20 00 - TABLE OF CONTENTS

1. **Delete:**

Specification Section 27 11 27 - Data Center Uninterruptible Power Supply

B. <u>SPECIFICATION SECTION 00 31 00 - BID FORM</u>

1. Replace:

Specification Section 00 31 00 - Bid Form with the attached revised Bid Form.

C. SPECIFICATION SECTION 01 12 00 - MULTIPLE CONTRACT SUMMARY

A. BID CATEGORY NO. 1 - GENERAL TRADES

1. Revise:

Specification Section 08 91 00 – Aluminum Wall Louvers (As Applicable)

to read:

Specification Section 08 91 00 – Aluminum Wall Louvers

I. BID CATEGORY NO. 09 - MECHANICAL

1. Delete:

Specification Section 08 91 00 – Aluminum Wall Louvers (As Applicable)

J. BID CATEGORY NO. 10 - ELECTRICAL

1. **Delete:**

Specification Section 27 11 27 - Data Center Uninterruptible Power Supply

D. SPECIFICATION SECTION 01 23 00 - ALTERNATES

1. Replace:

Specification Section 01 23 00 - Alternates with the attached revised section.

CONTRACTOR'S BID FOR PUBLIC WORKS FORM NO. 96

Format (Revised 2013) (Amended for CPCSC)

Lake Street Elementary School Additions, Renovations, and Related Work

Crown Point Community School Corporation Crown Point, IN

PART I

(To be completed for all bids. Please type or print)

	Date (month, day, year):
BIDDER (Firm)	
Address	P.O. Box
City/State/Zip	<u> </u>
Telephone Number:	Email Address:
Person to contact regarding this Bid	
Pursuant to notices given, the undersigned complete the public works project of:	offers to furnish labor and/or materials necessary to
Insert Catego	ry No. (s) and Name(s)
	cations prepared by Gibraltar Design, Inc., 9102 N. N 46260, as follows:
BASE BID	
For the sum of(Su	um in words)
,	DOLLARS (\$)
The undersigned acknowledges receipt of the	(Sum in figures)
Receipt of Addenda No. (s)	

TSC 220210.10

PROPOSAL TIME

Bidder agrees that this Bid shall remain in force for a period of sixty (60) consecutive calendar days from the due date, and Bids may be accepted or rejected during this period. Bids not accepted within said sixty (60) consecutive calendar days shall be deemed rejected.

Attended pre-bid conference	YES	NO
Has visited the jobsite	YES	NO
The Bidder has reviewed the Guidel Of the schedule can be met.	ine Schedule in Section YES	on 01 32 00 and the intent NO
		covers all employees of the bidder who or exceeds the requirements set in IC 4-NO

The undersigned further agrees to furnish a bond or certified check with this Bid for an amount specified in the Notice to Bidders. If Alternate Bids apply, submit a proposal for each in accordance with the Plans and Specifications.

If additional units of material included in the contract are needed, the cost of units must be the same as that shown in the original contract if accepted by the governmental unit. If the bid is to be awarded on a unit bases, the itemization of the units shall be shown on a separate attachment.

The contractor and his subcontractors, if any, shall not discriminate against or intimidate any employee, or applicant for employment, to be employed in the performance of this contract, with respect to any matter directly or indirectly related to employment because of race, religion, color, sex, national origin or ancestry. Breach of this covenant may be regarded as a material breach of the contract.

CERTIFICATION OF USE OF UNITED STATES STEEL PRODUCTS (if applicable)

I, the undersigned bidder, or agent as a contractor on a public works project, understand my statutory obligation to use steel products made in the United States (I.C. 5-16-8-2). I hereby certify that I and all subcontractors employed by me for this project will use U.S. steel on this project if awarded. I understand that violations hereunder may result in forfeiture of contractual payments.

ALTERNATE BIDS

A blank entry or an entry of "No Bid", "N/A", or similar entry on any Alternate will cause the bid to be rejected as non-responsive only if that Alternate is selected. If no change in the bid amount is required, indicate "No Change".

**MARK "ADD" OR "DEDUCT" FOR EACH ALTERNATE **

Alternate Bid No. 1 – Remove existing Acoustic Ceiling System, Devices, and Lighting Fixtures; Install New Acoustic Ceiling System and LED Lighting; Re-Install Devices

Change the Base Bid the sum of	
(sum in words)	
DOLLARG (A	ADD
DOLLARS (\$) (sum in figures)	DEDUCT
(Sum in figures)	
Alternate Bid No. 2 - Carpet Manufactured by Tarkett	
Change the Base Bid the sum of	
(sum in words)	
	ADD
DOLLARS (\$) (sum in figures)	DEDUCT
(sum in figures)	
Alternate Bid No. 3 – New Hydronic Coils in Dedicated Classrooms; Extend Ductwo	<u>ork</u>
Change the Base Bid the sum of	
(sum in words)	
	ADD
DOLLARS (\$) (sum in figures)	DEDUCT
(sum in figures)	
Alternate Bid No. 4A – Replace (2) Air Handling Units in Gymnasium Mezzanine	
Change the Base Bid the sum of	
(sum in words)	
DOLLARG (A	ADD
DOLLARS (\$) (sum in figures)	DEDUCT
(Sum in figures)	
Alternate Bid No. 4B – Air Handling Units Manufactured by Trane	
Change the Base Bid the sum of	
(sum in words)	
	ADD
DOLLARS (\$)	DEDUCT
(sum in figures)	

Alternate Bid No. 5A – Replace (4) Air Handlin	ig Units Above Cafeteria Ceiling	
Change the Base Bid the sum of		
	(sum in words)	ADD
	DOLLARS (\$) (sum in figures)	DEDUCT
	(sum in figures)	
Alternate Bid No. 5B – Air Handling Units Mar	nufactured by Trane	
Change the Base Bid the sum of		
	(sum in words)	ADD
	DOLLARS (\$) (sum in figures)	ADD DEDUCT
Alternate Bid No. 6A – Replace Chiller and Pu	<u>mps</u>	
Change the Base Bid the sum of		
	(sum in words)	4.00
	DOLLARS (\$) (sum in figures)	ADD DEDUCT
Alternate Bid No. 6B – Chillers Manufactured	by Trane	
Change the Base Bid the sum of		
	(sum in words)	ADD
	DOLLARS (\$) (sum in figures)	DEDUCT
Alternate Bid No. 7 – Remove Existing and Inst	tall New Domestic Water Heater	
Change the Base Bid the sum of		
	(sum in words)	4 D.D.
	DOLLARS (\$) (sum in figures)	ADD DEDUCT
<u>Alternate Bid No. 8 – Schneider Electric Tempe</u> <u>Controls</u>		recision
Controls		
Change the Base Bid the sum of	(sum in words)	
	(sum m words)	ADD
	DOLLARS (\$)	DEDUCT
	(sum in figures)	

Alternate Bid No. 9 – Chemical Water Treatn	nent Manufactured by Glo	<u>bal Water Te</u>	<u>echnology</u>
<u>Inc.</u>			
Change the Base Bid the sum of			
	(sum in words)		
			ADD
	DOLLARS (\$)	DEDUCT
	(sum in	n figures)	
Alternate Bid No. 10 – Existing Playground I	Demolition and New Aspha	alt Pavino	
Internate Bia 140. 10 Existing Flayground I	bemontion and thew hispine	ant I aving	
Change the Base Bid the sum of			
	(sum in words)		
			ADD
	DOLLARS (\$)	DEDUCT
	(sum ir	n figures)	

PART II

(For projects of \$150,000 or more – IC 36-1-12-4)

These statements to be submitted under oath by each bidder with and as a part of his bid. (Attach additional pages for each section as needed.)

SECTION I EXPERIENCE QUESTIONNAIRE

•	1	he date of the curren	0	completed for the period of one (1)				
	Contract Amount Class of Work Completion Name and Address of Owner							

Contract Amount	Class of Work	Completion Date	Name and Address of Owner

2. What public works projects are now in process of construction by your organization?

Contract Amount	Class of Work	Completion Date	Name and Address of Owner

3.	Have you even why?	failed to complete	any work awarded	l to you?	If so, where and
4.	List references	s from private firms	for which you have	ve performed work	

SECTION II PLAN AND EQUIPMENT QUESTIONNAIRE

1.	Explain your plan or layout for performing proposed Work. (Examples could include a narrative of when you could begin, complete the project, number of workers, etc. and any other information which you believe would enable the governmental unit to consider your bid.)
2.	Please list the names and addresses of all subcontractors (i.e. persons or firms outside your own firm who have performed part of the work) that you have used on public works projects during the past five (5) years along with a brief description of the work done by each subcontractor.
3.	If you intend to sublet any portion of the work, state the name and addresses of each subcontractor, equipment to be used by the subcontractor, and whether you will require a bond. However, if you are unable to currently provide a listing, please understand a listing must be provided prior to contract approval. Until the completion of the proposed project, you are under a continuing obligation to immediately notify the governmental unit in the event that you subsequently determine that you will use a subcontractor on the proposed project.

4.	used by subcontractors may also be required to be listed by the governmental unit.
5.	Have you into contracts or received offers for all materials which substantiate the prices used in preparing your proposal? If not, please explain the rationale used which corroborate the process listed.

SECTION III CONTRACTOR'S FINANCIAL STATEMENT

Attachment of Bidder's financial statement is mandatory. Any Bid submitted without said financial statement as required by statute shall thereby be rendered invalid. The financial statement provided hereunder to the governing body awarding the Contract must be specific enough in detail so that said governing body can make a proper determination of the Bidder's capability for completing the Project if awarded.

SECTION IV CONTRACTOR NON-COLLUSION AFFIDAVIT

The undersigned Bidder or agent, being duly sworn on oath, says that he has not, nor has any other member, representative, or agent of the firm, company, corporation or partnership represented by him, entered into any combination, collusion or agreement with any person relative to the price to be bid by anyone at such letting nor to prevent any person from bidding nor to induce anyone to refrain from bidding, and that this Bid is made without reference to any other bid and without any agreement, understanding or combination with any other person in reference to such bidding.

He further says that no person or persons, firms, or corporations has, have, or will receive directly or indirectly, any rebate, fee, gift, commission, or thing of value on account of such contract.

SECTION V OATH AND AFFIRMATION

I HEREBY AFFIRM UNDER THE PENALTIES OF PERJURY THAT THE FACTS AND INFORMATION CONTAINED IN THE FOREGOING BID FOR PUBLIC WORKS ARE TRUE AND CORRECT

Dated at	this	day of	, 20	
			(Name of Org	anization)
	Ву			
			(Title of Perso	on Signing)
	ACKNO	OWLEDGEM	•	<i>5 6)</i>
STATE OF) (55.)		
COUNTY OF				
Before me, a Notary Pul	olic, personally appe	eared the above	e-named	
Swore that the statemen	ts contained in the fo	oregoing doc	ament are true and	correct.
Subscribed and sworn to	before me this		day of	
(Title)				
	Notary Public			
My Commission Expire	s: _			
County of Residence:				

SECTION 01 23 00 - ALTERNATES

PART 1 - GENERAL

1.01 RELATED DOCUMENTS

A. Drawings and general provisions of the Contract, including amended General Conditions and other Division 1 Specification Sections, apply to work of this Section.

1.02 PURPOSE

A. The Bids for the Alternates described herein are required in order for the Owner to obtain information necessary for the proper consideration of the Project in its entirety.

1.03 ALTERNATES

A. Definitions: Alternates are defined as alternate products, materials, equipment, installations, or systems for the Work, which may, at Owner's option and under terms established by Instructions to Bidders, be selected and recorded in the Owner-Contractor Agreement to either supplement or displace corresponding basic requirements of Contract Documents. Alternates may or may not substantially change scope and general character of the Work; and must not be confused with "allowances", "unit prices", "change orders", "substitutions", and other similar provisions.

1.04 SCHEDULE OF ALTERNATES

- A. ALTERNATE NO. 1: State the cost to remove the existing acoustic ceiling system, existing devices, and lighting fixtures where noted on drawings as alternate bid. Install new acoustic ceiling system and LED lighting and reinstall devices as noted in corridors. Refer to the drawings for notes and work denoted as "ALTERNATE CORRIDOR COMMONS REFRESH". Base Bid: No additional work in corridors outside the base bid scope.
- B. <u>ALTERNATE NO. 2: State the cost to provide carpet manufactured by Tarkett if not already included in your base bid.</u>
- C. <u>ALTERNATE NO. 3: State the cost to install new hydronic coils in dedicated classrooms, and extend ductwork from classrooms into corridor, and any associated work. Refer to drawings. Base Bid: Existing mechanical system in classrooms and corridors to remain.</u>
- D. <u>ALTERNATE NO. 4A: State the cost to replace the (2) air handling units in the gymnasium mezzanine and any associated work. Refer to drawings. **Base Bid:** Existing air handling units in the gymnasium mezzanine to remain.</u>

TSC 220210.10 Alternates 01 23 00-1

- E. <u>ALTERNATE NO. 4B: State the cost to provide Air Handling Units manufactured by Trane to be installed as indicated on the Mechanical Drawings and Specifications if not already included in Alternate No. 4A.</u>
- F. <u>ALTERNATE NO. 5A: State the cost to replace the (4) air handling units above the cafeteria ceiling and related work. Refer to drawings. Base Bid: Existing air handling units above the cafeteria ceiling to remain.</u>
- G. <u>ALTERNATE NO. 5B: State the cost to provide Air Handling Units manufactured by Trane to be installed as indicated on the Mechanical Drawings and Specifications if not already included in Alternate No. 5A.</u>
- H. <u>ALTERNATE NO. 6A: State the cost to replace the chiller and pumps and associated related work. Refer to drawings. Base Bid: Existing chiller and pumps to remain.</u>
- I. <u>ALTERNATE NO. 6B: State the cost to provide Chillers manufactured by Trane to be installed as indicated on the Mechanical Drawings and Specifications if not already included in Alternate No. 6A.</u>
- J. ALTERNATE NO. 7: State the cost to remove the existing domestic water heater and provide and install a new domestic water heater, including all associated and related work. Refer to drawings. **Base Bid:** Existing domestic water heater system to remain.
- K. <u>ALTERNATE NO. 8: State the cost to provide Schneider Electric Temperature</u>

 <u>Controls manufactured by Precision Controls as indicated on the Mechanical Drawings and Specifications if not already included in your Base Bid.</u>
- L. <u>ALTERNATE NO. 9: State the cost to provide Chemical Water Treatment manufactured by Global Water Technology Inc. to be installed as indicated on the Plumbing Drawings and Specifications if not already included in your bid.</u>
- M. ALTERNATE NO. 10: State the cost to remove the existing mulch, sub-grade as required for undisturbed sub-soil, existing play structures, including all associated and related work as required to prepare the area indicated for new Asphalt Paving.

 Install new Asphalt Paving and blend into existing paving, refer to Civil Drawings for depth and type of paving. Base Bid: Existing play area to remain.

<u>PART 2 - PRODUCTS</u>, <u>PART 3 - EXECUTION</u> (Not Used)

END OF SECTION 01 23 00

TSC 220210.10 Alternates 01 23 00-2



ADDENDUM TWO

Addendum Two (AD.02) to the drawings and specifications prepared by Gibraltar Design for **Lake Street Elementary School Improvements** for Crown Point Community School Corporation, Crown Point, Indiana.

All Contractors bidding on this project shall read all of the items covered below and shall comply with all of the requirements as set forth, including any necessary refinements or additions generated by this Addendum and required by the intent of the original contract documents. All Contractors shall acknowledge on their bid form that they have received this Addendum and Addendum One, and include the appropriate content of same within their bid proposal.

SPECIFICATIONS

1. Specification Section 09 65 68

Roll Rubber Flooring

A. Add new Paragraph 2.1.A.2.c. as follows: "c. North West Rubber - SportFloor as an acceptable Manufacturer, Product ProXL".

2. Specification Section 27 11 27

Data Center Uninterruptible Power Supply

A. Remove this section in its entirety

DRAWINGS

3. Sheet AD-101

A. In Storage A-107, remove existing cage type wall dividing the space.

4. Sheet AD-103

A. In Art C-121, remove existing drywall partition wall dividing the overall space in two.

5. Sheet A-101

A. At Classroom Doors A-118A, A-119A, C-120A and A-121A, replace note 47 with note 43.

6. Sheet A-703

- A. Revise Bleacher Key Notes #4 and #5 to read as follows:
 - 4. (11) 26" ROWS WITH 3 AISLES.
 - 5. 427 NET SEATS (18" WIDE) WITH 6 RECOVERABLE / RETRACTABLE SEATS FOR 6 ADA COMPLIANT WHEELCHAIR SEATING LOCATIONS

7. Sheet A-901 - A-903

A. Revise plans to reflect locations of lighting fixtures shown on electrical drawings.

8. Sheet A-901 - A-904

A. Revise Reflected Ceiling Plan Note 90 to read: "NO ARCHITECTURAL WORK IN THIS AREA. REFER TO ELECTRICAL SHEETS FOR ANY PROPOSED LIGHTING UPDATES."



9. Sheet MV-103

- A. Refer to revised, full-size drawing, included in this Addendum, for the following revisions:
 - 1. Added gef-1 to storage C-126
 - 2. Added transfer air grilles and ducts to storage C-126

10. Sheet MV-104

- A. Refer to revised, full-size drawing, included in this Addendum, for the following revisions:
 - 1. Added Supply Air Grille and Ductwork to Storage D-102

11. Sheet M-501

- A. Refer to revised, full-size drawing, included in this Addendum, for the following revisions:
 - 1. Added GEF-1 to Mechanical Equipment Schedule
 - 2. Added E2 to Grille, Register and Diffuser Schedule

12. Sheet TD-100 through TD-104

- A. Refer to revised, full-size drawing, included in this Addendum, for the following revisions:
 - 1. Revised Demo Notes
 - 2. Added demo note locations on the plans.

13. Sheet ED-102

- A. Refer to revised, full-size drawing, included in this Addendum, for the following revisions:
 - 1. Added existing devices to be relocated

14. Sheet ED-104

- A. Refer to revised, full-size drawing, included in this Addendum, for the following revisions:
 - 1. Added existing floorboxes
 - 2. Added existing devices to be relocated

15. Sheet EL-101

- A. Refer to revised, full-size drawing, included in this Addendum, for the following revisions:
 - 1. Revised Sheet Note

16. Sheet EL-102

- A. Refer to revised, full-size drawing, included in this Addendum, for the following revisions:
 - 1. Revised sheet note
 - 2. Added relocated exterior wallpacks

17. Sheet EL-103

A. Refer to revised, full-size drawing, included in this Addendum, for the following revisions:



1. Revised Sheet Note

18. Sheet EL-104

- A. Refer to revised, full-size drawing, included in this Addendum, for the following revisions:
 - 1. Added relocated exterior wallpacks

19. Sheet EP-102

- A. Refer to revised, full-size drawing, included in this Addendum, for the following revisions:
 - 1. Added relocated devices

20. Sheet EP-103

- A. Refer to revised, full-size drawing, included in this Addendum, for the following revisions:
 - 1. Added GEF-1 electrical connection

21. Sheet EP-104

- A. Refer to revised, full-size drawing, included in this Addendum, for the following revisions:
 - 1. Added sheet note
 - 2. Added relocated devices
 - 3. Revised floorboxes to existing

22. Sheet E-601

- A. Refer to revised, full-size drawing, included in this Addendum, for the following revisions:
 - 1. Added GEF-1 to mechanical equipment schedule
 - 2. Added circuit to ex. Panel 17

23. Sheet

A. Refer to revised, full-size drawing, included in this Addendum, for the following revisions:

1.

24. Sheet T-102

- A. Refer to revised, full-size drawing, included in this Addendum, for the following revisions:
 - 1. added exterior paging horn rough-in location.

25. Sheet T-104


- A. Refer to revised, full-size drawing, included in this Addendum, for the following revisions:
 - 1. Office D-105 exterior, added new WAP location.
 - 2. Vestibule D-101 and Lobby D-102, reconfigured door access control requirements

Pages 1 through 4, inclusive, (No Specification Sections), and twenty (20) Full-Size Drawings, constitute the total makeup of **Addendum Two**.





Y:\21-117 Crown Point CSC - Lake Street ES Improvements\Specs\Addendum TWO\AD02.doc

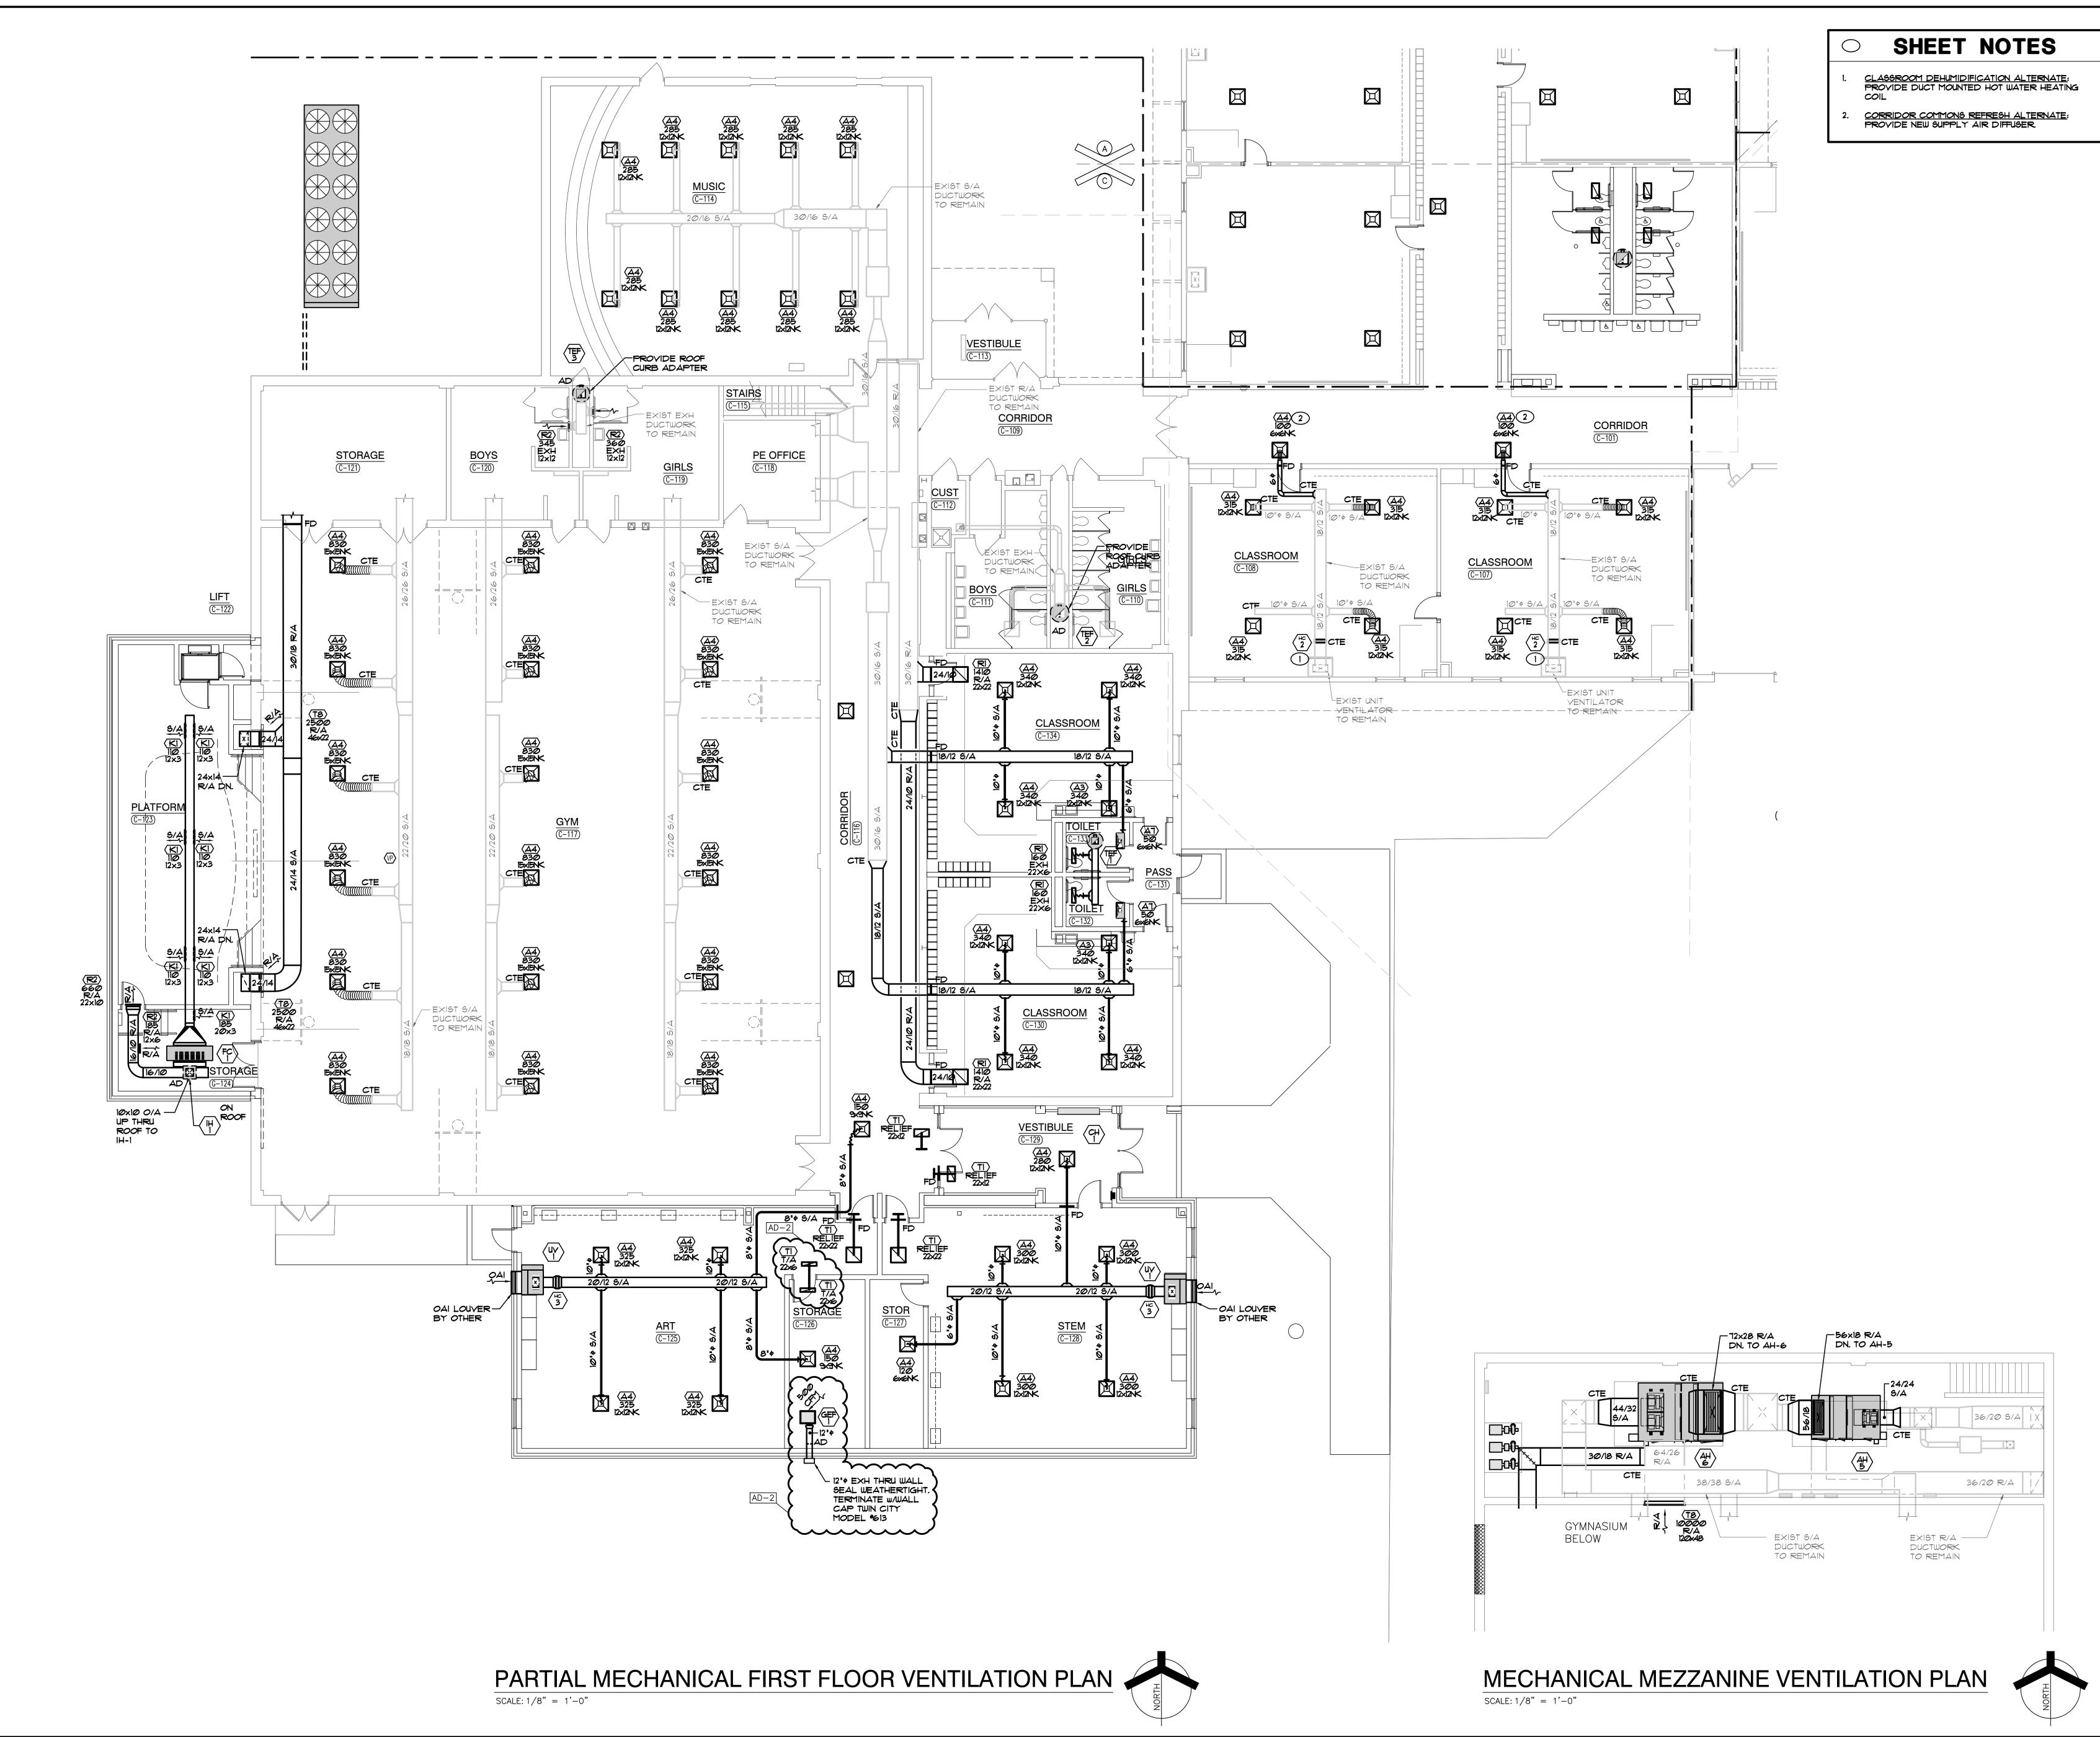


ARCHITECTURE • ENGINEERING • INTERIOR DESIGN



LAKE STREET ELEMENTARY SCHOOL ADDITION, RENOVATION AND RELATED WORK

CROWN POINT COMMUNITY SCHOOL CORPORATION

CROWN POINT, INDIANA

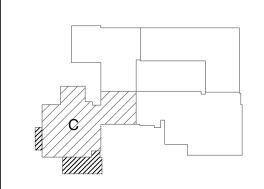

FIRST FLOOR KEY PLAN GIBRALTAR DESIGN 9102 N. Meridian St., Ste. 300

Indianapolis, IN 46260
Homepage www.GibraltarDesign.com
Email info@GibraltarDesign.com
Phone 317.580.5777 Fax 317.580.5778

CHECKED BY


MARK DATE ISSUED FOR AD-2 06/02/23 ADDENDUM NO. 02


DRAWING

PARTIAL MECHANICAL FIRST FLOOR VENTILATION PLAN

LAKE STREET ELEMENTARY SCHOOL ADDITION, RENOVATION AND RELATED WORK

GIBRALTAR DESIGN SHEET MV103

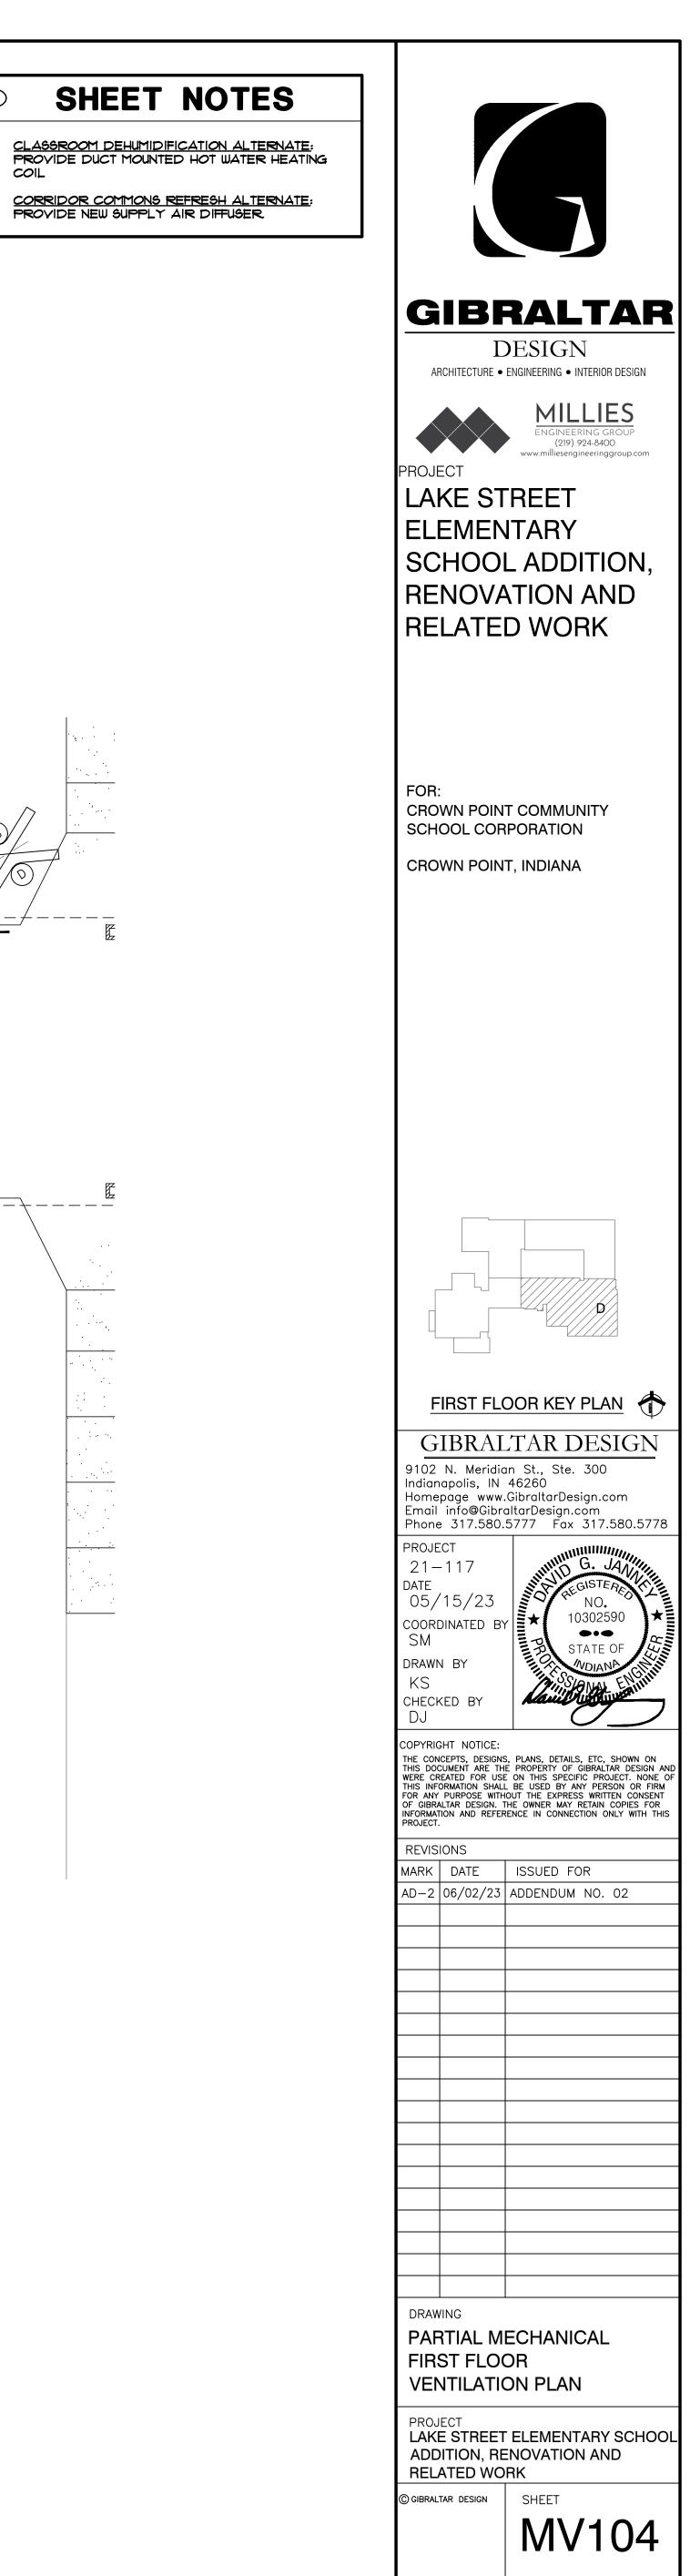

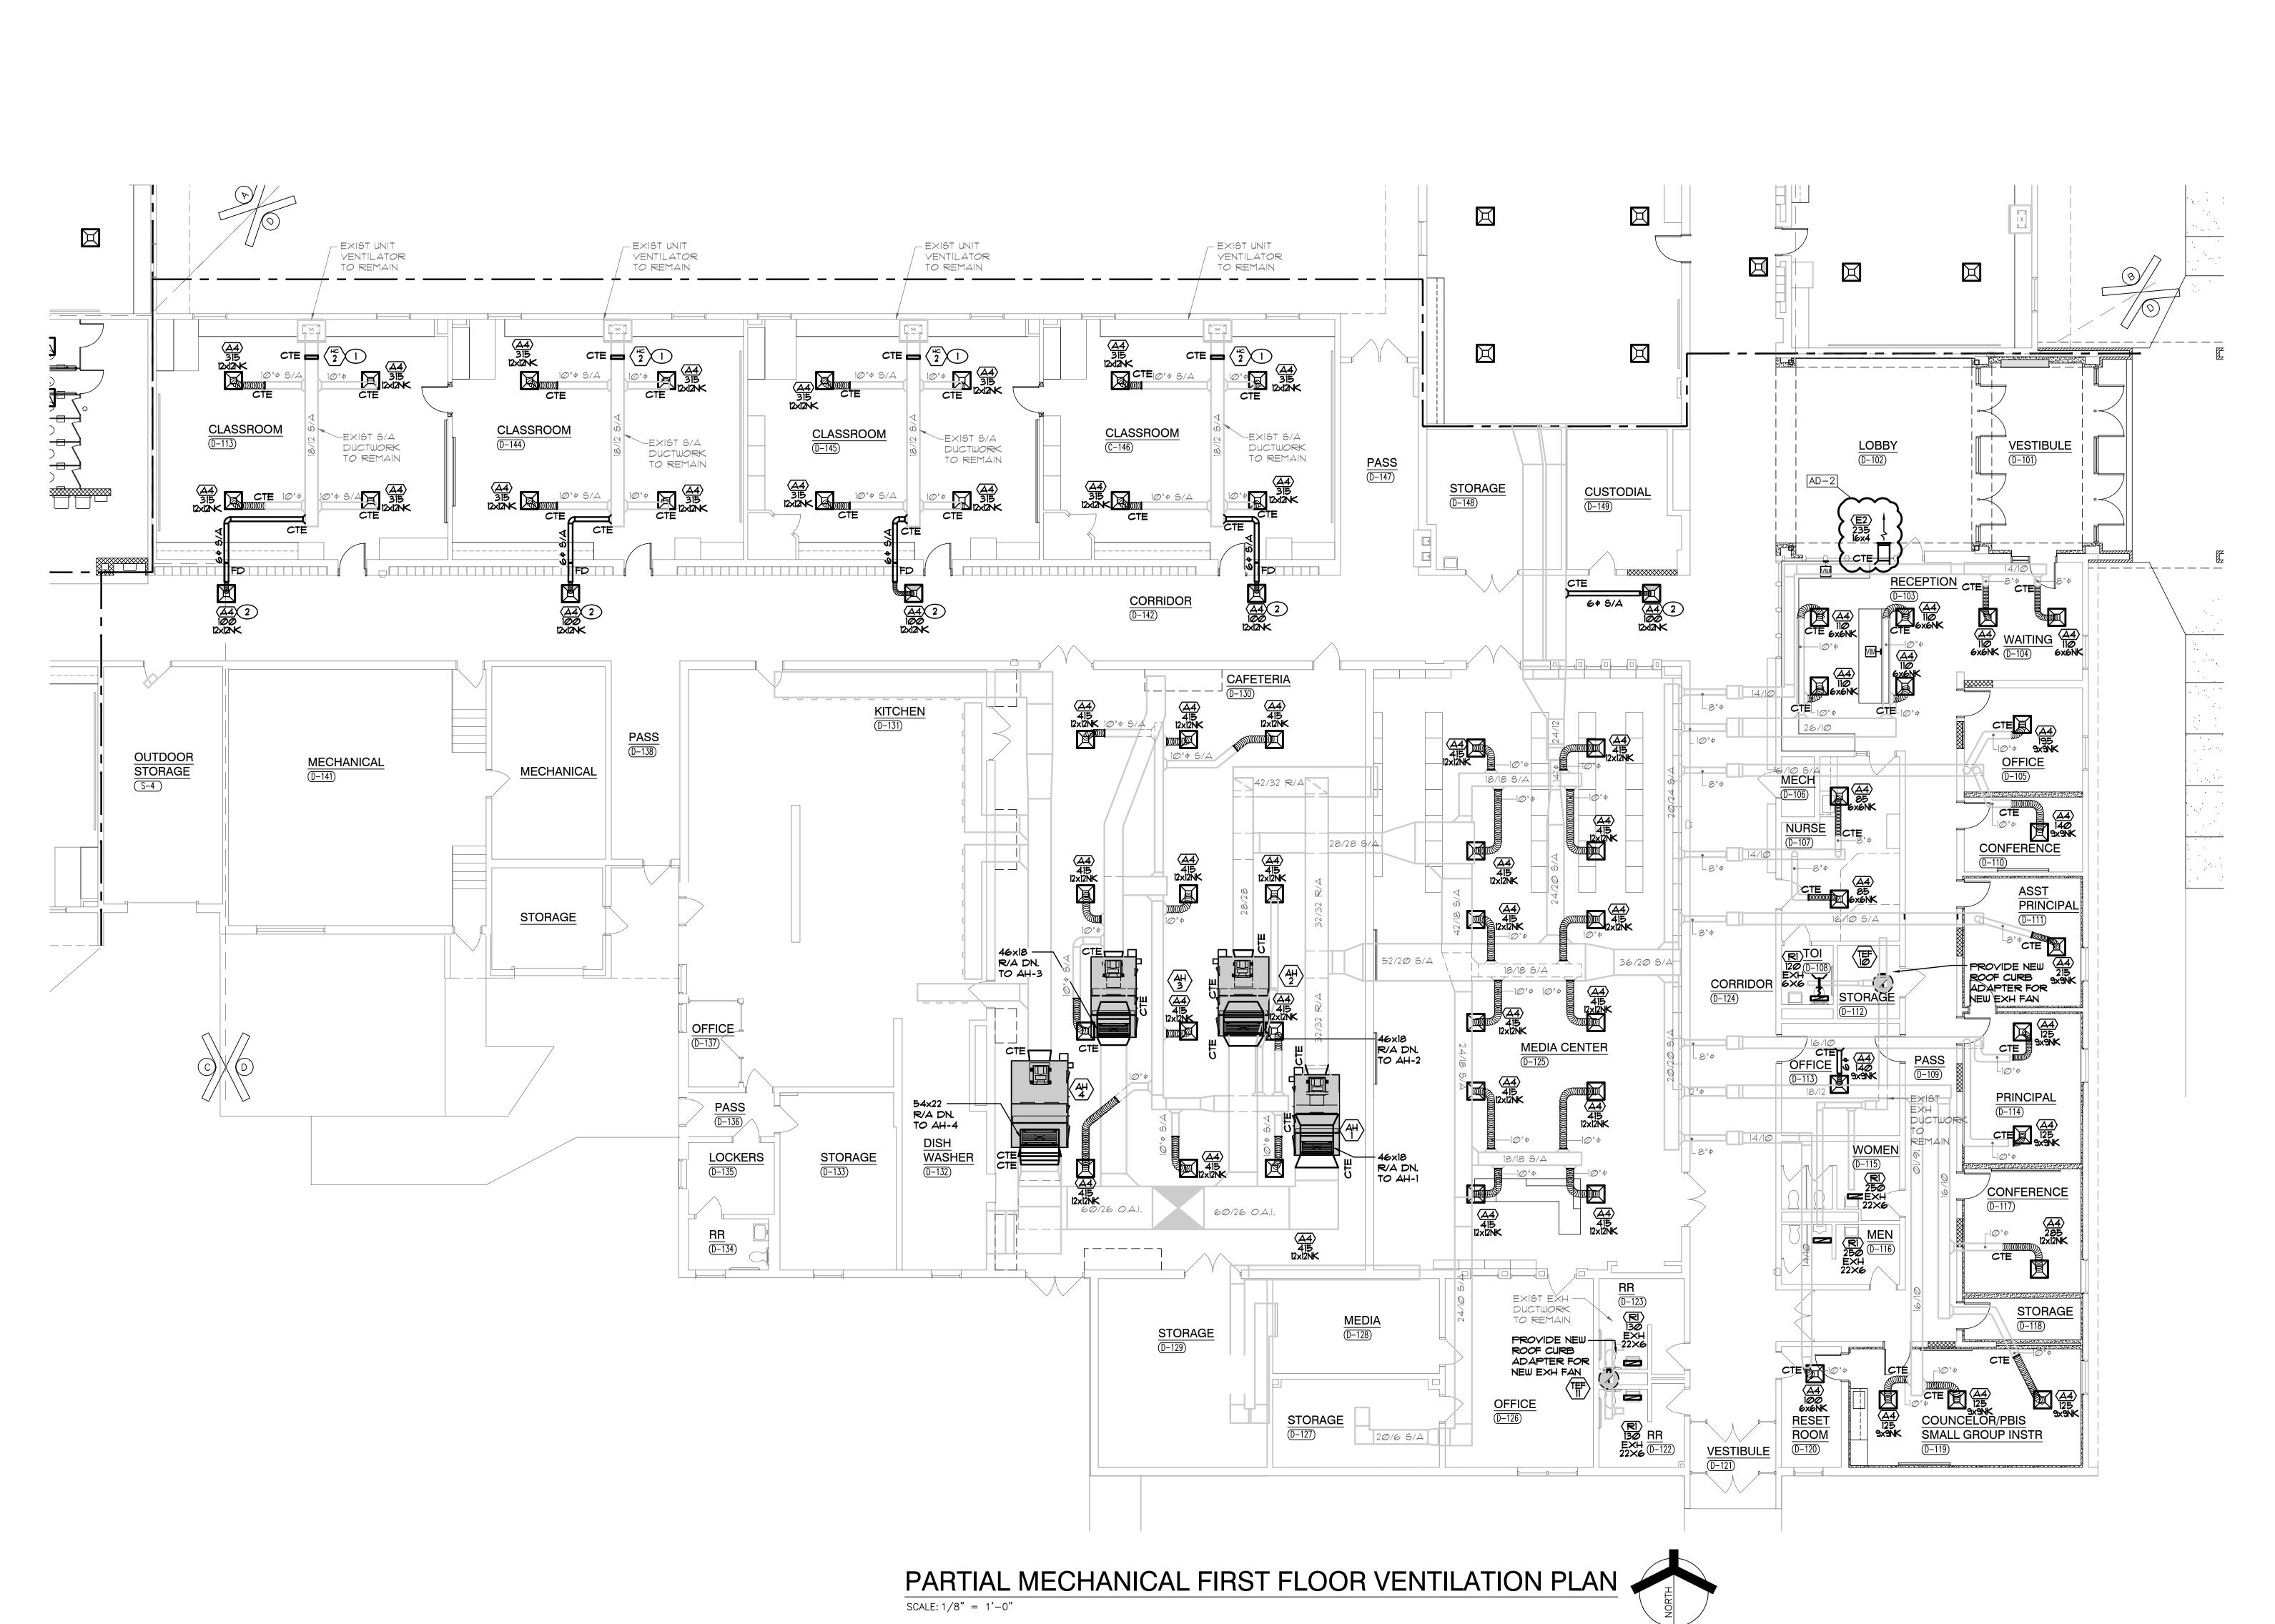

								ME	ECHA	NIC	AL E	EQUI	PME	ENT S	CHED	ULE														
					FAN MOT	OR DATA					CHILLED W	ATER COO	DLING EQU	NUIPMENT/COIL	DATA		НОТ	WATER HEAT	TING EQ	JIPMENT/C	OIL DATA					ELECT	RICAL DAT	Δ	UNITS	EQUIPMENT
TAG	MANUFACTURER	MODEL NUMBER	DESCRIPTION	EFF	1 1	MIN OAI CFM		_								MAX	MBI						LOAD	.					7	WEIGHT REMAR
C-1	TRANE	RTAF-280	GRADE MOUNTED AIR COOLED CHILLER	10.06 EER	CFM -	HIGH LO	DW TSF	P ESP	BHP HP	RPM_	MBH SHC 3161 -	5 GPM E	DB EWE	B LDB LWB		T WPD	CAT (IN)) (OUT) (<u> </u>	<u> </u>		JT WPD	- 544		1PS MOC - 700		9HASE HZ 3 60	MC. EC.	BY FMS	1Ø52Ø NOTE 1
AH-1	TRANE	UCCAHIØ	INTERIOR CENTRAL STATION AIR HANDLING UNIT HW HEATING / CHW COOLING - YAY		4125	1265	_	3	4.7 5	2240			309 654	6 50.2 50.1		4 15		214.6	21 4	6 94	180 16	<i>a</i> 15	- 28		- 50		3 60		FMS	1705 NOTE 2
AH-2	TRANE	UCCAH12	INTERIOR CENTRAL STATION AIR HANDLING UNIT HW HEATING / CHW COOLING - SZVAV			1500			5.9 7 1/2					32 592 582		1 15				61 96			- 35.5		- 60		3 60		FMS	1826 NOTE 2
							- -										- -													
AH-3	TRANE	UCCAHIØ	INTERIOR CENTRAL STATION AIR HANDLING UNIT HW HEATING / CHW COOLING - SZVAV	-		2000 -			4.8 7 1/2					Ø 54.4 54.Ø		1 15		286	29 4	Ø 92	180 16	0 15	- 35.5		- 60		3 60		FMS	169Ø NOTE 2
AH-4	TRANE	UCCAHIT	INTERIOR CENTRAL STATION AIR HANDLING UNIT CHW COOLING - SZYAY	-	8500	2125 -		1.5	9.4 10	2442	334 235	67 8	67.0 67.0	Ø 54.9 54.2	42 54	15		-	- '			-	- 53	- .	- 90	208	3 60	· × -	FMS	2099 NOTE 2
AH-5	TRANE	UCCAH12	INTERIOR CENTRAL STATION AIR HANDLING UNIT HW HEATING / CHW COOLING - YAY	-	6000	1500 .	- -	3	7.I 1Ø	2665	241 185	48 8	31.6 66.	.4 53.6 53.1	42 54	1 15	- -	337	34 4	5 96	180 16	0 15	- 53	-	- 90	208	3 60	· × -	FMS	191Ø NOTE 2
AH-6	TRANE	UCCAH3Ø	INTERIOR CENTRAL STATION AIR HANDLING UNIT HW HEATING / CHW COOLING - SZVAV	-	15000	5000 .		2	8.1 10	2291	553 353	3 110 8	30.3 69.	3.1 58.9 57.8	42 54	15		83Ø	83 4	5 96	180 16	0 15	- 74.8	3 -	- 125	208	3 60	· × -	FMS	33ØT NOTE 2
U ∨- 1	ENGINEERED AIRE	RUV-1600	VERTICAL UNIT VENTILATOR - 4 PIPE HW HEATING/CHW COOLING	-	1600	460	- -	-	- 3/4	-	63 43	12 8	67.0	Ø 55.Ø 54.Ø	42 54	15		ושו	11 4	0 95	180 16	Ø 15	- 13	- -	- 20	120	1 60	· × -	FMS	TOO NOTE 3
FC-1	TRANE	BHCEØ36	HORIZONTAL DUCTED FAN COIL - HW HEATING / CHW COOLING	-	830	215	- -	0.8	Ø.4 1/2	1448	36 26	7.4	19.0 64.0	Ø 50.0 46.0	42 54	5		82.3	8.1 4	7 138	180 16	0 5	- 9.3		- 15	120	1 60	· × -	FMS	299 NOTE 4
FC-2	TRANE	FCCBØ6Ø	HORIZONTAL DUCTED FAN COIL - HW HEATING / CHW COOLING	-	555	180 .		0.5	Ø.1 2/9	1273	23 16	8 8	32.4 67.8	.8 55.9 54.6	42 54	5		18	2.3 4	6 76	180 16	Ø 5	- 3.88	3 -	- 15	120	1 60	· × -	FMS	128 NOTE 4
FC-3	TRANE	FCCBØ6Ø	HORIZONTAL DUCTED FAN COIL - HW HEATING / CHW COOLING	-	520	190 .		0.4	- 2/9	-	20 14	6.3 8	66.	8 55.6 54.4	42 54	5		19.5	0.8	2 77	180 16	Ø 5	- 3.88	3 -	- 15	120	1 60	· × -	FMS	128 NOTE 4
TEF-1	TWIN CITY	VC-Ø98	ROOF MOUNTED TOILET EXHAUST FAN	-	320		- 06	- 8	Ø.1 1/6	1428		-	- -			-		-	-			-	1/6 -			120	1 60	· - ×	FMS	IØØ NOTE 5
TEF-2	TWIN CITY	DCRD 140	ROOF MOUNTED TOILET EXHAUST FAN	-	1110		- 06	.3 -	Ø2 3/4	1206		-				-		-	-	. -	- -	-	3/4 -			120	1 60	- ×	FMS	200 NOTE 5
TEF-3	TWIN CITY	DCRD 140	ROOF MOUNTED TOILET EXHAUST FAN	-	1410		- 06	,3 -	<i>0.</i> 3 3/4	13Ø2		-				-		-	-	. -			3/4 -			120	1 60	- ×	FMS	200 NOTE 5
TEF-4	TWIN CITY	DCRD 140	ROOF MOUNTED TOILET EXHAUST FAN	-	1840		- 0.6	-3 -	<i>0.</i> 4 3/4	1464		-				-		-		. -		_	3/4 -			120	1 60	- ×	FMS	200 NOTE 5
TEF-5	TWIN CITY	VC-Ø98	ROOF MOUNTED TOILET EXHAUST FAN	-	300		- 06	3 -	Ø.1 1/6	1412		-				-		-	- .				1/6 -	-		120	1 60	· - ×	FMS	100 NOTE 5
TEF-6	TWIN CITY	VC-Ø98	ROOF MOUNTED TOILET EXHAUST FAN	-	320		- 06	-3 -	Ø.1 1/6	1428		-				-		-	- .	. -			1/6 -			120	1 60	· - ×	FMS	100 NOTE 5
TEF-T	TWIN CITY	VC-Ø98	ROOF MOUNTED TOILET EXHAUST FAN	-	320		- 0.6	-3	Ø.1 1/6	1428		-				-		-		. -			1/6 -			120	1 60	· - ×	FMS	100 NOTE 5
TEF-8	TWIN CITY	VC-Ø98	ROOF MOUNTED TOILET EXHAUST FAN	-	320	- .	- 0.6	-3 -	Ø.1 1/6	1428		-	- -			-	- -	-				-	1/6 -		- -	120	1 60	- ×	FMS	100 NOTE 5
TEF-9	TWIN CITY	DCRD 140	ROOF MOUNTED TOILET EXHAUST FAN	-	1760	- .	- 06	- 3	<i>Ø.</i> 4 3/4	1432		-	- -			-		-	- .			-	3/4 -		- -	120	1 60	- ×	FMS	200 NOTE 5
TEF-10	TWIN CITY	VC-Ø85	ROOF MOUNTED TOILET EXHAUST FAN	-	120	-	- 0.50	ø -	0 1/6	1676		-				-		-					1/6 -			120	1 60	- ×	FMS	100 NOTE 5
TEF-11		VC-Ø98	ROOF MOUNTED TOILET EXHAUST FAN	-	520	-	- 06	-	Ø.1 1/6	1		-	- -			-		-	- .	. -			1/6 -			120	1 60	I I	FMS	100 NOTE 5
GEF-I		T-900H	CEILING MOUNTED GENERAL EXHAUST FAN (STORAGE C-126)	·	500	· ·	- 0.50		Ø.2 1/2						.		· ·					_	1/2 -			120	1 60		FMS	15 NOTE 1
CH-I		RW-04	RECESSED HW CABINET HEATER	<u> </u>	430			~~~	- **	<u> </u>				4. ·		-			3 6		180 16				4 15		1 60	l I	FMS	128 NOTE 6

NOTES:

FILTERS

REQUIREMENTS

4. PROVIDE WITH:
• DISCONNECT SWITCH PROVIDE WITH: VIBRATION ISOLATION · SOUND ATTENUATION KIT . TERMINAL STRIPS NEOPRENE PADS SEE SPECIFICATIONS FOR

2. PROVIDE WITH: SEE SECTIONS FOR MODULAR REQUIREMENTS SEE SPECIFICATIONS FOR ADDITIONAL

SEE SPECIFICATIONS FOR ADDITIONAL

SEE SPECIFICATIONS FOR ADDITIONAL REQUIREMENTS

REQUIREMENTS . PROVIDE WITH: · INTEGRATED ENTHALPY ECONOMIZER DISCONNECT SWITCH FACE/BYPASS DAMPER

> REQUIREMENTS 7. PROYIDE WITH:

REQUIREMENTS

REQUIREMENTS

6. PROVIDE WITH:

 BUILT IN BACK DRAFT DAMPER VIBRATION ISOLATORS INLINE ADAPTER · WALL CAP SEE SPECIFICATIONS FOR ADDITIONAL

SEE SPECIFICATIONS FOR ADDITIONAL

SEE SPECIFICATIONS FOR ADDITIONAL

 INTEGRAL THERMOSTAT DISCONNECT SWITCH

• DISCONNECT SWITCH											
 VIBRATION ISOLATION HANGERS TERMINAL STRIPS FOR DDC READY SEE SPECIFICATIONS FOR ADDITIONAL 		DUCT N	NOUNTED H	W HE	ATIN	G C	OIL	SC	HED	ULE	
REQUIREMENTS	TAG	MANUFACTURER	MODEL	SIZE	CFM	HW REH	EAT COIL	DATA			
				W×H		MBH	GPM	WPD	EAT	EWT	REMARKS
PROVIDE WITH: ECM MOTOR WITH POTENTIOMETER	HWC-1	TRANE	DWPB1202	20 × 12	1,600	39.9	4.0	5'	55	100	
SPEED CONTROLLER • MOTORIZED DAMPER	HWC-2	TRANE	DWPB1201	18 × 12	1,200	31.3	3.2	5'	55	100	
BIRD SCREENROOF CURB ADAPTOR	HWC-3	TRANE	DWPB1201	14 × 10	800	20.7	1.2	5'	55	100	

		IN	IAKE	RELIEF I	100D 2C	HEPULE
TAG	MANUFACTURER	MODEL *	THROAT SIZE	DESCRIPTION	HOOD LOCATION	REMARKS
RH-1	ACME	#TIV	SEE Plans	RELIEF AIR HOOD	ROOF	PROVIDE W/ BIRDSCREEN, BAROMETRIC RELIEF DAMPER. AND 18' HIGH ROOF CURB.

							PU	MP	SC	HE	DL	JLE		
							PUMP 1	MOTOR	DATA				SUCTION/	
TAG	MANUFACTURER	MODEL NUMBER	DESCRIPTION	GPM	HEAD	HP	RPM	VOLT	PHASE	HZ.	STAR	TER:	DISCHARGE	REMARKS
					(FT.)						MC.	EC.	SIZE	
CP-1	BELL 4 GOSSETT	SERIES ISIØ 5A	CHILLED WATER RECIRCULATION PUMP	524	32	1/2	1623	208	3	60	×	-	5' / 4'	-
CWP-1	BELL 4 GOSSETT	SERIES 1510 5A	CHILLED WATER DISTRIBUTION PUMP	262	75	10	1654	208	3	60	×	-	3' / 2.5'	CHILLED WATER PRIMARY PUMPS W/VFD OPERATING IN
CWP-2	BELL 4 GOSSETT	SERIES 1510 5A	CHILLED WATER DISTRIBUTION PUMP	262	75	10	1654	208	3	60	×	-	3' / 2.5'	PARALLEL. 524 GPM AT 15 FT. HD. WITH DUAL POWER FEEDERS

REFER TO SPECIFICATIONS FO	PR ADDITIONAL INSULATION REQUIREMENTS	
		ION TYPE
DUCTWORK TYPE		
	CONCEALED	EXPOSED
SUPPLY AIR DUCTWORK		
RECTANGULAR	11/2" LINER	11/2" LINER
ROUND	11/2" WRAP, NOTE 1.	PERFORATED DOUBLE WALL
RETURN AIR DUCTWORK		
RECTANGULAR	11/2" LINER	11/2" LINER
ROUND	PERFORATED DOUBLE WALL	PERFORATED DOUBLE WALL
JTSIDE AIR DUCTWORK		
RECTANGULAR	1½" WRAP	1½¹WRAP
TRANSFER AIR DUCTWORK	1/2" LINER	1/2" LINER
EXHAUST DUCTWORK		
WITHIN 10'-0" OF EXHAUST FAN	1/2" LINER	1/2" LINER

TAG	MANUFACTURER	MODEL NO.	DESCRIPTION	AIR PATTERN	MOUNTING	SIZE	TYPE OF CONTROL	REMARKS
A4	NAILOR	6500-0	SUPPLY CEILING DIFFUSER	4-WAY	2' × 2' LAY-IN PANEL	SEE PLANS	OBD.	
E2	NAILOR	61DH-0	SUPPLY CEILING REGISTER	DOUBLE DEFLECTION	SURFACE MOUNTED	SEE Plans	O.B.D.	HORIZONTAL FRONT BARS, VERTICAL BACK BARS
KI	NAILOR	61DHC	SUPPLY REGISTER	DOUBLE DEFLECTION	DUCT MOUNTED	SEE PLANS	FULL LENGTH EXTRACTOR	PROVIDE W/ MILL FINISH
RI	NAILOR	6145H-O	RETURN/EXHAUST REGISTER	LOUVERED GRILLE	LAY-IN PANEL	SEE Plans	O.B.D.	-
R2	NAILOR	6145H-O	RETURN/EXHAUST REGISTER	LOUVERED GRILLE	SURFACE MOUNTED	SEE Plans	-	-
TI	NAILOR	6145H	RETURN/EXHAUST/T.A. GRILLE	LOUVERED GRILLE	LAY-IN PANEL	SEE Plans	-	-
T8	NAILOR	6145H-HD	RETURN/EXHAUST/T.A. GRILLE	LOUVERED GRILLE	SURFACE MOUNTED	SEE Plans	-	HEAVY DUTY GRILLE



GIBRALTAR DESIGN


ARCHITECTURE ◆ ENGINEERING ◆ INTERIOR DESIGN



LAKE STREET ELEMENTARY SCHOOL ADDITION, RENOVATION AND RELATED WORK

CROWN POINT COMMUNITY SCHOOL CORPORATION

CROWN POINT, INDIANA

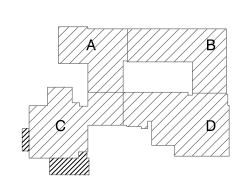

FIRST FLOOR KEY PLAN

GIBRALTAR DESIGN 9102 N. Meridian St., Ste. 300 Indianapolis, IN 46260 Homepage www.GibraltarDesign.com
Email info@GibraltarDesign.com
Phone 317.580.5777 Fax 317.580.5778

PROJECT 21-117 05/15/23 COORDINATED B'

DRAWN BY

CHECKED BY COPYRIGHT NOTICE: THE CONCEPTS, DESIGNS, PLANS, DETAILS, ETC, SHOWN ON THIS DOCUMENT ARE THE PROPERTY OF GIBRALTAR DESIGN AND WERE CREATED FOR USE ON THIS SPECIFIC PROJECT. NONE OF THIS INFORMATION SHALL BE USED BY ANY PERSON OR FIRM FOR ANY PURPOSE WITHOUT THE EXPRESS WRITTEN CONSENT OF GIBRALTAR DESIGN. THE OWNER MAY RETAIN COPIES FOR INFORMATION AND REFERENCE IN CONNECTION ONLY WITH THIS PROJECT.

MARK DATE ISSUED FOR AD-2 06/02/23 ADDENDUM NO. 02

DRAWING


MECHANICAL DETAILS & DIAGRAMS

PROJECT
LAKE STREET ELEMENTARY SCHOOL
ADDITION, RENOVATION AND
RELATED WORK

© GIBRALTAR DESIGN SHEET

Copyright © 2023 Millies Engineering Group


M-501

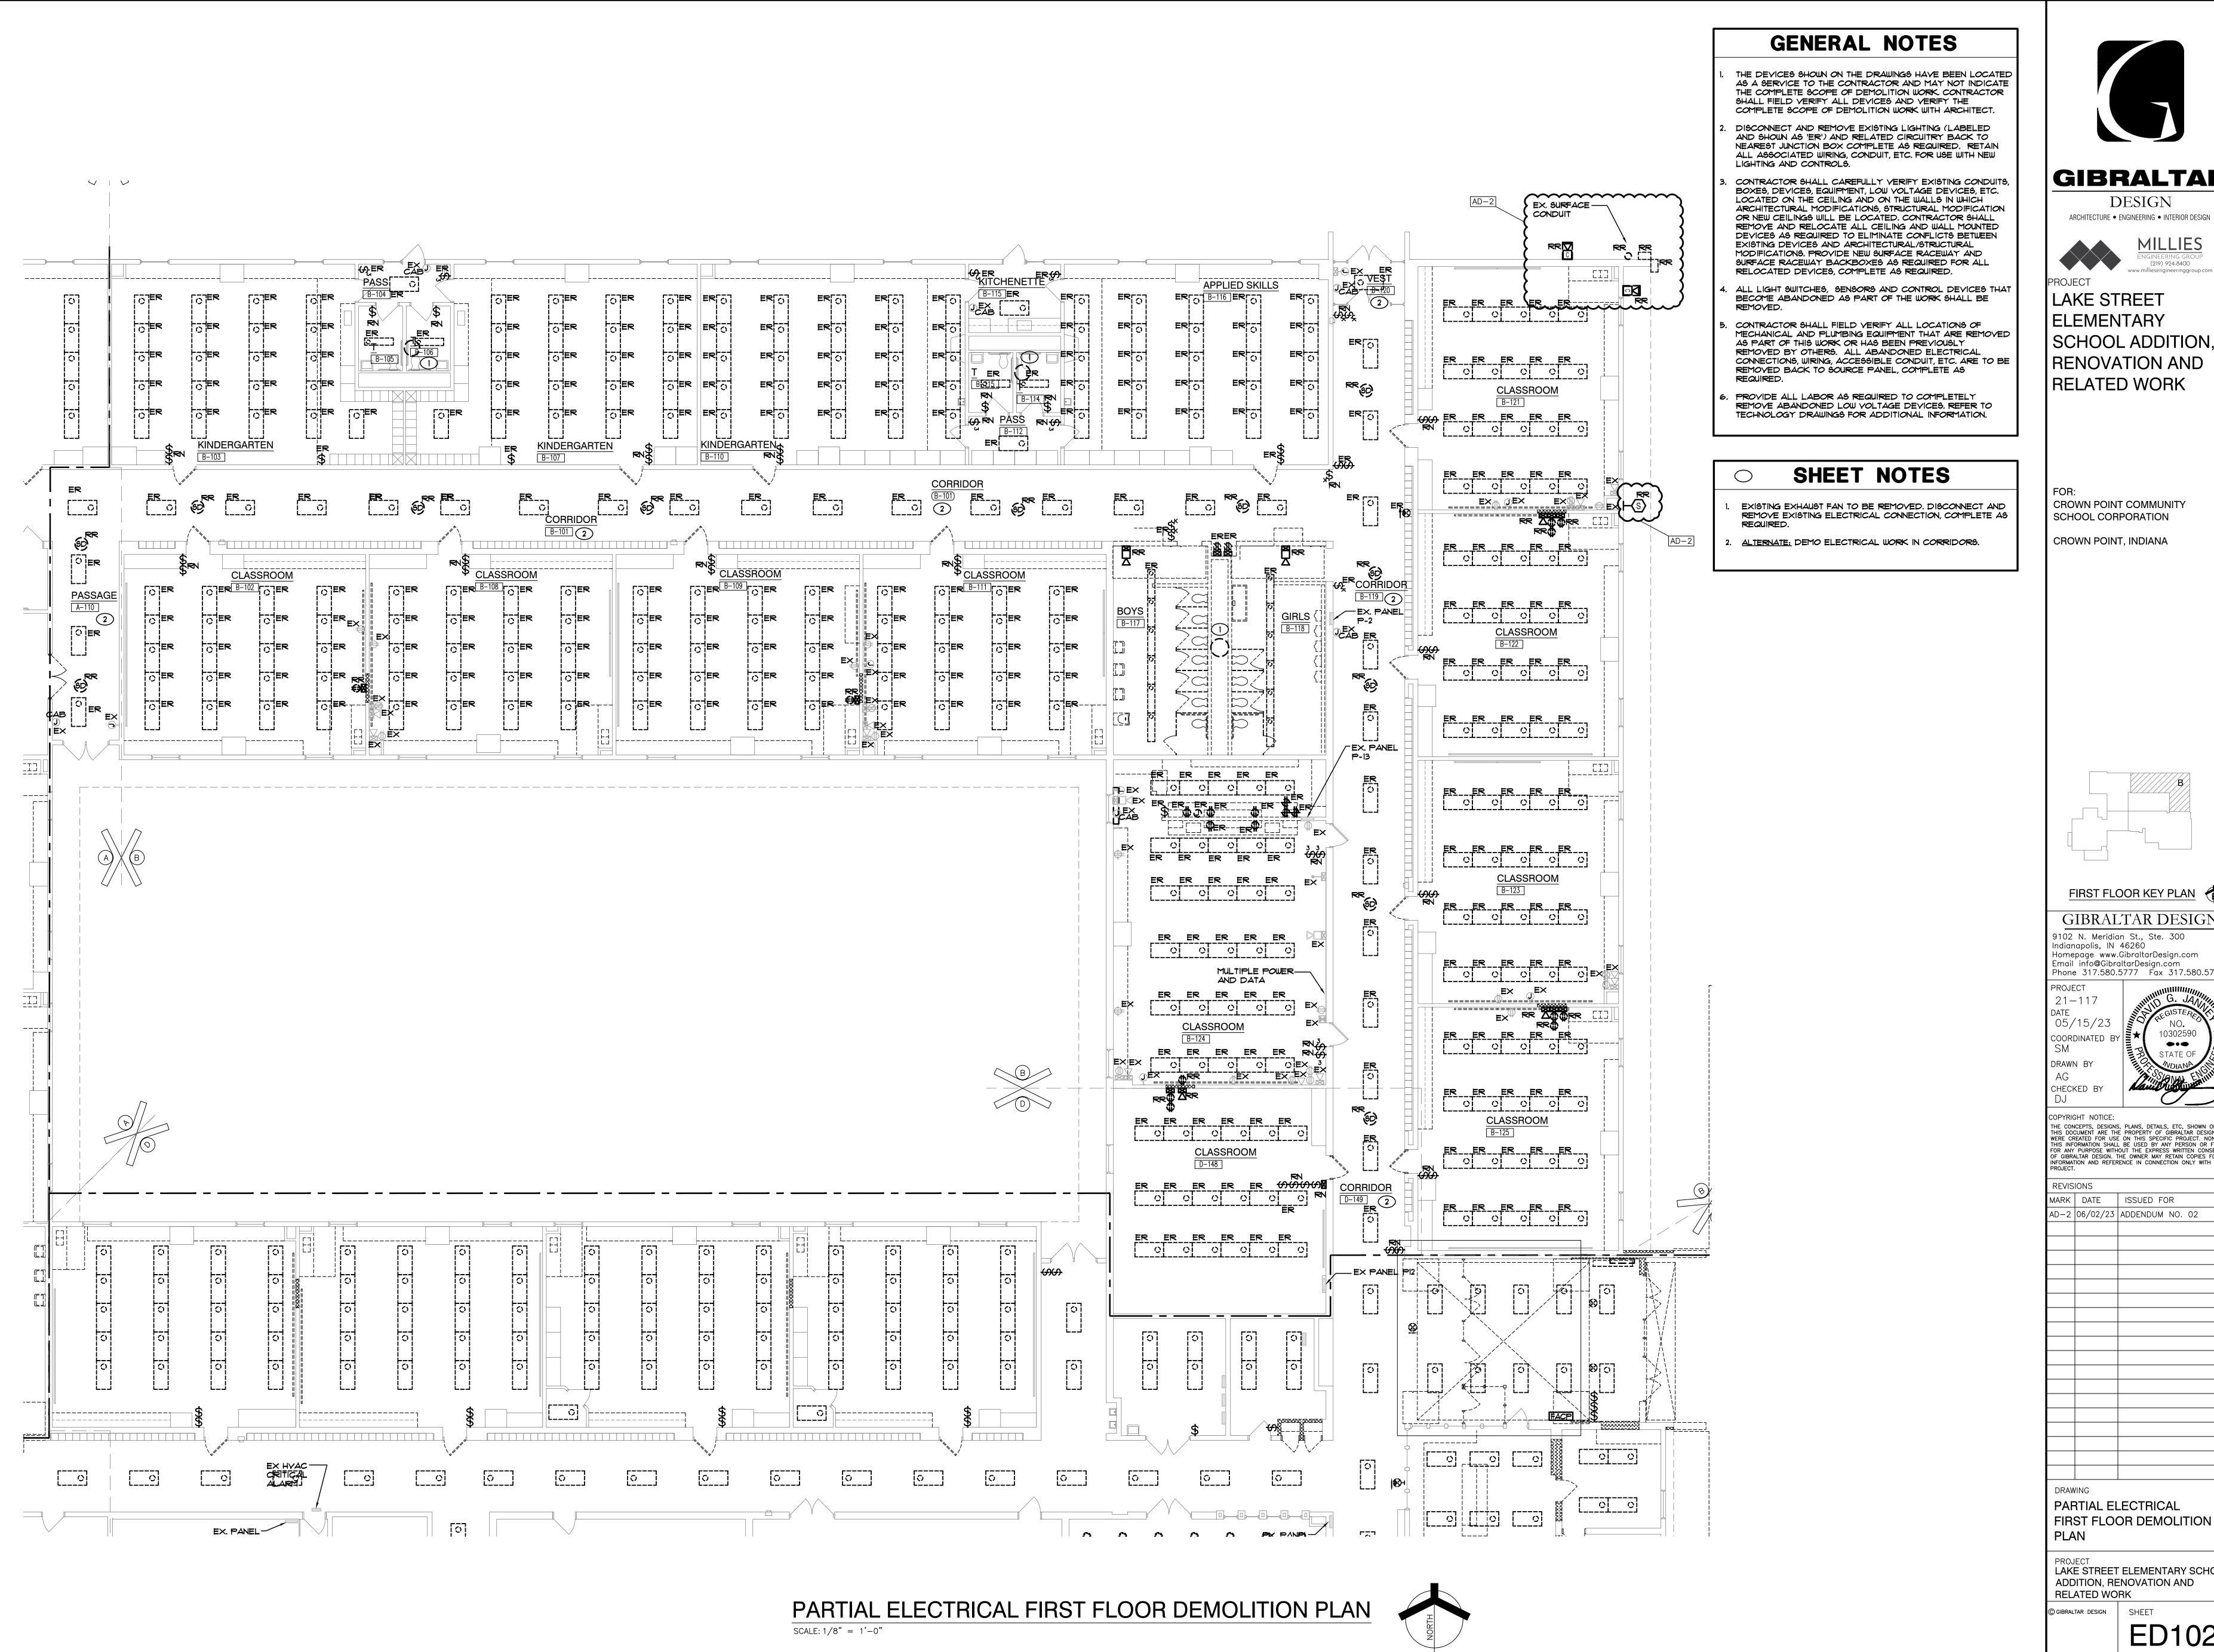

(219) 924-8400

LAKE STREET ELEMENTARY SCHOOL ADDITION RENOVATION AND RELATED WORK

CROWN POINT COMMUNITY SCHOOL CORPORATION CROWN POINT, INDIANA

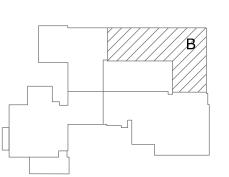

FIRST FLOOR KEY PLAN GIBRALTAR DESIGN

9102 N. Meridian St., Ste. 300 ndianapolis, IN 46260 Homepage www.GibraltarDesign.com Email info@GibraltarDesign.com

Phone 317.580.5777 Fax 317.580.577

COPYRIGHT NOTICE: THE CONCEPTS, DESIGNS, PLANS, DETAILS, ETC, SHOWN ON THIS DOCUMENT ARE THE PROPERTY OF GIBRALTAR DESIGN AND WERE CREATED FOR USE ON THIS SPECIFIC PROJECT. NONE OF THIS INFORMATION SHALL BE USED BY ANY PERSON OR FIRM FOR ANY PURPOSE WITHOUT THE EXPRESS WRITTEN CONSENT OF GIBRALTAR DESIGN. THE OWNER MAY RETAIN COPIES FOR INFORMATION AND REFERENCE IN CONNECTION ONLY WITH THIS PROJECT.

MARK DATE ISSUED FOR AD-2 06/02/23 ADDENDUM NO. 02

PARTIAL ELECTRICAL FIRST FLOOR DEMOLITION PLAN

LAKE STREET ELEMENTARY SCHOOL ADDITION, RENOVATION AND **RELATED WORK**

GIBRALTAR DESIGN SHEET

ED102

SHEET NOTES

- EXISTING AIR HANDLING UNIT TO BE REMOVED. DISCONNECT AND REMOVE EXISTING ELECTRICAL CONNECTION, COMPLETE AS REQUIRED.
- 2. <u>ALTERNATE:</u> DEMO ELECTRICAL WORK IN CORRIDORS.
- DISCONNECT AND REMOVE EXISTING ELECTRICAL CONNECTION, COMPLETE AS REQUIRED.
- 4. EXISTING EXHAUST FAN TO BE REMOVED. DISCONNECT AND REMOVE EXISTING ELECTRICAL CONNECTION, COMPLETE AS

GENERAL NOTES

- THE DEVICES SHOWN ON THE DRAWINGS HAVE BEEN LOCATED AS A SERVICE TO THE CONTRACTOR AND MAY NOT INDICATE THE COMPLETE SCOPE OF DEMOLITION WORK, CONTRACTOR SHALL FIELD VERIFY ALL DEVICES AND VERIFY THE COMPLETE SCOPE OF DEMOLITION WORK WITH ARCHITECT.
- DISCONNECT AND REMOVE EXISTING LIGHTING (LABELED AND SHOWN AS 'ER') AND RELATED CIRCUITRY BACK TO NEAREST JUNCTION BOX COMPLETE AS REQUIRED. RETAIN ALL ASSOCIATED WIRING, CONDUIT, ETC. FOR USE WITH NEW LIGHTING AND CONTROLS.
- CONTRACTOR SHALL CAREFULLY YERIFY EXISTING CONDUITS, BOXES, DEVICES, EQUIPMENT, LOW YOLTAGE DEVICES, ETC. LOCATED ON THE CEILING AND ON THE WALLS IN WHICH ARCHITECTURAL MODIFICATIONS, STRUCTURAL MODIFICATION OR NEW CEILINGS WILL BE LOCATED. CONTRACTOR SHALL REMOVE AND RELOCATE ALL CEILING AND WALL MOUNTED DEVICES AS REQUIRED TO ELIMINATE CONFLICTS BETWEEN EXISTING DEVICES AND ARCHITECTURAL/STRUCTURAL MODIFICATIONS. PROVIDE NEW SURFACE RACEWAY AND SURFACE RACEWAY BACKBOXES AS REQUIRED FOR ALL RELOCATED DEVICES, COMPLETE AS
- . ALL LIGHT SWITCHES, SENSORS AND CONTROL DEVICES THAT BECOME ABANDONED AS PART OF THE WORK SHALL BE REMOVED.
- 5. CONTRACTOR SHALL FIELD VERIFY ALL LOCATIONS OF MECHANICAL AND PLUMBING EQUIPMENT THAT ARE REMOVED AS PART OF THIS WORK OR HAS BEEN PREVIOUSLY REMOVED BY OTHERS. ALL ABANDONED ELECTRICAL CONNECTIONS, WIRING, ACCESSIBLE CONDUIT, ETC. ARE TO BE REMOVED BACK TO SOURCE PANEL, COMPLETE AS REQUIRED.
- 6. PROVIDE ALL LABOR AS REQUIRED TO COMPLETELY REMOVE ABANDONED LOW YOLTAGE DEVICES. REFER TO TECHNOLOGY DRAWINGS FOR ADDITIONAL INFORMATION.



DESIGN


PROJECT

ARCHITECTURE • ENGINEERING • INTERIOR DESIGN (219) 924-8400

LAKE STREET ELEMENTARY SCHOOL ADDITION RENOVATION AND RELATED WORK

CROWN POINT COMMUNITY SCHOOL CORPORATION

CROWN POINT, INDIANA

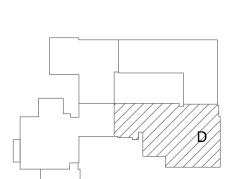

FIRST FLOOR KEY PLAN GIBRALTAR DESIGN

102 N. Meridian St., Ste. 300 Indianapolis, IN 46260
Homepage www.GibraltarDesign.com
Email info@GibraltarDesign.com

Phone 317.580.5777 Fax 317.580.577 COORDINATED

DRAWN B'

CHECKED BY


OPYRIGHT NOTICE: THE CONCEPTS, DESIGNS, PLANS, DETAILS, ETC, SHOWN ON THIS DOCUMENT ARE THE PROPERTY OF GIBRALTAR DESIGN AND WERE CREATED FOR USE ON THIS SPECIFIC PROJECT. NONE OF THIS INFORMATION SHALL BE USED BY ANY PERSON OR FIRM FOR ANY PURPOSE WITHOUT THE EXPRESS WRITTEN CONSENT OF GIBRALTAR DESIGN. THE OWNER MAY RETAIN COPIES FOR INFORMATION AND REFERENCE IN CONNECTION ONLY WITH THIS PROJECT


MARK DATE ISSUED FOR AD-2 | 06/02/23 | ADDENDUM NO. 02

PARTIAL ELECTRICAL FIRST FLOOR DEMOLITION PLAN

LAKE STREET ELEMENTARY SCHOOL ADDITION, RENOVATION AND **RELATED WORK**

© GIBRALTAR DESIGN SHEET ED104

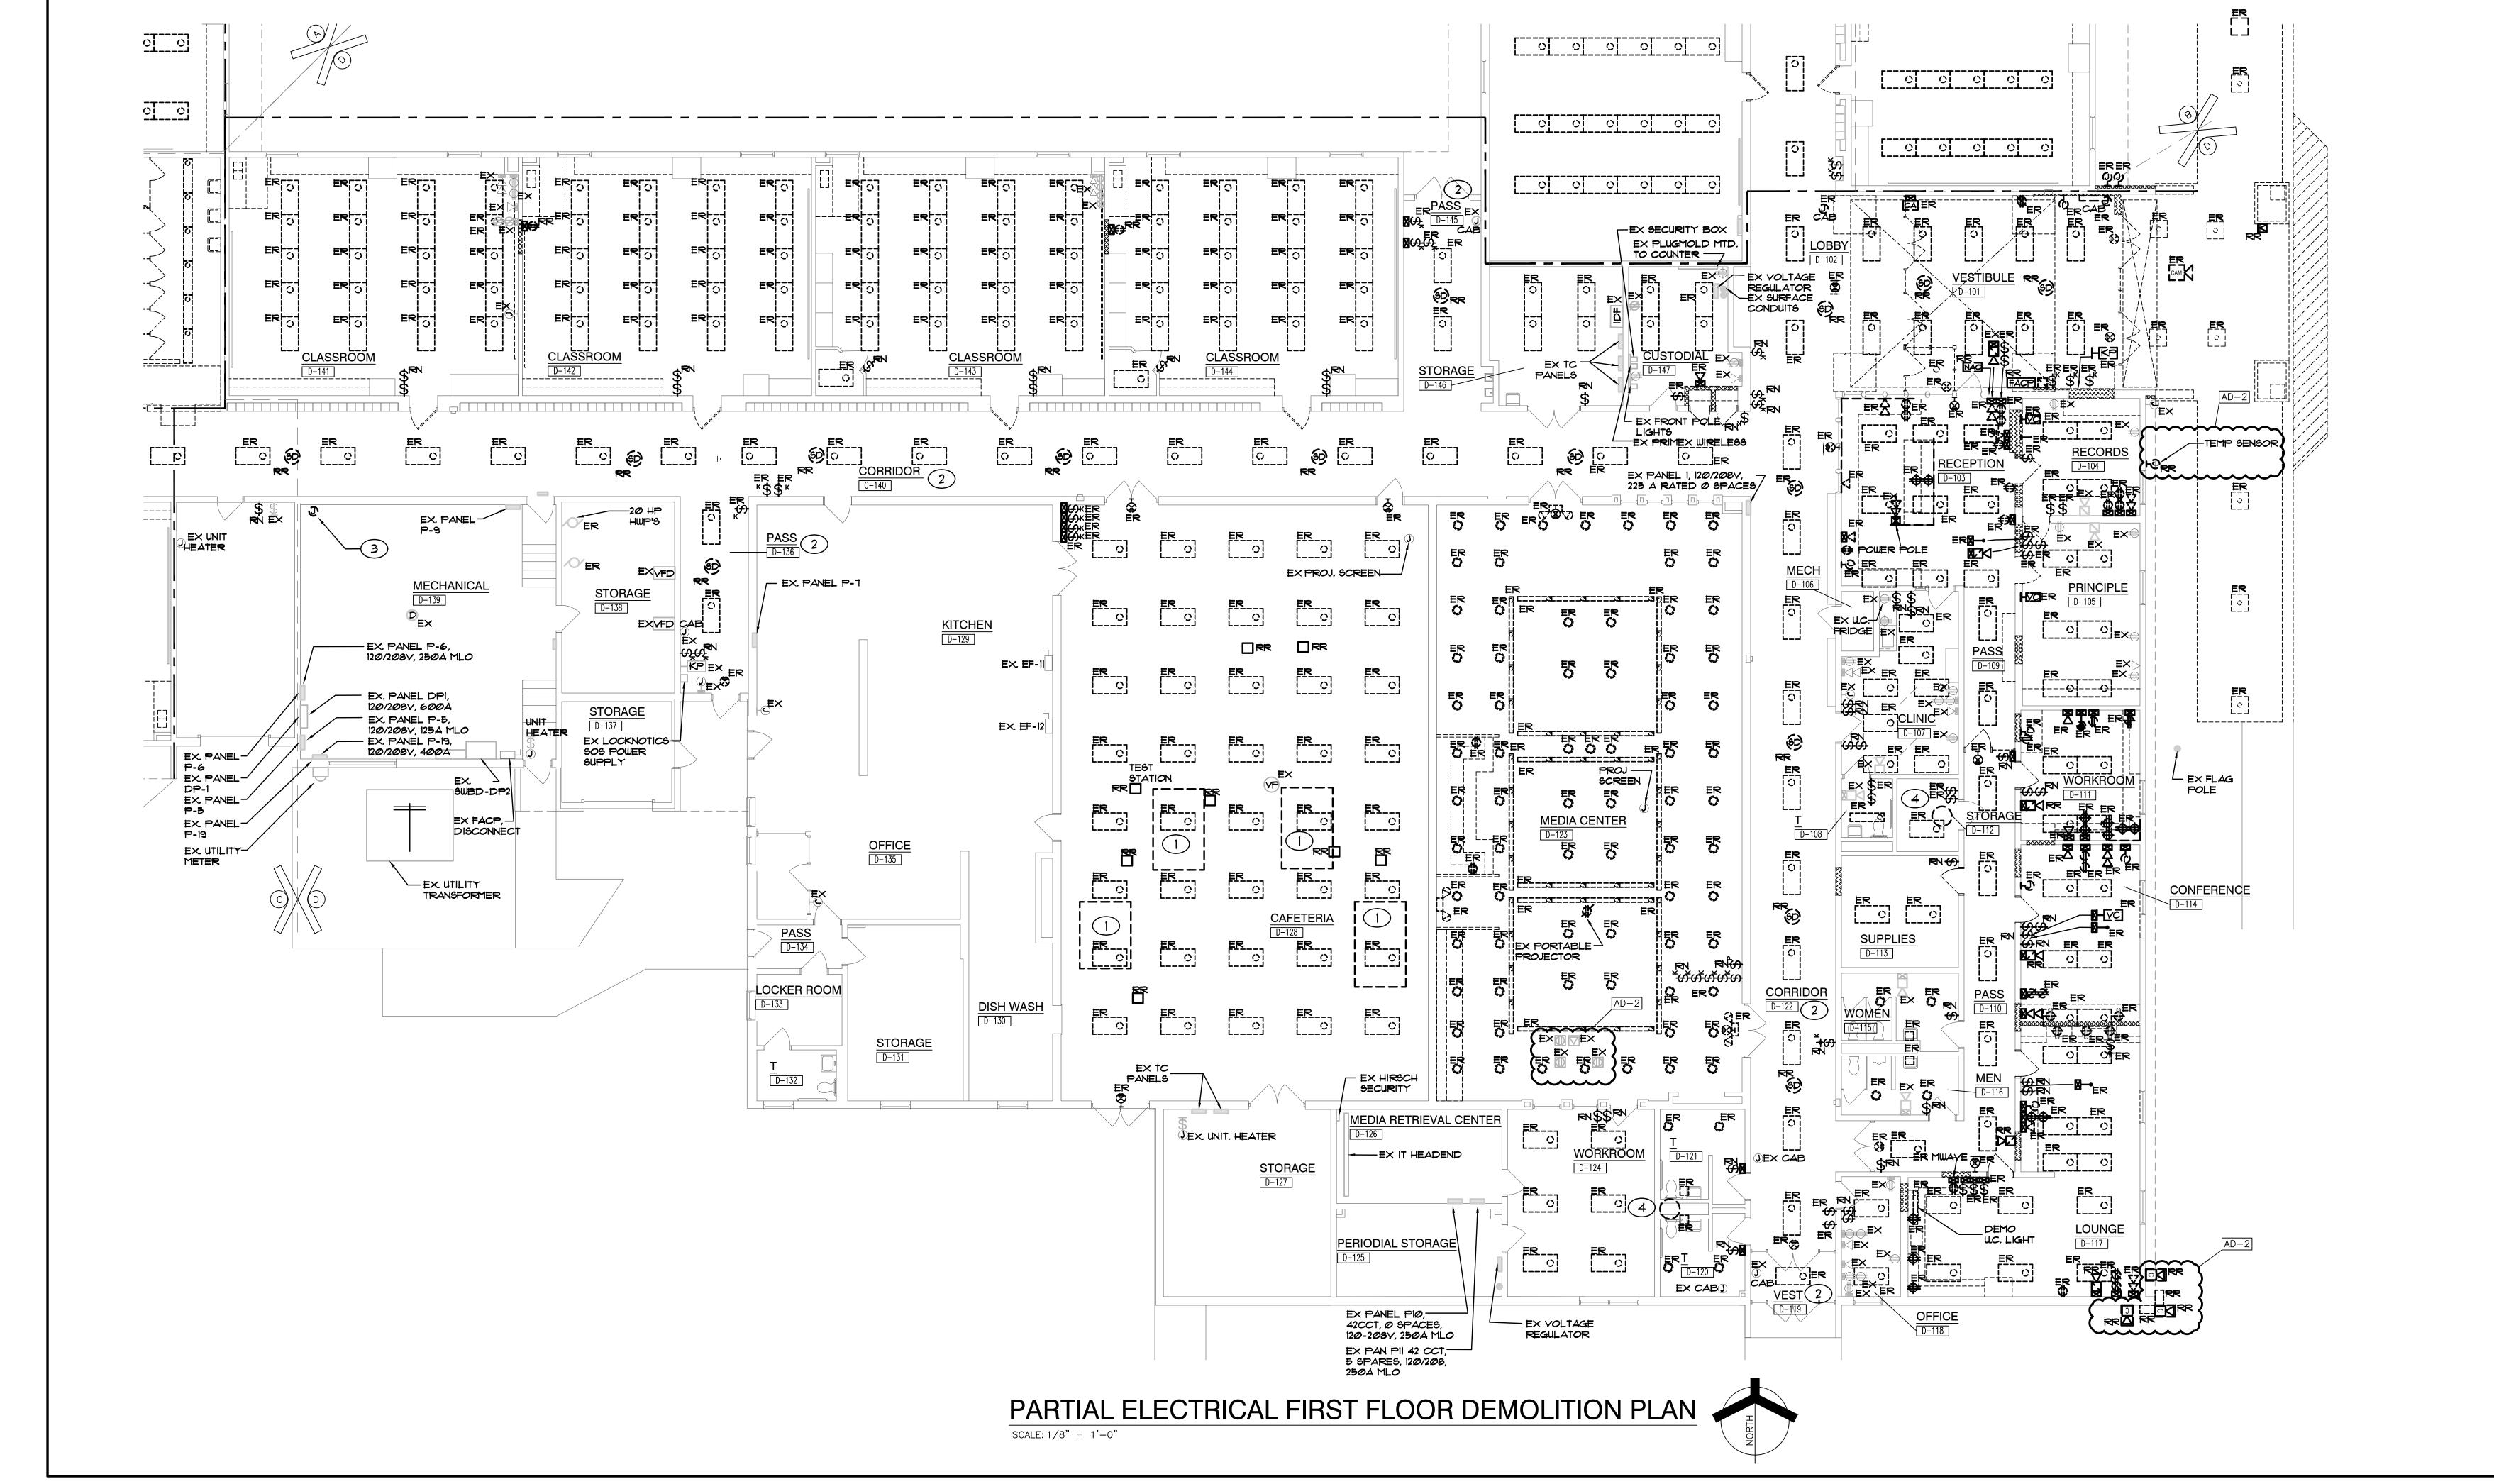

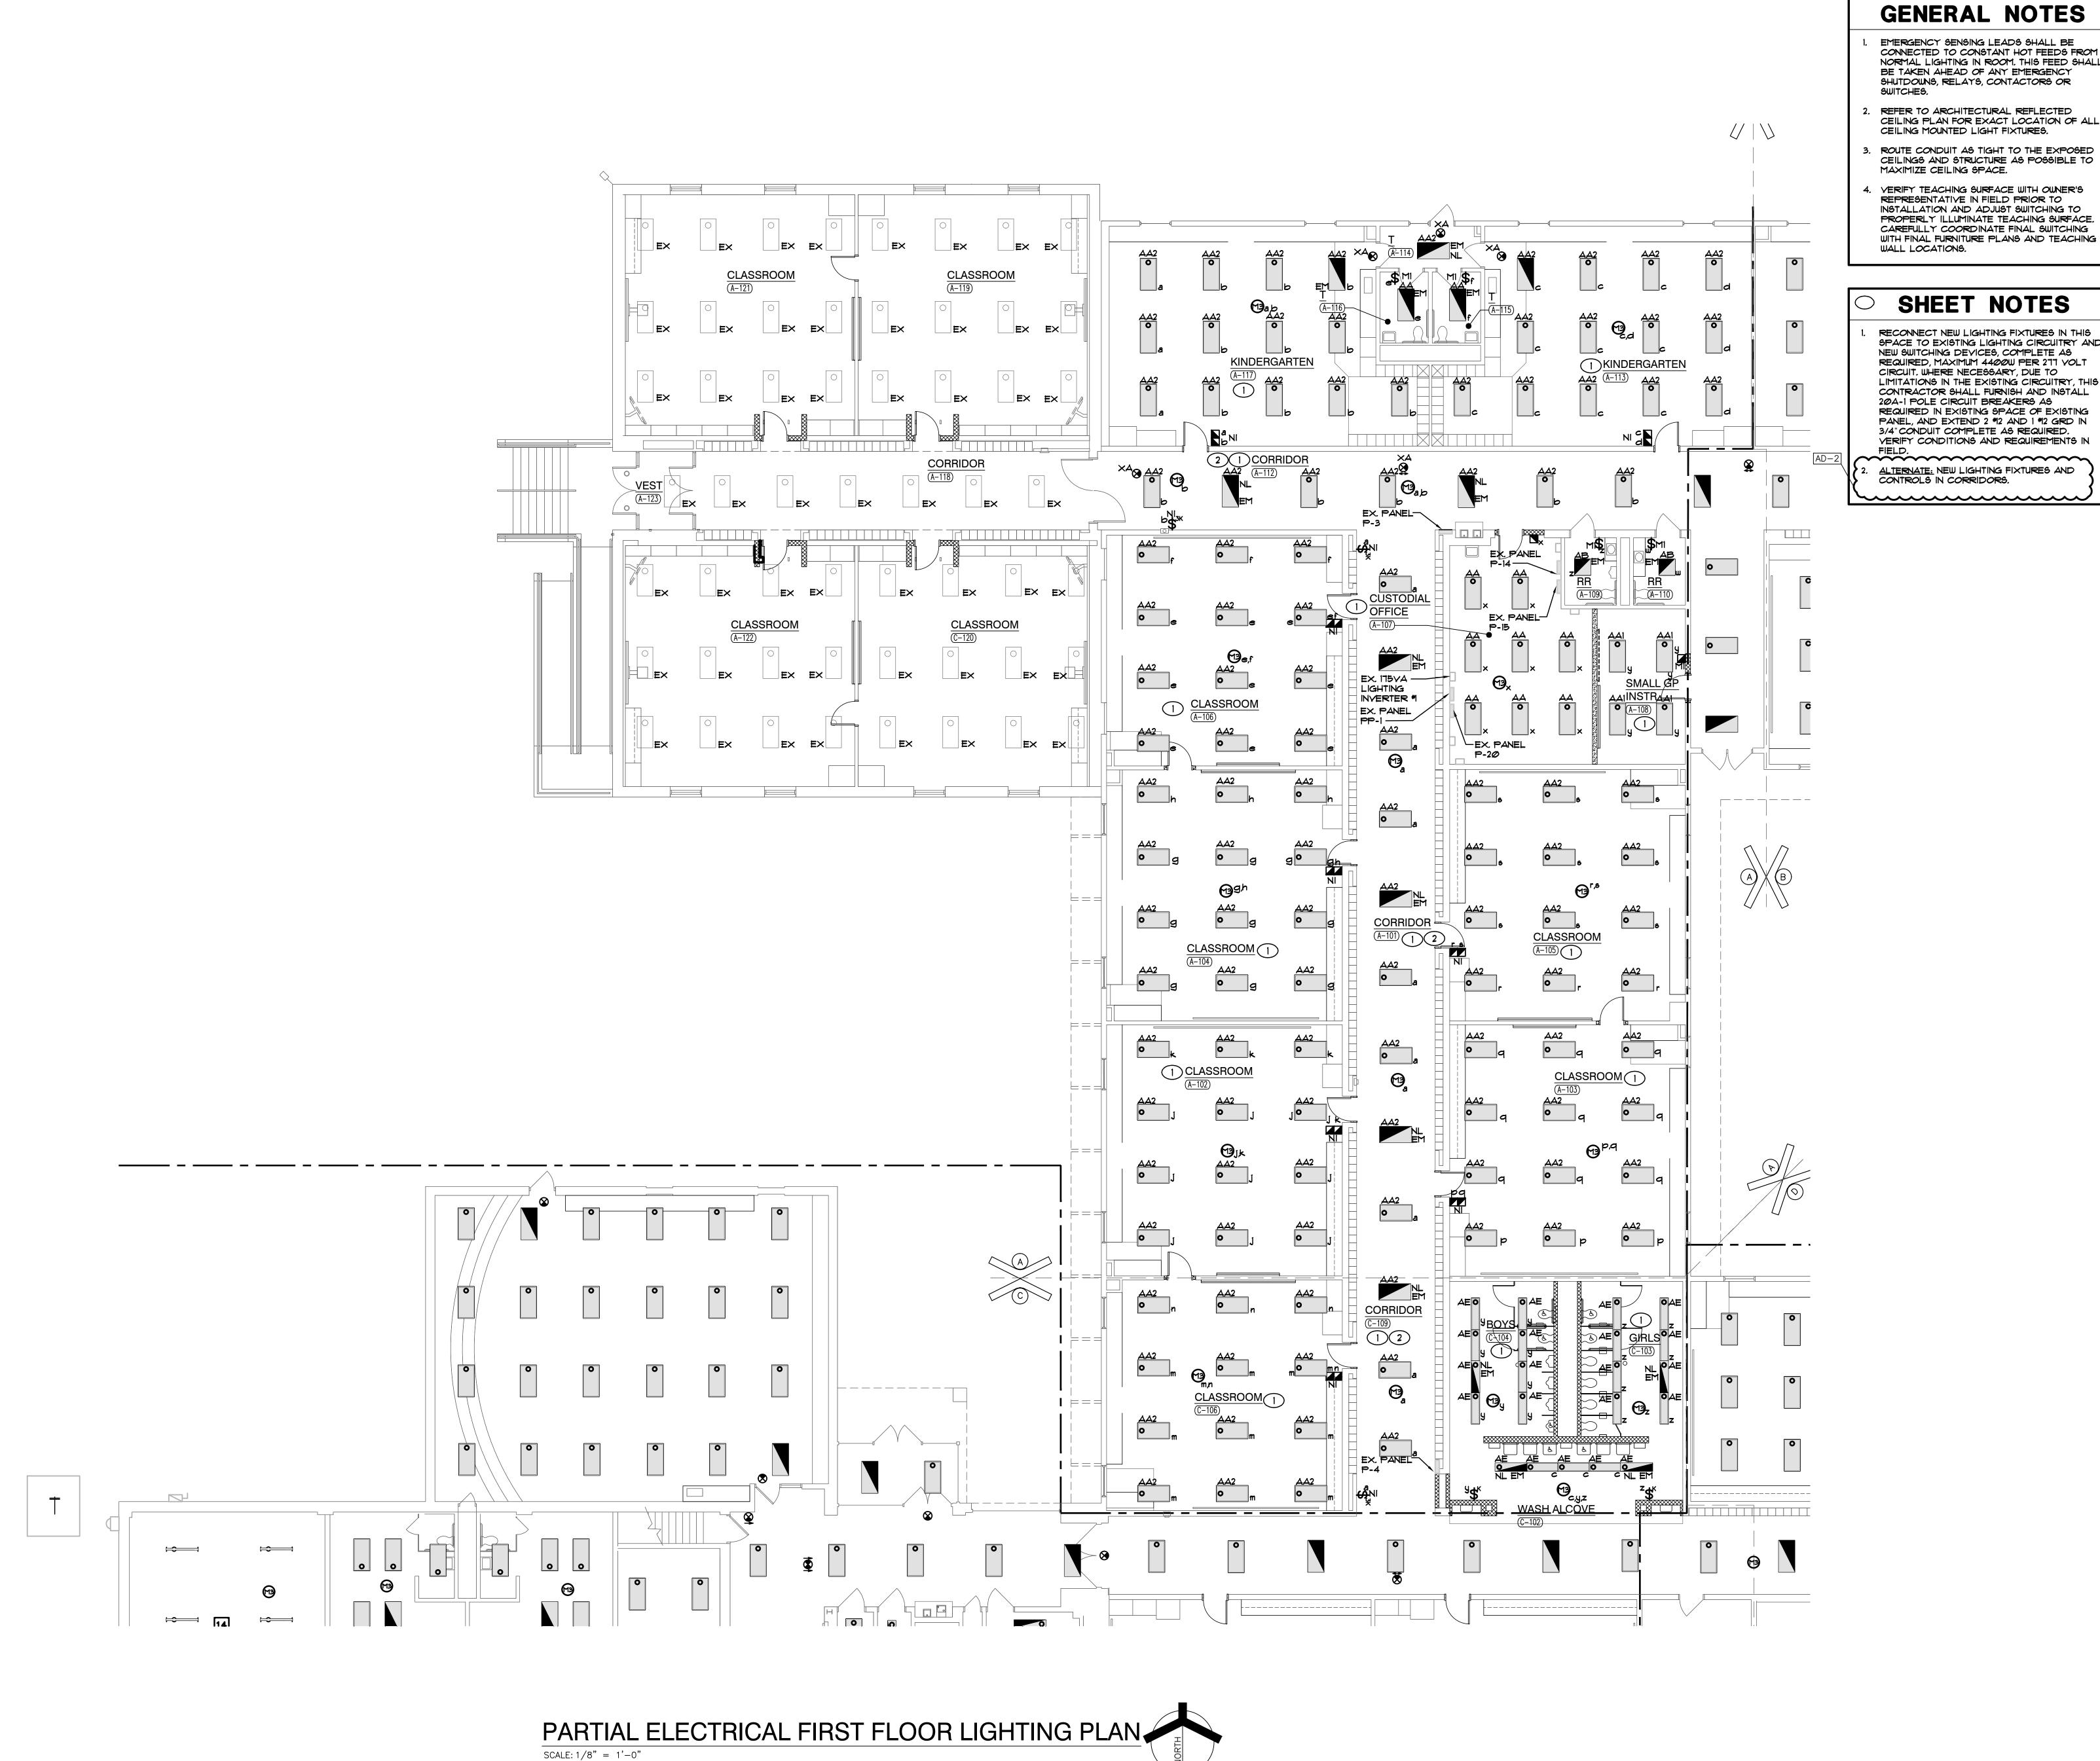

GENERAL NOTES

EMERGENCY SENSING LEADS SHALL BE CONNECTED TO CONSTANT HOT FEEDS FROM NORMAL LIGHTING IN ROOM. THIS FEED SHALL BE TAKEN AHEAD OF ANY EMERGENCY SHUTDOWNS, RELAYS, CONTACTORS OR

REFER TO ARCHITECTURAL REFLECTED

ROUTE CONDUIT AS TIGHT TO THE EXPOSED CEILINGS AND STRUCTURE AS POSSIBLE TO

VERIFY TEACHING SURFACE WITH OWNER'S REPRESENTATIVE IN FIELD PRIOR TO INSTALLATION AND ADJUST SWITCHING TO PROPERLY ILLUMINATE TEACHING SURFACE. CAREFULLY COORDINATE FINAL SWITCHING WITH FINAL FURNITURE PLANS AND TEACHING WALL LOCATIONS.

SHEET NOTES

RECONNECT NEW LIGHTING FIXTURES IN THIS SPACE TO EXISTING LIGHTING CIRCUITRY AND NEW SWITCHING DEVICES, COMPLETE AS REQUIRED, MAXIMUM 4400W PER 277 VOLT CIRCUIT, WHERE NECESSARY, DUE TO LIMITATIONS IN THE EXISTING CIRCUITRY, THIS CONTRACTOR SHALL FURNISH AND INSTALL 20A-1 POLE CIRCUIT BREAKERS AS REQUIRED IN EXISTING SPACE OF EXISTING PANEL, AND EXTEND 2 #12 AND 1 #12 GRD IN 3/4" CONDUIT COMPLETE AS REQUIRED. VERIFY CONDITIONS AND REQUIREMENTS IN

ALTERNATE: NEW LIGHTING FIXTURES AND CONTROLS IN CORRIDORS.



GIBRALTAR


DESIGN ARCHITECTURE ● ENGINEERING ● INTERIOR DESIGN

(219) 924-8400 www.milliesengineeringgroup.com PROJECT

LAKE STREET ELEMENTARY SCHOOL ADDITION, RENOVATION AND RELATED WORK

CROWN POINT COMMUNITY SCHOOL CORPORATION

CROWN POINT, INDIANA

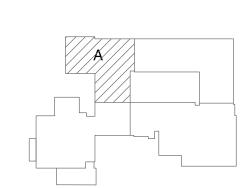

FIRST FLOOR KEY PLAN GIBRALTAR DESIGN

9102 N. Meridian St., Ste. 300 Indianapolis, IN 46260 Homepage www.GibraltarDesign.com Email info@GibraltarDesign.com Phone 317.580.5777 Fax 317.580.5778

COORDINATED

DRAWN BY CHECKED BY

COPYRIGHT NOTICE: THE CONCEPTS, DESIGNS, PLANS, DETAILS, ETC, SHOWN ON THIS DOCUMENT ARE THE PROPERTY OF GIBRALTAR DESIGN AND WERE CREATED FOR USE ON THIS SPECIFIC PROJECT. NONE OF THIS INFORMATION SHALL BE USED BY ANY PERSON OR FIRM FOR ANY PURPOSE WITHOUT THE EXPRESS WRITTEN CONSENT OF GIBRALTAR DESIGN. THE OWNER MAY RETAIN COPIES FOR INFORMATION AND REFERENCE IN CONNECTION ONLY WITH THIS PROJECT.

EVIS	IONS	
D N		


MARK DATE ISSUED FOR AD-2 06/02/23 ADDENDUM NO. 02

PARTIAL ELECTRICAL FIRST FLOOR LIGHTING PLAN

PROJECT
LAKE STREET ELEMENTARY SCHOOL ADDITION, RENOVATION AND RELATED WORK

© GIBRALTAR DESIGN SHEET

EL101

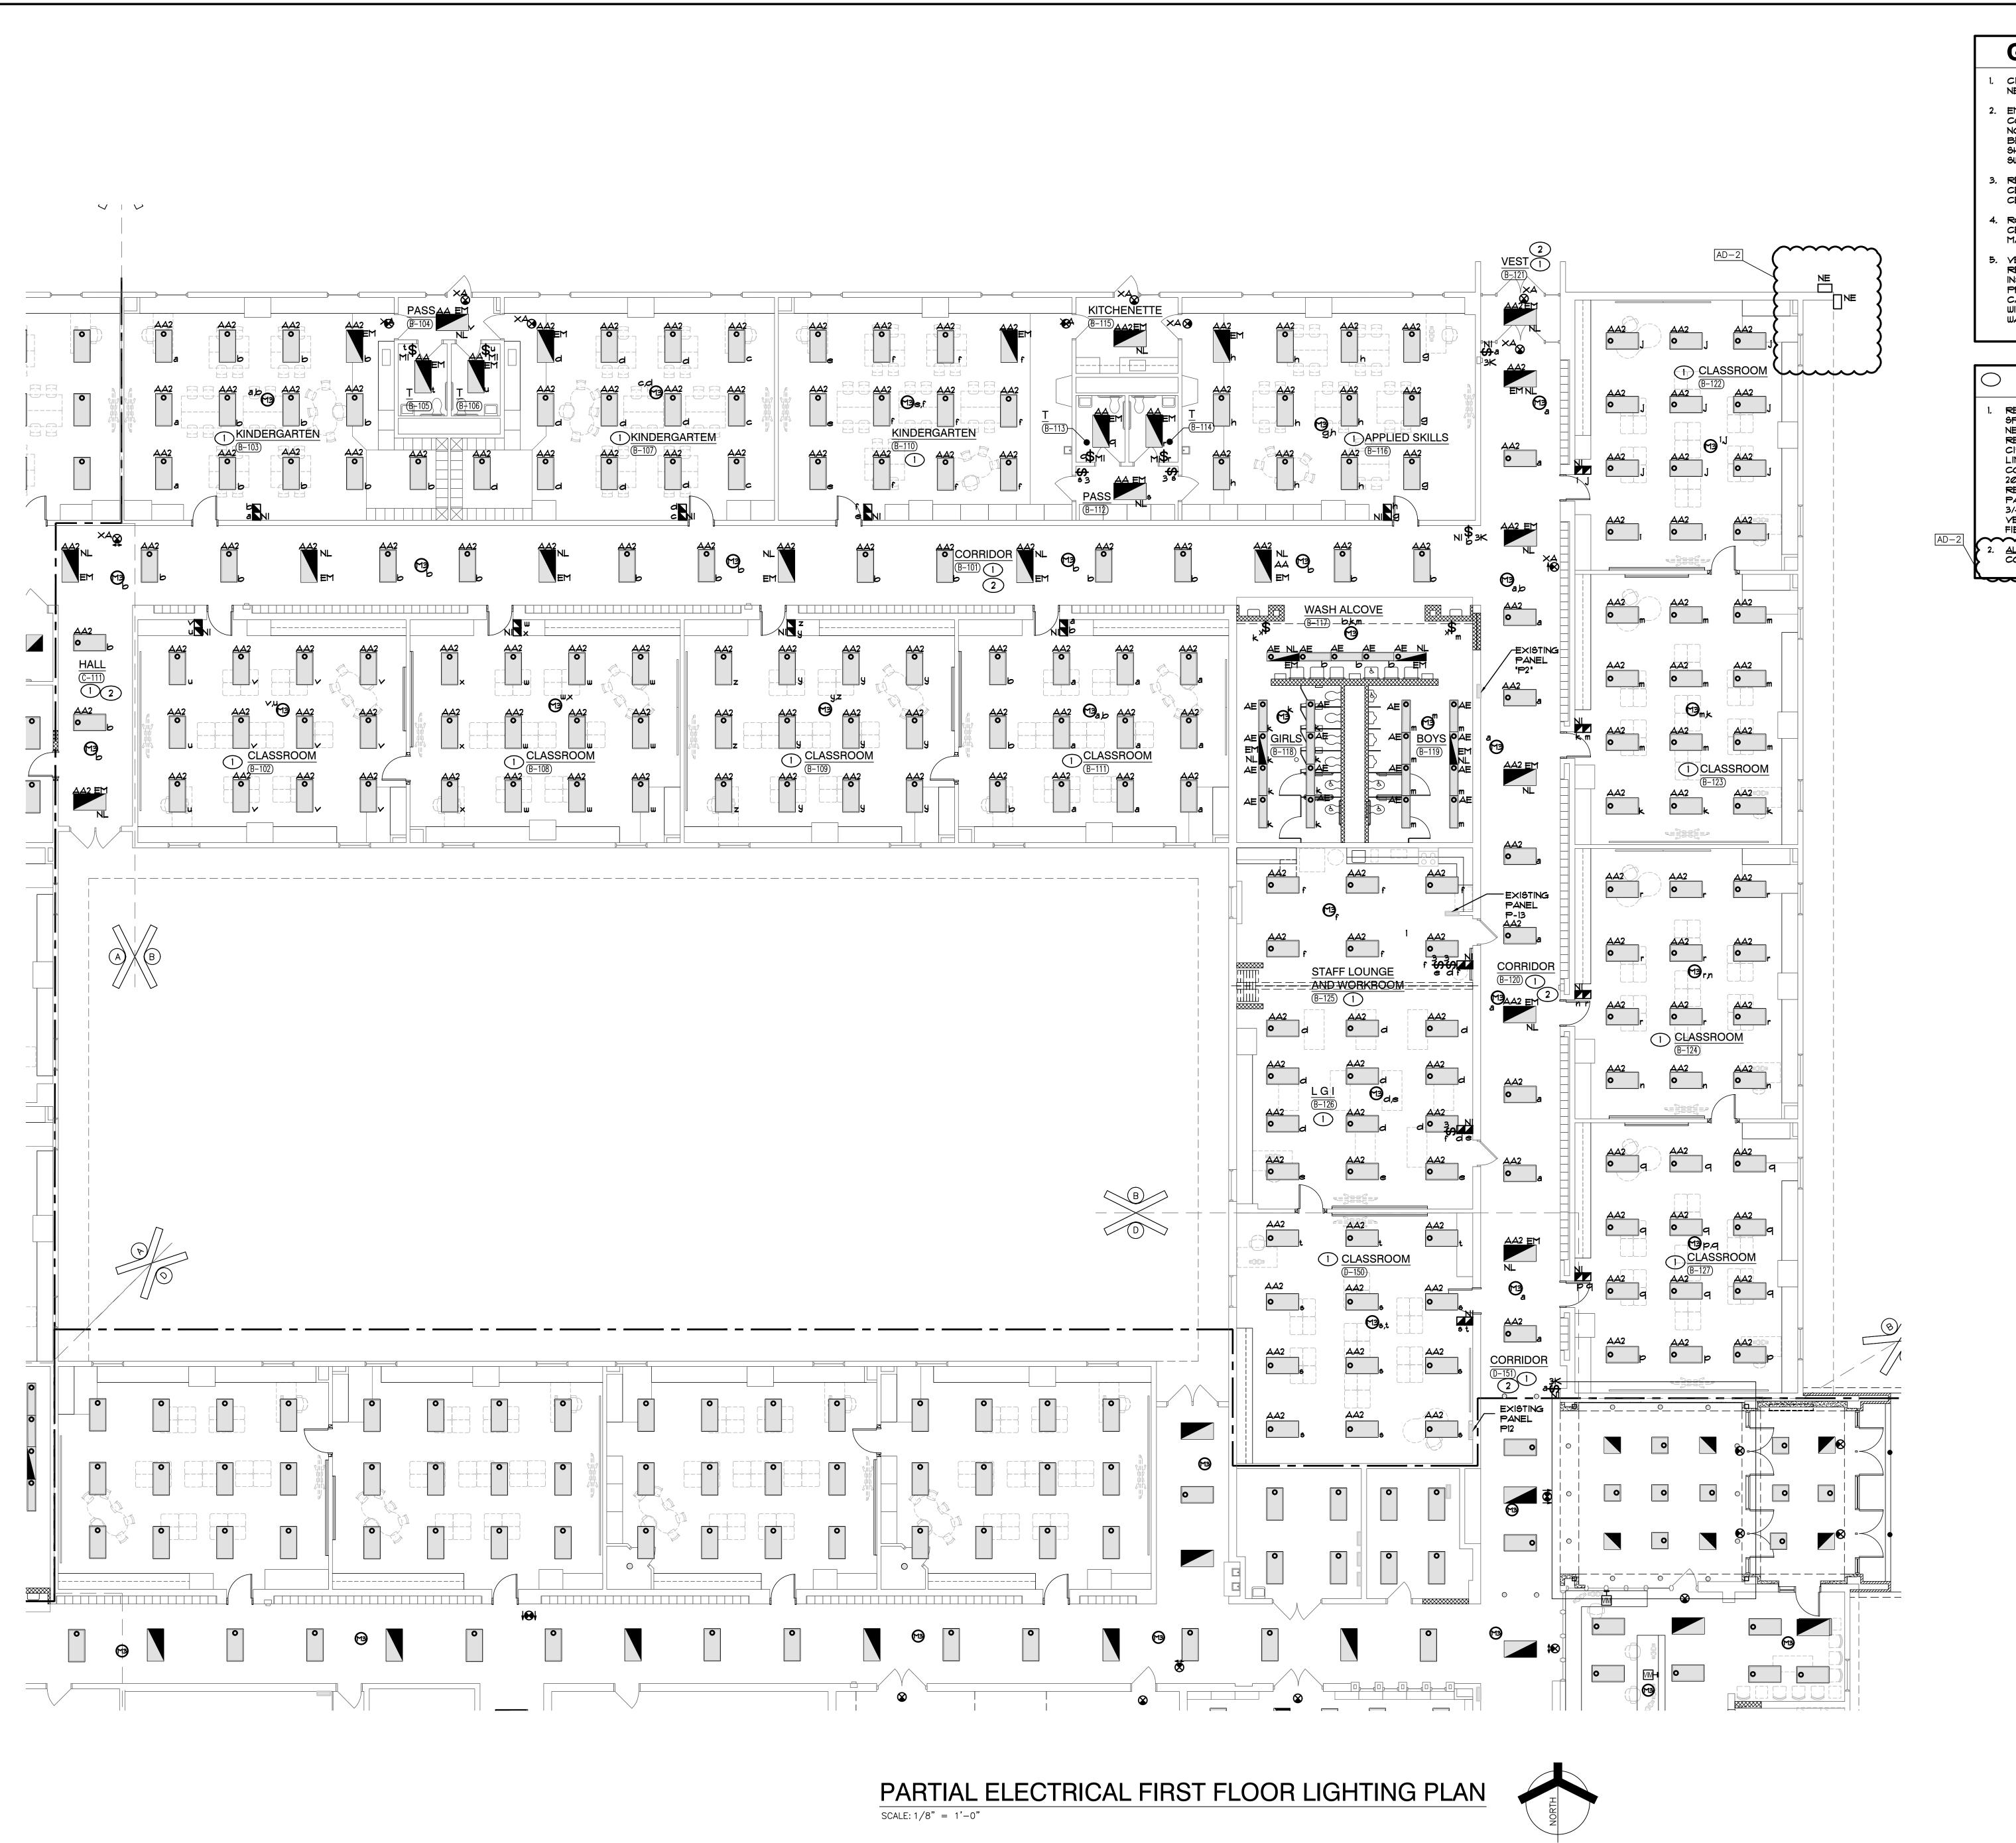

GENERAL NOTES

- 1. CIRCUIT ALL NORMAL LIGHTING FIXTURES TO NEW PANEL 2 UNLESS OTHERWISE NOTED.
- 2. EMERGENCY SENSING LEADS SHALL BE CONNECTED TO CONSTANT HOT FEEDS FROM NORMAL LIGHTING IN ROOM. THIS FEED SHALL BE TAKEN AHEAD OF ANY EMERGENCY SHUTDOWNS, RELAYS, CONTACTORS OR SWITCHES.
- 3. REFER TO ARCHITECTURAL REFLECTED CEILING PLAN FOR EXACT LOCATION OF ALL CEILING MOUNTED LIGHT FIXTURES.
- 4. ROUTE CONDUIT AS TIGHT TO THE EXPOSED CEILINGS AND STRUCTURE AS POSSIBLE TO MAXIMIZE CEILING SPACE.
- 5. VERIFY TEACHING SURFACE WITH OWNER'S REPRESENTATIVE IN FIELD PRIOR TO INSTALLATION AND ADJUST SWITCHING TO PROPERLY ILLUMINATE TEACHING SURFACE. CAREFULLY COORDINATE FINAL SWITCHING WITH FINAL FURNITURE PLANS AND TEACHING WALL LOCATIONS.

SHEET NOTES

1. RECONNECT NEW LIGHTING FIXTURES IN THIS SPACE TO EXISTING LIGHTING CIRCUITRY AND NEW SWITCHING DEVICES, COMPLETE AS REQUIRED, MAXIMUM 1400W PER 120 YOLT CIRCUIT. WHERE NECESSARY, DUE TO LIMITATIONS IN THE EXISTING CIRCUITRY, THIS CONTRACTOR SHALL FURNISH AND INSTALL 20A-1 POLE CIRCUIT BREAKERS AS REQUIRED IN EXISTING SPACE OF EXISTING PANEL, AND EXTEND 2 *12 AND 1 *12 GRD IN 3/4" CONDUIT COMPLETE AS REQUIRED. YERIFY CONDITIONS AND REQUIREMENTS IN

2. <u>ALTERNATE:</u> NEW LIGHTING FIXTURES AND CONTROLS IN CORRIDORS.



GIBRALTAR DESIGN

ARCHITECTURE • ENGINEERING • INTERIOR DESIGN


MILLIES ENGINEERING GROU (219) 924-8400

PROJECT

LAKE STREET
ELEMENTARY
SCHOOL ADDITION,
RENOVATION AND
RELATED WORK

FOR: CROWN POINT COMMUNITY SCHOOL CORPORATION

CROWN POINT, INDIANA

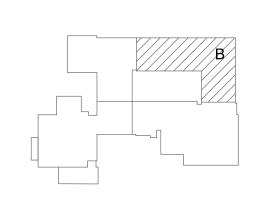

FIRST FLOOR KEY PLAN

GIBRALTAR DESIGN
9102 N. Meridian St., Ste. 300
Indianapolis, IN 46260
Homepage www.GibraltarDesign.com
Email info@GibraltarDesign.com

Phone 317.580.5777 Fax 317.580.577

PROJECT

21-117

DATE

05/15/23

COORDINATED BY

DRAWN BY

CHECKED BY

BY NO. 10302590

STATE OF WOIANA

WOIANA

AND ENGINE

COPYRIGHT NOTICE:
THE CONCEPTS, DESIGNS, PLANS, DETAILS, ETC, SHOWN ON THIS DOCUMENT ARE THE PROPERTY OF GIBRALTAR DESIGN AND WERE CREATED FOR USE ON THIS SPECIFIC PROJECT. NONE OF THIS INFORMATION SHALL BE USED BY ANY PERSON OR FIRM FOR ANY PURPOSE WITHOUT THE EXPRESS WRITTEN CONSENT OF GIBRALTAR DESIGN. THE OWNER MAY RETAIN COPIES FOR INFORMATION AND REFERENCE IN CONNECTION ONLY WITH THIS PROJECT.

REVISIONS

MARK DATE ISSUED FOR

AD-2 06/02/23 ADDENDUM NO. 02

DRAWING


PARTIAL ELECTF

PARTIAL ELECTRICAL
FIRST FLOOR LIGHTING
PLAN

PROJECT
LAKE STREET ELEMENTARY SCHOOL
ADDITION, RENOVATION AND
RELATED WORK

SHEET

EL102

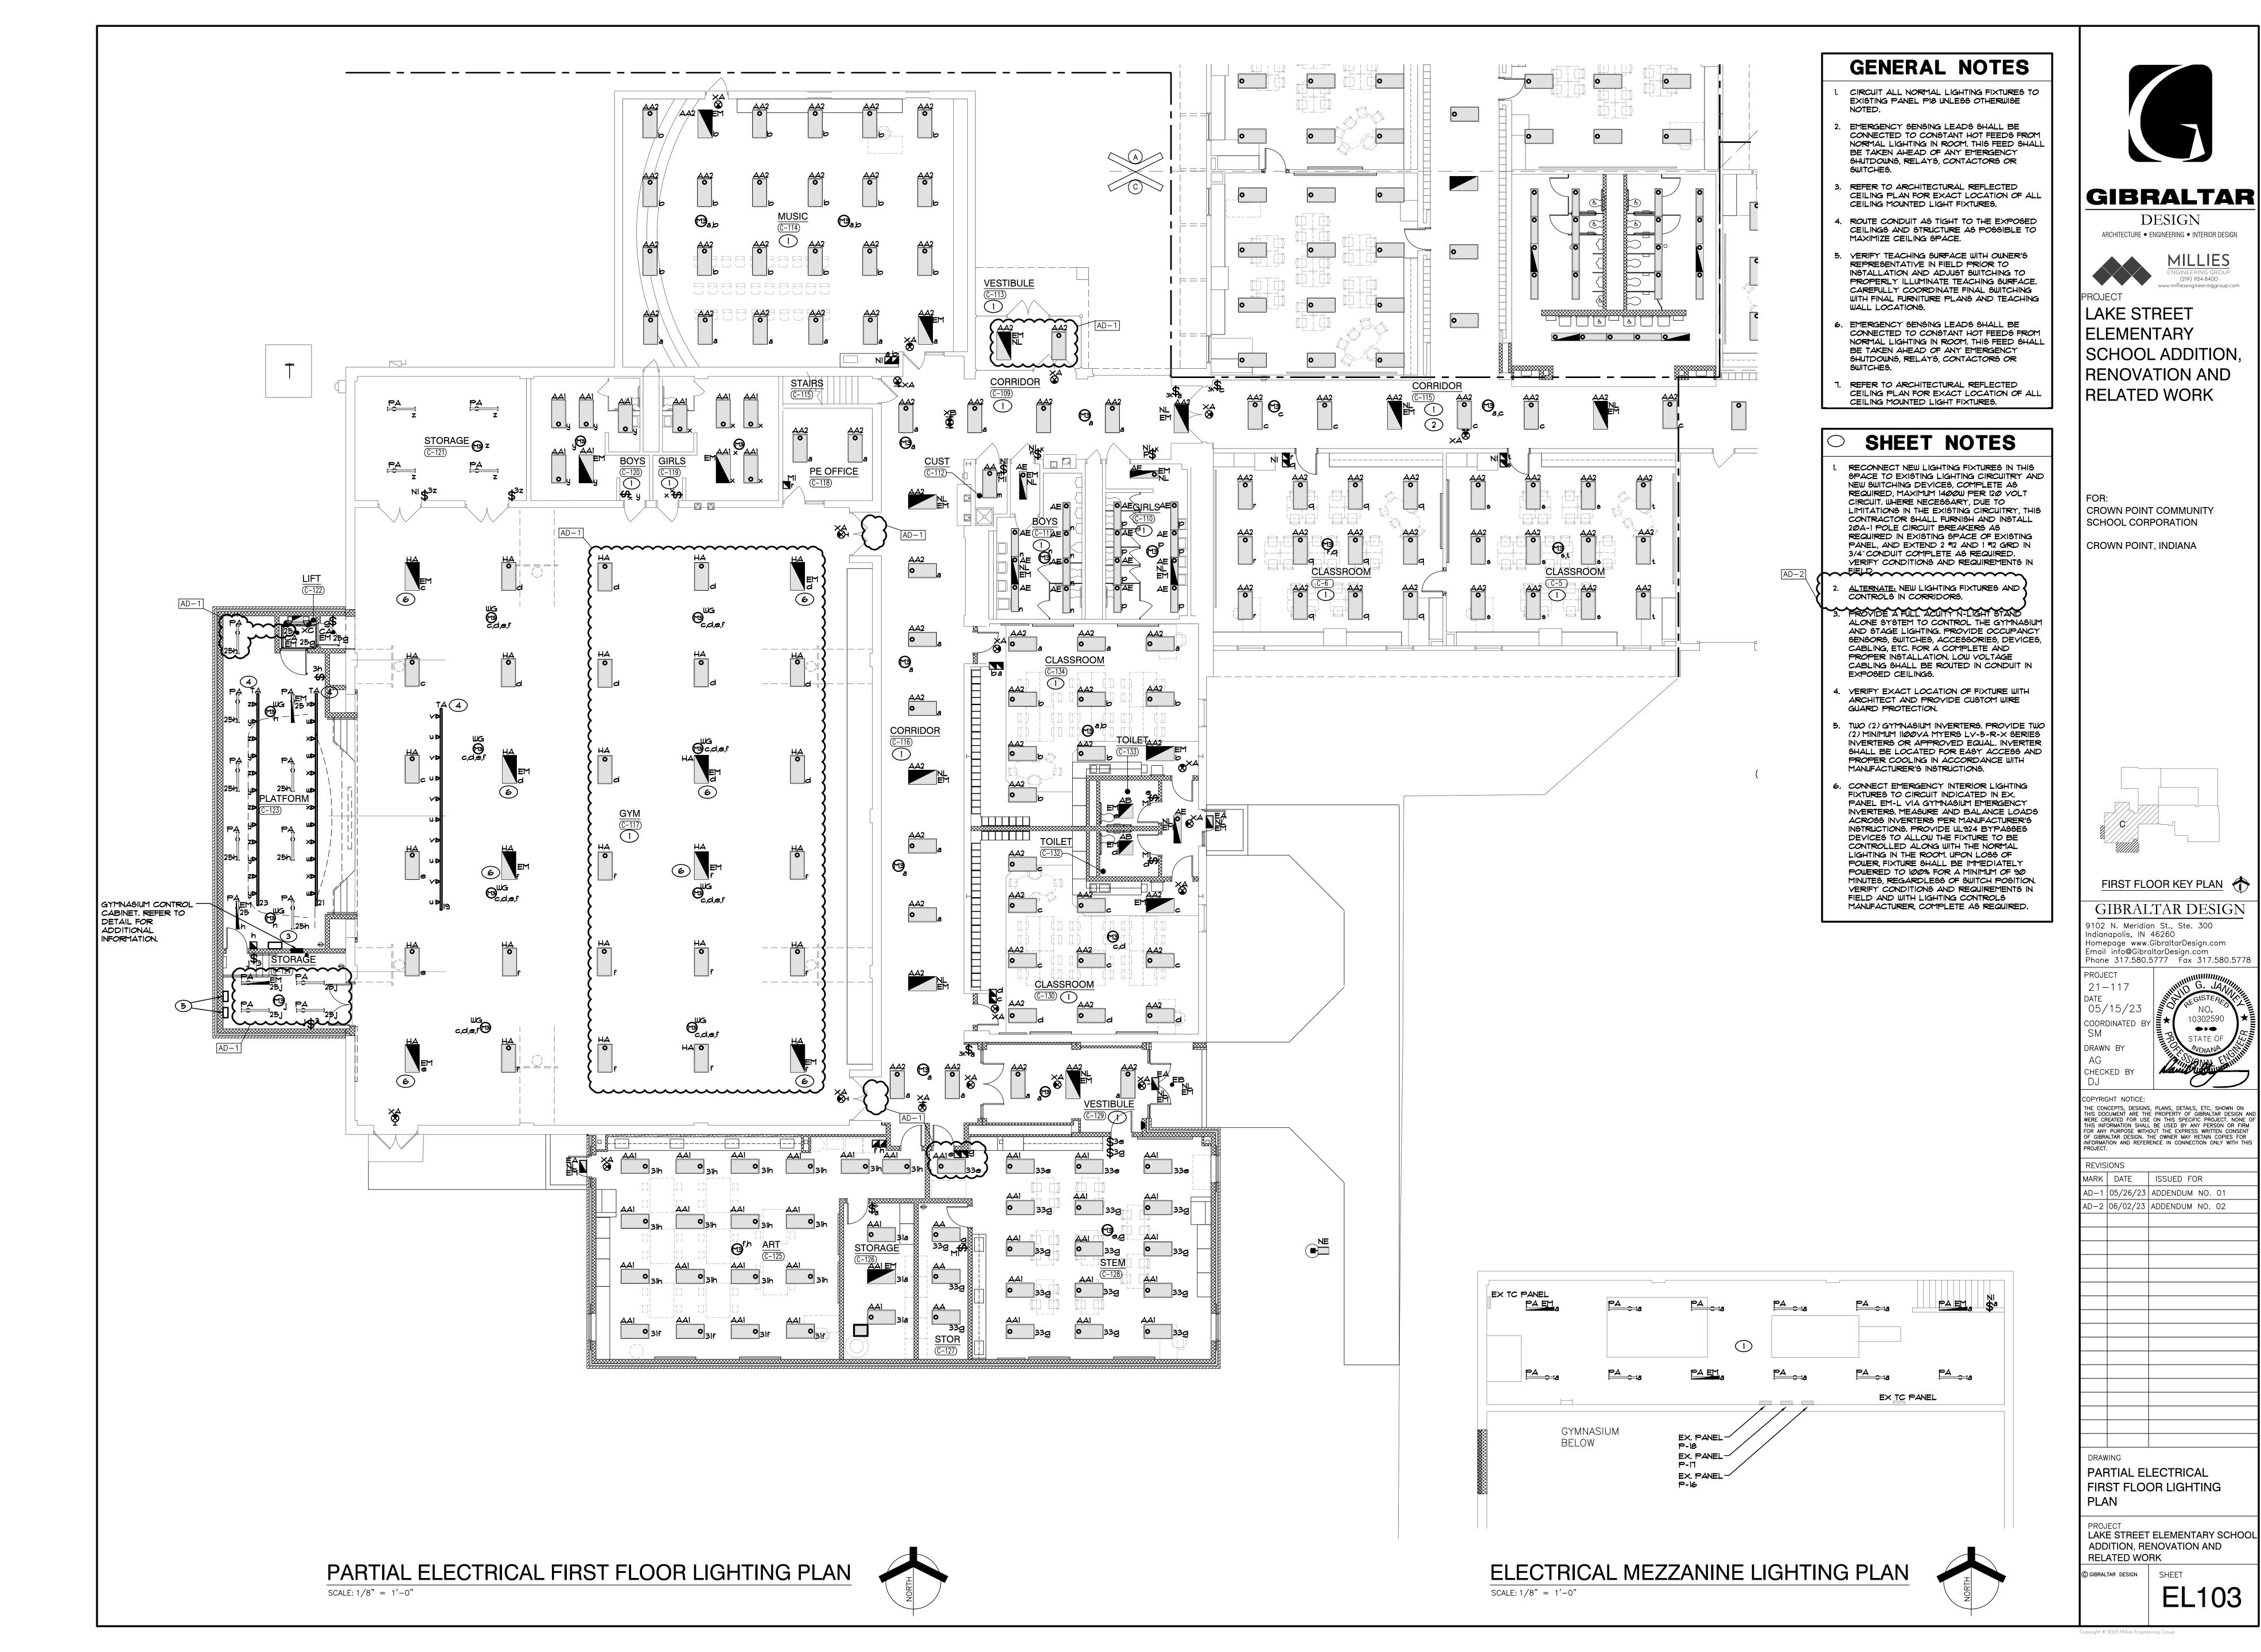

SHEET NOTES

RECONNECT NEW LIGHTING FIXTURES IN THIS SPACE TO EXISTING LIGHTING CIRCUITRY AND NEW SWITCHING DEVICES, COMPLETE AS REQUIRED, MAXIMUM 1400W PER 120 YOLT CIRCUIT. WHERE NECESSARY, DUE TO LIMITATIONS IN THE EXISTING CIRCUITRY, THIS CONTRACTOR SHALL FURNISH AND INSTALL 20A-1 POLE CIRCUIT BREAKERS AS REQUIRED IN EXISTING SPACE OF EXISTING PANEL, AND EXTEND 2 #12 AND 1 #12 GRD IN 3/4" CONDUIT COMPLETE AS REQUIRED. VERIFY CONDITIONS AND REQUIREMENTS IN FIELD. ALTERNATE: NEW LIGHTING FIXTURES AND CONTROLS

IN CORRIDORS.

GENERAL NOTES

- EMERGENCY SENSING LEADS SHALL BE CONNECTED TO CONSTANT HOT FEEDS FROM NORMAL LIGHTING IN ROOM. THIS FEED SHALL BE TAKEN AHEAD OF ANY EMERGENCY SHUTDOWNS, RELAYS, CONTACTORS OR
- SWITCHES. REFER TO ARCHITECTURAL REFLECTED CEILING PLAN FOR EXACT LOCATION OF ALL
- CEILING MOUNTED LIGHT FIXTURES. ROUTE CONDUIT AS TIGHT TO THE EXPOSED CEILINGS AND STRUCTURE AS POSSIBLE TO
- . VERIFY TEACHING SURFACE WITH OWNER'S REPRESENTATIVE IN FIELD PRIOR TO INSTALLATION AND ADJUST SWITCHING TO PROPERLY ILLUMINATE TEACHING SURFACE. CAREFULLY COORDINATE FINAL SWITCHING WITH FINAL FURNITURE PLANS AND TEACHING WALL LOCATIONS.

MAXIMIZE CEILING SPACE.



DESIGN ARCHITECTURE ● ENGINEERING ● INTERIOR DESIGN


(219) 924-8400

ROJECT

LAKE STREET ELEMENTARY SCHOOL ADDITION, RENOVATION AND RELATED WORK

CROWN POINT COMMUNITY SCHOOL CORPORATION

CROWN POINT, INDIANA

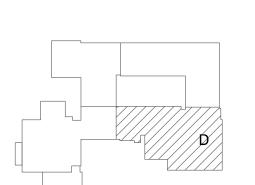

FIRST FLOOR KEY PLAN

GIBRALTAR DESIGN 9102 N. Meridian St., Ste. 300 Indianapolis, IN 46260 Homepage www.GibraltarDesign.com Email info@GibraltarDesign.com Phone 317.580.5777 Fax 317.580.5778

DRAWN BY

CHECKED BY


COPYRIGHT NOTICE: THE CONCEPTS, DESIGNS, PLANS, DETAILS, ETC, SHOWN ON THIS DOCUMENT ARE THE PROPERTY OF GIBRALTAR DESIGN AND WERE CREATED FOR USE ON THIS SPECIFIC PROJECT. NONE OF THIS INFORMATION SHALL BE USED BY ANY PERSON OR FIRM FOR ANY PURPOSE WITHOUT THE EXPRESS WRITTEN CONSENT OF GIBRALTAR DESIGN. THE OWNER MAY RETAIN COPIES FOR INFORMATION AND REFERENCE IN CONNECTION ONLY WITH THIS PROJECT.


MARK DATE ISSUED FOR AD-2 06/02/23 ADDENDUM NO. 02


PARTIAL ELECTRICAL FIRST FLOOR LIGHTING PLAN

PROJECT
LAKE STREET ELEMENTARY SCHOOL ADDITION, RENOVATION AND RELATED WORK

© GIBRALTAR DESIGN SHEET EL104

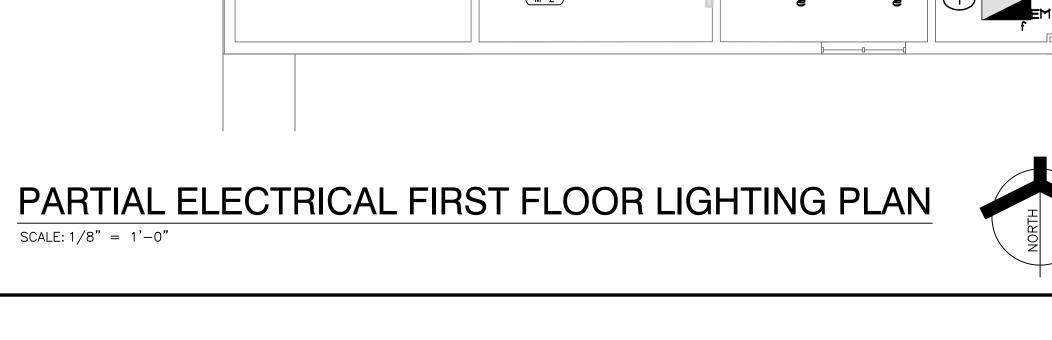

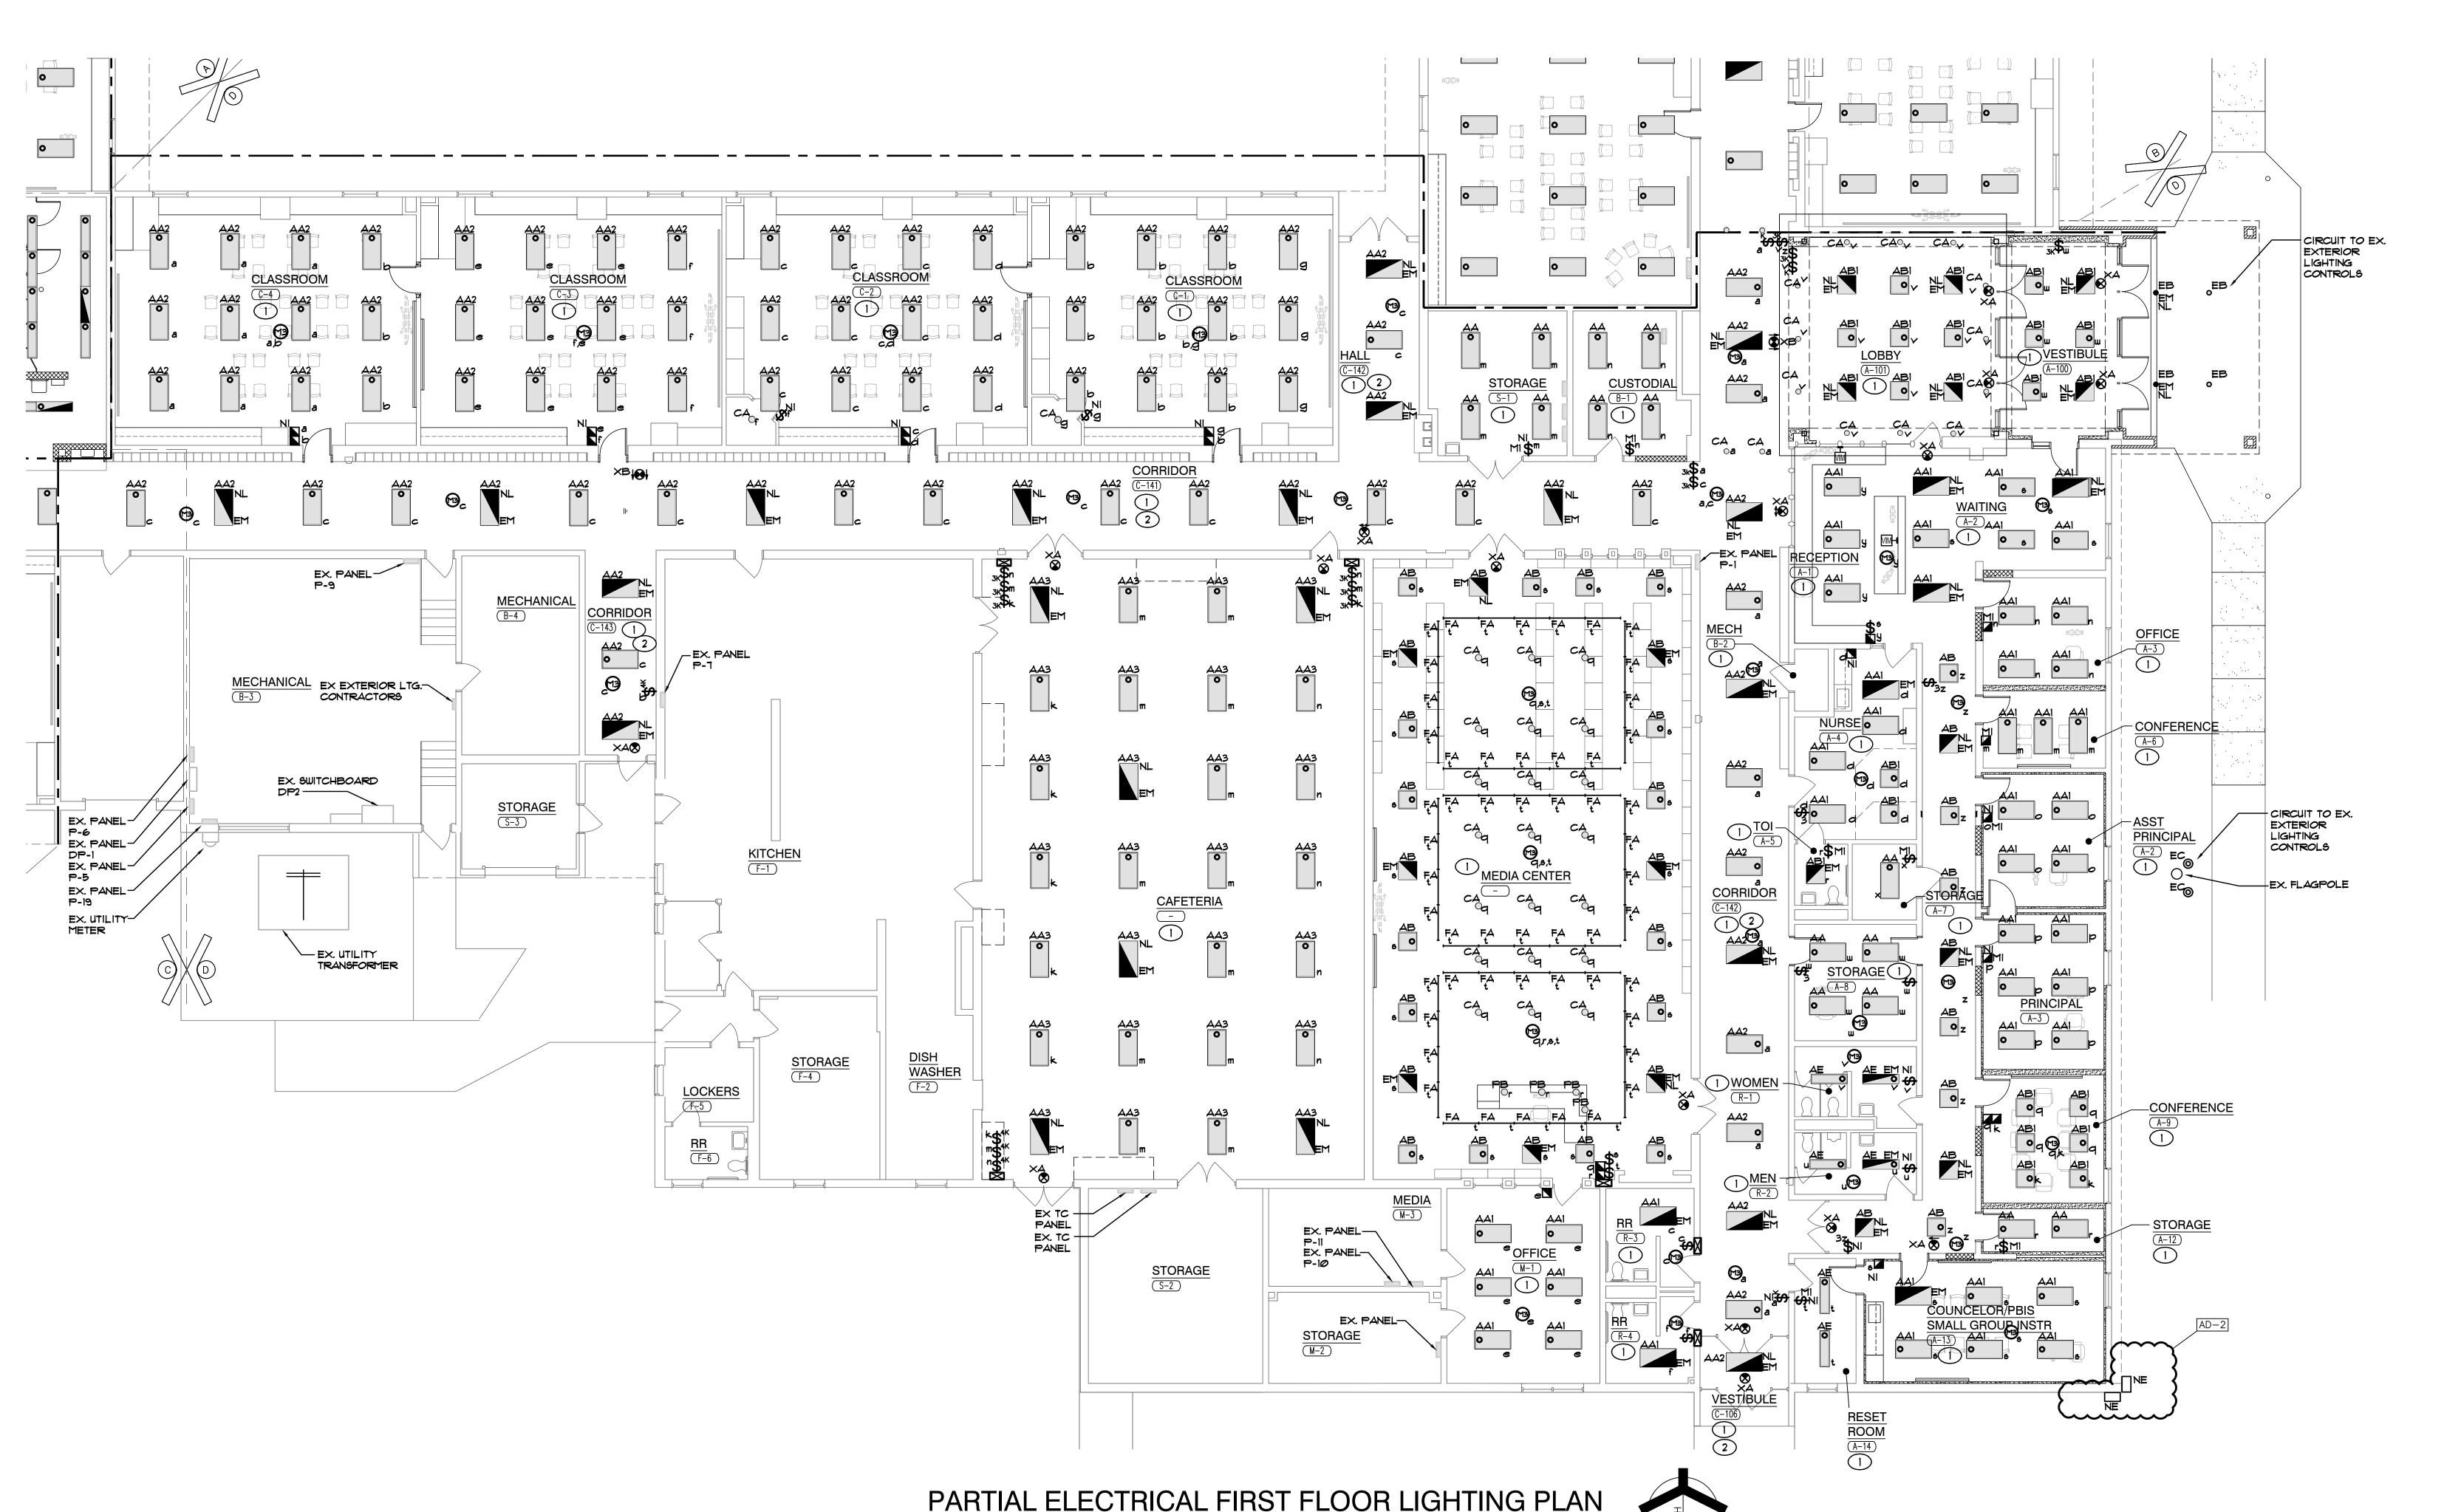

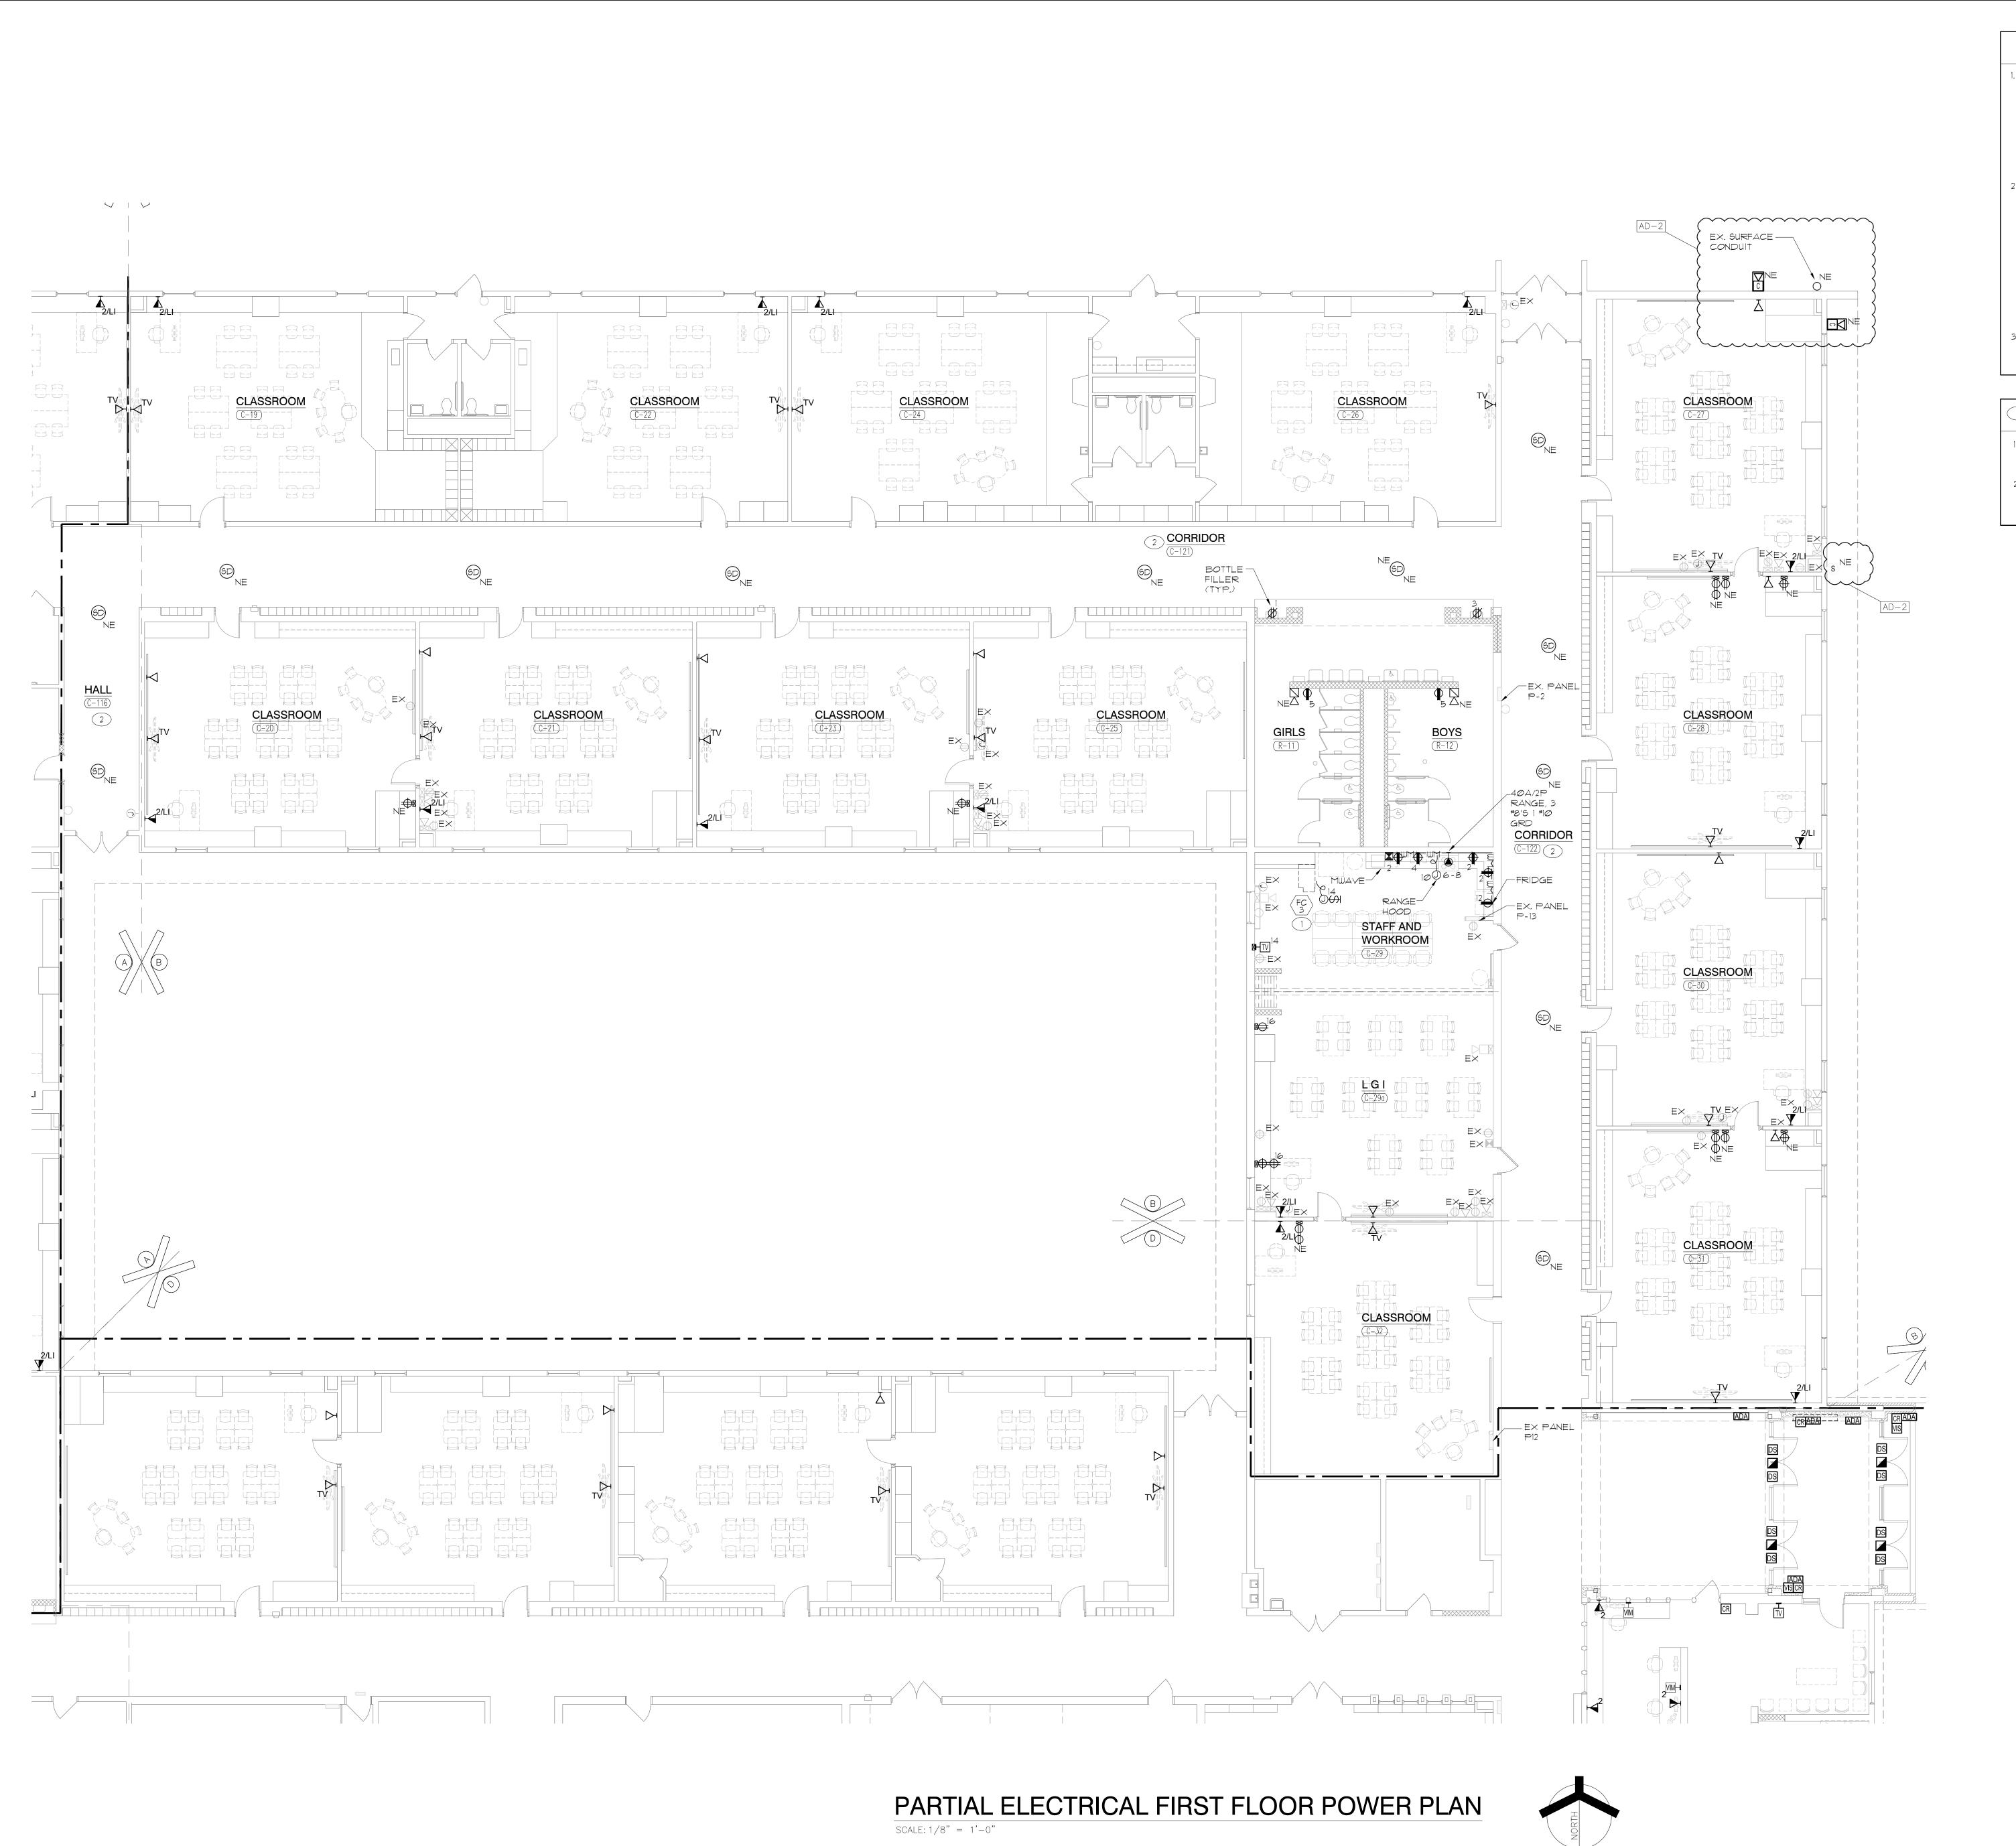

GENERAL NOTES

- CIRCUIT ALL DEVICES TO EXISTING PANEL P13 UNLESS OTHERWISE NOTED. CIRCUIT NUMBERS ARE ARBITRARY AND ARE ONLY SHOWN TO INDICATE CIRCUITING REQUIREMENTS. NEW CIRCUIT BREAKERS SHALL MATCH THE MAKE, MODEL AND WITHSTAND RATING OF THE EXISTING PANELBOARD, VERIFY EXACT CONDITIONS AND REQUIREMENTS IN FIELD. UTILIZE EXISTING CIRCUIT BREAKERS MADE AVAILABLE FROM DEMOLITION.
- PROVIDE ALL LABOR AND MATERIAL TO PROVIDE THE NECESSARY ROUGH-INS, RACEWAYS AND ELECTRICAL SERVICES FOR ALL OF THE ACCESS CONTROL, SOUND SYSTEMS, TECHNOLOGY SYSTEMS AND EQUIPMENT. SEE TECHNOLOGY DRAWINGS AND SPECIFICATIONS FOR LOCATIONS OF DEVICES/EQUIPMENT, MOUNTING HEIGHTS AND ELECTRICAL REQUIREMENTS. COORDINATE AND VERIFY EXACT LOCATIONS OF ALL OF THESE ROUGH-INS AND REQUIREMENTS WITH TECH DYNE, ARCHITECT, OWNER, CONSTRUCTION MANAGER AND DIVISION 27 CONTRACTOR PRIOR TO ROUGHING-IN.
- CUT AND PATCH EXISTING WALLS AS REQUIRED TO INSTALL NEW DEVICES, REPAIR SURFACES TO MATCH EXISTING OR NEW FINISH

SHEET NOTES

- REFER TO MECHANICAL EQUIPMENT CONNECTION SCHEDULE FOR ADDITIONAL CIRCUITING AND WIRING INFORMATION.
- <u>alternate:</u> NEW ELECTRICAL WORK IN CORRIDORS.



GIBRALTAR


DESIGN ARCHITECTURE • ENGINEERING • INTERIOR DESIGN

(219) 924-8400 www.milliesengineeringgroup.com PROJECT

LAKE STREET ELEMENTARY SCHOOL ADDITION, RENOVATION AND RELATED WORK

CROWN POINT COMMUNITY SCHOOL CORPORATION


CROWN POINT, INDIANA

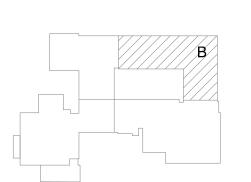

FIRST FLOOR KEY PLAN GIBRALTAR DESIGN

9102 N. Meridian St., Ste. 300 ndianapolis, IN 46260 Homepage www.GibraltarDesign.com Email info@GibraltarDesign.com

05/15/23 COORDINATED DRAWN BY

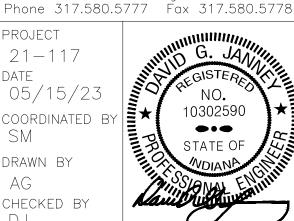

OPYRIGHT NOTICE: THE CONCEPTS, DESIGNS, PLANS, DETAILS, ETC, SHOWN ON THIS DOCUMENT ARE THE PROPERTY OF GIBRALTAR DESIGN AND WERE CREATED FOR USE ON THIS SPECIFIC PROJECT. NONE OF THIS INFORMATION SHALL BE USED BY ANY PERSON OR FIRM FOR ANY PURPOSE WITHOUT THE EXPRESS WRITTEN CONSENT OF GIBRALTAR DESIGN. THE OWNER MAY RETAIN COPIES FOR INFORMATION AND REFERENCE IN CONNECTION ONLY WITH THIS PROJECT


CHECKED B'

MARK DATE ISSUED FOR AD-2 |06/02/23 |ADDENDUM NO. 02

PARTIAL ELECTRICAL FIRST FLOOR POWER

LAKE STREET ELEMENTARY SCHOOL ADDITION, RENOVATION AND RELATED WORK

GIBRALTAR DESIGN SHEET EP102

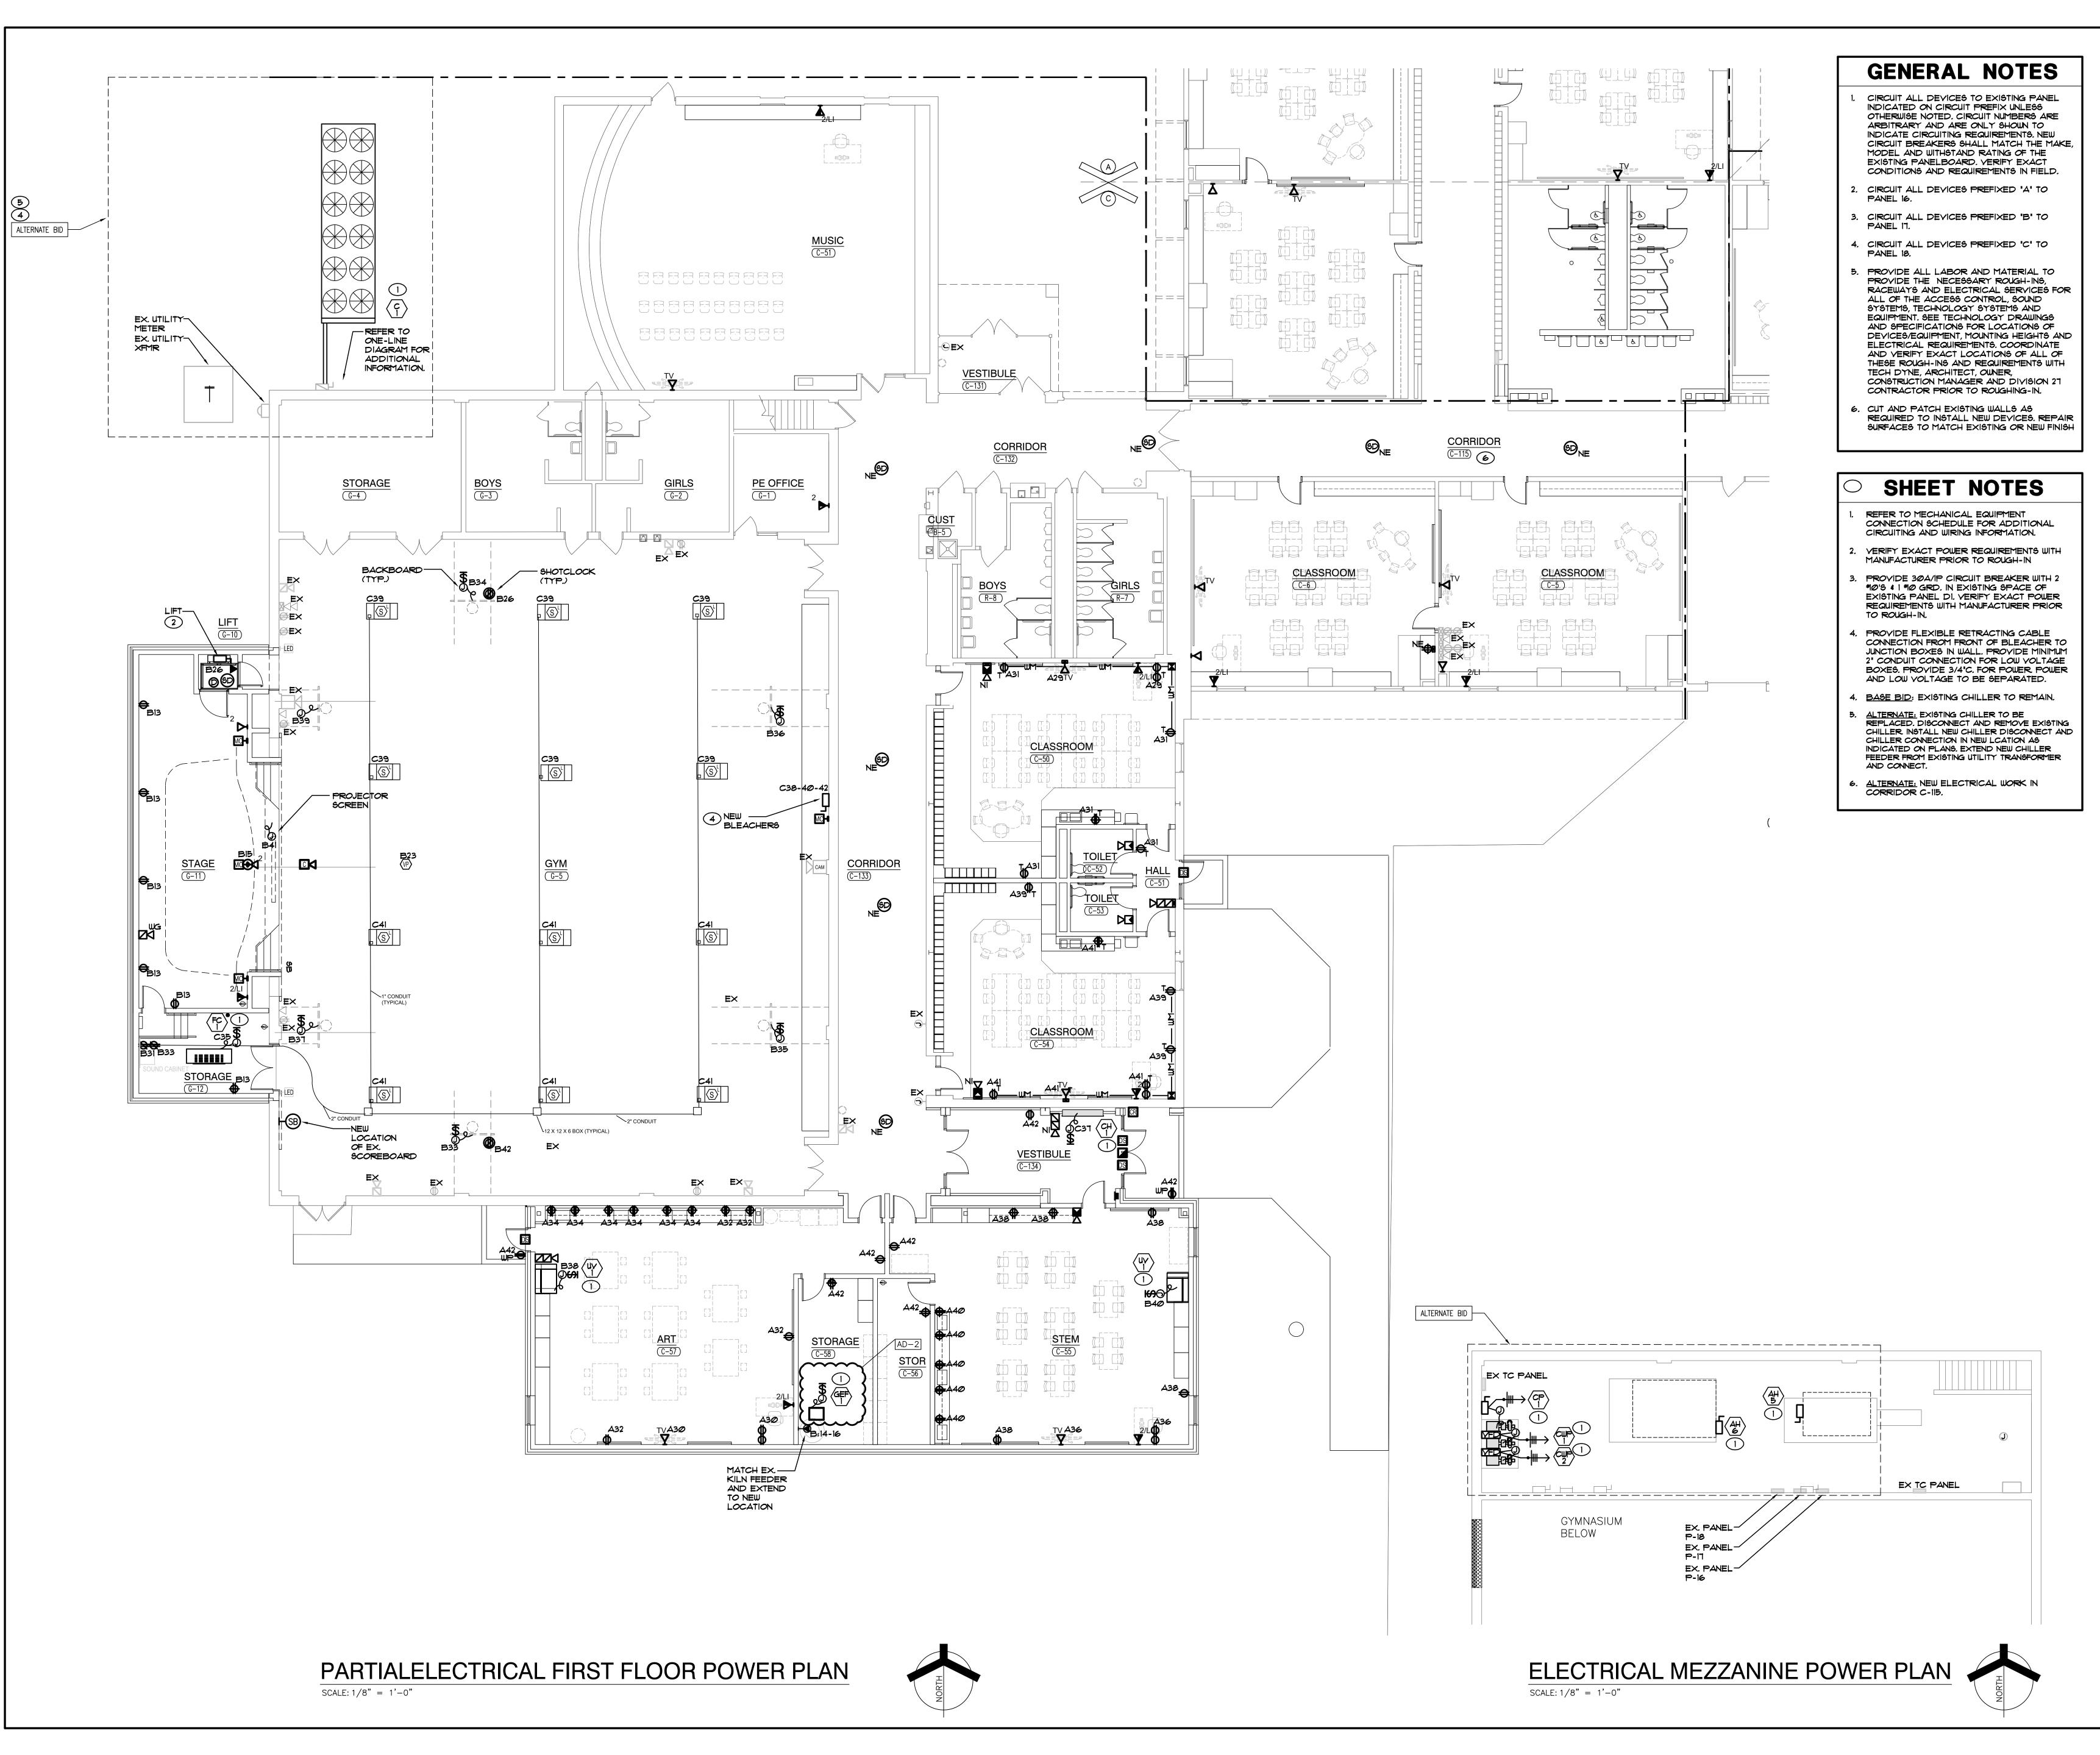



GIBRALTAR

DESIGN

ARCHITECTURE • ENGINEERING • INTERIOR DESIGN

MILLIES
ENGINEERING GROUP
(219) 924-8400
www.milliesengineeringgroup.cor

LAKE STREET
ELEMENTARY
SCHOOL ADDITION,
RENOVATION AND
RELATED WORK

FOR: CROWN POINT COMMUNITY SCHOOL CORPORATION

CROWN POINT, INDIANA

FIRST FLOOR KEY PLAN

GIBRALTAR DESIGN

9102 N. Meridian St., Ste. 300 Indianapolis, IN 46260 Homepage www.GibraltarDesign.com Email info@GibraltarDesign.com Phone 317.580.5777 Fax 317.580.5778

PROJECT

21-117

DATE

05/15/23

COORDINATED BY

SM

DRAWN BY

BY NO. 10302590 **

STATE OF VOIANA CONTINUES AND ENGINEER CE:

COPYRIGHT NOTICE:

THE CONCEPTS, DESIGNS, PLANS, DETAILS, ETC, SHOWN ON THIS DOCUMENT ARE THE PROPERTY OF GIBRALTAR DESIGN AND WERE CREATED FOR USE ON THIS SPECIFIC PROJECT. NONE OF THIS INFORMATION SHALL BE USED BY ANY PERSON OR FIRM FOR ANY PURPOSE WITHOUT THE EXPRESS WRITTEN CONSENT OF GIBRALTAR DESIGN. THE OWNER MAY RETAIN COPIES FOR INFORMATION AND REFERENCE IN CONNECTION ONLY WITH THIS PROJECT.

MARK	DATE	ISSUED FO)R	
4D-2	06/02/23	ADDENDUM	NO.	02
DRAW	/ING			
DΛE	TIAI EI	ECTRIC	Λ١	

PARTIAL ELECTRICAL
FIRST FLOOR POWER
PLAN

PROJECT
LAKE STREET ELEMENTARY SCHOOL
ADDITION, RENOVATION AND
RELATED WORK

© GIBRALTAR DESIGN SHEET

EP103

SHEET NOTES REFER TO MECHANICAL EQUIPMENT CONNECTION SCHEDULE FOR ADDITIONAL CIRCUITING AND WIRING INFORMATION. PROVIDE MINIMUM 3/4"C. FOR POWER AND 1-1/4"C. FOR LOW YOLTAGE UNDER FLOOR AND STUBBED UP WITHIN NEW FURNITURE SYSTEM TO NEW POWER AND DATA OUTLET SYSTEM. PRIOR TO CUTTING EXISTING FLOOR SLAB, CONTRACTOR SHALL RADAR SCAN SLAB FOR EXISTING UTILITIES. COORDINATE

~CONDITIONS AND REQUIREMENTS IN PIECES,~

ALTERNATE: NEW ELECTRICAL WORK IN CORRIDORS.

COMPLETE AS REQUIRED.

GENERAL NOTES

- CIRCUIT ALL DEVICES TO EXISTING PANELS PIØ AND PII UNLESS OTHERWISE NOTED. CIRCUIT NUMBERS ARE ARBITRARY AND ARE ONLY SHOWN TO INDICATE CIRCUITING REQUIREMENTS. NEW CIRCUIT BREAKERS SHALL MATCH THE MAKE, MODEL AND WITHSTAND RATING OF THE EXISTING PANELBOARD. VERIFY EXACT CONDITIONS AND REQUIREMENTS IN FIELD. UTILIZE EXISTING CIRCUIT BREAKERS MADE AVAILABLE FROM DEMOLITION.
- PROVIDE ALL LABOR AND MATERIAL TO PROVIDE THE NECESSARY ROUGH-INS, RACEWAYS AND ELECTRICAL SERVICES FOR ALL OF THE ACCESS CONTROL, SOUND SYSTEMS, TECHNOLOGY SYSTEMS AND EQUIPMENT. SEE TECHNOLOGY DRAWINGS AND SPECIFICATIONS FOR LOCATIONS OF DEVICES/EQUIPMENT, MOUNTING HEIGHTS AND ELECTRICAL REQUIREMENTS. COORDINATE AND VERIFY EXACT LOCATIONS OF ALL OF THESE ROUGH-INS AND REQUIREMENTS WITH TECH DYNE, ARCHITECT, OWNER, CONSTRUCTION MANAGER AND DIVISION 27 CONTRACTOR PRIOR TO ROUGHING-IN.
- CUT AND PATCH EXISTING WALLS AS REQUIRED TO INSTALL NEW DEVICES. REPAIR SURFACES TO MATCH EXISTING OR NEW FINISH



ARCHITECTURE ● ENGINEERING ● INTERIOR DESIGN (219) 924-8400


DESIGN

www.milliesengineeringgroup.com PROJECT LAKE STREET

ELEMENTARY SCHOOL ADDITION, RENOVATION AND RELATED WORK

CROWN POINT COMMUNITY SCHOOL CORPORATION

CROWN POINT, INDIANA

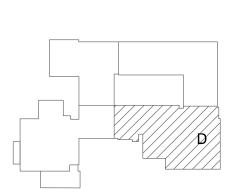

FIRST FLOOR KEY PLAN

GIBRALTAR DESIGN 9102 N. Meridian St., Ste. 300 Indianapolis, IN 46260 Homepage www.GibraltarDesign.com Email info@GibraltarDesign.com Phone 317.580.5777 Fax 317.580.5778

COORDINATED

DRAWN B' CHECKED BY


THE CONCEPTS, DESIGNS, PLANS, DETAILS, ETC, SHOWN ON THIS DOCUMENT ARE THE PROPERTY OF GIBRALTAR DESIGN AND WERE CREATED FOR USE ON THIS SPECIFIC PROJECT. NONE OF THIS INFORMATION SHALL BE USED BY ANY PERSON OR FIRM FOR ANY PURPOSE WITHOUT THE EXPRESS WRITTEN CONSENT OF GIBRALTAR DESIGN. THE OWNER MAY RETAIN COPIES FOR INFORMATION AND REFERENCE IN CONNECTION ONLY WITH THIS PROJECT.

MARK DATE ISSUED FOR AD-1 05/26/23 ADDENDUM NO. 01 AD-2 06/02/23 ADDENDUM NO. 02

PARTIAL ELECTRICAL FIRST FLOOR POWER PLAN

PROJECT
LAKE STREET ELEMENTARY SCHOOL ADDITION, RENOVATION AND RELATED WORK

©GIBRALTAR DESIGN SHEET EP104

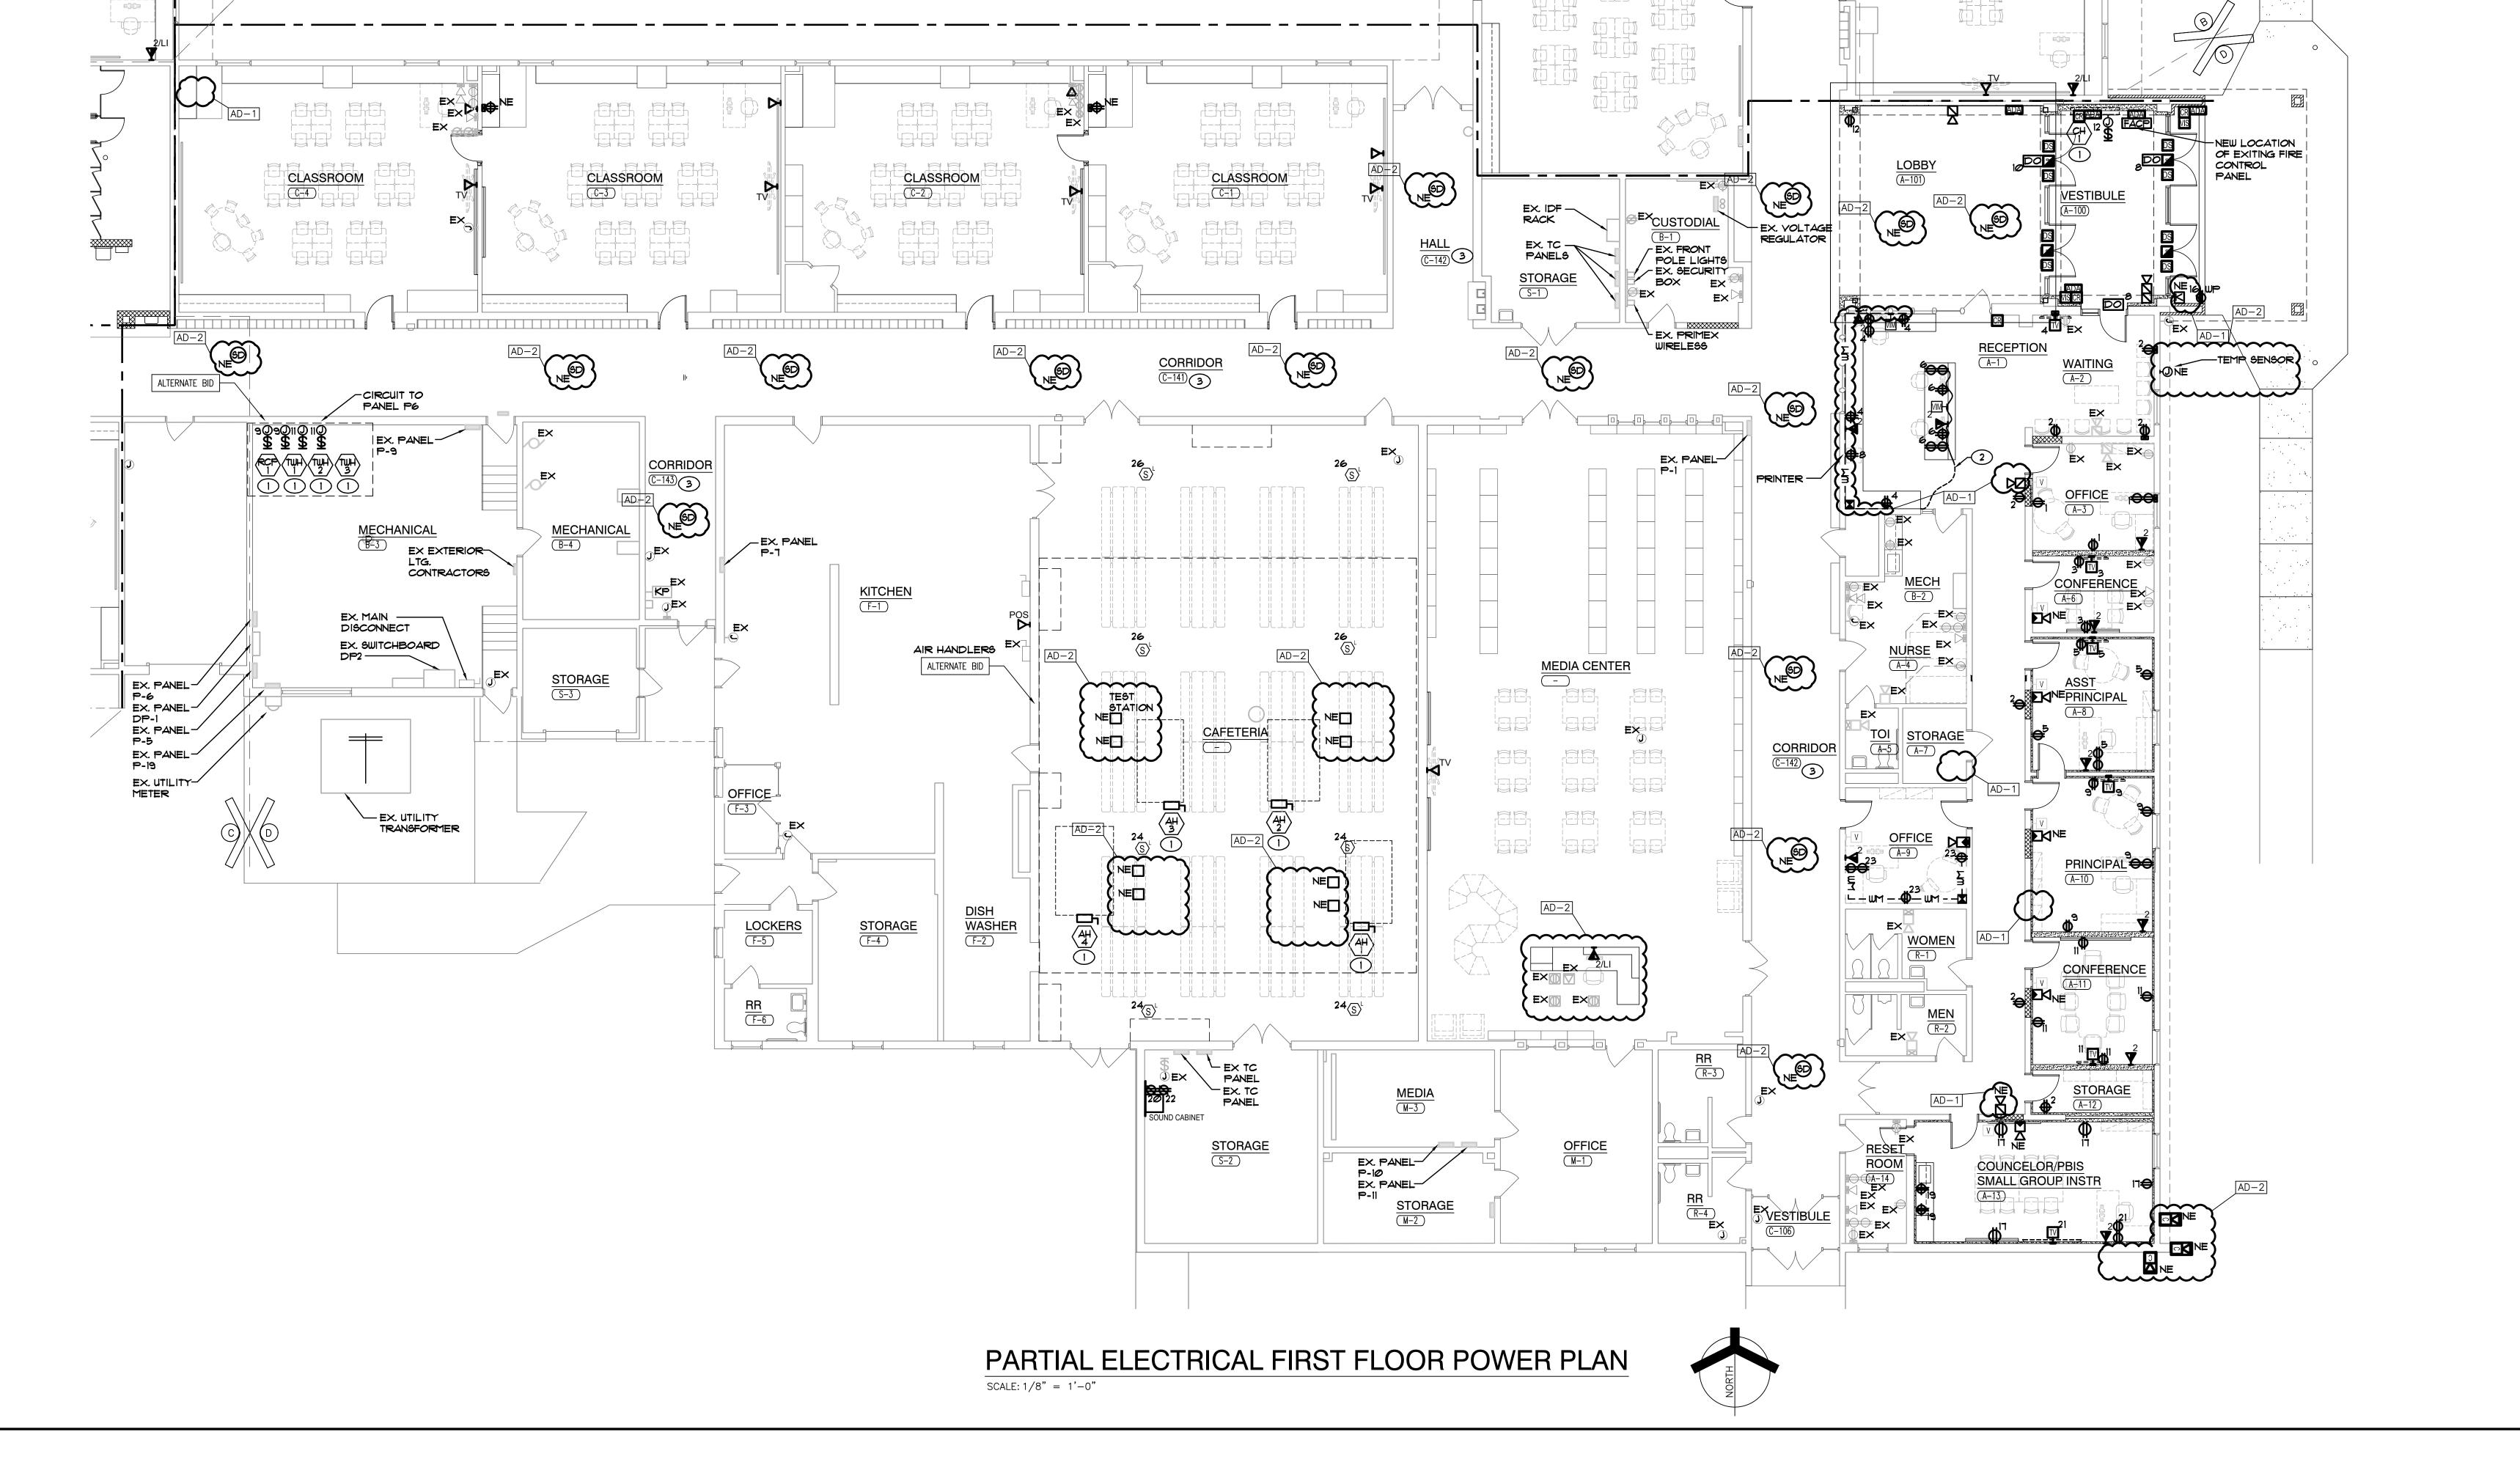

												FUSED						
-AG	DESCRIPTION		I	LOAD	I	1	MOCP	YOLT	PHASE	PANEL	CKT. NO.	SWITCH	FEEDER		STARTE		LOCATION	REMARKS
;-1	GRADE MOUNTED AIR COOLED CHILLER	451738	HP -	MCA 544	FLA -	AMPS	700	480	3	SEE ONE-LINE	SEE ONE-LINE	C/B 100A/3P	(2 SETS) 4 *500 \$ 1 *1/0 GRD	(2) 3-1/2		EC.		-ALTERNATE: REFUSE EX. SWITCH
H-1	AIR HANDLER	10076	_	28	-	_	50	208	3	EX. P-19	35-31-39	50A/3P	4 *6 \$ 1 *10 GRD	1"	×	-	-	-REPLACE EXISTING CIRCUIT BREAKER WITH NEW
H-2	AIR HANDLER	12774	_	35.5	-	_	60	208	3	EX. P-19	30-32-34	60A/3P	4 *4 # 1 *10 GRD	1-1/4"	×	-	-	-REPLACE EXISTING CIRCUIT BREAKER WITH NEW
H-3	AIR HANDLER	12774	-	35.5	-	-	60	208	3	EX. P-19	42-44-46	60A/3P	4 *4 \$ 1 *10 GRD	1-1/4"	×	-	-	-REPLACE EXISTING CIRCUIT BREAKER WITH NEW
H-4	AIR HANDLER	19@72	_	53	-	-	90	208	3	EX. P-19	36-38-40	9ØA/3P	4 *2 4 1 *8 GRD	1-1/4"	×	-	-	-REPLACE EXISTING CIRCUIT BREAKER WITH NEW
H-5	AIR HANDLER	19@72	-	53	-	-	90	208	3	EX. P-17	1-3-5	90A/3P	4 *2 4 1 *8 GRD	1-1/4"	×	-	-	-REPLACE EXISTING CIRCUIT BREAKER WITH NEW
H-6	AIR HANDLER	26898	-	74.75	-	-	125	208	3	EX. P-17	2-4-6	125A/3P	4 #1 #1 #6 GRD	1-1/4"	×	-	-	-REPLACE EXISTING CIRCUIT BREAKER WITH NEW
JV-1	VERTICAL UNIT VENTILATOR - 4 PIPE HW HEATING/CHW COOLING	1560	_	13	-	-	20	120	1	VARIES	VARIES	20A/IP	2 *12 4 1 *12 GRD	76'	×	-	-	-
FC-1	HORIZONTAL DUCTED FAN COIL - HW HEATING / CHW COOLING	1116	-	9.3	-	-	15	120	1	EX. P-18	35	20A/IP	2 #12 & 1 #12 GRD	7 ₈ ⁺	×	-	-	-REPLACE EXISTING CIRCUIT BREAKER WITH NEW
-C-2	HORIZONTAL DUCTED FAN COIL - HW HEATING / CHW COOLING	528	-	3.88	-	-	15	120	1	EX. PANEL	EX. CKT	20A/IP	2 #12 4 1 #12 GRD	78"	×	-	-	-
-C-3	HORIZONTAL DUCTED FAN COIL - HW HEATING / CHW COOLING	1656	-	3.88	-	-	15	120	1	EX. PANEL	EX. CKT	20A/IP	2 #12 4 1 #12 GRD	78"	×	-	-	-
EF-1	ROOF MOUNTED TOILET EXHAUST FAN	528	1/6	-	-	-	-	120	1	EX. P-17	18	20A/IP	2 #12 4 1 #12 GRD	78"	-	×	-	-UTILIZIE EXISITNG CIRCUIT BREAKER
EF-2	ROOF MOUNTED TOILET EXHAUST FAN	1656	3/4	-	-	-	-	120	1	EX. PANEL	EX. CKT	20A/IP	2 #12 4 1 #12 GRD	%"	-	×	-	-UTILIZIE EXISITNG CIRCUIT BREAKER
EF-3	ROOF MOUNTED TOILET EXHAUST FAN	1656	3/4	-	-	-	-	120	1	EX. PANEL	EX. CKT	20A/IP	2 #12 4 1 #12 GRD	%"	-	×	-	-UTILIZIE EXISITNG CIRCUIT BREAKER
EF-4	ROOF MOUNTED TOILET EXHAUST FAN	1656	3/4	-	-	-	-	120	1	EX. PANEL	EX. CKT	20A/IP	2 #12 4 1 #12 GRD	%"	-	×	-	-UTILIZIE EXISITING CIRCUIT BREAKER
EF-5	ROOF MOUNTED TOILET EXHAUST FAN	528	1/6	-	-	-	-	120	1	EX. PANEL	EX. CKT	20A/IP	2 #12 4 1 #12 GRD	₹"	-	×	-	-UTILIZIE EXISITING CIRCUIT BREAKER
EF-6	ROOF MOUNTED TOILET EXHAUST FAN	528	1/6	-	-	-	-	120	1	EX. PANEL	EX. CKT	20A/IP	2 #12 4 1 #12 GRD	₹'	-	×	-	-UTILIZIE EXISITING CIRCUIT BREAKER
EF-7	ROOF MOUNTED TOILET EXHAUST FAN	528	1/6	-	-	-	-	120	1	EX. PANEL	EX. CKT	20A/IP	2 #12 4 1 #12 GRD	₹'	-	×	-	-UTILIZIE EXISITING CIRCUIT BREAKER
EF-8	ROOF MOUNTED TOILET EXHAUST FAN	528	1/6	-	-	-	-	120	1	EX. PANEL	EX. CKT	20A/IP	2 #12 4 1 #12 GRD	7g"	-	×	-	-UTILIZIE EXISITING CIRCUIT BREAKER
EF-9	ROOF MOUNTED TOILET EXHAUST FAN	1656	3/4	-	-	-	-	120	1	EX. PANEL	EX. CKT	20A/IP	2 #12 4 1 #12 GRD	7g"	-	×	-	-UTILIZIE EXISITING CIRCUIT BREAKER
EF-10	ROOF MOUNTED TOILET EXHAUST FAN	528	1/6	-	-	-	-	120	1	EX. PANEL	EX. CKT	20A/IP	2 #12 # 1 #12 GRD	_የ "	-	×	-	-UTILIZIE EXISITNG CIRCUIT BREAKER
	BOOF MOUNTED TOILET EXHAUST FAN	528	VIEV .	~~	~~	~~	~~~	المحال	~	EXPANEL	₹X-KŢ	20A/IP	2 #12 4 1 #12 GPD	76'	~	×	~~~	-UTIL IZIE EXIGITING CIRCUIT BREAKER
SEF-1	CEILING MOUNTED GENERAL EXHAUST FAN (STORAGE C-126)	696	1/2	-	-	-	-	120	1	EX. P-17	27	20A/IP	2 #12 # 1 #12 GRD	%"	-	×	-	-UTILIZIE EXISITNG CIRCUIT BREAKER
-H-1	RECESSED HW CABINET HEATER	168	ب	ب	مبہ	1,4	15	120	\ <u>\</u>	VARIES	VARIE5	VARIES	2 42 T 42 GRD	1/8	<u>_</u>	\checkmark	مير	
CP-I	CHILLED WATER RECIRCULATION PUMP	8708	7 1/2	-	-	-	-	208	3	EX. P-18	32-34-36	50A/3P	4 *6 4 1 *10 GRD	1"	-	-	-	-ALTERNATE: PROVIDE NEW CCT BRK IN EX PANEL
WP-1	CHILLED WATER DISTRIBUTION PUMP	11083	10	-	-	-	-	208	3	EX. P-17	II-9-II	60A/3P	4 *4 \$1 *10 GRD	1-1/4"	-	-	-	-ALTERNATE: PROVIDE NEW CCT BRK IN EX PANEL
:WP-2	CHILLED WATER DISTRIBUTION PUMP	11083	10	-	-	-	-	208	3	EX. P-17	8-10-12	60A/3P	4 *4 \$1 *10 GRD	1-1/4"	-	-	-	-ALTERNATE: PROVIDE NEW CCT BRK IN EX PANEL
rwH-1	TANKLESS WATER HEATER	480	-	-	-	-	-	120	1	EX. PANEL	EX. CKT	20A/IP	2 #12 4 1 #12 GRD	%"	-	-	•	-ALTERNATE: PROVIDE NEW CCT BRK IN EX PANEL
RCP-1	RECIRCULATION PUMP	200	-	-	-	-	-	120	1	EX. PANEL	EX. CKT	20A/IP	2 #12 4 1 #12 GRD	<i>ነ</i> ያ'	-	-	•	-ALTERNATE: PROVIDE NEW CCT BRK IN EX PANEL

TOTAL KW: 95.1		FNGL	OSURE:	NFM	<u> </u>	PHZ	\SE:	34			YOLT!	∆GF:	120 / 208
MOUNTING: SURFACE			NG: CC		<u> </u>	_			RATIN	G: 22.0			MLO(AMPS): 225
FEEDER: SEE ONE-LIN	E					_			ZANINE				
		C/B		LOAD					LOAD		C	/B	
LOAD DESCRIPTION	TRIP	POLE	Дф	Bø	C¢	CCT	. NO.	Дф	B¢	Cþ	TRIP	POLE	LOAD DESCRIPTIO
	90		6357			1	2	8966			125		
AH-5				6357		3	4		8966				AH-6
		3			6357	5	6			8966		3	
	60		3694			٦	8	3694			60		
CWP-1				3694		9	10		3694				CWP-2
		3			3694		12			3694		3	
REC - G-11	20	1	1200			13		3500			50		KILN - RM C-58
M-PHONE - G-11	20	1		600		15	16		3500			2	
M-PHONE - G-11	20	1			600	17	18			528	20		TEF-1
EXISTING LOAD	20	1				19	20				20		EXISTING LOAD
EXISTING LOAD	15	1				21	22				20		EXISTING LOAD
PROJECTOR - G-5	20	1			1200	23	24				20	1	EXISTING LOAD
EXISTING LOAD	40				V \	25	26	1200			3Ø	1	LIFT G-10
GEF-1	20	1		696		27) 28				20		EXISTING LOAD
BEES-BOUND CAB	280	<u> </u>			1000	<u> </u>	30				20		EXISTING LOAD
REC - SOUND CAB	20	1	600			31	32				20	1	EXISTING LOAD
BACK BOARD - G5	20	1		1200		33	34		1200		2Ø	1	BACK BOARD - G5
BACK BOARD - G5	20	1	ļ. —	ļ	1200	35	36			1200	20	1	BACK BOARD - G5
BACK BOARD - G5	20	1	1200	45.5.5		37	38	1560			20		UY-1 - RM C-57
BACK BOARD - G5	20	1		1200	10.00	39	40		1560	10.0.0	20		UY-1 - RM C-55
PROJ SCRN - G5	20	1			1200	41	42			1200	2Ø	l	SHOT CLOCKS - G5
NOTE: REFER TO GENER	AL NO	TE 'B'		13747	14851	J		18920	18920	15588		₿=	31,971 32,667 30,439

TOTAL KW: 10.0		ENCL	OSURE:	NEM/	7- 1	PHA	SE:	3¢			VOLT,	AGE:	120 / 208	
MOUNTING: SURFACE		BUSSII	NG: CC	PPER		FAUL	_T Cl	IRREN	RATIN	NG: 22,0	000	AIC	MLO(AMPS):	225
FEEDER: SEE ONE-LI	Æ	7				LOC	ATIC	N: MEZ	ZANINE					
		C/B		LOAD					LOAD			C/B		
LOAD DESCRIPTION	TRIP	POLE	Дф	B♦	C¢	CCT	. NO.	Дф	B¢	Cŧ	TRIP	POLE	LOAD DESC	RIPTION
SPACE	20	1				1	2				20	1	EXISTING LOAD	
EXISTING LOAD	20	1				3	4				20	1	EXISTING LOAD	
EXISTING LOAD	20	1				5	6				20	1	EXISTING LOAD	
EXISTING LOAD	20	1				7	8				20	1	EXISTING LOAD	
EXISTING LOAD	20	1				9	10				20	1	EXISTING LOAD	
EXISTING LOAD	20	1				11	12				20	1	EXISTING LOAD	
EXISTING LOAD	20	1				13	14				20	1	EXISTING LOAD	
EXISTING LOAD	20	1				15	16				20	1	EXISTING LOAD	
EXISTING LOAD	20	1				17	18				20	1	EXISTING LOAD	
EXISTING LOAD	20	1				19	20				20	1	EXISTING LOAD	
EXISTING LOAD	20	1				21	22				20	1	EXISTING LOAD	
EXISTING LOAD	20	1				23	24				20	1	SPARE	
EXISTING LOAD	20	1				25	26				2Ø	1	EXISTING LOAD	
EXISTING LOAD	20	1				27	28				20	1	EXISTING LOAD	
TY/REC - RM C-50	20	1			900	29	30			900	20	1	TY/REC - RM C	.57
REC - RM C-50	20	1	1000			31	32	800			20	1	REC - RM C-57	
EXISTING LOAD	20	1				33	34		1000		20	1	REC - RM C-57	
EXISTING LOAD	20	1				35	36			900	20	1	TY/REC - RM C	·55
SPACE						37	38	800			20	1	REC - RM C-55	
REC - RM C-54	20	1		1000		39	40		800		20	1	REC - RM C-55	
TY/REC - RM C-54	20	1			900	41	42			1000	20	1	REC - RM C-56	/58
	•		1000	1000	1800			1600	1800	2800				

OTAL KW: 18.9		ENCL	OSURE:	NEMA	1 -1	PHA	SE:	3¢			YOLT,	4GE:	120 / 208
MOUNTING: SURFACE BUSSIN		NG: COPPER			FAULT CURRENT RATING: 22,000 AIC					AIC	MLO(AMPS): 225		
EEDER: SEE ONE-LIN	Æ					LOC	ATIC	N: MEZ	ZZANIN	E			
				LOAD					LOAD		C	C/B	
LOAD DESCRIPTION	TRIP	POLE	Дф	B♦	Cø	CCT	. NO.	Дф	B♦	Cø	TRIP	POLE	LOAD DESCRIPTION
XISTING LOAD						1	2						
XISTING LOAD						3	4						EXISTING LOAD
XISTING LOAD						5	6						
XISTING LOAD						٦	8				20	1	EXISTING LOAD
XISTING LOAD						9	10				20	1	EXISTING LOAD
XISTING LOAD						11	12				20	1	EXISTING LOAD
XISTING LOAD						13	14						
XISTING LOAD						15	16						
XISTING LOAD						ΙT	18				20	1	EXISTING LOAD
TG - TRK LTG G-5	20	1	900			19	20				20	1	EXISTING LOAD
TG - TRK LTG G-11	20	1		900		21	22				20	1	EXISTING LOAD
TG - TRK LTG G-11	20	1			900	23	24				20	1	EXISTING LOAD
TG - STAGE	20	1	474			25	26				20	1	EXISTING LOAD
XISTING LOAD						27	28				20	1	EXISTING LOAD
XISTING LOAD						29	3Ø				20	1	EXISTING LOAD
TG - RM C-51/58	20	1	960			31	32	29Ø2			50		
TG - RM C-55/56	2Ø	11		864		33	34		2902				CP-1 - MEZZ
C-1 - RM G-12	2Ø	1			1146	35	36			29Ø2		3	
H-1 -RM C-134	20	1	168			37	38	500			20		
		1 1		1200		39	40		500				BLEACHERS
YM SPEAKERS	20	<u> </u>											
· · · · · · · · · · · · · · · · · · ·	20	1			1200	41	42			500		3	



ARCHITECTURE • ENGINEERING • INTERIOR DESIGN

MILLIES
ENGINEERING GROUP
(219) 924-8400
www.milliesengineeringgroup.com

PROJECT

LAKE STREET ELEMENTARY SCHOOL ADDITION, RENOVATION AND RELATED WORK

FOR: CROWN POINT COMMUNITY SCHOOL CORPORATION

CROWN POINT, INDIANA

FIRST FLOOR KEY PLAN GIBRALTAR DESIGN

9102 N. Meridian St., Ste. 300 Indianapolis, IN 46260 Homepage www.GibraltarDesign.com Email info@GibraltarDesign.com Phone 317.580.5777 Fax 317.580.5778

COORDINATED BY DRAWN BY

CHECKED BY COPYRIGHT NOTICE: THE CONCEPTS, DESIGNS, PLANS, DETAILS, ETC, SHOWN ON THIS DOCUMENT ARE THE PROPERTY OF GIBRALTAR DESIGN AND WERE CREATED FOR USE ON THIS SPECIFIC PROJECT. NONE OF THIS INFORMATION SHALL BE USED BY ANY PERSON OR FIRM FOR ANY PURPOSE WITHOUT THE EXPRESS WRITTEN CONSENT OF GIBRALTAR DESIGN. THE OWNER MAY RETAIN COPIES FOR INFORMATION AND REFERENCE IN CONNECTION ONLY WITH THIS PROJECT.

MARK DATE ISSUED FOR
AD-2 06/02/23 ADDENDUM NO. 02


DRAW	/ING	

ELECTRICAL SCHEDULES

PROJECT
LAKE STREET ELEMENTARY SCHOOL
ADDITION, RENOVATION AND
RELATED WORK

© GIBRALTAR DESIGN SHEET E-601

Copyright © 2023 Millies Engineering Group

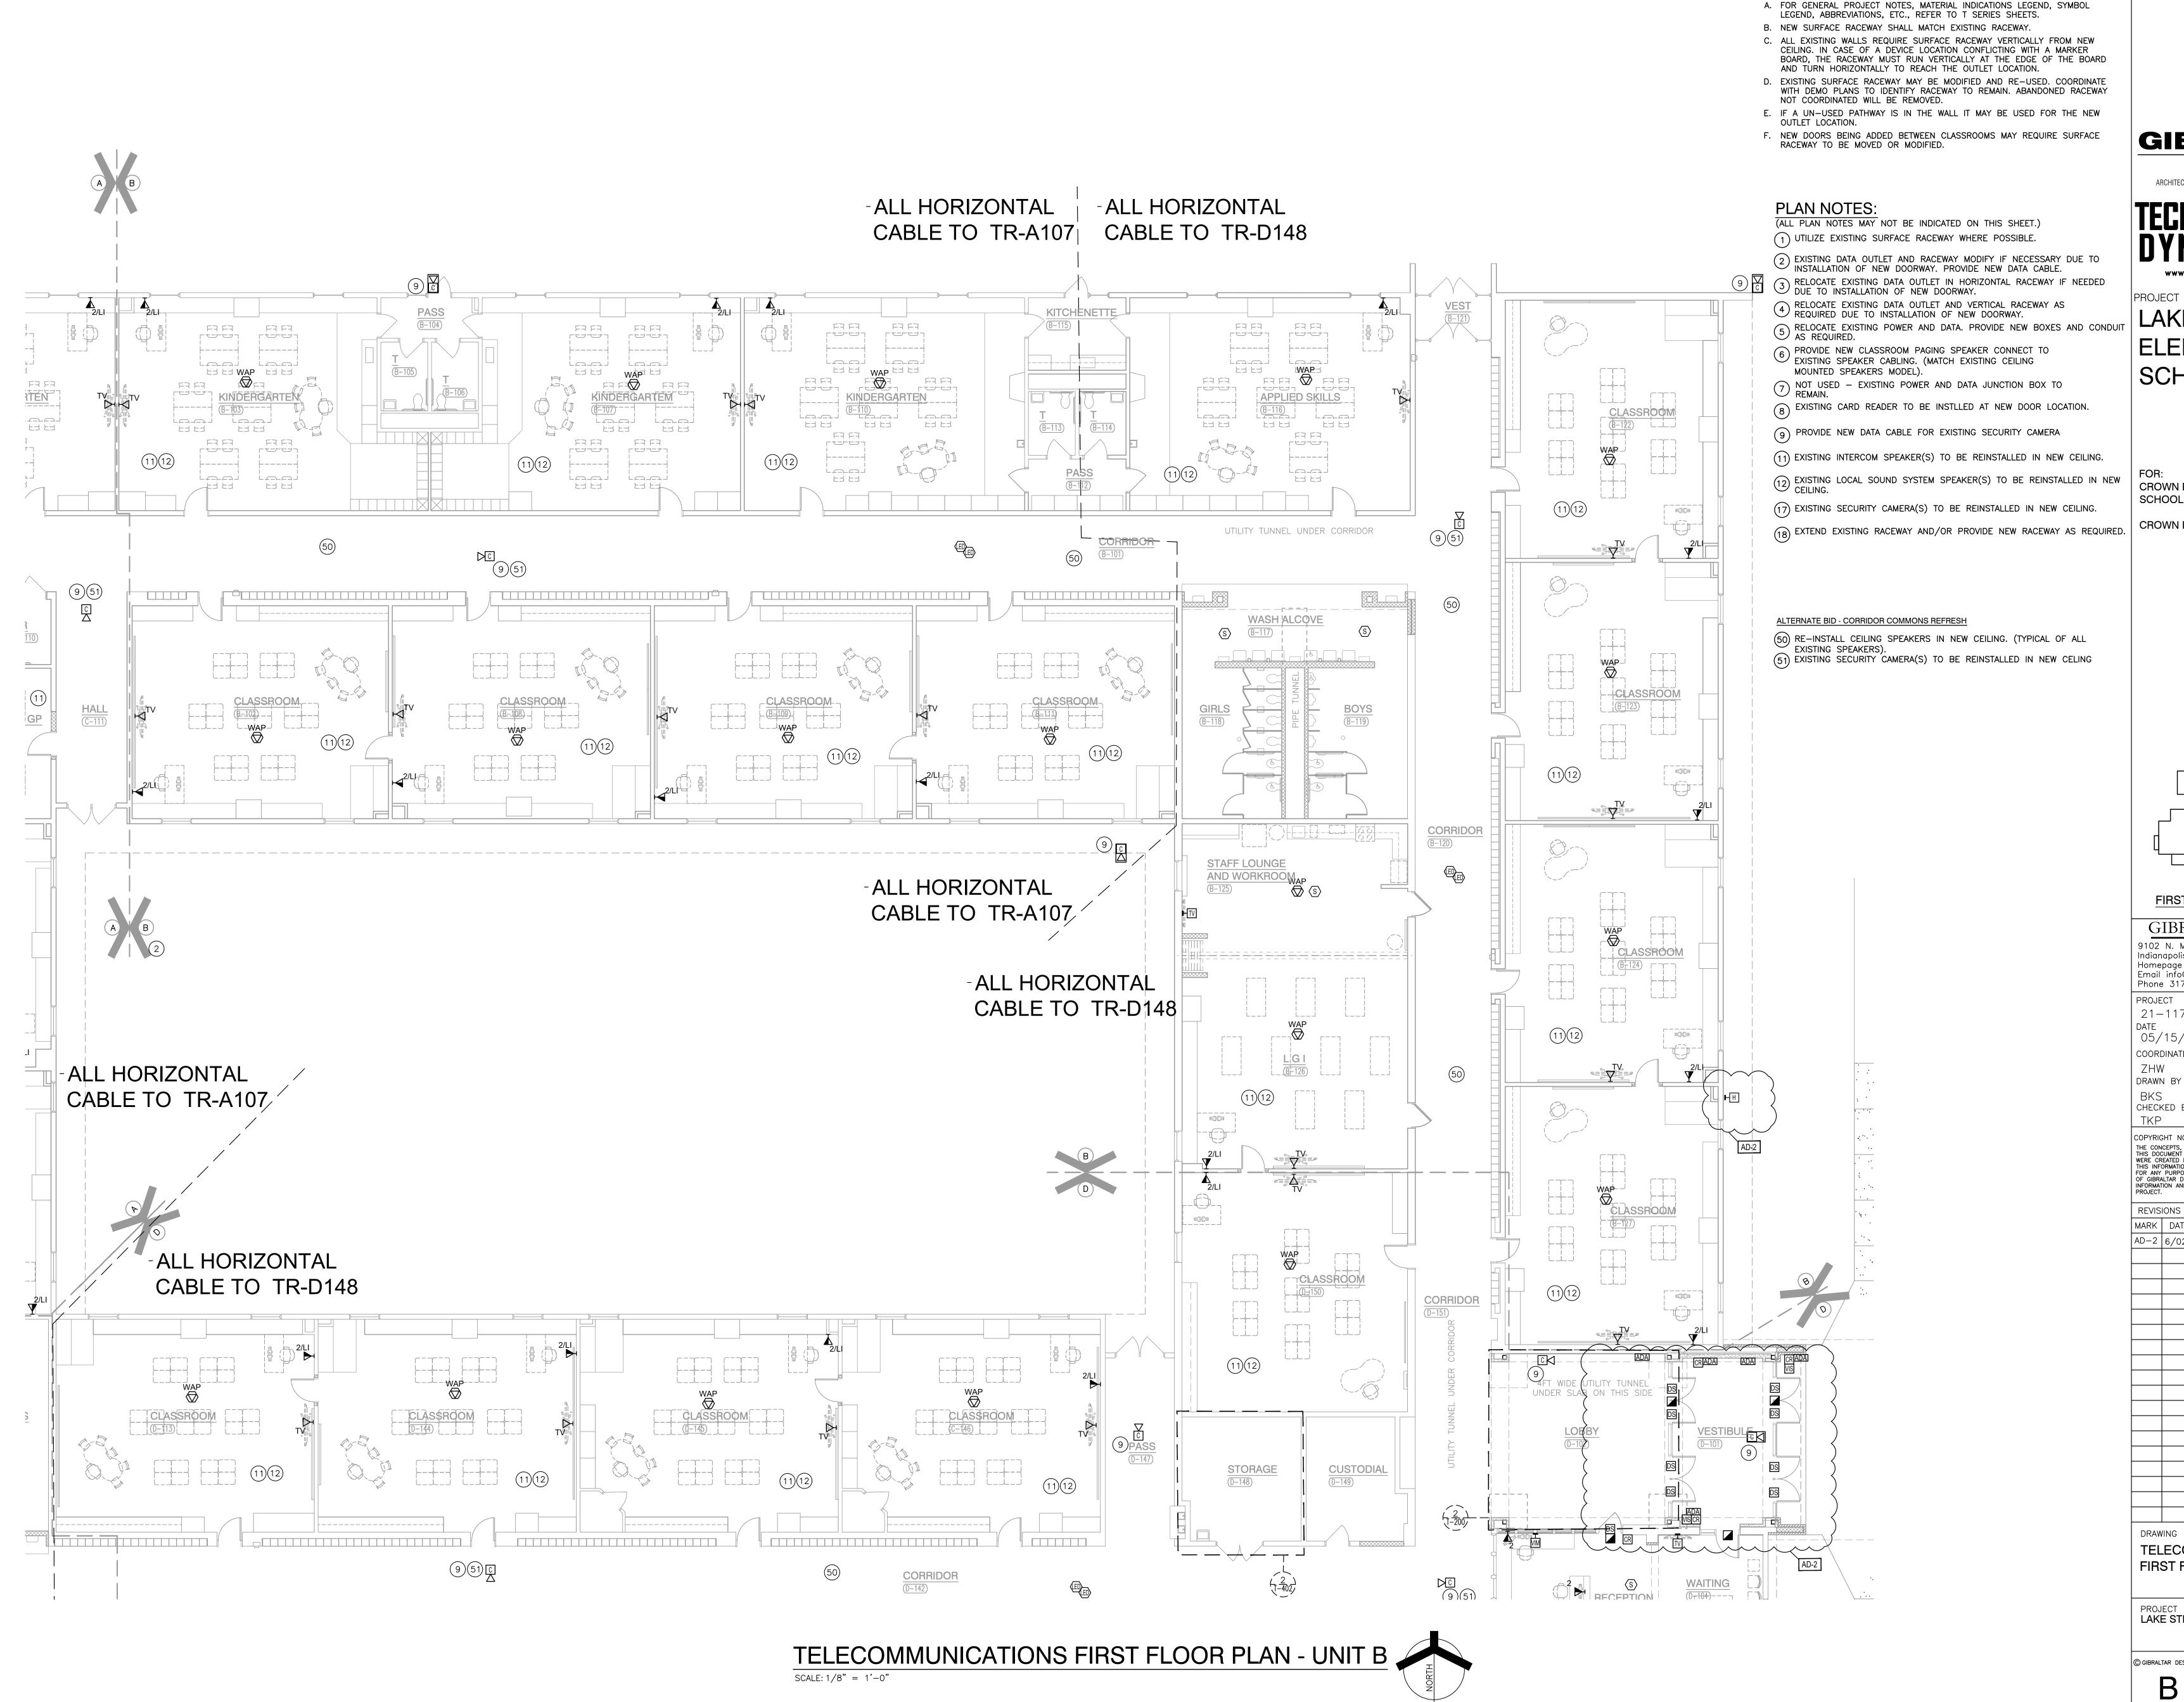

GENERAL PLAN NOTES:

ARCHITECTURE • ENGINEERING • INTERIOR DESIGN www.techdyn.net

LAKE STREET **ELEMENTARY** SCHOOL

CROWN POINT COMMUNITY SCHOOL CORPORATION

CROWN POINT, INDIANA

FIRST FLOOR KEY PLAN

GIBRALTAR DESIGN 9102 N. Meridian St., Ste. 300 Indianapolis, IN 46260 Homepage www.GibraltarDesign.com Email info@GibraltarDesign.com Phone 317.580.5777 Fax 317.580.5778

21-117 DATE 05/15/23 COORDINATED ZHW DRAWN BY

BKS CHECKED BY


Bicsi

REVIS	IONS	
MARK	DATE	ISSUED FOR
AD-2	6/02/23	ADDENDUM NO. 2

TELECOMMUNICATIONS FIRST FLOOR PLAN - UNIT B

PROJECT
LAKE STREET ELEMENTARY SCHOOL

T-102

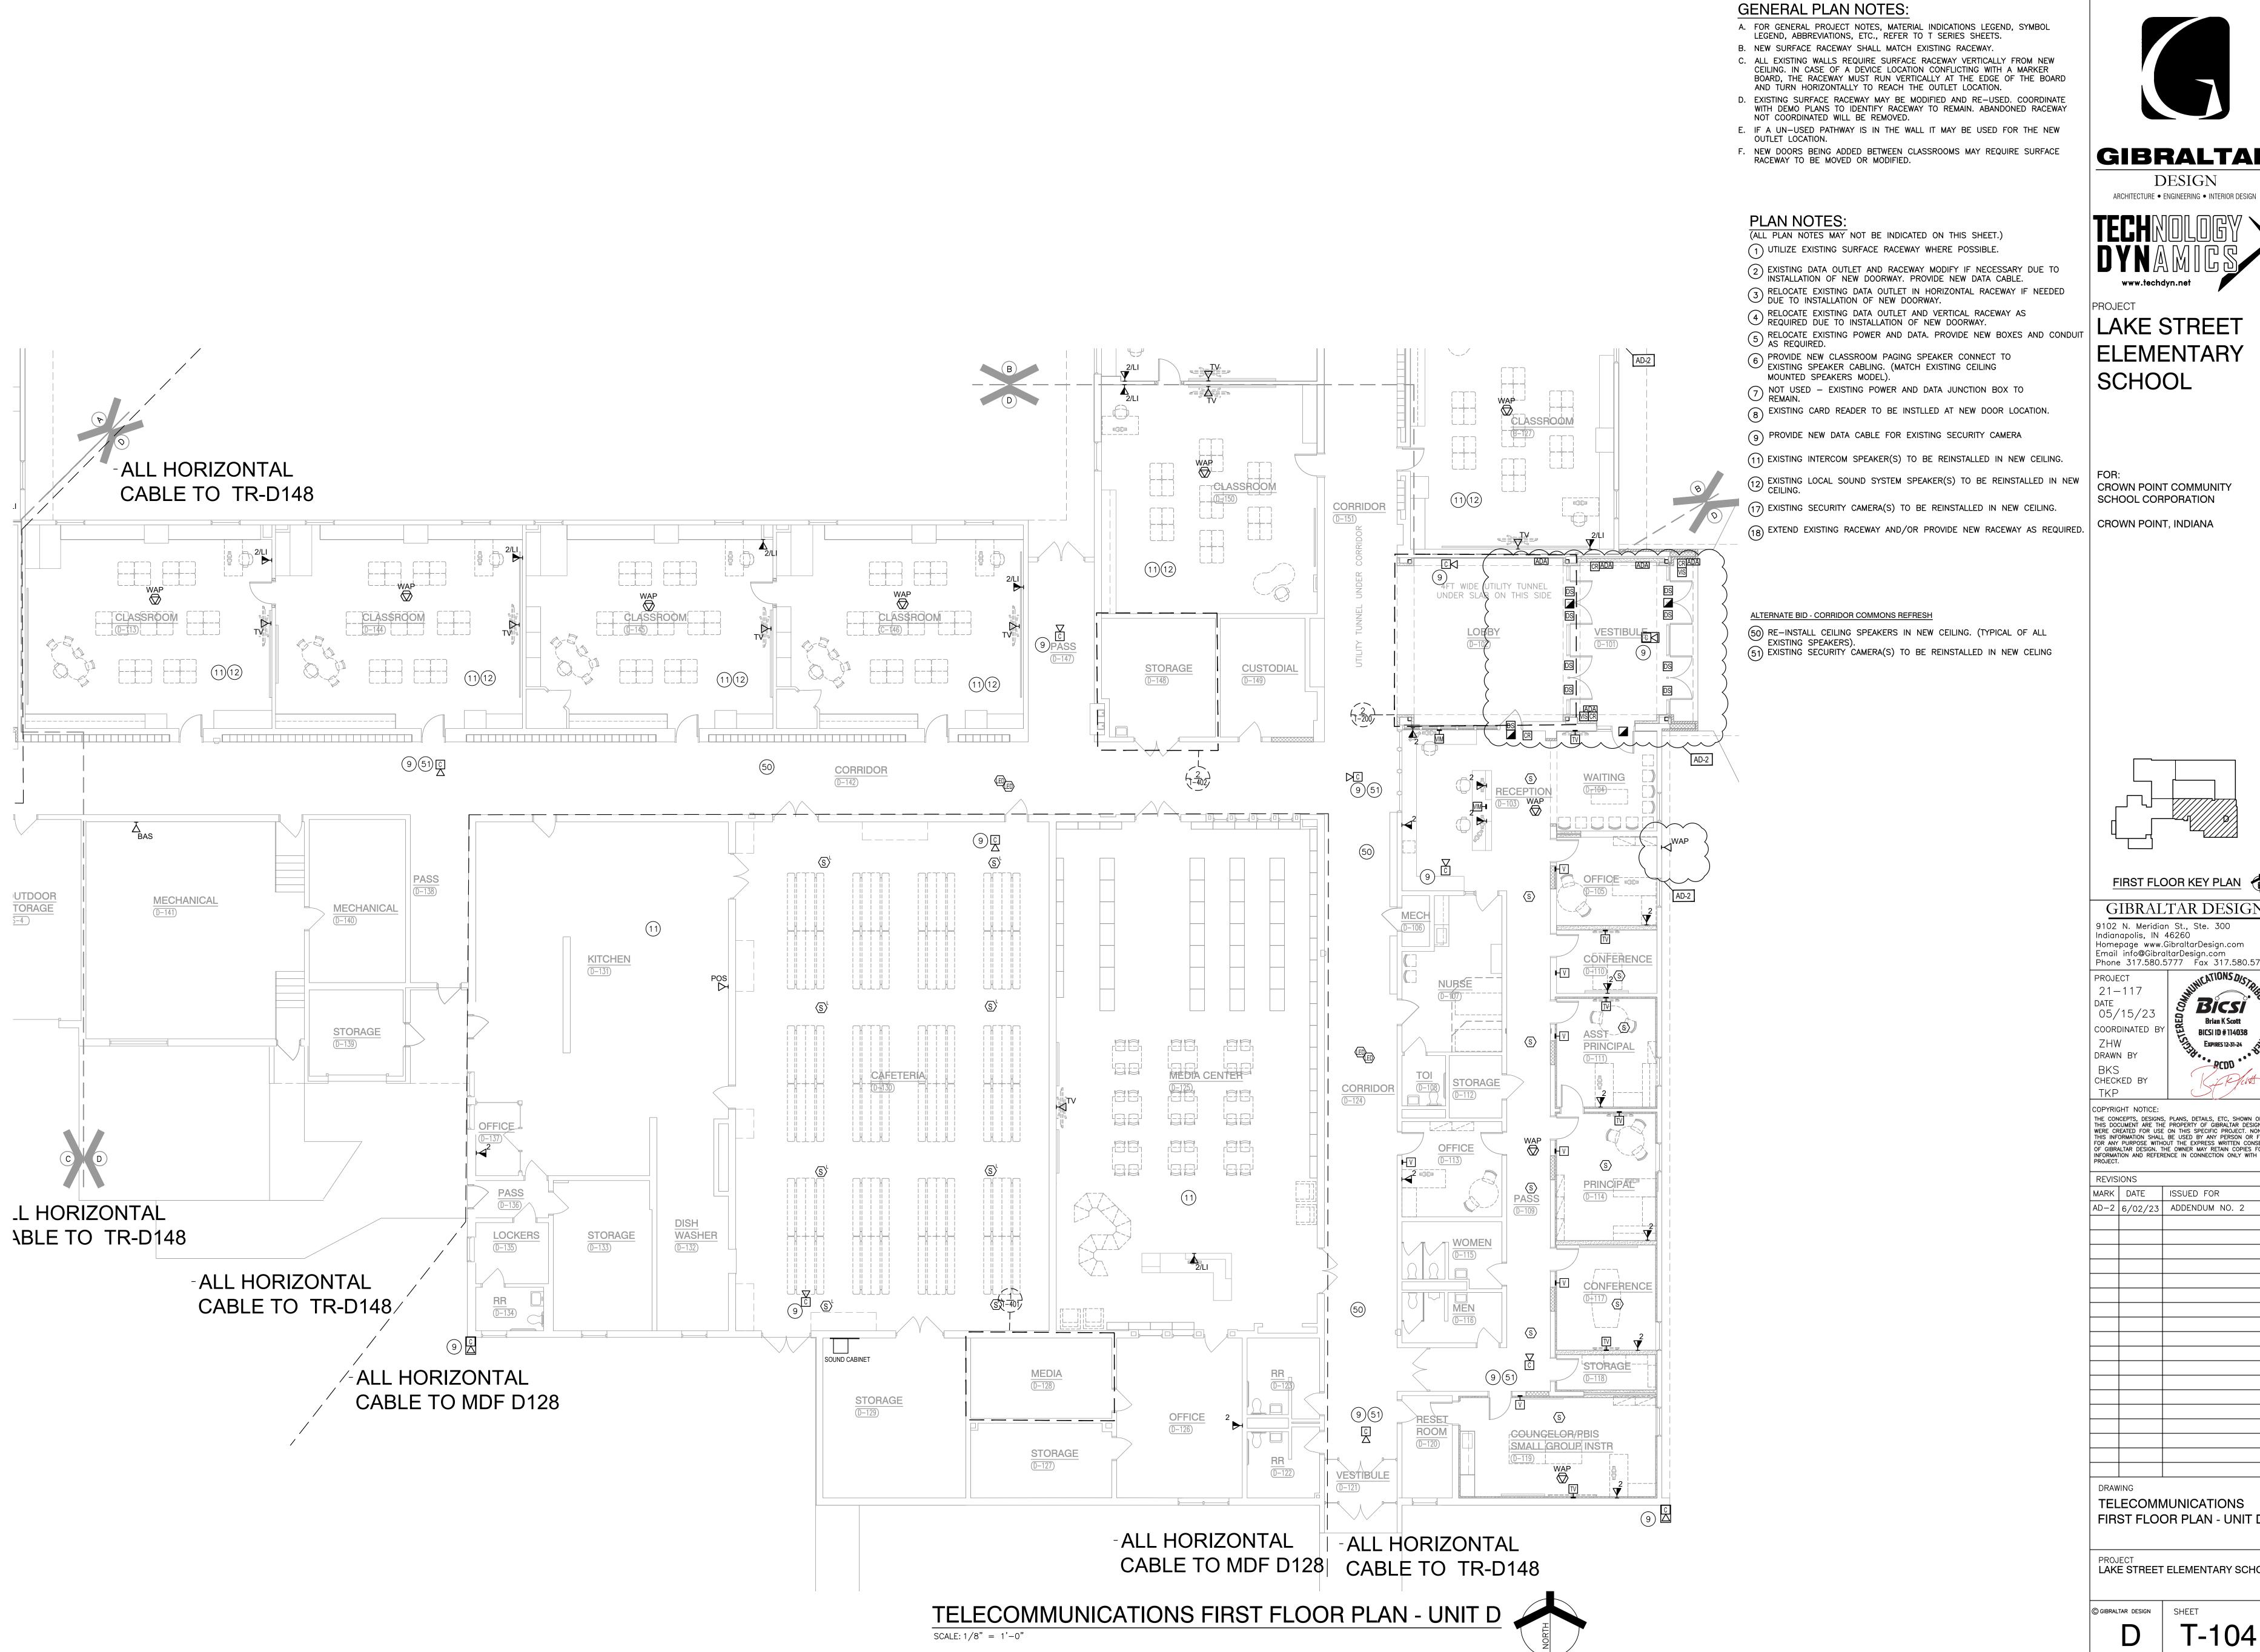

www.techdyn.net

LAKE STREET

ELEMENTARY SCHOOL

CROWN POINT COMMUNITY SCHOOL CORPORATION

CROWN POINT, INDIANA

FIRST FLOOR KEY PLAN

GIBRALTAR DESIGN

9102 N. Meridian St., Ste. 300 Indianapolis, IN 46260 Homepage www.GibraltarDesign.com Email info@GibraltarDesign.com Phone 317.580.5777 Fax 317.580.5778

21-117 DATE 05/15/23

Bicsi

MARK DATE ISSUED FOR AD-2 6/02/23 ADDENDUM NO. 2

TELECOMMUNICATIONS FIRST FLOOR PLAN - UNIT D

PROJECT
LAKE STREET ELEMENTARY SCHOOL

T-104



GENERAL DEMOLITION NOTES

- A. THE CONTRACT DOCUMENTS DO NOT PROPOSE TO SHOW ALL SYSTEMS, MATERIALS, OR EQUIPMENT EXISTING ON THE PROJECT THAT WILL REQUIRE DEMOLITION. DEMOLITION DRAWINGS ARE BASED ON PARTIAL FIELD OBSERVATION REPORT DISCREPANCIES TO THE CONSULTANT BEFORE DISTURBING EXISTING INSTALLATION.
- B. REMOVE ALL ABANDONED CABLING AS DEFINED BY THE NEC.
- C. ALL REMOVED TECHNOLOGY AND / OR SECURITY DEVICE TO BE INVENTORIED AND TURNED OVER TO THE OWNER. PROTECT AND STORE AS DIRECTED BY THE OWNER.
- D. IDENTIFY ITEMS TO BE SALVAGED WITH THE OWNER. PROVIDE NON-DESTRUCTIVE REMOVAL OF SYSTEMS, MATERIALS, AND EQUIPMENT FOR
- REUSE OR SALVAGE AS INDICATED. E. REMOVE ALL COMMUNICATIONS DEBRIS FROM SITE AND LEGALLY DISPOSE. F. COORDINATE ALL LOW VOLTAGE DEMO ACTIVITY WITH CONSTRUCTION MANAGER,
- REVIEW DEMO PHASING PLANS. G. CONTRACTOR UNDERSTANDS THAT ADJACENT AREAS NEED TO REMAIN IN OPERATION AND THAT SERVICES TO THESE AREAS NEED TO BE MAINTAINED.
- H. CONTRACTOR SHALL NOTIFY THE OWNER AND CONSULTANT NO LESS THAN THREE DAYS IN ADVANCE BEFORE COMMENCING ANY DEMOLITION TO INSURE THAT NO ADJACENT OCCUPIED AREAS WILL BE DISRUPTED. I. FIRE STOP ANY SLEEVES WHERE CABLES HAVE BEEN REMOVED.
- CONTRACTOR SHALL BE RESPONSIBLE FOR MAINTAINING TELEPHONE, DATA, CENTRAL SOUND, SECURITY CCTV AND ALARM SYSTEM SERVICES IN ALL EXISTING AREAS FOR DURATION OF PROJECT FOR MULTI-PHASED PROJECTS, CONTRACTOR SHALL COLLABORATE WITH OWNERS TECHNOLOGY PERSONAL AS NECESSARY AND PROVIDE TEMPORARY WIRING, CROSS-CONNECTS, TERMINATION DEVICES, AND LABOR TO MAINTAIN OPERATION ACCEPTABLE THE OWNER. CONTRACTOR SHALL REFER TO THE SPECIFICATIONS FOR ADDITIONAL INFORMATION RELATED TO PHASING.

DEMOLITION PLAN NOTES:

(ALL PLAN NOTES MAY NOT BE INDICATED ON THIS SHEET.)

- 1 EXISTING TELECOMMUNICATION OUTLET(S) TO BE REMOVED. IF OUTLET(S) ARE SURFACE RACEWAY IT CAN REMAIN IF IT DOES NOT INTERFERE WITH OTHER RENOVATION WORK.
- EXISTING WIRELESS ACCESS POINTS(S) TO BE REMOVED. REMOVE CABLE BACK TO THE SOURCE. SECURELY STORE IN A LOCATION DESIGNATED BY
- 3 EXISTING CLOCK TO BE REMOVED. SECURELY STORE IN A LOCATION DESIGNATED BY OWNER.
- 4 EXISTING INTERCOM SPEAKER TO BE REMOVED.
- 5 NOT USED.
- 6 EXISTING AUDIO/VIDEO SYSTEMS AND DEVICES (PROJECTOR AND/OR TELEVISION) AND RELATED MOUNTS AND CABLING, ETC. TO REMAIN. EXISTING AUDIO/VIDEO SYSTEMS AND DEVICES (PROJECTOR, TELEVISION, LOCAL SOUND, ECT.) AND RELATED MOUNTS AND CABLING, TO BE REMOVED. SECURELÝ STORE IN A LOCATION DESIGNATED BY OWNER.
- INTERCOM ETC.) AND RELATED MOUNTS TO BE REMOVED. REMOVE CABLE BACK TO THE SOURCE. SECURELY STORE IN A LOCATION DESIGNATED BY OWNER. 9 EXISTING SECURITY CAMERA(S) TO REMAIN. CEILING MOUNTED UNITS SHALL BE DISCONNECTED FROM CEILING TILE AND TEMPORARILY SUPPORTED TO
- STRUCTURE ABOVE CEILING. REINSTALL INTO NEW CEILING [10] EXISTING INTERCOM SPEAKER(S) TO REMAIN. DISCONNECT FROM CEILING TILE AND PROVIDE TEMPORARY ABOVE CEILING SUPPORT. (TYPICAL)
- EXISTING WIRELESS ACCESS POINT TO REMAIN. DISCONNECT FROM CEILING TILE AND PROVIDE TEMPORARY ABOVE CEILING SUPPORT. REMOVE THE ABANDONED CABLE TO CABINETS AFTER CUT-OVER TO NEW CABLING.
- [12] EXISTING SECURITY DEVICES (CARD READER, CONTROLLER, DOOR INTERCOM ETC.) TO REMAIN IN SERVICE AND/OR BE RELOCATED INTO NEW DOOR

13 EXISTING DEVICE (WIRELESS ACCESS POINT); REMOVE, ATTACH TO NEW CABLE RE-MOUNT TO NEW SOFFIT/FASCIA. 14 EXISTING SOUND CABINET TO REMAIN.

15 SOUND SYSTEM TO BE REMOVED. CORNER MOUNTED CAMERA. REMOVE AND RE-ATTACH TO NEW SOFFIT/FASCIA. CONNECT TO NEW DATA CABLE. 17 EXISTING WALL MOUNTED DOME CAMERAS (ABANDONED) SHALL BE REMOVE AND RETURNED TO OWNER. PLUG PENETRATIONS. 18 EXISTING DEVICE (PAGING HORN); REMOVE AND RE-MOUNT TO NEW SOFFIT/FASCIA.

40 EXISTING INTERCOM SPEAKER(S) TO REMAIN. DISCONNECT FROM CEILING TILE AND PROVIDE TEMPORARY ABOVE CEILING SUPPORT. (TYPICAL). TO BE REINSTALLED INTO NEW CEILING.

41 EXISTING LOCAL SOUND SYSTEM SPEAKER(S) TO REMAIN. DISCONNECT FROM CEILING TILE AND PROVIDE TEMPORARY ABOVE CEILING SUPPORT. (TYPICAL). TO BE REINSTALLED INTO NEW CEILING

ALTERNATE BID - CORRIDOR COMMONS REFRESH

50 EXISTING INTERCOM SPEAKER(S) TO REMAIN. DISCONNECT FROM CEILING TILE AND PROVIDE TEMPORARY ABOVE CEILING SUPPORT. (TYPICAL). TO BE REINSTALLED INTO NEW CEILING.

51 EXISTING SECURITY CAMERA(S) TO REMAIN. CEILING MOUNTED UNITS SHALL BE DISCONNECTED FROM CEILING TILE AND TEMPORARILY SUPPORTED TO STRUCTURE ABOVE CEILING. TO BE REINSTALLED INTO NEW CEILING



DESIGN ARCHITECTURE • ENGINEERING • INTERIOR DESIGN



LAKE STREET **ELEMENTARY** SCHOOL

CROWN POINT COMMUNITY SCHOOL CORPORATION CROWN POINT, INDIANA

FIRST FLOOR KEY PLAN

GIBRALTAR DESIGN 9102 N. Meridian St., Ste. 300

Indianapolis, IN 46260 Homepage www.GibraltarDesign.com Email info@GibraltarDesign.com Phone 317.580.5777 Fax 317.580.5778

Bicsi

PROJECT 05/15/23 COORDINATED E ZHW DRAWN BY BKS

REVISIONS

BICSI ID # 114038 **EXPIRES 12-31-24** CHECKED BY TKP


COPYRIGHT NOTICE: THE CONCEPTS, DESIGNS, PLANS, DETAILS, ETC, SHOWN ON THIS DOCUMENT ARE THE PROPERTY OF GIBRALTAR DESIGN AND WERE CREATED FOR USE ON THIS SPECIFIC PROJECT. NONE OF THIS INFORMATION SHALL BE USED BY ANY PERSON OR FIRM FOR ANY PURPOSE WITHOUT THE EXPRESS WRITTEN CONSENT OF GIBRALTAR DESIGN. THE OWNER MAY RETAIN COPIES FOR INFORMATION AND REFERENCE IN CONNECTION ONLY WITH THIS PROJECT

MARK	DATE	ISSUED FOR
AD-2	6/02/23	ADDENDUM NO. 2

OVERALL **TELECOMMUNICATIONS** FIRST FLOOR DEMOLITION

LAKE STREET ELEMENTARY SCHOOL

TD-100

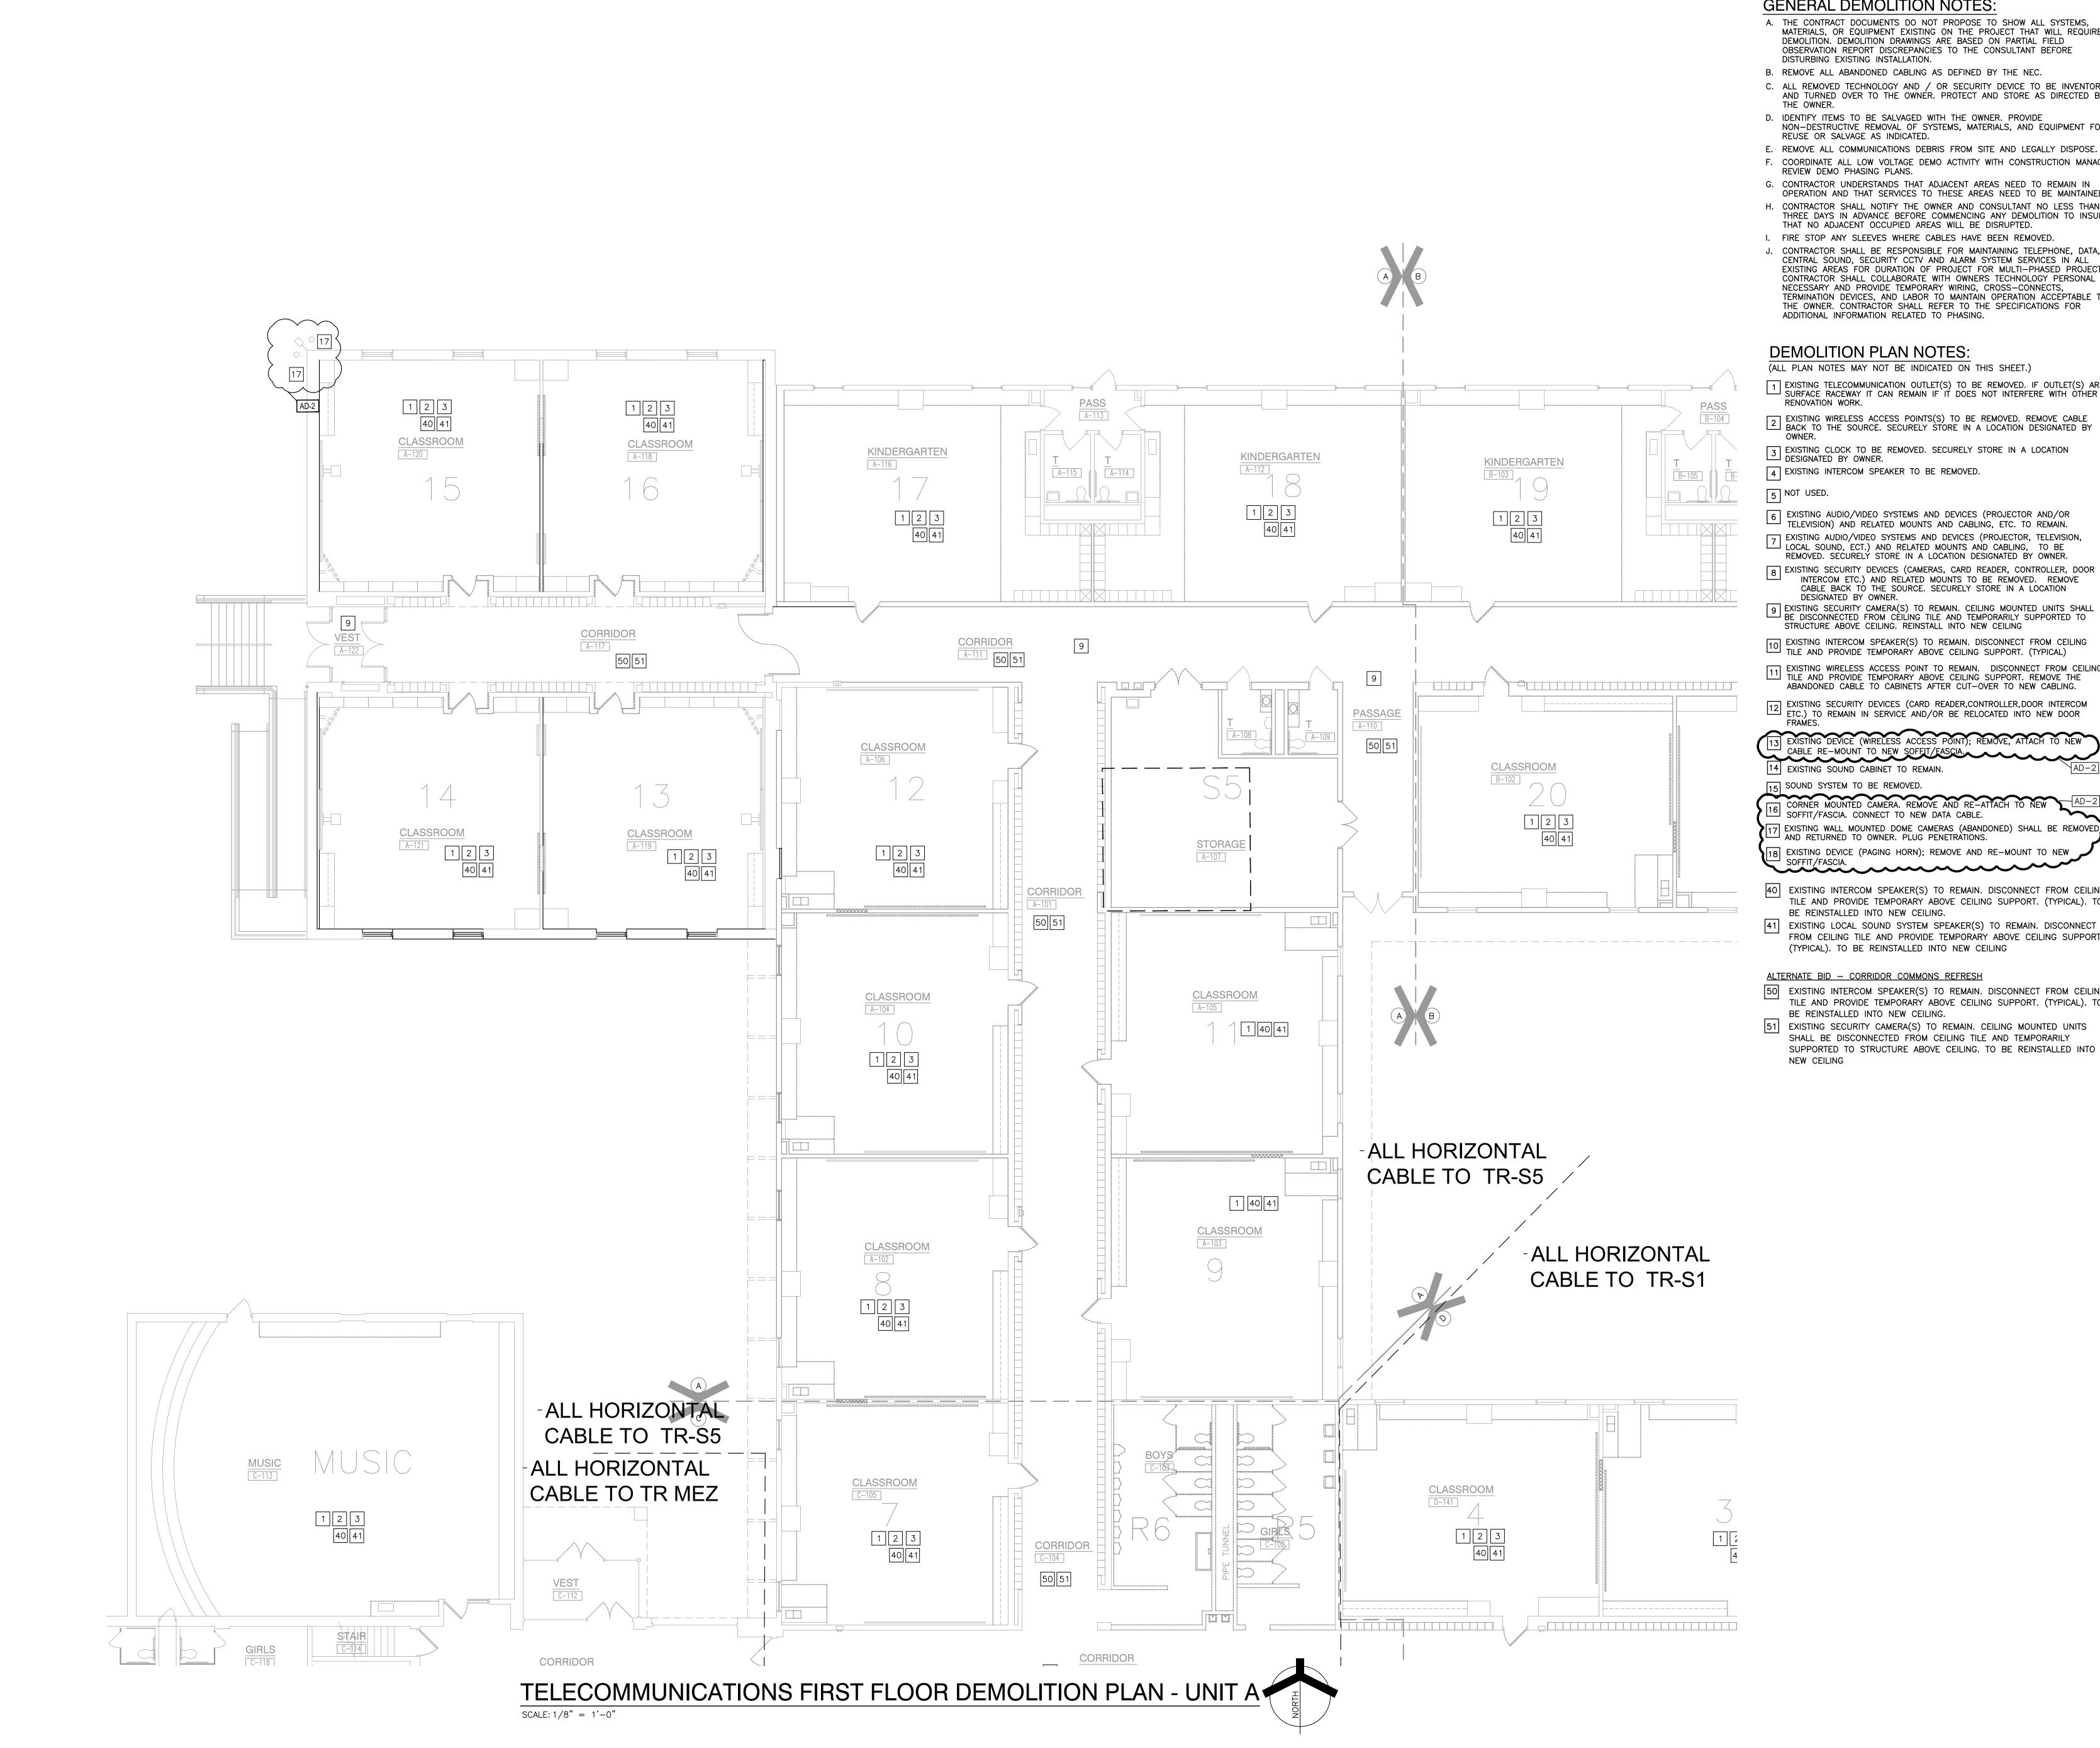

GENERAL DEMOLITION NOTES:

- A. THE CONTRACT DOCUMENTS DO NOT PROPOSE TO SHOW ALL SYSTEMS, MATERIALS, OR EQUIPMENT EXISTING ON THE PROJECT THAT WILL REQUIRE DEMOLITION. DEMOLITION DRAWINGS ARE BASED ON PARTIAL FIELD OBSERVATION REPORT DISCREPANCIES TO THE CONSULTANT BEFORE DISTURBING EXISTING INSTALLATION.
- B. REMOVE ALL ABANDONED CABLING AS DEFINED BY THE NEC.
- C. ALL REMOVED TECHNOLOGY AND / OR SECURITY DEVICE TO BE INVENTORIED AND TURNED OVER TO THE OWNER. PROTECT AND STORE AS DIRECTED BY
- D. IDENTIFY ITEMS TO BE SALVAGED WITH THE OWNER. PROVIDE NON-DESTRUCTIVE REMOVAL OF SYSTEMS, MATERIALS, AND EQUIPMENT FOR
- REUSE OR SALVAGE AS INDICATED. E. REMOVE ALL COMMUNICATIONS DEBRIS FROM SITE AND LEGALLY DISPOSE.
- F. COORDINATE ALL LOW VOLTAGE DEMO ACTIVITY WITH CONSTRUCTION MANAGER, REVIEW DEMO PHASING PLANS. G. CONTRACTOR UNDERSTANDS THAT ADJACENT AREAS NEED TO REMAIN IN
- OPERATION AND THAT SERVICES TO THESE AREAS NEED TO BE MAINTAINED. H. CONTRACTOR SHALL NOTIFY THE OWNER AND CONSULTANT NO LESS THAN THREE DAYS IN ADVANCE BEFORE COMMENCING ANY DEMOLITION TO INSURE THAT NO ADJACENT OCCUPIED AREAS WILL BE DISRUPTED.
- J. CONTRACTOR SHALL BE RESPONSIBLE FOR MAINTAINING TELEPHONE, DATA, CENTRAL SOUND, SECURITY CCTV AND ALARM SYSTEM SERVICES IN ALL EXISTING AREAS FOR DURATION OF PROJECT FOR MULTI-PHASED PROJECTS, CONTRACTOR SHALL COLLABORATE WITH OWNERS TECHNOLOGY PERSONAL AS NECESSARY AND PROVIDE TEMPORARY WIRING, CROSS-CONNECTS, TERMINATION DEVICES, AND LABOR TO MAINTAIN OPERATION ACCEPTABLE THE OWNER. CONTRACTOR SHALL REFER TO THE SPECIFICATIONS FOR

DEMOLITION PLAN NOTES:

(ALL PLAN NOTES MAY NOT BE INDICATED ON THIS SHEET.)

- 1 EXISTING TELECOMMUNICATION OUTLET(S) TO BE REMOVED. IF OUTLET(S) ARE SURFACE RACEWAY IT CAN REMAIN IF IT DOES NOT INTERFERE WITH OTHER
- EXISTING WIRELESS ACCESS POINTS(S) TO BE REMOVED. REMOVE CABLE $\stackrel{ extstyle op}{=}$ back to the source. Securely store in a location designated by
- 3 EXISTING CLOCK TO BE REMOVED. SECURELY STORE IN A LOCATION
- DESIGNATED BY OWNER. 4 EXISTING INTERCOM SPEAKER TO BE REMOVED.
- 6 EXISTING AUDIO/VIDEO SYSTEMS AND DEVICES (PROJECTOR AND/OR TELEVISION) AND RELATED MOUNTS AND CABLING, ETC. TO REMAIN. EXISTING AUDIO/VIDEO SYSTEMS AND DEVICES (PROJECTOR, TELEVISION, ∠ LOCAL SOUND, ECT.) AND RELATED MOUNTS AND CABLING, TO BE REMOVED. SECURELÝ STORE IN A LOCATION DESIGNATED BY OWNER.
- INTERCOM ETC.) AND RELATED MOUNTS TO BE REMOVED. REMOVE CABLE BACK TO THE SOURCE. SECURELY STORE IN A LOCATION DESIGNATED BY OWNER. g EXISTING SECURITY CAMERA(S) TO REMAIN. CEILING MOUNTED UNITS SHALL
- STRUCTURE ABOVE CEILING. REINSTALL INTO NEW CEILING EXISTING INTERCOM SPEAKER(S) TO REMAIN. DISCONNECT FROM CEILING TILE AND PROVIDE TEMPORARY ABOVE CEILING SUPPORT. (TYPICAL)
- [11] EXISTING WIRELESS ACCESS POINT TO REMAIN. DISCONNECT FROM CEILING TILE AND PROVIDE TEMPORARY ABOVE CEILING SUPPORT. REMOVE THE ABANDONED CABLE TO CABINETS AFTER CUT-OVER TO NEW CABLING.
- [12] EXISTING SECURITY DEVICES (CARD READER, CONTROLLER, DOOR INTERCOM ETC.) TO REMAIN IN SERVICE AND/OR BE RELOCATED INTO NEW DOOR

13 EXISTING DEVICE (WIRELESS ACCESS POINT); REMOVE, ATTACH TO NEW CABLE RE-MOUNT TO NEW SOFFIT/FASCIA. 14 EXISTING SOUND CABINET TO REMAIN

15 SOUND SYSTEM TO BE REMOVED. CORNER MOUNTED CAMERA. REMOVE AND RE-ATTACH TO NEW SOFFIT/FASCIA. CONNECT TO NEW DATA CABLE. EXISTING WALL MOUNTED DOME CAMERAS (ABANDONED) SHALL BE REMOVE AND RETURNED TO OWNER. PLUG PENETRATIONS.

40 EXISTING INTERCOM SPEAKER(S) TO REMAIN. DISCONNECT FROM CEILING TILE AND PROVIDE TEMPORARY ABOVE CEILING SUPPORT. (TYPICAL). TO BE REINSTALLED INTO NEW CEILING.

41 EXISTING LOCAL SOUND SYSTEM SPEAKER(S) TO REMAIN. DISCONNECT FROM CEILING TILE AND PROVIDE TEMPORARY ABOVE CEILING SUPPORT. (TYPICAL). TO BE REINSTALLED INTO NEW CEILING

ALTERNATE BID - CORRIDOR COMMONS REFRESH

50 EXISTING INTERCOM SPEAKER(S) TO REMAIN. DISCONNECT FROM CEILING TILE AND PROVIDE TEMPORARY ABOVE CEILING SUPPORT. (TYPICAL). TO BE REINSTALLED INTO NEW CEILING.

51 EXISTING SECURITY CAMERA(S) TO REMAIN. CEILING MOUNTED UNITS SHALL BE DISCONNECTED FROM CEILING TILE AND TEMPORARILY SUPPORTED TO STRUCTURE ABOVE CEILING. TO BE REINSTALLED INTO




DESIGN ARCHITECTURE • ENGINEERING • INTERIOR DESIGN



LAKE STREET **ELEMENTARY** SCHOOL

CROWN POINT COMMUNITY SCHOOL CORPORATION

CROWN POINT, INDIANA

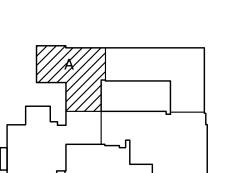

FIRST FLOOR KEY PLAN

GIBRALTAR DESIGN

Indianapolis, IN 46260 Homepage www.GibraltarDesign.com Email info@GibraltarDesign.com Phone 317.580.5777 Fax 317.580.5778

Bicsi

BICSI ID # 114038

EXPIRES 12-31-24

PROJECT 21-117 05/15/23 COORDINATED E ZHW


DRAWN BY BKS CHECKED BY COPYRIGHT NOTICE: THE CONCEPTS, DESIGNS, PLANS, DETAILS, ETC, SHOWN ON THIS DOCUMENT ARE THE PROPERTY OF GIBRALTAR DESIGN AND WERE CREATED FOR USE ON THIS SPECIFIC PROJECT. NONE OF THIS INFORMATION SHALL BE USED BY ANY PERSON OR FIRM FOR ANY PURPOSE WITHOUT THE EXPRESS WRITTEN CONSENT OF GIBRALTAR DESIGN. THE OWNER MAY RETAIN COPIES FOR INFORMATION AND REFERENCE IN CONNECTION ONLY WITH THIS PROJECT.

REVIS	IONS	
MARK	DATE	ISSUED FOR
AD-2	6/02/23	ADDENDUM NO. 2

TELECOMMUNICATIONS FIRST FLOOR DEMOLITION PLAN - UNIT A

PROJECT
LAKE STREET ELEMENTARY SCHOOL

TD-101

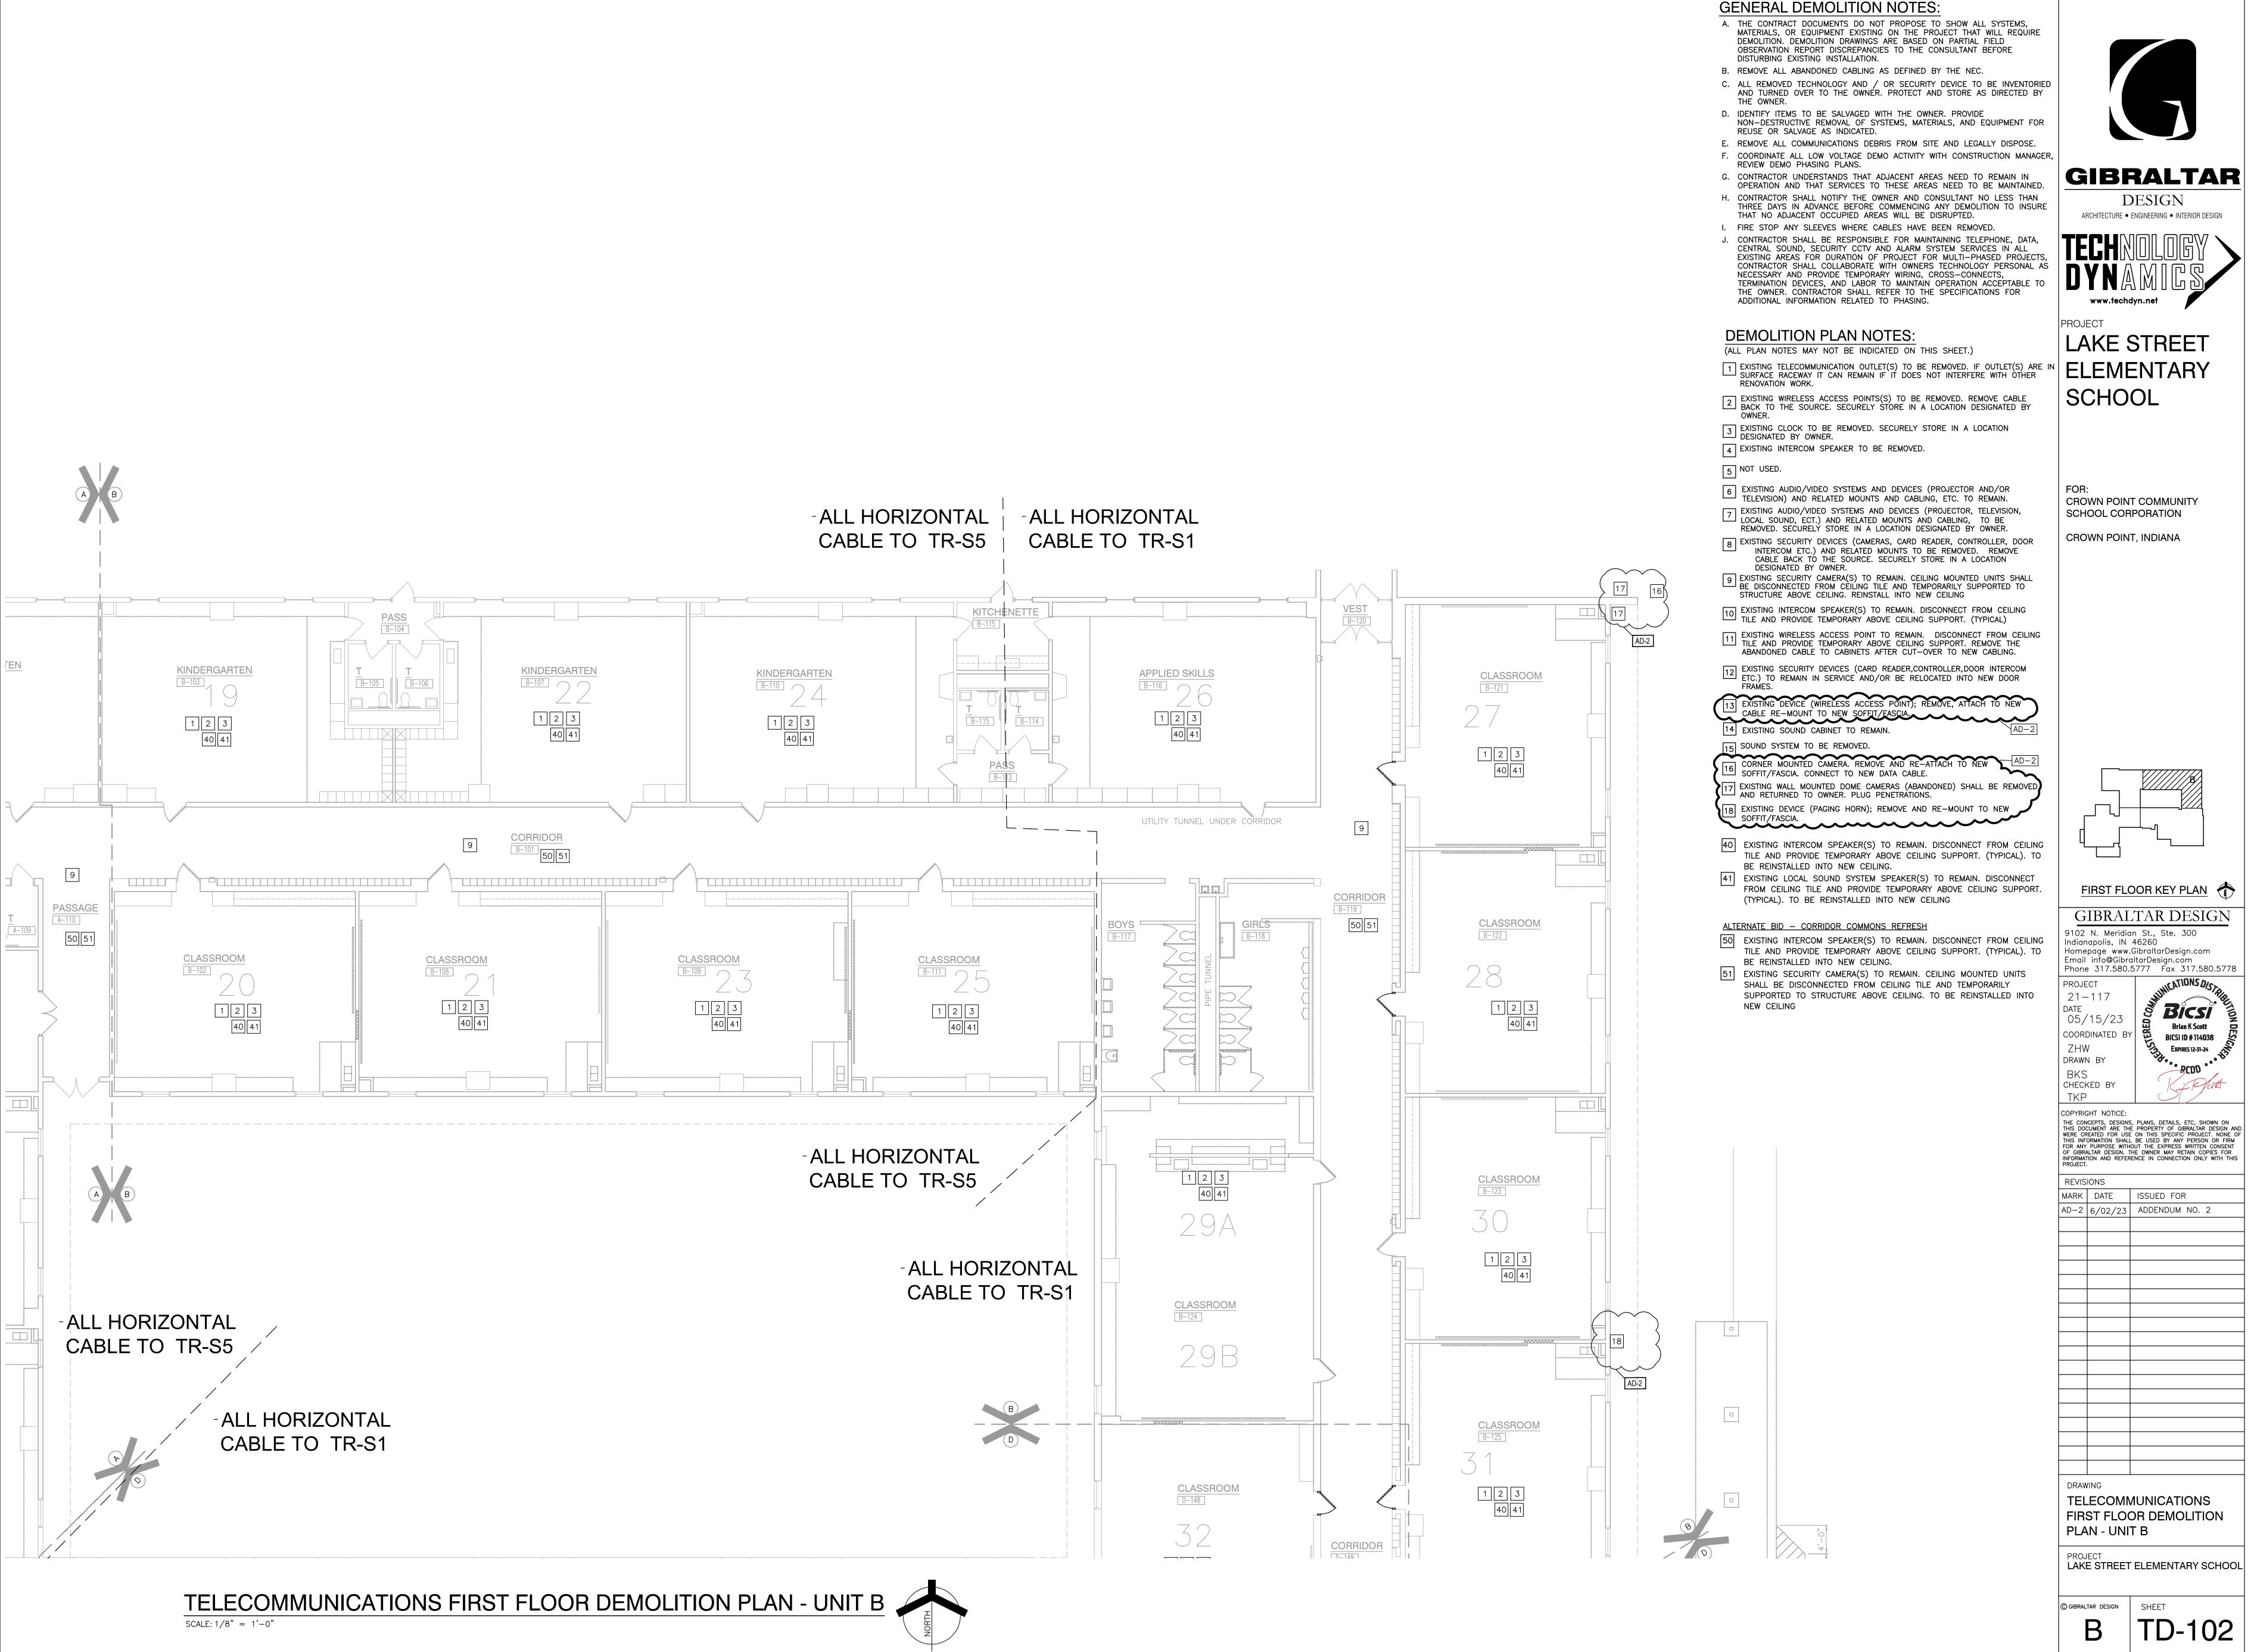


DESIGN

TD-102

Bicsi

BICSI ID # 114038

EXPIRES 12-31-24

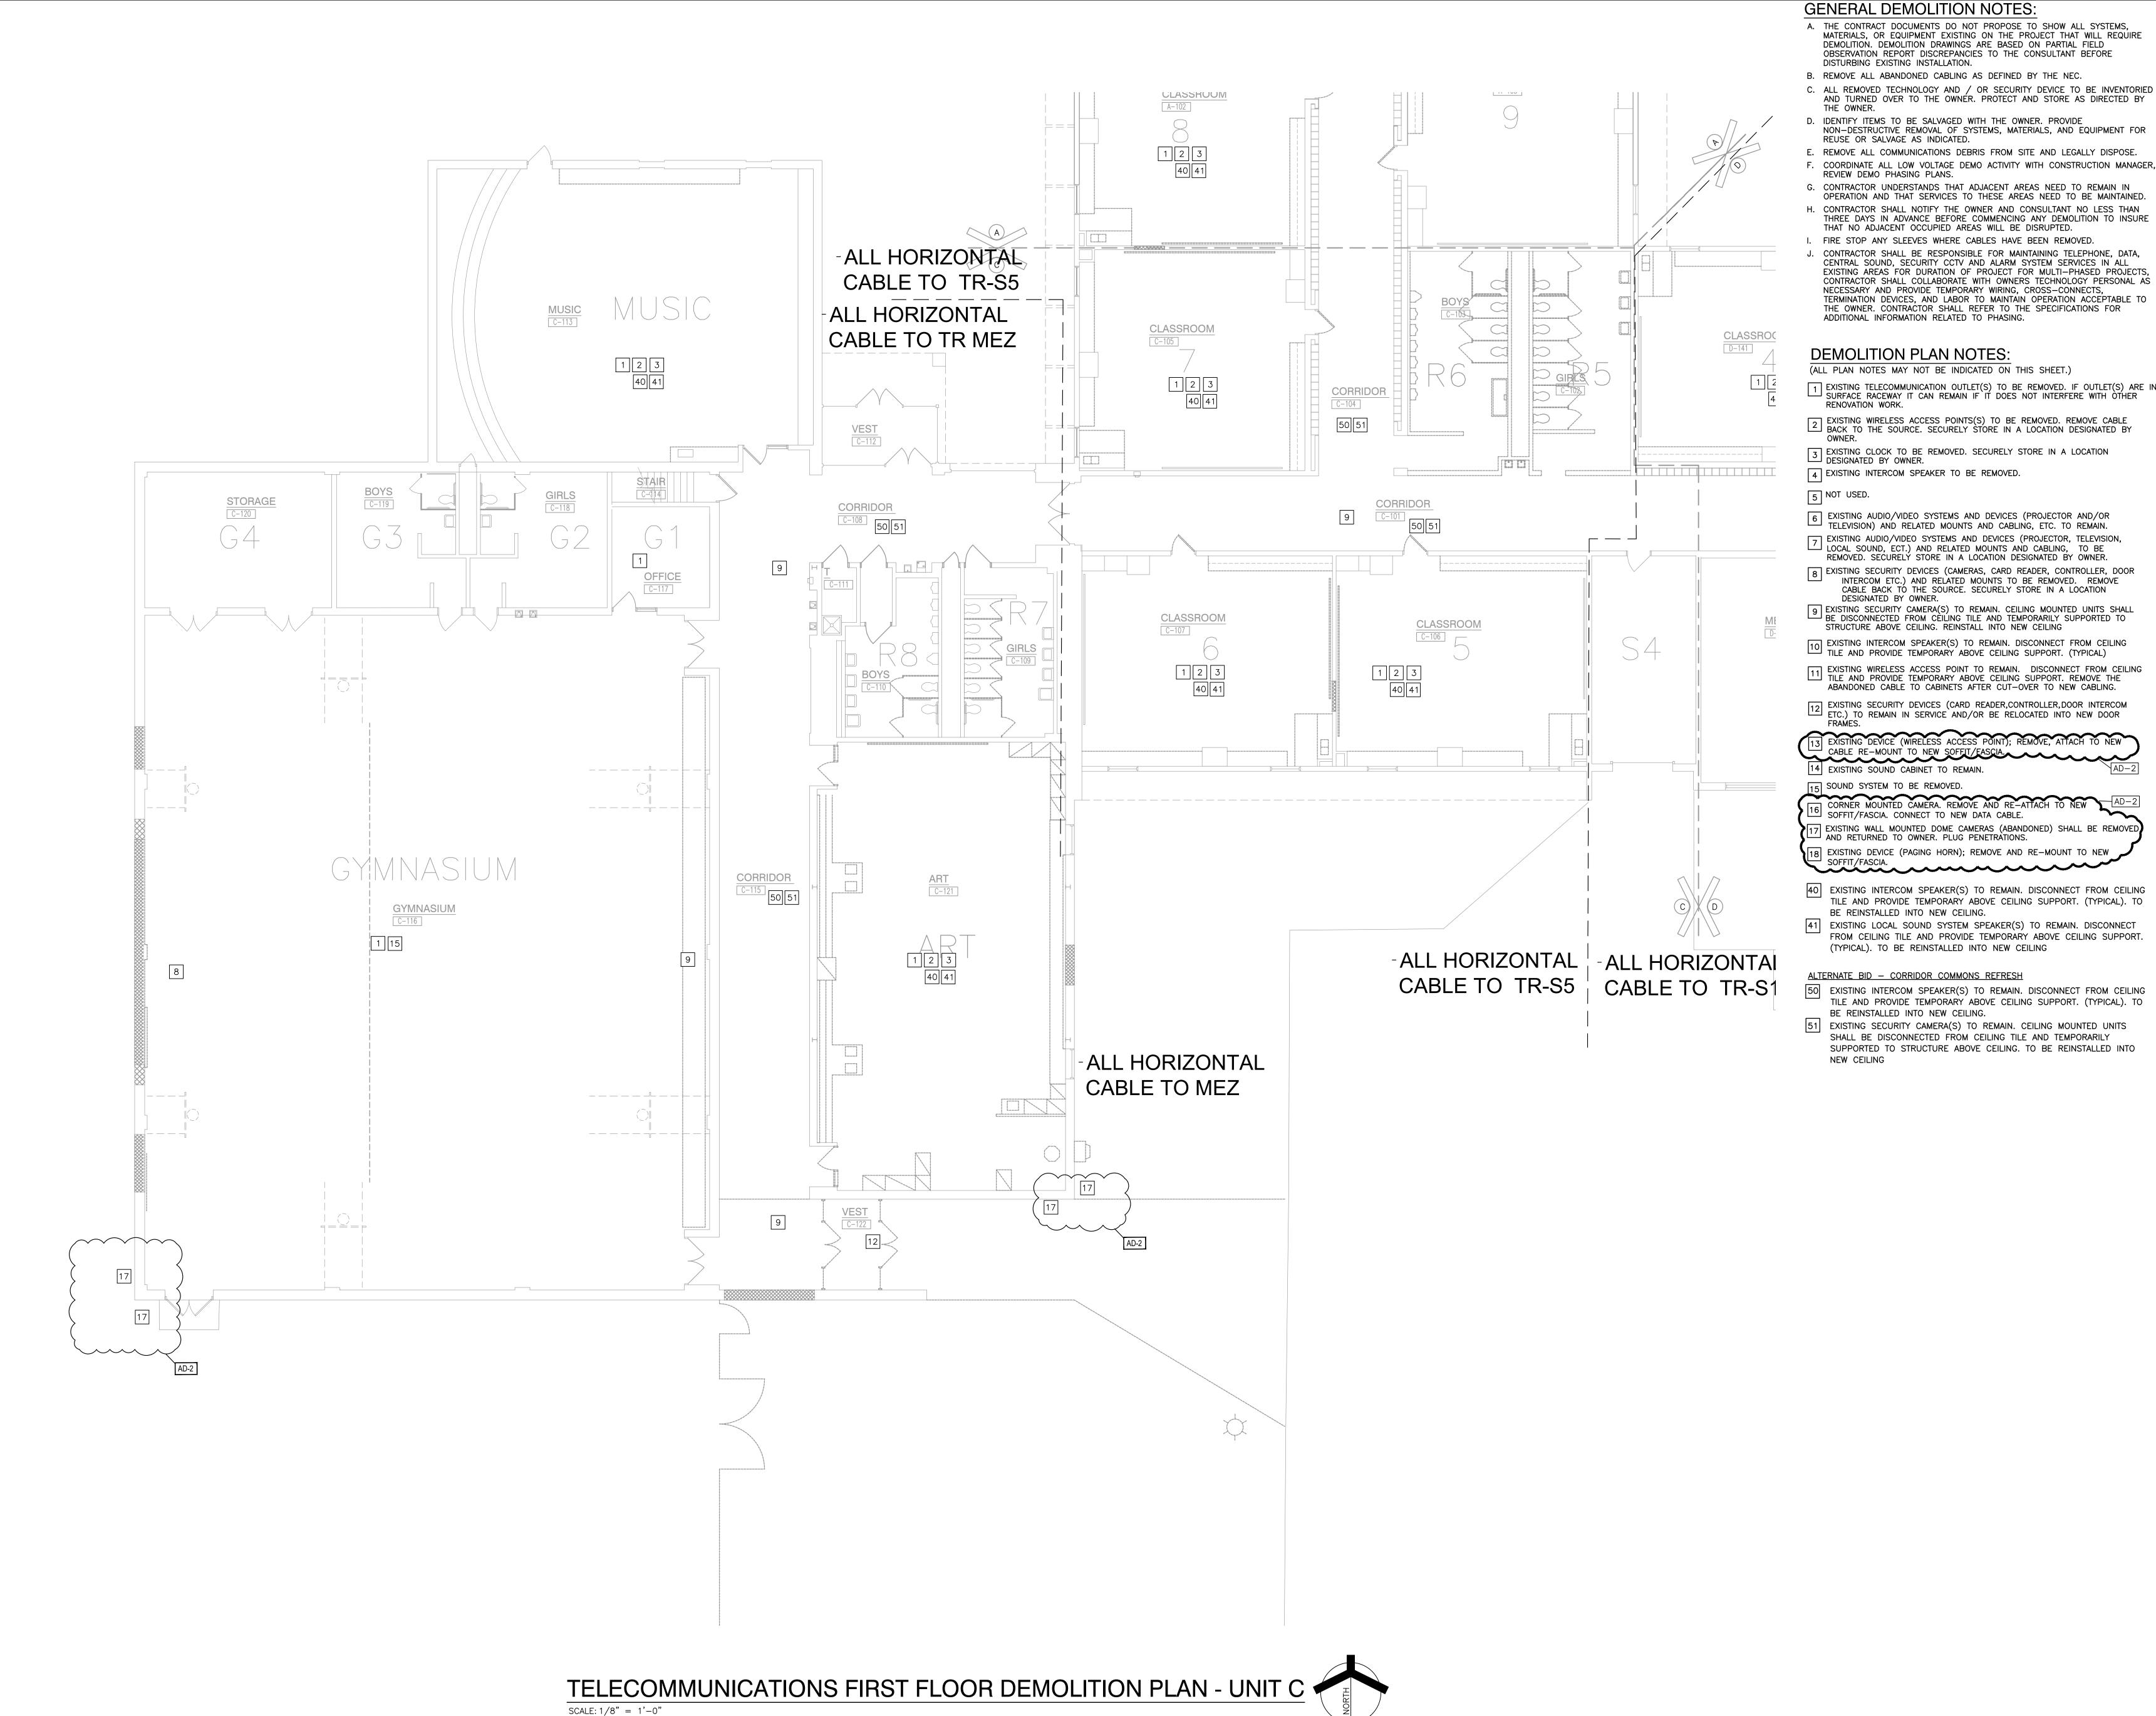

GENERAL DEMOLITION NOTES:

- A. THE CONTRACT DOCUMENTS DO NOT PROPOSE TO SHOW ALL SYSTEMS, MATERIALS, OR EQUIPMENT EXISTING ON THE PROJECT THAT WILL REQUIRE DEMOLITION. DEMOLITION DRAWINGS ARE BASED ON PARTIAL FIELD OBSERVATION REPORT DISCREPANCIES TO THE CONSULTANT BEFORE DISTURBING EXISTING INSTALLATION.
- B. REMOVE ALL ABANDONED CABLING AS DEFINED BY THE NEC.
- AND TURNED OVER TO THE OWNER. PROTECT AND STORE AS DIRECTED BY
- . IDENTIFY ITEMS TO BE SALVAGED WITH THE OWNER. PROVIDE NON-DESTRUCTIVE REMOVAL OF SYSTEMS, MATERIALS, AND EQUIPMENT FOR
- REUSE OR SALVAGE AS INDICATED. REMOVE ALL COMMUNICATIONS DEBRIS FROM SITE AND LEGALLY DISPOSE.
- F. COORDINATE ALL LOW VOLTAGE DEMO ACTIVITY WITH CONSTRUCTION MANAGER, REVIEW DEMO PHASING PLANS. G. CONTRACTOR UNDERSTANDS THAT ADJACENT AREAS NEED TO REMAIN IN
- OPERATION AND THAT SERVICES TO THESE AREAS NEED TO BE MAINTAINED. H. CONTRACTOR SHALL NOTIFY THE OWNER AND CONSULTANT NO LESS THAN THREE DAYS IN ADVANCE BEFORE COMMENCING ANY DEMOLITION TO INSURE THAT NO ADJACENT OCCUPIED AREAS WILL BE DISRUPTED.
- CONTRACTOR SHALL BE RESPONSIBLE FOR MAINTAINING TELEPHONE, DATA, CENTRAL SOUND, SECURITY CCTV AND ALARM SYSTEM SERVICES IN ALL EXISTING AREAS FOR DURATION OF PROJECT FOR MULTI-PHASED PROJECTS, CONTRACTOR SHALL COLLABORATE WITH OWNERS TECHNOLOGY PERSONAL AS NECESSARY AND PROVIDE TEMPORARY WIRING, CROSS-CONNECTS, TERMINATION DEVICES, AND LABOR TO MAINTAIN OPERATION ACCEPTABLE THE OWNER. CONTRACTOR SHALL REFER TO THE SPECIFICATIONS FOR ADDITIONAL INFORMATION RELATED TO PHASING.

DEMOLITION PLAN NOTES:

(ALL PLAN NOTES MAY NOT BE INDICATED ON THIS SHEET.)

- 1 EXISTING TELECOMMUNICATION OUTLET(S) TO BE REMOVED. IF OUTLET(S) ARE SURFACE RACEWAY IT CAN REMAIN IF IT DOES NOT INTERFERE WITH OTHER
- 2 EXISTING WIRELESS ACCESS POINTS(S) TO BE REMOVED. REMOVE CABLE BACK TO THE SOURCE. SECURELY STORE IN A LOCATION DESIGNATED BY
- 3 EXISTING CLOCK TO BE REMOVED. SECURELY STORE IN A LOCATION DESIGNATED BY OWNER. 4 EXISTING INTERCOM SPEAKER TO BE REMOVED.
- 6 EXISTING AUDIO/VIDEO SYSTEMS AND DEVICES (PROJECTOR AND/OR TELEVISION) AND RELATED MOUNTS AND CABLING, ETC. TO REMAIN. 7 EXISTING AUDIO/VIDEO SYSTEMS AND DEVICES (PROJECTOR, TELEVISION, LOCAL SOUND, ECT.) AND RELATED MOUNTS AND CABLING, TO BE REMOVED. SECURELY STORE IN A LOCATION DESIGNATED BY OWNER.
- 8 EXISTING SECURITY DEVICES (CAMERAS, CARD READER, CONTROLLER, DOOR INTERCOM ETC.) AND RELATED MOUNTS TO BE REMOVED. REMOVE CABLE BACK TO THE SOURCE. SECURELY STORE IN A LOCATION g EXISTING SECURITY CAMERA(S) TO REMAIN. CEILING MOUNTED UNITS SHALL
- → BE DISCONNECTED FROM CÈILING TILE AND TEMPORARILY SUPPORTED TO STRUCTURE ABOVE CEILING. REINSTALL INTO NEW CEILING EXISTING INTERCOM SPEAKER(S) TO REMAIN. DISCONNECT FROM CEILING
- TILE AND PROVIDE TEMPORARY ABOVE CEILING SUPPORT. (TYPICAL) [11] EXISTING WIRELESS ACCESS POINT TO REMAIN. DISCONNECT FROM CEILING
- [12] EXISTING SECURITY DEVICES (CARD READER, CONTROLLER, DOOR INTERCOM ETC.) TO REMAIN IN SERVICE AND/OR BE RELOCATED INTO NEW DOOR

CABLE RE-MOUNT TO NEW SOFFIT/FASCIA. 14 EXISTING SOUND CABINET TO REMAIN

CORNER MOUNTED CAMERA. REMOVE AND RE-ATTACH TO NEW SOFFIT/FASCIA. CONNECT TO NEW DATA CABLE. EXISTING WALL MOUNTED DOME CAMERAS (ABANDONED) SHALL BE REMOVE AND RETURNED TO OWNER. PLUG PENETRATIONS. 18 EXISTING DEVICE (PAGING HORN); REMOVE AND RE-MOUNT TO NEW

40 EXISTING INTERCOM SPEAKER(S) TO REMAIN. DISCONNECT FROM CEILING TILE AND PROVIDE TEMPORARY ABOVE CEILING SUPPORT. (TYPICAL). TO

41 EXISTING LOCAL SOUND SYSTEM SPEAKER(S) TO REMAIN. DISCONNECT FROM CEILING TILE AND PROVIDE TEMPORARY ABOVE CEILING SUPPORT. (TYPICAL). TO BE REINSTALLED INTO NEW CEILING

ALTERNATE BID - CORRIDOR COMMONS REFRESH

EXISTING INTERCOM SPEAKER(S) TO REMAIN. DISCONNECT FROM CEILING TILE AND PROVIDE TEMPORARY ABOVE CEILING SUPPORT. (TYPICAL). TO BE REINSTALLED INTO NEW CEILING.

51 EXISTING SECURITY CAMERA(S) TO REMAIN. CEILING MOUNTED UNITS SHALL BE DISCONNECTED FROM CEILING TILE AND TEMPORARILY SUPPORTED TO STRUCTURE ABOVE CEILING. TO BE REINSTALLED INTO

GIBRALTAR


DESIGN ARCHITECTURE • ENGINEERING • INTERIOR DESIGN



LAKE STREET **ELEMENTARY** SCHOOL

CROWN POINT COMMUNITY SCHOOL CORPORATION

CROWN POINT, INDIANA

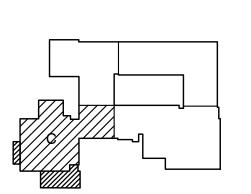

FIRST FLOOR KEY PLAN

GIBRALTAR DESIGN

ndianapolis, IN 46260 Homepage www.GibraltarDesign.com Email info@GibraltarDesign.com Phone 317.580.5777 Fax 317.580.5778

PROJECT 05/15/23 COORDINATED E ZHW DRAWN BY

BKS




COPYRIGHT NOTICE: THE CONCEPTS, DESIGNS, PLANS, DETAILS, ETC, SHOWN ON THIS DOCUMENT ARE THE PROPERTY OF GIBRALTAR DESIGN AND WERE CREATED FOR USE ON THIS SPECIFIC PROJECT. NONE OF THIS INFORMATION SHALL BE USED BY ANY PERSON OR FIRM FOR ANY PURPOSE WITHOUT THE EXPRESS WRITTEN CONSENT OF GIBRALTAR DESIGN. THE OWNER MAY RETAIN COPIES FOR INFORMATION AND REFERENCE IN CONNECTION ONLY WITH THIS PROJECT.

KEVIS	101/12	
MARK	DATE	ISSUED FOR
AD-2	6/02/23	ADDENDUM NO. 2

TELECOMMUNICATIONS FIRST FLOOR DEMOLITION PLAN - UNIT C

LAKE STREET ELEMENTARY SCHOOL

TD-103

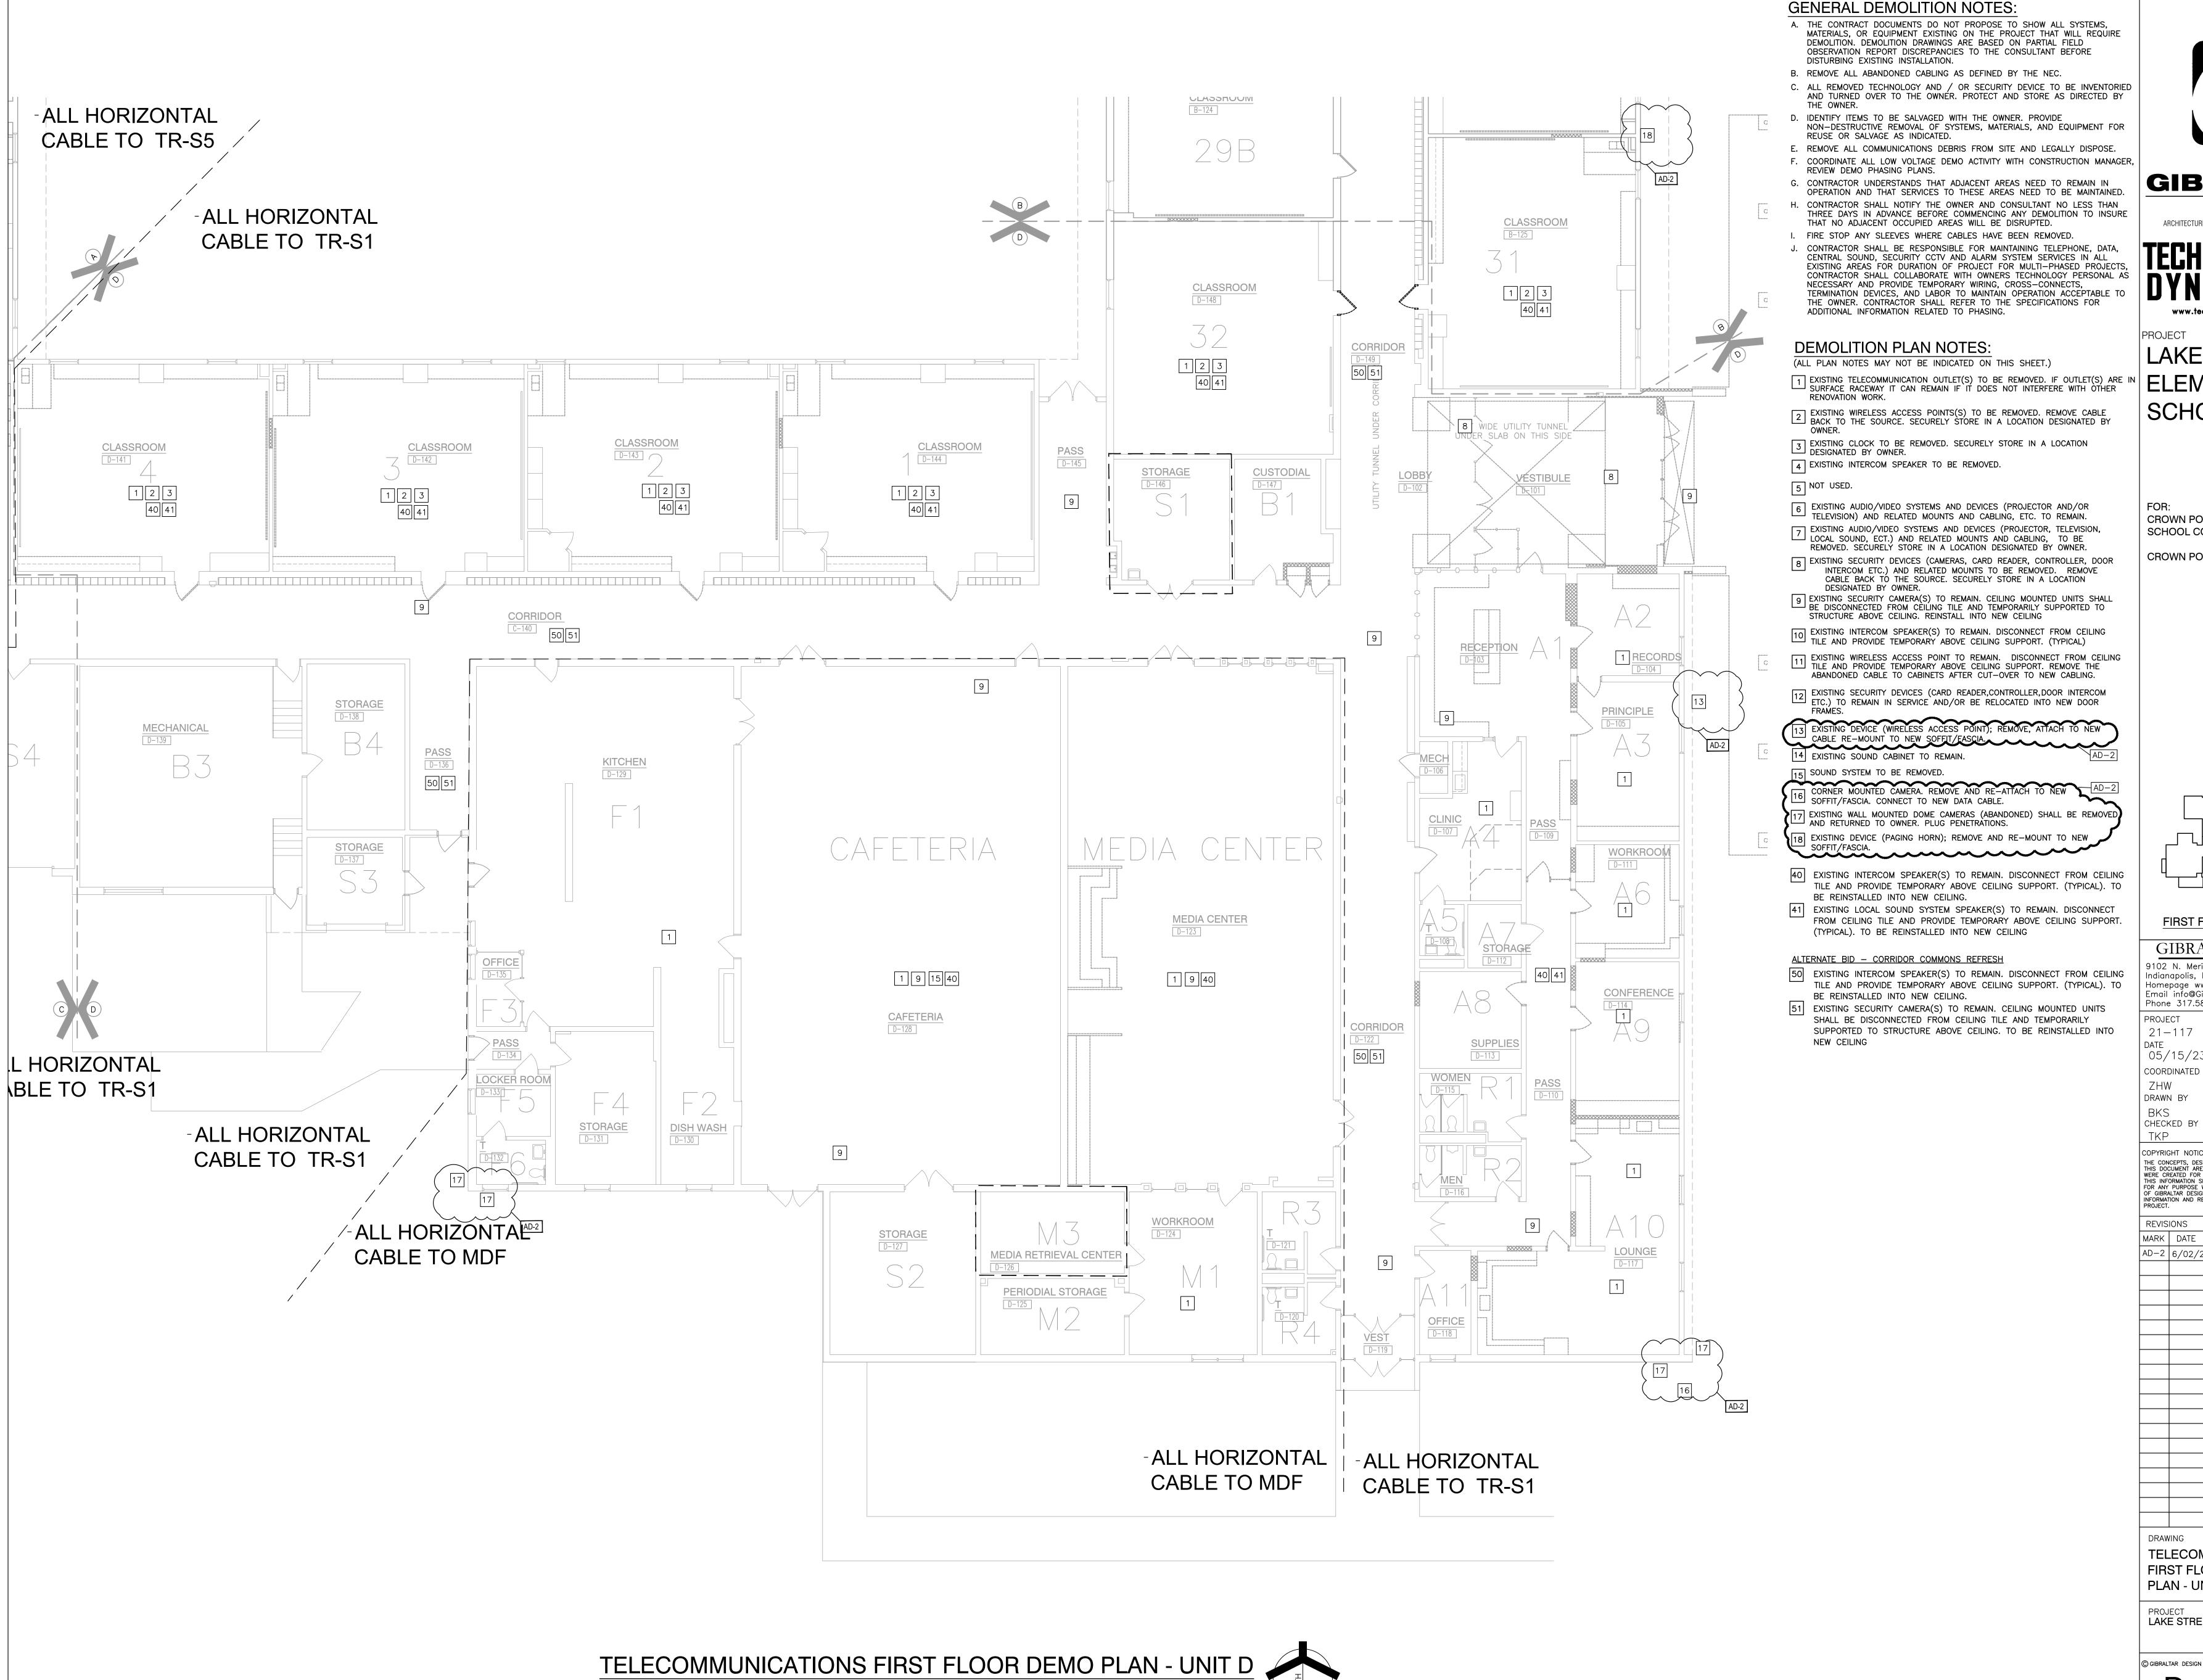

GIBRALTAR


DESIGN ARCHITECTURE ● ENGINEERING ● INTERIOR DESIGN

www.techdyn.net

LAKE STREET **ELEMENTARY** SCHOOL

CROWN POINT COMMUNITY SCHOOL CORPORATION

CROWN POINT, INDIANA

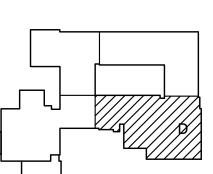


FIRST FLOOR KEY PLAN

GIBRALTAR DESIGN Indianapolis, IN 46260 Homepage www.GibraltarDesign.com

Email info@GibraltarDesign.com Phone 317.580.5777 Fax 317.580.5778

05/15/23 COORDINATED

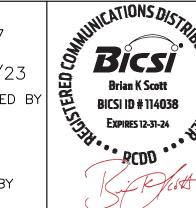

THE CONCEPTS, DESIGNS, PLANS, DETAILS, ETC, SHOWN ON THIS DOCUMENT ARE THE PROPERTY OF GIBRALTAR DESIGN AND WERE CREATED FOR USE ON THIS SPECIFIC PROJECT. NONE OF THIS INFORMATION SHALL BE USED BY ANY PERSON OR FIRM FOR ANY PURPOSE WITHOUT THE EXPRESS WRITTEN CONSENT OF GIBRALTAR DESIGN. THE OWNER MAY RETAIN COPIES FOR INFORMATION AND REFERENCE IN CONNECTION ONLY WITH THIS PROJECT.

REVISIONS						
IARK	DATE	ISSUED FOR				
D-2	6/02/23	ADDENDUM NO. 2				
DRAW	/ING					
TELECOMMUNICATIONS						

FIRST FLOOR DEMOLITION PLAN - UNIT D

LAKE STREET ELEMENTARY SCHOOL

TD-104