

ADDENDUM NO. 02

July 25, 2025

Clark-Pleasant WCHS Phase 3
300 E Main St.
Whiteland, IN 46184

TO: ALL BIDDERS OF RECORD

This Addendum forms a part of and modifies the Bidding Requirements, Contract Forms, Contract Conditions, the Specifications, and the Drawings dated June 2, 2025, by Lancer Associates of Architects (Architect). Acknowledge receipt of the Addendum in the space provided on the Bid Form. Failure to do so may subject the Bidder to disqualification.

This Addendum consists of Pages ADD 2-1 through ADD 2-3 and attached Lancer Associates of Architects, Addendum No. 02, dated July 23, 2025, consisting of 8 pages, Specification Sections 08 41 15 and 28 23 00, and Addendum 2 Drawings: Drawing :208, 300, 500, 801, L101, L201, S002, S101G.2, S101GR, S101N.1, S101N.2, S102A, S102N.2, AD101G, A101GR, A141, A315, A316, A318, A731, A750, A760, PD100G.2, P100G.2, P101G.2, E702, E703.

A. SPECIFICATION SECTION 01 12 00 - MULTIPLE CONTRACT SUMMARY

1. Paragraph 3.02 General Clarifications

Add the following Project Specific Clarifications:

2. Paragraph 3.03 Bid Categories

A. Bid Category No. 1 – General Trades

Add the following Specification Sections:

Section 08 41 15 - FRP FLUSH ALUMINUM DOORS

C. Bid Category No. 3 – Structural Steel/Misc Metals

Add the following specification section:

Section 01 34 00 - BIM Coordination and Clash Detection

Add the following clarification:

20. The Contractor's BIM Coordinator is required to produce three-dimensional CAD file drawings formatted to be imported into Autodesk Build. These files are to include all components needed to coordinate with 3D MEP Coordination files. These files are needed per the master schedule after approved shop drawings for specific areas of the building as scheduled. The Contractors BIM Coordinator and Site Forman are required to attend and participate in 3D Coordination Meetings and update their three-dimensional CAD file drawings from coordination through as-built.

E. Bid Category No. 5 – Metal Studs, Drywall, and Acoustical

Add the following specification section:

Section 01 34 00 BIM - Coordination and Clash Detection

Add the following clarification:

9. The Contractor's BIM Coordinator is required to produce three-dimensional CAD file drawings formatted to be imported into Autodesk Build. These files are to include all components needed to coordinate with 3D MEP Coordination files. These files are needed per the master schedule after approved shop drawings for specific areas of the building as scheduled. The Contractors BIM Coordinator and Site Forman are required to attend and participate in 3D Coordination Meetings and update their three-dimensional CAD file drawings from coordination through as-built.

K. Bid Category No. 11 – Fire Protection

Add the following clarification:

1. The Contractor's BIM Coordinator is required to produce three-dimensional CAD file drawings formatted to be imported into Autodesk Build. These files are to include all components needed to coordinate with 3D MEP Coordination files. These files are needed per the master schedule after approved shop drawings for specific areas of the building as scheduled. The Contractors BIM Coordinator and Site Forman are required to attend and participate in 3D Coordination Meetings and update their three-dimensional CAD file drawings from coordination through as-built.

L. Bid Category No. 12 – Plumbing

Add the following clarification:

1. The Contractor's BIM Coordinator is required to produce three-dimensional CAD file drawings formatted to be imported into Autodesk Build. These files are to include all components needed to coordinate with 3D MEP Coordination files. These files are needed per the master schedule after approved shop drawings for specific areas of the building as scheduled. The Contractors BIM Coordinator and Site Forman are required to attend and participate in 3D Coordination Meetings and update their three-dimensional CAD file drawings from coordination through as-built.

M. Bid Category No. 13 – HVAC

Add the following clarification:

1. The Contractor's BIM Coordinator is required to produce three-dimensional CAD file drawings formatted to be imported into Autodesk Build. These files are to include all components needed to coordinate with 3D MEP Coordination files. These files are needed per the master schedule after approved shop drawings for specific areas of the building as scheduled. The Contractors BIM Coordinator and Site Forman are required to attend and participate in 3D Coordination Meetings and update their three-dimensional CAD file drawings from coordination through as-built.

N. Bid Category No. 14 – Electrical & Technology

Add the following clarification:

1. The Contractor's BIM Coordinator is required to produce three-dimensional CAD file drawings formatted to be imported into Autodesk Build. These files are to include all components needed to coordinate with 3D MEP Coordination files. These files are needed per the master schedule after approved shop drawings for specific areas of the building as scheduled. The Contractors BIM Coordinator and Site Forman are required to attend and participate in 3D Coordination Meetings and update their three-dimensional CAD file drawings from coordination through as-built.

ADDENDUM NO. TWO

**PROJECT: CLARK-PLEASANT COMMUNITY SCHOOL CORP.
WHITELAND COMM. HIGH SCHOOL ADDITION
PHASE 3**

PROJECT NUMBER: 22130

DATE OF ADDENDUM: JULY 23, 2025



THIS ADDENDUM FORMS A PART OF THE CONTRACT DOCUMENTS AND IS ISSUED IN ACCORDANCE WITH THE INSTRUCTIONS TO BIDDERS. ACKNOWLEDGE RECEIPT OF THIS ADDENDUM BY SIGNING THE ADDENDUM ACKNOWLEDGMENT SECTION OF THE BID FORM.

QUESTIONS

Q: On the demo drawings it indicates to remove the pool tile (plan note 4 on AD 101G). with the pool shell being abandoned in place, is it acceptable to leave the pool shell tile in place below grade as the pool walls and floor are being left in place.

A: It is acceptable to leave the pool shell tile in place below grade.

Q: On the finish drawings it lists finish "SS CON" as the floor finish in room G119 and "S CON" in rooms G120 and G121. The Floor Finish legend does not show these designations for floor finish. Are these mislabeled in the rooms and should be noted as "SP CON"? Also, please advise what the "SP CONC" finish represents.

A: Rooms G120 and G121 do not need the stained finish. Room G119 needs the stained finish. These rooms are not mislabeled. SP CONC would refer to SP CON finish.

Q: Please confirm if wall pads, WP-4 need to be custom colored.

A: Yes, WP-4 needs to be a custom color.

Q: In spec section 07 54 19, there are multiple manufacturers listed for the PVC membrane. However, the additional membrane components are all related to Sarnafil (i.e. membrane attachment component, roof board attachment components, insulation, flashing and misc materials). Are other manufacturers acceptable for these items, or is Sika the only acceptable option?

A: Provide equal components from alternate manufacturers. Provide substitution request during submittal process to ensure the components are equal to the specified

Q: Sheet AD141 - Note 15 says to remove the ballast and roof membrane. On sheet A141 note 8 says to re-roof existing building after roof deck reinforcement. Is the intent to remove the membrane only and re-use the existing insulation or is the intent to replace all of the roof components to the deck? Can the designer please issue a roof assembly type for this roof area on an updated sheet A003?

A: The intent is to remove the membrane only and re-use insulation. The existing roof is gravel ballast over membrane roof over 4" min insulation of 5/8" type x gypsum board base over metal deck

Q: Will the electrical devices in the activity center be surface mounted or in the pre-cast? If they are in the pre-cast, who is responsible for the lay out and installation during fabrication?

A: The intent of all conduits to be inside the precast walls. Precast supplier to coordinate all conduits during the shop drawing process

Q: There are three spec sections (08 3300, 08 3314, 08 3316) that all appear to be for one overhead door. Is this correct?

A: Use spec section 08 33 00 for the exterior overhead door on the east side of the fieldhouse. Use spec section 08 33 16 for the Warrior Station. Disregard 08 33 14

Q: Spec calls for, and you show end curtains on end. These can be omitted, since the bleachers can go from wall-to-wall.

A: Omit the end curtains and go wall-to-wall

Q: You are calling for both plastic seats and wood seats.

A: Provide wood seats

Q: On demo drawing AD101G note 26 it indicates to Demo Deck, Patch Finishes as needed for new work. This note appears to be contradictory. We are assuming that "Demo Deck" means to demo the deck tile but the patching of finishes is throwing us off as that appears to mean the tile remains and is to be patched. Please clarify the intent of this note.

A: The note's intent is to demolish the pool deck inclusive of the concrete slab. Contractor is responsible for patching and prepping any adjacent finishes that might have been affected by demo work

Q: Are we to demo and haul off the starting bridge that spans across the pool?

A: Yes, demo all the pool equipment necessary to accommodate new work

Q: Note 26 on AD101G states to demo pool deck. It is assumed this include concrete down to stone base. Please confirm

A: Yes, pool deck removal includes removal of the concrete slab

Q: Drawing A101G.2 does not show wall pads going on any doors, but A752 shows all doors on North, South, West and East elevations getting pads. Should we pad all doors in the wrestling room?

A: Yes, provide wall pads over doors according to A752

Q: We have a curtain system design that can eliminate several of the junction boxes that you are currently showing. We are confident we can get down to 9 curtains, and therefore 9 motors requiring power.

A: Please provide 11 curtains as shown on the drawings

Q: We are showing the curtain 3" off the track radius. Ours will follow the track radius, and stay inside the track.

A: The curtains to not interfere with the track

Q: Project manual vol 1 – 055000-2 section 2.2 calls for a cat walk system "...indicated on the drawings" but I can't seem to locate it in the drawings. Is this a leftover section from a previous project or is there going to be a cat walk system for this project?

A: No catwalk system in this phase of the project

Q: Will a specification be issued for the Plastic Laminate panels. We are not finding those specified in 102600 Wall Protection, 064000 Architectural Woodwork or 123216 PL Casework.

A: The Plastic Laminate panels are in 10 26 05 Wall Protection 2.1.B and C

Q: Also, can you confirm the WP-3 and WP-4 material are part of 116623 Athletic Equipment.

A: WP-3 and WP-4 are part of 10 23 05

Q: Detail 3/A315 – calls for a steel ship ladder but the drawing looks like a vertical wall mounted steel ladder. Is it okay if we use a vertical wall mounted steel ladder?

A: Provide a vertical wall-mounted steel ladder

Q: The drawings in addendum #1 were issued on 8.5x11 could you re-issue those?

A: Please see attached

Q: Can you clarify the extent of the canopy demolition. It doesn't appear to show the full extents on the demo drawings.

A: Please refer to civil sheets for the complete canopy removal. The intent is to remove the whole canopy

Q: Will PVC in the interior of the greenhouse be acceptable?

A: Schedule 80 for electrical branch circuit wiring will be acceptable in the greenhouse.

Q: Could you provide the structural service loads (dead/live loads) for the footings? This can be very helpful for us to make the design work with a higher bearing pressure.

A: Service loads can be provided after bids are awarded. Contractors should assume that service loads are equivalent to 90% of the total load of the respective footings based on a 5,000 psf soil bearing capacity.

Q: Can you provide information on the depth of the pool wall demo below finished floor elevation?

A: Pool wall demo shall be sufficient to install the new slab on grade over top per notes on S101G.2.

Q: Can you confirm SKU codes for WOM-1 and WOM-3?

A: WOM-1 should be TDX118-119 and WOM-3 should be TDC118-119.

Q: Will the electrical devices in the activity center be surface mounted or in the pre-cast? If they are in the pre-cast, who is responsible for the layout and installation during fabrication?

A: All electrical devices and HVAC Control device shall be concealed in the precast. Precast supplier to provide coordination during shop drawings

CLARIFICATIONS:

1. The Hydronic System Cleaning note on Drawing Sheet M001 applies only to hot water heating systems indicated on Drawing Sheets MD101G.2 and MD101H.

SPECIFICATIONS

1. Specification Section: 28 23 00
Specification Title: Video Security
Change:
Updated camera model # for single sensor dome cameras (part 2.3.A.1) and single sensor bullet cameras (part 2.3.A.2).

2. Specification Section 12 66 15
Specification Title: Bleachers Electric
Change:
Delete 1.1 A1b (prevailing wage)

3. Specification Section: 11 66 23
Specification Title: Gymnasium Equipment
Change:

ADD: 1.2, a. 6.

6. Pole Vault Pit Cover. Aluminum Athletic Equipment Model APC size as indicated on drawings.

ADD: 1.2,a.7

7. Long Jump Equipment. Aluminum Athletic Equipment Model APC

Add GPSS 4020/4020-R Fold Up Divider Curtain as an approved product for divider curtains

2.3.C.2.:

Revise as follows:

2.Goal Height Adjuster: Adjustable from 8 to 10 feet with motorized Height Adjuster including a linear actuator with cam style limit switches equal to Draper.

2.3, E.6. a.

Revise as follows:

- a. Control Stations: Smart Gym Control System equal to Draper. Includes Smart Gym Processor Assembly, two Smart Gym Touch Screens and relay panels. Connect to ethernet communications. Touch Screen to control basketball goals, height adjusters, motorized curtains

2.6.F.

Revise to remove key operation control to the touchscreen operation in 2.3.E.6.a

4. Specification Section: 08 41 15
Specification Title: FRP FLUSH ALUMINUM DOORS
ADD:
Attached Section 08 41 15 FRP Flush Aluminum Doors in its entirety.
5. Specification Section 230713
Specification Title: "Duct Insulation".
Add Parts 3.10 R though U as follows:
 - R. Exposed, rectangular, supply-air duct insulation on ducts with sides greater than 18" located in mechanical rooms is the following:
 1. Glass-Fiber Board: 1-1/2 inches thick and 1.6 lb/cu. ft. nominal density (R-6.3 minimum).
 - S. Exposed, rectangular, return-air duct insulation on ducts with sides greater than 18" located in mechanical rooms is the following:
 1. Glass-Fiber Board: 1-1/2 inches thick and 1.6 lb/cu. ft. nominal density (R-6.3 minimum).
 - T. Exposed, rectangular, outdoor-air duct insulation on ducts with sides greater than 18" located in mechanical rooms is the following:
 1. Glass-Fiber Board: 3 inches thick and 1.6 lb/cu. ft. nominal density (R-12.5 minimum).
 - U. Exposed, rectangular, exhaust-air duct insulation on ducts with sides greater than 18" located in mechanical rooms is the following:
 1. Glass-Fiber Board: 3 inches thick and 1.6 lb/cu. ft. nominal density (R-12.5 minimum).
6. The following manufacturers are approved for the associated specification sections:
 - i. Indoor, Semi-Custom Air-Handling Units (237313): VTS
 - ii. Packaged, Small-Capacity, Rooftop Air-Conditioning Units (237416.11): Rheem

DRAWINGS REVISIONS:

1. Drawing Demolition Plan (sheet 208):
 - a. Revised demolition limits on north side of building addition.
2. Drawing Site Dimension Plan (sheet 300):
 - a. Revised pavement and fence on north side of building addition.
3. Drawing Grading Plan (sheet 500):
 - a. Revised pavement grading on north side of building addition.
4. Drawing Erosion Control Plan (sheet 801):
 - a. Revised construction limits and silt fence on north side of building addition.

5. Drawing S101G.2 – FOUNDATION PLAN – UNIT G.2
 - a. Updated extents of new slab on grade to align with demo plans.
6. Drawing S102A – EX. LOW ROOF FRAMING PLAN – UNIT A
 - a. New sheet showing added joist reinforcing details and requirements for new piping in existing building.
7. Drawing S102N.2 – SECOND FLOOR AND LOW ROOF FRAMING PLAN – UNIT N.2
 - a. Provided steel girt sizing.
8. Drawing: A141 Roof Plan
Change:
Changed keynote 8 to read: “REMOVE EXISTING ROOFING AND GRAVEL BALLAST, REUSE EXISTING INSULATION. RE-ROOF THE EXISTING ROOF, RE-USE EXISTING ROOF EDGE COPING AND EDGES”
Added keynote 10 to the roof to the south-east
See attached
9. Drawing: AD101G DEMOLITION PLAN - FIRST FLOOR - UNIT G
Change:
Added clarification drawings of location of existing stairs and railings in the pool mechanical room.
Change keynote 7 to read “DEMO EXISTING DOOR AND FRAME. CLEAN, PATCH AND PREP SURFACES FOR NEW WORK”

See attached
10. Drawings: A101G.1-A102N.2 – unit floor plans
Change:
Change keynote 2 to say “SEMI-RECESSED FIRE EXTINGUISHER”

Attachments:

Specification: 08 41 15, 28 23 00



Drawing :208, 300, 500, 801, L101, L201, S002, S101G.2, S101GR, S101N.1, S101N.2, S102A, S102N.2, AD101G, A101GR, A141, A315, A316, A318, A731, A750, A760, PD100G.2, P100G.2, P101G.2, E702, E703

End of Addendum 2

SECTION 08 4115 - FRP FLUSH ALUMINUM DOORS

PART 1 - GENERAL

1.01 SUMMARY

A. Section Includes

1. Heavy Duty Door; Fiberglass Reinforced Polyester (FRP), urethane foam-filled door, flush design, high traffic and high abuse, impact resistant.

1.02 SYSTEM PERFORMANCE REQUIREMENTS

A. Test Units

1. Air test unit shall be minimum size of 36" (914 mm) x 84" (2134 mm).

B. Test Procedures and Performances

1. Air Infiltration Test

- a. With door sash closed and locked, test unit in accordance with ASTM E 283 at a static air pressure difference of 1.57 psf (75 Pa).
- b. Air infiltration shall not exceed .50 cfm/SF (2.54 l/s•m²) of unit, for single doors.

1.03 SUBMITTALS

A. General Requirements

1. Prepare, review, approve, and submit specified submittals in accordance with "Conditions of the Contract" and Submittals Sections. Product data, shop drawings, samples, and similar submittals are defined in "Conditions of the Contract."

1.04 QUALITY ASSURANCE

- A. Submit certified independent laboratory test reports verifying compliance with all test requirements of 1.02 System Performance Requirements as requested by architect.
- B. Test reports shall be accompanied by the entrance door manufacturer's letter of certification stating that the tested door meets or exceeds the referenced criteria for the appropriate AAMA door type.
- C. Qualifications: Upon request, the manufacturer will provide written confirmation that the installer is authorized to install aluminum entrance products to be used on this project.

1.05 DELIVERY, STORAGE, AND HANDLING

A. Packing, Shipping, Handling, and Unloading

1. Materials will be packed, loaded, shipped, unloaded, stored and protected in accordance with AAMA CW-10.

LANCER ASSOCIATES

1.06 WARRANTY

A. Aluminum Entrance Warranty

1. Products: Submit a written warranty, executed by the aluminum entrance manufacturer, for a period of 2 years (10 years for insulated glass seal failure) from the date of manufacture, against defective materials or workmanship, including substantial non-compliance with applicable specification requirements and industry standards, which results in premature failure of the aluminum entrance, finish, factory-glazed glass, or parts, outside of normal wear.
 - a. In the event that the aluminum entrances or components are found defective, manufacturer will repair or provide replacements without charge at manufacturer's option.
 - b. Warranty for all components must be direct from the manufacturer (non-pass through) and non-prorated for the entire term. Warranty must be assignable to the non-residential owner, and transferable to subsequent owners through its length.
2. Installation: Submit a written warranty, executed by the aluminum entrance installer, for a period of 2 years from the date of substantial completion, against defective materials or workmanship, including substantial non-compliance with applicable specification requirements, which result in premature failure.
 - a. In the event that installation of aluminum entrances or components is found to be defective, installer will repair or provide replacements without charge at the installer's option.

PART 2 - PRODUCTS

2.01 MANUFACTURERS

A. Acceptable Manufacturer

1. Drawings and specifications are based on: Manko Window Systems 170 Series FRP Flush Aluminum Doors
2. Commercial Door Systems.
3. Special-Lite.
4. Architect approved equal.

B. Substitutions

1. Other manufacturers' products that meet or exceed specified design requirements may be considered. Submit the following information with request for substitutions at least ten (10) working days prior to bid date.
 - a. Test reports specified in 1.02 SYSTEM PERFORMANCE REQUIREMENTS
 - b. Full proposal details and samples specified in 1.03 SUBMITTALS
 - c. Copy of manufacturer's warranty specified in 1.06 WARRANTY
 - d. Other information as requested for evaluation

2.02 MATERIALS

A. Aluminum (Entrances and Components)

FRP FLUSH ALUMINUM DOORS

1. Material Standard: ASTM B221; 6063-T5 or 6063-T6 alloy and temper.
2. Door face sheets shall be pebbled texture fiberglass reinforced polyester (FRP) 0.120" thick Class A sheet. For interior and exterior, 1/8" tempered hardboard backer to be used with a face sheet for impact resistance.
3. Core of flush doors shall be foamed-in-place Class 1 urethane foam. Where applicable aluminum interior fire shield shall be assembled into product as required by building code.
4. The door stile and rail face dimensions entrance door will be as follows:

Door	Vertical Stile	Top Rail	Bottom Rail
Flush	4 1/2"	5 1/16"	5 1/16"
5. Mechanical joints of stiles and rails shall have extruded aluminum gussets with concealed 5/16" tie-rods.
6. Perimeter caps shall be extruded aluminum with the bottom cap having dual integral grooves to receive nylon brush door sweep.
7. Frame portions shall be complete with head and jamb weatherstripping, threshold, and door sweep. [Editor's note: Select 1 3/4" x 4 1/2" (450) or 2" x 4 1/2" (1450)]
8. Tolerances: Reference to tolerances for wall thickness and other cross-sectional dimensions of entrance members are nominal and in compliance with Aluminum Standards and Data. Fasteners, where exposed, shall be aluminum, stainless steel or zinc plated steel in accordance with ASTM A164. Perimeter anchors shall be aluminum or steel, providing the steel is properly isolated from the aluminum.

2.03 FABRICATION

A. General

1. Major portions of the door sections shall have .125" (3 mm) wall thickness.

B. Entrance Doors

1. Door stiles shall be no less than 4 1/2" wide face dimension and 1 3/4" overall depth.
2. Reinforcing plates shall be installed to accept specified hardware.
3. Where a pair of door leaves comprise a single opening and no dividing center post is provided, the edge of one door leaf shall be equipped with an astragal and the other shall have an adjustable bullnose with two wool pile weather strips.

C. Glazing

1. All units shall be dry glazed with extruded pressure fitting aluminum glazing stops, and a gasket that complies with ASTM E 2203 specification. See Section 08800 for glazing types.

2.05 FINISHES

A. Finish of Aluminum Components

1. Finish of all exposed areas of aluminum windows and components shall be done in accordance with the appropriate AAMA Voluntary Guide Specification shown (select from below).

Designation	Description	Standard	Color
-------------	-------------	----------	-------

LANCER ASSOCIATES

AAM12C21A44 Electrolytically AAMA 611 Dark Bronze
Deposited – Class I

PART 3 - EXECUTION

3.01 EXAMINATION

A. Site Verification of Conditions

1. Verify that building substrates permit installation of entrances according to the manufacturer's instructions, approved shop drawings, calculations and contract documents.
2. Do not install entrances until unsatisfactory conditions are corrected.

3.02 INSTALLATION

A. Erection of Aluminum Framed Entrances

1. Install entrances with skilled tradesman in exact accordance with approved shop drawings, installation instructions, specifications, and AAMA 101 and 101/I.S.-2.
2. Entrances must be installed plumb, square, and level for proper weathering and operation.
3. All joints between framing and the building structure shall be sealed in order to secure a water tight installation.
4. Aluminum that is not organically coated shall be insulated from direct contact with steel, masonry, concrete, or dissimilar metals by bituminous paint, zinc chromate primer, non-conductive shims or other suitable insulating material.

3.03 PROTECTION AND CLEANING

- ##### A.
- After completion of entrance installation, the General Contractor shall adequately protect exposed portions of aluminum surfaces from damage by grinding and polishing compounds, plaster, lime, acid, cement, or other contaminants. The General Contractor shall be responsible for the final cleaning. Manko Windows Systems, Inc. recommends mild soap and water to clean the aluminum surface of the doors.

END OF SECTION 08 4115

SECTION 28 23 00 – VIDEO SECURITY

PART 1 - GENERAL

1.1 RELATED DOCUMENTS

- A. Drawings and general provisions of the Contract, including General and Supplementary Conditions and Division 01 Specification Sections, apply to this Section.
- B. Specifications throughout all Divisions of the Project Manual are directly applicable to this Section, and this Section is directly applicable to them.

1.2 SUMMARY

- A. Provide all work as detailed in the Contract Drawings as a turn-key installation, including all material, software, licenses, labor, as-built documentation, warranties, taxes, freight and permits. Only items and requirements specifically stated to be provided under another section shall not be a requirement for this section of the work.
- B. The end product which the contractor is to produce shall be a complete, operational and functional integrated video security system.
- C. Provide the following Systems and Equipment:
 - 1. Security Cameras, Housings and Mounts
 - 2. Power supplies as needed
- D. Coordinate all installation and integration of the security system with the following related systems:
 - 1. Division 27 - Communications
 - 2. Section 28 13 00 - Access Control

1.3 EXISTING EQUIPMENT

- A. Certain installed existing cameras will require removal and reinstallation as described in the T-series drawings. Additionally, the owner may provide equipment for installation by the contractor. This equipment will be identified on the T-series drawings.

1.4 REFERENCE STANDARDS

- A. The latest published edition of a reference shall be applicable to this Project unless identified by a specific edition date.
- B. All reference amendments adopted prior to the effective date of this Contract shall be applicable to this Project.
- C. All materials, installation and workmanship shall comply with the applicable requirements and standards addressed within the Contract Documents.

1.5 QUALITY ASSURANCE

- A. Contractor Qualifications:
 - 1. All work specified herein shall be the responsibility of the Contractor. Contractors shall document a minimum of five years' experience in the fabrication, assembly and installation of system of similar complexity as specified herein. The documentation shall include the names, locations and points of contact for at least three installations of the type and complexity specified herein. The contractors shall provide a brief overview of each system detailing what video system was used; the amount of equipment installed; and certify that the system has been in operation for a minimum of 24 months.
 - 2. The Contractor shall have a service facility and organization with staffing capable of providing comprehensive maintenance and service to the specified systems within 4

- hours after being called, 24 hours per day and 7 days per week for the duration of any warranty or service contract.
3. The Contractor shall provide in-house engineering and project management capabilities consistent with the requirements of the work. The Contractor shall have a project manager and field supervisor in place which oversees the entire project till completion of the project. The assigned project manager will be responsible for coordination, scheduling, manpower, commissioning etc. of the project. The Contractor's field supervisor shall be present during the full duration of the project to oversee field installations and to coordinate with other trades to ensure progress on the project.
 4. The Contractor must be familiar with local codes and contract conditions pertaining to this project.

B. Product Standards:

1. All materials installed on this or any other project must be new and the latest specification and version from the manufacturer.
2. All products installed shall be what is depicted in these specifications with no exceptions.

1.6 SUBMITTALS

A. PRODUCT DATA SUBMITTALS

1. Submit manufacturer's product data for all security systems equipment within scope, including but not limited to; termination equipment, security system equipment, and any associated equipment and materials.
2. Include cut sheets with rated capacities, operating characteristics, electrical characteristics and other measurements and descriptions which describe these items in detail for product data submittals.

B. SHOP DRAWING SUBMITTALS

1. Contractor shall be responsible for producing and submitting their own original shop drawings detailing at a minimum security device locations, mounting information, cabling routing, headend equipment and panel sizing, and manufacturer & part numbers for all security cameras, camera mounts, camera lens positioning, card readers, door position sensors, panic buttons, door release buttons, motion/glass-break/water presence sensors, emergency pedestals, and associated security systems equipment.
2. These shop drawings must be created utilizing a modeling software such as Autodesk AutoCAD in addition to being exported in pdf version for design team and owner review. The owner reserves the right to request an electronic copy of the shop drawings in both Autodesk CAD (.DWG) format and pdf format.

C. RECORD DOCUMENTS:

1. Prior to final project closeout and completion, contractor shall be required to submit record documents to the design team in the form of as-built documentation. At a minimum, the as-built drawings shall identify component locations and any other changes that deviated from the contract documents.
2. Record documents turned over to the owner shall include the Manufacturer's warranty form in which manufacturer agrees to repair or replace components that fail, in materials or workmanship, within specified warranty period.

D. OPERATION AND MAINTENANCE DATA:

1. Operation Data:

- a. Prior to final project closeout and completion, contractor shall be required to submit operation data to the design team to turn over to the owner. At a minimum, the operations data shall include manufacturer's installation and operating instructions.
- 2. Maintenance Data:
 - a. Prior to final project closeout and completion, contractor shall be required to submit maintenance data to the design team to turn over to the owner. At a minimum, the maintenance data shall include servicing requirements, inspection data, preventative maintenance schedule, exploded assembly views, replacement part numbers and availability, location and contact numbers of service depot.

1.7 DELIVERY, STORAGE and HANDLING

- A. Equipment and components shall arrive onsite properly protected and undamaged with containers, packaging and labels intact.
- B. Store, handle and protect materials and equipment in accordance with Manufacturer's recommendations.
- C. Provide additional protection during handling as necessary to prevent breaking scraping, marring, or otherwise damaging products or surrounding areas.
- D. Protect all equipment and components that are to be installed within this project from theft, vandalism, and exposure to rain, freezing temperatures and direct sunlight.
- E. Protect installed equipment and components from damage and prevent use by unauthorized persons.

1.8 EXTRA MATERIALS

- A. Spare Parts:
 - 1. During the warranty period the Contractor will maintain a spare parts inventory to resolve any critical component failure the day of the incident. Critical components shall be:
 - a. Security Cameras
 - b. Power Distribution Unit Components (any and all components)

1.9 WARRANTY AND SERVICE

- A. Warranty:
 - 1. The Contractor shall warrantee the completed work for a period of one year, from the date of commissioning, to be free of defect in design, workmanship or material.
- B. Warranty Service:
 - 1. In the event that defects in the materials and/or workmanship are identified during the warranty period, the contractor shall provide all labor and materials to correct the deficiency.
 - 2. All service work shall be performed by manufacturer certified technicians.
 - 3. All warranty service shall include the replacement of all parts and or components as required to restore normal system operation. If parts or components need to be repaired, then a loaner will be supplied and installed until the part or component can be repaired and reinstalled.
 - 4. Immediately following a warranty service request, the Contractor shall provide written documentation to the owner which details the service work completed, cause of trouble and any outstanding work required to restore a complete and normal system.
- C. Repair or Replacement Service:

1. Service shall be completed within 48 hours from site arrival. If the failure exceeds 48 hours, the Owner reserves the right to require the Contractor to provide onsite manufacturer support at no additional cost to the Owner.

PART 2 - PRODUCTS

2.1 GENERAL

- A. All materials shall meet or exceed all applicable referenced standards, federal, state and local requirements, and conform to codes and ordinances of Authorities Having Jurisdiction.
- B. All new equipment shall be integrated into the existing Clark Pleasant Community School Corporation Hanwha Vision WAVE system.
- C. Each video security camera location shall require ceiling, wall or post mounting. Contractor shall include all ceiling or wall mounting hardware as needed for a complete and functional camera location. Where camera locations would result in cabling distances exceeding the maximum allowable distance for ethernet connectivity, contractor shall provide fiber optic cabling and associated converters as needed to transmit video, and required power supplies and power wiring to camera locations.
- D. Power for cameras shall be provided by owner furnished owner installed network switches. Where camera power requirements exceed the PoE budget of the switches, contractor shall provide PoE injectors to supply sufficient power. In the event that an exterior camera model features an integrated heater/blower which cannot be powered via industry standard PoE, contractor shall provide power supplies and wire as needed.

2.2 Video Security Storage

1. All new cameras installed as part of this project shall connect to the building LAN and shall communicate with the existing NVR server(s) at the High school. Video shall be recorded to and stored on the existing server. Contractor shall be responsible for calculating storage and bandwidth requirements of all new cameras to be installed as part of this project, and shall confirm current server loads to ensure that existing server(s) have sufficient bandwidth capacity and storage for new cameras. If existing server(s) cannot support all new cameras contractor shall notify the design team.

2.3 Video Security Cameras

- A. Multiple types of Video Security Cameras shall be provided as shown in the contract drawings. All new cameras shall meet or exceed the requirements outlined below:

1. Single sensor dome cameras
 - a. Single sensor cameras shall feature progressive scan CCD or CMOS color image sensor with a minimum resolution of 8 MP.
 - b. Shall have integrated analytics based on AI.
 - c. Capable of dual stream output.
 - d. Capable of H.265 video compression
 - e. Capable of frame rates of 30 frames per second (fps) or greater at full resolution.
 - f. Capable of orientation in hallway view mode.
 - g. Capable of horizontal field-of-view greater than 90°.
 - h. Acceptable Manufacturers:

1) Hanwha Techwin XNV-A9084R

2. Single sensor bullet cameras
 - a. Single sensor cameras shall feature progressive scan CCD or CMOS color image sensor with a minimum resolution of 2.1 MP.
 - b. Shall have integrated analytics based on AI.

- c. Shall be minimum IP67 rated.
- d. Capable of dual stream output.
- e. Capable of H.265 video compression
- f. Capable of frame rates of 30 frames per second (fps) or greater at full resolution.
- g. Capable of orientation in hallway view mode.
- h. Capable of horizontal field-of-view greater than 90°.
- i. Acceptable Manufacturers:

1) Hanwha Techwin XNO-A9084R

3. Dual sensor cameras

- a. Each sensor shall be progressive scan CCD or CMOS color image sensor with a minimum resolution of 6 MP.
- b. Shall have integrated analytics based on AI.
- c. Capable of dual stream output per sensor.
- d. Capable of H.265 video compression
- e. Capable of frame rates of 30 frames per second (fps) or greater at full resolution per sensor.
- f. Capable of orientation in hallway view mode for both lenses.
- g. Each lens shall be independently positionable.
- h. Capable of lens orientation that allows a seamless image with no blind spot between the fields-of-view of the two lenses.
- i. Acceptable Manufacturers:

1) Hanwha Techwin PNM-C12083RVD

4. Three sensor cameras

- a. Each sensor shall be progressive scan CCD or CMOS color image sensor with a minimum resolution of 8 MP.
- b. Shall have integrated analytics based on AI.
- c. Capable of dual stream output per sensor.
- d. Capable of H.265 video compression
- e. Capable of frame rates of 30 frames per second (fps) or greater at full resolution per sensor.
- f. Capable of orientation in hallway view mode for all lenses.
- g. Each lens shall be independently positionable.
- h. Capable of lens orientation that allows a seamless image with no blind spot between the fields-of-view of any two adjacent lenses.
- i. Acceptable Manufacturers:

1) Hanwha Techwin PNM-C32083RVQ

5. Four sensor cameras

- a. Each sensor shall be progressive scan CCD or CMOS color image sensor with a minimum resolution of 8 MP.
- b. Shall have integrated analytics based on AI.
- c. Capable of dual stream output per sensor.
- d. Capable of H.265 video compression
- e. Capable of frame rates of 30 frames per second (fps) or greater at full resolution per sensor.
- f. Capable of orientation in hallway view mode for all lenses.
- g. Each lens shall be independently positionable.
- h. Capable of lens orientation that allows a seamless image with no blind spot between the fields-of-view of any two adjacent lenses.
- i. Acceptable Manufacturers:

1) Hanwha Techwin PNM-C32083RVQ

6. Hemispheric (Fisheye) lens camera
 - a. Hemispheric lens cameras shall contain a single sensor with a 360° panoramic fixed lens.
 - b. Sensor shall be progressive scan CCD or CMOS color image sensor with a minimum resolution of 12 MP.
 - c. Shall have integrated analytics based on AI.
 - d. Capable of dual stream output
 - e. Capable of H.265 video compression
 - f. Minimum field-of-view angle of 180°
 - g. Compatible with dewarping functionality of VMS
 - h. Compatible with digital PTZ functionality of VMS
 - i. Acceptable Manufacturers:
 - 1) Hanwha Techwin XNF-9013RV
7. Pan-Tilt-Zoom (PTZ) lens camera
 - a. Sensor shall be capable of a pan range of 360° and a tilt range of 90° to -20°.
 - b. Sensor shall be progressive scan CCD or CMOS color image sensor with a minimum resolution of 8 MP and 31x zoom.
 - c. Shall have integrated analytics based on AI.
 - d. Capable of dual stream output
 - e. Capable of H.265 video compression
 - f. Acceptable Manufacturers:
 - 1) Hanwha Techwin XNP-C9310R
8. Four sensor camera with integrated Pan-Tilt-Zoom (PTZ) camera
 - a. Each sensor shall be progressive scan CCD or CMOS color image sensor with a minimum resolution of 8 MP.
 - b. PTZ sensor shall be capable of a pan range of 360° and a tilt range of 90° to -20° with a minimum resolution of 2 MP and 40x zoom.
 - c. Shall have integrated analytics based on AI.
 - d. Capable of dual stream output per sensor.
 - e. Capable of H.265 video compression
 - f. Capable of frame rates of 30 frames per second (fps) or greater at full resolution per sensor.
 - g. Capable of orientation in hallway view mode for all lenses.
 - h. Each lens shall be independently positionable.
 - i. Capable of lens orientation that allows a seamless image with no blind spot between the fields-of-view of any two adjacent lenses.
 - j. Acceptable Manufacturers:
 - 1) Hanwha Techwin PNM-C34404RQPZ
9. Exterior cameras
 - a. In addition to meeting the requirements listed above for various camera types, all exterior cameras shall meet the following requirements:
 - 1) Camera shall be rated for outdoor use
 - 2) Minimum IP66 compliant
 - 3) Vandal resistant
 - 4) Minimum operating temperature range of -4°F to 122°F
 - b. Acceptable Manufacturers:
 - 1) Hanwha Techwin

10. Contractor shall provide a memory card with each camera included in the project. Memory card shall meet the following requirements:
 - a. Format shall be as dictated by camera compatibility
 - b. Capacity shall be a minimum of 64GB

B. Exterior Camera Power Supply (If needed)

1. Contractor shall provide a Video security camera power supply for all exterior camera locations if required by the installed exterior camera model.
2. Power supplies shall be installed within the telecom rooms in the building.
3. Specifications:
 - a. 12 or 24V AC output to match exterior video security camera requirements.
 - b. Minimum of 8 individual outputs.
 - c. Each output shall be fused separately.
 - d. Include rack mount kit and fully connect to UPS within rack.
4. Acceptable Manufacturers:
 - a. Altronix
 - b. LifeSafety Power
 - c. Or approved equal

2.4 WIRE AND CABLE

- A. All wire and cable shall be Underwriter's Laboratories (UL) approved for its intended application, shall meet all national, state and local code requirements for its application, and shall meet or exceed manufacturers' recommendations for the components connected.
- B. All wire and cable shall meet individual system or subsystem manufacturer specifications.
- C. Wire and cable shall comply with the applicable requirements of the National Electrical Code (NEC), latest edition, in regards to cable construction and usage.
- D. Insulation shall be rated for a minimum of 300 volts.
- E. Provide exterior camera power wiring from each Telecom room location to the exterior camera locations if power supplies are used.
- F. UTP cabling shall be provided and installed by the division 27 contractor.

PART 3 - EXECUTION

3.1 GENERAL

- A. Installation shall meet or exceed all applicable federal, state and local requirements, referenced standards and conform to codes and ordinances of Authorities Having Jurisdiction.
- B. All installation shall be in accordance with manufacturers' specifications and published recommendations.
- C. Run wire with conduit, exposed above accessible ceilings, below accessible floors, cable trays and in riser rooms.
- D. Utilize low voltage corridor cable distribution system whenever possible.
- E. All cabling shall be installed per Owner's requirements.
- F. All cabling utilized shall be plenum rated.
- G. Provide code compliant fire proofing techniques for all penetrations of fire rated partitions and slabs.

- H. Fasten cables throughout cable paths securely to building structure every 5 feet at minimum.
- I. Cable runs shall be continuous from device location to the final point of termination.
- J. Provide grommets and strain relief material where necessary to avoid abrasion of wire and excess tension on wire and cable.
- K. Prepare wire ends for attachment to components in accordance with manufacturer recommendations.
- L. Wire nuts shall not be an acceptable means of connecting wire and cable. All connections shall be made by crimp connection only.

3.2 SYSTEM PROGRAMMING

- A. The Hanwha Vision WAVE video security system shall be fully programmed per the owners requirements including but not limited to local area network configuration, NVR configuration, camera configuration, camera naming, and VMS configuration. Contractor shall coordinate programming and configuration with the appropriate owner personnel.

3.3 SYSTEM ACCEPTANCE


- A. Upon notification of project completion by the Contractor to the Project Manager, a final, on-site review of the system shall be conducted by representatives of the Contractor, Owner, and the Architect. All components and systems must be deemed by all parties to be acceptable prior to final system commissioning.
- B. Contractor shall coordinate with the owner for electronic access control integration requirements. System at a minimum shall be capable of receiving input signals from the access control system to allow video recording to be triggered by an access control event.
- C. The Contractor shall provide two weeks advance notification to the Owner for scheduling of the final system acceptance.
- D. The Contractor shall provide both .pdf and AutoCAD .dwg format electronic versions of shop drawings and record documents. Refer to section 27 05 00 for requirements.
- E. The Contractor shall provide the Project Manager, Field Supervisor and a Support Technician during the final system acceptance process for adequate support during the testing process.
- F. The Contractor shall accompany the Owner's Staff in the field to assist in the functional demonstration of security devices.
- G. Punch list is developed and distributed by Architect and the Owner's Representative.
- H. The Contractor shall produce documentation to demonstrate the punch list has been completed and the installation is at Final Completion.
- I. Once the system has been accepted by the Owner, that date will be noted as the start of the warranty period. The Owner reserves the right to suspend and/or terminate testing at any time when the system fails to perform as specified.

3.4 TRAINING

- A. After final completion, provide instruction to Owner designated personnel.
- B. Provide a minimum of two (2) hours of training to the Owner. Training session(s) shall cover the following topics at a minimum:
 - 1. System Equipment Connectivity
 - 2. Device Configurations
 - 3. All general operation, maintenance, and upgrade procedures.

- C. Training shall be coordinated with Owner personnel to meet their needs.
- D. Training to occur in maximum of two (2) hour increments per personnel or groups of personnel.
- E. Training plan, time line, and agenda shall be provided to Owner and signed off by Owner and Contractor.
- F. Warranty certificate and agreement shall be provided to Owner at initial training session.
- G. Provide a digital video copy of the training sessions.

END OF SECTION 28 23 00

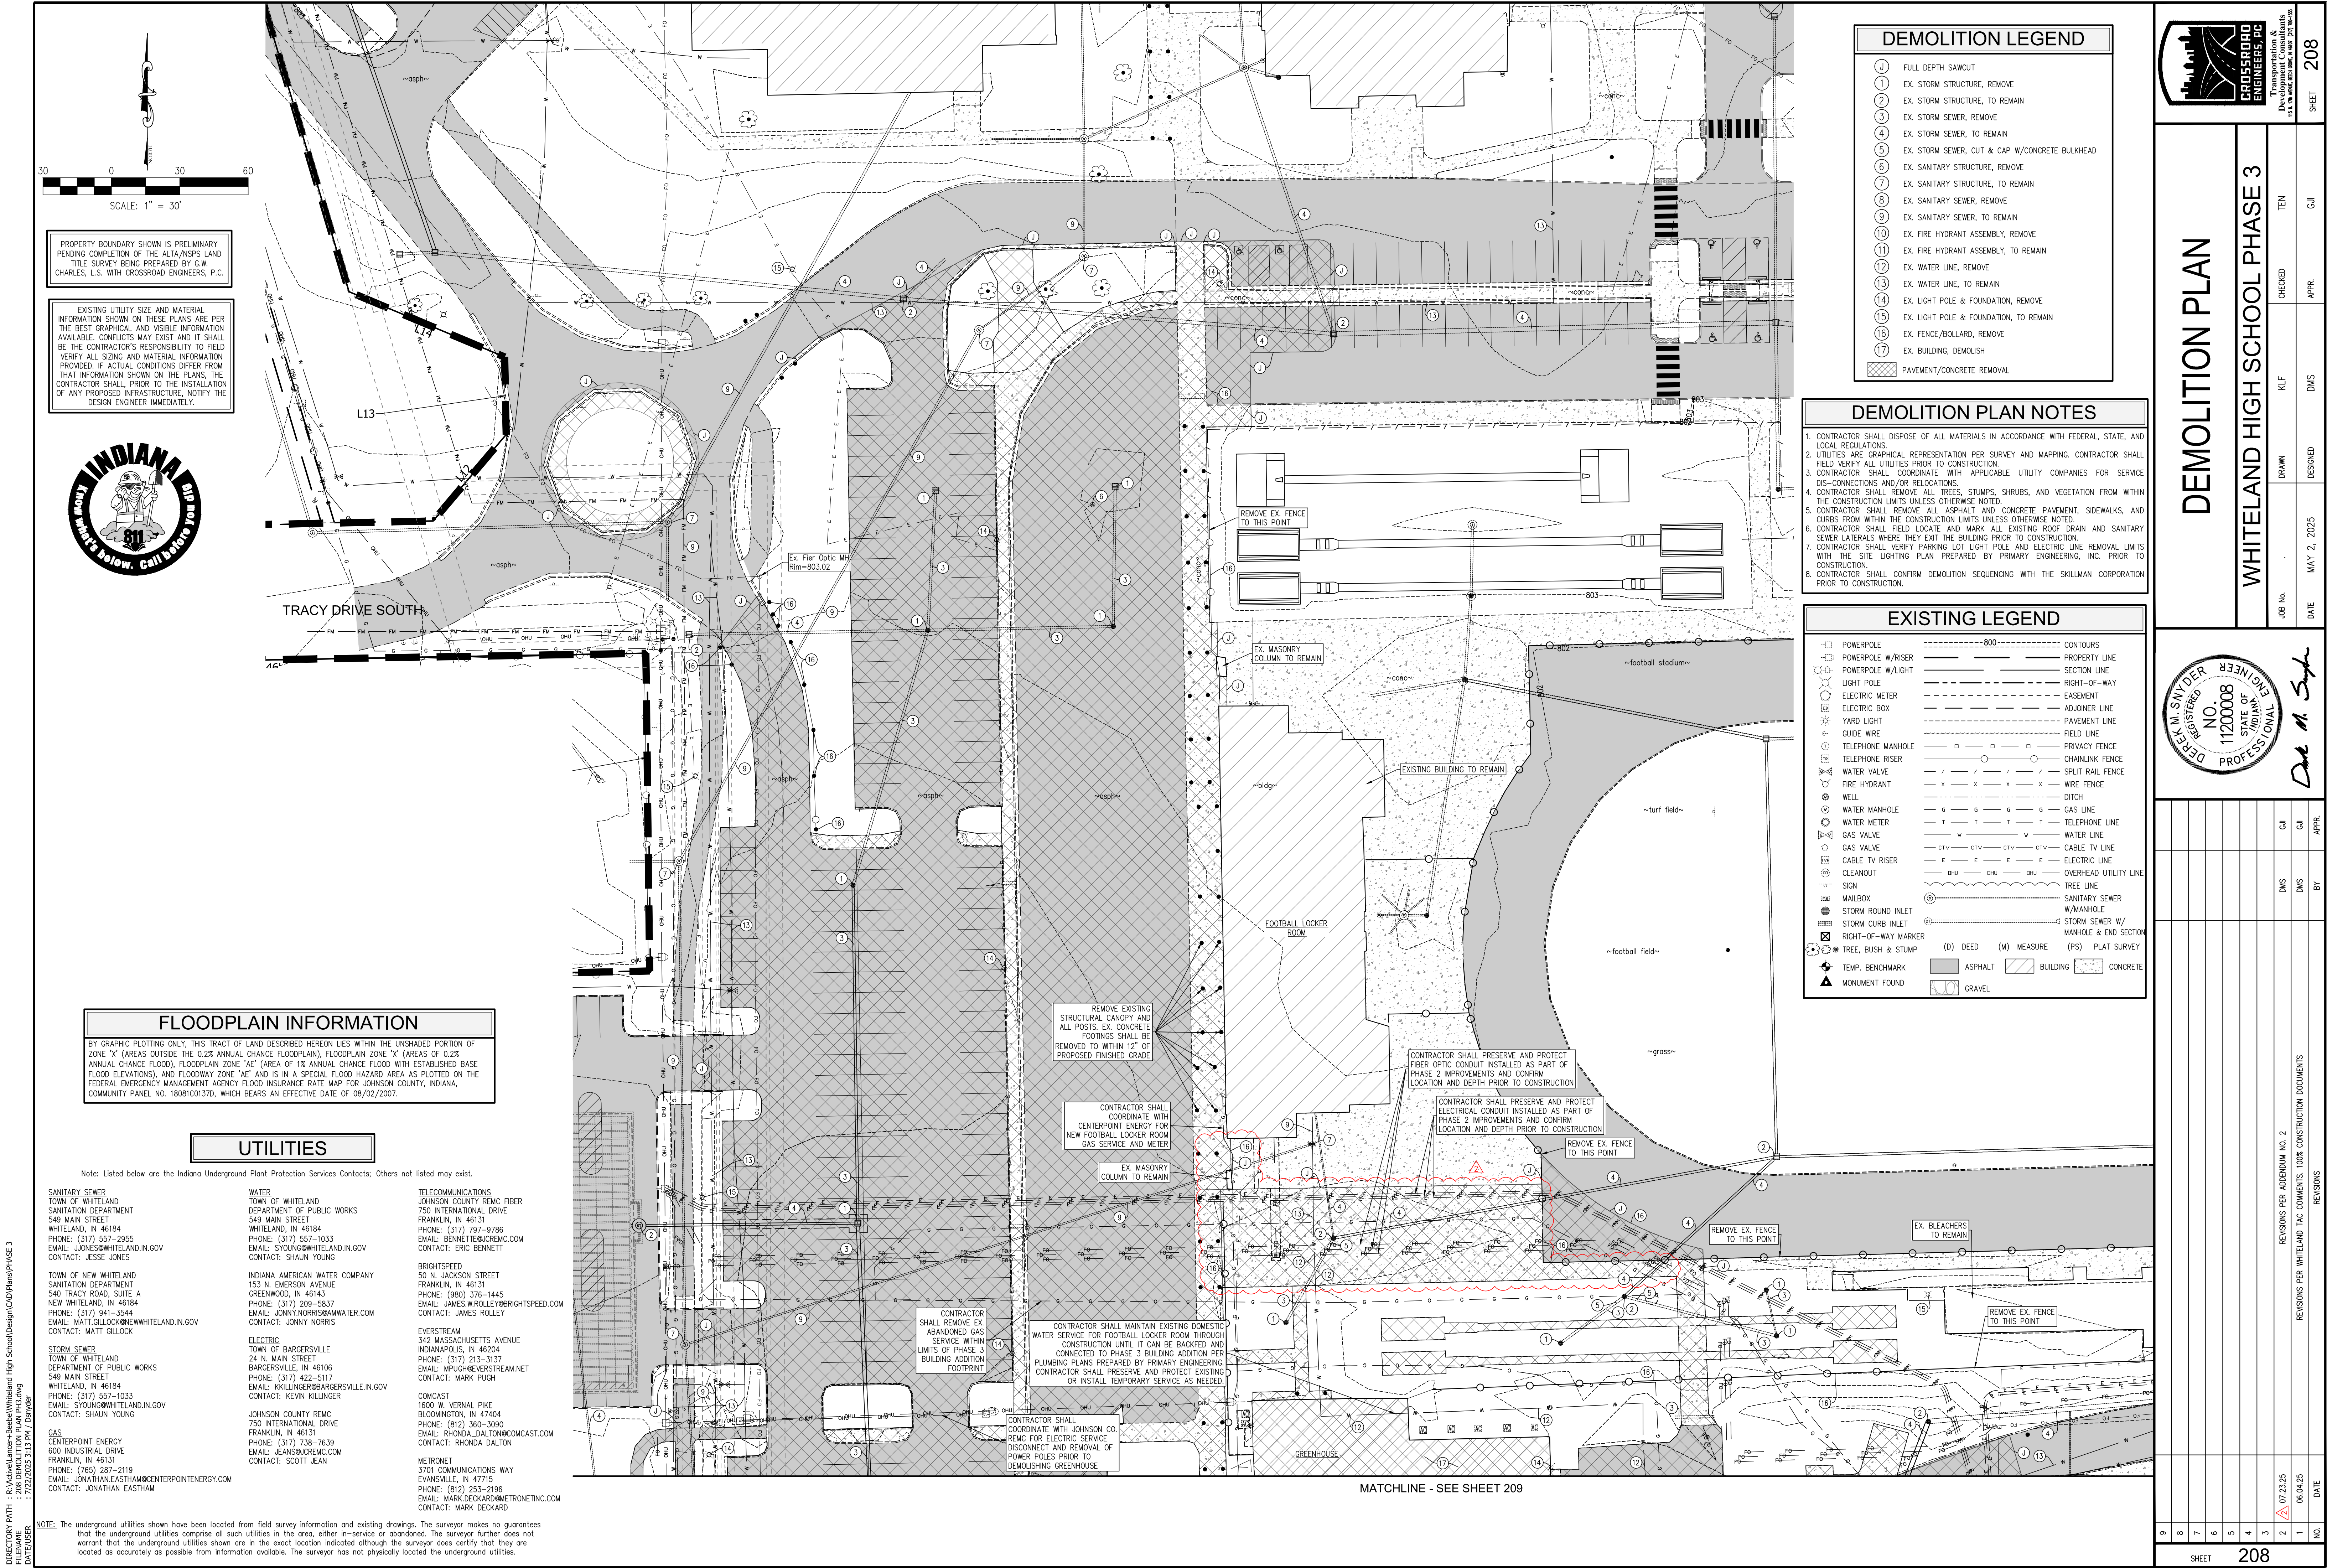

PROPERTY BOUNDARY SHOWN IS PRELIMINARY
PENDING COMPLETION OF THE ALTA/NSPS LAND
TITLE SURVEY BEING PREPARED BY G.W.
CHARLES, L.S. WITH CROSSROAD ENGINEERS, P.C.

EXISTING UTILITY SIZE AND MATERIAL
INFORMATION SHOWN ON THESE PLANS ARE PER
THE BEST GRAPHICAL AND VISIBLE INFORMATION
AVAILABLE. CONFLICTS MAY EXIST AND IT SHALL
BE THE CONTRACTOR'S RESPONSIBILITY TO FIELD
VERIFY ALL SIZING AND MATERIAL INFORMATION
PROVIDED. IF ACTUAL CONDITIONS DIFFER FROM
THAT INFORMATION SHOWN ON THE PLANS, THE
CONTRACTOR SHALL PRIOR TO THE INSTALLATION
OF ANY PROPOSED INFRASTRUCTURE, NOTIFY THE
DESIGN ENGINEER IMMEDIATELY.



FLOODPLAIN INFORMATION
BY GRAPHIC PLOTTING ONLY, THIS TRACT OF LAND DESCRIBED HEREON LIES WITHIN THE UNSHADED PORTION OF
ZONE "X" (AREAS OUTSIDE THE 0.2% ANNUAL CHANCE FLOODPLAIN), FLOODPLAIN ZONE "X" (AREAS OF 0.2%
ANNUAL CHANCE FLOOD), FLOODPLAIN ZONE "AE" (AREA OF 1% ANNUAL CHANCE FLOOD WITH ESTABLISHED BASE
FLOOD ELEVATIONS), AND FLOODWAY ZONE "AE" AND IS IN A SPECIAL FLOOD HAZARD AREA AS PLOTTED ON THE
FEDERAL EMERGENCY MANAGEMENT AGENCY FLOOD INSURANCE RATE MAP FOR JOHNSON COUNTY, INDIANA,
COMMUNITY PANEL NO. 18080101370, WHICH BEARS AN EFFECTIVE DATE OF 08/02/2007.

UTILITIES

Note: Listed below are the Indiana Underground Plant Protection Services Contacts; Others not listed may exist.

SANITARY SEWER
TOWN OF WHITELAND
SANITATION DEPARTMENT
549 MAIN STREET
WHITELAND, IN 46184
PHONE: (317) 557-2955
EMAIL: SYOUNG@WHITELAND.IN.GOV
CONTACT: JESSE JONES

TOWN OF NEW WHITELAND
SANITATION DEPARTMENT
540 TRACY ROAD, SUITE A
NEW WHITELAND, IN 46184
PHONE: (317) 941-3544
EMAIL: MATT.GILLOCK@NEWWHITELAND.IN.GOV
CONTACT: MATT GILLOCK

STORM SEWER
TOWN OF WHITELAND
SANITATION DEPARTMENT
549 MAIN STREET
WHITELAND, IN 46184
PHONE: (317) 557-1033
EMAIL: SYOUNG@WHITELAND.IN.GOV
CONTACT: SHAWN YOUNG

GAS
CENTERPOINT ENERGY
600 INDUSTRIAL DRIVE
FRANKLIN, IN 46131
PHONE: (765) 287-2119
EMAIL: JONATHAN.EASTHAM@CENTERPOINTENERGY.COM
CONTACT: JONATHAN EASTHAM

WATER
TOWN OF WHITELAND
DEPARTMENT OF PUBLIC WORKS
549 MAIN STREET
WHITELAND, IN 46184
PHONE: (317) 557-1033
EMAIL: SYOUNG@WHITELAND.IN.GOV
CONTACT: SHAWN YOUNG

INDIANA AMERICAN WATER COMPANY
153 N. EMERSON AVENUE
GREENWOOD, IN 46143
PHONE: (317) 209-5837
EMAIL: JONNY.NORRIS@AMERICANWATER.COM
CONTACT: JONNY NORRIS

ELECTRIC
TOWN OF BARGERSVILLE
24 N. MAIN STREET
BARGERSVILLE, IN 46106
PHONE: (317) 422-5117
EMAIL: KILLINGER@BARGERSVILLE.IN.GOV
CONTACT: KEVIN KILLINGER

JOHNSON COUNTY REMC
750 INTERNATIONAL DRIVE
FRANKLIN, IN 46131
PHONE: (317) 738-7639
EMAIL: JEANIS@CREMC.COM
CONTACT: SCOTT JEAN

TELECOMMUNICATIONS
JOHNSON COUNTY REMC FIBER
750 INTERNATIONAL DRIVE
FRANKLIN, IN 46131
PHONE: (317) 797-9786
EMAIL: JENNETTE@CREMC.COM
CONTACT: ERIC JENNETT

BRIGHTSPEED
50 N. JACKSON STREET
FRANKLIN, IN 46131
PHONE: (800) 376-1445
EMAIL: JAMES.W.ROLLEY@BRIGHTSPEED.COM
CONTACT: JAMES ROLLEY

EVERSTREAM
342 MASSACHUSETTS AVENUE
INDIANAPOLIS, IN 46204
PHONE: (317) 213-3137
EMAIL: MPUGH@EVERSTREAM.NET
CONTACT: MARK PUGH

COMCAST
1600 W. VERNAL PIKE
BLOOMINGTON, IN 47404
PHONE: (812) 360-3090
EMAIL: RHONDA.DALTON@COMCAST.COM
CONTACT: RHONDA DALTON

METRONET
3701 COMMUNICATIONS WAY
EVANSVILLE, IN 47715
PHONE: (812) 253-2196
EMAIL: MARK.DECKARD@METRONETINC.COM
CONTACT: MARK DECKARD

DEMOLITION LEGEND

- 1 FULL DEPTH SAWCUT
- 2 EX. STORM STRUCTURE, REMOVE
- 3 EX. STORM STRUCTURE, TO REMAIN
- 4 EX. STORM SEWER, REMOVE
- 5 EX. STORM SEWER, TO REMAIN
- 6 EX. STORM SEWER, CUT & CAP W/CONCRETE BULKHEAD
- 7 EX. SANITARY STRUCTURE, REMOVE
- 8 EX. SANITARY STRUCTURE, TO REMAIN
- 9 EX. SANITARY SEWER, REMOVE
- 10 EX. SANITARY SEWER, TO REMAIN
- 11 EX. FIRE HYDRANT ASSEMBLY, REMOVE
- 12 EX. FIRE HYDRANT ASSEMBLY, TO REMAIN
- 13 EX. WATER LINE, REMOVE
- 14 EX. WATER LINE, TO REMAIN
- 15 EX. LIGHT POLE & FOUNDATION, REMOVE
- 16 EX. LIGHT POLE & FOUNDATION, TO REMAIN
- 17 EX. FENCE/BOLLARD, REMOVE
- 18 EX. BUILDING, DEMOLISH
- 19 PAVEMENT/CONCRETE REMOVAL

DEMOLITION PLAN NOTES

- CONTRACTOR SHALL DISPOSE OF ALL MATERIALS IN ACCORDANCE WITH FEDERAL, STATE, AND LOCAL REGULATIONS.
- UTILITIES ARE GRAPHICAL REPRESENTATION PER SURVEY AND MAPPING. CONTRACTOR SHALL FIELD VERIFY ALL UTILITIES PRIOR TO CONSTRUCTION.
- CONTRACTOR SHALL COORDINATE WITH APPLICABLE UTILITY COMPANIES FOR SERVICE DIS-CONNECTIONS AND/OR RELOCATIONS.
- CONTRACTOR SHALL REMOVE ALL TREES, STUMPS, SHRUBS, AND VEGETATION FROM WITHIN THE CONSTRUCTION LIMITS UNLESS OTHERWISE NOTED.
- CONTRACTOR SHALL REMOVE ALL ASPHALT AND CONCRETE PAVEMENT, SIDEWALKS, AND CURBS WITHIN THE CONSTRUCTION LIMITS UNLESS OTHERWISE NOTED.
- CONTRACTOR SHALL FIELD LOCATE AND MARK ALL EXISTING ROOF DRAIN AND SANITARY SEWER LATERALS WHERE THEY EXIT THE BUILDING PRIOR TO CONSTRUCTION.
- CONTRACTOR SHALL VERIFY PARKING LOT LIGHT POLE AND ELECTRIC LINE REMOVAL LIMITS WITH THE SITE LIGHTING PLAN PREPARED BY PRIMARY ENGINEERING, INC. PRIOR TO CONSTRUCTION.
- CONTRACTOR SHALL CONFIRM DEMOLITION SEQUENCING WITH THE SKILLMAN CORPORATION PRIOR TO CONSTRUCTION.

EXISTING LEGEND

- POWERPOLE W/ RISER
 - POWERPOLE W/ LIGHT
 - LIGHT POLE
 - ELECTRIC METER
 - ELECTRIC BOX
 - YARD LIGHT
 - GUIDE WIRE
 - TELEPHONE MANHOLE
 - TELEPHONE RISER
 - WATER VALVE
 - FIRE HYDRANT
 - WELL
 - WATER MANHOLE
 - WATER METER
 - GAS VALVE
 - GAS VALVE
 - CABLE TV RISER
 - CLEANOUT
 - SIGN
 - MAILBOX
 - STORM ROUND INLET
 - STORM CURB INLET
 - RIGHT-OF-WAY MARKER
 - TREE, BUSH & STUMP
 - TEMP. BENCHMARK
 - MONUMENT FOUND
- CONTOURS
PROPERTY LINE
SECTION LINE
RIGHT-OF-WAY
EASEMENT
ADJOINER LINE
PAVEMENT LINE
FIELD LINE
PRIVACY FENCE
CHAINLINK FENCE
SPLIT RAIL FENCE
WIRE FENCE
DITCH
GAS LINE
TELEPHONE LINE
WATER LINE
CABLE TV LINE
ELECTRIC LINE
OVERHEAD UTILITY LINE
TREE LINE
SANITARY SEWER
W/ MANHOLE
STORM SEWER W/ MANHOLE & END SECTION
- (D) DEED (M) MEASURE (PS) PLAT SURVEY
- ASPHALT BUILDING CONCRETE GRAVEL

CROSSROAD ENGINEERS, P.C.
INDIANAPOLIS, IN 46106
PHONE: (317) 557-2955
EMAIL: SYOUNG@WHITELAND.IN.GOV

DEMOLITION PLAN

WHITELAND HIGH SCHOOL PHASE 3

DESIGNED: DJM
CHECKED: TEN
APPROVED: GJ


DATE: MAY 2, 2025

NO. 1120008
REGISTERED PROFESSIONAL ENGINEER
STATE OF INDIANA
DEREK M. SWYDER

REVISIONS PER ADDENDUM NO. 2

NO.	DATE	REVISIONS
1	07.23.25	REVISIONS PER WHITELAND TAC COMMENTS: 100% CONSTRUCTION DOCUMENTS
2	08.04.25	
3		
4		
5		
6		
7		
8		
9		

SHEET 208

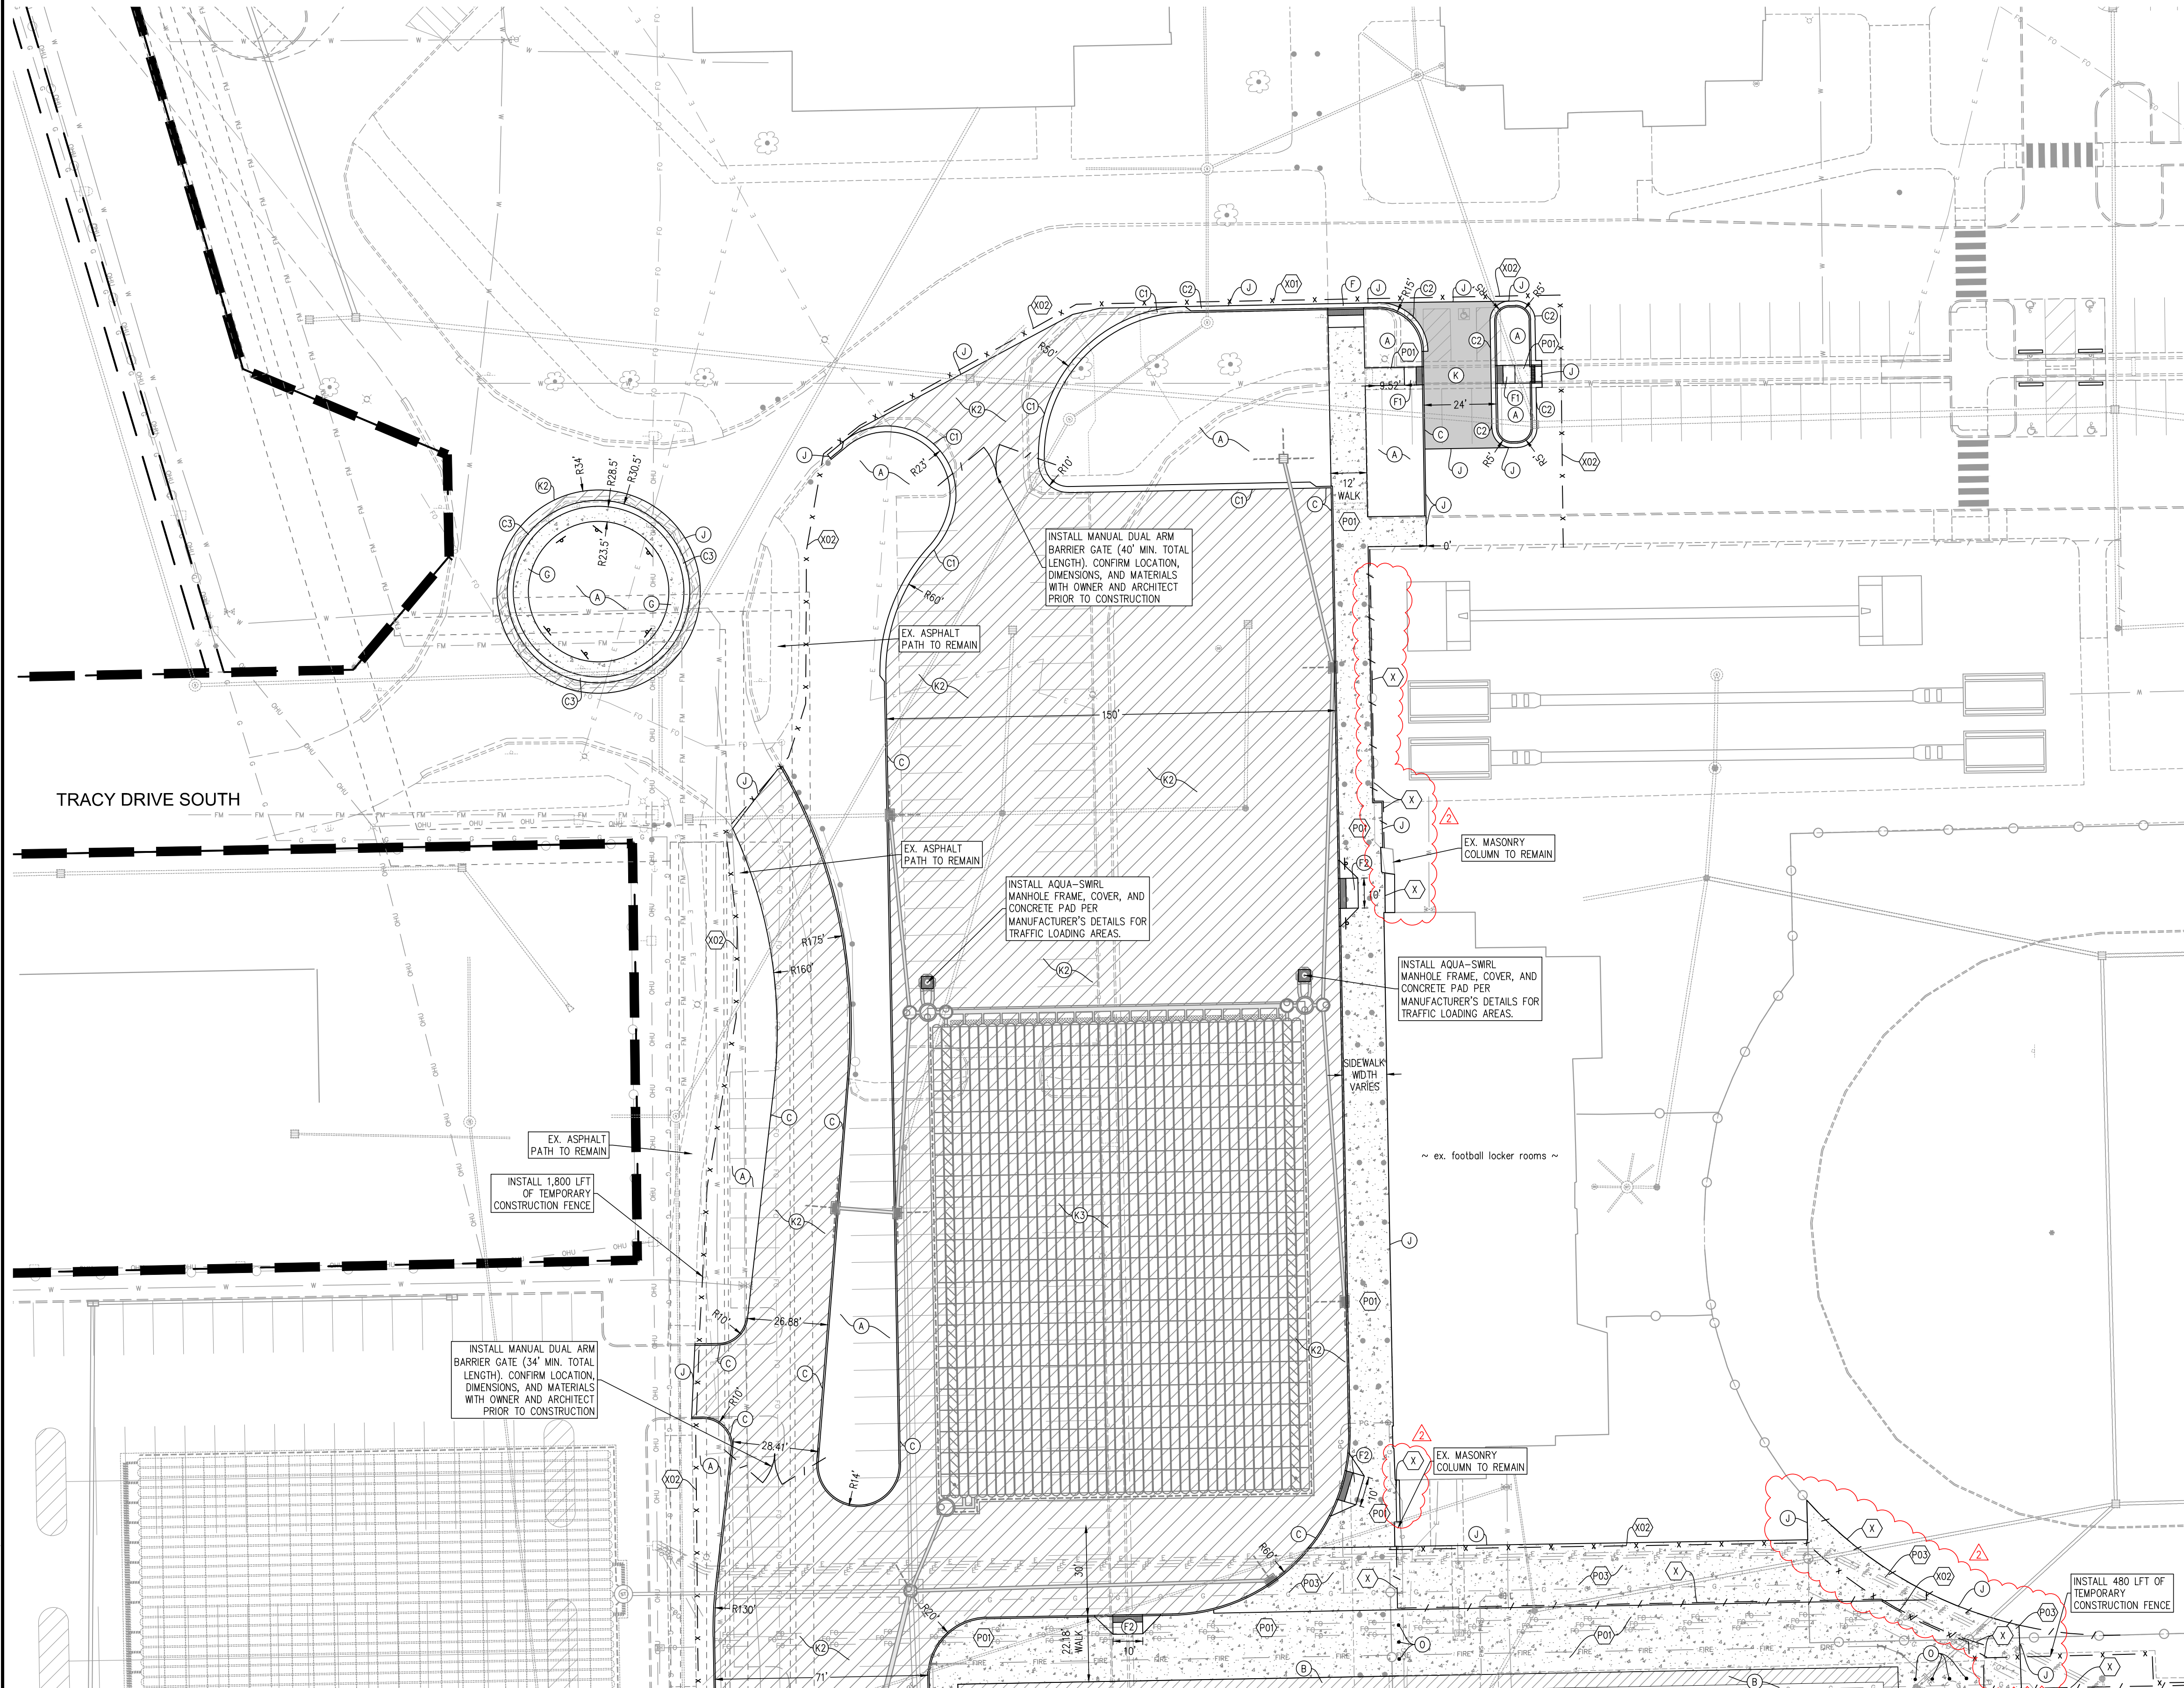

MATCHLINE - SEE SHEET 301

NOTE:
NO EARTHWORK DISTURBING ACTIVITY
MAY COMMENCE UNTIL A STORM WATER
MANAGEMENT PERMIT IS OBTAINED.



SITE DIMENSION LEGEND

- (A) LANDSCAPE AREAS (SEE CONTEXT PLANS)
- (B) STRUCTURE FOUNDATION - PER BUILDING PLANS
- (C) STRAIGHT CONCRETE CURB (SEE DETAIL-SHEET 900)
- (C1) SLOPED CONCRETE CURB (SEE DETAIL-SHEET 900)
- (C2) CONCRETE CURB AND GUTTER (SEE DETAIL-SHEET 900)
- (C3) CONCRETE ROLL CURB (SEE DETAIL-SHEET 900)
- (F0) CONCRETE, TYPE 01 (SEE CONTEXT PLANS)
- (F0.3) CONCRETE, HEAVY DUTY, 6" WITH REBAR (SEE CONTEXT PLANS)
- (F1) (F4) A.D.A. CURB RAMP (SEE DETAIL-SHEET 900)
- (G) TYPICAL CONCRETE TRUCK APRON SECTION
9" CONCRETE PAVEMENT WITH D-1
CONTRACTION JOINTS @ 13' MAX. SPACING, ON
6" COMPACTED AGGREGATE #53, ON
COMPACTED SUBGRADE (SEE DETAIL-SHEET 900)
- (H) DUMPSTER ENCLOSURE (SEE LANCER PLANS)
- (J) SAWCUT
- (K) TYPICAL LIGHT DUTY ASPHALT SECTION
1.5" HMA SURFACE 9.5mm, ON
3" HMA INTERMEDIATE 19.0mm, ON
6" COMPACTED AGGREGATE #53, ON
COMPACTED SUBGRADE (SEE DETAIL-SHEET 900)
- (K1) TYPICAL LIGHT DUTY ASPHALT SECTION OVER
DETENTION SECTION
1.5" HMA SURFACE 9.5mm, ON
3" HMA INTERMEDIATE 19.0mm, ON
VARIABLE DEPTH COMPACTED AGGREGATE #53, ON
GEOTEXTILE FABRIC OVER UNDERGROUND DETENTION
(SEE DETAIL-SHEET 900)
- (K2) TYPICAL HEAVY DUTY ASPHALT SECTION
1.5" HMA SURFACE 9.5mm, ON
4" HMA INTERMEDIATE 19.0mm, ON
8" COMPACTED AGGREGATE #53, ON
COMPACTED SUBGRADE (SEE DETAIL-SHEET 900)
- (K3) TYPICAL HEAVY DUTY ASPHALT SECTION OVER
DETENTION SECTION
1.5" HMA SURFACE 9.5mm, ON
4" HMA INTERMEDIATE 19.0mm, ON
VARIABLE DEPTH COMPACTED AGGREGATE #53, ON
GEOTEXTILE FABRIC OVER UNDERGROUND DETENTION
(SEE DETAIL-SHEET 900)
- (L) CONCRETE WHEEL STOP (SEE DETAIL-SHEET 900)
- (O) BOLLARD (SEE CONTEXT PLANS)
- (P) TYPICAL ASPHALT PATH SECTION
1" HMA SURFACE 9.5mm, ON
2" HMA INTERMEDIATE 19.0mm, ON
6" COMPACTED AGGREGATE #53, ON
COMPACTED SUBGRADE (SEE DETAIL - SHEET 900)
- (R) TYPICAL ASPHALT WEDGE & LEVEL SECTION
1.5" HMA SURFACE 9.5mm, ON
EXISTING ASPHALT MILLED 1" (SEE DETAIL-SHEET 900)
- (T) CONCRETE CURB TURNOUT (SEE DETAIL-SHEET 900)
- (W) RETAINING/SEAT WALL (SEE CONTEXT PLANS)
- (X) PERMANENT FENCING (SEE CONTEXT PLANS)
- (X0) PERMANENT CONSTRUCTION FENCE WITH
SCREENING ON DRIVEN POSTS
- (X02) TEMPORARY CONSTRUCTION FENCE ON
STANDS WITH SAND BAGS

PROPOSED LEGEND

- PROPERTY LINE
- SECTION LINE
- SETBACK LINE
- FENCE LINE
- DITCH LINE
- (S) SANITARY SEWER WITH CLEANOUT
- (S) SANITARY SEWER LATERAL WITH CLEANOUT
- (S) STORM SEWER W/MANHOLE & END SECTION
- (PG) WATER LINE
- (PG) WATER SERVICE LINE
- (PG) GAS LINE
- STORM MANHOLES
- STORM INLETS
- AQUA-SWIRL UNITS
- SIGN
- PERMANENT CONSTRUCTION FENCE WITH SCREENING ON DRIVEN POSTS
- TEMPORARY CONSTRUCTION FENCE ON STANDS WITH SAND BAGS

SITE DIMENSION NOTES

- ALL NEW SIGNAGE AND PARKING LOT LIGHTS SHALL MATCH WHITELAND COMMUNITY HIGH SCHOOLS' EXISTING SIGNAGE AND LIGHTING. CONTRACTOR SHALL COORDINATE WITH OWNER, LANDSCAPE ARCHITECT (CONTEXT DESIGN), AND MEP DESIGNER FOR LIGHT STYLES AND LAYOUT.
- CONTRACTOR SHALL NOTIFY ENGINEER, IF PROOF ROLL OF SUBGRADE FAILS, TO DETERMINE IF LIME STABILIZATION OF SUBGRADE IS NECESSARY.
- ALL RADI DIMENSIONS ARE TO THE FACE OF PROPOSED CURB.
- SIGNAGE SHALL INCLUDE ALL NECESSARY HARDWARE AND FITTINGS, INCLUDING 10 FT. OF 11 GAUGE FLANGED CHANNEL SIGN POST. REFER TO LANDSCAPE AND ARCHITECTURAL PLANS FOR ADDITIONAL SIGNAGE. VERIFY CONFLICTS WITH OWNER, ARCHITECT, AND LANDSCAPE ARCHITECT.
- CONTRACTOR SHALL BE RESPONSIBLE FOR MAINTAINING TRAFFIC AND PROVIDING ALL NECESSARY FLAGMAN, BARRELS, SIGNAGE, ETC. DURING CONSTRUCTION. ALL APPLICABLE M.U.T.C.D. STANDARDS SHALL GOVERN THIS WORK.
- LANDSCAPING PLAN TO BE PROVIDED BY CONTEXT DESIGN. CONTRACTOR SHALL COORDINATE WITH OWNER AND CONTEXT FOR SPECIFICATIONS.
- EXISTING UTILITY SIZE AND MATERIAL INFORMATION SHOWN ON THESE PLANS ARE PER THE BEST GRAPHICAL AND VISIBLE INFORMATION AVAILABLE. CONFLICTS MAY EXIST AND IT SHALL BE THE CONTRACTOR'S RESPONSIBILITY TO FIELD VERIFY ALL SIZING AND MATERIAL INFORMATION PROVIDED. IF ACTUAL CONDITIONS DIFFER FROM THAT INFORMATION SHOWN ON THE PLANS, THE CONTRACTOR SHALL PRIOR TO THE INSTALLATION OF ANY PROPOSED INFRASTRUCTURE, NOTIFY THE DESIGN ENGINEER IMMEDIATELY.
- SEE PAVEMENT MARKING AND SIGN PLAN (SHEETS 302-303) FOR STRIPING.
- CONTRACTOR SHALL REFER TO THE MATERIALS PLAN PREPARED BY CONTEXT DESIGN FOR THE MATERIALS, FINISHES, LAYOUTS, JOINT PATTERNS, DIMENSIONS, DETAILS, AND SECTIONS AT THE PEDESTRIAN ENTRANCE PLAZAS PRIOR TO CONSTRUCTION. REPORT ANY DIMENSIONAL OR LAYOUT DISCREPANCIES BETWEEN CONTEXT PLANS AND SITE DIMENSION PLANS (SHEETS 300-301) TO THE ENGINEER AND ARCHITECT IMMEDIATELY.
- CONTRACTOR SHALL CONFIRM CONSTRUCTION FENCE TYPE (TEMPORARY OR PERMANENT), LAYOUT, MATERIALS, AND GATE LOCATIONS WITH THE SKILLMAN CORPORATION AND OWNER PRIOR TO CONSTRUCTION. CONSTRUCTION FENCE SHALL BE INSTALLED SUCH THAT EXISTING IMPROVEMENTS TO REMAIN IN PLACE ARE NOT DAMAGED BY FENCE INSTALLATION OR REMOVAL.

CROSSROAD ENGINEERS, PC
Professional Engineering Firm
115 E. 17th Street, Suite 400 • Indianapolis, IN 46202-4000
Tel: 317.634.1100 • Fax: 317.634.1101
www.crossroadengineers.com

SITE DIMENSION PLAN

WHITELAND HIGH SCHOOL PHASE 3

JOB NO.	DRAWN	CHECKED	TEN	GJ
DATE	MAY 2, 2025	DESIGNED		


Derek M. Snyder
REGISTERED PROFESSIONAL ENGINEER
NO. 1120008
STATE OF INDIANA

Derek M. Snyder


NO.	DATE	REVISIONS	BY	APPR.
9				
8				
7				
6				
5				
4				
3				
2	07.23.25	REVISIONS PER ADDENDUM NO. 2	DMS	GJ
1	08.04.25	REVISIONS PER WHITELAND TAC COMMENTS: 100% CONSTRUCTION DOCUMENTS	DMS	GJ

SHEET

300

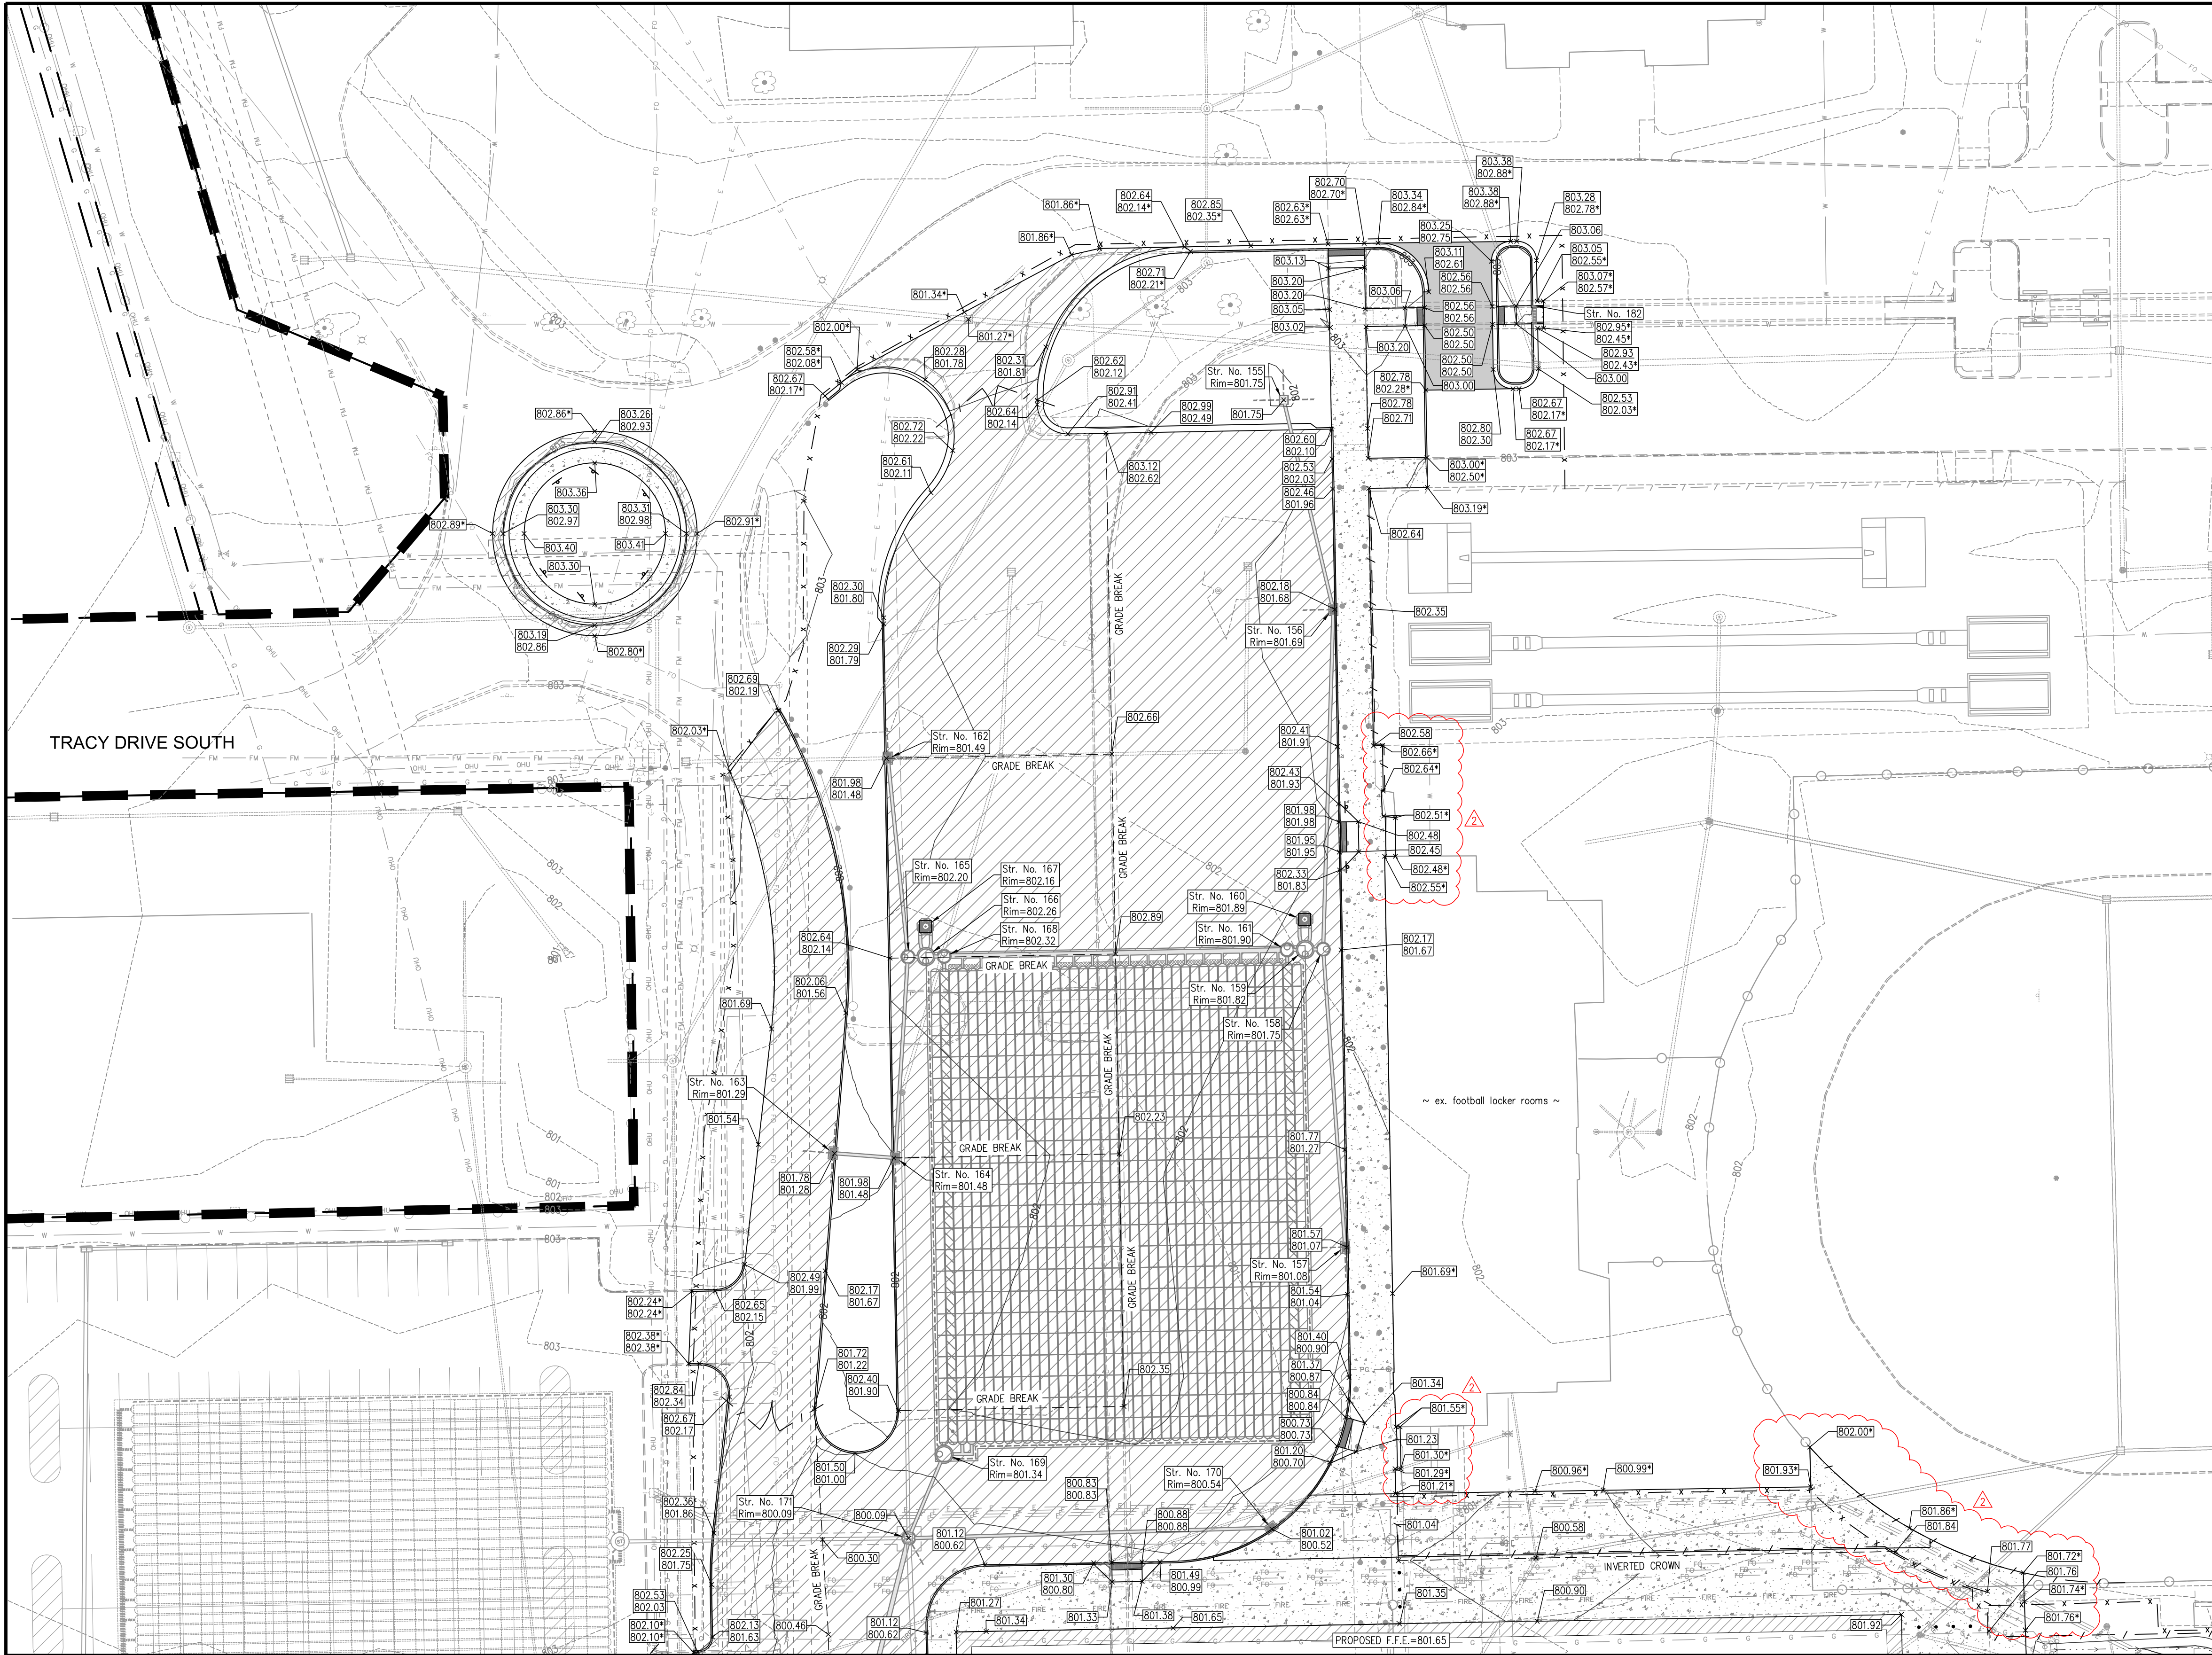

MATCHLINE - SEE SHEET 501

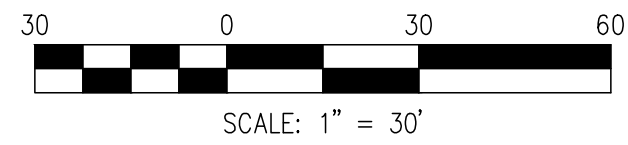

BENCHMARK INFORMATION

ORIGINATING BENCHMARK
DESIGNATION - X 13
PID - KAD010
STATE/COUNTY - IN/MORGAN
USGS QUAD - MOORESVILLE EAST (1980)
VERT ORDER - FIRST CLASS II
DESCRIBED BY COAST AND GEODETIC SURVEY 1946
1/2 MI N FROM WAVERLY
IN JOHNSON COUNTY, 1/2 MILES NORTH ALONG STATE HIGHWAY 37 FROM
THE INTERSECTION OF STATE HIGHWAY 144 AT WAVERLY, MORGAN COUNTY,
125 YARDS NORTH OF THE MORGAN-JOHNSON COUNTY LINE, 26 FEET WEST
OF THE CENTERLINE OF THE HIGHWAY, IN LINE WITH THE WEST
RIGHT-OF-WAY FENCE, 1.5 FEET SOUTH OF A WHITE WOODEN WITNESS
POST, AND ABOUT 2 FEET HIGHER THAN THE HIGHWAY. A STANDARD DISK,
STAMPED 686.370 X 13 1930 AND SET IN THE TOP OF A CONCRETE POST
PROJECTING 7 INCHES ABOVE GROUND.
RECOVERY NOTE BY IN DEPT OF NAT RES 1985
NEW DESC- AT THE INTERSECTION OF NEW STATE ROAD 144 AND OLD STATE
ROAD 37, IN THE SOUTHWEST QUARTER OF THE INTERSECTION, WITNESS POST
IS ONE RIGHT-OF-WAY FENCE IS CORN, ALL OTHER INFORMATION APPEARS TO
BE CORRECT.
ELEVATION = 685.94 (NAVD 88)
TBM #400
RR SPIKE SET IN E FACE OF PP#P21063" LOCATED ±180' N OF "TRACT
NORTH DRIVE" ±40' WEST OF "SAINT CHARLES WAY"
ELEV.=805.77
TBM #401
RR SPIKE SET IN E FACE OF PP#P21042" LOCATED ±6' W OF "TRACY ST."
±40' S OF N PARKING LOT ENTRANCE @ "CLARK PLEASANT EMPLOYEE
HEALTH & WELLNESS CENTER"
ELEV.=805.07
TBM #402
CUT BOX ON TOP OF CONC PIEDestal FOR UP ON N EDGE OF CONC.
LOCATED @ NE MOST CORNER OF PARKING LOT FOR "199 US-31 "BIG
SPASH CAR WASH"
ELEV.=806.18
TBM #403
SE MOST CORNER OF BOTTOM CONC STEP LOCATED @ SE CORNER OF
"STUDIO 31 SALON" "43 N. US-31" ON E FACE OF BUILDING.
ELEV.=801.28
TBM #404
NE CORNER OF TOP CONC STEP CONNECTED TO LEAD WALK @ "239 E MAIN
ST." LOCATED SE QUAD OF "E MAIN ST." & "TICHENOR LN."
ELEV.=799.90
TBM #405
RR SPIKE SET IN E FACE POWERPOLE, LOCATED 45' S OF "E MAIN ST." &
±XX' W OF DRIVE @ "399 E MAIN ST."
ELEV.=790.98
TBM #406
SW CORNER OF CONC PORCH @ "49 CENTER ST."
ELEV.=797.61
TBM #407
RR SPIKE SET IN S FACE OF PP# "P22C73". LOCATED ±5' E OF "CENTER
ST." & ±150' N OF "CLEM ST."
ELEV.=800.07
TBM #408
RR SPIKE SET IN E FACE OF POWER POLE, LOCATED @ SW CORNER OF
PROPERTY OF "329 CHRISTINA DR."
ELEV.=800.89


NOTE:
NO EARTHWORK DISTURBING ACTIVITY
MAY COMMENCE UNTIL A STORM WATER
MANAGEMENT PERMIT IS OBTAINED.

GRADING LEGEND

- | | | |
|----------|--|---------------------------------|
| X 860.00 | TOP OF CURB | PROPOSED ELEVATIONS |
| X 859.50 | EDGE OF PAVEMENT | |
| X 860.00 | FINISH GRADE | |
| X 860.00 | EXISTING ELEVATIONS | EXISTING ELEVATIONS |
| X 860.00 | (TO BE FIELD VERIFIED) | (TO BE FIELD VERIFIED) |
| X 860.00 | PROPOSED FINISH FLOOR ELEVATION | PROPOSED FINISH FLOOR ELEVATION |
| --- | PROPOSED DRAINAGE SWALE | PROPOSED DRAINAGE SWALE |
| --- | EXISTING CONTOURS | EXISTING CONTOURS |
| --- | PROPOSED CONTOURS | PROPOSED CONTOURS |
| --- | GRADE BREAK | GRADE BREAK |
| --- | CURB HEIGHT TO TAPER FROM 0.5' TO 0.0' IN 6 LFT. | |

GRADING NOTES


- CONTRACTOR SHALL PROVIDE POSITIVE DRAINAGE AWAY FROM ALL BUILDINGS IN FINAL GRADING OF SITE. NO INSTANCE SHALL DRAINAGE TOWARDS THE BUILDING FOUNDATION BE ALLOWED.
- CONTRACTOR SHALL FIELD VERIFY EXISTING PAVEMENT, SIDEWALK, AND CURB ELEVATIONS AT ALL TIE IN LOCATIONS PRIOR TO CONSTRUCTION AND REPORT DISCREPANCIES TO THE ENGINEER IMMEDIATELY.
- ALL CURB RAMPS SHALL BE A.D.A. COMPLIANT AND THE LONGITUDINAL AND CROSS SLOPES SHALL NOT EXCEED THE MAXIMUM SLOPES IDENTIFIED ON THE MISCELLANEOUS DETAILS (SEE SHEET 800). CONTRACTOR SHALL NOTIFY ENGINEER IMMEDIATELY IF FIELD CONDITIONS PREVENT CURB RAMPS FROM BEING CONSTRUCTED WITHOUT EXCEEDING MAXIMUM SLOPES. THE FINISHED FLOOR ELEVATION (F.F.E.) SHOWN HEREON CORRESPONDS TO EXISTING FINISHED FLOOR ELEVATIONS OF THE HIGH SCHOOL, AND THE PROPOSED ELEVATIONS OF THE ADDITIONS AT THE EXTERIOR BUILDING ENTRES WHICH ARE LABELED "T/SLAB-0'-0" ON THE FOUNDATION PLANS. CONTRACTOR SHALL CONFIRM THE EXISTING FINISHED FLOOR ELEVATIONS PRIOR TO CONSTRUCTION AND REFER TO THE ARCHITECTURAL AND STRUCTURAL PLANS FOR INTERNAL CHANGES TO THE PROPOSED FINISHED FLOOR ELEVATION, CONCRETE SLAB AND STONE SUBBASE THICKNESS, SLAB SLOPES, RECESSED SLABS, PIT ELEVATIONS, ETC.

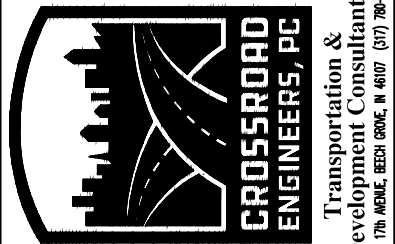

GRADING PLAN

WHITELAND HIGH SCHOOL PHASE 3

JOB NO.	DRAWN	KLF	CHECKED	TEN	APPR.	GJ	SHEET
DATE	MAY 2, 2025	DESIGNED					500

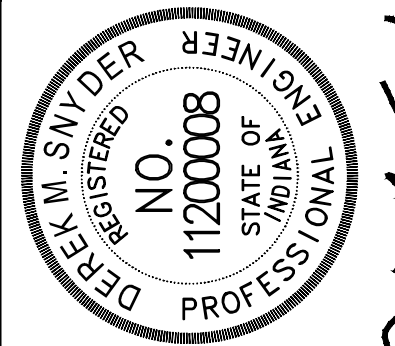


Derek M. Snyder

NO.	DATE	BY	APPR.	REVISIONS
9				
8				
7				
6				
5				
4				
3				
2	07.23.25			REVISIONS PER WHITELAND TAC COMMENTS: 100% CONSTRUCTION DOCUMENTS
1	06.04.25			REVISIONS PER ADDENDUM NO. 2


SHEET 500



DIRECTORY PATH : R:\Active\Unlance+Reade\Whiteland High School\Design\CAD\Plans\PHASE 3
FILE NAME : 230523 PH 3.dwg
DATE/USER : 7/22/2025 3:13 PM / Desnyder

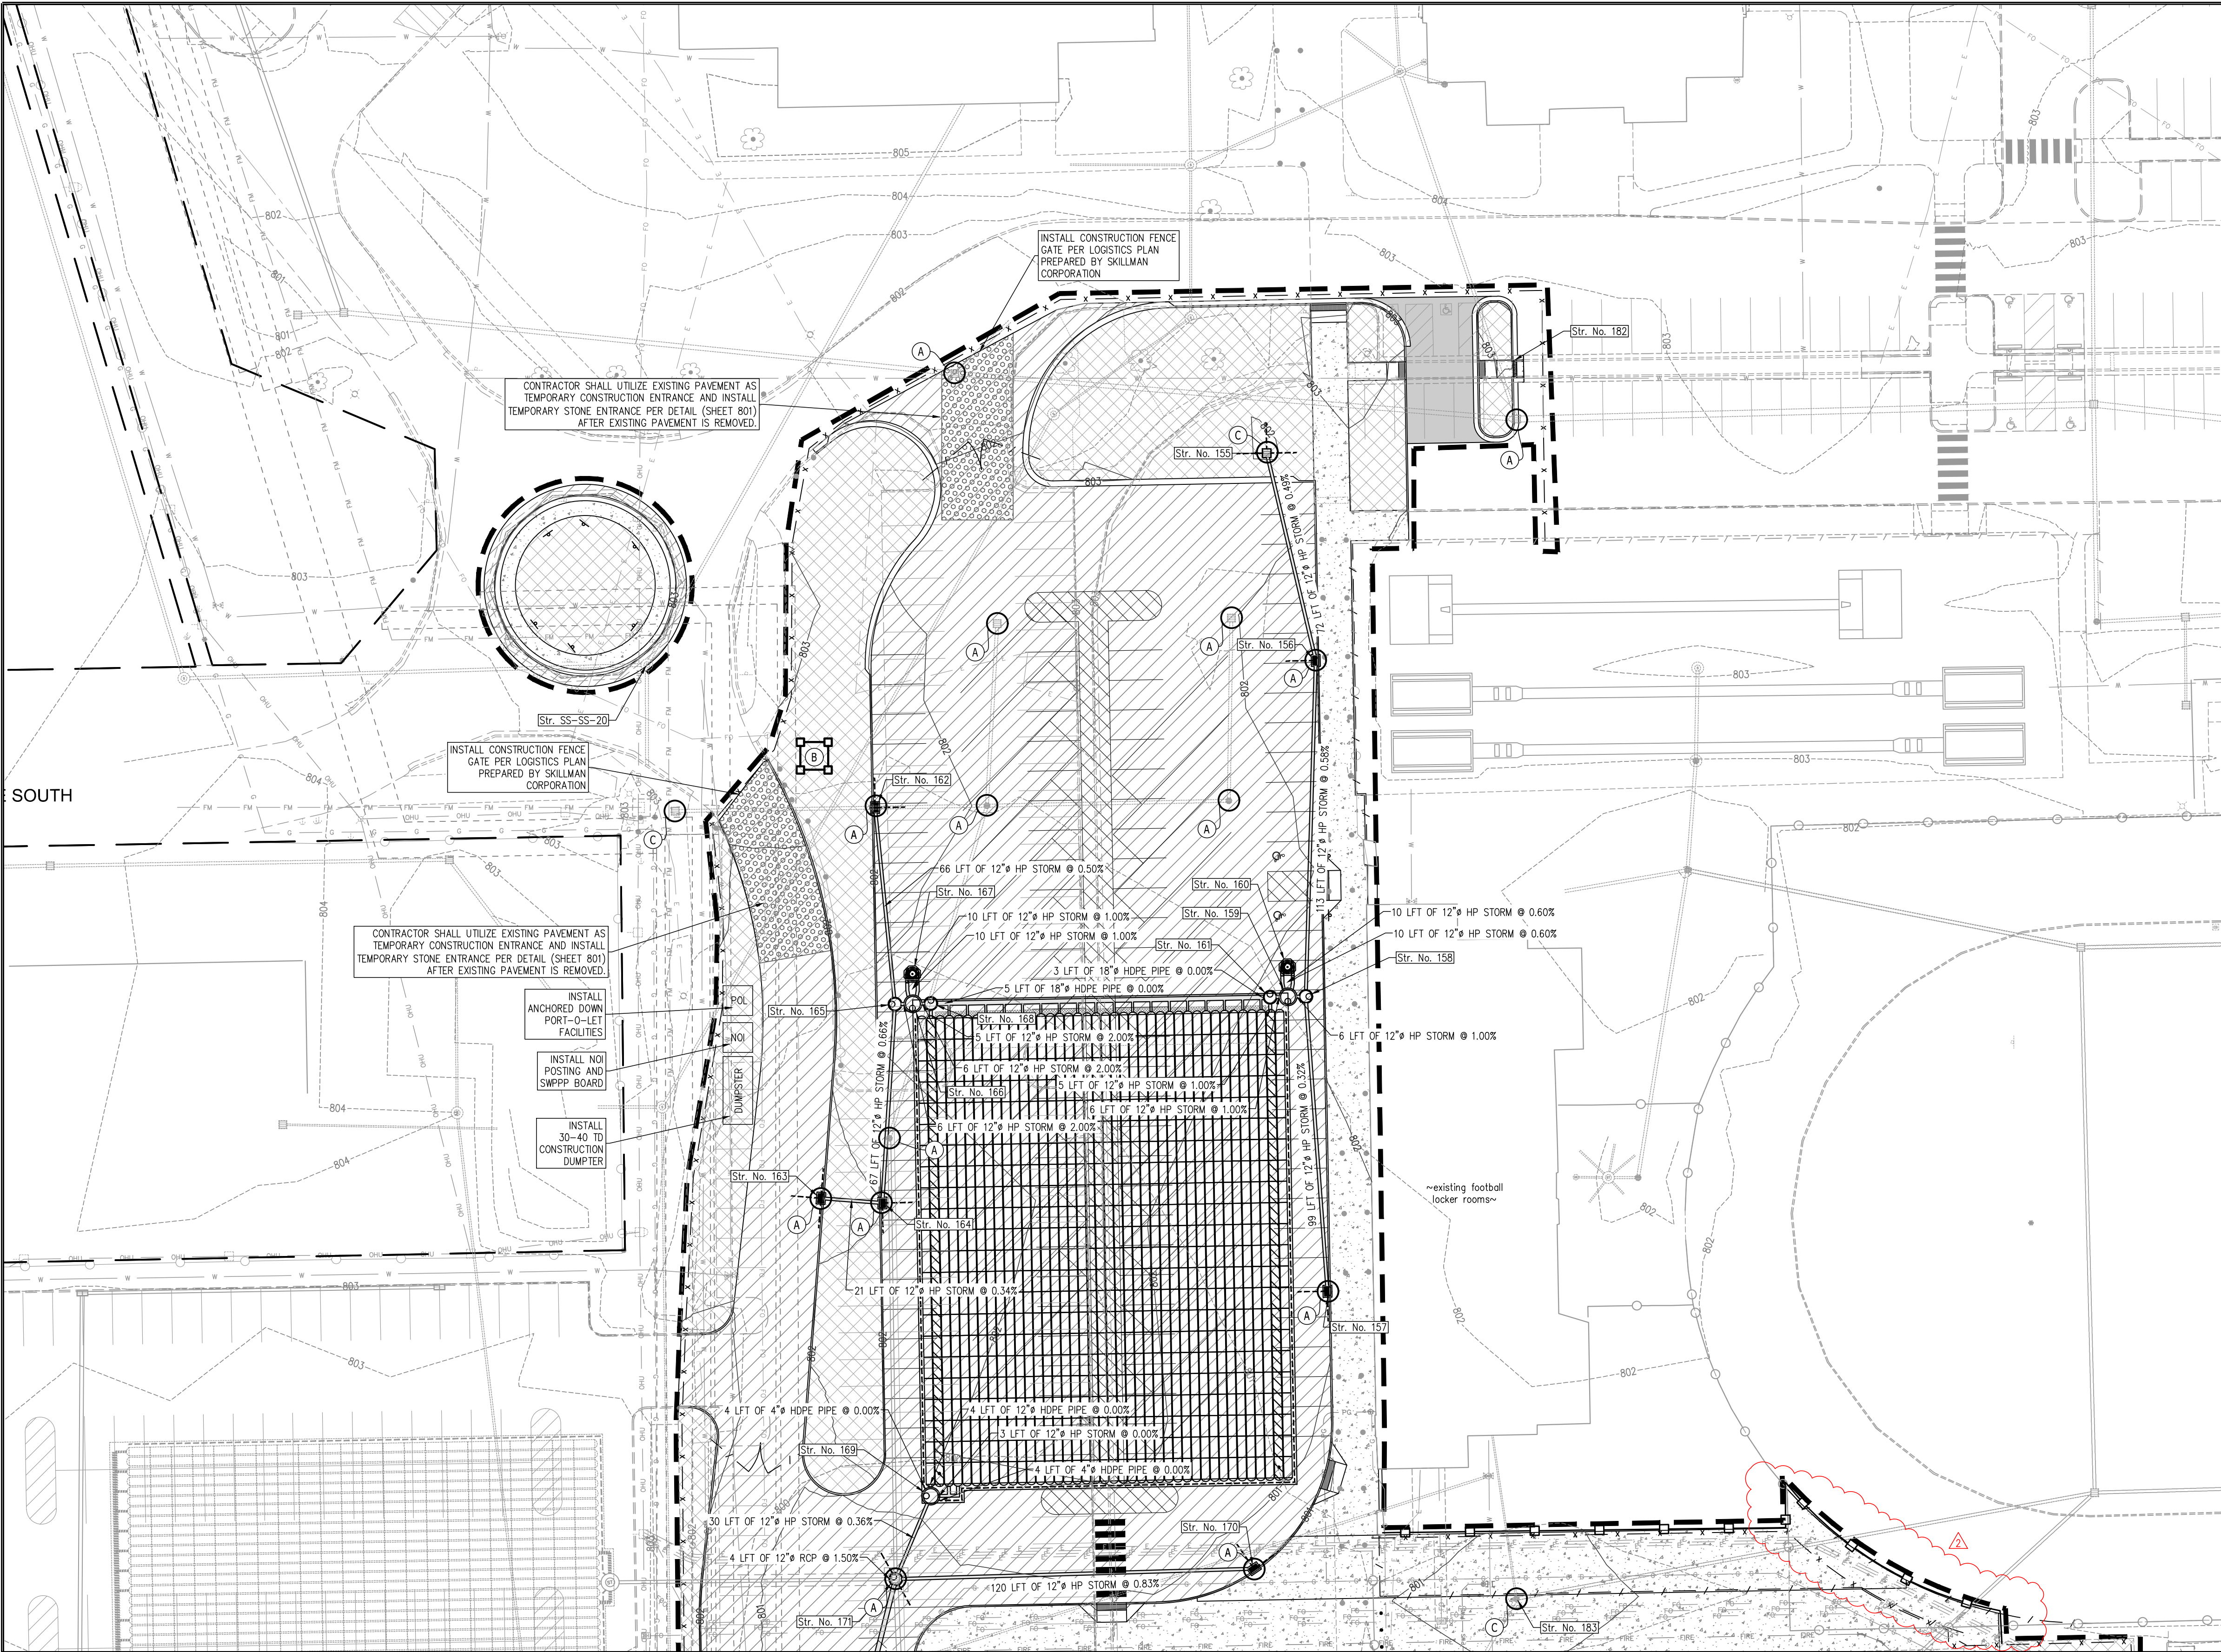

MATCHLINE - SEE SHEET 802

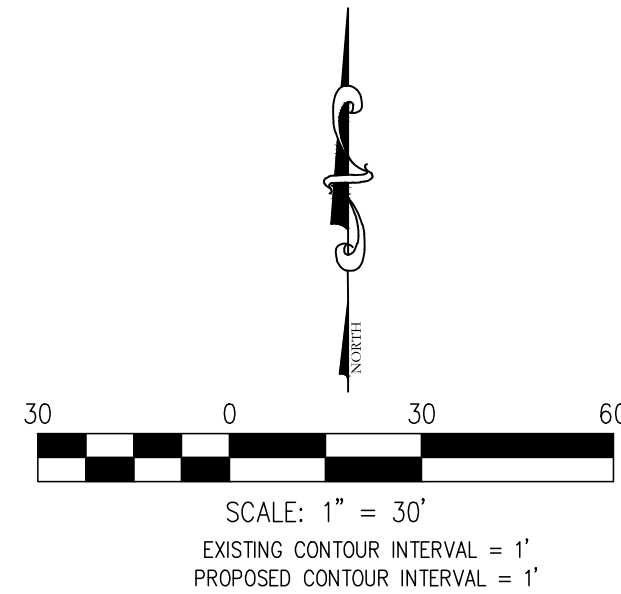


EROSION CONTROL LEGEND


- MULCHED SEEDING
- EROSION CONTROL BLANKET (NORTH AMERICAN GREEN SC-150 OR EQUAL) AND MULCHED SEEDING
- CONSTRUCTION DRIVE (SEE DETAIL—THIS SHEET)
- EXISTING CONTOURS
- PROPOSED CONTOURS
- SILT FENCE SLOPE CHECK (NUTEC 3 NWS-6 OR APPROVED EQUAL)
- CONSTRUCTION LIMITS
- CURB INLET PROTECTION (SEE DETAIL—SHEET 800)
- CONCRETE WASHOUT AREA (SEE DETAIL—SHEET 800)
- FABRIC DROP INLET PROTECTION (SEE DETAIL—SHEET 800)

EROSION CONTROL NOTES

- ADDITIONAL EROSION CONTROL MEASURES MAY BE REQUIRED BY STATE, COUNTY, OR LOCAL OFFICIALS.
- ADDITIONAL EROSION CONTROL MEASURES MAY BE REQUIRED IN THE FIELD BY THE INSPECTOR.
- THERE SHALL BE NO DIRT, DEBRIS, OR STORAGE OF MATERIALS WITHIN EXISTING OR PROPOSED PARKING AREAS OR PUBLIC RIGHT-OF-WAY.
- CONSTRUCTION STAGING AREA (TO BE DETERMINED BY CONTRACTOR) SHALL INCLUDE THE NO POSTING, PORT-O-LETS, TRASH CONTAINERS, AND FUELING TANKS. CONTRACTOR SHALL NOT LOCATE STAGING AREA WITHIN PROPOSED PARKING LOTS.
- A TRAINED INDIVIDUAL MUST PERFORM AN INSPECTION ONCE A WEEK AND AFTER EVERY 25' OR MORE RAIN EVENT. A LOG OF THE INSPECTION REPORTS MUST BE KEPT AND MADE AVAILABLE TO THE TOWN INSPECTOR UPON REQUEST.
- CONTRACTOR SHALL STREET SWEEP AS NEEDED AND IN ACCORDANCE WITH THE FRONT END DOCUMENTS/SPECIFICATIONS PREPARED BY THE SKILLMAN CORPORATION.

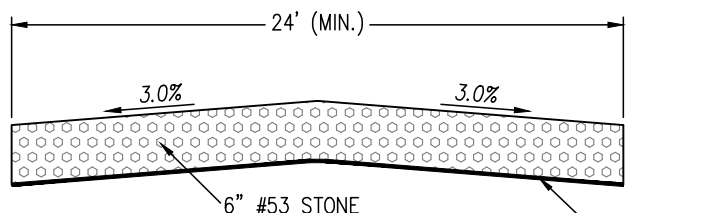


SECTION A-A

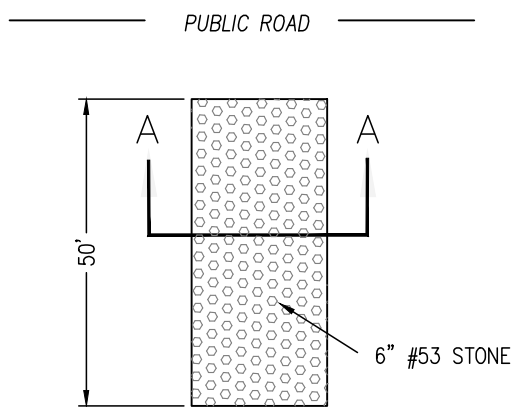

TEMPORARY CONSTRUCTION
ENTRANCE DETAIL
NOT TO SCALE

ADDITIONAL EROSION CONTROL
MEASURES MAY BE REQUIRED BY
STATE, CITY OR COUNTY OFFICIALS

NOTE:
NO EARTHWORK DISTURBING ACTIVITY
MAY COMMENCE UNTIL A STORM WATER
MANAGEMENT PERMIT IS OBTAINED.

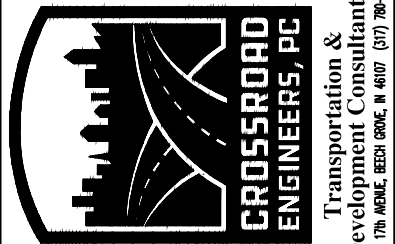

EROSION CONTROL PLAN

WHITELAND HIGH SCHOOL PHASE 3


JOB No.	DRAWN	KLF	CHECKED	TEN	APPR.	GJ	SHEET	801
DATE	MAY 2, 2025	DESIGNED						



Derek M. Swyder

NO.	DATE	REVISIONS	BY	APPR.
9				
8				
7				
6				
5				
4				
3	07.23.25	REVISIONS PER ADDENDUM NO. 2	DMS	GJ
2	08.04.25	REVISIONS PER WHITELAND TAC COMMENTS: 100% CONSTRUCTION DOCUMENTS	DMS	GJ
1				

SHEET 801

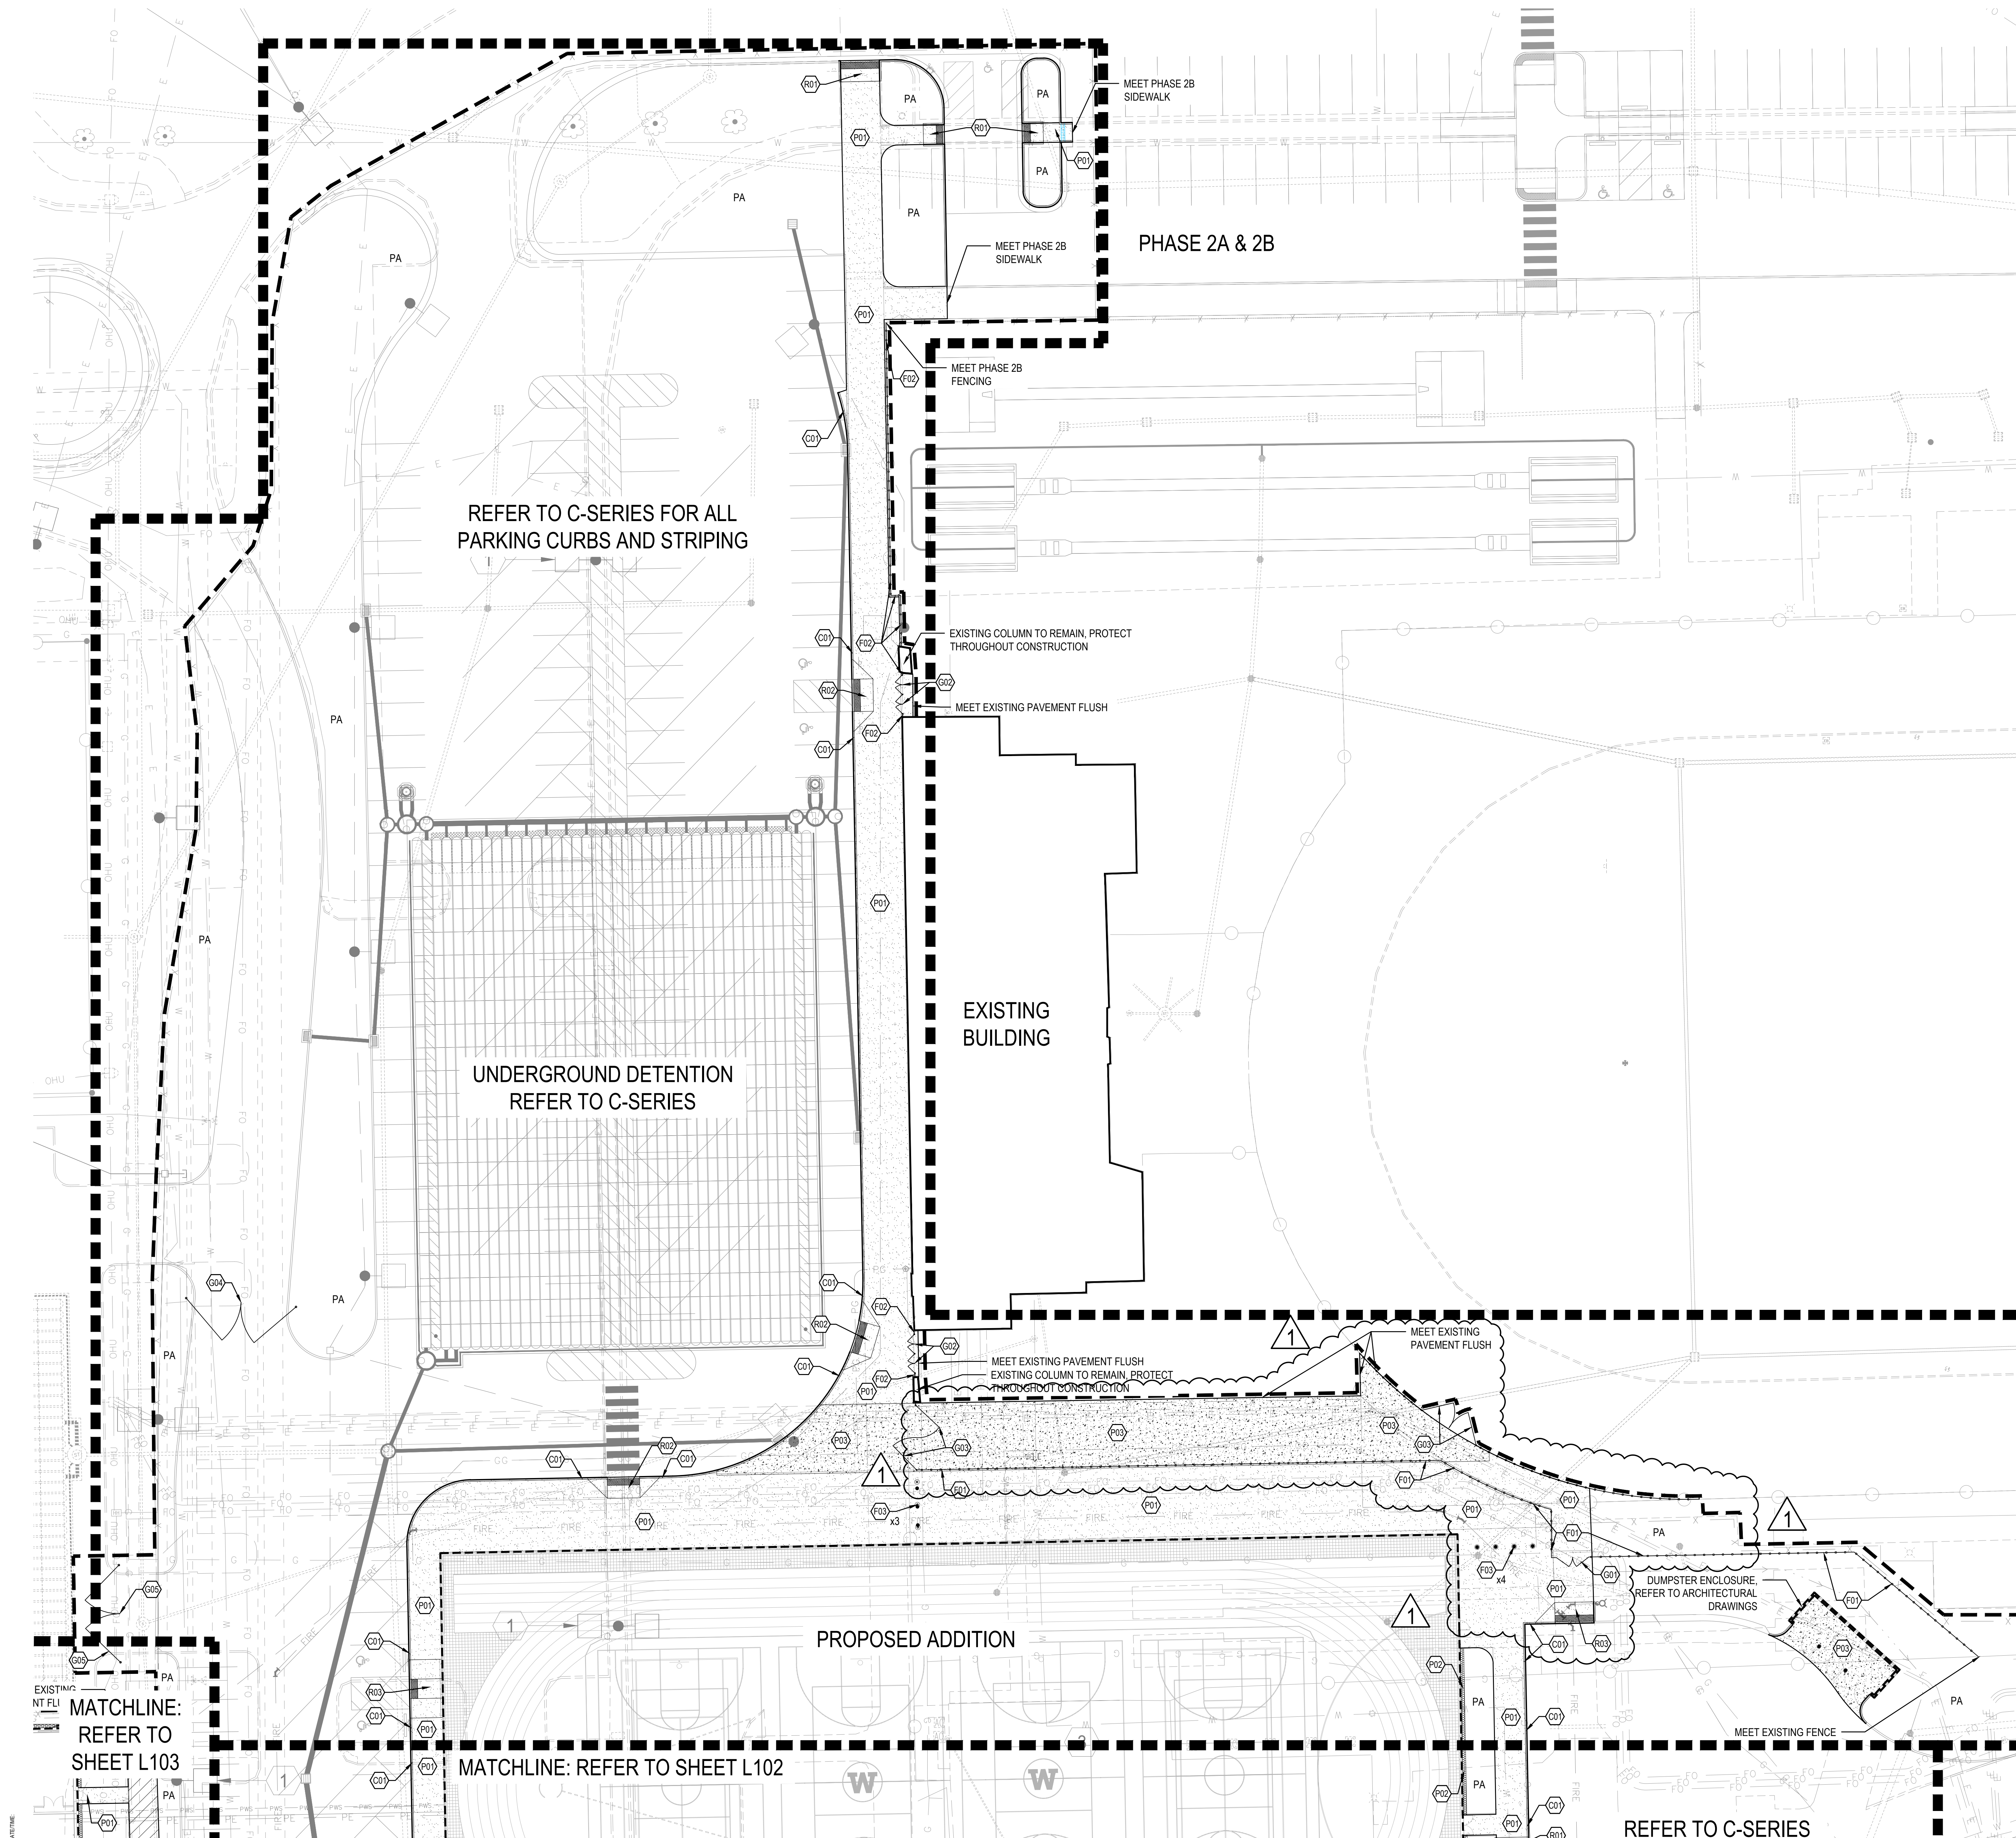

MATERIAL KEYNOTES	
KEY	DESCRIPTION / REFERENCE
(C01)	INTEGRAL CURB AND WALK REFER TO DETAIL 5/L601 AND SPEC. 32 13 13

FENCING	
KEY	DESCRIPTION / REFERENCE
(F01)	6'-0" HT. CHAIN-LINK FENCE, VINYL COATED, BLACK, REFER TO SPEC. 32 31 13
(F02)	6'-0" HT. ORNAMENTAL FENCE, BLACK REFER TO SPEC. 32 31 13
(F03)	STEEL PIPE BOLLARD, REFER TO DETAIL 9/L601

GATES	
KEY	DESCRIPTION / REFERENCE
(G01)	DOUBLE LEAF CHAIN-LINK SWING GATE, 10'-0" OPENING, MATCH HEIGHT OF ADJACENT FENCING, REFER TO SPEC. 32 31 13
(G02)	DOUBLE LEAF ORNAMENTAL SWING GATE, 6'-0" OPENING, MATCH HEIGHT OF ADJACENT FENCING, REFER TO SPEC. 32 31 13
(G03)	DOUBLE LEAF ORNAMENTAL SWING GATE, 20'-0" OPENING, MATCH HEIGHT OF ADJACENT FENCING, REFER TO SPEC. 32 31 13
(G04)	BARRIER GATE, 34'-0" OPENING REFER TO SPEC. 32 33 00
(G05)	BARRIER GATE, 30'-0" OPENING REFER TO SPEC. 32 33 00
(G06)	ELECTRONIC BARRIER GATE, 17'-0" SINGLE ARM REFER TO SPEC. 32 33 00 AND E-SERIES

PAVEMENTS	
KEY	DESCRIPTION / REFERENCE
(P01)	CONCRETE PAVEMENT REFER TO DETAILS 1-3/L601 AND SPEC. 32 13 13
(P02)	MOW STRIP MAINTENANCE EDGE, 1'-0" WIDTH REFER TO SITE DETAILS 6-7/L601 AND SPEC. 32 05 16
(P03)	CONCRETE, HEAVY DUTY REFER TO DETAILS 2, 4/L601 AND SPECIFICATION 32 13 13
(P04)	ASPHALT TRAIL REFER TO CIVIL DRAWINGS

RAMPS	
KEY	DESCRIPTION / REFERENCE
(R01)	ONE-WAY DIRECTIONAL CURB RAMP REFER TO CIVIL DRAWINGS
(R02)	PERPENDICULAR CURB RAMP REFER TO CIVIL DRAWINGS
(R03)	PARALLEL CURB RAMP REFER TO CIVIL DRAWINGS
(R04)	BRICK DETECTABLE WARNING SURFACE W/CONCRETE BORDER REFER TO CIVIL DRAWINGS


WALLS	
KEY	DESCRIPTION / REFERENCE
(W01)	CIP CONCRETE SEATWALL REFER TO DETAIL 8/L601 AND SPEC. 32 13 13

LANDSCAPE FEATURES	
KEY	DESCRIPTION / REFERENCE
PA	PLANTING AREA REFER TO L400 SHEET SERIES

LHB - COLUMN FOOTING SCHEDULE				
FTG. MARK	LENGTH	WIDTH	THICK	REINF. EACH WAY
F5.02H	5'-0"	5'-0"	1'-0"	(8) #5 x 4'-0"
F5.02L	5'-0"	5'-0"	1'-0"	(8) #5 x 4'-0" TOP & BOTTOM
F5.0x7.0SP1*	7'-0"	5'-0"	5'-10"	(8) #6 x 4'-0" & (8) #6 x 6'-0"
F5.0x7.0SP2*	7'-0"	5'-0"	5'-0"	(8) #6 x 4'-0" & (8) #6 x 6'-0"
F5.0x7.0SP3*	7'-0"	5'-0"	8'-2"	(8) #6 x 4'-0" & (8) #6 x 6'-0"
F5.0x7.0SP4*	7'-0"	5'-0"	10'-0"	(8) #6 x 4'-0" & (8) #6 x 6'-0"
F5.0x7.0SP5*	7'-0"	5'-0"	12'-0"	(8) #6 x 4'-0" & (8) #6 x 6'-0"
F5.0x7.0SP6*	7'-0"	5'-0"	5'-2"	(8) #6 x 4'-0" & (8) #6 x 6'-0"
F5.0x7.0SP7*	7'-0"	5'-0"	3'-10"	(8) #6 x 4'-0" & (8) #6 x 6'-0"
F5.0x7.0SP8*	7'-0"	5'-0"	3'-10"	(8) #6 x 4'-0" & (8) #6 x 6'-0" TOP & BOTTOM
F5.0x7.0SP9*	7'-0"	5'-0"	5'-2"	(8) #6 x 4'-0" & (8) #6 x 6'-0" TOP & BOTTOM
F5.0x7.0SP10*	7'-0"	5'-0"	3'-0"	(8) #6 x 4'-0" & (8) #6 x 6'-0" TOP & BOTTOM
F5.0x7.0SP11*	7'-0"	5'-0"	3'-0"	(8) #6 x 4'-0" & (8) #6 x 6'-0"
F6.0	6'-0"	6'-0"	1'-6"	(7) #6 x 5'-6"
F6.0x8.0SP1*	8'-0"	6'-0"	7'-10"	(9) #6 x 5'-6" & (7) #6 x 7'-6"
F6.0x8.0SP2*	8'-0"	6'-0"	7'-2"	(9) #6 x 5'-6" & (7) #6 x 7'-6"
F6.0x8.0SP3*	8'-0"	6'-0"	6'-6"	(9) #6 x 5'-6" & (7) #6 x 7'-6"
F6.0x8.0SP4*	8'-0"	6'-0"	5'-10"	(9) #6 x 5'-6" & (7) #6 x 7'-6"

NOTES:

- CENTER FOOTINGS BENEATH COLUMNS, U.N.O.
- ALL FOOTINGS MUST BE BOARD-FORMED, UNLESS APPROVED.
- INCREASE FOOTING DEPTH WHERE REQ'D TO ENCASE COLUMN ANCHOR RODS
- SP FOOTING DIMENSIONS AND REINFORCING HAS BEEN SHOWN FOR BIDDING PURPOSES DUE TO THE NATURE OF POURING THESE FOOTING AGAINST EXISTING FOUNDATIONS, THE BAR LENGTHS AND CONCRETE QUANTITIES MIGHT NEED TO BE ADJUSTED ONCE FIELD VERIFICATION HAS BEEN PERFORMED AT THESE LOCATIONS.

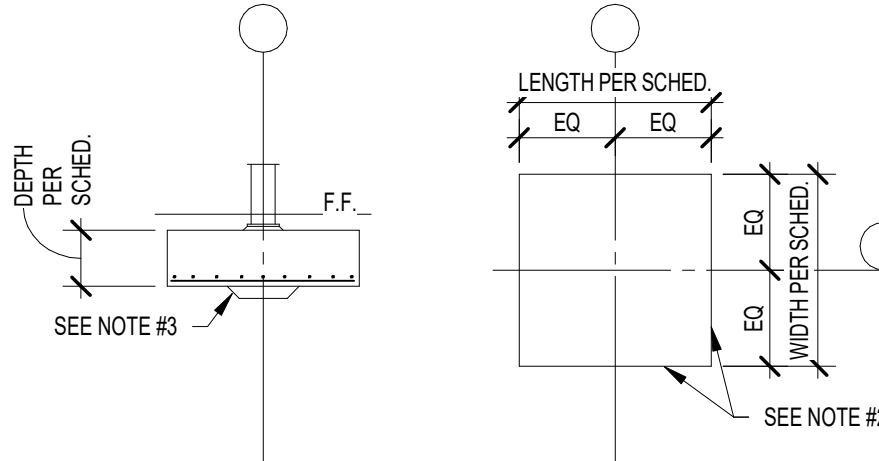

LHB - CONCRETE PIER SCHEDULE					
PIER MARK	LENGTH	WIDTH	VERT. REINF.	TIE REINF.	TIE DETAIL
P28A	28"	28"	(6) #7	#4 @ 12" o.c.	B
P28B	28"	28"	(4) #9	#4 @ 12" o.c.	A

1. PROVIDE MIN. 1 1/2' CLEAR TO PIER TIES.

2. 'CRITICAL HEIGHT' DENOTES THE HEIGHT ABOVE WHICH LARGER DIAMETER VERTICALS WITH FEWER TIES MAY BE USED. REF. FOUNDATION PLAN(S) FOR TOP OF PIER & FOOTING ELEV'S.

3. REF. 'TYPICAL CONCRETE PIER REINFORCING' ON FOUNDATION DETAIL SHEET FOR FURTHER INFORMATION ON TIE SPACING.

4. VERTICAL DOWELS ARE TO FUNCTION AS PIER VERTICALS FOR PIERS LESS THAN OR EQUAL TO 5' - 0" HIGH. PROVIDE SEPARATE DOWELS & VERTICALS FOR PIERS GREATER THAN OR EQUAL TO 5' - 0" HIGH, UNLESS APPROVED.

5. CONTACT THE STRUCTURAL ENGINEER FOR DIRECTION IF COLUMN ANCHOR RODS FOUL WITH PIER TIES OR VERTICALS.

6. MIN. HEIGHT OF PIERS: #6 VERTICALS = 2' - 0", #7 VERTICALS = 2' - 8".

DETAIL "A"

(1) SET

DETAIL "B"

(2) SETS

DETAIL "C"

(3) SETS

DETAIL "D"

(2) SETS

DETAIL "E"

(2) SETS


ALT. DETAIL "B"

(3) SETS

LHB - WALL FOOTING SCHEDULE				
FTG. MARK	WIDTH	THICK	CONF. REINF.	TRANS. REINF.
WF36*	3'-0"	2'-10"	(4) - #5 TOP & BOTTOM	#5 @ 12" o.c. TOP & BOTTOM
WF24	2'-0"	1'-0"	(3) - #5	#5 @ 12" o.c.
WF36	3'-0"	1'-2"	(4) - #5	#5 @ 12" o.c.
WF48PC	4'-0"	2'-6"	(4) - #7 TOP & BOTTOM	#7 @ 12" o.c. w/ 180 DEGREE HOOKS TOP & BOTTOM
WF54*	4'-6"	1'-4"	(5) - #5 TOP & BOTTOM	#5 @ 12" o.c. TOP & BOTTOM

1. CENTER FOOTINGS BENEATH WALLS, U.N.O.

CLARK-PLEASANT COMMUNITY SCHOOL CORP.
WHITELAND COMM. HIGH SCHOOL PHASE 3
300 E MAIN ST, WHITELAND, IN 46184

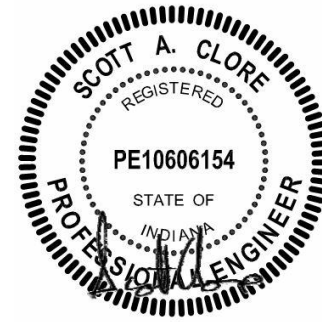

REVISIONS:		Dnec.	
#	Dnec.	DATE	DESCRIPTION
1	07/16/2022	ADDENDUM 1	


100% CONSTRUCTION DOCUMENTS

PROJECT: #22130
DATE: 05-30-2025
DRAWN BY: DJL


STRUCTURAL
NOTES &
SCHEDULES

S002

LANCER ASSOCIATES
ARCHITECTURE
427 S. COLLEGE AVE
INDIANAPOLIS, IN 46203

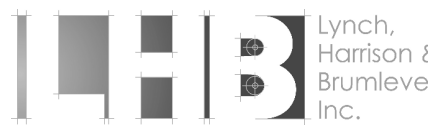

Lynch, Harrison & Grumleve, Inc.

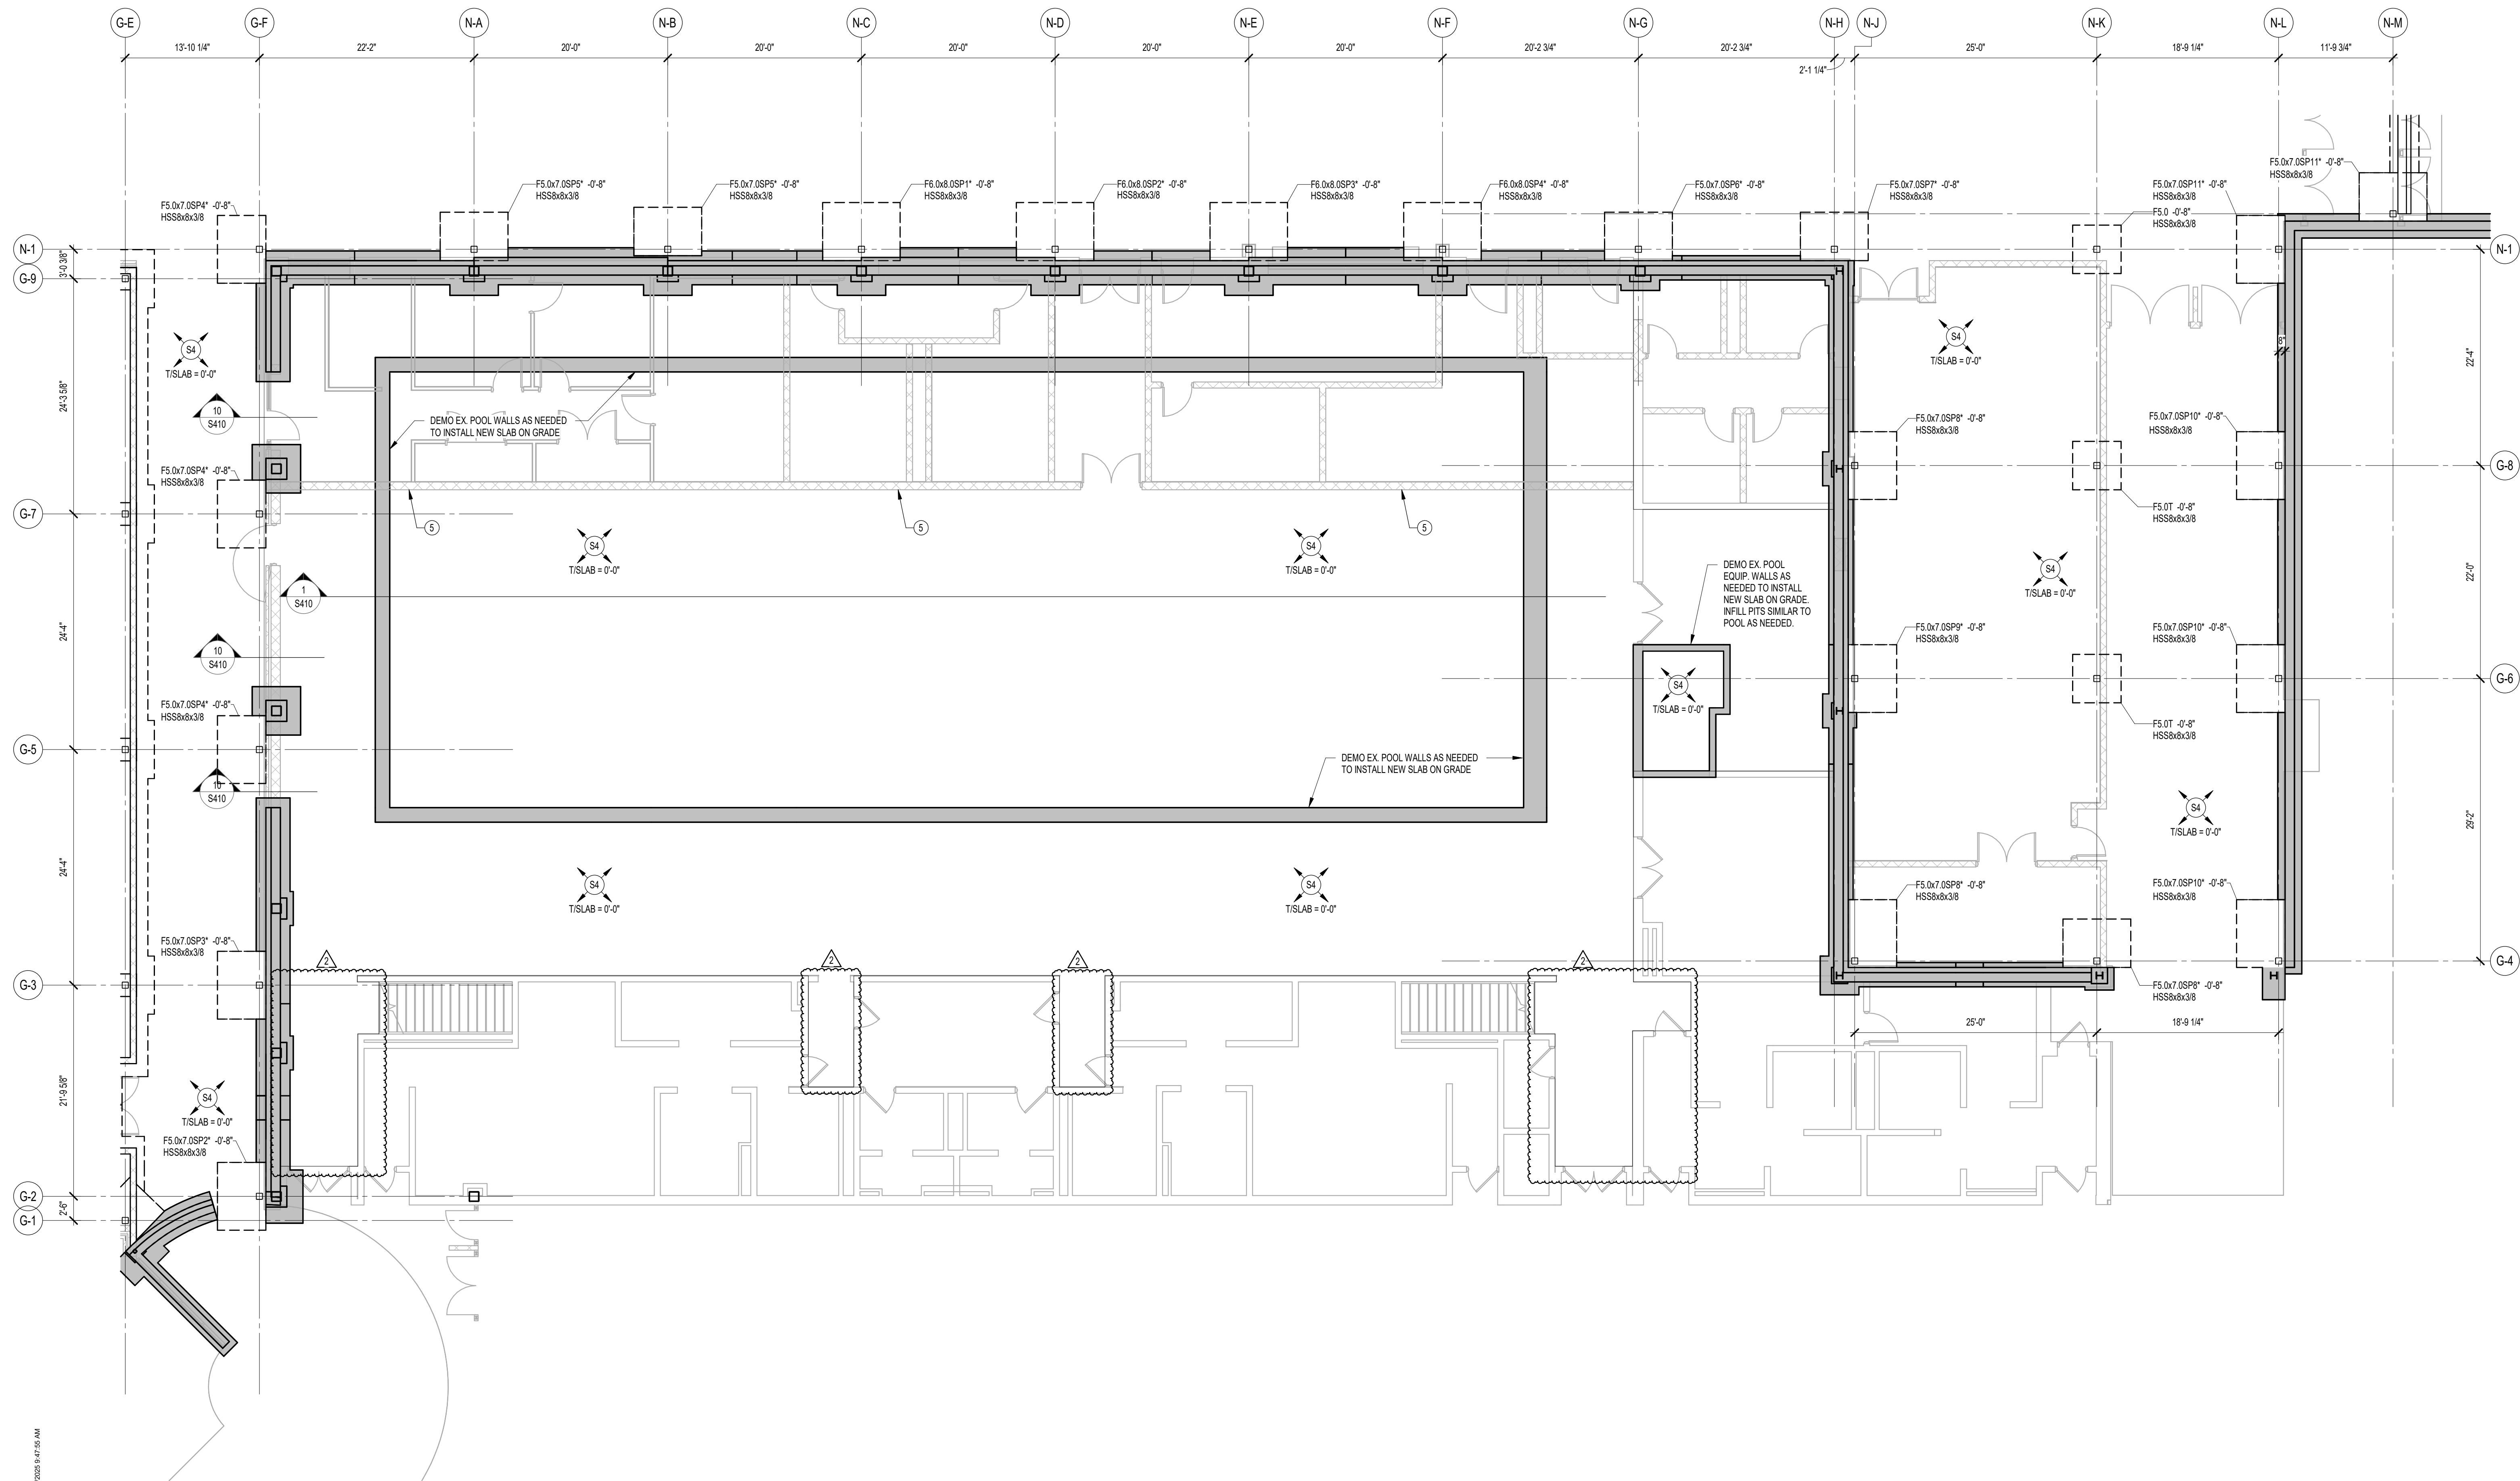

1 FOUNDATION PLAN - UNIT G.2
SCALE: 1/8" = 1'-0"


FOUNDATION PLAN NOTES

- REF. S001 & S002 FOR STRUCTURAL NOTES, DESIGN DATA & SCHEDULES.
- ALL CONTRACTORS ARE REQUIRED TO COORDINATE THEIR WORK WITH ALL DISCIPLINES TO AVOID CONFLICTS. THE MECHANICAL, ELECTRICAL, PLUMBING, ETC. ASPECTS ARE NOT IN THE SCOPE OF THESE DRAWINGS. THEREFORE, ALL REQUIRED MATERIALS AND WORK MAY NOT BE INDICATED.
- COORDINATE EXACT SIZE & LOCATION OF ALL OPENINGS IN FOUNDATION WALLS WITH THE MECHANICAL, ELECTRICAL, PLUMBING, ETC. CONTRACTORS.
- ALL ELEVATIONS ARE REFERENCED FROM THE FIRST FLOOR FINISH FLOOR ELEVATION 0'-0". REF. CIVIL DWGS. FOR USGS ELEVATION.
- REF. ARCH. DRAWINGS FOR ALL DIMENSIONS NOT SHOWN. CONTRACTOR SHALL VERIFY ALL DIMENSIONS PRIOR TO CONSTRUCTION AND IMMEDIATELY NOTIFY ARCHITECT/ENGINEER OF ANY DISCREPANCIES.
- REF. S400 & S401 FOR TYPICAL FOUNDATION DETAILS.
- ALL WALL AND COLUMN FOOTINGS SHALL BE LOWERED TO PASS BELOW UNDERGROUND UTILITIES (I.E. SANITARY & STORM SEWERS, WATER LINES, ETC.). THESE LINES HAVE BEEN SHOWN IN THE APPROXIMATE LOCATIONS ON THE CONTRACT DOCUMENTS AND NEED TO BE COORDINATED BY THE CONTRACTORS. PROVIDE FOOTING STEPS AS REQUIRED PER THE TYPICAL DETAILS ON S400.
- ALL SLAB RECESSES AND SLOPES SHALL BE LOCATED PER THE ARCHITECTURAL DRAWINGS. COORDINATE DEPTHS OF ALL SLAB RECESSES WITH THE ARCHITECTURAL DRAWINGS AND/OR THE FLOORING SUPPLIER.
- COORDINATE REINFORCING DOVELS FOR CMU VERTICAL REINFORCING WITH REINF. NOTED ON PLANS & SECTIONS.
- GROUT ALL CORES OF CMU BELOW FINISH FLOOR SOILD.
- COLUMN FOOTINGS, TRENCH FOOTINGS AND WALL FOOTINGS SHALL BEAR ON APPROVED SOIL. UNDERCUT AS REQ'D TO SUITABLE BEARING MATERIAL AS DETERMINED BY THE GEOTECHNICAL TESTING AGENCY. REF. TYPICAL FOOTING UNDERCUT DETAIL ON S400.
- COLUMN FOOTINGS SUPPORTING MORE THAN ONE COLUMN SHALL BE CENTERED AT THE MIDPOINT BETWEEN THE COLUMNS, UNLESS NOTED OTHERWISE ON PLAN.
- ALL EX. CONSTRUCTION SHOWN IN PLAN AND/OR SECTION WAS DERIVED FROM EXISTING DRAWINGS AND MUST BE FIELD VERIFIED. IF ANY DISCREPANCIES ARE DISCOVERED BETWEEN INFO. SHOWN ON THE DRAWINGS AND ACTUAL CONDITIONS IMMEDIATELY CONTACT ARCHITECT/ENGINEER FOR DIRECTION BEFORE PROCEEDING WITH THE WORK.
- PROVIDE THICKENED SLAB UNDER ALL INTERIOR CMU WALLS WITHOUT FOOTINGS. SEE 401 FOR THICKENED SLAB DETAIL. LAYOUT THICKENED SLABS FROM DIMENSIONS ON THE ARCHITECT FLOOR PLANS.
- PROVIDE CONTROL/CONTRACTION JOINTS IN SLABS ON GRADE. (REF. THE TYPICAL DETAILS ON SHEET S400). ALL JOINTS IN SLABS TO RECEIVE THIN OR THICK-SET TERRAZZO, CERAMIC OR PORCELAIN TILE, VINYL-COMPOSITION TILE (VCT) OR VINYL SHEET GOODS, EPOXY OR SIMILAR THIN-FLM FINISH FLOORING SHALL BE CAREFULLY COORDINATED WITH THE FLOORING CONTRACTOR. THE CONTRACTOR SHALL SUBMIT SLAB JOINT LAYOUT TO ARCHITECT/ENGINEER FOR REVIEW PRIOR TO PLACING SLABS.
- COLUMN AND WALL FOOTINGS NOTED WITH AN ASTERISK (*) ARE NOT REQUIRED TO BEAR ON AGGREGATE PIERS. REFERENCE NOTES ON S001 AND SPECIFICATIONS.
- PLAN LEGEND:


- S4**
T/SLAB = 0'-0"
- DEMOTES 4" CONC. SLAB-ON-GRADE w/ FIBERFORCE 300 @ 1.5LB/CY (OR APPROVED EQUAL) & ES SYSTEM CONSISTING OF:
ES INTERNAL CURE @ 40ZCWT &
ES CATALYST SPRAY ON BETWEEN 800-1,500 SF/GAL OVER 15-MILL CLASS A VAPOR BARRIER OVER 6" COMPACTED GRANULAR FILL (INDOT No. 53)
- S5**
T/SLAB = 0'-0"
- DEMOTES 5" CONC. SLAB-ON-GRADE w/ FIBERFORCE 300 @ 1.5LB/CY (OR APPROVED EQUAL) & ES SYSTEM CONSISTING OF:
ES INTERNAL CURE @ 40ZCWT &
ES CATALYST SPRAY ON BETWEEN 800-1,500 SF/GAL OVER 15-MILL CLASS A VAPOR BARRIER OVER 6" COMPACTED GRANULAR FILL (INDOT No. 53)
- S6**
T/SLAB = 0'-0"
- DEMOTES 6" CONC. SLAB-ON-GRADE w/ FIBERFORCE 750 @ 1.5LB/CY (OR APPROVED EQUAL) & ES SYSTEM CONSISTING OF:
ES INTERNAL CURE @ 40ZCWT &
ES CATALYST SPRAY ON BETWEEN 800-1,500 SF/GAL OVER 15-MILL CLASS A VAPOR BARRIER OVER 6" COMPACTED GRANULAR FILL (INDOT No. 53)
- F.F. DEMOTES FINISH FLOOR
T/X DEMOTES TOP OF FTG., GRADE BEAM, SLAB, PIER, ETC.
B/X DEMOTES BOTTOM OF FTG., GRADE BEAM, ETC.
WF30-Z-0" DEMOTES WALL FOOTING MARK & TOP OF FOOTING ELEVATION (SEE WALL FOOTING SCHEDULE)
DEMOTES WALL FOOTING WITH STEPS, REF. TYP. DETAIL ON S400
TIF-2'-0" TIF-1'-0" TIF-1'-0" TIF-1'-0"
- DEMOTES COLUMN FOOTING MARK & TOP OF FTG. ELEVATION (SEE FTG. SCHEDULE)
DEMOTES PIER MARK & TOP OF PIER ELEVATION (SEE PIER SCHEDULE)
COLUMN FOOTING
CONCRETE PIER
STEEL COLUMN
- CW18 DEMOTES C.I.P. CONCRETE WALL MARK
PCW12 DEMOTES PRECAST CONCRETE WALL MARK

KEYED NOTES - FOUNDATIONS

- TEMPORARY UTILITY MAY BE SLEEVED UNDER FOOTING PER 12S400.
- RECESS/SLOPE SLAB FOR LONG JUMP PIT AND POLE VAULT PIT PER TYPICAL DETAILS ON S401. COORDINATE WITH EQUIPMENT SUPPLIER.
- NEW 12" CMU TO BE TOOTHED INTO EX. 12" CMU WALL FULL HEIGHT. BOND BEAM REINFORCING TO BE DOVELED INTO EX. CMU MIN. 12" EMBEDMENT USING HILTI-HY 270.
- PROVIDE RIGID ANCHORS AT COLUMN TO CMU PER 15S500 @ 32" o.c.
- 10" CMU WALL TO HAVE #6 BARS @ 24" o.c.

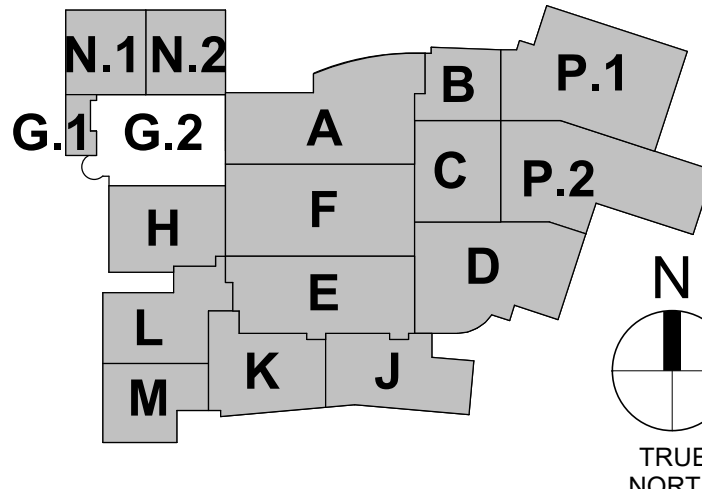

CLARK-PLEASANT COMMUNITY SCHOOL CORP.
WHITELAND COMM. HIGH SCHOOL PHASE 3
300 E MAIN ST, WHITELAND, IN 46184

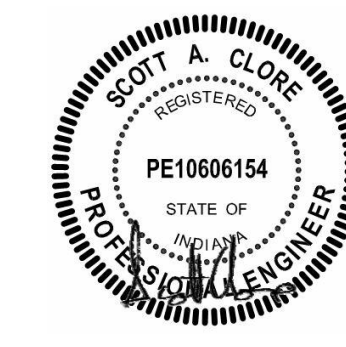






REVISIONS:		
#	Date	Desc.
2	07/23/2022	ADDENDUM 2

100% CONSTRUCTION DOCUMENTS

PROJECT: #22130
DATE: 05-30-2025
DRAWN BY: DJL

FOUNDATION PLAN - UNIT G.2

S101G.2

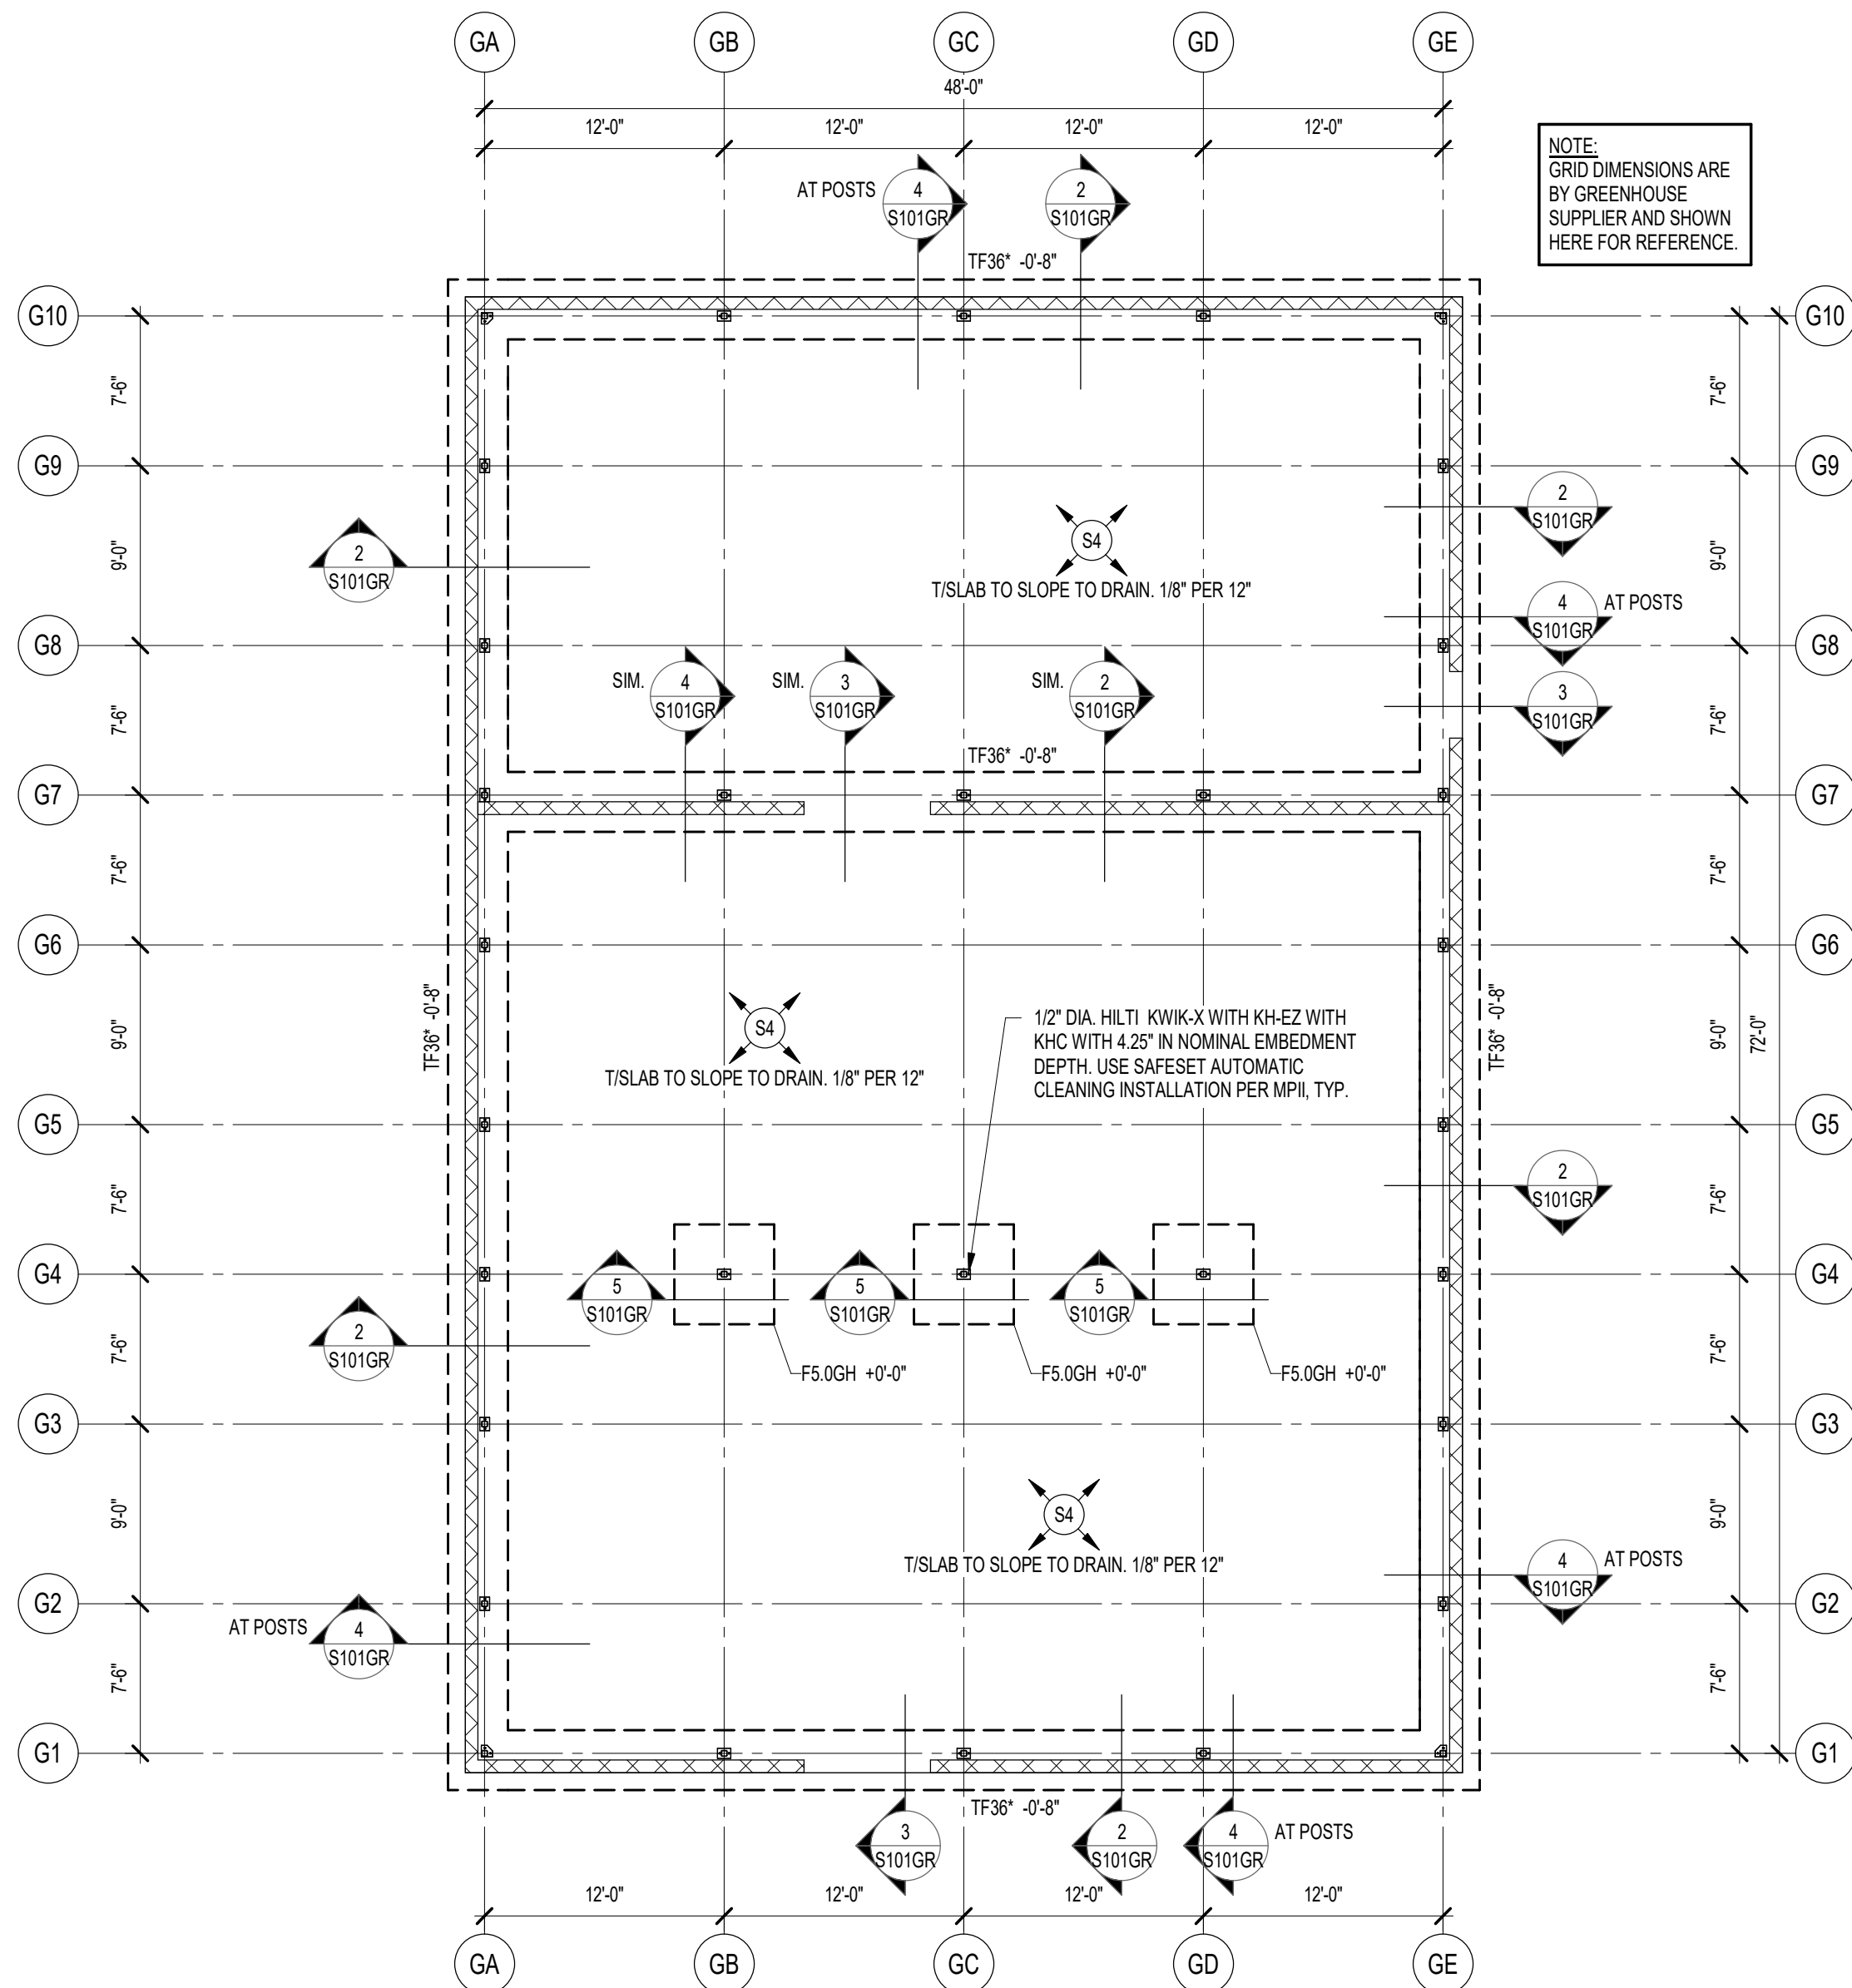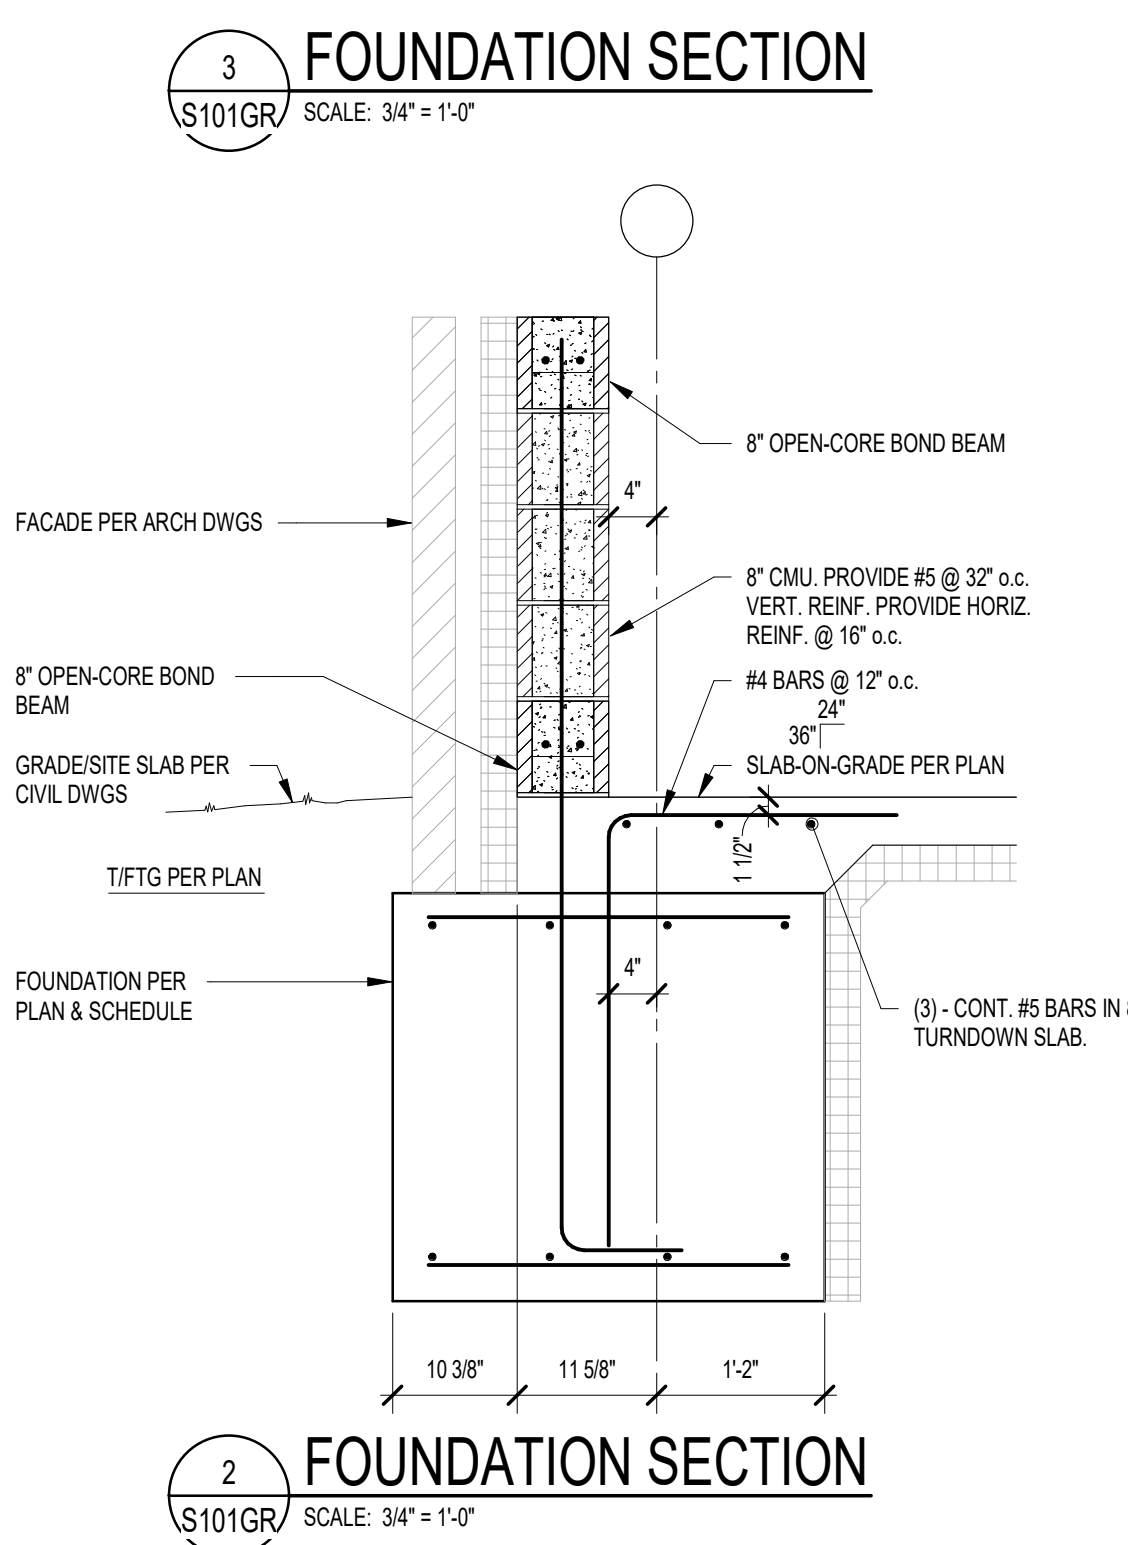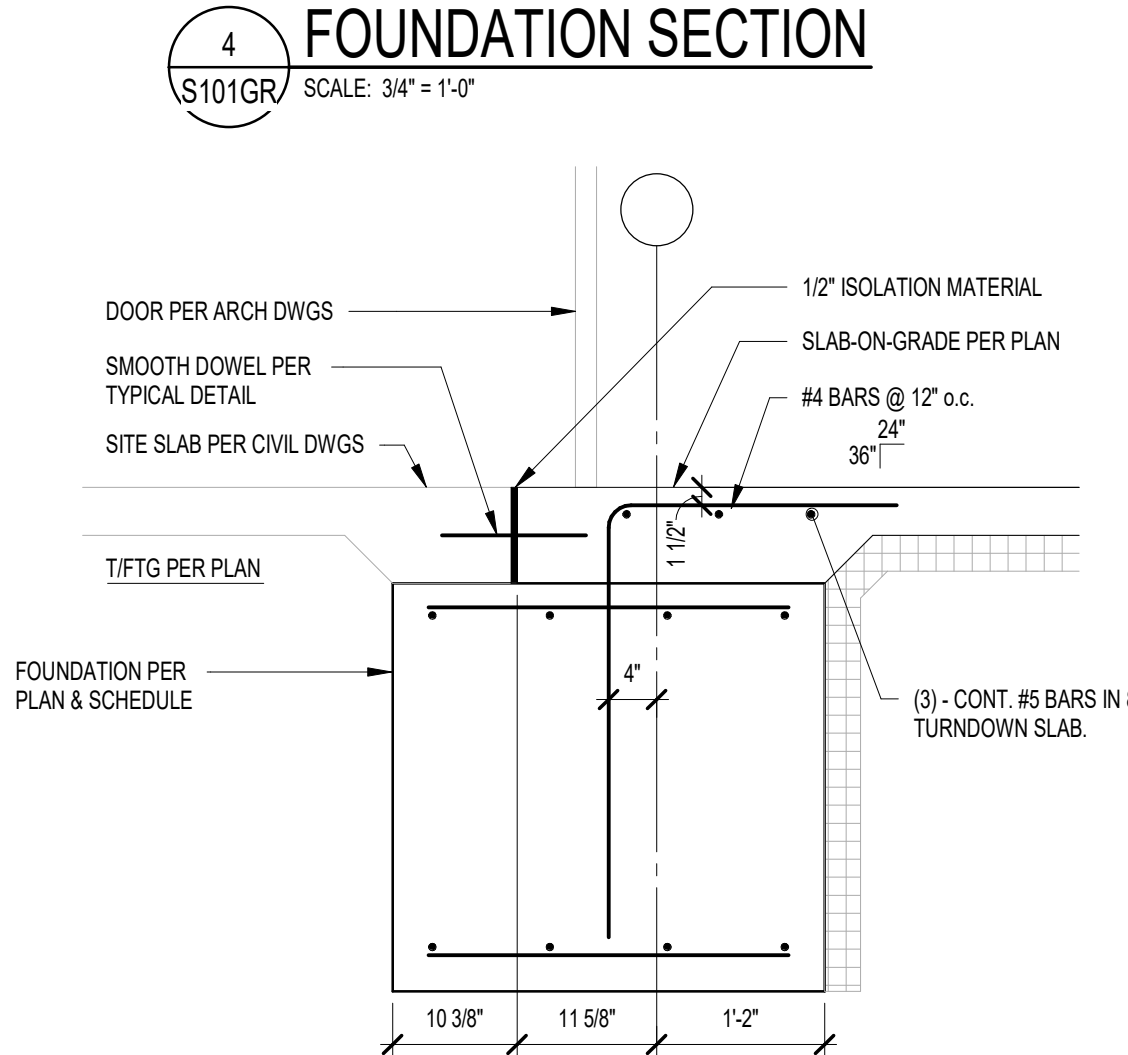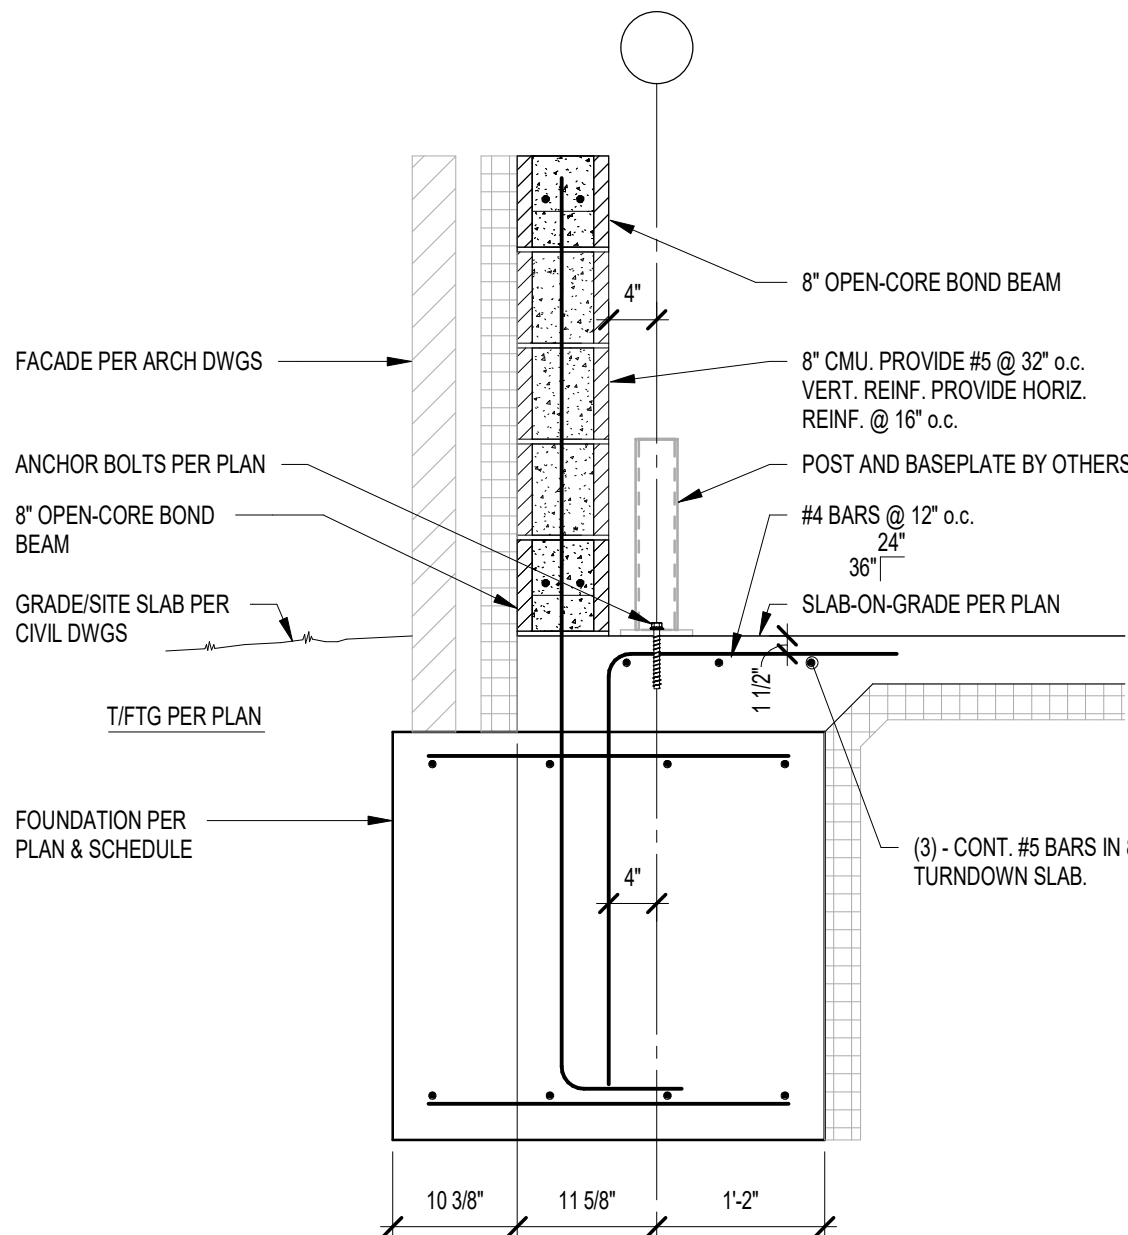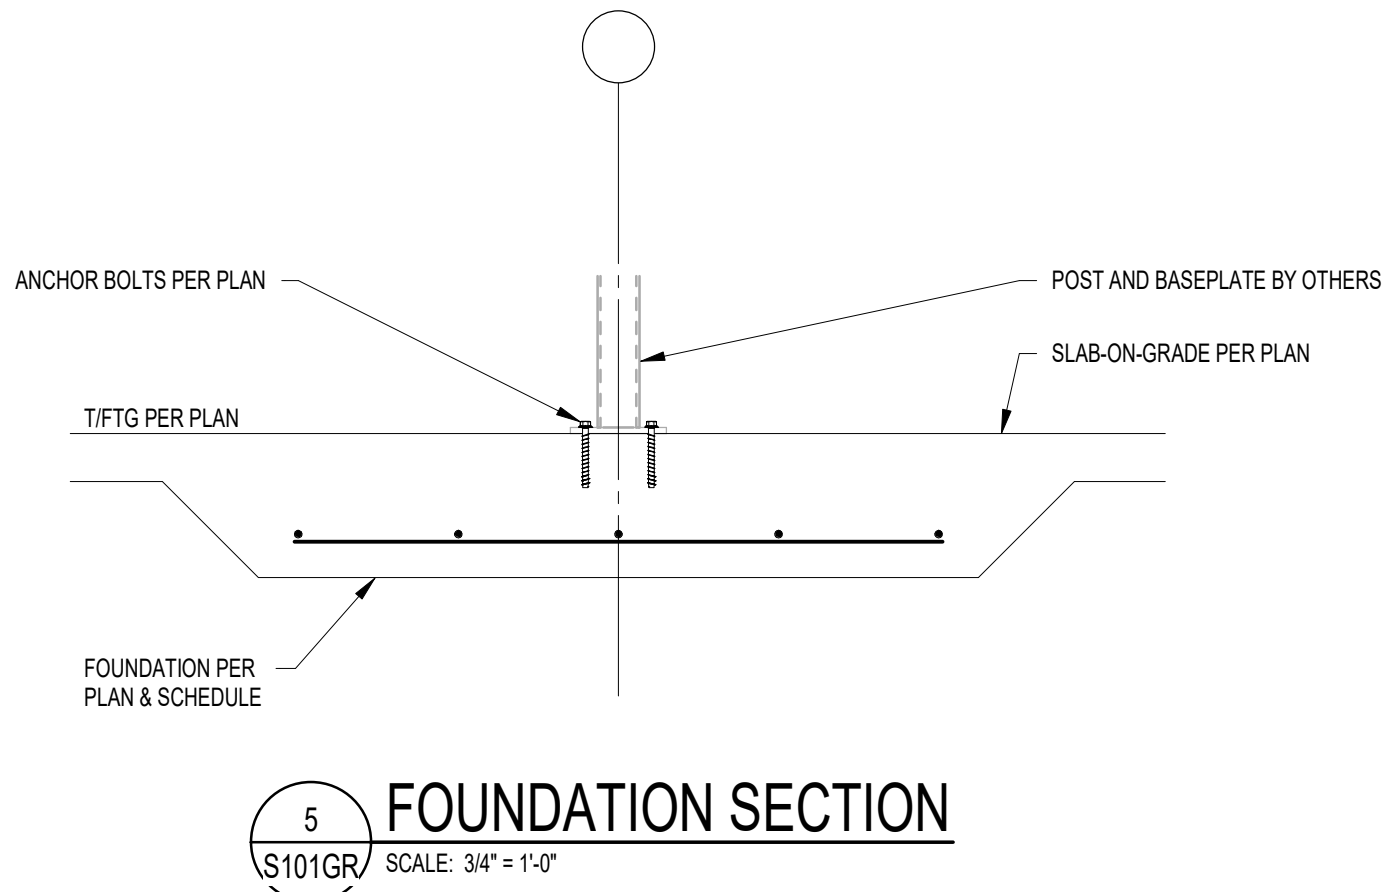

FOUNDATION PLAN NOTES

1. REF. S001 & S002 FOR STRUCTURAL NOTES, DESIGN DATA & SCHEDULES.

2. ALL CONTRACTORS ARE REQUIRED TO COORDINATE THEIR WORK WITH ALL DISCIPLINES TO AVOID CONFLICTS. THE MECHANICAL, ELECTRICAL, PLUMBING, ETC. ASPECTS ARE NOT IN THE SCOPE OF THESE DRAWINGS. THEREFORE, ALL REQUIRED MATERIALS AND WORK MAY NOT BE INDICATED.

3. COORDINATE EXACT SIZE & LOCATION OF ALL OPENINGS IN FOUNDATION WALLS WITH THE MECHANICAL, ELECTRICAL, PLUMBING, ETC. CONTRACTORS.

4. ALL ELEVATIONS ARE REFERENCED FROM THE FIRST FLOOR FINISH FLOOR ELEVATION 0'-0". REF. CIVIL DWGS. FOR USGS ELEVATION.

5. REF. ARCH. DRAWINGS FOR ALL DIMENSIONS NOT SHOWN. CONTRACTOR SHALL VERIFY ALL DIMENSIONS PRIOR TO CONSTRUCTION AND IMMEDIATELY NOTIFY ARCHITECT/ENGINEER OF ANY DISCREPANCIES.

6. REF. S400 & S401 FOR TYPICAL FOUNDATION DETAILS.

7. ALL WALL AND COLUMN FOOTINGS SHALL BE LOWERED TO PASS BELOW UNDERGROUND UTILITIES (I.E. SANITARY & STORM SEWERS, WATER LINES, ETC.). THESE LINES HAVE BEEN SHOWN IN THE APPROXIMATE LOCATIONS ON THE CONTRACT DOCUMENTS AND NEED TO BE COORDINATED BY THE CONTRACTORS. PROVIDE FOOTING STEPS AS REQUIRED PER THE TYPICAL DETAILS ON S400.

8. ALL SLAB RECESSES AND SLOPES SHALL BE LOCATED PER THE ARCHITECTURAL DRAWINGS. COORDINATE DEPTHS OF ALL SLAB RECESSES WITH THE ARCHITECTURAL DRAWINGS AND/OR THE FLOORING SUPPLIER.

9. COORDINATE REINFORCING DOWELS FOR CMU VERTICAL REINFORCING WITH REINF. NOTED ON PLANS & SECTIONS.

10. GROUT ALL CORES OF CMU BELOW FINISH FLOOR SOLID.

11. COLUMN FOOTINGS, TRENCH FOOTINGS AND WALL FOOTINGS SHALL BEAR ON APPROVED SOIL. UNDERCUT AS REQ'D TO SUITABLE BEARING MATERIAL AS DETERMINED BY THE GEOTECHNICAL TESTING AGENCY. REF. TYPICAL FOOTING UNDERCUT DETAIL ON S400.

12. COLUMN FOOTINGS SUPPORTING MORE THAN ONE COLUMN SHALL BE CENTERED AT THE MIDPOINT BETWEEN THE COLUMNS, UNLESS NOTED OTHERWISE ON PLAN.

13. ALL EX. CONSTRUCTION SHOWN IN PLAN AND/OR SECTION WAS DERIVED FROM EXISTING DRAWINGS AND MUST BE FIELD VERIFIED. IF ANY DISCREPANCIES ARE DISCOVERED BETWEEN INFO. SHOWN ON THE DRAWINGS AND ACTUAL CONDITIONS IMMEDIATELY CONTACT ARCHITECT/ENGINEER FOR DIRECTION BEFORE PROCEEDING WITH THE WORK.

14. PROVIDE THICKENED SLAB UNDER ALL INTERIOR CMU WALLS WITHOUT FOOTINGS. SEE 401 FOR THICKENED SLAB DETAIL. LAYOUT THICKENED SLABS FROM DIMENSIONS ON THE ARCHITECT FLOOR PLANS.

15. PROVIDE CONTROL/CONTRACTION JOINTS IN SLABS ON GRADE. (REF. THE TYPICAL DETAILS ON SHEET S400). ALL JOINTS IN SLABS TO RECEIVE THIN OR THICK-SET TERRAZZO, CERAMIC OR PORCELAIN TILE, VINYL-COMPOSITION TILE (VCT) OR VINYL SHEET GOODS, EPOXY OR SIMILAR THIN-FILM FINISH FLOORING SHALL BE CAREFULLY COORDINATED WITH THE FLOORING CONTRACTOR. THE CONTRACTOR SHALL SUBMIT SLAB JOINT LAYOUT TO ARCHITECT/ENGINEER FOR REVIEW PRIOR TO PLACING SLABS.

16. COLUMN AND WALL FOOTINGS NOTED WITH AN ASTERISK (*) ARE NOT REQUIRED TO BEAR ON AGGREGATE PIERS. REFERENCE NOTES ON S001 AND SPECIFICATIONS.

17. PLAN LEGEND:

S4

TI/SLAB = 0'-0"

S5

TI/SLAB = 0'-0"

S6

TI/SLAB = 0'-0"

F.F.

DENOTES FINISH FLOOR

TFX

DENOTES TOP OF FTG., GRADE BEAM, SLAB, PIER, ETC.

B/X

DENOTES BOTTOM OF FTG., GRADE BEAM, ETC.

WF30'-Z-0"

DENOTES WALL FOOTING MARK & TOP OF FOOTING ELEVATION (SEE WALL FOOTING SCHEDULE)

TF-2'-0"

TF-1'-0"

TF-1'-0"

TF-1'-0"

DENOTES WALL FOOTING WITH STEPS, REF. TYP. DETAIL ON S400

F2.0'-4'-0"

F24'-0'-0"

HSS60x63x8

DENOTES COLUMN FOOTING MARK & TOP OF FTG. ELEVATION (SEE FTG. SCHEDULE)

DENOTES PIER MARK & TOP OF PIER ELEVATION (SEE PIER SCHEDULE)

COLUMN FOOTING

CONCRETE PIER

STEEL COLUMN

CW18

DENOTES C.I.P. CONCRETE WALL MARK

PCW12

DENOTES PRECAST CONCRETE WALL MARK

CLARK-PLEASANT COMMUNITY SCHOOL CORP.
WHITELAND COMM. HIGH SCHOOL PHASE 3
300 E MAIN ST, WHITELAND, IN 46184

REVISIONS:		
#	Date	Desc.
1	07/16/2025	ADDENDUM 1

100% CONSTRUCTION DOCUMENTS
PROJECT: #22130
DATE: 05-30-2025
DRAWN BY: DJL


FOUNDATION
PLAN AND
SECTIONS -
GREENHOUSE

S101GR



LANCER ASSOCIATES
ARCHITECTURE


Lynch,
Harrison &
Grumbeine,
Inc.

427 S. COLLEGE AVE
INDIANAPOLIS, IN 46203

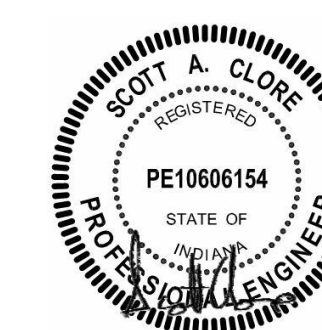

- ① TEMPORARY UTILITY MAY BE SLEEVED UNDER FOOTING PER 12/S400.
- ② RECESS/SLOPE SLAB FOR LONG JUMP PIT AND POLE VAULT PIT PER TYPICAL DETAILS ON S401 COORDINATE WITH EQUIPMENT SUPPLIER.
- ③ NEW 12" CMU TO BE TOOTHED INTO EX. 12" CMU WALL FULL HEIGHT. BOND BEAM REINFORCING TO BE DOWELED INTO EX. CMU MIN. 12" EMBEDMENT USING HILTI-HY 270.
- ④ PROVIDE RIGID ANCHORS AT COLUMN TO CMU PER 15/S500 @ 32" o.c.
- ⑤ 10" CMU WALL TO HAVE #6 BARS @ 24" o.c.

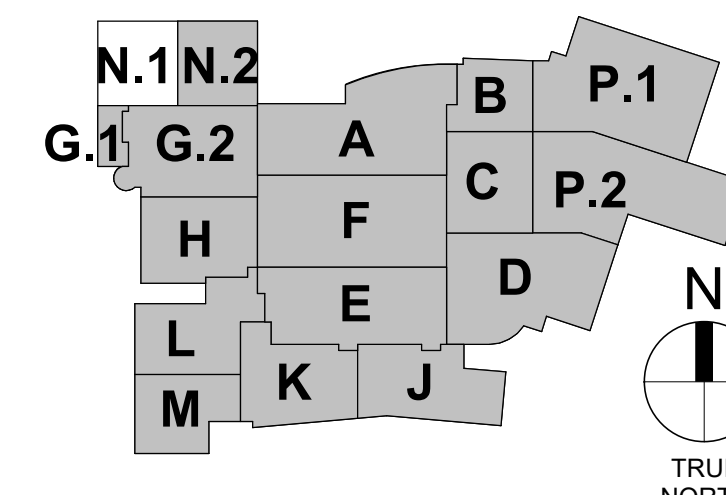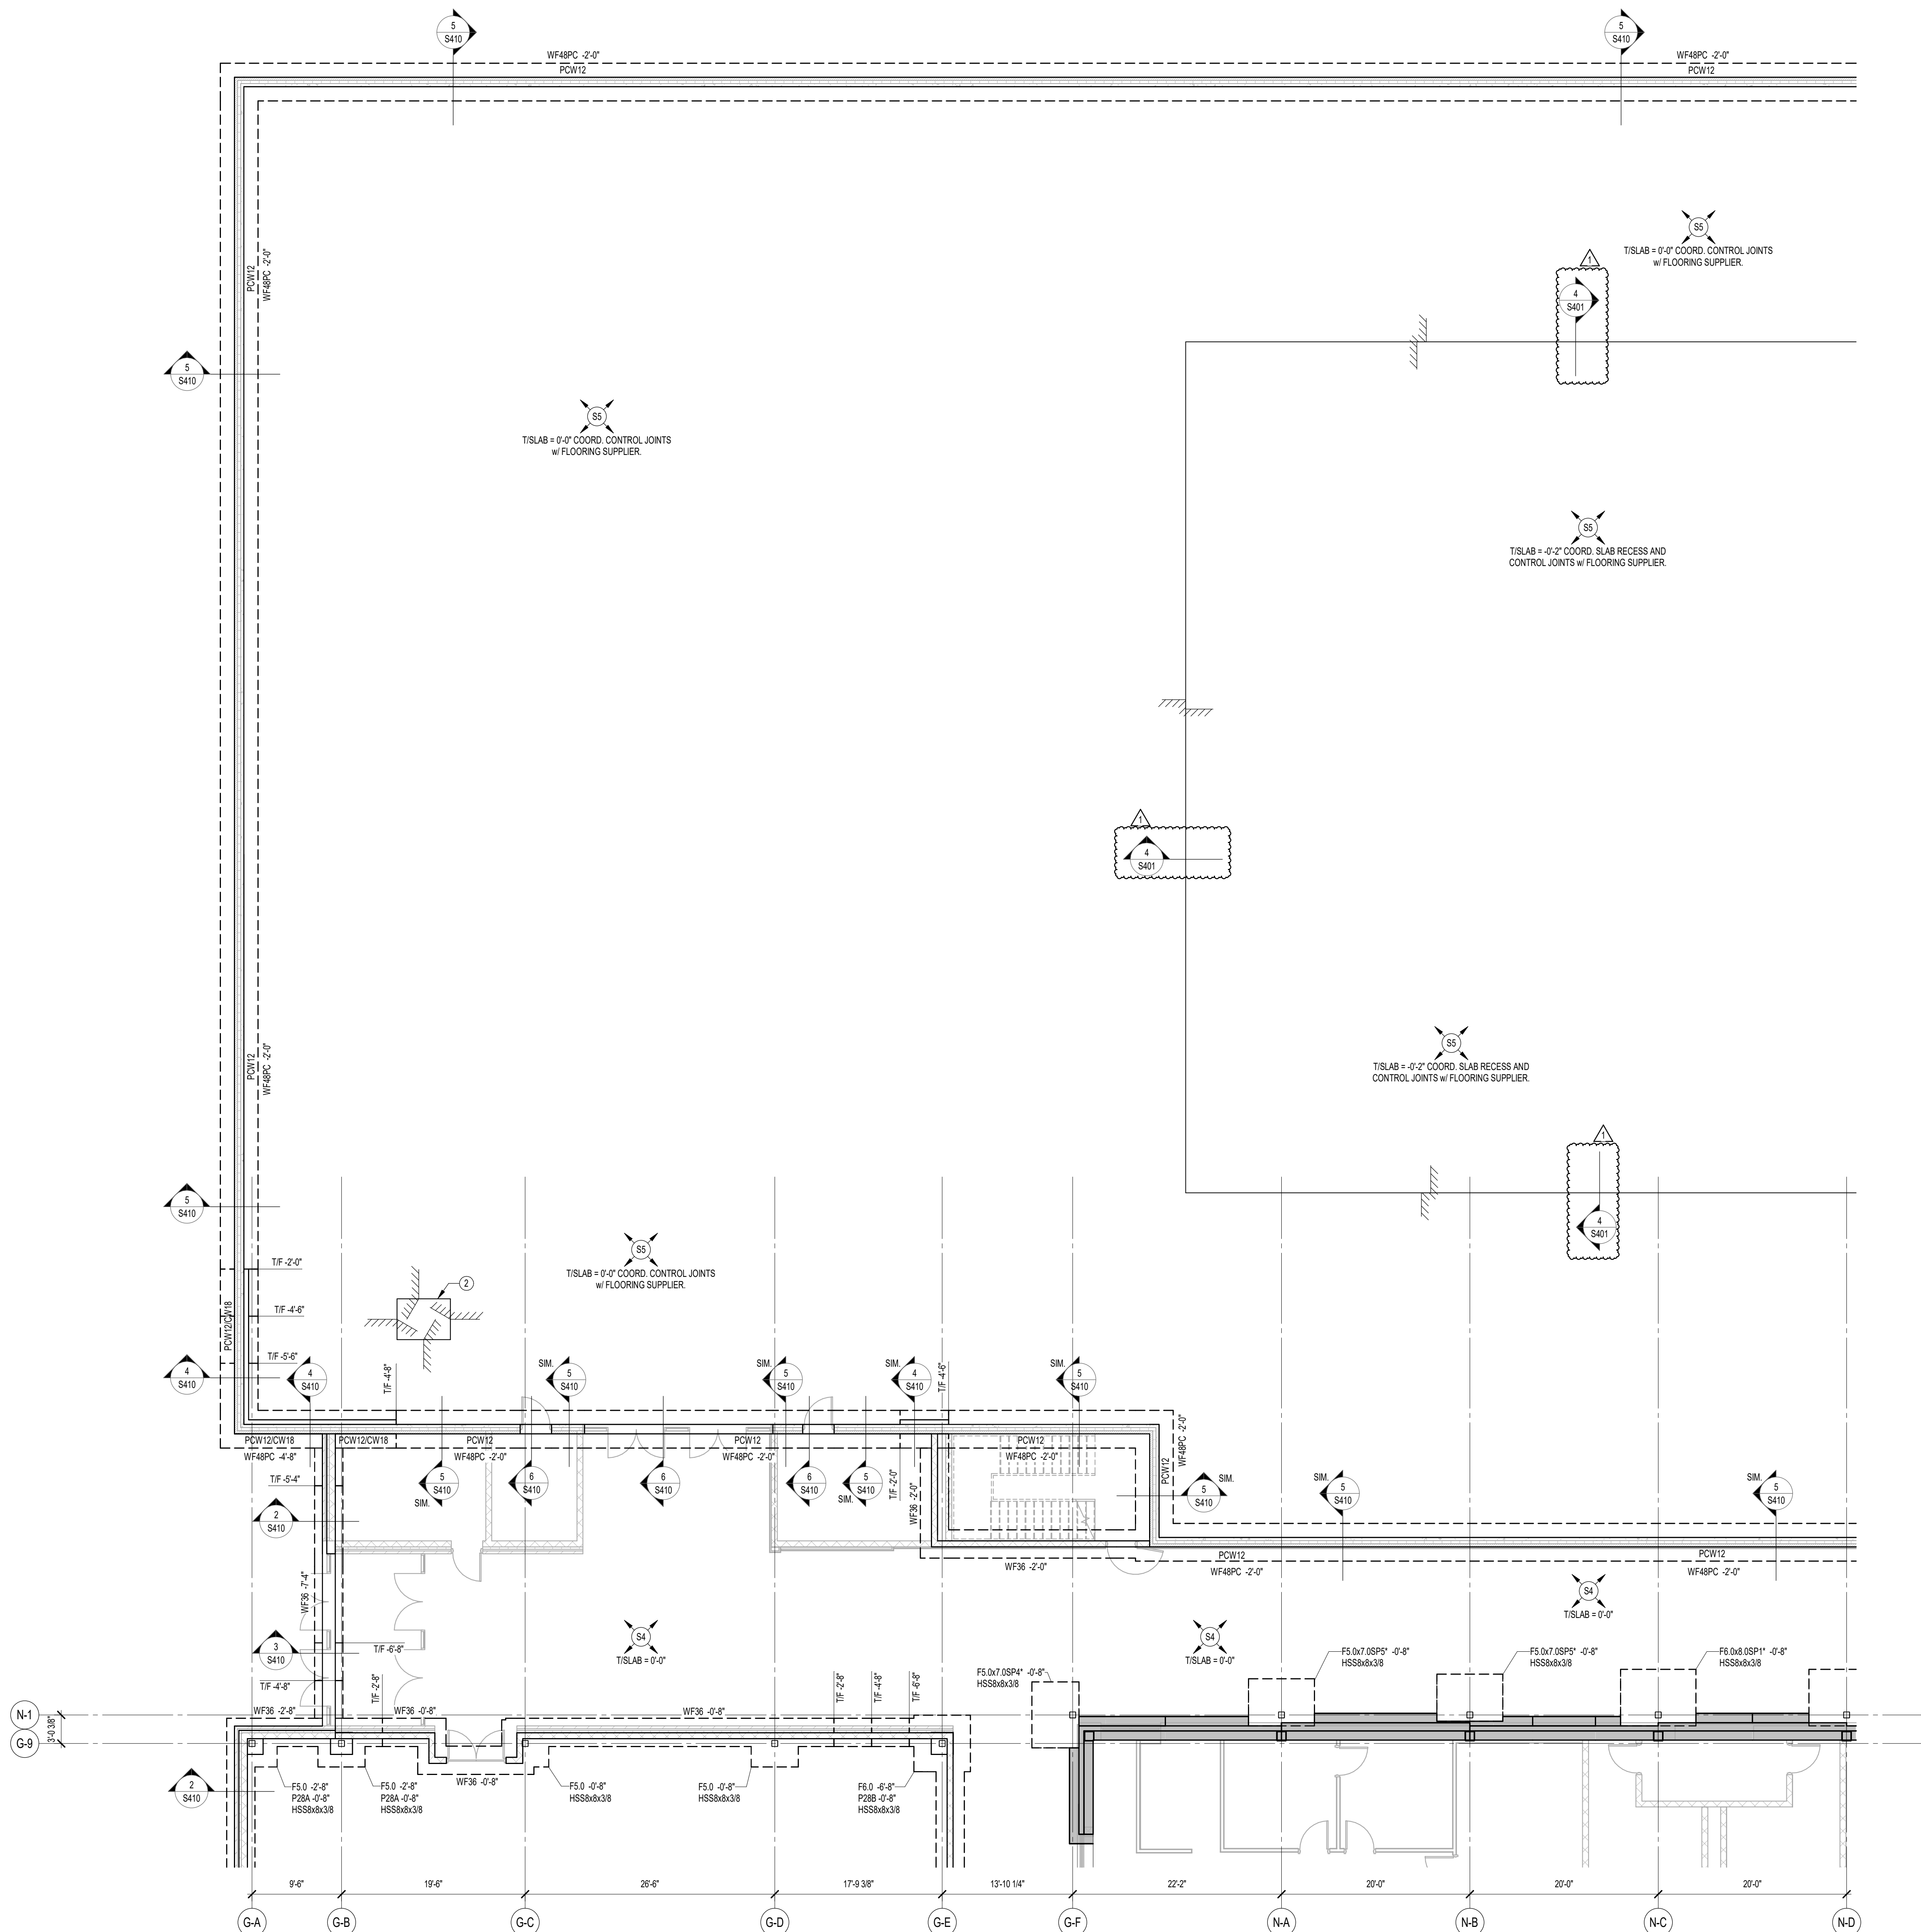

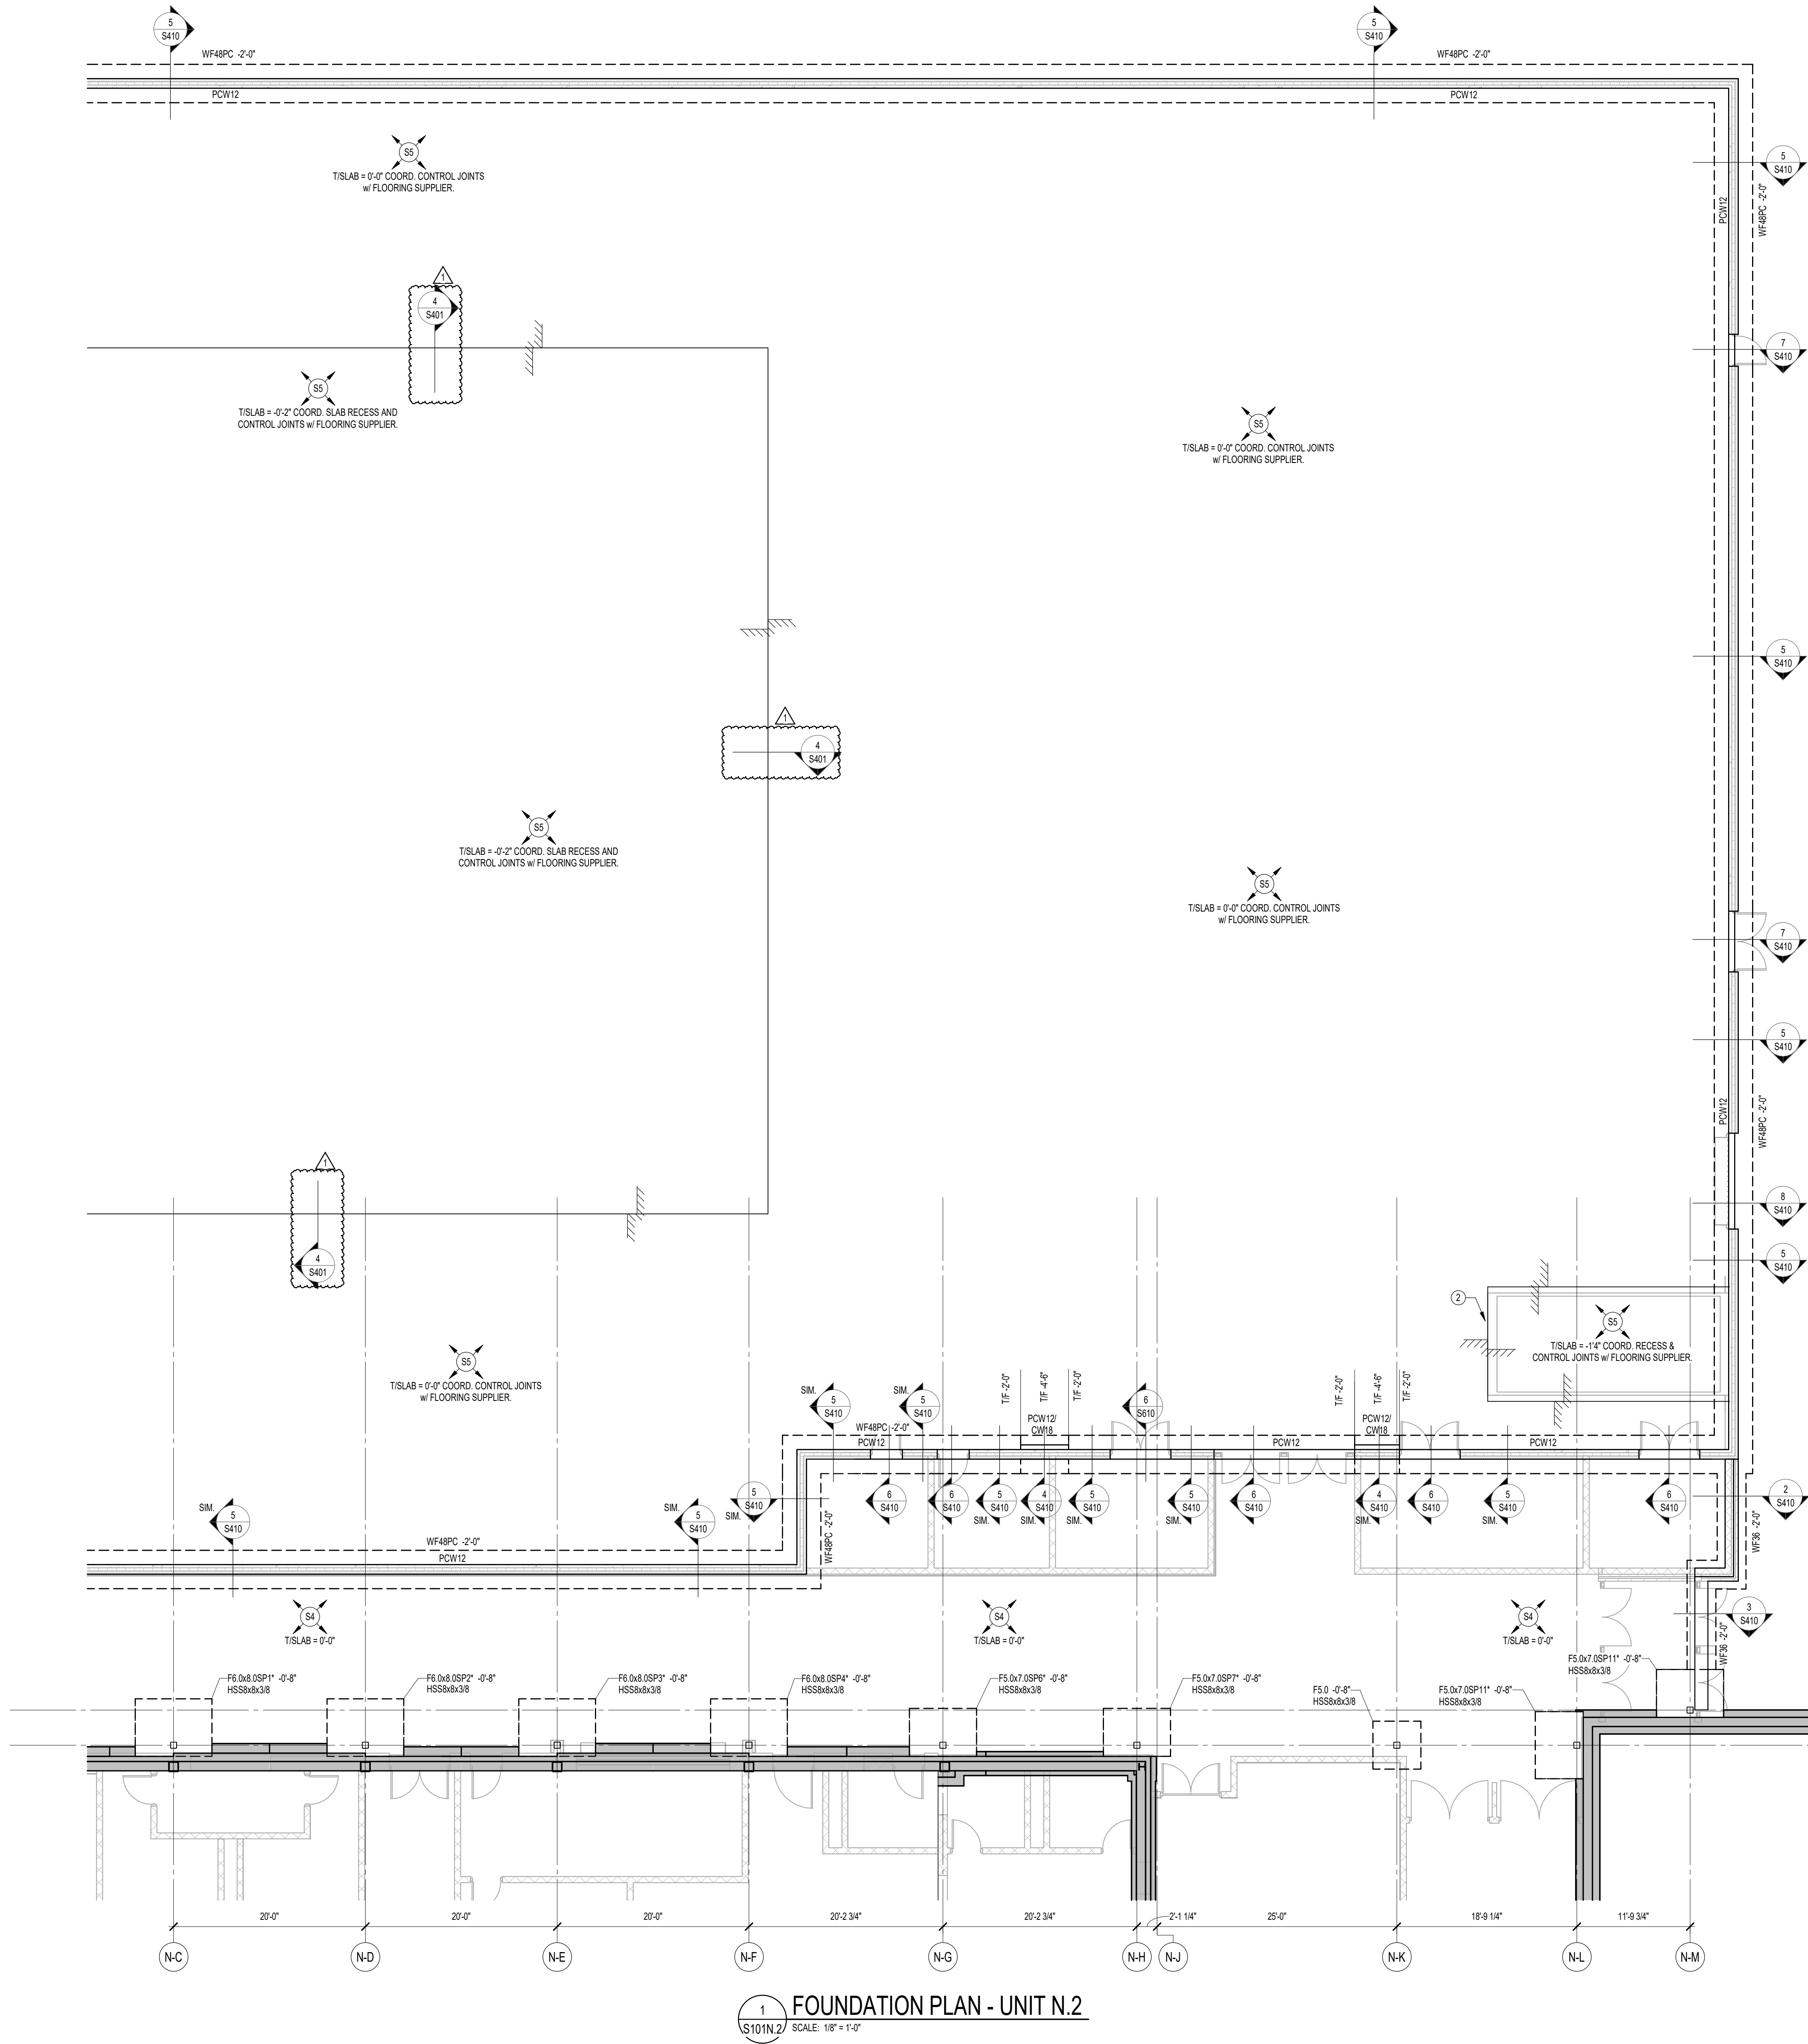

1 FOUNDATION PLAN - UNIT N.2
SCALE: 1/8" = 1'-0"


FOUNDATION PLAN NOTES

- REF. S001 & S002 FOR STRUCTURAL NOTES, DESIGN DATA & SCHEDULES.
- ALL CONTRACTORS ARE REQUIRED TO COORDINATE THEIR WORK WITH ALL DISCIPLINES TO AVOID CONFLICTS. THE MECHANICAL, ELECTRICAL, PLUMBING, ETC. ASPECTS ARE NOT IN THE SCOPE OF THESE DRAWINGS. THEREFORE, ALL REQUIRED MATERIALS AND WORK MAY NOT BE INDICATED.
- COORDINATE EXACT SIZE & LOCATION OF ALL OPENINGS IN FOUNDATION WALLS WITH THE MECHANICAL, ELECTRICAL, PLUMBING, ETC. CONTRACTORS.
- ALL ELEVATIONS ARE REFERENCED FROM THE FIRST FLOOR FINISH FLOOR ELEVATION 0'-0". REF. CIVIL DWGS. FOR USGS ELEVATION.
- REF. ARCH. DRAWINGS FOR ALL DIMENSIONS NOT SHOWN. CONTRACTOR SHALL VERIFY ALL DIMENSIONS PRIOR TO CONSTRUCTION AND IMMEDIATELY NOTIFY ARCHITECT/ENGINEER OF ANY DISCREPANCIES.
- REF. S400 & S401 FOR TYPICAL FOUNDATION DETAILS.
- ALL WALL AND COLUMN FOOTINGS SHALL BE LOWERED TO PASS BELOW UNDERGROUND UTILITIES (I.E. SANITARY & STORM SEWERS, WATER LINES, ETC.). THESE LINES HAVE BEEN SHOWN IN THE APPROXIMATE LOCATIONS ON THE CONTRACT DOCUMENTS AND NEED TO BE COORDINATED BY THE CONTRACTORS. PROVIDE FOOTING STEPS AS REQUIRED PER THE TYPICAL DETAILS ON S400.
- ALL SLAB RECESSES AND SLOPES SHALL BE LOCATED PER THE ARCHITECTURAL DRAWINGS. COORDINATE DEPTHS OF ALL SLAB RECESSES WITH THE ARCHITECTURAL DRAWINGS AND/OR THE FLOORING SUPPLIER.
- COORDINATE REINFORCING DOVELS FOR CMU VERTICAL REINFORCING WITH REINF. NOTED ON PLANS & SECTIONS.
- GROUT ALL CORES OF CMU BELOW FINISH FLOOR SOLID.
- COLUMN FOOTINGS, TRENCH FOOTINGS AND WALL FOOTINGS SHALL BEAR ON APPROVED SOIL. UNDERCUT AS REQ'D TO SUITABLE BEARING MATERIAL AS DETERMINED BY THE GEOTECHNICAL TESTING AGENCY. REF. TYPICAL FOOTING UNDERCUT DETAIL ON S400.
- COLUMN FOOTINGS SUPPORTING MORE THAN ONE COLUMN SHALL BE CENTERED AT THE MIDPOINT BETWEEN THE COLUMNS, UNLESS NOTED OTHERWISE ON PLAN.
- ALL EX. CONSTRUCTION SHOWN IN PLAN AND/OR SECTION WAS DERIVED FROM EXISTING DRAWINGS AND MUST BE FIELD VERIFIED. IF ANY DISCREPANCIES ARE DISCOVERED BETWEEN INFO. SHOWN ON THE DRAWINGS AND ACTUAL CONDITIONS IMMEDIATELY CONTACT ARCHITECT/ENGINEER FOR DIRECTION BEFORE PROCEEDING WITH THE WORK.
- PROVIDE THICKENED SLAB UNDER ALL INTERIOR CMU WALLS WITHOUT FOOTINGS. SEE 401 FOR THICKENED SLAB DETAIL. LAYOUT THICKENED SLABS FROM DIMENSIONS ON THE ARCHITECT FLOOR PLANS.
- PROVIDE CONTROL/CONTRACTION JOINTS IN SLABS ON GRADE. (REF. THE TYPICAL DETAILS ON SHEET S400). ALL JOINTS IN SLABS TO RECEIVE THIN OR THICK-SET TERRAZZO, CERAMIC OR PORCELAIN TILE, VINYL-COMPOSITION TILE (VCT) OR VINYL SHEET GOODS, EPOXY OR SIMILAR THIN-FILM FINISH FLOORING SHALL BE CAREFULLY COORDINATED WITH THE FLOORING CONTRACTOR. THE CONTRACTOR SHALL SUBMIT SLAB JOINT LAYOUT TO ARCHITECT/ENGINEER FOR REVIEW PRIOR TO PLACING SLABS.
- COLUMN AND WALL FOOTINGS NOTED WITH AN ASTERISK (*) ARE NOT REQUIRED TO BEAR ON AGGREGATE PIERS. REFERENCE NOTES ON S001 AND SPECIFICATIONS.
- PLAN LEGEND:


	DENOTES 4' CONC. SLAB-ON-GRADE w/ FIBERFORCE 300 @ 1.5LB/CY (OR APPROVED EQUAL) & ES SYSTEM CONSISTING OF: ES INTERNAL CURE @ 40ZCWT & ES CATALYST SPRAY ON BETWEEN 800-1500 SF/GAL OVER 15-MILL CLASS A VAPOR BARRIER OVER 6" COMPACTED GRANULAR FILL (INDOT No. 53)
	DENOTES 5' CONC. SLAB-ON-GRADE w/ FIBERFORCE 300 @ 1.5LB/CY (OR APPROVED EQUAL) & ES SYSTEM CONSISTING OF: ES INTERNAL CURE @ 40ZCWT & ES CATALYST SPRAY ON BETWEEN 800-1500 SF/GAL OVER 15-MILL CLASS A VAPOR BARRIER OVER 6" COMPACTED GRANULAR FILL (INDOT No. 53)
	DENOTES 6' CONC. SLAB-ON-GRADE w/ FIBERFORCE 750 @ 1.5LB/CY (OR APPROVED EQUAL) & ES SYSTEM CONSISTING OF: ES INTERNAL CURE @ 40ZCWT & ES CATALYST SPRAY ON BETWEEN 800-1500 SF/GAL OVER 15-MILL CLASS A VAPOR BARRIER OVER 6" COMPACTED GRANULAR FILL (INDOT No. 53)
F.F.	DENOTES FINISH FLOOR
T/X	DENOTES TOP OF FTG., GRADE BEAM, SLAB, PIER, ETC.
B/X	DENOTES BOTTOM OF FTG., GRADE BEAM, ETC.
WF30-Z-0'	DENOTES WALL FOOTING MARK & TOP OF FOOTING ELEVATION (SEE WALL FOOTING SCHEDULE)
	DENOTES WALL FOOTING WITH STEPS, REF. TYP. DETAIL ON S400
	DENOTES COLUMN FOOTING MARK & TOP OF FTG. ELEVATION (SEE FTG. SCHED.) DENOTES PIER MARK & TOP OF PIER ELEVATION (SEE PIER SCHED.)
	COLUMN FOOTING CONCRETE PIER STEEL COLUMN
CW18	DENOTES C.I.P. CONCRETE WALL MARK
PCW12	DENOTES PRECAST CONCRETE WALL MARK

KEYED NOTES - FOUNDATIONS

- TEMPORARY UTILITY MAY BE SLEEVED UNDER FOOTING PER 12S400.
- RECESS/SLOPE SLAB FOR LONG JUMP PIT AND POLE VAULT PIT PER TYPICAL DETAILS ON S401. COORDINATE WITH EQUIPMENT SUPPLIER.
- NEW 12" CMU TO BE TOOTHED INTO EX. 12" CMU WALL FULL HEIGHT. BOND BEAM REINFORCING TO BE DOWELED INTO EX. CMU MIN. 12" EMBEDMENT USING HLTH-Y 270.
- PROVIDE RIGID ANCHORS AT COLUMN TO CMU PER 15S500 @ 32" o.c.
- 10" CMU WALL TO HAVE #6 BARS @ 24" o.c.

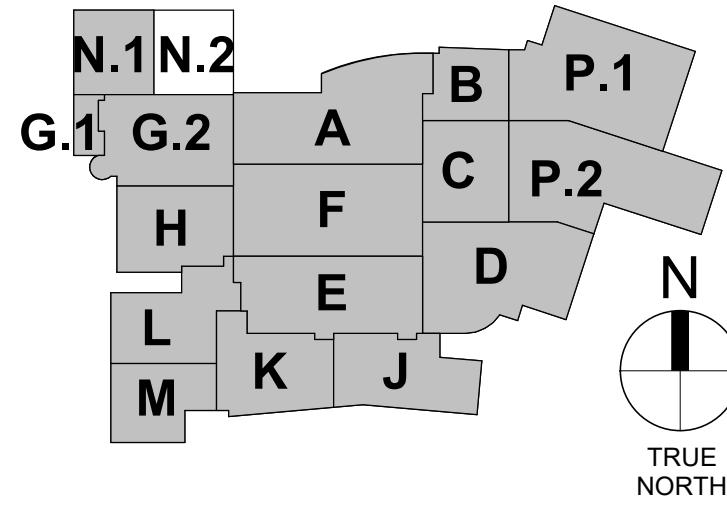

CLARK-PLEASANT COMMUNITY SCHOOL CORP.
WHITELAND COMM. HIGH SCHOOL PHASE 3
300 E MAIN ST, WHITELAND, IN 46184

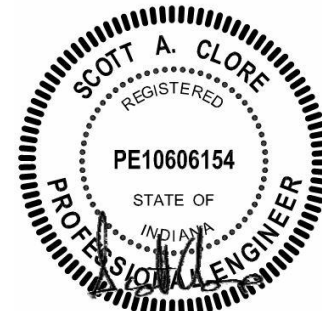

REVISIONS:	DATE	DESCRIPTION
1	07/16/2022	ADDENDUM 1


100% CONSTRUCTION DOCUMENTS

PROJECT:	#22130
DATE:	05-30-2025
DRAWN BY:	D.J.L.

FOUNDATION PLAN - UNIT N.2

S101N.2


LANCER ASSOCIATES
ARCHITECTURE
427 S. COLLEGE AVE
INDIANAPOLIS, IN 46203

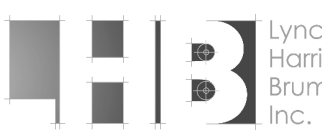

PLT DATE/TIME: 07/23/2025 8:47:59 AM

2 JOIST REINFORCING DETAILS

S102A SCALE: 3/4" = 1'-0"

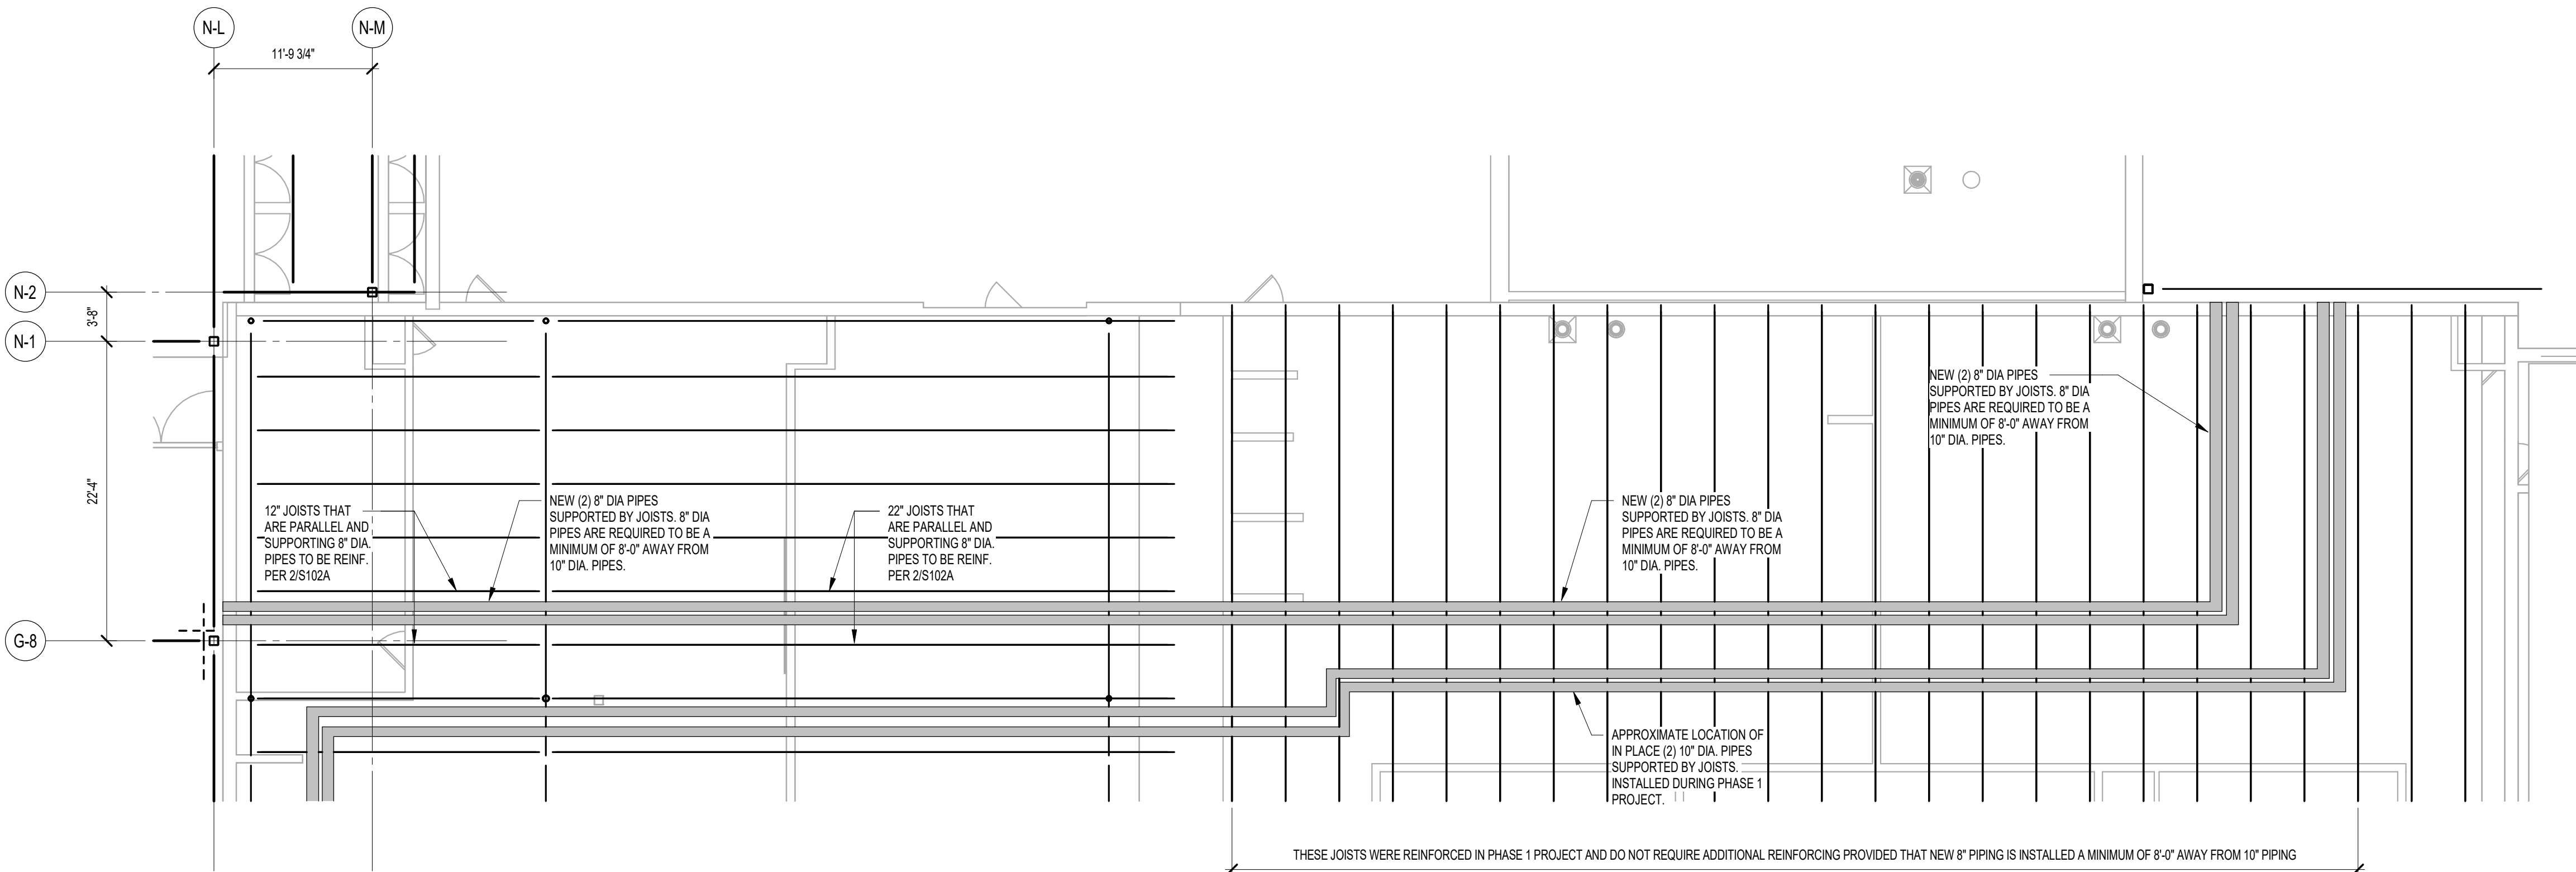

1 EX. LOW ROOF FRAMING PLAN - UNIT A

S102A SCALE: 1/8" = 1'-0"

FRAMING PLAN NOTES

- REF. S001 & S002 FOR STRUCTURAL NOTES, DESIGN DATA, SCHEDULES & LEGENDS.
- ALL CONTRACTORS ARE REQUIRED TO COORDINATE THEIR WORK WITH ALL DISCIPLINES TO AVOID CONFLICTS. THE MECHANICAL, ELECTRICAL, PLUMBING, ETC. ASPECTS ARE NOT IN THE SCOPE OF THESE DRAWINGS. THEREFORE, ALL REQUIRED MATERIALS AND WORK MAY NOT BE INDICATED.
- ALL ELEVATIONS ARE REFERENCED FROM THE FIRST FLOOR FIN. FLOOR ELEVATION +0'-0". COORD. LESS ELEVATION WITH CIVIL DWGS.
- SEE FOUNDATION PLANS FOR SIZES OF STEEL COLUMNS SUPPORTED ON FOUNDATIONS.
- REF. S000 & S001 FOR TYPICAL MASONRY DETAILS.
- REF. S000 & S001 FOR TYPICAL CONNECTION & FRAMING DETAILS.
- INSTALL CONTINUOUS BENT PLATE/ANGLE POUR STOPS AT ALL ELEVATED SLAB-ON-DECK PERIMETER EDGES AND AROUND ALL INTERIOR FLOOR OPENINGS (BOTH SHOWN AND NOT SHOWN). SEE DETAIL S000.
- INSTALL CONTINUOUS ANGLES AT ALL PERIMETER ROOF EDGES. SEE DETAIL 11 & 12 ON S000 FOR ATTACHMENT TO BEAM AND FOR ALL CONDITIONS NOT SPECIFICALLY DEFINED IN FRAMING SECTIONS.
- ALL WALLS SHALL BE LAID OUT FROM THE ARCHITECTURAL DRAWINGS.
- REF. ARCH. DRAWINGS FOR ALL DIMENSIONS NOT SHOWN. CONTRACTOR SHALL VERIFY ALL DIMENSIONS PRIOR TO CONSTRUCTION AND IMMEDIATELY NOTIFY ARCHITECT/ENGINEER OF ANY DISCREPANCIES.
- COORDINATE EXACT SIZE & LOCATION OF ANY MECHANICAL OPENINGS IN FLOOR SLAB, ROOF DECK, OR WALLS WITH THE MEP CONTRACTOR(S). LOCATION & SIZE OF ALL DUCT OPENINGS, GRILLES, ETC. SHALL BE VERIFIED PRIOR TO CONSTRUCTION.
- ALL ELEVATIONS SHOWN ON PLAN INDICATE TOP OF STEEL BEAM UNLESS NOTED OTHERWISE.
- PROVIDE CHANNEL FRAMES AT ALL SUPPORTED SLAB OPENINGS PER TYPICAL DETAIL ON S000. COORDINATE EXACT NUMBER, LOCATIONS & DIMENSIONS WITH THE APPROPRIATE CONTRACTORS & THE ARCH. & MEP DRAWINGS.
- PROVIDE FRAMES AT ALL ROOF DRAINS, ROOF HATCHES & OTHER ROOF OPENINGS PER TYPICAL DETAILS ON S000. COORD. EXACT NUMBER, LOCATIONS & DIMENSIONS WITH THE APPROPRIATE CONTRACTORS & THE ARCH. & MEP DWGS.
- ALL MASONRY BOND BEAMS, OTHER THAN BOND BEAM LINTELS OVER OPENINGS, SHALL BE "OPEN CORE" BOND BEAMS TO ALLOW VERTICAL REINFORCING TO PASS THROUGH, UNLESS NOTED OTHERWISE.
- REF. ARCH. DWGS. FOR MASONRY CONTROL & EXPANSION JOINT LOCATIONS.
- ALL HORIZONTAL AND DIAGONAL BRIDGING FOR STEEL JOISTS SHALL BE DESIGNED, LOCATED & PROVIDED BY THE JOIST SUPPLIER PER SJI SPECIFICATIONS.
- FOR ESTIMATING AND BIDDING PURPOSES ONLY, ASSUME AN ADDITIONAL 1/2" THICKNESS OF CONCRETE WILL BE NECESSARY FOR ALL ELEVATED SLABS ON METAL DECK. THE INTENT OF THIS REQUIREMENT IS TO ACCOUNT FOR ANTICIPATED DEAD LOAD DEFLECTIONS IN THE SUPPORTING STRUCTURE. THE FINISHED SLAB SHALL MEET THE FLATNESS REQUIREMENTS DEFINED IN THE SPECIFICATION.
- PLAN LEGEND

F.F. DENOTES FIN. FLOOR

T/X DENOTES TOP OF STEEL, SLAB, ETC.

B/X DENOTES BOTTOM OF LINTEL, ETC.

CSS DENOTES 2" 18 GA. COMPOSITE DECK W/ 3/16" MM CONC. SLAB W/ 6#6-W2 1-W2 1 WWF, TOTAL 'Y' = 5/16". REF. DETAIL 1800.

R18 DENOTES 1 1/2", 20 GA. WIDE RIB STEEL ROOF DECK. REF. DETAIL 2/S000.

R15A DENOTES 1 1/2", 20 GA. WIDE RIB ACOUSTICAL STEEL ROOF DECK. REF. DETAIL 3/S000.

RD2A DENOTES 2" 18 GA. ACOUSTICAL DOVETAIL STEEL ROOF DECK. REF. DETAIL 4/S000.

● DENOTES BEAM-THRU-BEAM MOMENT CONNECTION. REF. DETAILS ON S001.


--- DENOTES BRACED FRAME OR KNEE BRACE LOCATION

⊠ DENOTES APPROX. LOCATION OF OPENING IN DECK/SLAB. REF. TYPICAL DETAILS FOR TYPICAL OPENING FRAMES. FOR MULTIPLE CLOSELY SPACED OPENINGS, TREAT AS ONE LARGE OPENING.

23. WIDE-FLANGE BEAM & GIRDER NOTATION:

BEAM REACTIONS SHOWN IN KIPS TO BE USED FOR DESIGN OF SHEAR CONNECTION BY STEEL FABRICATOR'S SSE. LOADS SHOWN ARE FACTORED (LRFD).

REF. THE STEEL CONNECTION NOTES ON S001 FOR DESIGN OF CONNECTIONS AT BEAMS & GIRDERS WITH NO REACTION SHOWN. THE MIN. SHEAR CONNECTION DESIGN LOAD SHALL BE 25 KIPS.

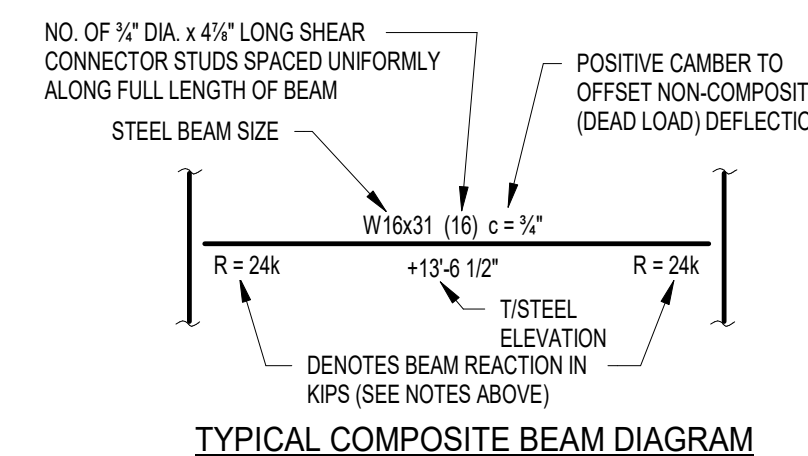

CLARK-PLEASANT COMMUNITY SCHOOL CORP. WHITELAND COMM. HIGH SCHOOL PHASE 3 300 E MAIN ST, WHITELAND, IN 46184




REVISIONS:		
#	Date	Desc.
2	07/23/2025	ADDENDUM 2


100% CONSTRUCTION DOCUMENTS

PROJECT: #22130
DATE: 05-30-2025
DRAWN BY: DJL


EX. LOW ROOF FRAMING PLAN - UNIT A

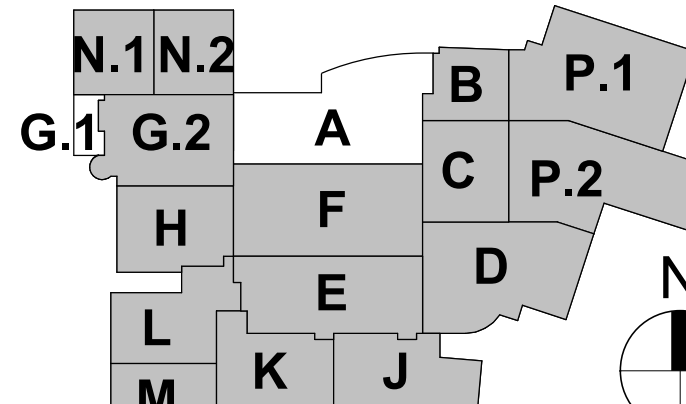

S102A

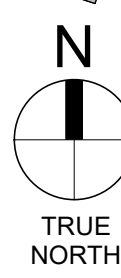

TRUE NORTH

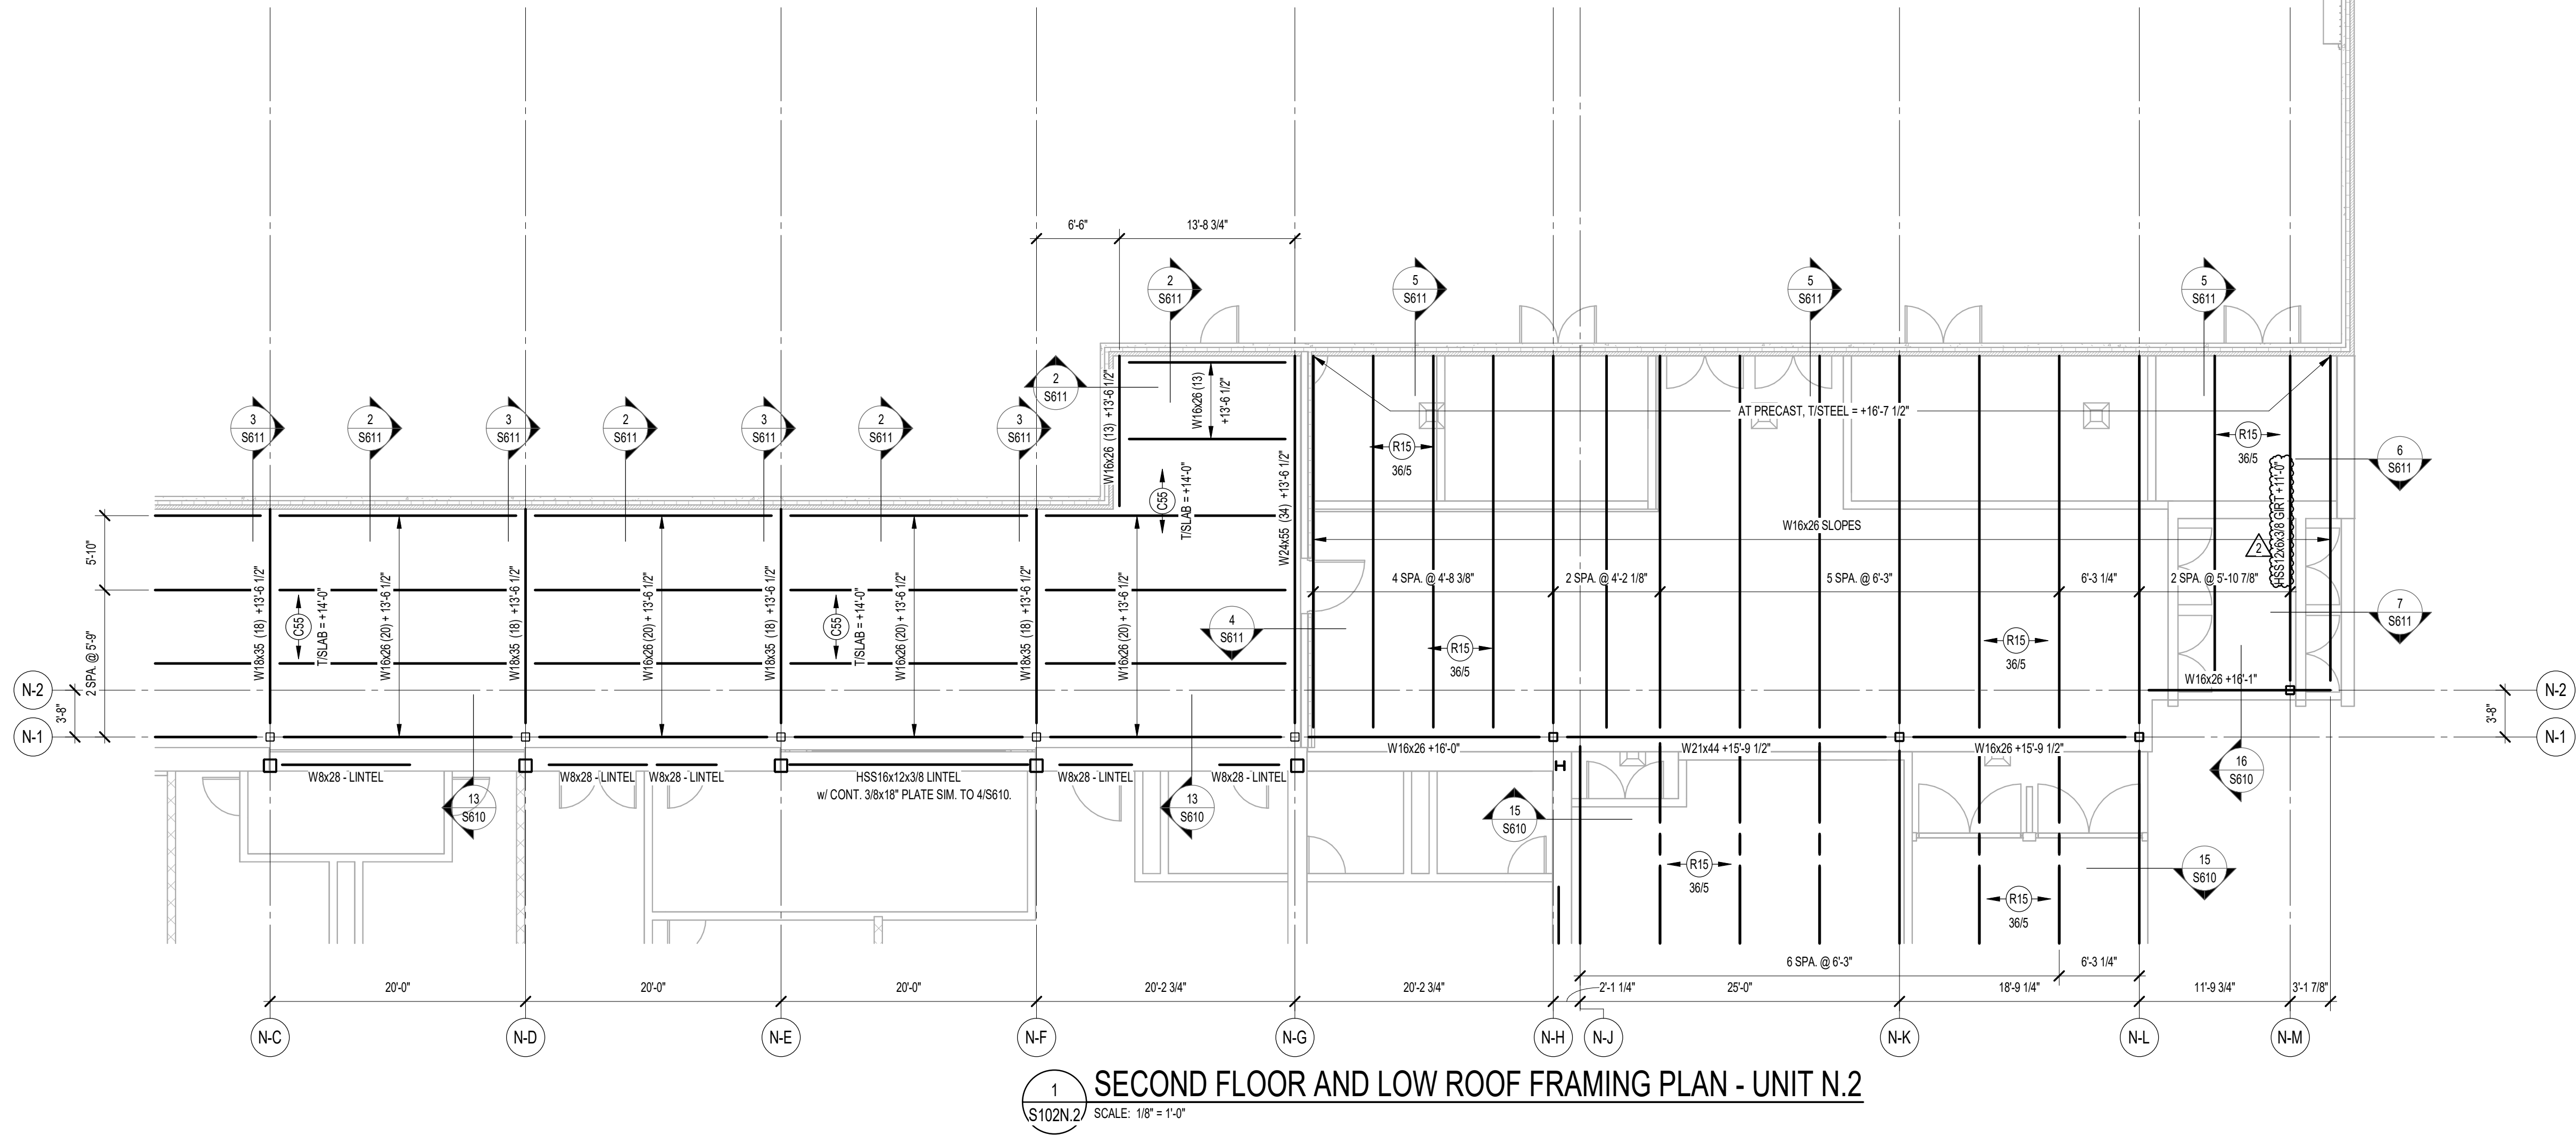

1
S102N.2
SECOND FLOOR AND LOW ROOF FRAMING PLAN - UNIT N.2
SCALE: 1/8" = 1'-0"

FRAMING PLAN NOTES

1. REF. S001 & S002 FOR STRUCTURAL NOTES, DESIGN DATA, SCHEDULES & LEGENDS.

2. ALL CONTRACTORS ARE REQUIRED TO COORDINATE THEIR WORK WITH ALL DISCIPLINES TO AVOID CONFLICTS. THE MECHANICAL, ELECTRICAL, PLUMBING, ETC. ASPECTS ARE NOT IN THE SCOPE OF THESE DRAWINGS. THEREFORE, ALL REQUIRED MATERIALS AND WORK MAY NOT BE INDICATED.

3. ALL ELEVATIONS ARE REFERENCED FROM THE FIRST FLOOR FIN. FLOOR ELEVATION +0'-0". COORD. USGS ELEVATION WITH CIVIL DWGS.

4. SEE FOUNDATION PLANS FOR SIZES OF STEEL COLUMNS SUPPORTED ON FOUNDATIONS.

5. REF. S000 & S001 FOR TYPICAL MASONRY DETAILS.

6. REF. S000 & S001 FOR TYPICAL CONNECTION & FRAMING DETAILS.

7. INSTALL CONTINUOUS BENT PLATE/ANGLE POUR STOPS AT ALL ELEVATED SLAB-ON-DECK PERIMETER EDGES AND AROUND ALL INTERIOR FLOOR OPENINGS (BOTH SHOWN AND NOT SHOWN). SEE DETAIL S0800.

8. INSTALL CONTINUOUS ANGLES AT ALL PERIMETER ROOF EDGES. SEE DETAIL 11 & 12 ON S000 FOR ATTACHMENT TO BEAM AND FOR ALL CONDITIONS NOT SPECIFICALLY DEFINED IN FRAMING SECTIONS.

9. ALL WALLS SHALL BE LAID OUT FROM THE ARCHITECTURAL DRAWINGS.

10. REF. ARCH. DRAWINGS FOR ALL DIMENSIONS NOT SHOWN. CONTRACTOR SHALL VERIFY ALL DIMENSIONS PRIOR TO CONSTRUCTION AND IMMEDIATELY NOTIFY ARCHITECT/ENGINEER OF ANY DISCREPANCIES.

11. COORDINATE EXACT SIZE & LOCATION OF ANY MECHANICAL OPENINGS IN FLOOR SLAB, ROOF DECK, OR WALLS WITH THE MEP CONTRACTOR(S). LOCATION & SIZE OF ALL DUCT OPENINGS, GRILLES, ETC. SHALL BE VERIFIED PRIOR TO CONSTRUCTION.

12. ALL ELEVATIONS SHOWN ON PLAN INDICATE TOP OF STEEL BEAM UNLESS NOTED OTHERWISE.

13. PROVIDE CHANNEL FRAMES AT ALL SUPPORTED SLAB OPENINGS PER TYPICAL DETAIL ON S000. COORDINATE EXACT NUMBER, LOCATIONS & DIMENSIONS WITH THE APPROPRIATE CONTRACTORS & THE ARCH. & MEP DRAWINGS.

14. PROVIDE FRAMES AT ALL ROOF DRAINS, ROOF HATCHES & OTHER ROOF OPENINGS PER TYPICAL DETAILS ON S000. COORD. EXACT NUMBER, LOCATIONS & DIMENSIONS WITH THE APPROPRIATE CONTRACTORS & THE ARCH. & MEP DWGS.

15. ALL MASONRY BOND BEAMS, OTHER THAN BOND BEAM LINTELS OVER OPENINGS, SHALL BE "OPEN-CORE" BOND BEAMS TO ALLOW VERTICAL REINFORCING TO PASS THROUGH, UNLESS NOTED OTHERWISE.

16. REF. ARCH. DWGS. FOR MASONRY CONTROL & EXPANSION JOINT LOCATIONS.

17. ALL HORIZONTAL AND DIAGONAL BRIDGING FOR STEEL JOISTS SHALL BE DESIGNED, LOCATED & PROVIDED BY THE JOIST SUPPLIER PER SJI SPECIFICATIONS.

18. FOR ESTIMATING AND BIDDING PURPOSES ONLY, ASSUME AN ADDITIONAL 1/2" THICKNESS OF CONCRETE WILL BE NECESSARY FOR ALL ELEVATED SLABS ON METAL DECK. THE INTENT OF THIS REQUIREMENT IS TO ACCOUNT FOR ANTICIPATED DEAD LOAD DEFLECTIONS IN THE SUPPORTING STRUCTURE. THE FINISHED SLAB SHALL MEET THE FLATNESS REQUIREMENTS DEFINED IN THE SPECIFICATION.

19. PLAN LEGEND

F.F.

DENOTES FIN. FLOOR

T/X

DENOTES TOP OF STEEL, SLAB, ETC.

B/X

DENOTES BOTTOM OF LINTEL, ETC.

CSS

DENOTES 2" 18 GA. COMPOSITE DECK W/ 3/4" MH CONC. SLAB W/ 6#6-W2.1-W2.1 WWF, TOTAL Y = 5/2". REF. DETAIL 1800.

R15

DENOTES 1 1/2", 20 GA. WIDE RIB STEEL ROOF DECK. REF. DETAIL 2/S000.

R15A

DENOTES 1 1/2", 20 GA. WIDE RIB ACOUSTICAL STEEL ROOF DECK. REF. DETAIL 3/S000.

RD2A

DENOTES 2" 18 GA. ACOUSTICAL DOVETAIL STEEL ROOF DECK. REF. DETAIL 4/S000.

DENOTES BEAM-THRU-BEAM MOMENT CONNECTION. REF. DETAILS ON S001.

DENOTES BRACED FRAME OR KNEE BRACE LOCATION

DENOTES APPROX. LOCATION OF OPENING IN DECK/SLAB. REF. TYPICAL DETAILS FOR TYPICAL OPENING FRAMES. FOR MULTIPLE CLOSELY SPACED OPENINGS, TREAT AS ONE LARGE OPENING.

23. WIDE-FLANGE BEAM & GIRDER NOTATION:

BEAM REACTIONS SHOWN IN KIPS TO BE USED FOR DESIGN OF SHEAR CONNECTION BY STEEL FABRICATOR'S SSE. LOADS SHOWN ARE FACTORED (LRFD).

REF. THE STEEL CONNECTION NOTES ON S001 FOR DESIGN OF CONNECTIONS AT BEAMS & GRIDERS WITH NO REACTION SHOWN. THE MIN. SHEAR CONNECTION DESIGN LOAD SHALL BE 25 KIPS.

NO. OF 1/2" DIA. x 4 1/2" LONG SHEAR CONNECTOR STUDS SPACED UNIFORMLY ALONG FULL LENGTH OF BEAM

STEEL BEAM SIZE

W16x31 (16) c = 14"

POSITIVE CAMBER TO OFFSET NON-COMPOSITE (DEAD LOAD) DEFLECTION

R = 24k

STEEL ELEVATION

DENOTES BEAM REACTION IN KIPS (SEE NOTES ABOVE)

TYPICAL COMPOSITE BEAM DIAGRAM

KEYED NOTES - FRAMING

1

JOIST DESIGNER TO COORD. LOCATIONS AND WEIGHTS OF ATHLETIC CURTAIN AND BASKETBALL GOALS W/ SUPPLIER.

2

KNEE BRACE PER DETAIL 11/S001

3

PROVIDE #5 BARS @ 32" o.c. GROUT STAIR WALLS SOLID.

4

COORD. STAIR ATTACHMENTS, AS NEEDED, WITH PRECAST SUPPLIER.

CLARK-PLEASANT COMMUNITY SCHOOL CORP.

WHITELAND COMM. HIGH SCHOOL PHASE 3

300 E MAIN ST, WHITELAND, IN 46184

LANCER ASSOCIATES

ARCHITECTURE

427 S. COLLEGE AVE

INDIANAPOLIS, IN 46203

PE19066154

DATE OF SIGNATURE

2

REVISIONS:

DATE

DESC.

ADDENDUM 2

100% CONSTRUCTION DOCUMENTS

PROJECT: #22130

DATE: 05-30-2025

DRAWN BY: DJL

SECOND FLOOR AND LOW ROOF FRAMING PLAN

- UNIT N.2

S102N.2



REVISIONS:		
#	Date	Desc.
2	07-23-2023	ADD#2

100% CONSTRUCTION DOCUMENTS		
PROJECT:	#22130	
DATE:	06-06-2025	
DRAWN BY:	Author	

DEMOLITION
PLAN - FIRST
FLOOR - UNIT G

AD101G


GENERAL NOTES: DEMO

- COORDINATE DEMOLITION WORK WITH NEW WORK.
- CLEAN AND PREP SURFACES FOR NEW WORK.
- COORDINATE DEMOLITION WORK WITH MEP WORK.
- OWNER SHALL HAVE FIRST RIGHT OF REFUSAL OF ANY DEMOLISHED DOORS, CASEWORK, MARKERBOARDS, CHALKBOARDS, ETC.


DEMO PORTION OF THE BUILDING COMPLETELY, INCLUDING BUT NOT LIMITED TO WALLS, ROOF, STRUCTURE, FOUNDATIONS, SLAB ETC


NOT IN SCOPE OF WORK

- PLAN NOTES - DEMOLITION**
- REMOVE WALL, AND STOREFRONT TO THE EXTENT INDICATED. PATCH, CLEAN, AND PREPARE SURFACES FOR NEW WORK
 - REMOVE DOOR(S). PATCH, CLEAN, AND PREPARE SURFACES FOR NEW WORK
 - DEMO EXISTING POOL EQUIPMENT INCLUDING BUT NOT LIMITED TO POOL TILE, POOL GUTTER, DRAINS, LADDERS, DIVING BOARDS, SCOREBOARDS, RECORD BOARDS, RAISED BULKHEADS, TILE WALL BASE, WALL BRACKETS, MARKERBOARDS, TACKBOARDS, OVERHEAD SPOTTING RIGS ETC. CLEAN, PATCH, PREP SURFACES FOR NEW WORK
 - DEMO EXISTING CANOPY, CLEAN, PATCH AND PREP SURFACES FOR NEW WORK
 - DEMO EXISTING DOOR AND FRAME. CLEAN, PATCH AND PREP SURFACES FOR NEW WORK
 - DEMO EXISTING CANOPY INCLUDING BUT NOT LIMITED TO THE ROOF, COLUMNS AND FOUNDATIONS. PRESERVE EXISTING METAL SIDING. CLEAN, PATCH AND PREP SURFACES FOR NEW WORK.
 - REMOVE ANY EXTERIOR LIGHTING FIXTURES AND CAMERAS FROM THE FACE OF THE WALL THAT WILL BE THE INTERIOR WALL. PATCH ANY HOLES LEFT BEHIND. CLEAN EXISTING MASONRY, METAL FINISHED AND WINDOWS. PREP SURFACES FOR NEW WORK
 - CUT NEW DOOR OPENING. PATCH, CLEAN, AND PREPARE SURFACES FOR NEW WORK. COORDINATE WORK WITH NEW WORK
 - DEMO WALL MOUNTED LAUNDRY SINK. PATCH, CLEAN, AND PREPARE SURFACES FOR NEW WORK. COORDINATE WORK WITH NEW WORK
 - DEMO EXISTING ROOF, SUPPORTING STRUCTURE, FOUNDATIONS AND SLAB. CLEAN, PREP AND PATCH SURFACES FOR NEW WORK
 - DEMO EXISTING OVERHEAD DOOR. INFILL THE OPENING
 - REMOVE EXISTING CAL WALL WINDOW. PRESERVE THE HEAD LINTEL. PATCH, CLEAN AND PREP SURFACES FOR NEW WORK
 - REMOVE EXISTING BALLAST ON THE ROOF. REMOVE ROOFING MEMBRANE. CLEAN, PATCH, PREP SURFACES FOR NEW WORK
 - REMOVE EXISTING LIMESTONE COPING (ELEVATION OF LIMESTON 8'-0" TO 10'-0" AFF)
 - CUT EXISTING METAL PANELS AS NEEDED TO ABOVE THE NEW ROOF LINE AND ALLOW FOR NEW FLASHING. CLEAN, PATCH AND PREP SURFACES FOR NEW WORK
 - DEMO EXISTING BRICK, INSULATION, WALL TIES UP TO 14'-0". CLEAN, PATCH AND PREP SURFACES FOR NEW WORK. ENSURE THE NEW SLAB CAN GO OVER EXISTING FOUNDATION WALLS LEVEL WITH ADJACENT SLABS
 - DEMO EXISTING PLUMBING FIXTURES PER PLUMBING PLANS. PATCH FINISHES AS NEEDED FOR RE-INSTALLATION OF NEW PLUMBING FIXTURES
 - DEMO EXISTING DIVING BOARDS INCLUDING BUT NOT LIMITED TO POOL TILE, POOL GUTTER, DRAINS, LADDERS, DIVING BOARDS, SCOREBOARDS, RECORD BOARDS, RAISED BULKHEADS, TILE WALL BASE ETC. CLEAN, PATCH, PREP SURFACES FOR NEW WORK
 - DEMO EXISTING LADDERS INCLUDING BUT NOT LIMITED TO POOL TILE, POOL GUTTER, DRAINS, LADDERS, DIVING BOARDS, SCOREBOARDS, RECORD BOARDS, RAISED BULKHEADS, TILE WALL BASE ETC. CLEAN, PATCH, PREP SURFACES FOR NEW WORK
 - DEMO DECK. PATCH FINISHES AS NEEDED FOR NEW WORK
 - REMOVE RAILINGS TO THE EXTENT INDICATED. PATCH, CLEAN, AND PREPARE SURFACES FOR NEW WORK
 - REMOVE STAIRS TO THE EXTENT INDICATED. PATCH, CLEAN, AND PREPARE SURFACES FOR NEW WORK

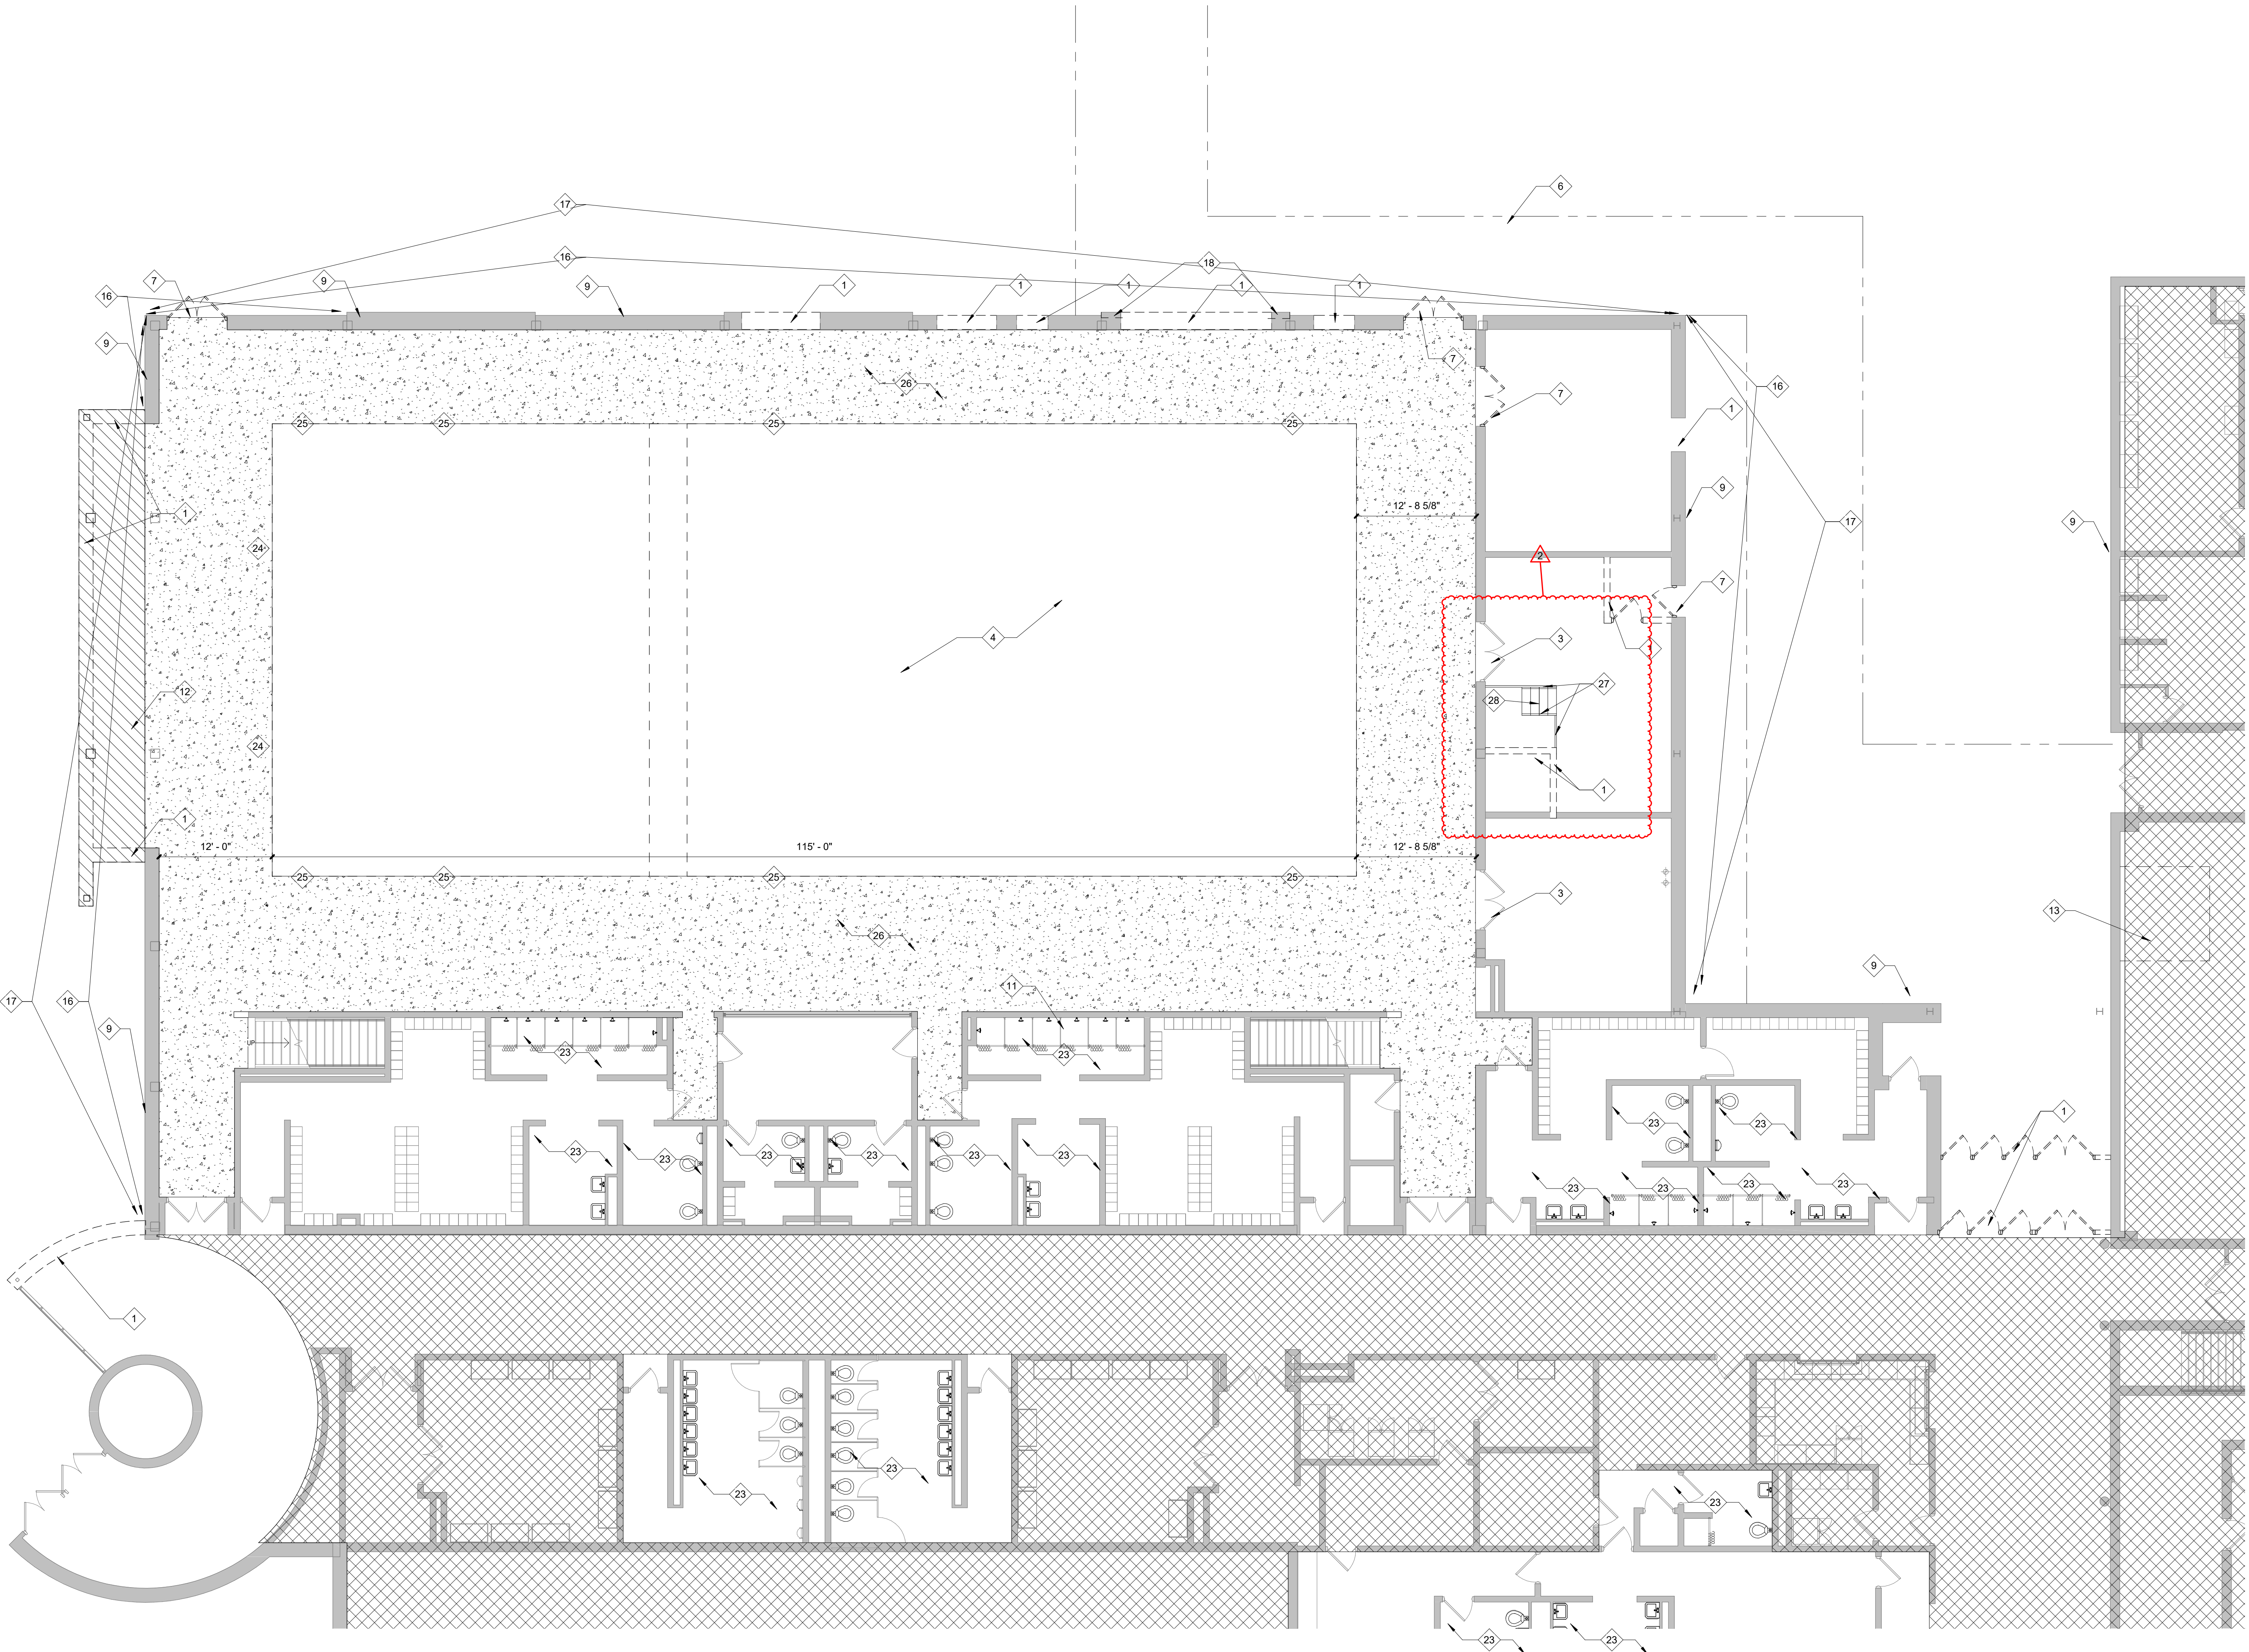


1 DEMOLITION PLAN - FIRST FLOOR - UNIT P.1
SCALE: 1/8" = 1'-0"

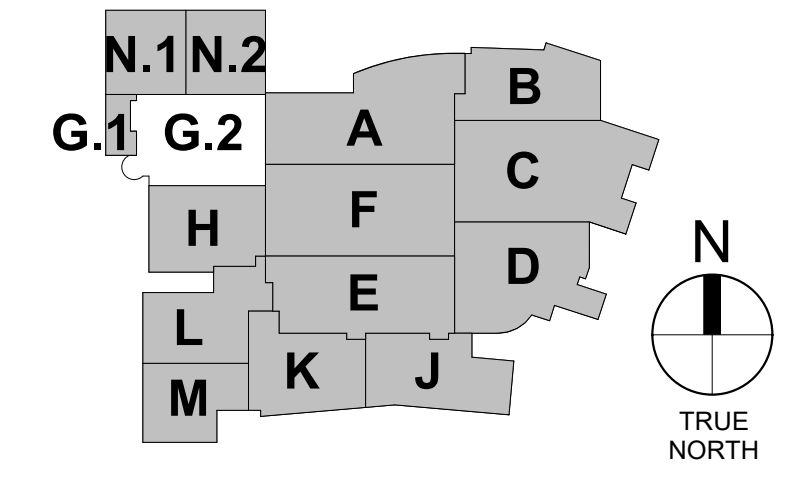


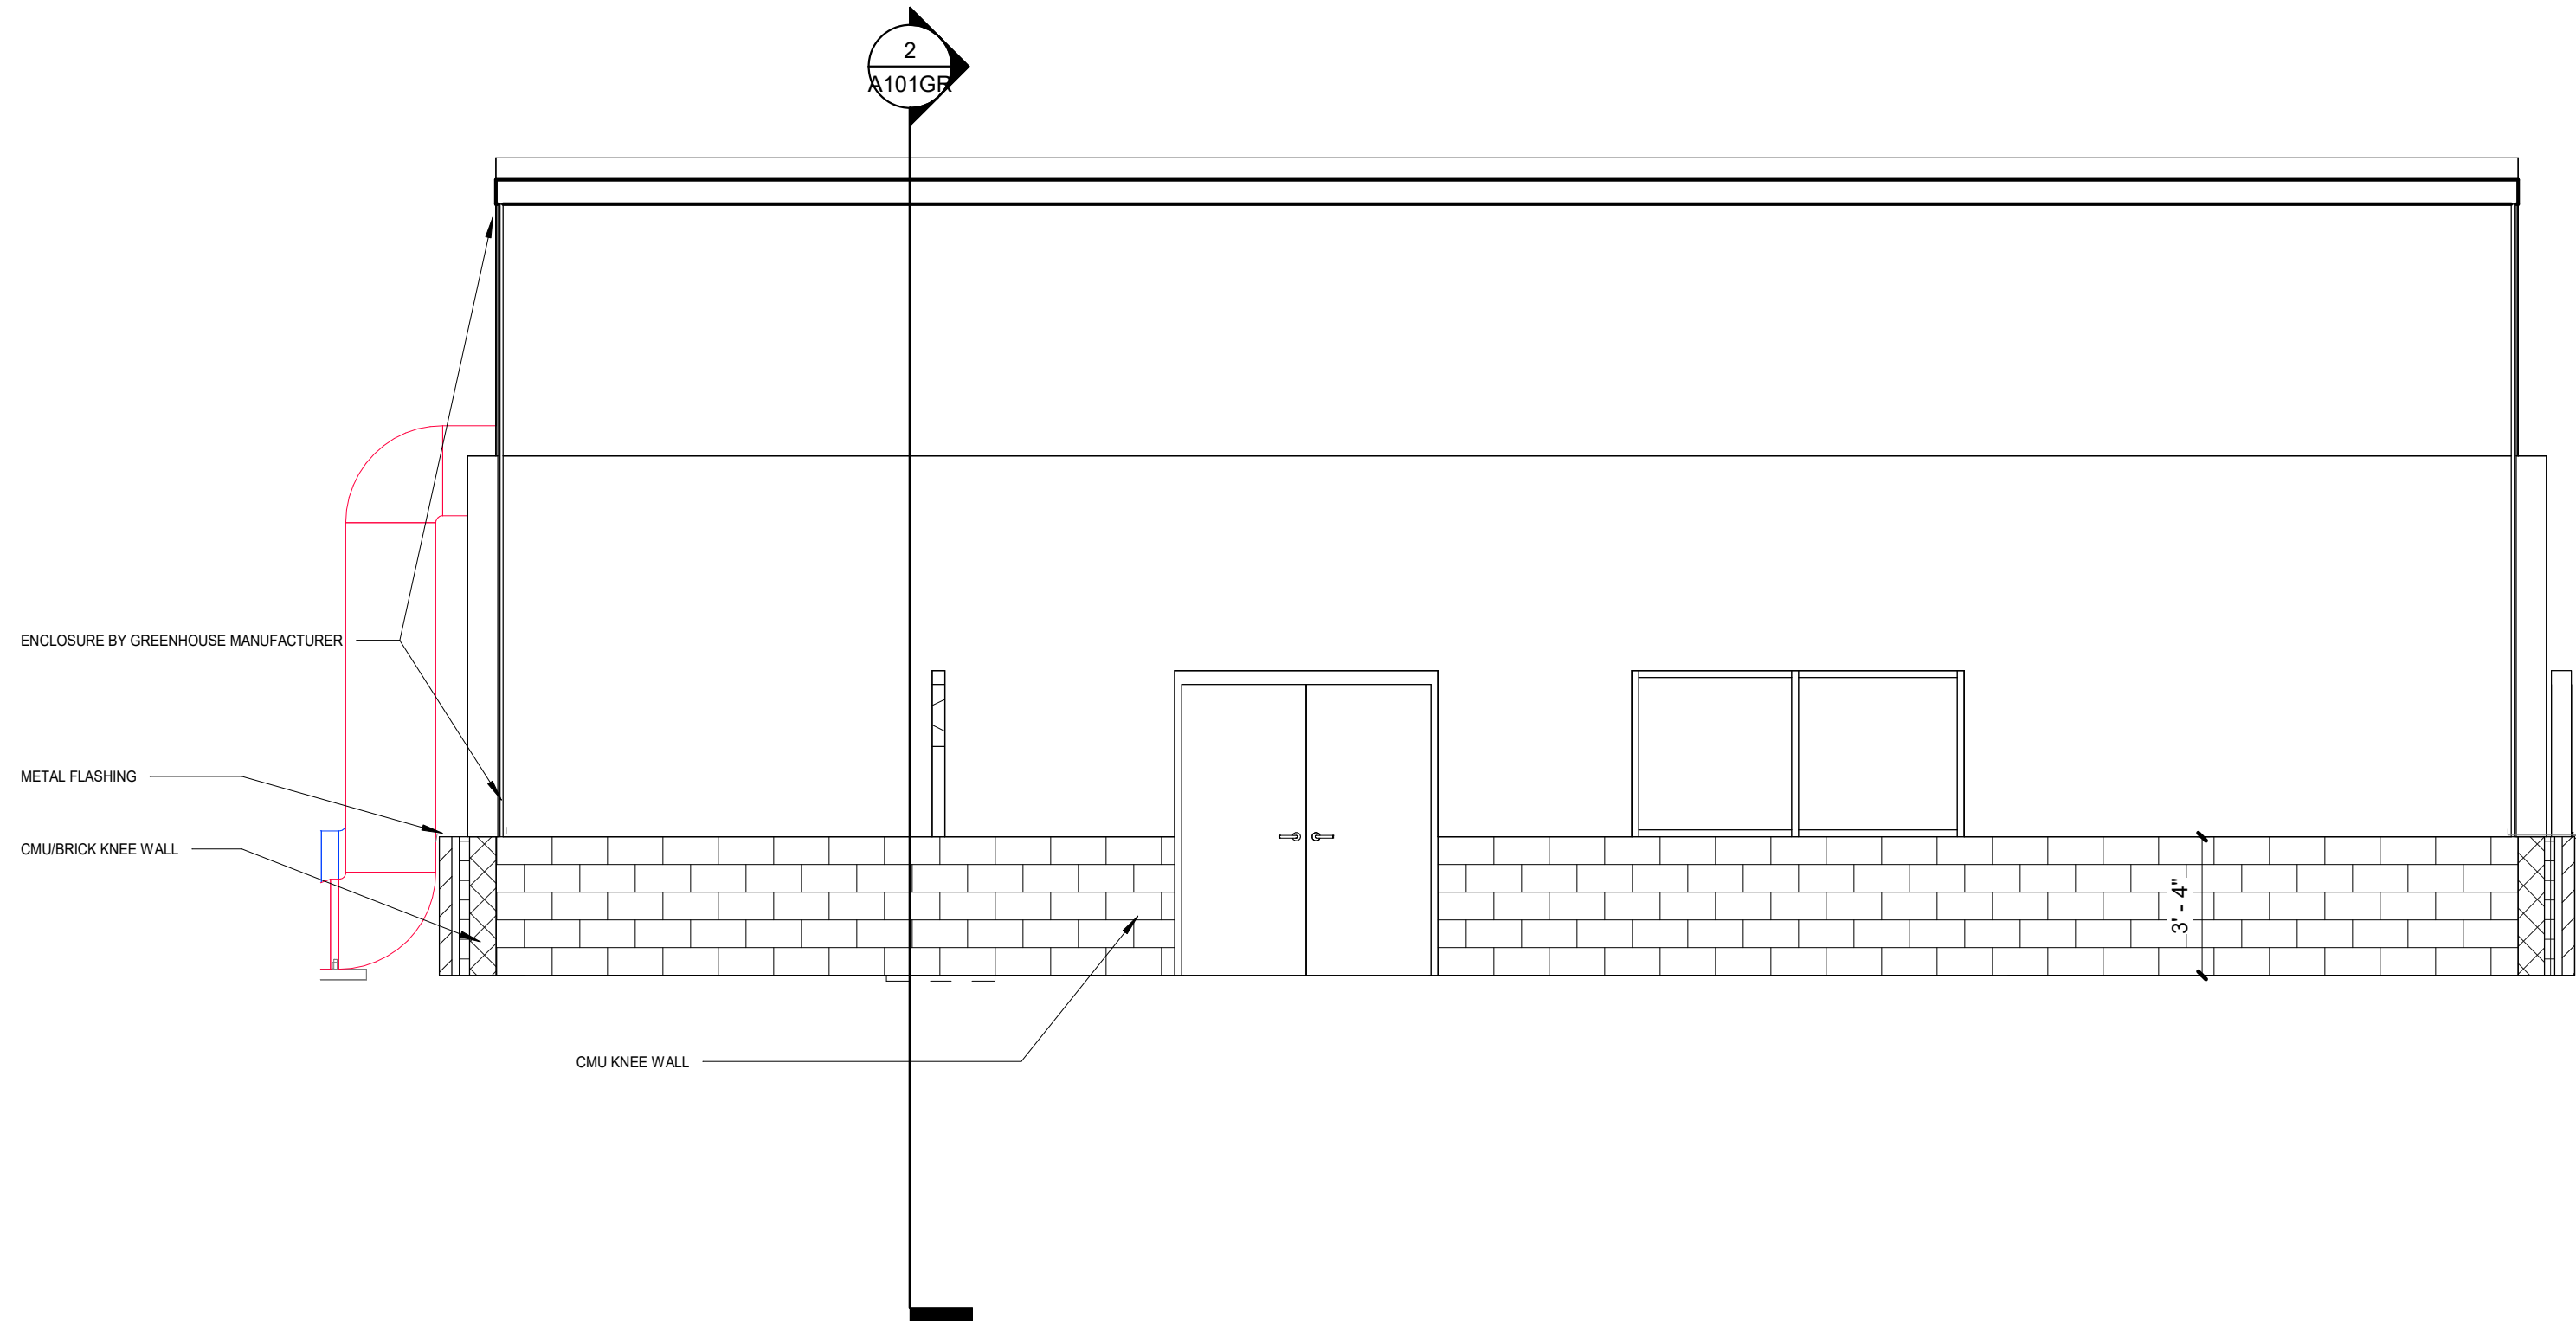


3 Section 35
SCALE: 1/4" = 1'-0"

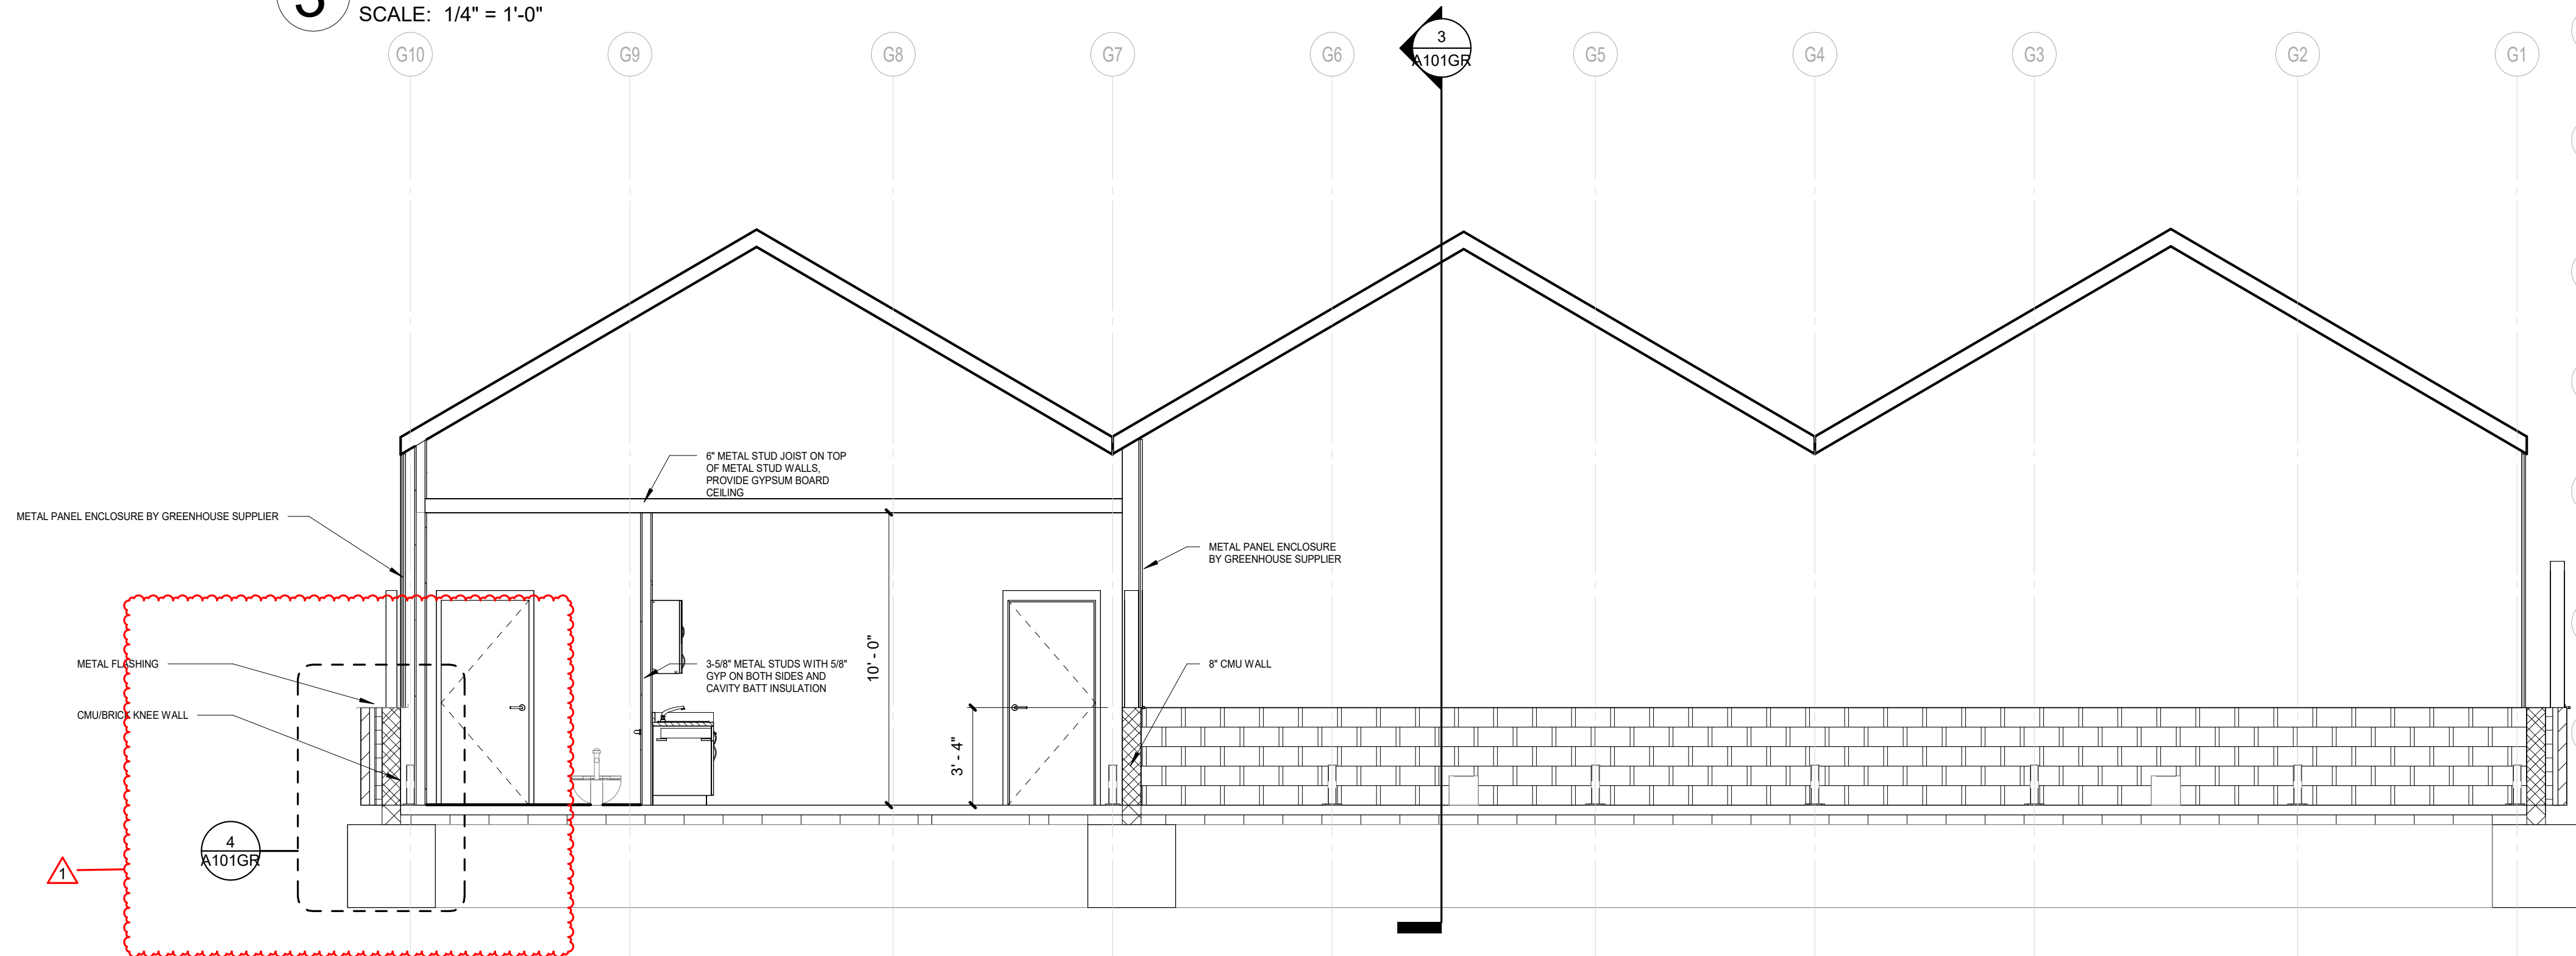

2 Section 34
SCALE: 1/4" = 1'-0"

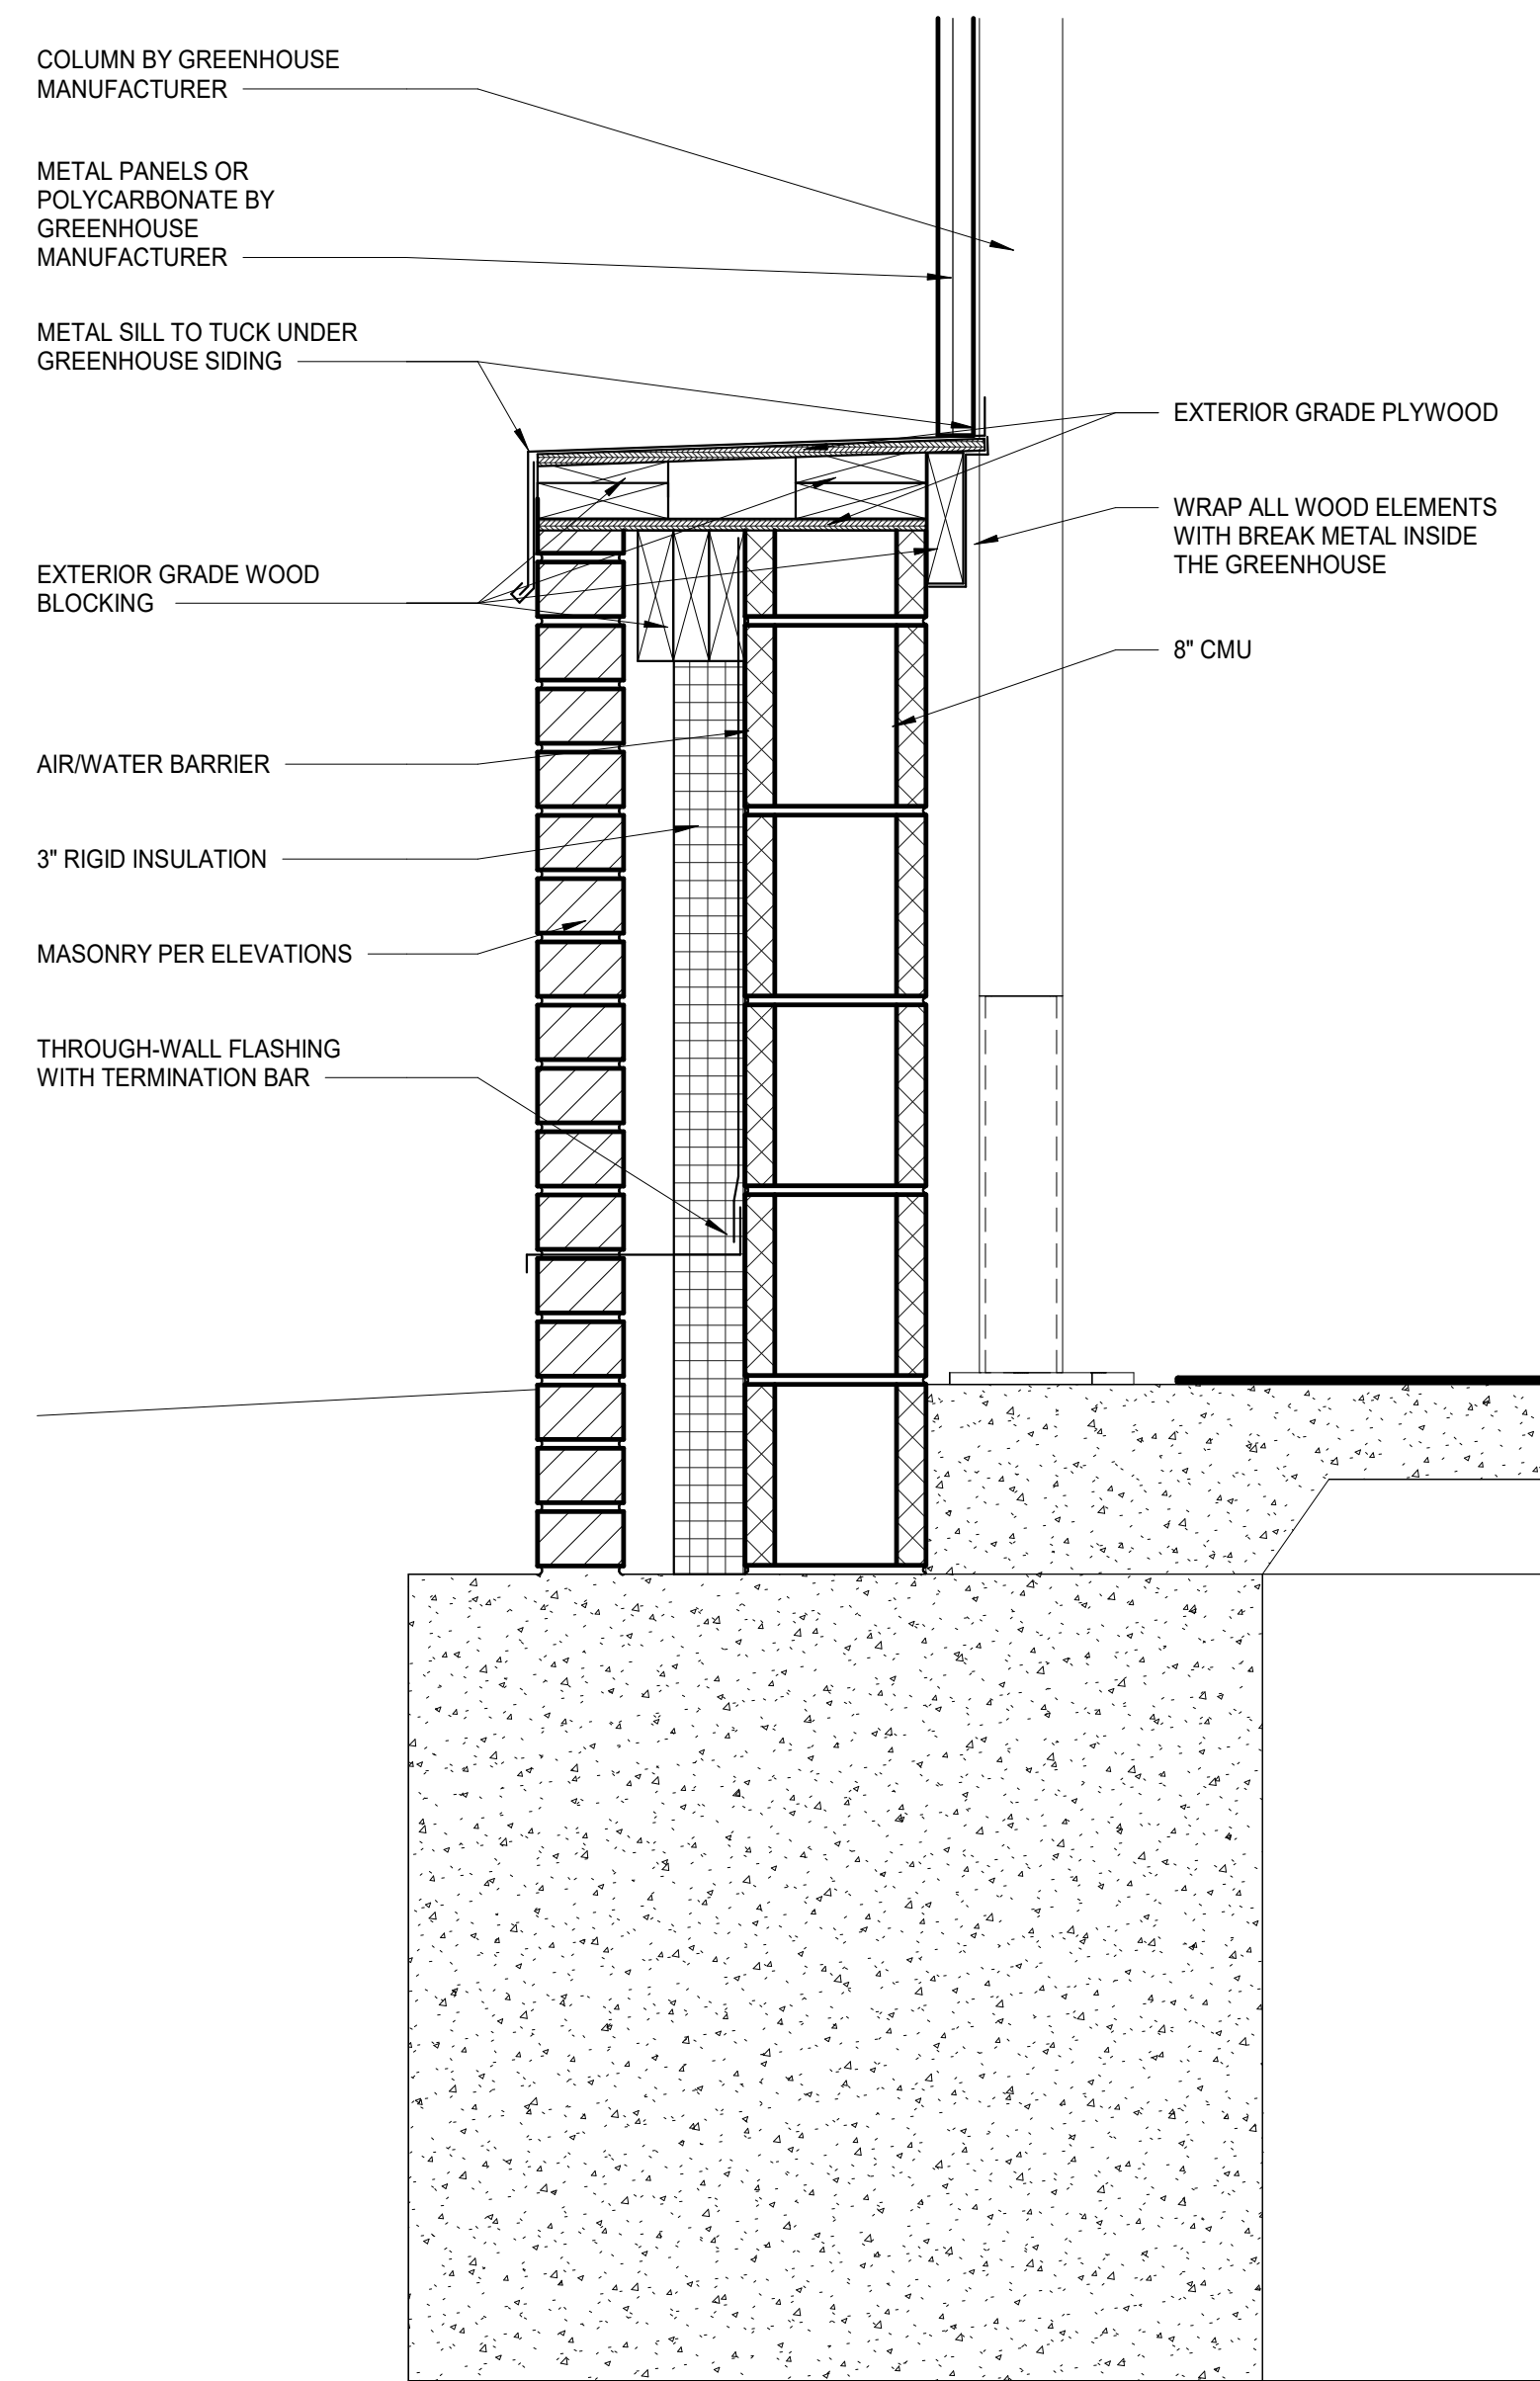

4 GREENHOUSE SECTION
SCALE: 1 1/2" = 1'-0"

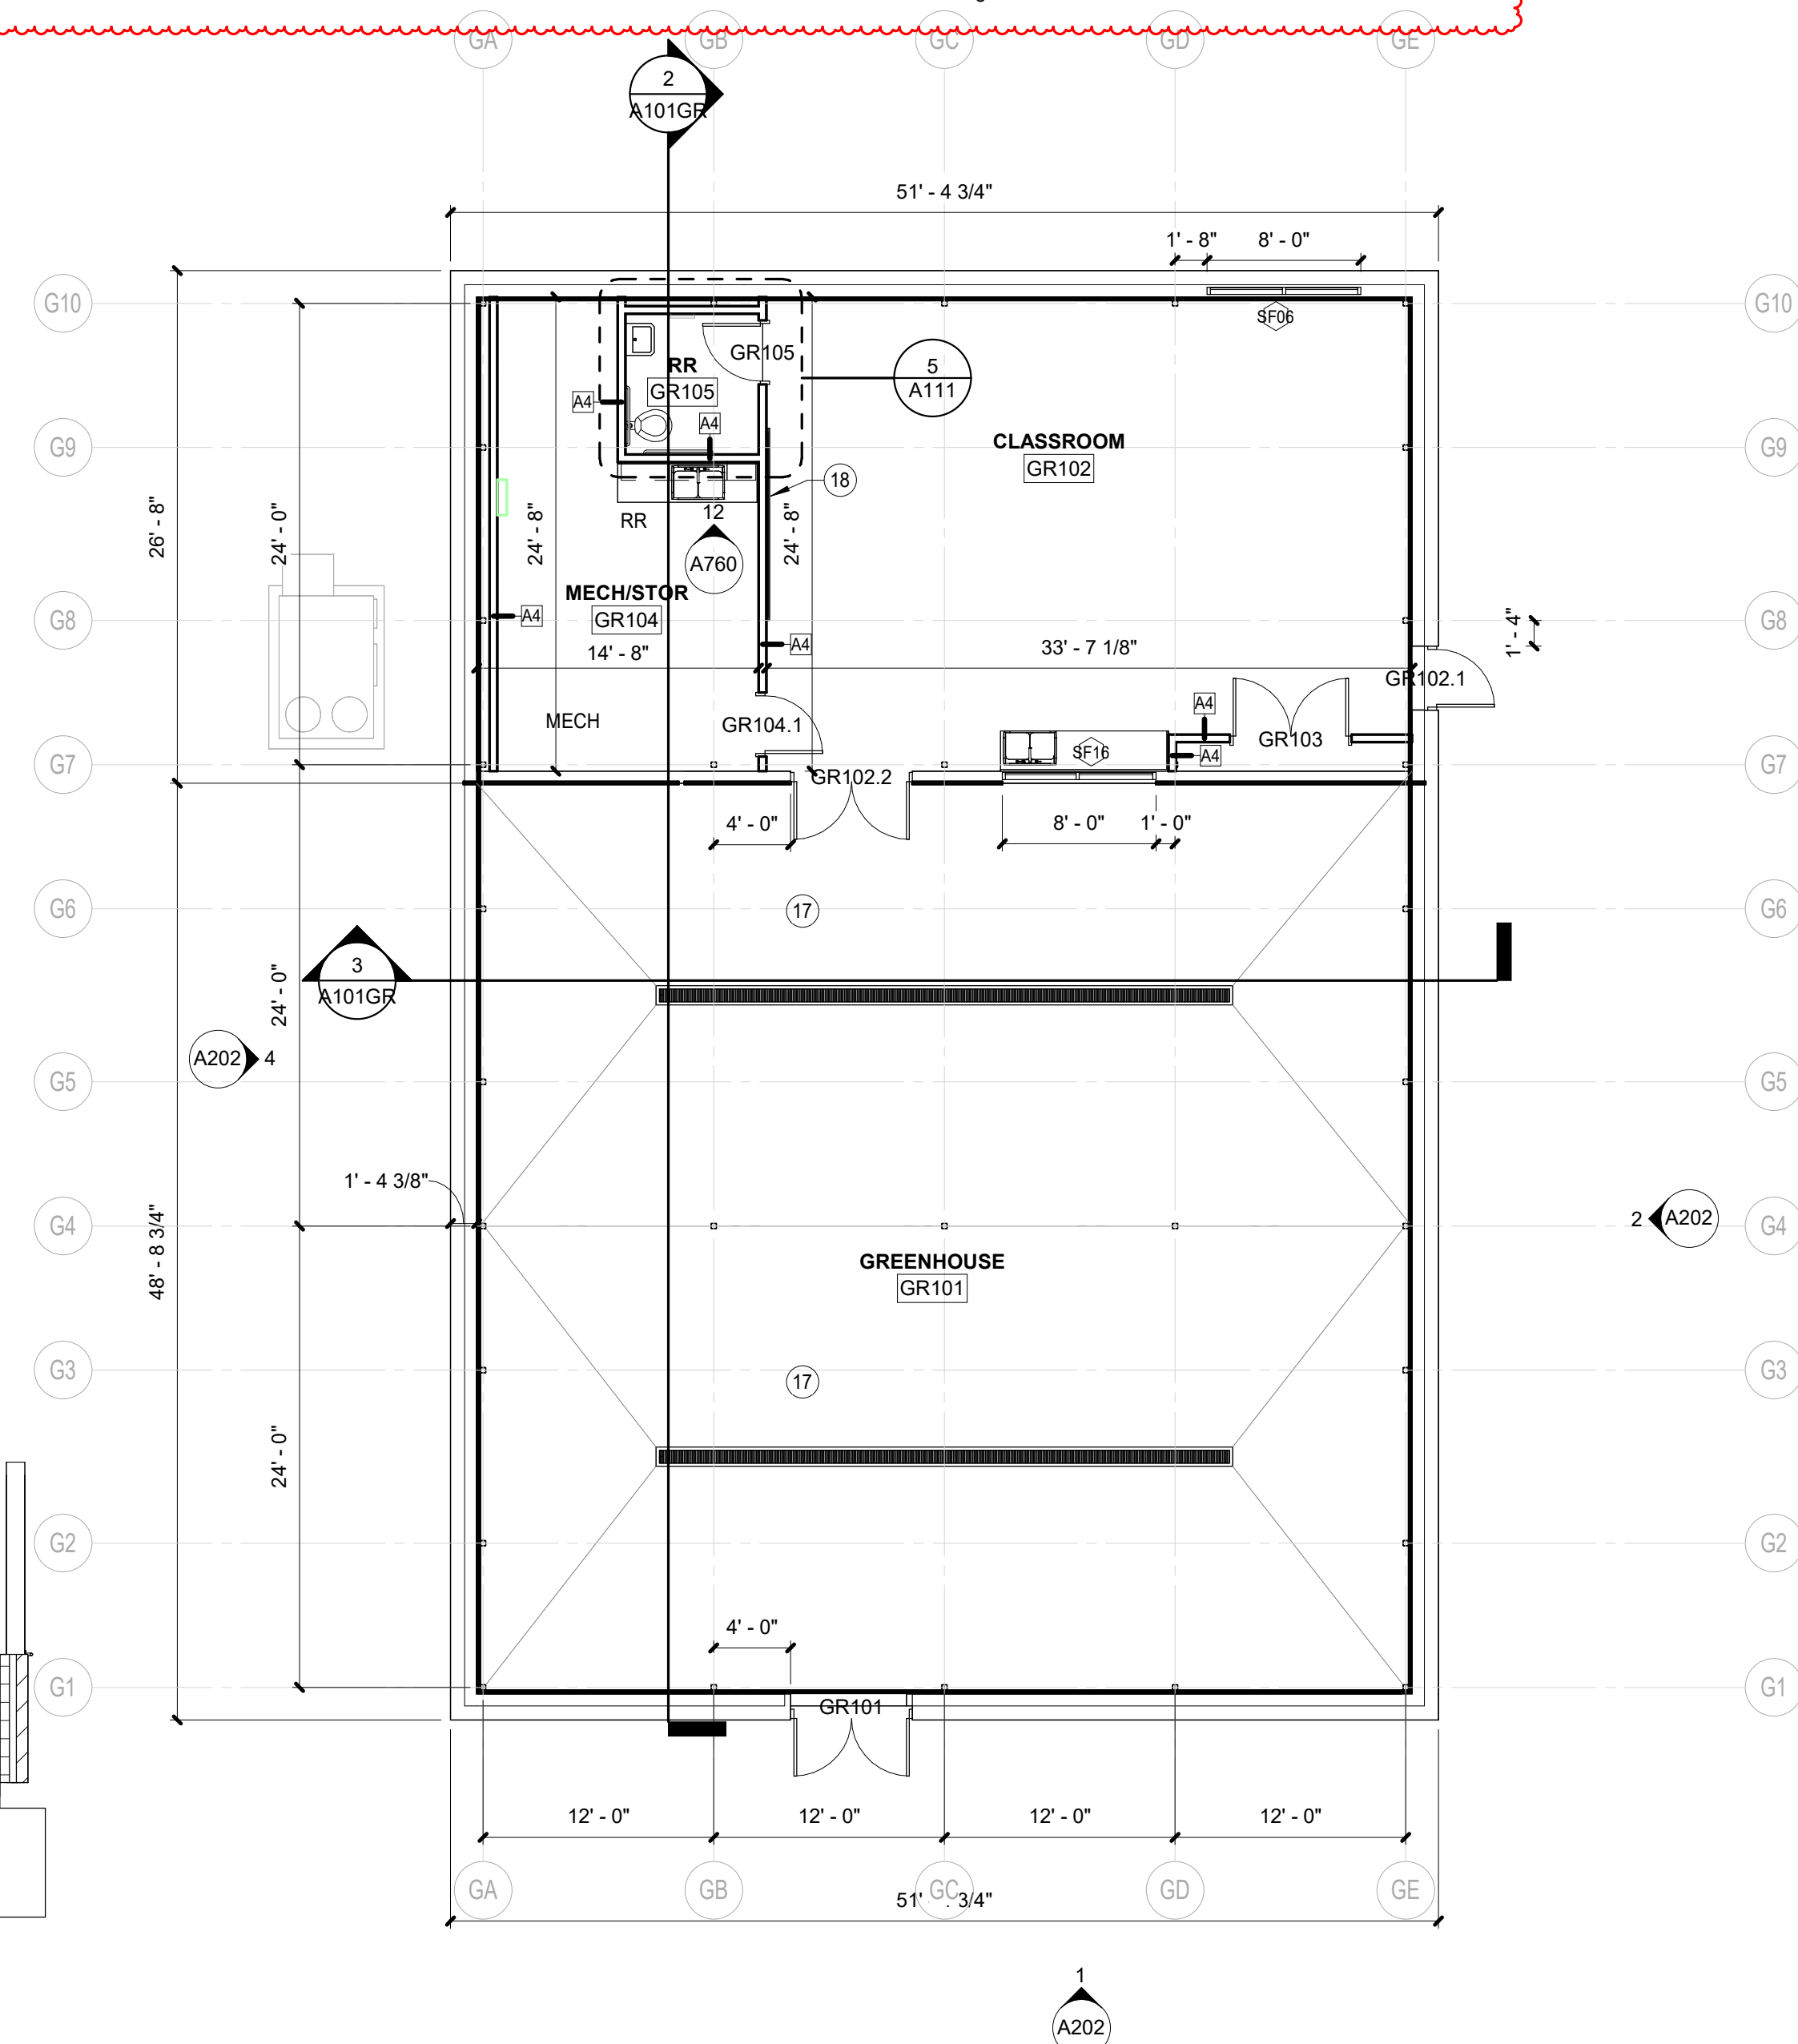

1 FLOOR PLAN - FIRST FLOOR - GREENHOUSE
SCALE: 1/8" = 1'-0"

GENERAL NOTES

1. PROVIDE 6'-0" HIGH CORNER GUARDS AT ALL OUTSIDE CORNERS WITH GYPSUM BOARD FINISH, FLOOR TO CEILING HEIGHT
2. PROVIDE BULL-NOSE FINISH ON ALL OUTSIDE CORNERS OF CMU WALLS
3. SEE ELEVATIONS FOR MASONRY TYPE AND SIZE
4. PROVIDE SOLID SURFACE WINDOW SILLS @ ALL STOREFRONT GLAZING SILLS ABOVE FINISHED FLOOR HEIGHT. WINDOW SILL TO EXTEND 1" PAST FINISHED WALL SURFACE. TYP. UNLESS OTHERWISE NOTED
5. SEE A110s FOR ENLARGED PLANS
6. FIELD VERIFY ALL DIMENSIONS FOR WINDOWS AND CASEWORK
7. INTERIOR DIMENSIONS ARE TAKEN TO THE FACE OF MASONRY OR STUDS
8. FOR ALL RESTROOM FACILITIES WITH GYPSUM WALL FINISH REPLACE 5/8" TYPE "X" GYPSUM BOARD W/HT 5/8" MOISTURE RESISTANT GYPSUM BOARD. SEE SPECS FOR DETAILS
9. WHERE COLUMN IS NOT INDICATED TO BE WRAPPED, PAINT IT P1 UNLESS NOTED OTHERWISE
10. TYPICAL FLOOR PLAN ANGLE IS 5 DEGREES FROM CARDINAL DIRECTIONS
11. WALLS TO GO UP TO DECK UNLESS OTHERWISE NOTED
12. PROVED WINDOW SHADES AT ALL EXTERIOR AND INTERIOR STOREFRONTS
13. PROVIDE NEW SIGNAGE ON ALL EXTERIOR DOORS AROUND THE BUILDING SHOWING UPDATED DOOR NUMBERS

PLAN NOTES - FLOOR PLAN

- 1 FLOOR/WALL EXPANSION JOINT AND COVER
- 2 NEW METAL LOCKERS DOUBLE-STACK. PRESERE CONCRETE BENCH
- 5 INFILL POOL. SEE STRUCTURAL FOR DETAILS. NEW SLAB
- 6 MOTORIZED PULL-OUT BLEACHERS. APPROX CAPACITY 300
- 7 TRACK
- 8 POLE VAULT. MATTS BY OWNER. PROVIDE POLE VAULT PIT. RECESS CONCRETE AS NEEDED
- 9 WOOD BASKETBALL COURT
- 10 SYNTHETIC BASKETBALL COURT
- 11 DIVIDER CURTAIN
- 12 TIP AND ROLL BLEACHERS BY OWNER
- 13 OVERHEAD COILING DOOR
- 14 NEW OPENING, 7'-4" TALL. PROVIDE HOLLOW METAL FRAME
- 5 LONG JUMP AREA. PROVIDE PIT WITH SAND CATCH AREAS. RECESS SLAB AS NEEDED
- 16 INFILL EXISTING CALWALL OPENINGS, 5/8" GYPSUM BOARD ON THE INSIDE OVER 6" METAL STUDS OVER 5/8" EXTERIOR GRADE WOOD SHEATHING OVER AIR/WATER RESISTIVE BARRIER OVER 2" RIGID INSULATION OVER 12" EXTERIOR GRADE WOOD SHEATHING
- 17 SLOPE SLAB TO DRAIN 1/8" TO 12"
- 8 6"x4" MARKERBOARD
- 19 METAL PAN STAIR (CONCRETE INFILL) WITH WALL-MOUNTED RAILINGS
- 20 INFILL FLOOR PITS. NEW SLAB TO BE LEVEL WITH ADJACENT SLABS
- 21 VOLLEYBALL COURT WITH POLE INSERTS
- 22 TENNIS COURT WITH NET POLE INSERTS
- 23 DRINKING FOUNTAIN WITH BOTTLE FILLER
- 25 MOP SINK
- 21 INFILL WALL AS NEEDED. MATCH EXISTING WALL CONSTRUCTION
- 22 REPLACED PLUMBING FIXTURES PER PLUMBING PLANS. PATCH FINISHES AS NEEDED FOR RE-INSTALLATION OF NEW PLUMBING FIXTURES

CLARK-PLEASANT COMMUNITY SCHOOL CORP.
WHITELAND COMM. HIGH SCHOOL PHASE 3
300 E MAIN ST, WHITELAND, IN 46184




REVISIONS:		
#	Date	Desc.
1	07-16-2025	ADD#1

100% CONSTRUCTION DOCUMENTS



PROJECT: #22130
DATE: 06-06-2025
DRAWN BY: Author

FLOOR PLAN -
FIRST FLOOR -
GREENHOUSE

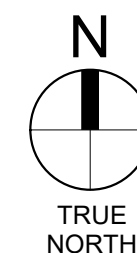

A101GR

PLOT DATE/TIME: 07/25/2023 8:03:38 AM

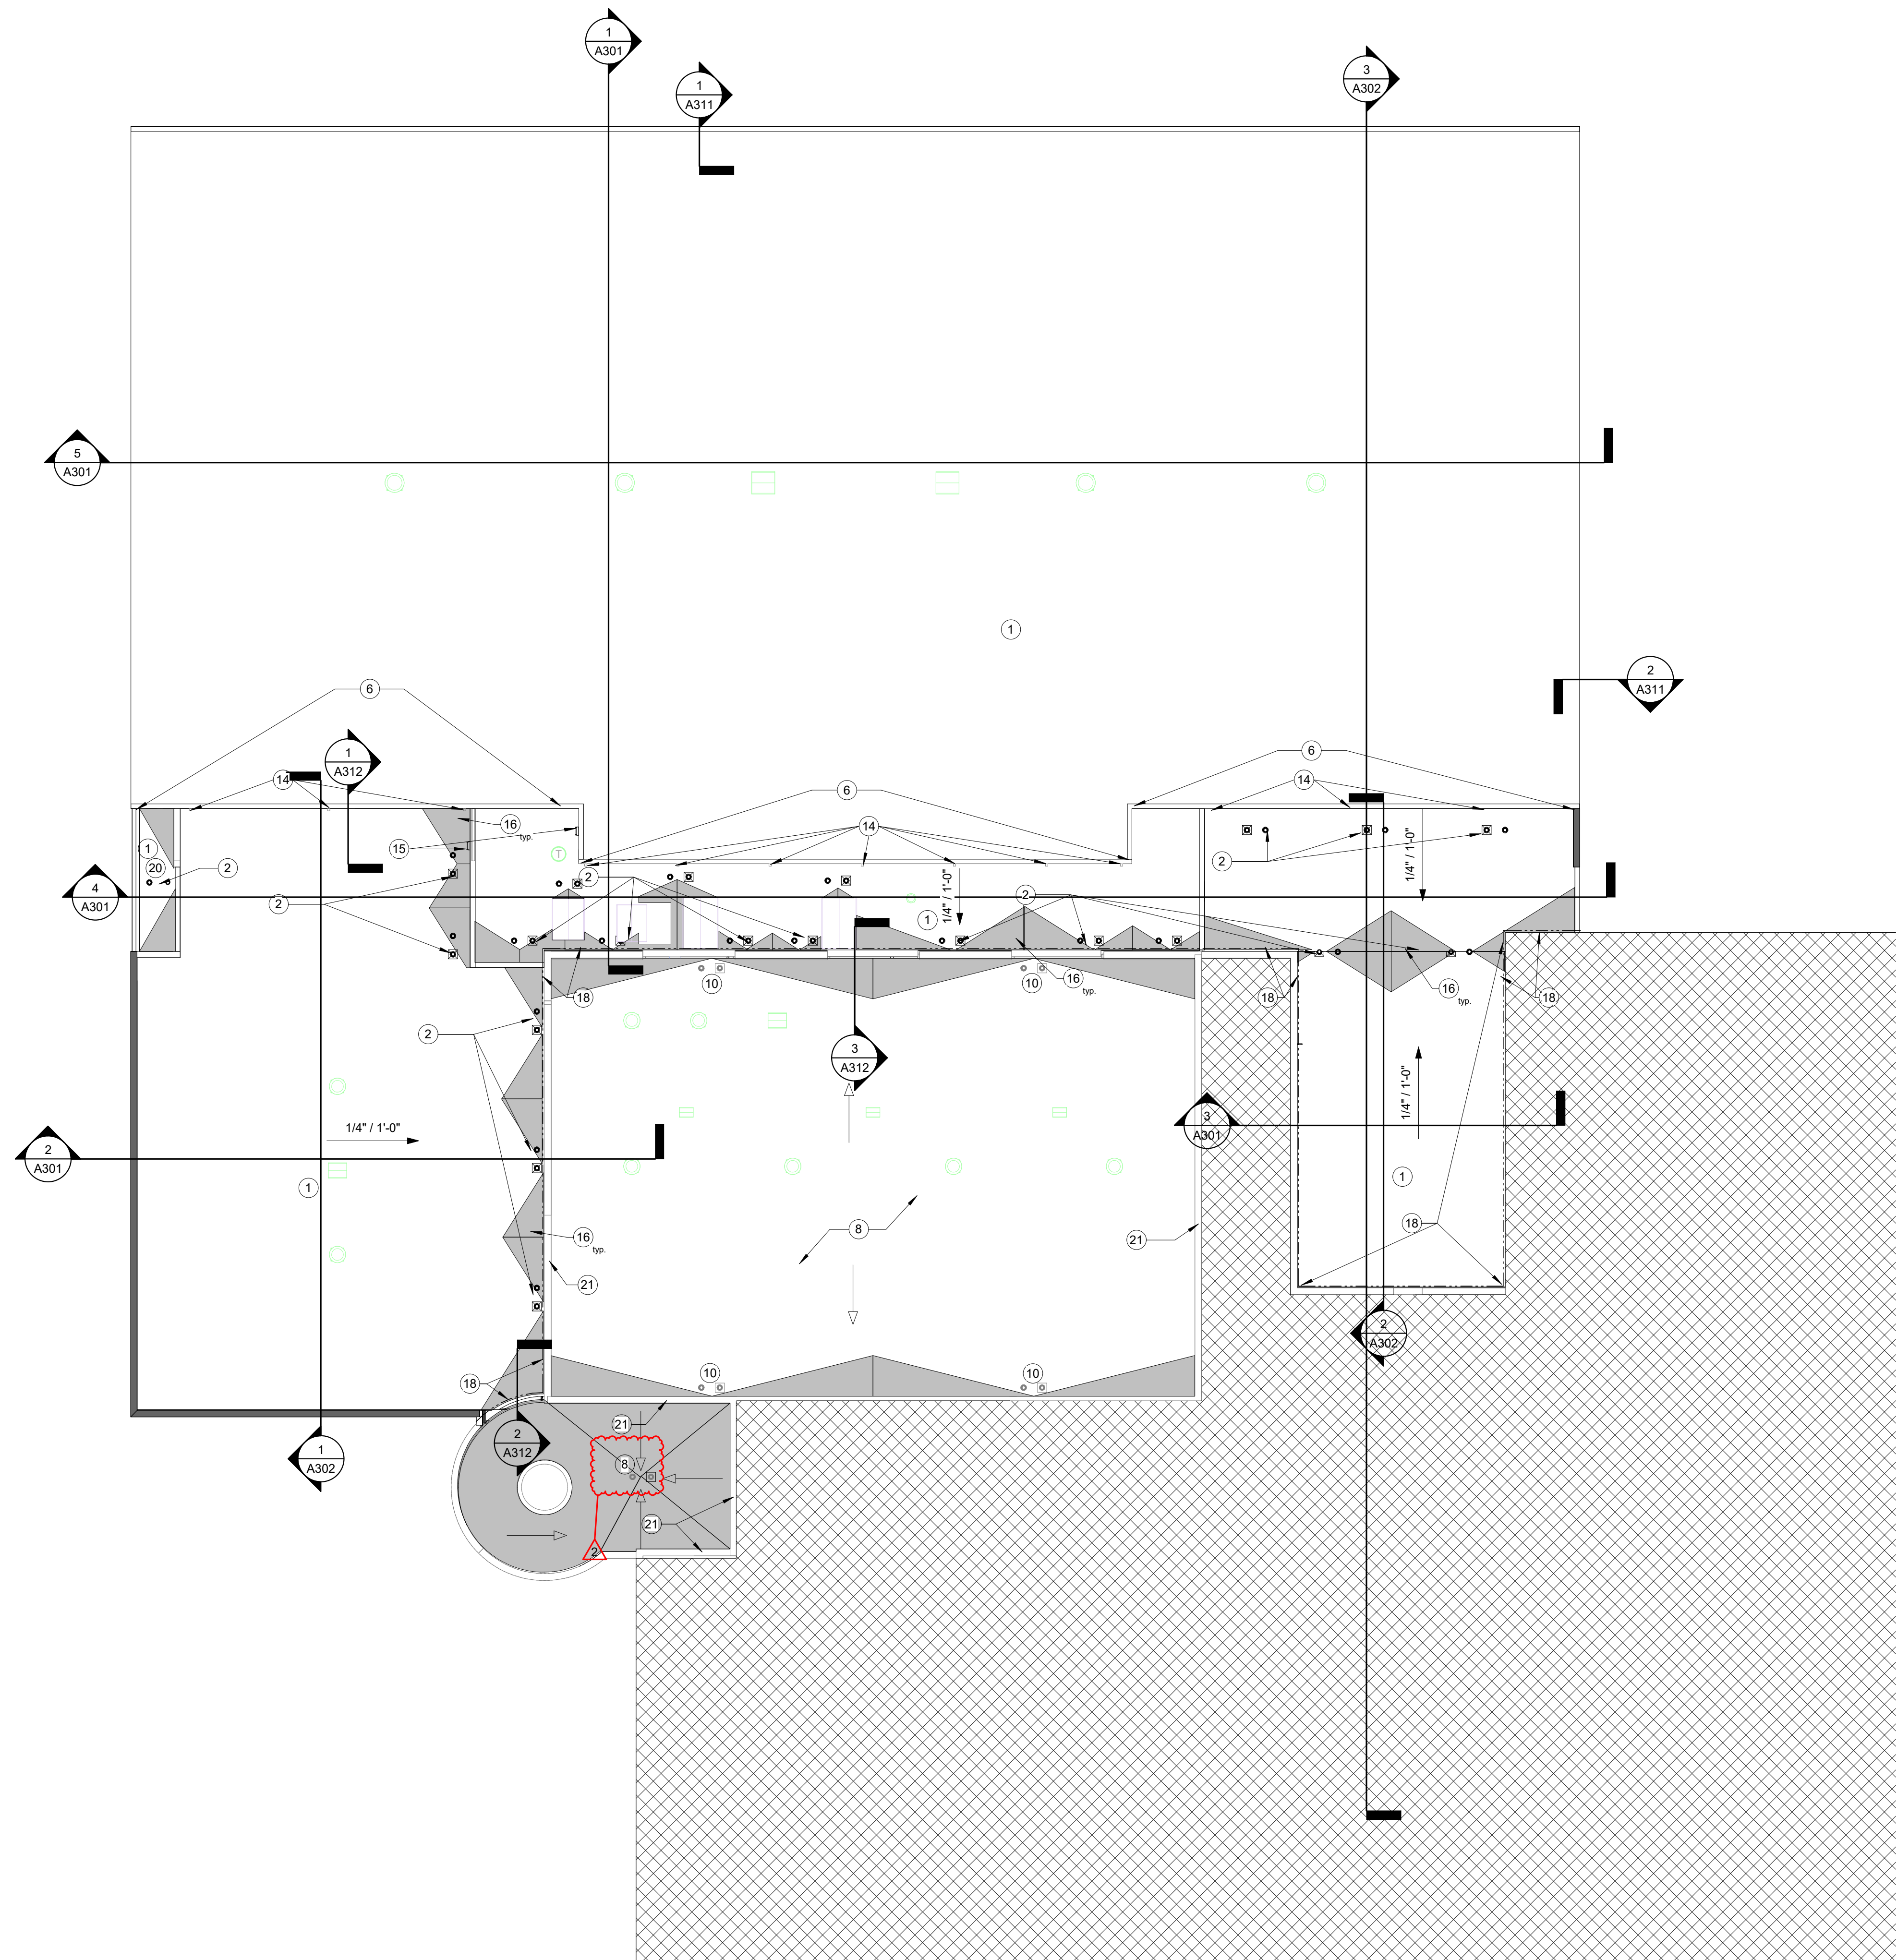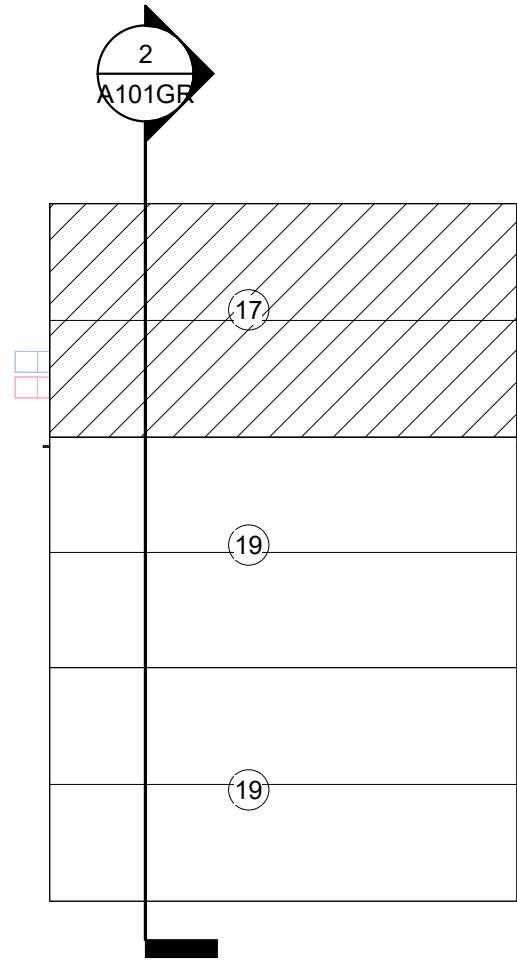

PLAN NOTES - ROOF PLAN

- 1 NEW PVC ROOF
- 2 ROOF DRAIN WITH OVERFLOW
- 3 BUILT-UP ROOF CRICKET TO DRAIN
- 4 ELEVATOR SHAFT POP-UP
- 5 EXPANSION JOINT
- 6 12" METAL GUTTER WITH DOWNSPOUTS
- 7 REFLASH EXISTING ROOF
- 8 REMOVE EXISTING ROOFING AND GRAVEL BALLAST. REUSE EXISTING INSULATION. RE-ROOF THE EXISTING ROOF. RE-USE EXISTING ROOF EDGE COPING AND EDGES
- 9 PROVIDE FALL PROTECTION SYSTEM PER OSHA STANDARDS
- 10 NEW ROOF DRAIN WITH OVERFLOW IN THE EXISTING ROOF. REMOVE EXISTING SCUPPER. RE-ROOF AND REFLASH AS NEEDED
- 12 BREAK METAL TRIM SLOPED TO DRAIN
- 13 PATCH EXISTING ROOF, SLOPE TO DRAIN
- 14 6" METLAD DOWNSPOUT WITH SPALSHBLOCK
- 15 ROOF LADDER WITH FALL PROTECTION
- 16 BUILD UP CRICKET WITH RIGID INSULATION TO DRAIN AS NEEDED
- 17 METAL ROOF BY GREENHOUSE SUPPLIER
- 18 ROOF EXPANSION JOINT
- 19 POLYCARBONATE ROOF BY GREENHOUSE SUPPLIER
- 20 SLOPE INSULATION TO DRAIN 6" MIN
- 21 NEW ROOF DRAIN WITH OVERFLOW IN THE EXISTING ROOF. REMOVE EXISTING SCUPPER. RE-ROOF AND REFLASH AS NEEDED
- 22

GENERAL NOTES

- 1 PROVIDE SPLASH BLOCKS WHERE DOWNSPOUTS OR EXTENDERS COME INTO CONTACT WITH ROOF SURFACE
- 2 PROVIDE 2X2 PROTECTIVE ROOF PADS OUTSIDE EVERY ROOF ACCESS POINT, ON TOP AND BOTTOM OF ROOF LADDERS, AROUND ALL ROOF MEP EQUIPMENT

1 OVERALL ROOF PLAN

SCALE: 1" = 20'-0"

CLARK-PLEASANT COMMUNITY SCHOOL CORP.
WHITELAND COMM. HIGH SCHOOL PHASE 3
300 E MAIN ST, WHITELAND, IN 46184



REVISIONS:		Date	Desc:
#			
1		07-16-2025	ADD#1
2		07-23-2023	ADD#2


100% CONSTRUCTION DOCUMENTS

PROJECT: #22130
DATE: 06-06-2025
DRAWN BY: Author


ROOF PLAN

A141


LANCER ASSOCIATES
ARCHITECTURE
145 N EAST STREET
INDIANAPOLIS, IN 46204

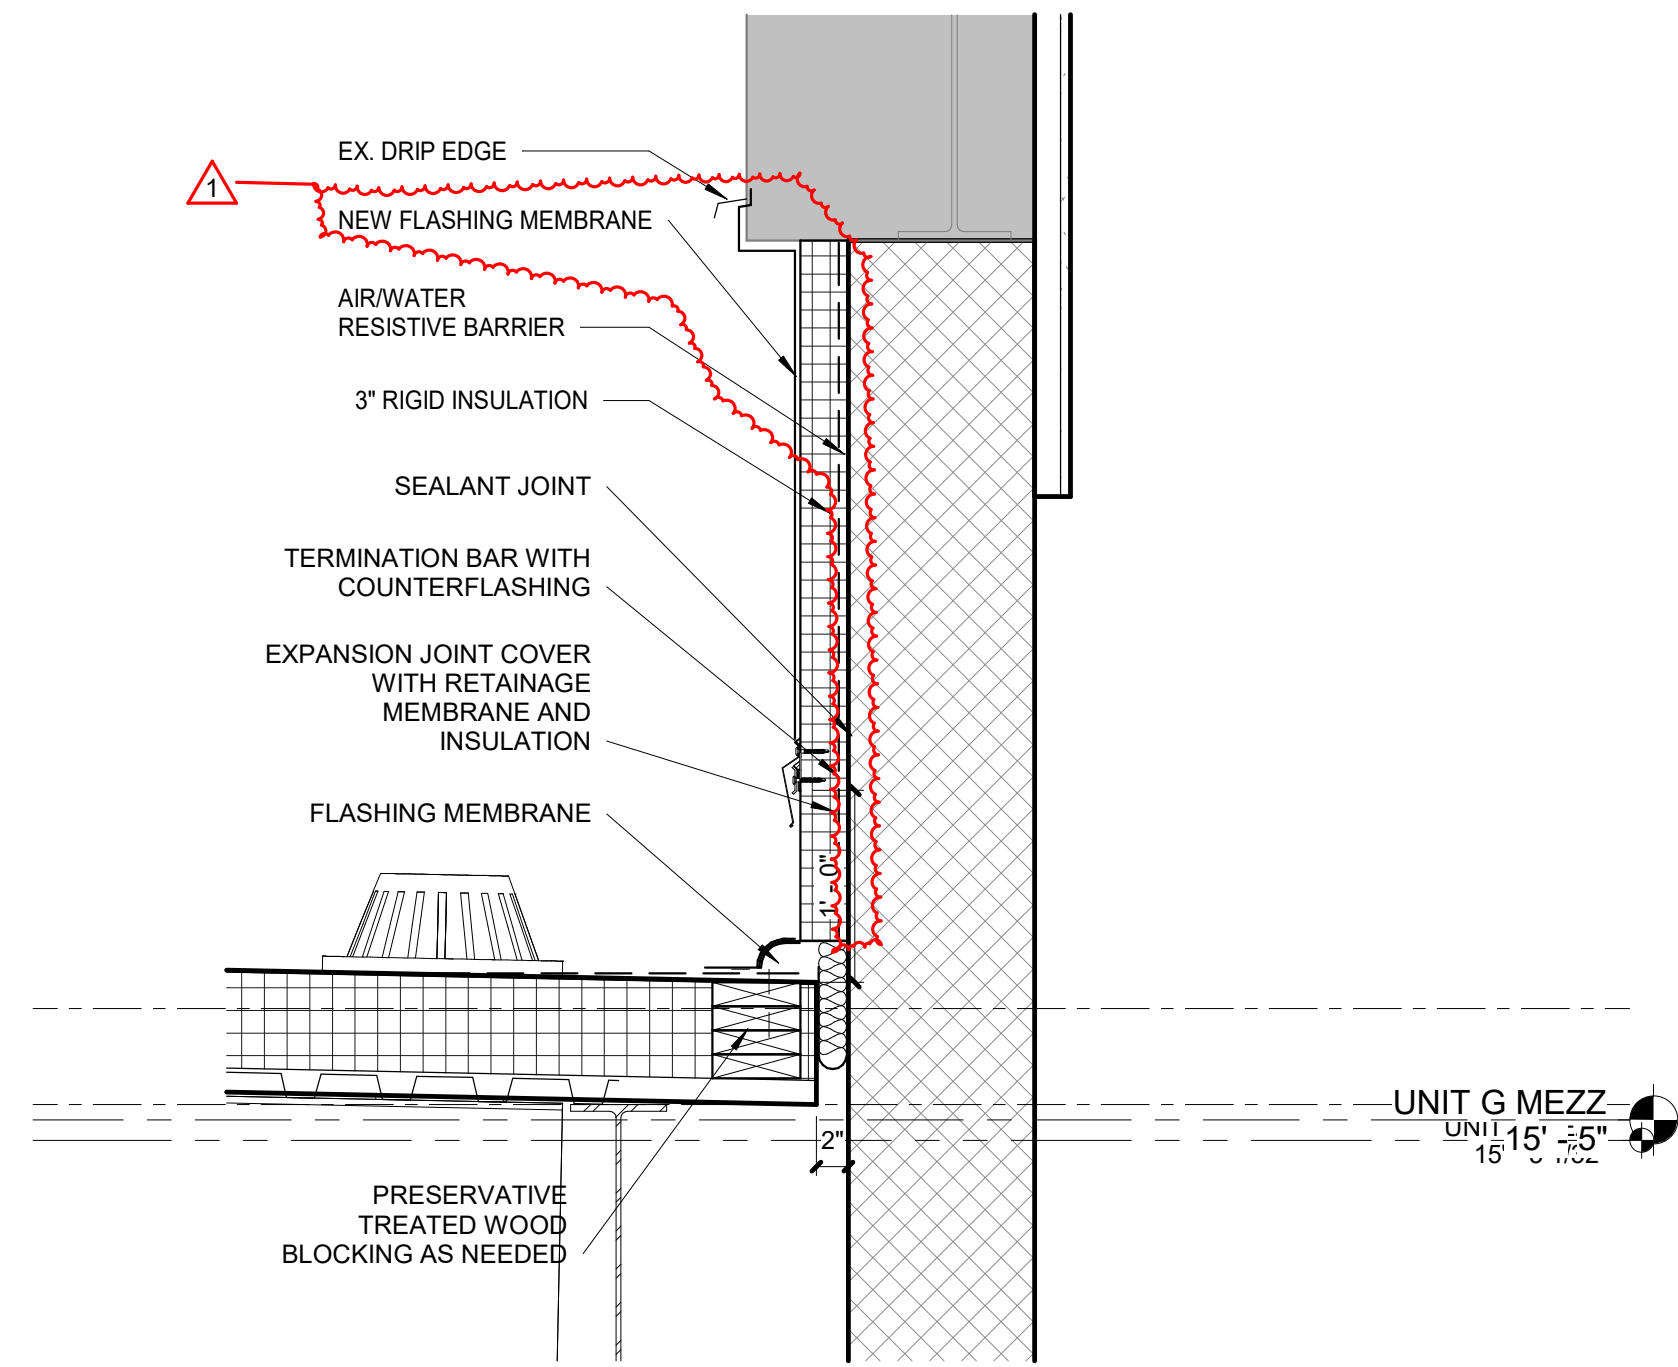


10 WALL DETAIL OF ROOF THRU N1000 EAST WALL
SCALE: 1" = 1'-0"

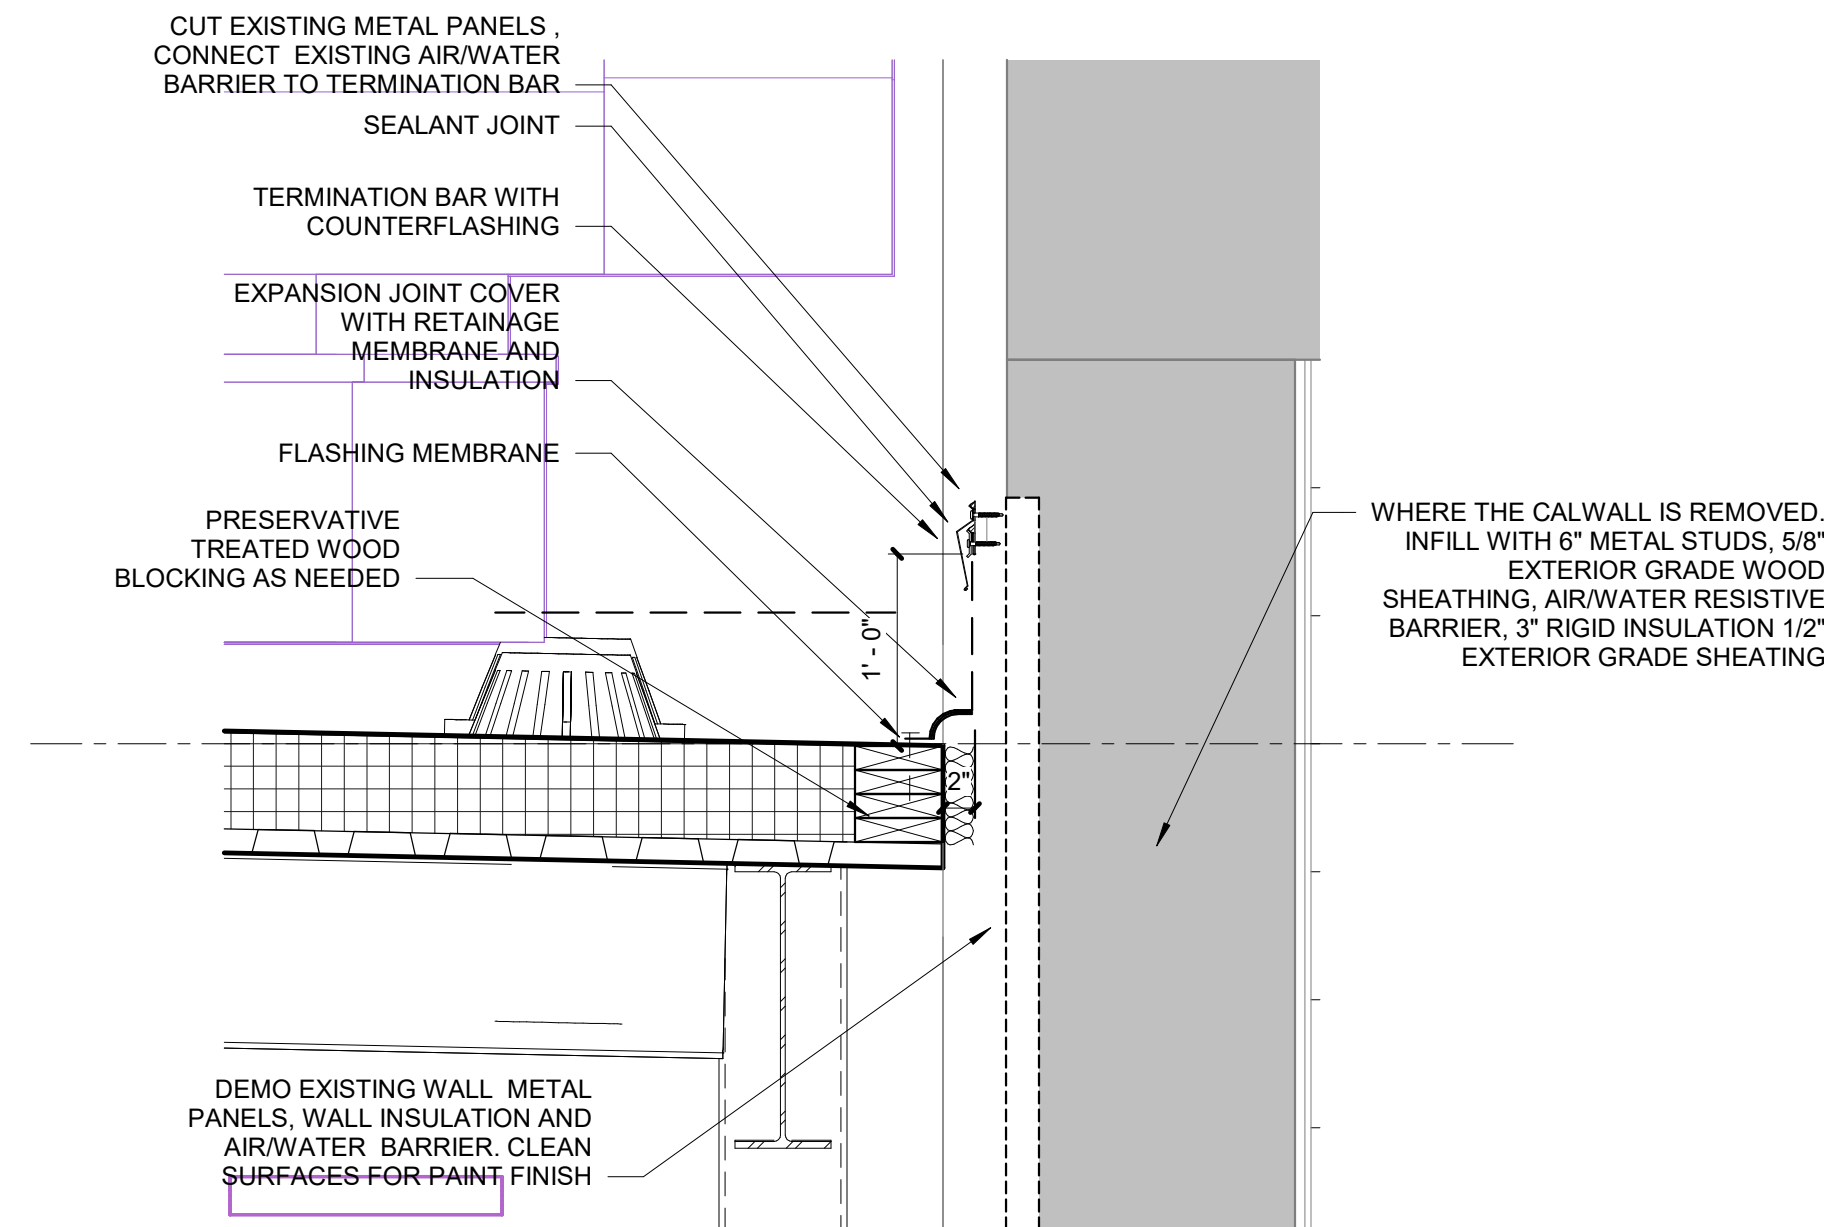


9 WALL DETAIL THRU ROOF IN N2001 SOUTH WALL
SCALE: 1" = 1'-0"

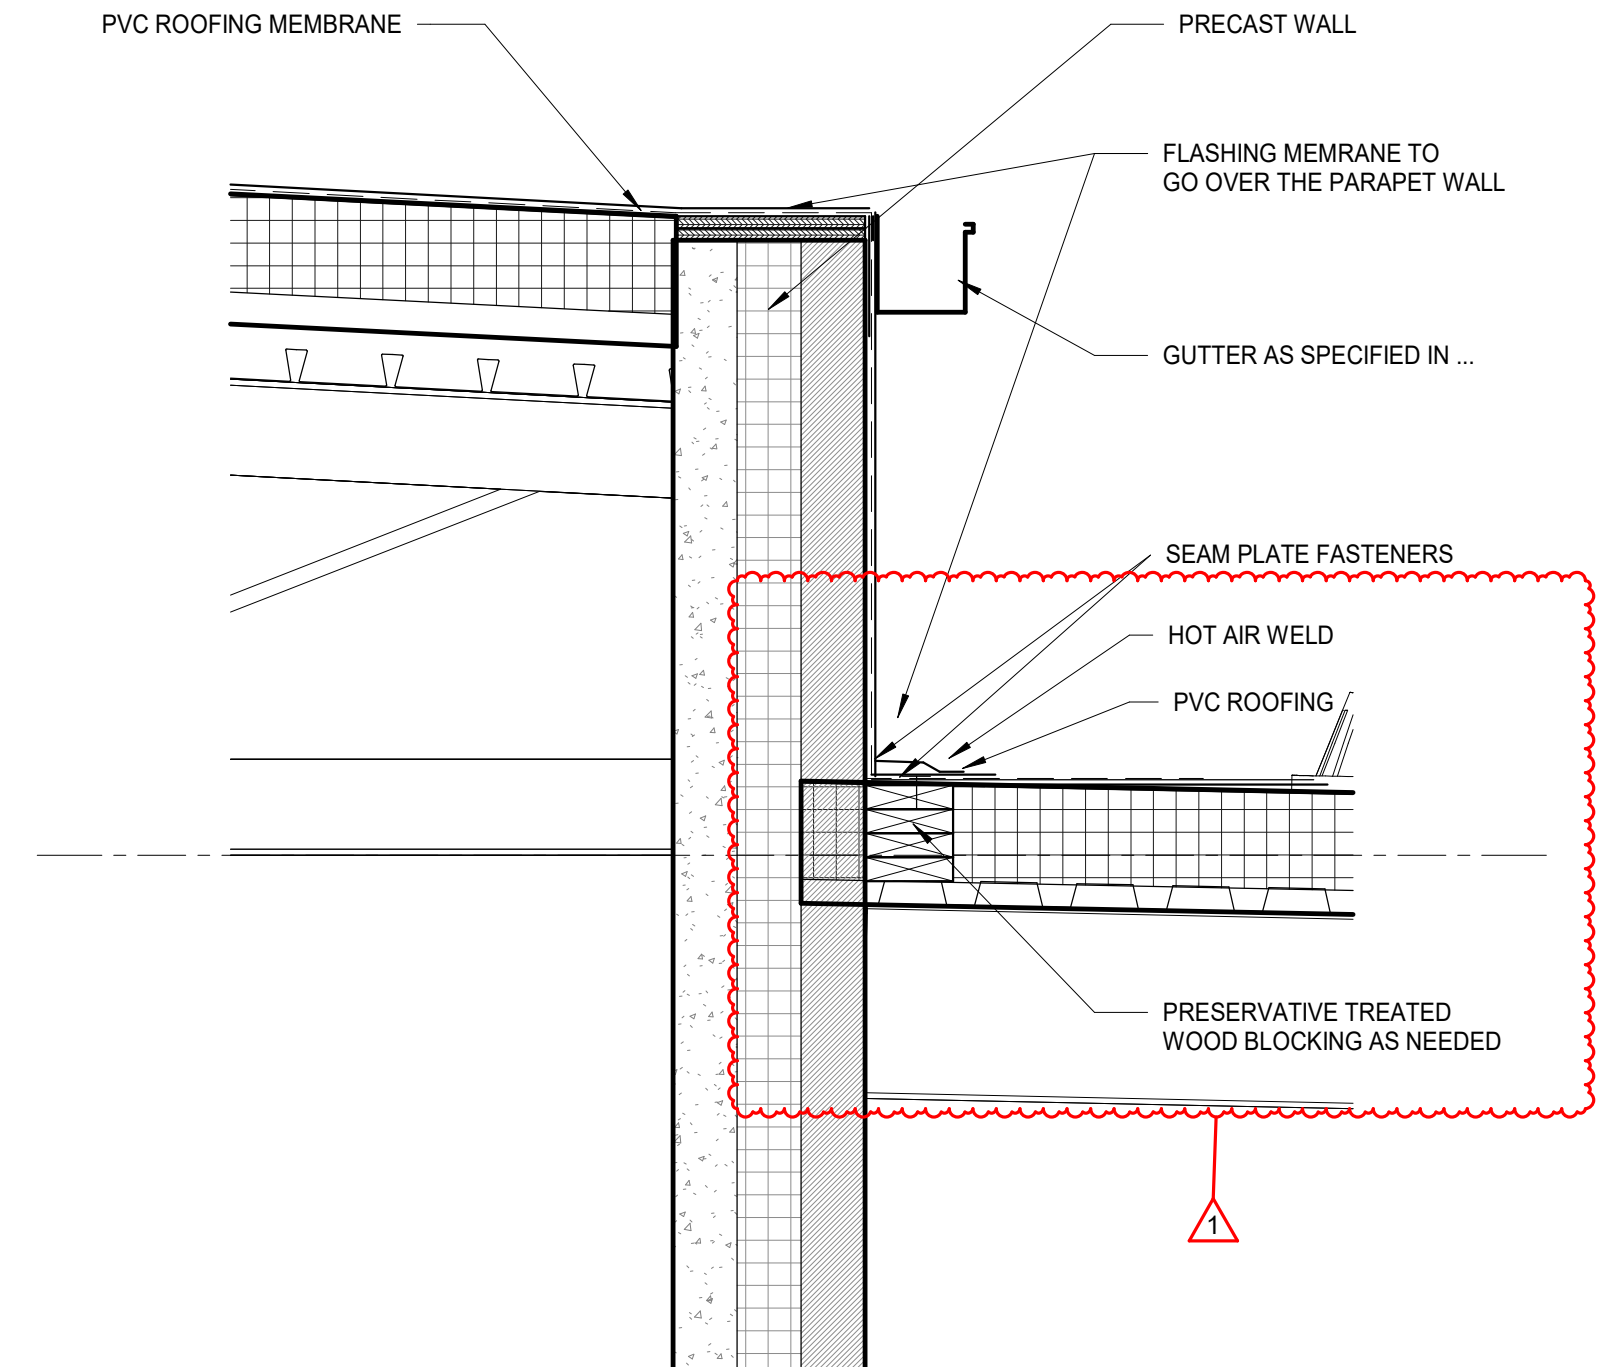


8 WALL DETAIL THRU TOP OF PARAPET IN SAC SOUTH WALL
SCALE: 1" = 1'-0"

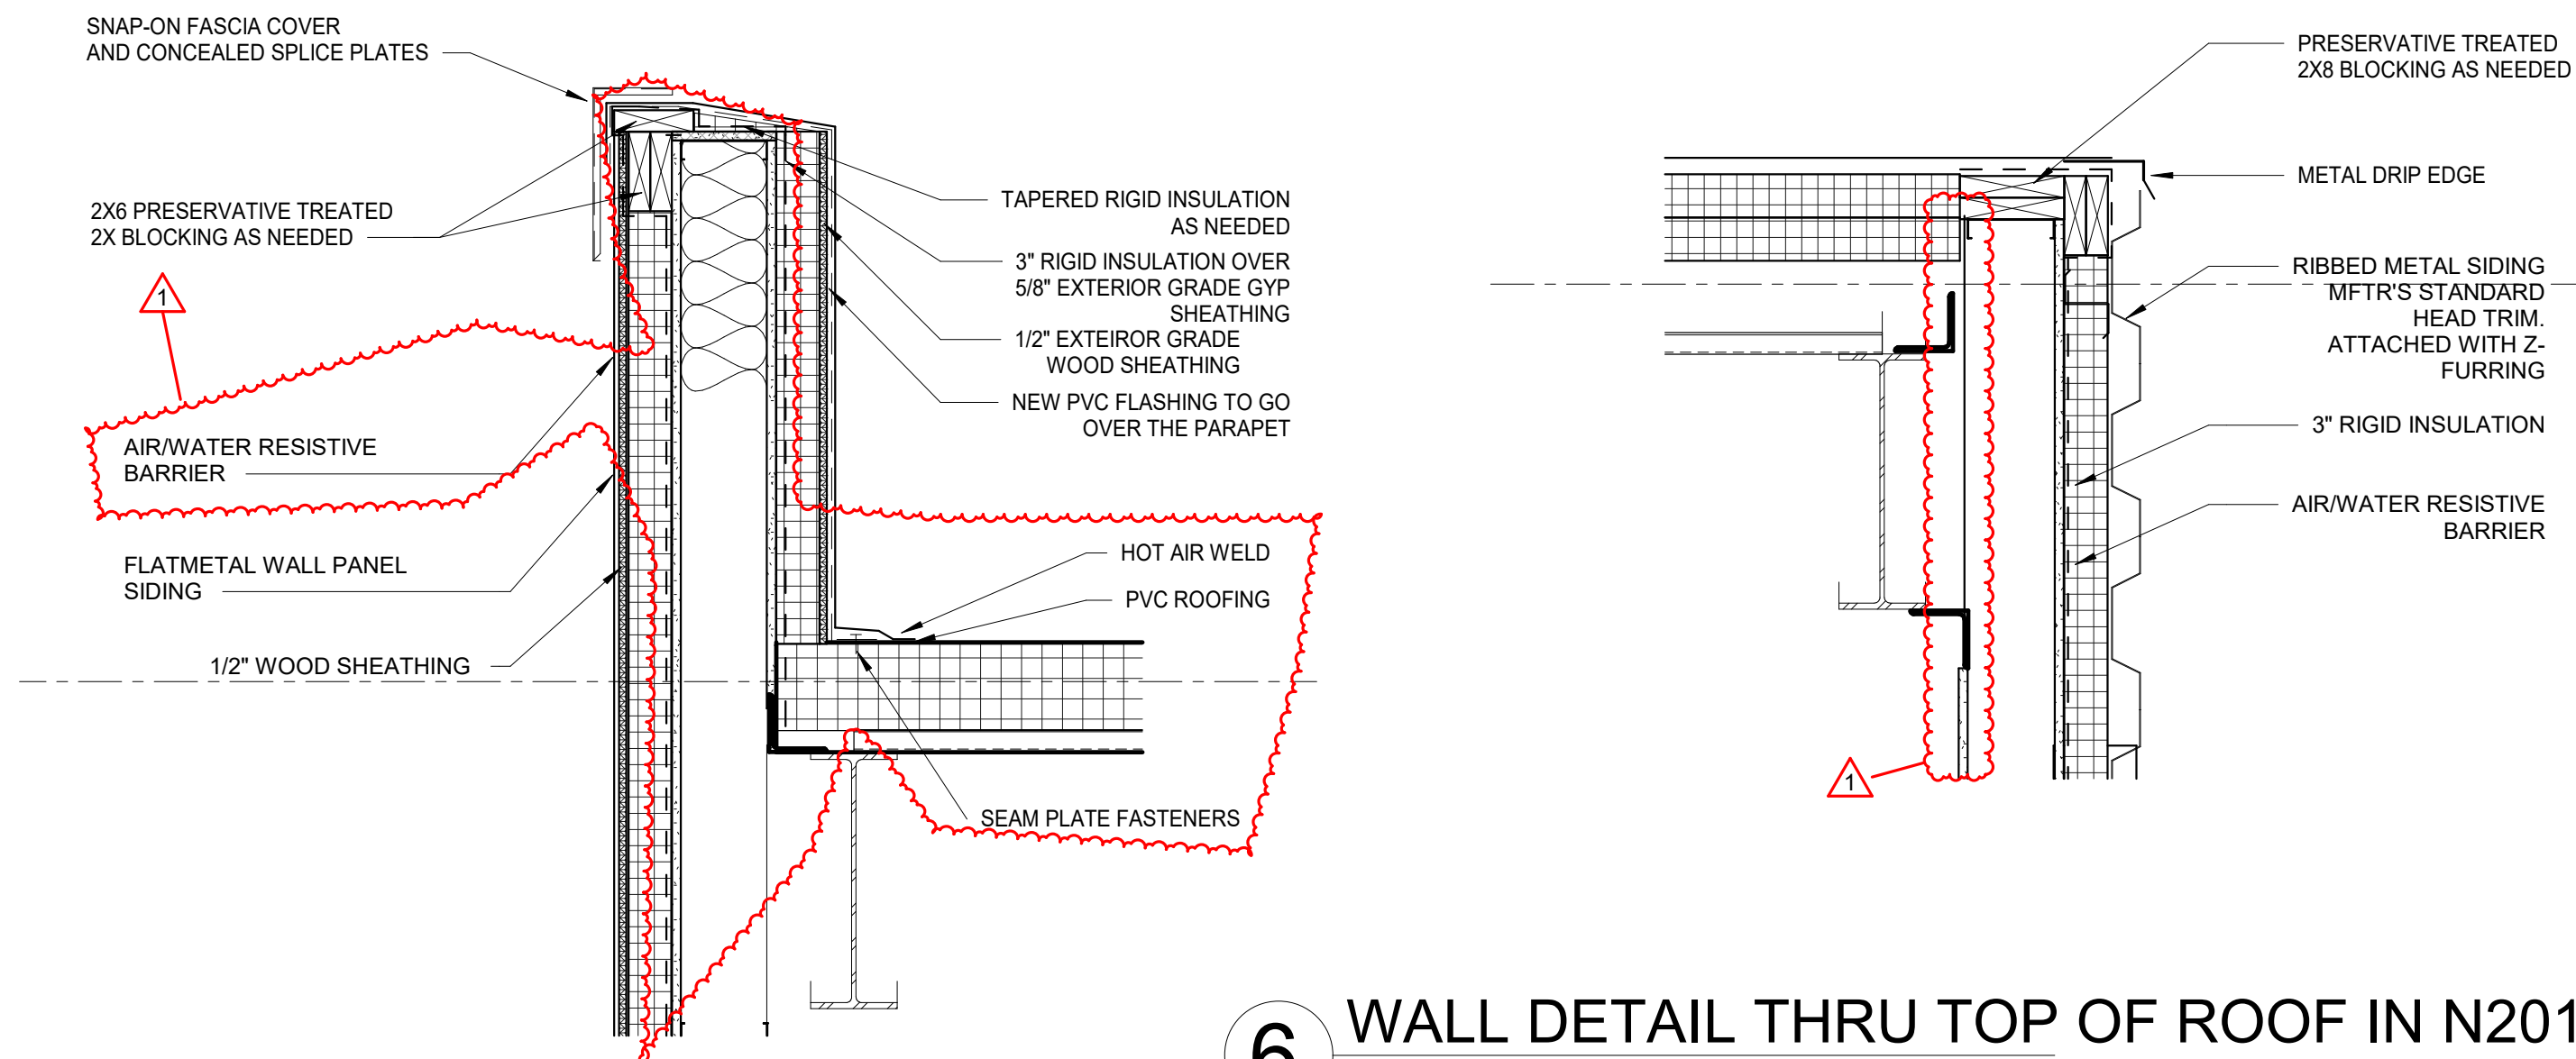

6 WALL DETAIL THRU TOP OF ROOF IN N201 EAST WALL
SCALE: 1" = 1'-0"

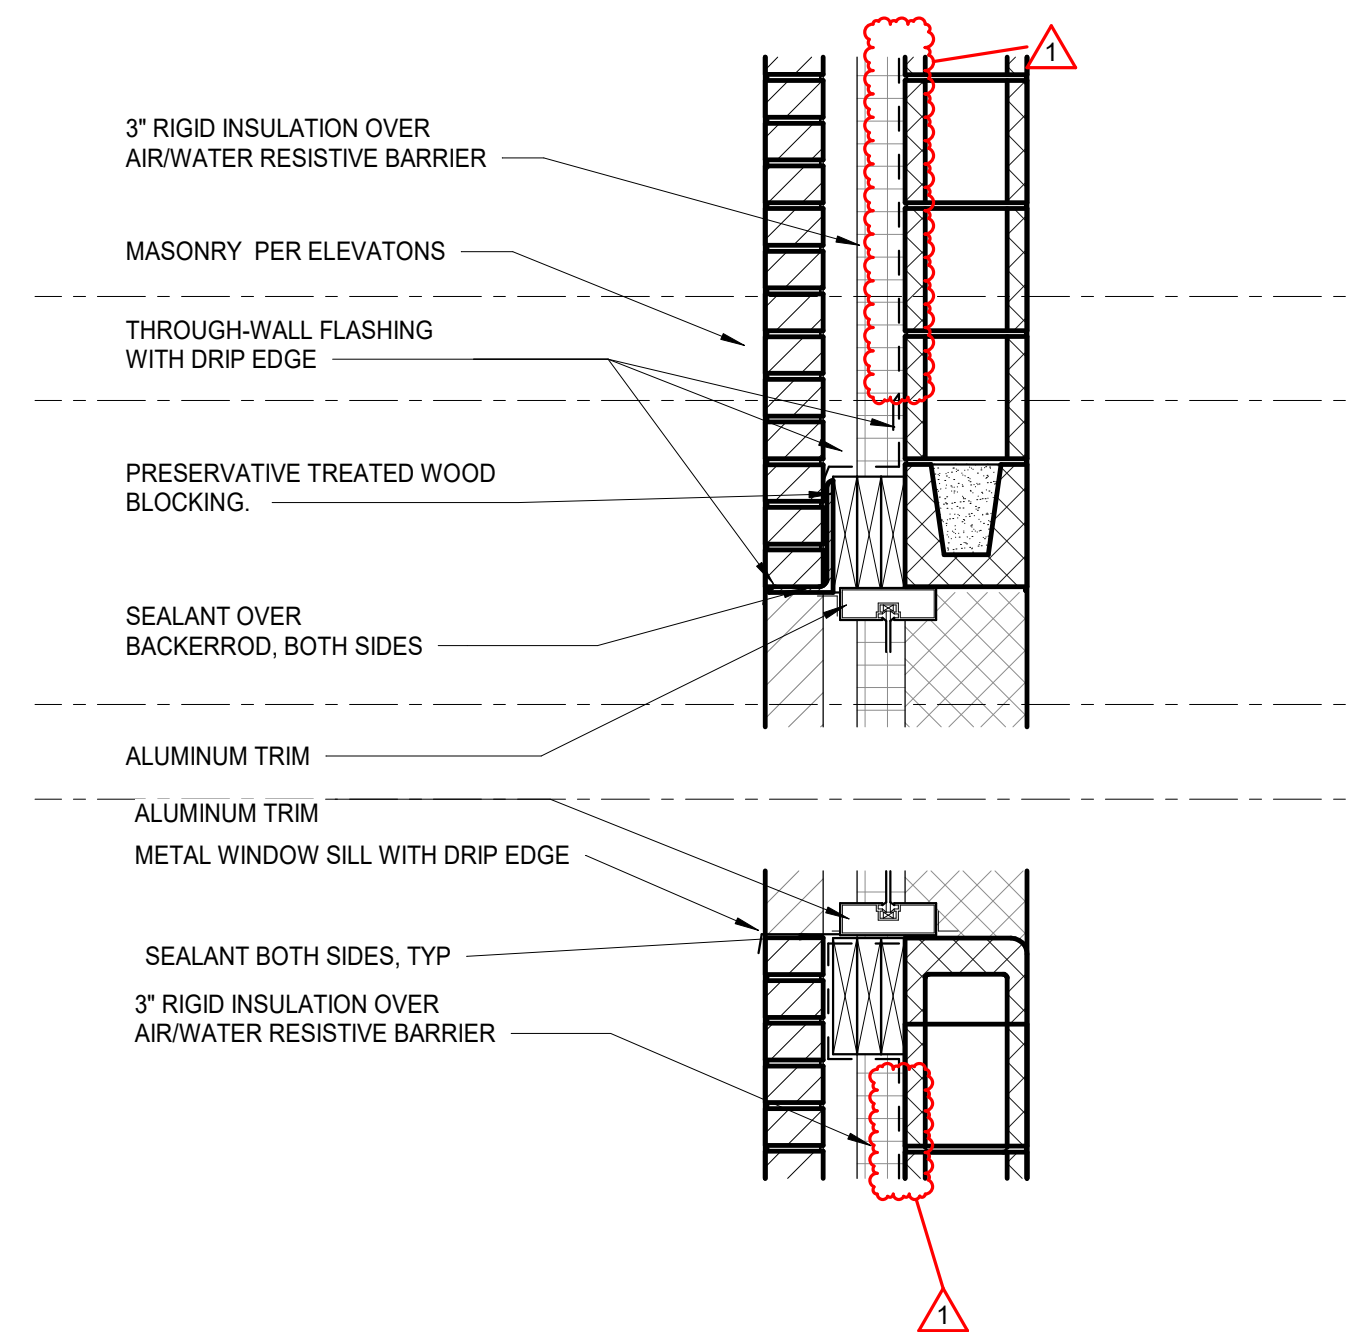


5 WEIGHT ROOM WINDOWS
SCALE: 1" = 1'-0"

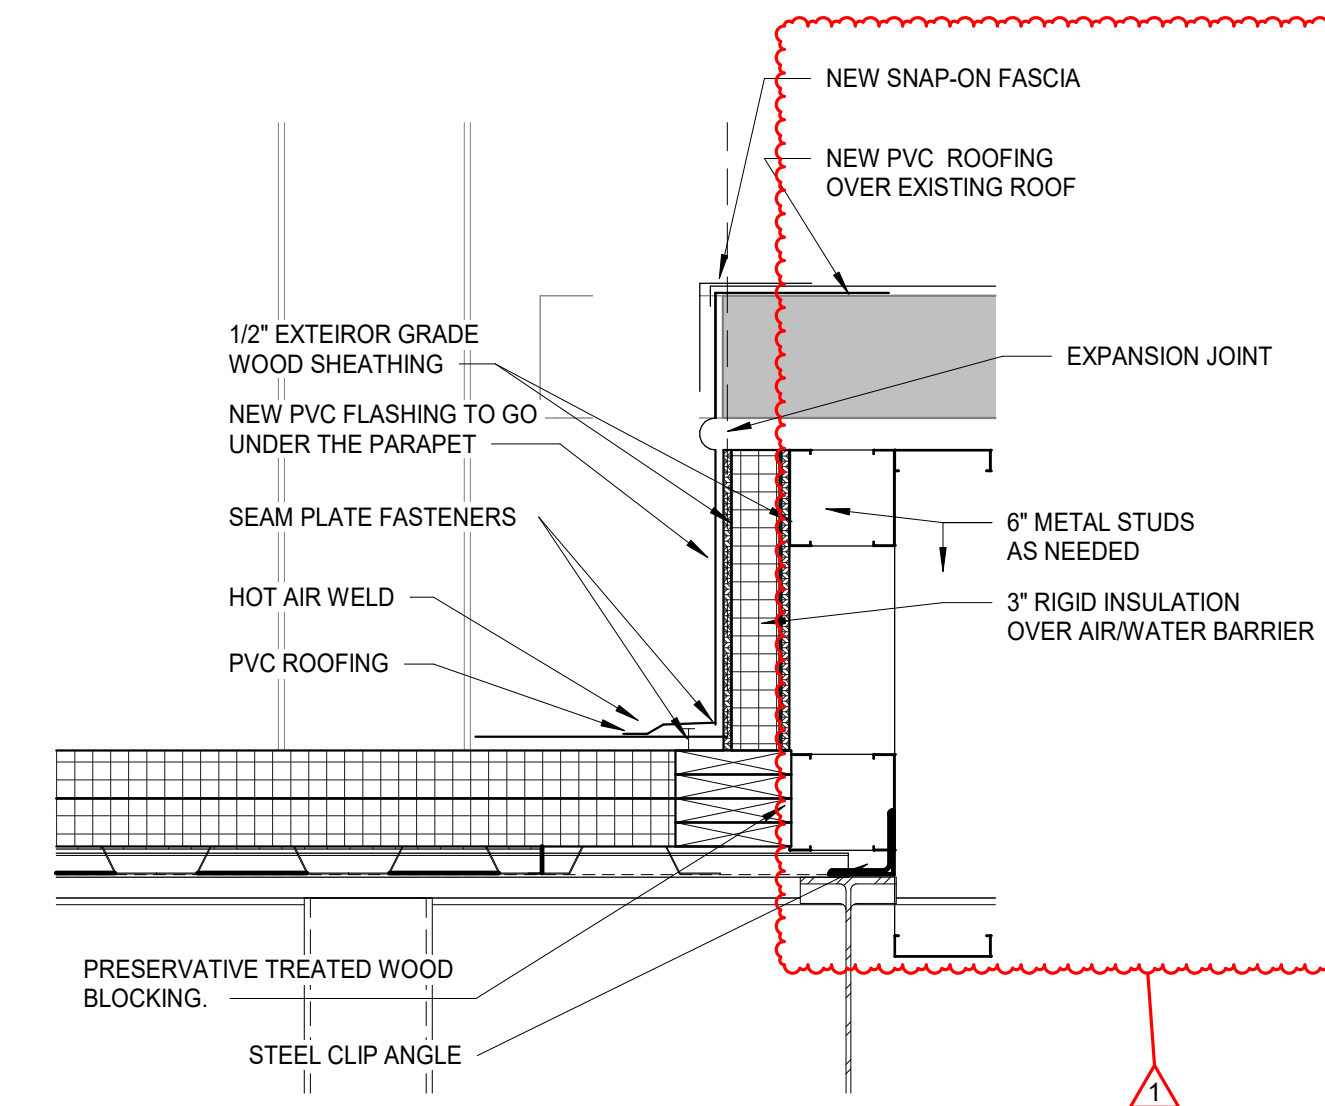


4 WALL DETAIL THRU TOP OF G1000 CORRIDOR
SCALE: 1" = 1'-0"


7 WALL DETAIL THRU EAST WALL PARAPET IN N201 EAST
SCALE: 1" = 1'-0"

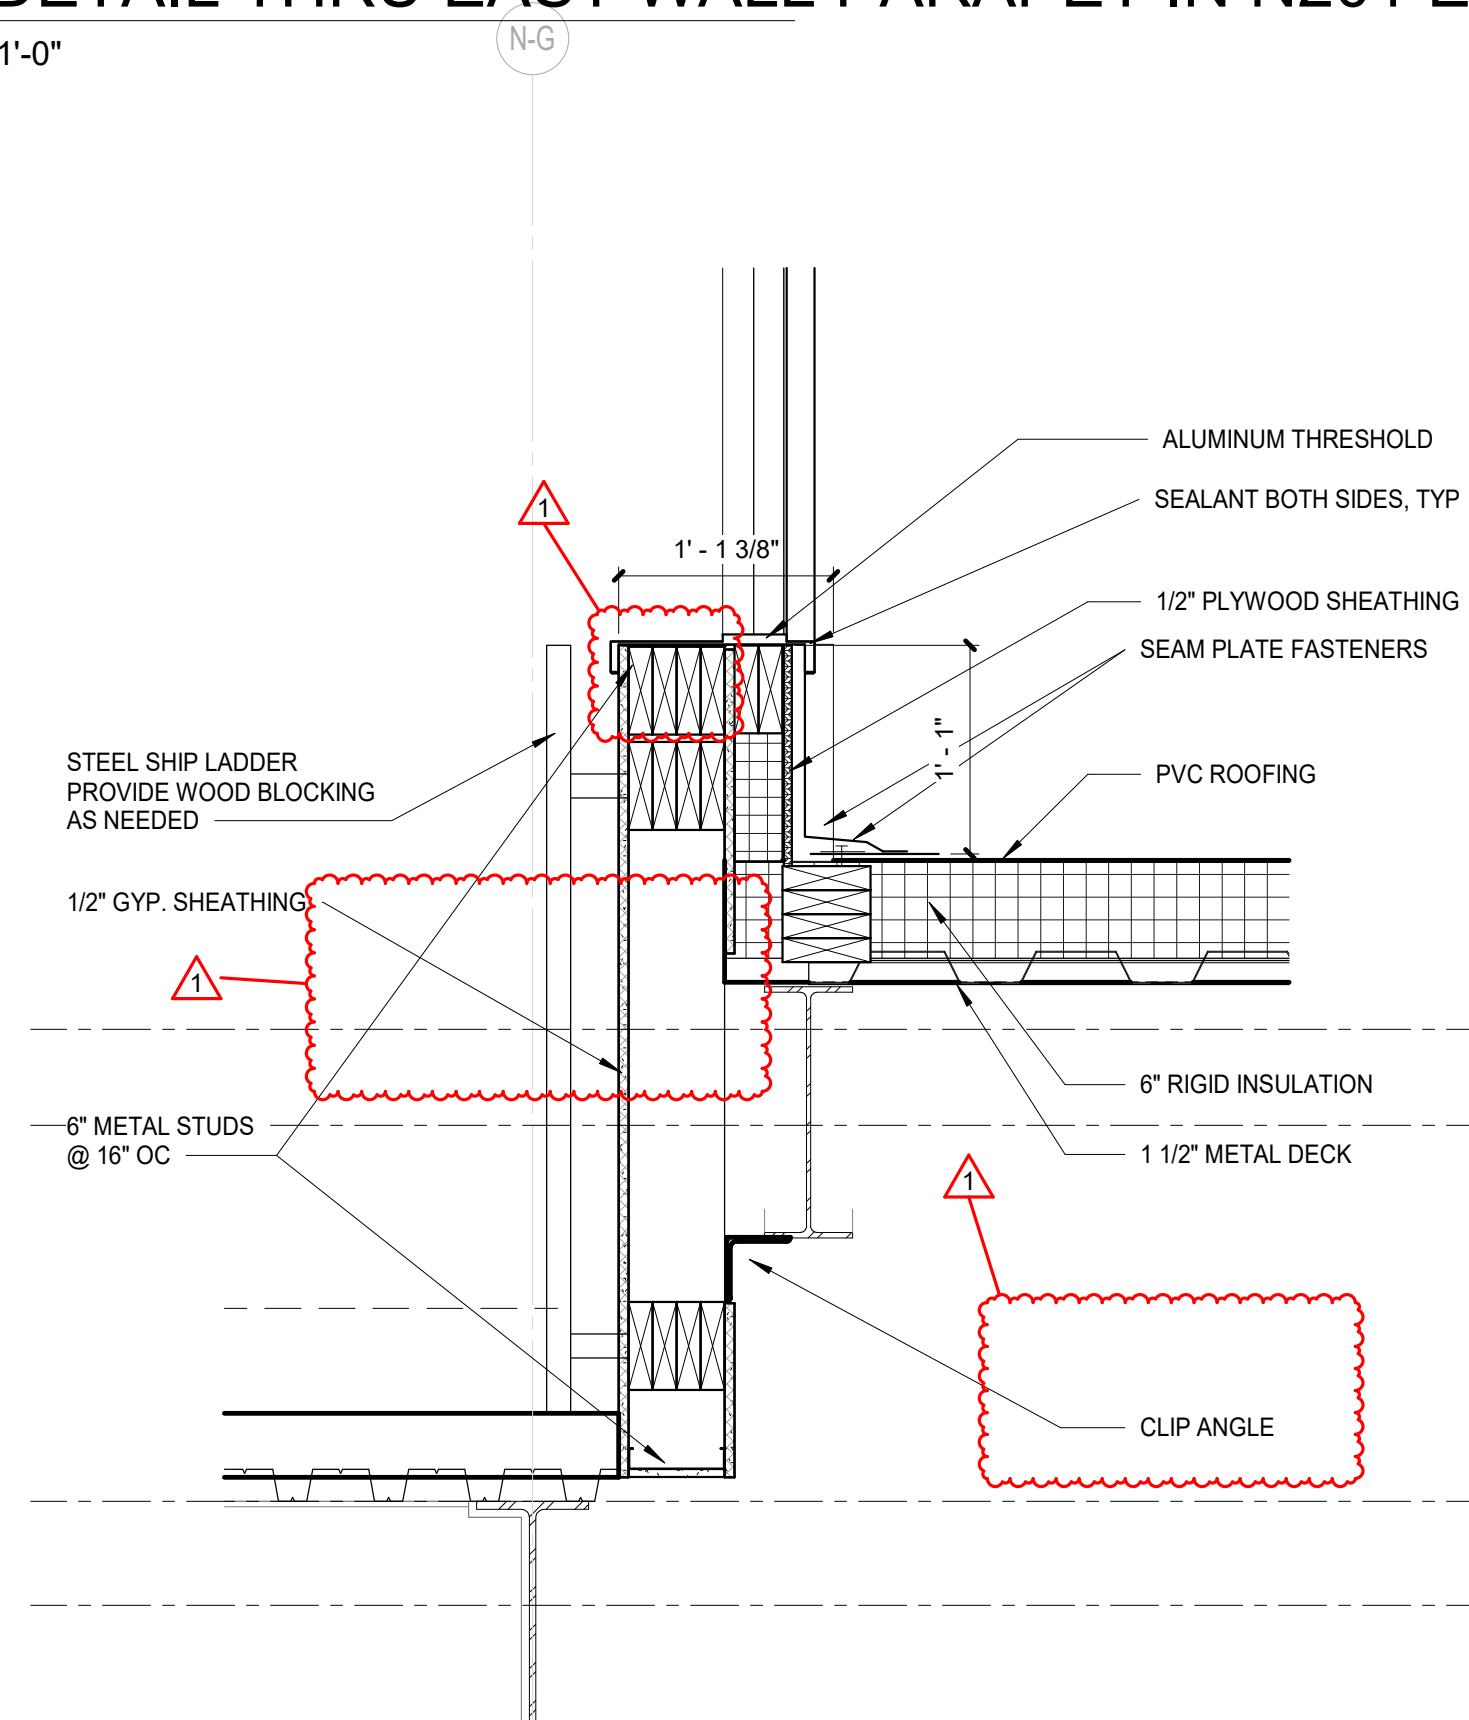


3 WALL DETAIL THRU WEST WALL IN N201 EAST WALL
SCALE: 1" = 1'-0"

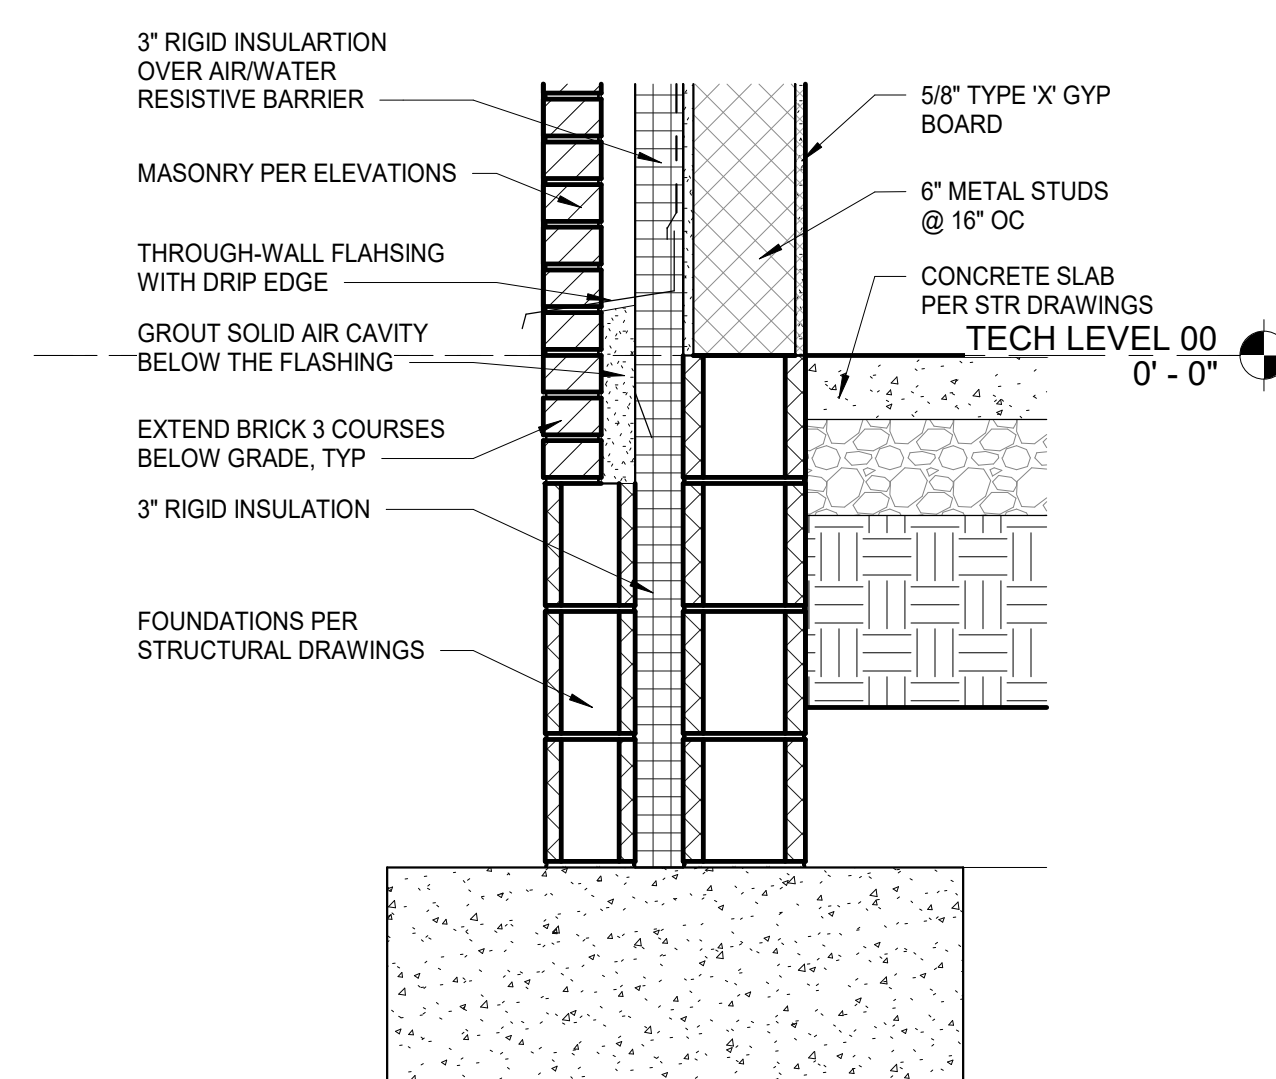


2 WALL DETAIL THRU WEIGHT ROOM WEST WALL FOUNDATION
SCALE: 1" = 1'-0"

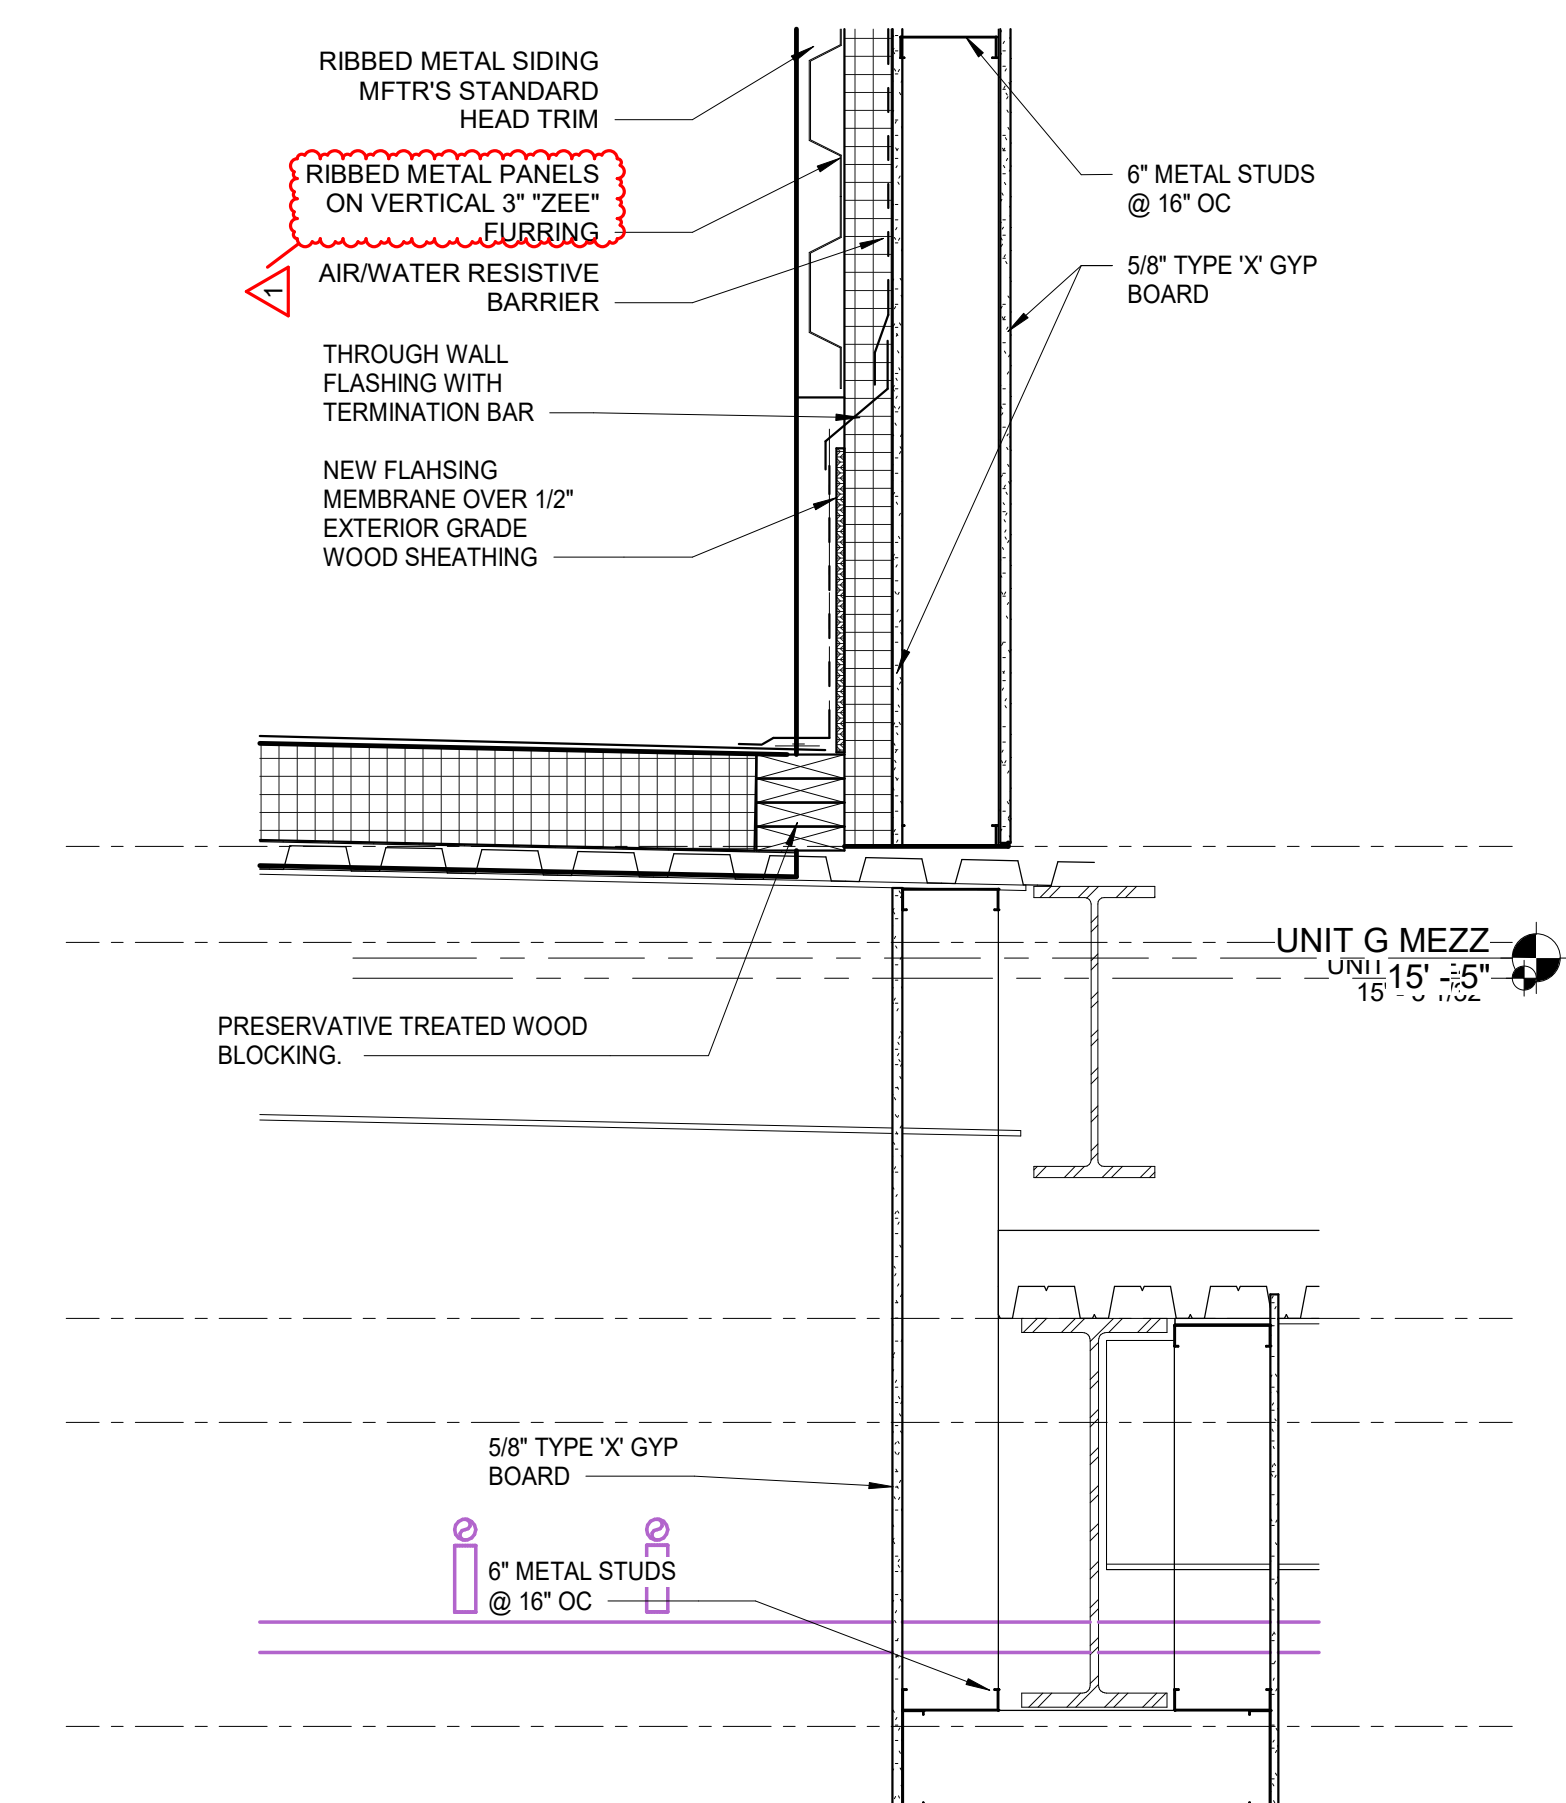


1 WALL DETAIL THRU WEST WALL IN N201 WEST
SCALE: 1" = 1'-0"

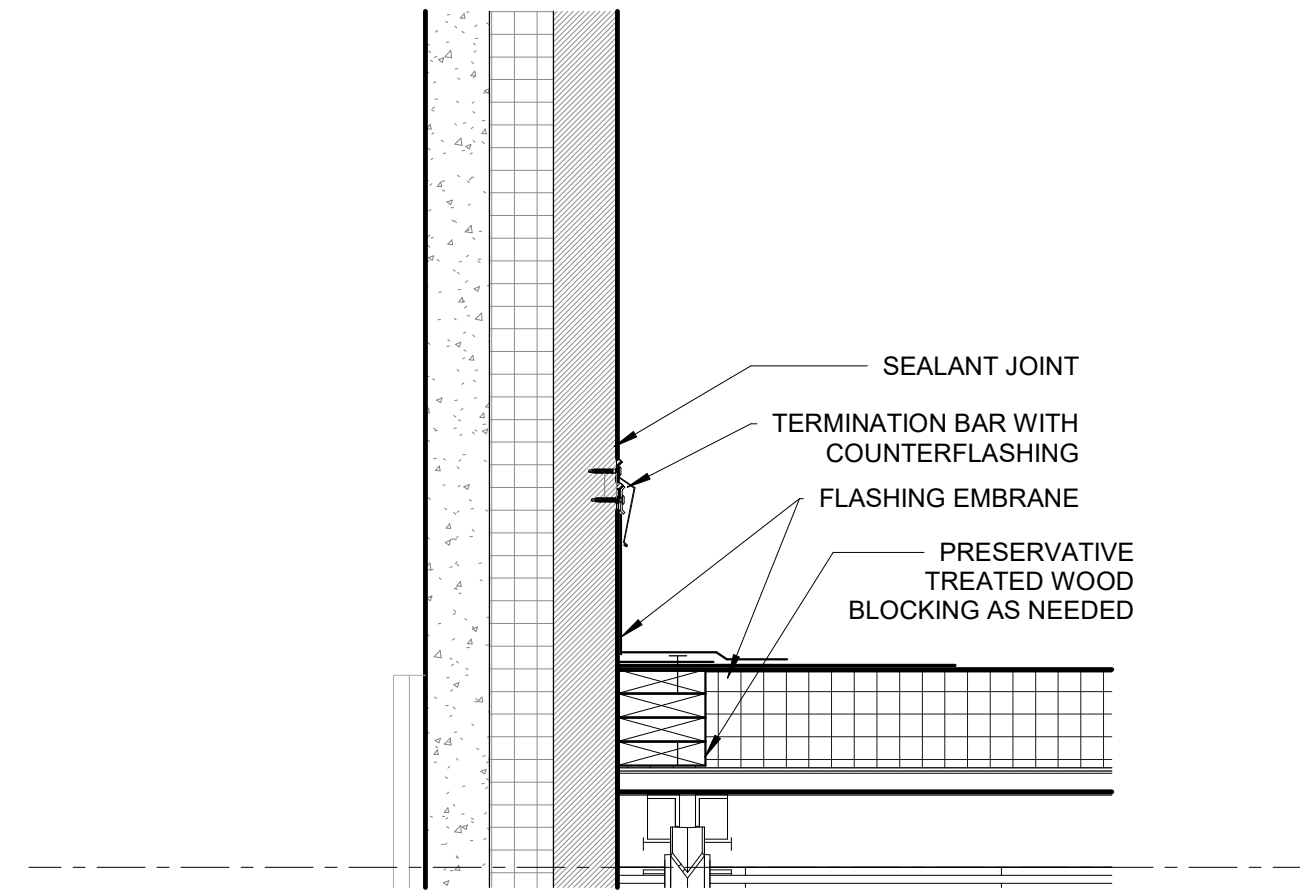


9 LOW ROOF @ PRECAST
SCALE: 1" = 1'-0"

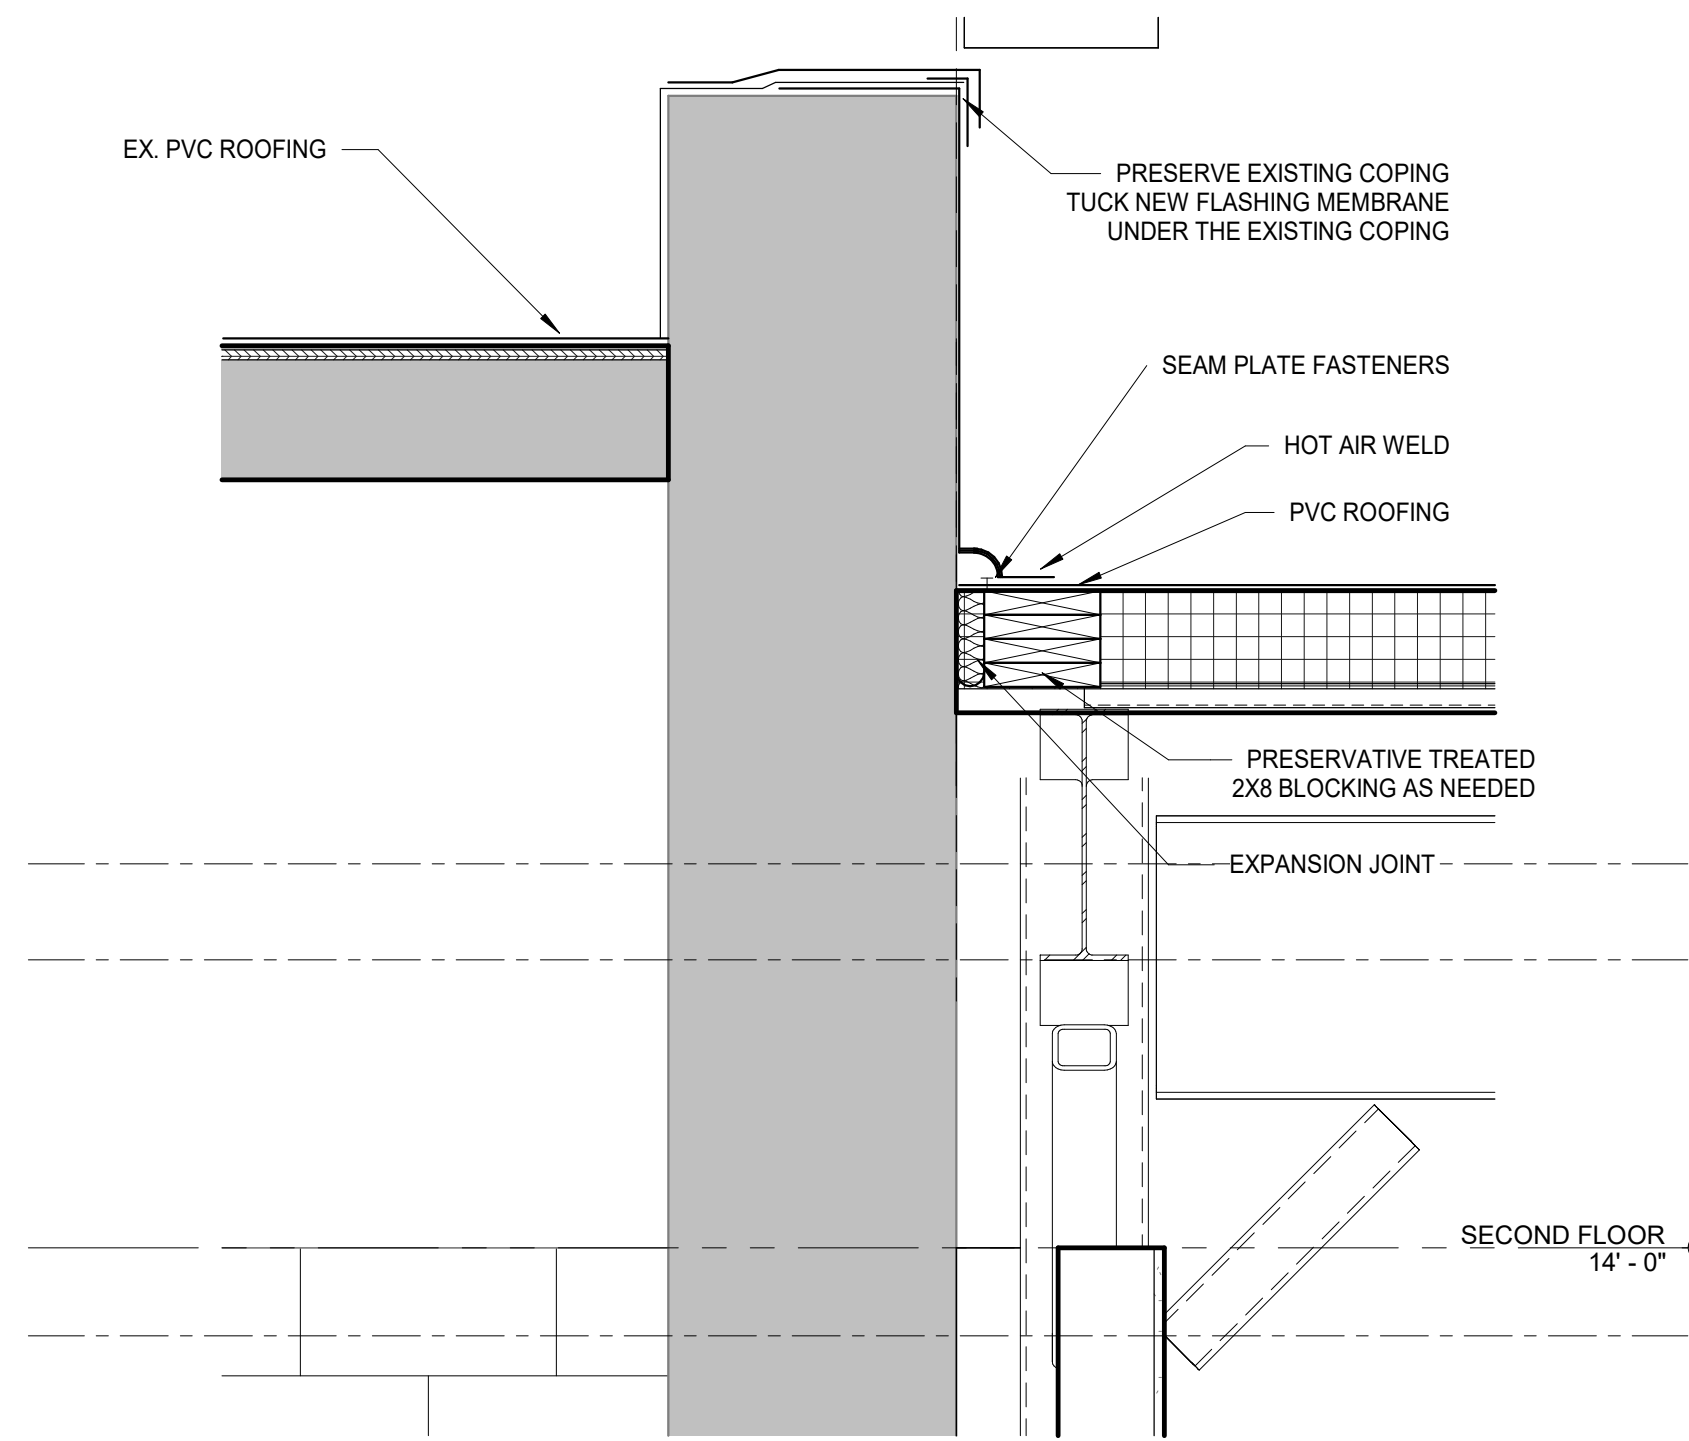


6 BUILDING DETAIL THROUGH PARAPET OF TRAINING CENTER WEST WALL
SCALE: 1" = 1'-0"

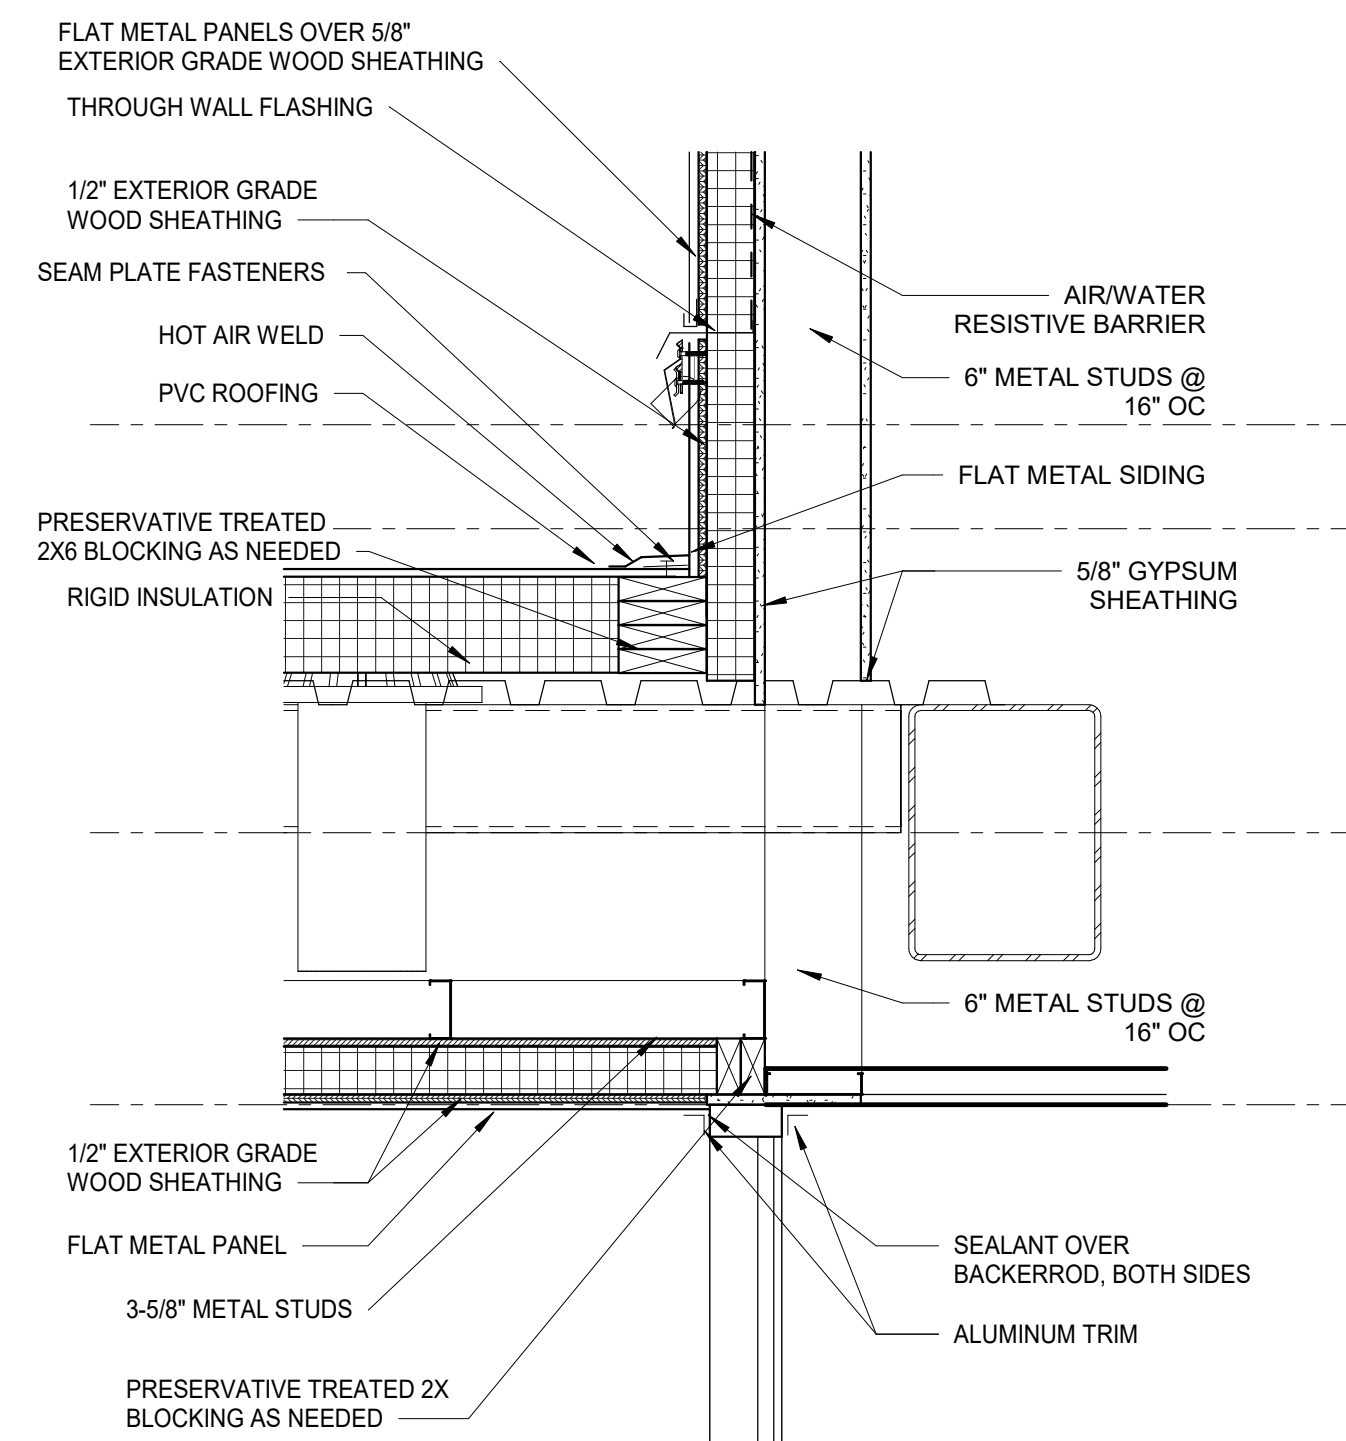


3 WALL DETAIL THRU WEST ENTRANCE
SCALE: 1" = 1'-0"

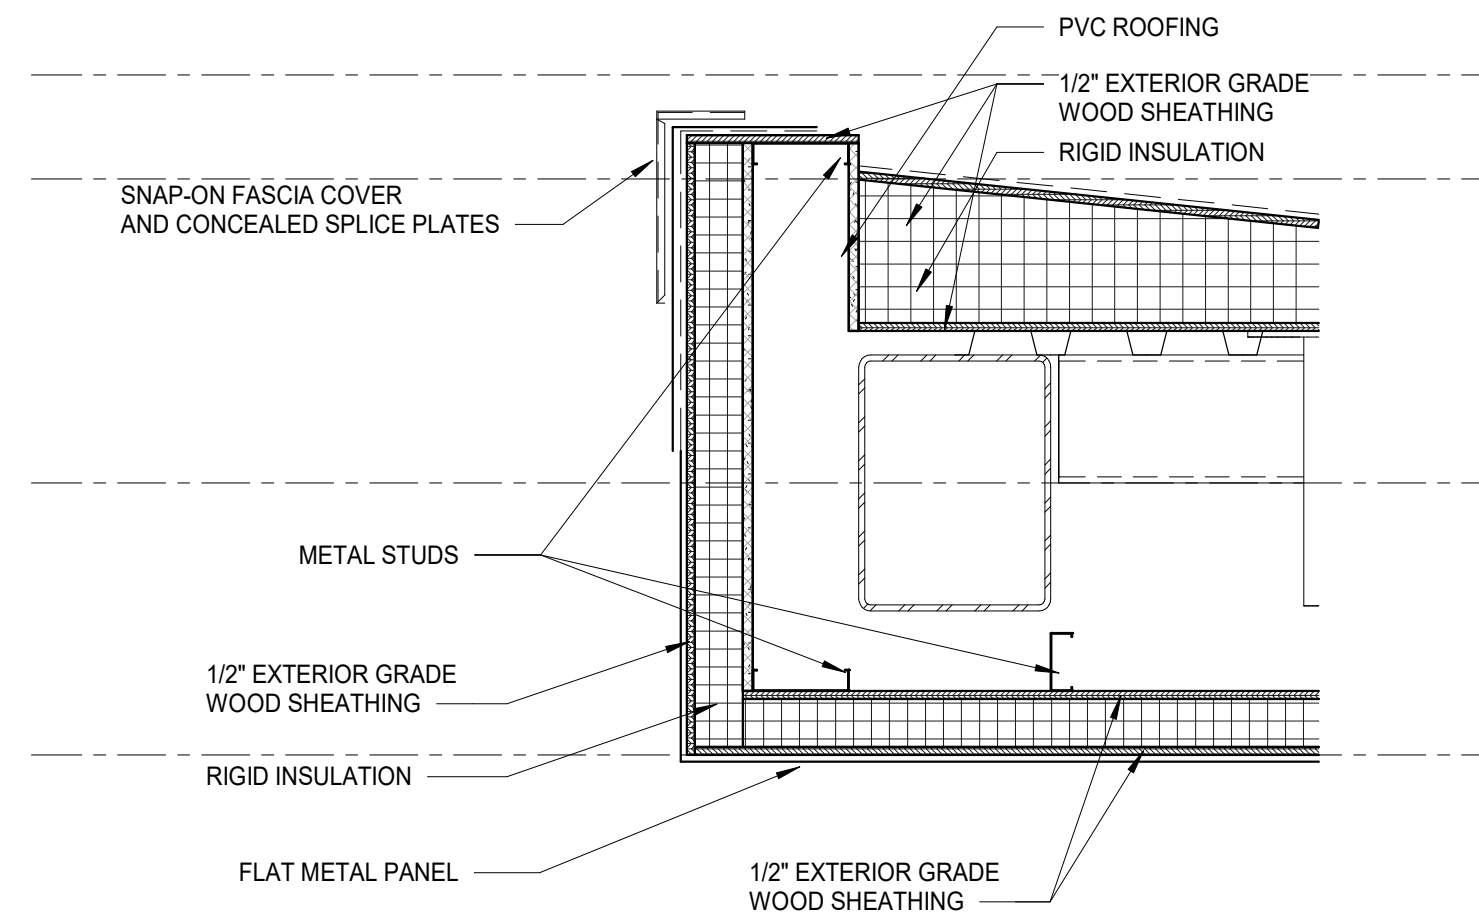


8 ROOF DETAIL THRU WEST ENTRANCE ROOF
SCALE: 1" = 1'-0"

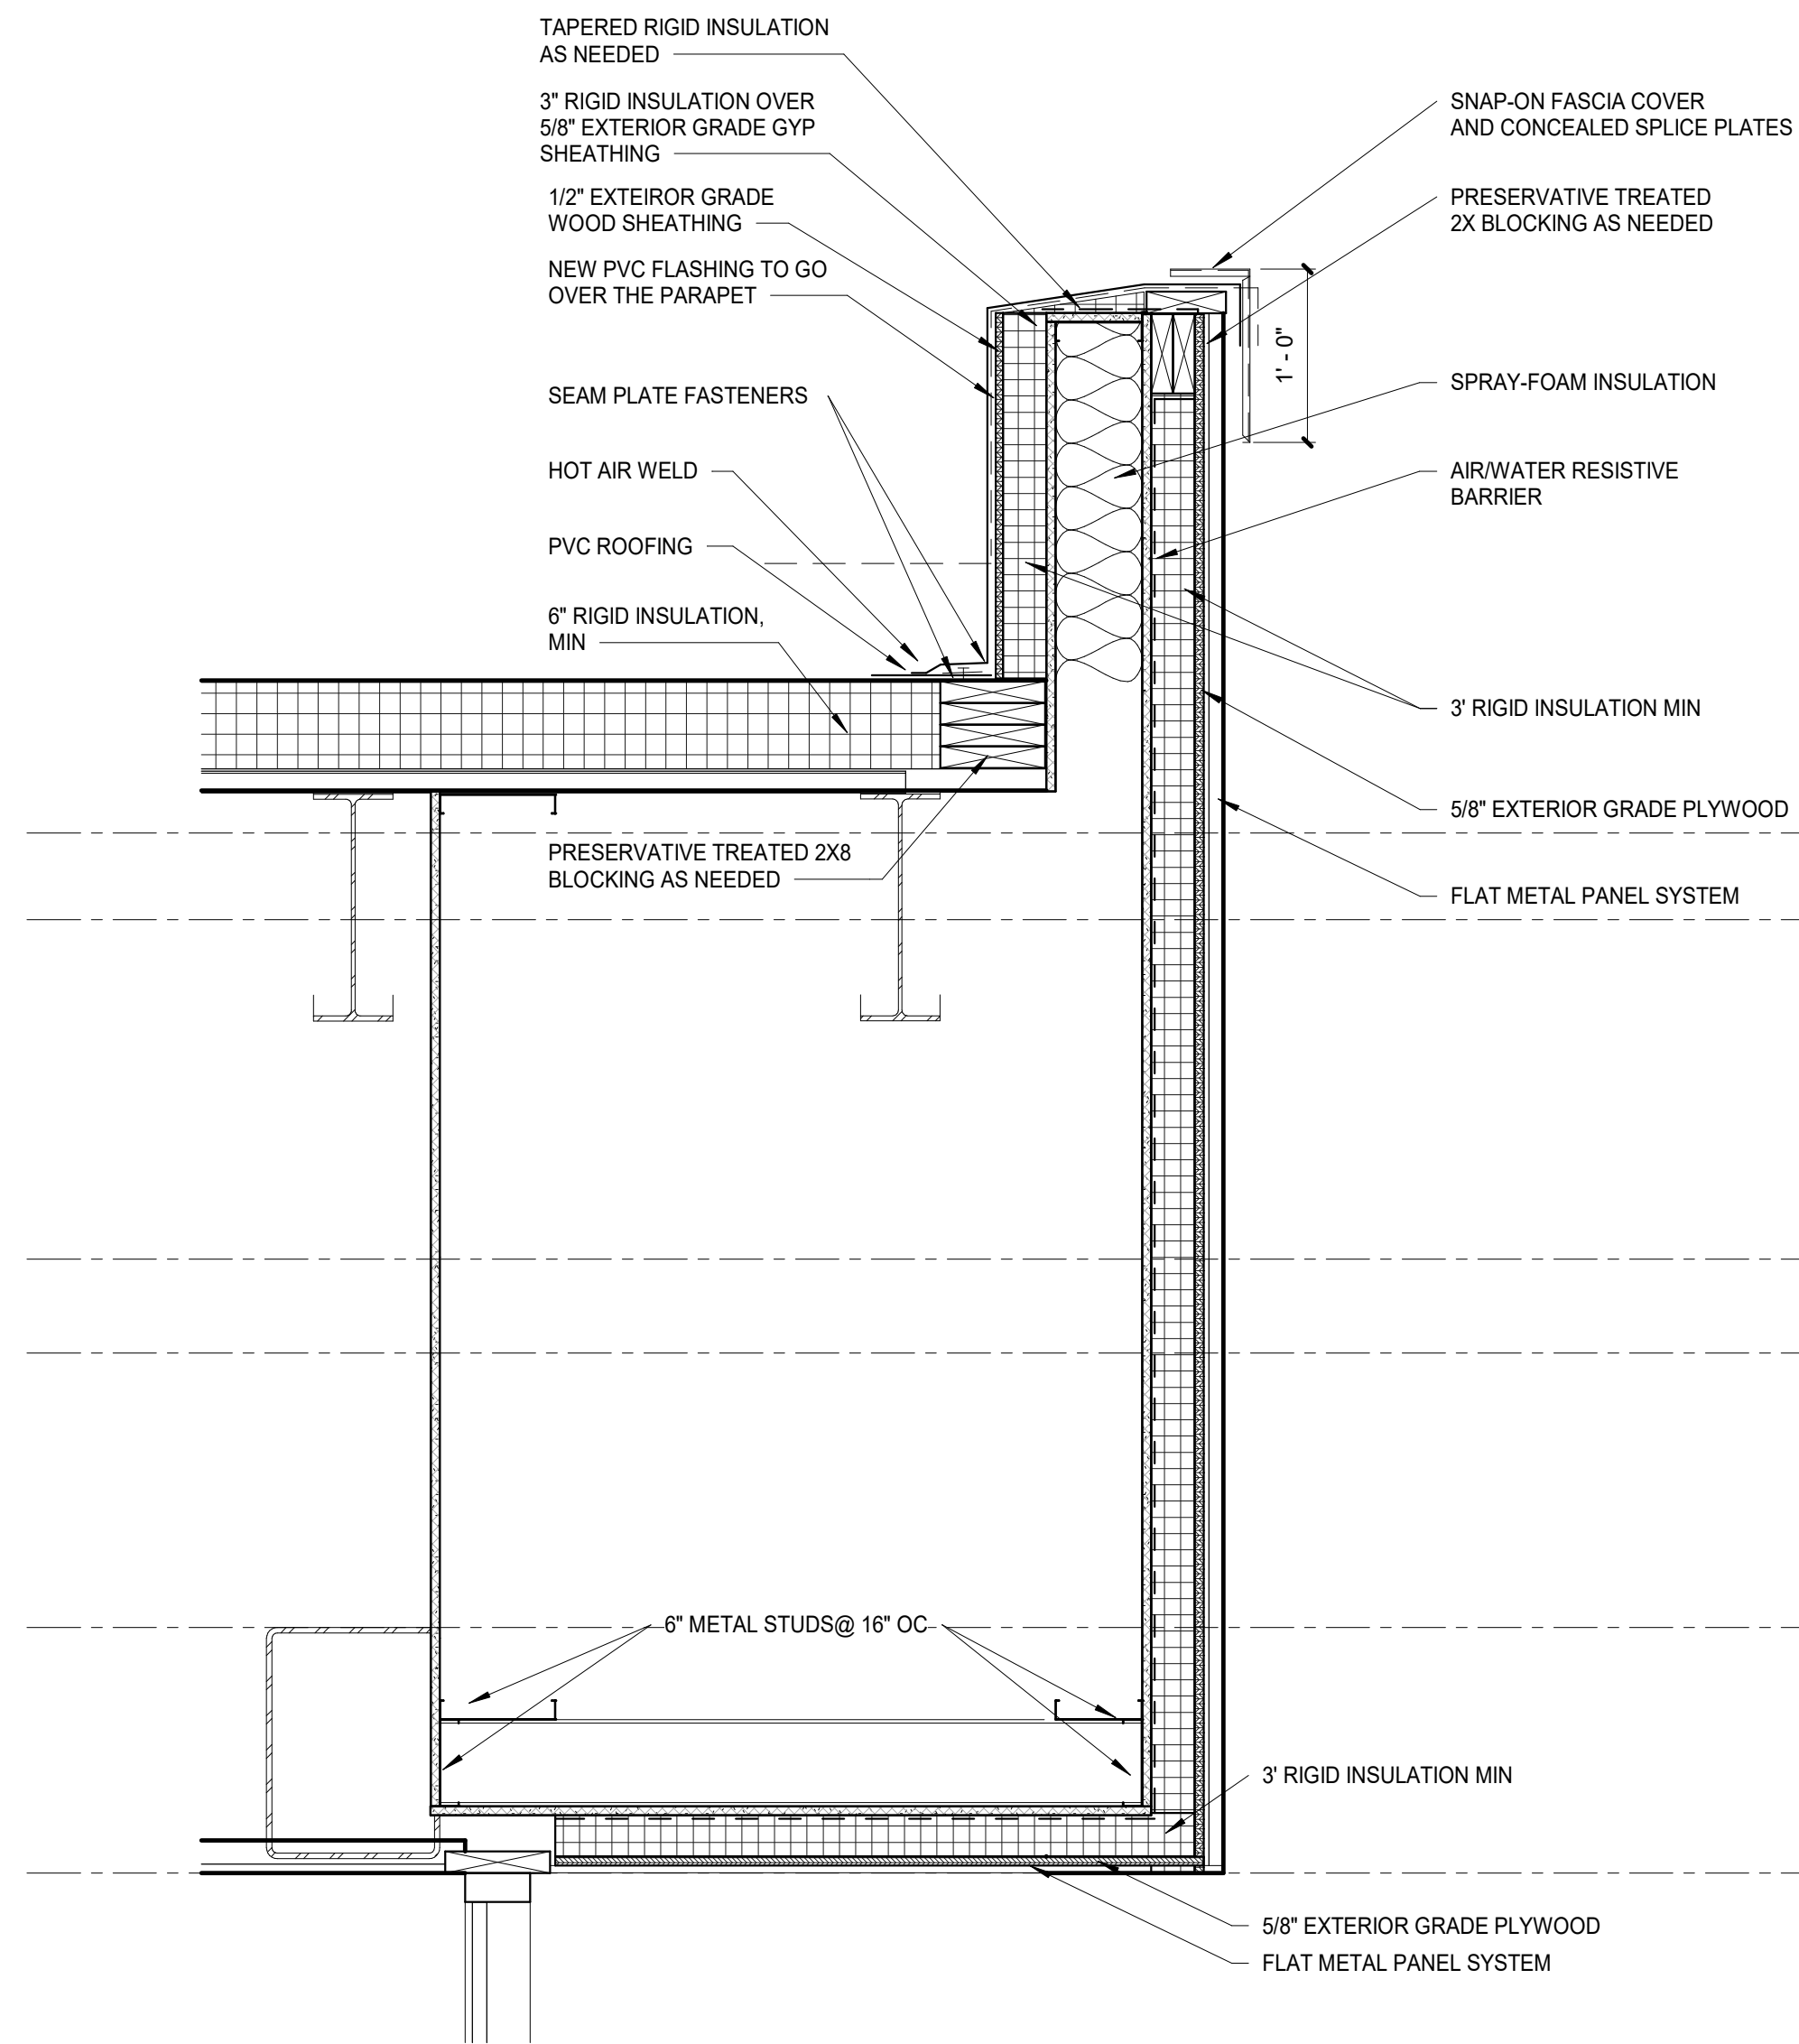


5 BUILDING DETAIL THRU PARAPET EAST N202 VEST
SCALE: 1" = 1'-0"

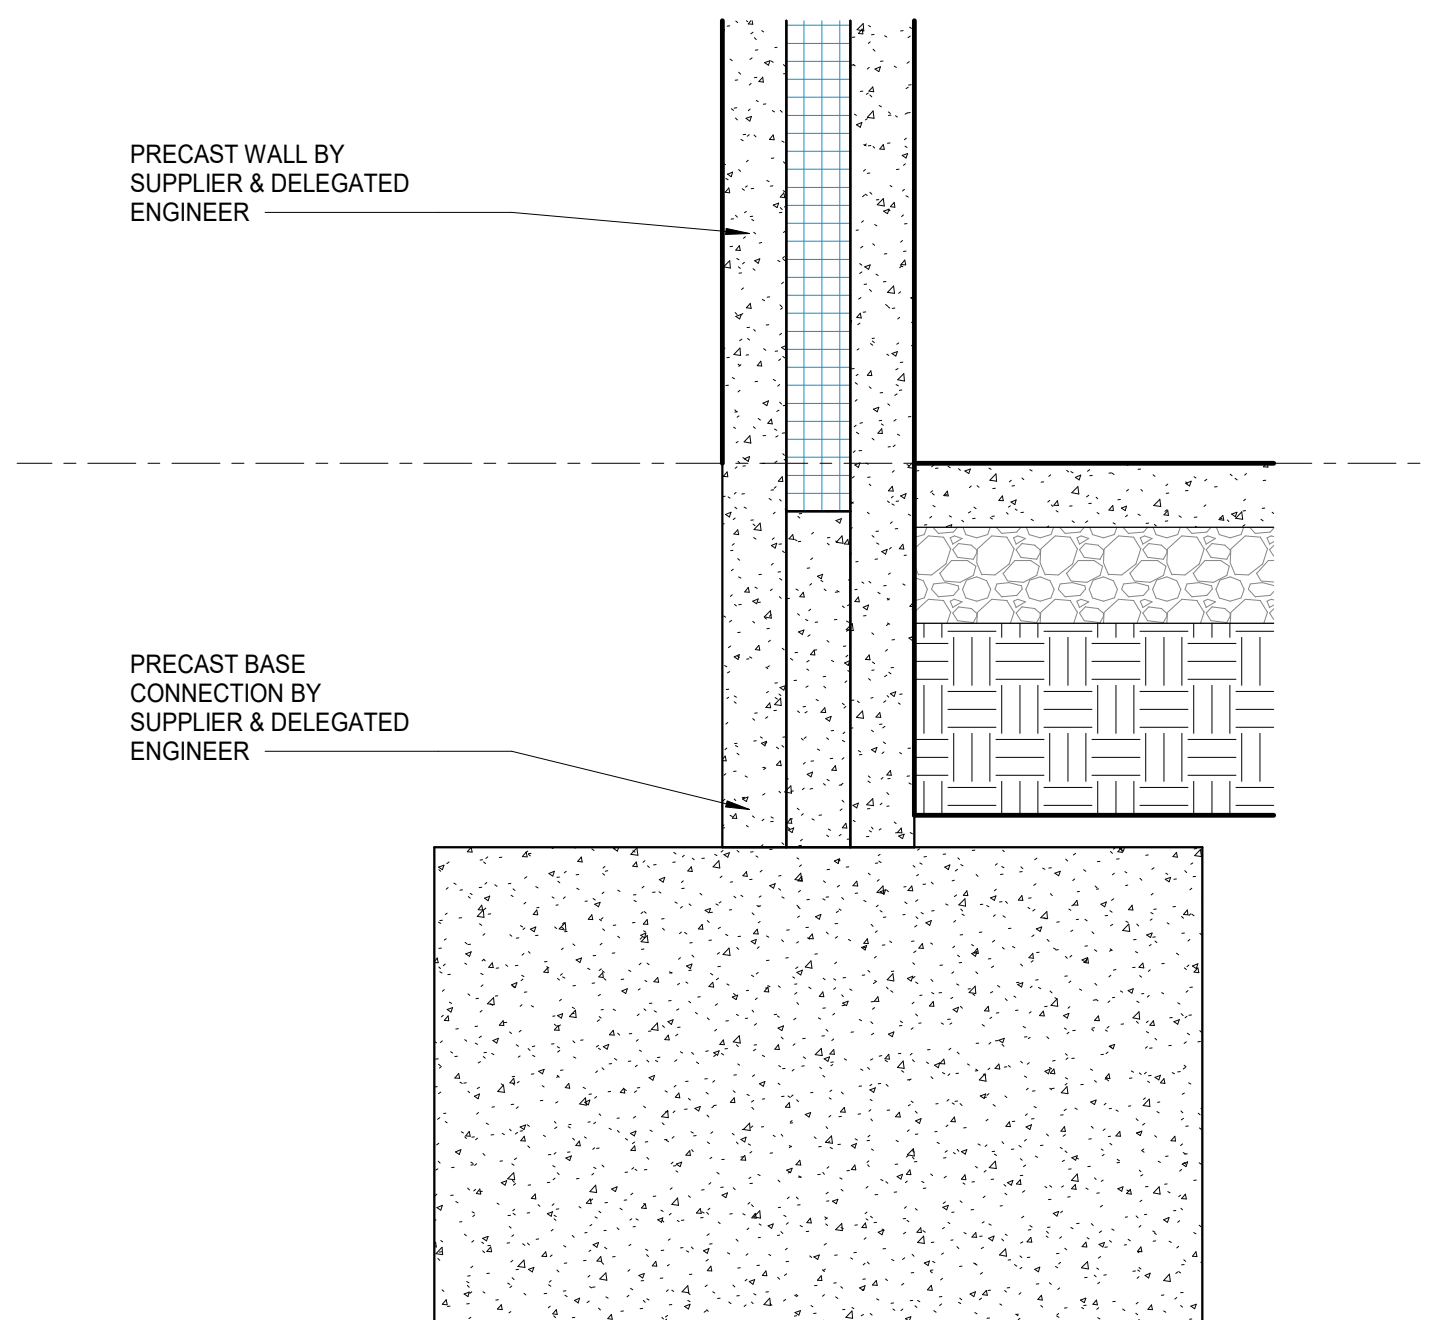


2 WALL DETAIL THRU FOUNDATION WEST WALL IN FIELDHOUSE
SCALE: 1" = 1'-0"

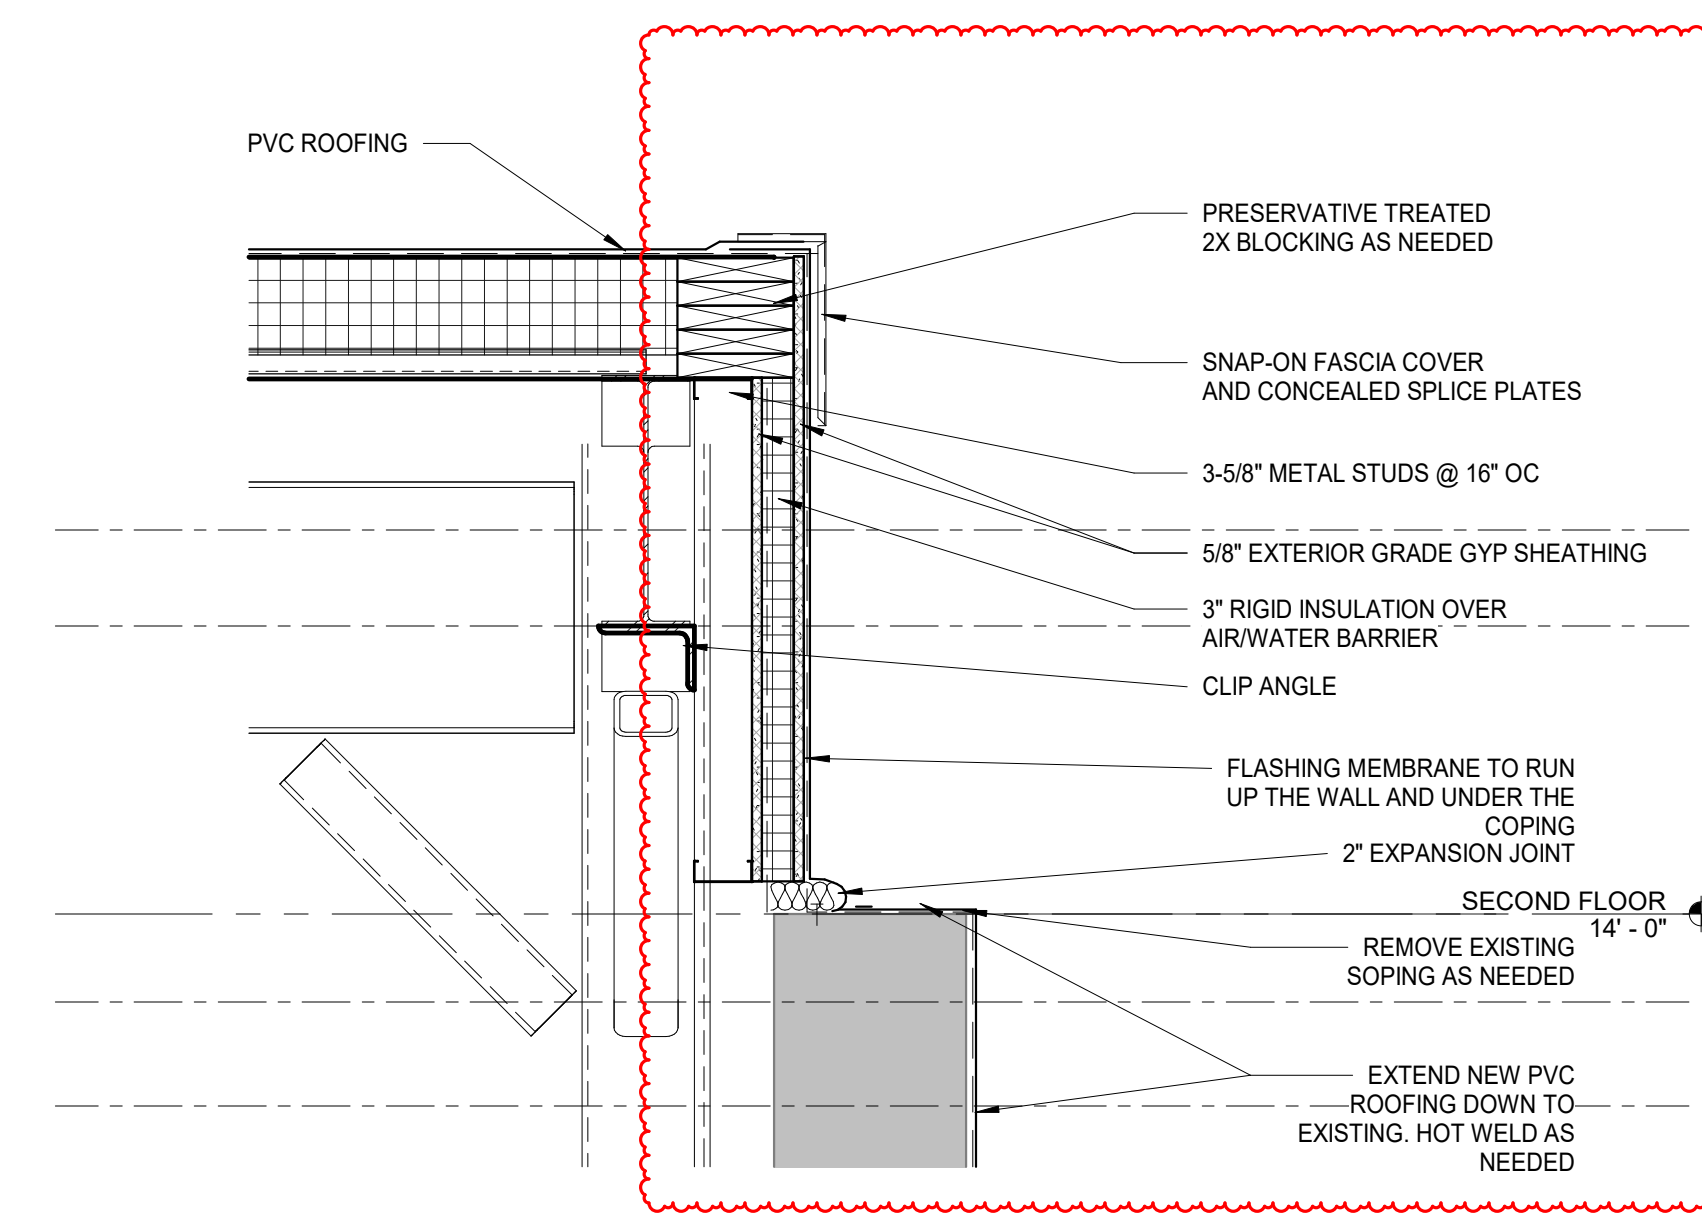

7 BUILDING DETAIL THROUGH PARAPET OF G1002 EAST WALL
SCALE: 1" = 1'-0"

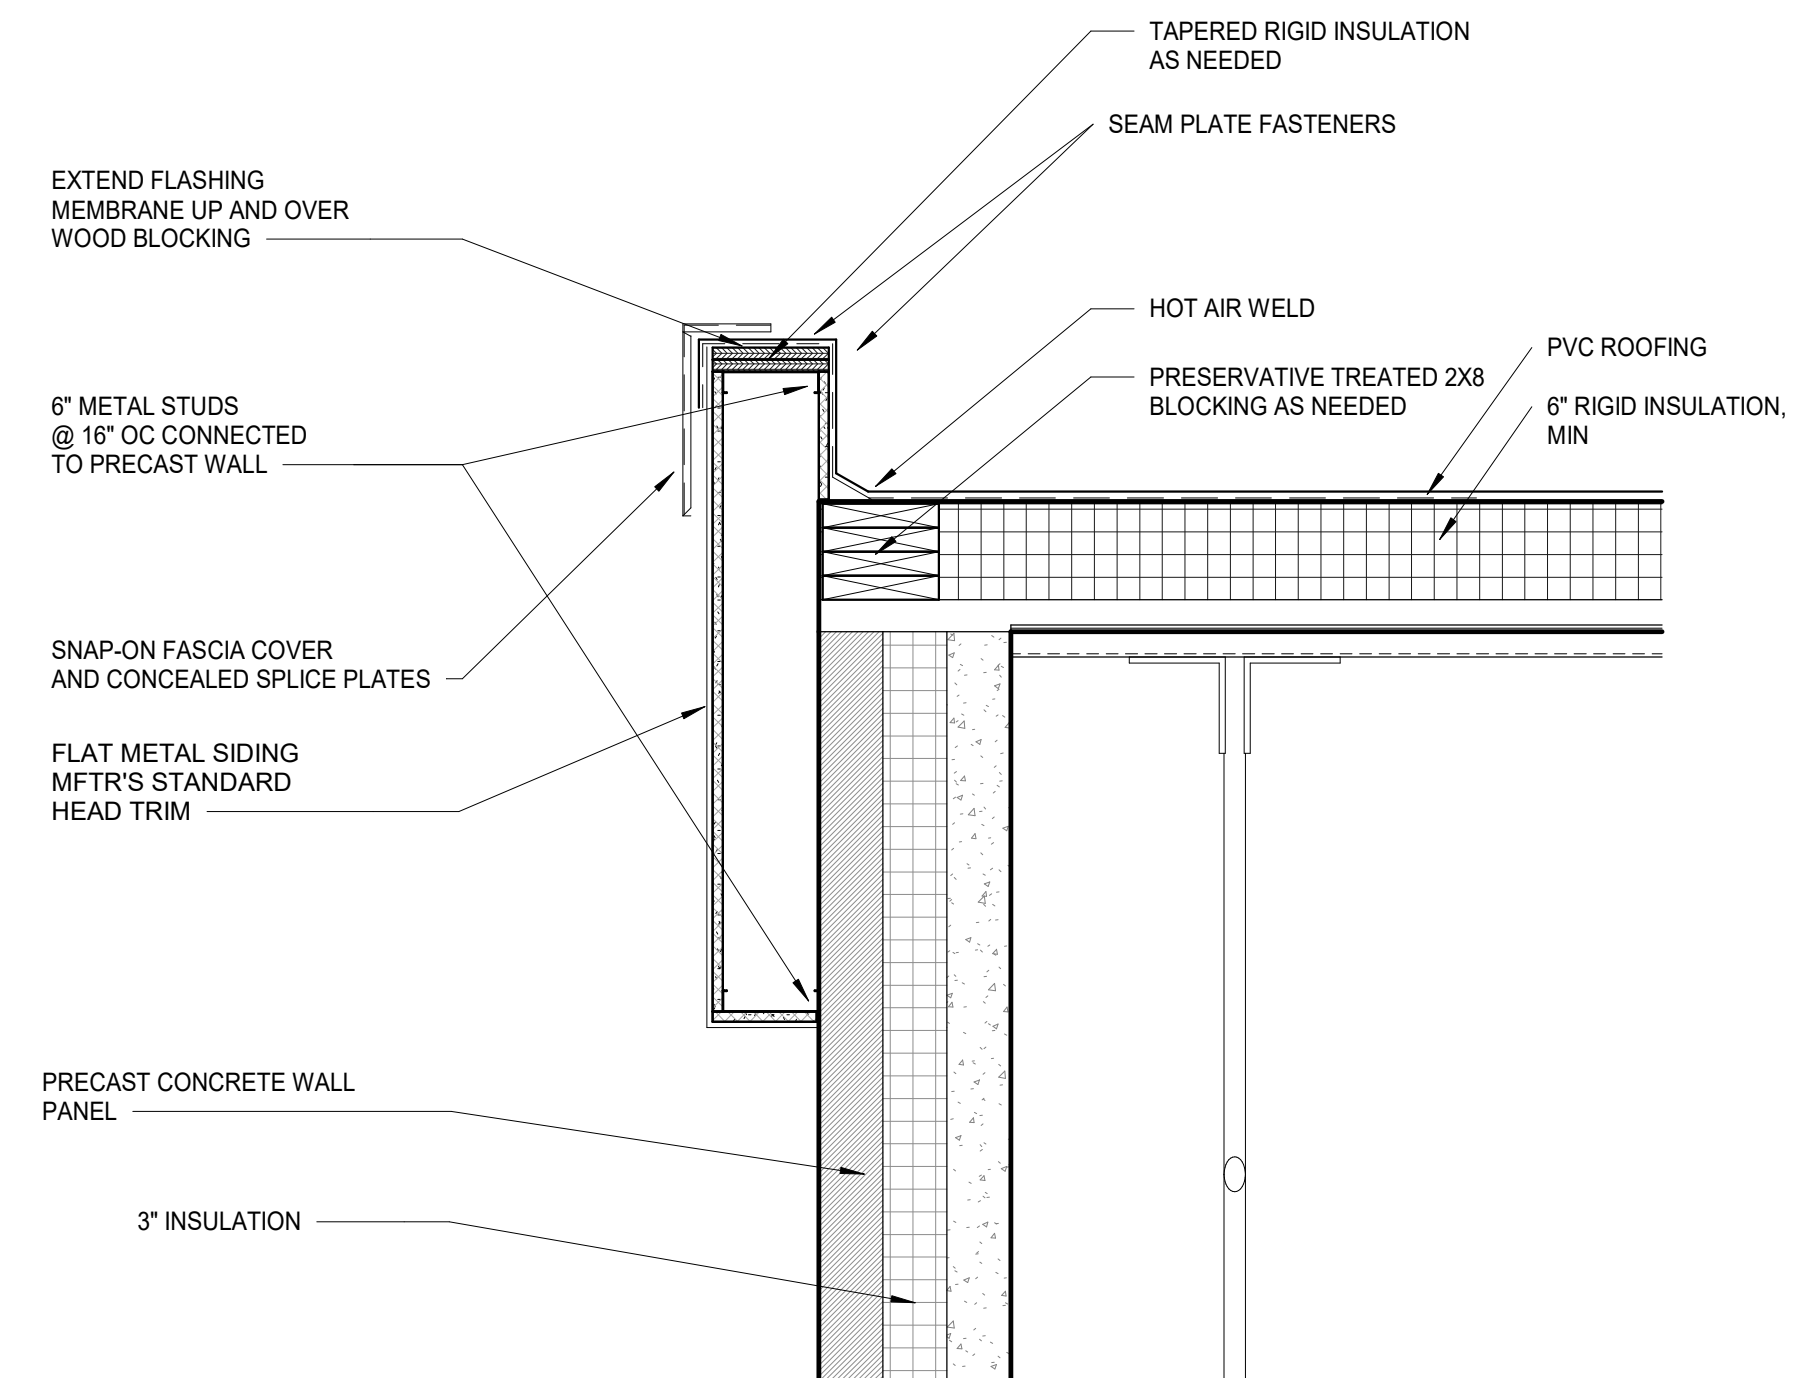

4 WALL DETAIL THRU PARAPET WEST WALL IN FIELDHOUSE
SCALE: 1" = 1'-0"

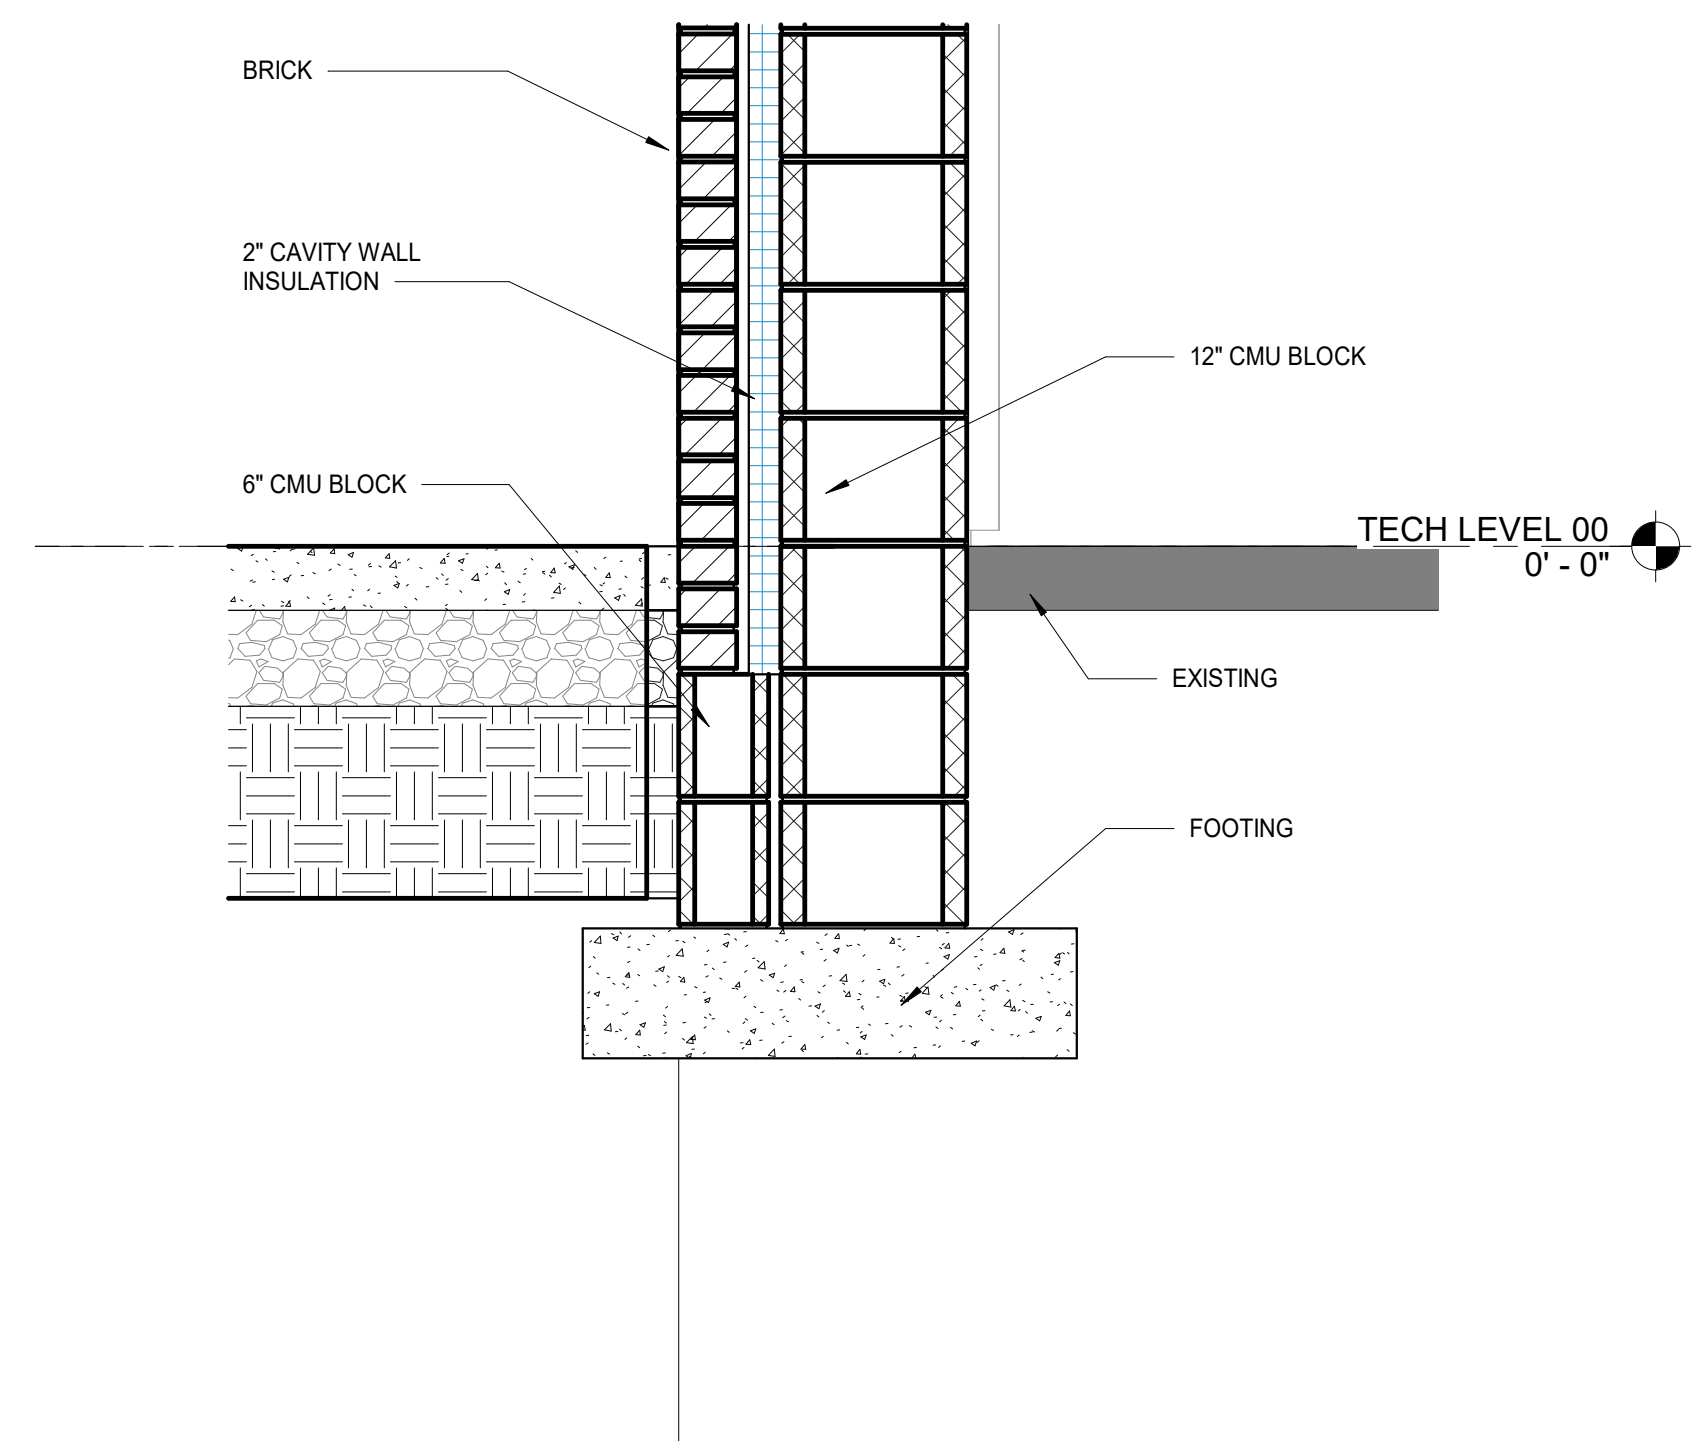


1 WALL DETAIL THRU FOUNDATION EAST WALL IN WEIGHT ROOM
SCALE: 1" = 1'-0"




REVISIONS:		Date	Desc.
#			
1		07-16-2025	ADD#1

100% CONSTRUCTION DOCUMENTS	
PROJECT:	#22130
DATE:	06-06-2025
DRAWN BY:	Author


DETAILS

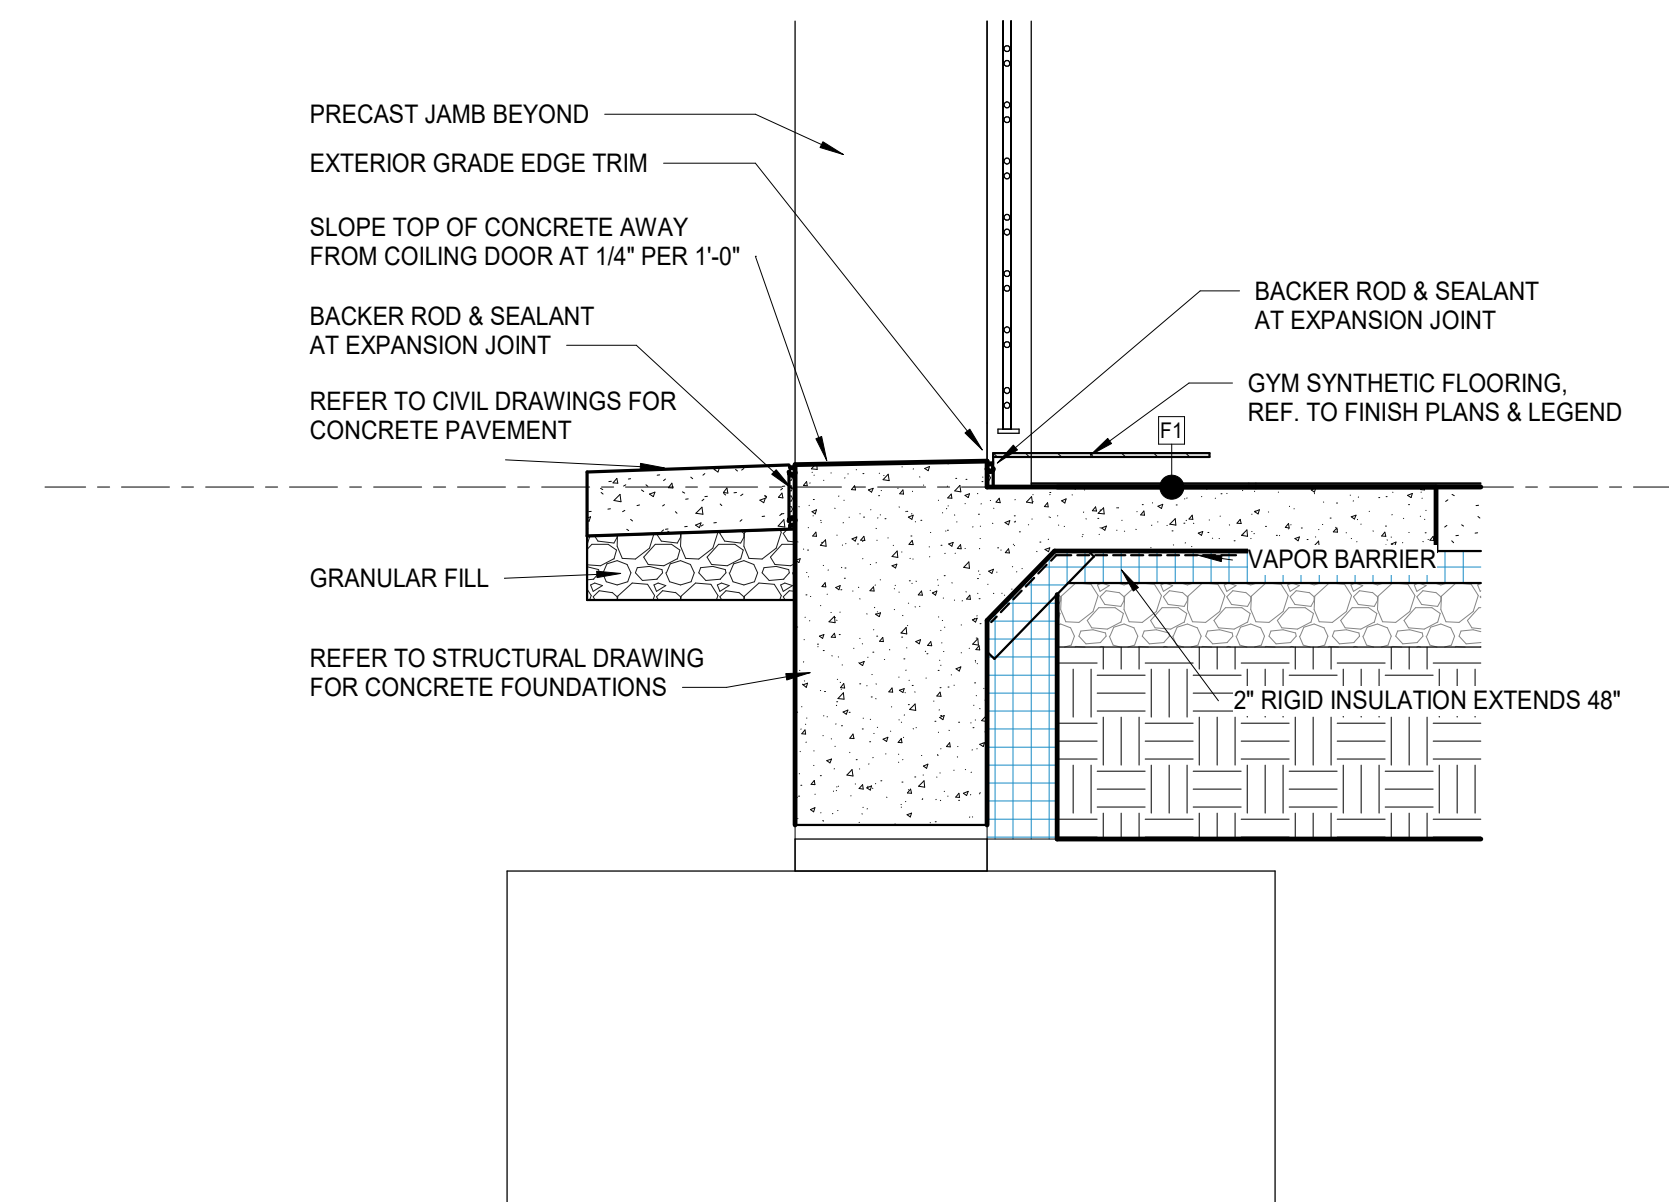


7 WALL SECTION THRU SAC EAST - FOUNDATION
SCALE: 1" = 1'-0"

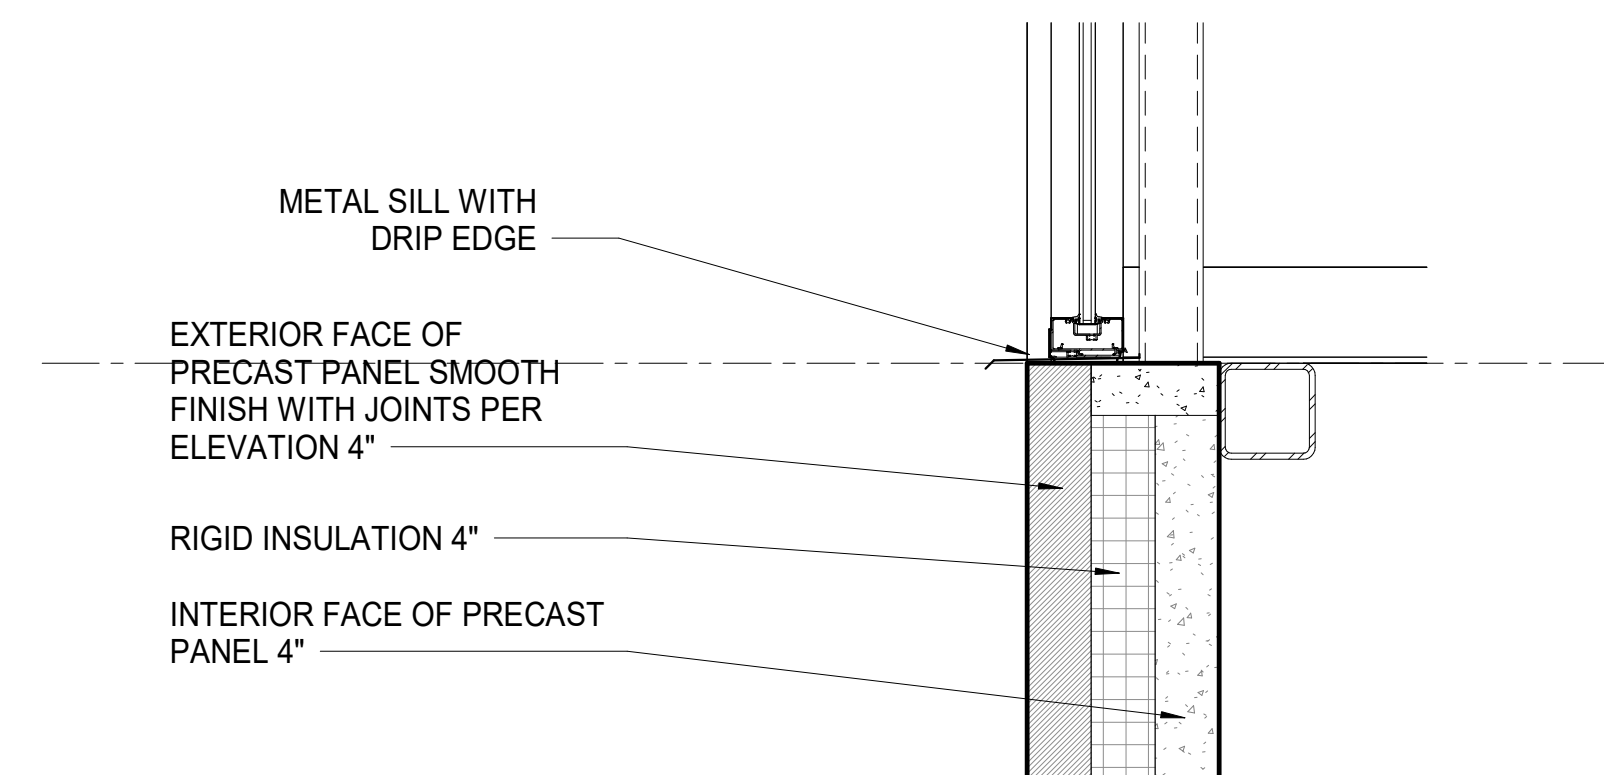


4 WALL SECTION THRU SAC NORTH - LOW ROOF
SCALE: 1" = 1'-0"

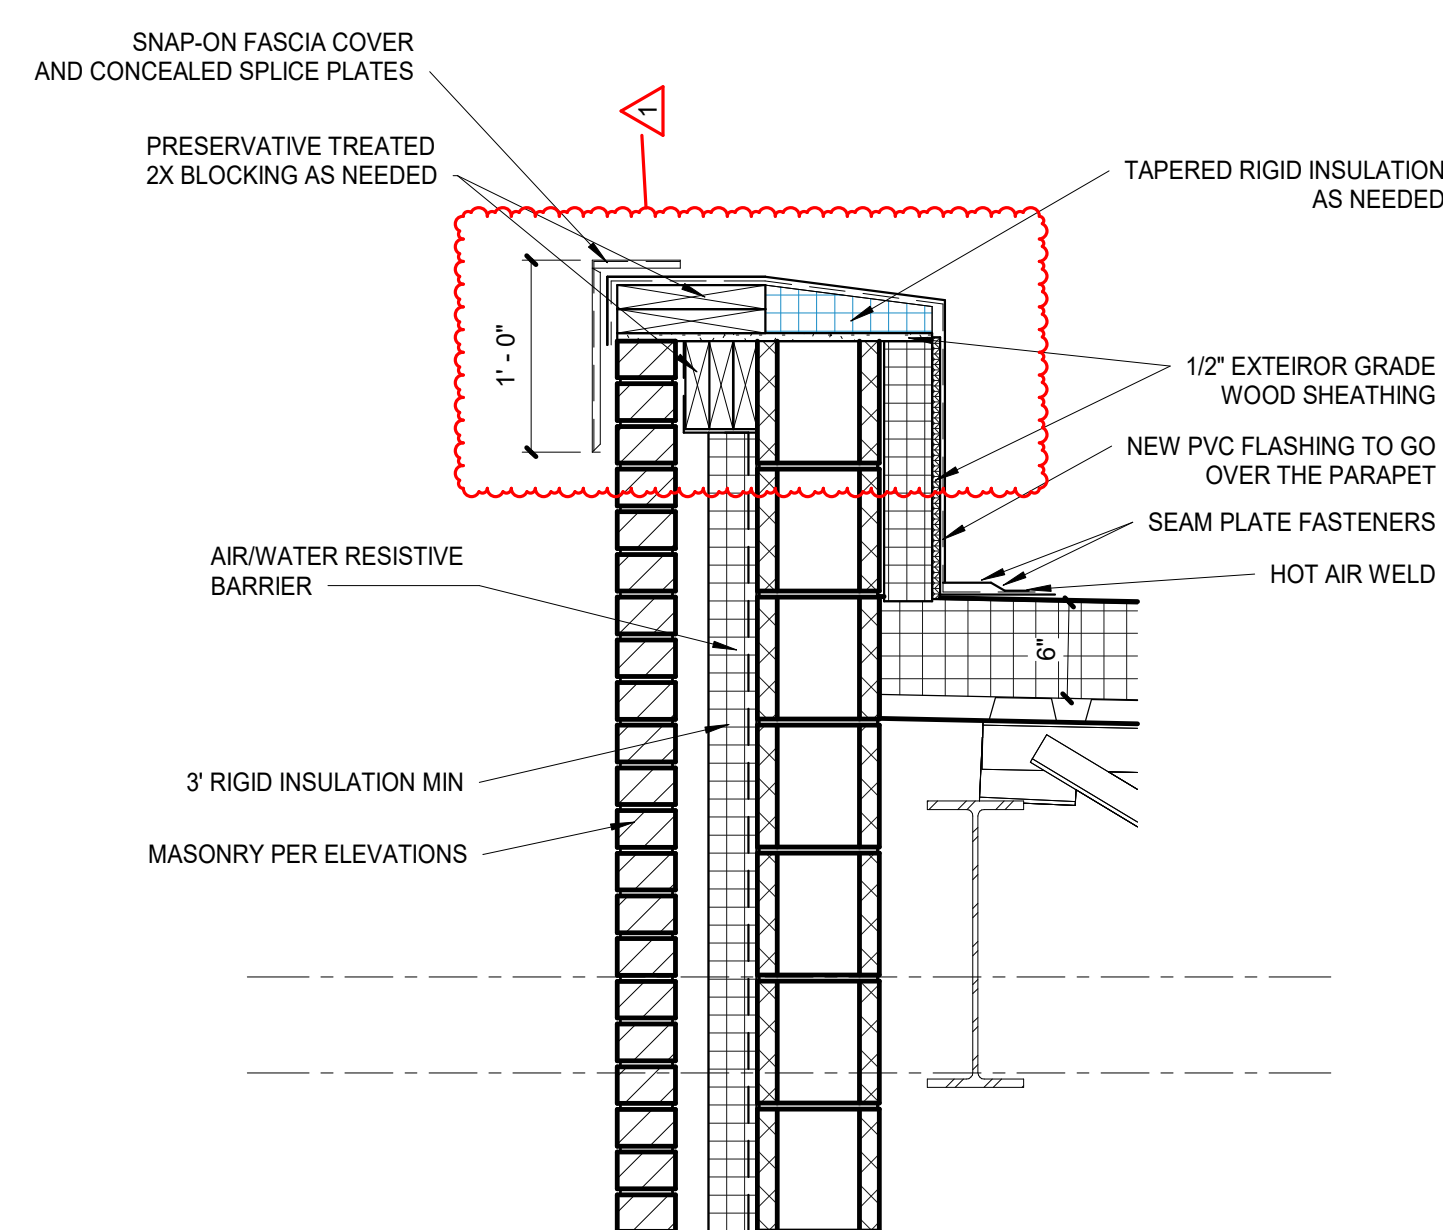


1 WALL SECTION THRU WEIGHT ROOM G136 WEST - PARAPET
SCALE: 1" = 1'-0"

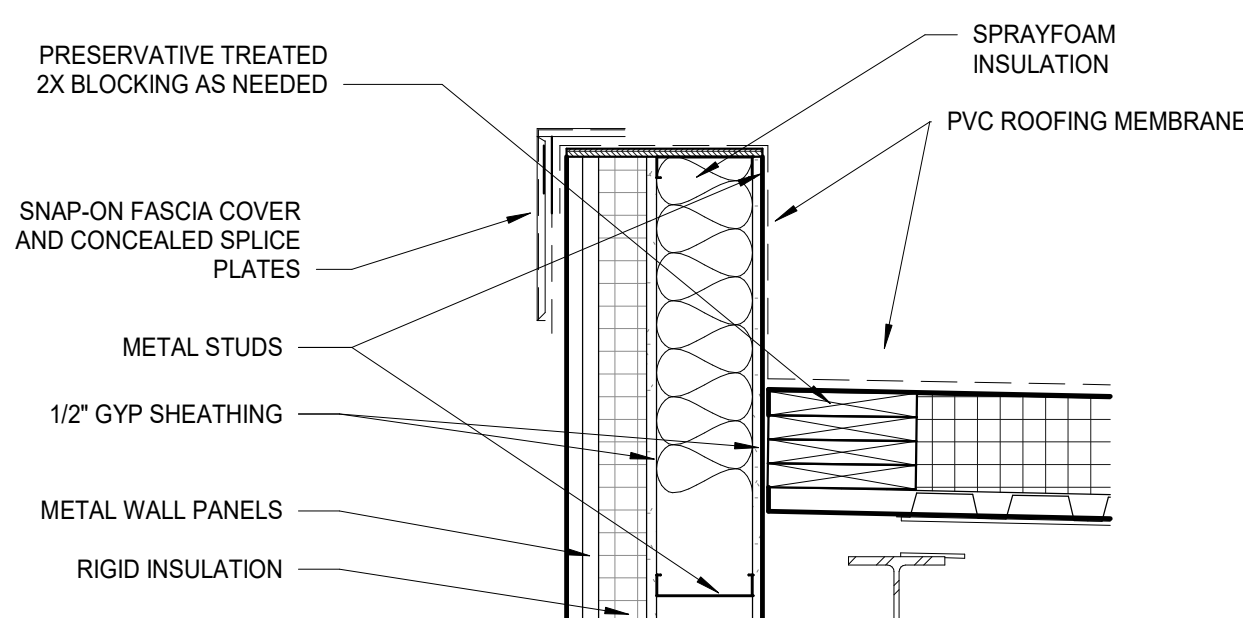


8 WALL DETAIL THRU PARAPET WEST VESTIBULE
SCALE: 1" = 1'-0"

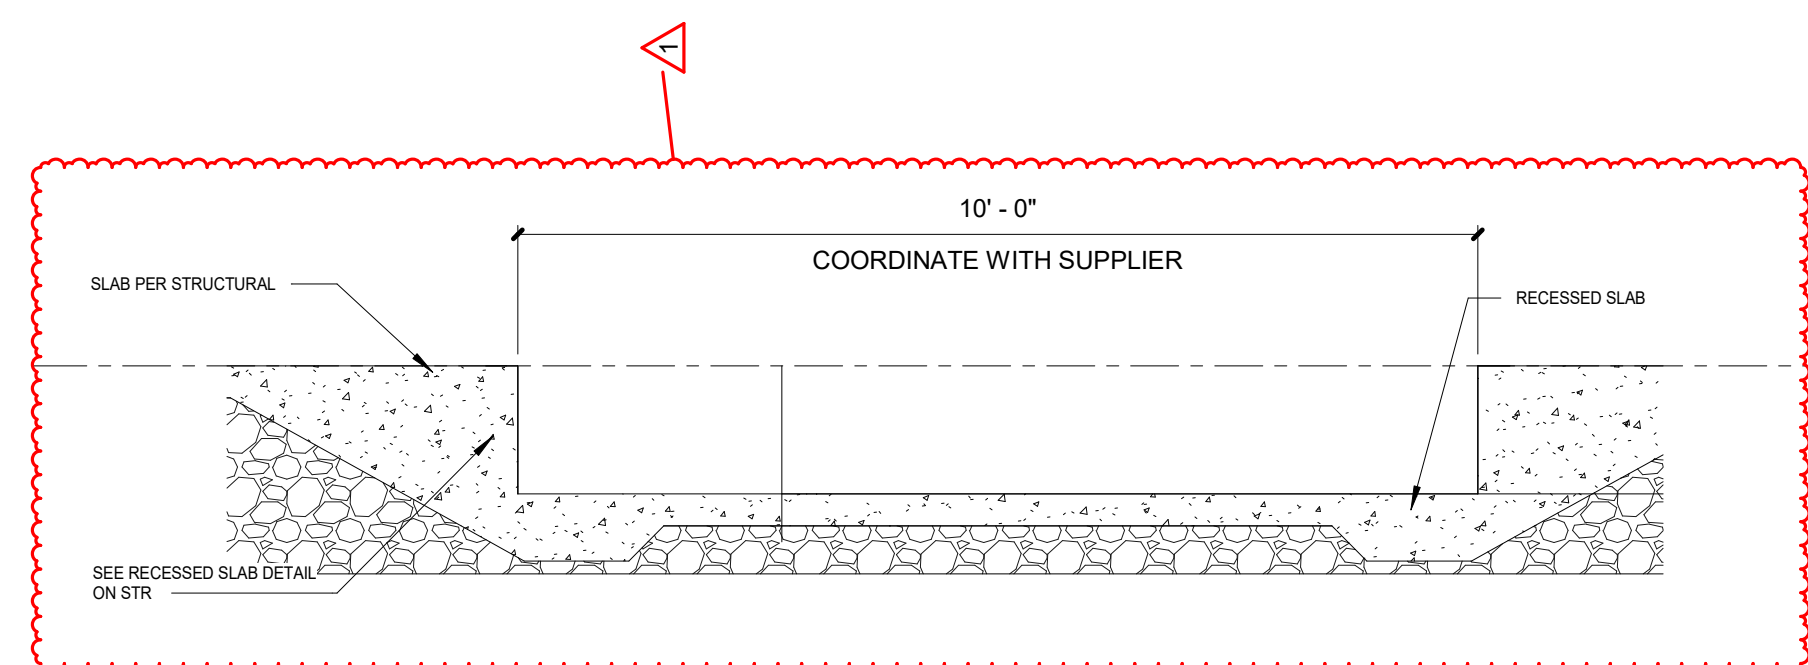


5 LONG JUMP RECESS
SCALE: 1/2" = 1'-0"

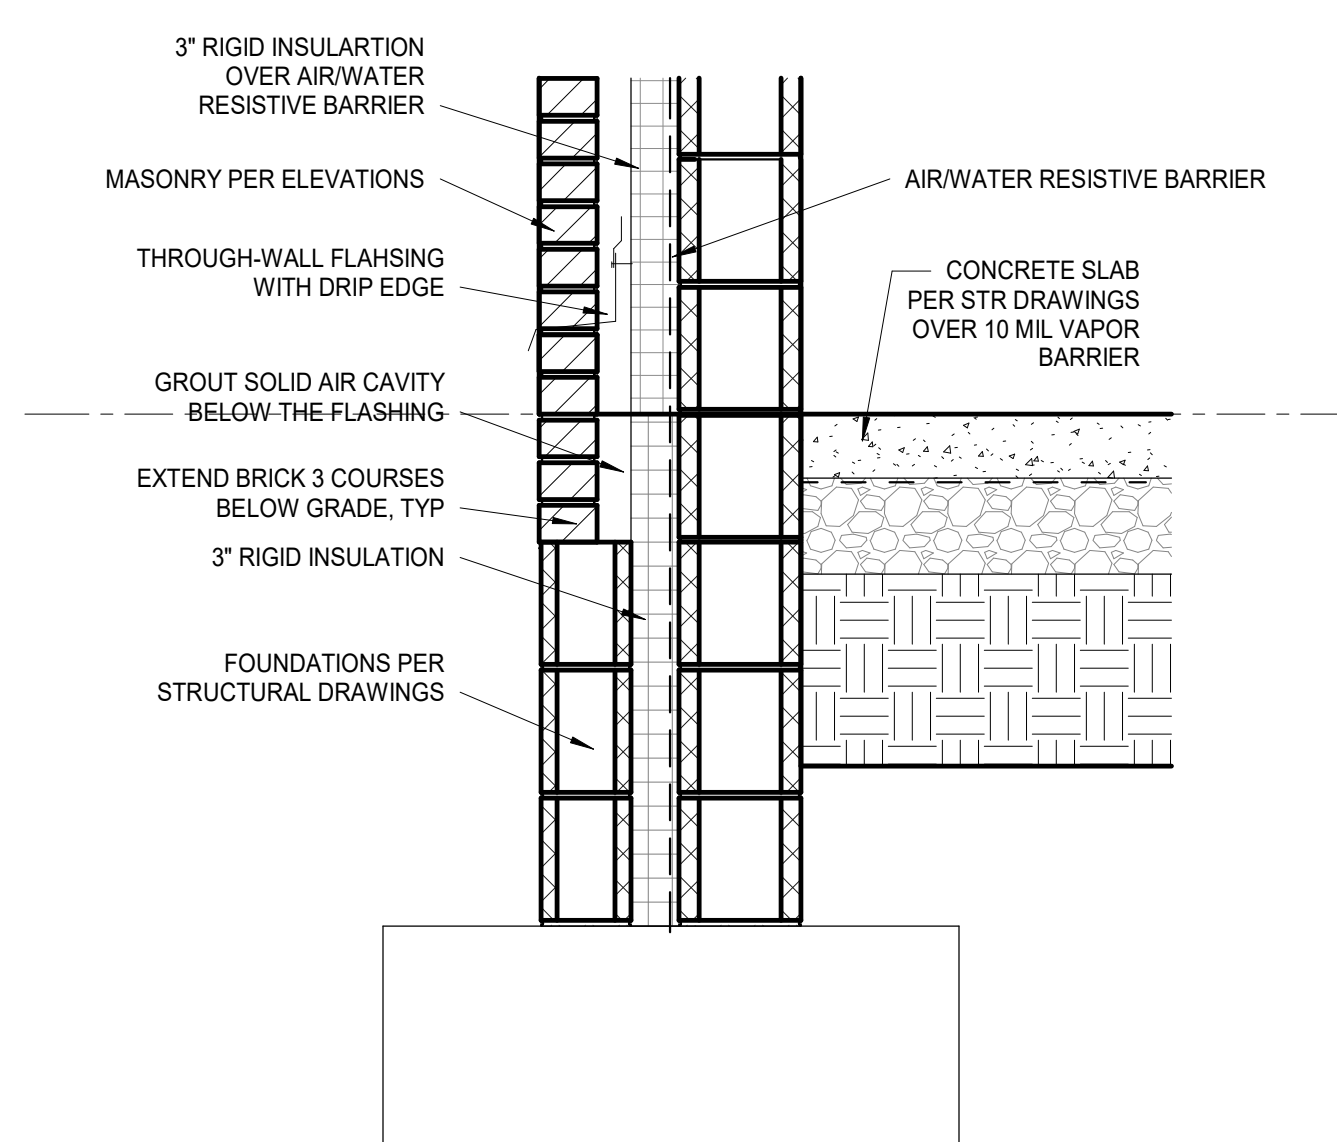


2 WALL SECTION THRU WEIGHT ROOM G136 WEST - FOUNDATION
SCALE: 1" = 1'-0"

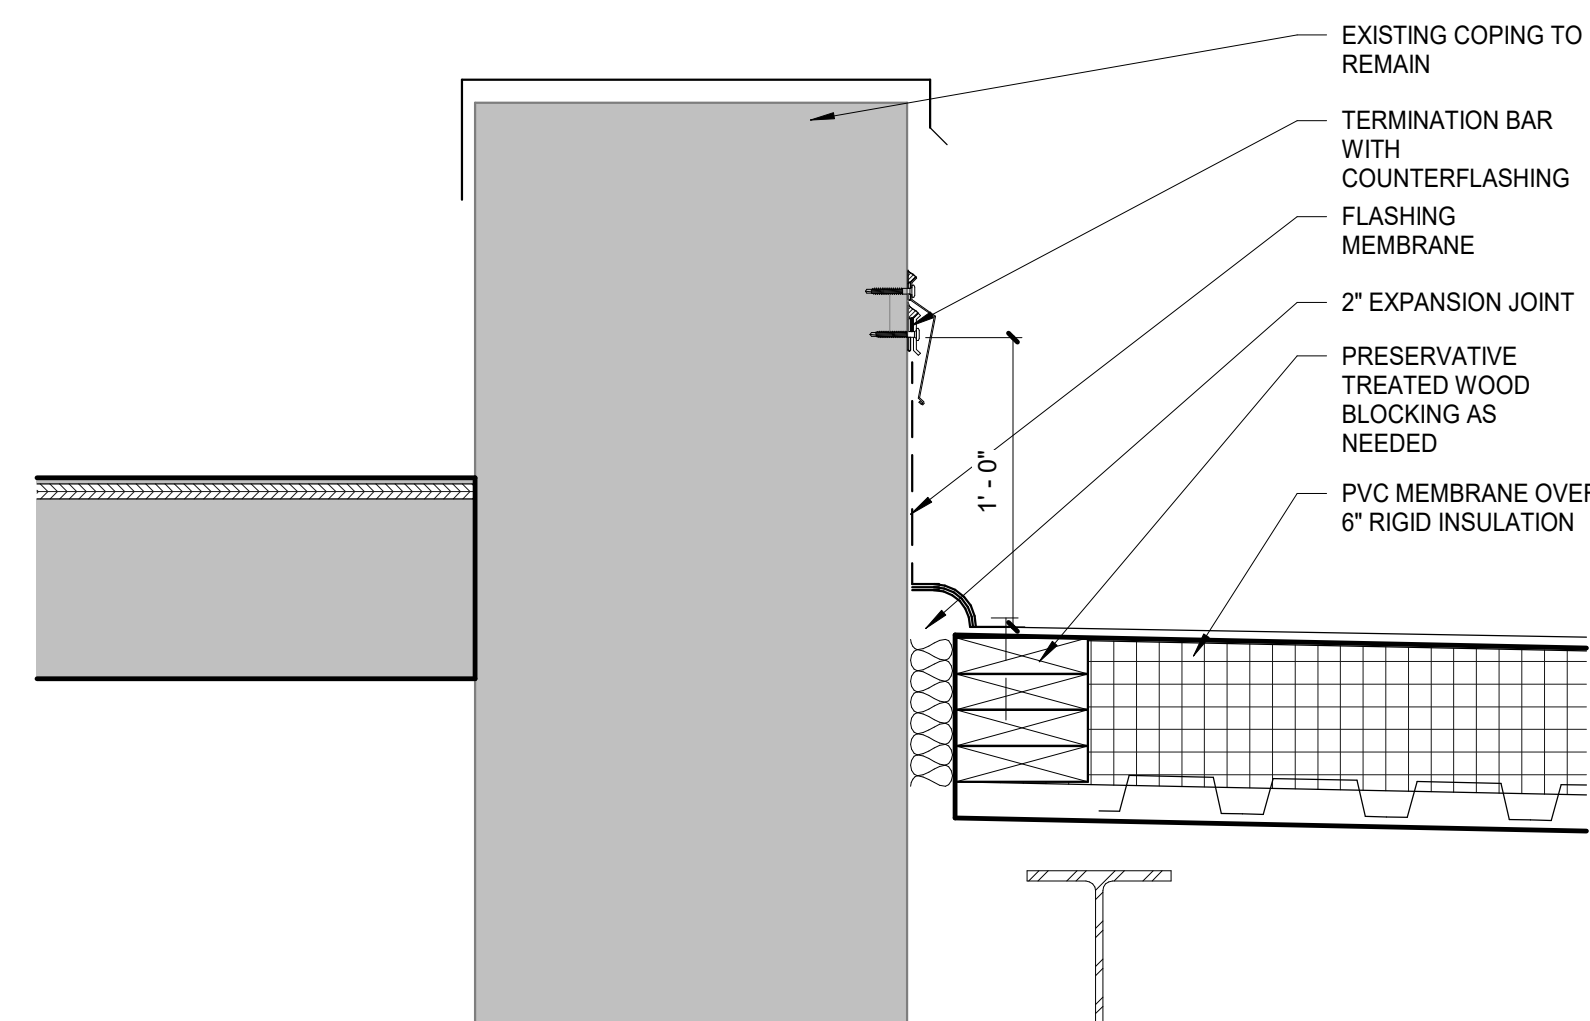

9 NEW ROOF EX WALL
SCALE: 1 1/2" = 1'-0"

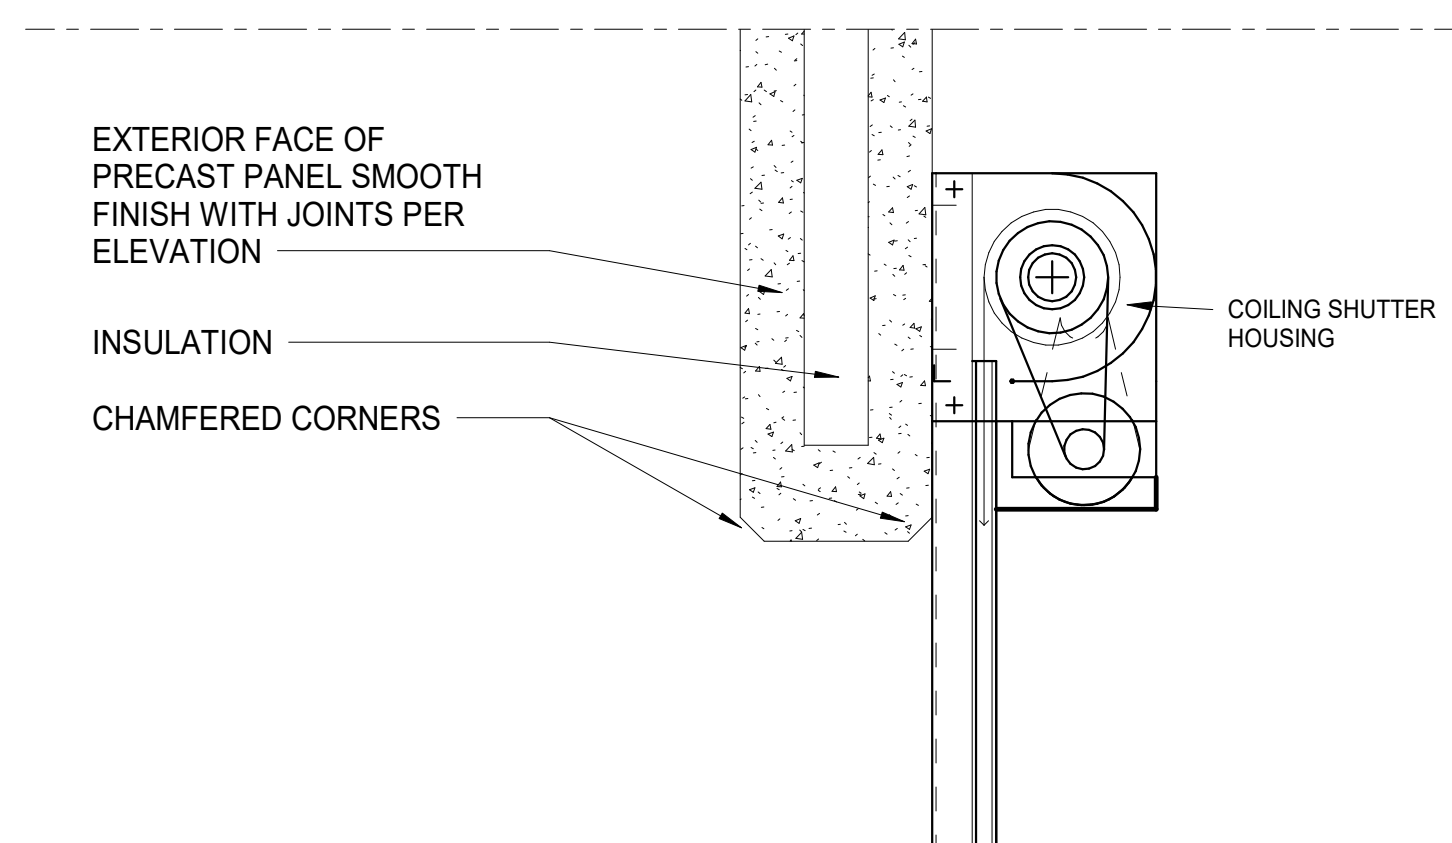


6 WALL SECTION THRU SAC EAST - ABOVE OVERHEAD GRILLE DOOR
SCALE: 1" = 1'-0"

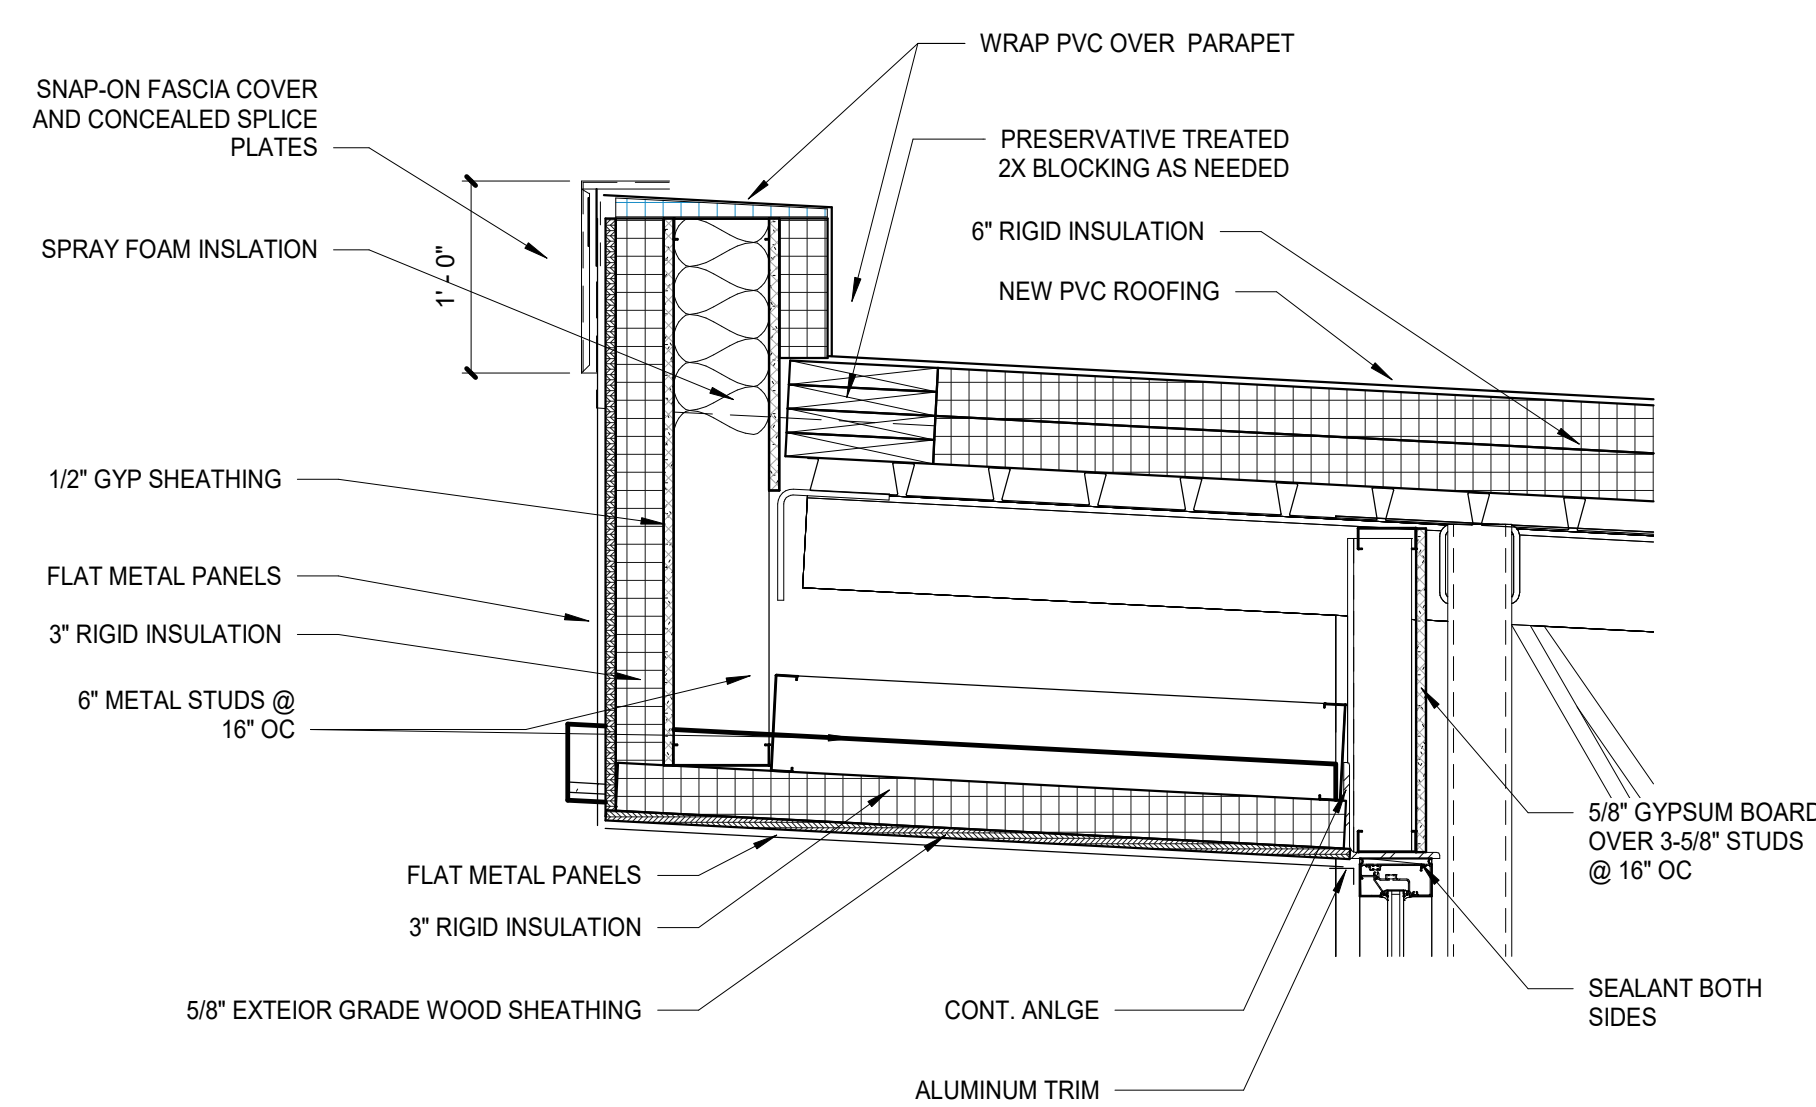


3 WALL SECTION THRU SAC NORTH - ROOF OVERHANG
SCALE: 1" = 1'-0"


PL07 DATE/TIME: 07/16/2025 12:00:01 PM

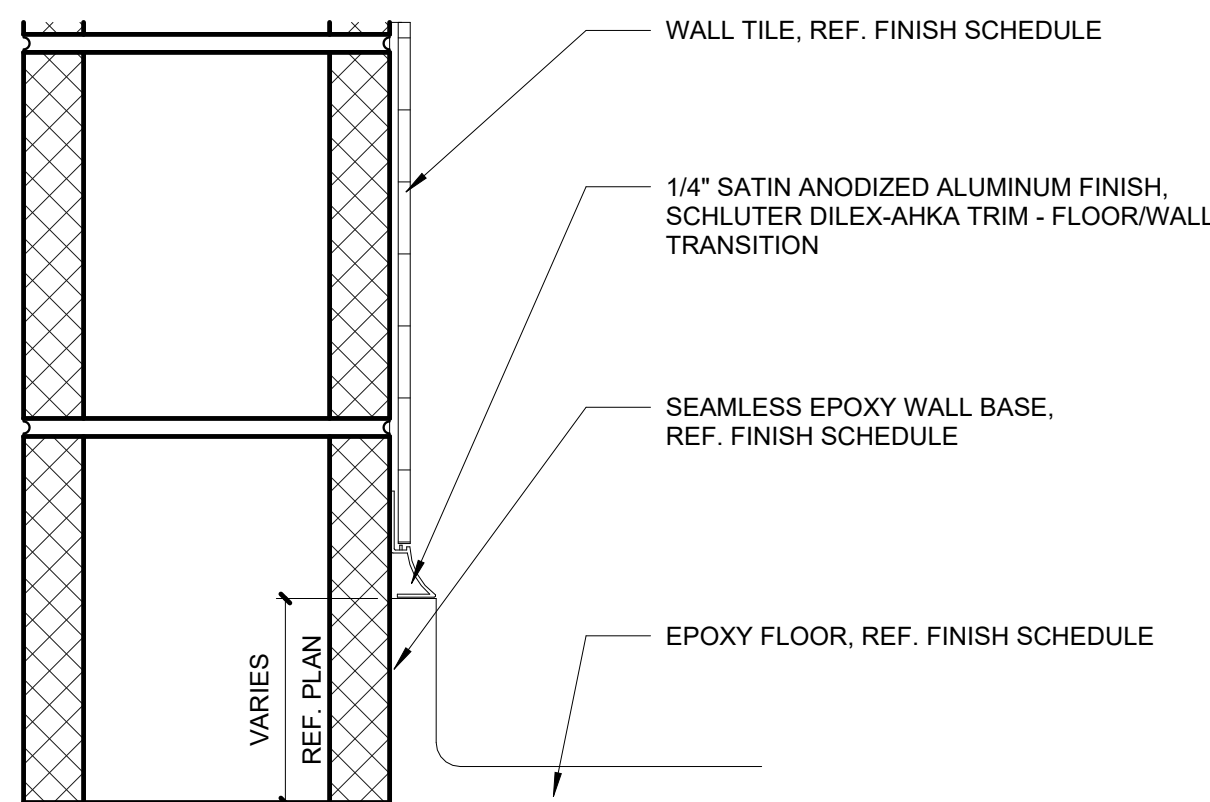


4 DETAIL - EPOXY BASE TO WALL TILE
SCALE: 3" = 1'-0"

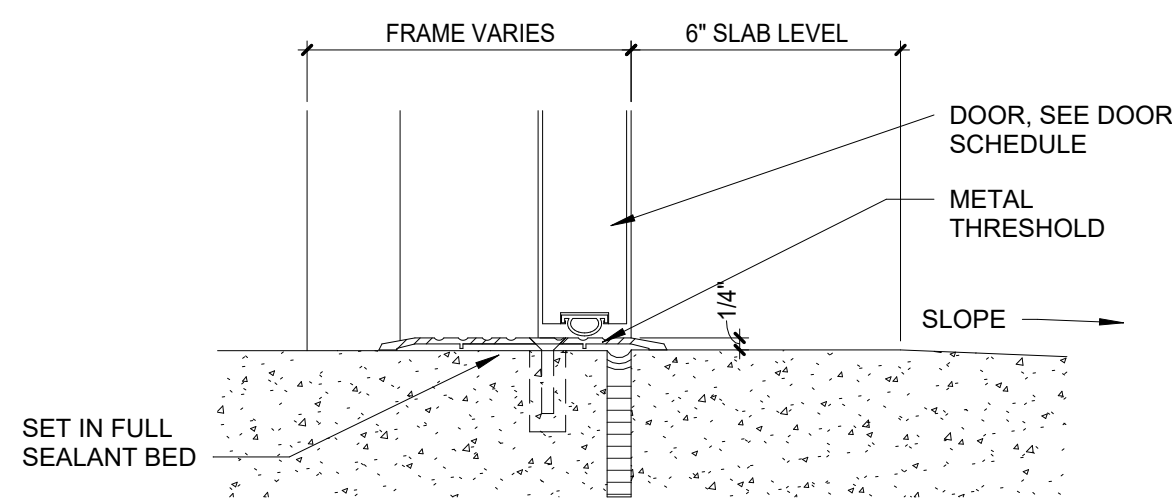


3 DETAIL- EXT. CONCRETE TO CONCRETE
SCALE: 3" = 1'-0"

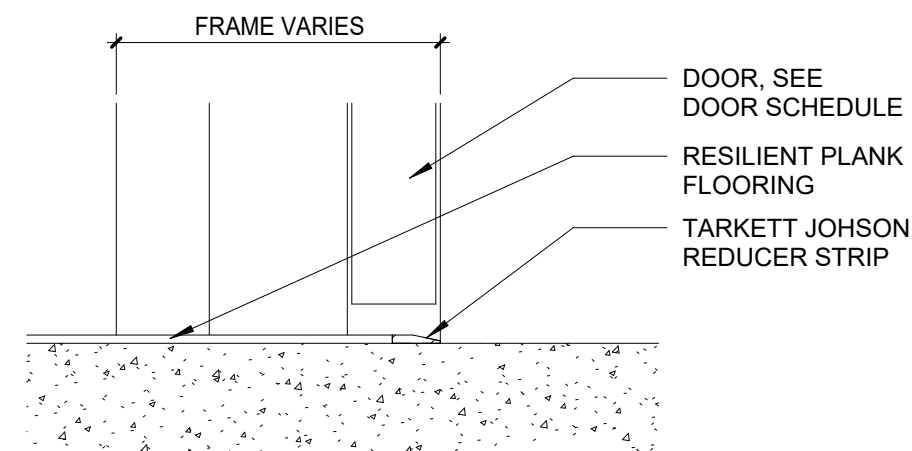


2 DETAIL-RESILIENT FLOOR TO CONCRETE
SCALE: 3" = 1'-0"

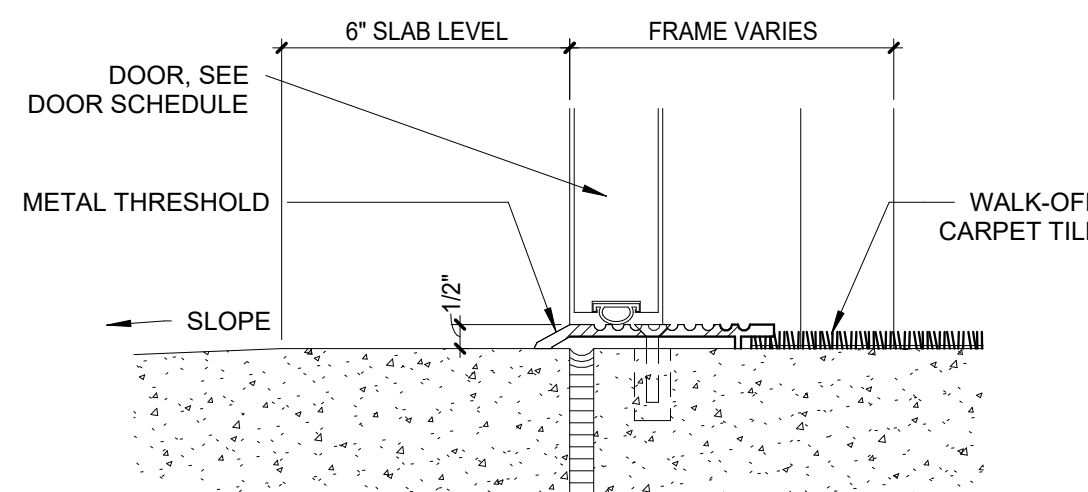


1 DETAIL- EXT. CONCRETE TO WALK-OFF CARPET
SCALE: 3" = 1'-0"

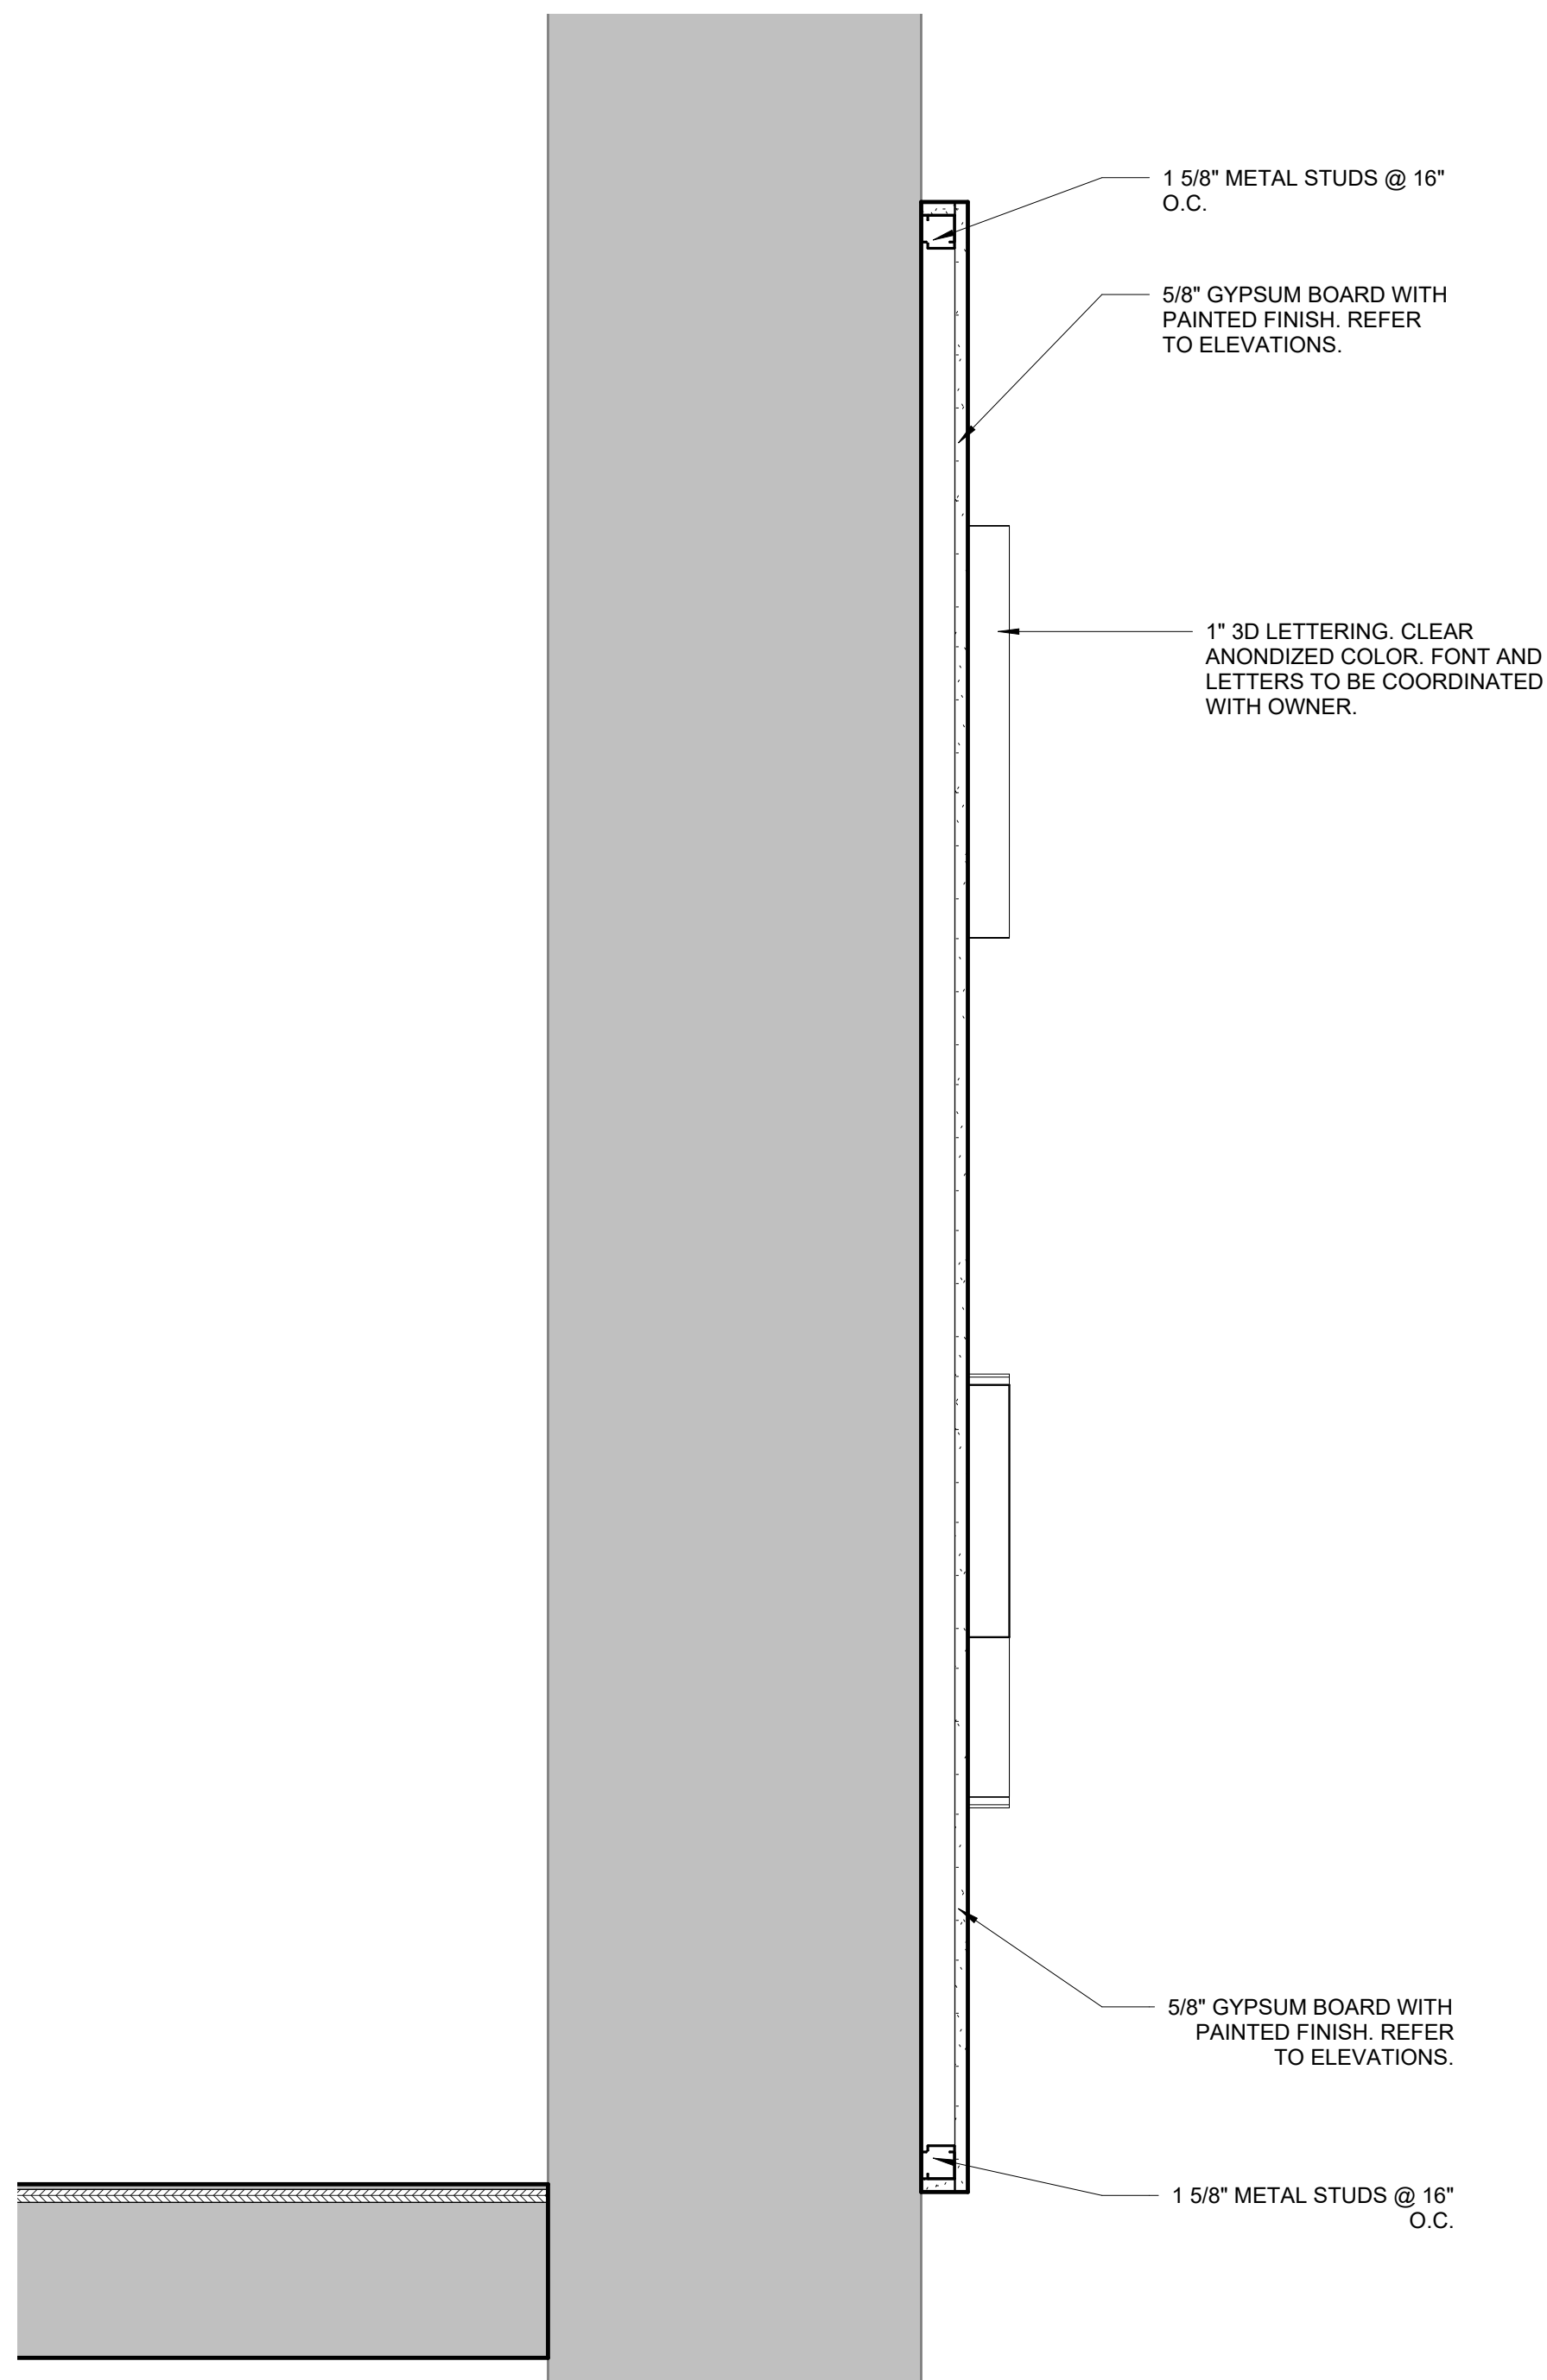


8 INT. DETAIL - WRESTLING WALL
SCALE: 1 1/2" = 1'-0"

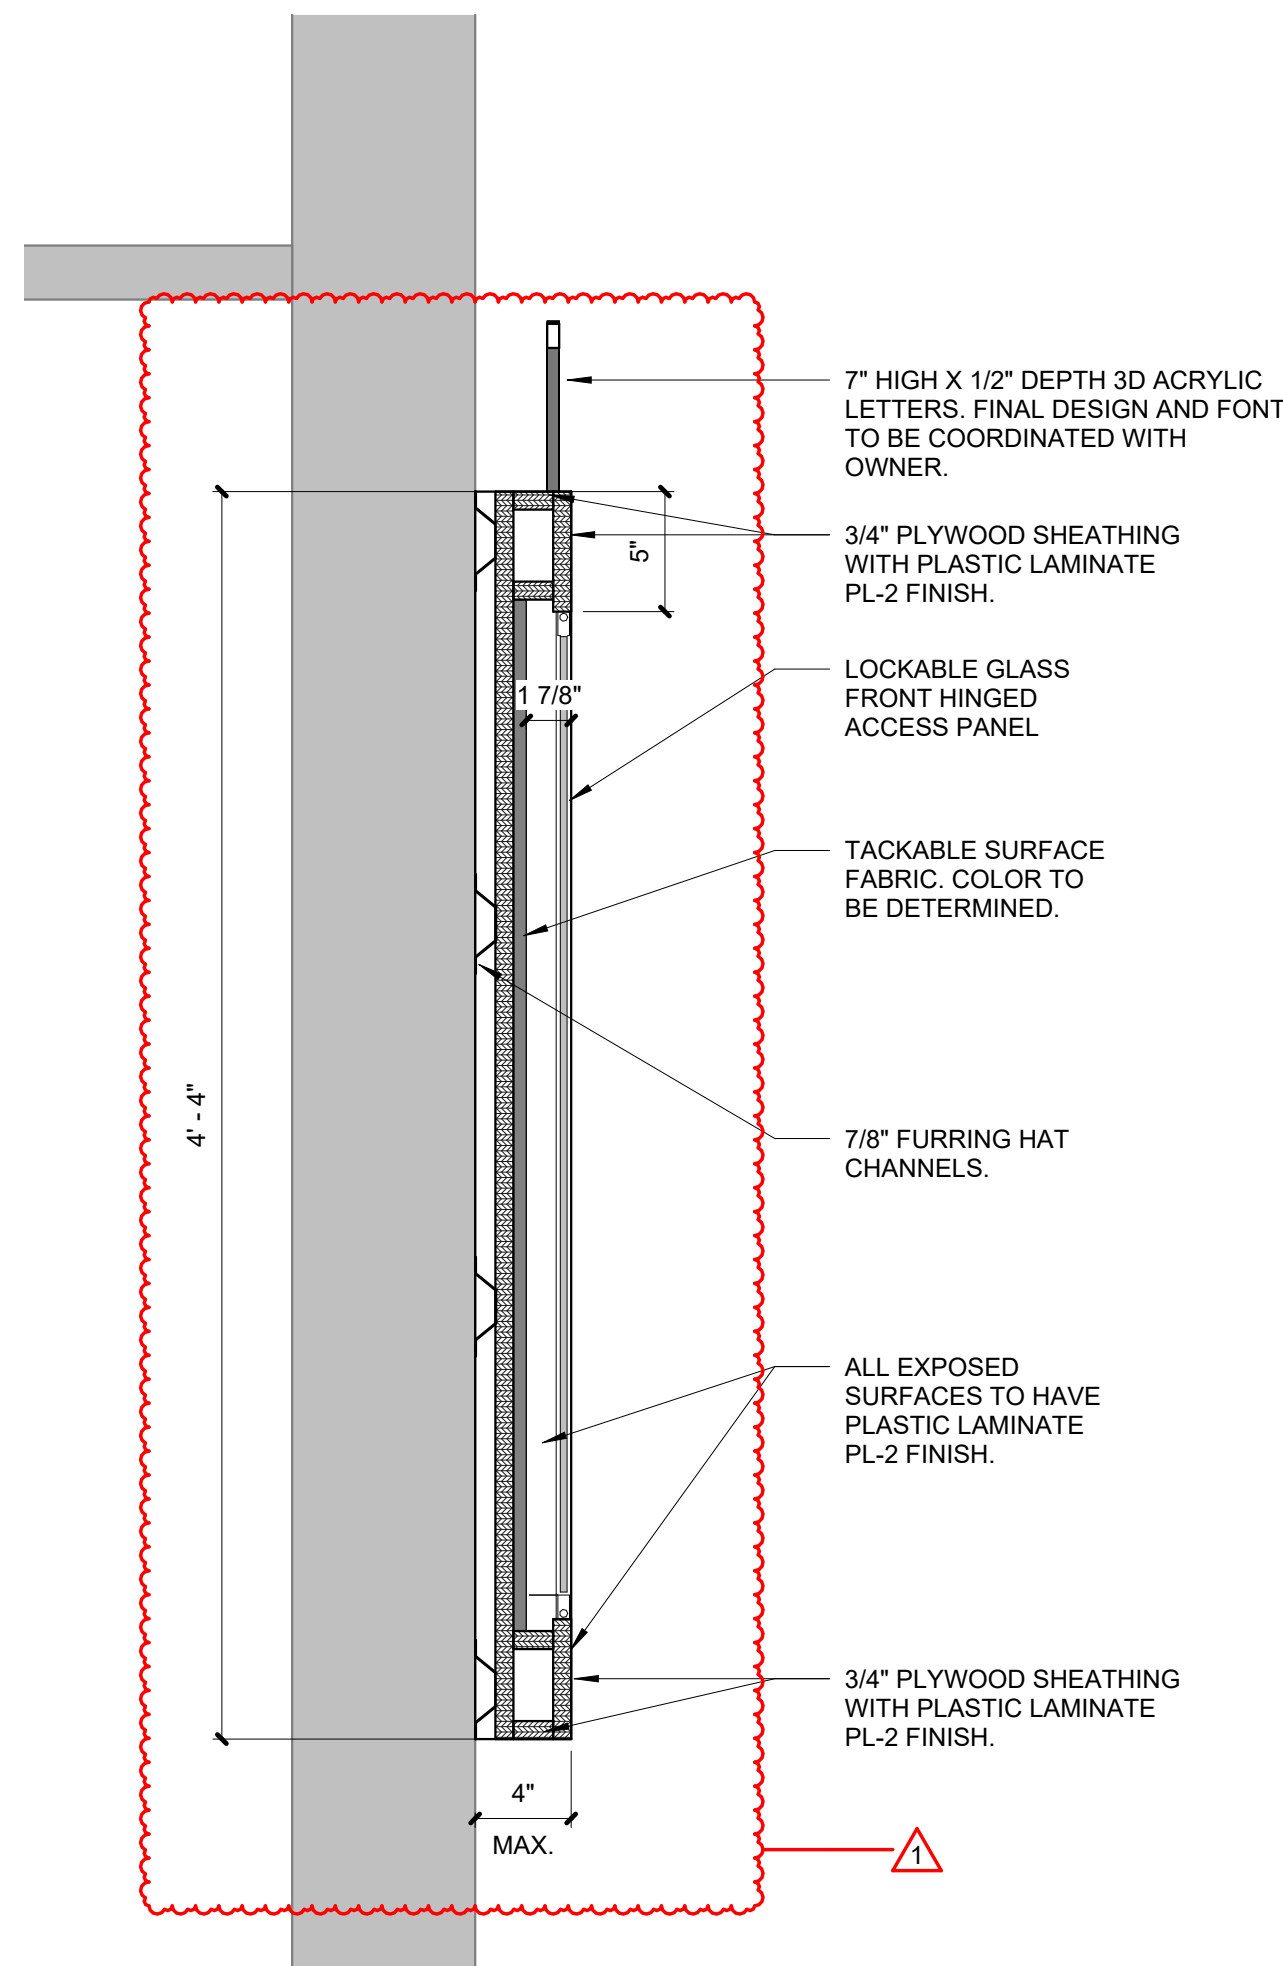


7 INT. DETAIL - WRESTLING DISPLAY
SCALE: 1 1/2" = 1'-0"

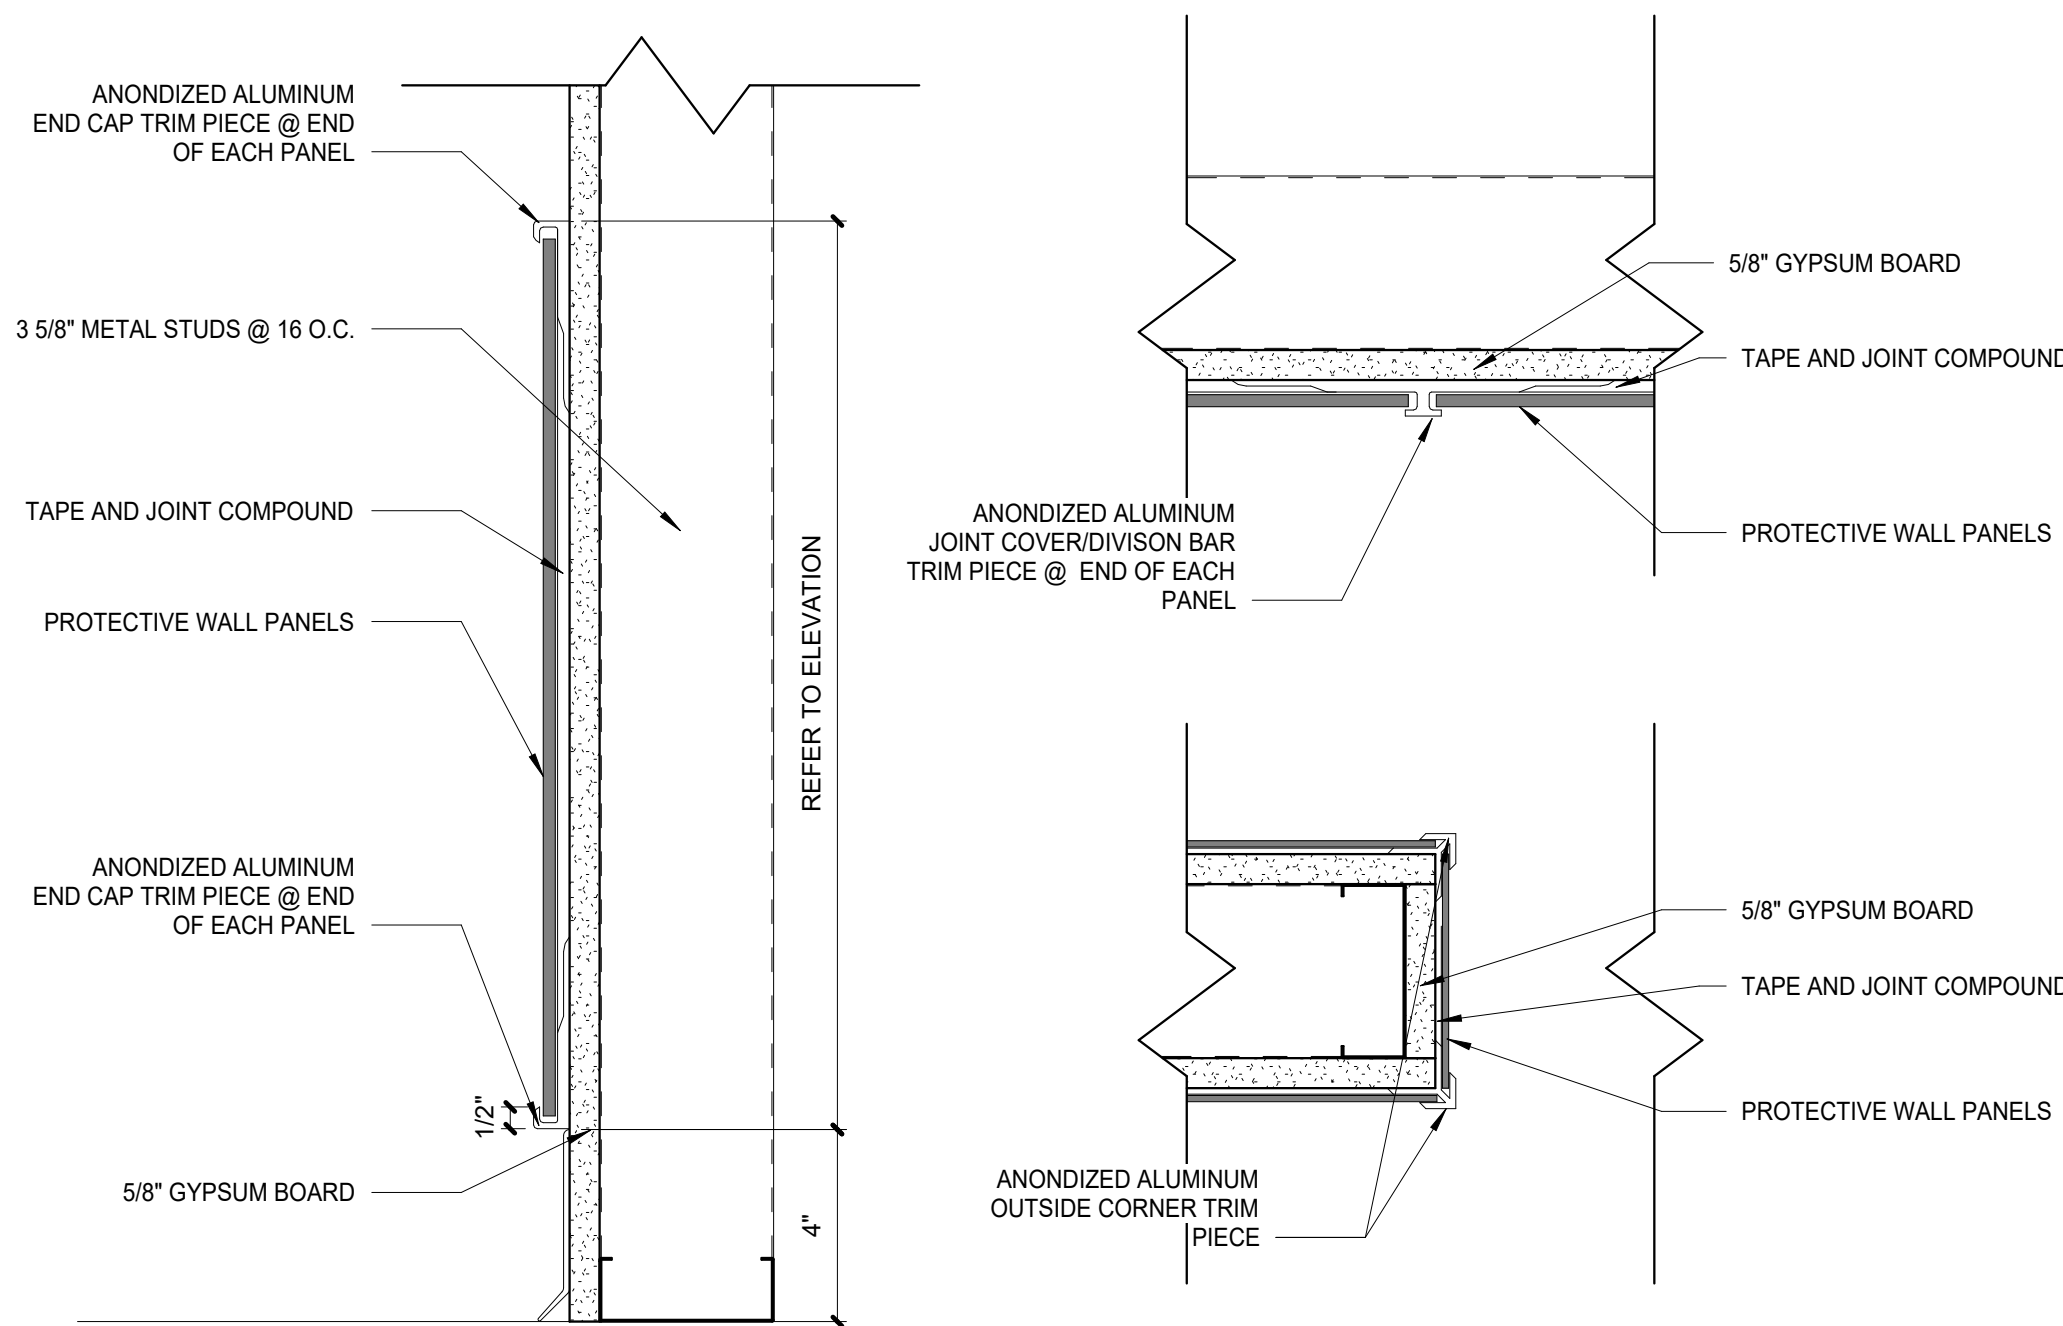

9 INT. DETAIL - TYP. WALL PANEL TRIM
SCALE: 3" = 1'-0"

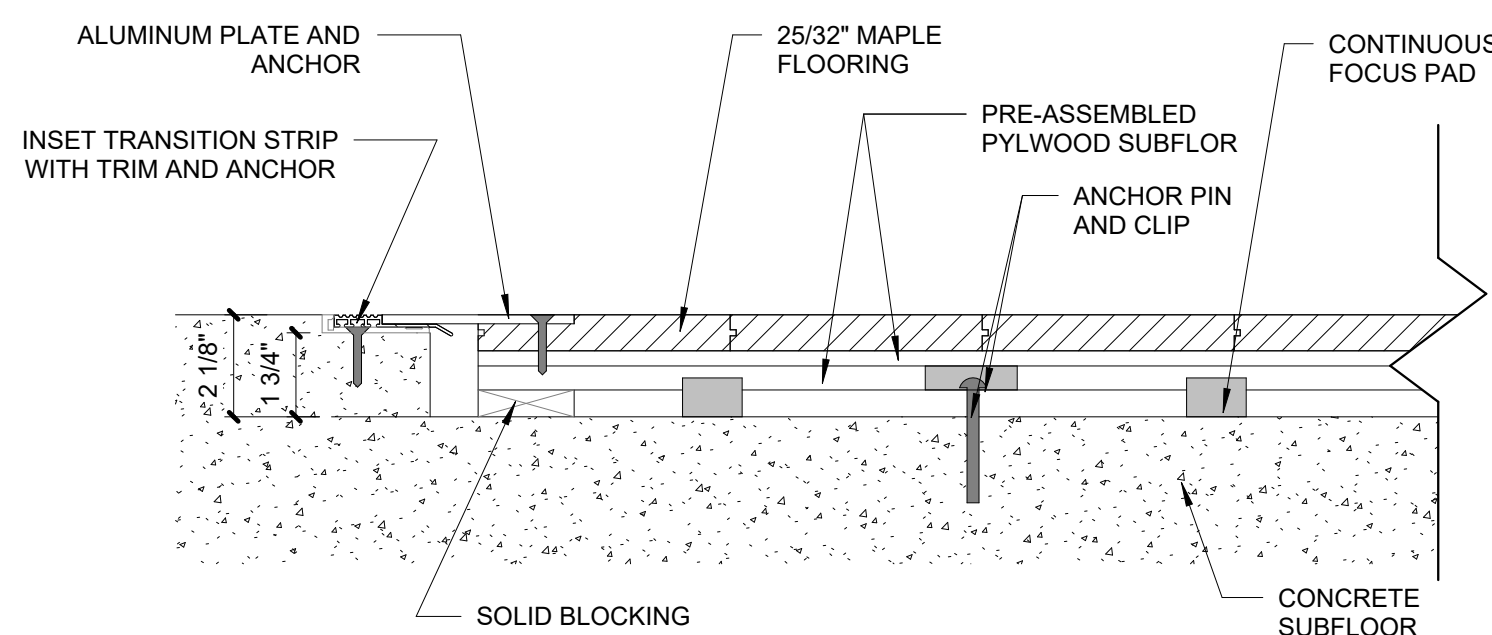

6 DETAIL - HARDWOOD PERFORMANCE SPORTS FLOOR
SCALE: 3" = 1'-0"

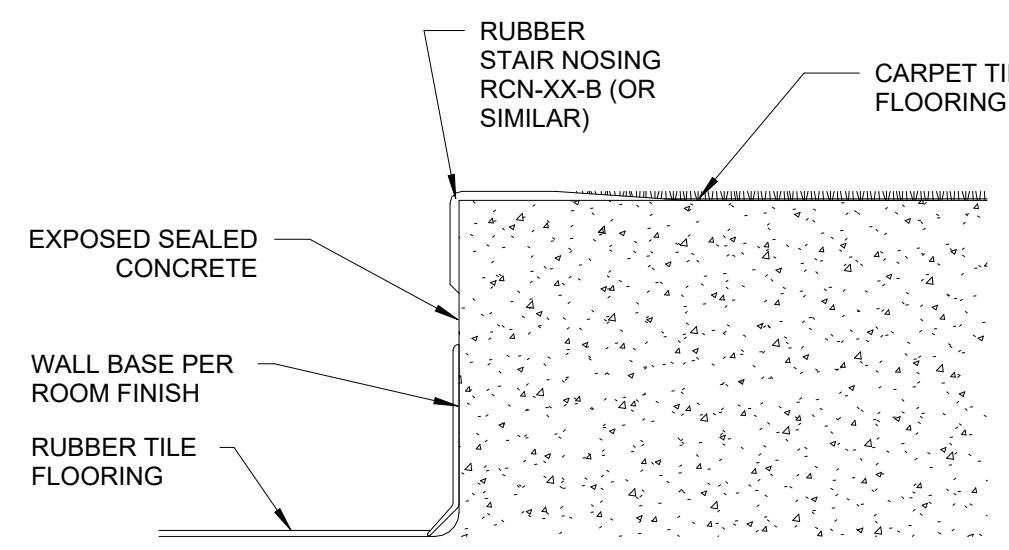

5 DETAIL-STAIR RISER TO CARPET
SCALE: 3" = 1'-0"

CLARK-PLEASANT COMMUNITY SCHOOL CORP.
WHITELAND COMM. HIGH SCHOOL PHASE 3
300 E MAIN ST, WHITELAND, IN 46184




REVISIONS:		Date	Desc.
#			
1		07-16-2025	ADD#1

100% CONSTRUCTION DOCUMENTS	
PROJECT:	#22130
DATE:	06-06-2025
DRAWN BY:	Author

INTERIOR
DETAILS


A731

GENERAL CASEWORK NOTES	
1. FABRICATE WOODWORK/ MILLWORK ITEMS TO ACTUAL FIELD DIMENSIONS. CONTRACTOR SHALL SUBMIT FOR DESIGNER APPROVALS SHOP DRAWING SAMPLES OR MANUFACTURER'S LITERATURE FOR ALL ITEMS. SHOP DRAWINGS SHALL SHOW SUFFICIENT DETAIL TO DETERMINE COMPLIANCE WITH STANDARDS AND DESIGN INTENT.	7. ALL PLASTIC LAMINATE SURFACES ON EXTERIOR OF CABINETS SHALL BE A STANDARD COLOR AS LISTED ON THE FINISH LEGEND.
2. PROVIDE ALL NECESSARY FURRING AND GROUNDS FOR WOODWORK AND FINISH ITEMS. COORDINATE LOCATION OF BLOCKING WITHIN FRAMED WALLS AS NECESSARY FOR ITEMS TO BE SECURED TO SURFACE. ALL FASTENERS SHALL BE CONCEALED.	8. ALL INTERIORS BEHIND DOORS/ DRAWERS AND NOT VISIBLE SHALL BE WHITE PLASTIC LAMINATE, UNLESS NOTED OTHERWISE.
3. FINISH ALL SIDES AND BACK OF MILLWORK/ CASEWORK	7. ALL SOLID SURFACE COUNTERTOPS SHALL BE A STANDARD COLOR AS LISTED ON THE FINISH LEGEND. REFER TO INTERIOR ELEVATION FOR TYPE.
4. PROVIDE GROMMETS IN COUNTERTOPS ABOVE ALL ELECTRICAL RECPETICALS AND TELEPHONE DATA ROUTINGS.	9. SEE ELEC. DWGS FOR ELECTRICAL DEVICES.
5. ALL PULLS TO BE 4" SATIN NICKEL SOLID WIRE PULL	10. SEE PLUMBING DWGS FOR PLUMBING FIXTURES.
6. PROVIDE LOCKS FOR ALL STORAGE CASE CABINETS/ TALL STORAGE CABINETS, ALL DRAWERS AND DOORS, ALL UPPER WALL CABINETS AND ALL DISPLAY CASE SLIDING GLASS PANELS.	11. ALL WALL BASE AT CASEWORK LOCATIONS TO BE RB-1.

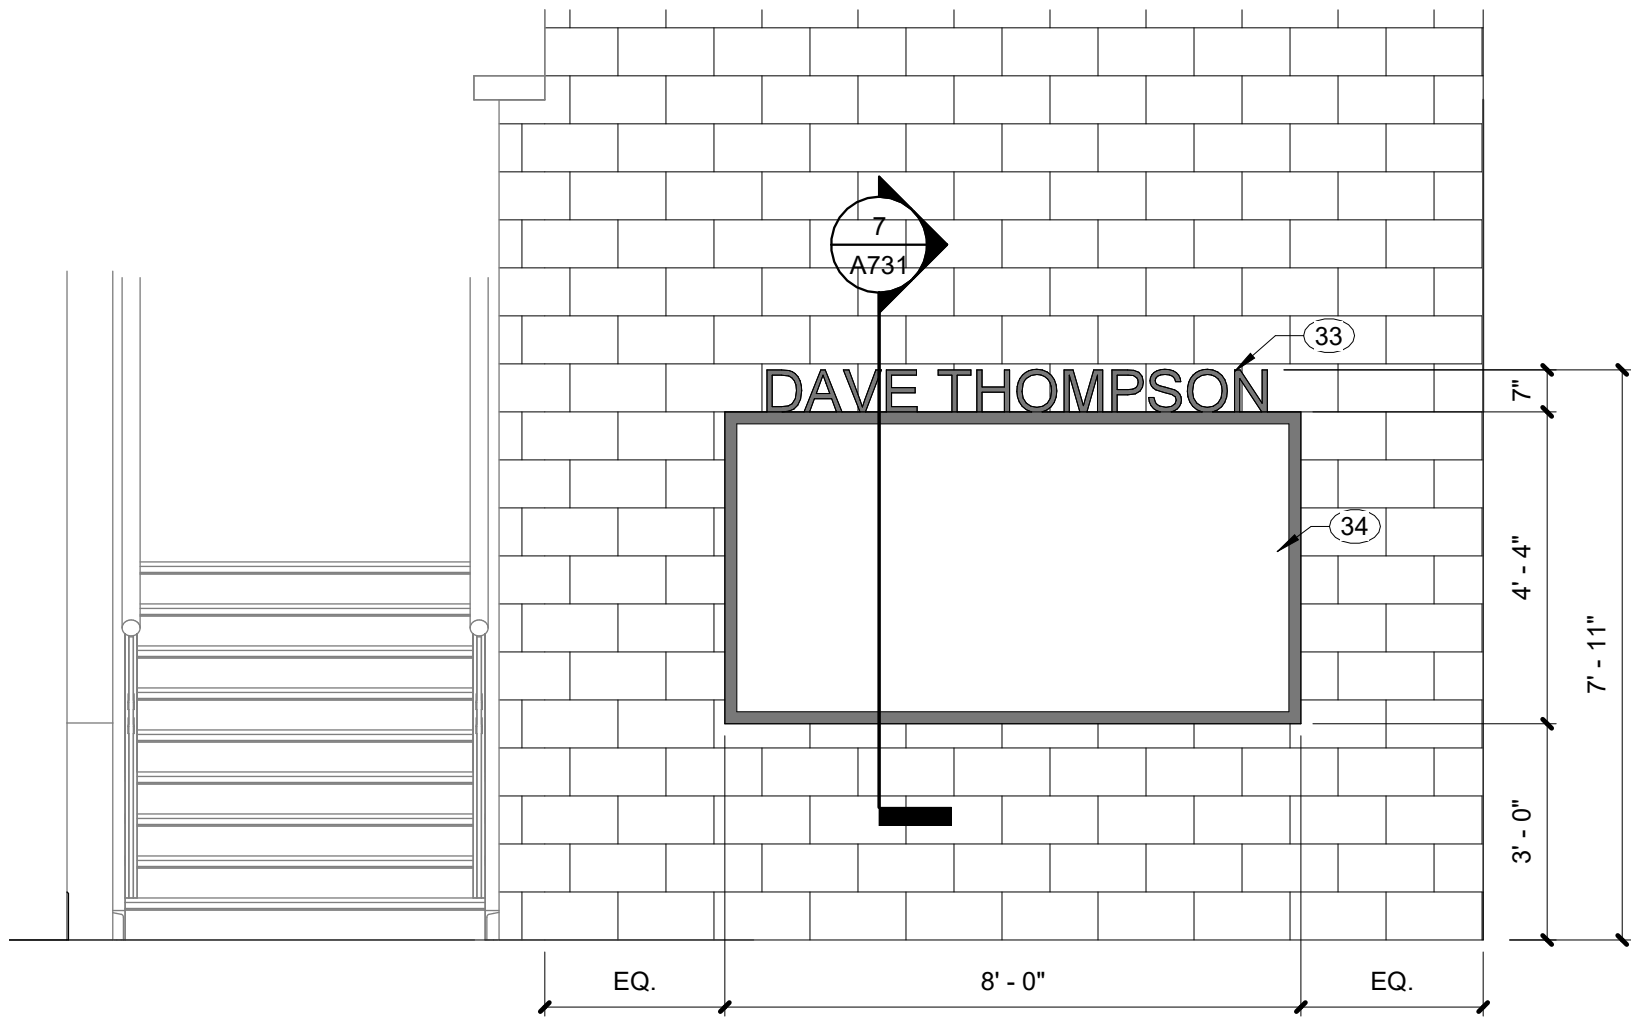


13 INT. ELEV. WRESTLING ENTRANCE
SCALE: 3/8" = 1'-0"


GENERAL NOTES - INTERIOR ELEVATIONS	
A. CONTRACTOR TO PROVIDE SCHLUTER EDGE WHERE TILE MEETS DISSIMILAR MATERIALS. REFER TO FINISH MATERIAL LEGEND AND INTERIOR ELEVATIONS FOR FURTHER DETAILS. LS	
B. DO NOT INSTALL GYPSUM BOARD BEHIND TILE BACKER BOARD LOCATIONS.	
C. CONTRACTOR TO PROVIDE DRYWALL REVEAL JOINT WHERE DRYWALL MEETS DISSIMILAR MATERIALS.	
D. CONTRACTOR TO PROVIDE SCHLUTER EDGE WHERE TILE MEETS DISSIMILAR MATERIALS. REFER TO FINISH MATERIAL LEGEND AND INTERIOR ELEVATIONS FOR FURTHER DETAILS.	
E. IF ONLY PAINT IS INDICATED AS THE FINISH, REFER TO ARCHITECTURAL FLOOR PLANS FOR SUBSTRATE INFORMATION.	
F. CONTRACTOR SHALL BE RESPONSIBLE FOR VERIFICATION OF DIMENSIONS AND JOB CONDITIONS. ANY DEVIATION FROM WHAT IS INDICATED ON THE FINISH PLANS SHALL BE BROUGHT TO THE ATTENTION OF THE ARCHITECTS AND DESIGNERS.	
G. ALL DIMENSIONS SHOWN ARE TO FACE OF FINISH MATERIAL, UNLESS INDICATED OTHERWISE ON PLANS.	
H. ALL EXPOSED METAL SURFACES, SUCH AS GRILLES, FIRE EXTINGUISHER CABINETS, ETC., THAT ARE NOTED TO BE PAINTED ARE TO BE PAINTED MATCH WALL COLOR.	
I. ALL WALLS TO BE PAINTED PT-1, UNLESS NOTED OTHERWISE.	

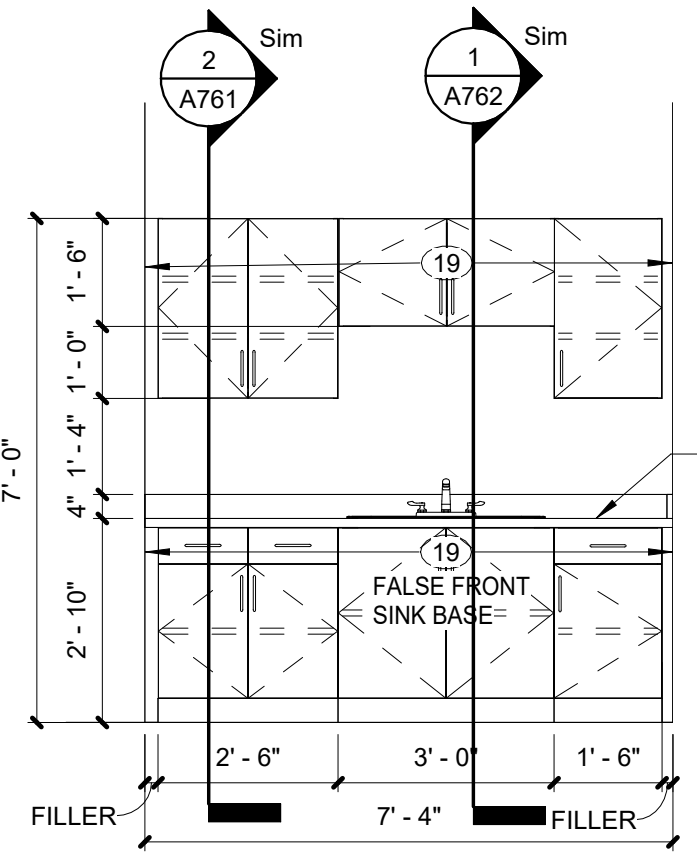


12 CSWK - GR104 STORAGE
SCALE: 3/8" = 1'-0"

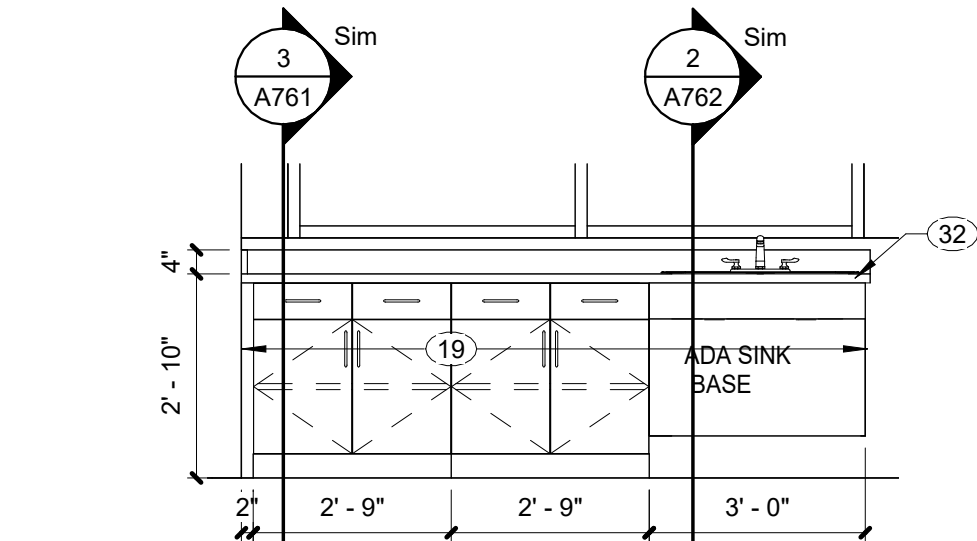


11 CSWK - GR102 CLASSROOM
SCALE: 3/8" = 1'-0"

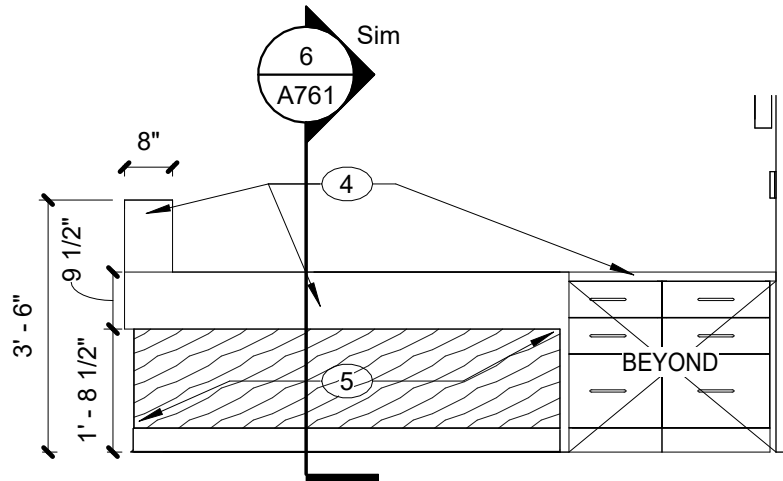


10 CSWK - RECEPT. G131 NORTH OUTSIDE
SCALE: 3/8" = 1'-0"

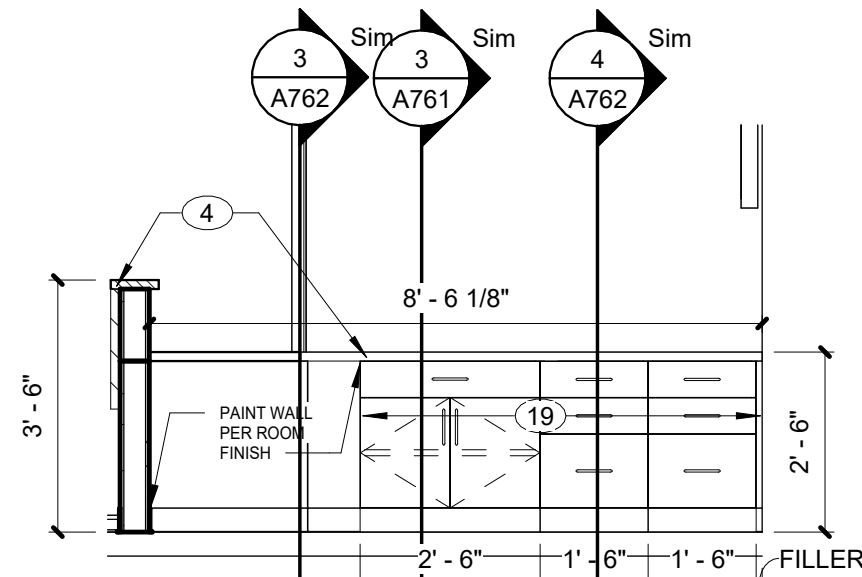


9 CSWK - RECEPT. G131 NORTH INSIDE
SCALE: 3/8" = 1'-0"

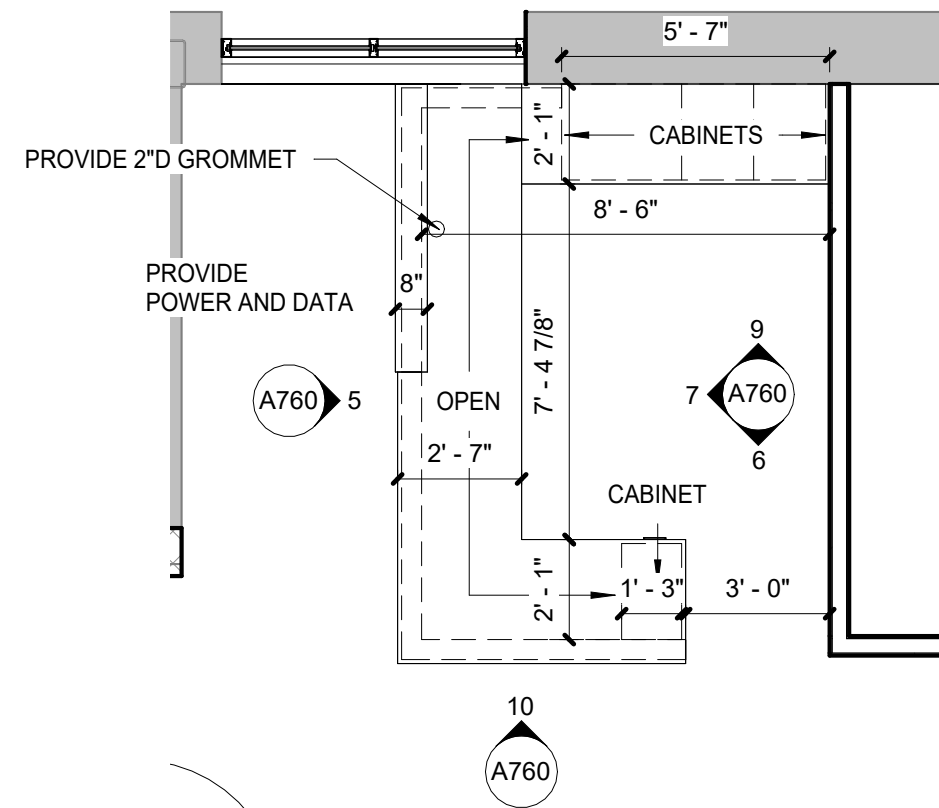


8 CASEWORK - ENLARGED RECEPTION PLAN
SCALE: 1/4" = 1'-0"

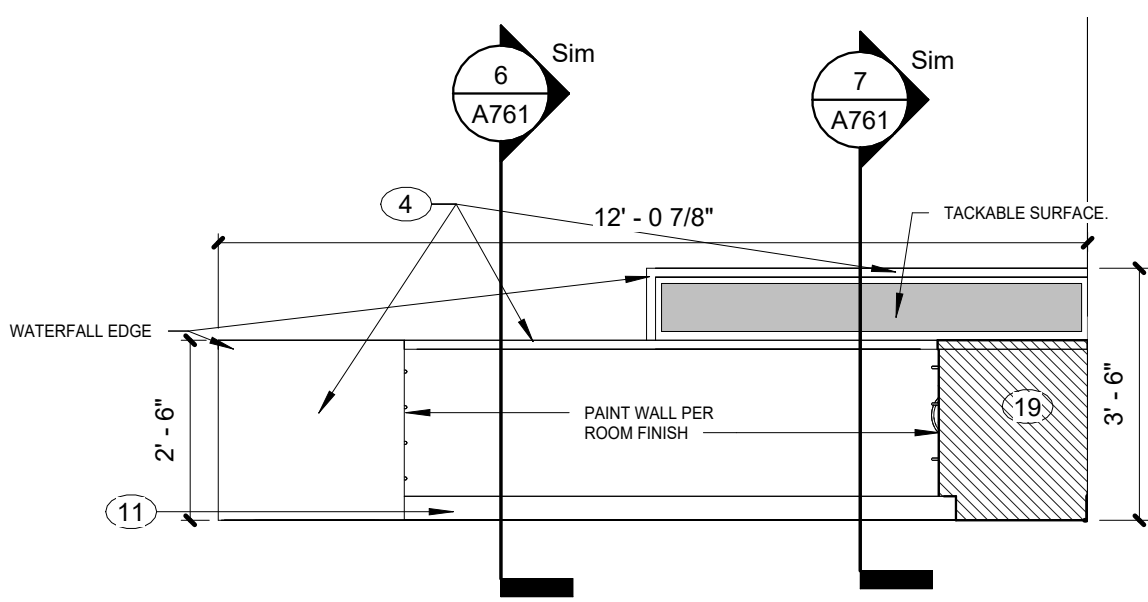


7 CSWK - RECEPTION G131 WEST
SCALE: 3/8" = 1'-0"

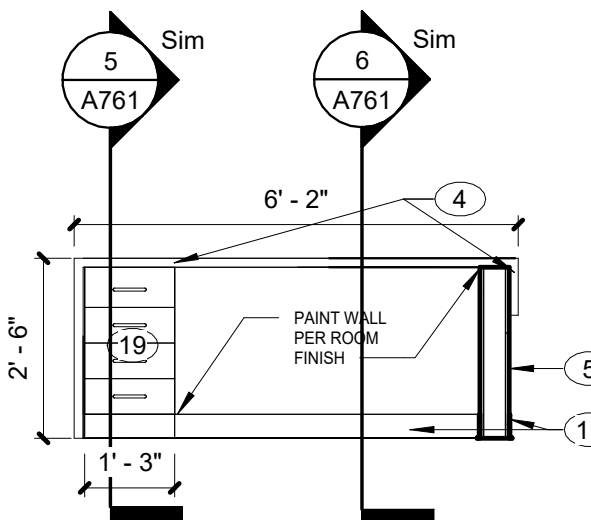


6 CSWK - RECEPTION G131 SOUTH
SCALE: 3/8" = 1'-0"

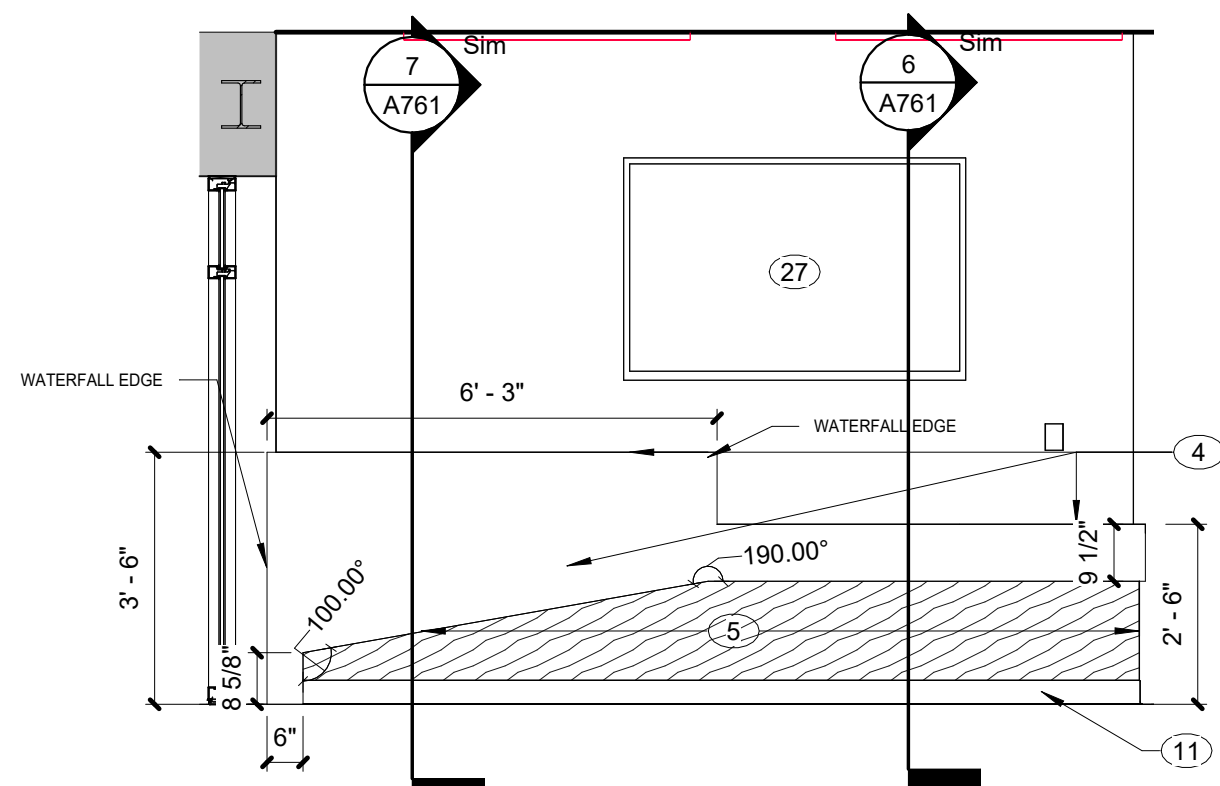


5 CSWK - RECEPTION G131 EAST
SCALE: 3/8" = 1'-0"

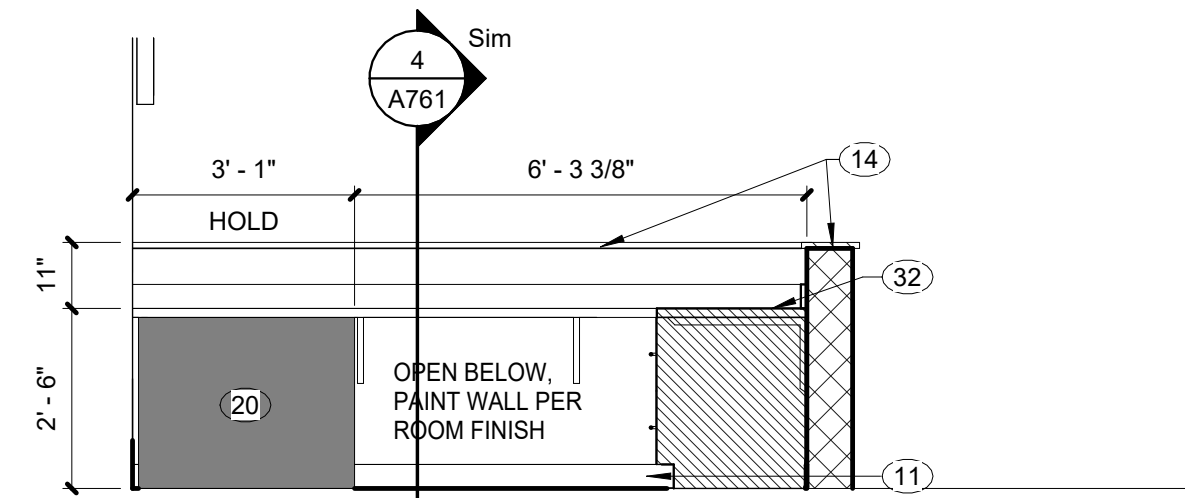


4 CSWK - WEIGHT RM G118 2
SCALE: 3/8" = 1'-0"

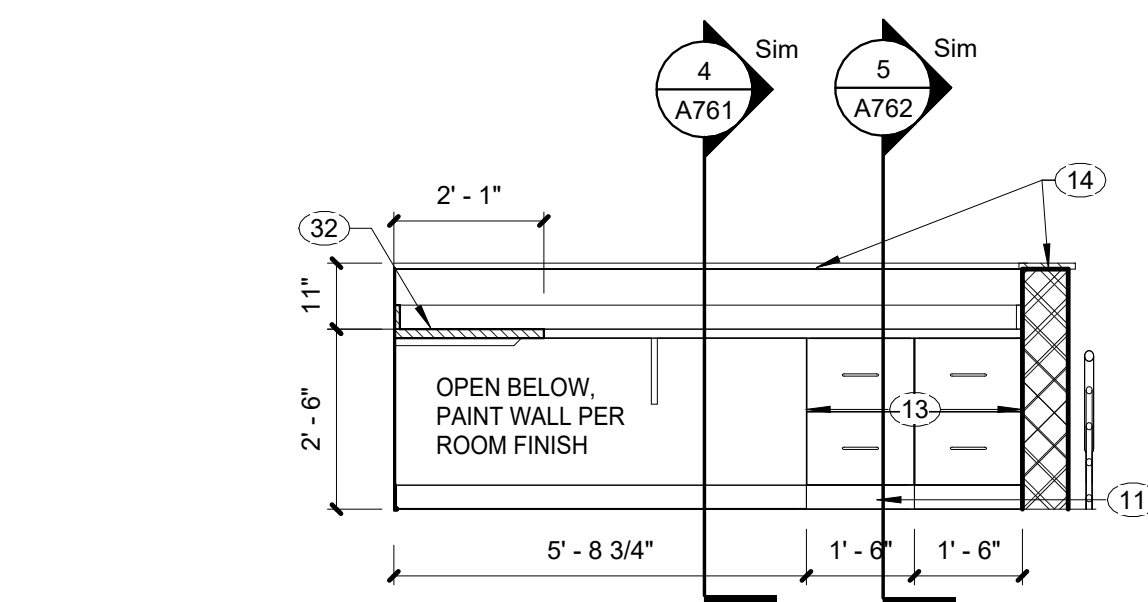

3 CSWK - WEIGHT RM G118
SCALE: 3/8" = 1'-0"

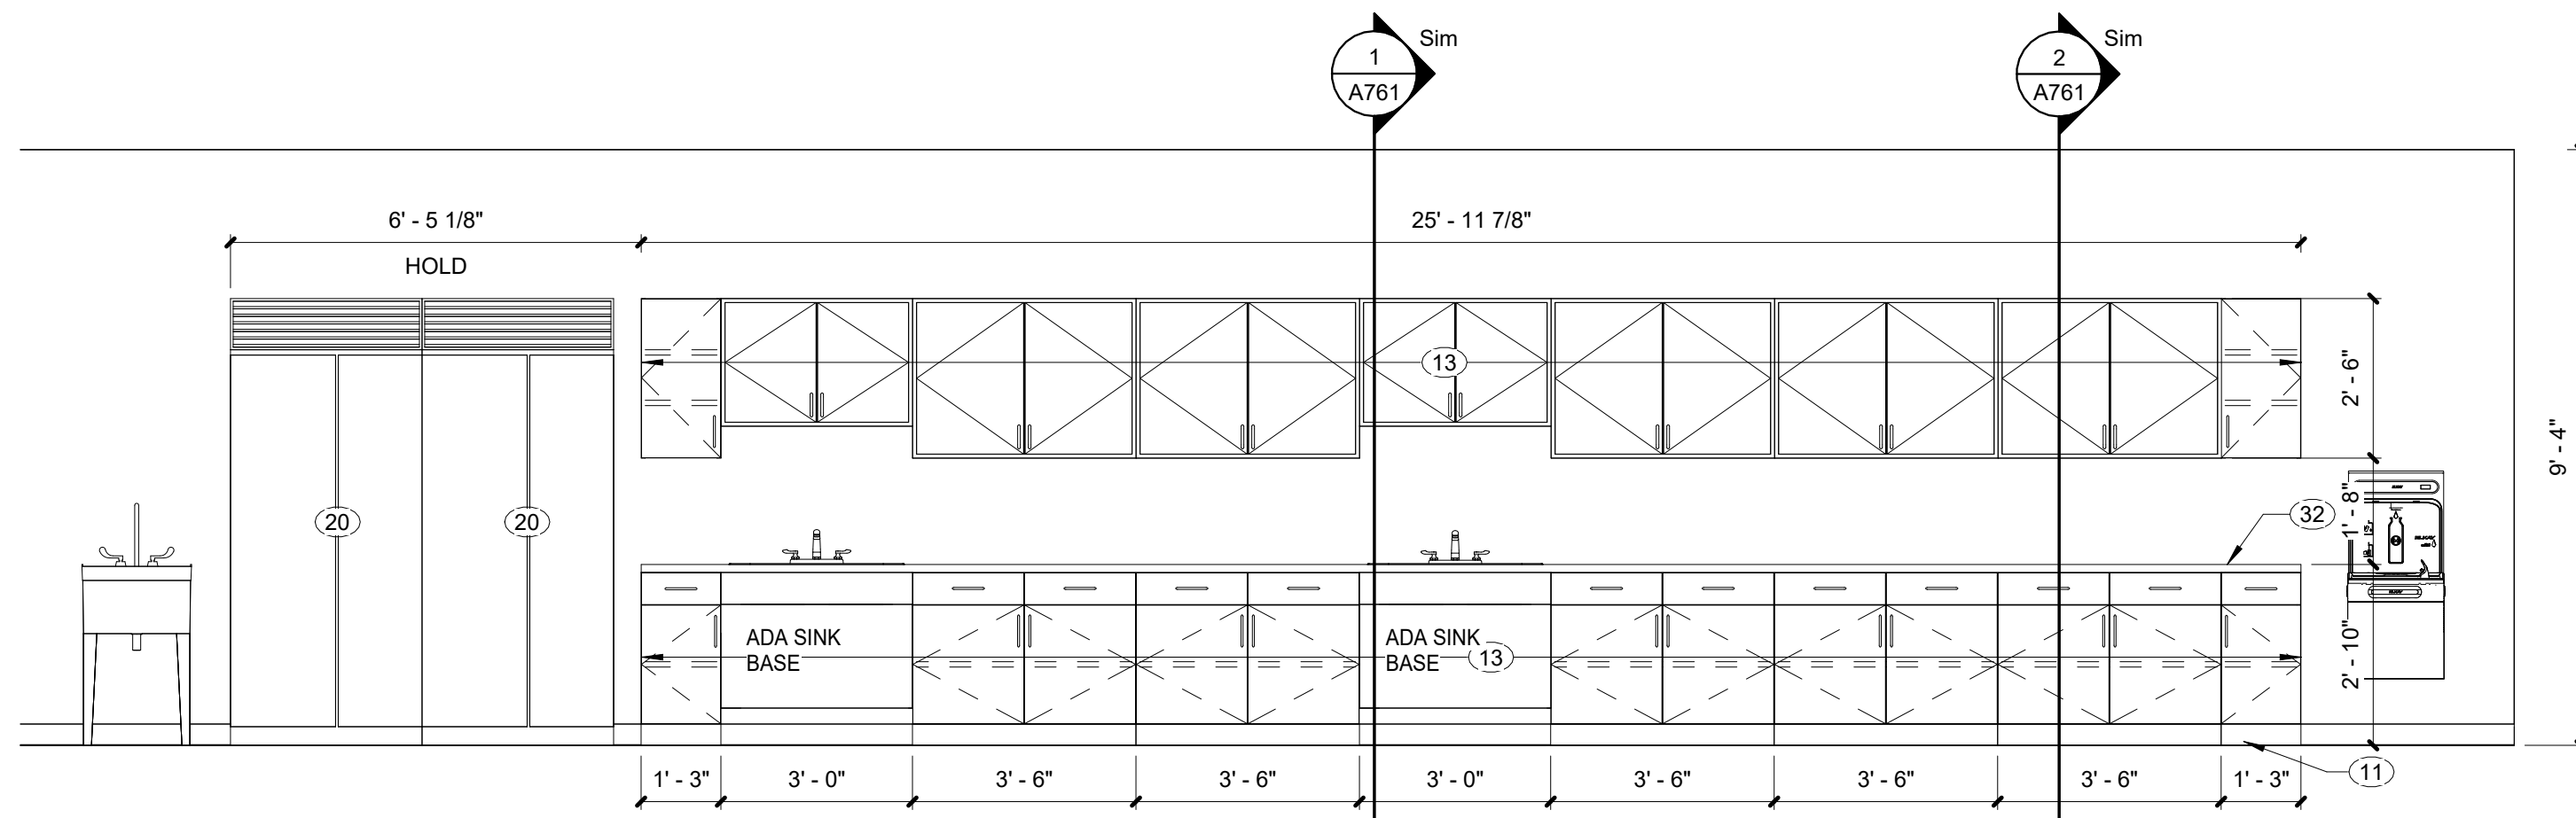

2 CSWK - TRAINING G101 WEST
SCALE: 3/8" = 1'-0"

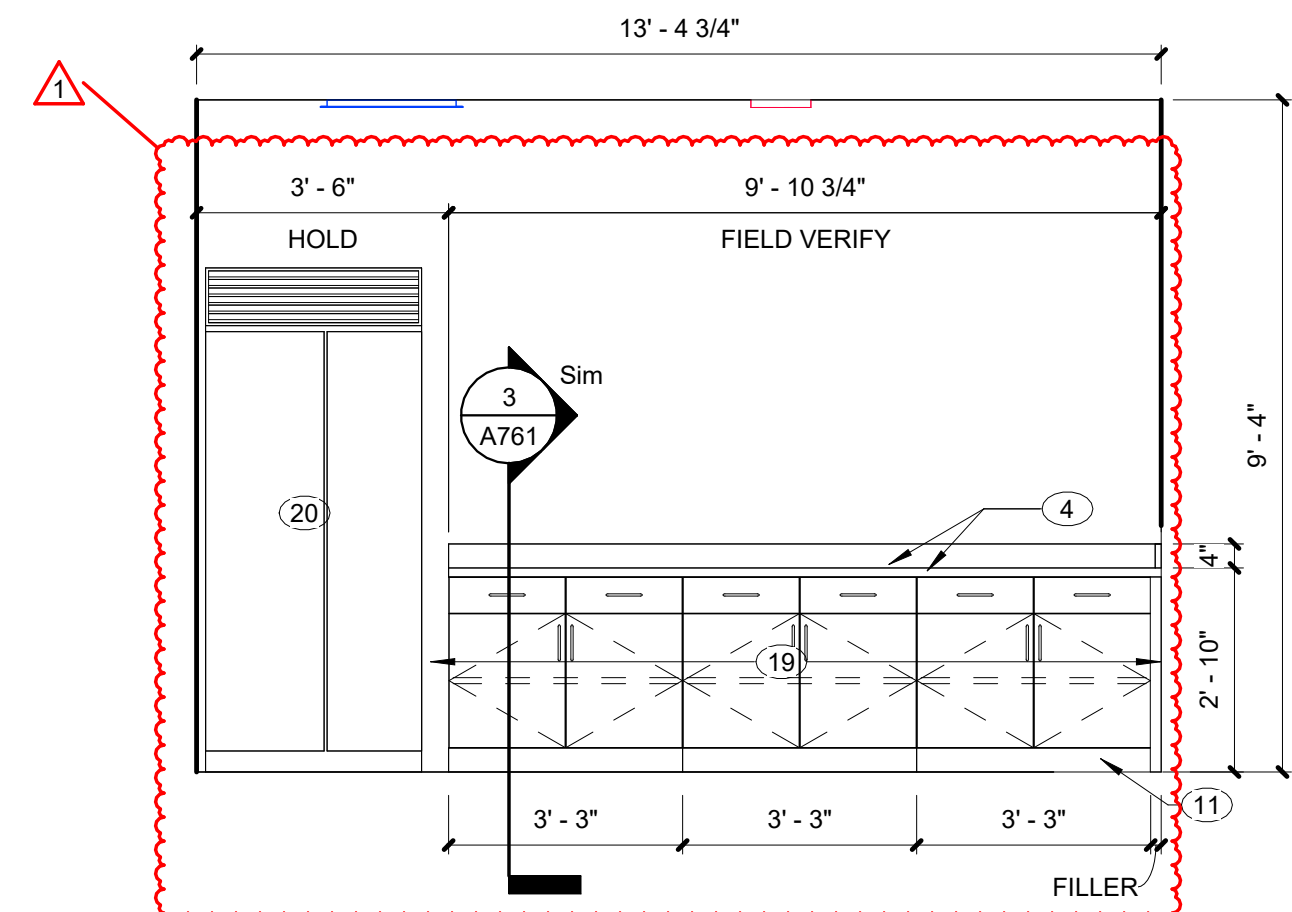

1 CSWK - CONF. G151 NORTH
SCALE: 3/8" = 1'-0"

ELEVATION NOTES - INTERIOR

1. ACOUSTIC PANEL, AWP-1. REFER TO FINISH LEGEND
2. ACOUSTIC PANEL AWP-2. REFER TO FINISH LEGEND
3. WALL PADS, WP-3. COLOR TO MATCH PANTONE PMS 187 OR BE SIMILAR GIVEN DESIGNER/OWNER APPROVAL
4. 1-1/2" SOLID SURFACE TOP, SS-1. REF. FINISH LEGEND.
5. PLASTIC LAMINATE RECEPTION FRONT AND SIDES, PL-1. REF. FINISH LEGEND.
6. FULL WALL CUSTOM GRAPHIC WALL PROTECTION PANELS, WP-2. COORDINATE FINAL GRAPHIC DESIGN WITH OWNER. REFER TO DETAILS AND SPECS FOR PANEL. INSTALL INFO
7. PLASTIC LAMINATE FINISHED PANELS, PL-1. 1/16" JOINTS. TRIM ON ALL EDGES. REFER TO FINISH LEGEND AND DETAILS.
8. WALL TILE, WT-1. REF. FINISH LEGEND.
9. ACCENT PAINT, PT-5 AT THIS LOCATION. REFER TO FINISH LEGEND.
10. CUSTOM 3D ACRYLIC SIGNAGE ELEMENT AT THIS LOCATION WITH LIGHTING. PROVIDE POWER FOR LED LIGHTS. COORDINATE FINAL DESIGN WITH OWNER.
11. RESILIENT BASE, RB-1. REFER TO FINISH LEGEND.
12. ACCENT PAINT, PT-4 AT THIS LOCATION. REFER TO FINISH LEGEND.
13. PLASTIC LAMINATE CASEWORK, PL-2.
14. PAINTED WOOD WALL CAP.
15. CUSTOM PAINT GRAPHIC AT THIS LOCATION. 3 COLORS USED. FINAL DESIGN TO BE COORDINATED WITH OWNER
16. 1" 3D LETTERING. CLEAR ANONIDIZED COLOR. FONT AND LETTERS TO BE COORDINATED WITH OWNER.
17. ACCENT PAINT, PT-3 AT THIS LOCATION. REFER TO FINISH LEGEND.
18. PAINTED LETTERING IN ACCENT PAINT, PT-4. FINAL FONT, SIZE, AND DESIGN TO BE COORDINATED WITH OWNER.
19. PLASTIC LAMINATE CASEWORK, PL-1.
20. SPACE FOR OWNER PROVIDED, CONTRACTOR INSTALLED APPLIANCE.
21. PROVIDE SHIP LADDER TO THE DOOR. DOOR SILL IS 4'-0" AFF.
22. PAINT ALL EXPOSED COLUMNS ADJACENT TO STRUCTURE OVERHEAD PT-4. REFER TO FINISH LEGEND.
23. PAINT DUCTWORK, PT-4. REFER TO FINISH LEGEND.
24. PAINTED LETTERING IN ACCENT PAINT, PT-1, PT-4, AND PT-5. FINAL FONT, SIZE, AND DESIGN TO BE COORDINATED WITH OWNER.
25. PAINT EXPOSED STRUCTURE, PT-4. REFER TO FINISH LEGEND.
26. ACCENT PAINT, PT-2 AT THIS LOCATION. REFER TO FINISH LEGEND.
27. TV MONITOR PROVIDED BY OWNER. INSTALLED BY CONTRACTOR. PROVIDE POWER.
28. PAINT EXPOSED STRUCTURE, MECHANICAL, AND UNDERSIDE OF DECK, PT-7. REFER TO FINISH LEGEND.
29. DIGITAL VIDEO BOARD. PROVIDED BY OWNER. PROVIDE POWER AND DATA.
30. WRAP PAINTED DESIGN AROUND WALLS AND CONTINUE.
31. INSTALL PRESERVED OLD GYM FLOOR GRAPHICS "WHITELAND" & "WARRIORS".
32. 1-1/2" SOLID SURFACE TOP, SS-2. REF. FINISH LEGEND.
33. 7" HIGH X 1/2" DEPTH 3D ACRYLIC LETTERS.
34. 6" DEEP DISPLAY CASE. CUSTOM PLASTIC LAMINATE FINISH WITH GLASS FRONT. HINGED ACCESS PANEL. INCLUDE FABRIC WRAPPED TACK SURFACE AT BACK OF PANEL.
35. PLASTIC LAMINATE FINISHED PANELS, PL-2. 1/16" JOINTS. TRIM ON ALL EDGES. REFER TO FINISH LEGEND AND DETAILS.
36. PAINTED LETTERING IN ACCENT PAINT, PT-5. FINAL FONT, SIZE, AND DESIGN TO BE COORDINATED WITH OWNER.
37. WALL PADS, WP-4. COLOR TO MATCH ACCENT PAINT PT-5 OR BE SIMILAR GIVEN DESIGNER/OWNER APPROVAL.
38. WALL PROTECTION PANEL WP-1 AT THIS LOCATION. INCLUDE TRIM ON ALL EDGES AND CORNERS. REFER TO FINISH LEGEND AND DETAILS.
39. PAINT WALL, SIDE WALLS, AND/OR BULKHEAD PT-6. REFER TO FINISH LEGEND.

CLARK-PLEASANT COMMUNITY SCHOOL CORP.

WHITELAND COMM. HIGH SCHOOL PHASE 3

300 E MAIN ST, WHITELAND, IN 46184



REVISIONS:	
#	Date
1	07-15-2025

100% CONSTRUCTION DOCUMENTS

PROJECT: #22130
DATE: 06-06-2025
DRAWN BY: Author

CASEWORK ELEVATIONS

A760

- DEMOLITION PLAN NOTES
1.

DISCONNECT AND REMOVE EXISTING UNDERGROUND PIPING. PREPARE REMAINING FOR RECONNECT WITH NEW.
2.

DISCONNECT AND REMOVE EXISTING UNDERGROUND PIPING. CAP AND ABANDON REMAINING PIPING.
3.

CAP AND ABANDON EXISTING UNDERGROUND PIPING.
4.

TEMPORARY UNDERGROUND DOMESTIC WATER SERVICE ENTRANCE. CORE DRILL EXISTING UNDERGROUND FOUNDATION AND SAWCUT EXISTING FLOOR AS REQUIRED. REFER TO CIVIL DRAWINGS FOR MORE INFORMATION. COORDINATE EXACT LOCATION AND DEPTH WITH SITE CONTRACTOR.

PLAN NOTES

1. SAWCUT AND REMOVE EXISTING FLOOR AS REQUIRED FOR INSTALLATION OF NEW PIPING AND TIE-IN WITH EXISTING. BACKFILL WITH COMPACTABLE FILL, DOWELL INTO EXISTING SLAB, AND PAN NEW SLAB OF SAME THICKNESS.

LANCER ASSOCIATES
ARCHITECTURE

145 N. EAST ST.
INDIANAPOLIS, IN 46204


PRIMARY
ENGINEERING INC.

Fort Wayne
2601 Lake Ave.
Fort Wayne, Indiana
46805
317.244.0444 ph
317.244.1221 fx

Indianapolis
9785 Crescent Blvd., Suite 102
Indianapolis, Indiana 46226
317.244.1221 ph
317.244.1221 fx

All concepts, ideas, plans, and details as shown on this document are the sole property of Primary Engineering, Inc. and shall not be used for any other purpose without their expressed written consent. The project owner shall be permitted to retain copies for information and reference purposes.
©2024 © Primary Engineering, Inc.

CLARK-PLEASANT COMMUNITY SCHOOL CORP.
WHITELAND COMM. HIGH SCHOOL PHASE 3
300 E MAIN ST, WHITELAND, IN 46184

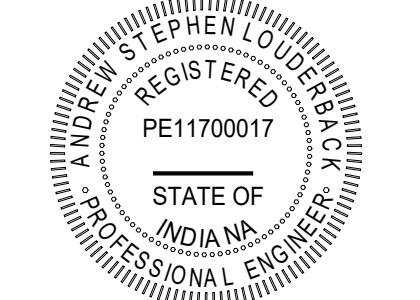

REVISIONS:

#	Date	Desc.
1	7-16-2025	Addendum #1


100% CONSTRUCTION DOCUMENTS

PROJECT: #22130
DATE: 05-30-2025
DRAWN BY: ASL


UNDERGROUND - PLUMBING
PLAN - UNIT G.2

P100G.2



PRIMARY JOB # 24612

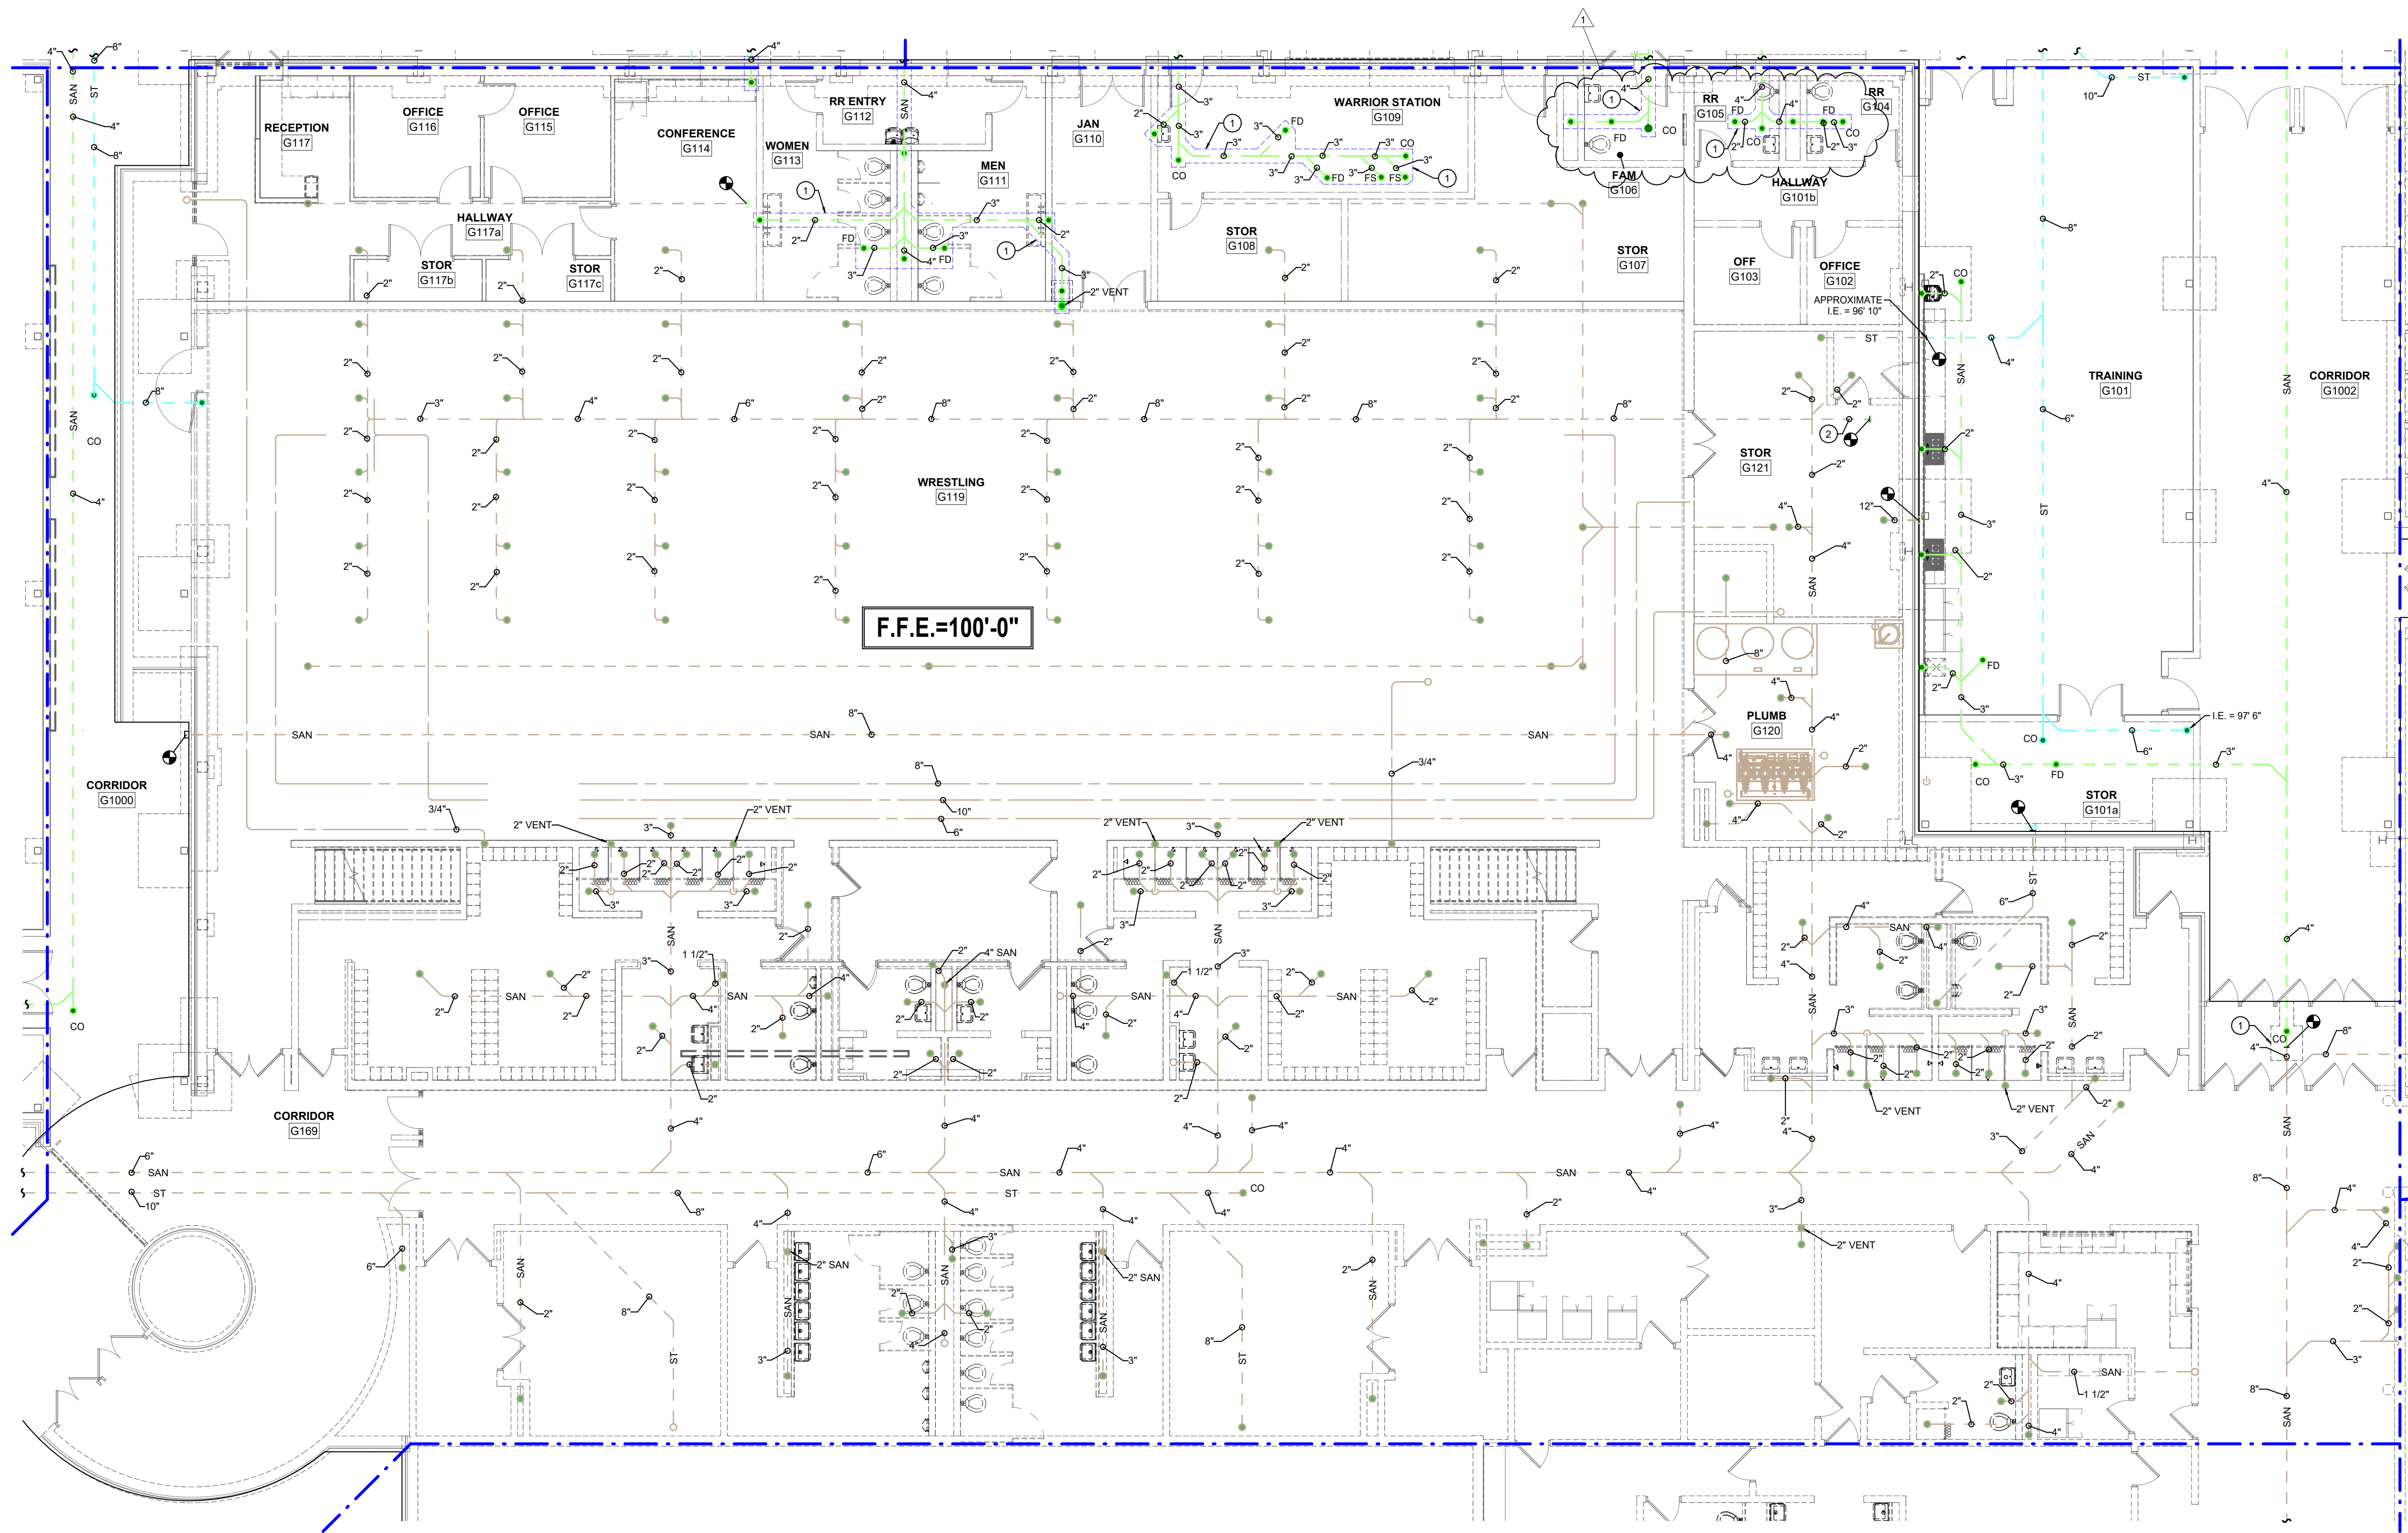

- PLAN NOTES
1. INSTALL NEW PLUMBING FIXTURE ON EXISTING FIXTURE CARRIER. TIE INTO EXISTING DOMESTIC AND SANITARY PIPING AS REQUIRED. PROVIDE AND INSTALL NEW WAX RING AND CAULK AROUND FIXTURE TO SEAL WATER TIGHT.
 2. TIE-IN TO EXISTING AND ROUTE NEW 1" TEMPERED SUPPLY THROUGH NEW 4"x4" HORIZONTAL CUSTOM STAINLESS STEEL SHROUD TIGHT TO EXISTING CEILING. ROUTE TO SHOWERS THROUGH VERTICAL CUSTOM SHROUD EXTENSION.
 3. TIE-IN TO EXISTING AND ROUTE NEW 3/4" HOT AND COLD SUPPLY TO NEW SHOWER THROUGH VERTICAL CUSTOM SHROUD EXTENSION.
 4. EXISTING CEILING ELEVATION APPROXIMATELY 8'0" AFF.
 5. EXISTING CEILING ELEVATION APPROXIMATELY 9'4" AFF.
 6. PROVIDE AND INSTALL NEW THERMOSTATIC MIXING VALVE IN EXISTING RECESSED CABINET. RECONNECT TO EXISTING PIPING.
 7. PROVIDE AND INSTALL NEW FLOOR DRAIN. TIE-IN TO EXISTING UNDERGROUND PIPING. PATCH FLOOR TO MATCH ADJACENT.

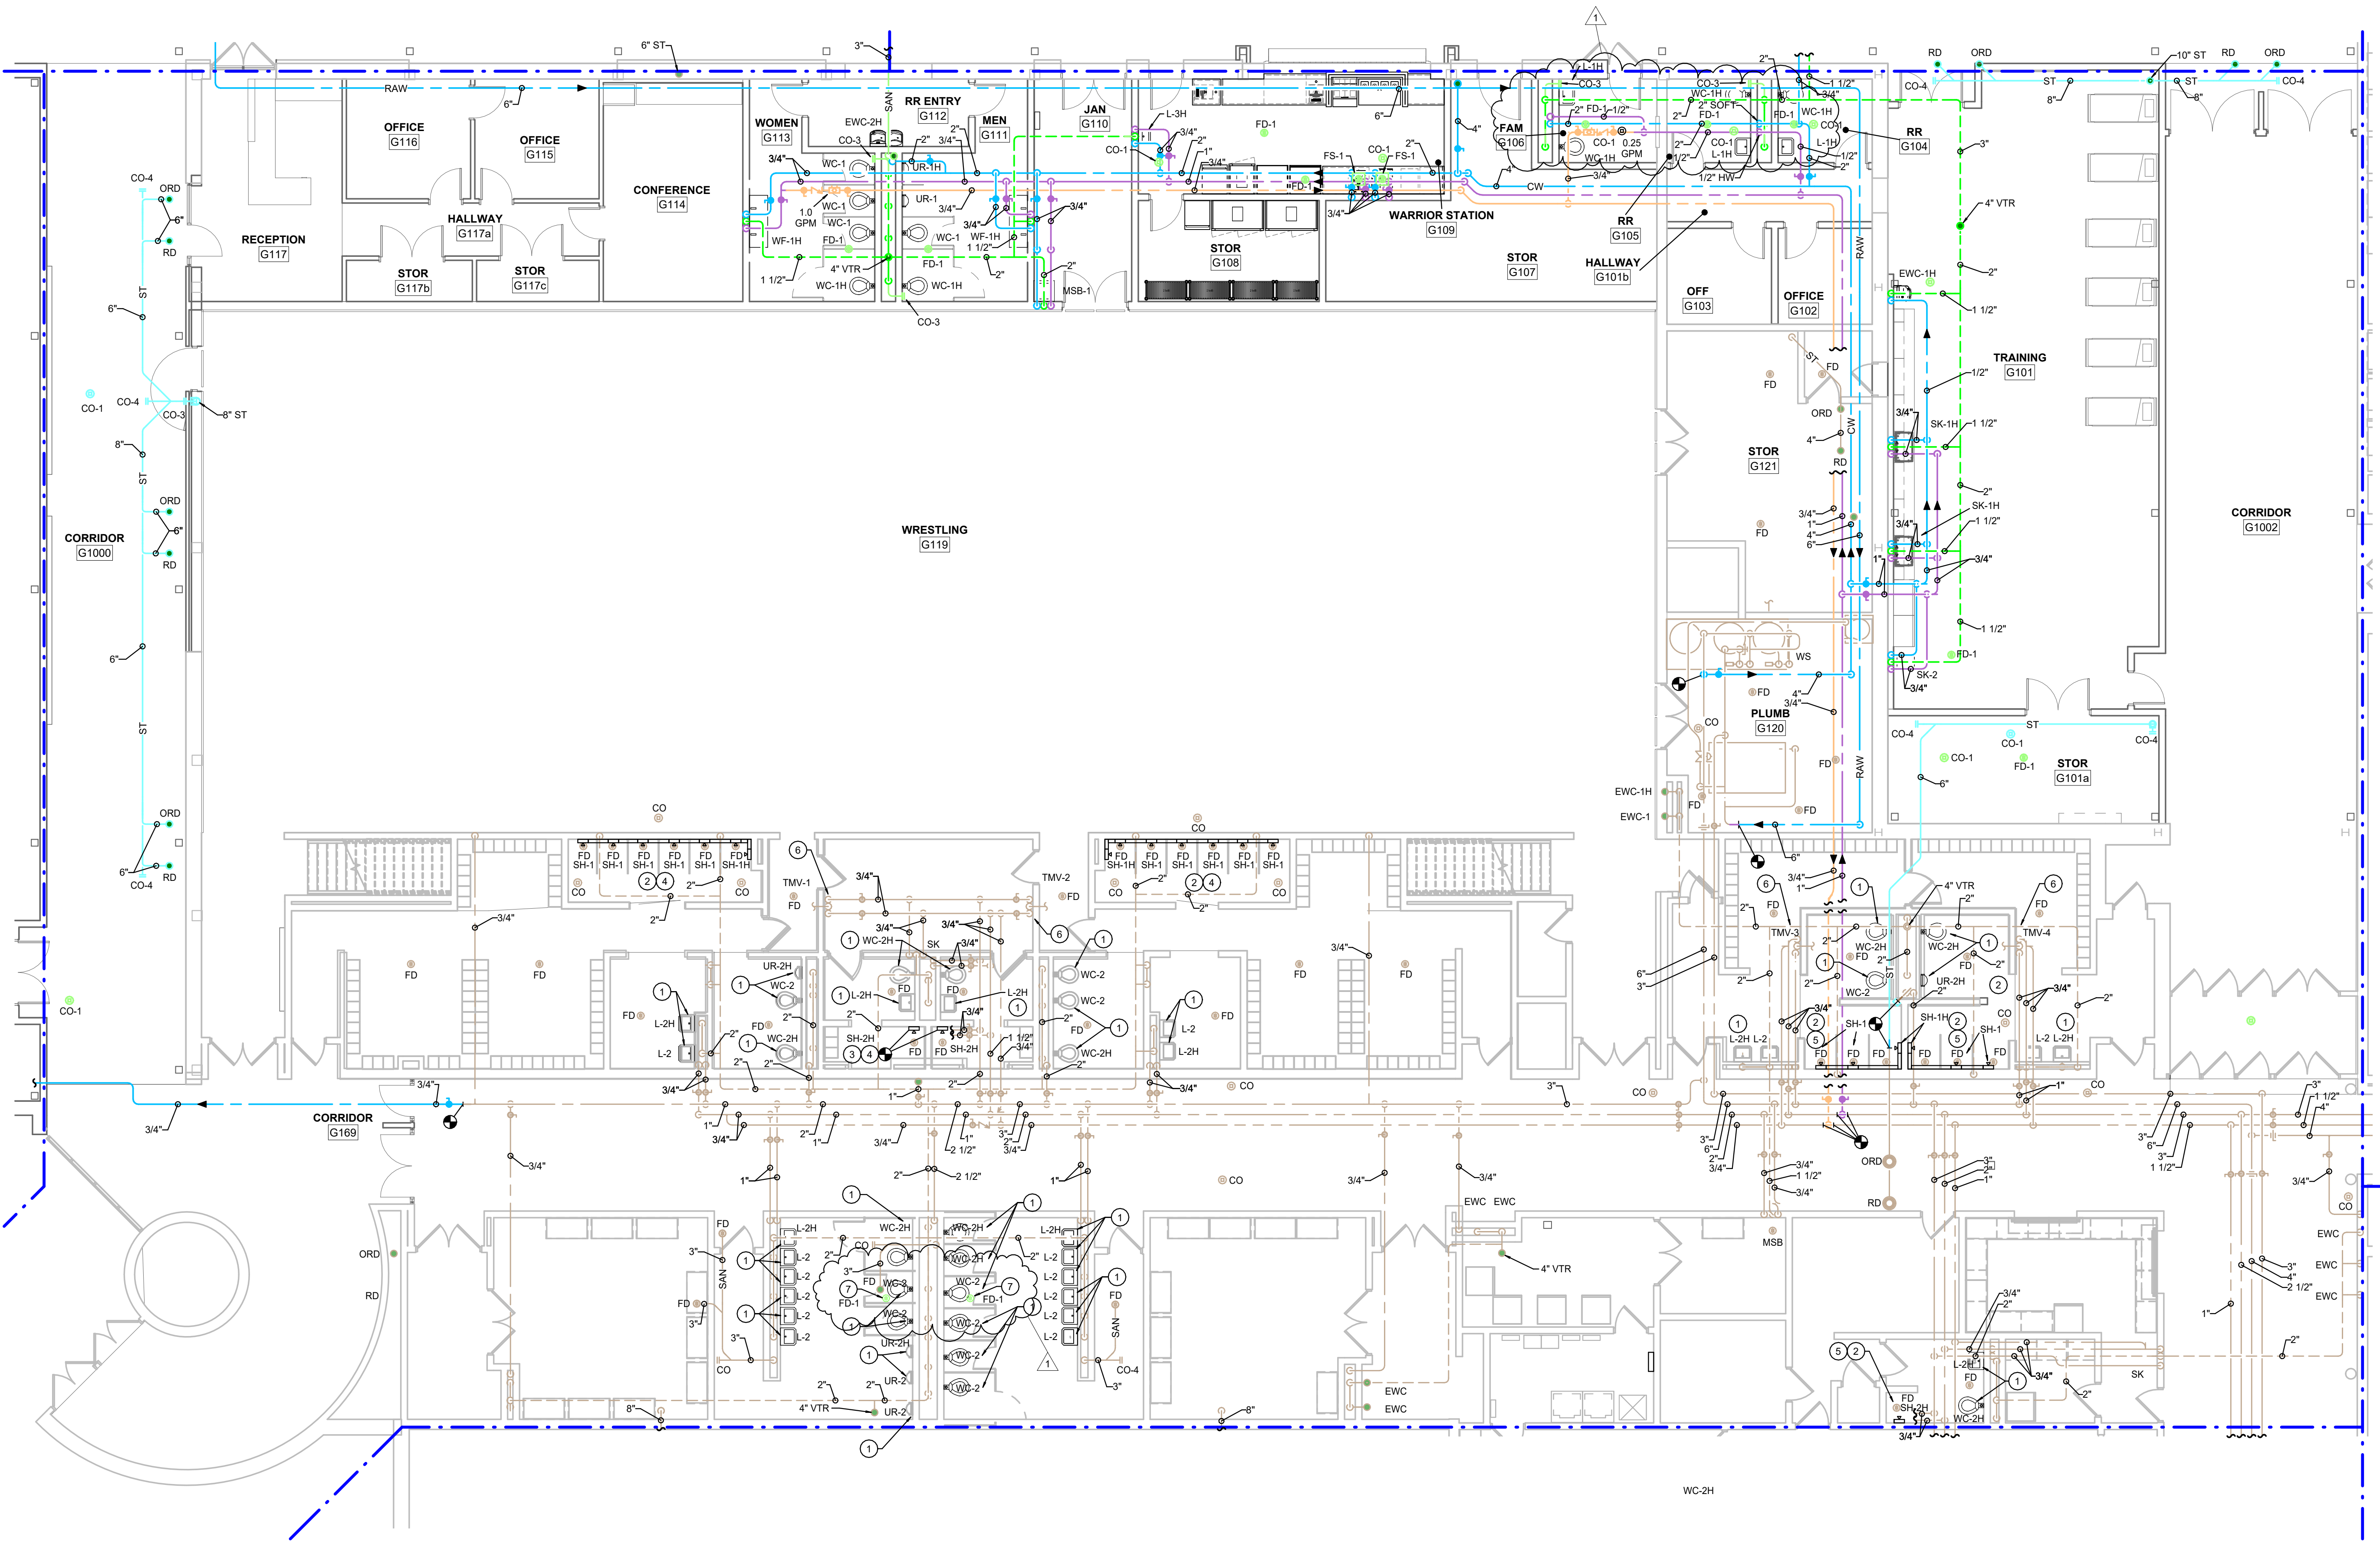

1 FIRST FLOOR - PLUMBING PLAN - UNIT G.2
SCALE: 1/8" = 1'-0"

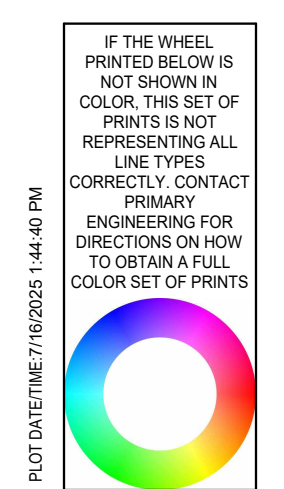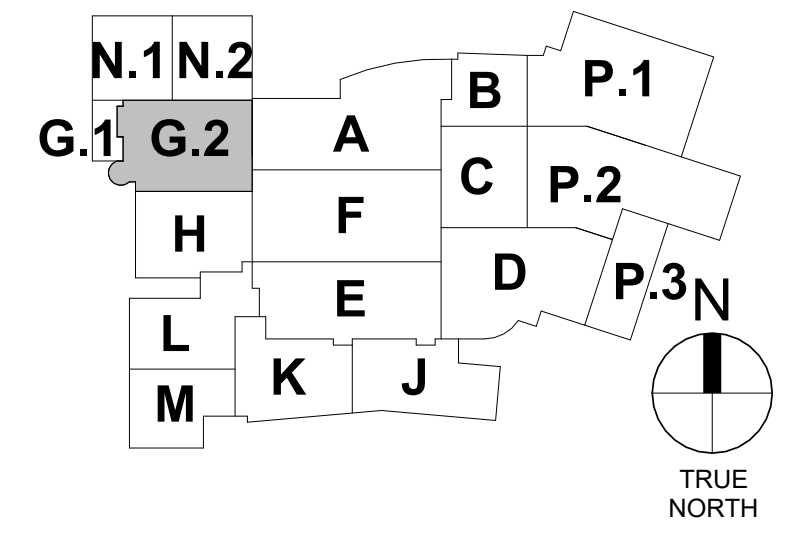

CLARK-PLEASANT COMMUNITY SCHOOL CORP.
WHITELAND COMM. HIGH SCHOOL PHASE 3
300 E MAIN ST, WHITELAND, IN 46184



REVISIONS:		
#	Date	Description
1	7-16-2025	Addendum #1

100% CONSTRUCTION DOCUMENTS
PROJECT: #22130
DATE: 05-30-2025
DRAWN BY: ASL


FIRST FLOOR - PLUMBING PLAN - UNIT G.2

P101G.2

PRIMARY JOB # 24612

PRIMARY ENGINEERING INC.
Fort Wayne, Indiana 46805
2620 Lake Ave. Suite 103
8785 Crosspoint Blvd., Suite 103
Indianapolis, Indiana 46226
317.284.1221 (ph)
317.284.1221 (fax)
All concepts, ideas, plans, and details as shown on this document are the sole property of Primary Engineering, Inc. and shall not be used for any other purpose without their expressed written consent. The project owner shall be permitted to retain copies for information and reference purposes.
©2024 © Primary Engineering, Inc.

LANCER ASSOCIATES ARCHITECTURE
145 N. EAST ST.
INDIANAPOLIS, IN 46204

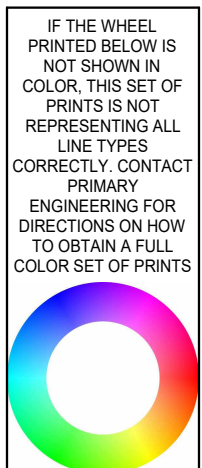


THE PAPER PRINTED BELOW IS NOT SHOWN IN COLOR. THE SET OF PRINTS IS NOT REPRESENTING ALL LINE TYPES. CORRECTLY CONTACT PRIMARY ENGINEERING FOR HOW TO OBTAIN A FULL COLOR SET OF PRINTS.

LIGHT FIXTURE SCHEDULE										
TAG	MANUFACTURER'S CATALOG NUMBER	MAX. WATTS	MOUNT	MIN. LUMEN OUTPUT *(D/I)	CCT	CRI	DESCRIPTION	REMARKS		
L13-4	LUMENWERX #VSPUR-D-TMG-HL-SW-80CRI-1000LMF-40K-4FT-UNV-D1-1C-EF-MTL-NATA FORUM LIGHTING #WBRLD-1000-80-4-S-4-W-UNV-DP-1-D-N A-LIGHT #DS 4 LH 40 BCRU U HE X X D K	39	RECESSED	4,000	4000	80	120V - 277V, 4' x 4'-0", SEALED LINEAR FIXTURE WITH TEMPERED CLEAR GLASS LENS, WHITE FINISH, 0-10V DIMMING DRIVER, DIMMABLE TO 1%, ELECTRONIC DRIVER WITH <20% THD, UL LISTED, IP66 WITH NATATORIUM FINISH, COLOR TO BE SELECTED BY ARCHITECT, CONTROL WIRING REQUIRED FOR OPERATION OF 0-10V DIMMING.			
L13-4A	SAME AS L13-4 EXCEPT WITH EMERGENCY BATTERY INVERTER									
L13-8	LUMENWERX #VSPUR-D-TMG-HL-SW-80CRI-1000LMF-40K-8FT-UNV-D1-1C-EF-MTL-NATA FORUM LIGHTING #WBRLD-1000-80-4-S-8-W-UNV-DP-1-D-N A-LIGHT #DS 8 LH 40 BCRU U HE X X D K	78	RECESSED	8,000	4000	80	120V - 277V, 4' x 4'-0", SEALED LINEAR FIXTURE WITH TEMPERED CLEAR GLASS LENS, WHITE FINISH, 0-10V DIMMING DRIVER, DIMMABLE TO 1%, ELECTRONIC DRIVER WITH <20% THD, UL LISTED, IP66 WITH NATATORIUM FINISH, COLOR TO BE SELECTED BY ARCHITECT, CONTROL WIRING REQUIRED FOR OPERATION OF 0-10V DIMMING.			
L13-8A	SAME AS L13-8 EXCEPT WITH EMERGENCY BATTERY INVERTER									
L13-12	LUMENWERX #VSPUR-D-TMG-HL-SW-80CRI-1000LMF-40K-12FT-UNV-D1-1C-TF-NATA FORUM LIGHTING #WBRLD-1000-80-4-S-12-W-UNV-DP-1-D-N A-LIGHT #DS 12 LH 40 BCRU U HE X X D K	116	RECESSED	12,000	4000	80	120V - 277V, 4' x 4'-0", SEALED LINEAR FIXTURE WITH TEMPERED CLEAR GLASS LENS, WHITE FINISH, 0-10V DIMMING DRIVER, DIMMABLE TO 1%, ELECTRONIC DRIVER WITH <20% THD, UL LISTED, IP66 WITH NATATORIUM FINISH, COLOR TO BE SELECTED BY ARCHITECT, CONTROL WIRING REQUIRED FOR OPERATION OF 0-10V DIMMING.			
L13-12A	SAME AS L13-12 EXCEPT WITH EMERGENCY BATTERY INVERTER									
L14	LUMENWERX #VSPUR-DI-TMG-HL-SW-80CRI-1000LMF-40K-8FT-UNV-D1-1C-TF-NATA FORUM LIGHTING #WBRLD-1000-80-4-S-8-W-UNV-DP-1-S(AI)-TF-N ACCOLADE #ALD2ST 8 LH DLH 40 BCRU U HE BW S XX 1 D K	158	PENDANT	8000/8000	4000	80	120V - 277V, 4' x 8'-0", SEALED DIRECT/INDIRECT LINEAR FIXTURE WITH TEMPERED CLEAR GLASS LENS, WHITE FINISH, 0-10V DIMMING DRIVER, DIMMABLE TO 1%, ELECTRONIC DRIVER WITH <20% THD, UL LISTED, IP66 WITH NATATORIUM FINISH, COLOR TO BE SELECTED BY ARCHITECT, CONTROL WIRING REQUIRED FOR OPERATION OF 0-10V DIMMING.			
L14A	SAME AS L14 EXCEPT WITH EMERGENCY BATTERY INVERTER									
L15-4	LUMENWERX #VIAIR-HLO-FH-80-1200-DUG-8FT-120-0-10-1 LITECONTROL #4L-LG-D-4-6-SOF-C1-276ST-D120-D01-1C-UNV-W1 MARK LIGHTING #SLAL LOP 4FT FLP FL 80CRI TUWH RHYR 1200LMF DARK 277	52	RECESSED	4,800	2700K/6000K	80	120V - 277V, 4' x 4'-0", RECESSED LINEAR FIXTURE WITH FLUSH LENS AND TUNABLE WHITE, WHITE FINISH, 0-10V DIMMING DRIVER, DIMMABLE TO 1%, ELECTRONIC DRIVER WITH <20% THD, UL LISTED, CONTROL WIRING REQUIRED FOR OPERATION OF 0-10V DIMMING.			
L15-4A	SAME AS L15-4 EXCEPT WITH EMERGENCY BATTERY INVERTER									
L15-8	LUMENWERX #VIAIR-HLO-FH-80-1200-DUG-8FT-120-0-10-1 LITECONTROL #4L-LG-D-8-6-SOF-C1-276ST-D120-D01-1C-UNV-W1 MARK LIGHTING #SLAL LOP 8FT FLP FL 80CRI TUWH RHYR 1200LMF DARK 277	104	RECESSED	9,600	2700K/6000K	80	120V - 277V, 4' x 8'-0", RECESSED LINEAR FIXTURE WITH FLUSH LENS AND TUNABLE WHITE, WHITE FINISH, 0-10V DIMMING DRIVER, DIMMABLE TO 1%, ELECTRONIC DRIVER WITH <20% THD, UL LISTED, CONTROL WIRING REQUIRED FOR OPERATION OF 0-10V DIMMING.			
L15-8A	SAME AS L15-8 EXCEPT WITH EMERGENCY BATTERY INVERTER									
L15-12	LUMENWERX #VIAIR-HLO-FH-80-1200-DUG-12FT-120-0-10-1 LITECONTROL #4L-LG-D-12-6-SOF-C1-276ST-D120-D01-1C-UNV-W1 MARK LIGHTING #SLAL LOP 12FT FLP FL 80CRI TUWH RHYR 1200LMF DARK 277	156	RECESSED	14,400	2700K/6000K	80	120V - 277V, 4' x 12'-0", RECESSED LINEAR FIXTURE WITH FLUSH LENS AND TUNABLE WHITE, WHITE FINISH, 0-10V DIMMING DRIVER, DIMMABLE TO 1%, ELECTRONIC DRIVER WITH <20% THD, UL LISTED, CONTROL WIRING REQUIRED FOR OPERATION OF 0-10V DIMMING.			
L15-12A	SAME AS L15-12 EXCEPT WITH EMERGENCY BATTERY INVERTER									
L16	LUMENWERX #VIAPOI-HLO-FH-CLO-LED-80-1200-500-DU-12FT-277-0-1-1-W LITECONTROL #4L-P-D-STD-12-06-SOF-C1-276ST-ISO-D120-D1-2C-UNV-XX MARK LIGHTING #S4PD LPP-12FT-MSL8-80CRI-TUWH-RHYR-1200LMF-80CRI-600LM-DCF-DFL-DC-MVOLT-XXX	192	PENDANT	20,400	2700K/6000K	80	120-277V, 4'x12'-0" DIRECT/INDIRECT LINEAR PENDANT WITH TUNABLE WHITE CONTROL.			
L16A	SAME AS L16 EXCEPT WITH EMERGENCY BATTERY INVERTER									
L17	METALUX #4BCLED-LD4-48HL-F-UNV-L840-CD-1- COLUMBIA #CWM4-40MLSM-FRPP-EDU LITHONIA #BLWP4 48L ADP EZ1 LP840	51	WALL	4,800	4000	80	120-277V WALL MOUNTED BRACKET LIGHT, 0-10V DIMMING DRIVER, DIMMABLE TO 1%, ELECTRONIC DRIVER WITH <20% THD, UL LISTED.			
L17A	SAME AS L17 EXCEPT WITH EMERGENCY BATTERY INVERTER									
L18	METALUX #24GR-FA-LDS-85-F1-UNV-L840-CD-1-G3 COLUMBIA # L724-XLOX-FAA12P (INV) EDU-G3 LITHONIA #23TL4-8BL-FN-A12125-GZ1N-LP840-ABC	73	RECESSED	8,567	4000	80	120-277V, 2'x4' LENSED TROFFER WITH FLUSH WHITE EXTRUDED ALUMINUM DOOR FRAME AND FROSTED #12 PATTERN LENSE, FLIP LENSE WITH FLUSH SIDE DOWN, PROVIDE GASKET BETWEEN DOOR FRAME AND HOUSING LENS AND FRAME AND FACE OF FIXTURE PROVIDE, 0-10V ELECTRONIC DIMMING TO 10% UL LISTED.			
L18A	SAME AS L18 EXCEPT WITH EMERGENCY BATTERY INVERTER									
L19	Q-TRAN #TR1SW-535-DRY-DOF-SD-S1-XX-T8C KELVIX #CH011-2-FRS-SF-EC BEULLX #J99-SLF-L400-IP00CT3S-EC-MC-DTR-16-IP00	15	SURFACE	1,035	3500	80	277V, 3'-0" X 3'-4" TALL LINEAR FIXTURE, PROVIDE NECESSARY MOUNT AND CABLING AS REQUIRED TO MAKE A COMPLETE AND OPERATIONAL SYSTEM, PROVIDE POWER SUPPLIES, AS REQUIRED, TO OPERATE WITH 0-10V DIMMING RELAY PANEL, UL LISTED			
TK1	CONTECH #806SV-S-3S-D-P ALINE #A-FLX15-3515T-WH (2-CIRCUITATK) ATK**2C-WH JUNO #T254L-35K-S/W /T4-W	20	TRACK	1,480	3500	80	120V, TRACK LIGHT WITH SPOT DISTRIBUTION, PROVIDE AND INSTALL 2 CIRCUIT TRACK AND ALL NECESSARY COMPONENTS TO MAKE A COMPLETE AND OPERATIONAL SYSTEM, REFER TO DRAWINGS FOR TRACK LENGTH, COLOR TO BE SELECTED BY ARCHITECT.			
BL1	MCORAW EDISON #IBS-SA1-D-740-U-T4W BEACON #GSP2-24L-80-4K7-4-UNV-XX LITHONIA #W50-P4-40K-SRM-MVOLT-XX	61	WALL	5,664	4000	70	120-277V, SMALL QUARTER SPHERE DIE CAST ALUMINUM WITH TYPE V DISTRIBUTION, ELECTRONIC DRIVER, UL LISTED, COLOR BY ARCHITECT, MOUNT FIXTURE AT 10'-0" A.F.G. UNLESS OTHERWISE NOTED.			
BL1A	SAME AS BL1 EXCEPT WITH EMERGENCY BATTERY INVERTER									
PD1-3	BETA CALCO #RNGP203-CR80-UD2-U1-DA01-DB01-SS-XXXX-CF-01-AP00-CS2-CO SCOTT LIGHTING #S2A31-L144-72U-40K**-QA-2C DAY-O-LITE # COML-44-DI DP 40 10000/16000 3 AC X	144	SUSPENDED	10,000/5,000	4000	80	120-277V, 3FT DIAMETER DIRECT/INDIRECT RING FIXTURE, CUSTOM COLOR TO BE SELECTED BY ARCHITECT, 0-10V ELECTRONIC DIMMING TO 10% UL LISTED.			
PD1-6	BETA CALCO #RNGP206-CR80-UD2-U1-DA01-DB01-SS-XXXX-CF-01-AP00-CS2-CO SCOTT LIGHTING #S2A34-L288-144U-40K**-QA-20 DAY-O-LITE #COML-44-DI DP 40 21000/16000 6 AC X	302	SUSPENDED	21,000/9,000	4000	80	120-277V, 6FT DIAMETER DIRECT/INDIRECT RING FIXTURE, CUSTOM COLOR TO BE SELECTED BY ARCHITECT, 0-10V ELECTRONIC DIMMING TO 10% UL LISTED.			
PD1-9	BETA CALCO #RNGP209-CR80-UD2-U1-DA01-DB01-SS-XXXX-CF-01-AP00-CS2-CO SCOTT LIGHTING #S2A36-Q-L504-186U-40K**-QA-2C DAY-O-LITE #COML-44-DI DP 40 32000/16000 9 AC X	454	SUSPENDED	32,000/16,000	4000	70	120-277V, 9FT DIAMETER DIRECT/INDIRECT RING FIXTURE, CUSTOM COLOR TO BE SELECTED BY ARCHITECT, 0-10V ELECTRONIC DIMMING TO 10% UL LISTED.			
PD2-10	LUMENWERX #VIAPOI-HLO-FH-HLO-SW-80-1200-400-40-10FT LITECONTROL #4L-P-D-STD-10-6-SOF-C1-40K-D120-D01-2C-UNV-W1-FA1 MARK LIGHTING #S4PD LOP 10FT MSL8 80CRI 40K 1200LMF 80CRI 40K 1400LMF SCT MINI FLL MVOLT WHITT ZT	133	PENDANT	12000/7000	0	4000	80	120V - 277V, 4' x 10'-0", DIRECT / INDIRECT LINEAR FIXTURE WITH FLUSH LENS, WHITE FINISH, 0-10V DIMMING DRIVER, DIMMABLE TO 1%, ELECTRONIC DRIVER WITH <20% THD, UL LISTED, CONTROL WIRING REQUIRED FOR OPERATION OF 0-10V DIMMING, PROVIDE WITH 2 CIRCUITS.		
PD2-10A	SAME AS PD2-10 EXCEPT WITH EMERGENCY BATTERY INVERTER									
PD2-16	LUMENWERX #VIAPOI-HLO-FH-HLO-SW-80-1200-400-40-16FT LITECONTROL #4L-P-D-STD-16-8-SOF-C1-40K-D120-D01-2C-UNV-W1-FA1 MARK LIGHTING #S4PD LOP 16FT MSL8 80CRI 40K 1200LMF 80CRI 40K 1400LMF SCT MINI FLL MVOLT WHITT ZT	212	PENDANT	19,200/4,200	0	4000	80	120V - 277V, 4' x 16'-0", DIRECT / INDIRECT LINEAR FIXTURE WITH FLUSH LENS, WHITE FINISH, 0-10V DIMMING DRIVER, DIMMABLE TO 10%, ELECTRONIC DRIVER WITH <20% THD, UL LISTED, CONTROL WIRING REQUIRED FOR OPERATION OF 0-10V DIMMING, PROVIDE WITH 2 CIRCUITS.		
PD2-16A	SAME AS PD2-16 EXCEPT WITH EMERGENCY BATTERY INVERTER									
PD3-8	LUMENWERX #VIAPO-HLO-FH-SW-80-1200-40-8FT LITECONTROL #4L-P-D-8-XX-SOF-C1-40K-D120-D01-1C-UNV-W1 MARK LIGHTING #S4PD LLP-8FT-MSL8-80CRI 40K 1200LMF SCT-MINI-FLL-MVOLT-WHITT-ZT	90	PENDANT	9,536	4000	80	120V - 277V, 4' x 8'-0", DIRECT LINEAR FIXTURE WITH FLUSH LENS, WHITE FINISH, 0-10V DIMMING DRIVER, DIMMABLE TO 1%, ELECTRONIC DRIVER WITH <20% THD, UL LISTED, CONTROL WIRING REQUIRED FOR OPERATION OF 0-10V DIMMING.			
PD3-8A	SAME AS PD3-8 EXCEPT WITH EMERGENCY BATTERY INVERTER									
PD3-10	LUMENWERX #VIAPO-HLO-FH-SW-80-1200-40-10FT LITECONTROL #4L-P-D-10-XX-SOF-C1-40K-D120-D01-1C-UNV-W1 MARK LIGHTING #S4PD LLP-10FT-MSL8-80CRI 40K 1200LMF SCT-MINI-FLL-MVOLT-WHITT-ZT	112	PENDANT	11,820	4000	80	120V - 277V, 4' x 10'-0", DIRECT LINEAR FIXTURE WITH FLUSH LENS, WHITE FINISH, 0-10V DIMMING DRIVER, DIMMABLE TO 1%, ELECTRONIC DRIVER WITH <20% THD, UL LISTED, CONTROL WIRING REQUIRED FOR OPERATION OF 0-10V DIMMING.			
PD3-10A	SAME AS PD3-10 EXCEPT WITH EMERGENCY BATTERY INVERTER									
PD3-12	LUMENWERX #VIAPO-HLO-FH-SW-80-1200-40-12FT LITECONTROL #4L-P-D-12-XX-SOF-C1-40K-D120-D01-1C-UNV-W1 MARK LIGHTING #S4PD LLP-12FT-MSL8-80CRI 40K 1200LMF SCT-MINI-FLL-MVOLT-WHITT-ZT	134	PENDANT	14,304	4000	80	120V - 277V, 4' x 12'-0", DIRECT LINEAR FIXTURE WITH FLUSH LENS, WHITE FINISH, 0-10V DIMMING DRIVER, DIMMABLE TO 1%, ELECTRONIC DRIVER WITH <20% THD, UL LISTED, CONTROL WIRING REQUIRED FOR OPERATION OF 0-10V DIMMING.			
PD3-12A	SAME AS PD3-12 EXCEPT WITH EMERGENCY BATTERY INVERTER									
PD3-16	LUMENWERX #VIAPO-HLO-FH-SW-80-1200-40-16FT LITECONTROL #4L-P-D-16-XX-SOF-C1-40K-D120-D01-1C-UNV-W1 MARK LIGHTING #S4PD LLP-16FT-MSL8-80CRI 40K 1200LMF SCT-MINI-FLL-MVOLT-WHITT-ZT	257	PENDANT	19,072	4000	80	120V - 277V, 4' x 16'-0", DIRECT LINEAR FIXTURE WITH FLUSH LENS, WHITE FINISH, 0-10V DIMMING DRIVER, DIMMABLE TO 1%, ELECTRONIC DRIVER WITH <20% THD, UL LISTED, CONTROL WIRING REQUIRED FOR OPERATION OF 0-10V DIMMING.			
PD3-16A	SAME AS PD3-16 EXCEPT WITH EMERGENCY BATTERY INVERTER									
PD3-24	LUMENWERX #VIAPO-HLO-FH-SW-80-1200-40-24FT LITECONTROL #4L-P-D-24-XX-SOF-C1-40K-D120-D01-1C-UNV-W1 MARK LIGHTING #S4PD LLP-24FT-MSL8-80CRI 40K 1200LMF SCT-MINI-FLL-MVOLT-WHITT-ZT	269	PENDANT	28,608	4000	80	120V - 277V, 4' x 24'-0", DIRECT LINEAR FIXTURE WITH FLUSH LENS, WHITE FINISH, 0-10V DIMMING DRIVER, DIMMABLE TO 1%, ELECTRONIC DRIVER WITH <20% THD, UL LISTED, CONTROL WIRING REQUIRED FOR OPERATION OF 0-10V DIMMING.			
PD3-24A	SAME AS PD3-24 EXCEPT WITH EMERGENCY BATTERY INVERTER									
HB1	METALUX #UHBS-1216-MV-L84050-U COLUMBIA # CRN2-1-LSCS-EDMV LITHONIA #CPRB ALO13 MVOLT SWW9 80CRI PM DW/H	106	SUSPENDED	15,000	4000	80	120-277V, SELECTABLE HIGH BAY FIXTURE			
HB2	METALUX #UHBS2-2436-W-L83065-MEDIUM-4000K-UHBS-WG13 COLUMBIA #CRN2-2-LSCS-EDMV	200	WALL	30,600	4000	80	120-277V, ROUND SELECTABLE WIDE DISTRIBUTION HIGH BAY FIXTURE WITH WIREGUARD, 0-10V DIMMING DRIVER, DIMMABLE TO 10%, ELECTRONIC DRIVER WITH <20% THD, UL LISTED, CONTROL WIRING REQUIRED FOR OPERATION OF 0-10V DIMMING.			
HB3	METALUX #UHBS2-2436-W-L83065-HIGH-4000K-UHBS-WG13 COLUMBIA #CRN2-2-LSCS-EDMV	240	WALL	35,040	4000	80	120-277V, ROUND SELECTABLE WIDE DISTRIBUTION HIGH BAY FIXTURE WITH WIREGUARD, 0-10V DIMMING DRIVER, DIMMABLE TO 10%, ELECTRONIC DRIVER WITH <20% THD, UL LISTED, CONTROL WIRING REQUIRED FOR OPERATION OF 0-10V DIMMING.			
RD1	HALO #HICBP-25-D016-HMB-2655-840-81-MD-H GREEN CREATIVE #LEM-90-40-DUALDIM1-MD-ADRB-CC	26	RECESSED	2,500	4000	80	120-277V, 8" ROUND RETRO-FIT DOWNLIGHT, ELECTRONIC 0-10V DIMMING DRIVER WITH RANGE FROM 100% TO 1% UL LISTED			
GENERAL COMMENTS: 1. CONTRACTOR SHALL REFER TO DRAWINGS FOR LOCATION THAT REQUIRE DRYWALL FRAMES.										

LIGHT FIXTURE SCHEDULE										
TAG	MANUFACTURER'S CATALOG NUMBER	MAX. WATTS	MOUNT	MIN. LUMEN OUTPUT *(*D)	CCT	CRI	DESCRIPTION	REMARKS		
DL1	HALO #HCA-20-D010-HM4025-840-41MD-H PRESCOLITE #LFR-4RD-M-20L40K-MD-MD1 LFR-4RD-T-SS LFR-4RD-H LITHONIA #LDN4 4030 L04AR LSS MVOLT G210	23	RECESSED	1,933	4000	80	120-277V, 4" DIAMETER DOWNLIGHT WITH MEDIUM DISTRIBUTION AND SELF-FLANGED SEMI-SPECULAR CLEAR REFLECTOR. ELECTRONIC 0-10V DIMMING DRIVER WITH RANGE FROM 100% TO 1% UL LISTED			
DL1A	SAME AS DL1 EXCEPT WITH EMERGENCY BATTERY INVERTER									
DL2	HALO #HCA-20-D010-HM4025-840-41MD-H PRESCOLITE #LFR-4RD-M-30L40K-MD-MD1 LFR-4RD-T-SS LFR-4RD-H LITHONIA #LDN4 4030 L04AR LSS MVOLT G210	32	RECESSED	3,000	4000	80	120-277V, 4" DIAMETER DOWNLIGHT WITH MEDIUM DISTRIBUTION AND SELF-FLANGED SEMI-SPECULAR CLEAR REFLECTOR. ELECTRONIC 0-10V DIMMING DRIVER WITH RANGE FROM 100% TO 1% UL LISTED			
DL2A	SAME AS DL2 EXCEPT WITH EMERGENCY BATTERY INVERTER									
DL3	HALO #HCA-20-D010-HM4025-840-41PS-M-W PRESCOLITE #LFR-4RD-M-30L40K-WD-MD1 LFR-4RD-T-SH-WT-ACL LFR-4RD-H	26	RECESSED	2,000	4000	80	120V-277V, 4" DOWN LIGHT WITH NON CONDUCTIVE POLYMER "DEAD FRONT" REFLECTOR AND MEDIUM DISTRIBUTION WITH WHITE FLANGE. UL WET LOCATION LISTED.			
DL3A	SAME AS DL3 EXCEPT WITH EMERGENCY BATTERY INVERTER									
L1	ALS #LPTW-4-WH-UD NEW STAR #AGG-G-24-OP-UN-TWO-CW56WATTS LITHONIA #CPXTW 2X4 TUWH RHYR 6000LM 80CRI SWL MVOLT NLT	56	RECESSED	4750-5250	2700K-6000K	80	120-277V, 2'x4' COLOR TUNNING FLAT PANEL. ELECTRONIC 0-10V DIMMING DRIVER WITH RANGE FROM 100% TO 10% UL LISTED			
L1A	SAME AS L1 EXCEPT WITH EMERGENCY BATTERY INVERTER									
L2	METALUX #24FPLS2SCT3-LOW COLUMBIA #CFP24-LSCS LITHONIA #CPX 2X4-AL08-80CRI-SWW7-SWL-MVOLT	27	RECESSED	3,150	4000	80	120-277V, 2'x4' LED FLAT PANEL WITH SELECTABLE LUMENS AND COLOR TEMPERATURE. 0-10V ELECTRONIC DIMMING TO 10% UL LISTED. COLOR TEMPERATURE AND LUMEN OUTPUT TO BE SET AT FACTORY AS INDICATED.			
L2A	SAME AS L2 EXCEPT WITH EMERGENCY BATTERY INVERTER									
L3	METALUX #24FPLS2SCT3-MED COLUMBIA #CFP24-LSCS LITHONIA #CPX 2X4-AL08-80CRI-SWW7-SWL-MVOLT	40	RECESSED	4,291	4000	80	120-277V, 2'x4' LED FLAT PANEL WITH SELECTABLE LUMENS AND COLOR TEMPERATURE. 0-10V ELECTRONIC DIMMING TO 10% UL LISTED. COLOR TEMPERATURE AND LUMEN OUTPUT TO BE SET AT FACTORY AS INDICATED.			
L3A	SAME AS L3 EXCEPT WITH EMERGENCY BATTERY INVERTER									
L4	METALUX #24FPLS2SCT3-HIGH COLUMBIA #CFP22-LSCS LITHONIA #CPX 2X2-AL07-80CRI-SWW7-SWL	56	RECESSED	6,011	4000	80	120-277V, 2'x4' LED FLAT PANEL WITH SELECTABLE LUMENS AND COLOR TEMPERATURE. 0-10V ELECTRONIC DIMMING TO 10% UL LISTED. COLOR TEMPERATURE AND LUMEN OUTPUT TO BE SET AT FACTORY AS INDICATED.			
L4A	SAME AS L4 EXCEPT WITH EMERGENCY BATTERY INVERTER									
L5-4	LUMENWERX #VIA4R-HLO-FH-SW-80-1000-40-4FT LITECONTROL #4L-LG-D-4-SOF-C1-40K-D100-D01-1C-UNV-W1 MARK LIGHTING #S4L-LOP-4FT-FLP-XX-80CRI-40K-1000LMF-277	41	RECESSED	4,000	4000	80	120V - 277V, 4" x 4'-0", RECESSED LINEAR FIXTURE WITH FLUSH LENS, WHITE FINISH, 0-10V DIMMING DRIVER, DIMMABLE TO 1%, ELECTRONIC DRIVER WITH <20% THD, UL LISTED. CONTROL WIRING REQUIRED FOR OPERATION OF 0-10V DIMMING.			
L5-4A	SAME AS L5-4 EXCEPT WITH EMERGENCY BATTERY INVERTER									
L5-8	LUMENWERX #VIA4R-HLO-FH-SW-80-1000-40-8FT LITECONTROL #4L-LG-D-8-SOF-C1-40K-D100-D01-1C-UNV-W1 MARK LIGHTING #S4L-LOP-8FT-FLP-XX-80CRI-40K-1000LMF-277	82	RECESSED	8,000	4000	80	120V - 277V, 4" x 8'-0", RECESSED LINEAR FIXTURE WITH FLUSH LENS, WHITE FINISH, 0-10V DIMMING DRIVER, DIMMABLE TO 1%, ELECTRONIC DRIVER WITH <20% THD, UL LISTED. CONTROL WIRING REQUIRED FOR OPERATION OF 0-10V DIMMING.			
L5-8A	SAME AS L5-8 EXCEPT WITH EMERGENCY BATTERY INVERTER									
L5-10	LUMENWERX #VIA4R-HLO-FH-SW-80-1000-40-10FT LITECONTROL #4L-LG-D-10-SOF-C1-40K-D100-D01-1C-UNV-W1 MARK LIGHTING #S4L-LOP-10FT-FLP-XX-80CRI-40K-1000LMF-277	102	RECESSED	10,000	4000	80	120V - 277V, 4" x 10'-0", RECESSED LINEAR FIXTURE WITH FLUSH LENS, WHITE FINISH, 0-10V DIMMING DRIVER, DIMMABLE TO 1%, ELECTRONIC DRIVER WITH <20% THD, UL LISTED. CONTROL WIRING REQUIRED FOR OPERATION OF 0-10V DIMMING.			
L5-10A	SAME AS L5-10 EXCEPT WITH EMERGENCY BATTERY INVERTER									
L5-12	LUMENWERX #VIA4R-HLO-FH-SW-80-1000-40-12FT LITECONTROL #4L-LG-D-12-SOF-C1-40K-D100-D01-1C-UNV-W1 MARK LIGHTING #S4L-LOP-12FT-FLP-XX-80CRI-40K-1000LMF-277	122	RECESSED	12,000	4000	80	120V - 277V, 4" x 12'-0", RECESSED LINEAR FIXTURE WITH FLUSH LENS, WHITE FINISH, 0-10V DIMMING DRIVER, DIMMABLE TO 1%, ELECTRONIC DRIVER WITH <20% THD, UL LISTED. CONTROL WIRING REQUIRED FOR OPERATION OF 0-10V DIMMING.			
L5-12A	SAME AS L5-12 EXCEPT WITH EMERGENCY BATTERY INVERTER									
L5-20	LUMENWERX #VIA4R-HLO-FH-SW-80-1000-4022FT LITECONTROL #4L-LG-D-20-SOF-C1-40K-D100-D01-1C-UNV-W1 MARK LIGHTING #S4L-LOP-20FT-FLP-XX-80CRI-40K-1000LMF-277	204	RECESSED	12,000	4000	80	120V - 277V, 4" x 12'-0", RECESSED LINEAR FIXTURE WITH FLUSH LENS, WHITE FINISH, 0-10V DIMMING DRIVER, DIMMABLE TO 1%, ELECTRONIC DRIVER WITH <20% THD, UL LISTED. CONTROL WIRING REQUIRED FOR OPERATION OF 0-10V DIMMING.			
L5-20A	SAME AS L5-20 EXCEPT WITH EMERGENCY BATTERY INVERTER									
L6-4	LUMENWERX #VIA4R-HLO-FH-SW-80-1500-40-4FT LITECONTROL #4L-LG-D-6-SOF-C1-40K-D100-D01-1C-UNV-W1 MARK LIGHTING #S4L-LOP-4FT FLP XX 80CRI 40K 1200LMF MINI 120 2T	44	RECESSED	4,800	4000	80	120V - 277V, 4" x 4'-0", RECESSED LINEAR FIXTURE WITH FLUSH LENS, WHITE FINISH, 0-10V DIMMING DRIVER, DIMMABLE TO 1%, ELECTRONIC DRIVER WITH <20% THD, UL LISTED. CONTROL WIRING REQUIRED FOR OPERATION OF 0-10V DIMMING.			
L6-4A	SAME AS L6-4 EXCEPT WITH EMERGENCY BATTERY INVERTER									
L7-4	LUMENWERX #VIA4R-HLO-FH-SW-80-1500-40-4FT LITECONTROL #4L-LG-D-4-4-SOF-C1-40K-D150-D01-1C-UNV-W1 MARK LIGHTING #S4L-LOP-4FT FLP XX 80CRI 40K 1500LMF MINI 120 2T	60	RECESSED	6,000	4000	80	120V - 277V, 4" x 4'-0", RECESSED LINEAR FIXTURE WITH FLUSH LENS, WHITE FINISH, 0-10V DIMMING DRIVER, DIMMABLE TO 1%, ELECTRONIC DRIVER WITH <20% THD, UL LISTED. CONTROL WIRING REQUIRED FOR OPERATION OF 0-10V DIMMING.			
L7-4A	SAME AS L7-4 EXCEPT WITH EMERGENCY BATTERY INVERTER									
L7-20	LUMENWERX #VIA4R-HLO-FH-SW-80-1500-40-20FT LITECONTROL #4L-LG-D-20-SOF-C1-40K-D150-D01-1C-UNV-W1 MARK LIGHTING #S4L LOP 20FT FLP XX 80CRI 40K 1500LMF MINI 120 2T	300	RECESSED	30,000	4000	80	120V - 277V, 4" x 20'-0", RECESSED LINEAR FIXTURE WITH FLUSH LENS, WHITE FINISH, 0-10V DIMMING DRIVER, DIMMABLE TO 1%, ELECTRONIC DRIVER WITH <20% THD, UL LISTED. CONTROL WIRING REQUIRED FOR OPERATION OF 0-10V DIMMING.			
L7-22	LUMENWERX #VIA4R-HLO-FH-SW-80-1500-40-22FT LITECONTROL #4L-LG-D-22-SOF-C1-40K-D150-D01-1C-UNV-W1 MARK LIGHTING #S4L LOP 20FT FLP XX 80CRI 40K 1500LMF MINI 120 2T	330	RECESSED	33,000	4000	80	120V - 277V, 4" x 22'-0", RECESSED LINEAR FIXTURE WITH FLUSH LENS, WHITE FINISH, 0-10V DIMMING DRIVER, DIMMABLE TO 1%, ELECTRONIC DRIVER WITH <20% THD, UL LISTED. CONTROL WIRING REQUIRED FOR OPERATION OF 0-10V DIMMING.			
L7-24	LUMENWERX #VIA4R-HLO-FH-SW-80-1500-40-24FT LITECONTROL #4L-LG-D-24-SOF-C1-40K-D150-D01-1C-UNV-W1 MARK LIGHTING #S4L LOP 24FT FLP XX 80CRI 40K 1500LMF MINI 120 2T	360	RECESSED	36,000	4000	80	120V - 277V, 4" x 24'-0", RECESSED LINEAR FIXTURE WITH FLUSH LENS, WHITE FINISH, 0-10V DIMMING DRIVER, DIMMABLE TO 1%, ELECTRONIC DRIVER WITH <20% THD, UL LISTED. CONTROL WIRING REQUIRED FOR OPERATION OF 0-10V DIMMING.			
L7-36	LUMENWERX #VIA4R-HLO-FH-SW-80-1500-40-28FT LITECONTROL #4L-LG-D-28-SOF-C1-40K-D150-D01-1C-UNV-W1 MARK LIGHTING #S4L LOP 26FT FLP XX 80CRI 40K 1500LMF MINI 120 2T	390	RECESSED	39,000	4000	80	120V - 277V, 4" x 28'-0", RECESSED LINEAR FIXTURE WITH FLUSH LENS, WHITE FINISH, 0-10V DIMMING DRIVER, DIMMABLE TO 1%, ELECTRONIC DRIVER WITH <20% THD, UL LISTED. CONTROL WIRING REQUIRED FOR OPERATION OF 0-10V DIMMING.			
L7-38	LUMENWERX #VIA4R-HLO-FH-SW-80-1500-40-28FT LITECONTROL #4L-LG-D-28-SOF-C1-40K-D150-D01-1C-UNV-W1 MARK LIGHTING #S4L LOP 28FT FLP XX 80CRI 40K 1500LMF MINI 120 2T	420	RECESSED	42,000	4000	80	120V - 277V, 4" x 28'-0", RECESSED LINEAR FIXTURE WITH FLUSH LENS, WHITE FINISH, 0-10V DIMMING DRIVER, DIMMABLE TO 1%, ELECTRONIC DRIVER WITH <20% THD, UL LISTED. CONTROL WIRING REQUIRED FOR OPERATION OF 0-10V DIMMING.			
L7-32	LUMENWERX #VIA4R-HLO-FH-SW-80-1500-40-32FT LITECONTROL #4L-LG-D-32-SOF-C1-40K-D150-D01-1C-UNV-W1 MARK LIGHTING #S4L LOP 32FT FLP XX 80CRI 40K 1500LMF MINI 120 2T	480	RECESSED	48,000	4000	80	120V - 277V, 4" x 32'-0", RECESSED LINEAR FIXTURE WITH FLUSH LENS, WHITE FINISH, 0-10V DIMMING DRIVER, DIMMABLE TO 1%, ELECTRONIC DRIVER WITH <20% THD, UL LISTED. CONTROL WIRING REQUIRED FOR OPERATION OF 0-10V DIMMING.			
L7-34	LUMENWERX #VIA4R-HLO-FH-SW-80-1500-40-34FT LITECONTROL #4L-LG-D-34-SOF-C1-40K-D150-D01-1C-UNV-W1 MARK LIGHTING #S4L LOP 34FT FLP XX 80CRI 40K 1500LMF MINI 120 2T	510	RECESSED	51,000	4000	80	120V - 277V, 4" x 34'-0", RECESSED LINEAR FIXTURE WITH FLUSH LENS, WHITE FINISH, 0-10V DIMMING DRIVER, DIMMABLE TO 1%, ELECTRONIC DRIVER WITH <20% THD, UL LISTED. CONTROL WIRING REQUIRED FOR OPERATION OF 0-10V DIMMING.			
L7-36	LUMENWERX #VIA4R-HLO-FH-SW-80-1500-40-36FT LITECONTROL #4L-LG-D-36-SOF-C1-40K-D150-D01-1C-UNV-W1 MARK LIGHTING #S4L LOP 36FT FLP XX 80CRI 40K 1500LMF MINI 120 2T	540	RECESSED	54,000	4000	80	120V - 277V, 4" x 36'-0", RECESSED LINEAR FIXTURE WITH FLUSH LENS, WHITE FINISH, 0-10V DIMMING DRIVER, DIMMABLE TO 1%, ELECTRONIC DRIVER WITH <20% THD, UL LISTED. CONTROL WIRING REQUIRED FOR OPERATION OF 0-10V DIMMING.			
L8	METALUX #14FPLS-025C-HIGH COLUMBIA #CFP14-LSCS LITHONIA #CPX-1X4-AL07-80CRI-SWW7-SWL-MVOLT	36	RECESSED	4,100	3500	80	120-277V, 1'x4' RECESSED LED PANEL. ELECTRONIC 0-10V DIMMING DRIVER WITH RANGE FROM 100% TO 10% UL LISTED.			
L8A	SAME AS L8 EXCEPT WITH EMERGENCY BATTERY INVERTER									
L9	FAIL-SAFE #FSP14-42-40-CP125-DFCL-1248W-U COLUMBIA #NB714-40-L036-G-FP-EDI-UL-IP65-FK14 KENALL #CVS050-14-4SL-40K8-DIM-FV-SF-4H-SYM-FN	45	RECESSED	3,800	4000	80	120-277V, 1'x4' SEALED LED FLAT PANEL WITH 0.125 CLEAR POLYCARBONATE LENS AND DRYWALL MNT. 0-10V ELECTRONIC DIMMING TO 10% UL WET LOCATION LISTED.			
L9A	SAME AS L9 EXCEPT WITH EMERGENCY BATTERY INVERTER									
L10	METALUX #3SNLED-LD5-41SL-UN-UNV-LH40-CD1 LITHONIA #Z1LD-L48-SMR-3000LM-FP-MVOLT-40K-80CRI-WH COLUMBIA #CL54-LSCS-GLHS	40	SUSPENDED	3,968	4000	80	120-277V, 4' LINEAR STRIP FIXTURE WITH FROSTED LENS AND COLD ROLLED STEEL HOUSING. ELECTRONIC 0-10V DIMMING DRIVER WITH RANGE FROM 100% TO 10% UL LISTED			
L10A	SAME AS L10 EXCEPT WITH EMERGENCY BATTERY INVERTER									
L11	METALUX #4V1T3-D5-RW-UNV-EL10W-LH40-CD1 COLUMBIA #LXEM4-40VL-RFP-EDU LITHONIA #FEM-L48-8000LM-IMAFI-MD-MVOLT-G210-40K-80CRI	67	SUSPENDED	8,000	4000	80	120-277V, 4' LED VAPOR TIGHT STRIP LIGHT, FULLY GASKETED, FIBERGLASS HOUSING AND LENS, UL WET LOCATION LISTED.			
L11A	SAME AS L11 EXCEPT WITH EMERGENCY BATTERY INVERTER									
L12	LUMENWERX #VIA4W-D1-ARQ2-FH-ARO-SW-80-1200-750-40-8FT-UNV-D1-1C LITECONTROL #4L-M-AD-IPAD-8-SOF-C1-40K-075-D150-D01-1C-UNV-W1 MARK LIGHTING #S4WD LFP 8FT MSLB 80CRI 40K 1200LMF IBCORI HOK 8000LM SCT MINI FL MVOLT WHITT ZT	158	WALL	9,600/8,000 0	4000	80	120V-277V, 4" x 8'-0" DIRECT/INDIRECT WALL MOUNTED LINEAR FIXTURE WITH FLUSH LENS AND ASYMMETRIC OPTIC, WHITE FINISH, 0-10V DIMMING DRIVER, DIMMABLE TO 1%, ELECTRONIC DRIVER WITH <20% THD, UL LISTED. CONTROL WIRING REQUIRED FOR OPERATION OF 0-10V DIMMING.			
L12A	SAME AS L12 EXCEPT WITH EMERGENCY BATTERY INVERTER									
GENERAL COMMENTS: 1. CONTRACTOR SHALL REFER TO DRAWINGS FOR LOCATION THAT REQUIRE DRYWALL FRAMES.										

PLT DATE TIME: 7/10/2025 9:34:39 AM

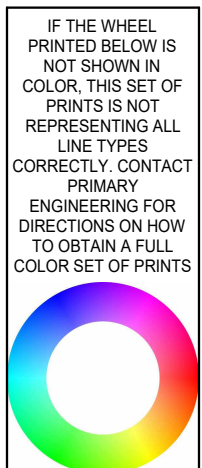

IF THE WHEN
PRINTED BELOW IS
NOT SHOWN IN
COLOR, THE SET OF
PRINTS IS NOT
REPRESENTING ALL
LINE TYPES
CORRECTLY. CONTACT
PRIMARY
ENGINEERING FOR
DIRECTION ON HOW
TO OBTAIN A FULL
COLOR SET OF PRINTS.

RELAY PANEL SCHEDULE																											
PANEL NAME: 2RPN1 LOCATION: RM. N201 MOUNTING: SURFACE PANEL REMARKS:										SUPPLY CIRCUIT: 2LN1-24 MANUFACTURER: GREENGATE MODEL: CK16-120/277-4-1-CKT-LB																	
RELAY NUMBER	DESCRIPTION	RELAY AMPACITY	DIMMING	POWER SOURCE				SCHOOL HOURS								AFTER HOURS								EXTERIOR CONTROLS		DIGITAL SWITCH CONTROL / PHOTOCELL	CONTROL SEQUENCE REMARKS
								OCCUPIED				UNOCCUPIED				OCCUPIED				UNOCCUPIED							
								CONTROL	LIGHT OUTPUT	CONTROL	LIGHT OUTPUT	CONTROL	LIGHT OUTPUT	CONTROL	LIGHT OUTPUT	CONTROL	LIGHT OUTPUT										
				NORMAL	EMERGENCY	VOLTAGE	BRANCH CIRCUIT DESIGNATION	ASTRONOMICAL TIMECLOCK	DIGITAL SWITCH	OCCUPANCY SENSOR	ON	OFF	ASTRONOMICAL TIMECLOCK	DIGITAL SWITCH	OCCUPANCY SENSOR	ON	OFF	ASTRONOMICAL TIMECLOCK	DIGITAL SWITCH	OCCUPANCY SENSOR	ON	OFF					
				1	LIGHTS - G119	20A	N	X		277V	2HN1-2	X		100%			X			0%		X		100%	X		
2	LIGHTS - G119	20A	N	X		277V	2HN1-4	X		100%			X			0%		X		100%	X		0%		DS3/DS4		
3	LIGHTS - G119	20A	N	X		277V	2HN1-6	X		100%			X			0%		X		100%	X		0%		DS3/DS4		
4	LIGHTS - G119	20A	N	X		277V	2HN4-8	X		100%			X			0%		X		100%	X		0%		DS3/DS4		
5	SPARE																										
6	SPARE																										
7	SPARE																										
8	SPARE																										
9	SPARE																										
10	SPARE																										
11	SPARE																										
12	SPARE																										
13	SPARE																										
14	SPARE																										
15	SPARE																										
16	SPARE																										
CONTROL SEQUENCE REMARKS: 1. RELAYS SHALL BE CONTROLLED 2. RELAY SHALL BE PROGRAMMED TO BE TURN OFF AFTER 10:00 PM DAILY. 3. RELAY SHALL BE TURNED ON FROM 7:00 AM TO 5:00 PM MONDAY THROUGH FRIDAY. AFTER HOURS CONVERT TO OCCUPANCY SENSING ON/OFF OPERATION.																											
GENERAL NOTES A. CONTRL SEQUENCE IS FOR BIDDING PURPOSES ONLY THE CONTRACTOR SHALL SCHEDULE TIME WITH OWNER TO VERIFY PROGRAMING REQUIREMENTS AND BUTTION NOMENCLATURE.																											

RELAY PANEL SCHEDULE																										
PANEL NAME: 2RPN2 LOCATION: RM. N201 MOUNTING: SURFACE PANEL REMARKS:										SUPPLY CIRCUIT: 2LN2-21 MANUFACTURER: GREENGATE MODEL: CK16-120/277-4-1-CKT-LB																
RELAY NUMBER	DESCRIPTION	RELAY AMPACITY	DIMMING	POWER SOURCE				SCHOOL HOURS								AFTER HOURS								EXTERIOR CONTROLS	DIGITAL SWITCH CONTROL LOGIC/SCREEN	CONTROL SEQUENCE REMARKS
								OCCUPIED				UNOCCUPIED				OCCUPIED				UNOCCUPIED						
								CONTROL		LIGHT OUTPUT		CONTROL		LIGHT OUTPUT		CONTROL		LIGHT OUTPUT		CONTROL		LIGHT OUTPUT				
				NORMAL	EMERGENCY	VOLTAGE	BRANCH CIRCUIT DESIGNATION	ASTRONOMICAL TIMECLOCK	DIGITAL SWITCH	OCCUPANCY SENSOR	ON	OFF	ASTRONOMICAL TIMECLOCK	DIGITAL SWITCH	OCCUPANCY SENSOR	ON	OFF	ASTRONOMICAL TIMECLOCK	DIGITAL SWITCH	OCCUPANCY SENSOR	ON	OFF	ASTRONOMICAL TIMECLOCK	DIGITAL SWITCH	PHOTOCELL	
				1	LIGHTS - TRACK N103	20A	N	X	277V	2HN4-1	X		100%			X			0%		X		100%	X		
2	LIGHTS - TRACK N103	20A	N	X	277V	2HN4-2	X		100%			X			0%		X		100%	X			0%		DS1/DS2	
3	LIGHTS - TRACK N103	20A	N	X	277V	2HN4-3	X		100%			X			0%		X		100%	X			0%		DS1/DS2	
4	LIGHTS - TRACK N103	20A	N	X	277V	2HN4-4	X		100%			X			0%		X		100%	X			0%		DS1/DS2	
5	LIGHTS - TRACK N103	20A	N	X	277V	2HN4-5	X		100%			X			0%		X		100%	X			0%		DS1/DS2	
6	LIGHTS - TRACK N103	20A	N	X	277V	2HN4-6	X		100%			X			0%		X		100%	X			0%		DS1/DS2	
7	LIGHTS - COURT 1 N103	20A	N	X	277V	2HN4-7	X		100%			X			0%		X		100%	X			0%		DS1/DS2	
8	LIGHTS - COURT 2 N103	20A	N	X	277V	2HN4-8	X		100%			X			0%		X		100%	X			0%		DS1/DS2	
9	LIGHTS - COURT 3 N103	20A	N	X	277V	2HN4-9	X		100%			X			0%		X		100%	X			0%		DS1/DS2	
10	LIGHTS - COURT 4 N103	20A	N	X	277V	2HN4-10	X		100%			X			0%		X		100%	X			0%		DS1/DS2	
11	LIGHTS - BETWEEN COURTS	20A	N	X	277V	2HN4-11	X		100%			X			0%		X		100%	X			0%		DS1/DS2	
12	SPARE																									
13	SPARE																									
14	SPARE																									
15	SPARE																									
16	SPARE																									
CONTROL SEQUENCE REMARKS: 1. RELAYS SHALL BE CONTROLLED 2. RELAY SHALL BE PROGRAMMED TO BE TURN OFF AFTER 10:00 PM DAILY. 3. RELAY SHALL BE TURNED ON FROM 7:00 AM TO 5:00 PM MONDAY THROUGH FRIDAY. AFTER HOURS CONVERT TO OCCUPANCY SENSING ON/OFF OPERATION.																										
GENERAL NOTES A. CONTRL SEQUENCE IS FOR BIDDING PURPOSES ONLY THE CONTRACTOR SHALL SCHEDULE TIME WITH OWNER TO VERIFY PROGRAMING REQUIREMENTS AND BUTTION NOMENCLATURE.																										

LIGHT FIXTURE SCHEDULE												
TAG	MANUFACTURER'S CATALOG NUMBER	MAX. WATTS	MOUNT	MIN. LUMEN OUTPUT *(D/I)	CCT	CRI	DESCRIPTION	REMARKS				
INV1	SURELITE #INV-220-PB-S DUAL LITE #LG250 ISOLITE #E3MMI-250-MB	220	SURFACE				120-277V, 220VA WALL MOUNTED BATTERY INVERTER UL LISTED					
INV2	SURELITE #INV-375-PB-S DUAL-LITE #LG375S ISOLITE #E3-375-LC-V2	375	SURFACE				120-277V, 375VA WALL MOUNTED BATTERY INVERTER UL LISTED					
EM1	EVENLITE #TCSWL-L47 DUAL LITE #EL-SE-205LED ISOLITE #H2N NC MBC L65 SD	5	WALL	600			120-277V 5.0W LED HIGH LUMEN LAMPS WITH INJECTION MOLDED HIGH-IMPACT THERMAL PLASTIC HOUSING WITH CLEAR COVER. UL LISTED FOR WET LOCATIONS.					
EM2	SURE LITE #SEL50 ABL #ELM4L-UVOLT-LTP-SDRT DUAL LITE #EVD2I	1	UNIVERSAL	438	-	-	120-277V, WHITE POLYCARBONATE HOUSING AND HEADS WITH SELF DIAGNOSTICS. MINIMUM OF 90 MINUTES OF RUN TIME. UL LISTED					
EM3	SURE LITE #SEL50-WG ABL #ELM4L-UVOLT-LTP-SDRT DUAL LITE #EVD2I	1	UNIVERSAL	438	-	-	120-277V, WHITE POLYCARBONATE HOUSING AND HEADS WITH SELF DIAGNOSTICS AND WIREGUARDS. MINIMUM OF 90 MINUTES OF RUN TIME. UL LISTED					
EX1	SURE LITE #LPX-7-SD LITHONIA #LOM-S-W-3-R-120/277-EL-N-SD DUAL LITE #EVE-U-R-W-E-I	2	UNIVERSAL	-	-	-	120-277V, WHITE POLYCARBONATE SELF POWERED EXIT SIGN WITH RED LETTERS AND NICKEL CADMIUM BATTERY. EXIT SIGN SHALL HAVE SELF DIAGNOSTIC. UL LISTED					
EX2	SURELITE #LPXW-7-1-R-SD BEGHELLI #PK-A-R-SA-AT LITHONIA #VLTE-GY-1-R-EL-SD	4	WALL	0	-	-	120-277V, POLYCARBONATE HOUSING WITH UV-STABILIZED POLYCARBONATE MOUNTING CANOPY WITH CLEAR LENSE. UL LISTED FOR WET LOCATIONS.					
EX3	SURE LITE #LPX-7-SD-WG10 LITHONIA #LOM-S-W-3-R-120/277-EL-N-SD-ELA-WG1 DUAL LITE #EVE-U-R-W-E-I-WGLX	1	UNIVERSAL	-	-	-	120-277V, WHITE POLYCARBONATE SELF POWERED EXIT SIGN WITH RED LETTERS WIRE GUARD, AND NICKEL CADMIUM BATTERY. EXIT SIGN SHALL HAVE SELF DIAGNOSTIC. UL LISTED					
EX4	SURE LITE #EU-S-7-D-R LITHONIA DUAL LITE	2	UNIVERSAL	0	-	-	120-277V,EDGE-LITE SELF POWERED EXIT SIGN WITH RED LETTERS AND NICKEL CADMIUM BATTERY. EXIT SIGN SHALL HAVE SELF DIAGNOSTIC. UL LISTED					
GENERAL COMMENTS: 1. CONTRACTOR SHALL REFER TO DRAWINGS FOR LOCATION THAT REQUIRE DRYWALL FRAMES.												

EXTERIOR LIGHT FIXTURE SCHEDULE - PHASE 3											
TAG	MANUFACTURER'S CATALOG NUMBER	MAX. WATTS	MOUNT	MIN. LUMEN OUTPUT (D/I)	CCT	CRI	DESCRIPTION	REMARKS			
SL1	STREETWORKS #VERD-M-CA3-160-740-HV-T4-A15-XX-MS/DIM-L40-SSA6X30WXM1GFV	163	POLE	24,394	4000	70	480V, DIE CAST ALUMINUM FIXTURE WITH TYPE IV, POLE MOUNT ARM. MOTION SENSOR WITH STAND-ALONE PASSIVE INFRARED MOTION SENSING. SENSOR SHALL HAVE CAPABILITIES TO BE PROGRAMMED THROUGH HAND HELD DEVICE USING INFRARED. POLE SHALL BE 30'-0" TALL. 4" SQUARE ALUMINUM POLE WITH SINGLE HEAD MOUNTING, VIBRATION PAD, GROUND LUG AND VIBRATION DAMPENER.	1.2			
SL1-HS	STREETWORKS #VERD-M-CA3-160-740-HV-T4-A15-XX-HSS-MS/DIM-L40-SSA6X30WXM1GFV	163	POLE	24,394	4000	70	480V, DIE CAST ALUMINUM FIXTURE WITH TYPE IV, POLE MOUNT ARM AND HOUSE SIDE SHIELD MOTION SENSOR WITH STAND-ALONE PASSIVE INFRARED MOTION SENSING. SENSOR SHALL HAVE CAPABILITIES TO BE PROGRAMMED THROUGH HAND HELD DEVICE USING INFRARED. POLE SHALL BE 30'-0" TALL. 4" SQUARE ALUMINUM POLE WITH SINGLE HEAD MOUNTING, VIBRATION PAD, GROUND LUG AND VIBRATION DAMPENER.	1.3			
SL2	STREETWORKS #VERD-M-CA3-160-740-HV-T5-A15-XX-MS/DIM-L40-SSA6X30WXM1GFV	163	POLE	24,011	4000	70	480V, SINGLE HEAD DIE CAST ALUMINUM FIXTURE WITH TYPE V, POLE MOUNT ARM. MOTION SENSOR WITH STAND-ALONE PASSIVE INFRARED MOTION SENSING. SENSOR SHALL HAVE CAPABILITIES TO BE PROGRAMMED THROUGH HAND HELD DEVICE USING INFRARED. POLE SHALL BE 30'-0" TALL. 4" SQUARE ALUMINUM POLE WITH SINGLE HEAD MOUNTING, VIBRATION PAD, GROUND LUG AND VIBRATION DAMPENER.	1.2			
SL2-2	STREETWORKS #VERD-M-CA3-160-740-HV-T5-A15-XX-MS/DIM-L40-SSA6X30WXM2GFV	326	POLE	48,022	4000	70	480V, DUAL HEAD DIE CAST ALUMINUM FIXTURE WITH TYPE V, POLE MOUNT ARM. MOTION SENSOR WITH STAND-ALONE PASSIVE INFRARED MOTION SENSING. SENSOR SHALL HAVE CAPABILITIES TO BE PROGRAMMED THROUGH HAND HELD DEVICE USING INFRARED. POLE SHALL BE 30'-0" TALL. 4" SQUARE ALUMINUM POLE WITH 2 AT 180 DEGREE HEAD MOUNTING, VIBRATION PAD, GROUND LUG AND VIBRATION DAMPENER. PROVIDE THREADED OPENING TO MOUNT FL2 FIXTURE.	1.4			
SL2-4	STREETWORKS #VERD-M-CA3-160-740-HV-T5-A15-XX-MS/DIM-L40-SSA6X30WXPBGV - S4A-6-X	652	POLE	96,044	4000	70	480V, DUAL HEAD DIE CAST ALUMINUM FIXTURE WITH TYPE V, POLE MOUNT ARM. MOTION SENSOR WITH STAND-ALONE PASSIVE INFRARED MOTION SENSING. SENSOR SHALL HAVE CAPABILITIES TO BE PROGRAMMED THROUGH HAND HELD DEVICE USING INFRARED. POLE SHALL BE 30'-0" TALL. 4" SQUARE ALUMINUM POLE WITH 2 AT 180 DEGREE HEAD MOUNTING, VIBRATION PAD, GROUND LUG AND VIBRATION DAMPENER. PROVIDE THREADED OPENING TO MOUNT FL2 FIXTURE.	1.5			
GENERAL REMARKS: 1. PROVIDE TWO (2) WIRELESS CONFIGURATIONS TOOLS TO OWNER AFTER COMPLETION OF PROJECT. 2. FIXTURE SHALL STOPPENER #FSP-211 UTILIZING FSR-100 CONFIGURATION TOOL.											
REMARKS: 1. MOTION SENSOR SHALL BE SET UP WITH HIGH SETTING TO BE 100% AND LOW SETTING TO BE 15%. 2. CONTRACTOR SHALL PROVIDE AN ALLOWANCE OF \$5,000.00 FOR FIXTURE AND POLE THIS INCLUDES FREIGHT AND SHIPPING COSTS. 3. CONTRACTOR SHALL PROVIDE AN ALLOWANCE OF \$5,000.00 FOR FIXTURE AND POLE THIS INCLUDES FREIGHT AND SHIPPING COSTS. 4. CONTRACTOR SHALL PROVIDE AN ALLOWANCE OF \$5,000.00 FOR FIXTURE AND POLE THIS INCLUDES FREIGHT AND SHIPPING COSTS. 5. CONTRACTOR SHALL PROVIDE AN ALLOWANCE OF \$8,000.00 FOR FIXTURE AND POLE THIS INCLUDES FREIGHT AND SHIPPING COSTS.											