### ADDENDUM NO. 3

October 17, 2025

BOONE GROVE HIGH SCHOOL RENOVATION AND RELATED WORK Valparaiso, IN 46341

#### TO: ALL BIDDERS OF RECORD

This Addendum forms a part of and modifies the Bidding Requirements, Contract Forms, Contract Conditions, the Specifications, and the Drawings dated September 15, 2025 by Gibraltar Design, Inc. Acknowledge receipt of the Addendum in the space provided on the Bid Form. Failure to do so may subject the Bidder to disqualification.

This Addendum consists of Pages ADD 3-1 and attached Addendum No. 3 from Gibraltar Design, Inc. dated October 16, 2025 and consisting of 4 pages and 23 drawings.



#### ADDENDUM THREE

**Addendum Three (AD.03)** to the drawings and specifications prepared by Gibraltar Design for **Boone Grove HS Renovation and Related Work** for Porter Township School Corporation, Valparaiso, Indiana.

All Contractors bidding on this project shall read all of the items covered below and shall comply with all of the requirements as set forth, including any necessary refinements or additions generated by this Addendum and required by the intent of the original contract documents. All Contractors shall acknowledge on their bid form that they have received this Addendum and include the appropriate content of same within their bid proposal.

#### **SPECIFICATIONS**

#### 1. Specification Section 09 84 00 Acoustical Wall and Ceiling Panels

- A. Add new Sub-Paragraph 2.1.B. as follows: "B. Additional acceptable manufacturer, G & S Acoustics, product AP1 Acoustical Wall Panels."
- B. Add new Sub-Paragraph 2.1.C. as follows: "C. Additional acceptable manufacturer, Specialty Products & Insulation, product Absorption Plus Wall Panels."

#### 2. Specification Section 21 05 00 Fire Protection Sprinkler System

- A. Modify the following paragraph: 2.04 SPRINKLER HEADS:
  - "Sprinkler heads in finished ceiling areas shall be of approved quick response extended coverage design with nominal 1/2" discharge orifice, semi-recessed type with white polyester finish. New sprinkler heads located in suspended lay-in ceiling: Systems shall be centered in each respective tile."

#### 3. Specification Section 23 88 00 Ductwork and Accessories

- A. Add new paragraph as follows: "A. Round, square, and/or rectangular supply air diffusers and return air registers with neck dimensions, capacity, and style to match existing. Registers and diffusers shall be constructed of the same materials as existing with baked off white enamel finish (unless otherwise noted), equipped with necessary baffles to eliminate drafts and provide proper air distribution. Each register and diffuser shall be equipped with approved style opposed blade volume damper as noted on the drawings.
  - 1. Coordinate type of each ceiling diffuser, grille and register with the ceiling system into which it is to be installed.
  - 2. Approved manufacturers of air diffusers and return air grilles include the following: Nailor, Titus, MetalAire, Krueger or Price.
  - 3. Supply diffusers shall have a minimum of four louvered vane assemblies. The inner vane assembly shall be removable without the use of tools for access to accessories. The inner vane assembly shall be fixed to provide the proper air distribution characteristics required. No deflecting blades are to be used. Coordinate diffuser frame style with the ceiling system into which it is to be installed.
  - 4. Supply register shall be double deflection type. Each bar shall be adjustable for the



- desired air flow deflection without affecting the setting of other bars. Damper shall be of the opposed blade type and interlock to ensure the minimum of air leakage when closed.
- 5. Linear supply air diffusers shall be adjustable slot type constructed of extruded aluminum with one or more parallel slots. Each slot shall contain pattern controls, adjustable from the face of the diffuser to deflect the discharge air along a selected axis within a semi-circle of 180 degrees. The same pattern controllers shall function as a volume damper without affecting the air discharge pattern. Coordinate diffuser frame style with the ceiling system into which it is to be installed. For continuous installations, butted units shall be provided with alignment spines. Screws or other fasteners shall not be visible. Finish shall consist of white anodized finish exterior and flat black interior components. Provide matching air supply plenums with extensions necessary for proper duct connections.
- 6. Return air and exhaust air registers shall combine a curved hemmed edge blade with an opposed blade damper. Damper blades shall be the same as that of the supply register."
- B. Provide alternate pricing for the following: "In-lieu-of cleaning and reinstalling the registers, diffusers and grilles, provide an alternate price to replace the existing registers, diffusers, and grilles with units that are equivalent to the existing. Registers, diffusers and grilles shall be manufactured by Nailor, Titus, MetalAire, Krueger or Price."

#### **DRAWINGS**

#### 4. Sheet S-201

A. Refer to revised, full-size drawing, included in this Addendum, for revisions.

#### 5. Sheet AD-101 through AD-106

A. Keynotes D27 and D28 added to sheet.

#### 6. Sheet AD-103

- A. Refer to revised, full-size drawing, included in this Addendum, for revisions.
  - 1. Keynotes D27 and D28 added to sheet.
  - 2. Keynotes D27 added to room C124.

#### 7. Sheet AD-106

- A. Refer to revised, full-size drawing, included in this Addendum, for revisions.
  - 1. Keynotes D27 and D28 added to sheet.
  - 2. Keynote D28 added to room F109.

#### 8. Sheets A-101 through A-106

A. Keynotes A11 and A12 added to sheet.

#### 9. Sheet A-102

- A. Refer to revised, full-size drawing, included in this Addendum, for revisions.
  - 1. Keynotes A11 and A12 added to sheet.
  - 2. Remove blank wall section indication at the plan south of Receiving B112.



#### 10. Sheet A-103

- A. Refer to revised, full-size drawing, included in this Addendum, for revisions.
  - 1. Keynotes A11 and A12 added to sheet.
  - 2. Keynote A11 added to room C124.

#### 11. Sheet A-106

- A. Refer to revised, full-size drawing, included in this Addendum, for revisions.
  - 1. Keynotes A11 and A12 added to sheet.
  - 2. Keynote A12 added to room F109.

#### 12. Sheet A-820

- A. Refer to revised, full-size drawing, included in this Addendum, for revisions.
  - 1. Revisions to finish schedule.

#### 13. Sheets A-901 through A-906

- A. Revision to REFLECTED CEILING PLAN KEYNOTES number C04 to read 'NOT USED'.
- B. Removed references of note C04 from the ceiling plans.
- C. Added note "K" to GENERAL NOTES that reads "REFER TO SPRINKLER SHEETS FOR EXTENT OF SPRINKLER WORK, INCLUDING SELECTED AREAS OF BRANCHLINE RELOCATION."

#### 14. Sheet A-902

- A. Refer to revised, full-size drawing, included in this Addendum, for revisions.
  - 1. Revised the Cafeteria B-105 ceiling type to ACT-5.
  - 2. Revision to REFLECTED CEILING PLAN KEYNOTES number C04 to read 'NOT USED'.
  - 3. Removed references of note C04 from the ceiling plans.
  - 4. Added note "K" to GENERAL NOTES that reads "REFER TO SPRINKLER SHEETS FOR EXTENT OF SPRINKLER WORK, INCLUDING SELECTED AREAS OF BRANCHLINE RELOCATION."

#### 15. Sheet A-905

- A. Refer to revised, full-size drawing, included in this Addendum, for revisions.
  - 1. Above the indication CORRIDOR E102, added the indication for existing gypsum board and Keynote C02 at the intersection of corridors E102 and E128.
  - 2. Revision to REFLECTED CEILING PLAN KEYNOTES number C04 to read 'NOT USED'.
  - 3. Removed references of note C04 from the ceiling plans.
  - 4. Added note "K" to GENERAL NOTES that reads "REFER TO SPRINKLER SHEETS FOR EXTENT OF SPRINKLER WORK, INCLUDING SELECTED AREAS OF BRANCHLINE RELOCATION."

#### 16. Sheet M-201

- A. Refer to revised, full-size drawing, included in this Addendum, for revisions.
  - 1. Added roof plan with make-up air unit and exhaust fan.

#### 17. Sheet M-204

A. Refer to revised, full-size drawing, included in this Addendum, for revisions.



- 1. Revised ductwork.
- 2. Added floor plan for Unit F Mezzanine.

#### 18. Sheet M-501

- A. Refer to revised, full-size drawing, included in this Addendum, for revisions.
  - 1. Added notes.

#### 19. Sheet M-602

- A. Refer to revised, full-size drawing, included in this Addendum, for revisions.
  - 1. Revised AHU-9 section.

#### 20. Sheet ED-101, ED-102, ED-104, ED-106

- A. Refer to revised, full-size drawing, included in this Addendum, for revisions.
  - 1. Added light fixtures to be removed and relocated.

#### 21. Sheet E-101, E-102, E-104, E-106

- A. Refer to revised, full-size drawing, included in this Addendum, for revisions.
  - 1. Added new locations for relocated light fixtures.

#### 22. Sheet E-204


- A. Refer to revised, full-size drawing, included in this Addendum, for revisions.
  - 1. Added demolition and new construction views for Unit F Mezzanine.
  - 2. Added light fixtures to be removed and relocated in Unit F Demolition Mezzanine Plan.
  - 3. Added new locations for relocated light fixtures in Unit F Mezzanine Floor Plan.


#### 23. Sheet FP-001


- A. Refer to revised, full-size drawing, included in this Addendum, for revisions.
  - 1. Added Unit F Mezzanine Scope.
  - 2. Removed office area from scope.


Pages 1 through 4, inclusive, and Twenty-Three (23) Full-Size Drawings, constitute the total makeup of **Addendum Three**.



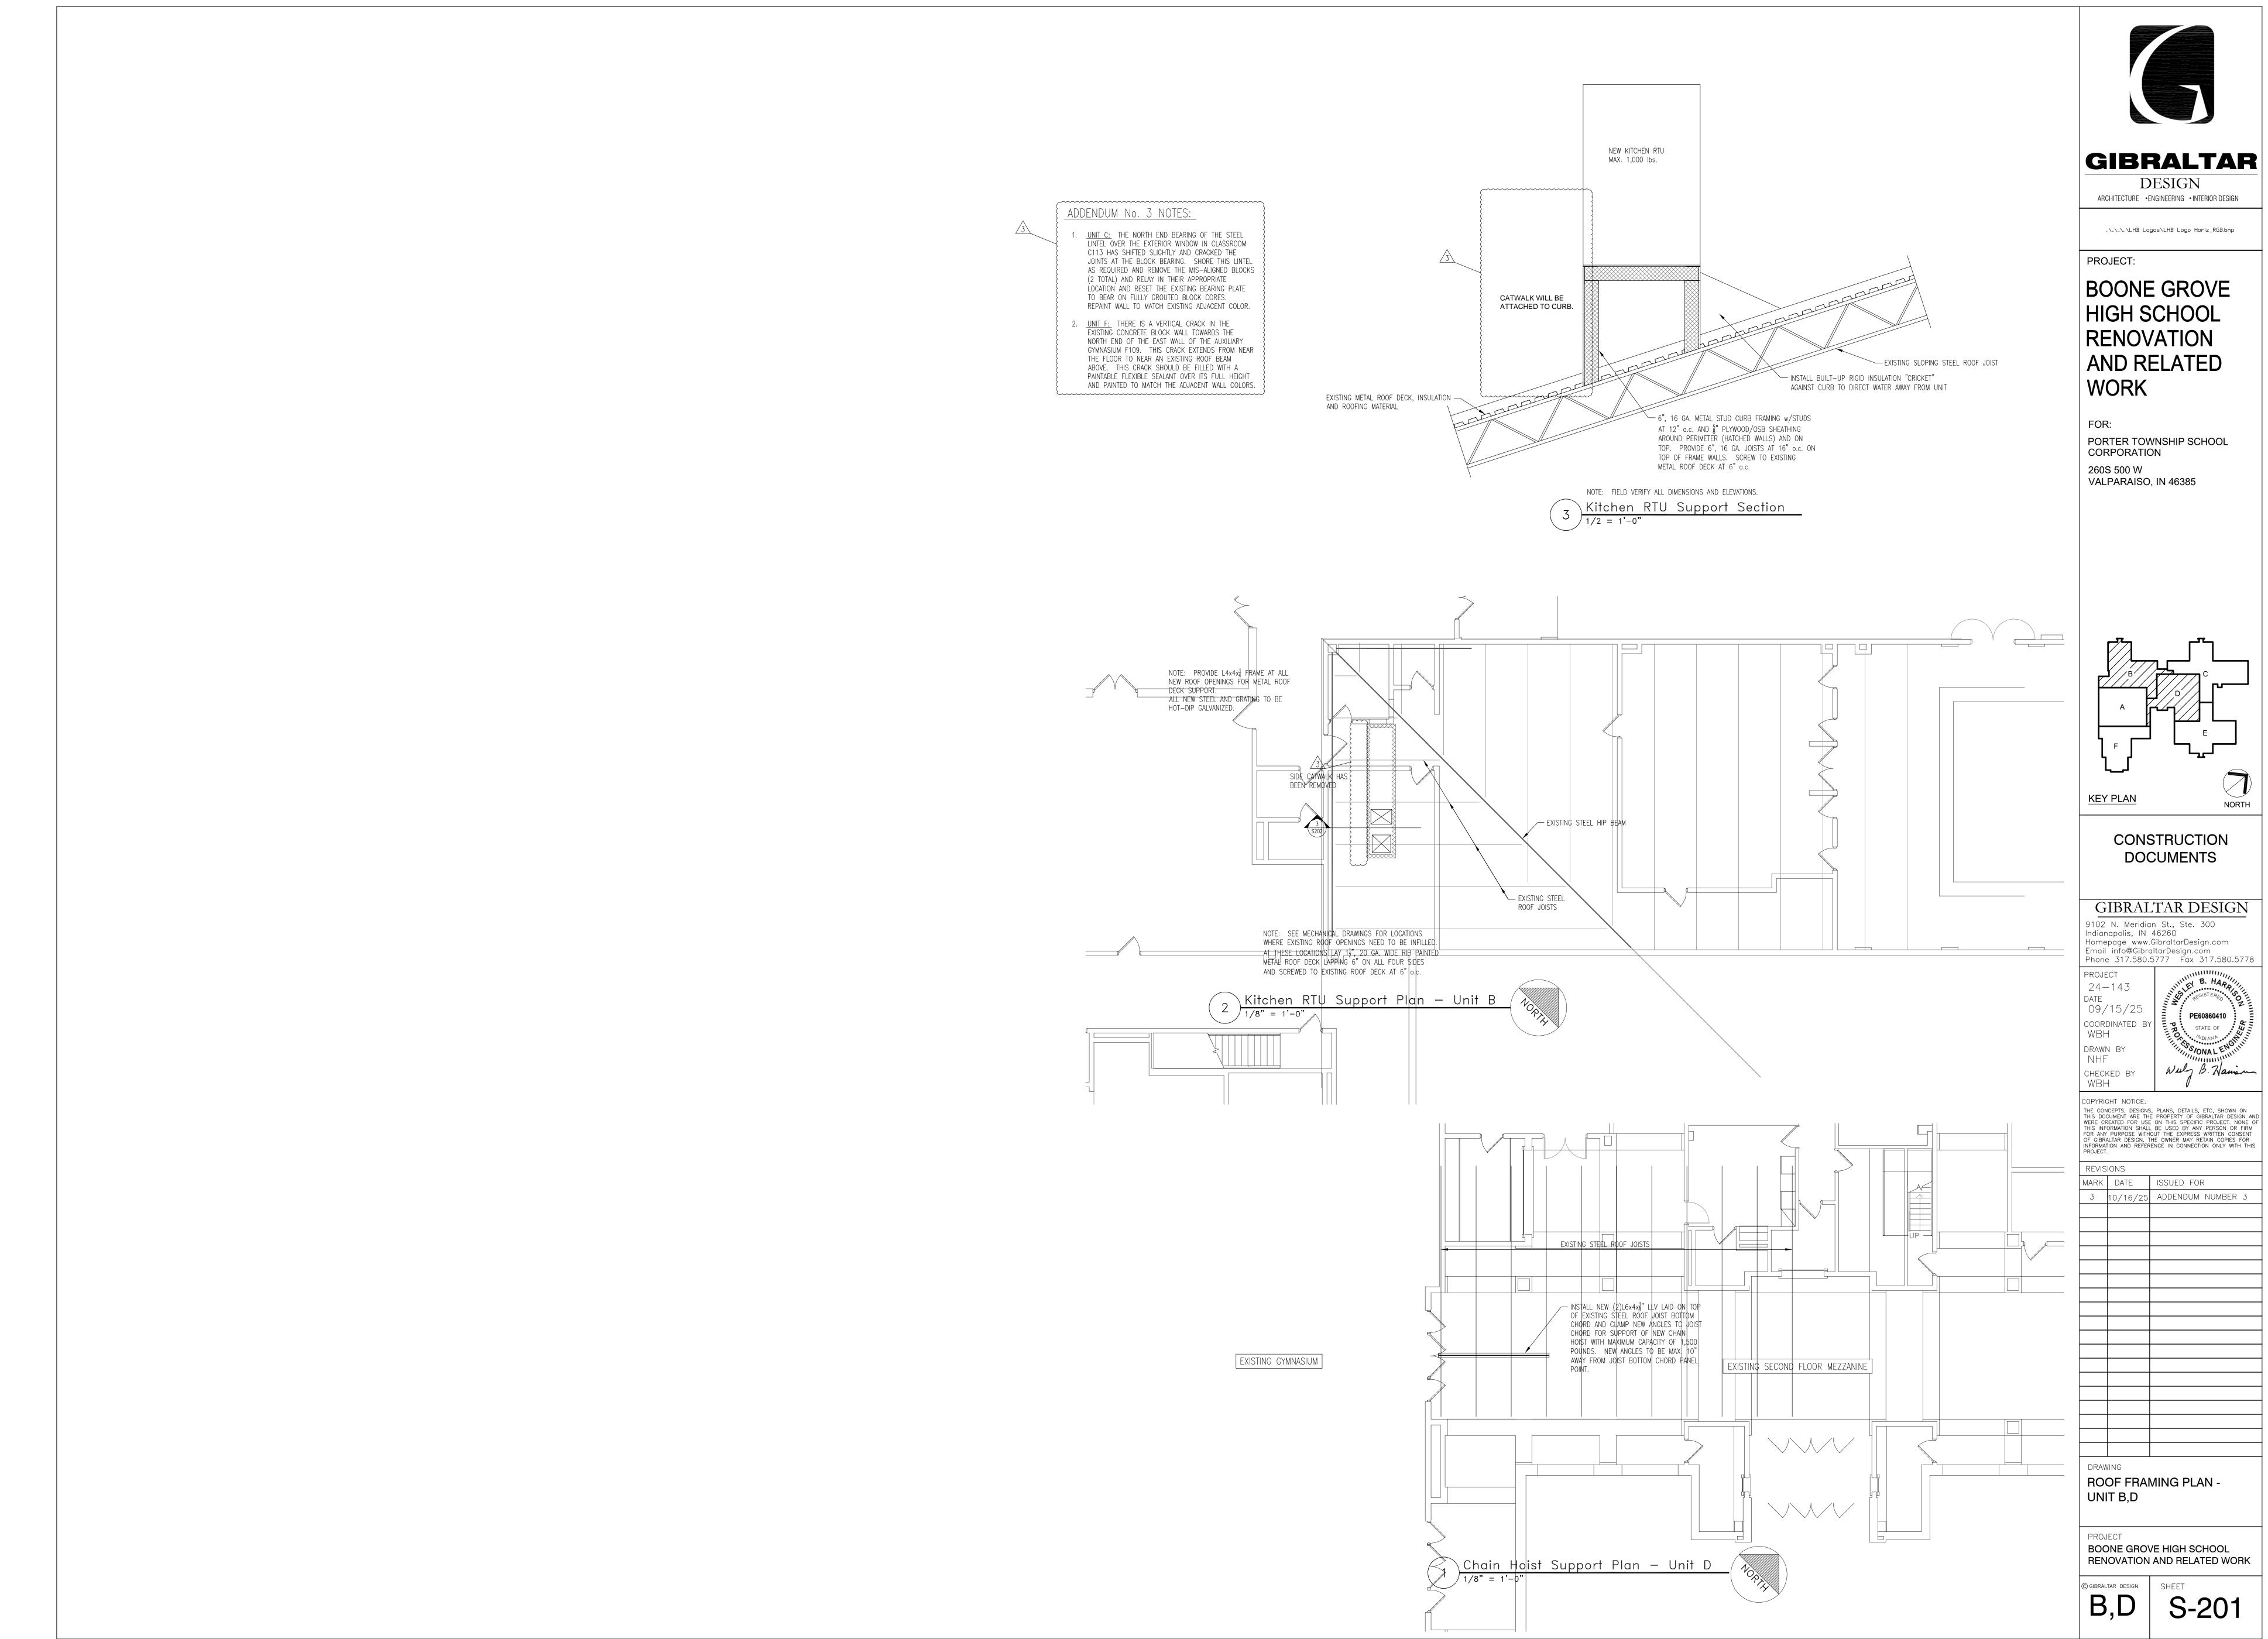

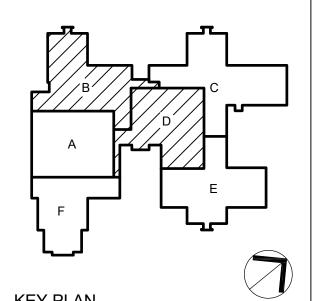

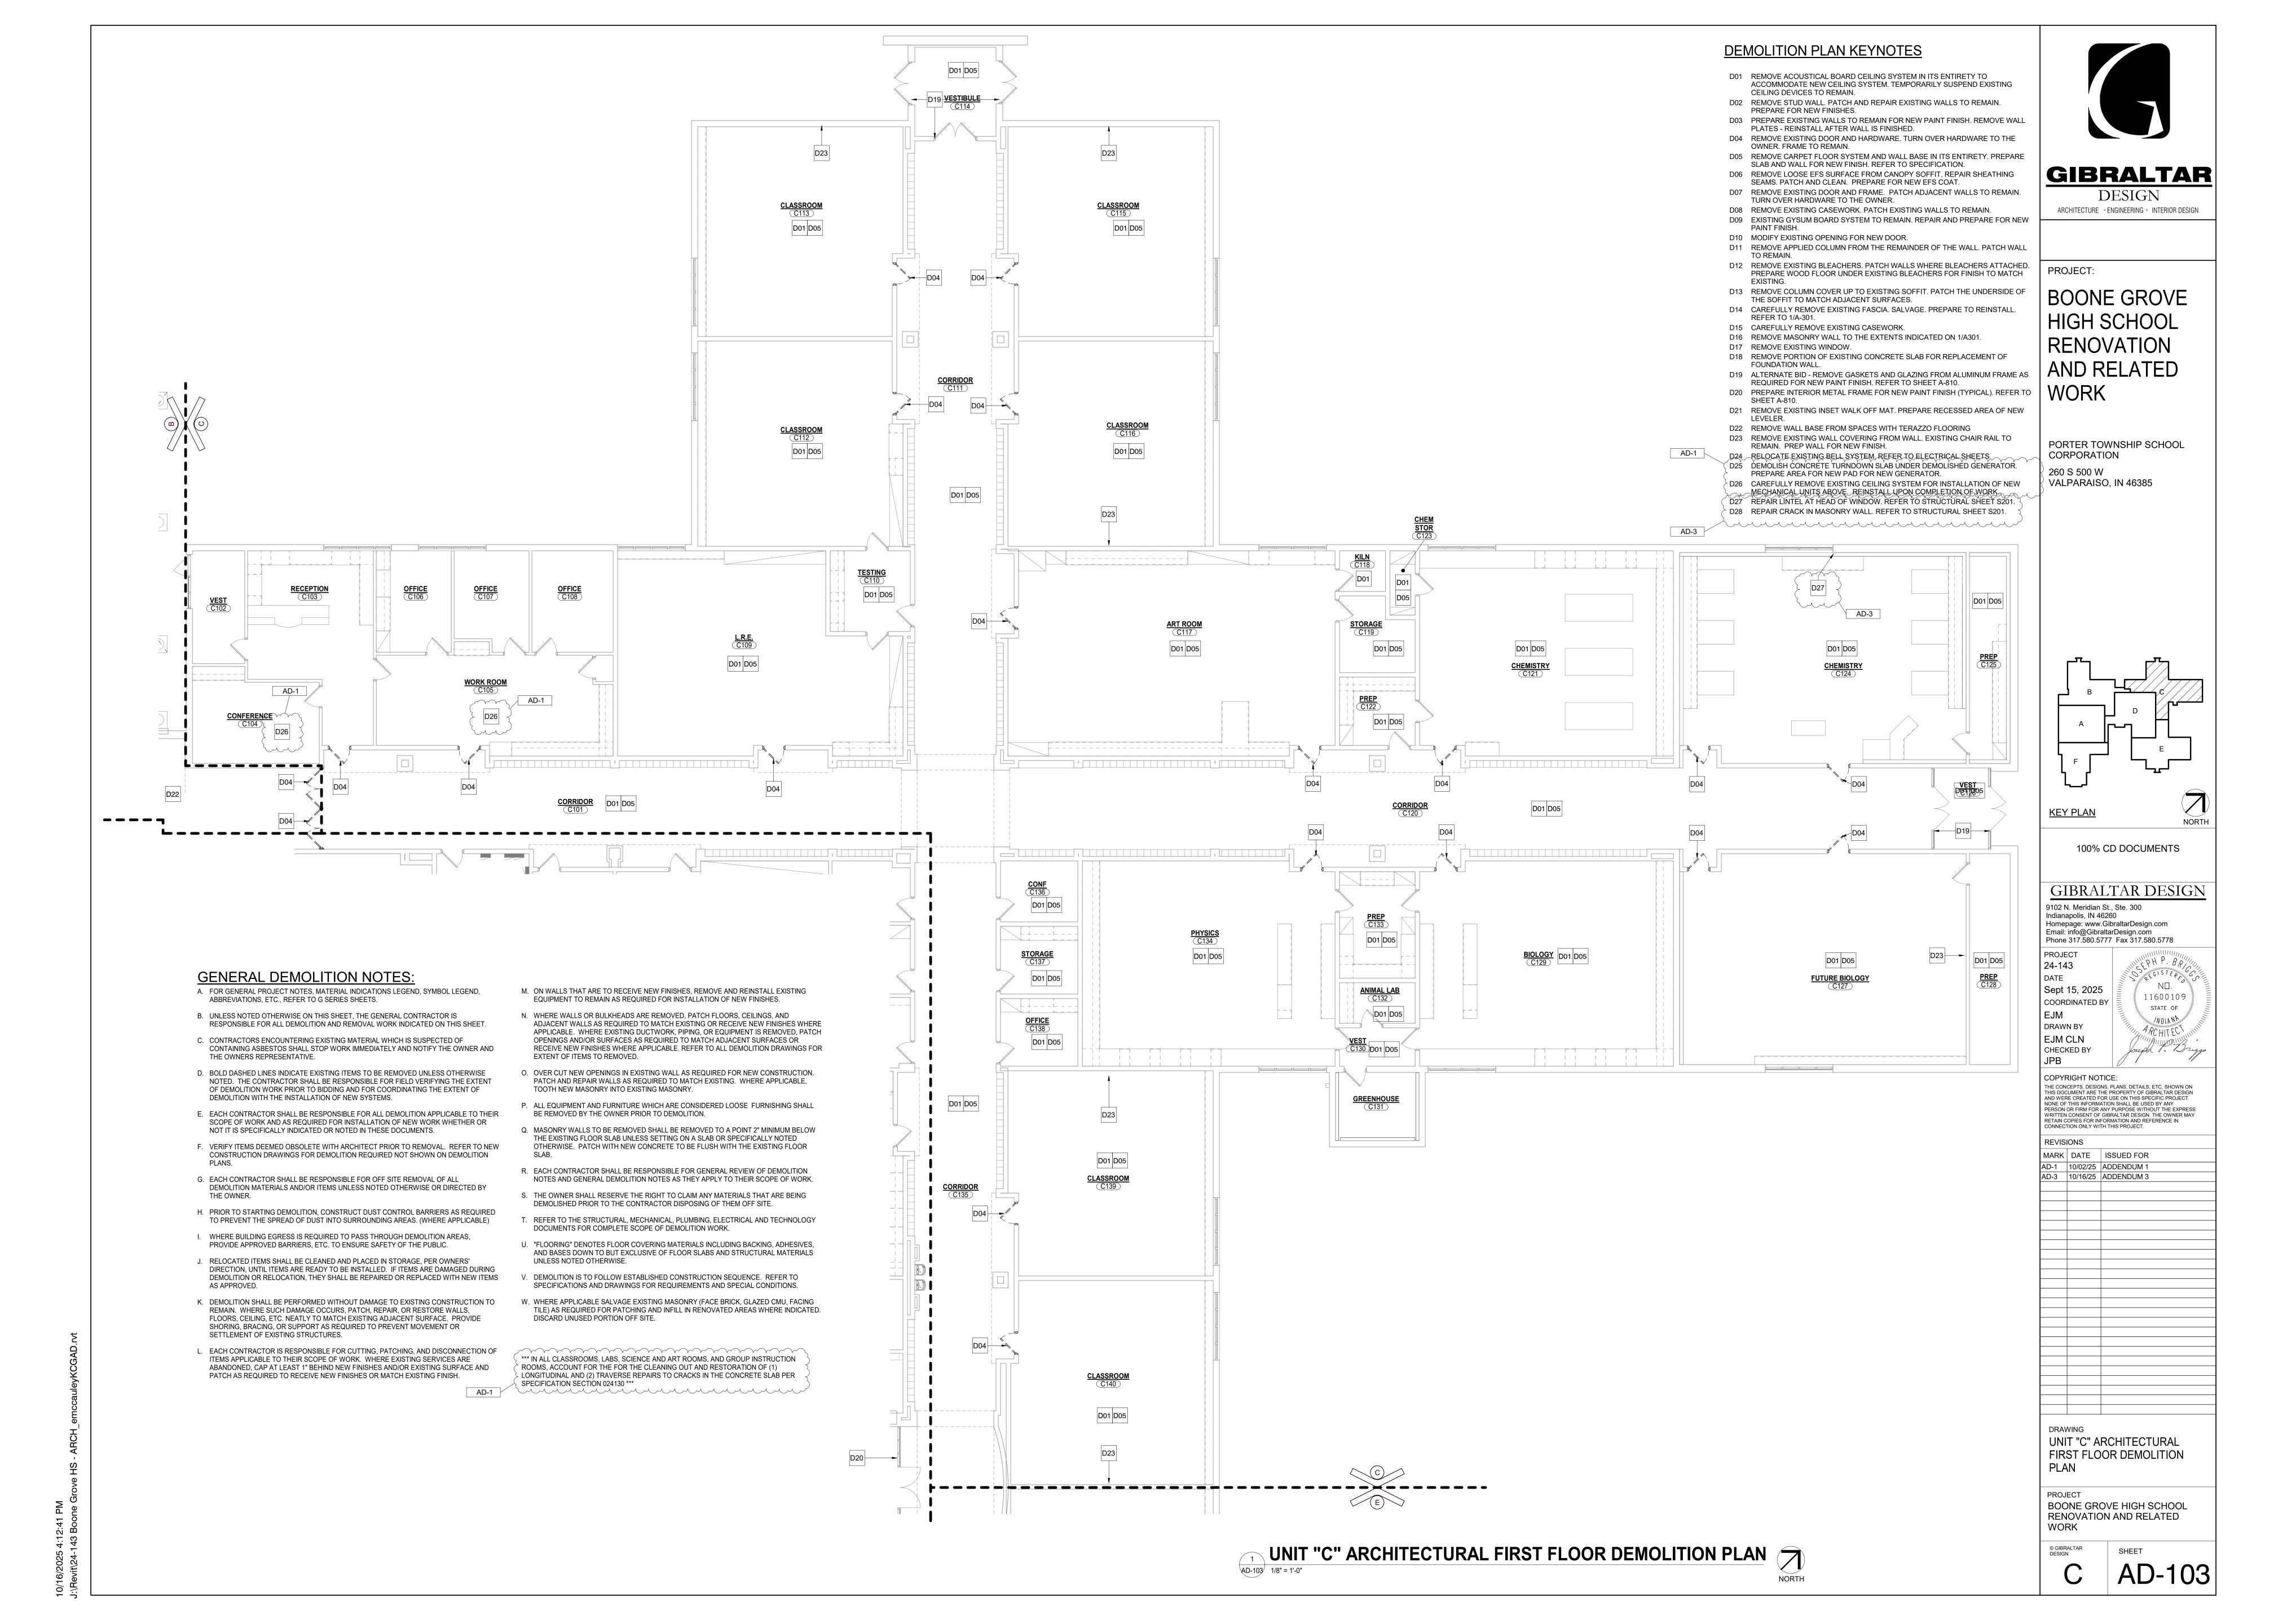

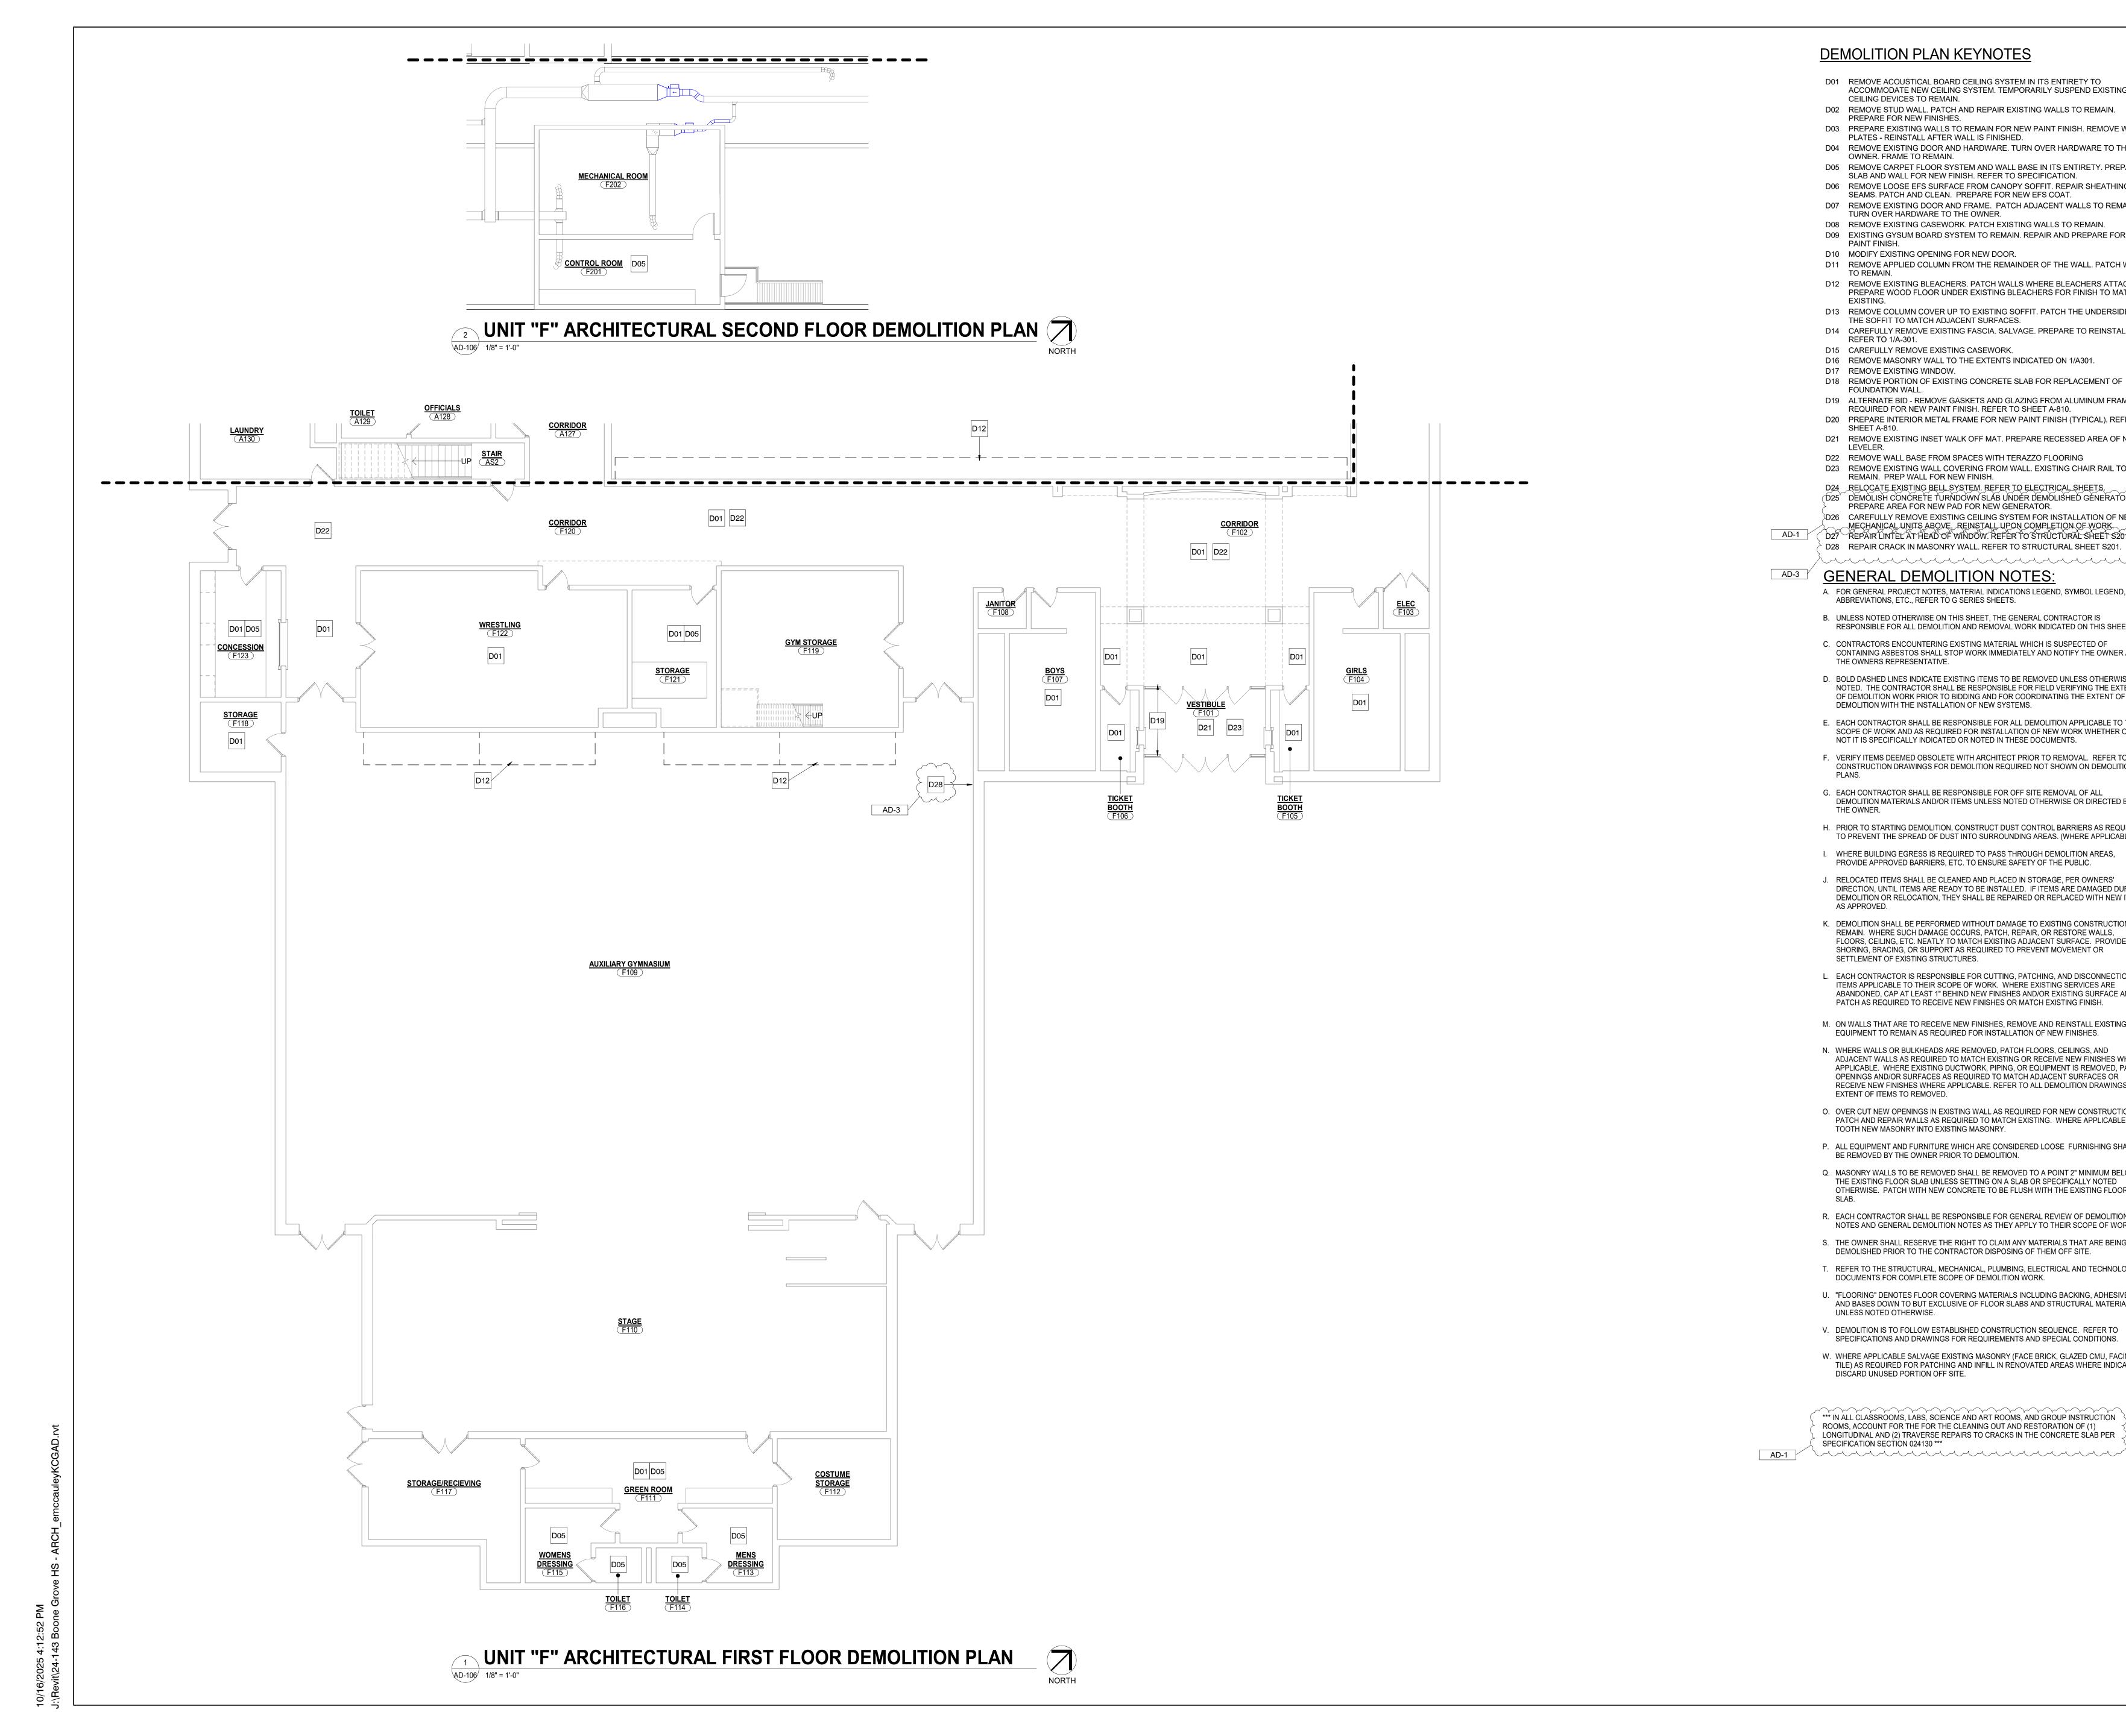

## **DEMOLITION PLAN KEYNOTES**

- D01 REMOVE ACOUSTICAL BOARD CEILING SYSTEM IN ITS ENTIRETY TO ACCOMMODATE NEW CEILING SYSTEM. TEMPORARILY SUSPEND EXISTING CEILING DEVICES TO REMAIN.
- D02 REMOVE STUD WALL. PATCH AND REPAIR EXISTING WALLS TO REMAIN. PREPARE FOR NEW FINISHES.
- D03 PREPARE EXISTING WALLS TO REMAIN FOR NEW PAINT FINISH. REMOVE WALL PLATES - REINSTALL AFTER WALL IS FINISHED.
- D04 REMOVE EXISTING DOOR AND HARDWARE. TURN OVER HARDWARE TO THE OWNER. FRAME TO REMAIN.
- D05 REMOVE CARPET FLOOR SYSTEM AND WALL BASE IN ITS ENTIRETY. PREPARE SLAB AND WALL FOR NEW FINISH. REFER TO SPECIFICATION. D06 REMOVE LOOSE EFS SURFACE FROM CANOPY SOFFIT. REPAIR SHEATHING
- SEAMS. PATCH AND CLEAN. PREPARE FOR NEW EFS COAT. D07 REMOVE EXISTING DOOR AND FRAME. PATCH ADJACENT WALLS TO REMAIN.
- TURN OVER HARDWARE TO THE OWNER. D08 REMOVE EXISTING CASEWORK. PATCH EXISTING WALLS TO REMAIN.
- D09 EXISTING GYSUM BOARD SYSTEM TO REMAIN. REPAIR AND PREPARE FOR NEW D10 MODIFY EXISTING OPENING FOR NEW DOOR.
- D11 REMOVE APPLIED COLUMN FROM THE REMAINDER OF THE WALL. PATCH WALL D12 REMOVE EXISTING BLEACHERS. PATCH WALLS WHERE BLEACHERS ATTACHED.
- PREPARE WOOD FLOOR UNDER EXISTING BLEACHERS FOR FINISH TO MATCH D13 REMOVE COLUMN COVER UP TO EXISTING SOFFIT. PATCH THE UNDERSIDE OF
- THE SOFFIT TO MATCH ADJACENT SURFACES. D14 CAREFULLY REMOVE EXISTING FASCIA. SALVAGE. PREPARE TO REINSTALL.
- REFER TO 1/A-301. D15 CAREFULLY REMOVE EXISTING CASEWORK.
- D16 REMOVE MASONRY WALL TO THE EXTENTS INDICATED ON 1/A301. D17 REMOVE EXISTING WINDOW.
- D18 REMOVE PORTION OF EXISTING CONCRETE SLAB FOR REPLACEMENT OF FOUNDATION WALL.
- REQUIRED FOR NEW PAINT FINISH. REFER TO SHEET A-810. D20 PREPARE INTERIOR METAL FRAME FOR NEW PAINT FINISH (TYPICAL). REFER TO SHEET A-810.

D19 ALTERNATE BID - REMOVE GASKETS AND GLAZING FROM ALUMINUM FRAME AS

- D21 REMOVE EXISTING INSET WALK OFF MAT. PREPARE RECESSED AREA OF NEW
- D22 REMOVE WALL BASE FROM SPACES WITH TERAZZO FLOORING D23 REMOVE EXISTING WALL COVERING FROM WALL. EXISTING CHAIR RAIL TO
- REMAIN. PREP WALL FOR NEW FINISH. D24 RELOCATE EXISTING BELL SYSTEM. REFER TO ELECTRICAL SHEETS. (Ď25) DÉMŎLISH CÓNČREŤE ŤURŇDOWN SLÁB UNDĚR DEMOLISHEĎ GĚNERATOR.
- PREPARE AREA FOR NEW PAD FOR NEW GENERATOR. D26 CAREFULLY REMOVE EXISTING CEILING SYSTEM FOR INSTALLATION OF NEW MECHANICAL UNITS ABOVE. REINSTALL UPON COMPLETION OF WORK Ď27 ŘEPÁIR LINTEL ÁT HEAĎ OF WINDÓW. ŘEFÉR TO STRÚCTÚRÁL SĤEET S201.

D28 REPAIR CRACK IN MASONRY WALL. REFER TO STRUCTURAL SHEET S201.

- A. FOR GENERAL PROJECT NOTES, MATERIAL INDICATIONS LEGEND, SYMBOL LEGEND, ABBREVIATIONS, ETC., REFER TO G SERIES SHEETS.
- B. UNLESS NOTED OTHERWISE ON THIS SHEET, THE GENERAL CONTRACTOR IS RESPONSIBLE FOR ALL DEMOLITION AND REMOVAL WORK INDICATED ON THIS SHEET.
- C. CONTRACTORS ENCOUNTERING EXISTING MATERIAL WHICH IS SUSPECTED OF CONTAINING ASBESTOS SHALL STOP WORK IMMEDIATELY AND NOTIFY THE OWNER AND THE OWNERS REPRESENTATIVE.
- D. BOLD DASHED LINES INDICATE EXISTING ITEMS TO BE REMOVED UNLESS OTHERWISE NOTED. THE CONTRACTOR SHALL BE RESPONSIBLE FOR FIELD VERIFYING THE EXTENT OF DEMOLITION WORK PRIOR TO BIDDING AND FOR COORDINATING THE EXTENT OF DEMOLITION WITH THE INSTALLATION OF NEW SYSTEMS.
- E. EACH CONTRACTOR SHALL BE RESPONSIBLE FOR ALL DEMOLITION APPLICABLE TO THEIR SCOPE OF WORK AND AS REQUIRED FOR INSTALLATION OF NEW WORK WHETHER OR NOT IT IS SPECIFICALLY INDICATED OR NOTED IN THESE DOCUMENTS.
- F. VERIFY ITEMS DEEMED OBSOLETE WITH ARCHITECT PRIOR TO REMOVAL. REFER TO NEW CONSTRUCTION DRAWINGS FOR DEMOLITION REQUIRED NOT SHOWN ON DEMOLITION
- G. EACH CONTRACTOR SHALL BE RESPONSIBLE FOR OFF SITE REMOVAL OF ALL DEMOLITION MATERIALS AND/OR ITEMS UNLESS NOTED OTHERWISE OR DIRECTED BY
- H. PRIOR TO STARTING DEMOLITION, CONSTRUCT DUST CONTROL BARRIERS AS REQUIRED TO PREVENT THE SPREAD OF DUST INTO SURROUNDING AREAS. (WHERE APPLICABLE)
- I. WHERE BUILDING EGRESS IS REQUIRED TO PASS THROUGH DEMOLITION AREAS, PROVIDE APPROVED BARRIERS, ETC. TO ENSURE SAFETY OF THE PUBLIC.
- J. RELOCATED ITEMS SHALL BE CLEANED AND PLACED IN STORAGE, PER OWNERS' DIRECTION, UNTIL ITEMS ARE READY TO BE INSTALLED. IF ITEMS ARE DAMAGED DURING DEMOLITION OR RELOCATION, THEY SHALL BE REPAIRED OR REPLACED WITH NEW ITEMS
- K. DEMOLITION SHALL BE PERFORMED WITHOUT DAMAGE TO EXISTING CONSTRUCTION TO REMAIN. WHERE SUCH DAMAGE OCCURS, PATCH, REPAIR, OR RESTORE WALLS, FLOORS, CEILING, ETC. NEATLY TO MATCH EXISTING ADJACENT SURFACE. PROVIDE SHORING, BRACING, OR SUPPORT AS REQUIRED TO PREVENT MOVEMENT OR SETTLEMENT OF EXISTING STRUCTURES.
- L. EACH CONTRACTOR IS RESPONSIBLE FOR CUTTING, PATCHING, AND DISCONNECTION OF ITEMS APPLICABLE TO THEIR SCOPE OF WORK. WHERE EXISTING SERVICES ARE ABANDONED, CAP AT LEAST 1" BEHIND NEW FINISHES AND/OR EXISTING SURFACE AND PATCH AS REQUIRED TO RECEIVE NEW FINISHES OR MATCH EXISTING FINISH.

N. WHERE WALLS OR BULKHEADS ARE REMOVED, PATCH FLOORS, CEILINGS, AND

- M. ON WALLS THAT ARE TO RECEIVE NEW FINISHES, REMOVE AND REINSTALL EXISTING EQUIPMENT TO REMAIN AS REQUIRED FOR INSTALLATION OF NEW FINISHES.
- APPLICABLE. WHERE EXISTING DUCTWORK, PIPING, OR EQUIPMENT IS REMOVED, PATCH OPENINGS AND/OR SURFACES AS REQUIRED TO MATCH ADJACENT SURFACES OR RECEIVE NEW FINISHES WHERE APPLICABLE. REFER TO ALL DEMOLITION DRAWINGS FOR EXTENT OF ITEMS TO REMOVED.

ADJACENT WALLS AS REQUIRED TO MATCH EXISTING OR RECEIVE NEW FINISHES WHERE

- O. OVER CUT NEW OPENINGS IN EXISTING WALL AS REQUIRED FOR NEW CONSTRUCTION. PATCH AND REPAIR WALLS AS REQUIRED TO MATCH EXISTING. WHERE APPLICABLE, TOOTH NEW MASONRY INTO EXISTING MASONRY.
- P. ALL EQUIPMENT AND FURNITURE WHICH ARE CONSIDERED LOOSE FURNISHING SHALL BE REMOVED BY THE OWNER PRIOR TO DEMOLITION.
- Q. MASONRY WALLS TO BE REMOVED SHALL BE REMOVED TO A POINT 2" MINIMUM BELOW THE EXISTING FLOOR SLAB UNLESS SETTING ON A SLAB OR SPECIFICALLY NOTED OTHERWISE. PATCH WITH NEW CONCRETE TO BE FLUSH WITH THE EXISTING FLOOR
- R. EACH CONTRACTOR SHALL BE RESPONSIBLE FOR GENERAL REVIEW OF DEMOLITION NOTES AND GENERAL DEMOLITION NOTES AS THEY APPLY TO THEIR SCOPE OF WORK.
- S. THE OWNER SHALL RESERVE THE RIGHT TO CLAIM ANY MATERIALS THAT ARE BEING DEMOLISHED PRIOR TO THE CONTRACTOR DISPOSING OF THEM OFF SITE.
- T. REFER TO THE STRUCTURAL, MECHANICAL, PLUMBING, ELECTRICAL AND TECHNOLOGY DOCUMENTS FOR COMPLETE SCOPE OF DEMOLITION WORK.
- U. "FLOORING" DENOTES FLOOR COVERING MATERIALS INCLUDING BACKING, ADHESIVES, AND BASES DOWN TO BUT EXCLUSIVE OF FLOOR SLABS AND STRUCTURAL MATERIALS UNLESS NOTED OTHERWISE.
- V. DEMOLITION IS TO FOLLOW ESTABLISHED CONSTRUCTION SEQUENCE. REFER TO SPECIFICATIONS AND DRAWINGS FOR REQUIREMENTS AND SPECIAL CONDITIONS.
- W. WHERE APPLICABLE SALVAGE EXISTING MASONRY (FACE BRICK, GLAZED CMU, FACING TILE) AS REQUIRED FOR PATCHING AND INFILL IN RENOVATED AREAS WHERE INDICATED. DISCARD UNUSED PORTION OFF SITE.

\*\*\* IN ALL CLASSROOMS, LABS, SCIENCE AND ART ROOMS, AND GROUP INSTRUCTION ROOMS, ACCOUNT FOR THE FOR THE CLEANING OUT AND RESTORATION OF (1) LONGITUDINAL AND (2) TRAVERSE REPAIRS TO CRACKS IN THE CONCRETE SLAB PER SPECIFICATION SECTION 024130 \*\*\*



**GIBRALTAR DESIGN** 


ARCHITECTURE • ENGINEERING • INTERIOR DESIGN

PROJECT:

## **BOONE GROVE** HIGH SCHOOL RENOVATION AND RELATED

PORTER TOWNSHIP SCHOOL CORPORATION

260 S 500 W VALPARAISO, IN 46385

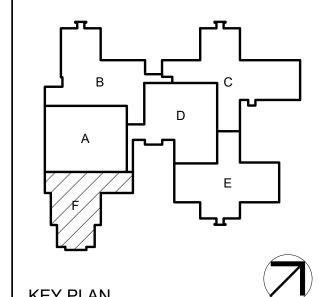

GIBRALTAR DESIGN

100% CD DOCUMENTS

9102 N. Meridian St., Ste. 300 Indianapolis, IN 46260 Homepage: www.GibraltarDesign.com Email: info@GibraltarDesign.com Phone 317.580.5777 Fax 317.580.5778

24-143 Sept 15, 2025 11600109 COORDINATED BY

DRAWN BY EJM CLN CHECKED BY

THE CONCEPTS, DESIGNS, PLANS, DETAILS, ETC, SHOWN ON THIS DOCUMENT ARE THE PROPERTY OF GIBRALTAR DESIGN AND WERE CREATED FOR USE ON THIS SPECIFIC PROJECT. NONE OF THIS INFORMATION SHALL BE USED BY ANY ERSON OR FIRM FOR ANY PURPOSE WITHOUT THE EXPRESS PRITTEN CONSENT OF GIBRALTAR DESIGN. THE OWNER MAY

RETAIN COPIES FOR INFORMATION AND REFERENCE IN CONNECTION ONLY WITH THIS PROJECT. REVISIONS


MARK DATE ISSUED FOR D-1 10/02/25 ADDENDUM 1 AD-3 | 10/16/25 | ADDENDUM 3


UNIT "F" ARCHITECTURAL FIRST & SECOND FLOOR

DEMOLITION PLANS


BOONE GROVE HIGH SCHOOL RENOVATION AND RELATED

AD-106

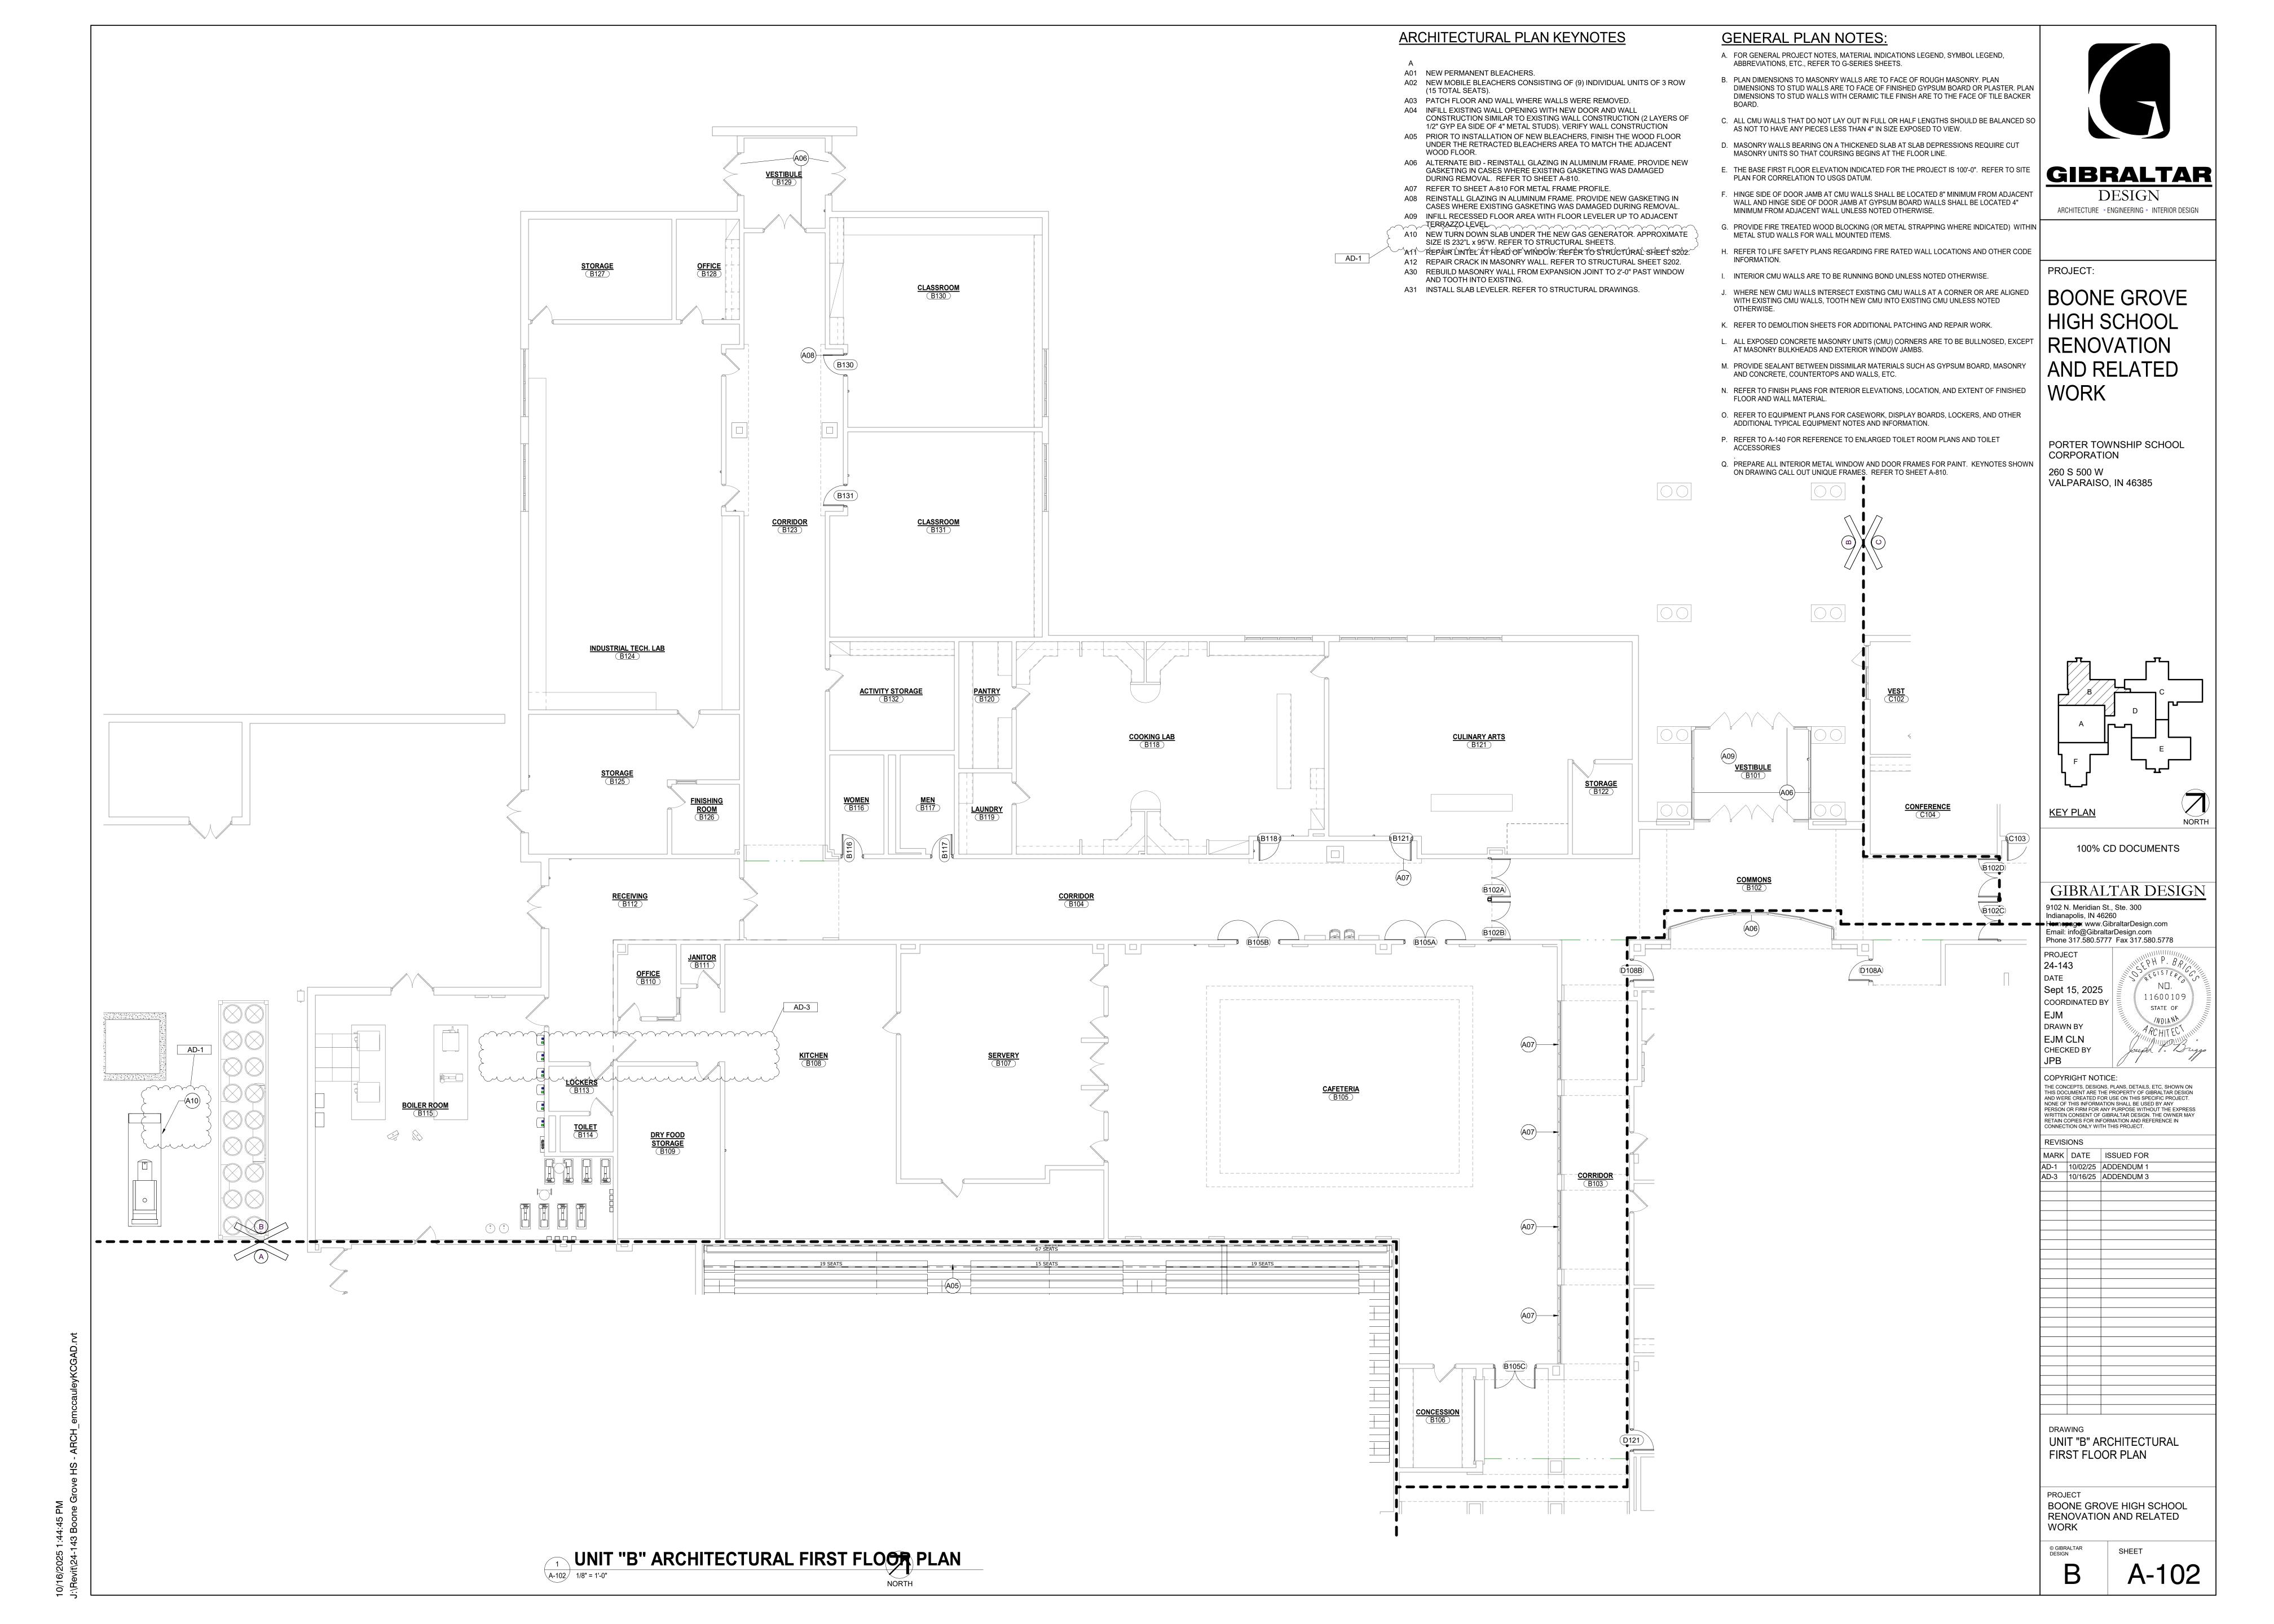

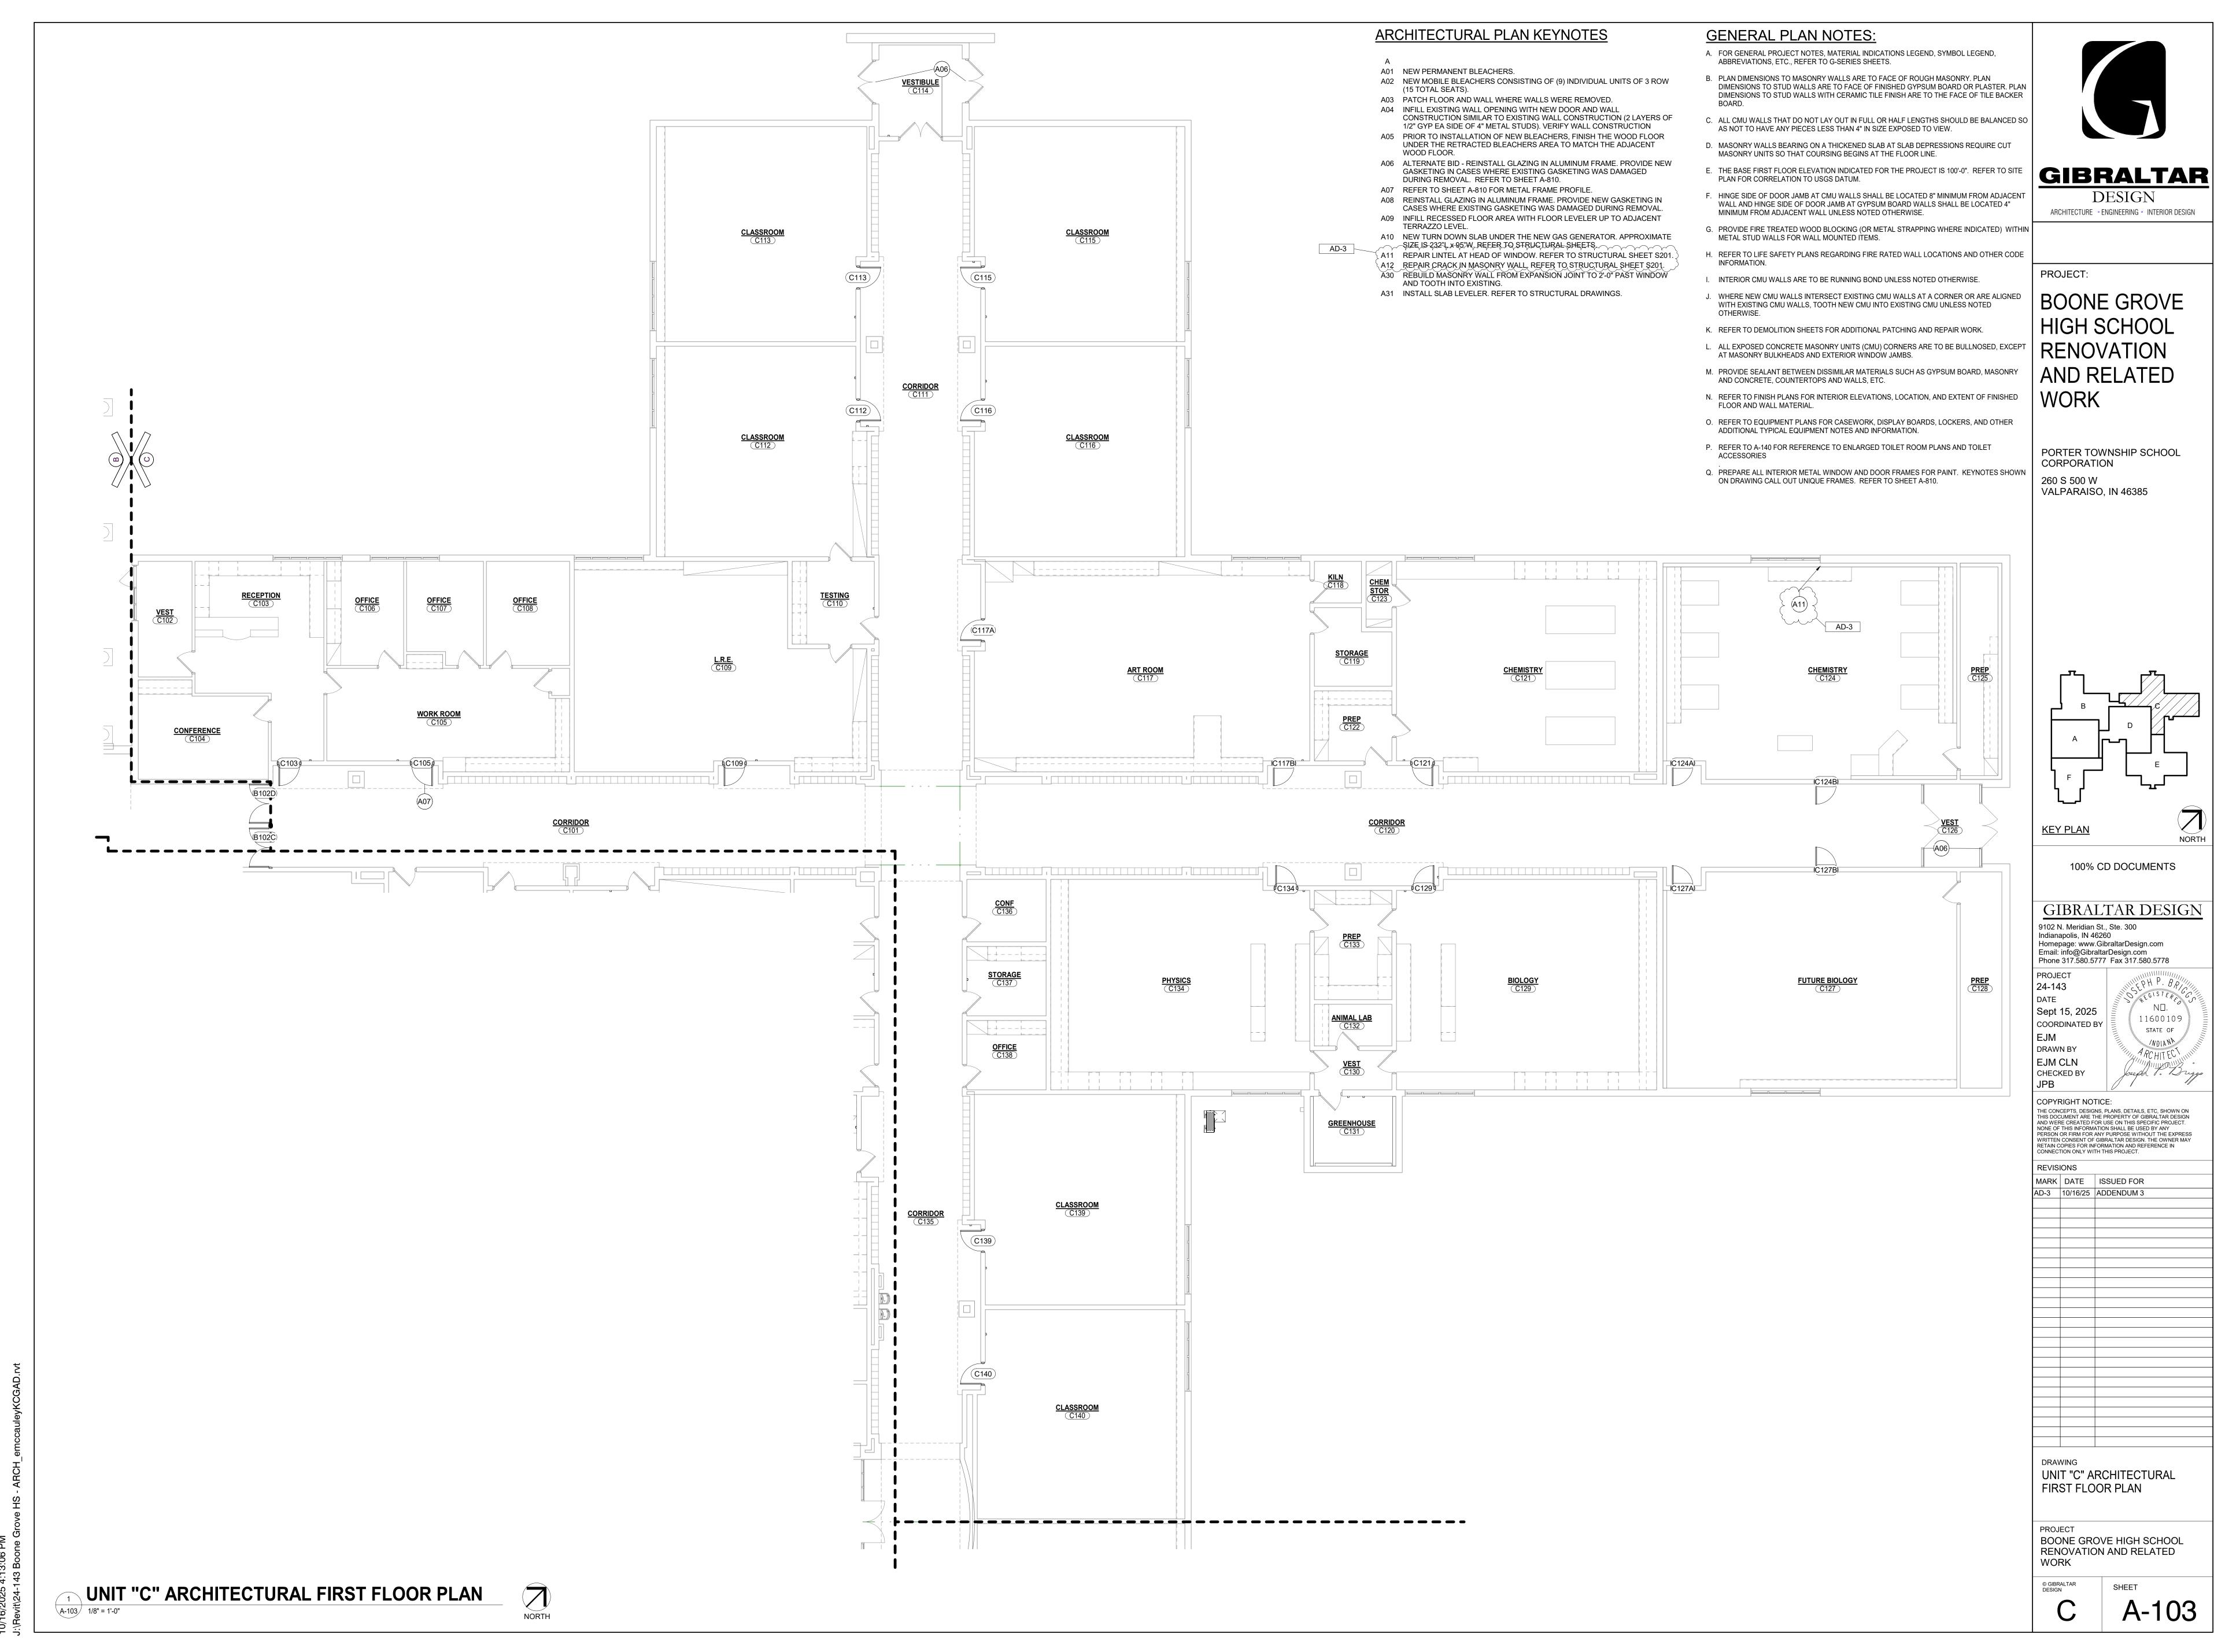

10/16/2025 4:13:06 PM

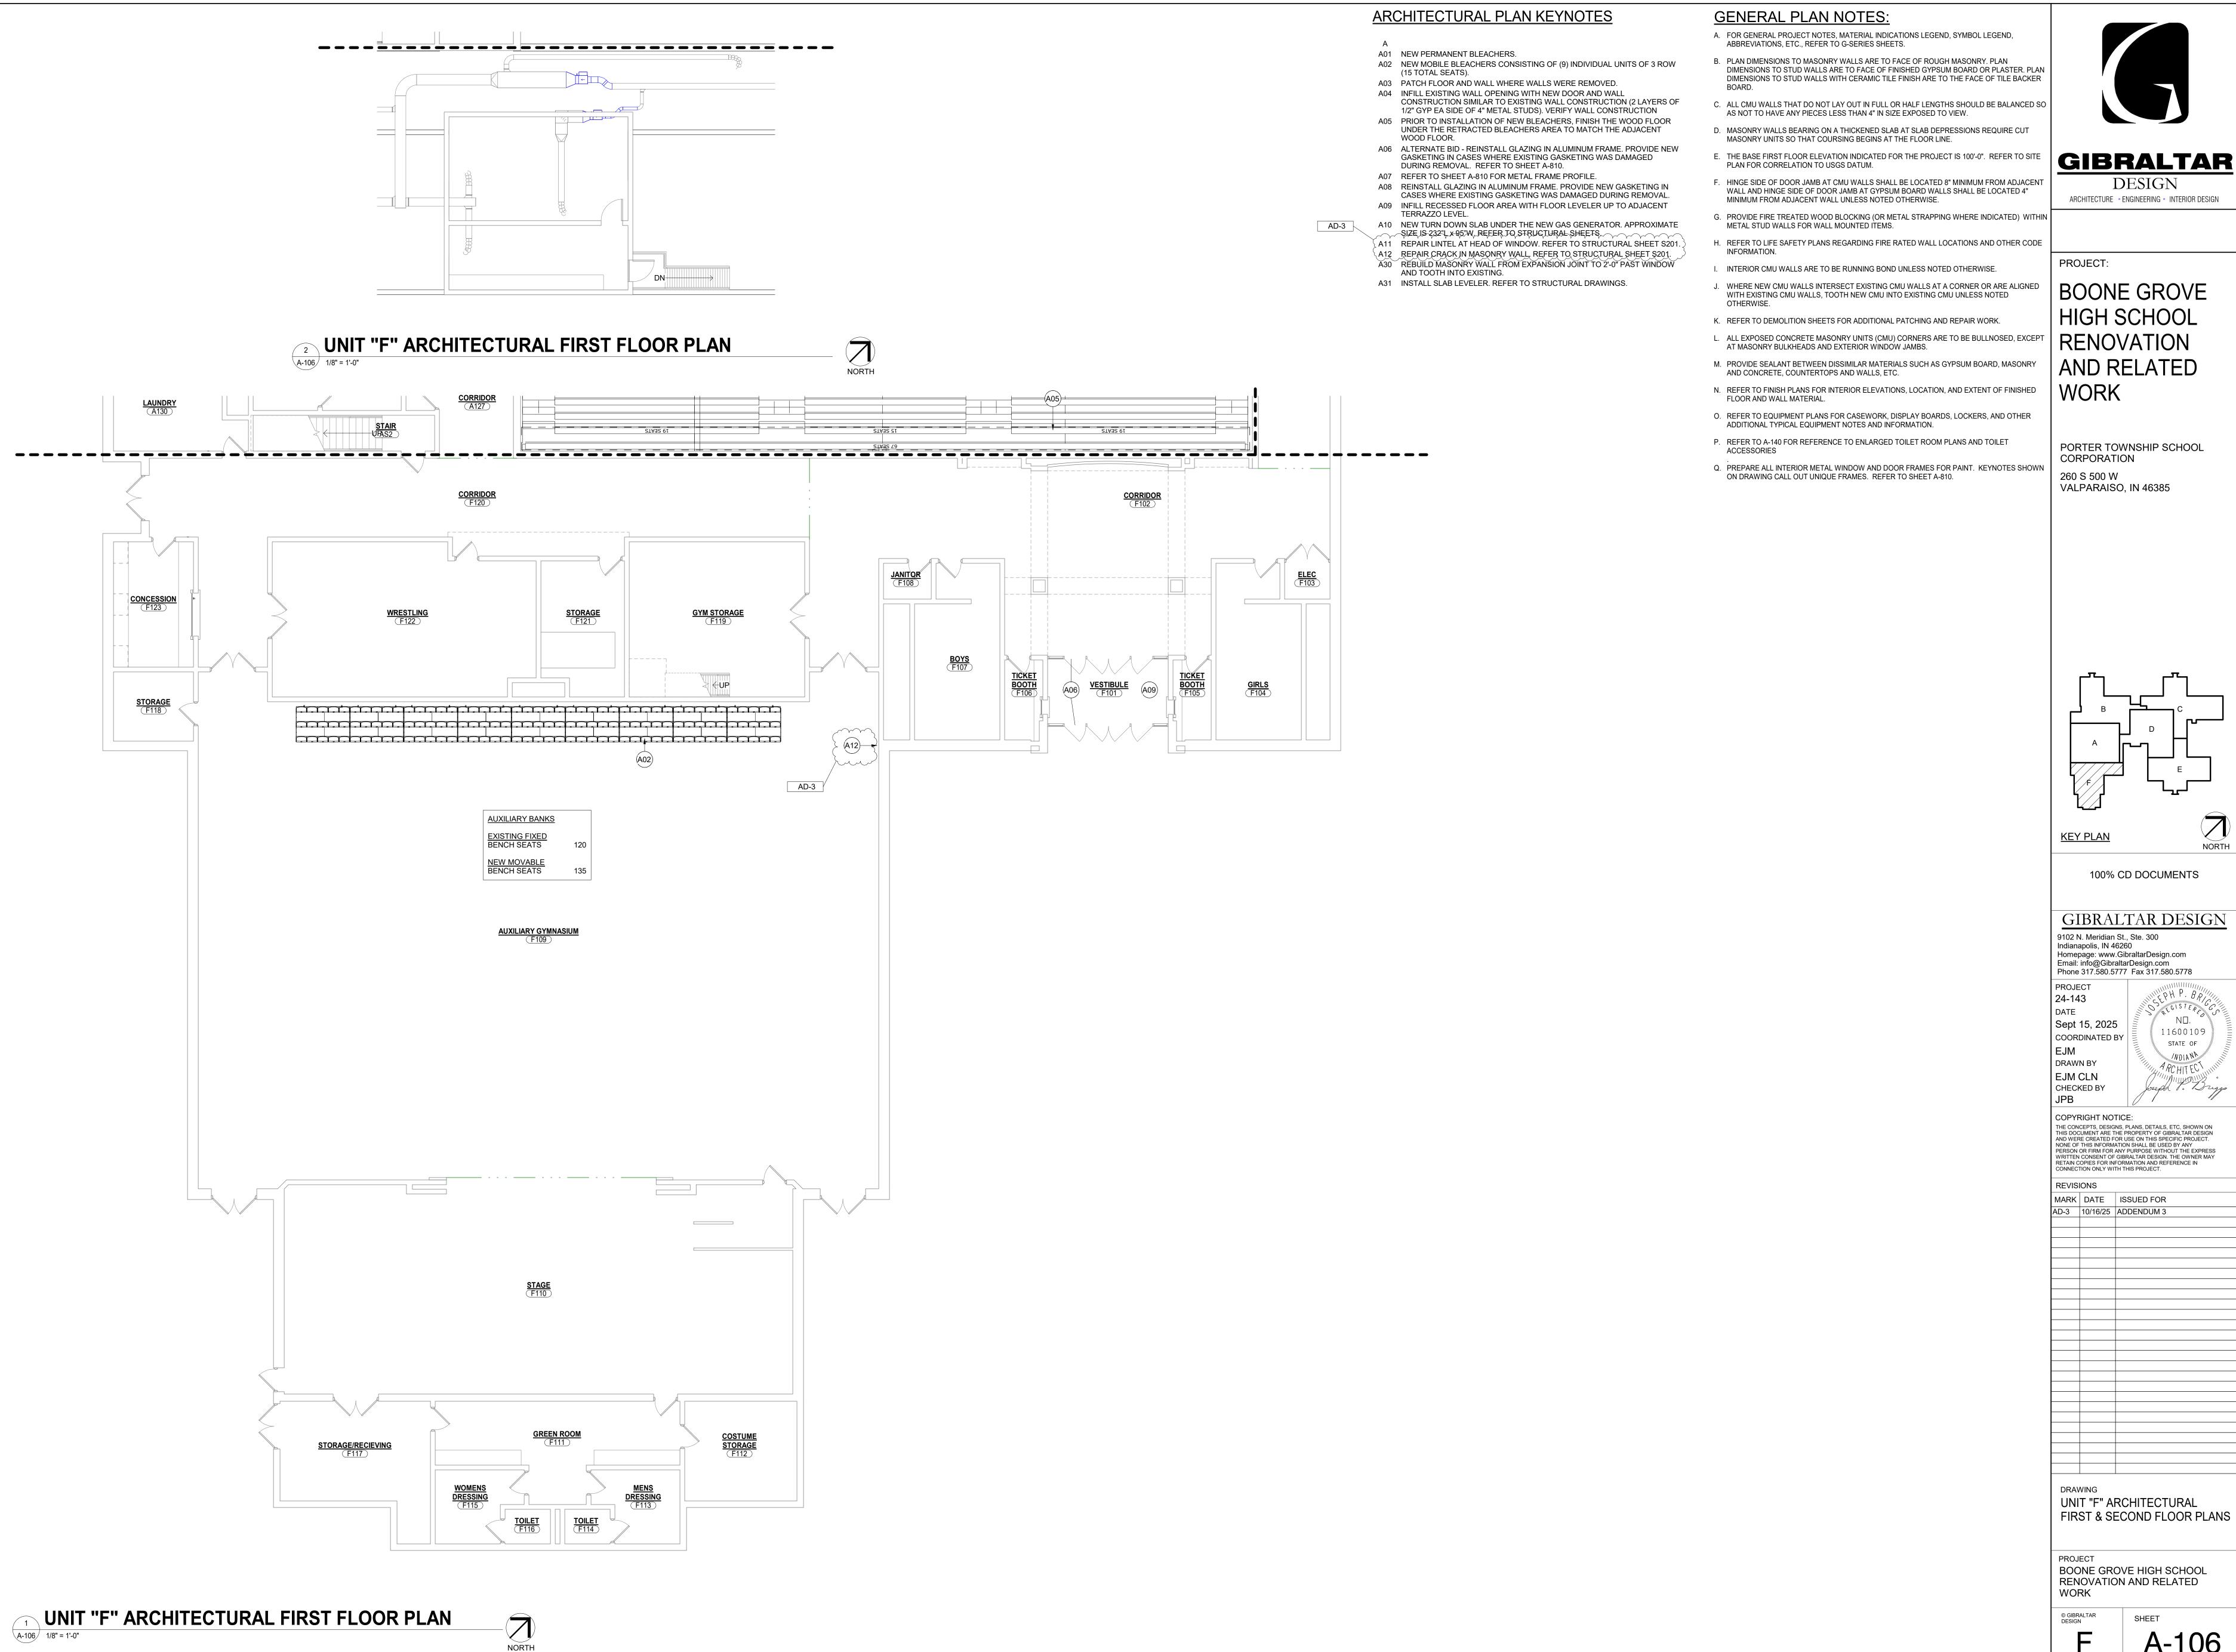

A-106

11600109

				FINISH LEG	GEND		,	
SURFACE	MARK	DESCRIPTION	MANUFACTURER	PATTERN/FINISH	NUMBER/COLOR	SIZE	COMMENTS	
CEILING MATER	DIAI C							
	ACT1	ACOUSTICAL CEILING TILE	ARMSTRONG CEILINGS	CIRRUS	WHITE (WH)	24" X 24"	SQUARE EDGE	
	ACT2	ACOUSTICAL CEILING TILE	ARMSTRONG CEILINGS	CLEAN ROOM VL	WHITE (WH)	24" X 24"	SQUARE EDGE	13
1	ACT3	ACOUSTICAL CEILING TILE	ARMSTRONG CEILINGS	CERAMAGUARD	WHITE (WH)	24" X 24"	SQUARE EDGE	
	ACT4	ACOUSTICAL CEILING TILE	ARMSTRONG CEILINGS	ARMATUFF	WHITE (WH)	24" X 24"	SQUARE EDGE	
	ACT5	ACOUSTICAL CEILING TILE	ARMSTRONG CEILINGS	ULTIMA HIGH NRC	WHITE (WH)	24" X 24"	SQUARE EDGE	
	P7	PAINT	SHERWIN WILLIAMS	<u> -</u>	SW 7007 CEILING BRIGHT WHITE	<u></u>	<del></del>	
WALL BASE & S	STAIRS B1	VINYL WALL BASE	TARKETT	T	63 BURNT UMBER	4" COVE		
	ы	VIIVIE WALL BAOL	IAINLII		03 BOTTO ONIDET			<b>GIBRAL</b>
FLOOR MATERI	IALS							
	C1a	WALK-OFF CARPET TILE	TARKETT	02578 ABRASIVE ACTION II	19103 WINTER GRAY	24" X 24"	INSTALL: MONOLITHIC	DESIGN
	C1b	WALK-OFF CARPET TILE	J+J FLOORING	7268 CATWALK II	1427 SPOTLIGHT	24" X 24"	INSTALL: QUARTER TURN	ARCHITECTURE • ENGINEERING • IN
	C2a	CARPET TILE	TARKETT	11769 CREATE PURPOSE	32811 INCLUSIVE	18" X 36"	INSTALL: VERTICAL ASHLAR	<u> </u>
	C2b	CARPET TILE CARPET TILE	J+J FLOORING TARKETT	7503 BALANCE	3638 BALTIC	24" X 24"	INSTALL: ASHLAR	1
	C3a C3b	CARPET TILE	J+J FLOORING	03026 AFTERMATH II 7311 INTRINSIC ACCENT	23512 TAPESTRY CUSTOM	24" X 24" 24" X 24"	INSTALL: QUARTER TURN INSTALL: QUARTER TURN, SEE NOTE 1	1
	C3b C4a	CARPET TILE  CARPET TILE	TARKETT	11770 CREATE BALANCE	32811 INCLUSIVE	18" X 36"	INSTALL: QUARTER TURN, SEE NOTE T	1
	C4a	CARPET TILE	J+J FLOORING	7502 RHYTHM	3638 BALTIC	24" X 24"	INSTALL: VERTICAL ASTILAR	DDO IECT:
	С5а	ROLLED CARPET	TARKETT	03026 AFTERMATH II	32811 INCLUSIVE	6' W ROLLS		PROJECT:
	C5b	ROLLED CARPET	J+J FLOORING	7311 INTRINSIC ACCENT	CUSTOM	12' W ROLLS		
								BOONE GRO
	LVT1	LUXURY VINYL TILE	MANNINGTON	ACTIVE LINES, CRISSCROSS	ALC101 FLASH	18" X 18"	INSTALL: OFFSET & STAGGERED, UNBEVELED EDGES	4
	LVT2 LVT3	LUXURY VINYL TILE LUXURY VINYL TILE	MANNINGTON MANNINGTON	ACTIVE LINES, BEND	ALB101 FLASH	18" X 18"	INSTALL: OFFSET & STAGGERED, UNBEVELED EDGES INSTALL: OFFSET & STAGGERED, UNBEVELED EDGES	HIGH SCHO
	LVIS	LUXURT VINTL TILE	INIAMININGTON	AMTICO SIGNATURE, ABSTRACT	AR0AMO22 MOSAIC SUMIRA	18" X 18"	INSTALL. OFFSET & STAGGERED, UNBEVELED EDGES	1
WALL MATERIA	LS						,	RENOVATIO
	P1	PAINT	SHERWIN WILLIAMS		SW 6168 MODERNE WHITE			
	P2	PAINT	SHERWIN WILLIAMS		SW 7015 REPOSE GRAY			AND RELATE
	P3	PAINT	SHERWIN WILLIAMS		SW 7066 GRAY MATTERS			AND VERVI
	P4	PAINT	SHERWIN WILLIAMS		SW 9163 TIN LIZZIE		DOOD WANDOW & COLORED CO.	MODIZ
	P5	PAINT	SHERWIN WILLIAMS	<del></del>	SW 7067 CITYSCAPE		DOOR, WINDOW, & STOREFRONT FRAMES	WORK
	P6	PAINT SEE CEILING MATERIALS	ICI PAINTS DULUX	<del></del>	30BB 08/225 WILD WATER 1	<u></u>	LOCKERS, SEE NOTE 2	
	11 /	OLL GLILING WATERIALS						
4	W1	WALL COATING	SHERWIN WILLIAMS		SW 6168 MODERNE WHITE			1
4	W2	WALL COATING	SHERWIN WILLIAMS		SW 7015 REPOSE GRAY			PORTER TOWNSHIP SC
	W3	WALL COATING	SHERWIN WILLIAMS		SW 7066 GRAY MATTERS			CORPORATION
	W4	WALL COATING	SHERWIN WILLIAMS		SW 9163 TIN LIZZIE			
	W5	NOT USED					<u> </u>	260 S 500 W
	W6 W7	NOT USED NOT USED					+	VALPARAISO, IN 46385
	W8	WALL COATING	SHERWIN WILLIAMS		MATCH EXISTING		+	
4	WC1	WALL COVERING	MOMENTUM	HAYDEN	L2-HN-06 BROADCLOTH			
	CMC	CDADHIC WALL COVERING	MDC	SHEDE	CUSTOM		ELEVIDI E CLIDOTDATE	
	GWC GWP	GRAPHIC WALL COVERING GRAPHIC WALL PANEL	MDC MDC	SUEDE SINTRA	CUSTOM	4'-0" X 8'-0" X 1/2"	FLEXIBLE SUBSTRATE RIGID SUBSTRATE	1
	PWG1	PAINTED WALL GRAPHIC	IVIDO	CHITTO	CUSTOM	- 7 7 7 7 7 1/Z	REFER TO SPECIFICATIONS	1
	PWG2	PAINTED WALL GRAPHIC			CUSTOM		REFER TO SPECIFICATIONS	1
	PWG3	PAINTED WALL GRAPHIC			CUSTOM		REFER TO SPECIFICATIONS	1
	PWG4	PAINTED WALL GRAPHIC			CUSTOM		REFER TO SPECIFICATIONS	
CASEWORK & N	MILLWORK							
	PL1	PLASTIC LAMINATE	PIONITE	TEXTURED/SUEDE (TS)	AG611 GRAVE OF THE ATLANTIC			
5	PL2	PLASTIC LAMINATE	WILSONART	FINE VELVET TEXTURE	4947-38 RAW COTTON			1
MISCELLANEOU	US						,	
		FABRIC-WRAPPED ACOUSTIC PANEL	MAYER FABRICS	EQUAL	EQ153 BALTIC			
		FABRIC-WRAPPED ACOUSTIC PANEL	MAYER FABRICS	EQUAL	EQ298 MEDIUM GRAY			1
	BL	BLEACHER SEAT	HUSSEY SEATING		301 BLUE			
			1.1000E1 OLATINO		1			
	WD	WOOD DOORS			MATCH EXISITNG			
I G	WDF	WOOD FLOOR FINISH			MATCH EXISTING		SEE NOTE 3	1
	•							1

100% CD DOCUMENTS

GIBRALTAR DESIGN 9102 N. Meridian St., Ste. 300 Indianapolis, IN 46260 Homepage: www.GibraltarDesign.com Email: info@GibraltarDesign.com Phone 317.580.5777 Fax 317.580.5778

11600109

STATE OF

24-143 DATE


Sept 15, 2025 COORDINATED BY EJM DRAWN BY ACS CHECKED BY

COPYRIGHT NOTICE: THE CONCEPTS, DESIGNS, PLANS, DETAILS, ETC, SHOWN ON THIS DOCUMENT ARE THE PROPERTY OF GIBRALTAR DESIGN AND WERE CREATED FOR USE ON THIS SPECIFIC PROJECT. NONE OF THIS INFORMATION SHALL BE USED BY ANY PERSON OR FIRM FOR ANY PURPOSE WITHOUT THE EXPRESS WRITTEN CONSENT OF GIBRALTAR DESIGN. THE OWNER MAY RETAIN COPIES FOR INFORMATION AND REFERENCE IN CONNECTION ONLY WITH THIS PROJECT.

REVISIONS MARK DATE ISSUED FOR AD-3 10/16/25 ADDENDUM 3

DRAWING FINISH LEGEND

BOONE GROVE HIGH SCHOOL RENOVATION AND RELATED

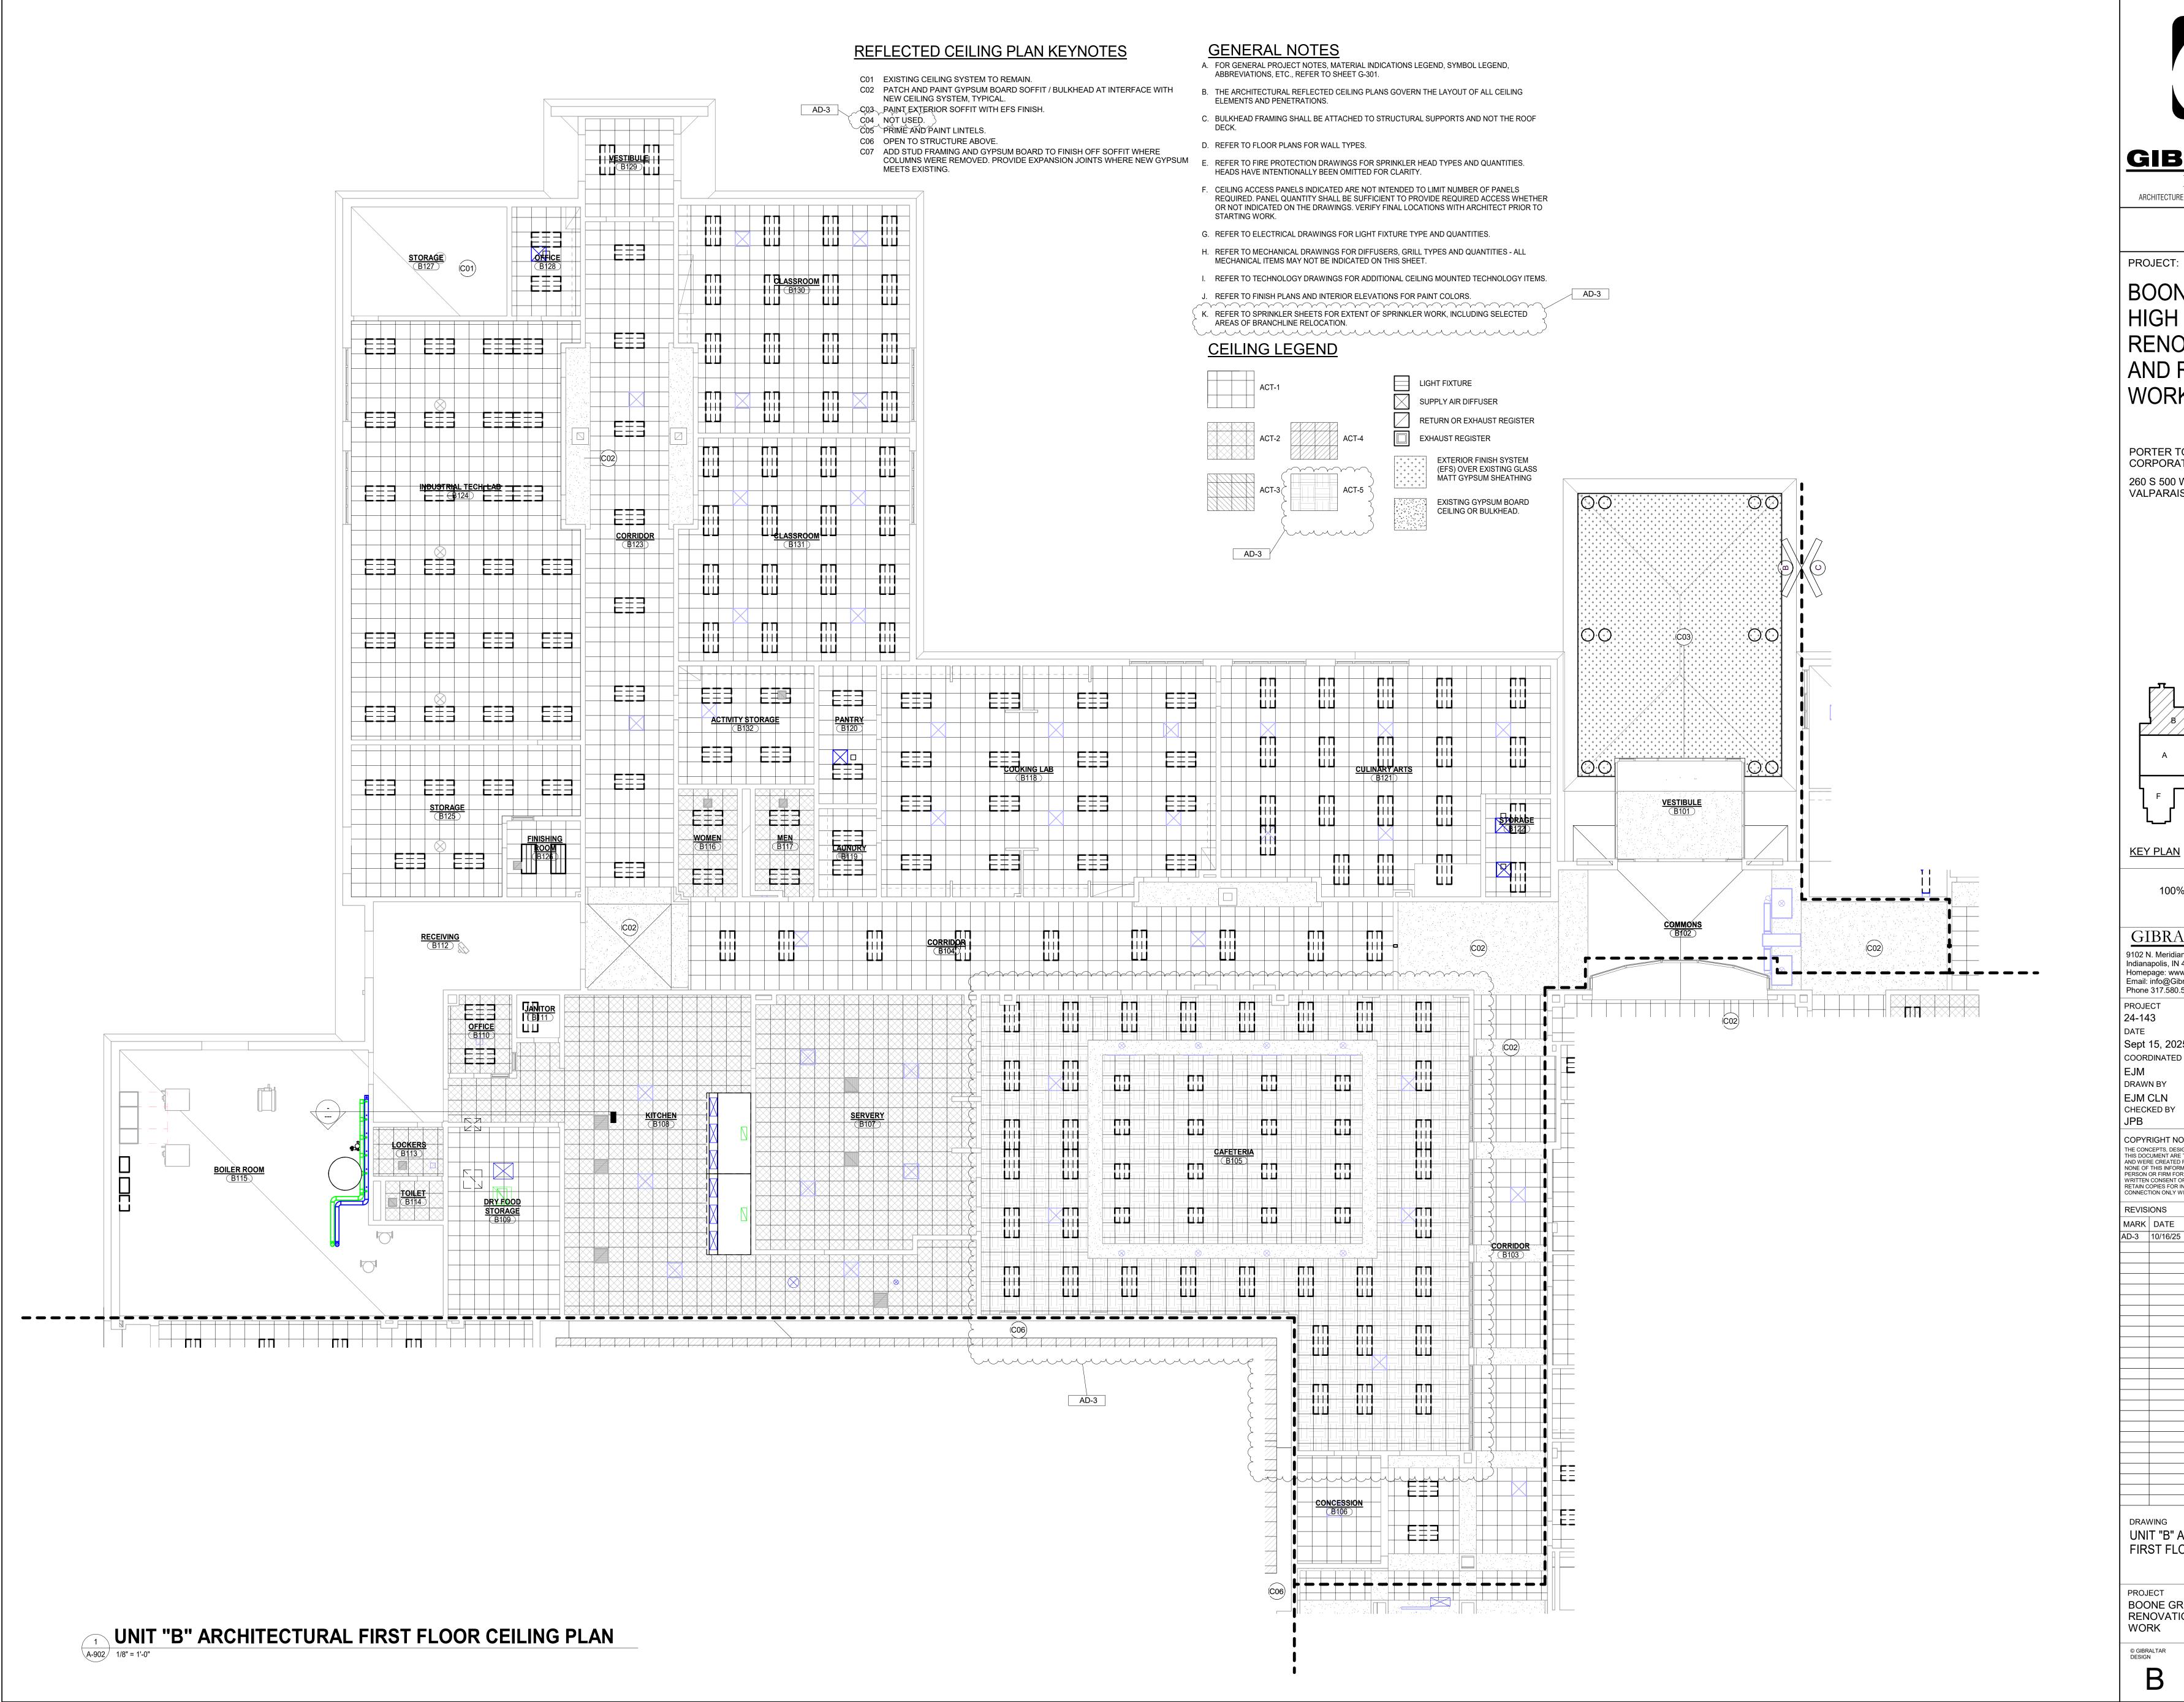




**DESIGN** ARCHITECTURE → ENGINEERING → INTERIOR DESIGN

PROJECT:

**BOONE GROVE** HIGH SCHOOL RENOVATION AND RELATED WORK

PORTER TOWNSHIP SCHOOL CORPORATION

260 S 500 W VALPARAISO, IN 46385

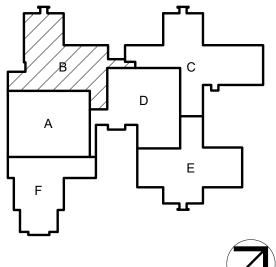

100% CD DOCUMENTS

GIBRALTAR DESIGN 9102 N. Meridian St., Ste. 300 Indianapolis, IN 46260
Homepage: www.GibraltarDesign.com
Email: info@GibraltarDesign.com
Phone 317.580.5777 Fax 317.580.5778

24-143

Sept 15, 2025 11600109 COORDINATED BY STATE OF DRAWN BY EJM CLN CHECKED BY

THE CONCEPTS, DESIGNS, PLANS, DETAILS, ETC, SHOWN ON THIS DOCUMENT ARE THE PROPERTY OF GIBRALTAR DESIGN AND WERE CREATED FOR USE ON THIS SPECIFIC PROJECT. NONE OF THIS INFORMATION SHALL BE USED BY ANY PERSON OR FIRM FOR ANY PURPOSE WITHOUT THE EXPRESS WRITTEN CONSENT OF GIBRALTAR DESIGN. THE OWNER MAY RETAIN COPIES FOR INFORMATION AND REFERENCE IN CONNECTION ONLY WITH THIS PROJECT.

REVISIONS


MARK DATE ISSUED FOR AD-3 10/16/25 ADDENDUM 3

UNIT "B" ARCHITECTURAL FIRST FLOOR CEILING PLAN

BOONE GROVE HIGH SCHOOL RENOVATION AND RELATED

В

A-902

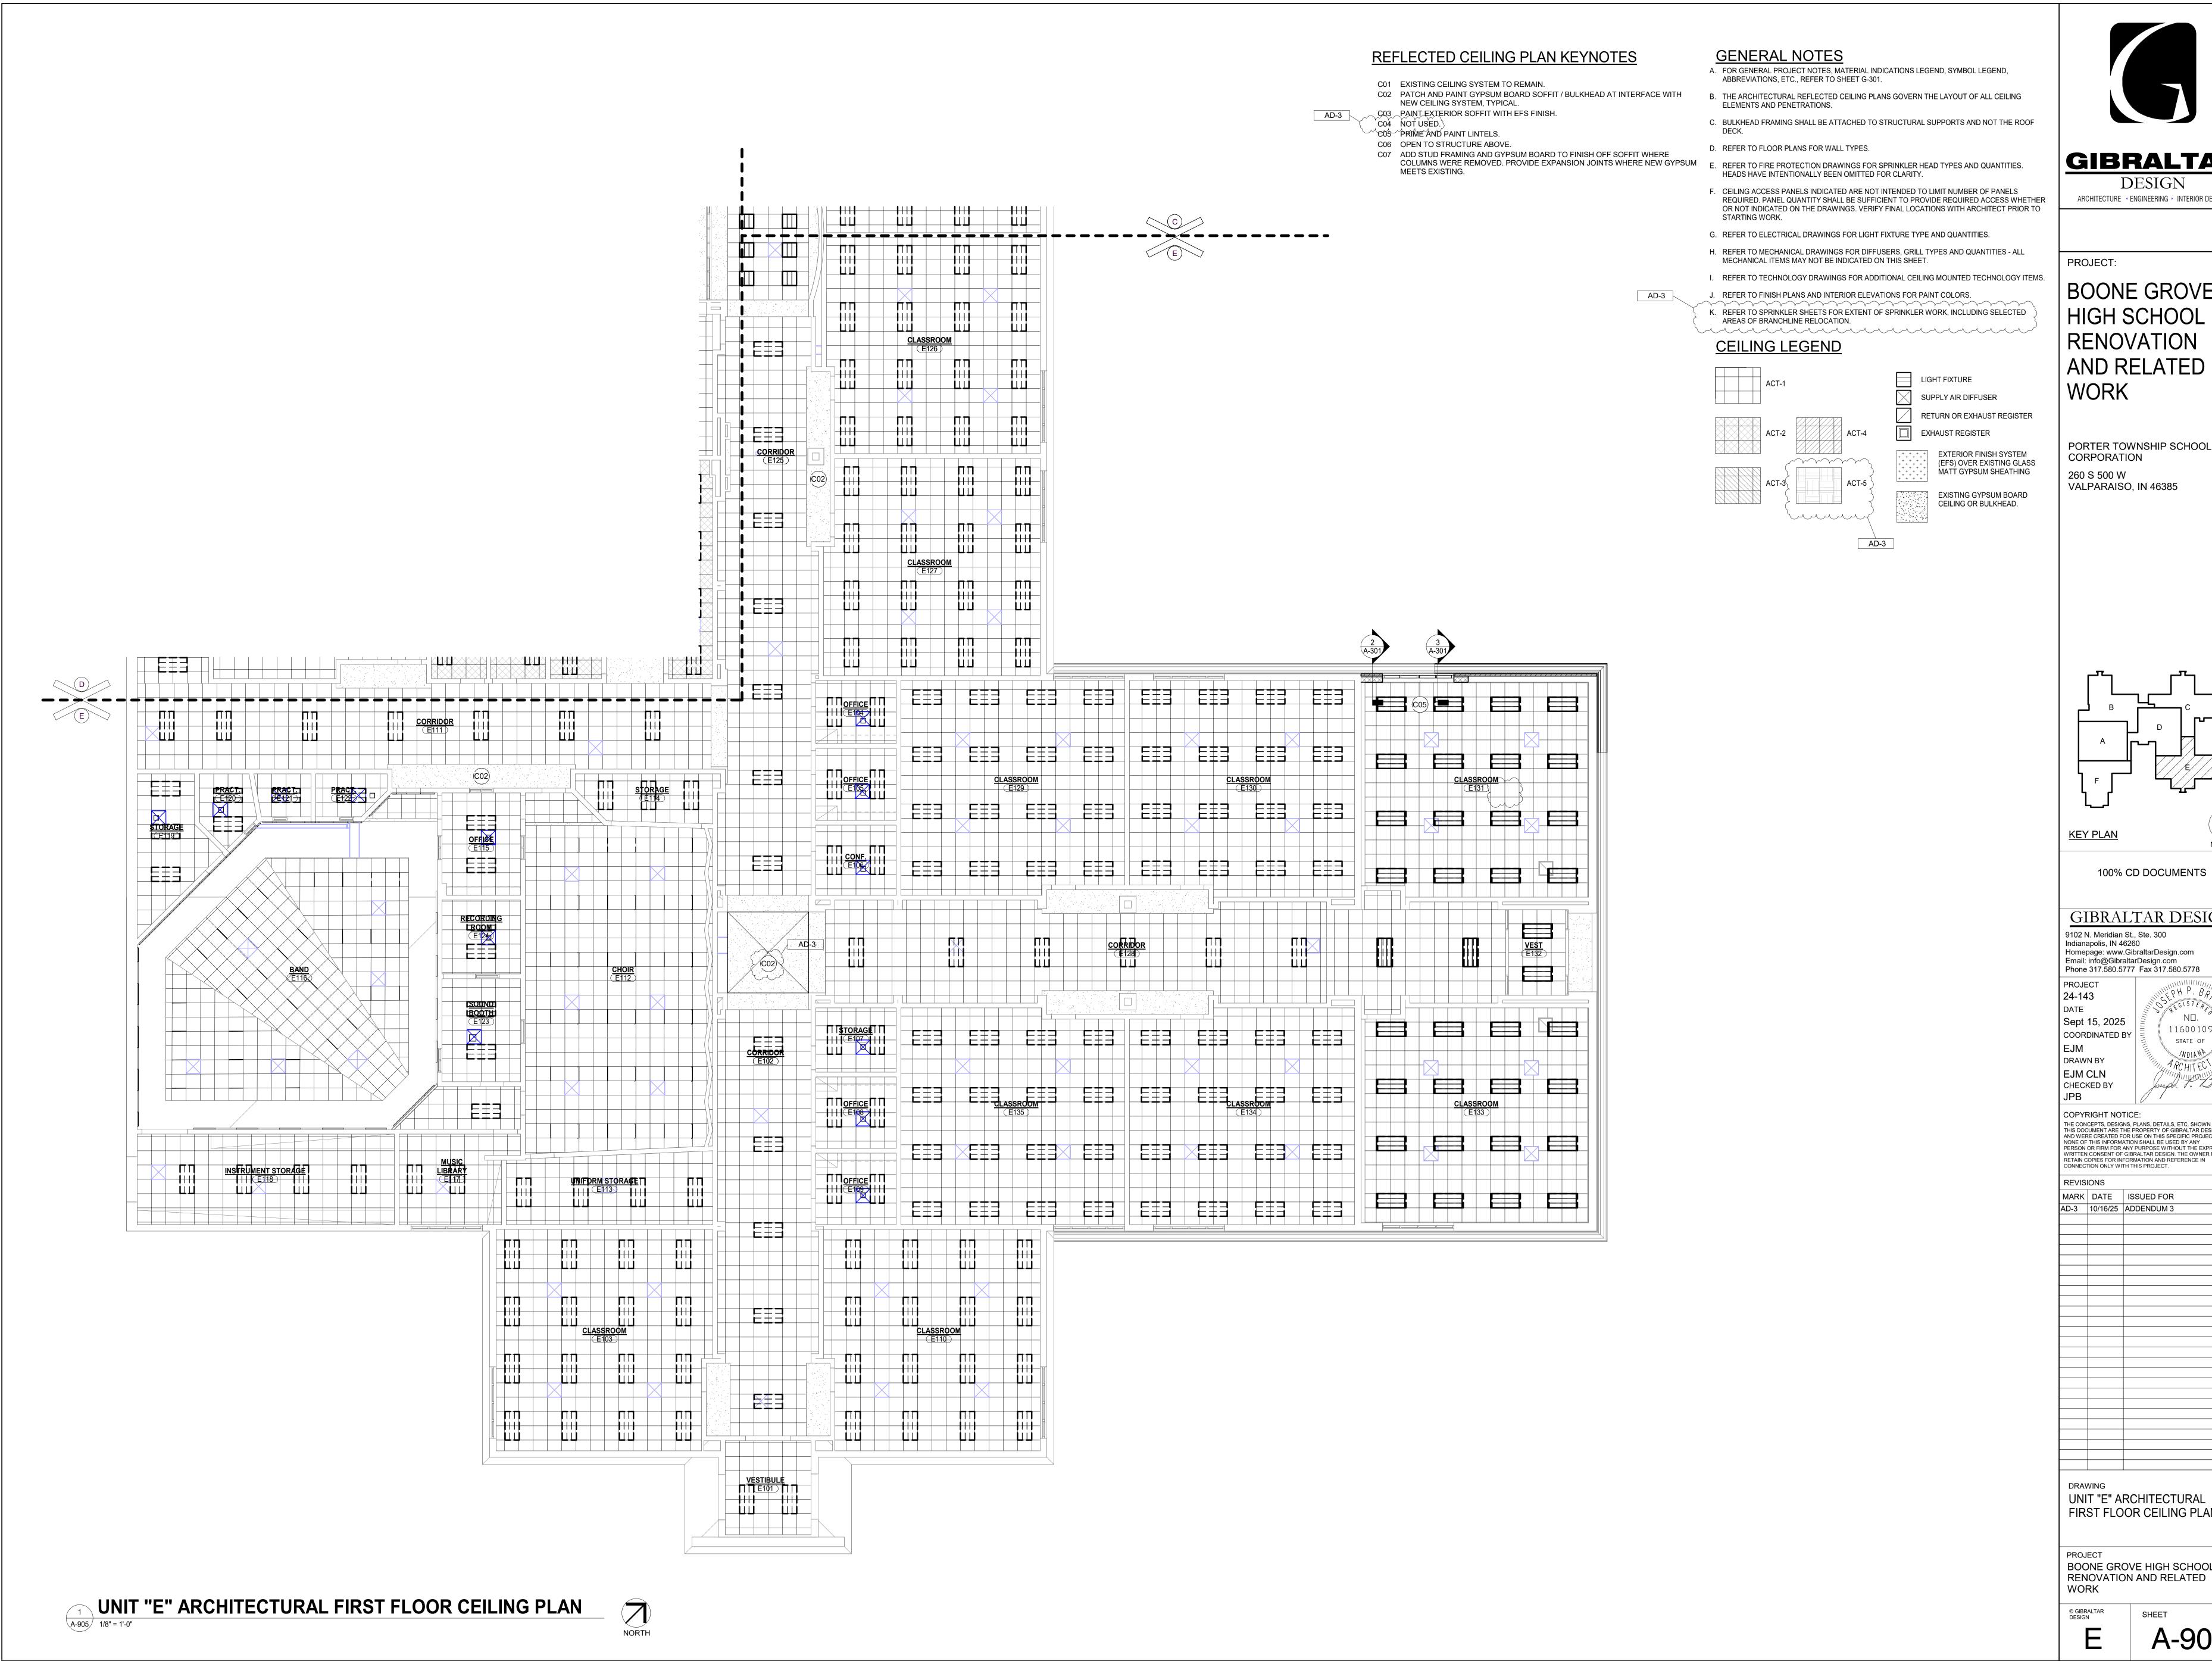

**GIBRALTAR** DESIGN ARCHITECTURE • ENGINEERING • INTERIOR DESIGN

**BOONE GROVE** HIGH SCHOOL RENOVATION AND RELATED WORK

PORTER TOWNSHIP SCHOOL CORPORATION

VALPARAISO, IN 46385

100% CD DOCUMENTS

GIBRALTAR DESIGN 9102 N. Meridian St., Ste. 300 Indianapolis, IN 46260
Homepage: www.GibraltarDesign.com
Email: info@GibraltarDesign.com
Phone 317.580.5777 Fax 317.580.5778

11600109

THE CONCEPTS, DESIGNS, PLANS, DETAILS, ETC, SHOWN ON THIS DOCUMENT ARE THE PROPERTY OF GIBRALTAR DESIGN AND WERE CREATED FOR USE ON THIS SPECIFIC PROJECT. NONE OF THIS INFORMATION SHALL BE USED BY ANY PERSON OR FIRM FOR ANY PURPOSE WITHOUT THE EXPRESS WRITTEN CONSENT OF GIBRALTAR DESIGN. THE OWNER MAY

MARK DATE ISSUED FOR AD-3 10/16/25 ADDENDUM 3

UNIT "E" ARCHITECTURAL FIRST FLOOR CEILING PLAN

BOONE GROVE HIGH SCHOOL RENOVATION AND RELATED

A-905



- PROVIDE NEW THERMOSTAT AND ASSOCIATED CONTROL WIRING, ETC. COMPLETE AS REQUIRED. 2. EXISTING SUPPLY AIR DIFFUSER TO REMAIN. INSPECT AND CLEAN EXISTING DIFFUSER COMPLETE AS REQUIRED. BALANCE EXISTING SUPPLY AIR DIFFUSER TO AIRFLOW QUANTITY
- PROVIDE NEW DDC CONTROLS, WIRING, ETC. ON EXISTING EXHAUST FAN COMPLETE AS REQUIRED. PROGRAM SEQUENCE, SCHEDULE, AND ALARMS COMPLETE AS REQUIRED AND TEST OPERATION.


INDICATED ON PLAN.





BOONE GROVE HIGH SCHOOL RENOVATION AND RELATED WORK

PORTER TOWNSHIP SCHOOL CORPORATION 260 S 500 W VALPARAISO, IN 46385

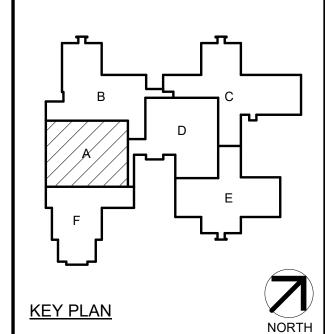

100% CONSTRUCTION SET

## GIBRALTAR DESIGN 9102 N. Meridian St., Ste. 300

Indianapolis, IN 46260
Homepage: www.GibraltarDesign.com
Email: info@GibraltarDesign.com
Phone 317.580.5777 Fax 317.580.5778 PROJECT

24-143 Sept 15, 2025 COORDINATED BY DRAWN BY


CHECKED BY COPYRIGHT NOTICE: THE CONCEPTS, DESIGNS, PLANS, DETAILS, ETC, SHOWN ON THIS DOCUMENT ARE THE PROPERTY OF GIBRALTAR DESIGN AND WERE CREATED FOR USE ON THIS SPECIFIC PROJECT. NONE OF THIS INFORMATION SHALL BE USED BY ANY PERSON OR FIRM FOR ANY PURPOSE WITHOUT THE EXPRESS WRITTEN CONSENT OF GIBRALTAR DESIGN. THE OWNER MAY RETAIN COPIES FOR INFORMATION AND REFERENCE IN CONNECTION ONLY WITH THIS PROJECT.

REVISIONS

MARK DATE ISSUED FOR AD-3 10/16/25 ADDENDUM NO. 3

UNIT "A" MECHANICAL MEZZANINE PLAN

BOONE GROVE HIGH SCHOOL RENOVATION AND RELATED

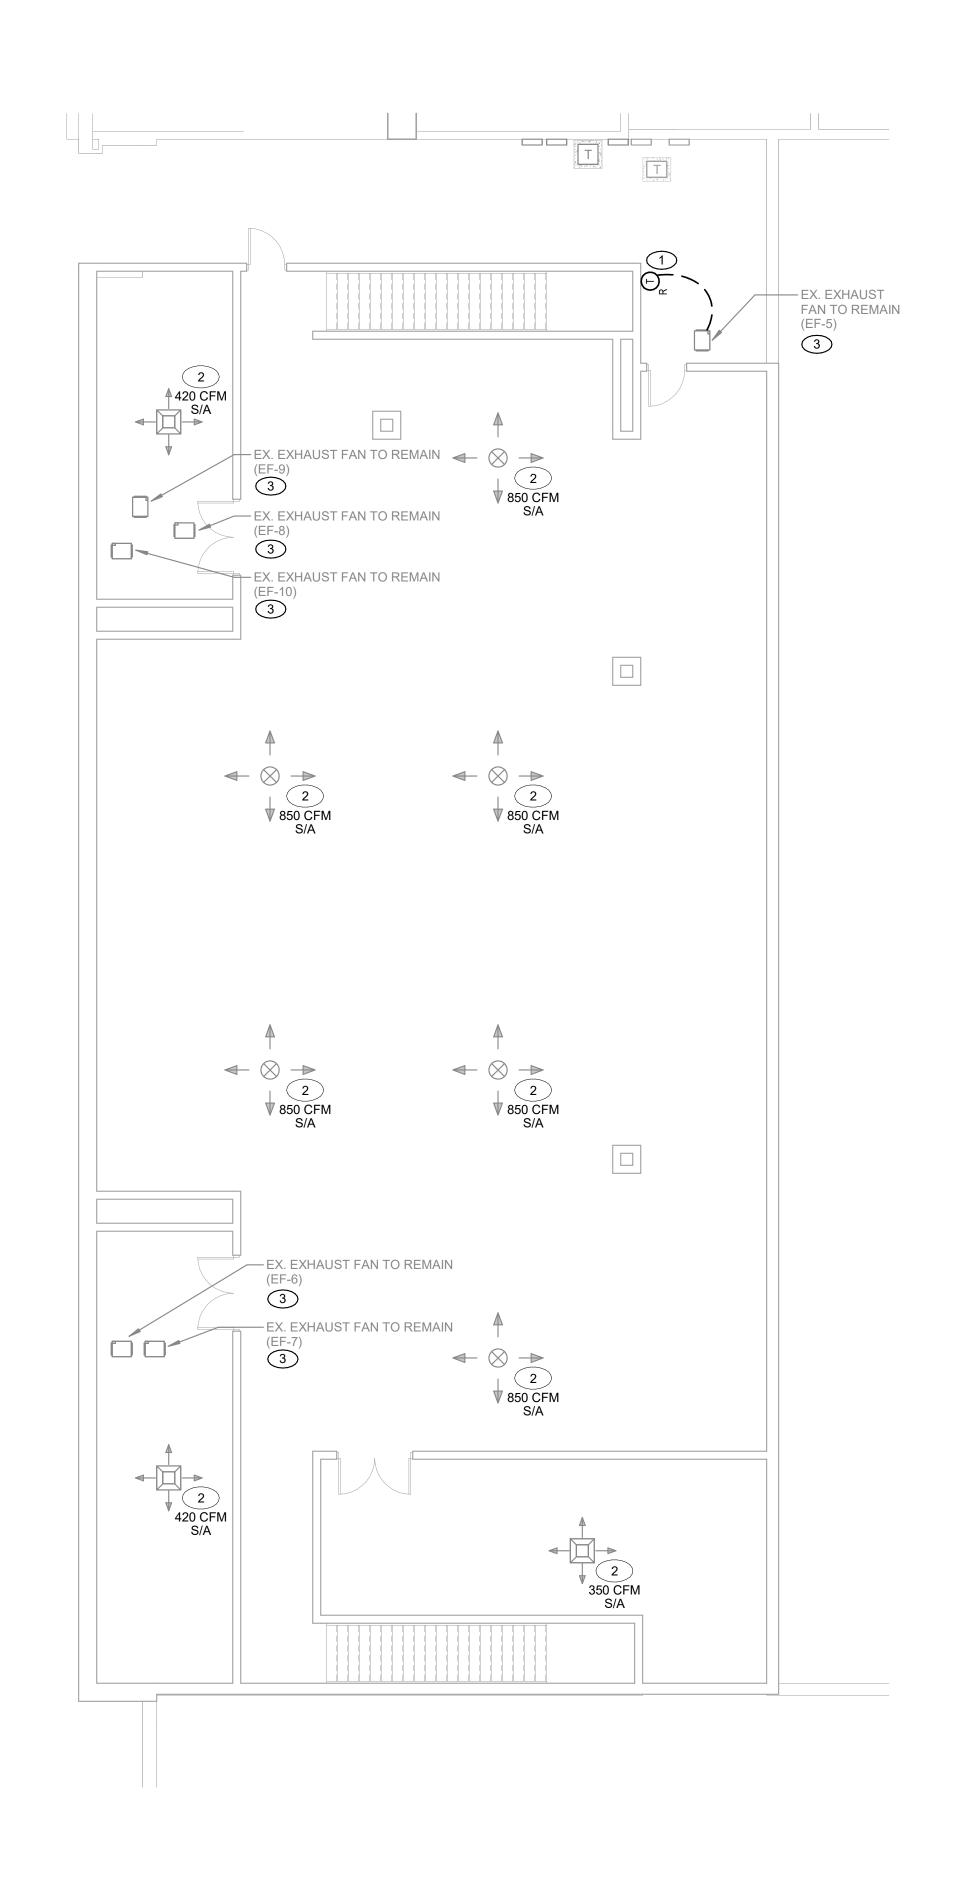


UNIT "A" MECHANICAL MEZZANINE PLAN

1/8" = 1'-0"

MANUFACTURER. — EQUIPMENT SUPPORT (TYPICAL). PROVIDE EVERY 4'0" ON CENTER. — MAKE-UP AIR UNIT PROVIDE WITH SINGLE SIDE ACCESS OPTION. ---- 32x26 S/A DN THRU ROOF IN CURB - SLOPED ROOF COMBINATION EXHAUST FAN / MAU CURB SLOPED ROOF COMBINATION EXHAUST FAN / MAU CURB 26x26 EXH DN THRU ROOF IN CURB UNIT "B" MECHANICAL ROOF PLAN

1/8" = 1'-0" manne a manne a

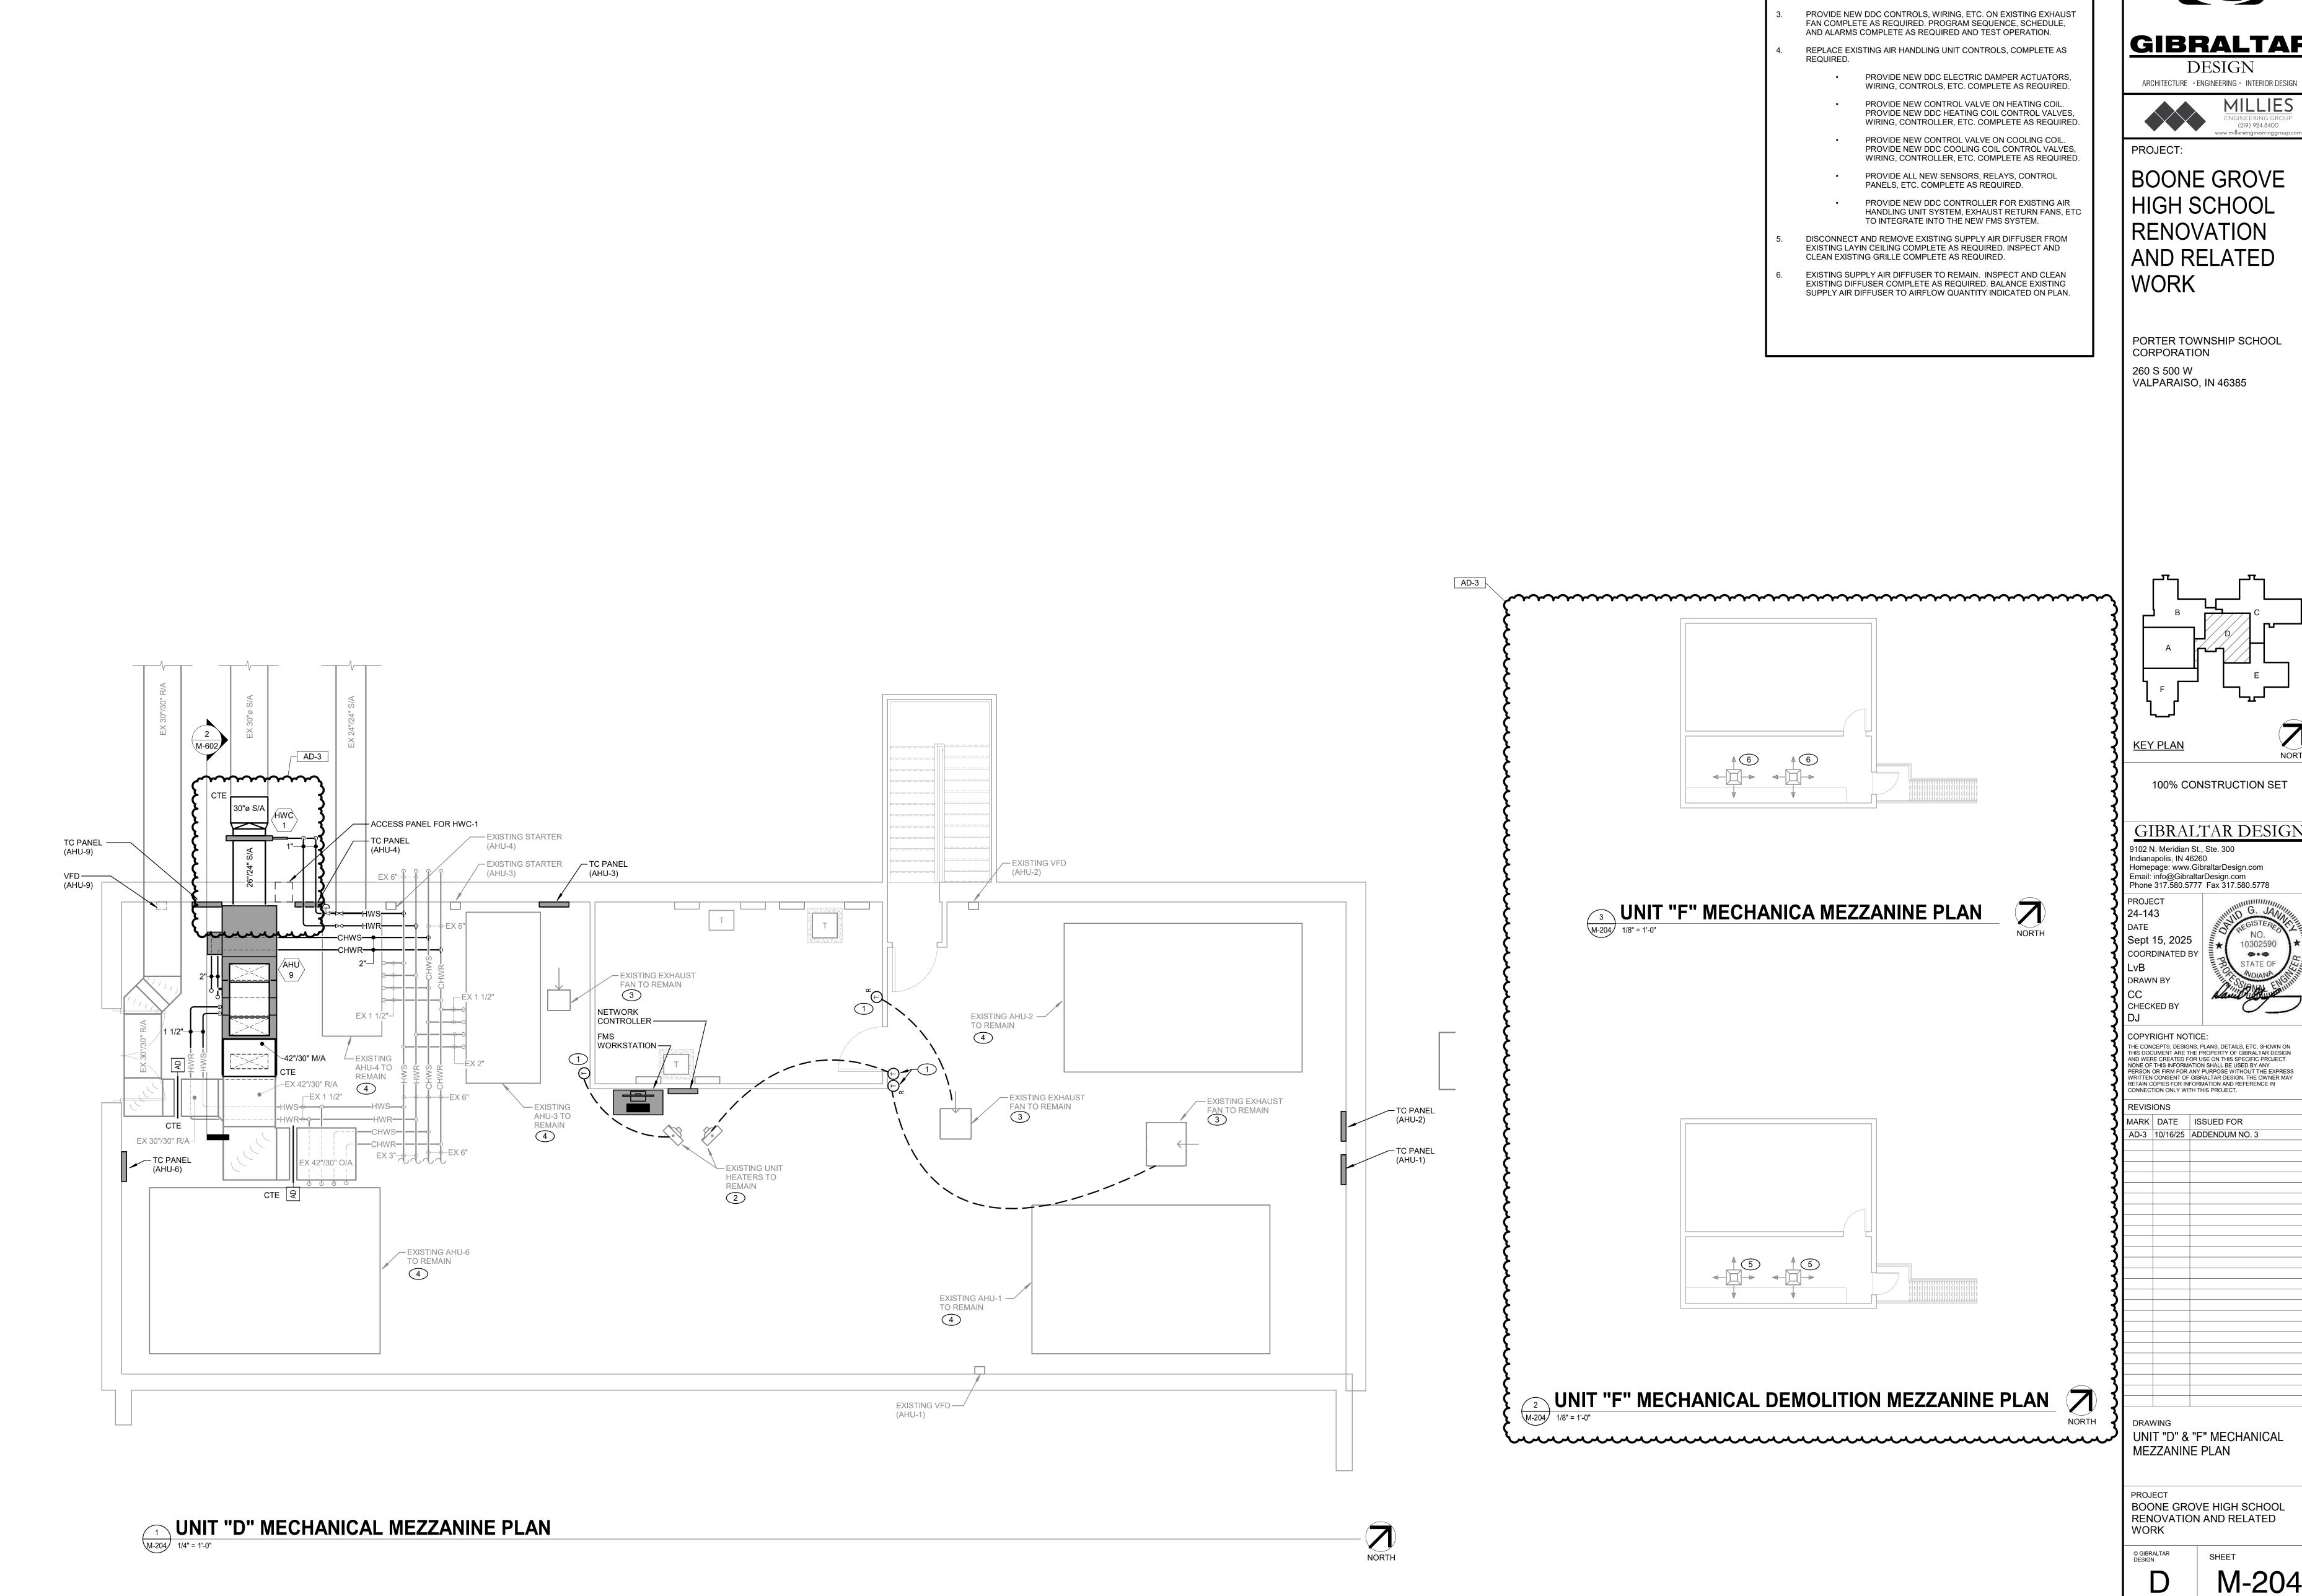



PROVIDE NEW THERMOSTAT AND ASSOCIATED CONTROL WIRING, ETC. COMPLETE AS REQUIRED.


PROVIDE NEW HYDRONIC CONTROL VALVE AND ASSOCIATED CONTROL WIRING, ETC. COMPLETE AS REQUIRED. CONNECT NEW CONTROL VALVE TO ASSOCIATED HYDRONIC PIPING.

GIBRALTAR DESIGN

(219) 924-8400

BOONE GROVE HIGH SCHOOL RENOVATION

PORTER TOWNSHIP SCHOOL

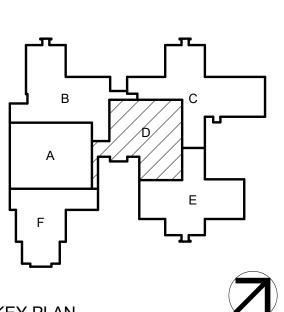

NORTH

100% CONSTRUCTION SET

GIBRALTAR DESIGN 9102 N. Meridian St., Ste. 300

Homepage: www.GibraltarDesign.com Email: info@GibraltarDesign.com Phone 317.580.5777 Fax 317.580.5778

THE CONCEPTS, DESIGNS, PLANS, DETAILS, ETC, SHOWN ON THIS DOCUMENT ARE THE PROPERTY OF GIBRALTAR DESIGN AND WERE CREATED FOR USE ON THIS SPECIFIC PROJECT. NONE OF THIS INFORMATION SHALL BE USED BY ANY PERSON OR FIRM FOR ANY PURPOSE WITHOUT THE EXPRESS WRITTEN CONSENT OF GIBRALTAR DESIGN. THE OWNER MAY RETAIN COPIES FOR INFORMATION AND REFERENCE IN CONNECTION ONLY WITH THIS PROJECT.

AD-3 10/16/25 ADDENDUM NO. 3

UNIT "D" & "F" MECHANICAL

						FAN MOTO	OR DATA			EXHAUST FA	ANS	GAS	FIRED HEATING EQUIPM		IT DATA	CHILLED WATER COOLING EQUIPMENT/COIL		DATA		HOT WATER HEATING EQ	UIPMENT/CC	DIL DATA	ELECTRICAL DATA									
					O.A.I.																				LOAD				STARTER:			
TAG	MANUFACTURER	MODEL	DESCRIPTION	EFFICIENCY	CFM CFM	TSP ES	Р ВНР	HP RPM	CFM E	SP BHP	HP R	MBH PM (IN)	MBH (OUT) EA	T LAT	STAGES	MBH SHC GPM	EDB EWB	LDB LWB EWT LV	MAX   WT APD WPD CA	T CFM	MBH MBH   GPM EAT	LAT EWT	LWT APD	1	MCA FLA	MOCP VOL	T PHASI	E HZ	PROV. BY:	UNITS CONTROLLED BY	EQUIPMEN WEIGHT	
AHU-9	TRANE	CSAA006	SUSPENDED AIR HANDELING UNIT		3410 900	8.5	7.3	7.5 3600								142.87 98.45 28.47	7 79.2 66.5	53 52.63 45 5	55 95	3410 CFM	110.5 11.08 50.1	80 140	120		14	20 480	0 3	60	Х	TSTAT	1550	NOT
MAU-1	GREENHECK	DGX-P118-H12-D1-8	ROOF MOUNTED GAS FIRED MAKEUP AIR UNIT		4334 4334	1.8 1		3 1725				376.5	346.4 -4	70											6	15 480	0 3	60	Х	INTERLOCK TO H-1	1558	ГОИ
H-1	GREENHECK	GHEW-264.00-S	KITCHEN EXHAUST HOOD	)					4334																	15 120	0 1	60	Х	HOOD SWITCH	800	NO
(EF-1	GREENHECK	CUE-200-VG	ROOF MOUNTED KITCHEN EXHAUST FAN	1					4334 1	1.5 2.06	3 13	350													4.3	15 480	0 3	60	Х	INTERLOCK TO H-1	250	NO
CU-1	MITSUBISHI	TRUYA0241HA70NA	GRADE MOUNTED CONDENSING UNIT	21.4 SEER																					19	25 208	8 1	60	Х	INTERLOCK TO AC-1	151	NO
KC-Y	MATS DESIGNATION	NFRAGANZANGANGAN	WALL MOUNTED COOLING UNIT	٠٠٠٠	635 <b>1</b>	~~~	~~	`\																		208	8 1	60	Х	TSTAT	46	NO
OVIDE WACHARGION OF MATER TEINSCHARGIVE FOR SERVICE OF MATER TEINSCHARGIVE FOR SERVICE OF SERVICE O	ICATIONS FOR ADD ITH REHEAT COIL D I NOMINAL COIL HE COIL SHALL PROVI 5 F TO 70 F AIR TEM IPERATURE DROP A I OPENING OF AHU IRAIGHT DUCT CON	IPERATURE RISE, 140 AT 5.6 GPM. SHALL MATCH REHEA INECTION. REHEAT CO	NAL REQUIREMENTS.  NAL REQUIREME				PR D	<ul> <li>BIRD S</li> <li>OUT C</li> <li>PIANC</li> <li>SAFET</li> <li>VENTI</li> </ul>	HINGES TY RETAINER ( LATED ROOF (	MOTOR w/ ENCLOS	SEE SPE	LC CA WI HA CC	OW AMBIENT CONTROLS FO APACITY DOWN TO -10°F IND BAFFLES AIL GUARDS ONCRETE EQUIPMENT PAD ONS FOR ADDITIONAL REQU		OOLING		WIRED THE CONDENSA	ATE PUMP	REQUIRE	EMENTS.												

	>					N	ИΕ	СН	ANI	IC/	AL E	EQU	IPME	NT SCHEDULE - PUMPS
									ECTRICAL	L DATA				
							PUMP	MOTOR D	AIA			RTER: DV. BY:	SUCTION/	
TAG	MANUFACTURER	MODEL	DESCRIPTION	GPM	HEAD (FT.)	HP	RPM	VOLT	PHASE	HZ -	M.C.	E.C.	DISCHARGE SIZE	REMARKS
P-1	BELL & GOSSET	1510: 2AD	HOT WATER BASE MOUNTED END SUCTION PUMP	285	90	15	1750	480		60	X		2½" / 2"	PROVIDE WITH BELL & GOSSET EC-3X SUCTION DIFFUSER AND BELL & GOSSETT 3D-4S TRIPPLE DUTY VALVE
P-2	BELL & GOSSET	1510: 2AD	HOT WATER BASE MOUNTED END SUCTION PUMP	285	90	15	1750	480	3	60	Х		2½" / 2"	PROVIDE WITH BELL & GOSSET EC-3X SUCTION DIFFUSER AND BELL & GOSSETT 3D-4S TRIPPLE DUTY VALVE
P-3	BELL & GOSSET	1510: 3AD	HOT WATER BASE MOUNTED END SUCTION PUMP	285	40	5	1750	480	3	60	Х		4" / 3"	PROVIDE WITH BELL & GOSSET EE-3X SUCTION DIFFUSER AND BELL & GOSSETT 3D-4S TRIPPLE DUTY VALVE
P-4	BELL & GOSSET	1510: 3AD	HOT WATER BASE MOUNTED END SUCTION PUMP	285	40	5	1750	480	3	60	Х		4" / 3"	PROVIDE WITH BELL & GOSSET EE-3X SUCTION DIFFUSER AND BELL & GOSSETT 3D-4S TRIPPLE DUTY VALVE
P-7	BELL & GOSSET	1510: 3BD	COLD WATER BASE MOUNTED END SUCTION PUMP	350	80	15	1750	480	3	60	Х		4" / 3"	PROVIDE WITH BELL & GOSSET GE-3X SUCTION DIFFUSER AND BELL & GOSSETT 3D-4S TRIPPLE DUTY VALVE
P-8	BELL & GOSSET	1510: 3BD	COLD WATER BASE MOUNTED END SUCTION PUMP	350	80	15	1750	480	3	60	Х		4" / 3"	PROVIDE WITH BELL & GOSSET GE-3X SUCTION DIFFUSER AND BELL & GOSSETT 3D-4S TRIPPLE DUTY VALVE
P-9	BELL & GOSSET	1510: 4BD	COLD WATER BASE MOUNTED END SUCTION PUMP	700	40	10	1750	480	3	60	Х		5" / 4"	PROVIDE WITH BELL & GOSSET GF-3X SUCTION DIFFUSER AND BELL & GOSSETT 3D-6S TRIPPLE DUTY VALVE
P-10	BELL & GOSSET	1510: 4BD	COLD WATER BASE MOUNTED END SUCTION PUMP	700	40	10	1750	480	3	60	Х		5" / 4"	PROVIDE WITH BELL & GOSSET GF-3X SUCTION DIFFUSER AND BELL & GOSSETT 3D-6S TRIPPLE DUTY VALVE

TAG	MANUFACTURER	MODEL	INLET	CFM SET	TING	HW RE	HEAT C	OIL DA	TA	CONTROL SE	QUENCE	REMARKS
			DIA.	MAX. CFM	MIN. CFM	МВН	GPM	WPD	EWT	OPEN/ CLOSED	OPEN/CLOSED/ OPEN	
2-1	NAILOR	D30RW-10	10"	960	285	31.2	3.1	5'	180	-	Х	-
2-2	NAILOR	D30RW-10	10"	960	285	31.2	3.1	5'	180	-	X	-
2-3	NAILOR	D30RW-10	10"	1,125	330	36.6	3.7	5'	180	-	X	-
2-4	NAILOR	D30RW-10	10"	1,050	310	34.2	3.4	5'	180	-	X	-
2-5	NAILOR	D30RW-10	10"	840	245	27.3	2.7	5'	180	-	X	-
2-6	NAILOR	D30RW-10	10"	1,110	325	36.1	3.6	5'	180	-	X	-
2-7	NAILOR	D30RW-06	6"	340	100	9.2	0.9	5'	180	X	-	-
2-8	NAILOR	D30RW-10	10"	960	285	31.2	3.1	5'	180	_	X	-
2-9	NAILOR	D30RW-10	10"	965	285	31.4	3.1	5'	180	_	X	-
2-10	NAILOR	D30RW-10	10"	925	270	30.1	3.0	5'	180	_	X	-
2-11	NAILOR	D30RW-10	10"	875	260	28.5	2.8	5'	180	-	X	-
2-12	NAILOR	D30RW-05	5"	175	50	4.7	0.5	5'	180	X	-	-
2-13	NAILOR	D30RW-12	12"	1,385	410	45.1	4.5	5'	180	_	X	-
2-14	NAILOR	D30RW-10	10"	835	245	27.2	2.7	5'	180	_	X	-
2-15	NAILOR	D30RW-10	10"	840	245	27.3	2.7	5'	180	_	X	-
2-16	NAILOR	D30RW-06	6"	300	90	8.1	0.8	5'	180	X	_	_
2-17	NAILOR	D30RW-10	10"	830	245	27.0	2.7	5'	180	_	X	-
2-18	NAILOR	D30RW-10	10"	900	265	24.4	2.4	5'	180	X	-	-
2-19	NAILOR	D30RW-10	10"	840	245	22.8	2.3	5'	180	X	_	-
2-20	NAILOR	D30RW-10	10"	1,040	305	28.2	2.8	5'	180	X	_	-
2-21	NAILOR	D30RW-08	8"	735	215	19.9	2.0	5'	180	X	_	-
2-22	NAILOR	D30RW-08	8"	600	175	16.3	1.6	5'	180	X	-	-
2-23	NAILOR	D30RW-05	5"	200	60	5.4	0.5	5'	180	X	_	-
2-24	NAILOR	D30RW-12	12"	1,310	385	42.6	4.3	5'	180	-	X	-
2-25	NAILOR	D30RW-12	12"	1,435	425	46.7	4.7	5'	180	_	X	<u>-</u>
2-26	NAILOR	D30RW-05	5"	215	65	5.8	0.6	5'	180	X	-	<u>-</u>
2-27	NAILOR	D30RW-10	10"	960	285	31.2	3.1	5'	180	-	X	-
2-28	NAILOR	D30RW-10	10"	915	270	29.8	3.0	5'	180	_	X	-
2-29	NAILOR	D30RW-05	5"	150	45	4.9	0.5	5'	180	_	X	-
2-30	NAILOR	D30RW-06	6"	300	90	8.1	0.8	5'	180	X	-	-
2-31	NAILOR	D30RW-06	6"	300	90	8.1	0.8	5'	180	X	-	-
2-32	NAILOR	D30RW-07	7"	450	135	14.6	1.5	5'	180	-	X	-
2-33	NAILOR	D30RW-06	6"	300	90	8.1	0.8	5'	180	X	-	<u>-</u>
2-34	NAILOR	D30RW-06	6"	300	90	9.8	1.0	5'	180	-	X	-
2-35	NAILOR	D30RW-06	6"	300	90	8.1	0.8	5'	180	X	-	-
2-36	NAILOR	D30RW-12	12"	1,400	410	45.6	4.6	5'	180	-	X	-
2-37	NAILOR	D30RW-12	12"	1,400	410	45.6	4.6	5'	180	_	X	

TA 6	MANUEL OT: :===										DULE	DE
TAG	MANUFACTURER	MODEL	INLET	CFM SET	TING	HW RE	HEAT CO	JIL DA	ΛΓA	CONTROL SE	QUENCE	REMARKS
			DIA.	MAX	MIN	MBH	GPM	WPD	EWT	OPEN/	OPEN/CLOSED/	
				CFM	CFM					CLOSED	OPEN	
1-1	NAILOR	D30RW-10	10"	1,045	360	34.0	3.4	5'	180	-	X	-
1-2	NAILOR	D30RW-08	8"	760	260	24.7	2.5	5'	180	-	X	-
1-3	NAILOR	D30RW-10	10"	995	340	32.4	3.2	5'	180	-	X	-
1-4	NAILOR	D30RW-10	10"	995	340	32.4	3.2	5'	180	-	X	-
1-5	NAILOR	D30RW-10	10"	885	305	28.8	2.9	5'	180	-	X	-
1-6	NAILOR	D30RW-10	10"	825	285	26.9	2.7	5'	180	-	X	-
1-7	NAILOR	D30RW-08	8"	625	215	20.3	2.0	5'	180	-	X	-
1-8	NAILOR	D30RW-05	5"	250	85	6.8	0.7	5'	180	Х	-	-
1-9	NAILOR	D30RW-05	5"	280	95	7.6	0.8	5'	180	Х	-	-
1-10	NAILOR	D30RW-10	10"	970	335	31.6	3.2	5'	180	-	Х	-
1-11	NAILOR	D30RW-10	10"	970	335	31.6	3.2	5'	180	-	Х	-
1-12	NAILOR	D30RW-10	10"	1,200	410	32.6	3.3	5'	180	Х	-	-
1-13	NAILOR	D30RW-06	6"	325	110	8.8	0.9	5'	180	Х	-	-
1-14	NAILOR	D30RW-12	12"	1,530	525	49.8	5.0	5'	180	-	X	-
1-15	NAILOR	D30RW-06	6"	300	105	8.1	0.8	5'	180	Х	-	-
1-16	NAILOR	D30RW-06	6"	300	105	8.1	0.8	5'	180	Х	-	-
1-17	NAILOR	D30RW-07	7"	550	190	14.9	1.5	5'	180	Х	-	-
1-18	NAILOR	D30RW-06	6"	300	105	8.1	0.8	5'	180	Х	-	-
1-19	NAILOR	D30RW-08	8"	800	275	21.7	2.2	5'	180	Х	-	-
1-20	NAILOR	D30RW-06	6"	300	105	9.8	1.0	5'	180	-	X	-
1-21	NAILOR	D30RW-12	12"	1,800	620	58.6	5.9	5'	180	-	X	-
1-22	NAILOR	D30RW-12	12"	1,800	620	58.6	5.9	5'	180	-	X	-
1-23	NAILOR	D30RW-08	8"	750	255	24.4	2.4	5'	180	-	X	-
1-24	NAILOR	D30RW-08	8"	600	205	19.5	2.0	5'	180	-	X	-
1-25	NAILOR	D30RW-12	12"	1,640	565	44.5	4.4	5'	180	Х	-	-
1-26	NAILOR	D30RW-05	5"	200	70	5.4	0.5	5'	180	Х	-	-
1-27	NAILOR	D30RW-06	6"	300	105	8.1	0.8	5'	180	Х	-	-
1-28	NAILOR	D30RW-10	10"	1,100	380	29.8	3.0	5'	180	Х	-	-
1-29	NAILOR	D30RW-10	10"	1,000	345	27.1	2.7	5'	180	X	-	_

TAG	MANUFACTURER	MODEL	INLET	CFM SET	TING	HW RE	HEAT C	OIL DA	TA	CONTROL SE	QUENCE		REMARKS
			DIA.	MAX CFM	MIN CFM	МВН	GPM	WPD	EWT	OPEN/ CLOSED	OPEN/CLOSE	D/	
3-2	NAILOR	D30RW-12	12"	1,545	260	50.3	5.0	5'	180	-	Х	-	
3-3	NAILOR	D30RW-12	12"	1,470	245	47.8	4.8	5'	180	-	Х	-	
3-4	NAILOR	D30RW-07	7"	425	70	13.8	1.4	5'	180	-	Х	-	
3-5	NAILOR	D30RW-05	5"	220	35	6.0	0.6	5'	180	Х	-	-	
3-6	NAILOR	D30RW-07	7"	415	70	11.3	1.1	5'	180	Х	-	-	
3-7	NAILOR	D30RW-05	5"	275	45	7.5	0.7	5'	180	Х	-	-	
3-8	NAILOR	D30RW-05	5"	260	45	7.1	0.7	5'	180	Х	-	-	
3-9	NAILOR	D30RW-07	7"	425	70	11.5	1.2	5'	180	Х	-	-	
3-10	NAILOR	D30RW-07	7"	425	70	11.5	1.2	5'	180	Х	-	-	
3-11	NAILOR	D30RW-08	8"	620	105	16.8	1.7	5'	180	Х	-	-	



GIBRALTAR DESIGN

BOONE GROVE HIGH SCHOOL RENOVATION AND RELATED WORK

PORTER TOWNSHIP SCHOOL CORPORATION 260 S 500 W VALPARAISO, IN 46385

100% CONSTRUCTION SET

GIBRALTAR DESIGN 9102 N. Meridian St., Ste. 300 Indianapolis, IN 46260
Homepage: www.GibraltarDesign.com
Email: info@GibraltarDesign.com
Phone 317.580.5777 Fax 317.580.5778

PROJECT 24-143 Sept 15, 2025 COORDINATED BY DRAWN BY CHECKED BY

COPYRIGHT NOTICE: THE CONCEPTS, DESIGNS, PLANS, DETAILS, ETC, SHOWN ON THIS DOCUMENT ARE THE PROPERTY OF GIBRALTAR DESIGN AND WERE CREATED FOR USE ON THIS SPECIFIC PROJECT. NONE OF THIS INFORMATION SHALL BE USED BY ANY PERSON OR FIRM FOR ANY PURPOSE WITHOUT THE EXPRESS WRITTEN CONSENT OF GIBRALTAR DESIGN. THE OWNER MAY RETAIN COPIES FOR INFORMATION AND REFERENCE IN CONNECTION ONLY WITH THIS PROJECT.


REVISIONS MARK DATE ISSUED FOR


AD-3 10/16/25 ADDENDUM NO. 3

MECHANICAL SCHEDULES

PROJECT
BOONE GROVE HIGH SCHOOL
RENOVATION AND RELATED

AD-3

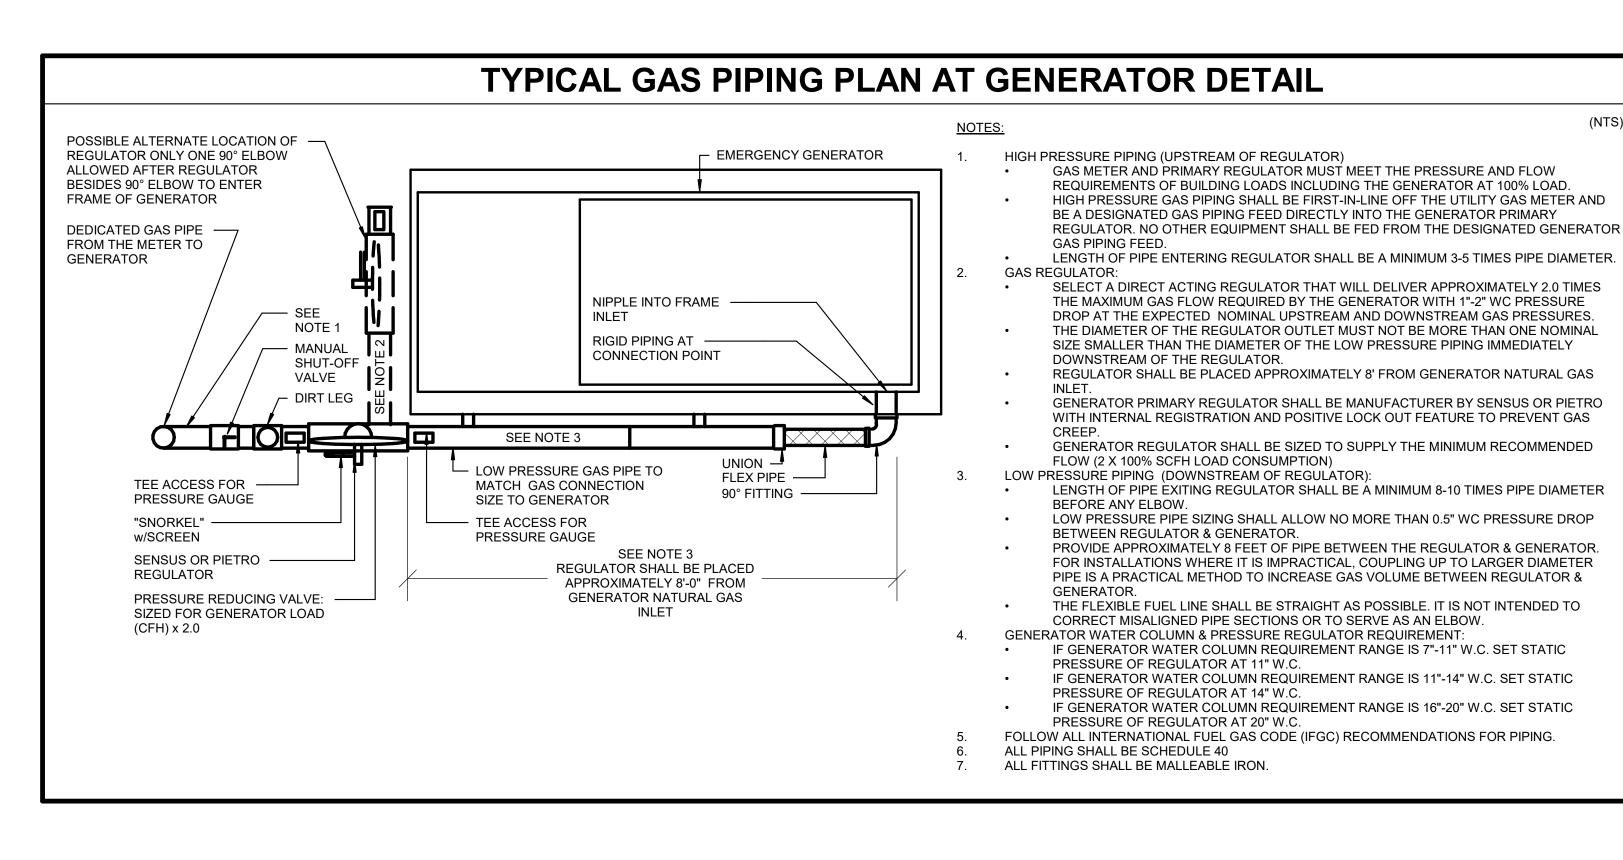

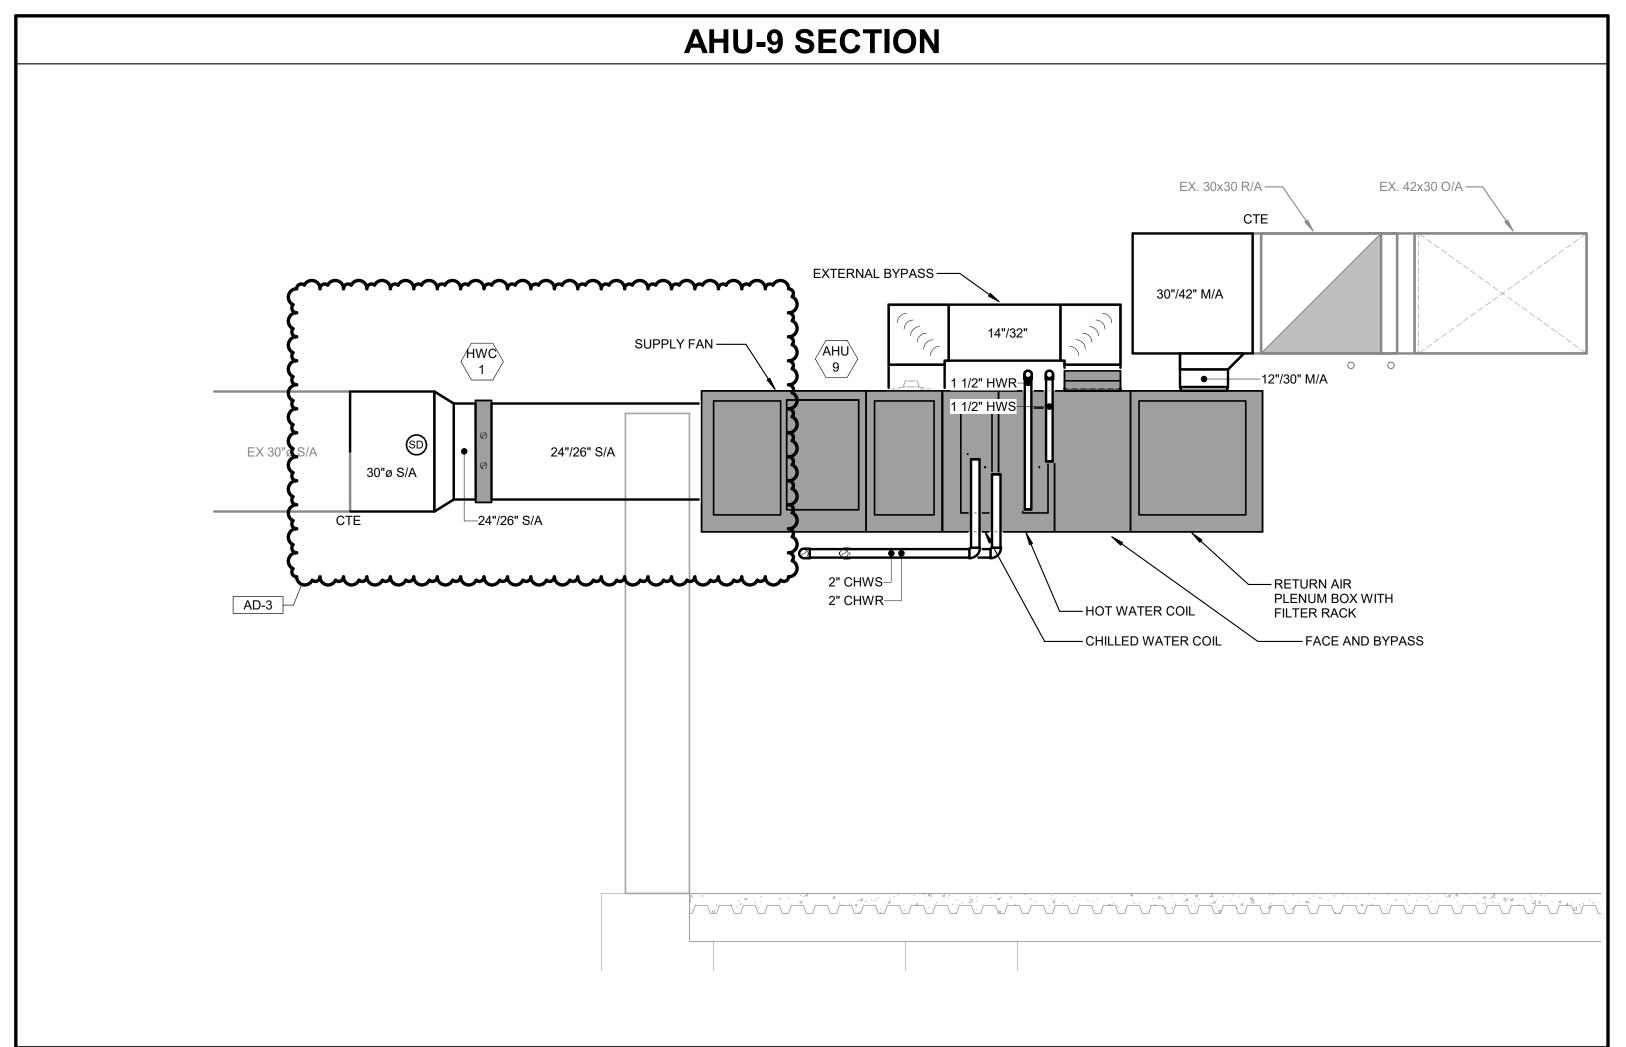



GIBRALTAR DESIGN



ARCHITECTURE • ENGINEERING • INTERIOR DESIGN

PROJECT:

BOONE GROVE HIGH SCHOOL RENOVATION AND RELATED WORK

PORTER TOWNSHIP SCHOOL CORPORATION 260 S 500 W VALPARAISO, IN 46385

100% CONSTRUCTION SET

# GIBRALTAR DESIGN

Indianapolis, IN 46260
Homepage: www.GibraltarDesign.com
Email: info@GibraltarDesign.com
Phone 317.580.5777 Fax 317.580.5778

PROJECT

24-143
DATE
Sept 15, 2025
COORDINATED BY
LVB
DRAWN BY
CC

CHECKED BY
DJ

COPYRIGHT NOTICE:

THE CONCEPTS, DESIGNS, PLANS, DETAILS, ETC, SHOWN ON THIS DOCUMENT ARE THE PROPERTY OF GIBRALTAR DESIGN AND WERE CREATED FOR USE ON THIS SPECIFIC PROJECT. NONE OF THIS INFORMATION SHALL BE USED BY ANY PERSON OR FIRM FOR ANY PURPOSE WITHOUT THE EXPRESS WRITTEN CONSENT OF GIBRALTAR DESIGN. THE OWNER MAY RETAIN COPIES FOR INFORMATION AND REFERENCE IN CONNECTION ONLY WITH THIS PROJECT.

REVISIONS

 MARK
 DATE
 ISSUED FOR

 AD-1
 10/02/25
 ADDENDUM NO. 1

 AD-3
 10/16/25
 ADDENDUM NO. 3

DRAWING
MECHANICAL DETAILS &
DIAGRAMS

PROJECT
BOONE GROVE HIGH SCHOOL
RENOVATION AND RELATED
WORK

© GIBRALTAR

M-602

EXISTING LIGHTING TO BE REMOVED IN AREAS OF CEILING REPLACEMENT. WHERE NECESSARY TO PERFORM MECHANICAL WORK ABOVE EXISTING CEILINGS, REMOVE. STORE, AND REINSTALL EXISTING LIGHTS, MOTION SENSORS, FIRE ALARM DEVICES, AND ANY OTHER CEILING MOUNTED ELECTRICAL DEVICES AS REQUIRED. REVIEW THE ENTIRE SET OF CONTRACT DOCUMENTS IN ORDER TO FULLY UNDERSTAND AND INCLUDE CEILING WORK NECESSARY FOR WORK ON THE PROJECT. WHEN THE WORK IS COMPLETED IN THE SPACE, REINSTALL EXISTING DEVICES AND EQUIPMENT TO COMPLETE MATCH EXISTING CONDITIONS. REPAIR OR REPLACE ANY DAMAGED EQUIPMENT OR DEVICES CAUSED BY THE REMOVAL, STORAGE, AND REINSTALLATION.

## **SHEET NOTES**

DISCONNECT AND REMOVE EXISTING EXIT SIGNS (LABELED AND SHOWN AS 'RN') AND RELATED CIRCUITRY BACK TO NEAREST JUNCTION BOX COMPLETE AS REQUIRED. RETAIN ALL ASSOCIATED WIRING, CONDUIT, ETC. FOR USE WITH NEW EXIT SIGNS.




GIBRALTAR DESIGN ARCHITECTURE • ENGINEERING • INTERIOR DESIGN



BOONE GROVE HIGH SCHOOL RENOVATION AND RELATED WORK

PORTER TOWNSHIP SCHOOL CORPORATION 260 S 500 W VALPARAISO, IN 46385

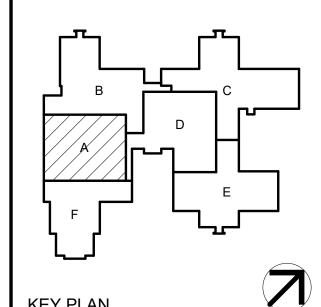

100% CONSTRUCTION SET

GIBRALTAR DESIGN 9102 N. Meridian St., Ste. 300 Indianapolis, IN 46260 Homepage: www.GibraltarDesign.com Email: info@GibraltarDesign.com Phone 317.580.5777 Fax 317.580.5778

24-143 Sept 15, 2025 **COORDINATED BY** 

DRAWN BY CHECKED BY


COPYRIGHT NOTICE: THE CONCEPTS, DESIGNS, PLANS, DETAILS, ETC, SHOWN ON THIS DOCUMENT ARE THE PROPERTY OF GIBRALTAR DESIGN AND WERE CREATED FOR USE ON THIS SPECIFIC PROJECT. NONE OF THIS INFORMATION SHALL BE USED BY ANY WRITTEN CONSENT OF GIBRALTAR DESIGN. THE OWNER MAY RETAIN COPIES FOR INFORMATION AND REFERENCE IN CONNECTION ONLY WITH THIS PROJECT.


REVISIONS

MARK DATE ISSUED FOR AD-3 10/16/25 ADDENDUM NO. 3

UNIT "A" ELECTRICAL FIRST FLOOR DEMOLITION PLAN

BOONE GROVE HIGH SCHOOL RENOVATION AND RELATED

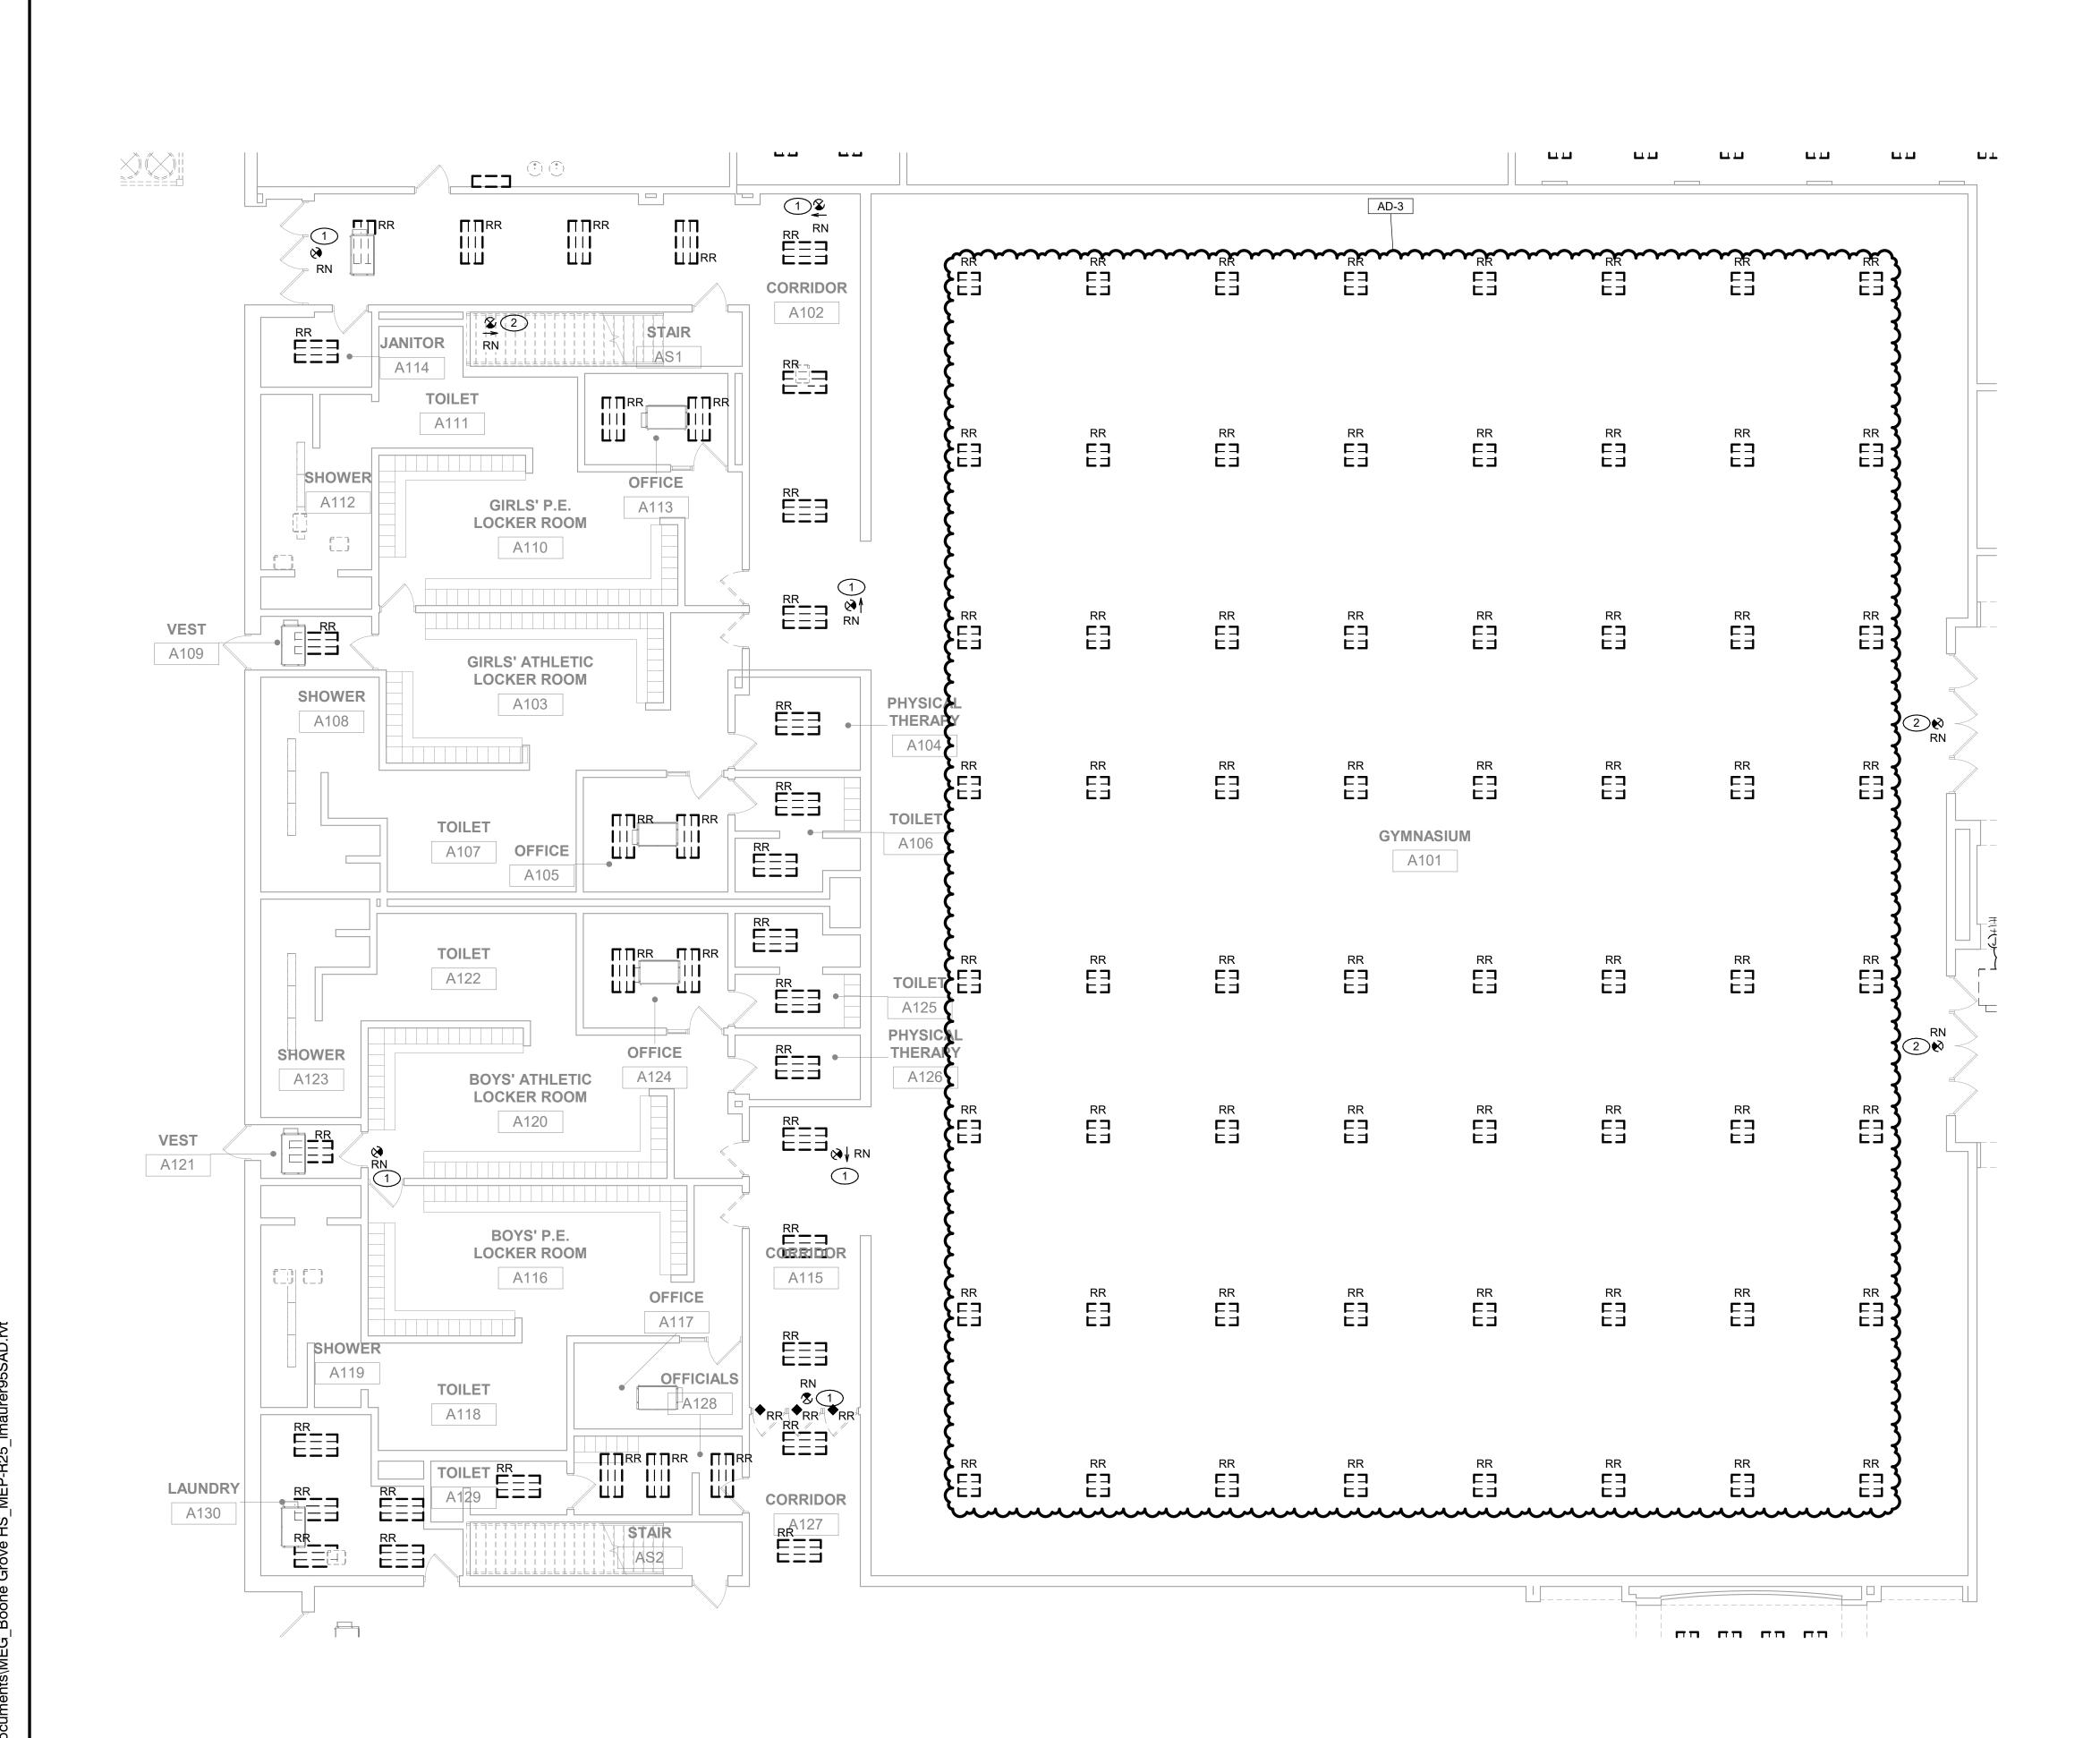


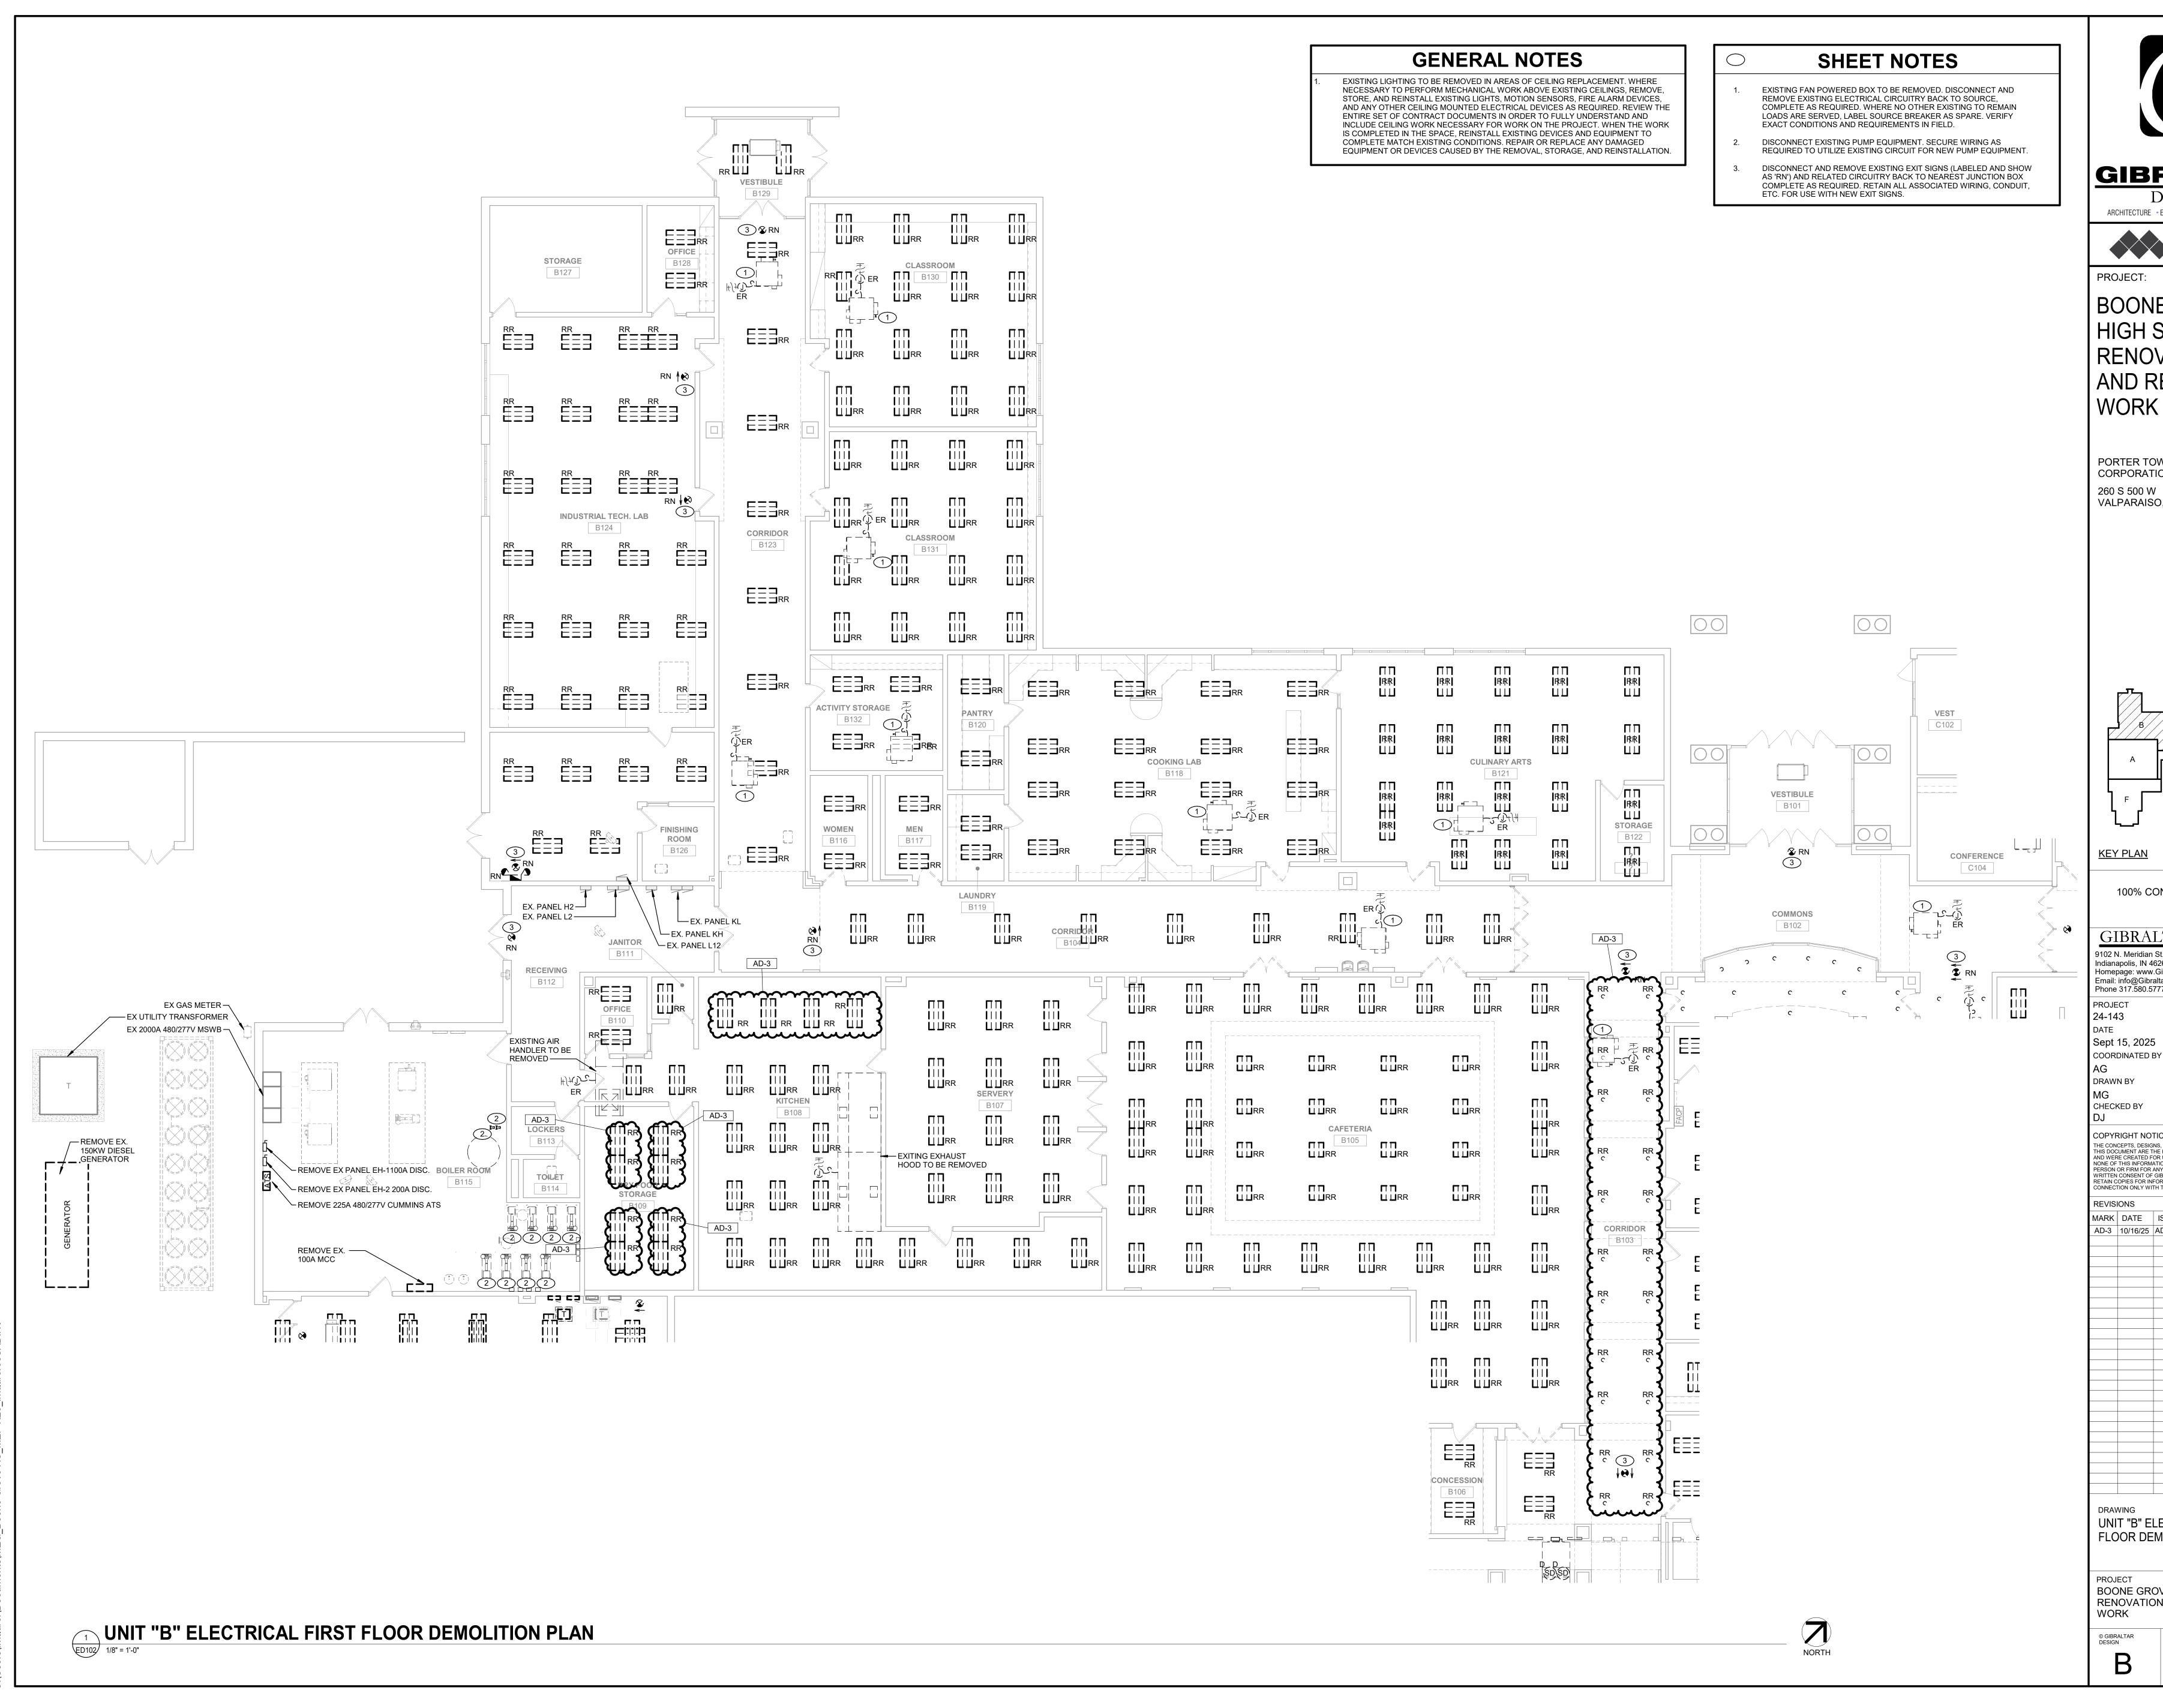

GIBRALTAR DESIGN ARCHITECTURE • ENGINEERING • INTERIOR DESIGN

BOONE GROVE HIGH SCHOOL RENOVATION AND RELATED

PORTER TOWNSHIP SCHOOL CORPORATION 260 S 500 W VALPARAISO, IN 46385

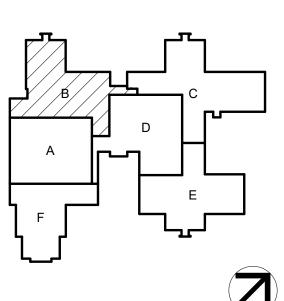

100% CONSTRUCTION SET

NORTH

GIBRALTAR DESIGN 9102 N. Meridian St., Ste. 300 Indianapolis, IN 46260 Homepage: www.GibraltarDesign.com Email: info@GibraltarDesign.com Phone 317.580.5777 Fax 317.580.5778

Sept 15, 2025 **COORDINATED BY** 

COPYRIGHT NOTICE: THE CONCEPTS, DESIGNS, PLANS, DETAILS, ETC, SHOWN ON THIS DOCUMENT ARE THE PROPERTY OF GIBRALTAR DESIGN AND WERE CREATED FOR USE ON THIS SPECIFIC PROJECT. NONE OF THIS INFORMATION SHALL BE USED BY ANY PERSON OR FIRM FOR ANY PURPOSE WITHOUT THE EXPRESS WRITTEN CONSENT OF GIBRALTAR DESIGN. THE OWNER MAY RETAIN COPIES FOR INFORMATION AND REFERENCE IN CONNECTION ONLY WITH THIS PROJECT.

MARK DATE ISSUED FOR AD-3 10/16/25 ADDENDUM NO. 3

UNIT "B" ELECTRICAL FIRST FLOOR DEMOLITION PLAN

BOONE GROVE HIGH SCHOOL RENOVATION AND RELATED

ED102

EXISTING LIGHTING TO BE REMOVED IN AREAS OF CEILING REPLACEMENT. WHERE NECESSARY TO PERFORM MECHANICAL WORK ABOVE EXISTING CEILINGS, REMOVE, STORE, AND REINSTALL EXISTING LIGHTS, MOTION SENSORS, FIRE ALARM DEVICES, AND ANY OTHER CEILING MOUNTED ELECTRICAL DEVICES AS REQUIRED. REVIEW THE ENTIRE SET OF CONTRACT DOCUMENTS IN ORDER TO FULLY UNDERSTAND AND INCLUDE CEILING WORK NECESSARY FOR WORK ON THE PROJECT. WHEN THE WORK IS COMPLETED IN THE SPACE, REINSTALL EXISTING DEVICES AND EQUIPMENT TO COMPLETE MATCH EXISTING CONDITIONS. REPAIR OR REPLACE ANY DAMAGED EQUIPMENT OR DEVICES CAUSED BY THE REMOVAL, STORAGE, AND REINSTALLATION.

## SHEET NOTES

- 1. EXISTING FAN POWERED BOX TO BE REMOVED. DISCONNECT AND REMOVE EXISTING ELECTRICAL CIRCUITRY BACK TO SOURCE, COMPLETE AS REQUIRED. WHERE NO OTHER EXISTING TO REMAIN LOADS ARE SERVED, LABEL SOURCE BREAKER AS SPARE. VERIFY EXACT CONDITIONS AND REQUIREMENTS IN FIELD.
- 2. DISCONNECT AND REMOVE EXISTING EXIT SIGNS (LABELED AND SHOWN AS 'RN') AND RELATED CIRCUITRY BACK TO NEAREST JUNCTION BOX COMPLETE AS REQUIRED. RETAIN ALL ASSOCIATED WIRING, CONDUIT, ETC. FOR USE WITH NEW EXIT SIGNS.






PROJECT:

BOONE GROVE HIGH SCHOOL RENOVATION AND RELATED WORK

PORTER TOWNSHIP SCHOOL CORPORATION 260 S 500 W VALPARAISO, IN 46385

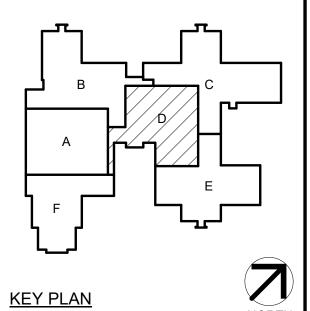

100% CONSTRUCTION SET

GIBRALTAR DESIGN
9102 N. Meridian St., Ste. 300
Indianapolis, IN 46260
Homepage: www.GibraltarDesign.com
Email: info@GibraltarDesign.com
Phone 317.580.5777 Fax 317.580.5778

PROJECT
24-143
DATE
Sept 15, 2025
COORDINATED BY
AG
DRAWN BY
MG
CHECKED BY

COPYRIGHT NOTICE:

THE CONCEPTS, DESIGNS, PLANS, DETAILS, ETC, SHOWN ON THIS DOCUMENT ARE THE PROPERTY OF GIBRALTAR DESIGN AND WERE CREATED FOR USE ON THIS SPECIFIC PROJECT. NONE OF THIS INFORMATION SHALL BE USED BY ANY PERSON OR FIRM FOR ANY PURPOSE WITHOUT THE EXPRESS WRITTEN CONSENT OF GIBRALTAR DESIGN. THE OWNER MAY RETAIN COPIES FOR INFORMATION AND REFERENCE IN CONNECTION ONLY WITH THIS PROJECT.

10302590

REVISIONS


MARK DATE ISSUED FOR

AD-3 10/16/25 ADDENDUM NO. 3

DRAWING
UNIT "D" ELECTRICAL FIRST
FLOOR DEMOLITION PLAN

PROJECT
BOONE GROVE HIGH SCHOOL
RENOVATION AND RELATED
WORK

ED104

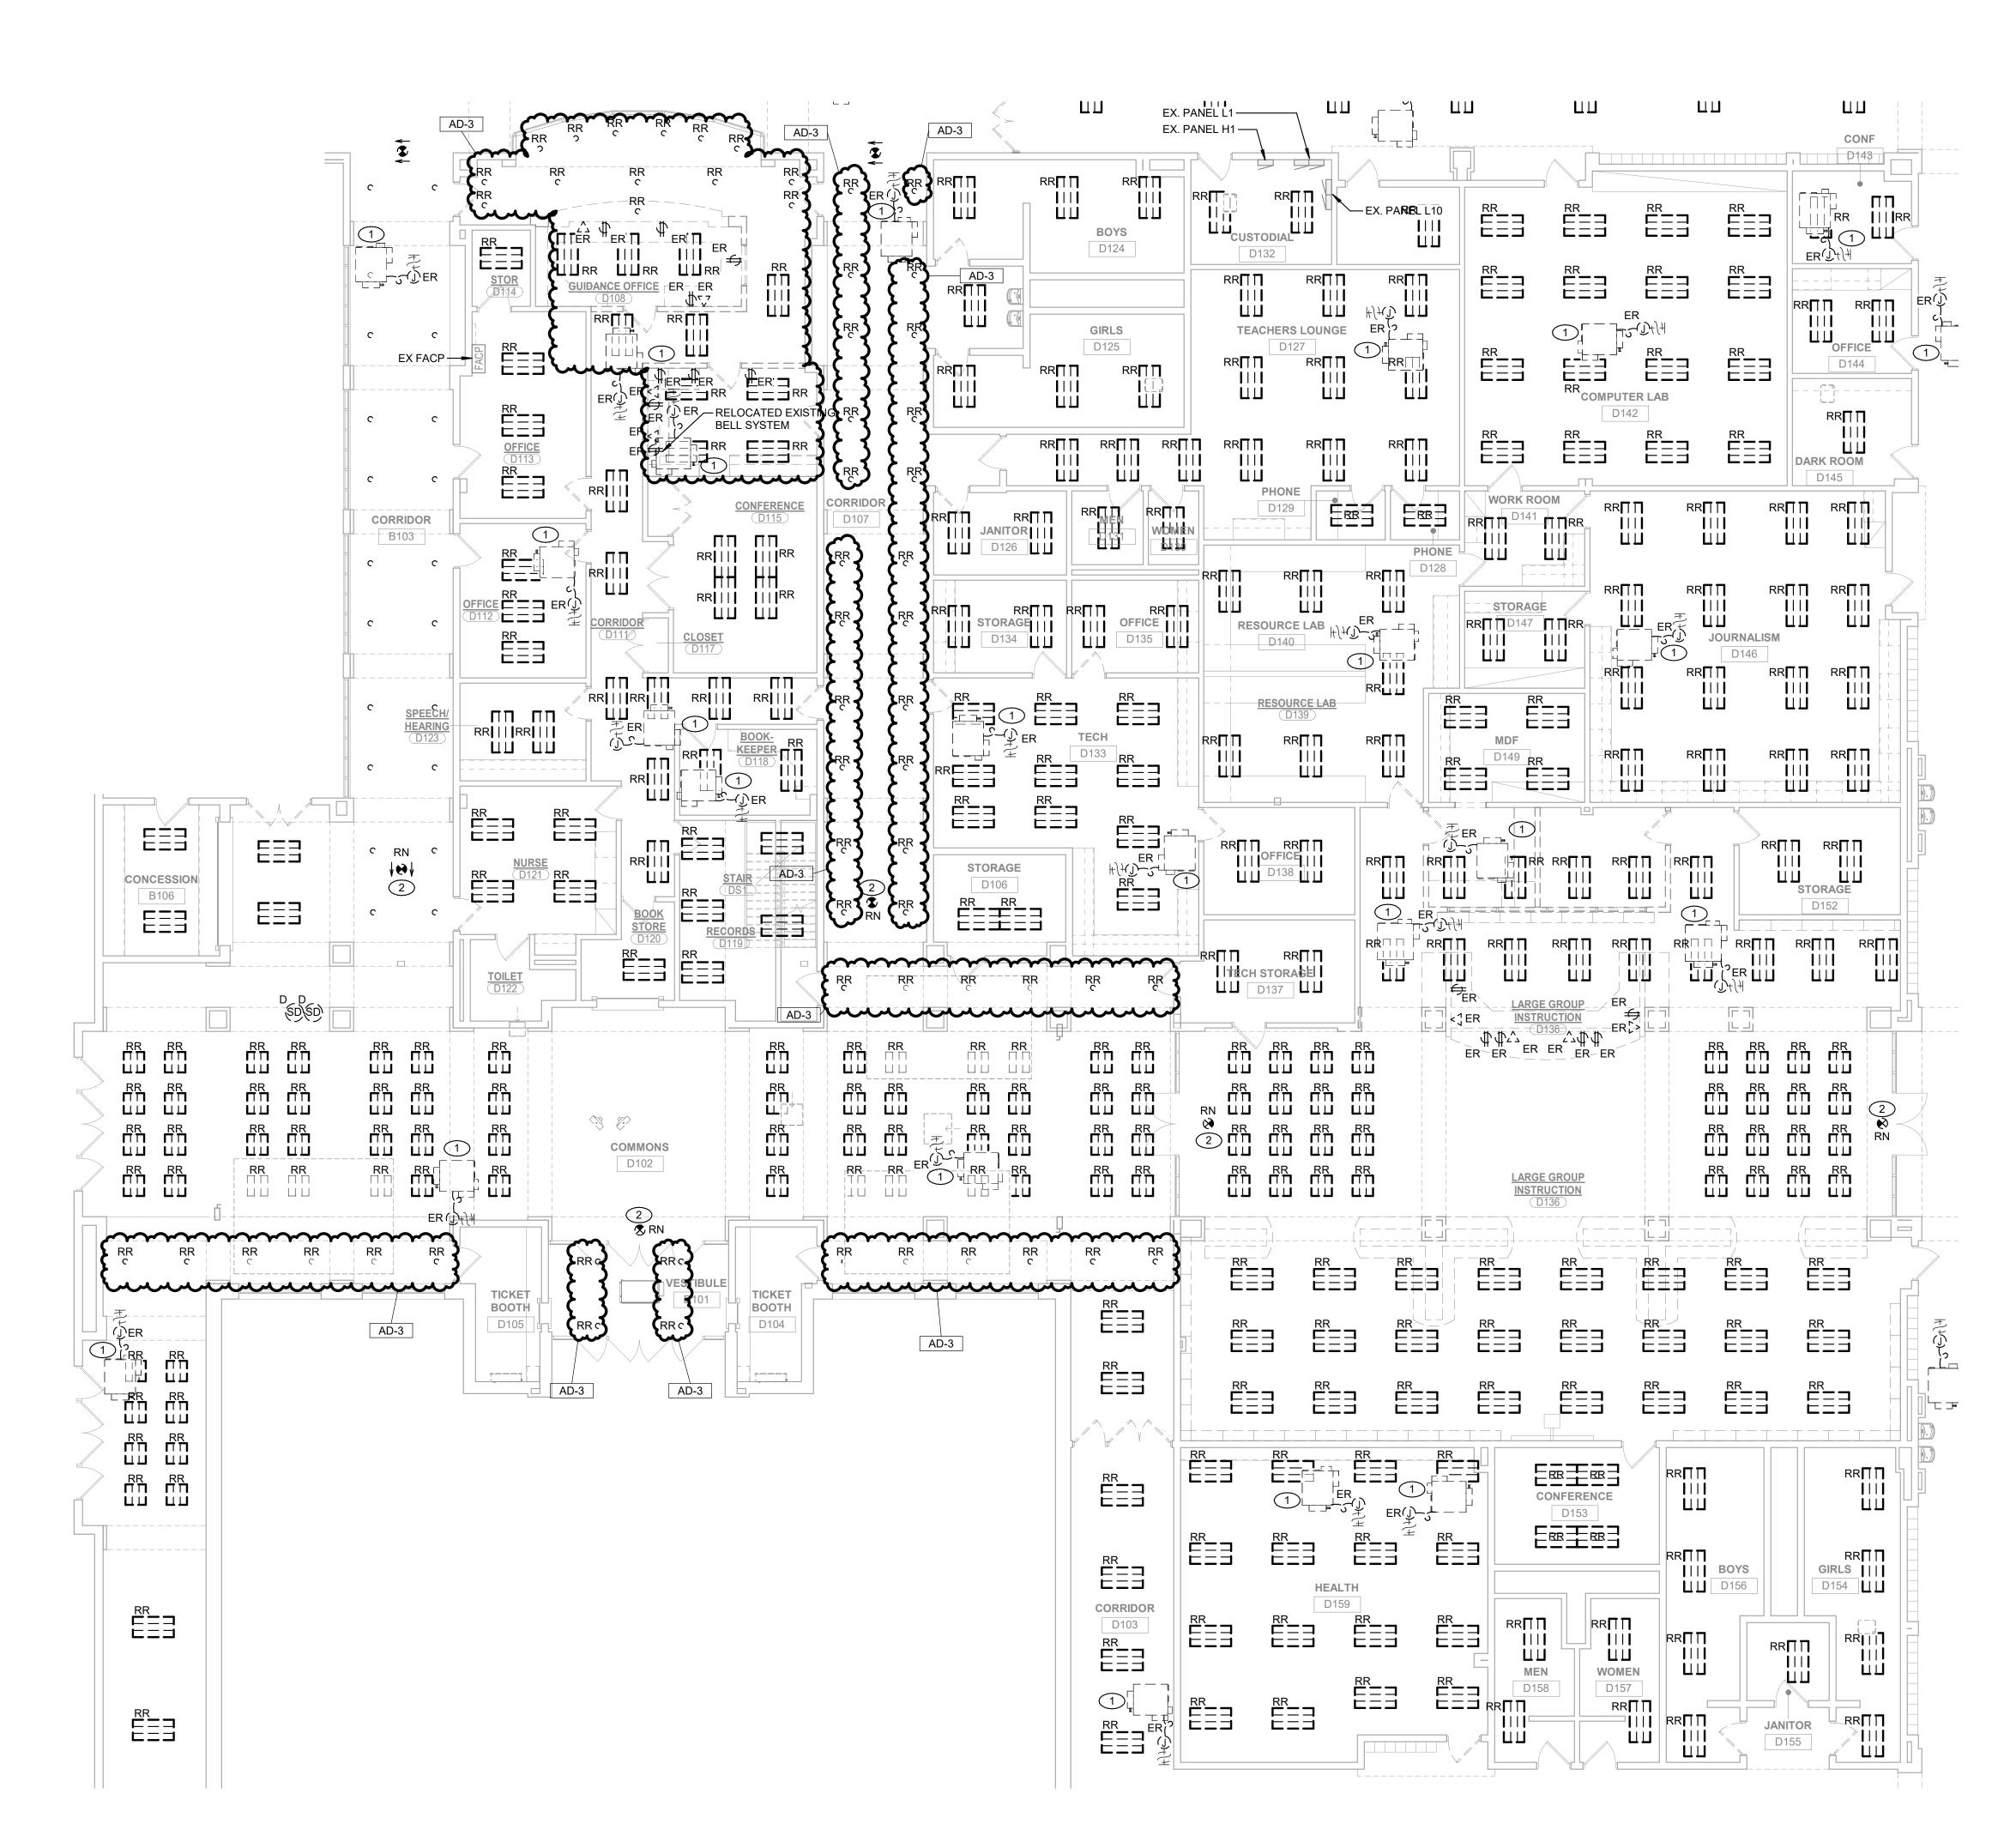

EXISTING LIGHTING TO BE REMOVED IN AREAS OF CEILING REPLACEMENT. WHERE NECESSARY TO PERFORM MECHANICAL WORK ABOVE EXISTING CEILINGS, REMOVE, STORE, AND REINSTALL EXISTING LIGHTS, MOTION SENSORS, FIRE ALARM DEVICES, AND ANY OTHER CEILING MOUNTED ELECTRICAL DEVICES AS REQUIRED. REVIEW THE ENTIRE SET OF CONTRACT DOCUMENTS IN ORDER TO FULLY UNDERSTAND AND INCLUDE CEILING WORK NECESSARY FOR WORK ON THE PROJECT. WHEN THE WORK IS COMPLETED IN THE SPACE, REINSTALL EXISTING DEVICES AND EQUIPMENT TO COMPLETE MATCH EXISTING CONDITIONS. REPAIR OR REPLACE ANY DAMAGED EQUIPMENT OR DEVICES CAUSED BY THE REMOVAL, STORAGE, AND REINSTALLATION.

## SHEET NOTES

- 1. EXISTING FAN POWERED BOX TO BE REMOVED. DISCONNECT AND REMOVE EXISTING ELECTRICAL CIRCUITRY BACK TO SOURCE, COMPLETE AS REQUIRED. WHERE NO OTHER EXISTING TO REMAIN LOADS ARE SERVED, LABEL SOURCE BREAKER AS SPARE. VERIFY EXACT CONDITIONS AND REQUIREMENTS IN FIELD.
- 2. DISCONNECT AND REMOVE EXISTING EXIT SIGNS (LABELED AND SHOWN AS 'RN') AND RELATED CIRCUITRY BACK TO NEAREST JUNCTION BOX COMPLETE AS REQUIRED. RETAIN ALL ASSOCIATED WIRING, CONDUIT, ETC. FOR USE WITH NEW EXIT SIGNS.






DESIGN

PROJECT:

BOONE GROVE HIGH SCHOOL RENOVATION AND RELATED WORK

PORTER TOWNSHIP SCHOOL CORPORATION 260 S 500 W VALPARAISO, IN 46385

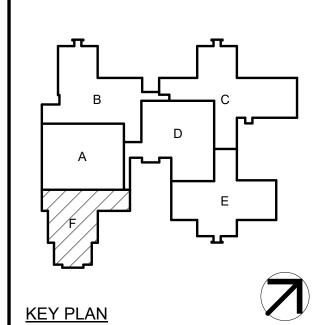

100% CONSTRUCTION SET

GIBRALTAR DESIGN
9102 N. Meridian St., Ste. 300
Indianapolis, IN 46260

Indianapolis, IN 46260
Homepage: www.GibraltarDesign.com
Email: info@GibraltarDesign.com
Phone 317.580.5777 Fax 317.580.5778

PROJECT

24-143
DATE
Sept 15, 2025
COORDINATED BY
AG
DRAWN BY
MG
CHECKED BY

COPYRIGHT NOTICE:

THE CONCEPTS, DESIGNS, PLANS, DETAILS, ETC, SHOWN ON THIS DOCUMENT ARE THE PROPERTY OF GIBRALTAR DESIGN AND WERE CREATED FOR USE ON THIS SPECIFIC PROJECT. NONE OF THIS INFORMATION SHALL BE USED BY ANY PERSON OR FIRM FOR ANY PURPOSE WITHOUT THE EXPRESS WRITTEN CONSENT OF GIBRALTAR DESIGN. THE OWNER MAY RETAIN COPIES FOR INFORMATION AND REFERENCE IN CONNECTION ONLY WITH THIS PROJECT.

REVISIONS


MARK DATE ISSUED FOR
AD-2 10/09/25 ADDENDUM NO. 2
AD-3 10/16/25 ADDENDUM NO. 3

DRAWING
UNIT "F" ELECTRICAL FIRST
FLOOR DEMOLITION PLAN

PROJECT
BOONE GROVE HIGH SCHOOL
RENOVATION AND RELATED

GIBRALTAR ESIGN

ED106

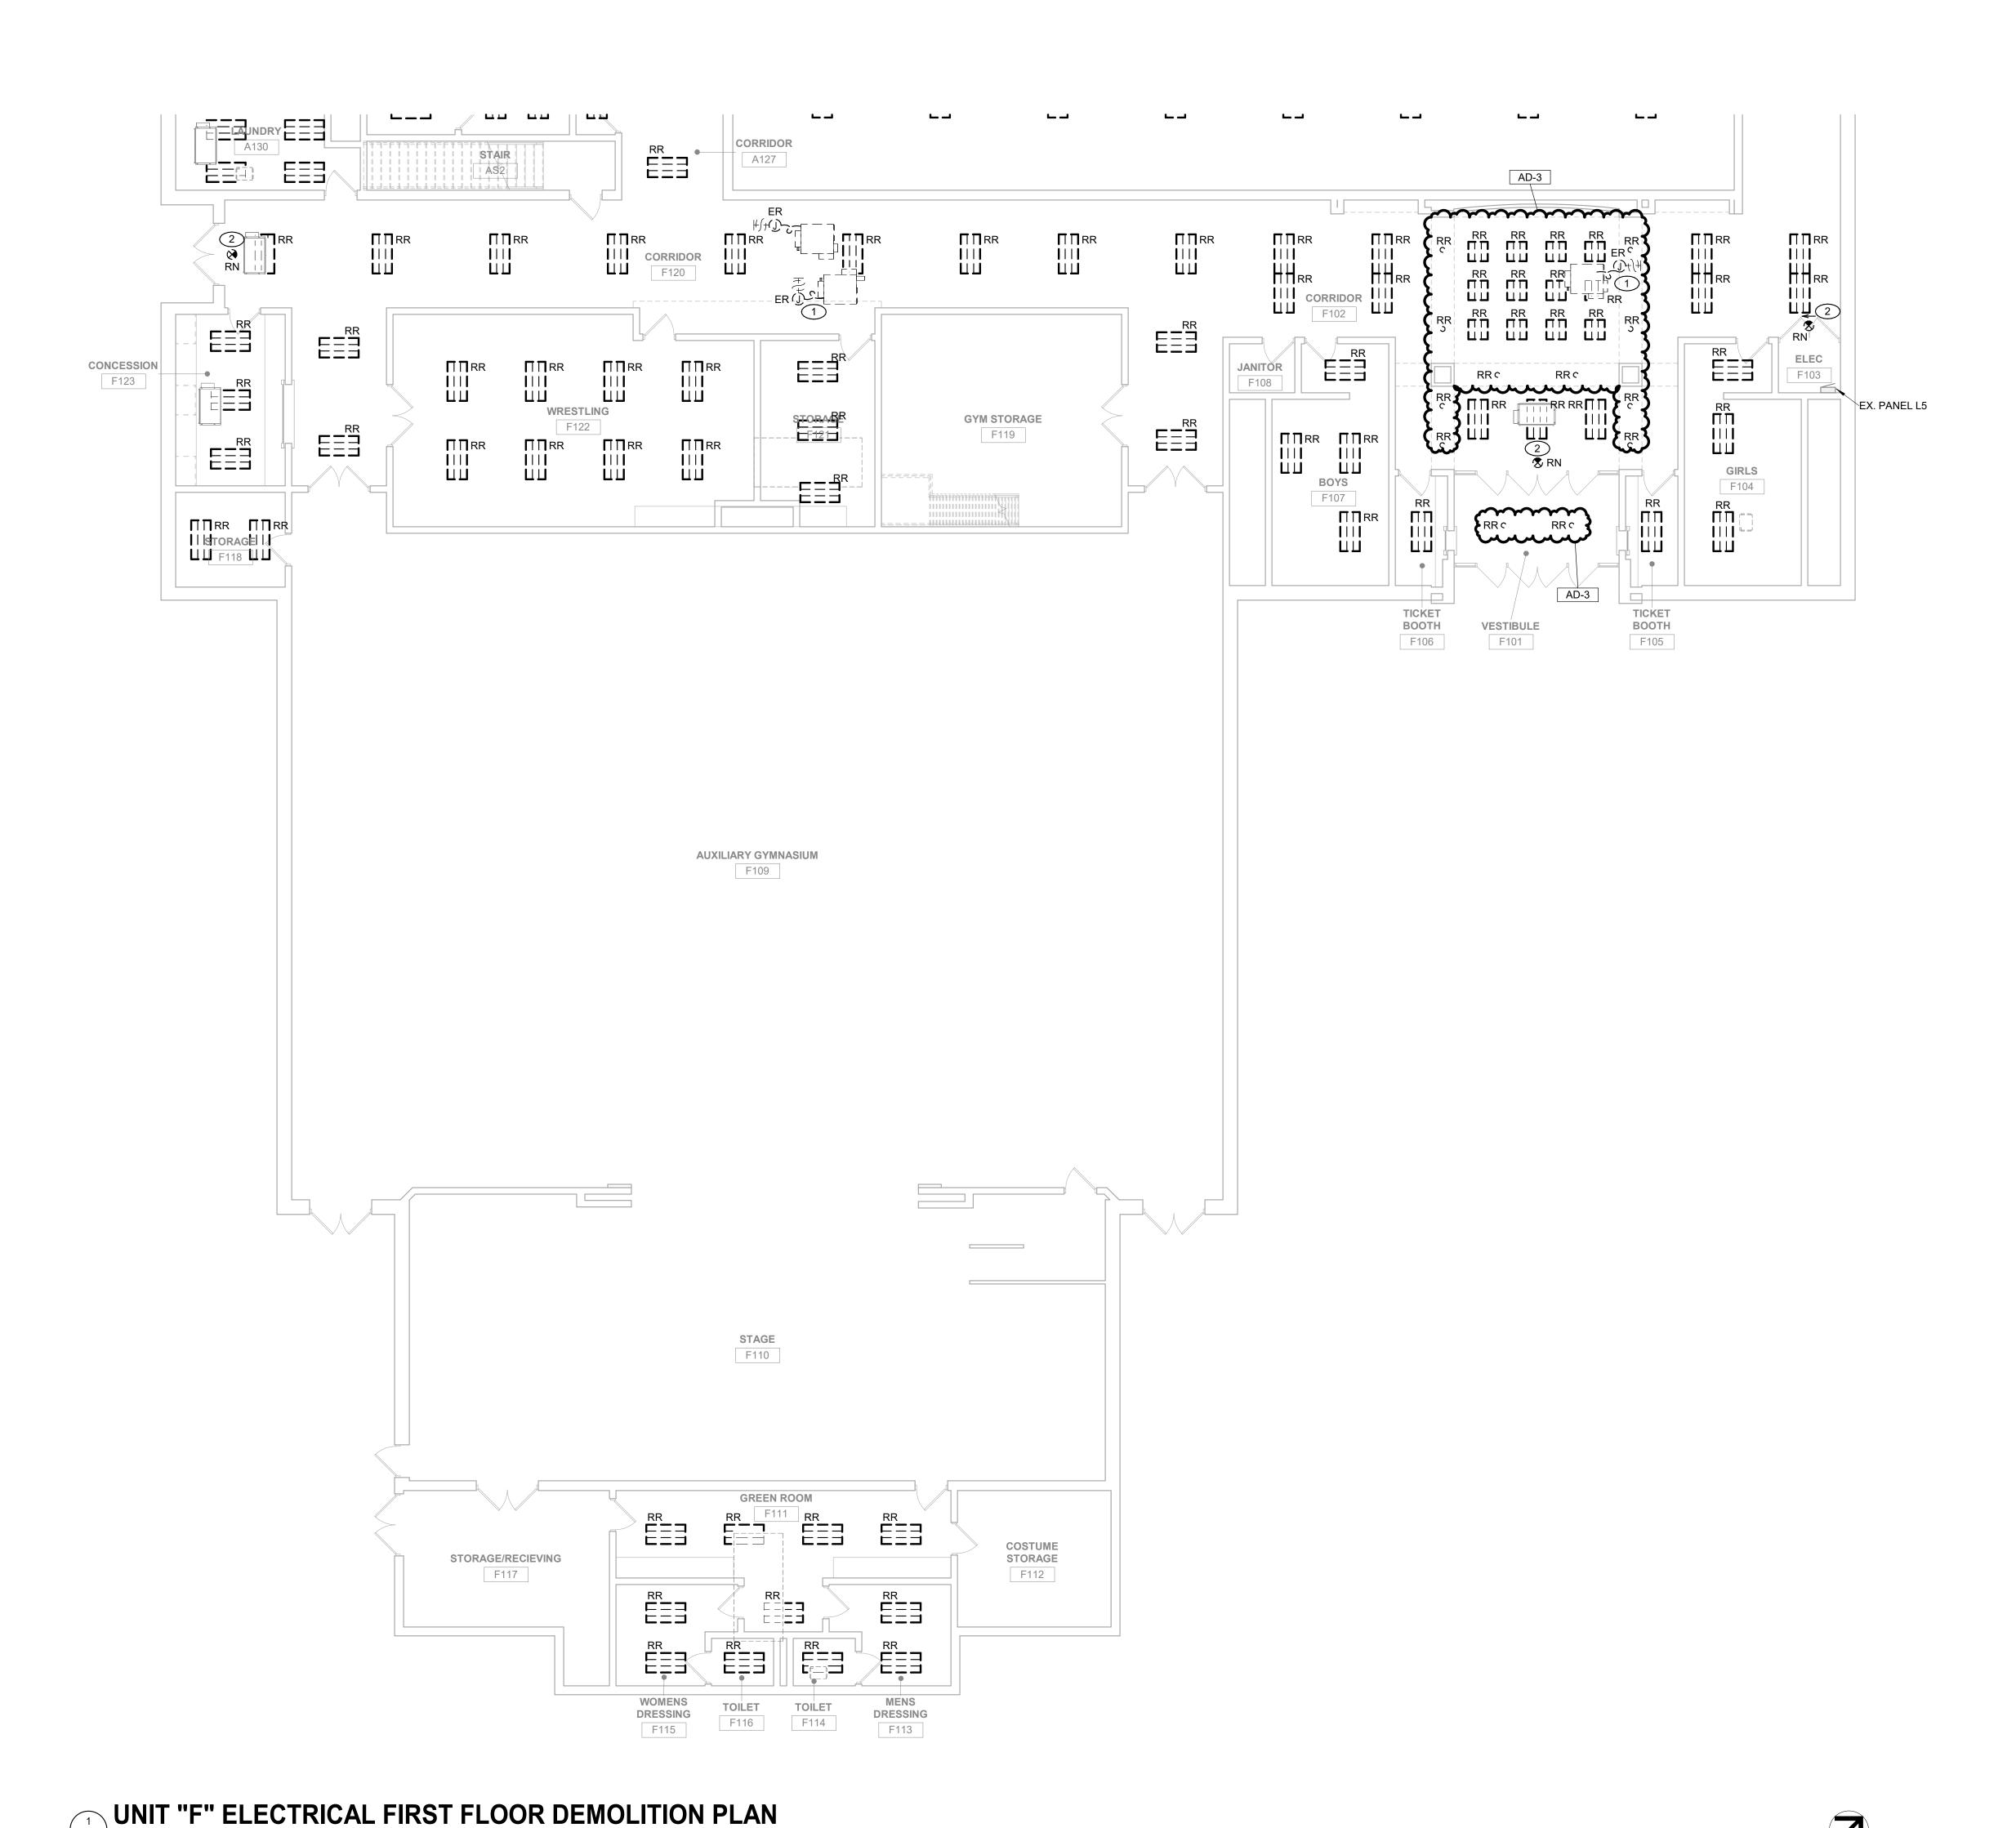

EXISTING LIGHTING TO REMAIN UNLESS OTHERWISE NOTED. WHERE NECESSARY TO PERFORM MECHANICAL WORK ABOVE EXISTING CEILINGS, REMOVE, STORE, AND REINSTALL EXISTING LIGHTS, MOTION SENSORS, FIRE ALARM DEVICES, AND ANY OTHER CEILING MOUNTED ELECTRICAL DEVICES AS REQUIRED. REVIEW THE ENTIRE SET OF CONTRACT DOCUMENTS IN ORDER TO FULLY UNDERSTAND AND INCLUDE CEILING WORK NECESSARY FOR WORK ON THE PROJECT. WHEN THE WORK IS COMPLETED IN THE SPACE, REINSTALL EXISTING DEVICES AND EQUIPMENT TO COMPLETE MATCH EXISTING CONDITIONS. REPAIR OR REPLACE ANY DAMAGED EQUIPMENT OR DEVICES CAUSED BY THE REMOVAL, STORAGE, AND REINSTALLATION.

## SHEET NOTES

1. CONNECT NEW EXIT SIGN LIGHTING FIXTURES TO EXISTING EXIT SIGN EMERGENCY LIGHTING CIRCUITRY COMPLETE AS REQUIRED, MAXIMUM 4400W PER 277 VOLT CIRCUIT. WHERE NECESSARY, DUE TO LIMITATIONS IN THE EXISTING CIRCUITRY, THIS CONTRACTOR SHALL FURNISH AND INSTALL 20A-1 POLE CIRCUIT BREAKERS AS REQUIRED IN EXISTING SPACE OF EXISTING PANEL, AND EXTEND 2 #12 AND 1 #12 GRD IN 3/4" CONDUIT COMPLETE AS REQUIRED. VERIFY CONDITIONS AND REQUIREMENTS IN FIELD.



GIBRALTAR DESIGN




ARCHITECTURE • ENGINEERING • INTERIOR DESIGN

PROJECT:

BOONE GROVE HIGH SCHOOL RENOVATION AND RELATED WORK

PORTER TOWNSHIP SCHOOL CORPORATION 260 S 500 W VALPARAISO, IN 46385

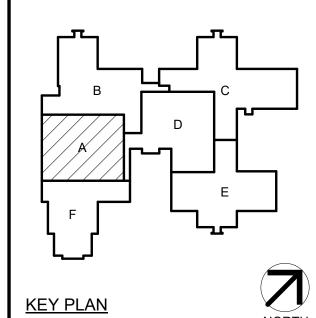

100% CONSTRUCTION SET

# GIBRALTAR DESIGN 9102 N. Meridian St., Ste. 300 Indianapolis, IN 46260 Homepage: www.GibraltarDesign.com

Indianapolis, IN 46260
Homepage: www.GibraltarDesign.com
Email: info@GibraltarDesign.com
Phone 317.580.5777 Fax 317.580.5778

PROJECT
24-143
DATE
Sept 15, 2025
COORDINATED BY
AG
DRAWN BY
MG
CHECKED BY

COPYRIGHT NOTICE:

THE CONCEPTS, DESIGNS, PLANS, DETAILS, ETC, SHOWN ON THIS DOCUMENT ARE THE PROPERTY OF GIBRALTAR DESIGN AND WERE CREATED FOR USE ON THIS SPECIFIC PROJECT. NONE OF THIS INFORMATION SHALL BE USED BY ANY PERSON OR FIRM FOR ANY PURPOSE WITHOUT THE EXPRESS WRITTEN CONSENT OF GIBRALTAR DESIGN. THE OWNER MAY RETAIN COPIES FOR INFORMATION AND REFERENCE IN CONNECTION ONLY WITH THIS PROJECT.

REVISIONS
MARK DATE


MARK DATE ISSUED FOR
AD-3 10/16/25 ADDENDUM NO. 3


DRAWING
UNIT "A" ELECTRICAL FIRST
FLOOR PLAN

PROJECT
BOONE GROVE HIGH SCHOOL
RENOVATION AND RELATED

© GIBRALTAR DESIGN

E-101

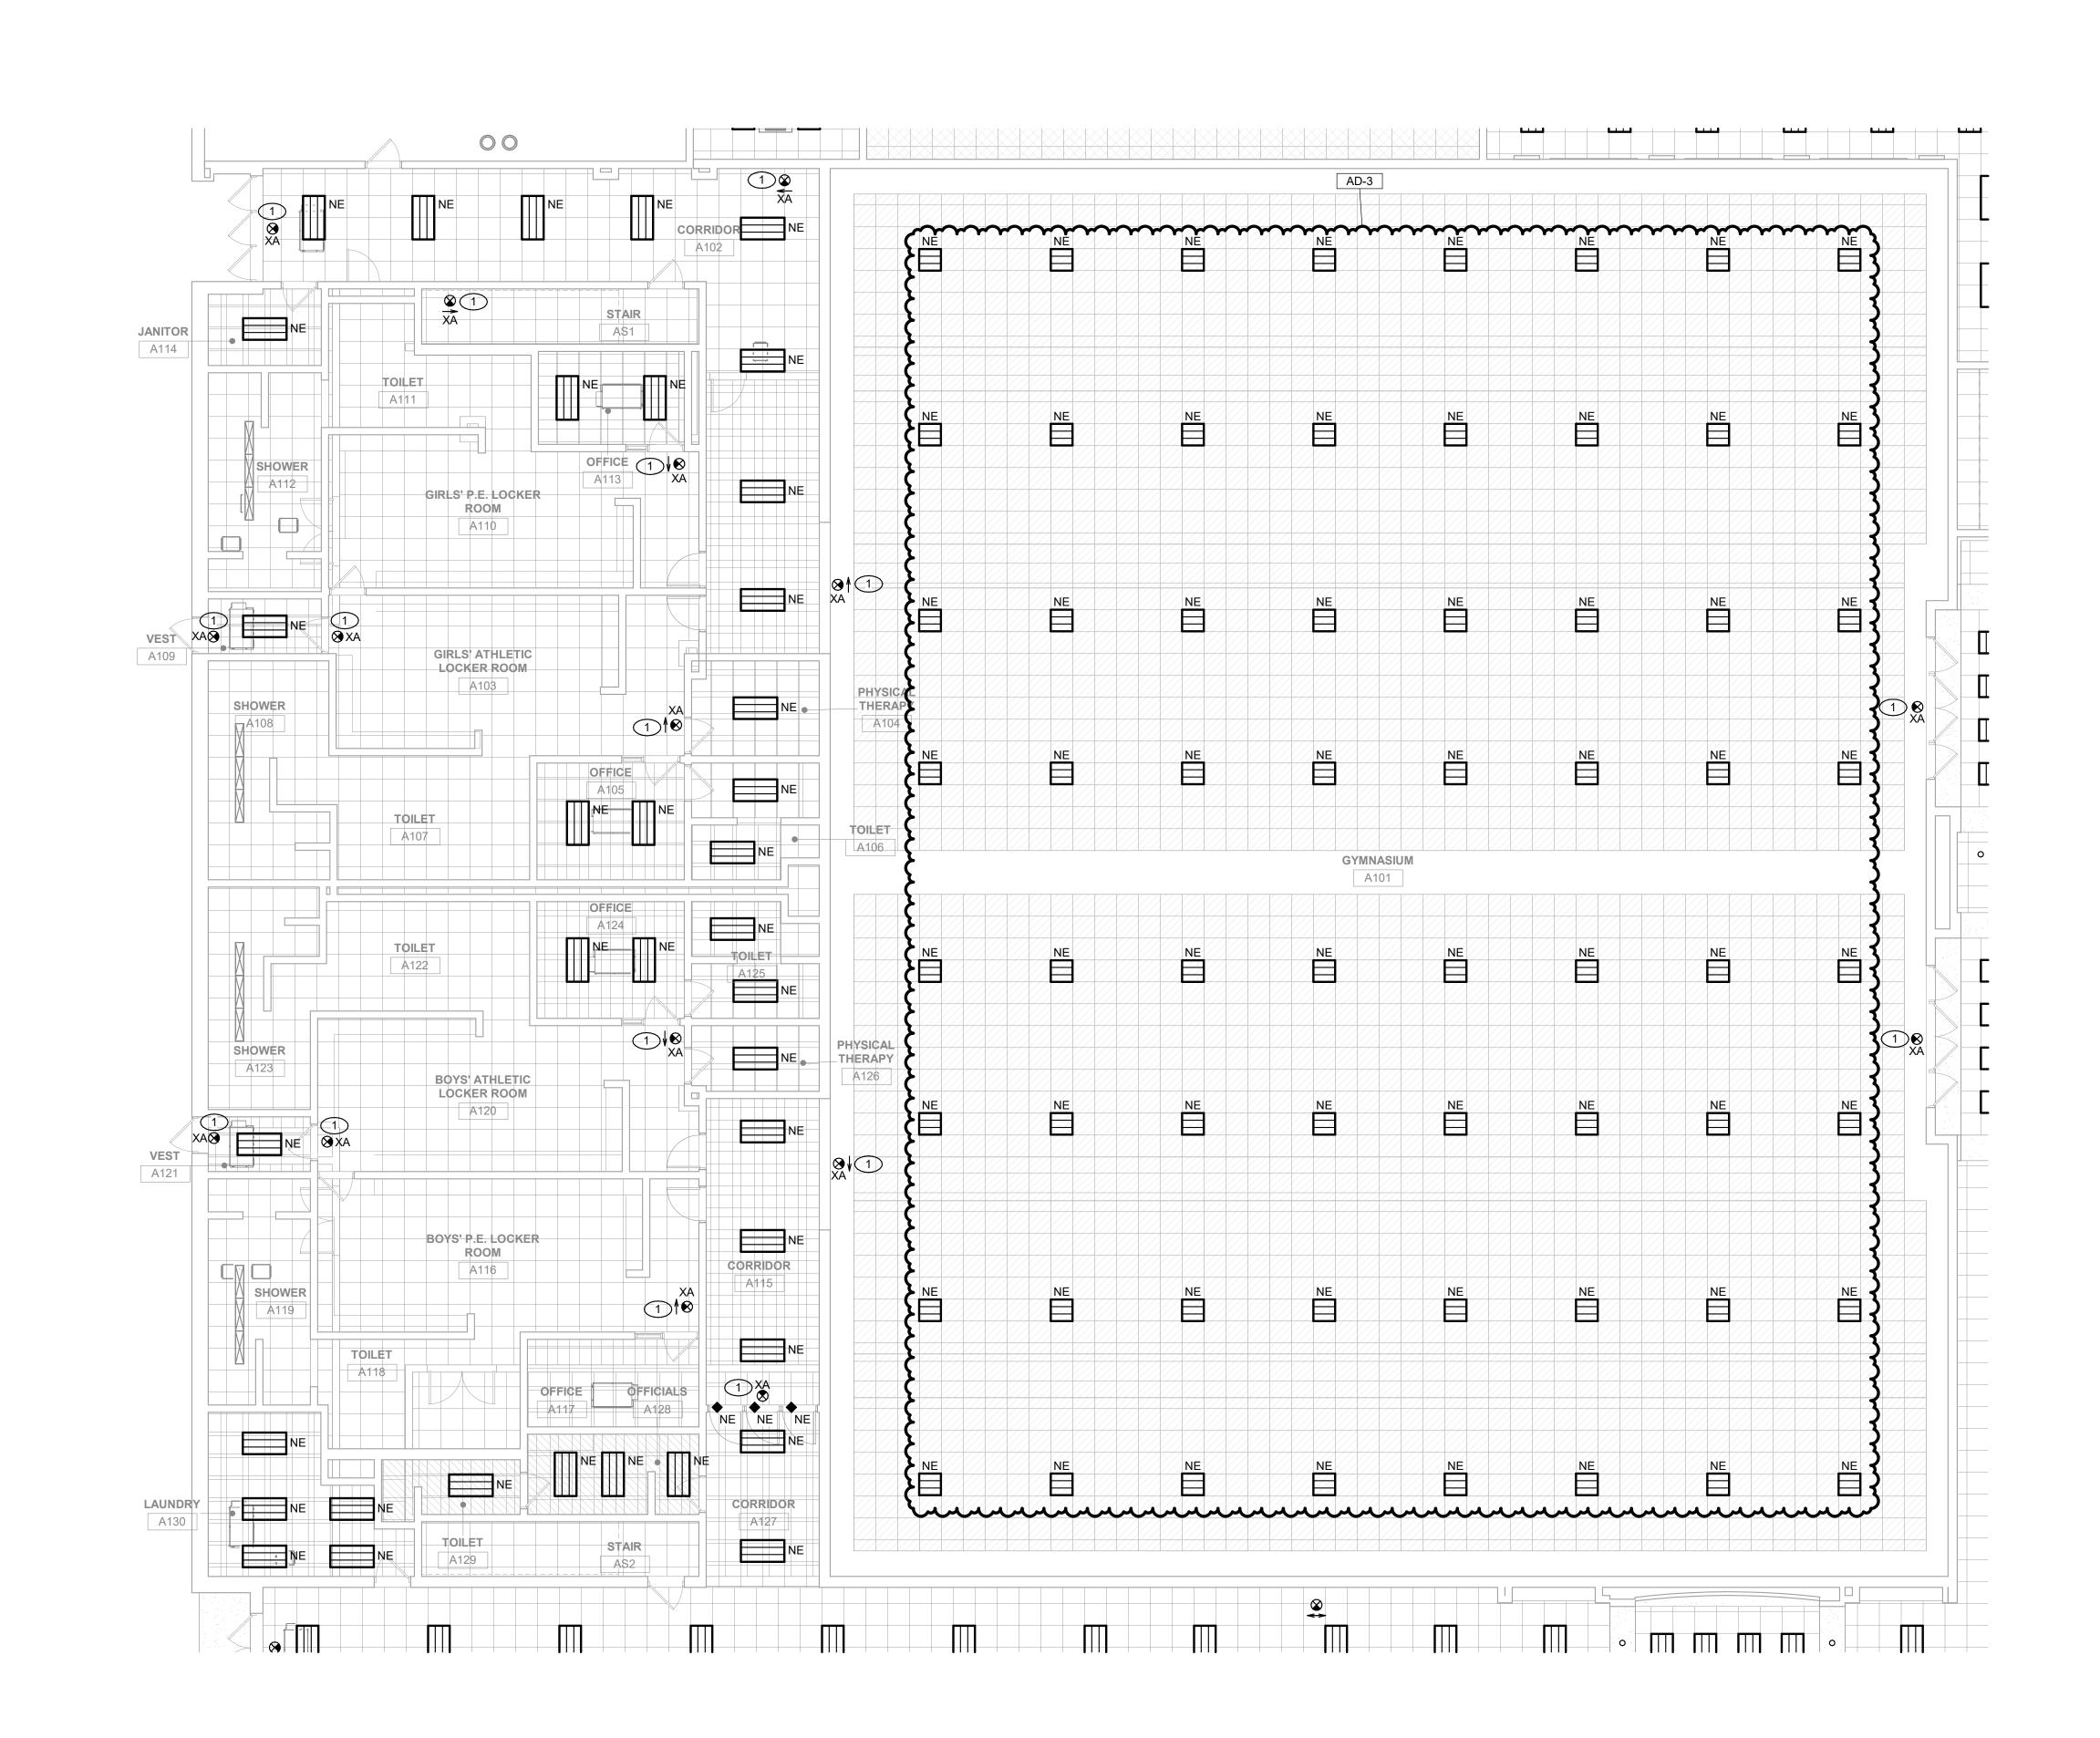

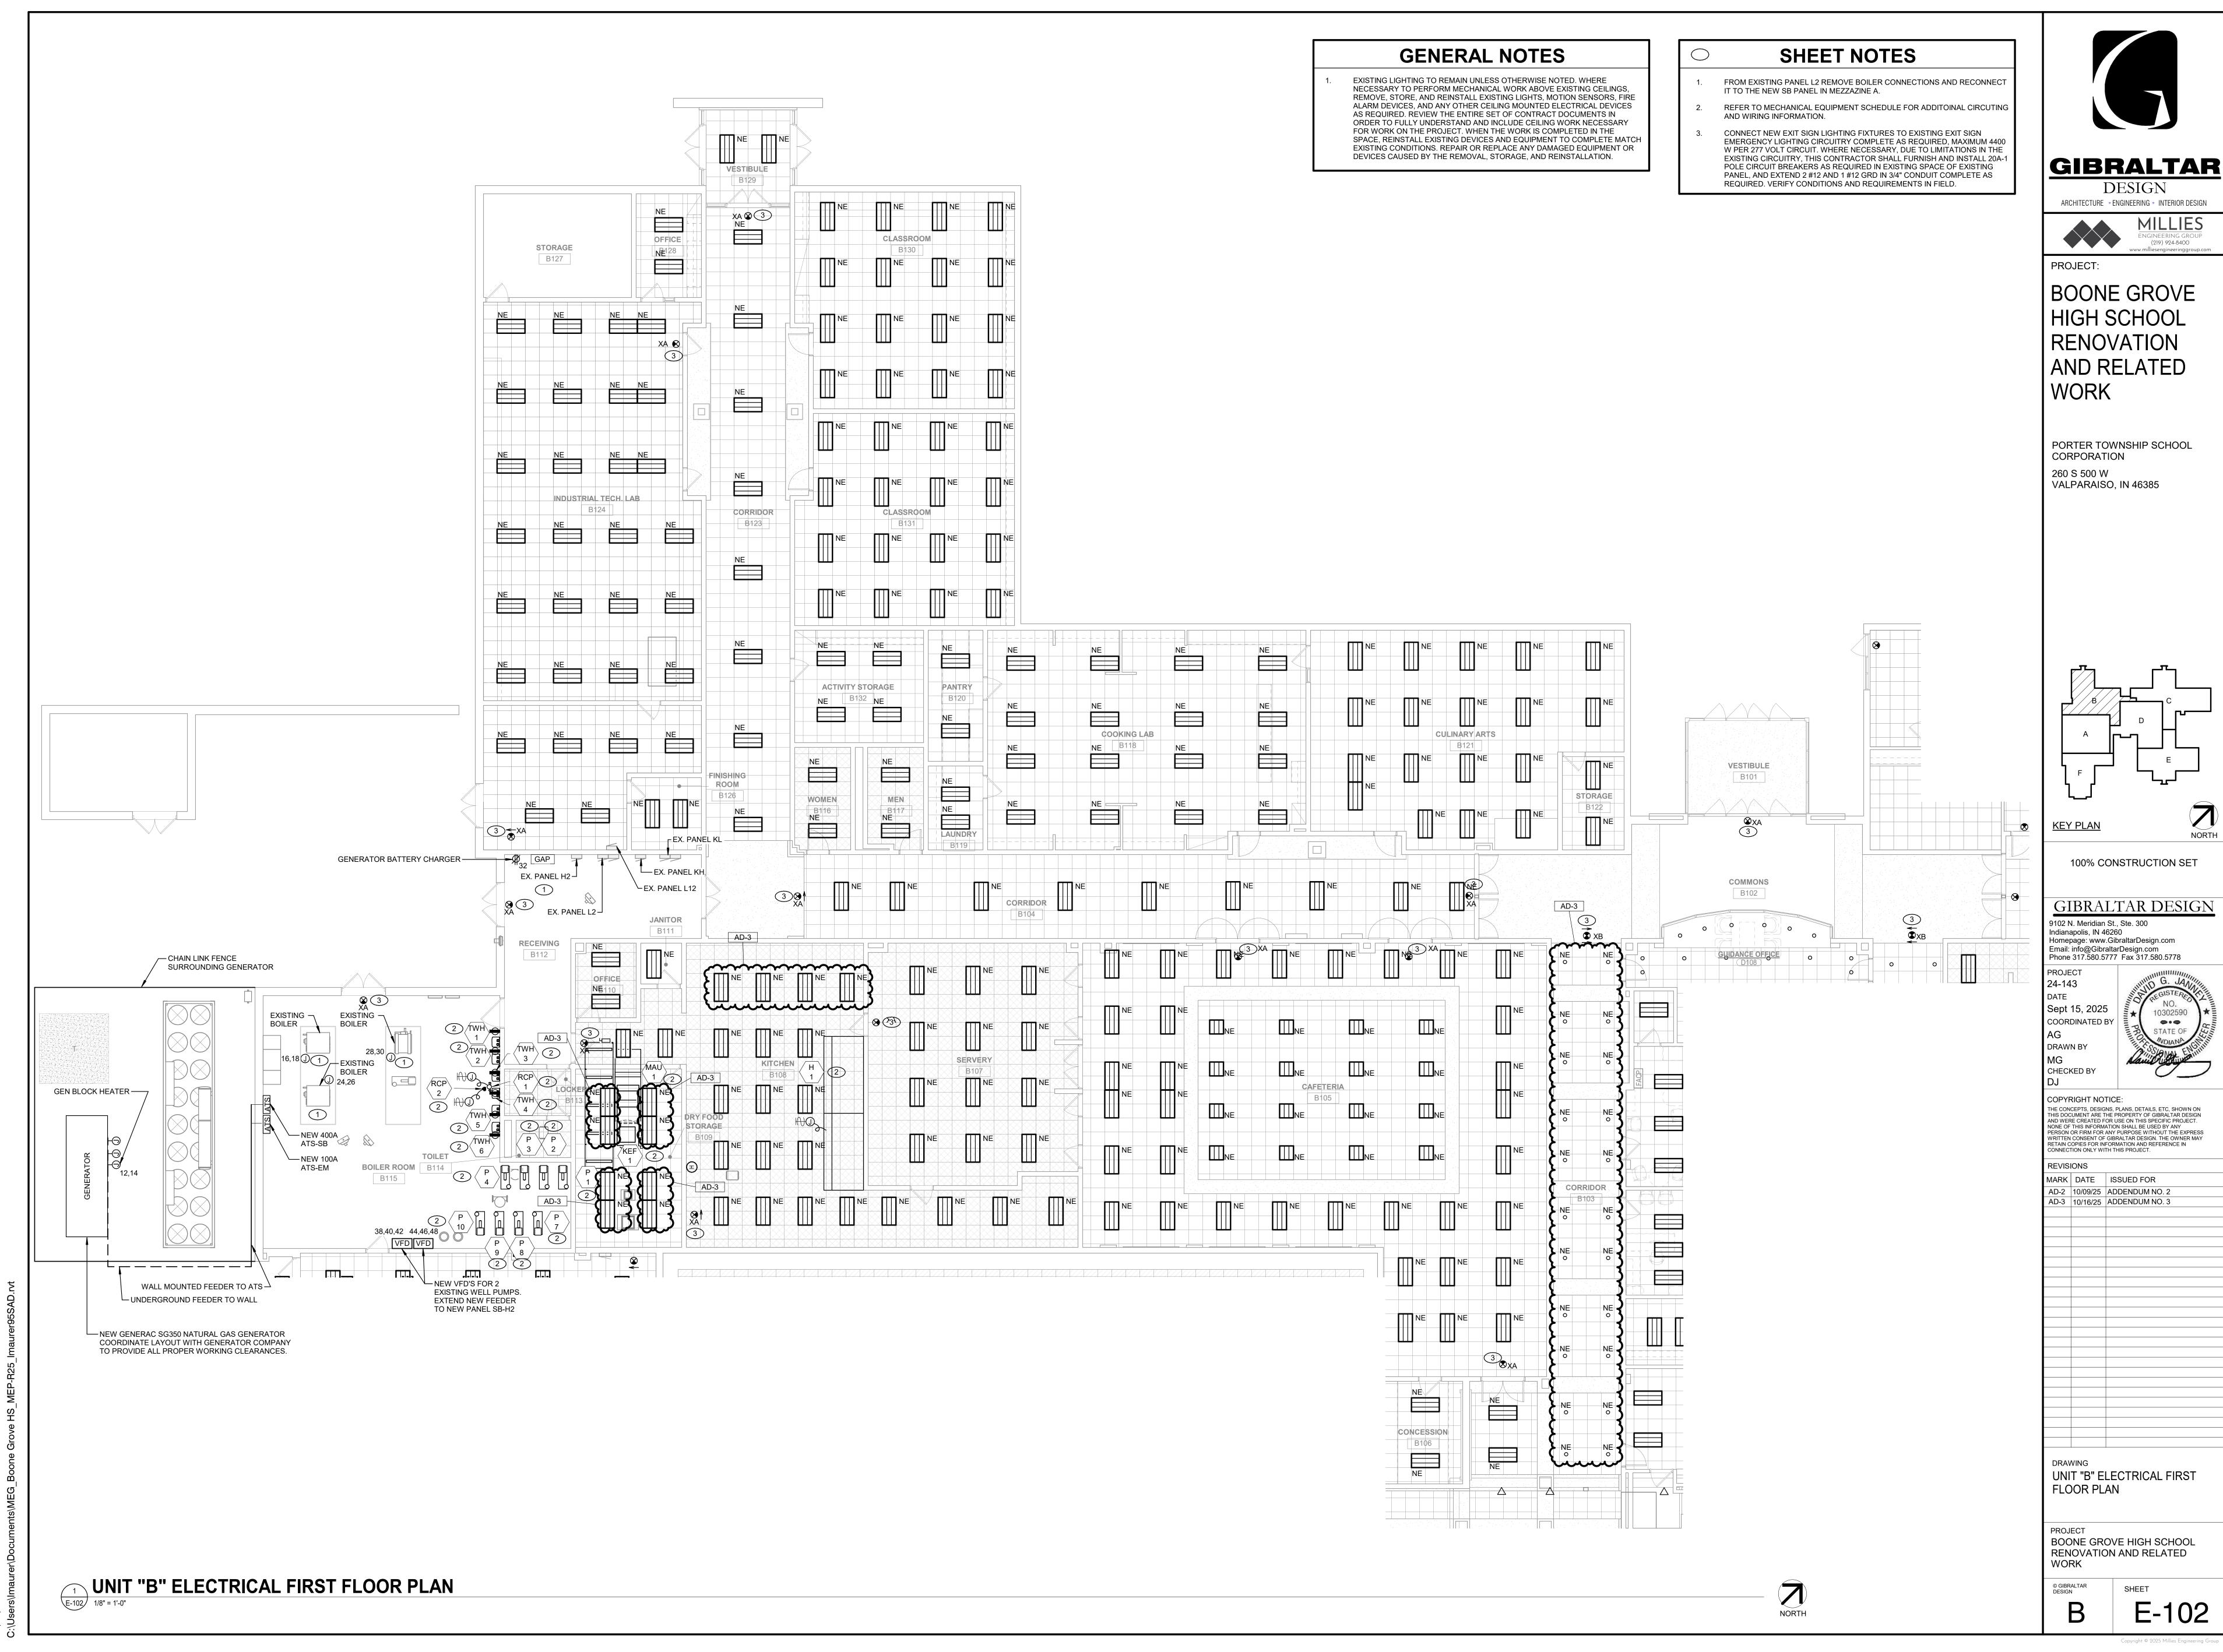

0/15/2025 2:39:44 PM

- EXISTING LIGHTING TO REMAIN UNLESS OTHERWISE NOTED. WHERE NECESSARY TO PERFORM MECHANICAL WORK ABOVE EXISTING CEILINGS, REMOVE, STORE, AND REINSTALL EXISTING LIGHTS, MOTION SENSORS, FIRE ALARM DEVICES, AND ANY OTHER CEILING MOUNTED ELECTRICAL DEVICES AS REQUIRED. REVIEW THE ENTIRE SET OF CONTRACT DOCUMENTS IN ORDER TO FULLY UNDERSTAND AND INCLUDE CEILING WORK NECESSARY FOR WORK ON THE PROJECT. WHEN THE WORK IS COMPLETED IN THE SPACE, REINSTALL EXISTING DEVICES AND EQUIPMENT TO COMPLETE MATCH EXISTING CONDITIONS. REPAIR OR REPLACE ANY DAMAGED EQUIPMENT OR DEVICES CAUSED BY THE REMOVAL, STORAGE, AND REINSTALLATION.
- CIRCUIT NUMBERS SHOWN ARE NOT ACTUAL, BUT ARE SHOWN TO INDICATED CIRCUITING REQUIREMENTS. VERIFY ACTUAL CIRCUIT NUMBER ASSIGNMENTS IN FIELD. UTILIZE EXISTING SPARE CIRCUITS MADE AVAILABLE BY DEMOLITION OF EXISTING DEVICES AND EQUIPMENT. ADDITIONAL CIRCUITS NEEDED SHALL UTILIZE EXISTING OR NEW 20A/1P CIRCUIT BREAKERS IN EXISTING PANEL L1 FOR OFFICE AND AND L4 FOR MEDIA CENTER.

## **SHEET NOTES**

CONNECT NEW EXIT SIGN LIGHTING FIXTURES TO EXISTING EXIT SIGN EMERGENCY LIGHTING CIRCUITRY COMPLETE AS REQUIRED, MAXIMUM 4400 W PER 277 VOLT CIRCUIT. WHERE NECESSARY, DUE TO LIMITATIONS IN THE EXISTING CIRCUITRY, THIS CONTRACTOR SHALL FURNISH AND INSTALL 20A-1 POLE CIRCUIT BREAKERS AS REQUIRED IN EXISTING SPACE OF EXISTING PANEL, AND EXTEND 2 #12 AND 1 #12 GRD IN 3/4" CONDUIT COMPLETE AS REQUIRED. VERIFY CONDITIONS AND REQUIREMENTS IN FIELD. REFER TO MECHANICAL EQUIPMENT CONNECTION SCHEDULE FOR ADDITIONAL CIRCUITING AND WIRING INFORMATION.




DESIGN ARCHITECTURE • ENGINEERING • INTERIOR DESIGN

PROJECT:

BOONE GROVE HIGH SCHOOL RENOVATION AND RELATED WORK

PORTER TOWNSHIP SCHOOL CORPORATION 260 S 500 W VALPARAISO, IN 46385

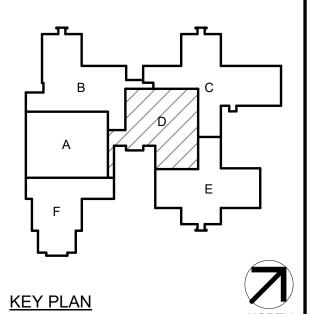

100% CONSTRUCTION SET

GIBRALTAR DESIGN 9102 N. Meridian St., Ste. 300 Indianapolis, IN 46260 Homepage: www.GibraltarDesign.com Email: info@GibraltarDesign.com Phone 317.580.5777 Fax 317.580.5778

PROJECT 24-143 Sept 15, 2025 COORDINATED BY

DRAWN BY


CHECKED BY COPYRIGHT NOTICE: THE CONCEPTS, DESIGNS, PLANS, DETAILS, ETC, SHOWN ON THIS DOCUMENT ARE THE PROPERTY OF GIBRALTAR DESIGN AND WERE CREATED FOR USE ON THIS SPECIFIC PROJECT. NONE OF THIS INFORMATION SHALL BE USED BY ANY PERSON OR FIRM FOR ANY PURPOSE WITHOUT THE EXPRESS WRITTEN CONSENT OF GIBRALTAR DESIGN. THE OWNER MAY RETAIN COPIES FOR INFORMATION AND REFERENCE IN CONNECTION ONLY WITH THIS PROJECT.

REVISIONS MARK DATE ISSUED FOR AD-3 10/16/25 ADDENDUM NO. 3

UNIT "D" ELECTRICAL FIRST FLOOR PLAN

BOONE GROVE HIGH SCHOOL RENOVATION AND RELATED

E-104

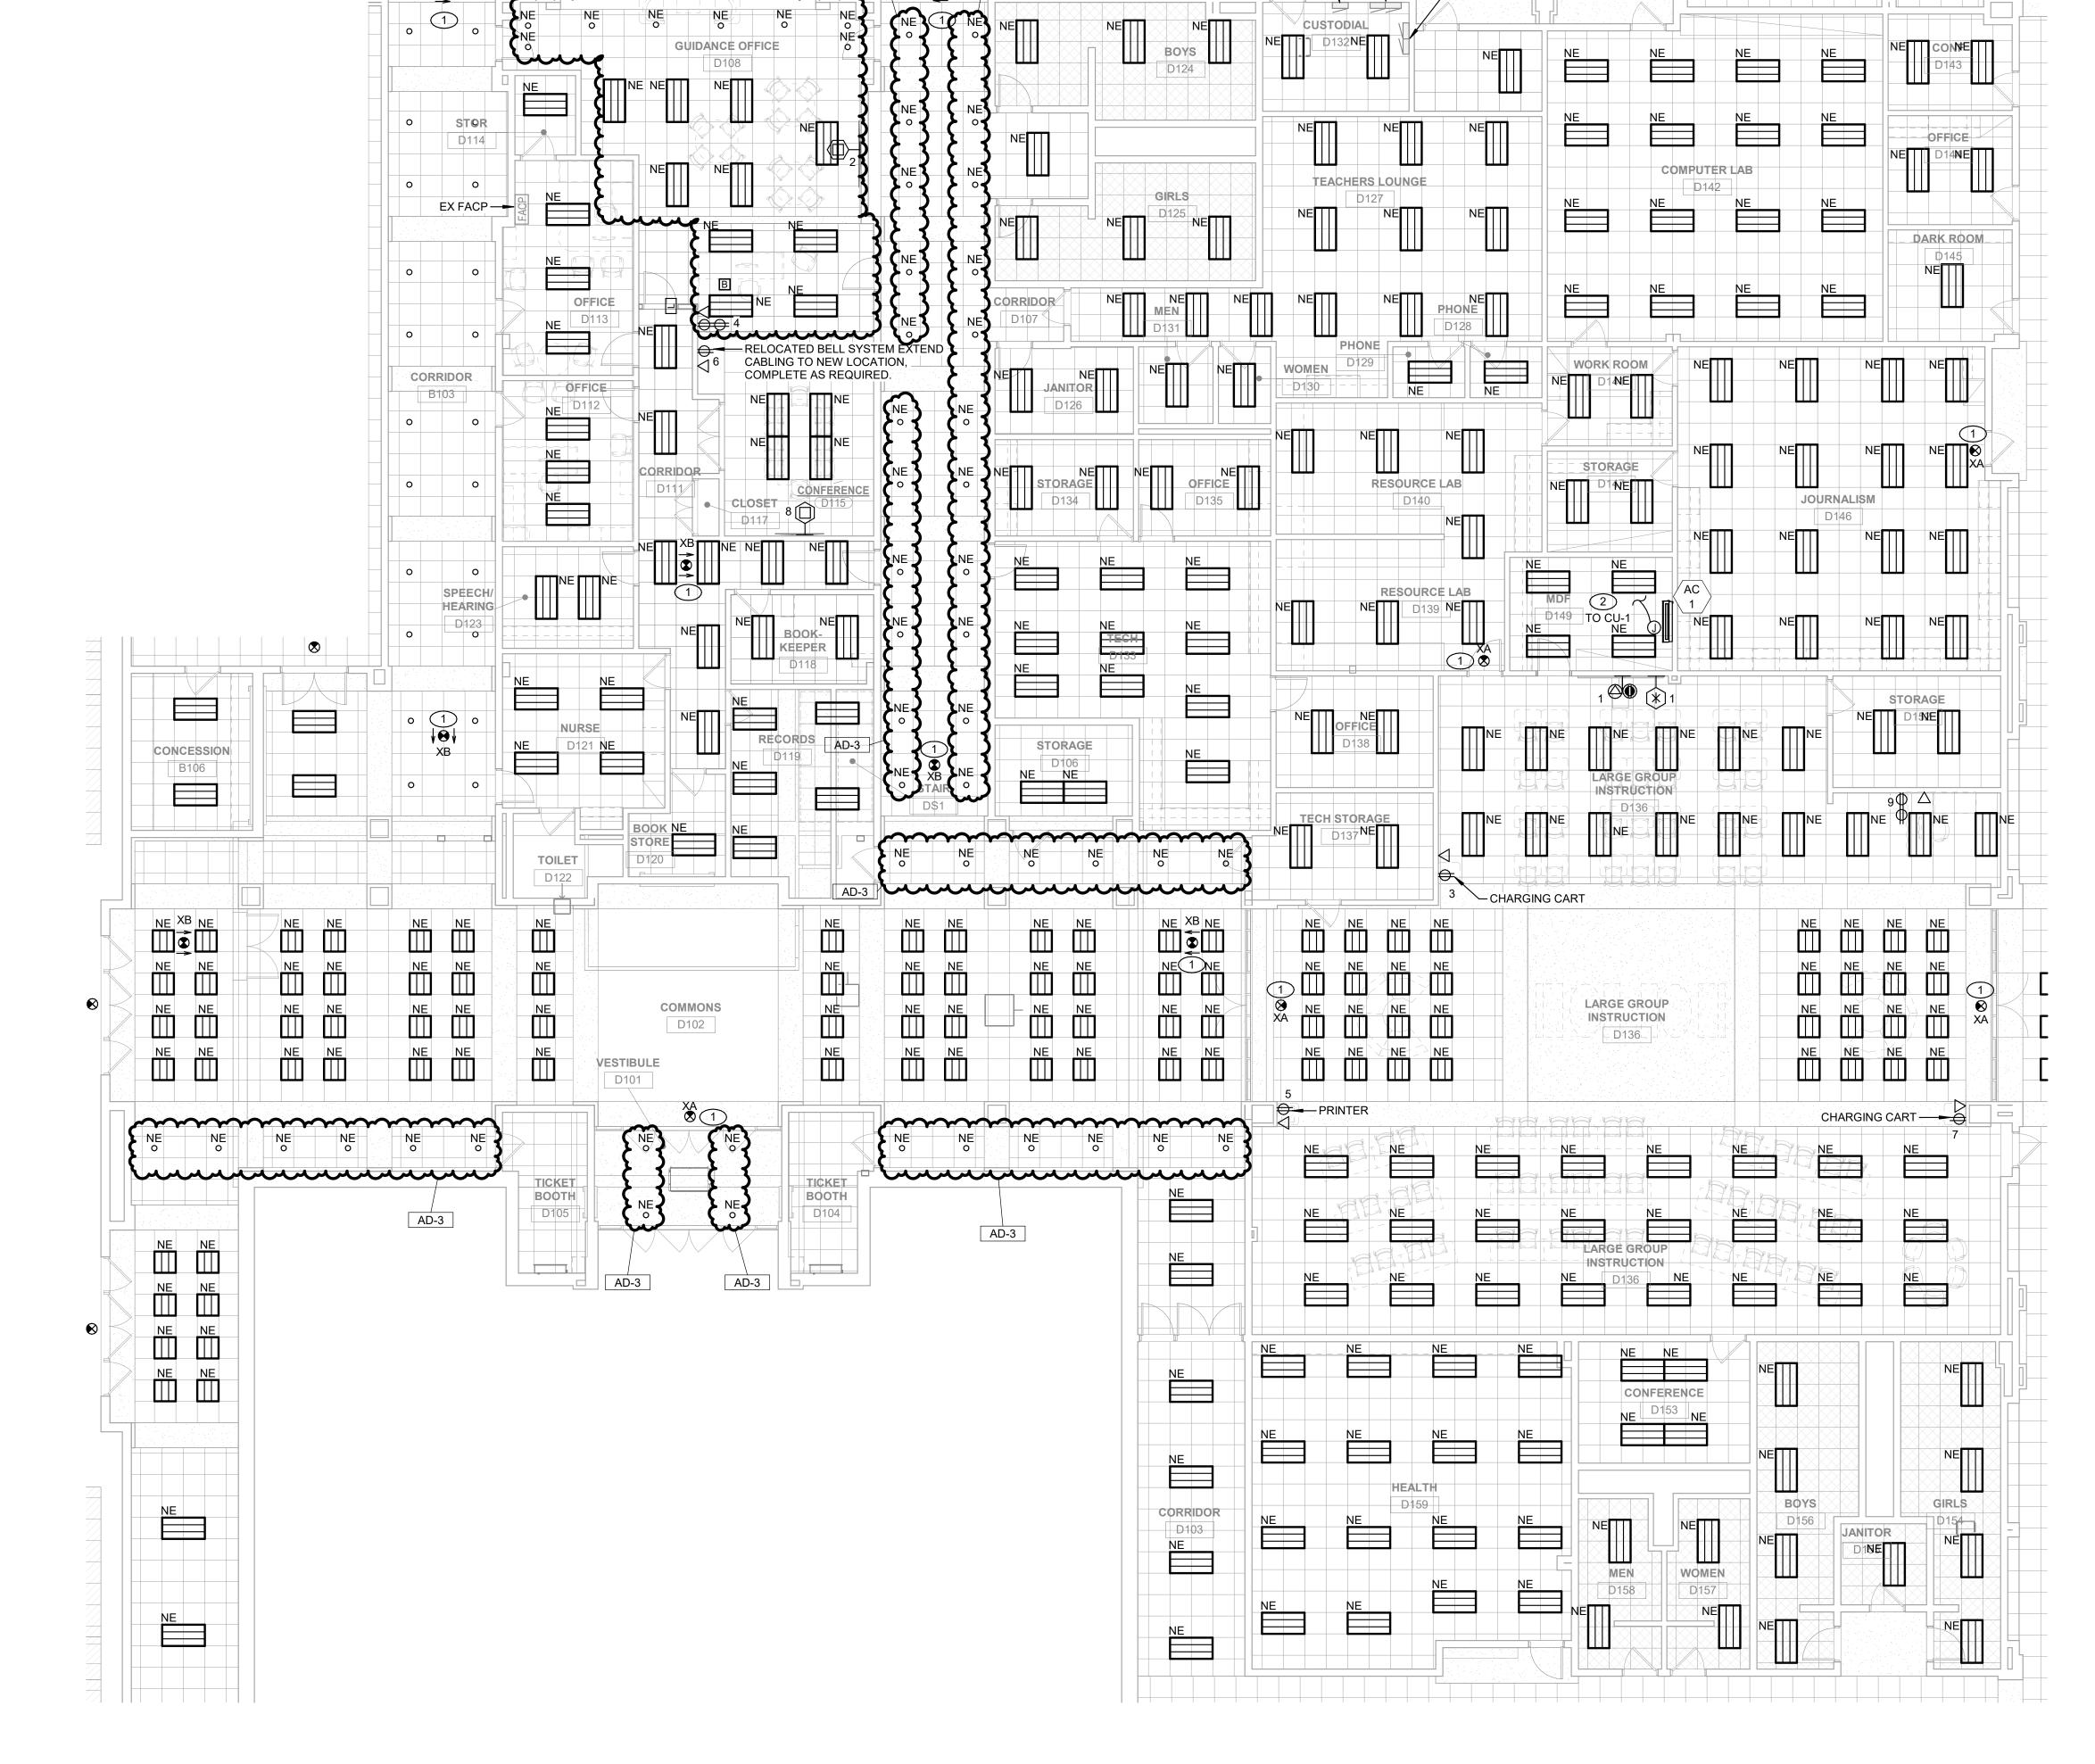

EX. PANEL L1

EX. PANEL L10

EX. PANEL H1—

EXISTING LIGHTING TO REMAIN UNLESS OTHERWISE NOTED. WHERE NECESSARY TO PERFORM MECHANICAL WORK ABOVE EXISTING CEILINGS, REMOVE, STORE, AND REINSTALL EXISTING LIGHTS, MOTION SENSORS, FIRE ALARM DEVICES, AND ANY OTHER CEILING MOUNTED ELECTRICAL DEVICES AS REQUIRED. REVIEW THE ENTIRE SET OF CONTRACT DOCUMENTS IN ORDER TO FULLY UNDERSTAND AND INCLUDE CEILING WORK NECESSARY FOR WORK ON THE PROJECT. WHEN THE WORK IS COMPLETED IN THE SPACE, REINSTALL EXISTING DEVICES AND EQUIPMENT TO COMPLETE MATCH EXISTING CONDITIONS. REPAIR OR REPLACE ANY DAMAGED EQUIPMENT OR DEVICES CAUSED BY THE REMOVAL, STORAGE, AND REINSTALLATION.

EX. PANEL L5

F102

TICKET

F106

BOOTH VESTIBULE

F101

NEO

TICKET

BOOTH

F105

NE

JANITOR

F108

## SHEET NOTES

1. RECONNECT NEW EXIT SIGN LIGHTING FIXTURES TO EXISTING EXIT SIGN EMERGENCY LIGHTING CIRCUITRY COMPLETE AS REQUIRED, MAXIMUM 4400 W PER 277 VOLT CIRCUIT. WHERE NECESSARY, DUE TO LIMITATIONS IN THE EXISTING CIRCUITRY, THIS CONTRACTOR SHALL FURNISH AND INSTALL 20A-1 POLE CIRCUIT BREAKERS AS REQUIRED IN EXISTING SPACE OF EXISTING PANEL, AND EXTEND 2 #12 AND 1 #12 GRD IN 3/4" CONDUIT COMPLETE AS REQUIRED. VERIFY CONDITIONS AND REQUIREMENTS IN FIELD.



DESIGN


ARCHITECTURE • ENGINEERING • INTERIOR DESIGN



PROJECT:

BOONE GROVE HIGH SCHOOL RENOVATION AND RELATED WORK

PORTER TOWNSHIP SCHOOL CORPORATION 260 S 500 W VALPARAISO, IN 46385

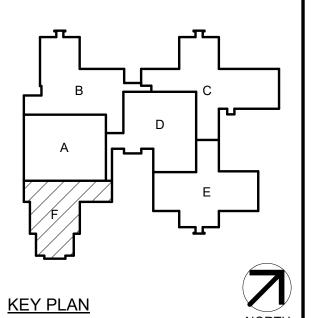

100% CONSTRUCTION SET

GIBRALTAR DESIGN
9102 N. Meridian St., Ste. 300
Indianapolis, IN 46260
Homepage: www.GibraltarDesign.com

9102 N. Meridian St., Ste. 300
Indianapolis, IN 46260
Homepage: www.GibraltarDesign.com
Email: info@GibraltarDesign.com
Phone 317.580.5777 Fax 317.580.5778

PROJECT
24-143

24-143
DATE
Sept 15, 2025
COORDINATED BY
AG
DRAWN BY
MG
CHECKED BY
DJ

COPYRIGHT NOTICE:

THE CONCEPTS, DESIGNS, PLANS, DETAILS, ETC, SHOWN ON THIS DOCUMENT ARE THE PROPERTY OF GIBRALTAR DESIGN AND WERE CREATED FOR USE ON THIS SPECIFIC PROJECT. NONE OF THIS INFORMATION SHALL BE USED BY ANY PERSON OR FIRM FOR ANY PURPOSE WITHOUT THE EXPRESS WRITTEN CONSENT OF GIBRALTAR DESIGN. THE OWNER MAY RETAIN COPIES FOR INFORMATION AND REFERENCE IN CONNECTION ONLY WITH THIS PROJECT.

REVISIONS

 MARK
 DATE
 ISSUED FOR

 AD-2
 10/09/25
 ADDENDUM NO. 2

 AD-3
 10/16/25
 ADDENDUM NO. 3

DRAWING
UNIT "F" ELECTRICAL FIRST
FLOOR PLAN

PROJECT
BOONE GROVE HIGH SCHOOL
RENOVATION AND RELATED
WORK

E-106



STORAGE/RECIEVING
F117

CORRIDOR

STORAGE

TWISTLOCK RECEPTACLE FOR

UTILIZE EX. 120V DEDICATED CIRCUIT. COORDINATE WITH

FINAL EQUIPMENT SHOP DRAWING AND PROVIDE NEW

CIRCUITRY AS REQUIRED.

AUXILIARY GYMNASIUM F109

> STAGE F110

NEW MOVABLE BLEACHERS.

**GYM STORAGE** F119

F112

NORTH

aurer\Documents\MEG\_Boone Grove HS\_MEP-R25\_Imaurer95SAD.rvt

LAUNDRY


A130

NE .

INL

CONCESSION



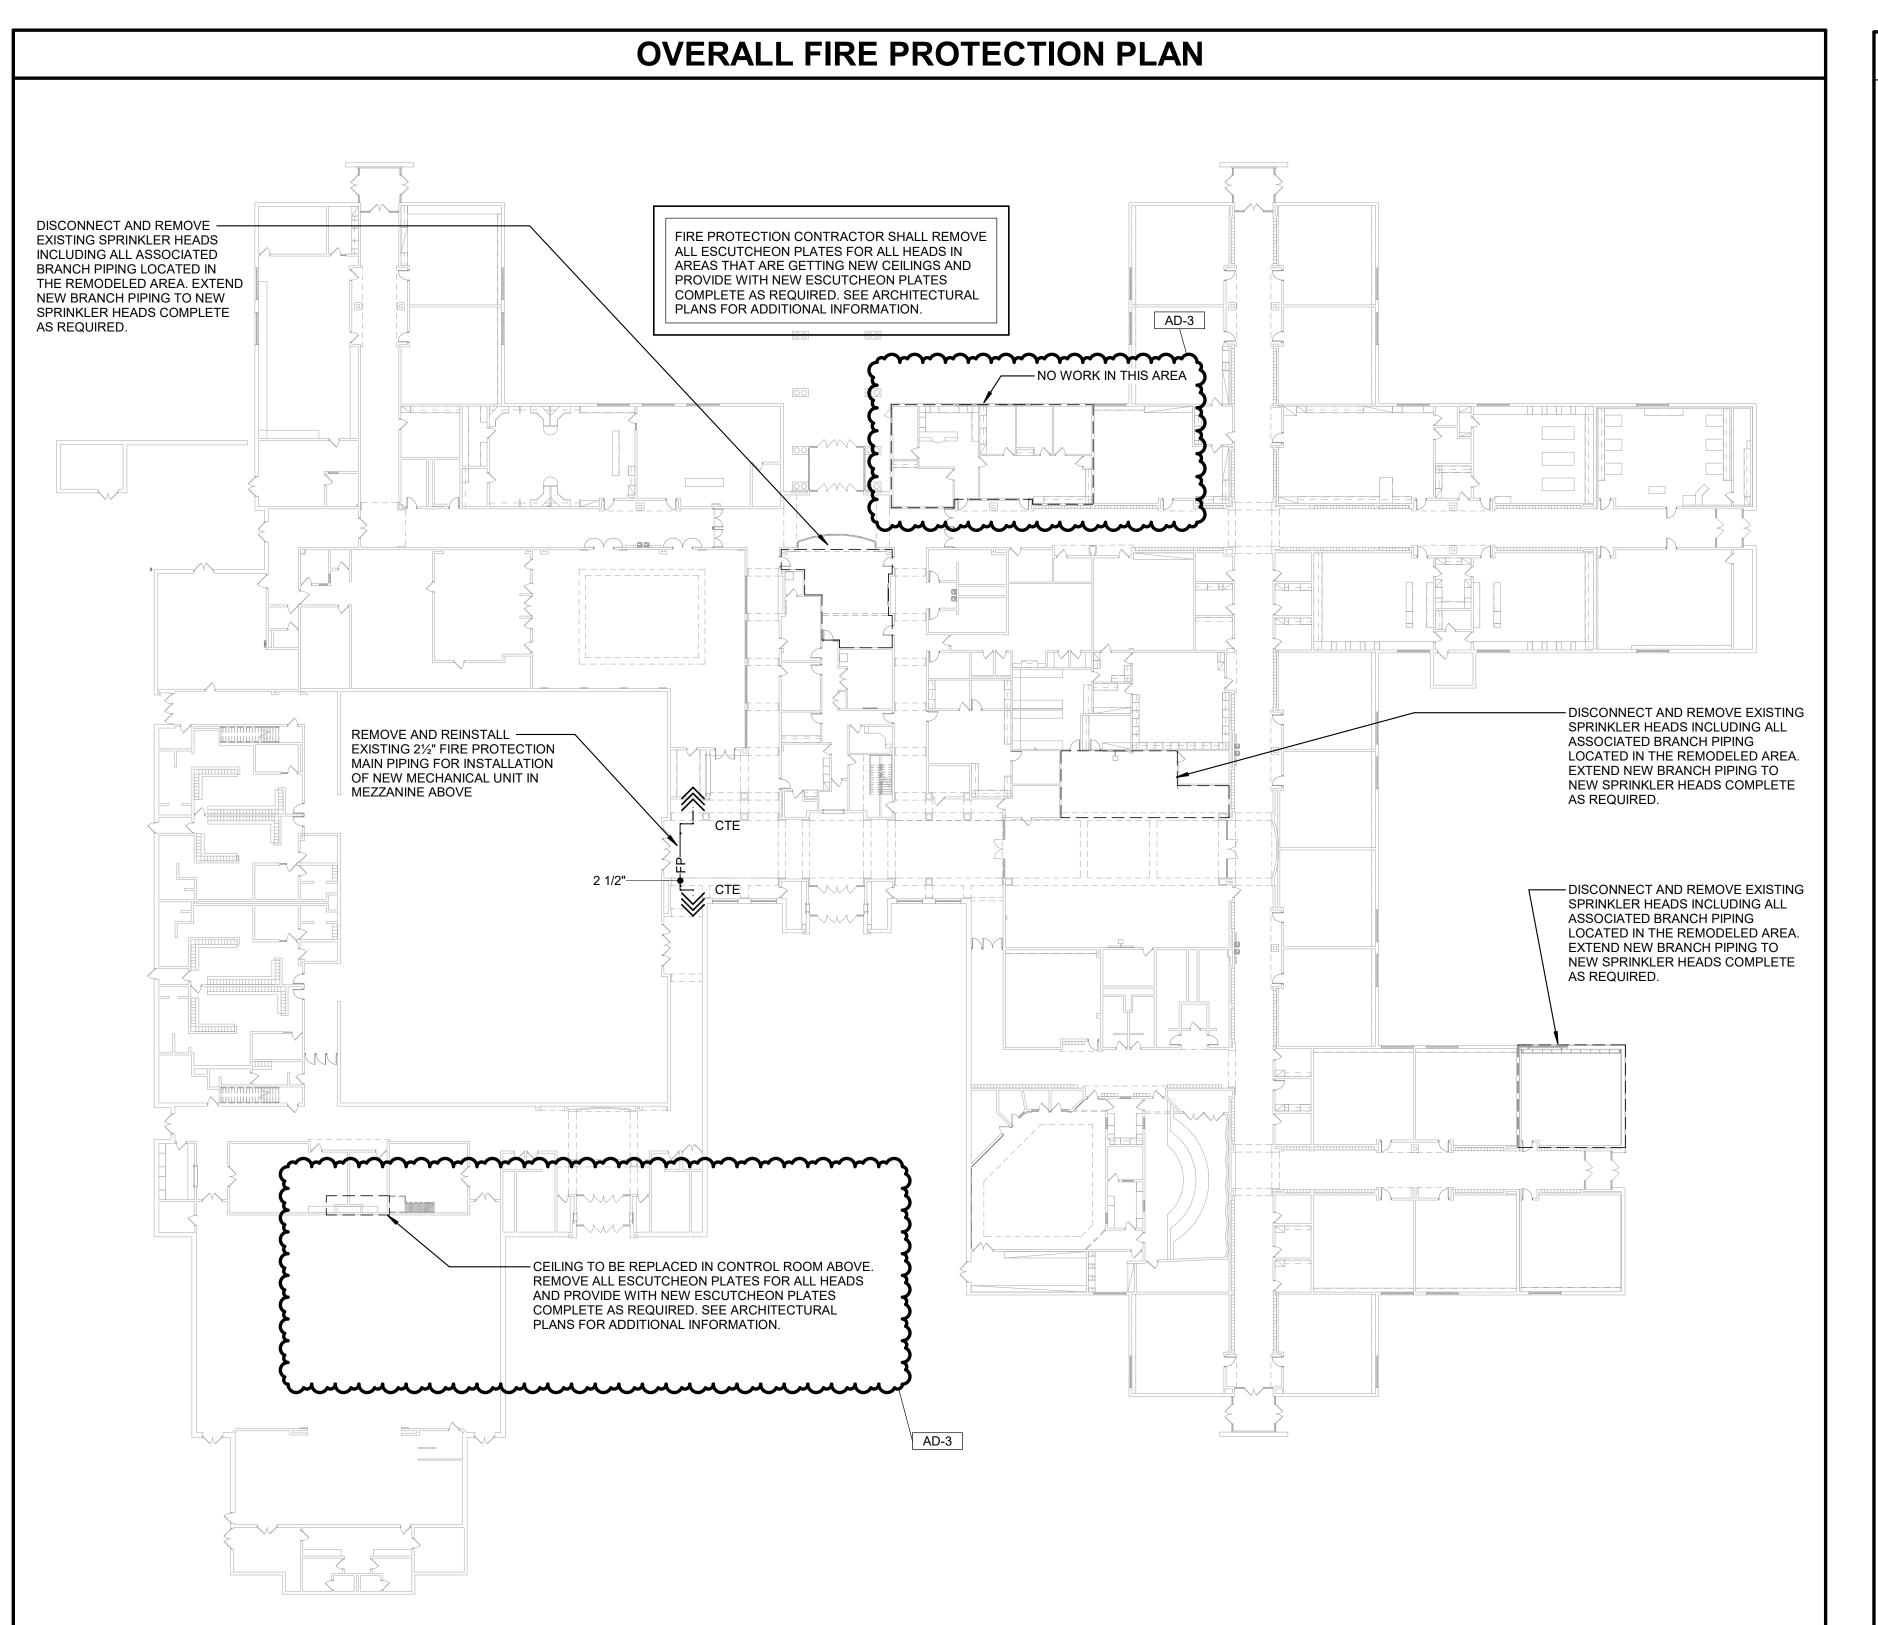

- WORK SHALL COMPLY WITH LOCAL, MUNICIPAL, STATE FIRE PROTECTION CODES, THE LATEST NFPA 13 REQUIREMENTS.
- B. THE SCOPE OF WORK SPECIFIED HEREIN AND IN THE SPECIFICATIONS SHALL BE COORDINATED WITH THE CONSTRUCTION MANAGER REFER TO THE SCOPE OF WORK FOR EACH TRADE. ANY DISCREPANCIES BETWEEN THE CONSTRUCTION DOCUMENTS AND CONSTRUCTION MANAGERS SCOPE SHALL BE BROUGHT TO THE ATTENTION OF THE ARCHITECT/ENGINEER FOR CLARIFICATION. THE ARCHITECT/ENGINEER'S DECISION SHALL BE FINAL.
- C. THE ENTIRE BUILDING SHALL BE FURNISHED AND INSTALLED WITH A COMPLETE AUTOMATIC SPRINKLER SYSTEM. EXISTING, REMODELED AND NEW ADDITION AREAS OF THIS BUILDING SHALL BE COVERED INCLUDING TUNNEL, ATTIC, CRAWLSPACE AND INTERSTITIAL SPACES.
- D. THE BUILDING HAS MULTIPLE OCCUPANCY CLASSIFICATIONS AND THE SPRINKLER SYSTEM SHALL BE DESIGNED FOR EACH CLASSIFICATION ACCORDING TO NFPA REQUIREMENTS. FOR PORTIONS OF THE FACILITY WITH AREAS OF DIFFERENT CLASSIFICATIONS THAT ARE NOT PHYSICALLY SEPARATED BY A BARRIER OR PARTITION, THE REQUIRED SPRINKLER PROTECTION FOR THE MORE DEMANDING AREA SHALL EXTEND 15'-0" BEYOND ITS PERIMETER.
- a. GENERAL AREAS ARE LIGHT HAZARD, 0.10 GPM/SQ.FT. FOR THE MOST REMOTE 1500 SO FT
- b. KITCHEN AREA IS ORDINARY HAZARD (GROUP 1), 0.15 GPM SQ.FT. FOR THE MOST REMOTE 1500 SQ.FT.
- E. THE REMODELED AREA SHALL HAVE THE EXISTING SPRINKLER SYSTEM MODIFIED WITH NEW SPRINKLER HEADS DESIGNED TO DELIVER A DENSITY OF .10 GPM OVER THE MOST REMOTE 1500 SQ.FT. CALCULATIONS SHALL BE IN ACCORDANCE WITH THE LATEST NFPA #13 CHAPTER FOR LIGHT HAZARD.
- LAYOUT IS DIAGRAMMATIC. INSTALL PIPING AND EQUIPMENT TO MEET ACTUAL FIELD CONDITIONS. REVIEW PROJECT SPECIFICATIONS BEFORE STARTING ANY WORK. SUBMIT SHOP DRAWINGS OF WORK AS PER SPECIFICATIONS.
- G. COORDINATE PHASING OF WORK AND PROVIDE TEMPORARY PIPING AND SERVICES AS REQUIRED FOR THE IMPLEMENTATION OF WORK WHILE MAINTAINING SERVICES TO PORTIONS OF BUILDING TO REMAIN OCCUPIED.
- H. SCHEDULE WORK TO AVOID DOWNTIME AND INCONVENIENCE TO OWNER. OWNER'S EXISTING FACILITY SHALL REMAIN IN OPERATION AT TIMES. REQUIRED SHUTDOWN OF EXISTING UTILITIES SHALL BE SCHEDULED WITH OWNER'S OPERATING PERSONNEL. NOTIFY OWNER'S REPRESENTATIVE 48 HOURS IN ADVANCE PRIOR TO ANY SHUTDOWN OF EXISTING SYSTEMS.
- I. FIRE PROTECTION PIPING ROUTING TO BE FIELD COORDINATED WITH NEW AND EXISTING HVAC DUCTWORK, HVAC PIPING, PLUMBING PIPING AND STRUCTURE TO ENSURE NO CONFLICTS WILL OCCUR DUE TO INTERFERENCE.
- J. REFER TO ARCHITECTURAL REFLECTED CEILING PLANS FOR HVAC DIFFUSER LAYOUT AND ELECTRICAL SPECIALTY DEVICES IN CONJUCTION WITH ELECTRICAL LIGHTING, SPRINKLER HEAD LAYOUT, AND CEILING GRID SYSTEM.
- K. VISIT SITE PRIOR TO BIDDING TO DETERMINE FIELD CONDITIONS. COORDINATE NEW INSTALLATIONS WITH EXISTING SYSTEMS. EXISTING CONDUIT, PIPING, DUCTWORK, EQUIPMENT, ETC., SHALL BE REWORKED AS REQUIRED TO AVOID CONFLICTS WITH THE INSTALLATION OF THE NEW FIRE PROTECTION SYSTEMS. NO EXTRAS WILL BE ALLOWED AFTER BIDDING FOR ANY REWORK OF EXISTING FIELD CONDITIONS TO RESOLVE CONFLICTS OR NOT FULLY UNDERSTANDING THE SCOPE OF THE WORK REQUIRED.
- L. EXISTING INFORMATION IDENTIFIED ON THE CONTRACT DOCUMENTS IS SCHEMATIC ONLY AS AN AID TO THE CONTRACTOR. PROPERLY ADDRESS EXISTING CONDITIONS FOR A COMPLETE AND PROPER INSTALLATION OF NEW SYSTEMS. EXISTING EQUIPMENT NOT IDENTIFIED SHALL BE REPORTED IN WRITTEN FORM FOR REVIEW AS TO WHETHER THE EQUIPMENT SHALL REMAIN AND BE RECONNECTED TO THE NEW SERVICES, BE RELOCATED, BE ABANDONED, ETC.
- M. HIDDEN CONDITIONS IDENTIFIED THROUGH THE COURSE OF CONSTRUCTION SHALL BE IMMEDIATELY REPORTED IN WRITTEN FORM FOR REVIEW AND DIRECTION. FAILURE TO DO SO SHALL MAKE THE CONTRACTOR RESPONSIBLE FOR REQUIRED CHANGES AND COSTS TO CORRECT SAID HIDDEN CONDITION.
- N. COORDINATE NEW INSTALLATIONS WITH EXISTING SYSTEMS. EXISTING CONDUIT, PIPING, DUCTWORK, EQUIPMENT, ETC., SHALL BE REWORKED AS REQUIRED TO AVOID CONFLICTS WITH THE INSTALLATION OF THE NEW FIRE PROTECTION SYSTEMS. NO EXTRAS WILL BE ALLOWED AFTER BIDDING FOR ANY REWORK OF EXISTING FIELD CONDITIONS TO RESOLVE CONFLICTS OR NOT FULLY UNDERSTANDING THE SCOPE OF THE WORK REQUIRED.
- O. REMOVE EXISTING CEILINGS REQUIRED FOR INSTALLATION OF NEW WORK. REINSTALL CEILING UPON COMPLETION OF WORK REPLACE DAMAGED CEILING MATERIALS TO MATCH EXISTING. GYPSUM BOARD CEILINGS: PROVIDE CONCEALED CONTROL JOINT AT EDGES ABUTTING EXISTING GYPSUM BOARD CEILINGS. TAPE IN NEW AREAS TO EXISTING FLUSH PROVIDE TEXTURE TO MATCH EXISTING.
- P. REMOVE EXISTING SPRINKLER HEADS AND ASSOCIATED BRANCH SPRINKLER PIPING COMPLETE AS REQUIRED. EXTEND AND MODIFY EXISTING PIPING AS REQUIRED FOR NEW SPRINKLER HEAD
- Q. REMOVED PIPING IS TO BE TERMINATED PROPERLY BACK TO EXISTING MAINS. CAP PIPING WATERTIGHT. PROVIDE ADDITIONAL PIPING AS REQUIRED TO MAINTAIN CONTINUITY OF EXISTING SYSTEMS MODIFIED DUE TO REMOVAL OF PORTION OF SYSTEMS. NO EQUIPMENT, PIPING, SUPPORTS, HANGERS, ETC, IS TO BE LEFT ABANDONED. VERIFY QUANTITY, LOCATION AND ELEVATION OF EXISTING TO BE REMOVED IN FIELD.
- REMOVE EXISTING CEILINGS AND LIGHT FIXTURES REQUIRED FOR INSTALLATION OF NEW WORK. REINSTALL CEILING AND LIGHT FIXTURES UPON COMPLETION OF WORK. REPLACE DAMAGED CEILING MATERIALS TO MATCH EXISTING.
- S. CUT OR CHANNEL INTO EXISTING WALL CONSTRUCTIONS AS REQUIRED FOR INSTALLATION OF NEW PIPING WITHIN EXISTING WALLS. PATCH WALL SURFACES AND FINISH AS REQUIRED TO MATCH EXISTING CONDITIONS.
- T. SPRINKLER HEADS IN FINISHED CEILING SPACES SHALL BE SEMI-RECESSED TYPE WITH WHITE ESCUTCHEON PLATE OR CONCEALED TYPE. SPRINKLER HEADS IN UNFINISHED SPACES SHALL BE PENDENT, UPRIGHT, OR SIDEWALL TYPE.
- U. SPRINKLER HEADS LOCATED IN SUSPENDED LAY-IN CEILING SYSTEMS SHALL BE CENTERED IN EACH RESPECTIVE TILE. PROVIDE 6" SWINGS TO PLACE THE SPRINKLER IN THE CENTER OF THE
- V. PIPING SHALL BE HYDROSATICALLY TESTED AT 200 PSI OR 50 PSI OVER THE MAXIMUM OPERATING PRESSURE, WHICHEVER IS GREATER, FOR A PERIOD OF TWO HOURS.
- W. PIPES SHALL BE SUPPORTED FROM THE BUILDING STRUCTURE IN ACCORDANCE WITH THE
- X. PIPING, EQUIPMENT, ETC. SHALL NOT BE SUPPORTED FROM THE BOTTOM CHORD OF ENGINEERED JOISTS WITHOUT WRITTEN APPROVAL FROM THE STRUCTURAL ENGINEER.
- WET SYSTEM PIPING SHALL BE INSTALLED LEVEL, TO DRAIN BACK TO THE SYSTEM RISER. TRAPPED SECTIONS OF PIPING SHALL HAVE AUXILLIARY DRAIN CONNECTIONS IN ACCORDANCE WITH LATEST NFPA #13.
- WITH LATEST NEPA #13.Z. PROVIDE EXTENDED COVERAGE HEADS IN CORRIDORS WIDER THAN 15'-0".

## **SYMBOLS & ABBREVIATIONS LIST**

- CONCEALED TYPE SPRINKLER HEAD WITH WHITE COVER PLATE
- SEMI-RECESSED TYPE SPRINKLER HEAD WITH WHITE ESCUTCHEON PLATE
- EXPOSED UPRIGHT OR PENDANT TYPE SPRINKLER HEAD

— FP — FIRE PROTECTION PIPING

PIPING ROUTED DN

PIPING ROUTED UP

FP FIRE PROTECTION

GIBRALTAR DESIGN



ARCHITECTURE • ENGINEERING • INTERIOR DESIGN

PROJECT:

BOONE GROVE HIGH SCHOOL RENOVATION AND RELATED WORK

PORTER TOWNSHIP SCHOOL CORPORATION

VALPARAISO, IN 46385

260 S 500 W

100% CONSTRUCTION SET

GIBRALTAR DESIGN

9102 N. Meridian St., Ste. 300
Indianapolis, IN 46260
Homepage: www.GibraltarDesign.com
Email: info@GibraltarDesign.com
Phone 317.580.5777 Fax 317.580.5778

PROJECT

24-143
DATE
Sept 15, 2025
COORDINATED BY
LVB
DRAWN BY
CC

REGISTERED NO.

10302590

STATE OF

AVDIANA

AND ENGINE

COPYRIGHT NOTICE:

THE CONCEPTS, DESIGNS, PLANS, DETAILS, ETC, SHOWN ON THIS DOCUMENT ARE THE PROPERTY OF GIBRALTAR DESIGN AND WERE CREATED FOR USE ON THIS SPECIFIC PROJECT. NONE OF THIS INFORMATION SHALL BE USED BY ANY PERSON OR FIRM FOR ANY PURPOSE WITHOUT THE EXPRESS WRITTEN CONSENT OF GIBRALTAR DESIGN. THE OWNER MAY RETAIN COPIES FOR INFORMATION AND REFERENCE IN CONNECTION ONLY WITH THIS PROJECT.

REVISIONS

CHECKED BY

 MARK
 DATE
 ISSUED FOR

 AD-2
 10/09/25
 ADDENDUM NO. 2

 AD-3
 10/16/25
 ADDENDUM NO. 3

DRAWING
FIRE PROTECTIN NOTES,
SYMBOLS & ABBREVIATIONS

PROJECT
BOONE GROVE HIGH SCHOOL
RENOVATION AND RELATED

© GIBRALTAR

FP-001