PROJECT:

# VALPARAISO HIGH SCHOOL WEST CAMPUS IMPROVEMENTS

VALPARAISO COMMUNITY SCHOOLS
VALPARAISO, INDIANA

100% CONSTRUCTION DOCUMENTS
07/24/2020

## SHEET INDEX


### G GENERAL

G-101 COVER SHEET AND SHEET INDEX
G-201 LIFE SAFETY PLAN
G-301 MOUNTING HEIGHTS, ABBREVIATIONS, AND SYMBOLOGY

### C CIVIL

C-1.0 EXISTING TOPOGRAPHY AND UTILITIES
C-1.1 DEMOLITION PLAN
C-2.1 SITE PLAN
C-2.1A SITE PLAN – ALTERNATE
C-2.1B ENLARGE SOFTBALL FIELD LAYOUT PLAN
C-2.1C ENLARGE BASEBALL FIELD LAYOUT PLAN — AD-2
C-3.1 GRADING, WATER MAIN & SANITARY SEWER PLAN
C-3.2 GRADING, WATER MAIN & SANITARY SEWER PLAN
C-3.2A GRADING PLAN – ALTERNATE
C-3.3 GRADING, WATER MAIN & SANITARY SEWER PLAN
C-4.0 DETAILS AND SPECIFICATIONS
C-4.1 DETAILS AND SPECIFICATIONS
C-4.2 DETAILS
C-5.0 STORM WATER POLLUTION PREVENTION PLAN (SWPPP)
C-6.0 SWPPP GENERAL NOTES
C-6.1 SWPPP DETAILS AND SPECIFICATIONS
C-6.2 SWPPP DETAILS AND SPECIFICATIONS

### S STRUCTURAL

S-201 CLEAT HOUSE FOUNDATION PLAN
S-202 PRESS BOX AND DUGOUT FOUNDATION PLANS
S-203 CLEAT HOUSE STRUCTURAL FRAMING PLAN
S-204 PRESS BOX AND DUGOUT STRUCTURAL FRAMING PLANS
S-401 FOUNDATION SECTIONS AND DETAILS
S-402 FOUNDATION SECTIONS AND DETAILS
S-403 FRAMING/STRUCTURAL DETAILS
S-501 STRUCTURAL NOTES

### A ARCHITECTURAL

A-101 CLEAT HOUSE ARCHITECTURAL DEMOLITION AND NEW FLOOR PLANS
A-102 PRESS BOX AND DUGOUT ARCHITECTURAL FLOOR PLANS
A-110 PLAN DETAILS
A-201 ARCHITECTURAL ROOF PLAN AND TYPICAL DETAILS
A-210 ROOF DETAILS
A-301 CLEAT HOUSE EXTERIOR ELEVATIONS
A-302 PRESS BOX AND DUGOUT EXTERIOR ELEVATIONS
A-303 TENNIS PLATFORM AND ENTRANCE GATE EXTERIOR ELEVATIONS — AD-1
A-401 WALL SECTIONS
A-402 WALL SECTIONS
A-403 WALL SECTIONS
A-501 TYPICAL DETAILS
A-601 DOOR SCHEDULE, FRAME PROFILES, ELEVATIONS, AND DETAILS
A-610 STOREFRONT AND WINDOW ELEVATIONS AND DETAILS
A-701 CLEAT HOUSE AND PRESS BOX EQUIPMENT PLANS
A-710 ENLARGED TOILET ROOM PLANS
A-720 CASEWORK SCHEDULE AND ELEVATIONS
A-801 CLEAT HOUSE AND PRESS BOX FINISH PLANS, FINISH LEGEND AND DETAILS
A-901 CLEAT HOUSE REFLECTED CEILING PLAN

### M MECHANICAL

M-001 MECHANICAL NOTES, SYMBOLS & ABBREVIATIONS
M-101 MECHANICAL DEMOLITION FLOOR & ROOF PLANS
M-201 MECHANICAL HVAC FLOOR PLANS
M-301 MECHANICAL HVAC ROOF PLAN
M-501 MECHANICAL SCHEDULES
M-601 MECHANICAL DIAGRAMS

### P PLUMBING

P-001 PLUMBING NOTES, SYMBOLS & ABBREVIATIONS
P-101 PLUMBING DEMOLITION FLOOR & ROOF PLANS
P-201 PLUMBING UNDERFLOOR PLANS
P-202 PLUMBING FLOOR PLAN
P-301 PLUMBING ROOF PLAN
P-501 PLUMBING EQUIPMENT SCHEDULES & DETAILS
P-601 PLUMBING DIAGRAMS

### E ELECTRICAL

E-001 ELECTRICAL SYMBOLS, DETAILS AND NOTES
ES101 ELECTRICAL DEMOLITION SITE PLAN
ES102 ELECTRICAL SITE PLAN
ES103 ENLARGED ELECTRICAL PLANS OF SOFTBALL AND BASEBALL FIELDS
E-101 ELECTRICAL CLEAT HOUSE LIGHTING PLANS
E-201 ELECTRICAL CLEAT HOUSE POWER PLANS
E-202 ELECTRICAL PLANS OF THE PRESSBOXES AND TENNIS COURT PLATFORM
E-203 ELECTRICAL PLANS OF DUGOUTS
E-401 ENLARGED ELECTRICAL PLANS
E-501 ELECTRICAL DETAILS
E-601 ELECTRICAL SCHEDULES
E-602 ELECTRICAL SCHEDULES
E-603 ELECTRICAL SCHEDULES
E-701 ELECTRICAL POWER DISTRIBUTION DIAGRAM

### T TELECOMMUNICATIONS

T001 TELECOMMUNICATIONS LEGEND
T002 TELECOMMUNICATIONS LEGEND
T003 TELECOMMUNICATIONS NOTES
T100 TELECOMMUNICATIONS SITE PLAN
T101 CLEAT HOUSE TELECOMMUNICATIONS PLAN
T301 CLEAT HOUSE TELECOMMUNICATIONS ELEVATIONS
T302 PRESS BOX TELECOMMUNICATIONS PLAN
T401 TELECOMMUNICATIONS ENLARGED PLAN
T501 FACEPLATES
T601 GROUNDING DIAGRAM
T701 TELECOM DEVICE SYSTEMS ROUGH-IN
T761 A/V SYSTEMS ROUGH-IN
T781 SECURITY SYSTEMS ROUGH-IN



TORRENGA ENGINEERING, INC.
CONSULTING ENGINEERS & LAND SURVEYORS

Lynch, Harrison & Brumleve, Inc.

MILLIES ENGINEERING GROUP
MILLIES • JANNEY • HROMADA
9711 VALPARAISO DR
SUITE A
MUNSTER, IN 46321
219-924-8400

TECHNOLOGY DYNAMICS
www.techdyn.net

GIBRALTAR DESIGN
ARCHITECTURE ENGINEERING INTERIOR DESIGN
The SKILLMAN Corporation


ARCHITECT OF RECORD — JOSEPH P. BRIGGS, REGISTERED NO. 11600109, STATE OF INDIANA, ARCHITECT

ENGINEER OF RECORD — DONALD C. TORRENGA, REGISTERED No. 19868, STATE OF INDIANA, PROFESSIONAL ENGINEER

ENGINEER OF RECORD — WESLEY B. HARRISON, REGISTERED No. 8604101, STATE OF INDIANA, PROFESSIONAL ENGINEER

ENGINEER OF RECORD — DAVID G. JANNEY, REGISTERED NO. 10302590, STATE OF INDIANA, PROFESSIONAL ENGINEER

ENGINEER OF RECORD — REGISTERED COMMUNICATIONS DISTRIBUTION DESIGNER, BICSI, Brian K Scott, BICSI ID # 114038, EXPIRES 12-31-21

GIBRALTAR DESIGN
ARCHITECTURE • ENGINEERING • INTERIOR DESIGN

PROJECT
VALPARAISO HIGH SCHOOL WEST CAMPUS IMPROVEMENTS
VALPARAISO COMMUNITY SCHOOLS
VALPARAISO, INDIANA


GIBRALTAR DESIGN
9102 N. Meridian St., Ste. 300
Indianapolis, IN 46260
Homepage www.GibraltarDesign.com
Email info@GibraltarDesign.com
Phone 317.580.5777 Fax 317.580.5778


PROJECT 20-130
DATE 07/24/20
COORDINATED BY JPB
DRAWN BY DTB
CHECKED BY JPB


COPYRIGHT NOTICE:
THE CONCEPTS, DESIGNS, PLANS, DETAILS, ETC., SHOWN ON THIS DOCUMENT ARE THE PROPERTY OF GIBRALTAR DESIGN AND WERE CREATED FOR USE ON THIS SPECIFIC PROJECT. NONE OF THIS INFORMATION SHALL BE USED BY ANY PERSON OR FIRM FOR ANY PURPOSE WITHOUT THE EXPRESS WRITTEN CONSENT OF GIBRALTAR DESIGN. THE OWNER MAY RETAIN COPIES FOR INFORMATION AND REFERENCE IN CONNECTION ONLY WITH THIS PROJECT.


REVISIONS

| MARK | DATE | ISSUED FOR |
|---|---|---|
| AD-1 | 08/03/20 | ADDENDUM NO. 1 |
| AD-2 | 08/07/20 | ADDENDUM NO. 2 |

DRAWING
COVER-SHEET INDEX

PROJECT
VALPARAISO HIGH SCHOOL WEST CAMPUS IMPROVEMENTS


© GIBRALTAR DESIGN


SHEET
G-101

Friday, 8/7/2020 – 5:06 PM – LAST SAVED BY:DBURNS
Y:\20-130 VALPARAISO CS – VHS WEST CAMPUS IMPROVEMENTS\20-130 DRAWINGS\02 GENR\G-101.DWG

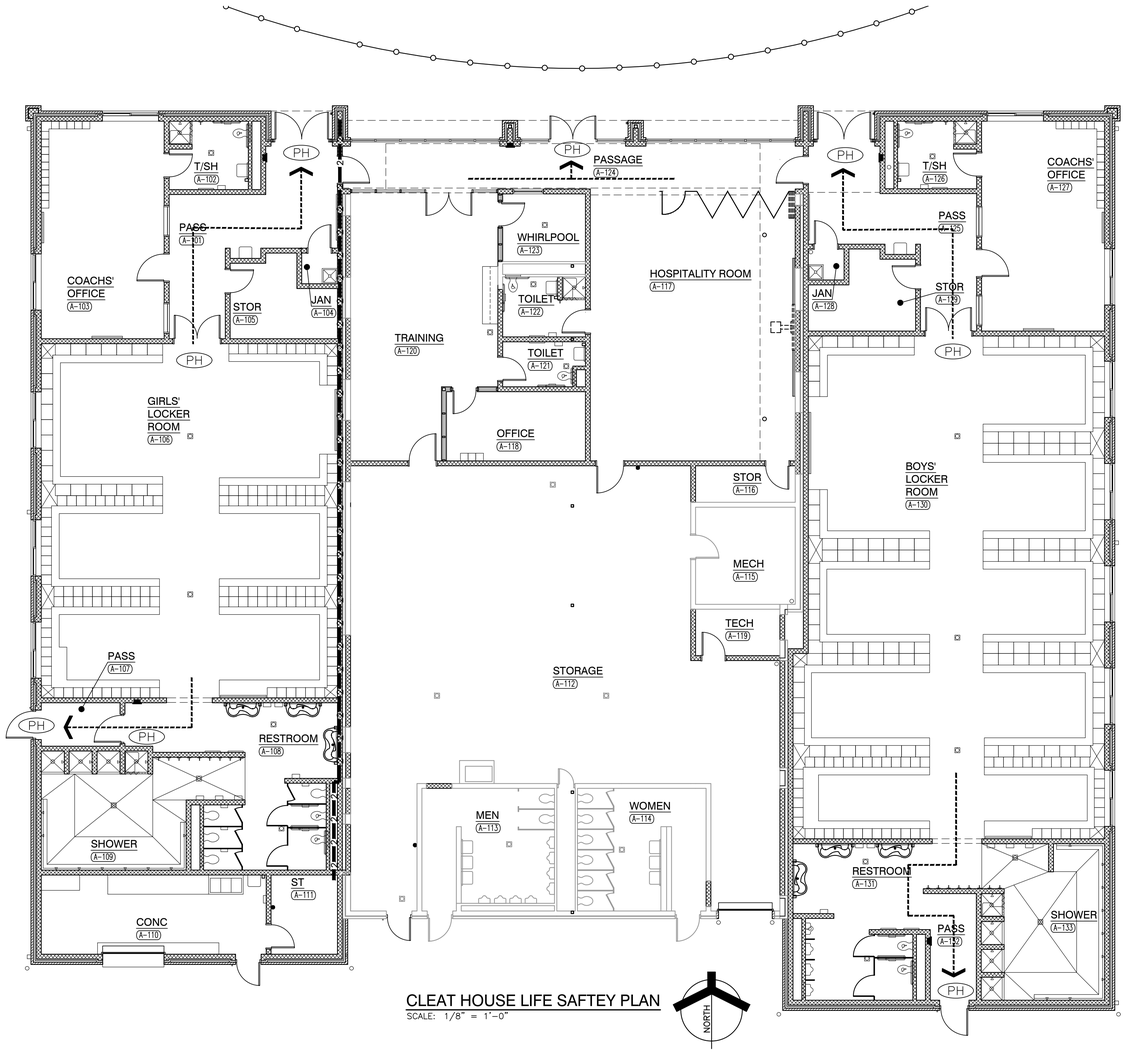


CLEAT HOUSE LIFE SAFTEY PLAN
SCALE: 1/8" = 1'-0"

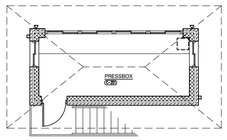


BASEBALL PRESS BOX SECOND FLOOR LIFE SAFTEY PLAN
SCALE: 1/8" = 1'-0"

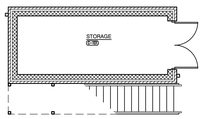


BASEBALL PRESS BOX FIRST FLOOR LIFE SAFTEY PLAN
SCALE: 1/8" = 1'-0"

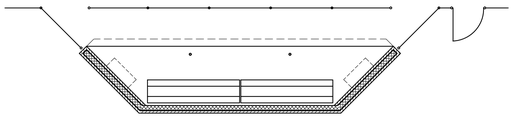

DUGOUT LIFE SAFTEY PLAN
SCALE: 1/8" = 1'-0"

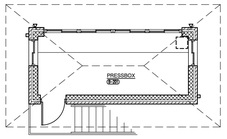


SOFTBALL PRESS BOX SECOND FLOOR LIFE SAFTEY PLAN
SCALE: 1/8" = 1'-0"

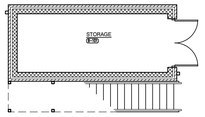


SOFTBALL PRESS BOX FIRST FLOOR LIFE SAFTEY PLAN
SCALE: 1/8" = 1'-0"

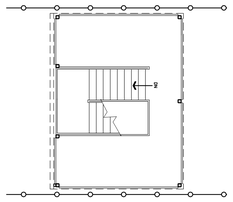

TENNIS PLATFORM LIFE SAFTEY PLAN
SCALE: 1/8" = 1'-0"

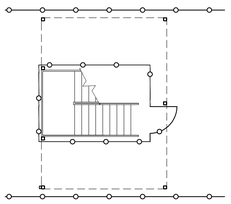


TENNIS PLATFORM GROUND LIFE SAFTEY PLAN
SCALE: 1/8" = 1'-0"

## LIFE SAFETY GENERAL NOTE:

LIFE SAFETY INFORMATION IS PROVIDED FOR USE BY ALL CONTRACTORS. CONTRACTORS ARE RESPONSIBLE FOR COMPLYING WITH CODE REQUIREMENTS (INCLUDING BUT NOT LIMITED TO: RATED ASSEMBLIES, FIRE PROTECTION, FIRESTOPPING, DAMPERS, AND HARDWARE) INDICATED INCLUDING CONDITIONS WHERE THESE REQUIREMENTS ARE NOT DETAILED. REPORT CONFLICTS OR DISCREPANCIES TO THE ARCHITECT FOR RESOLUTION PRIOR TO STARTING WORK.

## CLEAT HOUSE CODE REVIEW:

| | |
|---|---|
| Applicable Code: | 2014 Indiana Building Code (IBC 2012)<br>General Administrative Rules, 2nd Edition (GAR)<br>2014 Indiana Mechanical Code (IMC)<br>ICC/ANSI A-117.1 Standard, 2009 Edition |
| Occupancy Classifications: | Educational use areas for elementary school students<br>– E Occupancy [305.1]<br>Assembly uses accessory to an E Occupancy are not considered separate occupancies [303.1.3] |
| Scope of Project: | The project is a renovation of a 1 story Cleat House building along with 2 locker room additions on either side. |
| Code Strategy: | The additions are allowed to be unseparated from the existing building based on compliance with the current code for allowable area and height. |
| Construction Type: | Type II B (unprotected) Construction permitted based upon allowable area. [503.1] |
| Allowable Area: | Tabular Area: 14,500 sf [Table 503]<br>Frontage Increase: 10,875 sf [506.2]<br>Allowable Area: 25,375 sf<br>Actual Area: 15,377 sf |
| Allowable Height: | 2 Stories allowed [504.2]<br>1 Stories actual |
| Building Elements – Fire Resistive Requirements: | Bearing walls, structural frame, floor assemblies, and roof assembly are permitted to be of nonrated noncombustible construction [Table 601]<br>Exterior walls are permitted to be nonrated based upon having a fire separation distance of 10 feet or more [Table 602]<br>Penetrations through fire-resistance-rated assemblies shall be provided with firestopping per project manual. |
| Incidental Use Separations: | Required per table 509 |
| Means of Egress: | 2 means of egress are required from rooms with a calculated occupant load of 50 or more, or where exceeding 75 feet common path of travel in E Occupancy spaces and 100 feet in B Occupancy spaces [1015.1] |
| Exit Access Travel Distance: | The maximum travel distance to an exterior exit is permitted to be a maximum of 200 feet [1016.1] |
| Panic Hardware: | Panic hardware is required on all means of egress doors serving an occupant load of 50 or more [1008.1.9] |
| Automatic Sprinklers: | Automatic sprinklers are not required based on each fire area having less than 12,000 sq ft or area, and provision of required fire fighter access openings [903.2.3]<br>A 2-hour fire barrier will be provided to separate the west addition in order to limit fire areas in the building to less than 12,000 sq ft. [707.3.10] |
| Fire Alarm System: | Fire alarm system required throughout [907.2.3] |
| Smoke Detectors: | Smoke detectors are required for HVAC shutdown for systems delivering in excess of 2,000 cfm. [606.1, IMC] |

## PRESS BOX CODE REVIEW:

| | |
|---|---|
| Occupancy Classifications: | Press box<br>– B Occupancy [304.1]<br>Storage<br>– S-1 Occupancy [311.2] |
| Construction Type and Allowable Area and Height: | Type IIIB Construction required based upon 2 stories allowable height [Table 503]<br>Allowable area per floor is 17,500 sq ft [Table 503]<br>Actual area per floor is approximately 200 sq ft |
| Building Elements | Building elements are permitted to be of nonrated combustible construction other than exterior walls which are required to be noncombustible [Table 601] |
| Incidental Use Separations: | None applicable [Table 509] |
| Automatic Sprinklers: | Not required [903.2.3] |
| Fire Alarm System: | Not required [907.2.2] |
| Accessibility: | An accessible route is not required to the press box [1104.3.2, exc. 2] |

## DUGOUT CODE REVIEW:

| | |
|---|---|
| Occupancy Classifications: | Dugout – personal shelter with less than 50 occupants<br>– B Occupancy [304.1] |
| Construction Type and Allowable Area: | Type VB Construction permitted based upon allowable area of 9,000 sq ft [Table 503]<br>Actual area is 340 square feet for each structure |
| Building Elements | Building elements are permitted to be of nonrated combustible construction [Table 601] |
| Incidental Use Separations: | None applicable [Table 509] |
| Automatic Sprinklers: | Not required [903.2] |
| Fire Alarm System: | Not required [907.2] |

## TENNIS PLATFORM CODE REVIEW:

| | |
|---|---|
| Occupancy Classifications: | Elevated platform for coaches and officials for viewing of tennis matches – occupant load of less than 50<br>– B Occupancy [304.1] |
| Construction Type and Allowable Area: | Type VB Construction permitted based upon allowable area of 9,000 sq ft [Table 503]<br>Actual area is 388 square feet |
| Building Elements | Building elements are permitted to be of nonrated combustible construction [Table 601] |
| Incidental Use Separations: | None applicable [Table 509] |
| Automatic Sprinklers: | Not required [903.2] |
| Fire Alarm System: | Not required [907.2] |

## LIFE SAFETY PLAN LEGEND

AD-2

DOORS WITH PANIC HARDWARE — PH

MAJOR EGRESS ROUTES

2 HOUR CONSTRUCTION — 2 — 2 — INDICATES 2 HOUR FIRE-RESISTANT RATE FIRE BARRIER WITH 90 MIN RATED OPENING PROTECTIVES, SECTION 706

## CLEAT HOUSE SQUARE FOOTAGE ANALYSIS

| | |
|---|---|
| EXISTING | 6,166 SQ. FT. |
| RENOVATED | 2,829 SQ. FT. |
| NEW | 9,359 SQ. FT. |
| TOTAL | 15,525 SQ. FT. |

GIBRALTAR DESIGN
ARCHITECTURE • ENGINEERING • INTERIOR DESIGN

PROJECT
# VALPARAISO HIGH SCHOOL WEST CAMPUS IMPROVEMENTS

VALPARAISO COMMUNITY SCHOOLS
VALPARAISO, INDIANA

GIBRALTAR DESIGN
9102 N. Meridian St., Ste. 300
Indianapolis, IN 46260
Homepage www.GibraltarDesign.com
Email info@GibraltarDesign.com
Phone 317.580.5777 Fax 317.580.5778

PROJECT 20-130
DATE 07/24/20
COORDINATED BY JPB
DRAWN BY DTB
CHECKED BY JPB GWT

JOSEPH P. BRIGGS REGISTERED NO. 11600109 STATE OF INDIANA ARCHITECT

COPYRIGHT NOTICE:
THE CONCEPTS, DESIGNS, PLANS, DETAILS, ETC., SHOWN ON THIS DOCUMENT ARE THE PROPERTY OF GIBRALTAR DESIGN AND WERE CREATED FOR USE ON THIS SPECIFIC PROJECT. NONE OF THIS INFORMATION SHALL BE USED BY ANY PERSON OR FIRM FOR ANY PURPOSE WITHOUT THE EXPRESS WRITTEN CONSENT OF GIBRALTAR DESIGN. THE OWNER MAY RETAIN COPIES FOR INFORMATION AND REFERENCE IN CONNECTION ONLY WITH THIS PROJECT.

REVISIONS

| MARK | DATE | ISSUED FOR |
|---|---|---|
| AD-2 | 08/07/20 | ADDENDUM NO. 2 |

DRAWING
FIRST FLOOR LIFE SAFETY PLAN

PROJECT
VALPARAISO HIGH SCHOOL WEST CAMPUS IMPROVEMENTS

© GIBRALTAR DESIGN

SHEET
G-201

Friday, 8/7/2020 – 2:11 PM – LAST SAVED BY:DBURNS
Y:\20-130 VALPARAISO CS – VHS WEST CAMPUS IMPROVEMENTS\20-130 DRAWINGS\02 GENR\G-201.DWG

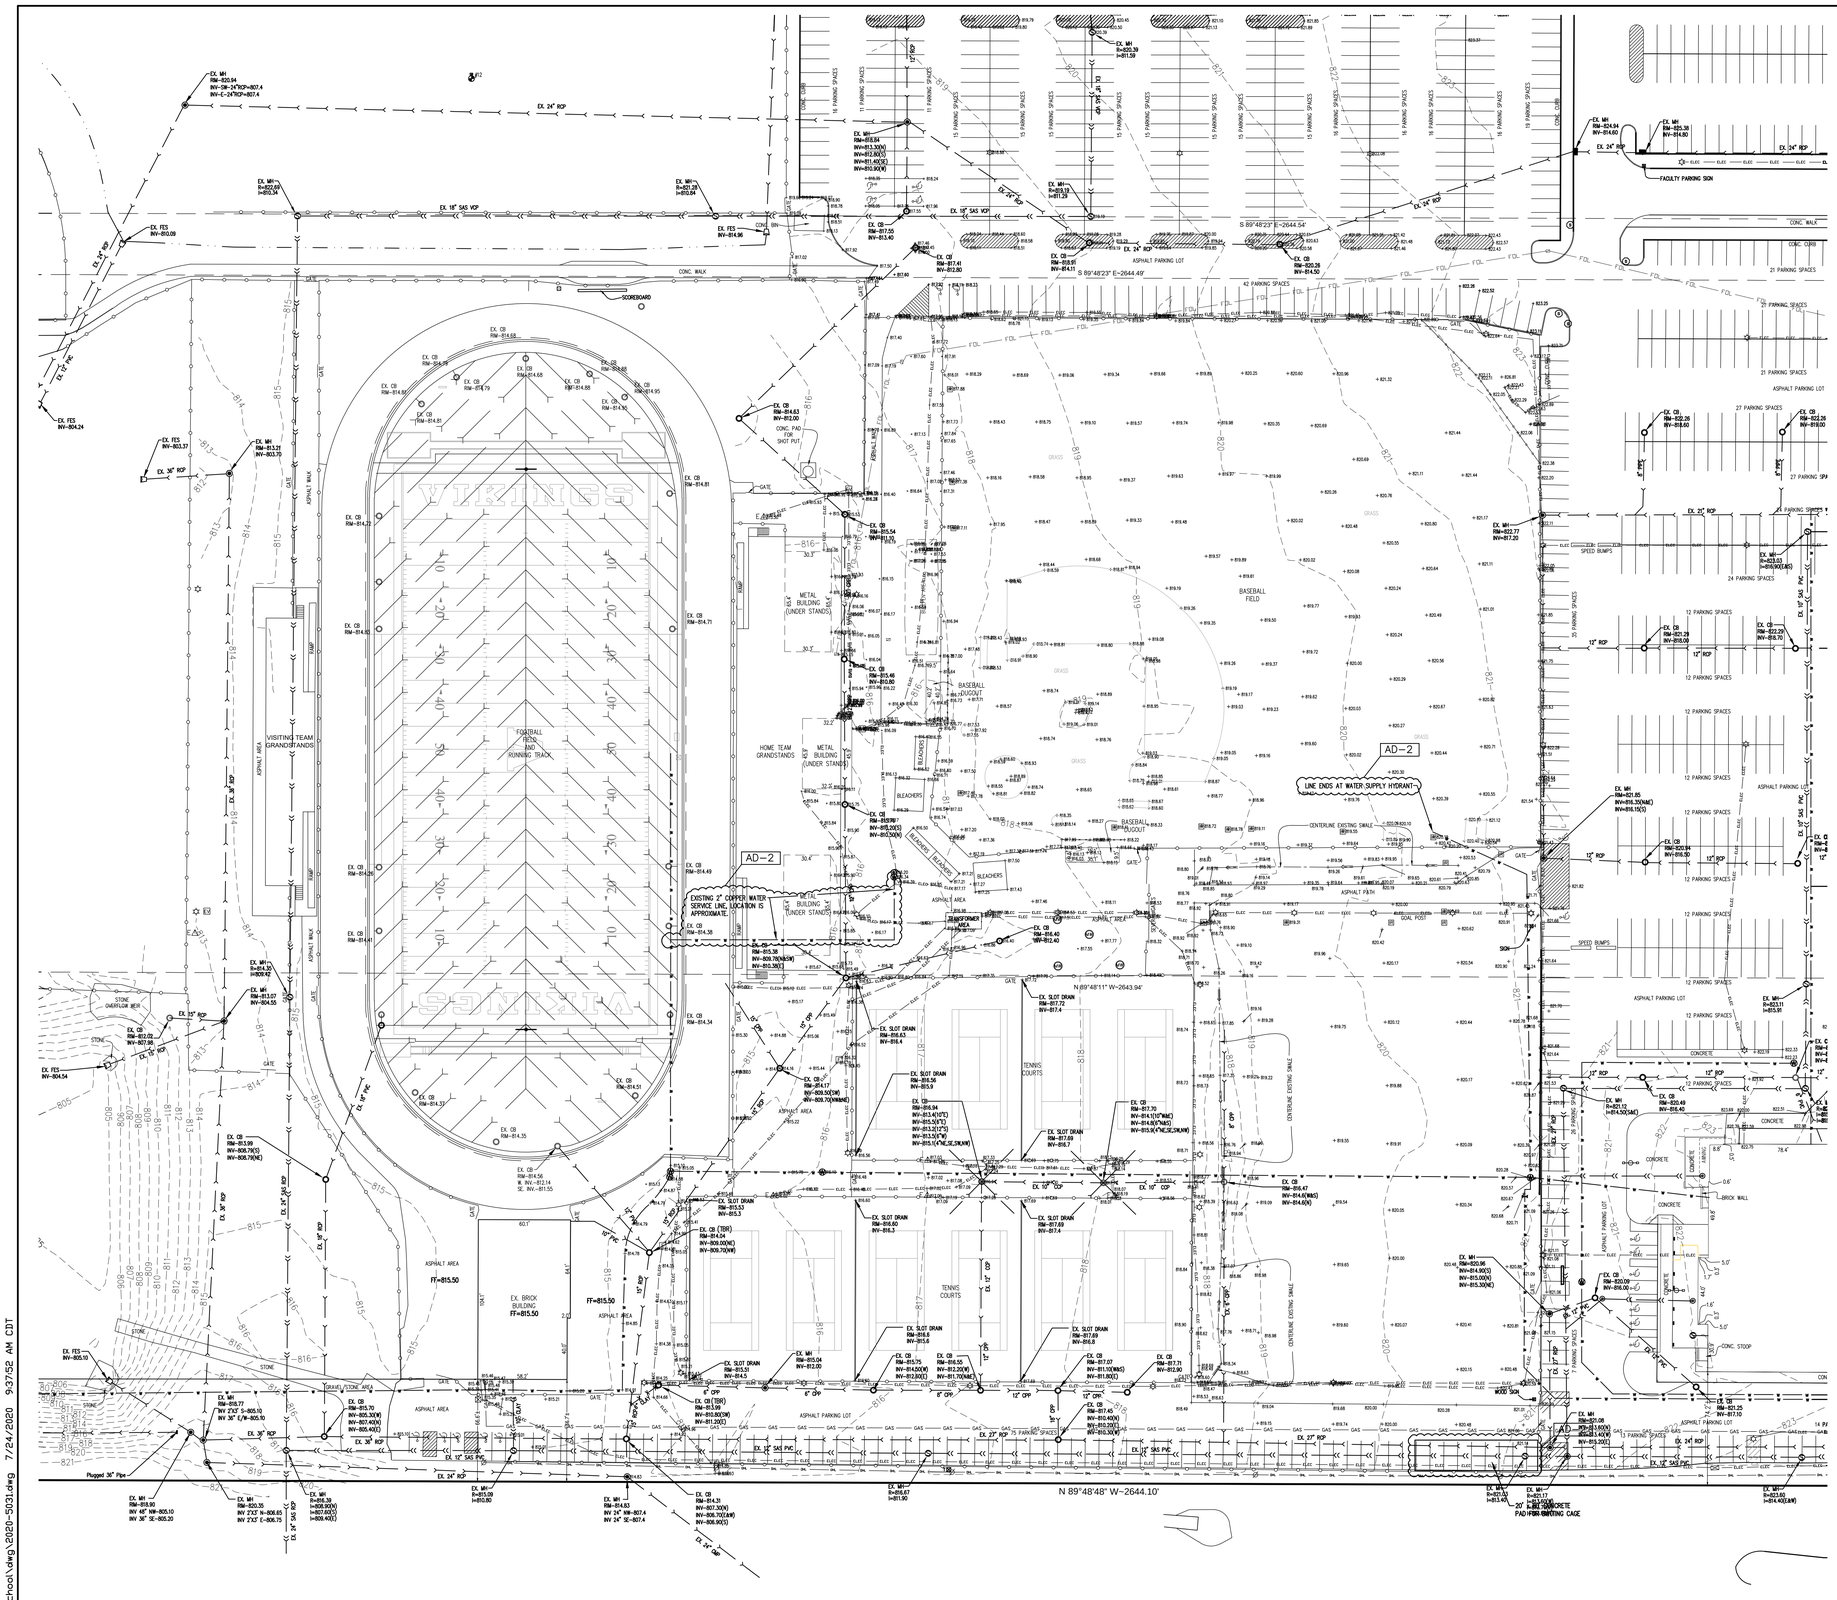


## LEGEND:

EXISTING

- FLAG POLE
- SURVEY TRAVERSE POINT
- POWER POLE
- POWER POLE w/ LIGHT
- GUY WIRE W/ANCHOR
- LIGHT POLE
- SIGNS (STOP, YIELD, etc.)
- CATCH BASIN/INLET
- CURB DRAIN
- END SECTION
- MANHOLE (SANITARY)
- MANHOLE (STORM)
- MANHOLE (UNMARKED)
- CLEAN OUT
- FIRE HYDRANT
- WATER VALVE
- TELEPHONE PEDESTAL
- TELEPHONE MANHOLE
- STEEL POST/BOLLARD
- ELECTRIC MANHOLE
- ELECTRIC VAULT
- ELECTRIC OUTLET
- CABLE TV PEDESTAL
- GAS METER
- SOIL BORING W/NUMBER
- IRRIGATION CONTROL VALVE
- SPRINKLER HEAD
- MONITORING WELL
- OVERHEAD LINES
- CHAIN LINK FENCE
- STORM SEWER LINE
- SANITARY SEWER LINE
- WATER LINE
- UNDERGROUND ELECTRIC LINE
- UNDERGROUND GAS LINE
- UNDERGROUND FIBER OPTIC LINE
- CONTOUR

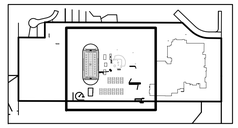

KEY MAP

NORTH
GRAPHIC SCALE

( IN FEET )
1 inch = 40 ft.

**GIBRALTAR**
DESIGN
ARCHITECTURE • ENGINEERING • INTERIOR DESIGN

PROJECT
# VALPARAISO HIGH SCHOOL
WEST CAMPUS IMPROVEMENTS AND RELATED WORK

VALPARAISO COMMUNITY SCHOOLS
VALPARAISO, INDIANA


TORRENGA ENGINEERING, INC.
CONSULTING ENGINEERS & LAND SURVEYORS
907 RIDGE ROAD
MUNSTER, IN 46321
T: (219) 836-8918
F: (219) 836-1138

GIBRALTAR DESIGN
9102 N. Meridian St., Ste. 300
Indianapolis, IN 46260
Homepage www.GibraltarDesign.com
Email info@GibraltarDesign.com
Phone 317.580.5777 Fax 317.580.5778


PROJECT 20-130
DATE 07/24/2020
COORDINATED BY DCT
DRAWN BY EM/NM
CHECKED BY DCT

DONALD C. TORRENGA REGISTERED No. 19868 STATE OF INDIANA PROFESSIONAL ENGINEER


COPYRIGHT NOTICE:
THE CONCEPTS, DESIGNS, PLANS, DETAILS, ETC. SHOWN ON THIS DOCUMENT ARE THE PROPERTY OF GIBRALTAR DESIGN AND WERE CREATED FOR USE ON THIS SPECIFIC PROJECT. NONE OF THIS INFORMATION SHALL BE USED BY ANY PERSON FOR ANY PURPOSE OTHER THAN THE PROJECT WITHOUT THE WRITTEN CONSENT OF GIBRALTAR DESIGN. THE OWNER MAY RETAIN COPIES FOR INFORMATION AND REFERENCE IN CONNECTION ONLY WITH THIS PROJECT.


REVISIONS

| MARK | DATE | ISSUED FOR |
|---|---|---|
| AD-2 | 08/07/20 | ADDENDUM NO. 2 |

DRAWING
EXISTING TOPOGRAPHY AND UTILITIES

PROJECT
VALPARAISO HIGH SCHOOL
WEST CAMPUS IMPROVEMENTS AND RELATED WORK

© GIBRALTAR DESIGN

SHEET
C-1.0

Z:\2020-5031 Valparaiso High School\dwg\2020-5031.dwg 7/24/2020 9:37:52 AM CDT

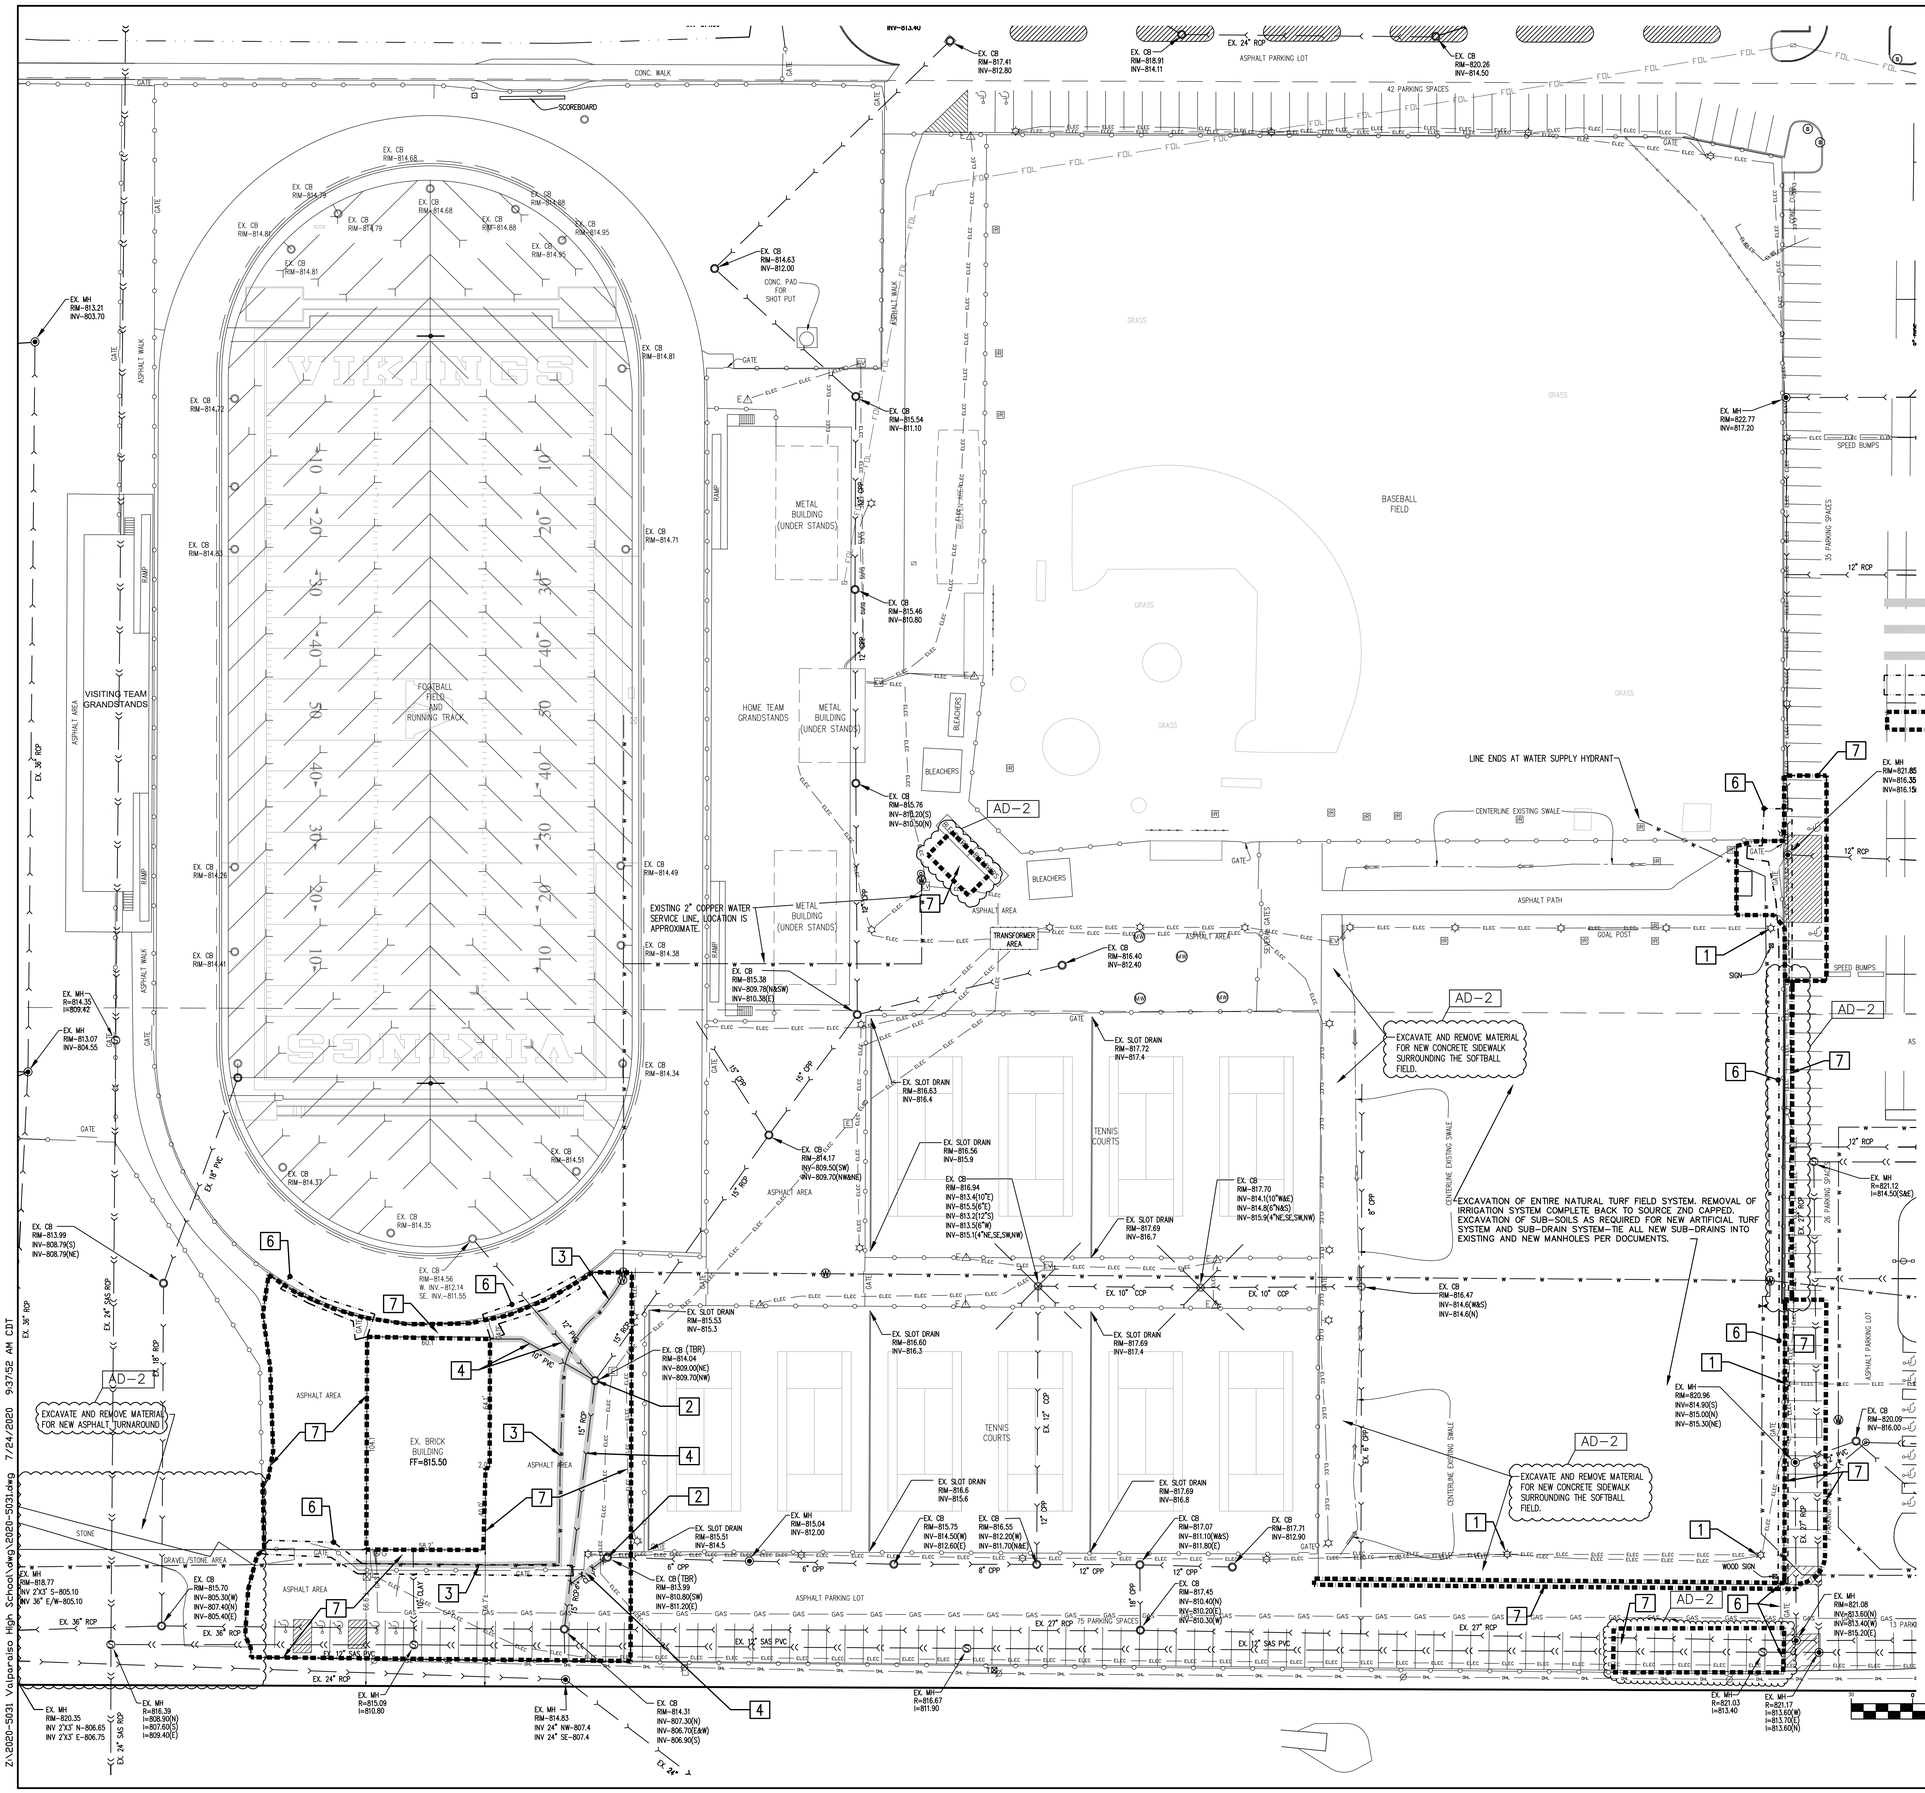


DEMOLITION NOTES

1. REMOVE LIGHT POLE (SEE ELECTRICAL PLAN)
2. REMOVE INLET/CATCH BASIN
3. REMOVE WATER LINE
4. REMOVE STORM SEWER LINE
5. REMOVE SANITARY SEWER LINE
6. REMOVE FENCE & GATE
7. REMOVE PAVEMENT

GIBRALTAR DESIGN
ARCHITECTURE • ENGINEERING • INTERIOR DESIGN

PROJECT
# VALPARAISO HIGH SCHOOL
WEST CAMPUS IMPROVEMENTS AND RELATED WORK

VALPARAISO COMMUNITY SCHOOLS
VALPARAISO, INDIANA


TORRENGA ENGINEERING, INC.
CONSULTING ENGINEERS & LAND SURVEYORS
907 RIDGE ROAD
MUNSTER, IN 46321
T: (219) 836-8918
F: (219) 836-1138

GIBRALTAR DESIGN
9102 N. Meridian St., Ste. 300
Indianapolis, IN 46260
Homepage www.GibraltarDesign.com
Email info@GibraltarDesign.com
Phone 317.580.5777 Fax 317.580.5778


PROJECT 20-130
DATE 07/24/2020
COORDINATED BY DCT
DRAWN BY EM/NM
CHECKED BY DCT

DONALD C. TORRENGA REGISTERED No. 19868 STATE OF INDIANA PROFESSIONAL ENGINEER


COPYRIGHT NOTICE:
THE CONCEPTS, DESIGNS, PLANS, DETAILS, ETC. SHOWN ON THIS DOCUMENT ARE THE PROPERTY OF GIBRALTAR DESIGN AND WERE CREATED FOR USE ON THIS SPECIFIC PROJECT. NONE OF THIS INFORMATION SHALL BE USED BY ANY PERSON OR FIRM FOR ANY PURPOSE WITHOUT THE EXPRESS WRITTEN CONSENT OF GIBRALTAR DESIGN. THE OWNER MAY RETAIN COPIES FOR INFORMATION AND REFERENCE IN CONNECTION ONLY WITH THIS PROJECT.


REVISIONS

| MARK | DATE | ISSUED FOR |
|---|---|---|
| AD-2 | 08/07/20 | ADDENDUM NO. 2 |

DRAWING
DEMOLITION PLAN

PROJECT
VALPARAISO HIGH SCHOOL
WEST CAMPUS IMPROVEMENTS AND RELATED WORK

© GIBRALTAR DESIGN

SHEET C-1.1

Z:\2020-5031 Valparaiso High School\dwg\2020-5031.dwg 7/24/2020 9:37:52 AM CDT

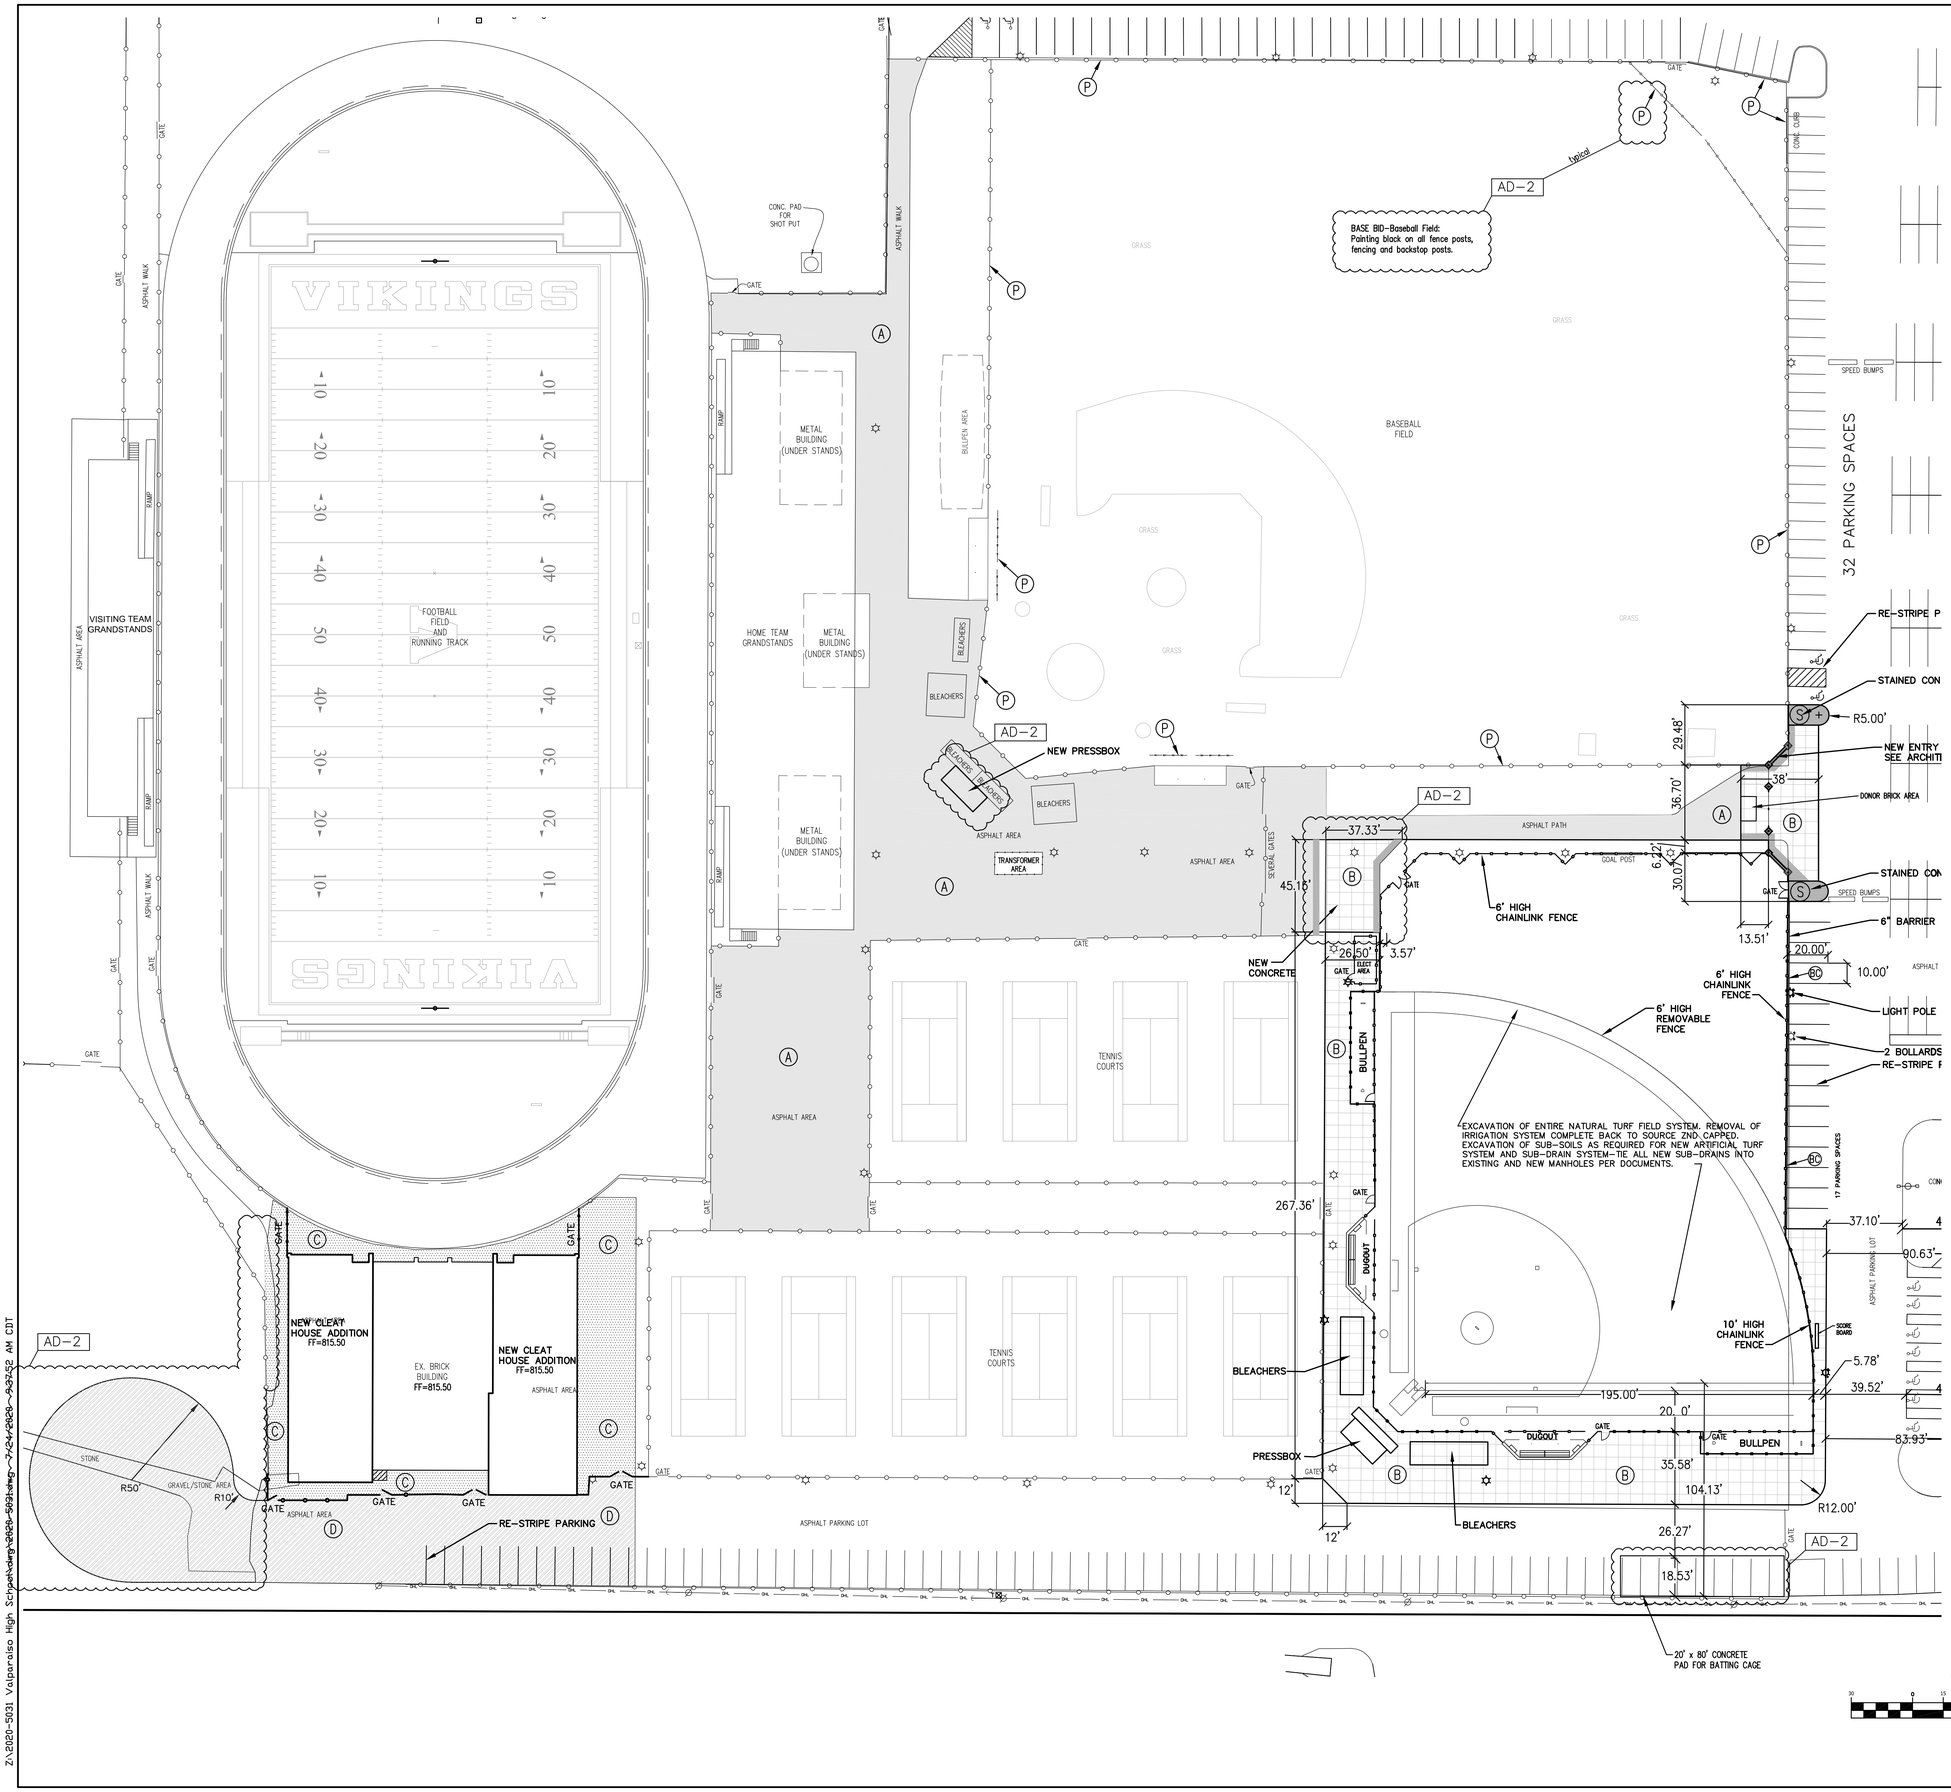


## LEGEND:

PROPOSED

- (A) CRACK-FILL AND SEAL COAT EXISTING ASPHALT
- (B) CONCRETE PAVING WITH STAINED ACCESS EDGES 3 FEET WIDE
- (S) CONCRETE PAVING WITH STAINED ACCESS EDGES 3 FEET WIDE
- (C) ASPHALT
- (D) HEAVY DUTY ASPHALT
- (BC) BARRIER CURB (SEE SHEET C-4.0)
- (P) EXISTING FENCE TO BE PAINTED AS PART OF BASE BID - BLACK

Z:\2020-5031 Valparaiso High School\drawings\2020-5031.dwg-7/24/2020-9:37:52 AM CDT

GIBRALTAR DESIGN
ARCHITECTURE • ENGINEERING • INTERIOR DESIGN

PROJECT
# VALPARAISO HIGH SCHOOL
WEST CAMPUS IMPROVEMENTS AND RELATED WORK

VALPARAISO COMMUNITY SCHOOLS
VALPARAISO, INDIANA


TORRENGA ENGINEERING, INC.
CONSULTING ENGINEERS & LAND SURVEYORS
907 RIDGE ROAD
MUNSTER, IN 46321
T: (219) 836-8918
F: (219) 836-1138

GIBRALTAR DESIGN
9102 N. Meridian St., Ste. 300
Indianapolis, IN 46260
Homepage www.GibraltarDesign.com
Email info@GibraltarDesign.com
Phone 317.580.5777 Fax 317.580.5778


PROJECT 20-130
DATE 07/17/2020
COORDINATED BY DCT
DRAWN BY EM/NM
CHECKED BY DCT

DONALD C. TORRENGA REGISTERED No. 19868 STATE OF INDIANA PROFESSIONAL ENGINEER


COPYRIGHT NOTICE:
THE CONCEPTS, DESIGNS, PLANS, DETAILS, ETC. SHOWN ON THIS DOCUMENT ARE THE PROPERTY OF GIBRALTAR DESIGN AND WERE CREATED FOR USE ON THIS SPECIFIC PROJECT. NONE OF THIS INFORMATION SHALL BE USED BY ANY PERSON OR FIRM FOR OTHER PROJECTS WITHOUT EXPRESS WRITTEN CONSENT OF GIBRALTAR DESIGN. THE OWNER MAY RETAIN COPIES FOR INFORMATION AND REFERENCE IN CONNECTION ONLY WITH THIS PROJECT.


REVISIONS

| MARK | DATE | ISSUED FOR |
|---|---|---|
| AD-2 | 08/07/20 | ADDENDUM NO. 2 |

DRAWING
SITE PLAN

PROJECT
VALPARAISO HIGH SCHOOL
WEST CAMPUS IMPROVEMENTS AND RELATED WORK

© GIBRALTAR DESIGN

SHEET
C-2.1

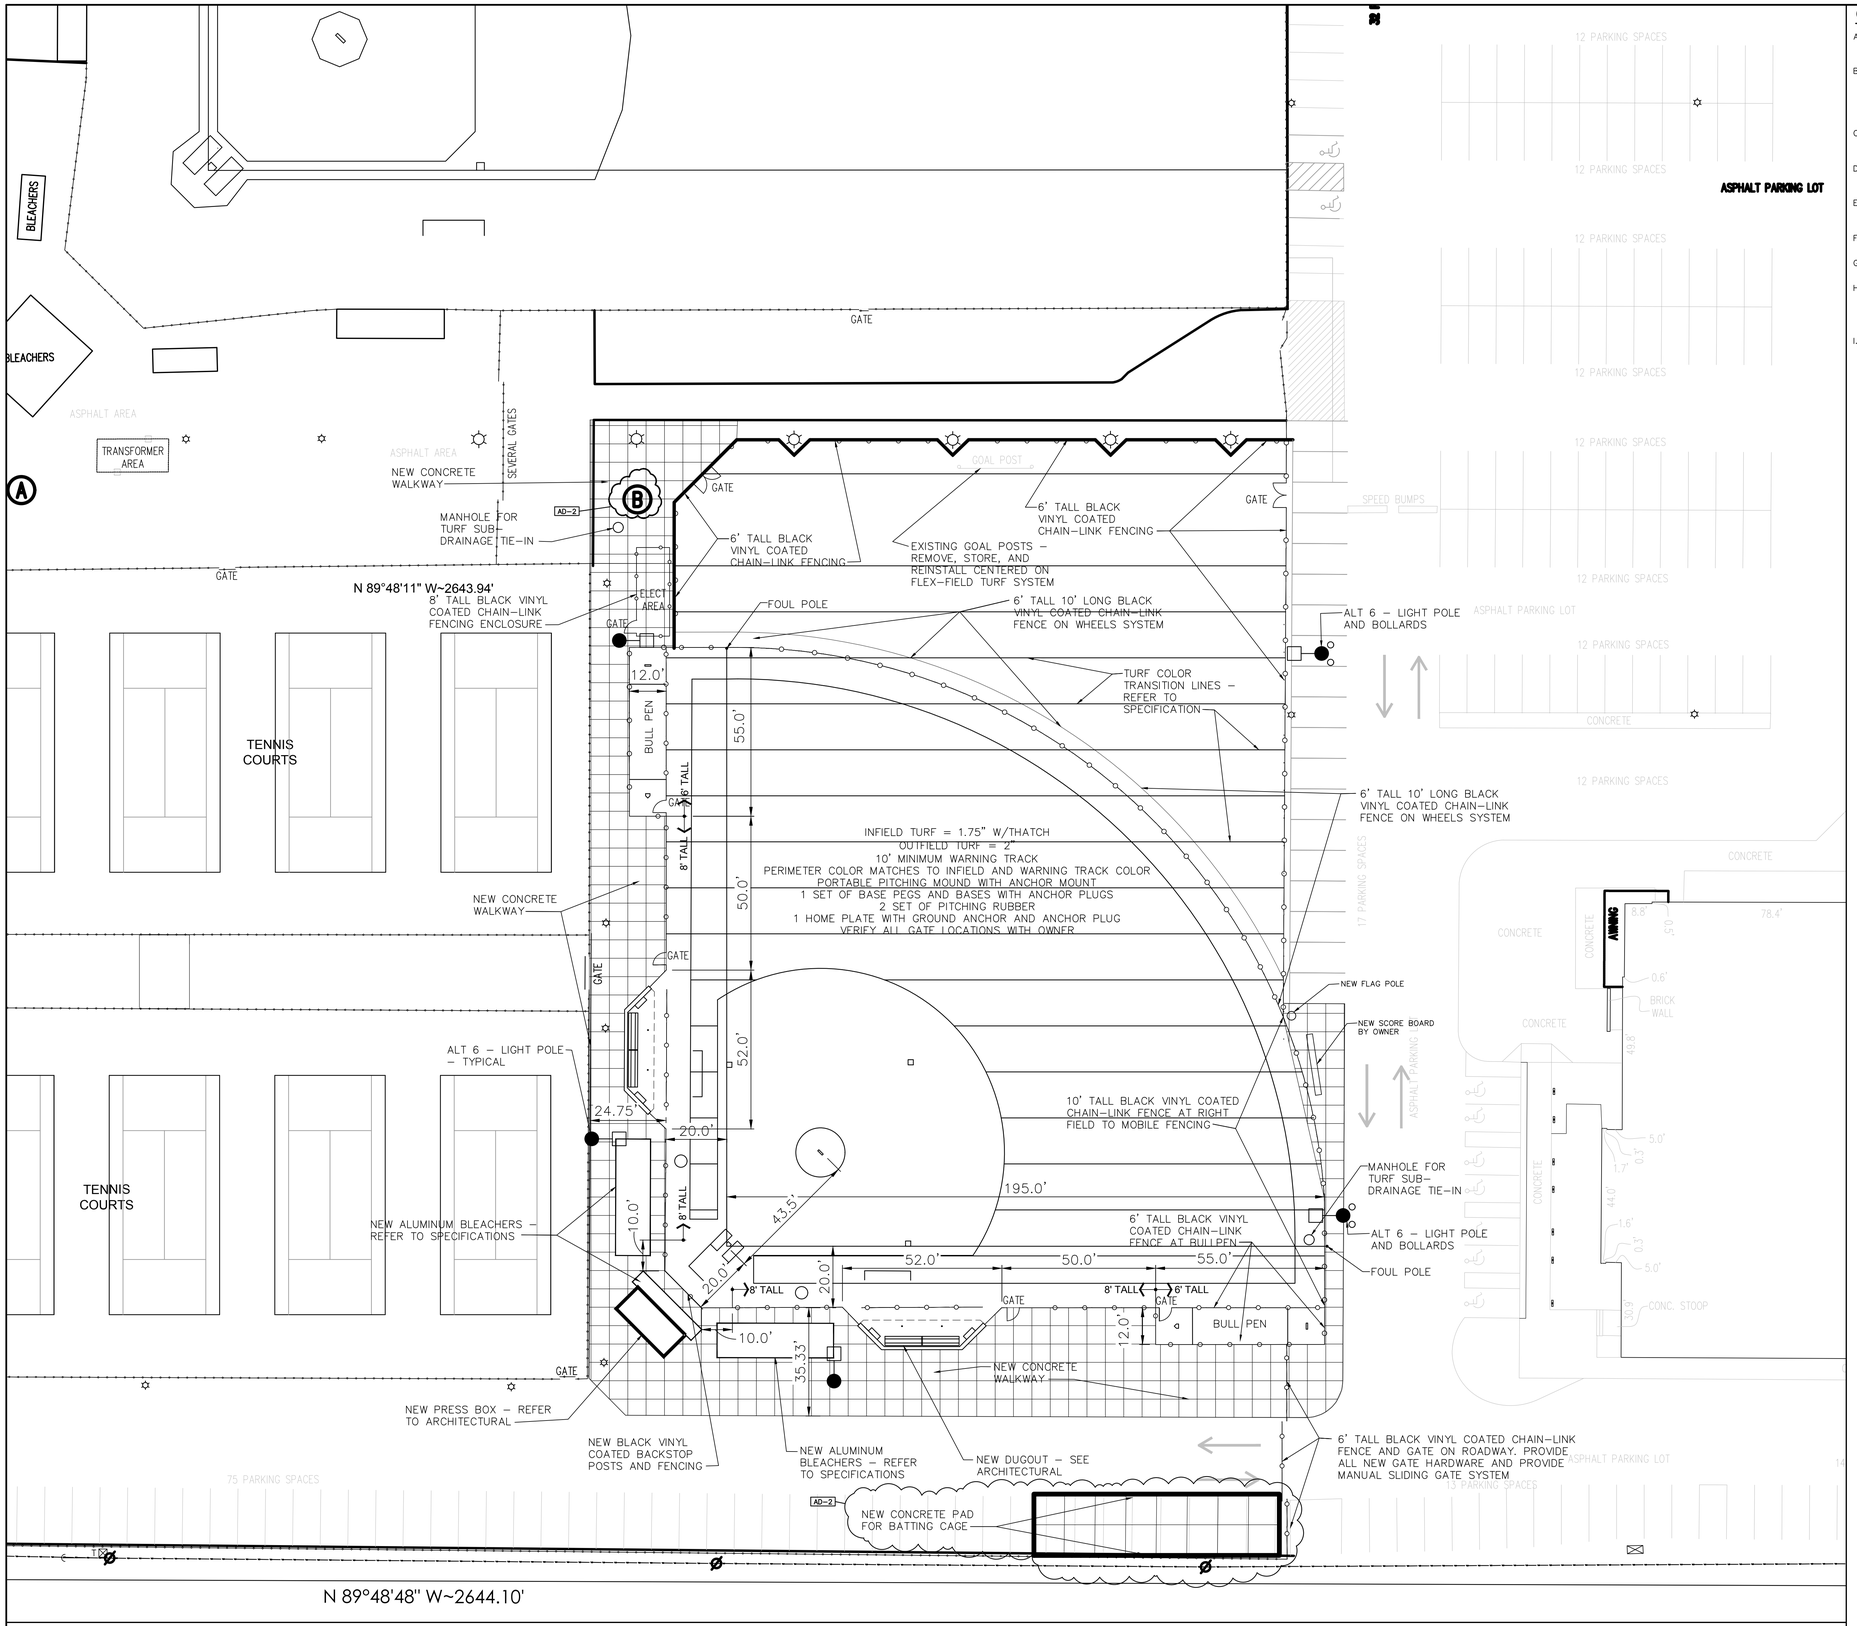


## SOFTBALL FIELD SITE PLAN

0 10' 20' 40'

SCALE: 1" = 20'

NORTH

## GENERAL PLAN NOTES:

A. SITE SURVEY INFORMATION IS PROVIDED BY TORRENGA ENGINEERING INC. CONTRACTOR IS TO VERIFY ALL ELEVATIONS AND NOTIFY CM OF ANY DISCREPANCIES.

B. UNDERGROUND UTILITIES ARE SHOWN IN APPROXIMATE LOCATIONS BASED ON INFORMATION AT THE TIME OF SURVEY. CONTRACTOR IS RESPONSIBLE FOR DETERMINING EXACT LOCATIONS OF ALL EXISTING UNDERGROUND UTILITIES TO REMAIN AND REPAIRING OR REPLACING ANY DAMAGE DUE TO CONSTRUCTION ACTIVITY. CONTRACTOR IS TO NOTIFY CM AND ARCHITECT OF ANY DISCREPANCIES.

C. CONTRACTOR IS RESPONSIBLE FOR COSTS ASSOCIATED WITH DISCONNECTING, REMOVING, OR RELOCATING/RECONNECTING EXISTING UTILITIES ALONG WITH CONNECTING NEW UTILITIES ASSOCIATED WITH CONSTRUCTION SCOPE.

D. VALVES, MANHOLES, HAND-HOLES, UTILITY BOXES, AND SIMILAR STRUCTURES NOT DESIGNATED FOR REMOVAL, SHALL BE PROTECTED AND ADJUSTED TO NEW FINISH ELEVATIONS BY CONTRACTOR.

E. CONTRACTOR IS TO VERIFY ALL DIMENSIONS, VERTICALLY AND HORIZONTALLY BETWEEN EXISTING AND NEW CONSTRUCTION, AND NOTIFY CONSTRUCTION MANAGER/ARCHITECT IF ANY DISCREPANCIES.

F. CONTRACTOR IS REQUIRED TO PROVIDE DEMOLITION AND CONSTRUCTION PLAN FOR OWNER AND CONSTRUCTION MANAGER APPROVAL.

G. SYNTHETIC TURF SURFACE SHALL BE INSTALLED AT PROPOSED GRADES INDICATED STARTING FROM EAST TO WEST.

H. CONTRACTOR IS TO PROVIDE TOTAL ARTIFICIAL TURF REPLACEMENT COMPLETE, NEW TURF, NEW INFILL, NEW 2X4 PERIMETER TREATED WOOD BLOCKING, NEW SUB-DRAINAGE SYSTEM AND NEW STORM CONNECTIONS AS INDICATED. CONTRACTOR IS REQUIRED TO PROVIDE ENGINEERED DESIGN FOR SUB-DRAINAGE SYSTEM PER THE SPECIFICATIONS.

I. CONTRACTOR IS TO REMOVE ALL EXISTING IRRIGATION SYSTEM COMPLETE WHERE NEW ARTIFICIAL TURF SYSTEM IS BEING INSTALLED.

## GENERAL PLAN NOTES:

1. TYPICAL SUB-DRAINAGE HORIZONTAL MULTI-FLOW PIPE RUN DETAILS AND PERFORATED PIPE TIE-INS AND UNDER-DRAIN SLOPED RUNS. — 1 / C-4.2, 4 / C-4.2
2. TYPICAL TURF SECTION — 3 / C-4.2
3. TYPICAL FENCING ON FULL PERIMETER OF FIELD AND AT PARKING LOT CONDITIONS. — 1 / C-4.2, 2 / C-4.2

GIBRALTAR DESIGN
ARCHITECTURE • ENGINEERING • INTERIOR DESIGN

PROJECT
# VALPARAISO HIGH SCHOOL WEST CAMPUS IMPROVEMENTS

VALPARAISO COMMUNITY SCHOOLS
VALPARAISO, INDIANA


GIBRALTAR DESIGN
9102 N. Meridian St., Ste. 300
Indianapolis, IN 46260
Homepage www.GibraltarDesign.com
Email info@GibraltarDesign.com
Phone 317.580.5777 Fax 317.580.5778


PROJECT 20-130
DATE 07/24/20
COORDINATED BY XXX
DRAWN BY XXX XXX
CHECKED BY XXX XXX

REGISTERED ARCHITECT JOSEPH P. BRIGGS NO. 11600109 STATE OF INDIANA


COPYRIGHT NOTICE: THE CONCEPTS, DESIGNS, PLANS, DETAILS, ETC. SHOWN ON THIS DOCUMENT ARE THE PROPERTY OF GIBRALTAR DESIGN AND WERE CREATED FOR USE ON THIS SPECIFIC PROJECT. NONE OF THIS INFORMATION SHALL BE USED WITHOUT PERMISSION OR FOR ANY PURPOSE WHATSOEVER WITHOUT THE EXPRESS WRITTEN CONSENT OF GIBRALTAR DESIGN. THE OWNER MAY RETAIN COPIES FOR INFORMATION AND REFERENCE IN CONNECTION ONLY WITH THIS PROJECT.


REVISIONS

| MARK | DATE | ISSUED FOR |
|---|---|---|
| AD-2 | 08/07/20 | ADDENDUM NO. 2 |

DRAWING
ENLARGED SOFTBALL FIELD LAYOUT PLAN

PROJECT
VALPARAISO HIGH SCHOOL WEST CAMPUS IMPROVEMENTS

© GIBRALTAR DESIGN

SHEET
C-2.1B


Sunday, 8/9/2020 - 10:31 PM - LAST SAVED BY:JBRIGGS
Y:\20-130 VALPARASO CS - VHS WEST CAMPUS IMPROVEMENTS\20-130 DRAWINGS\03 SITE\C-101.DWG

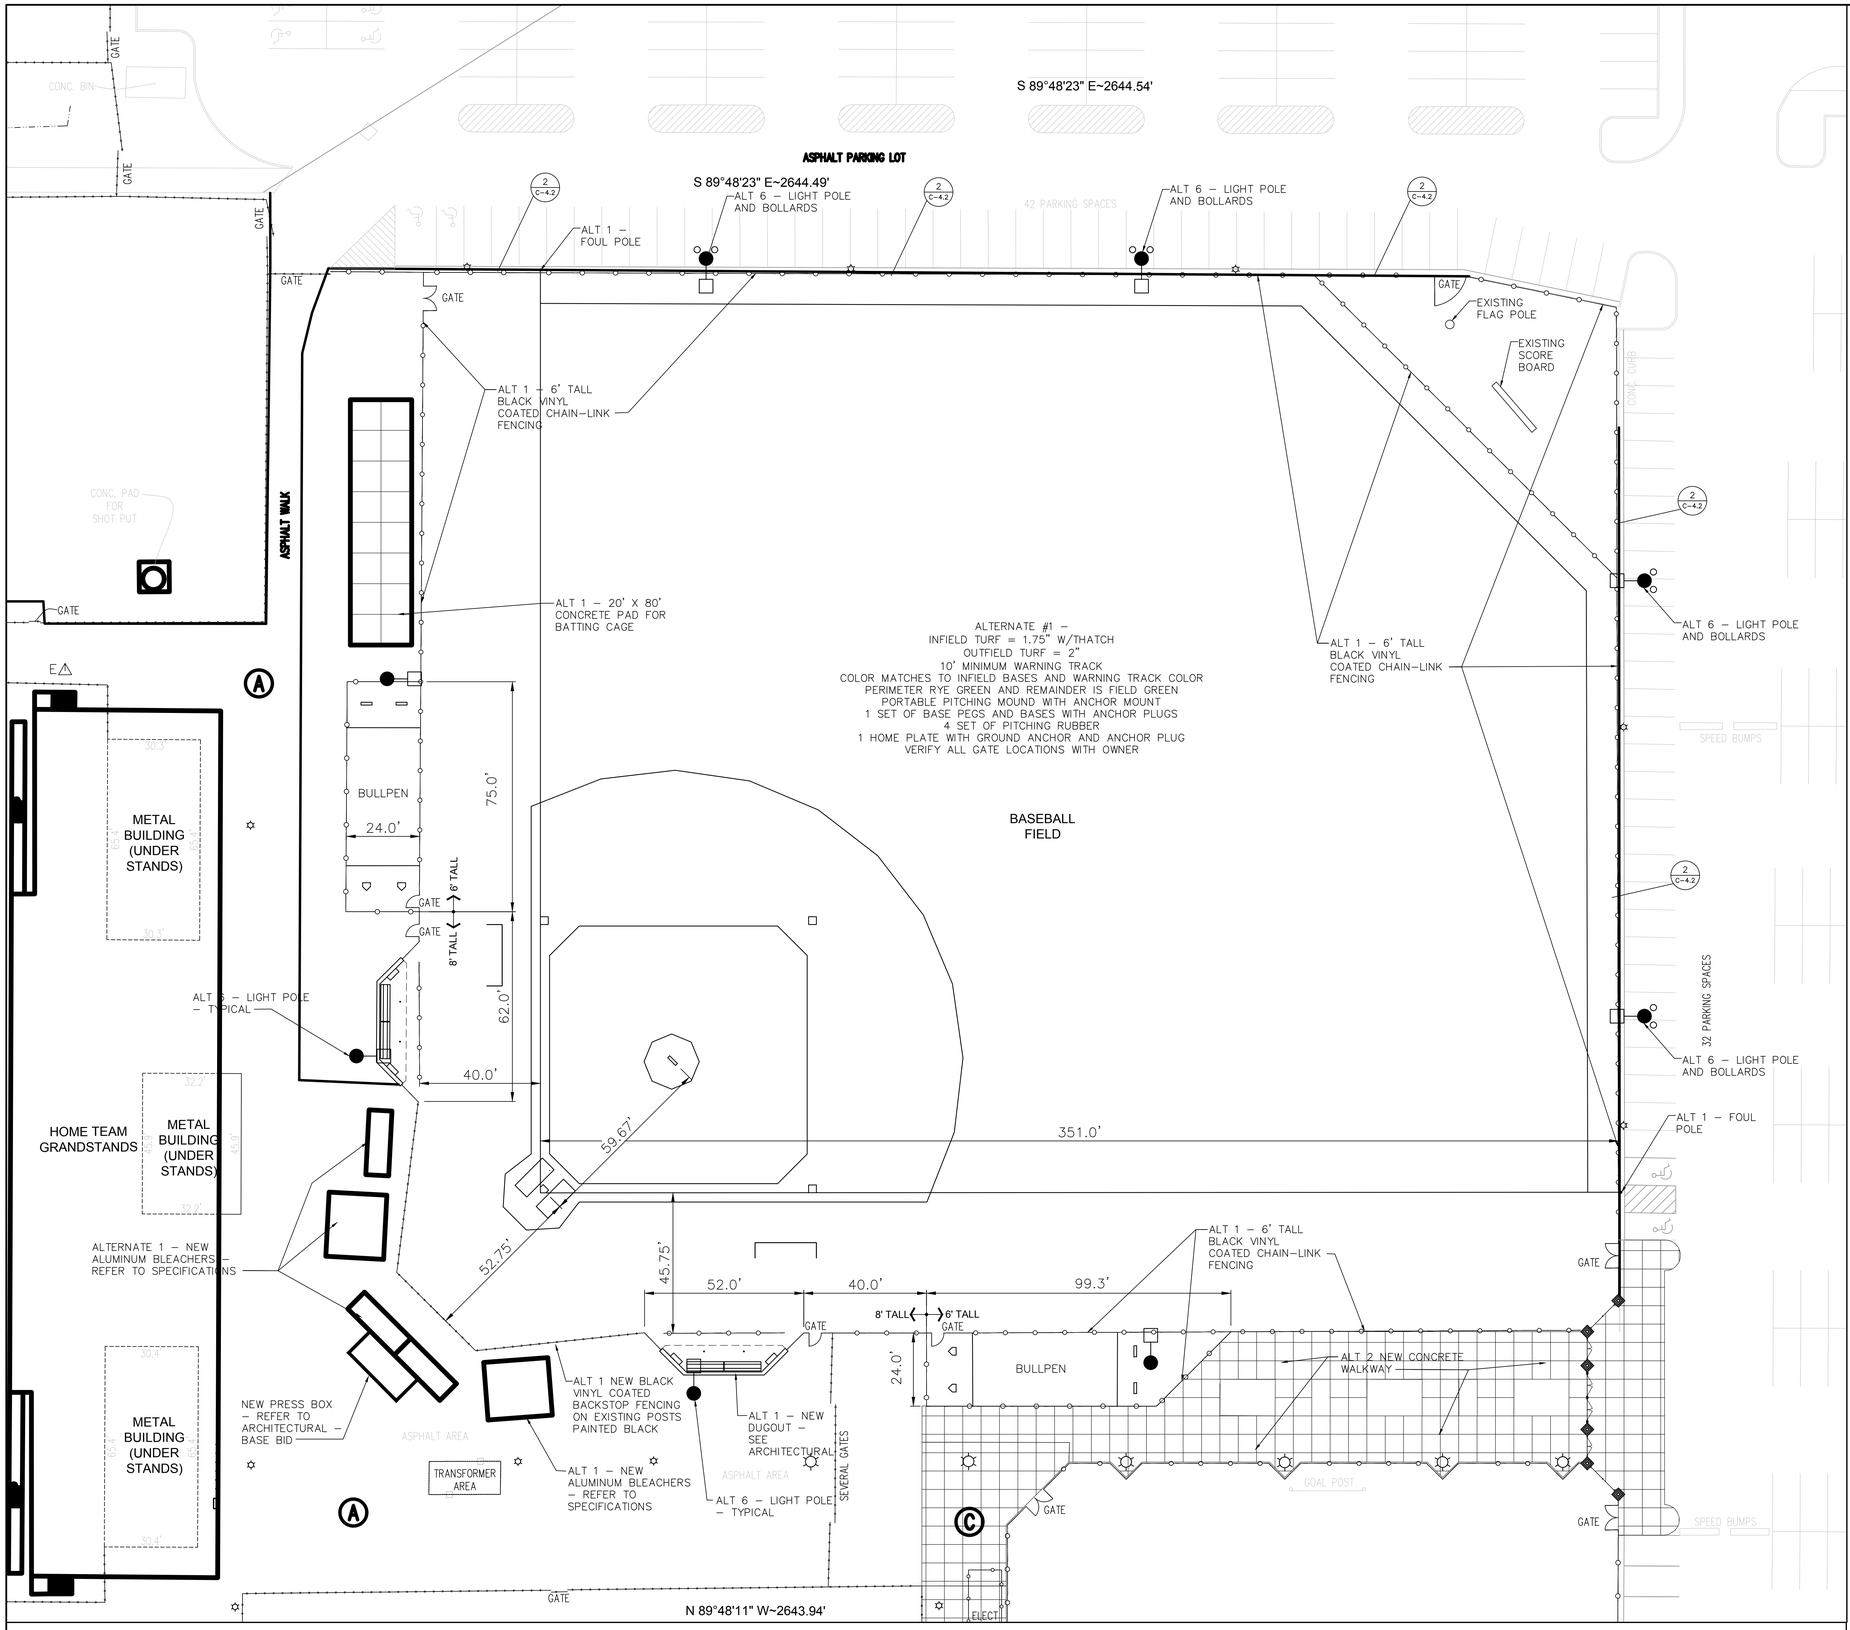


## BASEBALL FIELD SITE PLAN

0 10' 20' 40'

SCALE: 1" = 20'

NORTH

## GENERAL PLAN NOTES:

A. SITE SURVEY INFORMATION IS PROVIDED BY TORRENGA ENGINEERING INC. CONTRACTOR IS TO VERIFY ALL ELEVATIONS AND NOTIFY CM OF ANY DISCREPANCIES.

B. UNDERGROUND UTILITIES ARE SHOWN IN APPROXIMATE LOCATIONS BASED ON INFORMATION AT THE TIME OF SURVEY. CONTRACTOR IS RESPONSIBLE FOR DETERMINING EXACT LOCATIONS OF ALL EXISTING UNDERGROUND UTILITIES TO REMAIN AND REPAIRING OR REPLACING ANY DAMAGE DUE TO CONSTRUCTION ACTIVITY. CONTRACTOR IS TO NOTIFY CM AND ARCHITECT OF ANY DISCREPANCIES.

C. CONTRACTOR IS RESPONSIBLE FOR COSTS ASSOCIATED WITH DISCONNECTING, REMOVING, OR RELOCATING/RECONNECTING EXISTING UTILITIES ALONG WITH CONNECTING NEW UTILITIES ASSOCIATED WITH CONSTRUCTION SCOPE.

D. VALVES, MANHOLES, HAND–HOLES, UTILITY BOXES, AND SIMILAR STRUCTURES NOT DESIGNATED FOR REMOVAL, SHALL BE PROTECTED AND ADJUSTED TO NEW FINISH ELEVATIONS BY CONTRACTOR.

E. CONTRACTOR IS TO VERIFY ALL DIMENSIONS, VERTICALLY AND HORIZONTALLY BETWEEN EXISTING AND NEW CONSTRUCTION, AND NOTIFY CONSTRUCTION MANAGER/ARCHITECT IF ANY DISCREPANCIES.

F. CONTRACTOR IS REQUIRED TO PROVIDE DEMOLITION AND CONSTRUCTION PLAN FOR OWNER AND CONSTRUCTION MANAGER APPROVAL.

G. SYNTHETIC TURF SURFACE SHALL BE INSTALLED AT PROPOSED GRADES INDICATED STARTING FROM EAST TO WEST.

H. CONTRACTOR IS TO PROVIDE TOTAL ARTIFICIAL TURF REPLACEMENT COMPLETE, NEW TURF, NEW INFILL, NEW 2X4 PERIMETER TREATED WOOD BLOCKING, NEW SUB–DRAINAGE SYSTEM AND NEW STORM CONNECTIONS AS INDICATED. CONTRACTOR IS REQUIRED TO PROVIDE ENGINEERED DESIGN FOR SUB–DRAINAGE SYSTEM PER THE SPECIFICATIONS.

I. CONTRACTOR IS TO REMOVE ALL EXISTING IRRIGATION SYSTEM COMPLETE WHERE NEW ARTIFICIAL TURF SYSTEM IS BEING INSTALLED.

## GENERAL PLAN NOTES:

1. TYPICAL SUB–DRAINAGE HORIZONTAL MULTI–FLOW PIPE RUN DETAILS AND PERFORATED PIPE TIE–INS AND UNDER–DRAIN SLOPED RUNS. — 1/C–4.2, 4/C–4.2
2. TYPICAL TURF SECTION — 3/C–4.2
3. TYPICAL FENCING ON FULL PERIMETER OF FIELD AND AT PARKING LOT CONDITIONS. — 1/C–4.2, 2/C–4.2

GIBRALTAR DESIGN
ARCHITECTURE • ENGINEERING • INTERIOR DESIGN

PROJECT
# VALPARAISO HIGH SCHOOL WEST CAMPUS IMPROVEMENTS

VALPARAISO COMMUNITY SCHOOLS
VALPARAISO, INDIANA


GIBRALTAR DESIGN
9102 N. Meridian St., Ste. 300
Indianapolis, IN 46260
Homepage www.GibraltarDesign.com
Email: info@GibraltarDesign.com
Phone 317.580.5777 Fax 317.580.5778


PROJECT 20–130
DATE 07/24/20
COORDINATED BY XXX
DRAWN BY XXX XXX
CHECKED BY XXX XXX


COPYRIGHT NOTICE:
THE CONCEPTS, DESIGNS, PLANS, DETAILS, ETC. SHOWN ON THIS DOCUMENT ARE THE PROPERTY OF GIBRALTAR DESIGN AND WERE CREATED FOR USE ON THIS SPECIFIC PROJECT. NONE OF THIS INFORMATION SHALL BE USED BY ANY PERSON OR FIRM FOR ANY PURPOSE WITHOUT THE EXPRESS WRITTEN CONSENT OF GIBRALTAR DESIGN. THE OWNER MAY RETAIN COPIES FOR INFORMATION AND REFERENCE IN CONNECTION ONLY WITH THIS PROJECT.


REVISIONS

| MARK | DATE | ISSUED FOR |
|---|---|---|
| AD–2 | 08/07/20 | ADDENDUM NO. 2 |

DRAWING
ENLARGED BASEBALL FIELD

PROJECT
VALPARAISO HIGH SCHOOL WEST CAMPUS IMPROVEMENTS

© GIBRALTAR DESIGN

SHEET
C-2.1C


Monday, 8/10/2020 – 12:16 AM – LAST SAVED BY:JBRIGGS
Y:\20–130 VALPARAISO CS – VHS WEST CAMPUS IMPROVEMENTS\20–130 DRAWINGS\03 SITE\C–102.DWG

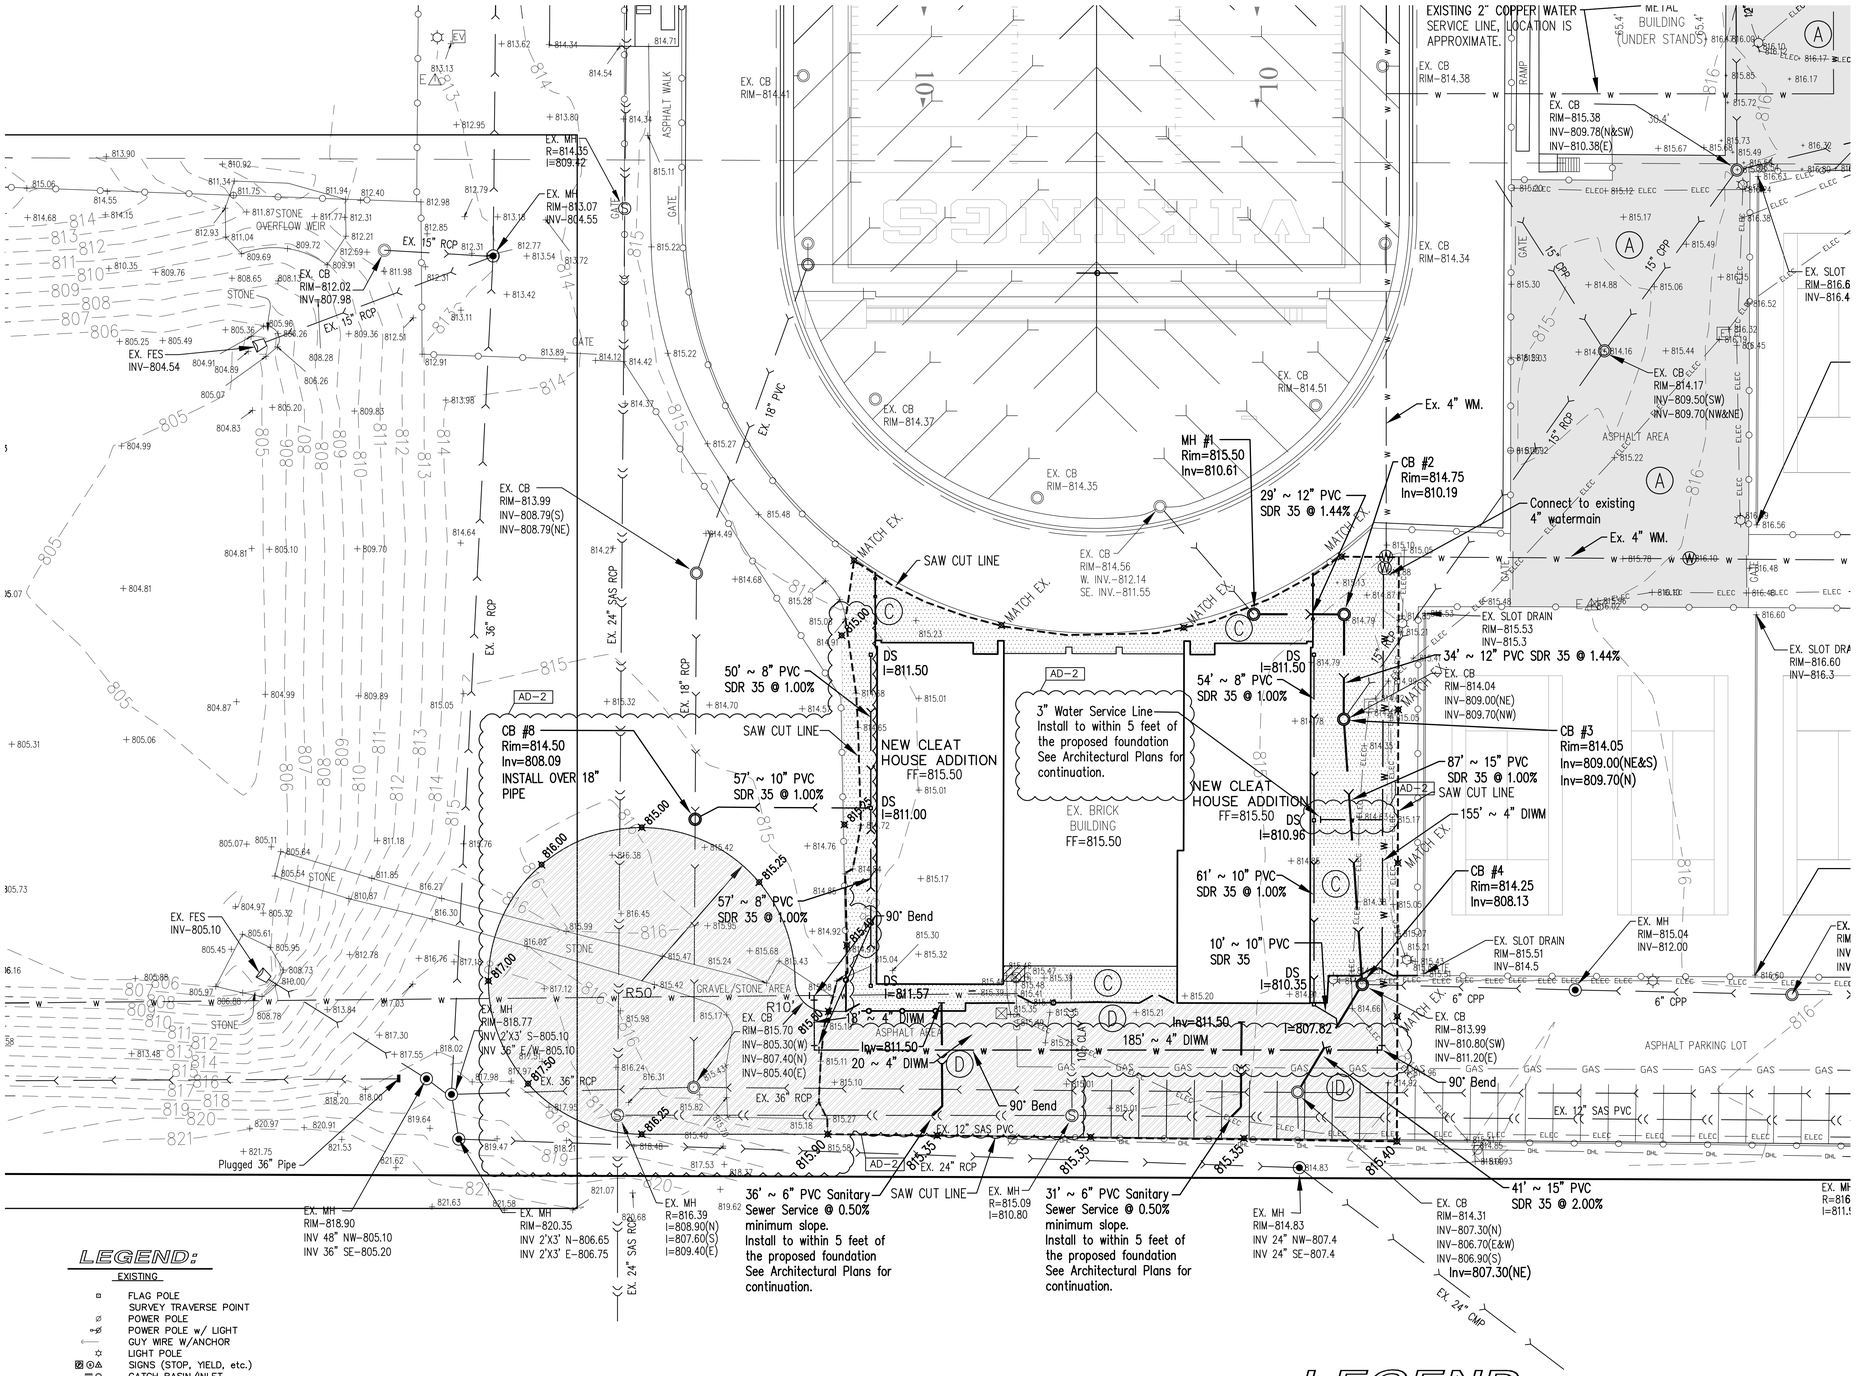


## LEGEND:

EXISTING

- FLAG POLE
- SURVEY TRAVERSE POINT
- POWER POLE
- POWER POLE w/ LIGHT
- GUY WIRE W/ANCHOR
- LIGHT POLE
- SIGNS (STOP, YIELD, etc.)
- CATCH BASIN/INLET
- CURB DRAIN
- END SECTION
- MANHOLE (SANITARY)
- MANHOLE (STORM)
- MANHOLE (UNMARKED)
- CLEAN OUT
- FIRE HYDRANT
- WATER VALVE
- TELEPHONE PEDESTAL
- TELEPHONE MANHOLE
- STEEL POST/BOLLARD
- ELECTRIC MANHOLE
- ELECTRIC VAULT
- ELECTRIC OUTLET
- CABLE TV PEDESTAL
- GAS METER
- SOIL BORING W/NUMBER
- IRRIGATION CONTROL VALVE
- SPRINKLER HEAD
- MONITORING WELL
- OVERHEAD LINES
- CHAIN LINK FENCE
- STORM SEWER LINE
- SANITARY SEWER LINE
- WATER LINE
- UNDERGROUND ELECTRIC LINE
- UNDERGROUND GAS LINE
- UNDERGROUND FIBER OPTIC LINE
- CONTOUR

## LEGEND:

PROPOSED

- SANITARY SEWER
- STORM SEWER
- WATER MAIN
- GRADE
- DRAINAGE FLOW
- P — PAVEMENT
- TC — TOP OF CURB
- TW — TOP OF WALK

SCOPE OF WORK:

1) THE CONTRACTOR SHALL REMOVE ALL ASPHALT AS SHOWN ON SHEET C-1.1 DEMOLITION PLAN.
2) ALL AREAS WHERE ASPHALT IS REMOVED SHALL BE REPLACED WITH EITHER THE ASPHALT SECTION OR HEAVY DUTY ASPHALT SECTION AS SHOWN ON SHEET C-4.0.
3) CHAIN LINK FENCE SHALL BE REMOVED AS SHOWN ON SHEET C-1.1 DEMOLITION PLAN AND REPLACED AS SHOWN.
4) THE CONTRACTOR SHALL CRACK SEAL AND FILL ALL EXISTING ASPHALT AREAS DESIGNATED.

## LEGEND:

PROPOSED

- (A) CRACK-FILL AND SEAL COAT EXISTING ASPHALT
- (B) CONCRETE PAVING WITH STAINED ACCESS EDGES 3 FEET WIDE
- (C) ASPHALT (SEE SHEET C-4.0)
- (D) HEAVY DUTY ASPHALT (SEE SHEET C-4.0)

NORTH
GRAPHIC SCALE
20 0 10 20 40 80
( IN FEET )
1 inch = 20 ft.

Z:\2020-5031 Valparaiso High School\dwg\2020-5031.dwg 7/24/2020 9:37:52 AM CDT

GIBRALTAR DESIGN
ARCHITECTURE • ENGINEERING • INTERIOR DESIGN

PROJECT
# VALPARAISO HIGH SCHOOL
WEST CAMPUS IMPROVEMENTS AND RELATED WORK

VALPARAISO COMMUNITY SCHOOLS
VALPARAISO, INDIANA


TORRENGA ENGINEERING, INC.
CONSULTING ENGINEERS & LAND SURVEYORS
907 RIDGE ROAD
MUNSTER, IN 46321
T: (219) 836-8918
F: (219) 836-1138

GIBRALTAR DESIGN
9102 N. Meridian St., Ste. 300
Indianapolis, IN 46260
Homepage www.GibraltarDesign.com
Email info@GibraltarDesign.com
Phone 317.580.5777 Fax 317.580.5778


PROJECT 20-130
DATE 07/24/2020
COORDINATED BY DCT
DRAWN BY NM/EM
CHECKED BY DCT

DONALD C. TORRENGA REGISTERED No. 19868 STATE OF INDIANA PROFESSIONAL ENGINEER


COPYRIGHT NOTICE:
THE CONCEPTS, DESIGNS, PLANS, DETAILS, ETC. SHOWN ON THIS DOCUMENT ARE THE PROPERTY OF GIBRALTAR DESIGN AND ARE COVERED FOR USE ON THIS SPECIFIC PROJECT. NONE OF THIS INFORMATION SHALL BE USED BY ANY PERSON OR FIRM FOR ANY PURPOSE WITHOUT THE EXPRESS WRITTEN CONSENT OF GIBRALTAR DESIGN. THE OWNER MAY RETAIN COPIES FOR INFORMATION AND REFERENCE IN CONNECTION ONLY WITH THIS PROJECT.


REVISIONS

| MARK | DATE | ISSUED FOR |
|---|---|---|
| AD-2 | 08/07/20 | ADDENDUM NO. 2 |

DRAWING
GRADING, WATER MAIN & SANITARY SEWER PLAN

PROJECT
VALPARAISO HIGH SCHOOL
WEST CAMPUS IMPROVEMENTS AND RELATED WORK

© GIBRALTAR DESIGN

SHEET
C-3.1

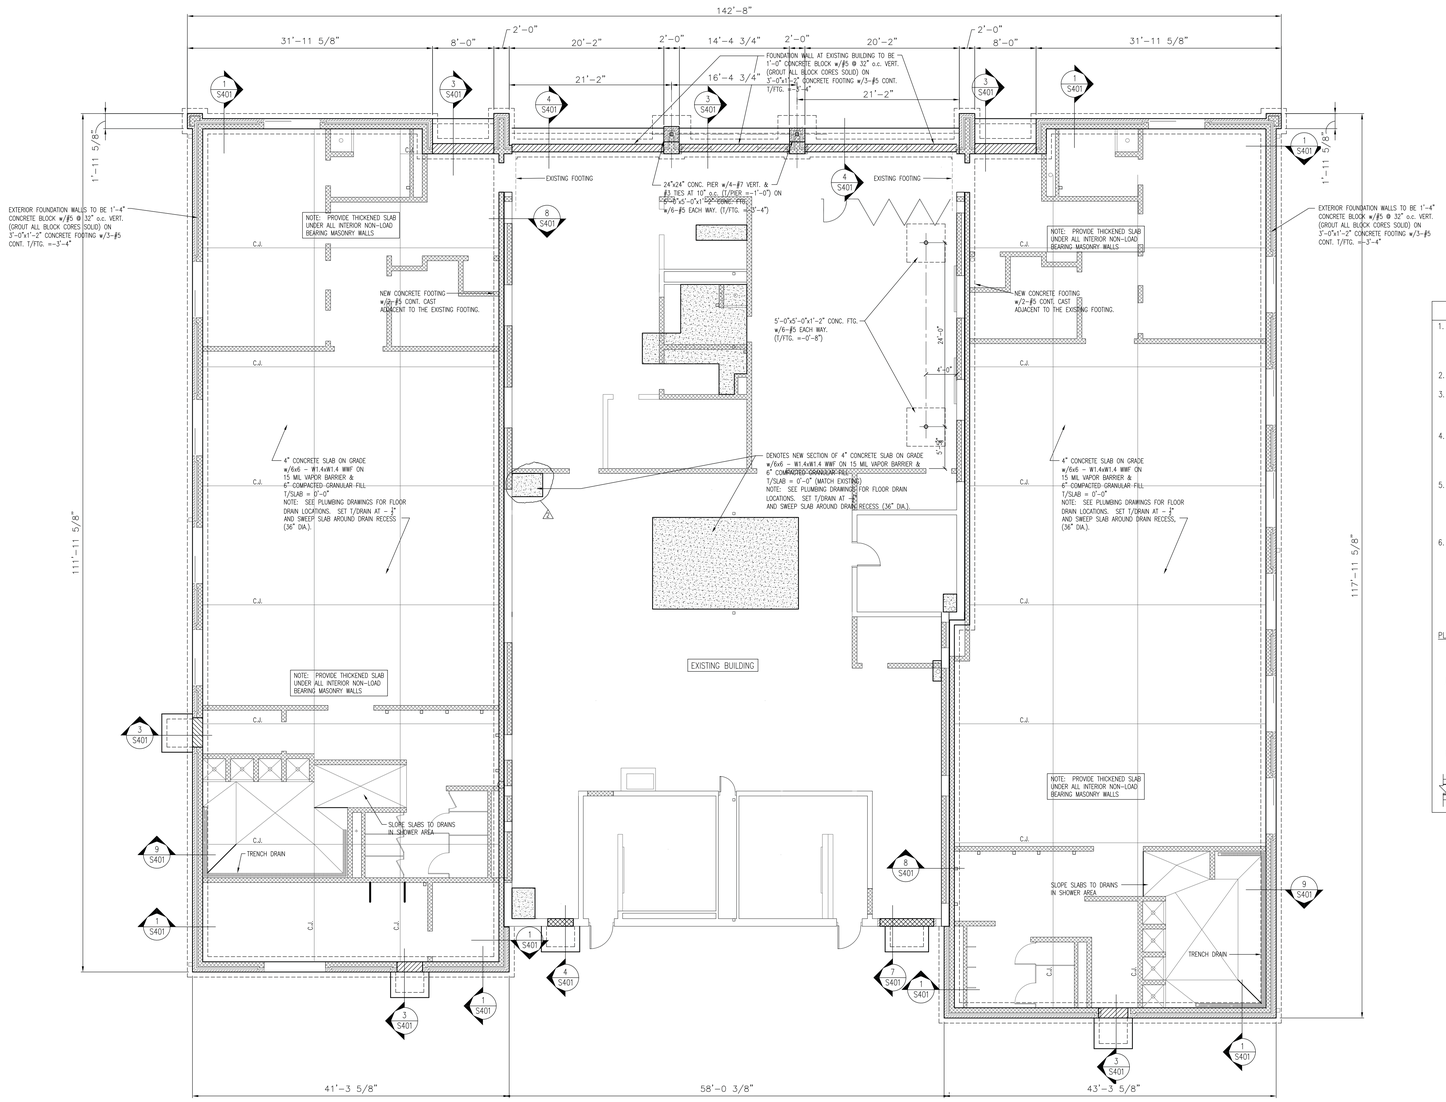


1 Foundation Plan - Cleat House

Scale: 1/8" = 1'-0"

## FOUNDATION PLAN NOTES

1. ALL CONTRACTORS ARE REQUIRED TO COORDINATE THEIR WORK WITH ALL DISCIPLINES TO AVOID CONFLICTS. THE MECHANICAL, ELECTRICAL, AND PLUMBING ASPECTS ARE NOT IN THE SCOPE OF THESE DRAWINGS. THEREFORE, ALL REQUIRED MATERIALS AND WORK MAY NOT BE INDICATED.
2. 0'-0" = NEW FINISHED FLOOR. REF. SITE/CIVIL DRAWINGS FOR EXACT USGS ELEVATION.
3. STEP THE BOTTOM OF ALL PERIMETER WALL AND COLUMN FOOTINGS AND SLEEVE AS REQUIRED FOR PLUMBING LINES (I.E. SANITARY SEWER, STORM SEWER, WATER LINES, ETC.) SHOWN ON PLUMBING DRAWINGS.
4. PROVIDE CONTROL JOINTS (C.J.) AS SHOWN ON PLAN. CONTROL JOINT SPACING SHOULD NOT GENERALLY NOT EXCEED 12'-0" IN ANY DIRECTION, WITH A MAXIMUM PANEL ASPECT RATIO OF 1.5. SUBMIT CONTROL JOINT LAYOUT PLAN FOR REVIEW PRIOR TO SLAB CONSTRUCTION.
5. COLUMN AND WALL FOOTINGS TO BEAR ON ASSUMED ALLOWABLE SOIL PRESSURE OF 2,000 AND 1,700 PSF RESPECTIVELY. WHERE THIS CAPACITY CANNOT BE ACHIEVED, THE SOIL SHOULD BE REMOVED TO A DEPTH APPROVED BY THE SOILS ENGINEER AND REPLACED WITH ENGINEERED FILL WITH AN ALLOWABLE SOIL PRESSURE MATCHING THE DESIGN PRESSURE LISTED ABOVE.
6. EARTH-FORMED FOOTINGS ARE ACCEPTABLE WHERE SOIL CONDITIONS PERMIT (i.e. WHERE THE BANKS OF THE EXCAVATION WILL HOLD WITHOUT CAVING). HOWEVER, THE PLAN DIMENSIONS OF ANY EARTH-FORMED FOOTINGS MUST BE INCREASED BY A MINIMUM OF 2" ALONG ALL EDGES TO COMPENSATE FOR INACCURACIES ASSOCIATED WITH EARTH-FORMING: 2'-0" WALL FOOTINGS BECOME 2'-4" WIDE, AND 5'-0" SQUARE COLUMN FOOTINGS BECOME 5'-4" SQUARE.

PLAN LEGEND:

COL. FOOTING SIZE PER SCHEDULE
TOP OF FTG. ELEVATION

FX.X -X'-X"
PXX -X'-X" ← TOP OF PIER ELEVATION

CONC. PIER SIZE PER SCHEDULE

F.F. DENOTES FINISH FLOOR
T/X' DENOTES TOP OF WALL, FOOTING, PIER, ETC.

HOLD FOUNDATION WALL DOWN 8" FOR TYP. EXTERIOR ENTRANCE DETAIL. REF.

GIBRALTAR
DESIGN
ARCHITECTURE • ENGINEERING • INTERIOR DESIGN

PROJECT

# VALPARAISO HIGH SCHOOL WEST CAMPUS IMPROVEMENTS

VALPARAISO COMMUNITY SCHOOLS
VALPARAISO, INDIANA


GIBRALTAR DESIGN
9102 N. Meridian St., Ste. 300
Indianapolis, IN 46260
Homepage www.GibraltarDesign.com
Email info@GibraltarDesign.com
Phone 317.580.5777 Fax 317.580.5778


PROJECT 20-130
DATE 07/24/20
COORDINATED BY WBH
DRAWN BY NHF
CHECKED BY WBH

WESLEY B. HAMILTON REGISTERED PE60860410 STATE OF INDIANA PROFESSIONAL ENGINEER


COPYRIGHT NOTICE:
THE CONCEPTS, DESIGNS, PLANS, DETAILS, ETC. SHOWN ON THIS DOCUMENT ARE THE PROPERTY OF GIBRALTAR DESIGN AND WERE CREATED FOR USE ON THIS SPECIFIC PROJECT. NONE OF THIS INFORMATION SHALL BE USED BY ANY PERSON OR FIRM FOR ANY PURPOSE WITHOUT THE EXPRESS WRITTEN CONSENT OF GIBRALTAR DESIGN. THE OWNER MAY RETAIN COPIES FOR INFORMATION AND REFERENCE IN CONNECTION ONLY WITH THIS PROJECT.


REVISIONS

| MARK | DATE | ISSUED FOR |
|---|---|---|
| 1 | 8/03/20 | ADDENDUM NUMBER 1 |
| 2 | 8/07/20 | ADDENDUM NUMBER 2 |

DRAWING

PROJECT
VALPARAISO HIGH SCHOOL WET CAMPUS IMPROVEMENTS

© GIBRALTAR DESIGN

SHEET
S201

Friday, 8/7/2020 - 1:12 PM - LAST SAVED BY:WES
F:\2020\20067 VALPO HS WEST CAMPUS\S-FP01.DWG

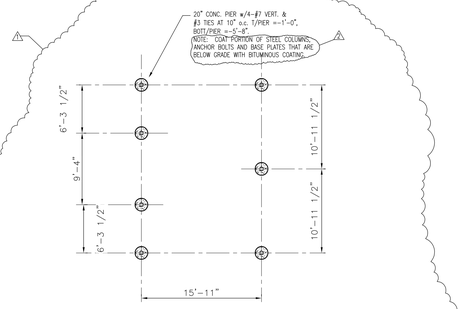


4 Foundation Plan - Tennis Platform

Scale: 1/8" = 1'-0"

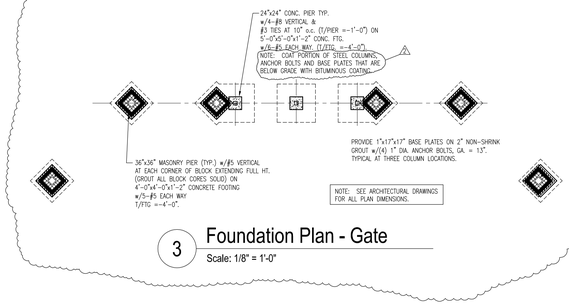


3 Foundation Plan - Gate

Scale: 1/8" = 1'-0"

## FOUNDATION PLAN NOTES

1. ALL CONTRACTORS ARE REQUIRED TO COORDINATE THEIR WORK WITH ALL DISCIPLINES TO AVOID CONFLICTS. THE MECHANICAL, ELECTRICAL, AND PLUMBING ASPECTS ARE NOT IN THE SCOPE OF THESE DRAWINGS. THEREFORE, ALL REQUIRED MATERIALS AND WORK MAY NOT BE INDICATED.
2. 0'-0" = NEW FINISHED FLOOR. REF. SITE/CIVIL DRAWINGS FOR EXACT USGS ELEVATION.
3. STEP THE BOTTOM OF ALL PERIMETER WALL AND COLUMN FOOTINGS AND SLEEVE AS REQUIRED FOR PLUMBING LINES (I.E. SANITARY SEWER, STORM SEWER, WATER LINES, ETC.) SHOWN ON PLUMBING DRAWINGS.
4. PROVIDE CONTROL JOINTS (C.J.) AS SHOWN ON PLAN. CONTROL JOINT SPACING SHOULD NOT GENERALLY NOT EXCEED 12'-0" IN ANY DIRECTION, WITH A MAXIMUM PANEL ASPECT RATIO OF 1.5. SUBMIT CONTROL JOINT LAYOUT PLAN FOR REVIEW PRIOR TO SLAB CONSTRUCTION.
5. COLUMN AND WALL FOOTINGS TO BEAR ON ASSUMED ALLOWABLE SOIL PRESSURE OF 2,000 AND 1,700 PSF RESPECTIVELY. WHERE THIS CAPACITY CANNOT BE ACHIEVED, THE SOIL SHOULD BE REMOVED TO A DEPTH APPROVED BY THE SOILS ENGINEER AND REPLACED WITH ENGINEERED FILL WITH AN ALLOWABLE SOIL PRESSURE MATCHING THE DESIGN PRESSURE LISTED ABOVE.
6. EARTH-FORMED FOOTINGS ARE ACCEPTABLE WHERE SOIL CONDITIONS PERMIT (i.e. WHERE THE BANKS OF THE EXCAVATION WILL HOLD WITHOUT CAVING). HOWEVER, THE PLAN DIMENSIONS OF ANY EARTH-FORMED FOOTINGS MUST BE INCREASED BY A MINIMUM OF 2" ALONG ALL EDGES TO COMPENSATE FOR INACCURACIES ASSOCIATED WITH EARTH-FORMING: 2'-0" WALL FOOTINGS BECOME 2'-4" WIDE, AND 5'-0" SQUARE COLUMN FOOTINGS BECOME 5'-4" SQUARE.

PLAN LEGEND:

COL. FOOTING SIZE PER SCHEDULE
TOP OF FTG. ELEVATION

F.X.X —X'-X"
PXX —X'-X" ← TOP OF PIER ELEVATION

CONC. PIER SIZE PER SCHEDULE

F.F. DENOTES FINISH FLOOR
T/'X' DENOTES TOP OF WALL, FOOTING, PIER, ETC.

HOLD FOUNDATION WALL DOWN 8" FOR TYP. EXTERIOR ENTRANCE DETAIL. REF.

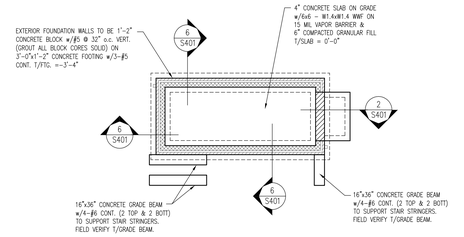


2 Foundation Plan - Pressbox

Scale: 1/8" = 1'-0"

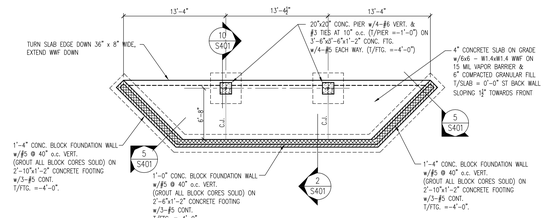


1 Foundation Plan - Dugout

Scale: 1/8" = 1'-0"

GIBRALTAR
DESIGN
ARCHITECTURE • ENGINEERING • INTERIOR DESIGN

PROJECT

# VALPARAISO HIGH SCHOOL WEST CAMPUS IMPROVEMENTS

VALPARAISO COMMUNITY SCHOOLS
VALPARAISO, INDIANA

GIBRALTAR DESIGN
9102 N. Meridian St., Ste. 300
Indianapolis, IN 46260
Homepage www.GibraltarDesign.com
Email info@GibraltarDesign.com
Phone 317.580.5777 Fax 317.580.5778

PROJECT 20-130
DATE 07/24/20
COORDINATED BY WBH
DRAWN BY NHF
CHECKED BY WBH

WESLEY B. HARRISON REGISTERED PE60860410 STATE OF INDIANA PROFESSIONAL ENGINEER

COPYRIGHT NOTICE:
THE CONCEPTS, DESIGNS, PLANS, DETAILS, ETC. SHOWN ON THIS DOCUMENT ARE THE PROPERTY OF GIBRALTAR DESIGN AND WERE CREATED FOR USE ON THIS SPECIFIC PROJECT. NONE OF THIS INFORMATION SHALL BE USED BY ANY PERSON OR FIRM FOR ANY PURPOSE WITHOUT THE EXPRESS WRITTEN CONSENT OF GIBRALTAR DESIGN. THE OWNER MAY RETAIN COPIES FOR INFORMATION AND REFERENCE IN CONNECTION ONLY WITH THIS PROJECT.

REVISIONS

| MARK | DATE | ISSUED FOR |
|---|---|---|
| 1 | 8/03/20 | ADDENDUM NUMBER 1 |
| 2 | 8/07/20 | ADDENDUM NUMBER 2 |

DRAWING

PROJECT
VALPARAISO HIGH SCHOOL WET CAMPUS IMPROVEMENTS

© GIBRALTAR DESIGN

SHEET
S202

Friday, 8/7/2020 - 7:59 AM - LAST SAVED BY:NWES
F:\2020\20067 VALPO HS WEST CAMPUS\S-FP01.DWG

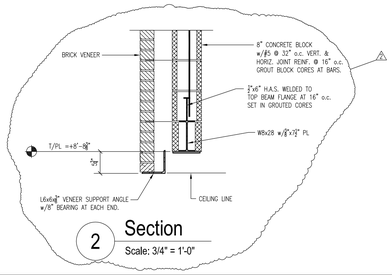


2 Section
Scale: 3/4" = 1'-0"

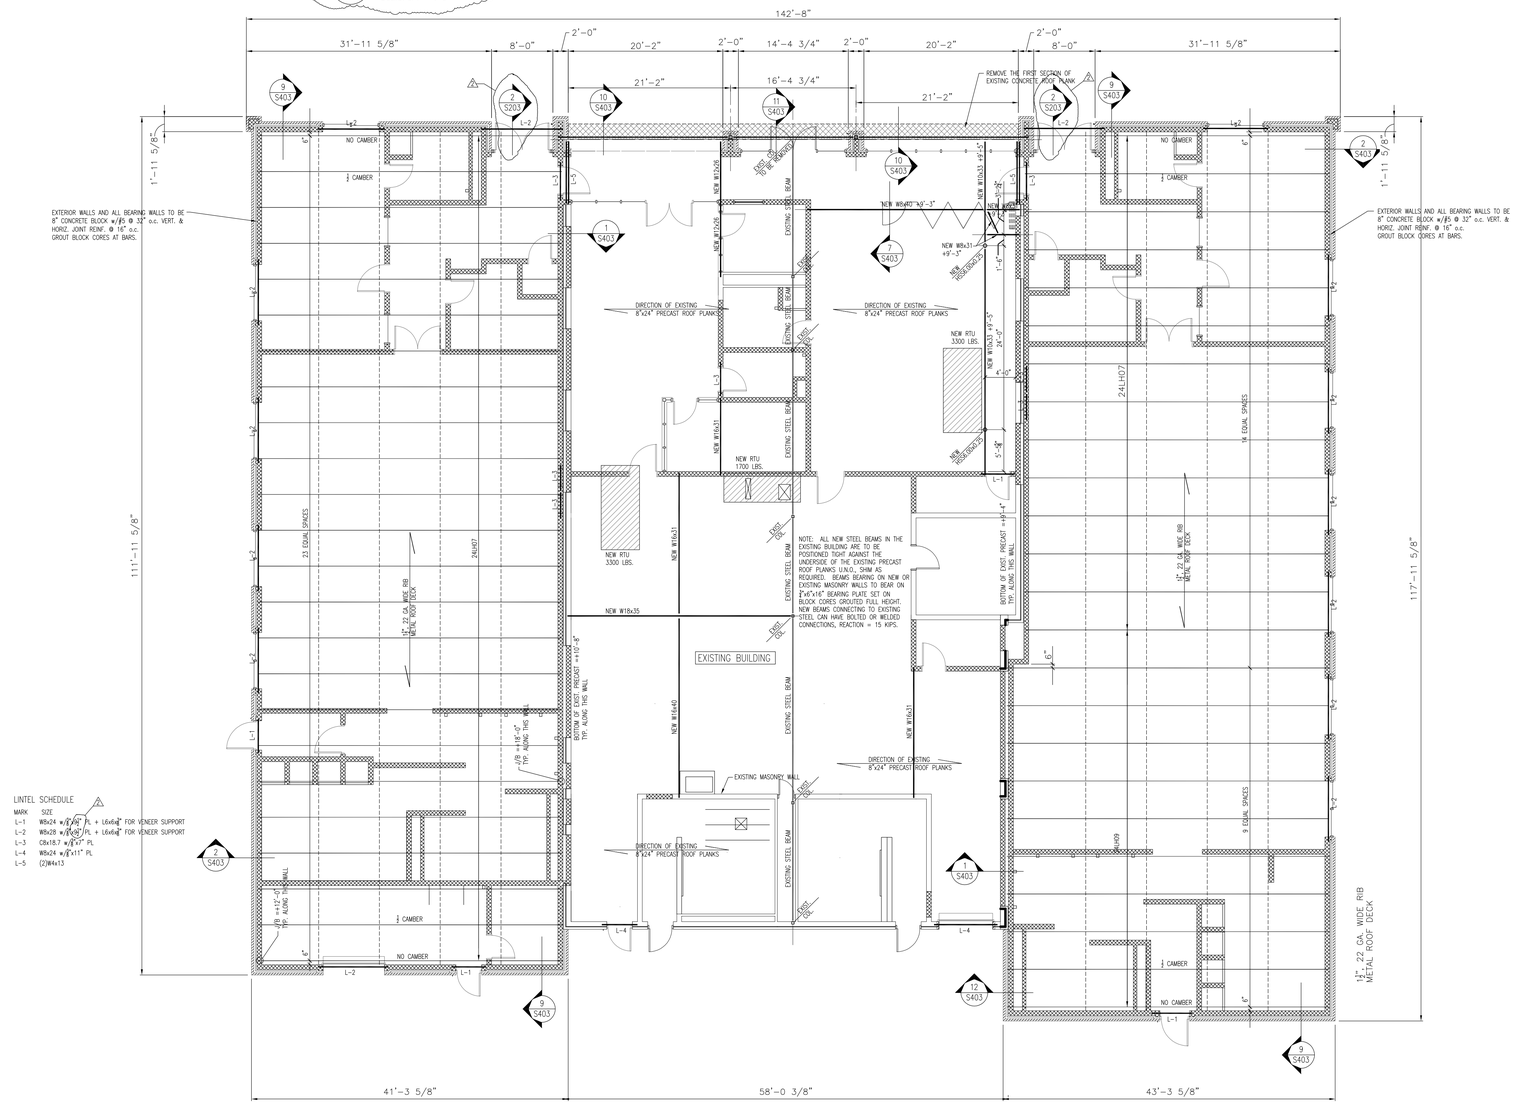


LINTEL SCHEDULE

| MARK | SIZE |
|---|---|
| L-1 | W8x24 w/3/8" PL + L6x6x3/8" FOR VENEER SUPPORT |
| L-2 | W8x28 w/3/8" PL + L6x6x3/8" FOR VENEER SUPPORT |
| L-3 | C8x18.7 w/3/8"x7" PL |
| L-4 | W8x24 w/3/8"x11" PL |
| L-5 | (2)#4x13 |

1 Roof Framing Plan - Cleat House
Scale: 1/8" = 1'-0"

GIBRALTAR
DESIGN
ARCHITECTURE • ENGINEERING • INTERIOR DESIGN

PROJECT

# VALPARAISO HIGH SCHOOL WEST CAMPUS IMPROVEMENTS

VALPARAISO COMMUNITY SCHOOLS
VALPARAISO, INDIANA

GIBRALTAR DESIGN
9102 N. Meridian St., Ste. 300
Indianapolis, IN 46260
Homepage www.GibraltarDesign.com
Email info@GibraltarDesign.com
Phone 317.580.5777 Fax 317.580.5778

PROJECT 20-130
DATE 07/24/20
COORDINATED BY WBH
DRAWN BY NHF
CHECKED BY WBH

WESLEY B. HARRISON REGISTERED PE60860410 STATE OF INDIANA PROFESSIONAL ENGINEER

COPYRIGHT NOTICE:
THE CONCEPTS, DESIGNS, PLANS, DETAILS, ETC, SHOWN ON THIS DOCUMENT ARE THE PROPERTY OF GIBRALTAR DESIGN AND WERE CREATED FOR USE ON THIS SPECIFIC PROJECT. NONE OF THIS INFORMATION SHALL BE USED BY ANY PERSON OR FIRM FOR ANY PURPOSE WITHOUT THE EXPRESS WRITTEN CONSENT OF GIBRALTAR DESIGN. THE OWNER MAY RETAIN COPIES FOR INFORMATION AND REFERENCE IN CONNECTION ONLY WITH THIS PROJECT.

REVISIONS

| MARK | DATE | ISSUED FOR |
|---|---|---|
| 1 | 8/03/20 | ADDENDUM NUMBER 1 |
| 2 | 8/07/20 | ADDENDUM NUMBER 2 |

DRAWING

PROJECT
VALPARAISO HIGH SCHOOL WET CAMPUS IMPROVEMENTS

© GIBRALTAR DESIGN

SHEET
S203

Friday, 8/7/2020 – 8:00 AM – LAST SAVED BY:WES
F:\2020\20067 VALPO HS WEST CAMPUS\S-FP02.DWG

## GENERAL PLAN NOTES:

A. FOR GENERAL PROJECT NOTES, MATERIAL INDICATIONS LEGEND, SYMBOL LEGEND, ABBREVIATIONS, ETC., REFER TO GI SERIES SHEETS.

B. PLAN DIMENSIONS TO MASONRY WALLS ARE TO FACE OF ROUGH MASONRY. PLAN DIMENSIONS TO STUD WALLS ARE TO FACE OF FINISHED GYPSUM BOARD OR PLASTER. PLAN DIMENSIONS TO STUD WALLS WITH CERAMIC TILE FINISH ARE TO THE FACE OF TILE BACKER BOARD.

C. ALL CMU WALLS THAT DO NOT LAY OUT IN FULL OR HALF LENGTHS SHOULD BE BALANCED SO AS NOT TO HAVE ANY PIECES LESS THAN 4" IN SIZE EXPOSED TO VIEW.

D. MASONRY WALLS BEARING ON A THICKENED SLAB AT SLAB DEPRESSIONS REQUIRE CUT MASONRY UNITS SO THAT COURSING BEGINS AT THE FLOOR LINE.

E. THE BASE FIRST FLOOR ELEVATION INDICATED FOR THE PROJECT IS 100'-0". REFER TO SITE PLAN FOR CORRELATION TO USGS DATUM.

F. HINGE SIDE OF DOOR JAMB AT CMU WALLS SHALL BE LOCATED 8" MINIMUM FROM ADJACENT WALL AND HINGE SIDE OF DOOR JAMB AT GYPSUM BOARD WALLS SHALL BE LOCATED 4" MINIMUM FROM ADJACENT WALL UNLESS NOTED OTHERWISE.

G. PROVIDE WOOD BLOCKING (OR METAL STRAPPING WHERE APPLICABLE) AS REQUIRED WITHIN METAL STUD WALLS FOR WALL MOUNTED ITEMS.

H. REFER TO LIFE SAFETY PLANS REGARDING FIRE RATED WALL LOCATIONS AND OTHER CODE INFORMATION.

I. INTERIOR CMU WALLS ARE TO BE STACK BOND UNLESS NOTED OTHERWISE.

J. WHERE NEW CMU WALLS INTERSECT EXISTING CMU WALLS AT A CORNER OR ARE ALIGNED WITH EXISTING CMU WALLS, TOOTH NEW CMU INTO EXISTING CMU UNLESS NOTED OTHERWISE.

K. REFER TO FINISH PLANS FOR LOCATION AND EXTENT OF FINISHED FLOOR AND WALL MATERIAL.

L. ALL EXPOSED CONCRETE MASONRY UNITS (CMU) CORNERS ARE TO BE BULLNOSED, EXCEPT AT MASONRY BULKHEADS AND EXTERIOR WINDOW JAMBS.

M. REFER TO DEMOLITION SHEETS FOR ADDITIONAL PATCHING AND REPAIR WORK.

N. ALL PARTITIONS TO BE TYPE B8 UNLESS NOTED OTHERWISE.

## PLAN LEGEND:

INDICATES WALL TYPES REFER TO G-201 FOR WALL THICKNESS, HEIGHT, AND COMPOSITION.

## PLAN NOTES:

1. CONCRETE STOOP.
2. FLOOR DRAIN. SEE PLUMBING DRAWINGS.
3. DISPLAY WALL, REFER TO EQUIPMENT PLAN.
4. CASEWORK AND/OR MILLWORK, REFER TO EQUIPMENT PLANS.
5. DASH LINE INDICATES TYPICAL BULKHEAD, REFER TO SECTIONS AND REFLECTED CEILING PLANS.
6. PLUMBING FIXTURE, REFER TO EQUIPMENT DRAWINGS AND PLUMBING DRAWINGS.
7. BASE BID: NO FOLDING PARTITION
   ALTERNATE BID: GLASS FOLDING PARTITION.
8. 4" X 4" ALUMINUM DOWNSPOUT, VERIFY SIZE.
9. 6" PIPE BOLLARD. — 3/A-501
10. PROVIDE NEW CMU AND CONCRETE LOCKER BASE. — 3/A-501, A-501
11. INFILL EXISTING OPENING WITH 8" CMU.
12. ALIGN
13. PUSH PAD FOR ADA OPERATOR, REFER TO ELECTRICAL DRAWINGS.
14. CARD/FOB READER, REFER TO ELECTRICAL DRAWINGS.
15. KNOX BOX.
16. ALUMINUM BLEACHERS.
17. HELMET SHELF.
18. SPEAKERS, REFER TO TECHNOLOGY DRAWINGS.
19. SOUND SYSTEM, REFER TO TECHNOLOGY DRAWINGS.
20. ALL HOLES, CHIPS, DEFECTIONS IN EXISTING PRECAST PANELS TO BE PATCHED OR COVERED WITH .040 METAL PLATE TO PROVIDE SMOOTH FINISH. PAINT TO MATCH EXISTING PRECAST PANELS.
21. NEW CONCRETE SLAB.
22. FIRE EXTINGUISHER CABINET. — 5/A-501
23. FIRE EXTINGUISHER.
24. 4X4X1/4 MIN STEEL TUBE COLUMN.
25. 1X6 FINISHED WOOD TRIM IN THIS ROOM WHERE WALL OR BULKHEAD MEET CONCRETE CORE SLAB CEILING.
26. CHAIN LINK FENCE, REFER TO CIVIL.
27. NEW ALUMINUM ORNAMENTAL FENCE. — AD-1
28. NEW ALUMINUM ORNAMENTAL GATE.
29. STEEL COLUMN, REFER TO STRUCTURAL.
30. METAL GUARDRAIL/HANDRAIL. — 7/A-501
31. METAL STAIR. — 8/A-501, 9/A-501, 10/A-501
32. 3" X 4" ALUMINUM DOWNSPOUT, VERIFY SIZE.
33. GUARDRAIL. — 11/A-501 — AD-1
34. 8'H BLACK VINYL CHAINLINK FENCE, REFER TO SPECIFICATIONS. — AD-2

## GENERAL DEMOLITION NOTES:

A. FOR GENERAL PROJECT NOTES, MATERIAL INDICATIONS LEGEND, SYMBOL LEGEND, ABBREVIATIONS, ETC., REFER TO GI SERIES SHEETS.

B. CONTRACTORS ENCOUNTERING EXISTING MATERIAL WHICH IS SUSPECTED OF CONTAINING ASBESTOS SHALL STOP WORK IMMEDIATELY AND NOTIFY THE OWNER AND THE OWNERS REPRESENTATIVE.

C. BOLD DASHED LINES INDICATE EXISTING ITEMS TO BE REMOVED UNLESS OTHERWISE NOTED. THE CONTRACTOR SHALL BE RESPONSIBLE FOR FIELD VERIFYING THE EXTENT OF DEMOLITION WORK PRIOR TO BIDDING AND FOR COORDINATING THE EXTENT OF DEMOLITION WITH THE INSTALLATION OF NEW SYSTEMS.

D. EACH CONTRACTOR SHALL BE RESPONSIBLE FOR ALL DEMOLITION APPLICABLE TO THEIR SCOPE OF WORK AND AS REQUIRED FOR INSTALLATION OF NEW WORK WHETHER OR NOT IT IS SPECIFICALLY INDICATED OR NOTED IN THESE DOCUMENTS.

E. REMOVE ALL ITEMS AND FINISHES MADE OBSOLETE BY NEW CONSTRUCTION. VERIFY ITEMS DEEMED OBSOLETE WITH ARCHITECT PRIOR TO REMOVAL. REFER TO NEW CONSTRUCTION DRAWINGS FOR DEMOLITION REQUIRED NOT SHOWN ON DEMOLITION PLANS.

F. EACH CONTRACTOR SHALL BE RESPONSIBLE FOR OFF SITE REMOVAL OF ALL DEMOLITION MATERIALS AND/OR ITEMS UNLESS NOTED OTHERWISE OR DIRECTED BY THE OWNER.

G. DEMOLITION SHALL BE PERFORMED WITHOUT DAMAGE TO EXISTING CONSTRUCTION TO REMAIN. WHERE SUCH DAMAGE OCCURS, PATCH, REPAIR, OR RESTORE WALLS, FLOORS, CEILING, ETC. NEATLY TO MATCH EXISTING ADJACENT SURFACE. PROVIDE SHORING, BRACING, OR SUPPORT AS REQUIRED TO PREVENT MOVEMENT OR SETTLEMENT OF EXISTING STRUCTURES.

H. EACH CONTRACTOR IS RESPONSIBLE FOR CUTTING, PATCHING, AND DISCONNECTION OF ITEMS APPLICABLE TO THEIR SCOPE OF WORK. WHERE EXISTING SERVICES ARE ABANDONED, CAP AT LEAST 1" BEHIND NEW FINISHES AND/OR EXISTING SURFACE AND PATCH AS REQUIRED TO RECEIVE NEW FINISHES OR MATCH EXISTING FINISH.

I. ON WALLS THAT ARE TO RECEIVE NEW FINISHES, REMOVE AND REINSTALL EXISTING EQUIPMENT TO REMAIN AS REQUIRED FOR INSTALLATION OF NEW FINISHES.

J. WHERE WALLS OR BULKHEADS ARE REMOVED, PATCH FLOORS, CEILINGS, AND ADJACENT WALLS AS REQUIRED TO MATCH EXISTING OR RECEIVE NEW FINISHES WHERE APPLICABLE. WHERE EXISTING DUCTWORK, PIPING, OR EQUIPMENT IS REMOVED, PATCH OPENINGS AND/OR SURFACES AS REQUIRED TO MATCH ADJACENT SURFACES OR RECEIVE NEW FINISHES WHERE APPLICABLE. REFER TO ALL DEMOLITION DRAWINGS FOR EXTENT OF ITEMS TO REMOVED.

K. OVER CUT NEW OPENINGS IN EXISTING WALL AS REQUIRED FOR NEW CONSTRUCTION. PATCH AND REPAIR WALLS AS REQUIRED TO MATCH EXISTING. WHERE APPLICABLE, TOOTH NEW MASONRY INTO EXISTING MASONRY.

## GENERAL DEMOLITION NOTES CONTINUED:

L. ALL EQUIPMENT AND FURNITURE WHICH ARE CONSIDERED LOOSE FURNISHING SHALL BE REMOVED BY THE OWNER PRIOR TO DEMOLITION.

M. MASONRY WALLS TO BE REMOVED SHALL BE REMOVED TO A POINT 2" MINIMUM BELOW THE EXISTING FLOOR SLAB UNLESS SETTING ON A SLAB OR SPECIFICALLY NOTED OTHERWISE. PATCH WITH NEW CONCRETE TO BE FLUSH WITH THE EXISTING FLOOR SLAB.

N. EACH CONTRACTOR SHALL BE RESPONSIBLE FOR GENERAL REVIEW OF DEMOLITION NOTES AND GENERAL DEMOLITION NOTES AS THEY APPLY TO THEIR SCOPE OF WORK.

O. THE OWNER SHALL RESERVE THE RIGHT TO CLAIM ANY MATERIALS THAT ARE BEING DEMOLISHED PRIOR TO THE CONTRACTOR DISPOSING OF THEM OFF SITE.

P. REFER TO THE STRUCTURAL, MECHANICAL, PLUMBING, ELECTRICAL AND TECHNOLOGY DOCUMENTS FOR COMPLETE SCOPE OF DEMOLITION WORK.

Q. "FLOORING" DENOTES FLOOR COVERING MATERIALS INCLUDING BACKING, ADHESIVES, AND BASES DOWN TO BUT EXCLUSIVE OF FLOOR SLABS AND STRUCTURAL MATERIALS UNLESS NOTED OTHERWISE.

R. DEMOLITION IS TO FOLLOW ESTABLISHED CONSTRUCTION SEQUENCE. REFER TO SPECIFICATIONS AND DRAWINGS FOR REQUIREMENTS AND SPECIAL CONDITIONS.

## DEMOLITION PLAN NOTES:

1. REMOVE CERAMIC OR PORCELAIN TILE AND MUD SLAB FLOORING SYSTEM IN ITS ENTIRETY.
2. REMOVE TACK BOARD, MARKER BOARD OR CHALKBOARD IN THEIR ENTIRETY. PATCH WALL AS REQUIRED TO RECEIVE NEW FINISHES.
3. REMOVE PLUMBING FIXTURE. REFER TO PLUMBING DRAWINGS. WHERE PIPING IS REQUIRED TO BE CAPPED, CAP BELOW AND/OR BEHIND FINISHED SURFACE.
4. REMOVE MASONRY WALL (AS REQUIRED FOR NEW CONSTRUCTION.) PATCH AND REPAIR FLOOR AND WALL AS REQUIRED TO ACCEPT NEW FINISHES.
5. REMOVE HOLLOW METAL DOOR, FRAME AND HARDWARE IN ITS ENTIRETY.
6. REMOVE OVERHEAD DOOR IN ITS ENTIRETY.
7. REMOVE METAL LOCKERS. REMOVE CONCRETE BASE AS REQUIRED FOR NEW CONSTRUCTION.
8. EXISTING STEEL COLUMN TO REMAIN.
9. REMOVE MECHANICAL UNIT. PATCH AND REPAIR WALL AND FLOOR TO RECEIVE NEW FINISHES. REFER TO MECHANICAL DRAWINGS.
10. REMOVE PLUMBING UNIT. PATCH AND REPAIR WALL AND FLOOR TO RECEIVE NEW FINISHES. REFER TO PLUMBING DRAWINGS.
11. REMOVE PORTION OF MASONRY WALL AS REQUIRED TO INSTALL NEW DOOR.
12. REMOVE TOILET ACCESSORIES AND TURN OVER TO THE OWNER.
13. HATCH INDICATES AREA OF FLOOR TO BE REMOVED AS REQUIRED FOR NEW CONSTRUCTION. REFER TO STRUCTURAL DRAWINGS.
14. REMOVE ELECTRICAL PANELS. REFER TO ELECTRICAL DRAWINGS.
15. REMOVE WINDOW IN ITS ENTIRETY.
16. REMOVE EXISTING FLOOR DRAIN. REFER TO PLUMBING DRAWINGS.
17. REMOVE VOID SLAB/STOOP/STEPS/RAMP AS REQUIRED FOR NEW CONSTRUCTION.
18. REMOVE EXISTING BUILT-IN CASEWORK.
19. REMOVE DOWNSPOUT AND BOOT IN THEIR ENTIRETY.
20. REMOVE EXISTING COLUMN.
21. REMOVE PORTION OF EXISTING CONCRETE SLAB AS REQUIRED FOR NEW CONSTRUCTION.

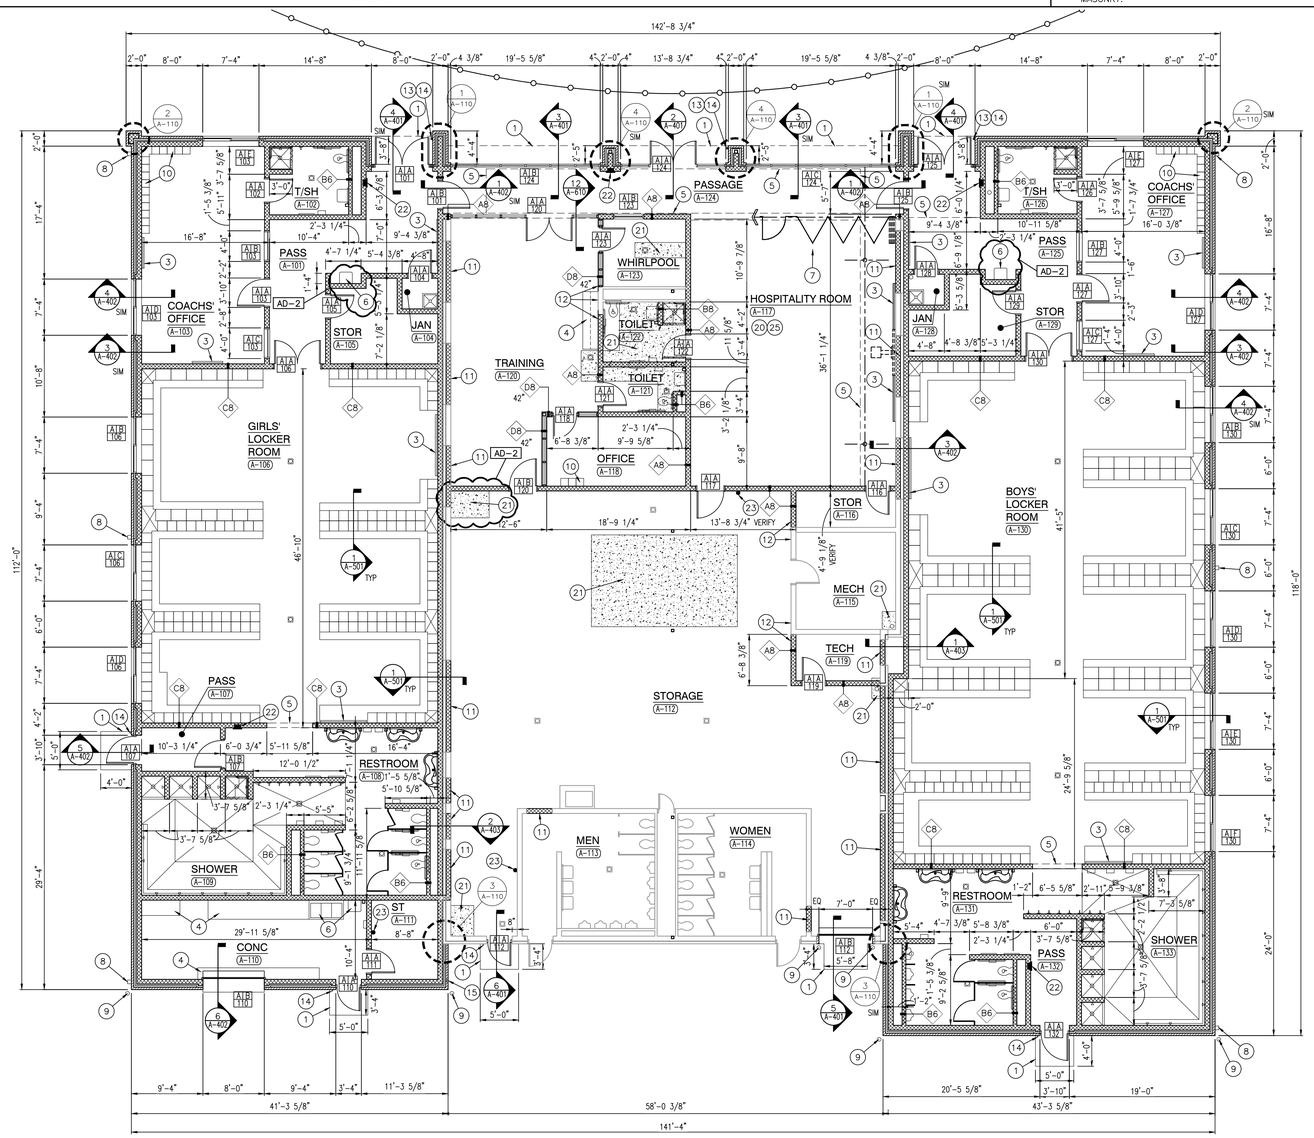


## CLEAT HOUSE ARCHITECTURAL FLOOR PLAN

SCALE: 1/8" = 1'-0"

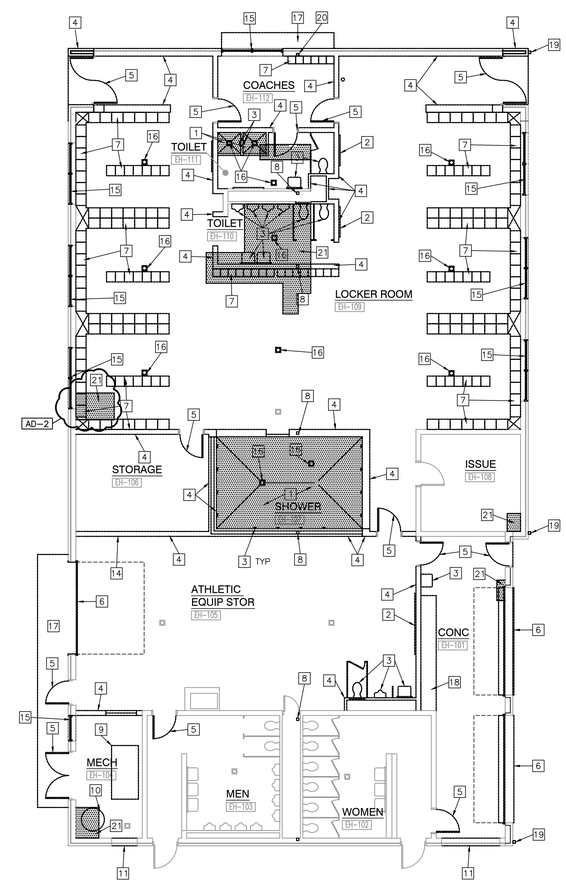


## CLEAT HOUSE ARCHITECTURAL DEMOLITION PLAN

SCALE: 1/8" = 1'-0"

GIBRALTAR DESIGN
ARCHITECTURE • ENGINEERING • INTERIOR DESIGN

PROJECT
VALPARAISO HIGH SCHOOL WEST CAMPUS IMPROVEMENTS
VALPARAISO COMMUNITY SCHOOLS
VALPARAISO, INDIANA


GIBRALTAR DESIGN
9102 N. Meridian St., Ste. 300
Indianapolis, IN 46260
Homepage www.GibraltarDesign.com
Email info@GibraltarDesign.com
Phone 317.580.5777 Fax 317.580.5778


PROJECT 20-130
DATE 07/24/20
COORDINATED BY JPB
DRAWN BY DTB
CHECKED BY JPB GWT

JOSEPH P. BRIGGS REGISTERED NO. 11600109 STATE OF INDIANA ARCHITECT


COPYRIGHT NOTICE:
THE CONCEPTS, DESIGNS, PLANS, DETAILS, ETC. SHOWN ON THIS DOCUMENT ARE THE PROPERTY OF GIBRALTAR DESIGN AND WERE CREATED FOR USE ON THIS SPECIFIC PROJECT. NONE OF THE INFORMATION SHOWN IS TO BE REPRODUCED OR FOR THE BENEFIT OF ANYONE WITHOUT THE EXPRESS WRITTEN CONSENT OF GIBRALTAR DESIGN. THE OWNER MAY RETAIN COPIES FOR INFORMATION AND REFERENCE IN CONNECTION ONLY WITH THIS PROJECT.


REVISIONS

| MARK | DATE | ISSUED FOR |
|---|---|---|
| AD-1 | 08/03/20 | ADDENDUM NO. 1 |
| AD-2 | 08/07/20 | ADDENDUM NO. 2 |

DRAWING
CLEAT HOUSE ARCHITECTURAL DEMOLITION AND NEW FLOOR PLANS

PROJECT
VALPARAISO HIGH SCHOOL WEST CAMPUS IMPROVEMENTS

© GIBRALTAR DESIGN

SHEET
A-101

Friday, 8/7/2020 – 4:06 PM – LAST SAVED BY:DBURNS
Y:\20-130 VALPARASO CS – VHS WEST CAMPUS IMPROVEMENTS\20-130 DRAWINGS\05 ARCH\A-101.DWG

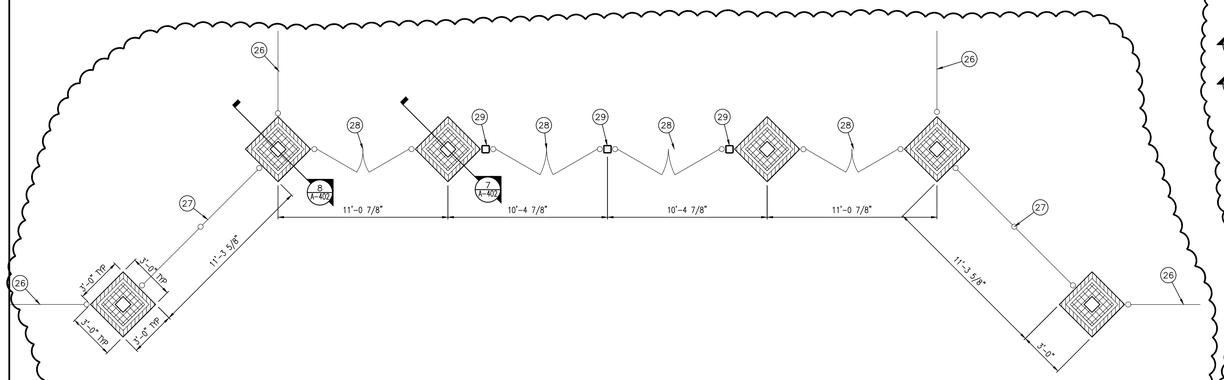


## ENTRANCE GATE ARCHITECTURAL FLOOR PLAN

SCALE: 1/4" = 1'-0"

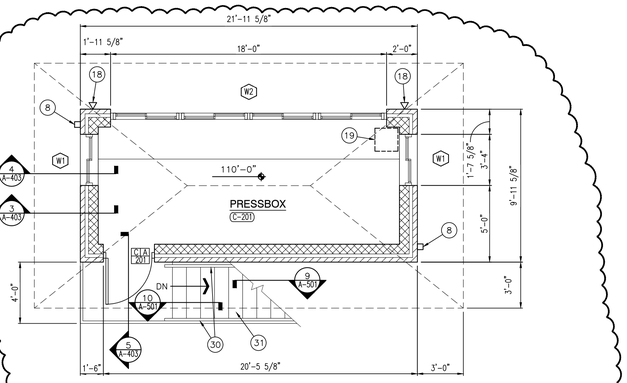


## BASEBALL PRESS BOX ARCHITECTURAL SECOND FLOOR PLAN

SCALE: 1/4" = 1'-0"

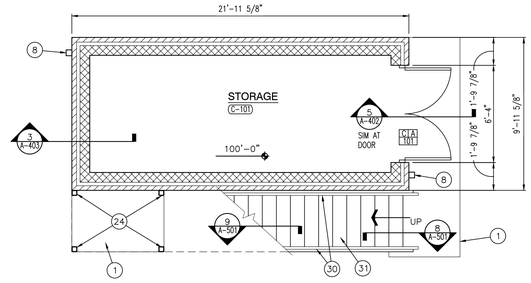


## BASEBALL PRESS BOX ARCHITECTURAL FIRST FLOOR PLAN

SCALE: 1/4" = 1'-0"

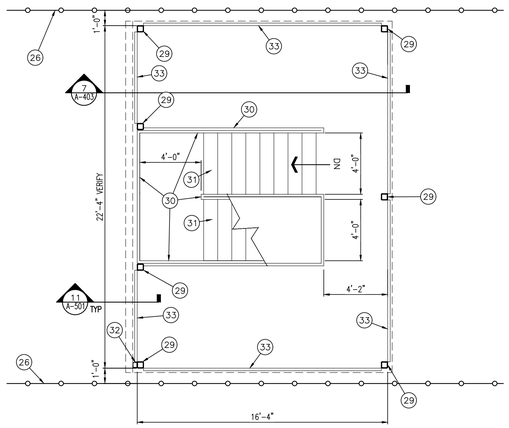


## TENNIS PLATFORM ARCHITECTURAL FLOOR PLAN

AD-1

SCALE: 1/4" = 1'-0"

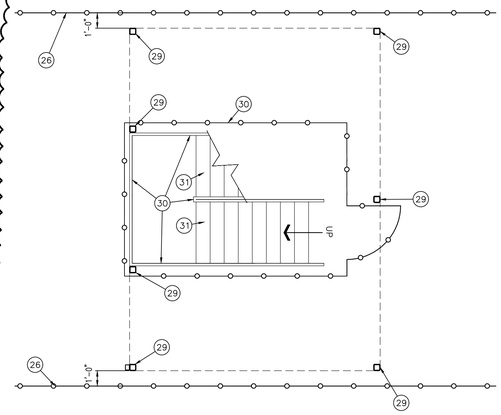


## TENNIS PLATFORM ARCHITECTURAL GROUND FLOOR PLAN

SCALE: 1/4" = 1'-0"

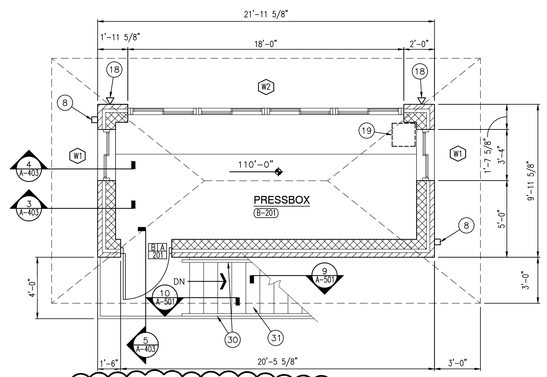


AD-2

## SOFTBALL PRESS BOX ARCHITECTURAL SECOND FLOOR PLAN

SCALE: 1/4" = 1'-0"

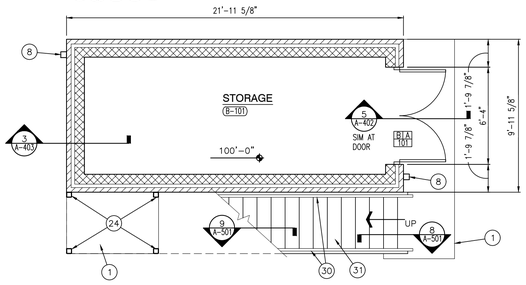


AD-2

## SOFTBALL PRESS BOX ARCHITECTURAL FIRST FLOOR PLAN

SCALE: 1/4" = 1'-0"

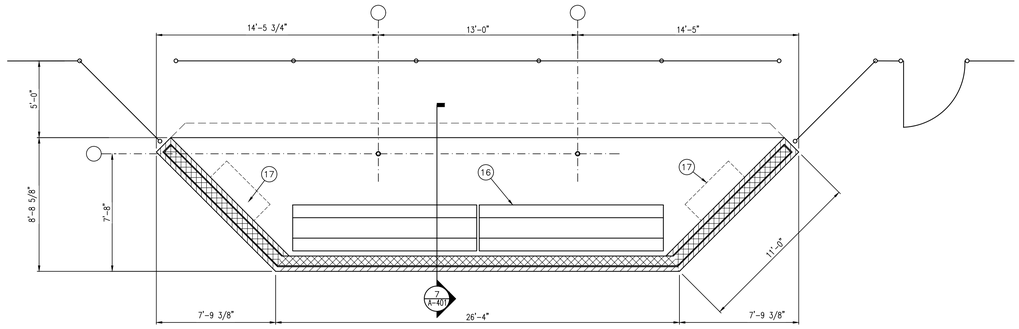


## DUGOUT ARCHITECTURAL FLOOR PLAN

SCALE: 1/4" = 1'-0"

## GENERAL PLAN NOTES:

A. FOR GENERAL PROJECT NOTES, MATERIAL INDICATIONS LEGEND, SYMBOL LEGEND, ABBREVIATIONS, ETC., REFER TO GI SERIES SHEETS.

B. PLAN DIMENSIONS TO MASONRY WALLS ARE TO FACE OF ROUGH MASONRY. PLAN DIMENSIONS TO STUD WALLS ARE TO FACE OF FINISHED GYPSUM BOARD OR PLASTER. PLAN DIMENSIONS TO STUD WALLS WITH CERAMIC TILE FINISH ARE TO THE FACE OF TILE BACKER BOARD.

C. ALL CMU WALLS THAT DO NOT LAY OUT IN FULL OR HALF LENGTHS SHOULD BE BALANCED SO AS NOT TO HAVE ANY PIECES LESS THAN 4" IN SIZE EXPOSED TO VIEW.

D. MASONRY WALLS BEARING ON A THICKENED SLAB AT SLAB DEPRESSIONS REQUIRE CUT MASONRY UNITS SO THAT COURSING BEGINS AT THE FLOOR LINE.

E. THE BASE FIRST FLOOR ELEVATION INDICATED FOR THE PROJECT IS 100'-0". REFER TO SITE PLAN FOR CORRELATION TO USGS DATUM.

F. HINGE SIDE OF DOOR JAMB AT CMU WALLS SHALL BE LOCATED 8" MINIMUM FROM ADJACENT WALL AND HINGE SIDE OF DOOR JAMB AT GYPSUM BOARD WALLS SHALL BE LOCATED 4" MINIMUM FROM ADJACENT WALL UNLESS NOTED OTHERWISE.

G. PROVIDE WOOD BLOCKING (OR METAL STRAPPING WHERE APPLICABLE) AS REQUIRED WITHIN METAL STUD WALLS FOR WALL MOUNTED ITEMS.

H. REFER TO LIFE SAFETY PLANS REGARDING FIRE RATED WALL LOCATIONS AND OTHER CODE INFORMATION.

I. INTERIOR CMU WALLS ARE TO BE STACK BOND UNLESS NOTED OTHERWISE.

J. WHERE NEW CMU WALLS INTERSECT EXISTING CMU WALLS AT A CORNER OR ARE ALIGNED WITH EXISTING CMU WALLS, TOOTH NEW CMU INTO EXISTING CMU UNLESS NOTED OTHERWISE.

K. REFER TO FINISH PLANS FOR LOCATION AND EXTENT OF FINISHED FLOOR AND WALL MATERIAL.

L. ALL EXPOSED CONCRETE MASONRY UNITS (CMU) CORNERS ARE TO BE BULLNOSED, EXCEPT AT MASONRY BULKHEADS AND EXTERIOR WINDOW JAMBS.

M. REFER TO DEMOLITION SHEETS FOR ADDITIONAL PATCHING AND REPAIR WORK.

N. ALL PARTITIONS TO BE TYPE B8 UNLESS NOTED OTHERWISE.

## PLAN LEGEND:

◇ INDICATES WALL TYPES REFER TO G-201 FOR WALL THICKNESS, HEIGHT, AND COMPOSITION.

## PLAN NOTES:

1. CONCRETE STOOP.
2. FLOOR DRAIN. SEE PLUMBING DRAWINGS.
3. DISPLAY WALL, REFER TO EQUIPMENT PLAN.
4. CASEWORK AND/OR MILLWORK, REFER TO EQUIPMENT PLANS.
5. DASH LINE INDICATES TYPICAL BULKHEAD, REFER TO SECTIONS AND REFLECTED CEILING PLANS.
6. PLUMBING FIXTURE, REFER TO EQUIPMENT DRAWINGS AND PLUMBING DRAWINGS.
7. BASE BID: NO FOLDING PARTITION
   ALTERNATE BID: GLASS FOLDING PARTITION.
8. 4" X 4" ALUMINUM DOWNSPOUT, VERIFY SIZE.
9. 6" PIPE BOLLARD. — 3/A-501, 1/A-501
10. PROVIDE NEW CMU AND CONCRETE LOCKER BASE.
11. INFILL EXISTING OPENING WITH 8" CMU.
12. ALIGN
13. PUSH PAD FOR ADA OPERATOR, REFER TO ELECTRICAL DRAWINGS.
14. CARD/FOB READER, REFER TO ELECTRICAL DRAWINGS.
15. KNOX BOX.
16. ALUMINUM BLEACHERS.
17. HELMET SHELF.
18. SPEAKERS, REFER TO TECHNOLOGY DRAWINGS.
19. SOUND SYSTEM, REFER TO TECHNOLOGY DRAWINGS.
20. ALL HOLES, CHIPS, DEFECTIONS IN EXISTING PRECAST PANELS TO BE PATCHED OR COVERED WITH .040 METAL PLATE TO PROVIDE SMOOTH FINISH. PAINT TO MATCH EXISTING PRECAST PANELS.
21. NEW CONCRETE SLAB.
22. FIRE EXTINGUISHER CABINET. — 5/A-501
23. FIRE EXTINGUISHER.
24. 4X4X1/4 MIN STEEL TUBE COLUMN.
25. 1X6 FINISHED WOOD TRIM IN THIS ROOM WHERE WALL OR BULKHEAD MEET CONCRETE CORE SLAB CEILING.
26. CHAIN LINK FENCE, REFER TO CIVIL.
27. NEW ALUMINUM ORNAMENTAL FENCE.
28. NEW ALUMINUM ORNAMENTAL GATE.
29. STEEL COLUMN, REFER TO STRUCTURAL.
30. METAL GUARDRAIL/HANDRAIL. — 7/A-501
31. METAL STAIR: — 8/A-501, 9/A-501, 10/A-501 — AD-1
32. 3" X 4" ALUMINUM DOWNSPOUT, VERIFY SIZE.
33. GUARDRAIL. — 11/A-501
34. 8'H BLACK VINYL CHAINLINK FENCE. REFER TO SPECIFICATIONS. — AD-2

GIBRALTAR DESIGN

ARCHITECTURE • ENGINEERING • INTERIOR DESIGN

PROJECT

# VALPARAISO HIGH SCHOOL WEST CAMPUS IMPROVEMENTS

VALPARAISO COMMUNITY SCHOOLS
VALPARAISO, INDIANA


GIBRALTAR DESIGN
9102 N. Meridian St., Ste. 300
Indianapolis, IN 46260
Homepage www.GibraltarDesign.com
Email info@GibraltarDesign.com
Phone 317.580.5777 Fax 317.580.5778


PROJECT 20-130
DATE 07/24/20
COORDINATED BY JPB
DRAWN BY DTB
CHECKED BY JPB GWT

JOSEPH P. BRIGGS REGISTERED NO. 11600109 STATE OF INDIANA ARCHITECT


COPYRIGHT NOTICE:
THE CONCEPTS, DESIGNS, PLANS, DETAILS, ETC., SHOWN ON THIS DOCUMENT ARE THE PROPERTY OF GIBRALTAR DESIGN AND WERE CREATED FOR USE ON THIS SPECIFIC PROJECT. NONE OF THIS INFORMATION SHALL BE USED BY ANY PERSON OR FIRM FOR ANY PURPOSE WITHOUT THE EXPRESS WRITTEN CONSENT OF GIBRALTAR DESIGN. THE OWNER MAY RETAIN COPIES FOR INFORMATION AND REFERENCE IN CONNECTION ONLY WITH THIS PROJECT.


REVISIONS

| MARK | DATE | ISSUED FOR |
|---|---|---|
| AD-1 | 08/03/20 | ADDENDUM NO. 1 |
| AD-2 | 08/07/20 | ADDENDUM NO. 2 |

DRAWING
PRESS BOX AND DUGOUT ARCHITECTURAL FLOOR PLANS

PROJECT
VALPARAISO HIGH SCHOOL WEST CAMPUS IMPROVEMENTS

© GIBRALTAR DESIGN

SHEET
A-102


Friday, 8/7/2020 – 2:09 PM – LAST SAVED BY:DBURNS
Y:\20-130 VALPARAISO CS – VHS WEST CAMPUS IMPROVEMENTS\20-130 DRAWINGS\05 ARCH\A-102.DWG

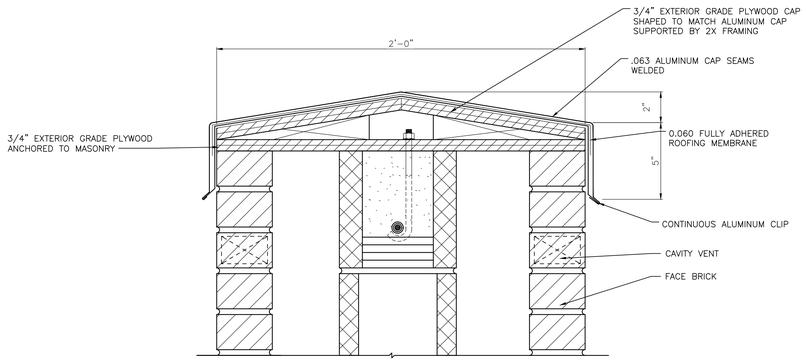


## PIER CAP DETAIL

SCALE: 3" = 1'-0"

9 / A-210

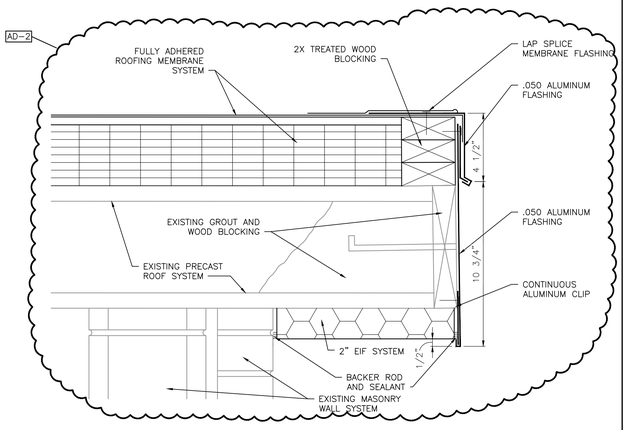


## ROOF EDGE DETAIL

SCALE: 3" = 1'-0"

6 / A-210

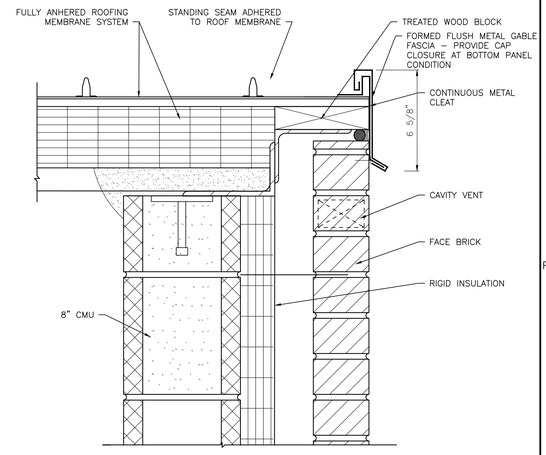


## ROOF EDGE DETAIL

SCALE: 3" = 1'-0"

3 / A-210

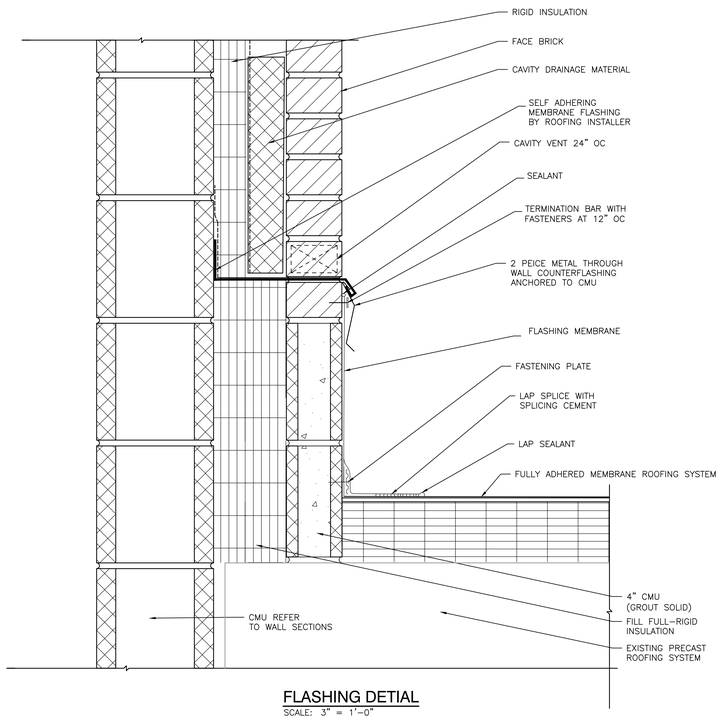


## FLASHING DETIAL

SCALE: 3" = 1'-0"

8 / A-210

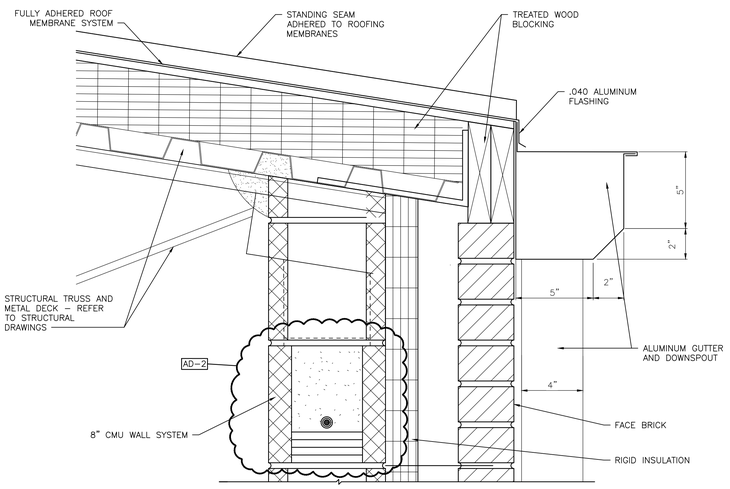


## ROOF EDGE DETAIL

SCALE: 3" = 1'-0"

5 / A-210

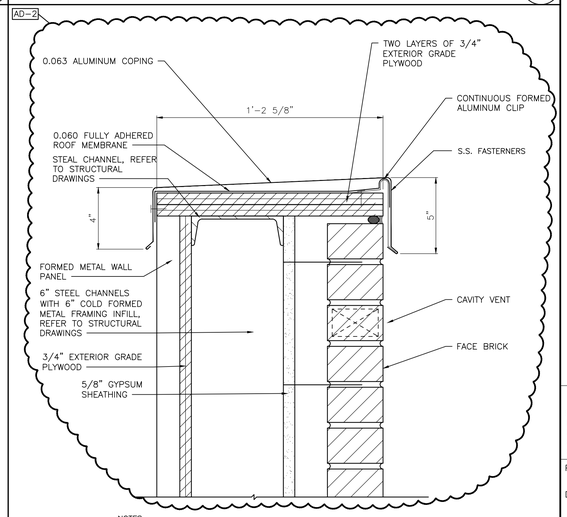


NOTES:
1) FASTEN COPING IN ACCORDANCE WITH CURRENT SMACNA AND FM RECOMMENDATIONS.

## COPING DETAIL

SCALE: 3" = 1'-0"

2 / A-210

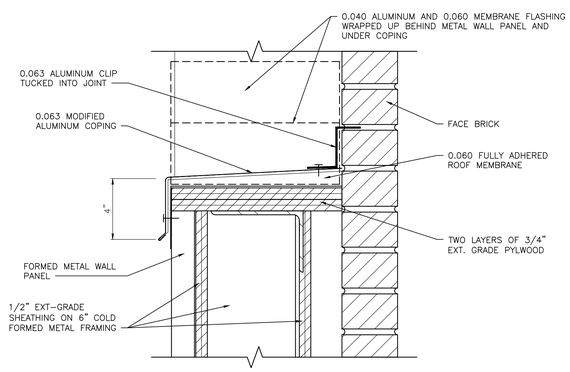


## COPING DETIAL

SCALE: 3" = 1'-0"

7 / A-210

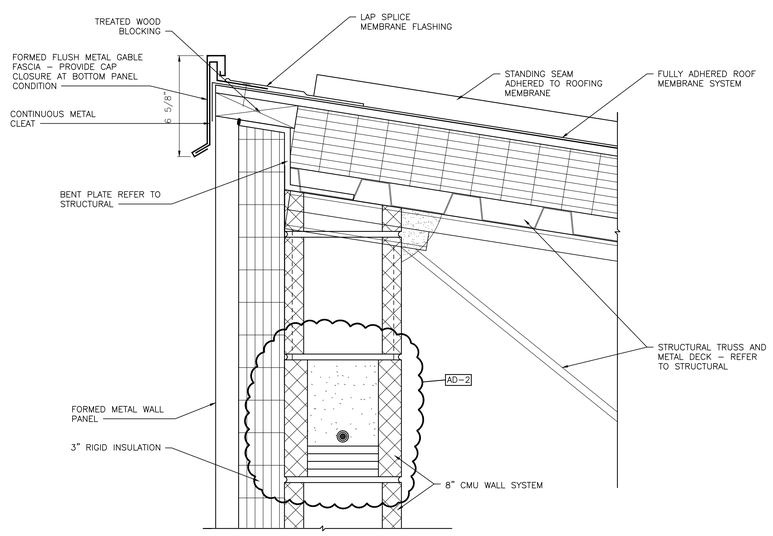


## ROOF EDGE DETAIL

SCALE: 3" = 1'-0"

4 / A-210

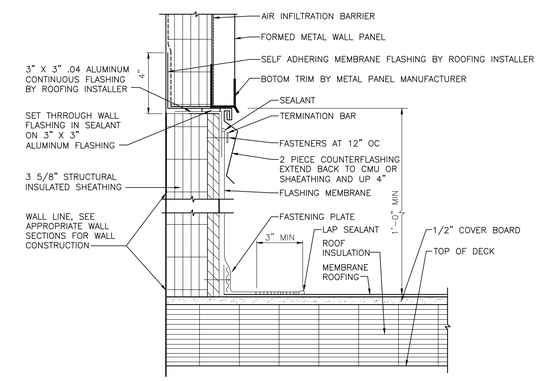


## WALL/ROOF COUNTER FLASHING DETAIL

SCALE: 3" = 1'-0"

1 / A-210

GIBRALTAR
DESIGN
ARCHITECTURE • ENGINEERING • INTERIOR DESIGN

PROJECT
# VALPARAISO HIGH SCHOOL WEST CAMPUS IMPROVEMENTS

VALPARAISO COMMUNITY SCHOOLS
VALPARAISO, INDIANA


GIBRALTAR DESIGN
9102 N. Meridian St., Ste. 300
Indianapolis, IN 46260
Homepage www.GibraltarDesign.com
Email info@GibraltarDesign.com
Phone 317.580.5777 Fax 317.580.5778


PROJECT 20-130
DATE 07/24/20
COORDINATED BY JPB
DRAWN BY DTB
CHECKED BY JPB GWT

JOSEPH P. BRIGGS
REGISTERED
NO. 11600109
STATE OF INDIANA
ARCHITECT


COPYRIGHT NOTICE:
THE CONCEPTS, DESIGNS, PLANS, DETAILS, ETC, SHOWN ON THIS DOCUMENT ARE THE PROPERTY OF GIBRALTAR DESIGN AND WERE CREATED FOR USE ON THIS SPECIFIC PROJECT. NONE OF THIS INFORMATION SHALL BE USED BY ANY PERSON OR FIRM FOR ANY PURPOSE WITHOUT THE EXPRESS WRITTEN CONSENT OF GIBRALTAR DESIGN. THE OWNER MAY RETAIN COPIES FOR INFORMATION AND REFERENCE IN CONNECTION ONLY WITH THIS PROJECT.


REVISIONS

| MARK | DATE | ISSUED FOR |
|---|---|---|
| AD-2 | 08/07/20 | ADDENDUM NO. 2 |

DRAWING
ROOF DETAILS

PROJECT
VALPARAISO HIGH SCHOOL WEST CAMPUS IMPROVEMENTS

©GIBRALTAR DESIGN

SHEET
A-210

Friday, 8/7/2020 – 4:19 PM – LAST SAVED BY:DBURNS
Y:\20-130 VALPARAISO CS – VHS WEST CAMPUS IMPROVEMENTS\20-130 DRAWINGS\05 ARCH\A-210.DWG

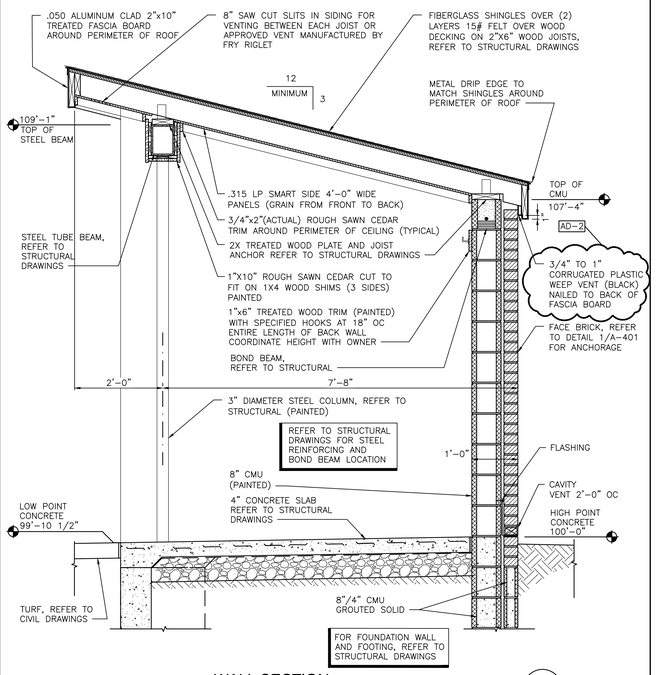


## WALL SECTION
SCALE: 3/4" = 1'-0"
7 / A-401

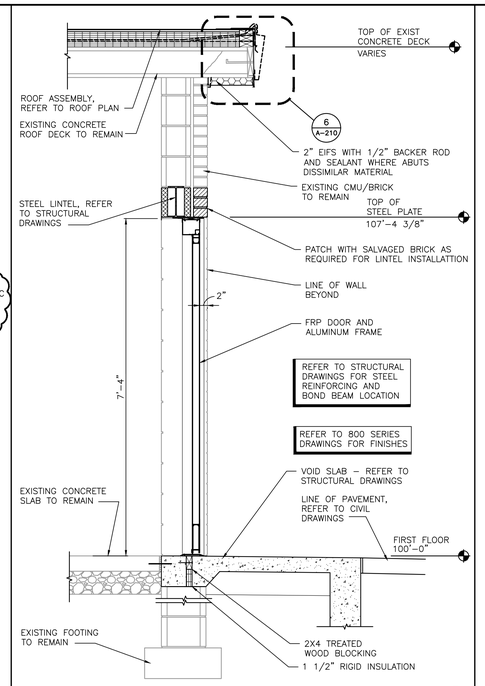


## WALL SECTION
SCALE: 3/4" = 1'-0"
6 / A-401

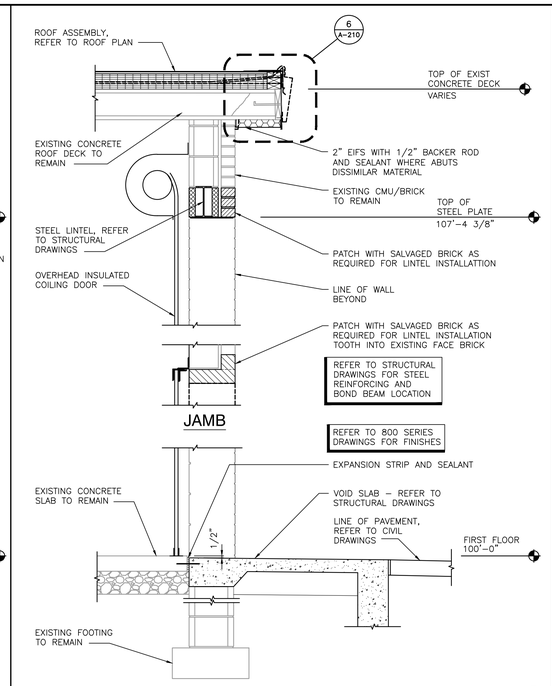


## WALL SECTION
SCALE: 3/4" = 1'-0"
5 / A-401

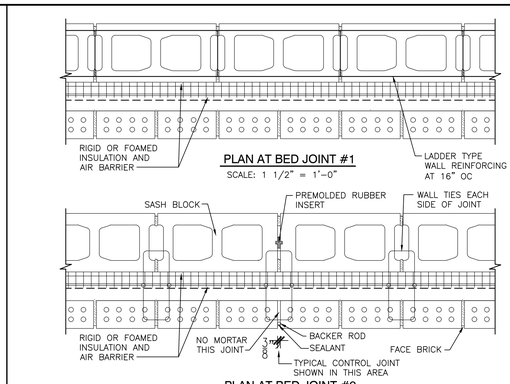


## PLAN AT BED JOINT #1
SCALE: 1 1/2" = 1'-0"

## PLAN AT BED JOINT #2
SCALE: 1 1/2" = 1'-0"

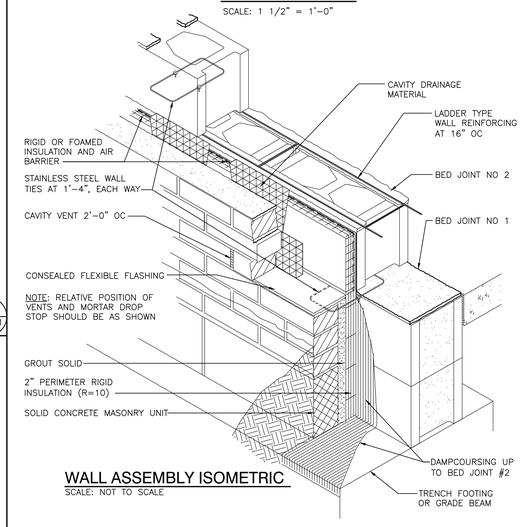


## WALL ASSEMBLY ISOMETRIC
SCALE: NOT TO SCALE

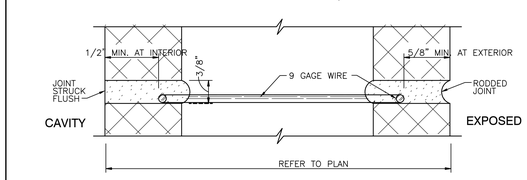


## DETAIL AT BED JOINT #1
SCALE: FULL SIZE

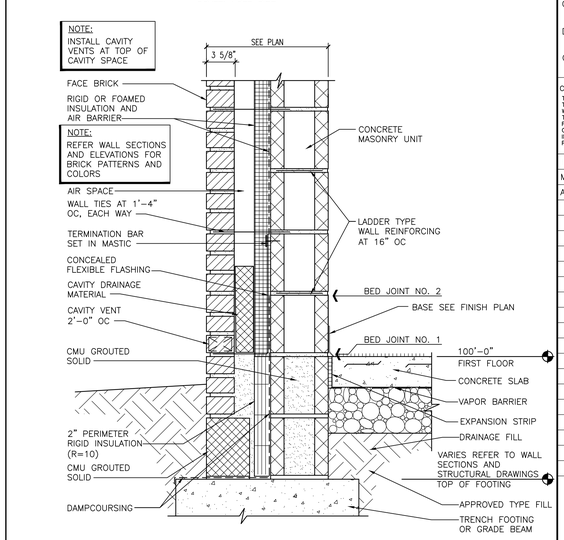


## TYPICAL EXTERIOR MASONRY WALL CONSTRUCTION DETAIL
SCALE: AS INDICATED
1 / A-401

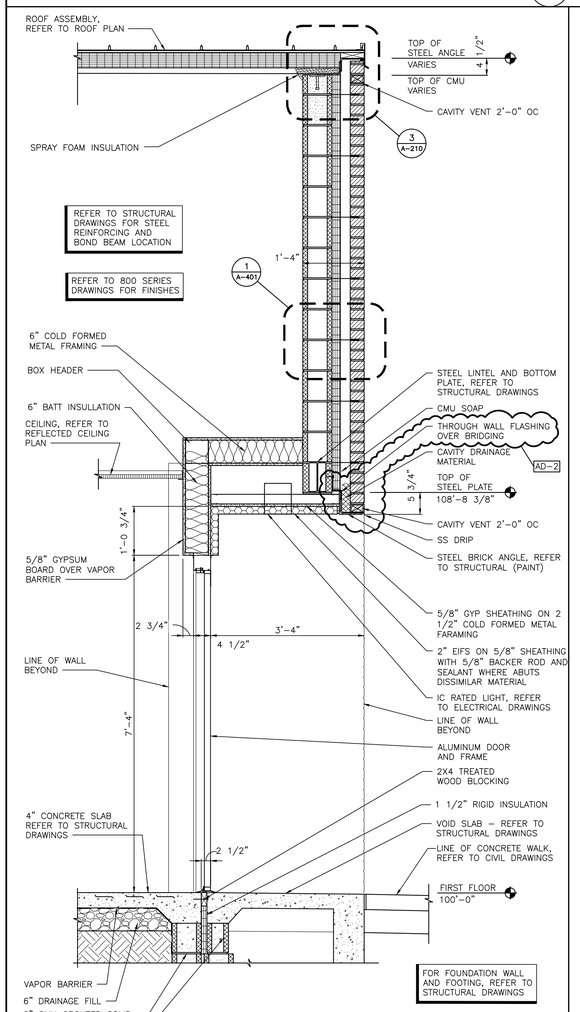


## WALL SECTION
SCALE: 3/4" = 1'-0"
4 / A-401

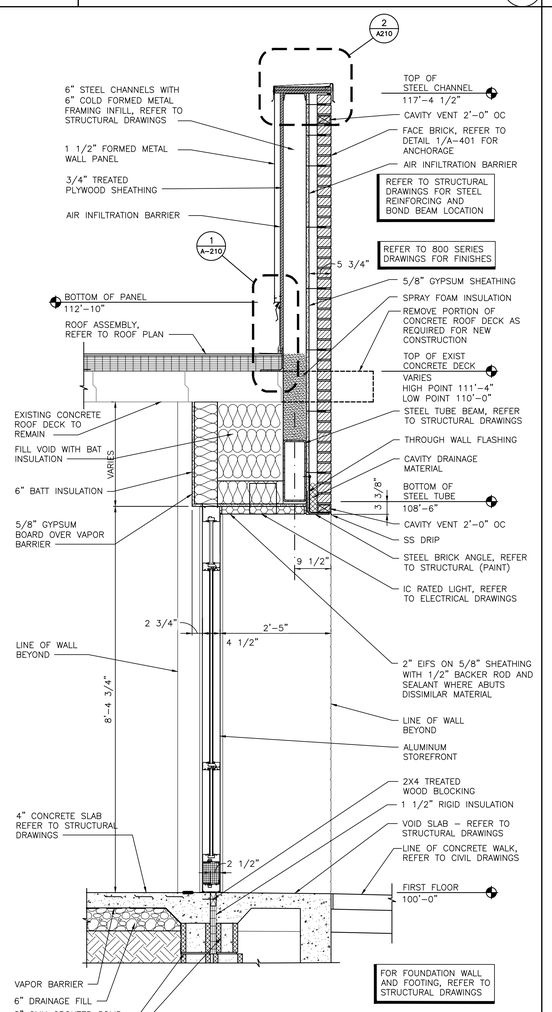


## WALL SECTION
SCALE: 3/4" = 1'-0"
3 / A-401

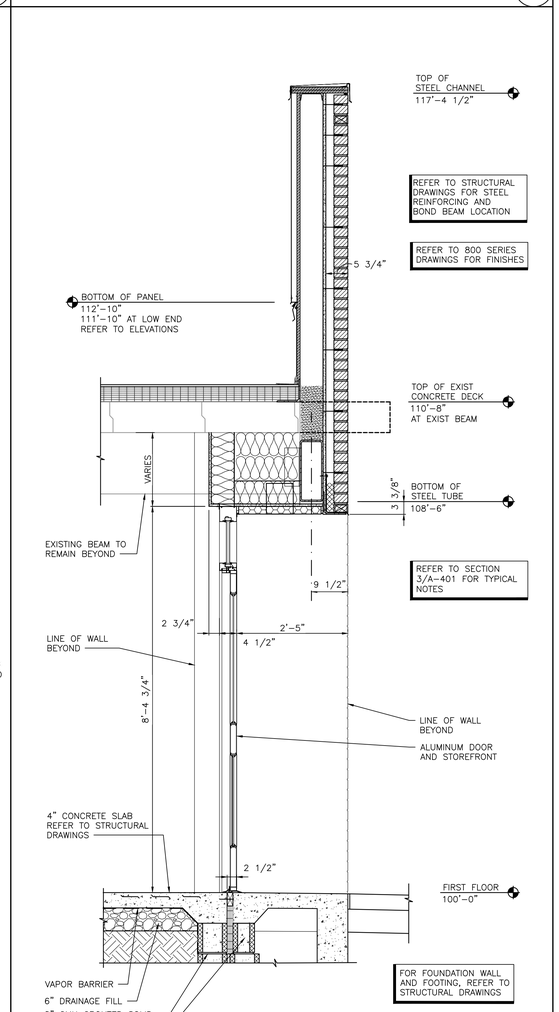


## WALL SECTION
SCALE: 3/4" = 1'-0"
2 / A-401

GIBRALTAR
DESIGN
ARCHITECTURE • ENGINEERING • INTERIOR DESIGN

PROJECT
# VALPARAISO HIGH SCHOOL WEST CAMPUS IMPROVEMENTS
VALPARAISO COMMUNITY SCHOOLS
VALPARAISO, INDIANA


GIBRALTAR DESIGN
9102 N. Meridian St., Ste. 300
Indianapolis, IN 46260
Homepage www.GibraltarDesign.com
Email info@GibraltarDesign.com
Phone 317.580.5777 Fax 317.580.5778


PROJECT 20-130
DATE 07/24/20
COORDINATED BY JPB
DRAWN BY DTB GWT
CHECKED BY JPB GWT

JOSEPH P. BRIGGS REGISTERED NO. 11600109 STATE OF INDIANA ARCHITECT


COPYRIGHT NOTICE:
THE CONCEPTS, DESIGNS, PLANS, DETAILS, ETC. SHOWN ON THIS DOCUMENT ARE THE PROPERTY OF GIBRALTAR DESIGN AND WERE CREATED FOR USE ON THIS SPECIFIC PROJECT. NONE OF THIS INFORMATION SHALL BE USED BY ANY PERSON OR FIRM FOR ANY PURPOSE WITHOUT THE EXPRESS WRITTEN CONSENT OF GIBRALTAR DESIGN. THE OWNER MAY RETAIN COPIES FOR INFORMATION AND REFERENCE IN CONNECTION ONLY WITH THIS PROJECT.


REVISIONS

| MARK | DATE | ISSUED FOR |
|---|---|---|
| AD-2 | 08/07/20 | ADDENDUM NO. 2 |

DRAWING
WALL SECTIONS

PROJECT
VALPARAISO HIGH SCHOOL WEST CAMPUS IMPROVEMENTS

© GIBRALTAR DESIGN

SHEET
A-401


Friday, 8/7/2020 – 10:14 AM – LAST SAVED BY:DBURNS
Y:\20-130 VALPARAISO CS – VHS WEST CAMPUS IMPROVEMENTS\20-130 DRAWINGS\05 ARCH\A-401.DWG

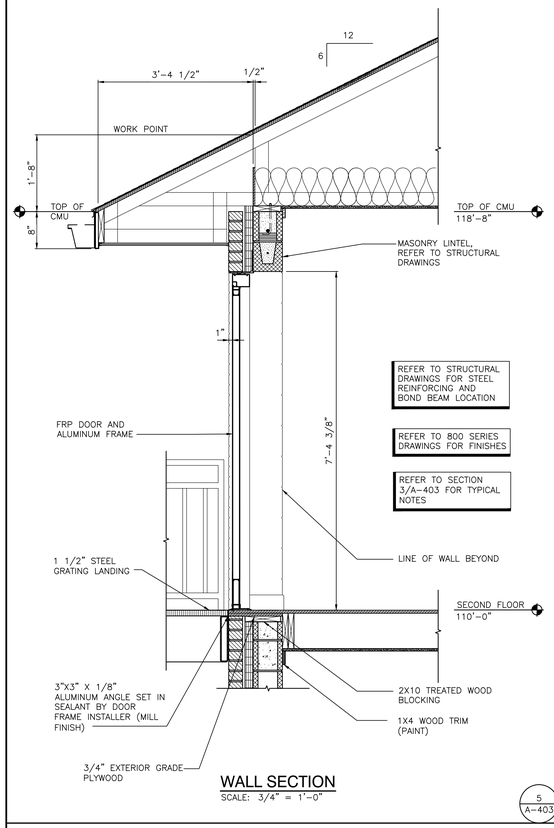


## WALL SECTION

SCALE: 3/4" = 1'-0"

5 / A-403

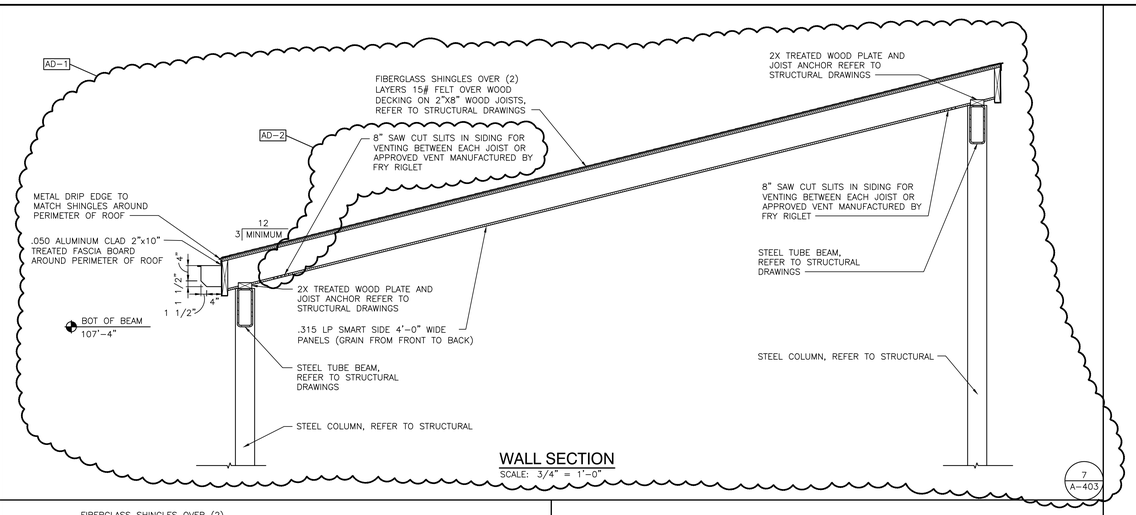


## WALL SECTION

SCALE: 3/4" = 1'-0"

7 / A-403

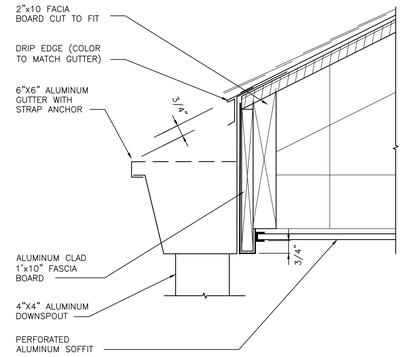


## GUTTER DETAIL

SCALE: 3" = 1'-0"

6 / A-403

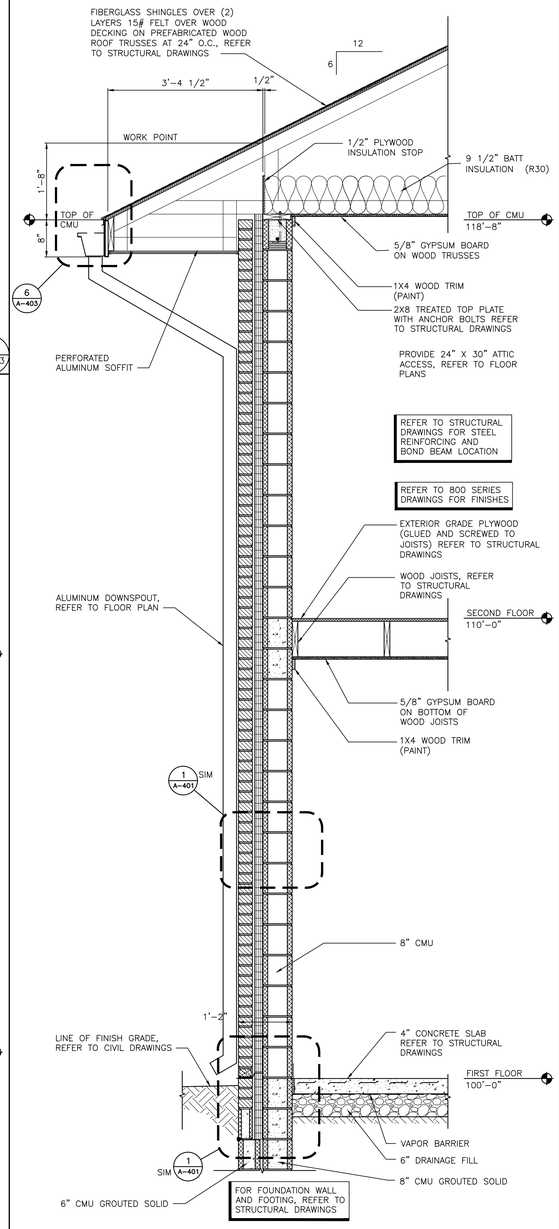


## WALL SECTION

SCALE: 3/4" = 1'-0"

3 / A-403

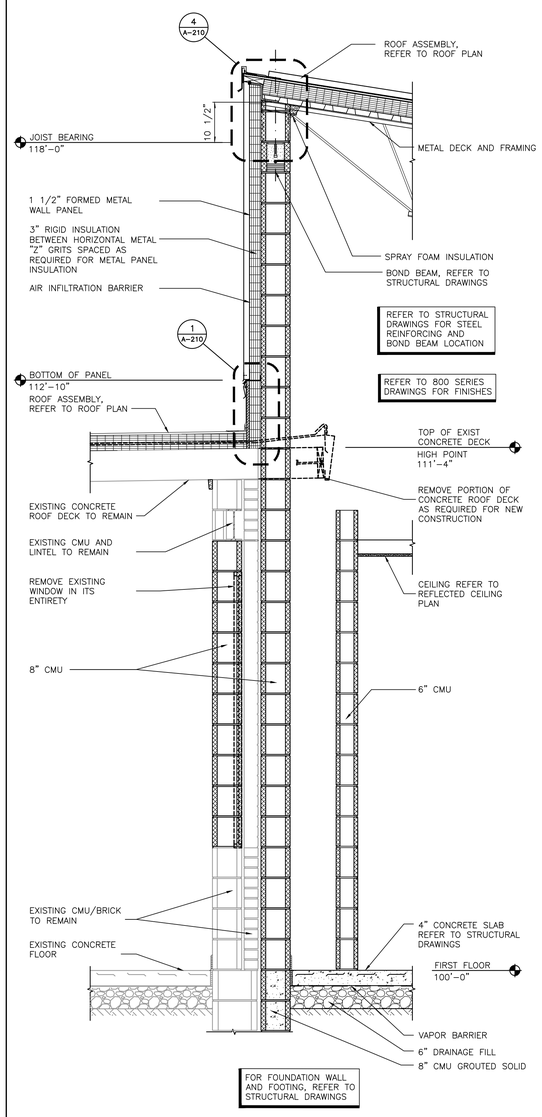


## WALL SECTION

SCALE: 3/4" = 1'-0"

2 / A-403

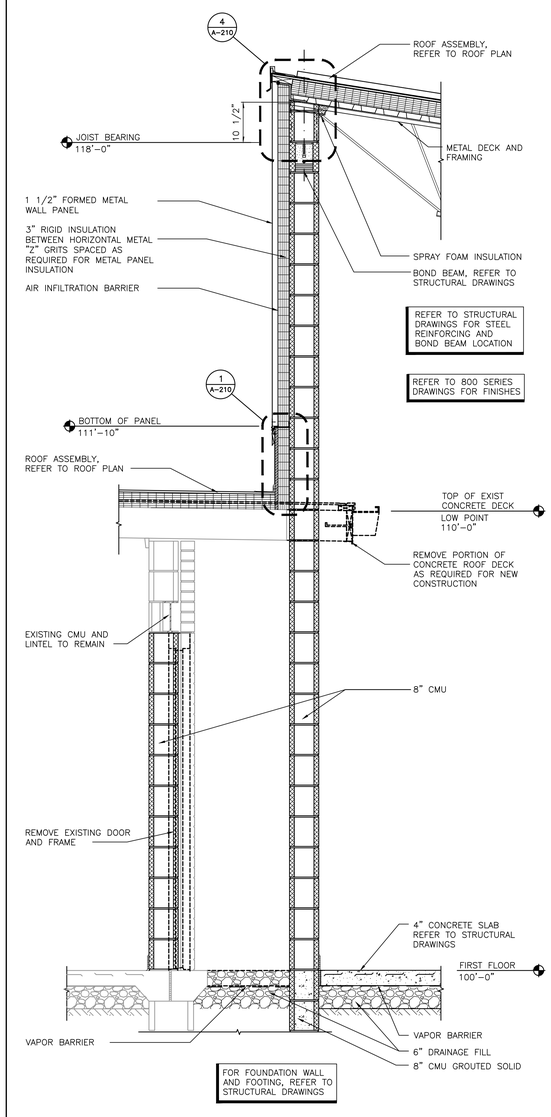


## WALL SECTION

SCALE: 3/4" = 1'-0"

1 / A-403

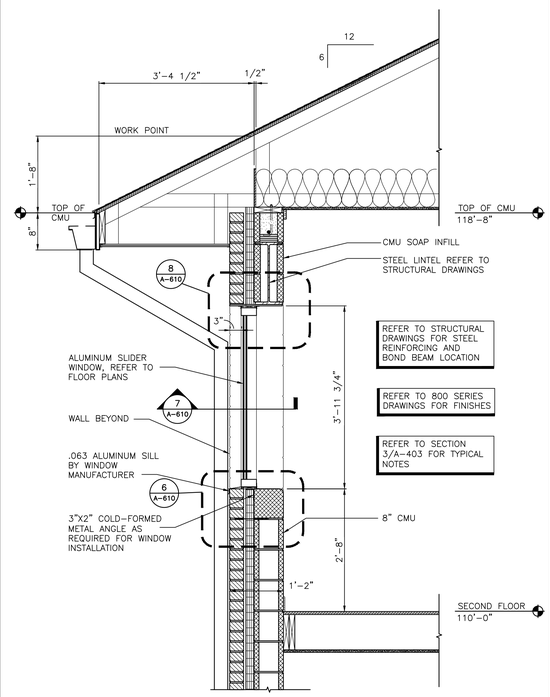


## WALL SECTION

SCALE: 3/4" = 1'-0"

4 / A-403

GIBRALTAR
DESIGN
ARCHITECTURE • ENGINEERING • INTERIOR DESIGN

PROJECT
# VALPARAISO HIGH SCHOOL WEST CAMPUS IMPROVEMENTS

VALPARAISO COMMUNITY SCHOOLS
VALPARAISO, INDIANA


GIBRALTAR DESIGN
9102 N. Meridian St., Ste. 300
Indianapolis, IN 46260
Homepage www.GibraltarDesign.com
Email info@GibraltarDesign.com
Phone 317.580.5777 Fax 317.580.5778


PROJECT 20-130
DATE 07/24/20
COORDINATED BY JPB
DRAWN BY DTB GWT
CHECKED BY JPB GWT

JOSEPH P. BRIGGS REGISTERED NO. 11600109 STATE OF INDIANA ARCHITECT


COPYRIGHT NOTICE:
THE CONCEPTS, DESIGNS, PLANS, DETAILS, ETC. SHOWN ON THIS DOCUMENT ARE THE PROPERTY OF GIBRALTAR DESIGN AND WERE CREATED FOR USE ON THIS SPECIFIC PROJECT. NONE OF THIS INFORMATION SHALL BE USED BY ANY PERSON OR FIRM FOR ANY PURPOSE WITHOUT THE EXPRESS WRITTEN CONSENT OF GIBRALTAR DESIGN. THE OWNER MAY RETAIN COPIES FOR INFORMATION AND REFERENCE IN CONNECTION ONLY WITH THIS PROJECT.


REVISIONS

| MARK | DATE | ISSUED FOR |
|---|---|---|
| AD-1 | 08/03/20 | ADDENDUM NO. 1 |
| AD-2 | 08/07/20 | ADDENDUM NO. 2 |

DRAWING
## EXTERIOR ELEVATIONS

PROJECT
VALPARAISO HIGH SCHOOL WEST CAMPUS IMPROVEMENTS

© GIBRALTAR DESIGN

SHEET
# A-403


Friday, 8/7/2020 - 10:15 AM - LAST SAVED BY:DBURNS
Y:\20-130 VALPARISO CS - VHS WEST CAMPUS IMPROVEMENTS\20-130 DRAWINGS\05 ARCH\A-403.DWG

| | | | | | | | | | | | | | | | | | | |
|---|---|---|---|---|---|---|---|---|---|---|---|---|---|---|---|---|---|---|
| A-130D | STOREFRONT FRAME | | | | | | C | | AL | 4 1/2" | SEE ELEV | SEE ELEV | SEE ELEV | SF9 | | | | |
| A-130E | STOREFRONT FRAME | | | | | | C | | AL | 4 1/2" | SEE ELEV | SEE ELEV | SEE ELEV | SF9 | | | | |
| A-130F | STOREFRONT FRAME | | | | | | C | | AL | 4 1/2" | SEE ELEV | SEE ELEV | SEE ELEV | SF9 | | | | |
| A-132A | SINGLE | 1 | 42 x 84 | FRP | | | | | AL | 4 1/2" | SEE ELEV | SEE ELEV | | SF1 | | Y | Y | 1,2,4 |
| B-101A | DOUBLE | 1 | PR 36 x 84 | FRP | | | | | AL | 4 1/2" | SEE ELEV | SEE ELEV | | SF7 | | | | |
| B-201A | SINGLE | 1 | 36 x 84 | FRP | | | | | AL | 4 1/2" | SEE ELEV | SEE ELEV | | SF1 | | | | |
| C-101A | DOUBLE | 1 | PR 36 x 84 | FRP | | | | | AL | 4 1/2" | SEE ELEV | SEE ELEV | | SF7 | | | | |
| C-201A | SINGLE | 1 | 36 x 84 | FRP | | | | | AL | 4 1/2" | SEE ELEV | SEE ELEV | | SF1 | | | | |

## GENERAL DOOR NOTES

AD-2

A. JAMB, HEAD, AND SILL DO NOT SHOW WALL CONSTRUCTION. SEE FLOOR PLAN FOR WALL MATERIALS. REFER TO A800 SERIES DRAWINGS FOR WALL FINISHES.
B. SEAL ALL JAMBS AND HEADS WHERE FRAMES MEET EXPOSED MASONRY AND/OR GYPSUM BOARD.
C. PROVIDE A SCRIBE MOLD AT ALL EXTERIOR DOOR FRAMES AND WHERE NOTED ON DRAWINGS. SCRIBE MOLD TO BE 3/4" X 3/4" METAL AT EXTERIOR OF METAL FRAMES AND AT BOTH SIDES OF ALUMINUM FRAMES. SET SCRIBE MOLDS IN SEALANT.
D. PROVIDE GLAZING AND GLASS STOPS AS REQUIRED.
E. FIELD VERIFY ALL DIMENSIONS AND CONDITIONS, BOTH NEW AND EXISTING.
F. SHIM SPACE IS NOT SHOWN ON DOOR FRAME ELEVATIONS FOR ALUMINUM STOREFRONT. TAKE THESE DIMENSIONS INTO ACCOUNT AND ADJUST DIMENSIONS ACCORDINGLY.
G. FOR DOOR POSITION WITHIN WALL REFER TO FRAME MOUNTING DETAIL 2-A601.
H. FOR ELECTRICAL ROUGH-IN AT DOORS REFER TO DETAIL 1-A601.
I. FOR HOLLOW METAL FRAME ELEVATIONS (HM) REFER TO 3-A601. FOR HOLLOW METAL (HM) FRAME PROFILES REFER TO 4-A601.
J. FOR ALUMINUM STOREFRONT ELEVATIONS (SF) REFER TO 1-A610. FOR STOREFRONT (SF) FRAME PROFILES REFER TO 2-A610.
K. GLASS NOTED IN SIDELIGHT COLUMN FOR STOREFRONT WITH NO DOOR APPLIES TO ALL OPENINGS IN FRAME UNLESS NOTED OTHERWISE.
L. REFER TO FLOOR PLANS FOR LOCATIONS OF NEW AND EXISTING ADA PUSH PADS FOR POWER ASSISTED OPERATORS.

## DOOR SCHEDULE NOTES (REMARKS):

1. PANIC DEVICE TO HAVE ELECTRIC LATCH BOLT. PREPARE FRAME FOR ELECTRIFIED HINGE.
2. DOOR TO BE CONTROLLED BY CARD READER/FOB. REFER TO ELECTRICAL DRAWINGS FOR ROUGH IN.
3. PROVIDE POWER ASSISTED OPERATOR ON ONE LEAF OF DOUBLE DOORS.
4. PROVIDE ALUMINUM THRESHOLD SET IN FULL BED OF MASTIC.
5. KEYED REMOVABLE MULLION.
6. WALL MOUNTED ELECTROMAGNETIC DOOR HOLDER(S) BY DIVISION 26, DOOR MOUNTED ARMATURE SHALL BE INSTALLED BY HARDWARE INSTALLER.

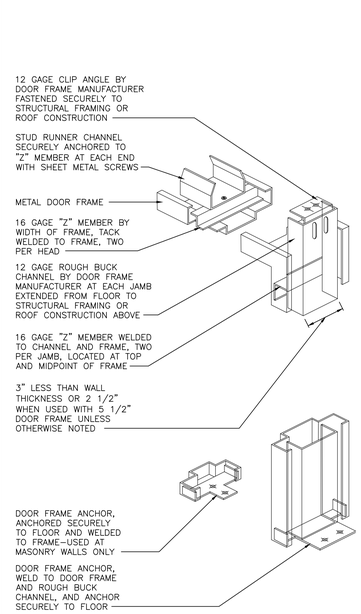


TYPICAL HEAD & JAMB ANCHORAGE
SCALE: NTS
5 / A-601

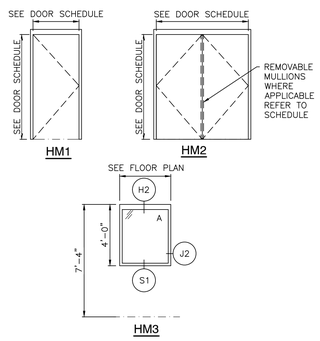


## NOTES - HOLLOW METAL (HM)

1. FOR HOLLOW METAL HEAD, JAMB AND SILL DETAILS REFER TO WALL SECTIONS AND HOLLOW METAL (HM) FRAME PROFILES 3/A-601.
2. PROVIDE SEALANT AROUND PERIMETER OF ALL FRAMES.
3. DIMENSIONS SHOWN ARE NOMINAL. FIELD VERIFY ALL DIMENSIONS SHOWN PRIOR TO FABRICATION AND INSTALLATION.
4. JAMB, HEAD, AND SILL DO NOT SHOW WALL CONSTRUCTION. SEE FLOOR PLAN FOR WALL MATERIALS. SEE ROOM FINISH SCHEDULE FOR WALL FINISHES.
5. PROVIDE GLAZING AND GLASS STOPS AS REQUIRED.

HOLLOW METAL FRAME ELEVATIONS (HM)
SCALE: 1/4" = 1'-0"
4 / A-601

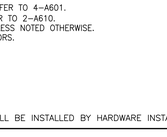


FRAME MOUNTING DETAIL
SCALE: NTS
2 / A-601

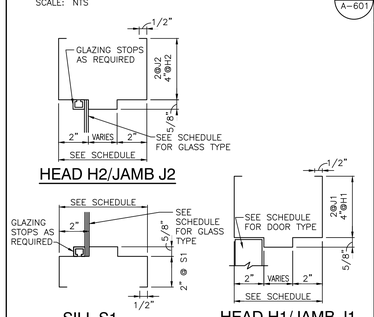


HOLLOW METAL (HM) FRAME PROFILES
SCALE: 3" = 1'-0"
4 / A-601

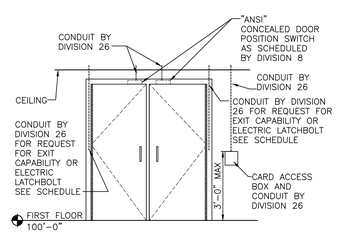


ELECRTICAL ROUGH-IN AT DOOR FRAMES
SCALE: NTS
1 / A-601

| GLASS SCHEDULE | |
|---|---|
| MK | GLASS TYPES |
| A | 1/4" CLEAR TEMPERED |
| B | 1" INSUL. GLASS |
| C | 1" INSUL. FROSTED GLASS |

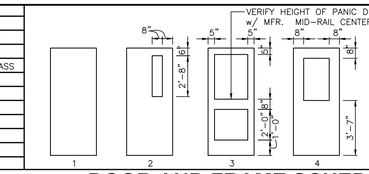


| LOUVER SCHEDULE | |
|---|---|
| MK | LOUVER SIZE |

# DOOR AND FRAME SCHEDULE

| DOOR | | | | | GLASS | | | FRAME | | | | | | LABEL | HARDWARE | | NOTES |
|---|---|---|---|---|---|---|---|---|---|---|---|---|---|---|---|---|---|
| NO | DESCRIPTION | TYPE | DOOR SIZE (WxH) (INCHES) | MATERIAL | LOU | DOOR | SIDE LGT | TRA | MAT'L | WIDTH | JAMB | HEAD | SILL | ELEV | | EXIT DEVICE | CLOSER | |
| A-101A | DOUBLE | 4 | PR 42 x 84 | AL | | B | | | AL | 4 1/2" | SEE ELEV | SEE ELEV | | SF7 | | Y | Y | 1,2,3,4,5 |
| A-101B | SINGLE | 2 | 42 x 84 | WD | | A | | | HM | 8 3/4" | J1 | H1 | | HM1 | 90 | | Y | 1,6 |
| A-102A | SINGLE | 1 | 36 x 84 | WD | | | | | HM | 8 3/4" | J1 | H1 | | HM1 | | | | |
| A-103A | SINGLE | 2 | 42 x 84 | WD | | A | | | HM | 8 3/4" | J1 | H1 | | HM1 | | | | |
| A-103B | BORROWED LIGHT | | | | | | A | | HM | 8 3/4" | J2 | H2 | S1 | HM3 | | | | |
| A-103C | BORROWED LIGHT | | | | | | A | | HM | 8 3/4" | J2 | H2 | S1 | HM3 | | | | |
| A-103D | STOREFRONT FRAME | | | | | | B | | AL | 4 1/2" | SEE ELEV | SEE ELEV | SEE ELEV | SF9 | | | | |
| A-103E | STOREFRONT FRAME | | | | | | B | | AL | 4 1/2" | SEE ELEV | SEE ELEV | SEE ELEV | SF9 | | | | |
| A-104A | SINGLE | 1 | 36 x 84 | WD | | | | | HM | 8 3/4" | J1 | H1 | | HM1 | | | | |
| A-105A | SINGLE | 1 | 36 x 84 | WD | | | | | HM | 8 3/4" | J1 | H1 | | HM1 | | | | |
| A-106A | DOUBLE | 1 | PR 36 x 84 | WD | | | | | HM | 8 3/4" | J1 | H1 | | HM1 | | Y | Y | |
| A-106B | STOREFRONT FRAME | | | | | | C | | AL | 4 1/2" | SEE ELEV | SEE ELEV | SEE ELEV | SF9 | | | | |
| A-106C | STOREFRONT FRAME | | | | | | C | | AL | 4 1/2" | SEE ELEV | SEE ELEV | SEE ELEV | SF9 | | | | |
| A-106D | STOREFRONT FRAME | | | | | | C | | AL | 4 1/2" | SEE ELEV | SEE ELEV | SEE ELEV | SF9 | | | | |
| A-107A | SINGLE | 1 | 42 x 84 | FRP | | | | | AL | 4 1/2" | SEE ELEV | SEE ELEV | | SF1 | | Y | Y | 1,2,4 |
| A-107B | SINGLE | 1 | 42 x 84 | FRP | | | | | AL | 4 1/2" | SEE ELEV | SEE ELEV | | SF1 | | Y | Y | 6 |
| A-110A | SINGLE | 1 | 36 x 84 | FRP | | | | | AL | 4 1/2" | SEE ELEV | SEE ELEV | | SF1 | | Y | Y | 1,2,4 |
| A-110B | OVERHEAD DOOR | | 96 x 48 | | | | | | | 3" | | | | | | | | |
| A-111A | SINGLE | 1 | 36 x 84 | WD | | | | | HM | 8 3/4" | J1 | H1 | | HM1 | | | | |
| A-112A | SINGLE | 1 | 36 x 84 | FRP | | | | | AL | 4 1/2" | SEE ELEV | SEE ELEV | | SF1 | | Y | Y | 1,2,4 |
| A-112B | OVERHEAD DOOR | | 84 x 84 | | | | | | | 3" | | | | | | | | |
| A-116A | SINGLE | 1 | 36 x 84 | WD | | | | | HM | 8 3/4" | J1 | H1 | | HM1 | | | | |
| A-117A | SINGLE | 1 | 42 x 84 | WD | | | | | HM | 8 3/4" | J1 | H1 | | HM1 | | | | |
| A-118A | SINGLE | 3 | 36 x 84 | WD | | A | A | | AL | 4 1/2" | SEE ELEV | SEE ELEV | SEE ELEV | SF6 | | | Y | |
| A-119A | SINGLE | 1 | 36 x 84 | WD | | | | | HM | 8 3/4" | J1 | H1 | | HM1 | | | | |
| A-120A | DOUBLE | 3 | PR 36 x 84 | WD | | A | A | | AL | 4 1/2" | SEE ELEV | SEE ELEV | SEE ELEV | SF2 | | | Y | |
| A-120B | SINGLE | 1 | 42 x 84 | WD | | | | | HM | 8 3/4" | J1 | H1 | | HM1 | | | | |
| A-121A | SINGLE | 1 | 36 x 84 | WD | | | | | HM | 8 3/4" | J1 | H1 | | HM1 | | | | |
| A-122A | SINGLE | 1 | 36 x 84 | WD | | | | | HM | 8 3/4" | J1 | H1 | | HM1 | | | | |
| A-123A | SINGLE | 3 | 36 x 84 | WD | | A | A | | AL | 4 1/2" | SEE ELEV | SEE ELEV | SEE ELEV | SF5 | | | Y | |
| A-124A | DOUBLE | 3 | PR 36 x 84 | AL | | B | B | B | AL | 4 1/2" | SEE ELEV | SEE ELEV | SEE ELEV | SF4 | | Y | Y | 1,2,3,4,5 |
| A-124B | STOREFRONT FRAME | | | | | | B | B | AL | 4 1/2" | SEE ELEV | SEE ELEV | SEE ELEV | SF3 | | | | |
| A-124C | STOREFRONT FRAME | | | | | | B | B | AL | 4 1/2" | SEE ELEV | SEE ELEV | SEE ELEV | SF3 | | | | |
| A-125A | DOUBLE | 4 | PR 42 x 84 | AL | | B | | | AL | 4 1/2" | SEE ELEV | SEE ELEV | | SF7 | | Y | Y | 1,2,3,4,5 |
| A-125B | SINGLE | 2 | 42 x 84 | WD | | A | | | HM | 8 3/4" | J1 | H1 | | HM1 | | | Y | 1,6 |
| A-126A | SINGLE | 1 | 36 x 84 | WD | | | | | HM | 8 3/4" | J1 | H1 | | HM1 | | | | |
| A-127A | SINGLE | 2 | 42 x 84 | WD | | A | | | HM | 8 3/4" | J1 | H1 | | HM1 | | | | |
| A-127B | BORROWED LIGHT | | | | | | A | | HM | 8 3/4" | J2 | H2 | S1 | HM3 | | | | |
| A-127C | BORROWED LIGHT | | | | | | A | | HM | 8 3/4" | J2 | H2 | S1 | HM3 | | | | |
| A-127D | STOREFRONT FRAME | | | | | | B | | AL | 4 1/2" | SEE ELEV | SEE ELEV | SEE ELEV | SF9 | | | | |
| A-127E | STOREFRONT FRAME | | | | | | B | | AL | 4 1/2" | SEE ELEV | SEE ELEV | SEE ELEV | SF9 | | | | |
| A-128A | SINGLE | 1 | 36 x 84 | WD | | | | | HM | 8 3/4" | J1 | H1 | | HM1 | | | | |
| A-129A | SINGLE | 1 | 36 x 84 | WD | | | | | HM | 8 3/4" | J1 | H1 | | HM1 | | | | |
| A-130A | DOUBLE | 1 | PR 36 x 84 | WD | | | | | HM | 8 3/4" | J1 | H1 | | HM1 | | Y | Y | |
| A-130B | STOREFRONT FRAME | | | | | | C | | AL | 4 1/2" | SEE ELEV | SEE ELEV | SEE ELEV | SF9 | | | | |
| A-130C | STOREFRONT FRAME | | | | | | C | | AL | 4 1/2" | SEE ELEV | SEE ELEV | SEE ELEV | SF9 | | | | |

GIBRALTAR
DESIGN
ARCHITECTURE • ENGINEERING • INTERIOR DESIGN

PROJECT
VALPARAISO HIGH SCHOOL WEST CAMPUS IMPROVEMENTS
VALPARAISO COMMUNITY SCHOOLS
VALPARAISO, INDIANA


GIBRALTAR DESIGN
9102 N. Meridian St., Ste. 300
Indianapolis, IN 46260
Homepage www.GibraltarDesign.com
Email info@GibraltarDesign.com
Phone 317.580.5777 Fax 317.580.5778


PROJECT 20-130
DATE 07/24/20
COORDINATED BY JPB
DRAWN BY DTB
CHECKED BY JPB GWT

JOSEPH P. BRIGGS REGISTERED NO. 11600109 STATE OF INDIANA ARCHITECT


COPYRIGHT NOTICE:
THE CONCEPTS, DESIGNS, PLANS, DETAILS, ETC. SHOWN ON THIS DOCUMENT ARE THE PROPERTY OF GIBRALTAR DESIGN AND WERE CREATED FOR USE ON THIS SPECIFIC PROJECT. NONE OF THIS INFORMATION SHALL BE USED BY ANY PERSON OR FIRM FOR ANY PURPOSE WITHOUT THE EXPRESS WRITTEN CONSENT OF GIBRALTAR DESIGN. THE OWNER MAY RETAIN COPIES FOR INFORMATION AND REFERENCE IN CONNECTION ONLY WITH THIS PROJECT.


REVISIONS

| MARK | DATE | ISSUED FOR |
|---|---|---|
| AD-2 | 08/07/20 | ADDENDUM NO. 2 |

DRAWING
DOOR SCHEDULE, FRAME PROFILES, ELEVATIONS, AND DETAILS

PROJECT
VALPARAISO HIGH SCHOOL WEST CAMPUS IMPROVEMENTS


© GIBRALTAR DESIGN


SHEET
A-601


Friday, 8/7/2020 - 9:45 AM - LAST SAVED BY:DBURNS
Y:\20-130 VALPARAISO CS - VHS WEST CAMPUS IMPROVEMENTS\20-130 DRAWINGS\05 ARCH\A-601.DWG

## GENERAL EQUIPMENT NOTES:

A. REFER TO SPECIFICATIONS AND FINISH LEGEND FOR ADDITIONAL INFORMATION.

B. FIELD VERIFY ALL DIMENSIONS.

C. CASEWORK AND/OR MILLWORK INSTALLER TO COORDINATE ELECTRICAL AND PLUMBING WORK. REFER TO ELECTRICAL DRAWINGS AND SCHEDULES FOR ELECTRICAL DEVICE TYPES, HEIGHTS, AND LOCATIONS.

D. REFER TO G-301 FOR MOUNTING HEIGHTS.

E. REFER TO ENLARGED TOILET ROOM PLANS, SHEET A-710, FOR TOILET ROOM EQUIPMENT

## PLAN LEGEND:

INDICATES MISCELLANEOUS CASEWORK ELEVATION SYMBOL – REFER TO A-800 SERIES DRAWINGS FOR ELEVATIONS AND DETAILS.

------- INDICATES ITEMS TO BE PART OF LOOSE EQUIPMENT PACKAGE BY OWNER. (NOT INCLUDED IN CONSTRUCTION CONTRACT)

---- INDICATES BULKHEADS OR OTHER OVERHEAD ITEMS (INCLUDED IN CONSTRUCTION CONTRACTS).

(TB) INDICATES 4" HIGH TACK BOARD LENGTH AS INDICATED, REFER TO MOUNTING HEIGHT DRAWING.

(MB) INDICATES 4' HIGH MARKER BOARD LENGTH AS INDICATED, REFER TO MOUNTING HEIGHT DRAWING.

(PMB) INDICATES 4' HIGH PROJECTABLE MARKER BOARD, LENGTH AS INDICATED

(MH) INDICATES MOP HOLDER ABOVE SERVICE SINK.

## EQUIPMENT PLAN NOTES:

(ALL PLAN NOTES MAY NOT BE INDICATED ON THIS PLAN.)

1. COACHES DESK AND CHAIR, BY OWNER
2. PROJECTOR, BY OWNER
3. TABLES AND CHAIRS, BY OWNER
4. FILE CABINETS, BY OWNER
5. DRINK COOLER, BY OWNER
6. POPCORN MAKER, BY OWNER
7. PRETZEL WARMER, BY OWNER
8. HOT DOG WARMER, BY OWNER
9. MICROWAVE, BY OWNER
10. COFFEE MAKER, BY OWNER — AD-2
11. ICE MAKER, BY OWNER
12. TRAINING TABLES AND EQUIPMENT, BY OWNER
13. SPEAKERS, REFER TO TECHNOLOGY DRAWINGS
14. NOT USED
15. CHAIR, BY OWNER
16. ACCESSIBLE WATER COOLER WITH BOTTLE FILLER, REFER TO PLUMBING DRAWINGS
17. NOT USED. — AD-2
18. OZONE MACHINE, BY OWNER

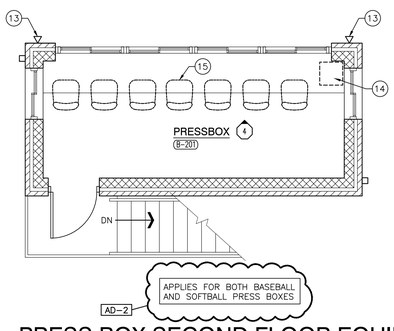


## PRESS BOX SECOND FLOOR EQUIPMENT PLAN

SCALE: 1/4" = 1'-0"

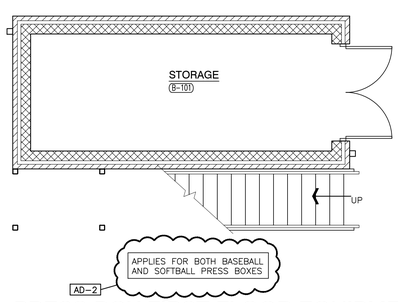


## PRESS BOX FIRST FLOOR EQUIPMENT PLAN

SCALE: 1/4" = 1'-0"

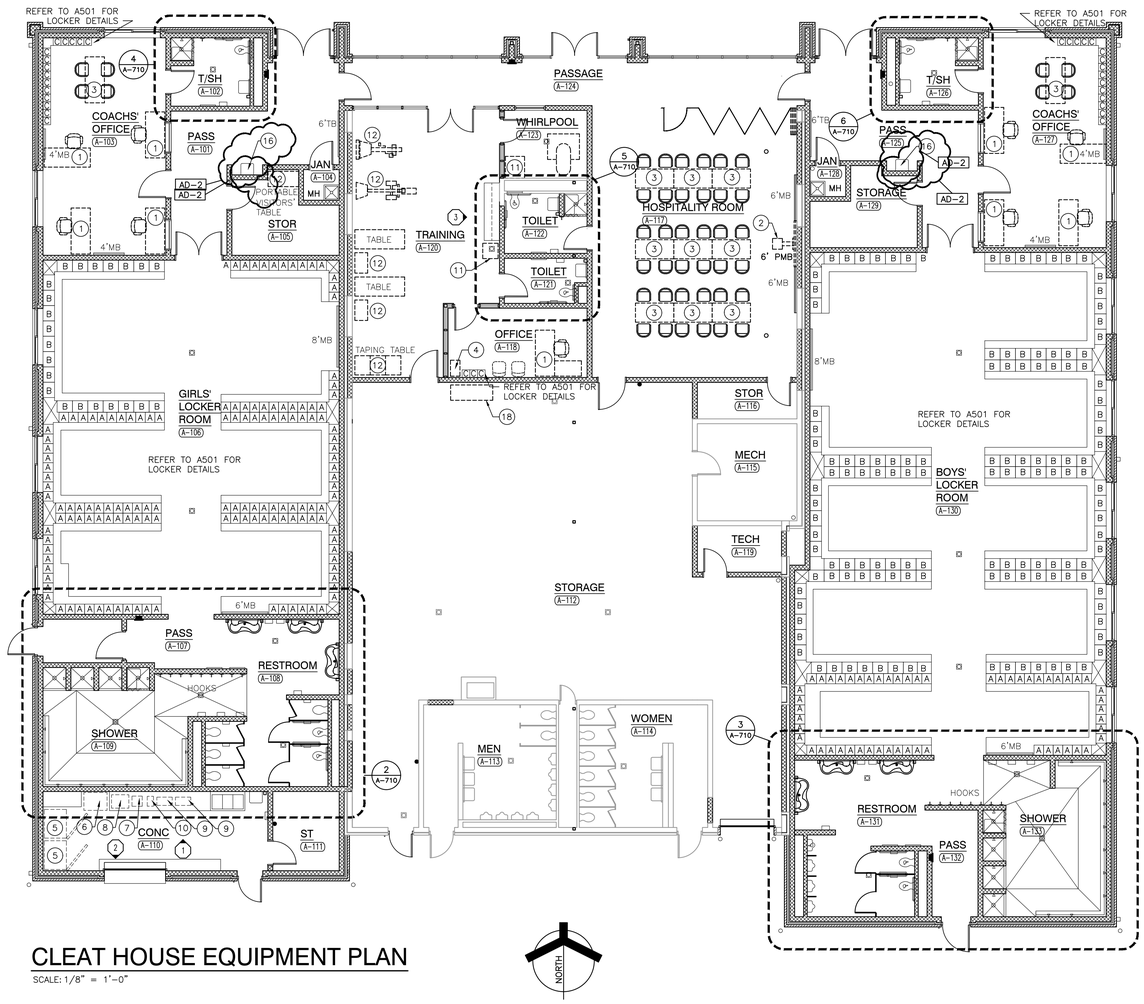


## CLEAT HOUSE EQUIPMENT PLAN

SCALE: 1/8" = 1'-0"

GIBRALTAR DESIGN

ARCHITECTURE • ENGINEERING • INTERIOR DESIGN

PROJECT

# VALPARAISO HIGH SCHOOL WEST CAMPUS IMPROVEMENTS

VALPARAISO COMMUNITY SCHOOLS
VALPARAISO, INDIANA


GIBRALTAR DESIGN
9102 N. Meridian St., Ste. 300
Indianapolis, IN 46260
Homepage www.GibraltarDesign.com
Email: info@GibraltarDesign.com
Phone 317.580.5777 Fax 317.580.5778


PROJECT 20-130
DATE 07/24/20
COORDINATED BY JPB
DRAWN BY ARM
CHECKED BY RJG

JOSEPH P. BRIGGS REGISTERED NO. 11600109 STATE OF INDIANA ARCHITECT


COPYRIGHT NOTICE: THE CONCEPTS, DESIGNS, PLANS, DETAILS, ETC. SHOWN ON THIS DOCUMENT ARE THE PROPERTY OF GIBRALTAR DESIGN AND WERE CREATED FOR USE ON THIS SPECIFIC PROJECT. NONE OF THIS INFORMATION SHALL BE USED BY ANY PERSON OR FIRM FOR ANY PURPOSE WITHOUT THE EXPRESS WRITTEN CONSENT OF GIBRALTAR DESIGN. THE OWNER MAY RETAIN COPIES FOR INFORMATION AND REFERENCE IN CONNECTION ONLY WITH THIS PROJECT.


REVISIONS

| MARK | DATE | ISSUED FOR |
|---|---|---|
| AD-1 | 08/03/20 | ADDENDUM NO. 1 |
| AD-2 | 08/07/20 | ADDENDUM NO. 2 |

DRAWING

CLEAT HOUSE AND PRESS BOX EQUIPMENT PLANS

PROJECT

VALPARAISO HIGH SCHOOL WEST CAMPUS IMPROVEMENTS


© GIBRALTAR DESIGN


SHEET

A-701


Friday, 8/7/2020 – 9:45 AM – LAST SAVED BY:DBURNS
Y:\20-130 VALPARAISO CS – VHS WEST CAMPUS IMPROVEMENTS\20-130 DRAWINGS\05 ARCH\A-701.DWG

## SHEET NOTES

1. 1½" SANITARY UP TO LAVATORY
2. 4" SANITARY UP TO WATER CLOSET
3. 2" SANITARY UP TO URINAL
4. 2" SANITARY UP TO SINK
5. 1½" SANITARY UP TO ELECTRIC WATER COOLER
6. 4" SANITARY UP TO FLOOR DRAIN/SINK
7. 2" VENT UP
8. 4" SANITARY UP TO MOP BASIN
9. 4" SANITARY UP TO TRENCH DRAIN
10. 4" MAIN VENT UP

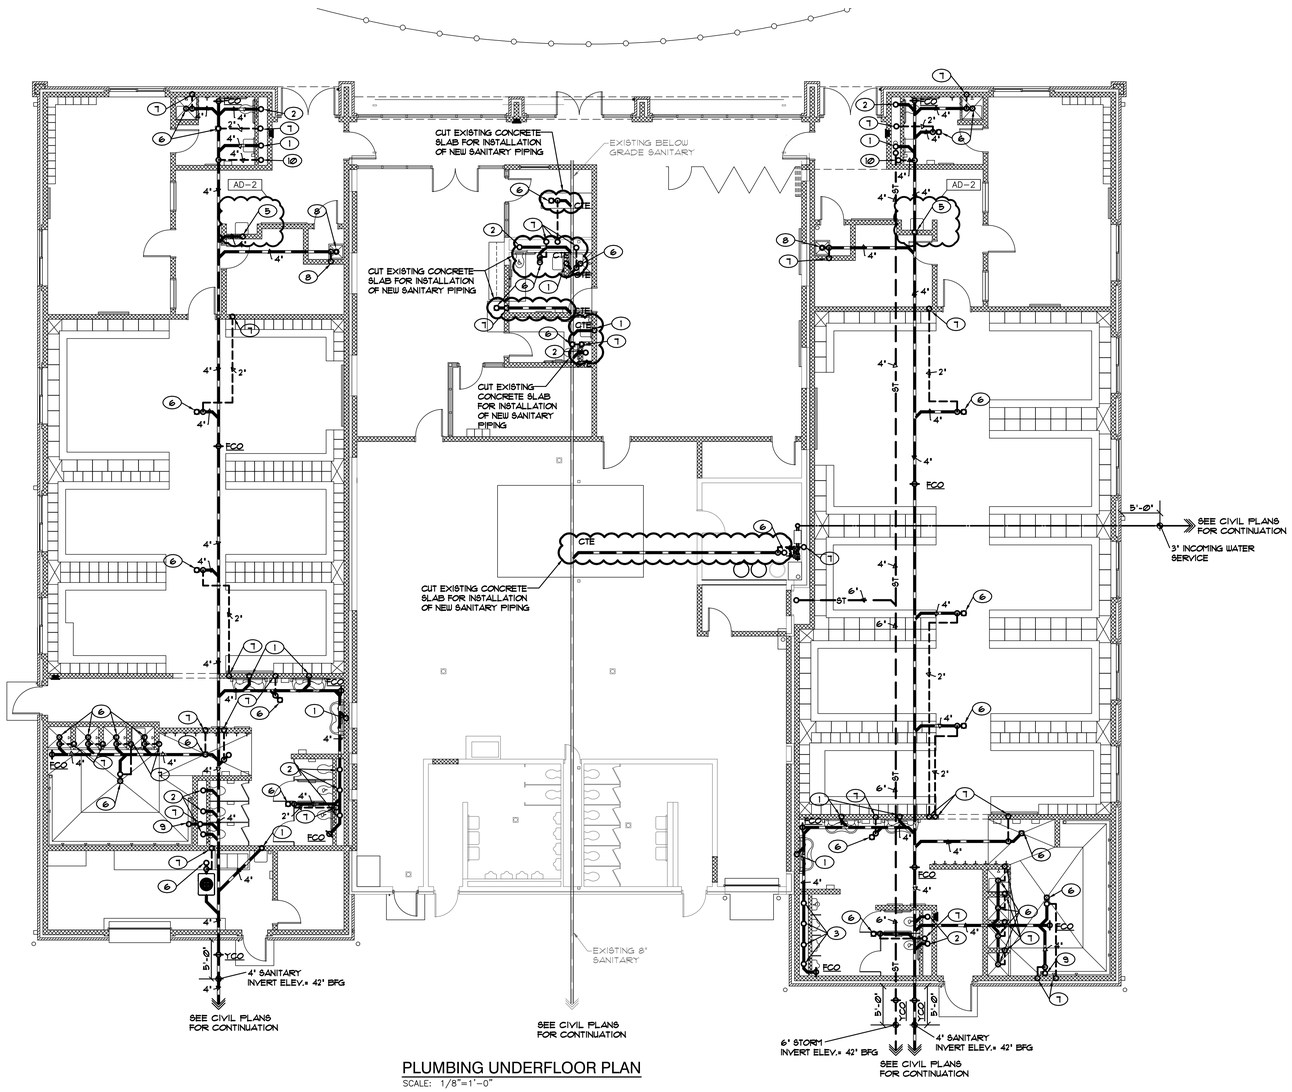


## PLUMBING UNDERFLOOR PLAN

SCALE: 1/8"=1'-0"

GIBRALTAR DESIGN
ARCHITECTURE • ENGINEERING • INTERIOR DESIGN

MILLIES ENGINEERING GROUP
(219) 924-5400
www.milliesengineeringgroup.com

PROJECT

VALPARAISO HIGH SCHOOL WEST CAMPUS IMPROVEMENTS

VALPARAISO COMMUNITY SCHOOLS
VALPARAISO, INDIANA


GIBRALTAR DESIGN
9102 N. Meridian St., Ste. 300
Indianapolis, IN 46260
Homepage www.GibraltarDesign.com
Email info@GibraltarDesign.com
Phone 317.580.5777 Fax 317.580.5778


PROJECT 20-130
DATE 07/24/20
COORDINATED BY JC
DRAWN BY CC
CHECKED BY DJ

REGISTERED DAVID G. JANNEY NO. 10302590 STATE OF INDIANA PROFESSIONAL ENGINEER


COPYRIGHT NOTICE:
THE CONCEPTS, DESIGNS, PLANS, DETAILS, ETC. SHOWN ON THIS DOCUMENT ARE THE PROPERTY OF GIBRALTAR DESIGN AND WERE CREATED FOR USE ON THIS SPECIFIC PROJECT. NONE OF THIS INFORMATION SHALL BE USED BY ANY PERSON OR FIRM FOR ANY PURPOSE WITHOUT THE EXPRESS WRITTEN CONSENT OF GIBRALTAR DESIGN. THE OWNER MAY RETAIN COPIES FOR INFORMATION AND REFERENCE IN CONNECTION ONLY WITH THIS PROJECT.


REVISIONS

| MARK | DATE | ISSUED FOR |
|---|---|---|
| AD-2 | 08/07/20 | ADDENDUM NO. 2 |

DRAWING
PLUMBING UNDERFLOOR PLAN

PROJECT
VALPARAISO HIGH SCHOOL WEST CAMPUS IMPROVEMENTS

© GIBRALTAR DESIGN

SHEET
P-201

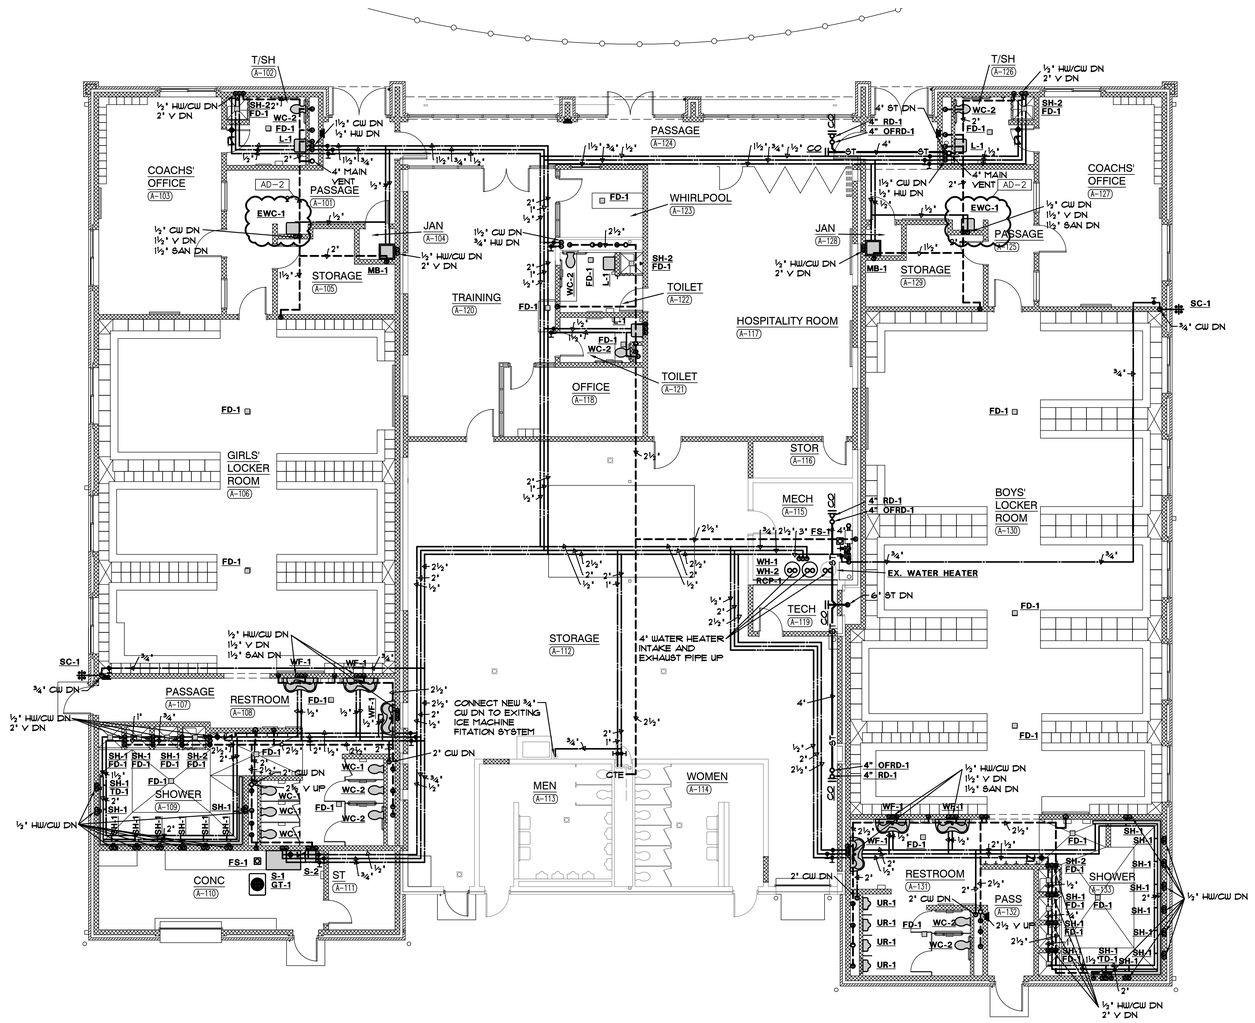


## PLUMBING FLOOR PLAN

SCALE: 1/8"=1'-0"

GIBRALTAR DESIGN

ARCHITECTURE • ENGINEERING • INTERIOR DESIGN

MILLIES ENGINEERING GROUP (219) 924-5400 www.milliesengineeringgroup.com

PROJECT

# VALPARAISO HIGH SCHOOL WEST CAMPUS IMPROVEMENTS

VALPARAISO COMMUNITY SCHOOLS
VALPARAISO, INDIANA

GIBRALTAR DESIGN
9102 N. Meridian St., Ste. 300
Indianapolis, IN 46260
Homepage www.GibraltarDesign.com
Email info@GibraltarDesign.com
Phone 317.580.5777 Fax 317.580.5778

PROJECT 20-130
DATE 07/24/20
COORDINATED BY JC
DRAWN BY CC
CHECKED BY DJ

REGISTERED DAVID G. JANEY NO. 10302590 STATE OF INDIANA PROFESSIONAL ENGINEER

COPYRIGHT NOTICE:
THE CONCEPTS, DESIGNS, PLANS, DETAILS, ETC. SHOWN ON THIS DOCUMENT ARE THE PROPERTY OF GIBRALTAR DESIGN AND WERE CREATED FOR USE ON THIS SPECIFIC PROJECT. NONE OF THIS INFORMATION SHALL BE USED BY ANY PERSON OR FIRM FOR ANY PURPOSE WITHOUT THE EXPRESS WRITTEN CONSENT OF GIBRALTAR DESIGN. THE OWNER MAY RETAIN COPIES FOR INFORMATION AND REFERENCE IN CONNECTION ONLY WITH THIS PROJECT.

REVISIONS

| MARK | DATE | ISSUED FOR |
|---|---|---|
| AD-2 | 08/07/20 | ADDENDUM NO. 2 |

DRAWING
PLUMBING FLOOR PLAN

PROJECT
VALPARAISO HIGH SCHOOL WEST CAMPUS IMPROVEMENTS

© GIBRALTAR DESIGN

SHEET
P-202

# PLUMBING EQUIPMENT AND FIXTURE SCHEDULE

| TAG NO. | FIXTURE/EQUIPMENT TYPE | FIXTURE/EQUIPMENT DESCRIPTION | FIXTURE/EQUIPMENT MANUFACTURER AND MODEL NO. | ACCEPTABLE MANUF. | FIXTURE VALVE/FAUCET TYPE | FIXTURE VALVE/FAUCET TYPE | ACCEPTABLE MANUF. | ACCESSORIES/REMARKS (SEE SPECIFICATIONS FOR ADDITIONAL INFORMATION) | ELECTRICAL DATA HP | MCA | FLA | AMPS | MOCP | VOLT | PH | HZ |
|---|---|---|---|---|---|---|---|---|---|---|---|---|---|---|---|---|
| WC-1 | WATER CLOSET | VITREOUS CHINA, WALL MOUNTED | AMERICAN STANDARD #3351.001 | NOTE #1 | BATTERY SENSOR FLUSH VALVE | SLOAN "G2 OPTIMA" #8116-1.6 | NOTE 6 | BEMIS #155-C SEAT | - | - | - | - | - | - | - | - |
| WC-2 | WATER CLOSET | VITREOUS CHINA, WALL MOUNTED | AMERICAN STANDARD #3351.001 | NOTE #1 | BATTERY SENSOR FLUSH VALVE | SLOAN "G2 OPTIMA" #8111-1.6 | NOTE #6 | BEMIS #155-C SEAT | - | - | - | - | - | - | - | - |
| UR-1 | URINAL | .125 GAL PER FLUSH, VITREOUS CHINA, WALL MOUNTED, ADA | ZURN #Z5715S-W | NOTE #1 | BATTERY SENSOR FLUSH VALVE | VALVE INCLUDED | NOTE #6 | - | - | - | - | - | - | - | - | - |
| WF-1 | WASHFOUNTAIN | 2 STATION WASHFOUNTAIN, ADA | BRADLEY #56-2N/IR/STD/L5D-2/TMA | - | INTEGRATED VALVE | - | - | W/ INFRARED METERING VALVE, STANDARD HEIGHT | - | - | - | - | - | 120 | 1 | 60 |
| L-1 | LAVATORY | VITREOUS CHINA, WALL MOUNTED, 20"x18", ADA | AMERICAN STANDARD #0355.012 | NOTE #1 | Ø.5 GPM-ELECTRONIC BATTERY SENSOR, 4" CENTERS | EUROPEAN #EBF-650-BDT | NOTE #1 | PROVIDED WITH THERMOSTATIC MIXING VALVE. MCGUIRE #PU-215Ø-UC 1-1/2" PROURAP, MCGUIRE #4216TCCLK SUPPLIES | - | - | - | - | - | - | - | - |
| S-1 | SINK | THREE COMPARTMNT SINK, 49"x22", 16"x14"x12" COMPT. | JUST #TLXDN-2249-A-GR | - | (2) 2 HANDLE, SWING SPOUT | ELKAY #LKD2432BHC | NOTE #4 | (3) ELKAY #335 STRAINER, ELKAY #LK-16 DRAIN ASSEMBLY, MCGUIRE #4216TCCLK SUPPLIES | - | - | - | - | - | - | - | - |
| S-2 | SINK | SINGLE COMPARTMENT STAINLESS STEEL SINK 14" x 16-1/2" | ELKAY #ELS-14X | - | 2 HANDLE, HIGH GOOSENECK (INCLUDED) | - | NOTE #4 | MCGUIRE #B-8312-C8CF P-TRAP, MCGUIRE #4216TCCLK SUPPLIES | - | - | - | - | - | - | - | - |
| EWC-1 | ELECTRIC WATER COOLER | ELECTRIC WALL MOUNTED W/ BOTTLE FILLER | ELKAY #LZS8WSLP AD-2 | NOTE #2 | - | - | - | - | - | - | 4.8 | - | - | 115 | 1 | 60 |
| SH-1 | SHOWER | - | - | - | 1-HANDLE PRESSURE/TEMP. BALANCED | POWERS #E110-M-2 | NOTE #7 | - | - | - | - | - | - | - | - | - |
| SH-2 | SHOWER | - | - | - | 1-HANDLE PRESSURE/TEMP. BALANCED | POWERS #E110-M-2-6-B-W | NOTE #7 | HANDHELD SHOWER HEAD, HOSE, WALL BRACKET, VACUUM BREAKER AND 24" SLIDEBAR | - | - | - | - | - | - | - | - |
| MB-1 | MOP BASIN | MOLDED STONE, 30"x30"x6"H | FIAT #SB-3030 | NOTE #3 | WALL MOUNTED SERVICE FAUCET | CHICAGO FAUCET CO. #897-CP | NOTE #7 | W/ 3/4" HOSE THREAD, VACUUM BREAKER, WALL BRACE | - | - | - | - | - | - | - | - |
| TD-1 | SHOWER TRENCH DRAIN | PRESLOPED HIGH DENSITY POLYPROPYLENE | ZURN #Z-886-PG | - | - | - | - | STAINLESS STEEL LOCKDOWN, WITH GALVANIZED STEEL SLOTTED LIGHT DUTY GRATE | - | - | - | - | - | - | - | |
| FD-1 | FLOOR DRAIN | CAST IRON BODY, ADJUSTABLE 6"x6" NICKEL BRONZE TOP | WADE #1100-G6 | NOTE #4 | - | - | - | VANDALPROOF SCREWS | - | - | - | - | - | - | - | - |
| FS-1 | FLOOR SINK | CAST IRON, 8-1/8" DEEP, ACID RESISTING, 12"x12" TOP | WADE #9140 | NOTE #4 | - | - | - | ALUMINUM DOME STRAINER, SECURED HINGED GRATE, SLOPED RIM. TOP TO BE MOUNTED FLUSH WITH FLOOR | - | - | - | - | - | - | - | - |
| WH-1 | WATER HEATER | 199 MBH, 235 GPH @ 100°F, 100 GAL. STORAGE | STATE #SYF-100-199NE | - | - | - | - | TEMP. RELIEF VALVE, DRAIN VALVE PIPED TO FLOOR DRAIN | - | - | - | - | - | 120 | 1 | 60 |
| WH-2 | WATER HEATER | 199 MBH, 235 GPH @ 100°F, 100 GAL. STORAGE | STATE #SYF-100-199NE | - | - | - | - | TEMP. RELIEF VALVE, DRAIN VALVE PIPED TO FLOOR DRAIN | - | - | - | - | - | 120 | 1 | 60 |
| RCP-1 | RECIRCULATION PUMP | 2.5 GPM @ 13' HEAD, ALL BRONZE CONSTRUCTION | B&G #LR-15B | - | - | - | - | W/ STRAP ON AQUASTAT | 1/12 | - | - | - | - | 120 | 1 | 60 |
| RD-1 | ROOF DRAIN | CAST IRON BODY, GRAVEL STOP, LARGE SUMP | MIFAB #R1200-EU | NOTE #4 | - | - | - | - | - | - | - | - | - | - | - | |
| OFRD-1 | OVERFLOW ROOF DRAIN | CAST IRON BODY, GRAVEL STOP, LARGE SUMP | MIFAB #R1200-W | NOTE #4 | - | - | - | - | - | - | - | - | - | - | - | |
| SC-1 | SILLCOCK | NON-FREEZE, VACUUM BREAKER, REMOVABLE KEY | WADE #86-00 | - | - | - | - | - | - | - | - | - | - | - | - | - |
| GT-1 | GREASE TRAP | 15 GPM, LIQUID CAP 40 GAL | SCHIER #SB3 | - | - | - | - | - | - | - | - | - | - | - | - | - |

NOTE #1: AMERICAN STANDARD, KOHLER, ZURN, SLOAN
NOTE # 2: OASIS, HAWS, SUNROC
NOTE #3: MUSTEE, SWAN, ACORN, STERN-WILLIAMS
NOTE #4: ZURN, JOSAM, J.R. SMITH, MIFAB
NOTE #5: JOSAM, ZURN, J.R. SMITH, WOODFORD
NOTE #6: ZURN, TOTO
NOTE #7: ZURN, DELTA, T&S BRASS, CHICAGO FAUCET CO.

## GT-1 - GREASE TRAP DETAIL

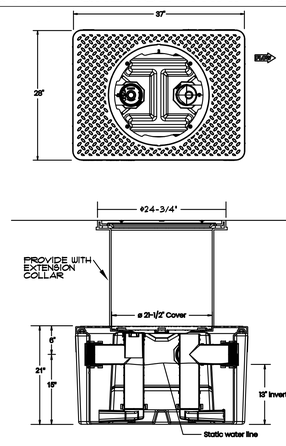


GREASETRAP
SCHIER #SB-3 W/ #LR24, 37"Lx28"W.
75 GAL. CAPACITY.

## WATER HEATER DIAGRAM

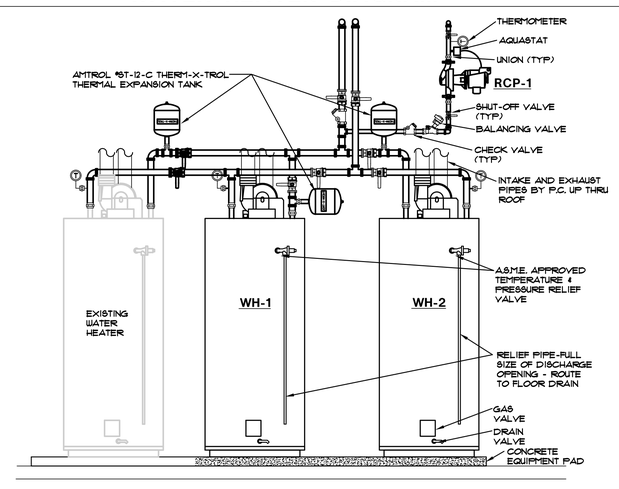


## INCOMING DOMESTIC WATER SERVICE DIAGRAM

NTS

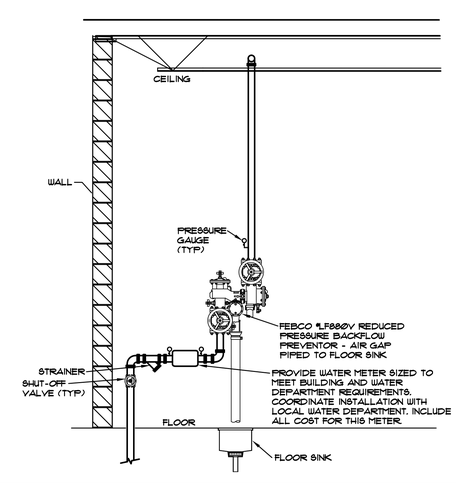


## TEMPERED WATER VALVE DIAGRAM

NTS

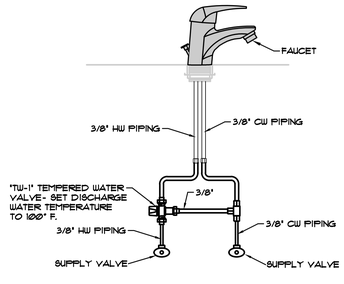


## ROOF and OVERFLOW DRAIN DETAIL

NTS

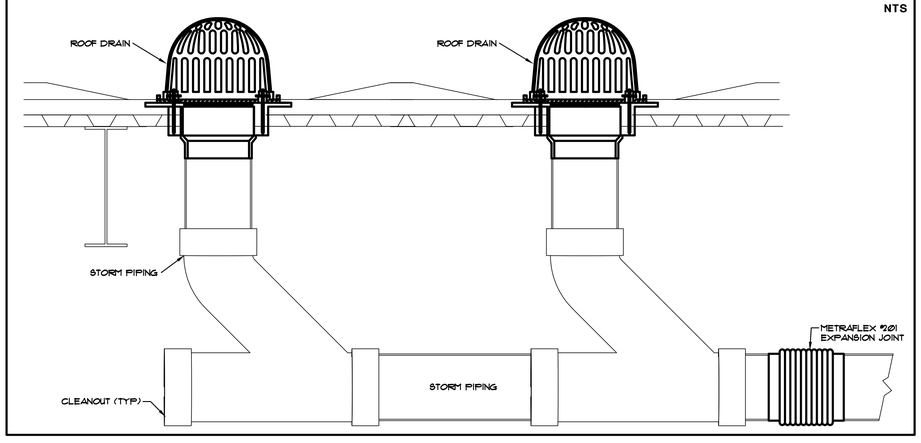


GIBRALTAR DESIGN
ARCHITECTURE • ENGINEERING • INTERIOR DESIGN
MILLIES ENGINEERING GROUP (317) 924-5400 www.milliesengineeringgroup.com

PROJECT

VALPARAISO HIGH SCHOOL WEST CAMPUS IMPROVEMENTS
VALPARAISO COMMUNITY SCHOOLS
VALPARAISO, INDIANA


GIBRALTAR DESIGN
9102 N. Meridian St., Ste. 300
Indianapolis, IN 46260
Homepage www.GibraltarDesign.com
Email info@GibraltarDesign.com
Phone 317.580.5777 Fax 317.580.5778


PROJECT 20-130
DATE 07/24/20
COORDINATED BY JC
DRAWN BY CC
CHECKED BY DJ

DAVID G. JANNEY REGISTERED NO. 10302590 STATE OF INDIANA PROFESSIONAL ENGINEER


COPYRIGHT NOTICE:
THE CONCEPTS, DESIGNS, PLANS, DETAILS, ETC. SHOWN ON THIS DOCUMENT ARE THE PROPERTY OF GIBRALTAR DESIGN AND WERE CREATED FOR USE ON THIS SPECIFIC PROJECT. NONE OF THIS INFORMATION SHALL BE USED BY ANY PERSON OR FIRM FOR ANY PURPOSE WITHOUT THE EXPRESS WRITTEN CONSENT OF GIBRALTAR DESIGN. THE OWNER MAY RETAIN COPIES FOR INFORMATION AND REFERENCE IN CONNECTION ONLY WITH THIS PROJECT.


REVISIONS

| MARK | DATE | ISSUED FOR |
|---|---|---|
| AD-2 | 08/07/20 | ADDENDUM NO. 2 |

DRAWING
PLUMBING EQUIPMENT SCHEDULES & DETAILS

PROJECT
VALPARAISO HIGH SCHOOL WEST CAMPUS IMPROVEMENTS

© GIBRALTAR DESIGN

SHEET
P-401

AD-2

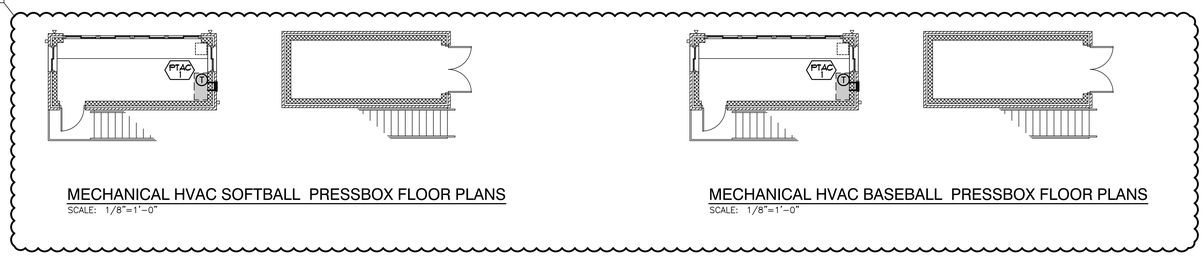


MECHANICAL HVAC SOFTBALL PRESSBOX FLOOR PLANS
SCALE: 1/8"=1'-0"

MECHANICAL HVAC BASEBALL PRESSBOX FLOOR PLANS
SCALE: 1/8"=1'-0"

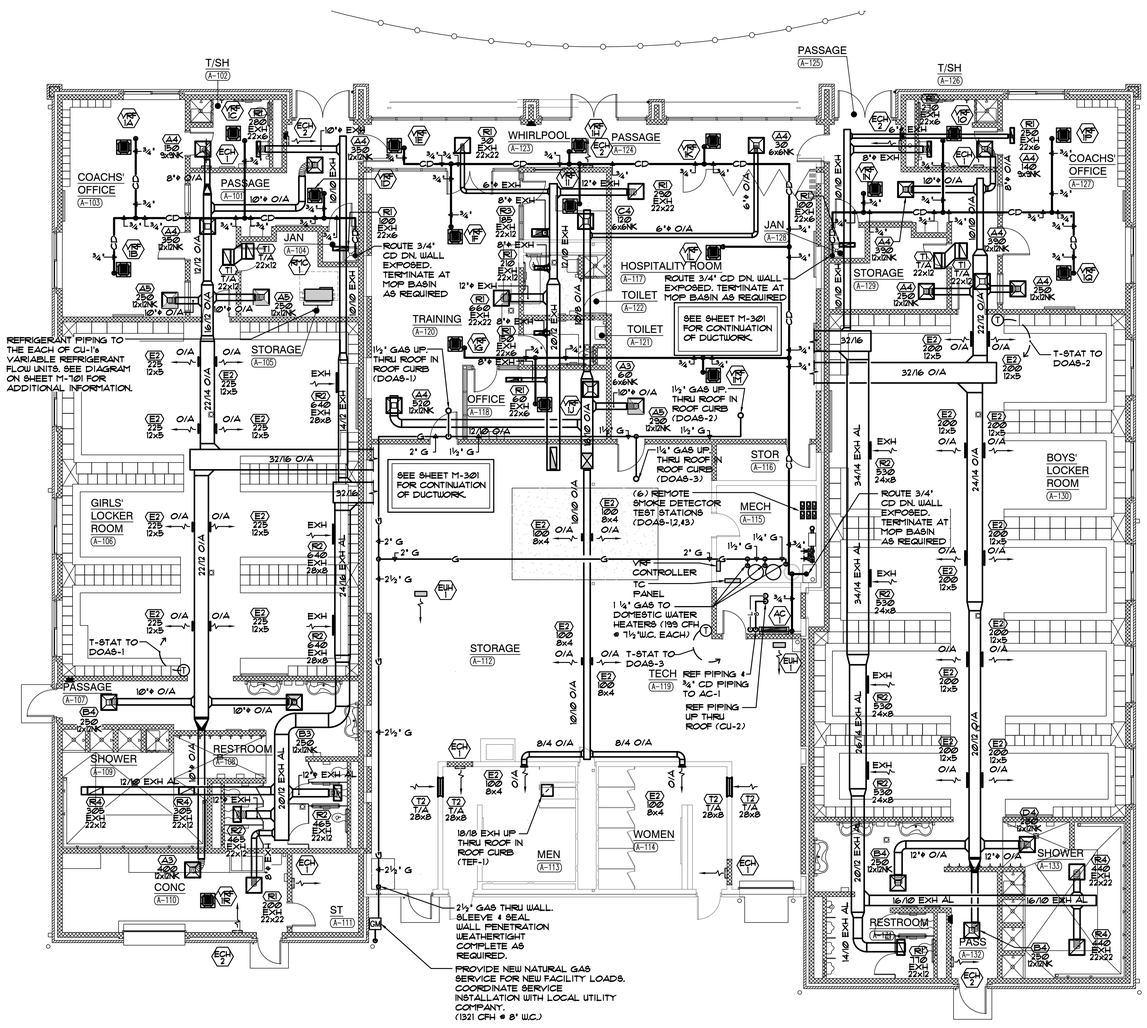


MECHANICAL HVAC CLEAT HOUSE FLOOR PLAN
SCALE: 1/8"=1'-0"

GIBRALTAR
DESIGN
ARCHITECTURE • ENGINEERING • INTERIOR DESIGN

MILLIES
ENGINEERING GROUP
(219) 924-5400
www.milliesengineeringgroup.com

PROJECT

VALPARAISO HIGH SCHOOL WEST CAMPUS IMPROVEMENTS

VALPARAISO COMMUNITY SCHOOLS
VALPARAISO, INDIANA


GIBRALTAR DESIGN
9102 N. Meridian St., Ste. 300
Indianapolis, IN 46260
Homepage www.GibraltarDesign.com
Email info@GibraltarDesign.com
Phone 317.580.5777 Fax 317.580.5778


PROJECT
20-130
DATE
07/24/20
COORDINATED BY
JC
DRAWN BY
CC
CHECKED BY
DJ

DAVID G. JANNEY
REGISTERED
NO.
10302590
STATE OF
INDIANA
PROFESSIONAL ENGINEER


COPYRIGHT NOTICE:
THE CONCEPTS, DESIGNS, PLANS, DETAILS, ETC., SHOWN ON THIS DOCUMENT ARE THE PROPERTY OF GIBRALTAR DESIGN AND WERE CREATED FOR USE ON THIS SPECIFIC PROJECT. NONE OF THIS INFORMATION SHALL BE USED BY ANY PERSON OR FIRM FOR ANY PURPOSE OTHER THAN THE PERFORMANCE OF WORK BY OF GIBRALTAR DESIGN. THE OWNER MAY RETAIN COPIES FOR INFORMATION AND REFERENCE IN CONNECTION ONLY WITH THIS PROJECT.


REVISIONS

| MARK | DATE | ISSUED FOR |
|---|---|---|
| AD-2 | 08/07/20 | ADDENDUM NO. 2 |

DRAWING
MECHANICAL HVAC FLOOR PLANS

PROJECT
VALPARAISO HIGH SCHOOL WEST CAMPUS IMPROVEMENTS

© GIBRALTAR DESIGN

SHEET
M-201

## DEMOLITION PLAN NOTES:
(THESE NOTES APPLY TO THIS SHEET ONLY)

1. EXISTING PAD MOUNTED TRANSFORMER SHALL REMAIN.
2. EXISTING PANELS, TRANSFORMER, ELECTRICAL EQUIPMENT AND LIGHTING CONTROLS SHALL REMAIN.
3. REMOVE, STORE AND PREPARE EXISTING SERVICE ENTRANCE DISCONNECT FOR RELOCATION. REMOVE SUPPORT STRUCTURE AND ALL ASSOCIATED CONDUIT AND WIRE BACK TO THE SOURCE, UNLESS OTHERWISE NOTED. | EXISTING PAD MOUNTED TRANSFORMER AND UTILITY COMPANY METER TO BE REMOVED/RELOCATED BY NIPSCO. UNDERGROUND PRIMARY CONDUIT TO BE ABANDONED AND PRIMARY CABLES TO BE REMOVED BY NIPSCO.
4. EXISTING SITE LIGHTING FIXTURE SHALL REMAIN.
5. EXISTING TENNIS COURT LIGHTING SHALL REMAIN.
6. REMOVE, STORE AND PREPARE EXISTING SITE LIGHTING POLE FOR RELOCATION. REMOVE EXISTING CONCRETE BASE. INTERCEPT EXISTING CONDUIT AND WIRE AND EXTEND TO NEW LOCATION AS SHOWN ON SHEET E-102.
7. REMOVE EXISTING CONDUIT AND WIRE. AD-2

## SITE PLAN NOTES - GENERAL

1. ALL WORK SHOWN ON THIS SHEET IS NEW AND BY THE ELECTRICAL TRADES, UNLESS OTHERWISE INDICATED.
2. NOT ALL UTILITIES HAVE BEEN SHOWN. VERIFY LOCATIONS AND ROUTING OF ALL NEW AND EXISTING UTILITIES PRIOR TO ANY NEW WORK.

## GENERAL NOTES:

1. FOR ADDITIONAL GENERAL ELECTRICAL NOTES, SEE GENERAL ELECTRICAL PROJECT NOTES ON SHEET E-001.
2. SEE E-600 SHEETS FOR ELECTRICAL DETAILS AND SCHEDULES.
3. SEE E-700 SHEETS FOR ELECTRICAL DISTRIBUTION DIAGRAMS.

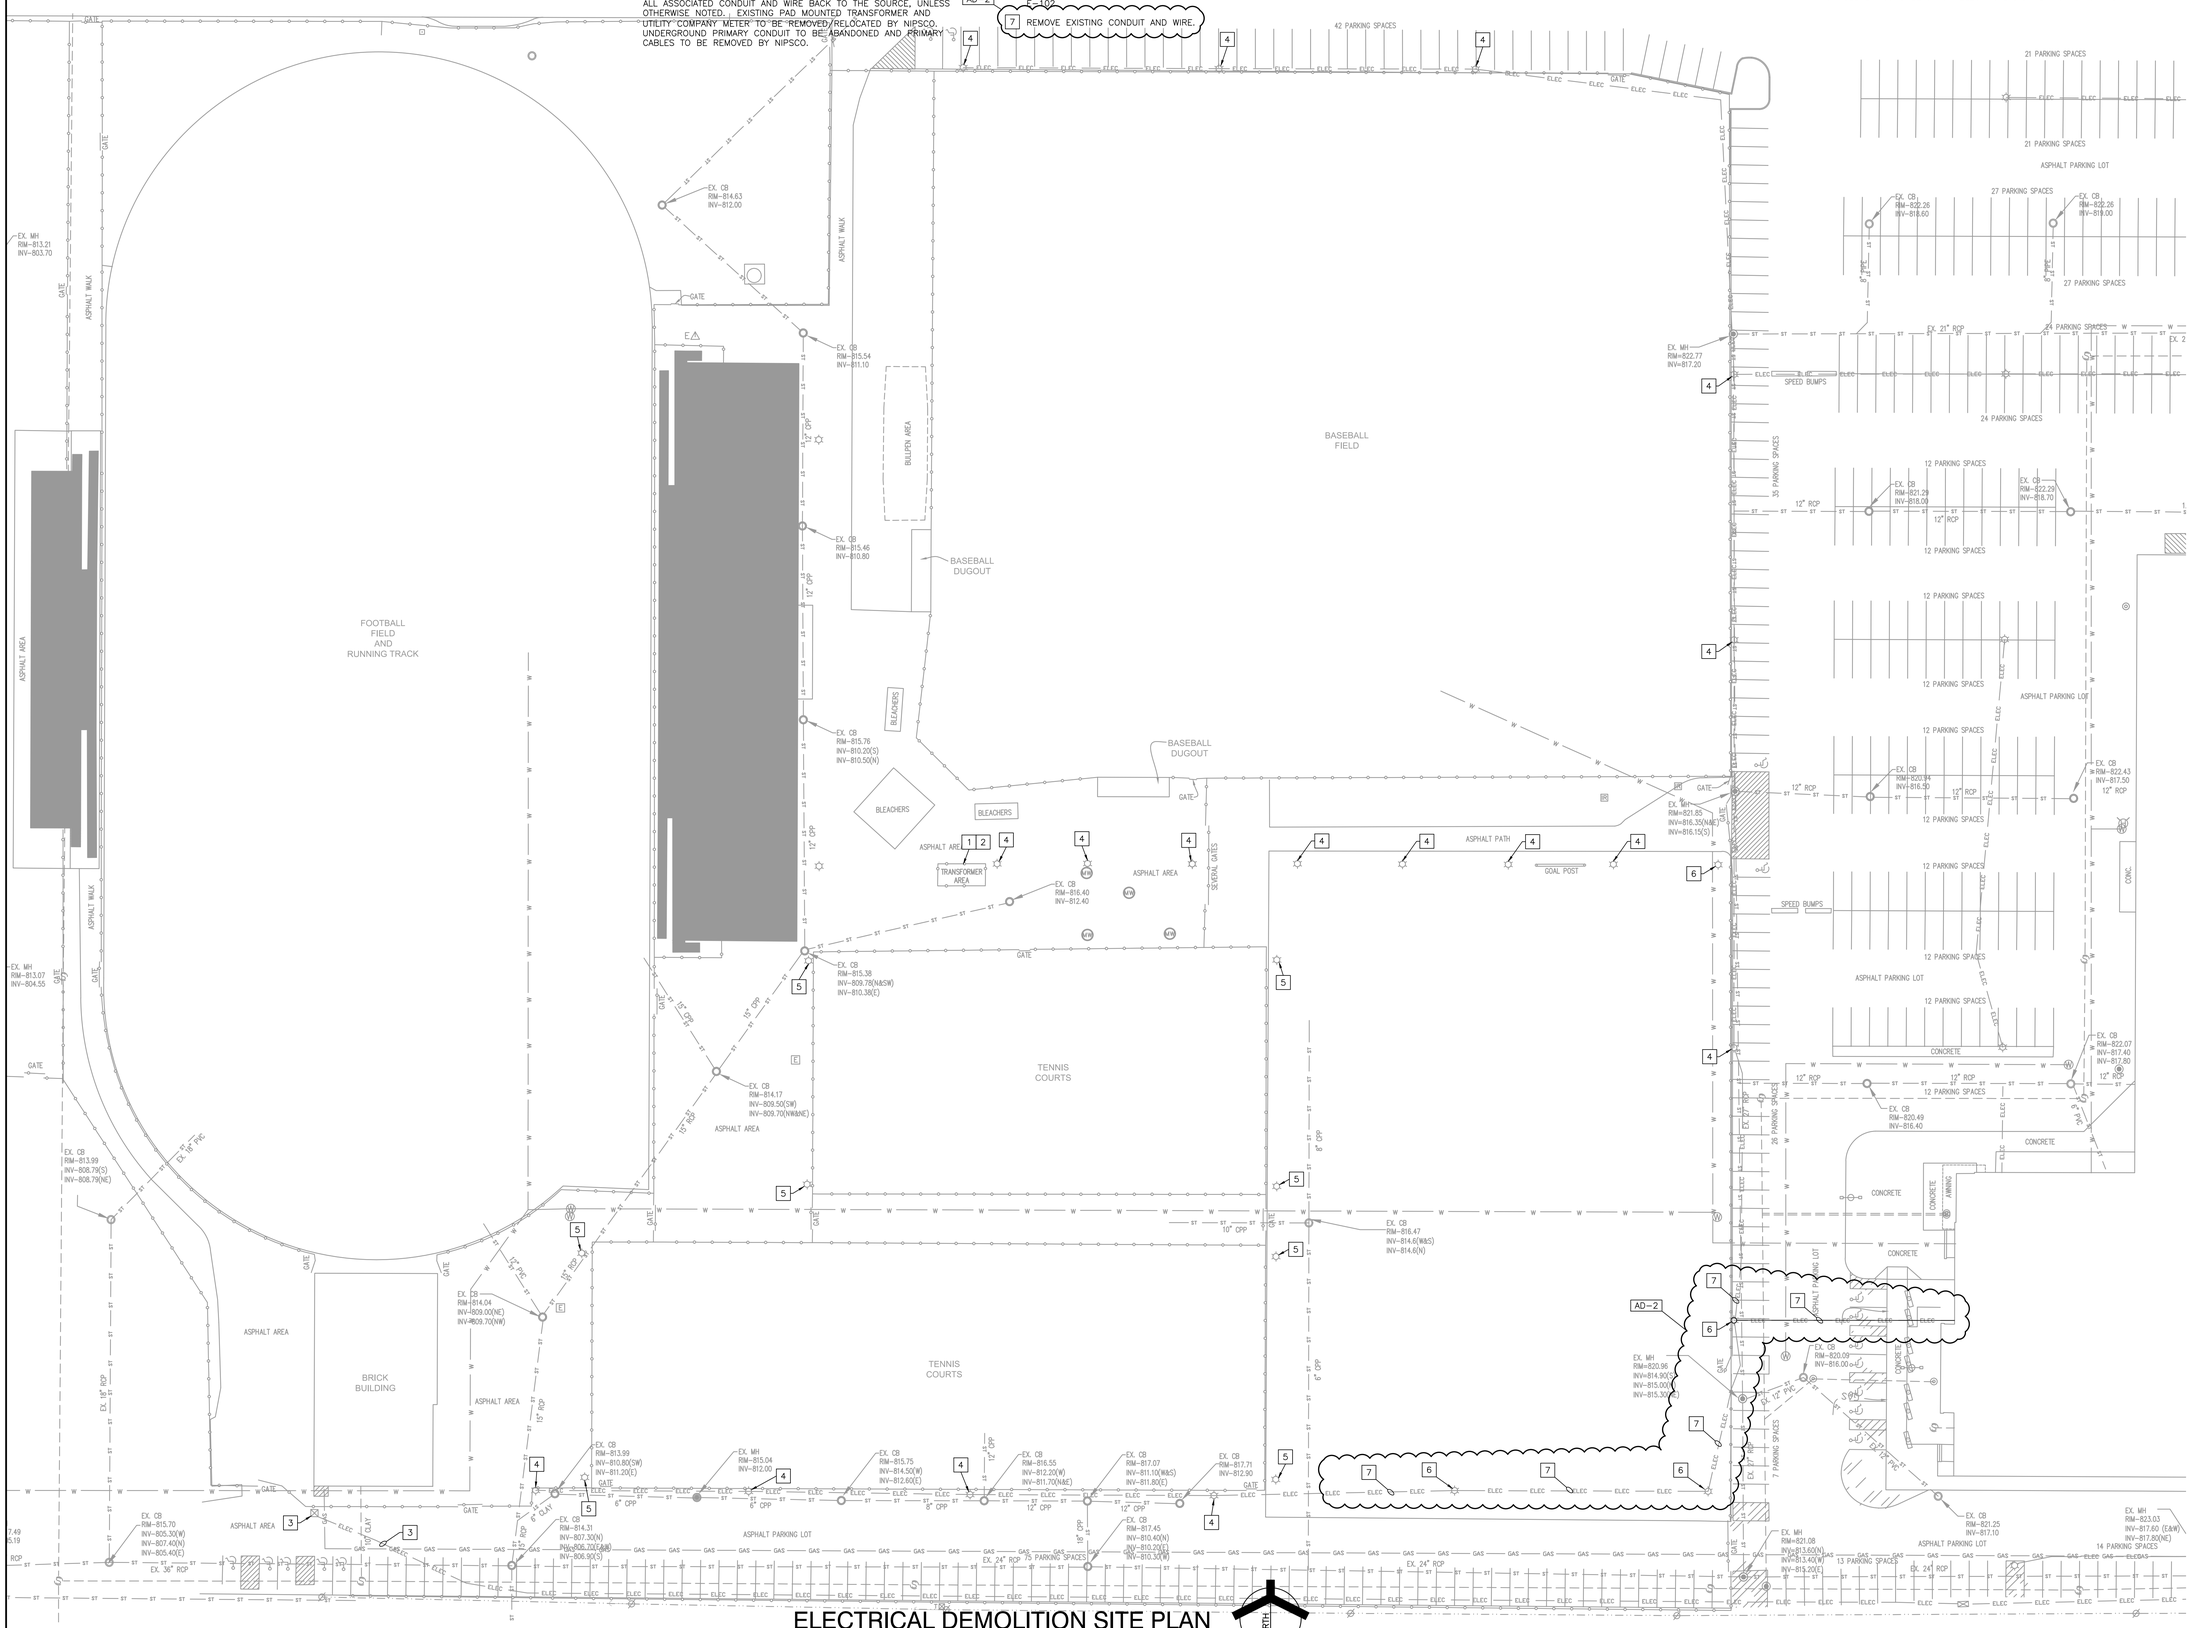


## ELECTRICAL DEMOLITION SITE PLAN
SCALE: 1" = 30'-0"

GIBRALTAR DESIGN
ARCHITECTURE • ENGINEERING • INTERIOR DESIGN

PROJECT
# VALPARAISO HIGH SCHOOL WEST CAMPUS IMPROVEMENTS
VALPARAISO COMMUNITY SCHOOLS
VALPARAISO, INDIANA


GIBRALTAR DESIGN
9102 N. Meridian St., Ste. 300
Indianapolis, IN 46260
Homepage www.GibraltarDesign.com
Email info@GibraltarDesign.com
Phone 317.580.5777 Fax 317.580.5778


PROJECT 20-130
DATE 07/24/20
COORDINATED BY PCB
DRAWN BY PCB/JVC
CHECKED BY JPB

JOSEPH P. BRIGGS REGISTERED NO. 11600109 STATE OF INDIANA ARCHITECT


COPYRIGHT NOTICE:
THE CONCEPTS, DESIGNS, PLANS, DETAILS, ETC. SHOWN ON THIS DOCUMENT ARE THE PROPERTY OF GIBRALTAR DESIGN AND WERE CREATED FOR USE ON THIS SPECIFIC PROJECT. NONE OF THIS INFORMATION SHALL BE USED BY ANY PERSON OR FIRM FOR ANY OTHER PROJECT WITHOUT WRITTEN AUTHORIZATION OF GIBRALTAR DESIGN. THE OWNER MAY RETAIN COPIES FOR INFORMATION AND REFERENCE IN CONNECTION ONLY WITH THIS PROJECT.


REVISIONS

| MARK | DATE | ISSUED FOR |
|---|---|---|
| AD-2 | 08/07/20 | ADDENDUM NO. 2 |

DRAWING
ELECTRICAL DEMOLITION SITE PLAN

PROJECT
VALPARAISO HIGH SCHOOL WEST CAMPUS IMPROVEMENTS

© GIBRALTAR DESIGN

SHEET
ES101

Y:\20-130 VALPARAISO CS - VHS WEST CAMPUS IMPROVEMENTS\20-130 DRAWINGS\09 ELEC\ES101.DWG

## SITE PLAN NOTES - GENERAL

1. ALL WORK SHOWN ON THIS SHEET IS NEW AND BY THE ELECTRICAL TRADES, UNLESS OTHERWISE INDICATED.
2. RELOCATE OR REMOVE ANY OR ALL EXISTING SERVICES, POLES, ETC., AS MAY BE REQUIRED TO ACCOMMODATE NEW CONSTRUCTION, UNLESS OTHERWISE INDICATED.
3. PAY ALL FEES AND OTHER COSTS NOT BORNE BY THE POWER COMPANY TO PROVIDE NEW ELECTRICAL SERVICE.
4. COORDINATE LOCATIONS OF UNDERGROUND CONDUITS, HANDHOLES AND MANHOLES WITH OTHER SITE UTILITIES, UNDERGROUND DRAINS, SERVICES, STRUCTURES AND FINAL GRADING.
5. NOT ALL UTILITIES HAVE BEEN SHOWN. VERIFY LOCATIONS AND ROUTING OF ALL NEW AND EXISTING UTILITIES PRIOR TO ANY NEW WORK.
6. FOR ADDITIONAL GENERAL ELECTRICAL NOTES, SEE GENERAL ELECTRICAL PROJECT NOTES ON SHEET E-001.
7. SEE E-600 SHEETS FOR ELECTRICAL DETAILS AND SCHEDULES.
8. SEE E-700 SHEETS FOR ELECTRICAL DISTRIBUTION DIAGRAMS.
9. BASEBALL AND SOFTBALL FIELD LIGHTING SYSTEMS (LIGHTING FIXTURES, POLES, CONDUIT, WIRES, RELAYS, PANELS, ETC. SHALL BE BID AS AN ALTERNATE BID.

## ELECTRICAL SITE PLAN NOTES:

(THESE NOTES APPLY TO THIS SHEET ONLY)

1. EXISTING SITE LIGHTING FIXTURE SHALL REMAIN.
2. EXISTING TENNIS COURT LIGHTING FIXTURES AND POLE SHALL REMAIN.
3. NEW BASEBALL FIELD LIGHTING FIXTURES AND POLE. (ALTERNATE BID)
4. NEW SOFTBALL FIELD LIGHTING FIXTURES AND POLE. (ALTERNATE BID)
5. NEW FLEX FIELD LIGHTING FIXTURES AND POLE. (ALTERNATE BID)
6. NEW FLUSH IN-GROUND PULL BOX.
7. NEW SOFTBALL FIELD SCOREBOARD.
8. ALL WORK ASSOCIATED WITH THE NEW LIGHTING FIXTURES FOR EAST ENTRANCE GATE SHALL BE BID AS AN ALTERNATE BID.
9. RELOCATED SITE LIGHTING POLE. PROVIDE NEW CONCRETE POLE BAS.
10. WEATHERPROOF DIGITAL TIMECLOCK (BBH1-19)(ALTERNATE BID)

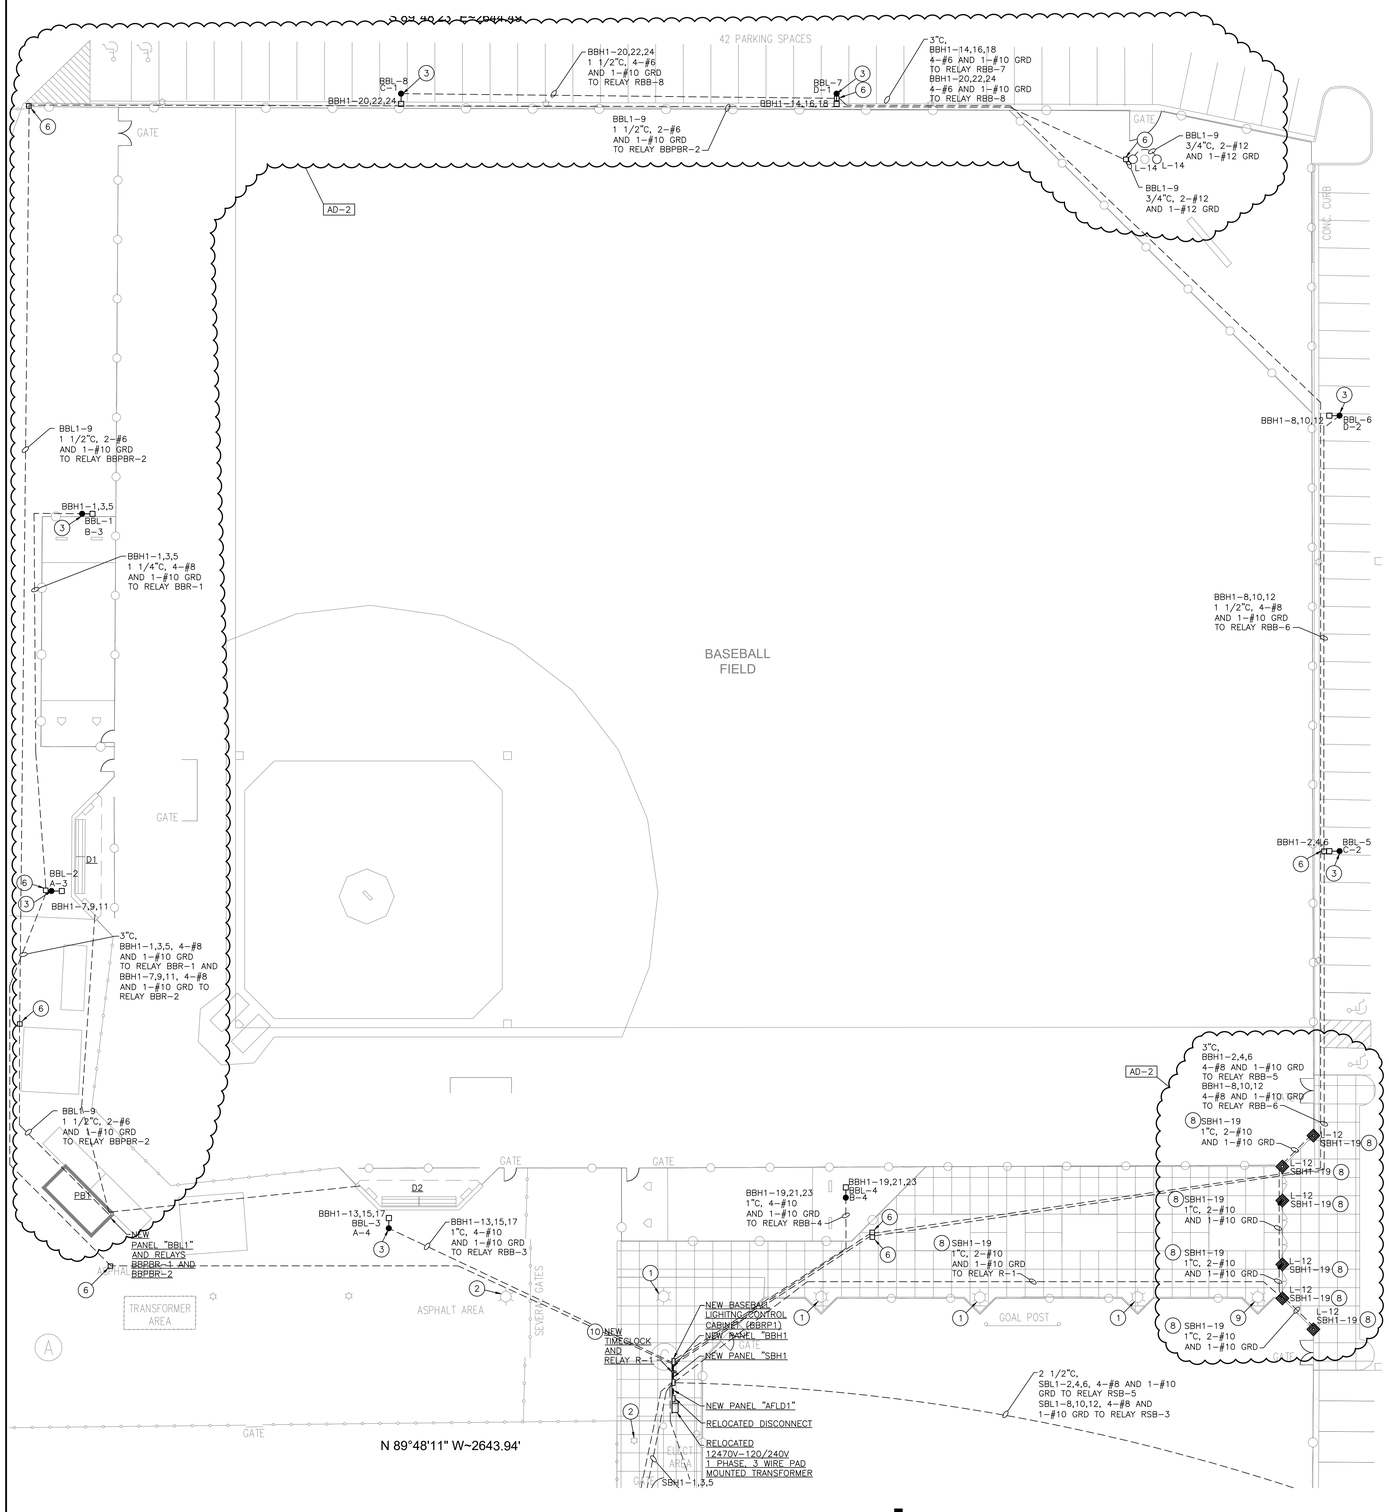


## BASEBALL FIELD ELECTRICAL SITE PLAN

SCALE: 1" = 20'-0"

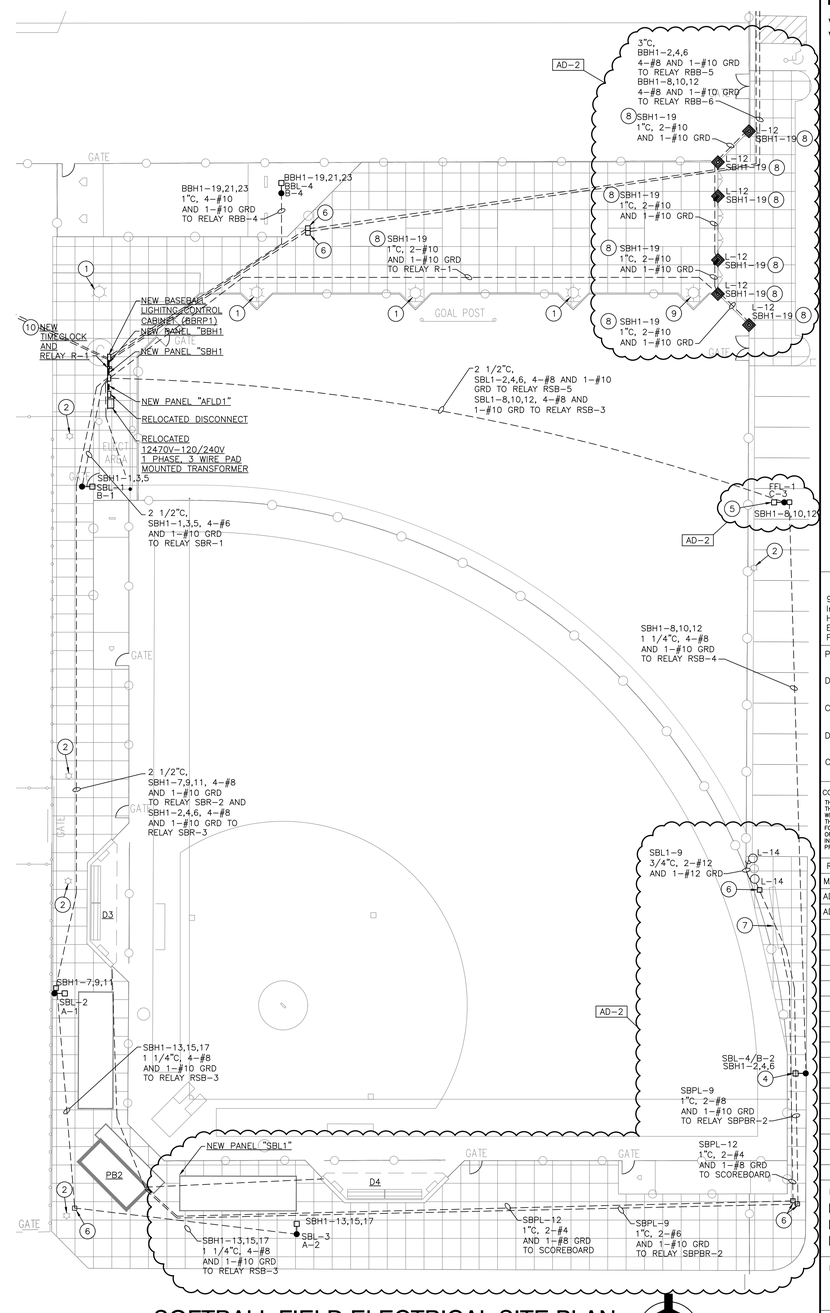


## SOFTBALL FIELD ELECTRICAL SITE PLAN

SCALE: 1" = 20'-0"

GIBRALTAR
DESIGN
ARCHITECTURE • ENGINEERING • INTERIOR DESIGN

PROJECT
# VALPARAISO HIGH SCHOOL WEST CAMPUS IMPROVEMENTS

VALPARAISO COMMUNITY SCHOOLS
VALPARAISO, INDIANA


GIBRALTAR DESIGN
9102 N. Meridian St., Ste. 300
Indianapolis, IN 46260
Homepage www.GibraltarDesign.com
Email info@GibraltarDesign.com
Phone 317.580.5777 Fax 317.580.5778


PROJECT 20-130
DATE 07/24/20
COORDINATED BY PCB
DRAWN BY PCB/JVC
CHECKED BY JPB

JOSEPH P. BRIGGS REGISTERED NO. 11600109 STATE OF INDIANA ARCHITECT


COPYRIGHT NOTICE:
THE CONCEPTS, DESIGNS, PLANS, DETAILS, ETC, SHOWN ON THIS DOCUMENT ARE THE PROPERTY OF GIBRALTAR DESIGN AND WERE CREATED FOR USE ON THIS SPECIFIC PROJECT. NONE OF THIS INFORMATION SHALL BE USED BY ANY PERSON OR FIRM FOR ANY PURPOSE WITHOUT THE EXPRESS WRITTEN CONSENT OF GIBRALTAR DESIGN. THE OWNER MAY RETAIN COPIES FOR INFORMATION AND REFERENCE IN CONNECTION ONLY WITH THIS PROJECT.


REVISIONS

| MARK | DATE | ISSUED FOR |
|---|---|---|
| AD-1 | 08/03/20 | ADDENDUM NO. 1 |
| AD-2 | 08/07/20 | ADDENDUM NO. 2 |

DRAWING
BASEBALL AND SOFTBALL FIELDS ELECTRICAL SITE PLANS

PROJECT
VALPARAISO HIGH SCHOOL WEST CAMPUS IMPROVEMENTS

© GIBRALTAR DESIGN

SHEET
ES103

Y:\20-130 VALPARAISO CS - VHS WEST CAMPUS IMPROVEMENTS\20-130 DRAWINGS\09 ELEC\ES103.DWG

## ELECTRICAL PLAN NOTES:

(ALL PLAN NOTES MAY NOT APPLY TO THIS SHEET.)

1. HAND DRYER.
2. HAIR DRYER.
3. FIRE ALARM SYSTEM REMOTE ANNUNCIATOR.
4. PROVIDE POWER CONNECTION FOR AUTOMATIC DOORS/CARD READERS.
5. OVERHEARD DOOR CONTROLLER BY OVERHEAD DOOR SUPPLIER/CONTACTOR INSTALLED BY DIVISION 26.
6. REPLACE EXISTING RECEPTACLE WITH NEW GFI RECEPTACLE AND CONNECT TO CIRCUIT INDICATED.
7. 3/4"C, 2–#10 AND 1–#10 GRD.
8. EXISTING ICE MACHINES SHALL REMAIN. INTERCEPT EXISTING CIRCUITS AND CONNECT TO NEW PANEL "CHL2".

## GENERAL NOTES:

1. FOR ADDITIONAL GENERAL ELECTRICAL NOTES, SEE GENERAL ELECTRICAL PROJECT NOTES ON SHEET E–001.
2. SEE E–600 SHEETS FOR ELECTRICAL DETAILS AND SCHEDULES.
3. SEE E–700 SHEETS FOR ELECTRICAL DISTRIBUTION DIAGRAMS.
4. SEE T SERIES DRAWINGS AND DIVISION 27 SPECIFICATIONS FOR ADDITIONAL ELECTRICAL REQUIREMENTS. COORDINATE EXACT LOCATIONS, MOUNTING HEIGHTS AND ELECTRICAL REQUIREMENTS OF ALL TECHNOLOGY SYSTEMS DEVICES AND EQUIPMENT WITH T SERIES DRAWINGS, DIVISION 27 CONTRACTOR, ARCHITECT AND CONSTRUCTION MANAGER PRIOR TO ROUGHING–IN AND PROVIDE ALL ADDITIONAL ELECTRICAL WORK REQUIRED.
5. COORDINATE THE LOCATION OF THE FIRE ALARM SYSTEM DUCT DETECTORS FOR MECHANICAL EQUIPMENT WITH ARCHITECT AND CONSTRUCTION MANAGER PRIOR TO ROUGHING–IN.
6. PROVIDE THE APPROPRIATE GALVANIZED STRUCTURAL STEEL SUPPORTS FOR DISCONNECTS AND RECEPTACLES.

## ROOM LEGEND

| ROOM NO. | ROOM NAME |
|---|---|
| A–101 | PASSAGE |
| A–102 | TOILET/SHOWER |
| A–103 | COACH'S OFFICE |
| A–104 | JANITOR |
| A–105 | STORAGE |
| A–106 | GIRLS LOCKER RM |
| A–107 | PASSAGE |
| A–108 | RESTROOM |
| A–109 | SHOWER |
| A–110 | CONCESSIONS |
| A–111 | STORAGE |
| A–112 | STORAGE |
| A–113 | MEN |
| A–114 | WOMEN |
| A–115 | MECHANICAL |
| A–116 | STORAGE |
| A–117 | HOSPITALITY ROOM |
| A–118 | OFFICE |
| A–119 | TECHNOLOGY |
| A–120 | TRAINING |
| A–121 | TOILET |
| A–122 | TOILET |
| A–123 | WHIRLPOOL |
| A–124 | PASSAGE |
| A–125 | PASSAGE |
| A–126 | TOILET/SHOWER |
| A–127 | COACH'S OFFICE |
| A–128 | JANITOR |
| A–129 | STORAGE |
| A–130 | BOYS LOCKER RM |
| A–131 | RESTROOM |
| A–132 | PASSAGE |
| A–133 | SHOWER |

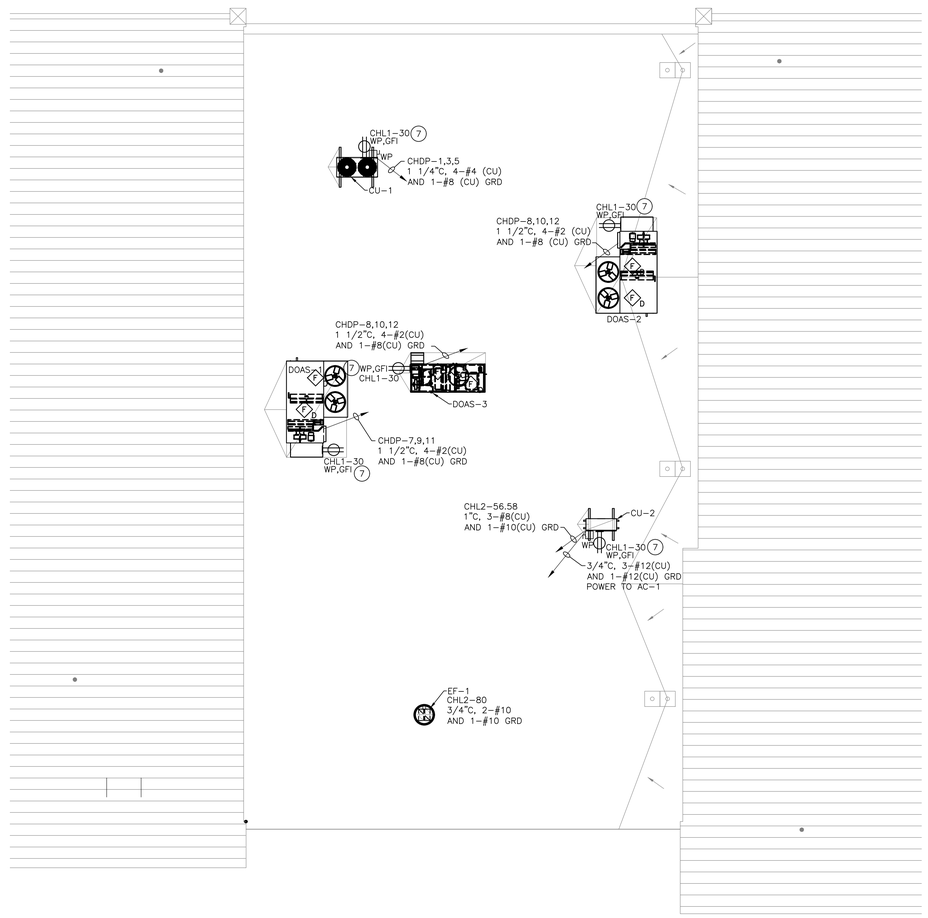


## ELECTRICAL ROOF PLAN

SCALE: 1/8" = 1'–0"

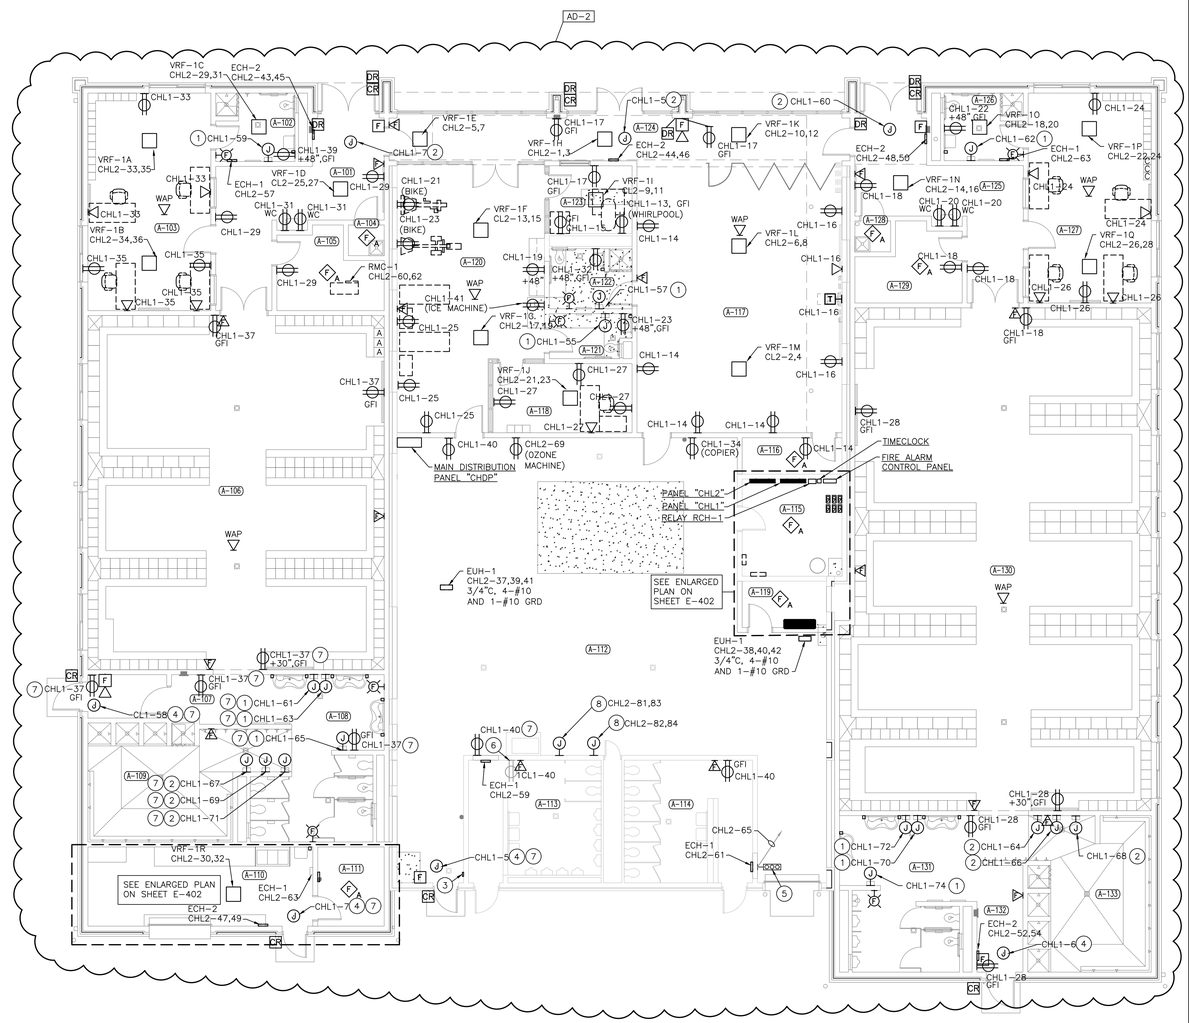


## ELECTRICAL POWER PLAN

SCALE: 1/8" = 1'–0"

GIBRALTAR DESIGN

ARCHITECTURE • ENGINEERING • INTERIOR DESIGN

PROJECT

# VALPARAISO HIGH SCHOOL WEST CAMPUS IMPROVEMENTS

VALPARAISO COMMUNITY SCHOOLS
VALPARAISO, INDIANA


GIBRALTAR DESIGN
9102 N. Meridian St., Ste. 300
Indianapolis, IN 46260
Homepage www.GibraltarDesign.com
Email info@GibraltarDesign.com
Phone 317.580.5777 Fax 317.580.5778


PROJECT 20–130
DATE 07/24/20
COORDINATED BY PCB
DRAWN BY PCB/JVC
CHECKED BY JPB

JOSEPH P. BRIGGS REGISTERED NO. 11600109 STATE OF INDIANA ARCHITECT


COPYRIGHT NOTICE:
THE CONCEPTS, DESIGNS, PLANS, DETAILS, ETC., SHOWN ON THIS DOCUMENT ARE THE PROPERTY OF GIBRALTAR DESIGN AND WERE CREATED FOR USE ON THIS SPECIFIC PROJECT. NONE OF THIS INFORMATION SHALL BE USED BY ANY PERSON OR FIRM FOR ANY OTHER PROJECT WITHOUT WRITTEN AUTHORIZATION OF GIBRALTAR DESIGN. THE OWNER MAY RETAIN COPIES FOR INFORMATION AND REFERENCE IN CONNECTION ONLY WITH THIS PROJECT.


REVISIONS

| MARK | DATE | ISSUED FOR |
|---|---|---|
| AD–1 | 08/03/20 | ADDENDUM NO. 1 |
| AD–2 | 08/07/20 | ADDENDUM NO. 2 |

DRAWING

CLEAT HOUSE ELECTRICAL POWER PLAN

PROJECT

VALPARAISO HIGH SCHOOL WEST CAMPUS IMPROVEMENTS

© GIBRALTAR DESIGN

SHEET

E–201


Friday, 8/7/2020 – 9:53 AM – LAST SAVED BY:PBROWN
Y:\20–130 VALPARAISO CS – VHS WEST CAMPUS IMPROVEMENTS\20–130 DRAWINGS\09 ELEC\E–201.DWG

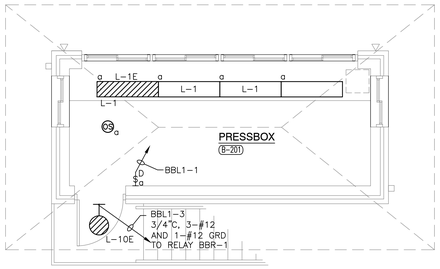


## BASEBALL FIELD PRESSBOX
## SECOND FLOOR ELECTRICAL LIGHTING PLAN

SCALE: 1/4" = 1'-0"

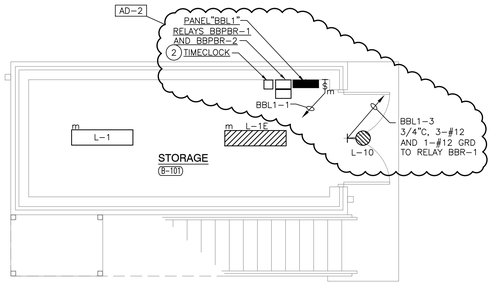


## BASEBALL FIELD PRESSBOX
## FIRST FLOOR ELECTRICAL LIGHTING PLAN

SCALE: 1/4" = 1'-0"

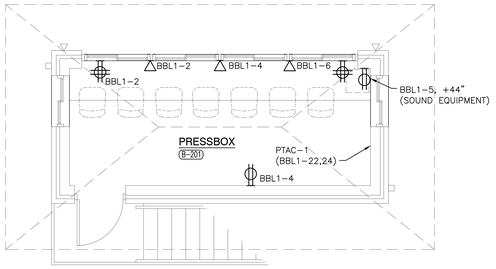


## BASEBALL FIELD PRESSBOX
## SECOND FLOOR ELECTRICAL POWER PLAN

SCALE: 1/4" = 1'-0"

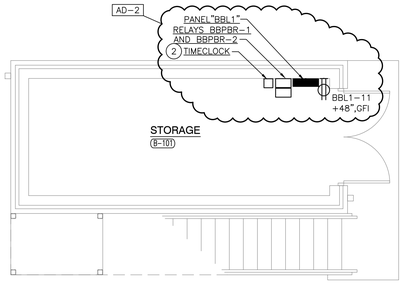


## BASEBALL FIELD PRESSBOX
## FIRST FLOOR ELECTRICAL POWER PLAN

SCALE: 1/4" = 1'-0"

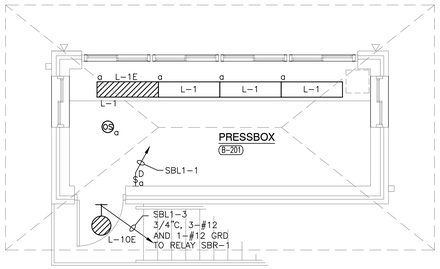


## SOFTBALL FIELD PRESSBOX
## SECOND FLOOR ELECTRICAL LIGHTING PLAN

SCALE: 1/4" = 1'-0"

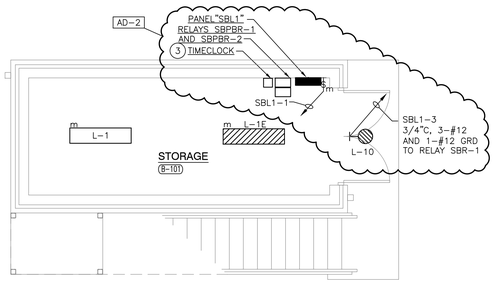


## SOFTBALL FIELD PRESSBOX
## FIRST FLOOR ELECTRICAL LIGHTING PLAN

SCALE: 1/4" = 1'-0"

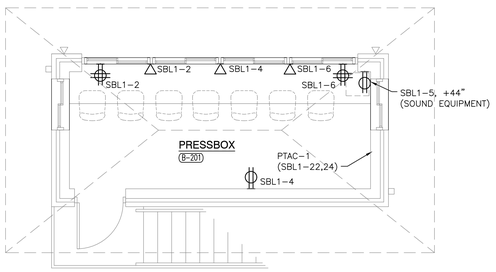


## SOFTBALL FIELD PRESSBOX
## SECOND FLOOR ELECTRICAL POWER PLAN

SCALE: 1/4" = 1'-0"

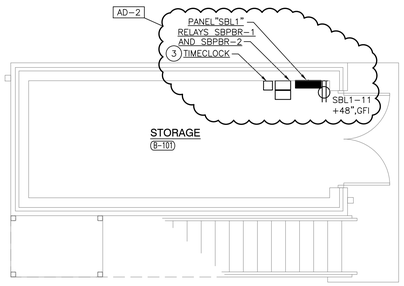


## SOFTBALL FIELD PRESSBOX
## FIRST FLOOR ELECTRICAL POWER PLAN

SCALE: 1/4" = 1'-0"

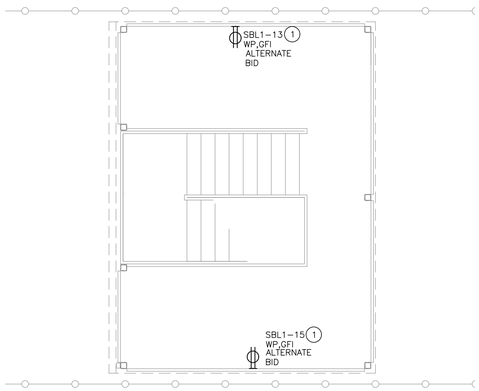


## TENNIS PLATFORM ELECTRICAL PLAN

SCALE: 1/4" = 1'-0"

## GENERAL NOTES:

1. FOR ADDITIONAL GENERAL ELECTRICAL NOTES, SEE GENERAL ELECTRICAL PROJECT NOTES ON SHEET E-001.
2. SEE E-600 SHEETS FOR ELECTRICAL DETAILS AND SCHEDULES.
3. SEE E-700 SHEETS FOR ELECTRICAL DISTRIBUTION DIAGRAMS.

## ELECTRICAL PLAN NOTES:

(ALL PLAN NOTES MAY NOT APPLY TO THIS SHEET.)

1. 1 1/4"C, 2-#6 AND 1-#10 GRD.
2. NSL/TORK DZS200BP TWO-CHANNEL DIGITAL TIMECLOCK. CHANNEL ONE CONTROLS RELAY BBR-1 (EXTERIOR LIGHTS) AND CHANNEL TWO CONTROLS RELAY BBR-2 (FLAG POLE LIGHTS). (BBL1-9).
3. NSL/TORK DZS200BP TWO-CHANNEL DIGITAL TIMECLOCK. CHANNEL ONE CONTROLS RELAY SBR-1 (EXTERIOR LIGHTS) AND CHANNEL TWO CONTROLS RELAY SBR-2 (FLAG POLE LIGHTS). (SBL1-9).

GIBRALTAR
DESIGN
ARCHITECTURE • ENGINEERING • INTERIOR DESIGN

PROJECT
VALPARAISO HIGH SCHOOL WEST CAMPUS IMPROVEMENTS
VALPARAISO COMMUNITY SCHOOLS
VALPARAISO, INDIANA


GIBRALTAR DESIGN
9102 N. Meridian St., Ste. 300
Indianapolis, IN 46260
Homepage www.GibraltarDesign.com
Email info@GibraltarDesign.com
Phone 317.580.5777 Fax 317.580.5778


PROJECT 20-130
DATE 07/24/20
COORDINATED BY PCB
DRAWN BY PCB/JVC
CHECKED BY JPB

JOSEPH P. BRIGGS REGISTERED NO. 11600109 STATE OF INDIANA ARCHITECT


COPYRIGHT NOTICE:
THE CONCEPTS, DESIGNS, PLANS, DETAILS, ETC., SHOWN ON THIS DOCUMENT ARE THE PROPERTY OF GIBRALTAR DESIGN AND WERE CREATED FOR USE ON THIS SPECIFIC PROJECT. NONE OF THIS INFORMATION SHALL BE USED BY ANY PERSON OR FIRM FOR ANY PURPOSE OTHER THAN THE PROJECT WITHOUT THE CONSENT OF GIBRALTAR DESIGN. THE OWNER MAY RETAIN COPIES FOR INFORMATION AND REFERENCE IN CONNECTION ONLY WITH THIS PROJECT.


REVISIONS

| MARK | DATE | ISSUED FOR |
|---|---|---|
| AD-2 | 08/07/20 | ADDENDUM NO. 2 |

DRAWING
ENLARGED ELECTRICAL PLANS OF PRESSBOXES AND TENNIS PLATFORM

PROJECT
VALPARAISO HIGH SCHOOL WEST CAMPUS IMPROVEMENTS

© GIBRALTAR DESIGN

SHEET
E-202


Friday, 8/7/2020 - 3:03 PM - LAST SAVED BY:JCHAMBERS
Y:\20-130 VALPARAISO CS - VHS WEST CAMPUS IMPROVEMENTS\20-130 DRAWINGS\09 ELEC\E-202.DWG

# VALPARAISO HIGH SCHOOL ATHLETIC FIELDS LIGHTING FIXTURE SCHEDULE

| TYPE | MANUFACTURERS | VOLTAGE | LIGHT SOURCE | MINIMUM LUMENS | DEGREE K. | MAXIMUM WATTAGE | DIMMING | MOUNTING | DESCRIPTION |
|---|---|---|---|---|---|---|---|---|---|
| BBL-1/B3 | MUSCO TLC-LED-1500 OR APPROVED EQUAL | 480 | LED | 136,000 LUMENS | 5700 | 1500 WATTS | | POLE | FOUR(4) LED TYPE LIGHTING FIXTURE MOUNTED ON CROSSARM AND 80 FOOT (ABOVE GROUND) POLE. |
| BBL-2/A3 | MUSCO TLC-LED-1500/MUSCO TLC-BT-575/MUSCO TLC-LED-900/MUSCO TLC-LED-1500 OR APPROVED EQUAL | 480 | LED | 136,000 LUMENS | 5700 | 1200 WATTS | | POLE | ONE 1200 WATT LED TYPE LIGHTING FIXTURE MOUNTED ON CROSSARM AT 80'-0" ABOVE GROUND, SIX (6) 1500 WATT LED LIGHTING FIXTURE MOUNTED ON CROSSARM AT +80'-0" ABOVE GROUND, ONE (1) 900 WATT LED LIGHTING FIXTURE MOUNTED ON CROSSARM AT +70'-0" ABOVE GROUND AND TWO (2) 575 WATT LED LIGHTING FIXTURE MOUNTED ON CROSSARM AT +15'-6" ABOVE GROUND ON 80'-0" (ABOVE GROUND) POLE. |
| BBL-3/A4 | MUSCO TLC-LED-1500/MUSCO TLC-BT-575/MUSCO TLC-LED-900/MUSCO TLC-LED-1500 OR APPROVED EQUAL | 480 | LED | 136,000 LUMENS | 5700 | 1200 WATTS | | POLE | ONE 1200 WATT LED TYPE LIGHTING FIXTURE MOUNTED ON CROSSARM AT 80'-0" ABOVE GROUND, SIX (6) 1500 WATT LED LIGHTING FIXTURE MOUNTED ON CROSSARM AT +80'-0" ABOVE GROUND, ONE (1) 900 WATT LED LIGHTING FIXTURE MOUNTED ON CROSSARM AT +70'-0" ABOVE GROUND AND TWO (2) 575 WATT LED LIGHTING FIXTURE MOUNTED ON CROSSARM AT +15'-6" ABOVE GROUND ON 80'-0" POLE (ABOVE GROUND). |
| BBL-4/B4 | MUSCO TLC-LED-1500/MUSCO TLC-BT-575/MUSCO TLC-LED-900/MUSCO TLC-LED-1500 OR APPROVED EQUAL | 480 | LED | 136,000 LUMENS | 5700 | 1200 WATTS | | POLE | ONE 1200 WATT LED TYPE LIGHTING FIXTURE MOUNTED ON CROSSARM AT 80'-0" ABOVE GROUND, SIX (6) 1500 WATT LED LIGHTING FIXTURE MOUNTED ON CROSSARM AT +80'-0" ABOVE GROUND, ONE (1) 900 WATT LED LIGHTING FIXTURE MOUNTED ON CROSSARM AT +70'-0" ABOVE GROUND AND TWO (2) 575 WATT LED LIGHTING FIXTURE MOUNTED ON CROSSARM AT +15'-6" ABOVE GROUND ON 80'-0" POLE (ABOVE GROUND). |
| BBL-5/C-2 | MUSCO TLC-LED-1200/MUSCO TLC-BT-575/MUSCO TLC-LED-900 OR APPROVED EQUAL | 480 | LED | 136,000 LUMENS | 5700 | 1200 WATTS | | POLE | TWO (2) 1200 WATT LED TYPE LIGHTING FIXTURE MOUNTED ON CROSSARM AT 70'-0" ABOVE GROUND, ONE (1) 900 WATT LED LIGHTING FIXTURE MOUNTED ON CROSSARM AT +70'-0" ABOVE GROUND AND ONE (1) 575 WATT LED LIGHTING FIXTURE MOUNTED ON CROSSARM AT +15'-6" ABOVE GROUND ON 70'-0" ABOVE GROUND POLE. |
| BBL-6/D-1 | MUSCO TLC-LED-1200/MUSCO TLC-BT-575/MUSCO TLC-LED-900 OR APPROVED EQUAL | 480 | LED | 136,000 LUMENS | 5700 | 1200 WATTS | | POLE | THREE (3) 1200 WATT LED TYPE LIGHTING FIXTURE MOUNTED ON CROSSARM AT 70'-0" ABOVE GROUND, ONE (1) 900 WATT LED LIGHTING FIXTURE MOUNTED ON CROSSARM AT +70'-0" ABOVE GROUND AND ONE (1) 575 WATT LED LIGHTING FIXTURE MOUNTED ON CROSSARM AT +15'-6" ABOVE GROUND ON 70'-0" ABOVE GROUND POLE. |
| BBL-7/D-2 | MUSCO TLC-LED-1200/MUSCO TLC-BT-575/MUSCO TLC-LED-900 OR APPROVED EQUAL | 480 | LED | 136,000 LUMENS | 5700 | 1200 WATTS | | POLE | THREE (3) 1200 WATT LED TYPE LIGHTING FIXTURE MOUNTED ON CROSSARM AT 70'-0" ABOVE GROUND, ONE (1) 900 WATT LED LIGHTING FIXTURE MOUNTED ON CROSSARM AT +70'-0" ABOVE GROUND AND ONE (1) 575 WATT LED LIGHTING FIXTURE MOUNTED ON CROSSARM AT +15'-6" ABOVE GROUND ON 70'-0" ABOVE GROUND POLE. |
| BBL-8/C-1 | MUSCO TLC-LED-1200/MUSCO TLC-BT-575/MUSCO TLC-LED-900 OR APPROVED EQUAL | 480 | LED | 136,000 LUMENS | 5700 | 1200 WATTS | | POLE | TWO (2) 1200 WATT LED TYPE LIGHTING FIXTURE MOUNTED ON CROSSARM AT 70'-0" ABOVE GROUND, ONE (1) 900 WATT LED LIGHTING FIXTURE MOUNTED ON CROSSARM AT +70'-0" ABOVE GROUND AND ONE (1) 575 WATT LED LIGHTING FIXTURE MOUNTED ON CROSSARM AT +15'-6" ABOVE GROUND ON 70'-0" ABOVE GROUND POLE. |
| SBL-1/B1 | MUSCO TLC-LED-1500/MUSCO TLC-BT-575/MUSCO TLC-LED-1500 OR APPROVED EQUAL | 480 | LED | 136,000 LUMENS | 5700 | 1200 WATTS | | POLE | ONE (1) 1500 WATT LED TYPE LIGHTING FIXTURE MOUNTED ON CROSSARM AT 70'-0" ABOVE GROUND, SIX (6) 1200 WATT LED LIGHTING FIXTURE MOUNTED ON CROSSARM AT +70'-0" ABOVE GROUND AND ONE (1) 575 WATT LED LIGHTING FIXTURE MOUNTED ON CROSSARM AT +15'-6" ABOVE GROUND ON 70'-0" (ABOVE GROUND) POLE. |
| SBL-2/A1 | MUSCO TLC-LED-1500/MUSCO TLC-BT-575/MUSCO TLC-LED-1500 OR APPROVED EQUAL | 480 | LED | 136,000 LUMENS | 5700 | 1200 WATTS | | POLE | ONE (1) 1500 WATT LED TYPE LIGHTING FIXTURE MOUNTED ON CROSSARM AT 70'-0" ABOVE GROUND, THREE (3) 900 WATT LED LIGHTING FIXTURE MOUNTED ON CROSSARM AT +70'-0" ABOVE GROUND AND ONE (1) 575 WATT LED LIGHTING FIXTURE MOUNTED ON CROSSARM AT +15'-6" ABOVE GROUND ON 70'-0" (ABOVE GROUND) POLE. |
| SBL-3/A2 | MUSCO TLC-LED-1500/MUSCO TLC-BT-575/MUSCO TLC-LED-1500 OR APPROVED EQUAL | 480 | LED | 136,000 LUMENS | 5700 | 1200 WATTS | | POLE | ONE (1) 1500 WATT LED TYPE LIGHTING FIXTURE MOUNTED ON CROSSARM AT 80'-0" ABOVE GROUND, THREE (3) 900 WATT LED LIGHTING FIXTURE MOUNTED ON CROSSARM AT +80'-0" ABOVE GROUND AND ONE (1) 575 WATT LED LIGHTING FIXTURE MOUNTED ON CROSSARM AT +15'-6" ABOVE GROUND ON 80'-0" (ABOVE GROUND) POLE. |
| SBL-4/B2 | MUSCO TLC-LED-1500/MUSCO TLC-BT-575/MUSCO TLC-LED-1500 OR APPROVED EQUAL | 480 | LED | 136,000 LUMENS | 5700 | 1200 WATTS | | POLE | TWO (2) 1500 WATT LED TYPE LIGHTING FIXTURE MOUNTED ON CROSSARM AT 70'-0" ABOVE GROUND, THREE (3) 1200 WATT LED LIGHTING FIXTURE MOUNTED ON CROSSARM AT +70'-0" ABOVE GROUND AND ONE (1) 575 WATT LED LIGHTING FIXTURE MOUNTED ON CROSSARM AT +15'-6" ABOVE GROUND ON 70'-0" (ABOVE GROUND) POLE. |
| FFL-1/C3 AD-2 | MUSCO TLC-LED-1500/MUSCO TLC-BT-575/MUSCO TLC-LED-1500 OR APPROVED EQUAL | 480 | LED | 136,000 LUMENS | 5700 | 1200 WATTS | | POLE | FOUR (4) 1200 WATT LED TYPE LIGHTING FIXTURE MOUNTED ON CROSSARM AT 70'-0" ABOVE GROUND AND ONE (1) 575 WATT LED LIGHTING FIXTURE MOUNTED ON CROSSARM AT +15'-6" ABOVE GROUND ON 70'-0" (ABOVE GROUND) POLE. |

NOTE: ANY SUBMITTED EQUALS MUST INLCUDE DATA SHEETS, FULL SIZE DRAWINGS SHOWING FOOTCANDLES AND ALL APPROPRIATE INFORMATION SHOWING COMPLIANCE WITH DESIGN CRITERIA AND BE SUBMITTED AND APPROVED PRIOR TO BIDDING.

# VALAPARISO HIGH SCHOOL WEST CAMPUS LIGHTING FIXTURE SCHEDULE

| TYPE | MANUFACTURERS | VOLTAGE | LIGHT SOURCE | MINIMUM LUMENS | DEGREE K. | MAXIMUM WATTAGE | DIMMING | MOUNTING | DESCRIPTION |
|---|---|---|---|---|---|---|---|---|---|
| L-1 | METALUX SNLED-LD1-28-LW<br>COLUMBIA MPS4-40-VW-C-W-E-U-PAF<br>LITHONIA ZL1D-L48-5000LM-FST-MVOLT-40K-80CRI | 120/277 | LED | 2800 | 4000 | 33 | NONE | PENDANT | 4' PENDANT MOUNTED INDUSTRIAL LIGHTING FIXTURE WITH LENSED AND WIDE DISTRIBUTION |
| L-1E | METALUX SNLED-LD1-28-LW-EL14WSD<br>COLUMBIA MPS4-40-VW-C-W-E-U-PAF-ELL14<br>LITHONIA ZL1D-L48-5000LM-FST-MVOLT-40K-80CRI-EL14SLSD | 120/277 | LED | 2800 | 4000 | 33 | NONE | PENDANT | 4' PENDANT MOUNTED INDUSTRIAL LIGHTING FIXTURE WITH LENSED, WIDE DISTRIBUTION AND INTEGRAL EMERGENCY BATTERY UNIT WITH SELF - DIAGNOSTIC FEATURE. |
| L-2 | METALUX 24CZ-LD5-40S-UNV-L840-CD1-EQ-CLIP-PAF<br>COLUMBIA LCAT4-40LWG-ED1-U-EQCLIP-PAF<br>LITHONIA 2BLTBA4-40L-ADP-EZ1-LP840-EQCLIP-PAF | MVOLT | LED | 4000 (4124/ 4465/4009) | 4000 | 29/36/ 34 | 0-10V | GRID | 2X4 RECESSED GRID MOUNTED DIRECT/INDIRECT LED TYPE LIGHTING FIXTURE WITH EARTHQUAKE CLIPS AND MULTI-VOLT LED DIMMING DRIVER. (0-10V DIMMING DRIVER -1%-100% DIMMING). |
| L-2E | METALUX 24CZ-LD5-40S-UNV-L840-CD1-EQ-CLIP-PAF-EL14WSD<br>COLUMBIA LCAT4-40LWG-ED1-U-EQCLIP-PAF-ELL14SD<br>LITHONIA 2BLTBA4-40L-ADP-EZ1-LP840-EQCLIP-PAF-EL14SLSD | MVOLT | LED | 4000 (4124/ 4465/4009) | 4000 | 29/36/ 34/XX | 0-10V | GRID | 2X4 RECESSED GRID MOUNTED DIRECT/INDIRECT LED TYPE LIGHTING FIXTURE WITH EARTHQUAKE CLIPS, ACRYLIC LENS (0.125 MINIMUM THICKNESS). MULTI-VOLT LED DIMMING DRIVER AND INTEGRAL EMERGENCY BATTERY UNIT WITH SELF-DIAGNOSTIC FEATURE. (0-10V DIMMING DRIVER -1%-100% DIMMING) |
| L-3 | METALUX 24GR-LD5-30-A125-CD1-PAF-EQ-CLIP-U-PAF<br>COLUMBIA LJT24-40VWG-FSA12125-EDU-EQCLIP-PAF<br>LITHONIA 2GTL-4-30L-A12125-EZ1-LP840-EQCLIP-PAF | MVOLT | LED | 3000 (3074/ 3495/ 3102) | 4000 | 23.4/27/ 32.02/XX | 0-10V | GRID | 2X4 RECESSED GRID MOUNTED LED LENS TROFFER TYPE LIGHTING FIXTURE WITH EARTHQUAKE CLIPS, ACRYLIC LENS (0.125 MINIMUM THICKNESS) AND MULTI-VOLT LED DIMMING DRIVER. (0-10V DIMMING DRIVER -1%-100% DIMMING) |
| L-3E | METALUX 24GR-LD5-30-A125-UNV-L840-CD1-PAF-EQ-CLIP-U-EL14WSD<br>COLUMBIA LJT24-40VWG-FSA12125-EU-PAF-EQCLIP-ELL14SD<br>LITHONIA 2GTL-4-30L-A12125-EZ1-LP840-LATC-PAF-EL14LSD | 120/277 | LED | 3000 (3074/ 3495/ 3102) | 4000 | 23.4/27/ 32.02/XX | 0-10V | GRID | 2X4 RECESSED GRID MOUNTED LED LENS TROFFER TYPE LIGHTING FIXTURE WITH EARTHQUAKE CLIPS, ACRYLIC LENS (0.125 MINIMUM THICKNESS). MULTI-VOLT LED DIMMING DRIVER AND INTEGRAL EMERGENCY BATTERY UNIT WITH SELF-DIAGNOSTIC FEATURE. (0-10V DIMMING DRIVER -1%-100% DIMMING) |
| L-4 | METALUX 14GR-LD5-43-A125-HCD1-PAF-DF-14-WU<br>COLUMBIA LJT24-40LWG-FSA12125-EDU-FK24<br>LITHONIA GTL-4-40L-EZ1-LP840-LATC-DGA14 | MVOLT | LED | 4800 | 4000 | 42 | NONE | RECESSED FLANGE | 1X4 RECESSED MOUNTED FLANGED LED LENS TROFFER TYPE LIGHTING FIXTURE WITH ACRYLIC LENS (0.125 MINIMUM THICKNESS) AND MULTI-VOLT LED DRIVER. |
| L-4E | METALUX 14GR-LD5-43-A125-HCD1-PAF-DF-14-WU-EL14W<br>COLUMBIA LJT24-40LWG-FSA12125-EDU-FK24-ELL14<br>LITHONIA GTL-4-40L-EZ1-LP840-LATC-DGA14-PAF-EL14L | MVOLT | LED | 4800 | 4000 | 42 | NONE | RECESSED FLANGE | 1X4 RECESSED MOUNTED FLANGED LED LENS TROFFER TYPE LIGHTING FIXTURE WITH ACRYLIC LENS (0.125 MINIMUM THICKNESS), MULTI-VOLT LED DRIVER AND INTEGRAL BATTERY UNIT WITH SELF DIAGNOSTICS UNIT. |
| L-5 | METALUX 24CZ-LD5-60S-UNV-L840-CD1-EQ-CLIP-PAF<br>COLUMBIA LCAT24-40VL-G-ED1-U-EQCLIP-PAF<br>LITHONIA 2BLTBA4-60L-ADP-EZ1-LP840-EQCLIP-PAF | MVOLT | LED | 6000 (6221/7321 /6112) | 4000 | 52.2/59/ 47.59 | 0-10V | GRID | 2X4 RECESSED GRID MOUNTED DIRECT/INDIRECT LED TYPE LIGHTING FIXTURE WITH EARTHQUAKE CLIPS AND MULTI-VOLT LED DIMMING DRIVER. (0-10V DIMMING DRIVER -1%-100% DIMMING). |
| L-5E | METALUX 24CZ-LD5-60S-UNV-L840-CD1-EQ-CLIP-PAF-EL14WSD<br>COLUMBIA LCAT24-40HL-SM-FS-A12125-ED1-U-PAF-ELL14SD<br>LITHONIA 2BLTBA4-60L-ADP-EZ1-LP840-EQCLIP-PAF-EL14SLSD | MVOLT | LED | 6000 (6221/7321 /6112) | 4000 | 52.2/44/ 47.59 | 0-10V | GRID | 2X4 RECESSED GRID MOUNTED DIRECT/IDIRECT LED TYPE LIGHTING FIXTURE WITH EARTHQUAKE CLIPS, ACRYLIC LENS (0.125 MINIMUM THICKNESS). MULTI-VOLT LED DRIVER AND INTEGRAL EMERGENCY BATTERY UNIT WITH SELF-DIAGNOSTIC FEATURE. (0-10V DIMMING DRIVER -1%-100% DIMMING) |
| L-6 | METALUX 4WSL-LD2-50-SPS-UNV-L850-CD1<br>LITHONIA GRD-LSL-4-MSL4-80CRI-40K-ID1500LMF-0/100-MIN1-ZT-120-SCT | MVOLT | LED | 4900 (4988/ 5067) | 4000 | 44.8/40 | 0-10V | PENDANT | 1X4 PENDANT MOUNTED LED LIGHTING FIXTURE WITH MULTI-VOLT LED DIMMING DRIVER. (0-10V DIMMING DRIVER -1%-100% DIMMING) |
| L-6E | METALUX 4WSL-LD2-50-SPS-UNV-L850-CD1-EL14W<br>LITHONIA GRD-LSL-4-MSL4-80CRI-40K-ID1500LMF-0/100-MIN1-ZT-120-SCT-E10WLCP | MVOLT | LED | 4900 (4988/ 5067) | 4000 | 44.8/40 | 0-10V | PENDANT | 1X4 PENDANT MOUNTED LED LIGHTING FIXTURE WITH MULTI-VOLT LED DIMMING DRIVER AND INTEGAL EMERGENCY BATTERY UNIT WITH SELF-DIAGNOSTIC FEATURE. (0-10V DIMMING DRIVER -1%-100% DIMMING) |
| L-7 | METALUX 14GR-LD5-40-A125-UNV-L840-CD1-PAF-EQ-CLIP-U<br>COLUMBIA LJT14-40MWG-FSA12125-EU-PAF-EQCLIP<br>LITHONIA GTL-4-40L-A12125-EZ1-LP840-LATC-PAF | 120/277 | LED | 4000 (4045/ 4222/ 3938.5) | 4000 | 38.8/38/ 40.1 | NONE | GRID | 1X4 RECESSED GRID MOUNTED LED LENS TROFFER TYPE LIGHTING FIXTURE WITH EARTHQUAKE CLIPS, ACRYLIC LENS (0.125 MINIMUM THICKNESS) AND MULTI-VOLT LED DRIVER. |
| L-7E | METALUX 14GR-LD5-40-A125-UNV-L840-CD1-PAF-EQ-CLIP-U-EL14WSD<br>COLUMBIA LJT14-40MWG-FSA12125-EU-PAF-EQCLIP-ELL14SD<br>LITHONIA GTL-4-33L-A12125-EZ1-LP840-LATC-PAF-EL14LSD | 120/277 | LED | 4000 (4045/ 4222/ 3938.5) | 4000 | 38.8/38/ 40.1 | NONE | GRID | 1X4 RECESSED GRID MOUNTED LED LENS TROFFER TYPE LIGHTING FIXTURE WITH EARTHQUAKE CLIPS, ACRYLIC LENS (0.125 MINIMUM THICKNESS). MULTI-VOLT LED DRIVER AND INTEGRAL EMERGENCY BATTERY UNIT WITH SELF-DIAGNOSTIC FEATURE. |
| L-8 | FAIL SAFE GRW-12-4-FA-LD4-64-40-A12125-UNV-EDC1<br>COLUMBIA LJT14-40MLG-FSA12125-EDU-FK14 -WL<br>LITHONIA | MVOLT | LED | 5322 | 4000 | 42 | NONE | RECESSED FLANGE | 1X4 RECESSED MOUNTED FLANGED CHASSIS, LED LAMPS, FRAMED LENS, WET LOCATION TROFFER TYPE LIGHTING FIXTURE WITH ACRYLIC LENS (0.125 MINIMUM THICKNESS) AND MULTI-VOLT LED DRIVER. UL LISTED FOR WET LOCATIONS. |
| L-8E | FAIL SAFE GRW-12-4-FA-LD4-64-40-A12125-UNV-EDC1-EL14WSD<br>COLUMBIA LJT14-40MLG-FSA12125-EDU-FK14 -WL<br>LITHONIA | MVOLT | LED | 5322 | 4000 | 42 | NONE | RECESSED FLANGE | 1X4 RECESSED MOUNTED FLANGED CHASSIS, LED LAMPS, FRAMED LENS, WET LOCATION TROFFER TYPE LIGHTING FIXTURE WITH ACRYLIC LENS (0.125 MINIMUM THICKNESS) AND MULTI-VOLT LED DRIVER. UL LISTED FOR WET LOCATIONS. |
| L-9 | METALUX 4VT2-LD4-6000-DR-UNV-L840-SSL<br>COLUMBIA LCL4-40ML-EDU-PAF<br>LITHONIA DWW2XXXXXXXXXXXXXX | MVOLT | LED | 5000 | 4000 | 42 | NONE | PENDANT | 4' PENDANT MOUNTED VAPORTIGHT TYPE LIGHTING FIXTURE WITH FIBERGLASS BODY AND MULTI-VOLT LED DRIVER. |
| L-9E | METALUX 4VT2-LD4-6000-DR-UNV-L840-SSL-EMSD<br>COLUMBIA LCL4-40ML-EDU-PAF-EMSD<br>LITHONIA DWW2XXXXXXXXXXXXXX | MVOLT | LED | 5000 | 4000 | 42 | NONE | PENDANT | 4' PENDANT MOUNTED VAPORTIGHT TYPE LIGHTING FIXTURE WITH FIBERGLASS BODY, MULTI-VOLT LED DRIVER AND INTEGRAL EMERGENCY BATTERY UNIT WITH SELF DIAGNOSTICS FEATURE. |
| L-10 | LITHONIA WSQ LED-P3-40K-MVOLT-DDBXD<br>MCGRAW EDISON ISS-AF-600-LED-E1-T3-BZ | 120/277 | LED | 6000/8375 | 4000 | 50/66 | NONE | WALL | WALL MOUNTED OUTDOOR WEATHERPROOF QUARTER SPHERE CUTOFF TYPE LIGHTING FIXTURE WITH LED LAMPS AND LED DRIVER. UL LISTED FOR WET LOCATIONS. COLOR TO BE SELECTED BY THE ARCHITECT. |
| L-10E | LITHONIA WSQ LED-P3-40K-MVOLT-E20WC-DDBXD<br>MCGRAW EDISON ISS-AF-600-LED-E1-T3-BZ-CWB | 120/277 | LED | 6000/8375 | 4000 | 50/66 | NONE | WALL | WALL MOUNTED OUTDOOR WEATHERPROOF QUARTER SPHERE CUTOFF TYPE LIGHTING FIXTURE WITH LED LAMPS, LED DRIVER AND COLD WEATHER EMRGENCY BATTERY PACK. UL LISTED FOR WET LOCATIONS. COLOR TO BE SELECTED BY THE ARCHITECT. |
| L-11 | HALO PD6-30-D010-PDM6A-840-61V-C<br>LITHONIA LDN6-40/30-L06AR-LSS-MVOLT-EZ10 | MVOLT | LED | 2963/ 3033.9 | 4000 | 36.4/34.69 | 0-10V | RECESSED | 6" ROUND RECESSED MOUNTED DOWNLIGHT WITH CLEAR ALZAK REFLECTOR AND MULTI-VOLT LED DIMMING DRIVER. UL LISTED FOR DAMP LOCATIONS. FIXTURE SHALL BE IC RATED. |
| L-11E | HALO PD6-30-D010-PDM6A-840-61V-C-EM<br>LITHONIA LDN6-40/30-L06AR-LSS-MVOLT-EZ10-ELRSD | MVOLT | LED | 2963/ 3033.9 | 4000 | 36.4/34.69 | 0-10V | RECESSED | 6" ROUND RECESSED MOUNTED DOWNLIGHT WITH CLEAR ALZAK REFLECTOR, MULTI-VOLT LED DIMMING DRIVER AND INTEGRAL BATTERY UNIT WITH SELF DIAGNOSTIC FEATURE. UL LISTED FOR DAMP LOCATIONS. FIXTURE SHALL BE IC RATED. |
| AD-2 L-12 | ANP LIGHTING LA062-POST-FR-P046LD4-X-T5-40K--CM | MVOLT | LED | 5197 | 4000 | 46 | 0-10V | POST TOP | DECORATIVE LED TYPE FIXTURE COLUMN MOUNTED ON CONCRETE PIERS, LED LAMPS AND MULTI-VOLT LED DRIVER. UL LISTED FOR WET LOCATIONS. |
| L-13 | METALUX 14GR-LD5-43-A125-HCD1-PAF-DF-14-WU<br>COLUMBIA LJT24-40LWG-FSA12125-EDU-FK24<br>LITHONIA GTL-4-40L-EZ1-LP840-LATC-DGA14 | MVOLT | LED | 4800 | 4000 | 42 | NONE | RECESSED FLANGE | 1X4 RECESSED MOUNTED FLANGED LED LENS TROFFER TYPE LIGHTING FIXTURE WITH ACRYLIC LENS (0.125 MINIMUM THICKNESS) AND MULTI-VOLT LED DIMMING DRIVER. (0-10V DIMMING DRIVER -1%-100% DIMMING) |
| L-14 | VISTA 1188-Z-MF-40-C-MV-AX-ND-B34<br>HYDREL M9720C-SS-LED-P2-40K-MVOLT-MFL-FLCSAS-345-DNA | MVOLT | LED | 2718/3537 | 4000 | 35.8/35 | NONE | IN-GROUND | FLUSH IN-GROUND MOUNTED FLOOD LIGHT WITH ANTI-SLIP CLEAR LENS AND MULTI-VOLT LED DIMMING NON-DIMMED DRIVER |
| X1 | SURE-LITES LPX6-R<br>DUAL LITE SESRW<br>LITHONIA LESW1R | 120/277 | LED | | | 1 | NONE | | SURFACE MOUNTED WHITE DIE CAST ALUMINUM EXIT SIGN WITH SINGLE STENCIL FACE AND RED LETTERS (ARROWS AS INDICATED ON DRAWINGS) AND NI-CAD BATTERY. |

GIBRALTAR DESIGN
ARCHITECTURE • ENGINEERING • INTERIOR DESIGN

PROJECT
VALPARAISO HIGH SCHOOL WEST CAMPUS IMPROVEMENTS
VALPARAISO COMMUNITY SCHOOLS
VALPARAISO, INDIANA

GIBRALTAR DESIGN
9102 N. Meridian St., Ste. 300
Indianapolis, IN 46260
Homepage www.GibraltarDesign.com
Email info@GibraltarDesign.com
Phone 317.580.5777 Fax 317.580.5778

PROJECT 20-130
DATE 07/24/20
COORDINATED BY PCB
DRAWN BY PCB/JVC
CHECKED BY JPB

JOSEPH P. BRIGGS REGISTERED NO. 11600109 STATE OF INDIANA ARCHITECT

COPYRIGHT NOTICE:
THE CONCEPTS, DESIGNS, PLANS, DETAILS, ETC., SHOWN ON THIS DOCUMENT ARE THE PROPERTY OF GIBRALTAR DESIGN AND WERE CREATED FOR USE ON THIS SPECIFIC PROJECT. NONE OF THIS INFORMATION SHALL BE USED BY ANY PERSON OR FIRM FOR ANY PURPOSE WITHOUT THE EXPRESS WRITTEN CONSENT OF GIBRALTAR DESIGN. THE OWNER MAY RETAIN COPIES FOR INFORMATION AND REFERENCE IN CONNECTION ONLY WITH THIS PROJECT.

REVISIONS

| MARK | DATE | ISSUED FOR |
|---|---|---|
| AD-2 | 08/07/20 | ADDENDUM NO. 2 |

DRAWING
ELECTRICAL SCHEDULES

PROJECT
VALPARAISO HIGH SCHOOL WEST CAMPUS IMPROVEMENTS

© GIBRALTAR DESIGN

SHEET
E-601

Friday, 8/7/2020 - 3:10 PM - LAST SAVED BY:PBROWN
Y:\20-130 VALPARAISO CS - VHS WEST CAMPUS IMPROVEMENTS\20-130 DRAWINGS\09 ELEC\E-601.DWG