

# ADDENDUM NO. 1

**March 18, 2022**

**WESTCHESTER INTERMEDIATE SCHOOL ADDITIONS  
AND RENOVATIONS  
Chesterton, IN 46304**

**TO: ALL BIDDERS OF RECORD**

This Addendum forms a part of and modifies the Bidding Requirements, Contract Forms, Contract Conditions, the Specifications, and the Drawings dated March 1, 2022 by Gibraltar Design. Acknowledge receipt of the Addendum in the space provided on the Bid Form. Failure to do so may subject the Bidder to disqualification.

This Addendum consists of Pages ADD 1-1 through ADD 1-4 and attached Addendum No. 1 from Gibraltar Design dated March 16, 2022 and consisting of 4 pages, Specification Section 08 71 00 - Door Hardware, and 48 drawings.

**A. SPECIFICATION SECTION 00 00 20 - TABLE OF CONTENTS**

**1. Add:**

- a. Specification Section 08 71 00 Door Hardware

**B. SPECIFICATION SECTION 00 31 00 - BID FORM**

**1. Replace:**

- a. Specification Section 00 31 00 - Bid Form with the attached revised section.

C. **SPECIFICATION SECTION 01 12 00 - MULTIPLE CONTRACT SUMMARY**

3.02 General Requirements:

1. **PROVIDED BY ALL CONTRACTORS AS APPLICABLE**

a. **Replace:**

Specification Section 01 52 60 Rubbish Container in its entirety.

D. **BID CATEGORY NO. 1 - GENERAL TRADES**

1. **Delete:**

- a. Specification Section 05 40 00 Cold Formed Metal Framing in its entirety.

2. **Delete:**

- a. Specification Section 10 26 00 Wall Protection in its entirety.

3. **Add:**

- a. Specification Section 08 71 00 Door Hardware

4. **Revise:**

a. Clarification No. 13:

The **Bid Category No. 2 Contractor** is responsible for cutting in openings (include demolition and removal) in existing masonry walls where mechanical openings or louvers require a steel lintel; this work shall be coordinated with the **Bid Category No. 2 Contractor**. Also include patch and repair of the masonry to match adjacent masonry. Coordinate all work with the **Bid Category No. 12 Contractor**.

5. **Add:**

a. Clarification No. 27:

The **Bid Category No. 1 Contractor** is responsible to provide full protection of the existing terrazzo flooring in the Corridors with a layer of Rosin Paper under a Masonite Board or equal for the duration of each phase. Reference the Guideline Schedule/Phasing plan for these dates. At the end of each phase, and at the direction of the Construction Manager, the **Bid Category No. 1 Contractor** shall fully remove the floor protection and thoroughly clean the terrazzo flooring.

## **E. BID CATEGORY NO. 2 - MASONRY**

### **1. Revise:**

#### **a. Clarification No. 4:**

The **Bid Category No. 2 Contractor** is responsible for cutting in openings (include demolition and removal) in existing masonry walls where mechanical openings or louvers require a steel lintel. Also include patch and repair of the masonry to match adjacent masonry. Coordinate all work with the **Bid Category No. 12 Contractor**.

### **2. Revise:**

#### **a. Clarification No. 6:**

Regarding Specification Section 07 21 27 Enclosed Cavity Foam Insulation, and Specification Section 07 72 31 Air Infiltration Barrier; the **Bid Category No. 2 Contractor** shall provide all Foam Insulation attached to or within the masonry walls. The **Bid Category No. 5 Contractor** shall provide all Foam Insulation attached to or within the metal stud walls system. The **Bid Category No. 3 Contractor** shall provide all other Foam Insulation included in this section.

## **F. BID CATEGORY NO. 3 - ROOFING/METAL COMPOSITES**

### **1. Delete:**

#### **a. Clarification No. 3:**

The **Bid Category No. 1 Contractor** is responsible for cutting in openings (include demolition and removal) in existing masonry walls where mechanical openings or louvers require a steel lintel; this work shall be coordinated with the **Bid Category No. 3 Contractor**. Also include patch and repair of the masonry to match adjacent masonry. Coordinate all work with the **Bid Category No. 12 Contractor**.

### **2. Revise:**

#### **a. Clarification No. 4:**

Regarding Specification Section 07 21 27 Enclosed Cavity Foam Insulation, and Specification Section 07 72 31 Air Infiltration Barrier; the **Bid Category No. 2 Contractor** shall provide all Foam Insulation attached to or within the masonry walls. The **Bid Category No. 5 Contractor** shall provide all Foam Insulation attached to or within the metal stud walls system. The **Bid Category No. 3 Contractor** shall provide all other Foam Insulation included in this section.

**G. BID CATEGORY NO. 4 - ALUMINUM ENTRANCES AND GLAZING**

**1. Add:**

- a. Specification Section 08 71 00 Door Hardware

**H. BID CATEGORY NO. 5 - METAL STUDS/DRYWALL AND ACOUSTICS**

**1. Add:**

- a. Specification Section 05 40 00 Cold Formed Metal Framing in its entirety.

**2. Add:**

- a. Specification Section 10 26 00 Wall Protection in its entirety.

**I. BID CATEGORY NO. 12 -HVAC**

**1. Revise:**

a. Clarification No. 4:

The **Bid Category No. 2 Contractor** is responsible for cutting in openings (include demolition and removal) in existing masonry walls where mechanical openings or louvers require a steel lintel; this work shall be coordinated with the **Bid Category No. 2 Contractor**. Also include patch and repair of the masonry to match adjacent masonry. Coordinate all work with the **Bid Category No. 12 Contractor**.

**J. SPECIFICATION SECTION 01 23 00 - ALTERNATES**

**1. Replace:**

- a. Specification Section 01 23 00 Alternates with the attached revised section

**K. SPECIFICATION SECTION 01 32 00 - SCHEDULES AND REPORTS**

**1. Add:**

- a. Attached Guideline Schedule and Phasing Plans



CONTRACTOR'S BID FOR PUBLIC WORKS FORM NO. 96

Format (Revised 2013)  
(Amended for DSC)

**Westchester Intermediate School**  
**Additions and Renovations**  
Duneland School Corporation  
Chesterton, IN

**PART I**

(To be completed for all bids. Please type or print)

Date (month, day, year): \_\_\_\_\_

BIDDER (Firm) \_\_\_\_\_

Address \_\_\_\_\_ P.O. Box \_\_\_\_\_

City/State/Zip \_\_\_\_\_

Telephone Number: \_\_\_\_\_ Email Address: \_\_\_\_\_

Person to contact regarding this Bid \_\_\_\_\_

Pursuant to notices given, the undersigned offers to furnish labor and/or materials necessary to complete the public works project of:

\_\_\_\_\_  
Insert Category No. (s) and Name(s)

Of public works project, ***Westchester Intermediate School Additions and Renovations***, in accordance with Plans and Specifications prepared by ***Gibraltar Design, 9102 N. Meridian St., Ste. #300, Indianapolis, IN 46260***, as follows:

BASE BID

For the sum of \_\_\_\_\_  
(Sum in words)

\_\_\_\_\_ DOLLARS (\$ \_\_\_\_\_)  
(Sum in figures)

The undersigned acknowledges receipt of the following Addenda:

Receipt of Addenda No. (s) \_\_\_\_\_

**PROPOSAL TIME**

Bidder agrees that this Bid shall remain in force for a period of sixty (60) consecutive calendar days from the due date, and Bids may be accepted or rejected during this period. Bids not accepted within said sixty (60) consecutive calendar days shall be deemed rejected.

Attended pre-bid conference                      YES \_\_\_\_\_                      NO \_\_\_\_\_

Has visited the jobsite                              YES \_\_\_\_\_                      NO \_\_\_\_\_

The Bidder has reviewed the Guideline Schedule in Section 01 32 00 and the intent  
Of the schedule can be met.

YES \_\_\_\_\_                      NO \_\_\_\_\_

Bidder has included their Written Drug Testing Plan that covers all employees of the bidder who will perform work on the public work project and meets or exceeds the requirements set in IC 4-13-18-5 or IC 4-13-18-6.

YES \_\_\_\_\_                      NO \_\_\_\_\_

The Skillman Corporation's diversity initiative is to create a program to encourage, assist and measure the active participation of Minority- Owned, Women-Owned, Veteran – Owned and Disabled Individual-Owned Businesses. The Program is to ensure that MWVDBEs are provided full and equal opportunity to participate in all Skillman Corporation's Projects.

|                      |                  |          |
|----------------------|------------------|----------|
| Bidder has included: | DBE: YES _____ % | NO _____ |
|                      | MBE: YES _____ % | NO _____ |
|                      | WBE: YES _____ % | NO _____ |
|                      | VBE: YES _____ % | NO _____ |

The undersigned further agrees to furnish a bond or certified check with this Bid for an amount specified in the Notice to Bidders. If Alternate Bids apply, submit a proposal for each in accordance with the Plans and Specifications.

If additional units of material included in the contract are needed, the cost of units must be the same as that shown in the original contract if accepted by the governmental unit. If the bid is to be awarded on a unit bases, the itemization of the units shall be shown on a separate attachment.

The contractor and his subcontractors, if any, shall not discriminate against or intimidate any employee, or applicant for employment, to be employed in the performance of this contract, with respect to any matter directly or indirectly related to employment because of race, religion, color, sex, national origin, or ancestry. Breach of this covenant may be regarded as a material breach of the contract.

CERTIFICATION OF USE OF UNITED STATES STEEL PRODUCTS  
(if applicable)

I, the undersigned bidder, or agent as a contractor on a public works project, understand my statutory obligation to use steel products made in the United States (I.C. 5-16-8-2). I hereby certify that I and all subcontractors employed by me for this project will use U.S. steel on this project if awarded. I understand that violations hereunder may result in forfeiture of contractual payments.

ALTERNATE BIDS

A blank entry or an entry of "No Bid", "N/A", or similar entry on any Alternate will cause the bid to be rejected as non-responsive only if that Alternate is selected. If no change in the bid amount is required, indicate "No Change".

**\*\*MARK "ADD" OR "DEDUCT" FOR EACH ALTERNATE\*\***

Alternate Bid No. 1 – Tremco TPA roofing for ALL new roofs

Change the Base Bid the sum of \_\_\_\_\_  
(sum in words)

\_\_\_\_\_ DOLLARS (\$\_\_\_\_\_) ADD  
(sum in figures) DEDUCT

Alternate Bid No. 2 – Tremco TPA roofing for All existing roofs

Change the Base Bid the sum of \_\_\_\_\_  
(sum in words)

\_\_\_\_\_ DOLLARS (\$\_\_\_\_\_) ADD  
(sum in figures) DEDUCT

Alternate Bid No. 3 – Entrance Canopy

Change the Base Bid the sum of \_\_\_\_\_  
(sum in words)

\_\_\_\_\_ DOLLARS (\$\_\_\_\_\_) ADD  
(sum in figures) DEDUCT

Alternate Bid No. 4 – Divider curtain in Gymnasium A-113

Change the Base Bid the sum of \_\_\_\_\_  
(sum in words)

\_\_\_\_\_ DOLLARS (\$\_\_\_\_\_) ADD  
(sum in figures) DEDUCT

Alternate Bid No. 5 – Epoxy terrazzo floor finish

Change the Base Bid the sum of \_\_\_\_\_  
(sum in words)

\_\_\_\_\_ DOLLARS (\$\_\_\_\_\_) ADD  
(sum in figures) DEDUCT

Alternate Bid No. 6 – Schneider Electric Temperature Controls Installed by Precision Controls

Change the Base Bid the sum of \_\_\_\_\_  
(sum in words)

\_\_\_\_\_ DOLLARS (\$\_\_\_\_\_) ADD  
(sum in figures) DEDUCT

Alternate Bid No. 7 – Roof Top Units Manufactured by Trane

Change the Base Bid the sum of \_\_\_\_\_  
(sum in words)

\_\_\_\_\_ DOLLARS (\$\_\_\_\_\_) ADD  
(sum in figures) DEDUCT

Alternate Bid No. 8 – Chillers Manufactured by Trane

Change the Base Bid the sum of \_\_\_\_\_  
(sum in words)

\_\_\_\_\_ DOLLARS (\$\_\_\_\_\_) ADD  
(sum in figures) DEDUCT

Alternate Bid No. 9 – Air Handling Units Manufactured by Trane

Change the Base Bid the sum of \_\_\_\_\_  
(sum in words)

\_\_\_\_\_ DOLLARS (\$\_\_\_\_\_) ADD  
(sum in figures) DEDUCT

Alternate Bid No. 10 – Chemical Water Treatment Manufactured by H-O-H

Change the Base Bid the sum of \_\_\_\_\_  
(sum in words)

\_\_\_\_\_ DOLLARS (\$\_\_\_\_\_) ADD  
(sum in figures) DEDUCT

Alternate Bid No. 11 – Fire Alarm System Manufactured by Notifier

Change the Base Bid the sum of \_\_\_\_\_  
(sum in words)  
\_\_\_\_\_ DOLLARS (\$\_\_\_\_\_) ADD  
(sum in figures) DEDUCT

Alternate Bid No. 12 – Emergency Generator Manufactured by Caterpillar

Change the Base Bid the sum of \_\_\_\_\_  
(sum in words)  
\_\_\_\_\_ DOLLARS (\$\_\_\_\_\_) ADD  
(sum in figures) DEDUCT

## PART II

(For projects of \$150,000 or more – IC 36-1-12-4)

These statements to be submitted under oath by each bidder with and as a part of his bid. (Attach additional pages for each section as needed.)

### SECTION I EXPERIENCE QUESTIONNAIRE

1. What public works projects has your organization completed for the period of one (1) year prior to the date of the current bid?

| Contract Amount | Class of Work | Completion Date | Name and Address of Owner |
|-----------------|---------------|-----------------|---------------------------|
|                 |               |                 |                           |
|                 |               |                 |                           |
|                 |               |                 |                           |

2. What public works projects are now in process of construction by your organization?

| Contract Amount | Class of Work | Completion Date | Name and Address of Owner |
|-----------------|---------------|-----------------|---------------------------|
|                 |               |                 |                           |
|                 |               |                 |                           |
|                 |               |                 |                           |

3. Have you ever failed to complete any work awarded to you?\_\_\_\_\_If so, where and why?

---

---

---

4. List references from private firms for which you have performed work.

---

---

---

## SECTION II PLAN AND EQUIPMENT QUESTIONNAIRE

1. Explain your plan or layout for performing proposed Work. (Examples could include a narrative of when you could begin, complete the project, number of workers, etc. and any other information which you believe would enable the governmental unit to consider your bid.)

---

---

---

---

2. Please list the names and addresses of all subcontractors (i.e. persons or firms outside your own firm who have performed part of the work) that you have used on public works projects during the past five (5) years along with a brief description of the work done by each subcontractor.

---

---

---

---

3. If you intend to sublet any portion of the work, state the name and addresses of each subcontractor, equipment to be used by the subcontractor, and whether you will required a bond. However, if you are unable to currently provide a listing, please understand a listing must be provided prior to contract approval. Until the completion of the proposed project, you are under a continuing obligation to immediately notify the governmental unit in the event that you subsequently determine that you will use a subcontractor on the proposed project.

---

---

---

---

4. What equipment do you have available to use for the proposed Project? Any equipment used by subcontractors may also be required to be listed by the governmental unit.

---

---

---

5. Have you into contracts or received offers for all materials which substantiate the prices used in preparing your proposal? If not, please explain the rationale used which corroborate the process listed.

---

---

---

### **SECTION III CONTRACTOR'S FINANCIAL STATEMENT**

Attachment of Bidder's financial statement is mandatory. Any Bid submitted without said financial statement as required by statute shall thereby be rendered invalid. The financial statement provided hereunder to the governing body awarding the Contract must be specific enough in detail so that said governing body can make a proper determination of the Bidder's capability for completing the Project if awarded.

### **SECTION IV CONTRACTOR NON-COLLUSION AFFIDAVIT**

The undersigned Bidder or agent, being duly sworn on oath, says that he has not, nor has any other member, representative, or agent of the firm, company, corporation or partnership represented by him, entered into any combination, collusion or agreement with any person relative to the price to be bid by anyone at such letting nor to prevent any person from bidding nor to induce anyone to refrain from bidding, and that this Bid is made without reference to any other bid and without any agreement, understanding or combination with any other person in reference to such bidding.

He further says that no person or persons, firms, or corporations has, have, or will receive directly or indirectly, any rebate, fee, gift, commission, or thing of value on account of such contract.



## SECTION V OATH AND AFFIRMATION

I HEREBY AFFIRM UNDER THE PENALTIES OF PERJURY THAT THE FACTS AND INFORMATION CONTAINED IN THE FOREGOING BID FOR PUBLIC WORKS ARE TRUE AND CORRECT

Dated at \_\_\_\_\_ this \_\_\_\_\_ day of \_\_\_\_\_, 20

\_\_\_\_\_  
(Name of Organization)

By

\_\_\_\_\_  
(Title of Person Signing)

## ACKNOWLEDGEMENT

STATE OF \_\_\_\_\_ )  
 ) SS:  
COUNTY OF \_\_\_\_\_ )

Before me, a Notary Public, personally appeared the above-named

\_\_\_\_\_  
Swore that the statements contained in the foregoing document are true and correct.

Subscribed and sworn to before me this \_\_\_\_\_ day of \_\_\_\_\_,  
\_\_\_\_\_  
(Title)

\_\_\_\_\_  
Notary Public

My Commission Expires: \_\_\_\_\_

County of Residence: \_\_\_\_\_

END OF SECTION 00 31 00

## **SECTION 01 23 00 - ALTERNATES**

### **PART 1 - GENERAL**

#### **1.01 RELATED DOCUMENTS**

- A. Drawings and general provisions of the Contract, including amended General Conditions and other Division 1 Specification Sections, apply to work of this Section.

#### **1.02 PURPOSE**

- A. The Bids for the Alternates described herein are required in order for the Owner to obtain information necessary for the proper consideration of the Project in its entirety.

#### **1.03 ALTERNATES**

- A. Definitions: Alternates are defined as alternate products, materials, equipment, installations or systems for the Work, which may, at Owner's option and under terms established by Instructions to Bidders, be selected and recorded in the Owner-Contractor Agreement to either supplement or displace corresponding basic requirements of Contract Documents. Alternates may or may not substantially change scope and general character of the Work; and must not be confused with "allowances", "unit prices", "change orders", "substitutions", and other similar provisions.

#### **1.04 SCHEDULE OF ALTERNATES**

- A. ALTERNATE NO. 1: State the cost to provide new Tremco TPA roofing for ALL new roofs as indicted on the Contract Documents.
- B. ALTERNATE NO. 2: State the cost to provide new Tremco TPA roofing at portions of the existing roof membrane as indicated on the Contract Documents.
- C. ALTERNATE NO. 3: State the cost to provide the new entrance canopy in its entirety located between Units F and H, as indicated on the Contract Documents.
- D. ALTERNATE NO. 4: State the cost to provide a divider curtain in Gymnasium A-113.
- E. ALTERNATE NO. 5: State the cost to provide epoxy terrazzo floor finish in new corridors in lieu of LVT floor finish as indicated on the Contract Documents.
- F. ALTERNATE NO. 6: State the cost to provide Schneider Electric Controls installed by Precision Controls as indicated on the Mechanical Drawings and Specifications if not already included in your Base Bid.

- G. ALTERNATE NO. 7: State the cost to provide Roof Top Units manufactured by Trane as indicated on the Mechanical Drawings and Specifications if not already included in your Base bid.
- H. ALTERNATE NO. 8: State the cost to provide Chillers manufactured by Trane as indicated on the Mechanical Drawings and Specifications if not already included in your Base Bid.
- I. ALTERNATE NO. 9: State the cost to provide Air Handling Units manufactured by Trane as indicated on the Mechanical Drawings Specifications if not already included in your Base Bid.
- J. ALTERNATE NO. 10: State the cost to provide Chemical Water Treatment manufactured by H-O-H. as indicated on the Plumbing Drawings and Specifications if not already included in your Base Bid.
- K. ALTERNATE NO. 11: State the cost to provide Fire Alarm System manufactured by Notifier as indicated on the Electrical Drawings and Specifications if not already included in your Base Bid.
- L. ALTERNATE NO. 12: State the cost to provide Emergency Generator manufactured by Caterpillar as indicated on the Electrical Drawings and Specifications if not already included in your Base Bid.

PART 2 - PRODUCTS, PART 3 - EXECUTION (Not Used)

END OF SECTION 01 23 00

## **SECTION 01 52 60 - RUBBISH CONTAINER**

### **PART 1 - GENERAL**

#### **1.01 RELATED DOCUMENTS**

- A. Drawings and general provisions of the Contract, including amended General Conditions and other Division 1 Specification Sections, apply to work of this Section.
- B. Masonry, Roofing, and Metal Studs & Drywall Contractors are to provide their own rubbish containers (See Section 01 56 90, Paragraph 3.01C)


#### **1.02 RUBBISH CONTAINER**


- A. The **Bid Category No. 1 Contractor** shall provide three hundred (210) each 30 yarders dumpster type rubbish container for the Project waste, debris, and rubbish for all Contractors, except as specified in 1.01.B above, for the life of the Project.
- B. This amount shall be listed on the Schedule of Values for approval. Any unused amounts shall be credit back to the Owner as a deductive Change Order.
- C. Dispose of container contents weekly or at more frequent intervals if required by inadequate container capacity.
- D. **Provide fifteen (15) one cubic yard mobile trash carts that can be used during the project by all Contractors, after the initial floors are cast.**
  - 1. **The General Trades Contractor shall empty all one cubic yard trash carts at the end of the workday, regardless of the Prime Contractor filling the cart. All trash carts shall be returned to their appropriate spot upon being emptied. The General Trades Contractor will be fined \$50 for every cart not emptied and returned to the original assigned location, as determined by the Construction Manager.**
  - 2. **The Masonry, Roofing, and Drywall Contractors are not permitted to use the one cubic yard trash carts supplied by the General Trades Contractor. The Masonry and Drywall Contractors are to supply sufficient trash carts to remove their debris on a daily basis. A \$50 fine will be assessed for each cart container not emptied at the end of the day, as determined by the Construction Manager.**

#### **1.03 TRASH CHUTES**

- A. The **Bid Category No. 1 Contractor** shall erect a suitable, closed, relatively dust-free chutes for the use by all trades during construction above ground floor. No material or debris will be permitted to drop free.
  - 1. Coordinate this installation with the Construction Manager and other Contractors.

END OF SECTION 01 52 60

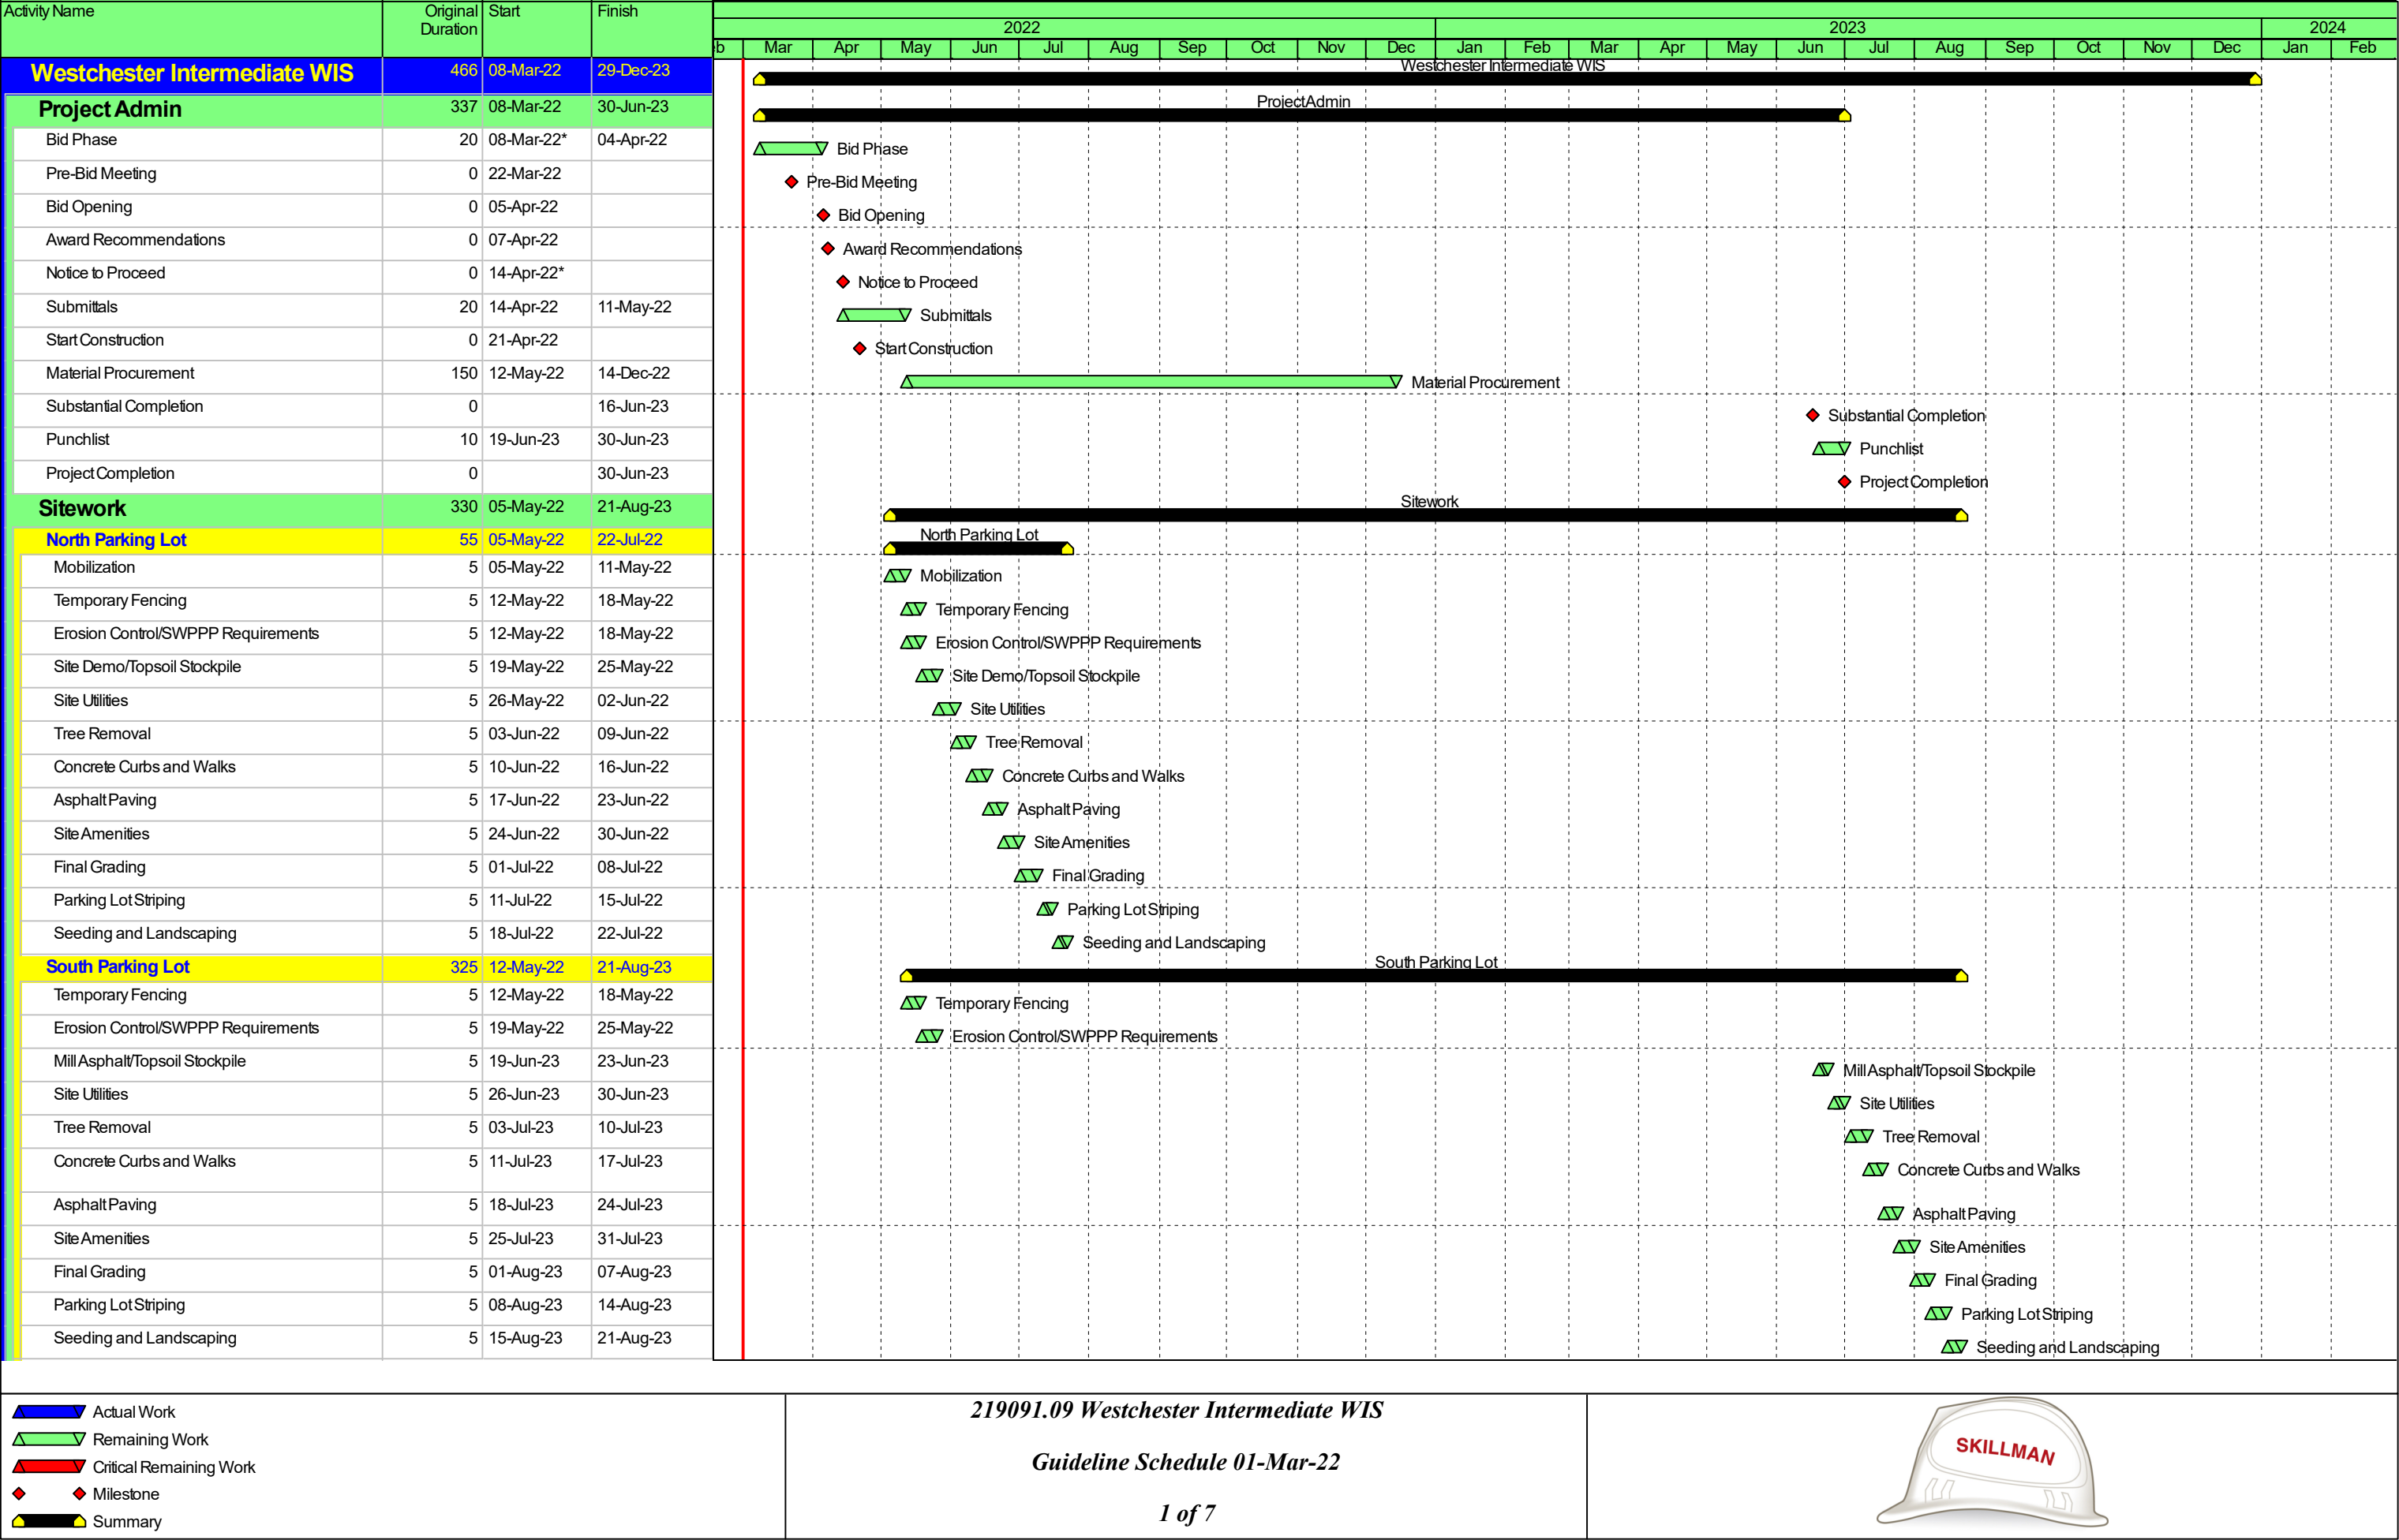

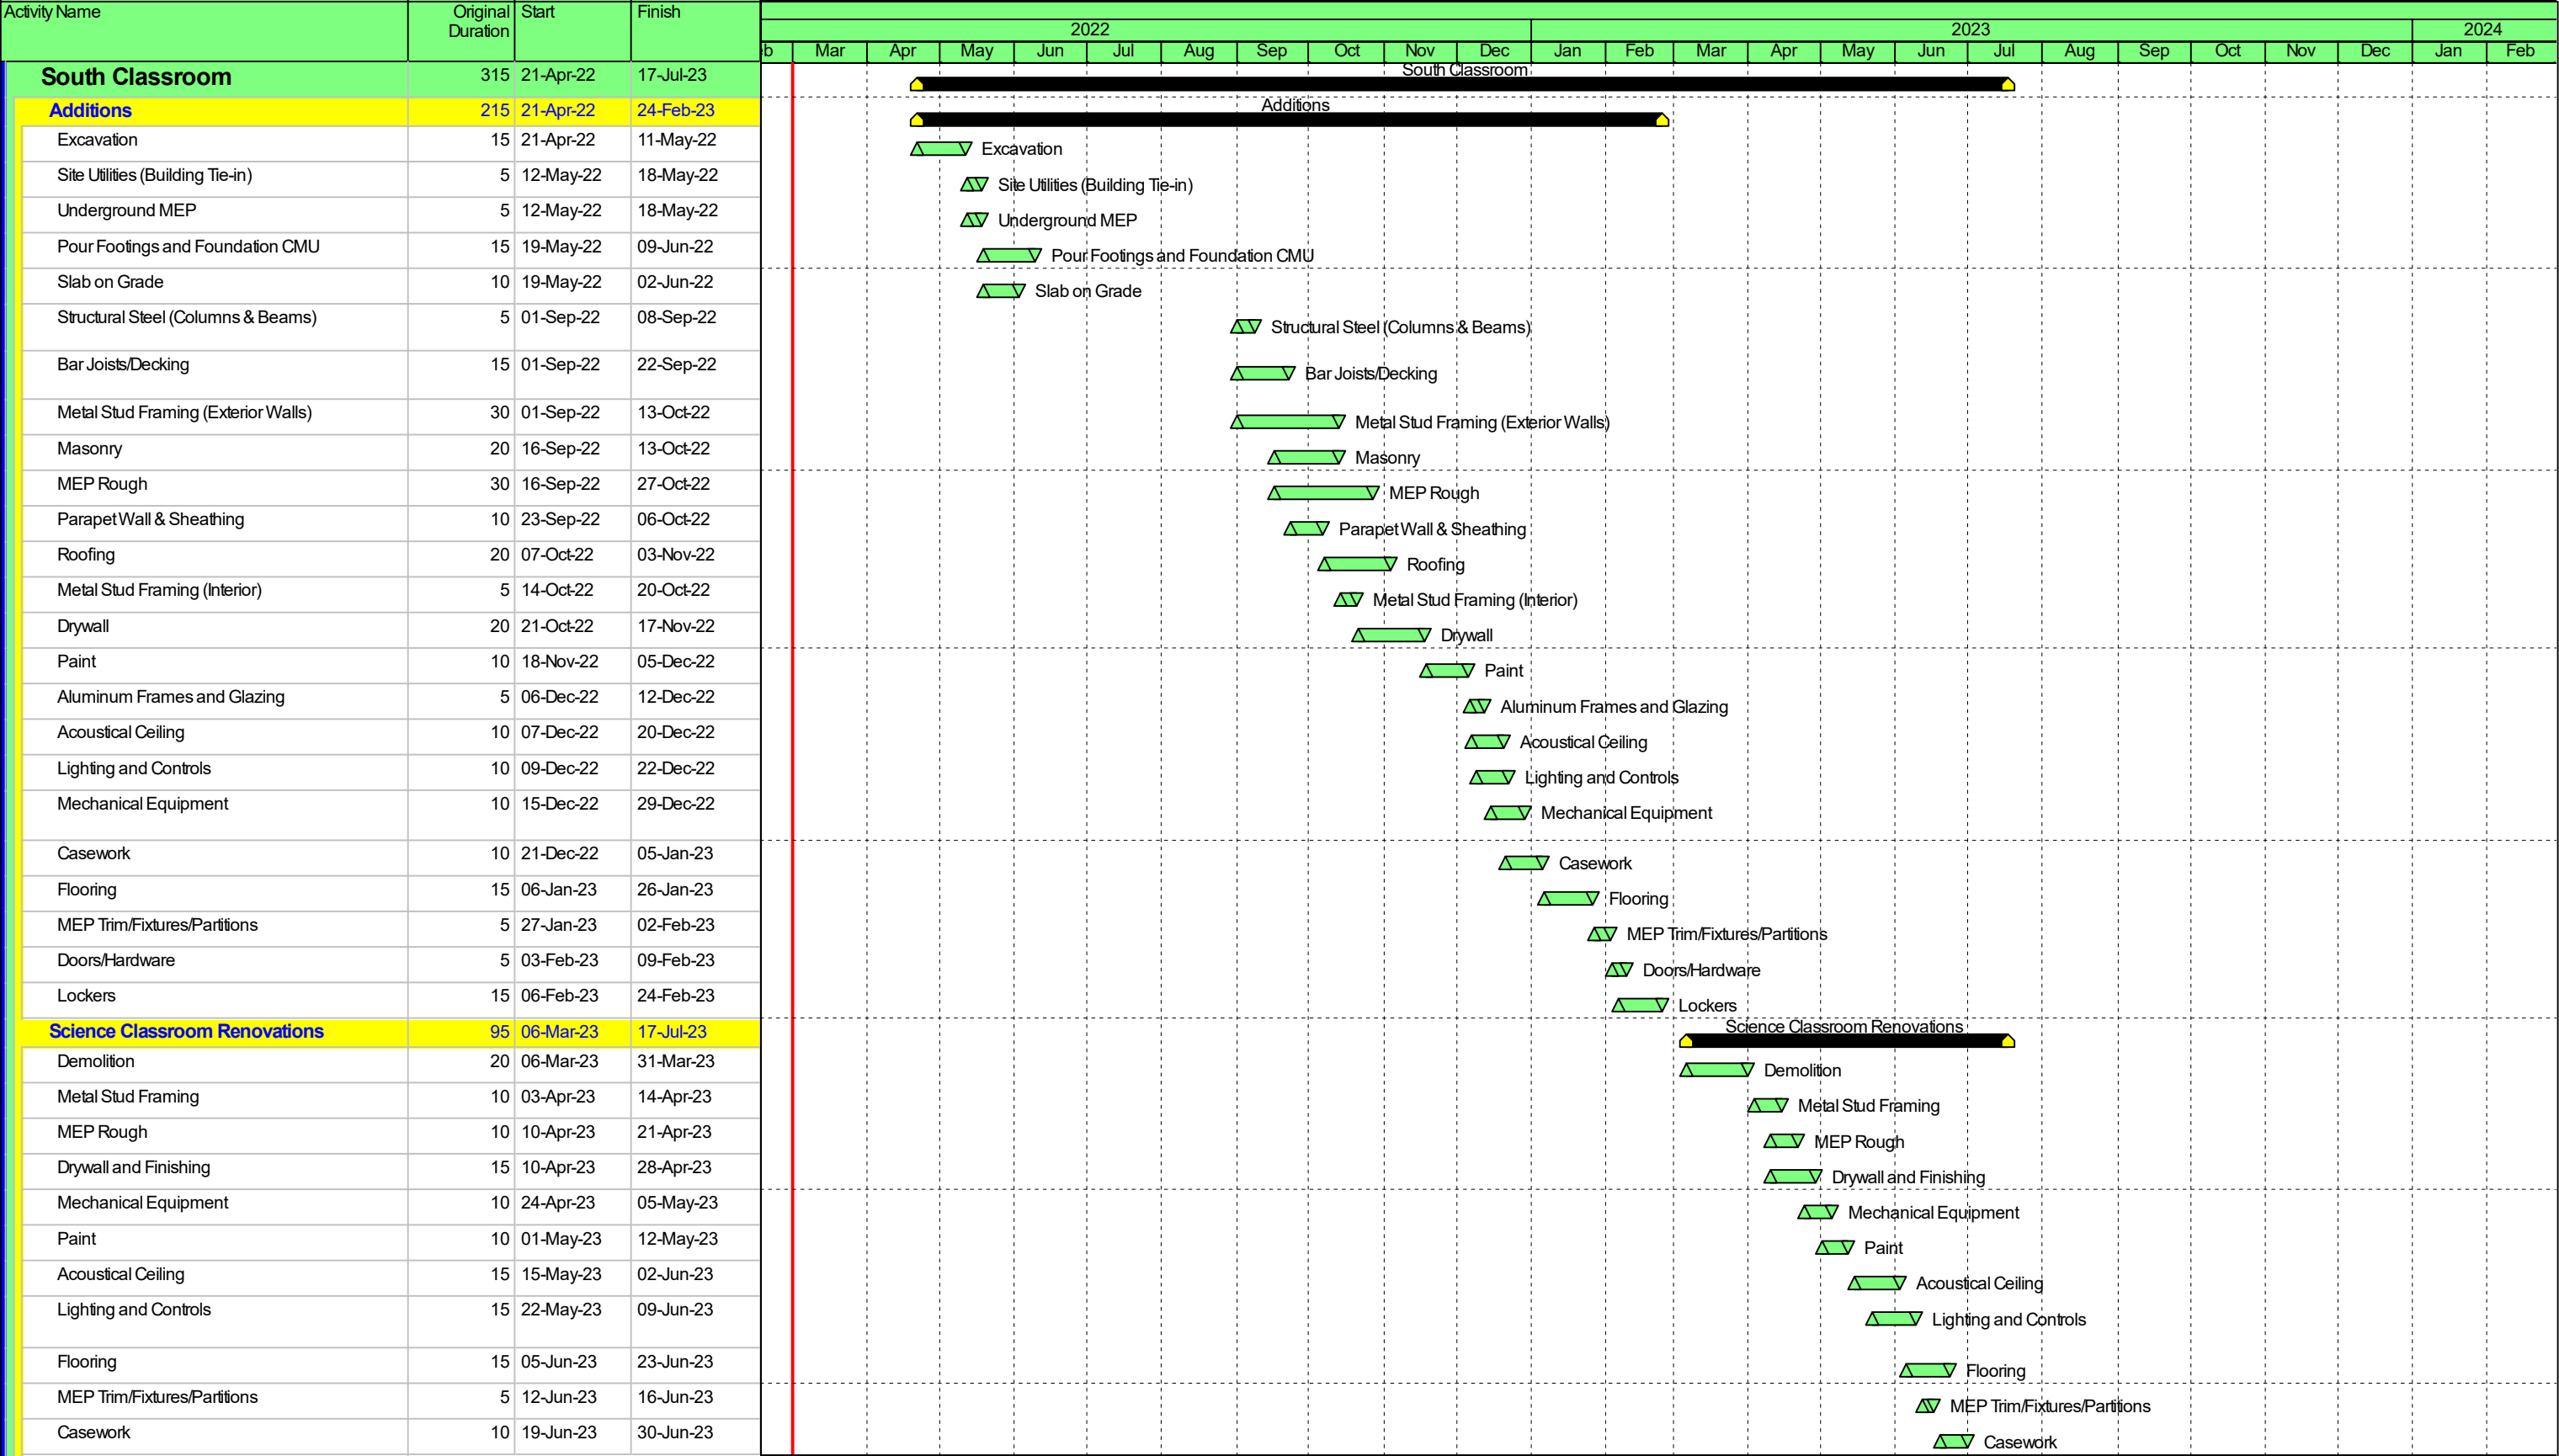

- Actual Work
- Remaining Work
- Critical Remaining Work
- Milestone
- Summary

219091.09 Westchester Intermediate WIS

Guideline Schedule 01-Mar-22



| Activity Name                       | Original Duration | Start     | Finish    | 2022 |     |     |     |     |     |     |     |     |     |     |     | 2023 |     |     |     |     |     |     |     |     |     |     |     | 2024 |  |
|-------------------------------------|-------------------|-----------|-----------|------|-----|-----|-----|-----|-----|-----|-----|-----|-----|-----|-----|------|-----|-----|-----|-----|-----|-----|-----|-----|-----|-----|-----|------|--|
|                                     |                   |           |           | Feb  | Mar | Apr | May | Jun | Jul | Aug | Sep | Oct | Nov | Dec | Jan | Feb  | Mar | Apr | May | Jun | Jul | Aug | Sep | Oct | Nov | Dec | Jan | Feb  |  |
|                                     |                   
| Lockers                             | 10                | 03-Jul-23 | 17-Jul-23 |      |     
| Science Casework                    | 10                | 03-Jul-23 | 17-Jul-23 |      |     
| East Classroom                      | 205               | 12-May-22 | 03-Mar-23 |      |     
| Addition                            | 169               | 12-May-22 | 12-Jan-23 |      |     
| Excavation                          | 15                | 12-May-22 | 02-Jun-22 |      |     
| Site Utilities (Building Tie-in)    | 5                 | 03-Jun-22 | 09-Jun-22 |      |     
| Underground MEP                     | 5                 | 03-Jun-22 | 09-Jun-22 |      |     
| Footings and Foundation CMU         | 15                | 10-Jun-22 | 30-Jun-22 |      |     
| Slab on Grade                       | 5                 | 10-Jun-22 | 16-Jun-22 |      |     
| Structural Steel (Columns & Beams)  | 5                 | 01-Sep-22 | 08-Sep-22 |      |     
| Bar Joists/Decking                  | 15                | 01-Sep-22 | 22-Sep-22 |      |     
| Metal Stud Framing (Exterior Walls) | 10                | 01-Sep-22 | 15-Sep-22 |      |     
| Masonry                             | 15                | 09-Sep-22 | 29-Sep-22 |      |     
| MEP Rough                           | 10                | 09-Sep-22 | 22-Sep-22 |      |     
| Metal Stud Framing (Interior)       | 10                | 16-Sep-22 | 29-Sep-22 |      |     
| Parapet Wall & Sheathing            | 10                | 23-Sep-22 | 06-Oct-22 |      |     
| Mechanical Equipment                | 10                | 23-Sep-22 | 06-Oct-22 |      |     
| Drywall                             | 10                | 30-Sep-22 | 13-Oct-22 |      |     
| Roofing                             | 15                | 07-Oct-22 | 27-Oct-22 |      |     
| Paint                               | 10                | 14-Oct-22 | 27-Oct-22 |      |     
| Acoustical Ceiling                  | 10                | 28-Oct-22 | 10-Nov-22 |      |     
| Lighting and Controls               | 10                | 28-Oct-22 | 10-Nov-22 |      |     
| Aluminum Frames and Glazing         | 5                 | 28-Oct-22 | 03-Nov-22 |      |     
| Casework                            | 5                 | 11-Nov-22 | 17-Nov-22 |      |     
| Flooring                            | 15                | 18-Nov-22 | 12-Dec-22 |      |     
| MEP Trim/Fixtures/Partitions        | 5                 | 13-Dec-22 | 19-Dec-22 |      |     
| Doors/Hardware                      | 5                 | 20-Dec-22 | 27-Dec-22 |      |     
| Lockers                             | 15                | 21-Dec-22 | 12-Jan-23 |      |     
| Art/Classroom Renovations           | 95                | 18-Oct-22 | 03-Mar-23 |      |     
| Demolition                          | 20                | 18-Oct-22 | 14-Nov-22 |      |     
| Metal Stud Framing                  | 10                | 15-Nov-22 | 30-Nov-22 |      |     
| MEP Rough                           | 10                | 22-Nov-22 | 07-Dec-22 |      |     
| Drywall and Finishing               | 15                | 22-Nov-22 | 14-Dec-22 |      |     
| Mechanical Equipment                | 10                | 08-Dec-22 | 21-Dec-22 |      |     
| Paint                               | 10                | 15-Dec-22 | 29-Dec-22 |      |     
| Acoustical Ceiling                  | 15                | 30-Dec-22 | 20-Jan-23 |      |     
| Lighting and Controls               | 15                | 09-Jan-23 | 27-Jan-23 |      |     
| Flooring                            | 15                | 23-Jan-23 | 10-Feb-23 |      |     
| MEP Trim/Fixtures/Partitions        | 5                 | 30-Jan-23 | 03-Feb-23 |      |     

Actual Work

Remaining Work

Critical Remaining Work

Milestone

Summary


219091.09 Westchester Intermediate WIS


Guideline Schedule 01-Mar-22


3 of 7

SKILLMAN



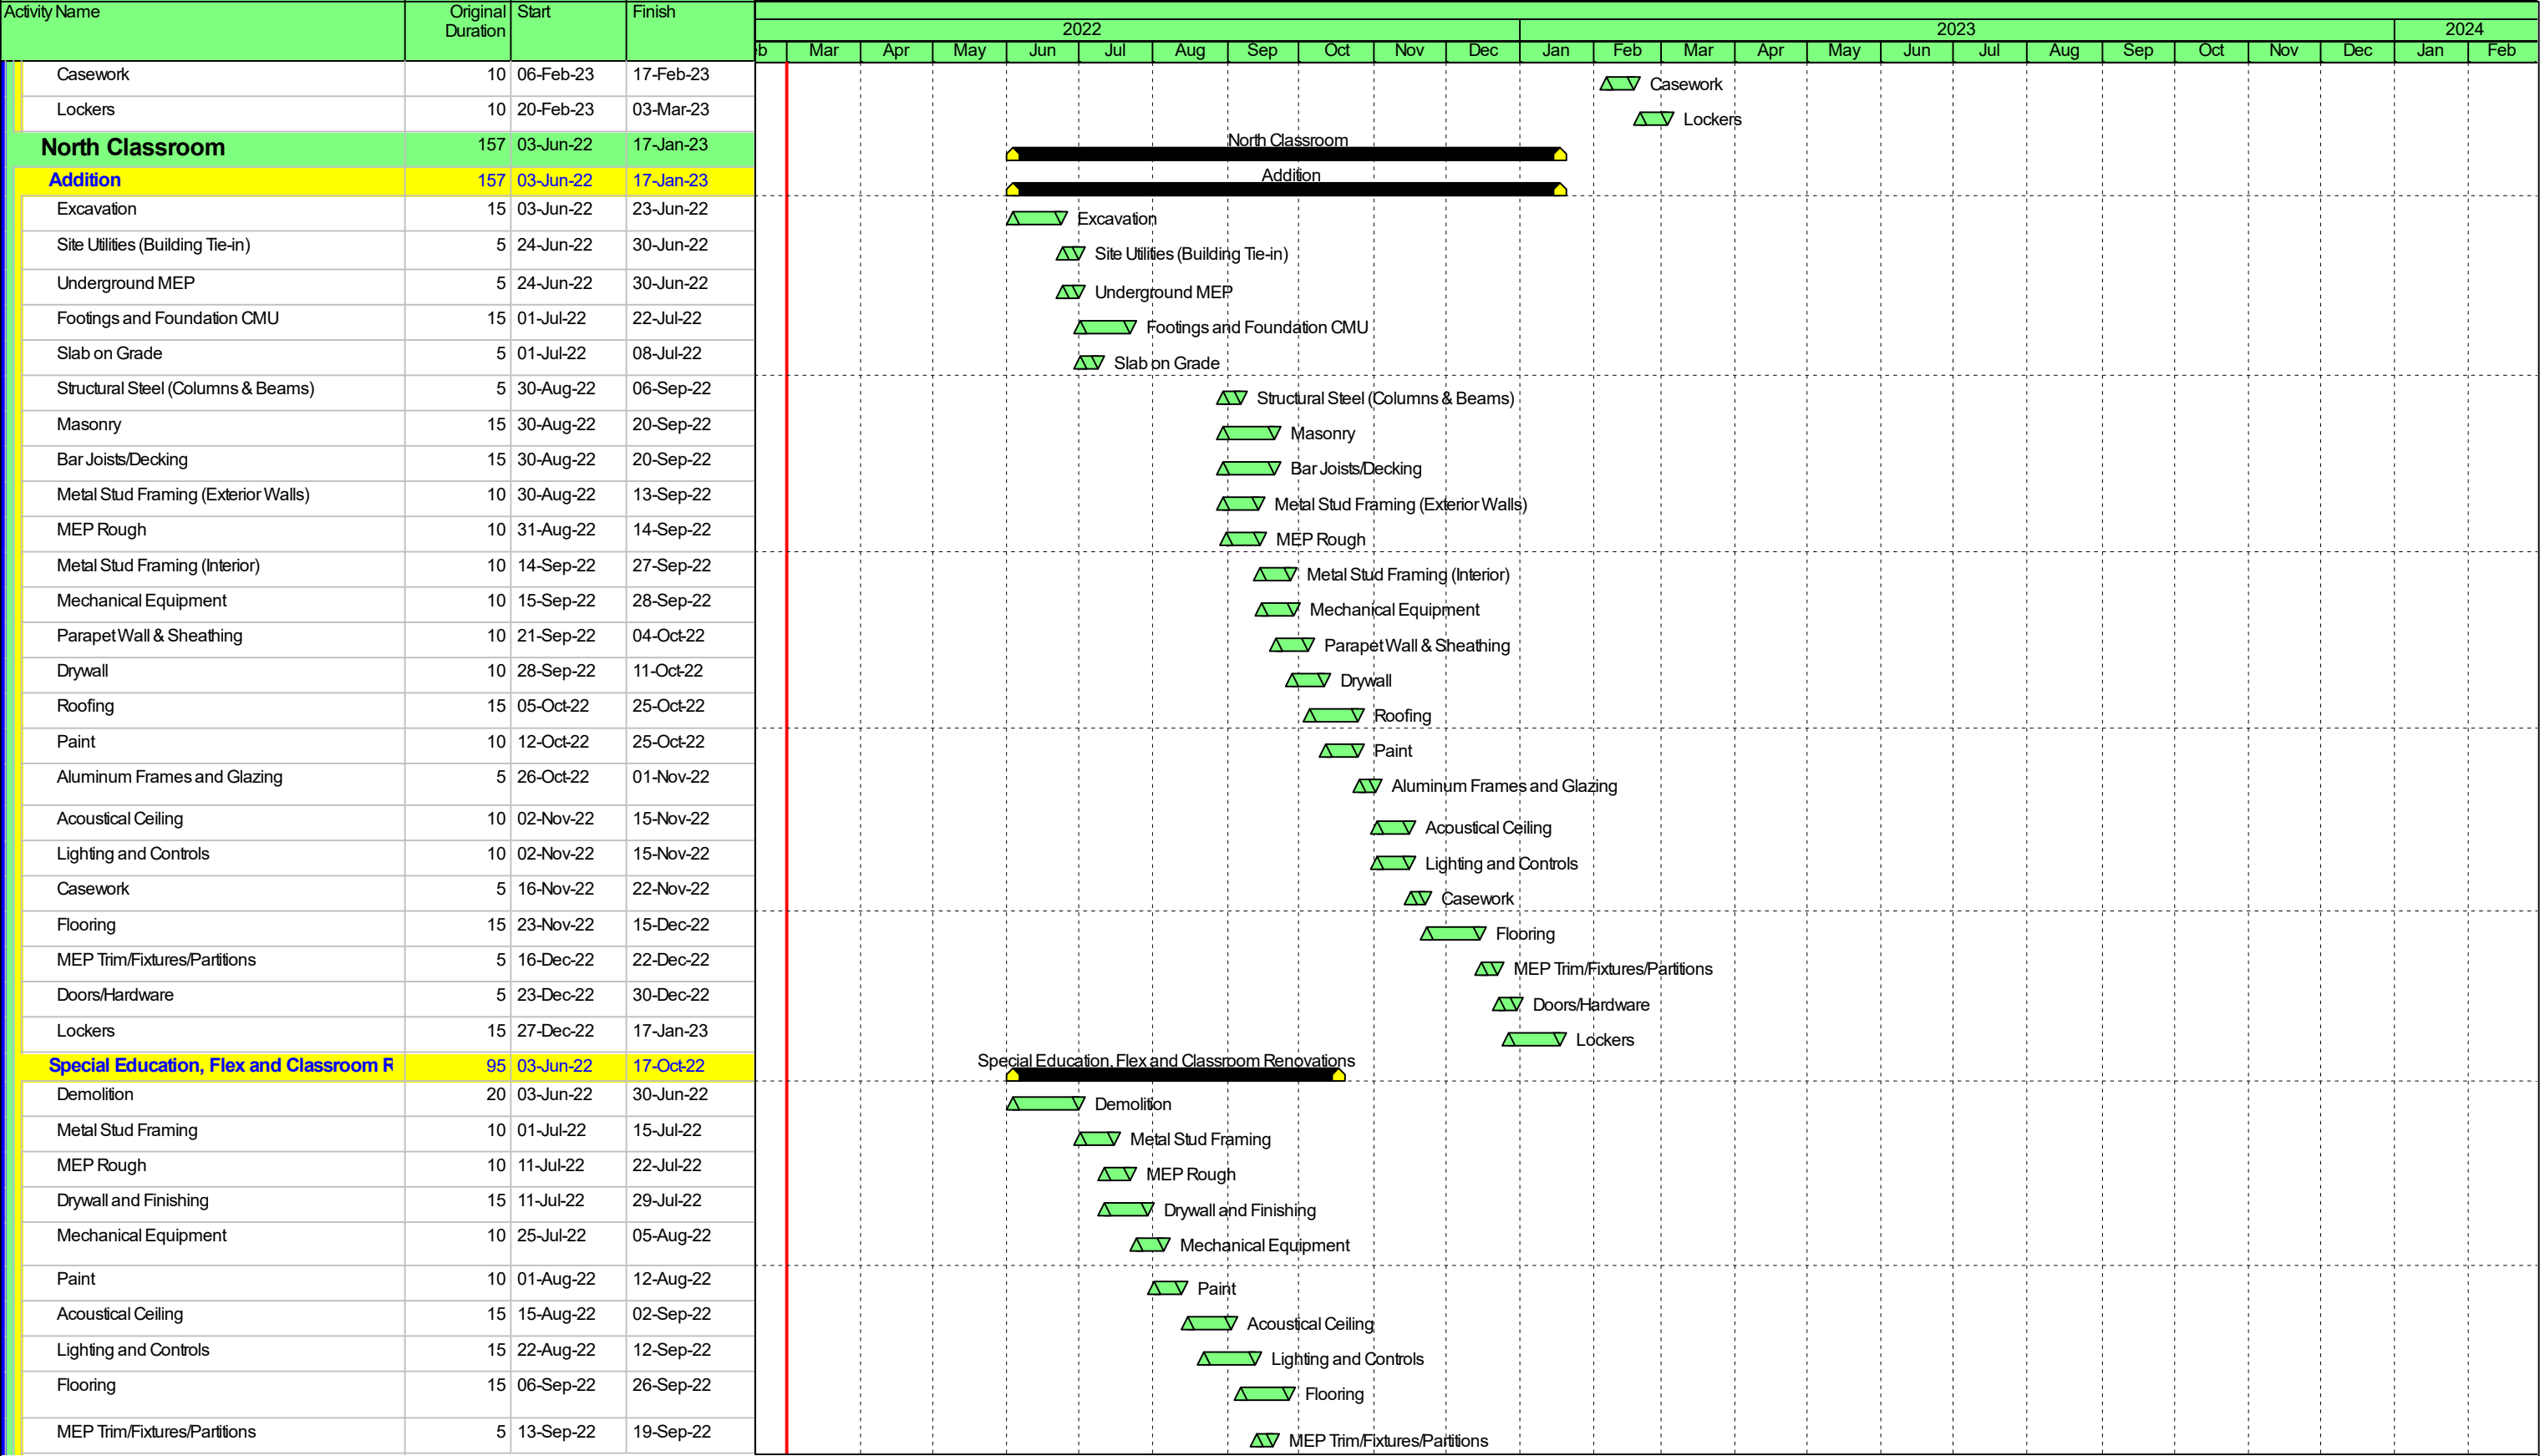

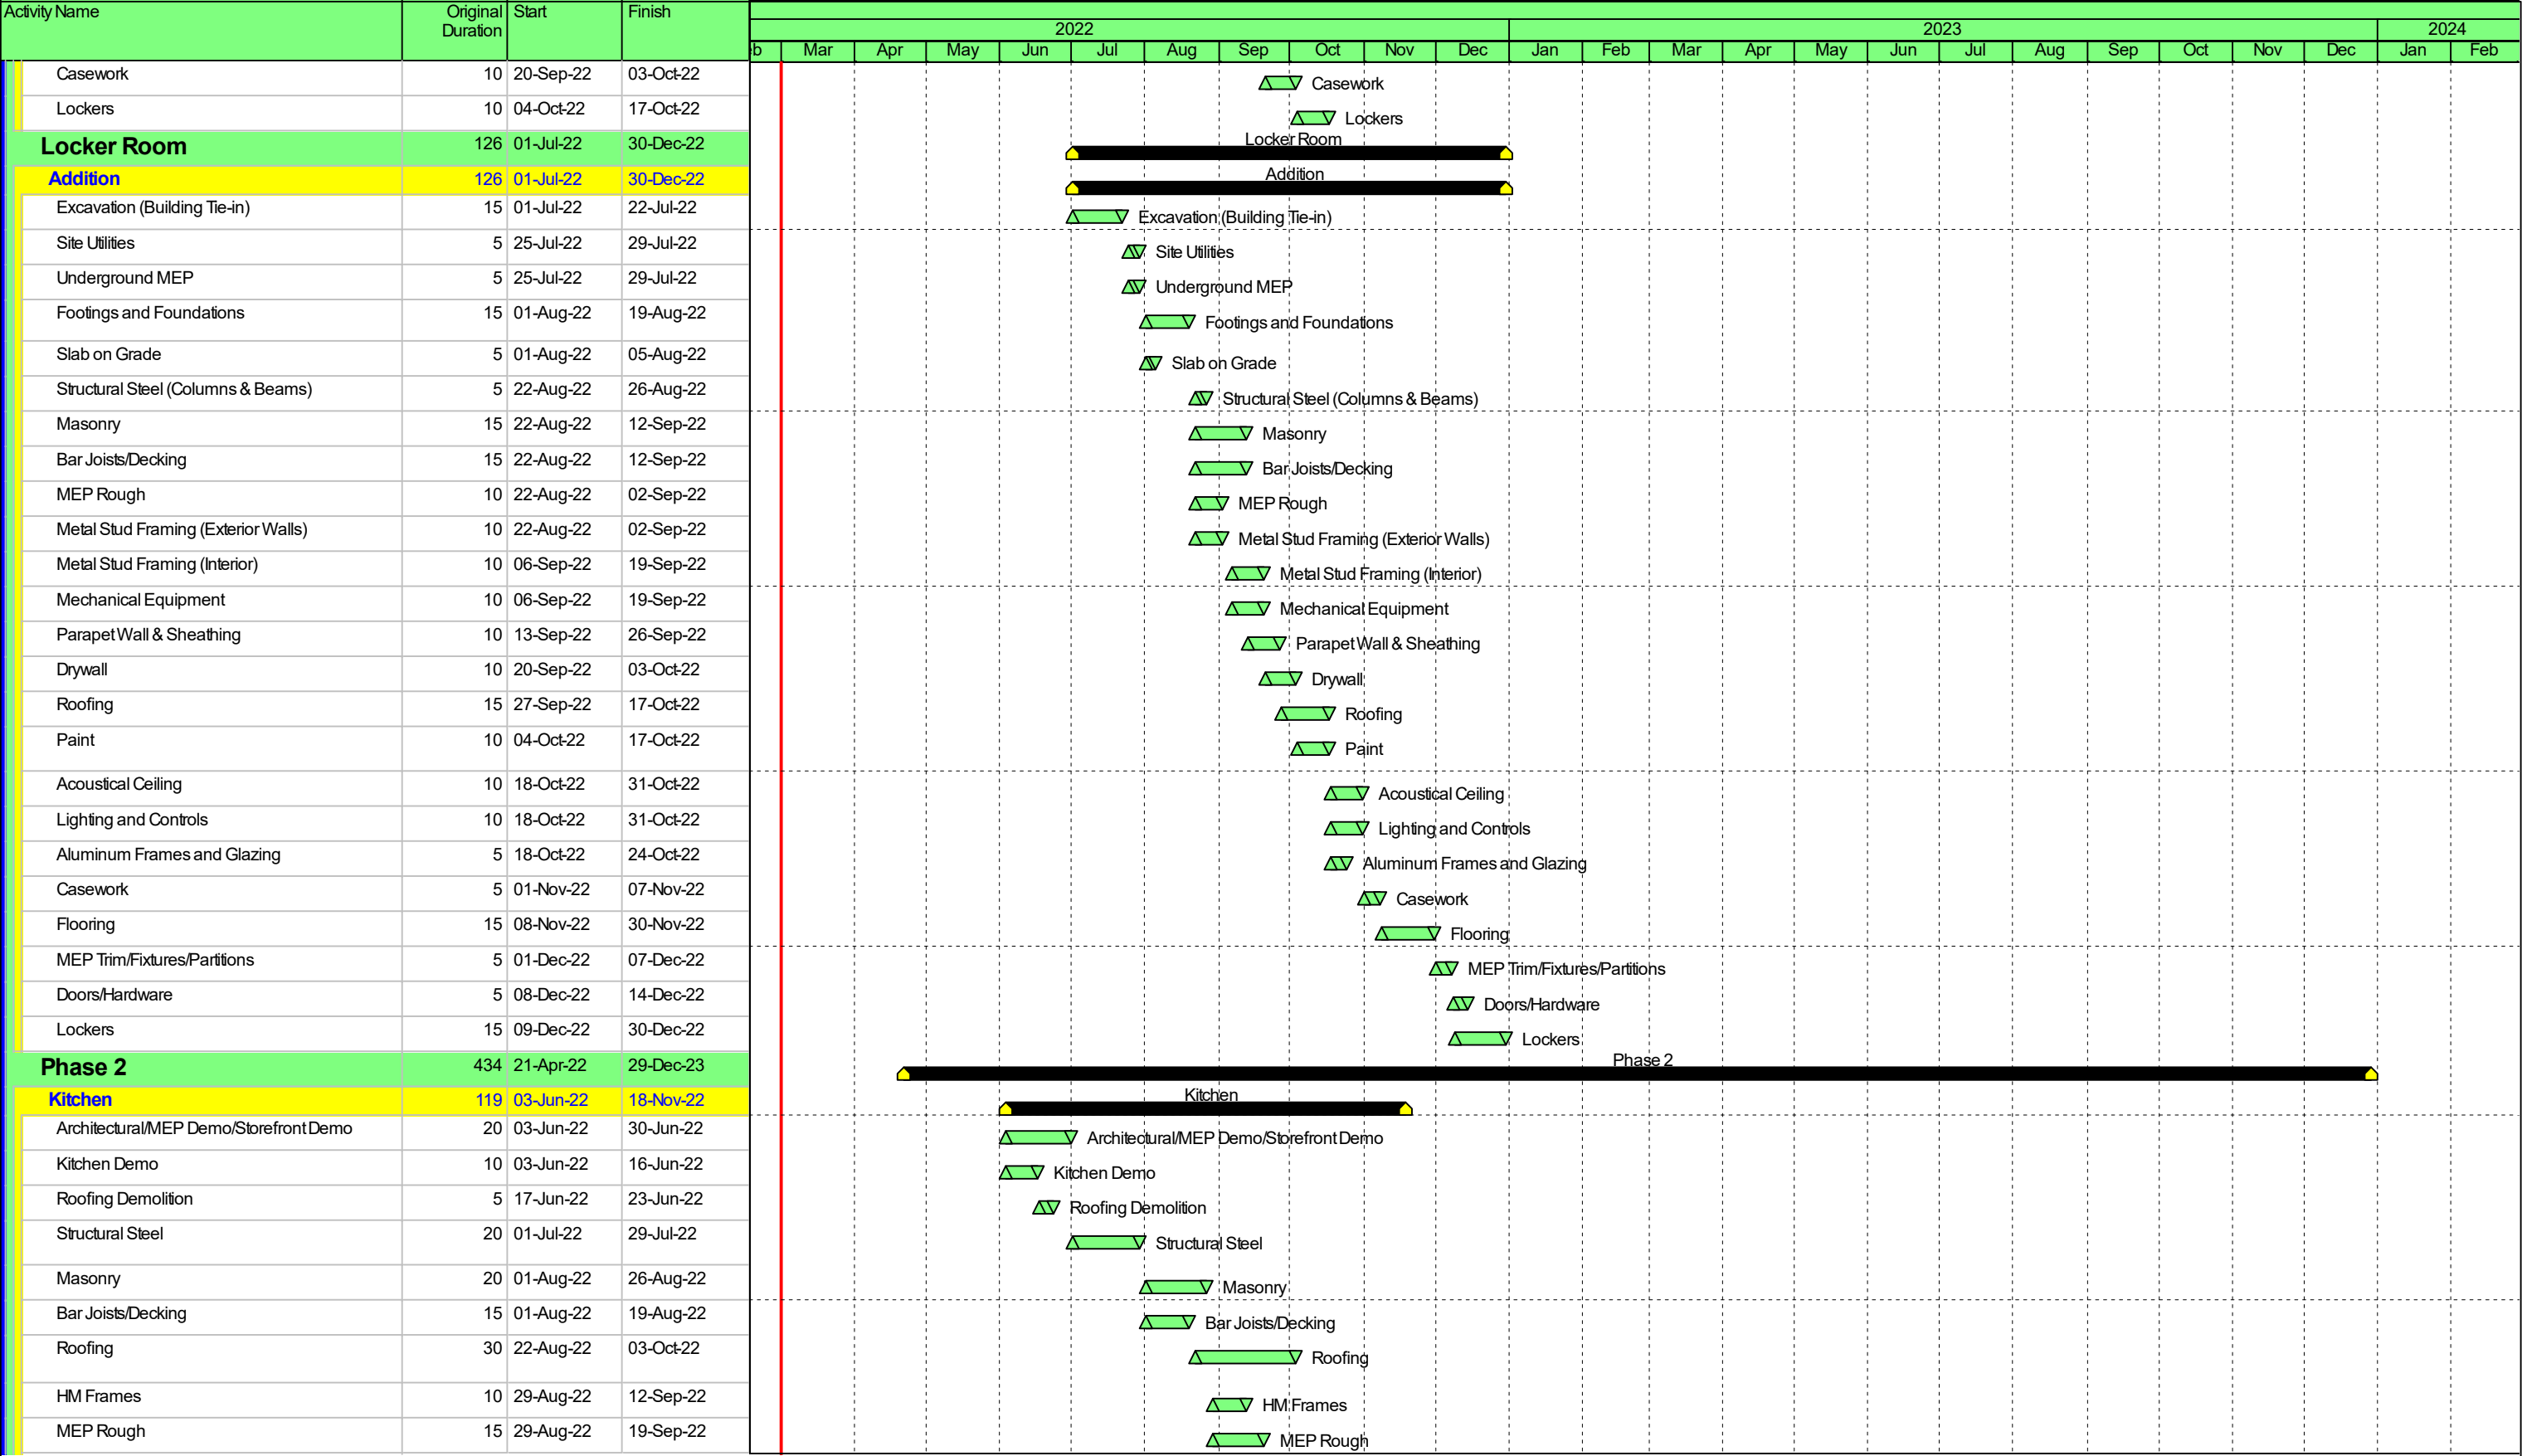

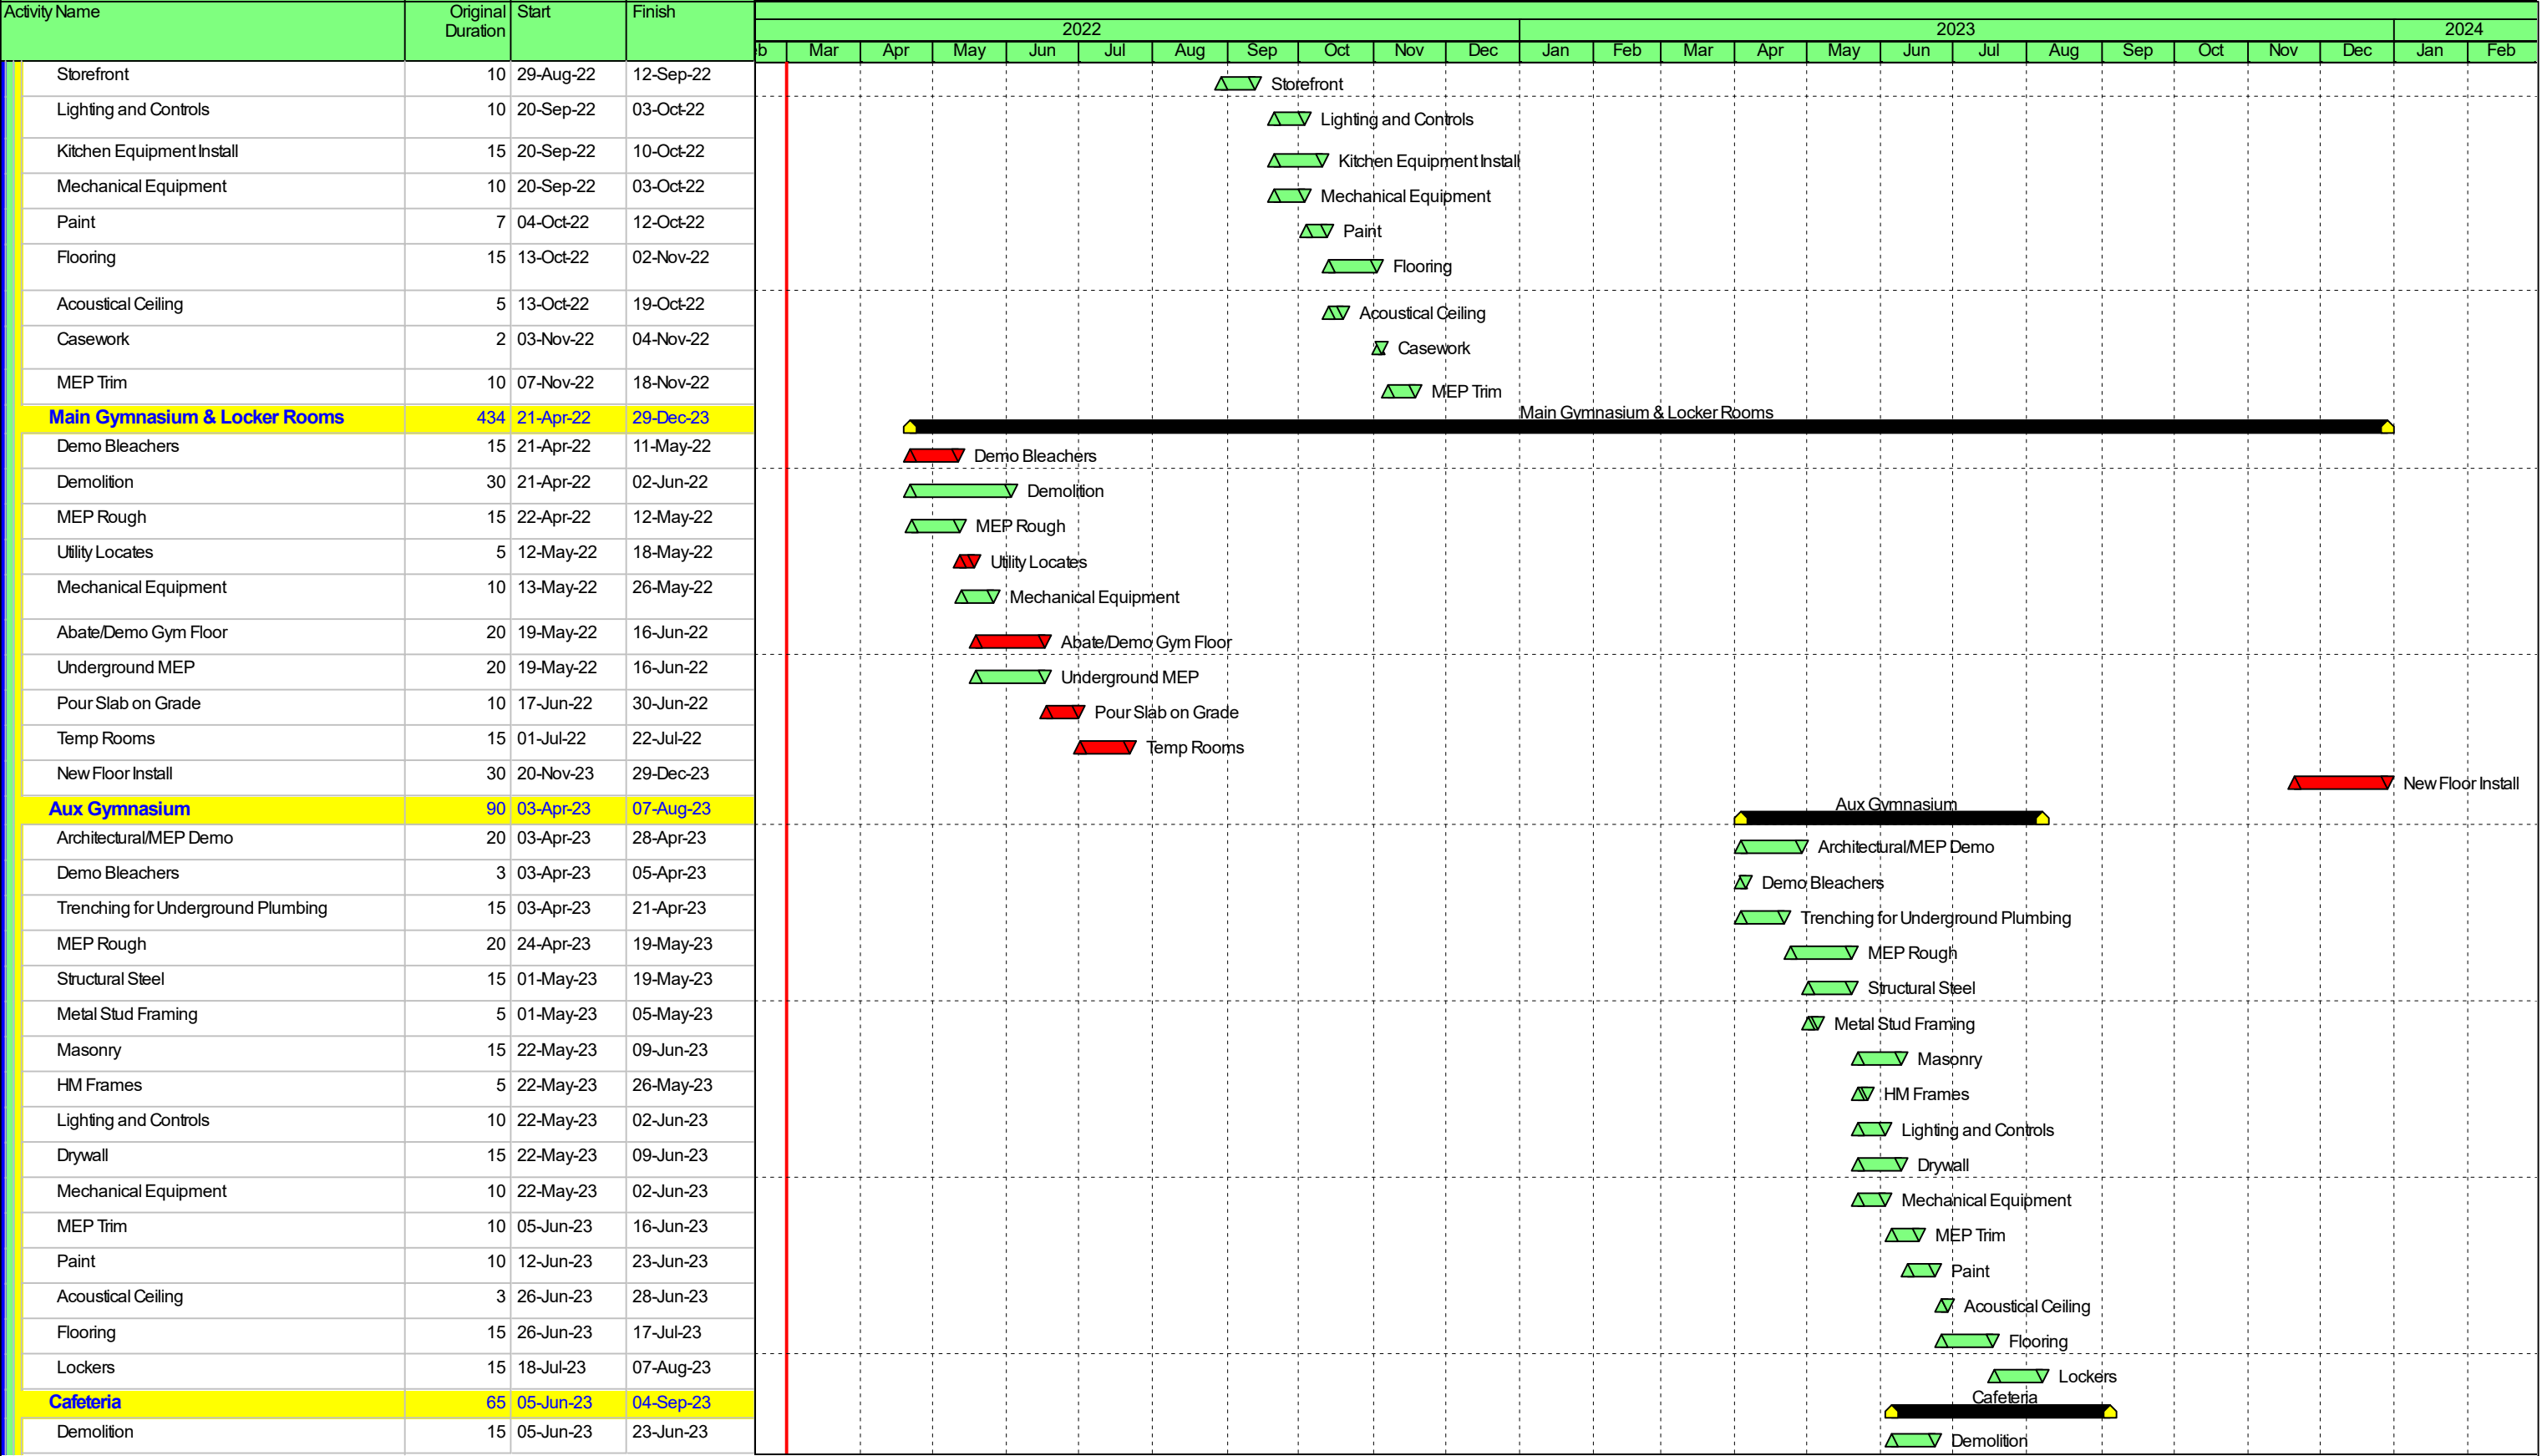

- Actual Work
- Remaining Work
- Critical Remaining Work
- Milestone
- Summary


219091.09 Westchester Intermediate WIS

Guideline Schedule 01-Mar-22





| Activity Name |                    | Original Duration | Start     | Finish    | 2022   |     |     |     |     |     |     |     |     |     |     |     | 2023 |     |     |     |     |     |     |     |     |     |     |     | 2024 | |
|---|
|               |                    |                   |           |           | Feb  | Mar | Apr | May | Jun | Jul | Aug | Sep | Oct | Nov | Dec | Jan | Feb  | Mar | Apr | May | Jun | Jul | Aug | Sep | Oct | Nov | Dec | Jan | Feb  | |
| Main Project  | Metal Stud Framing | 5                 | 26-Jun-23 | 30-Jun-23 | Timeline visualization with Gantt bars and activity names across months. | |



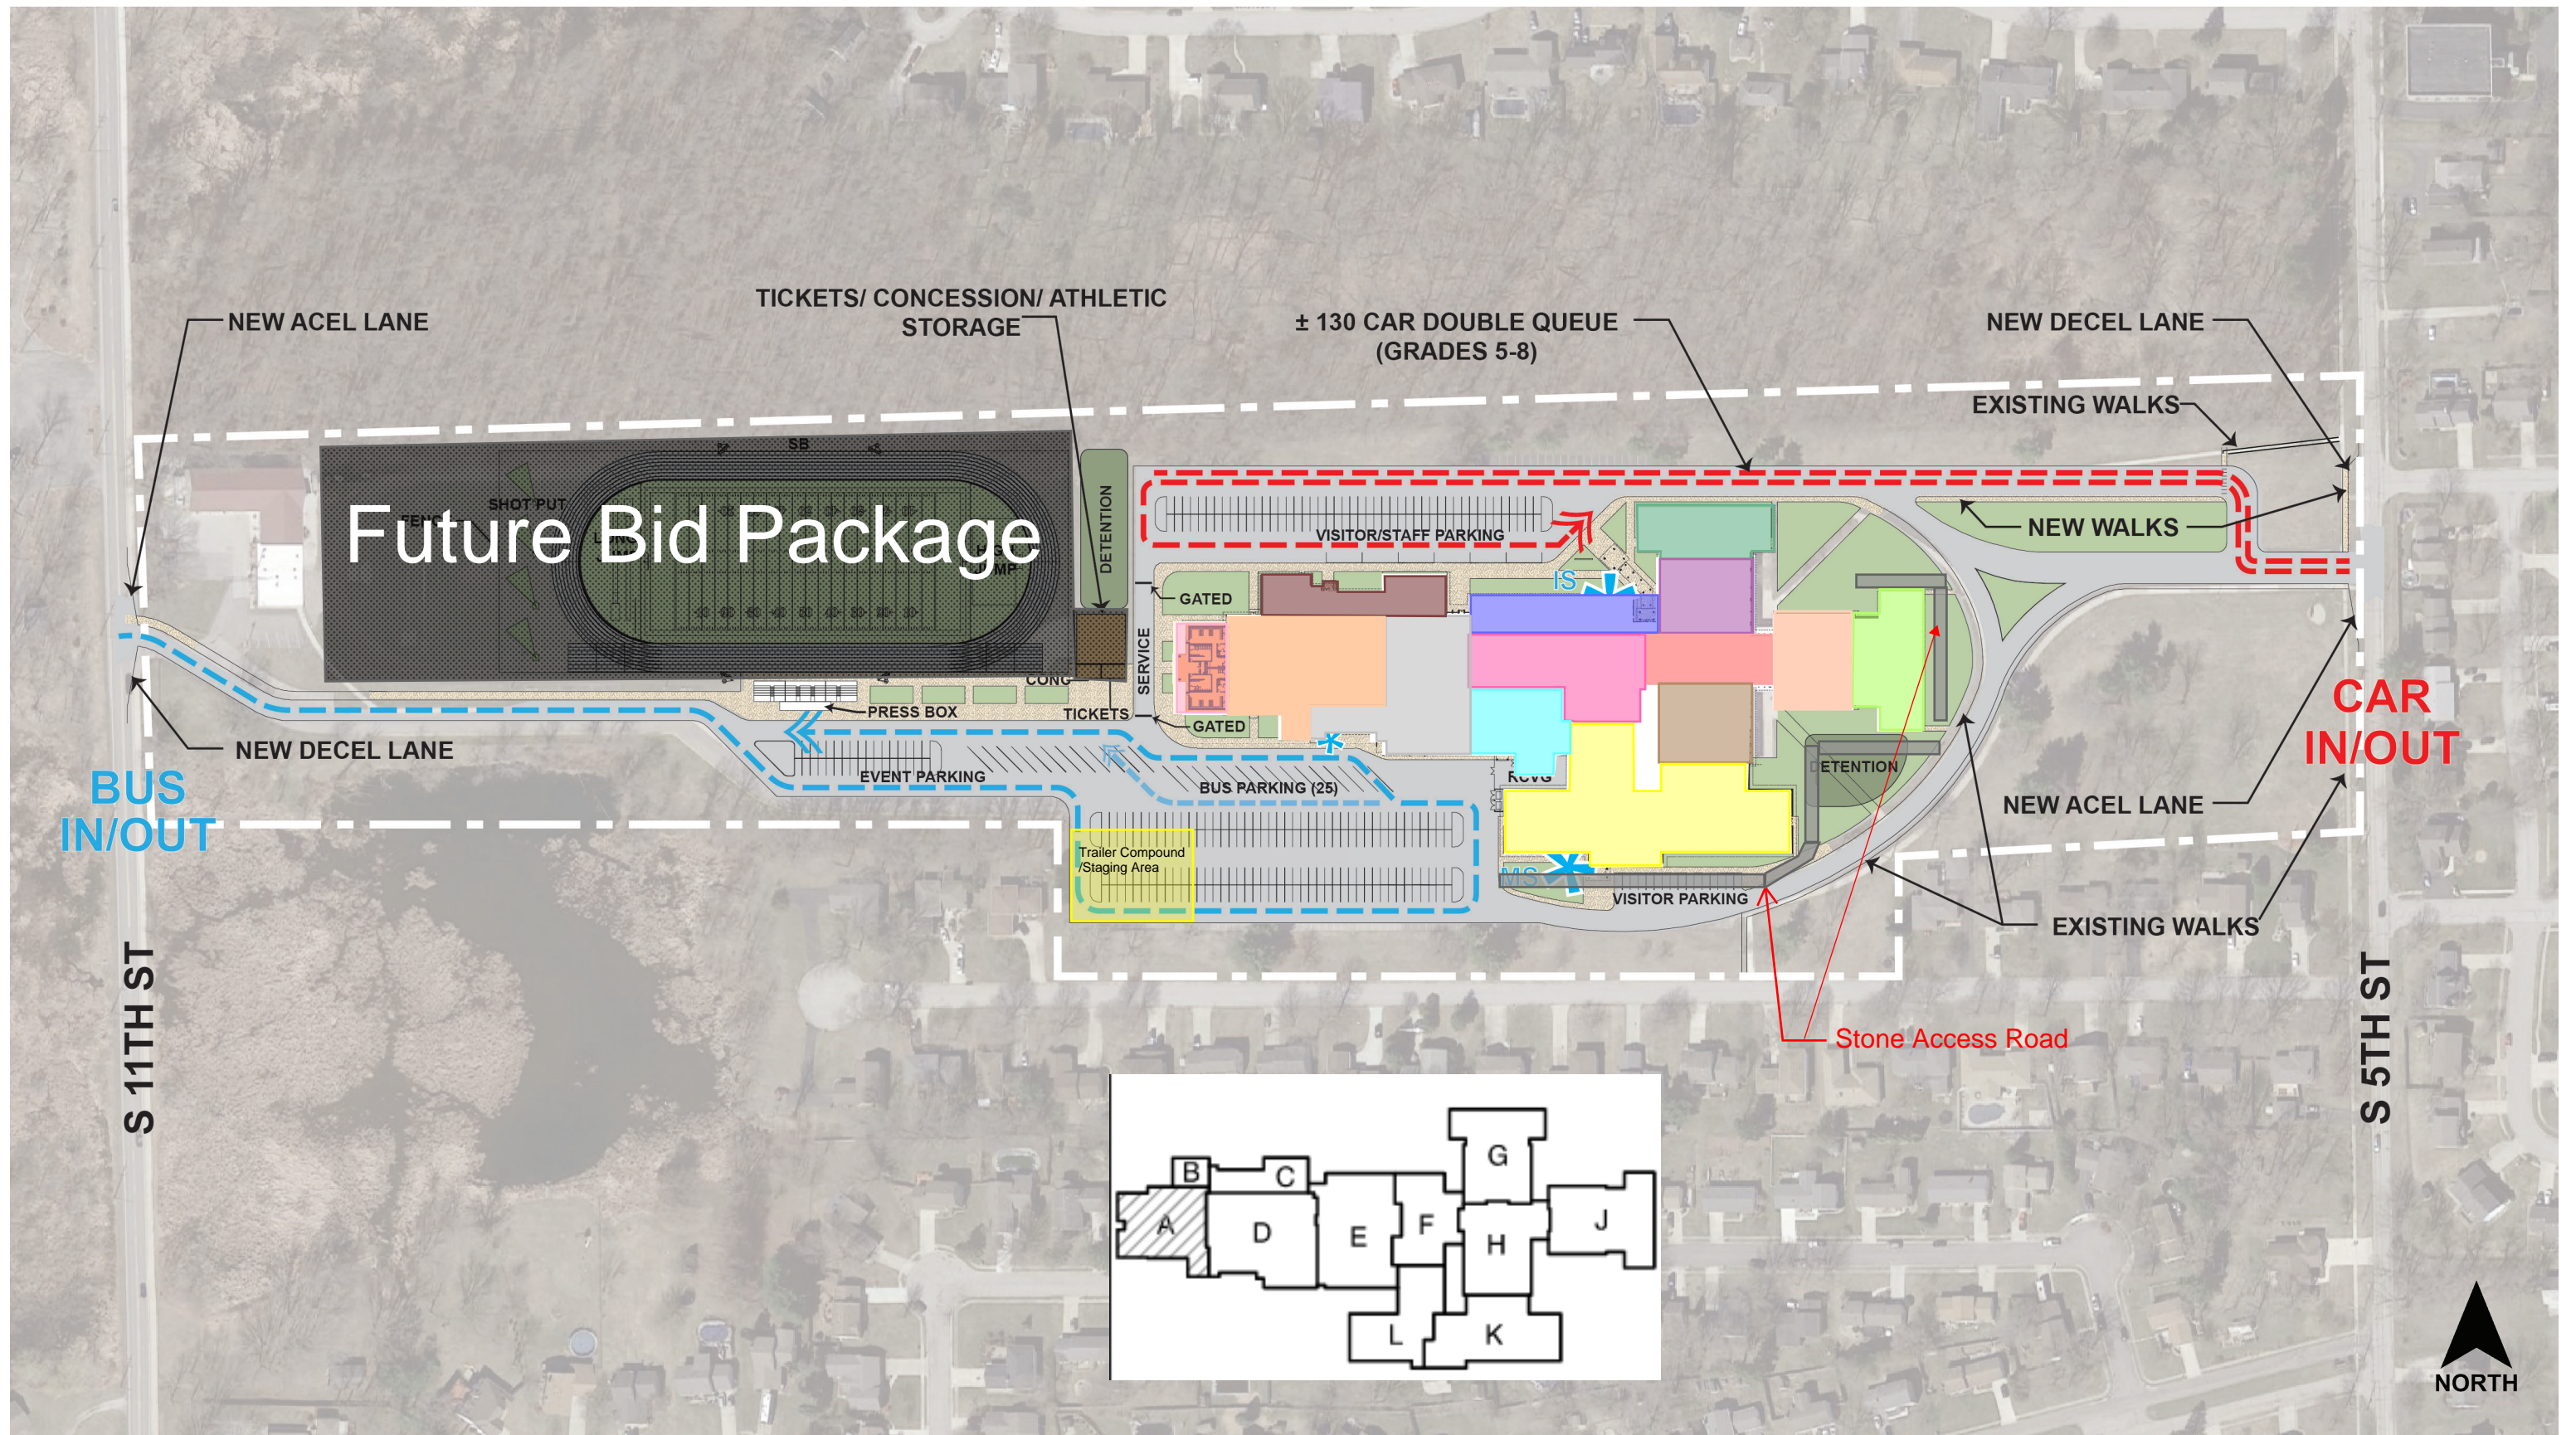



 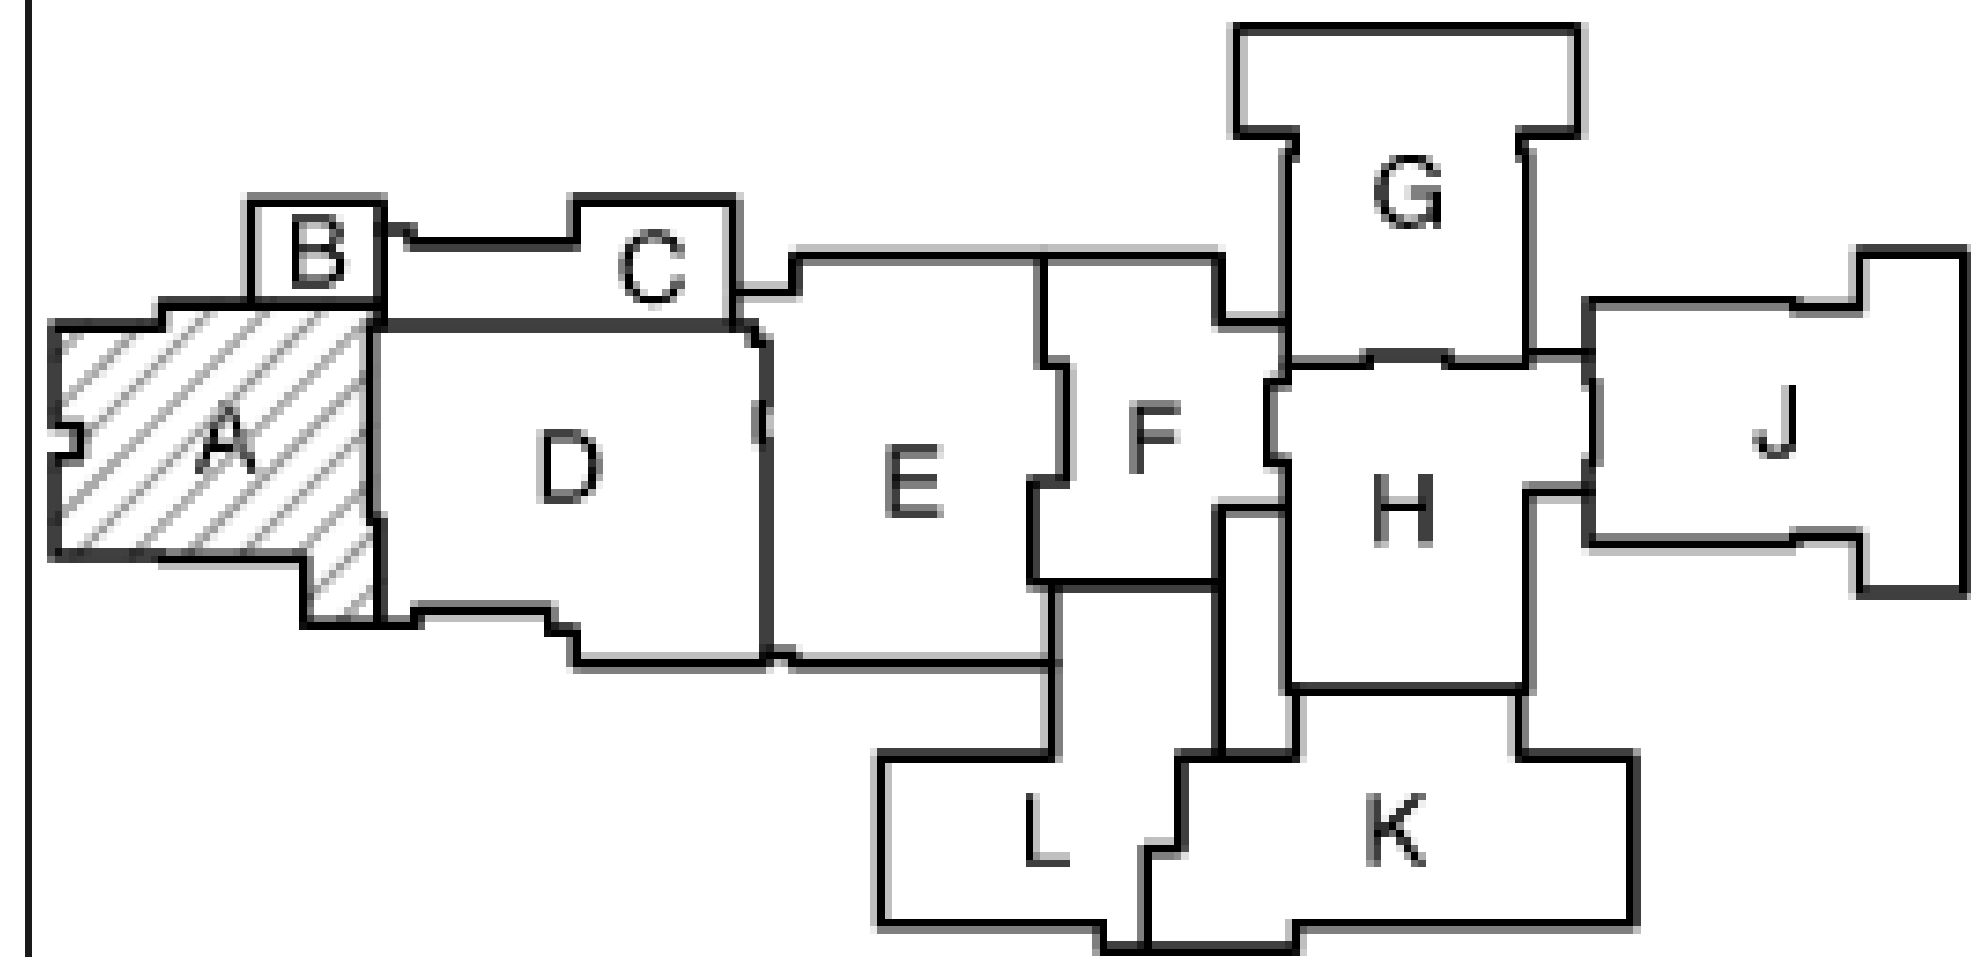

| Zones                          |
|--------------------------------|
| April 2022 - December 2023     |
| April 2022 - February 2023     |
| May 2022 - January 2023        |
| June 2022 - January 2023       |
| June 2022 - October 2022       |
| June 2022 - November 2022      |
| July 2022 - December 2022      |
| October 2022 - March 2023      |
| December 2022 - May 2023       |
| March 2023 - July 2023         |
| April 2023 - August 2023       |
| June 2023 - August 2023        |
| June 2023 - September 2023     |
| September 2023 - December 2023 |



## ADDENDUM ONE

**Addendum One (AD.01)** to the drawings and specifications prepared by Gibraltar Design for **Westchester Intermediate School Additions and Renovations** for Duneland School Corporation, Chesterton, Indiana.

All Contractors bidding on this project shall read all of the items covered below and shall comply with all of the requirements as set forth, including any necessary refinements or additions generated by this Addendum and required by the intent of the original contract documents. All Contractors shall acknowledge on their bid form that they have received this Addendum and include the appropriate content of same within their bid proposal.

## SPECIFICATIONS

- 1. Specification Section 08 71 00                      Door Hardware**
  - A. Add Specification Section 08 71 00, Door Hardware, included in this Addendum, to the Project Manual.
- 2. Specification Section 12 35 53                      Science Laboratory Casework & Equipment**
  - A. Add Paragraph 2.7 A.3 to read: "Kewaunee Scientific Corporation, Statesville, North Carolina."

## DRAWINGS

- 3. Civil Sheets: (15 Total)**  
**C-1.2, C-1.3, C-2.0, C-2.1, C-3.0, C-3.1, C-3.2, C-3.3;**  
**C-4.0, C-4.1, C-4.2, C-4.3; C-4.4, C-5.0 and C-5.1**
  - A. Replace Civil Drawing Sheets listed above with fifteen (15) revised full size drawings included in this Addendum.
- 4. Sheets S-001, S-103, S-104, S-105, S-107, S-109**
  - A. Refer to six (6) revised full size drawings, included in this Addendum, for revisions.
- 5. Sheets S-200 thru S-208**
  - A. Refer to nine (9) revised, full-size drawings included in this Addendum, for revisions.
- 6. Sheets S-411, S-412 and S-413**
  - A. Refer to three (3) revised, full-size drawings included in this Addendum, for revisions.
- 7. Sheets S-420 and S-421**
  - A. Refer to two (2) revised, full-size drawings included in this Addendum, for revisions.
- 8. Sheet A-801**
  - A. Change Plan Note 6 to read: "Not Used".
  - B. In the following rooms, provide "RF3" in lieu of "CT": A-114, A-115.
  - C. In the following rooms, provide "B3" in lieu of "TB1": A-114, A-115.

D. Change Plan Note 24 to read: "Paint bottom and face of bulkhead, P4".

**9. Sheets A-802 and A-803**

A. Change Plan Note 6 to read: "Not Used".

B. Change Plan Note 24 to read: "Paint bottom and face of bulkhead, P4".

**10. Sheet A-804**

A. Change Plan Note 6 to read: "Not Used".

B. Change Plan Note 24 to read: "Paint bottom and face of bulkhead, P4".

C. In Rooms E-116, E-117, E-118, E-119, E-120, E-121, E-122, E-123, E-124, E-125 and E-126, provide "QT" in lieu of "PT".

D. In the following rooms, provide "RF3" in lieu of "CT": E-102 and E-103.

E. In the following rooms, provide "B3" in lieu of "TB1": E-102 and E-103.

**11. Sheet A-805**

A. Change Plan Note 6 to read: "Not Used".

B. Change Plan Note 24 to read: "Paint bottom and face of bulkhead, P4".

**12. Sheet A-806**

A. Change Plan Note 6 to read: "Not Used".

B. Change Plan Note 24 to read: "Paint bottom and face of bulkhead, P4".

C. In the following rooms, provide "RF3" in lieu of "CT": G-123 and G-125.

D. In the following rooms, provide "B3" in lieu of "TB1": G-123 and G-125.

**13. Sheet A-807**

A. Change Plan Note 6 to read: "Not Used".

B. Change Plan Note 24 to read: "Paint bottom and face of bulkhead, P4".

C. In the following rooms, provide "RF3" in lieu of "CT": H-127.

D. In the following rooms, provide "B3" in lieu of "TB1": H-127.

E. In the following rooms, provide "B3" in lieu of "B1": H-110, H-111, H-112.

F. In the following rooms, provide "RF3" in lieu of "LVT1": H-110, H-111, H-112.

**14. Sheet A-808**

A. Change Plan Note 6 to read: "Not Used".

B. Change Plan Note 24 to read: "Paint bottom and face of bulkhead, P4".

C. In the following rooms, provide "RF3" in lieu of "CT": J-113, J-115.

D. In the following rooms, provide "B3" in lieu of "TB1": J-113, J-115.

**15. Sheet A-809**

A. Change Plan Note 6 to read: "Not Used".

B. Change Plan Note 24 to read: "Paint bottom and face of bulkhead, P4".

C. In the following rooms, provide "RF3" in lieu of "CT": K-109.

D. In the following rooms, provide "B3" in lieu of "TB1": K-109.



**16. Sheet A-810**

- A. Change Plan Note 6 to read: "Not Used".
- B. Change Plan Note 24 to read: "Paint bottom and face of bulkhead, P4".
- C. In the following rooms, provide "RF3" in lieu of "CT": L-119, L-120.
- D. In the following rooms, provide "B3" in lieu of "TB1": L-119, L-120.
- E. In Extended Learning L-112, change Plan Note 6 to Plan Note 7.

**17. Sheet PD103**

- A. Refer to revised, full-size drawing included in this Addendum, for the following revisions:
  - 1. Added Note 4 to sinks in Art Room ED-116.
  - 2. Added Notes 1 and 4 to fixtures in STEM ED-117.
  - 3. Added Note 4 to sink in Choir ED-121.
  - 4. Added Sheet Note 19 and showed existing piping.
  - 5. Added Note 1 and 2 to fixtures in Toilet ED-103.
  - 6. Added Note 4 to sink in Girls Locker Room ED-110.

**18. Sheet PD104**

- A. Refer to revised, full-size drawing included in this Addendum, for notes added to sanitary piping in Boiler Room EE-06.

**19. Sheet PD107**

- A. Refer to revised, full-size drawing included in this Addendum, for notes added to Toilet EH-112 and EH-113.

**20. Sheet PD005**

- A. Refer to revised, full-size drawing included in this Addendum, for note added to existing piping.

**21. Sheet P-104**

- A. Refer to revised, full-size drawing included in this Addendum, for vent added for greasy waste line.

**22. Sheet P-204**

- A. Refer to revised, full-size drawing included in this Addendum, for 4" VTR added in Receiving E-128.

**23. Sheets FP-004 and FP-005**

- A. Refer to two (2) revised, full-size drawings included in this Addendum, for Sheet Note 1 added to note routing of fire protection piping is conceptual.

**24. Sheets FP-105**

- A. Refer to revised, full-size drawing included in this Addendum, for the following revisions:
  - 1. Sheet Note 1 added to note routing of fire protection piping is conceptual.
  - 2. Added conceptual routing of fire protection piping in chase between Toilet H-123 and H-124.

**25. Sheet FP-106**

- A. Refer to revised, full-size drawing included in this Addendum, for the following revisions:
1. Sheet Note 1 added to note routing of fire protection piping is conceptual.
  2. Added conceptual routing of fire protection piping in chase between Toilet J-119 and J-120.

**26. Sheet EL-105**

- A. Refer to revised, full-size drawing included in this Addendum, for lighting revised in Rooms F-103, F-104, F-105 and F-106 from recessed to pendant style fixtures.

**27. Sheet EP-105**

- A. Replace Sheet EP-105 with full-size drawing included in this Addendum. Fire alarm devices have been added.

**28. Sheet E604**

- A. Refer to revised, full-size drawing included in this Addendum, for fume hood circuit added to Panel PP-6 for Science H-118.

Pages 1 through 4, inclusive, Specification Section 08 71 00, and Forty-Eight (48) Full-Size Drawings, constitute the total makeup of **Addendum One**.



Y:\21-141 Duneland SC - Westchester Intermediate School Additions and Renovations\Specs\Addendum ONE\AD01.doc

## SECTION 08 71 00 – DOOR HARDWARE

### PART 1 - GENERAL

#### 1.01 RELATED DOCUMENTS

- A. Drawings and general provisions of the Contract, including General and Supplementary Conditions and Division 01 Specification Sections, apply to this Section.

#### 1.02 SUMMARY

A. Section includes:

1. Mechanical and electrified door hardware for:
  - a. Swinging doors.
2. Electronic access control system components, including:
  - a. Electronic access control devices.
3. Field verification, preparation and modification of existing doors and frames to receive new door hardware.
4. The intent of the hardware specification is to specify the hardware for interior and exterior doors, and to establish a type, continuity, and standard of quality. However, it is the door hardware supplier's responsibility to thoroughly review existing conditions, schedules, specifications, drawings, and other Contract Documents to verify the suitability of the hardware specified.

- B. Exclusions: Unless specifically listed in hardware sets, hardware is not specified in this section for:

1. Windows
2. Cabinets (casework), including locks in cabinets
3. Signage
4. Toilet accessories
5. Overhead doors

C. Related Sections:

1. Division 01 Section "Alternates" for alternates affecting this section.
2. Division 07 Section "Joint Sealants" for sealant requirements applicable to threshold installation specified in this section.
3. Division 09 sections for touchup, finishing or refinishing of existing openings modified by this section.
4. Division 26 sections for connections to electrical power system and for low-voltage wiring.

5. Division 28 sections for coordination with other components of electronic access control system.

### 1.03 REFERENCES

#### A. UL - Underwriters Laboratories

1. UL 10B - Fire Test of Door Assemblies
2. UL 10C - Positive Pressure Test of Fire Door Assemblies
3. UL 1784 - Air Leakage Tests of Door Assemblies
4. UL 305 - Panic Hardware

#### B. DHI - Door and Hardware Institute

1. Sequence and Format for the Hardware Schedule
2. Recommended Locations for Builders Hardware
3. Key Systems and Nomenclature

#### C. ANSI - American National Standards Institute

1. ANSI/BHMA A156.1 - A156.29, and ANSI/BHMA A156.31 - Standards for Hardware and Specialties

### 1.04 SUBMITTALS

#### A. General:

1. Submit in accordance with Conditions of Contract and Division 01 requirements.
2. Highlight, encircle, or otherwise specifically identify on submittals deviations from Contract Documents, issues of incompatibility or other issues which may detrimentally affect the Work.
3. Prior to forwarding submittal, comply with procedures for verifying existing door and frame compatibility for new hardware, as specified in PART 3, "EXAMINATION" article, herein.

#### B. Action Submittals:

1. Product Data: Technical product data for each item of door hardware, installation instructions, maintenance of operating parts and finish, and other information necessary to show compliance with requirements.
2. Riser and Wiring Diagrams: After final approval of hardware schedule, submit details of electrified door hardware, indicating:
  - a. Wiring Diagrams: For power, signal, and control wiring and including:
    - 1) Details of interface of electrified door hardware and building safety and security systems.
    - 2) Schematic diagram of systems that interface with electrified door hardware.
    - 3) Point-to-point wiring.
    - 4) Risers.

3. Samples for Verification: If requested by Architect, submit production sample or sample installations of each type of exposed hardware unit in finish indicated, and tagged with full description for coordination with schedule.
  - a. Samples will be returned to supplier. Units that are acceptable to Architect may, after final check of operations, be incorporated into Work, within limitations of key coordination requirements.
4. Door Hardware Schedule: Submit schedule with hardware sets in vertical format as illustrated by Sequence of Format for the Hardware Schedule as published by the Door and Hardware Institute. Indicate complete designations of each item required for each door or opening, include:
  - a. Door Index; include door number, heading number, and Architects hardware set number.
  - b. Opening Lock Function Spreadsheet: List locking device and function for each opening.
  - c. Quantity, type, style, function, size, and finish of each hardware item.
  - d. Name and manufacturer of each item.
  - e. Fastenings and other pertinent information.
  - f. Location of each hardware set cross-referenced to indications on Drawings.
  - g. Explanation of all abbreviations, symbols, and codes contained in schedule.
  - h. Mounting locations for hardware.
  - i. Door and frame sizes and materials.
  - j. Name and phone number for local manufacturer's representative for each product.
  - k. Operational Description of openings with any electrified hardware (locks, exits, electromagnetic locks, electric strikes, automatic operators, door position switches, magnetic holders or closer/holder units, and access control components).  
Operational description should include operational descriptions for: egress, ingress (access), and fire/smoke alarm connections.
  - l. Submittal Sequence: After field verifying existing conditions, submit door hardware schedule, including and noting any adjustments required based on field verification of existing conditions, concurrent with submissions of Product Data, Samples, and Shop Drawings; Coordinate submission of door hardware schedule with scheduling requirements of other work to facilitate fabrication of other work that is critical in Project construction schedule.
5. Key Schedule:
  - a. After Keying Conference, provide keying schedule listing levels of keying as well as explanation of key system's function, key symbols used and door numbers controlled.
  - b. Use ANSI/BHMA A156.28 "Recommended Practices for Keying Systems" as guideline for nomenclature, definitions, and approach for selecting optimal keying system.
  - c. Provide 3 copies of keying schedule for review prepared and detailed in accordance with referenced DHI publication. Include schematic keying diagram and index each key to unique door designations.
  - d. Index keying schedule by door number, keyset, hardware heading number, cross keying instructions, and special key stamping instructions.
  - e. Provide one complete bitting list of key cuts and one key system schematic illustrating system usage and expansion.
    - 1) Forward bitting list, key cuts and key system schematic directly to Owner, by means as directed by Owner.

- f. Prepare key schedule by or under supervision of supplier, detailing Owner's final keying instructions for locks.
  - 6. Templates: After final approval of hardware schedule, provide templates for doors, frames and other work specified to be factory or shop prepared for door hardware installation.
- C. Informational Submittals:
- 1. Qualification Data: For Supplier, Installer and Architectural Hardware Consultant.
  - 2. Product data for electrified door hardware:
    - a. Certify that door hardware approved for use on types and sizes of labeled fire-rated doors complies with listed fire-rated door assemblies.
  - 3. Certificates of Compliance:
    - a. UL listings for fire-rated hardware and installation instructions if requested by Architect or Authority Having Jurisdiction.
    - b. Installer Training Meeting Certification: Letter of compliance, signed by Contractor, attesting to completion of installer training meeting specified in "QUALITY ASSURANCE" article, herein.
    - c. Electrified Hardware Coordination Conference Certification: Letter of compliance, signed by Contractor, attesting to completion of electrified hardware coordination conference, specified in "QUALITY ASSURANCE" article, herein.
  - 4. Warranty: Special warranty specified in this Section.
- D. Closeout Submittals:
- 1. Operations and Maintenance Data: Provide in accordance with Division 01 and include:
    - a. Complete information on care, maintenance, and adjustment; data on repair and replacement parts, and information on preservation of finishes.
    - b. Catalog pages for each product.
    - c. Factory order acknowledgement numbers (for warranty and service)
    - d. Name, address, and phone number of local representative for each manufacturer.
    - e. Parts list for each product.
    - f. Final approved hardware schedule, edited to reflect conditions as-installed.
    - g. Final keying schedule
    - h. Copies of floor plans with keying nomenclature
    - i. As-installed wiring diagrams for each opening connected to power, both low voltage and 110 volts.
    - j. Copy of warranties including appropriate reference numbers for manufacturers to identify project.

## 1.05 QUALITY ASSURANCE

- A. Requirements of Regulatory Agencies:
- 1. Furnish finish hardware to comply with the requirements of laws, codes, ordinances, and regulations of the governmental authorities having jurisdiction where such requirements exceed the requirements of the Specifications.

2. Furnish finish hardware to comply with the requirements of the regulations for public building accommodations for physically handicapped persons of the governmental authority having jurisdiction and to comply with Americans with Disabilities Act.
  3. Provide hardware for fire rated openings in compliance with NFPA 80 and state and local building code requirements. Provide only hardware that has been tested and listed by UL for types and sizes of doors required and complies with requirements of door and door frame labels.
- B. Supplier:
1. Mechanical Hardware
    - a. Shall be an established firm dealing in contract builders' hardware. Distributor must have adequate inventory, qualified personnel on staff and be located within 100 miles of the project. The distributor must be a factory-authorized dealer for all materials required. The supplier shall be or have in employment an Architectural Hardware Consultant (AHC).
    - b. Door Hardware distributor/supplier listed on the Bid Form shall be a factory authorized distributor for the hardware specified. This requirement will not be allowed to be met by a non-factory authorized dealer subcontracting to a factory authorized dealer. Any submitted bid that attempts to circumvent this requirement will be considered non-response and will be removed from consideration.
  2. Electrified Hardware:
    - a. Shall be an experienced door hardware supplier who has completed projects with electrified door hardware similar in material, design, and extent to that indicated for this project, whose work has resulted in construction with a record of successful in-service performance, and who is acceptable to manufacturer of primary materials. The supplier must be a factory-authorized distributor for all materials required.
    - b. Shall prepare data for electrified door hardware, including shop drawings, based on testing and engineering analysis of manufacturer's standard units in assemblies similar to those indicated for this project.
    - c. Shall have experience in providing consulting services for electrified door hardware installations.
- C. Installer Qualifications:
1. Qualified tradesmen, skilled in application of commercial grade hardware with record of successful in-service performance for installing door hardware similar in quantity, type, and quality to that indicated for this Project.
- D. Architectural Hardware Consultant Qualifications: Person who is experienced in providing consulting services for door hardware installations that are comparable in material, design, and extent to that indicated for this Project and meets these requirements:
1. For door hardware, DHI-certified, Architectural Hardware Consultant (AHC).
  2. Can provide installation and technical data to Architect and other related subcontractors.
  3. Can inspect and verify components are in working order upon completion of installation.
  4. Capable of producing wiring diagrams.
  5. Capable of coordinating installation of electrified hardware with Architect and electrical engineers.
- E. Single Source Responsibility: Obtain each type of door hardware from single manufacturer.

- F. Fire-Rated Door Openings: Provide door hardware for fire-rated openings that complies with NFPA 80 and requirements of authorities having jurisdiction. Provide only items of door hardware that are listed products tested by Underwriters Laboratories, Intertek Testing Services, or other testing and inspecting organizations acceptable to authorities having jurisdiction for use on types and sizes of doors indicated, based on testing at positive pressure and according to NFPA 252 or UL 10C and in compliance with requirements of fire-rated door and door frame labels.
- G. Electrified Door Hardware: Listed and labeled as defined in NFPA 70, Article 100, by testing agency acceptable to authorities having jurisdiction.
- H. Accessibility Requirements: For door hardware on doors in an accessible route, comply with governing accessibility regulations cited in "REFERENCES" article, herein.
- I. Field Verification Conference
  - 1. To ensure design intent can be met after verification of existing conditions, conduct an onsite door by door review of the submittal
  - 2. Conduct the meeting with the architect and the owner to complete a final verification of how each door will function, including product to be supplied.
- J. Keying Conference
  - 1. Incorporate keying conference decisions into final keying schedule after reviewing door hardware keying system including:
    - a. Function of building, flow of traffic, purpose of each area, degree of security required, and plans for future expansion.
    - b. Preliminary key system schematic diagram.
    - c. Requirements for key control system.
    - d. Requirements for access control.
    - e. Address for delivery of keys.
  - 2. Attendees of Keying Conference: Owner, Contractor, Architect, Installer, Owner's security consultant and Supplier's Architectural Hardware Consultant.
- K. Pre-installation Conference
  - 1. Review and finalize construction schedule and verify availability of materials, Installer's personnel, equipment, and facilities needed to make progress and avoid delays.
  - 2. Inspect and discuss preparatory work performed by other trades.
  - 3. Inspect and discuss electrical roughing-in for electrified door hardware.
  - 4. Review sequence of operation for each type of electrified door hardware.
  - 5. Review required testing, inspecting, and certifying procedures.
- L. Coordination Conferences:
  - 1. Installation Coordination Conference: Prior to hardware installation, schedule and hold meeting to review questions or concerns related to proper installation and adjustment of door hardware.
  - 2. Electrified Hardware Coordination Conference: Prior to ordering electrified hardware, schedule and hold meeting to coordinate door hardware with security, electrical, doors and frames, and other related suppliers.



#### 1.06 DELIVERY, STORAGE, AND HANDLING

- A. Inventory door hardware on receipt and provide secure lock-up for hardware delivered to Project site.
- B. Tag each item or package separately with identification coordinated with final door hardware schedule, and include installation instructions, templates, and necessary fasteners with each item or package.
  - 1. Deliver each article of hardware in manufacturer's original packaging.
- C. Project Conditions:
  - 1. Maintain manufacturer-recommended environmental conditions throughout storage and installation periods.
  - 2. Provide secure lock-up for door hardware delivered to Project. Control handling and installation of hardware items so that completion of Work will not be delayed by hardware losses both before and after installation.
- D. Protection and Damage:
  - 1. Promptly replace products damaged during shipping.
  - 2. Handle hardware in manner to avoid damage, marring, or scratching. Correct, replace or repair products damaged during Work.
  - 3. Protect products against malfunction due to paint, solvent, cleanser, or any chemical agent.
- E. Deliver keys to Owner by registered mail or overnight package service.

#### 1.07 COORDINATION

- A. Coordinate layout and installation of floor-recessed door hardware with floor construction. Cast anchoring inserts into concrete.
- B. Installation Templates: Distribute for doors, frames, and other work specified to be factory or shop prepared. Check Shop Drawings of other work to confirm that adequate provisions are made for locating and installing door hardware to comply with indicated requirements.
- C. Security: Coordinate installation of door hardware, access control, and keying with Owner's security consultant.
- D. Electrical System Roughing-In: Coordinate layout and installation of electrified door hardware with connections to power supplies and building safety and security systems.
- E. Existing Openings: Where existing doors, frames and/or hardware are to remain, field verify existing functions, conditions and preparations and coordinate to suit opening conditions and to provide proper door operation.

## 1.08 WARRANTY

- A. Warranty: Manufacturer's standard form in which manufacturer agrees to repair or replace components of door hardware that fail in materials or workmanship within specified warranty period.
1. Warranty Period: Beginning from date of Substantial Completion, for durations indicated.
    - a. Closers:
      - 1) Mechanical: 30 years.
    - b. Automatic Operators: 2 years.
    - c. Exit Devices:
      - 1) Mechanical: 3 years.
      - 2) Electrified: 1 year.
    - d. Locksets:
      - 1) Mechanical: 3 years; Schlage ND series, 10 years
      - 2) Electrified: 1 year.
    - e. Continuous Hinges: Lifetime warranty.
    - f. Key Blanks: Lifetime
  2. Warranty does not cover damage or faulty operation due to improper installation, improper use or abuse.

## 1.09 MAINTENANCE

- A. Maintenance Tools: Furnish complete set of special tools required for maintenance and adjustment of hardware, including changing of cylinders.

## PART 2 - PRODUCTS

### 2.01 MANUFACTURERS

- A. The Owner requires use of certain products for their unique characteristics and project suitability to insure continuity of existing and future performance and maintenance standards. After investigating available product offerings, the Awarding Authority has elected to prepare proprietary specifications. These products are specified with the notation: "No Substitute."
1. Where "No Substitute" is noted, submittals and substitution requests for other products will not be considered.
- B. Approval of manufacturers and/or products other than those listed as "Scheduled Manufacturer" or "Acceptable Manufacturers" in the individual article for the product category shall be in accordance with QUALITY ASSURANCE article, herein.
- C. Approval of products from manufacturers indicated in "Acceptable Manufacturers" is contingent upon those products providing all functions and features and meeting all requirements of scheduled manufacturer's product.

- D. Where specified hardware is not adaptable to finished shape or size of members requiring hardware, furnish suitable types having same operation and quality as type specified, subject to Architect's approval.

## 2.02 MATERIALS

### A. Fasteners

1. Provide hardware manufactured to conform to published templates, generally prepared for machine screw installation.
2. Furnish screws for installation with each hardware item. Finish exposed (exposed under any condition) screws to match hardware finish, or, if exposed in surfaces of other work, to match finish of this other work including prepared for paint surfaces to receive painted finish.
3. Provide concealed fasteners for hardware units exposed when door is closed except when no standard units of type specified are available with concealed fasteners. Do not use thru-bolts for installation where bolt head or nut on opposite face is exposed in other work unless thru-bolts are required to fasten hardware securely. Review door specification and advise Architect if thru-bolts are required.
4. Install hardware with fasteners provided by hardware manufacturer.

### B. Modification and Preparation of Existing Doors: Where existing door hardware is indicated to be removed and reinstalled.

1. Provide necessary fillers, Dutchmen, reinforcements, and fasteners, compatible with existing materials, as required for mounting new opening hardware and to cover existing door and frame preparations.
2. Use materials which match materials of adjacent modified areas.
3. When modifying existing fire-rated openings, provide materials permitted by NFPA 80 as required to maintain fire-rating.

### C. Provide screws, bolts, expansion shields, drop plates and other devices necessary for hardware installation.

1. Where fasteners are exposed to view: Finish to match adjacent door hardware material.

## 2.03 HINGES

### A. Manufacturers and Products:

1. Scheduled Manufacturer and Product: Ives 5BB series.
2. Acceptable Manufacturers and Products: Hager BB series (ECBB series not approved), McKinney TA/T4A series (MacPro series not approved).

### B. Requirements:

1. Provide hinges conforming to ANSI/BHMA A156.1.
2. 1-3/4 inch (44 mm) thick doors, up to and including 36 inches (914 mm) wide:
  - a. Exterior: Standard weight, bronze or stainless steel, 4-1/2 inches (114 mm) high
  - b. Interior: Standard weight, steel, 4-1/2 inches (114 mm) high

3. 1-3/4 inch (44 mm) thick doors over 36 inches (914 mm) wide:
  - a. Exterior: Heavy weight, bronze/stainless steel, 5 inches (127 mm) high
  - b. Interior: Heavy weight, steel, 5 inches (127 mm) high
4. 2 inches or thicker doors:
  - a. Exterior: Heavy weight, bronze or stainless steel, 5 inches (127 mm) high
  - b. Interior: Heavy weight, steel, 5 inches (127 mm) high
5. Provide three hinges per door leaf for doors 90 inches (2286 mm) or less in height, and one additional hinge for each 30 inches (762 mm) of additional door height.
6. Where new hinges are specified for existing doors or existing frames, provide new hinges of identical size to hinge preparation present in existing door or existing frame.
7. Hinge Pins: Except as otherwise indicated, provide hinge pins as follows:
  - a. Steel Hinges: Steel pins
  - b. Non-Ferrous Hinges: Stainless steel pins
  - c. Out-Swinging Exterior Doors: Non-removable pins
  - d. Out-Swinging Interior Lockable Doors: Non-removable pins
  - e. Interior Non-lockable Doors: Non-rising pins
8. Width of hinges: 4-1/2 inches (114 mm) at 1-3/4 inch (44 mm) thick doors, and 5 inches (127 mm) at 2 inches (51 mm) or thicker doors. Adjust hinge width as required for door, frame, and wall conditions to allow proper degree of opening.

## 2.04 CONTINUOUS HINGES

### A. Aluminum Geared

1. Manufacturers:
  - a. Scheduled Manufacturer: Ives.
  - b. Acceptable Manufacturers: Pemko, Select.
2. Requirements:
  - a. Provide aluminum geared continuous hinges conforming to ANSI/BHMA A156.26, Grade 1.
  - b. Provide aluminum geared continuous hinges, where specified in the hardware sets, fabricated from 6063-T6 aluminum.
  - c. Provide split nylon bearings at each hinge knuckle for quiet, smooth, self-lubricating operation.
  - d. Provide hinges capable of supporting door weights up to 450 pounds, and successfully tested for 1,500,000 cycles.
  - e. On fire-rated doors, provide aluminum geared continuous hinges that are classified for use on rated doors by testing agency acceptable to authority having jurisdiction.
  - f. Install hinges with fasteners supplied by manufacturer.
  - g. Provide hinges 1 inch (25 mm) shorter in length than nominal height of door, unless otherwise noted or door details require shorter length and with symmetrical hole pattern.

## 2.05 ELECTRIC POWER TRANSFER

- A. Manufacturers:
  - a. Scheduled Manufacturer: Von Duprin EPT-10.
  - b. Acceptable Manufacturers: Precision EPT-12C, Securitron CEPT-10.
- B. Provide power transfer with electrified options as scheduled in the hardware sets. Provide with number and gage of wires sufficient to accommodate electric function of specified hardware.
- C. Locate electric power transfer per manufacturer's template and UL requirements, unless interference with operation of door or other hardware items.

## 2.06 FLUSH BOLTS

- A. Manufacturers:
  - 1. Scheduled Manufacturer: Ives.
  - 2. Acceptable Manufacturers: Burns, Rockwood.
- B. Requirements:
  - 1. Provide automatic, constant latching, and manual flush bolts with forged bronze or stainless-steel face plates, extruded brass levers, and with wrought brass guides and strikes. Provide 12 inch (305 mm) steel or brass rods at doors up to 90 inches (2286 mm) in height. For doors over 90 inches (2286 mm) in height increase top rods by 6 inches (152 mm) for each additional 6 inches (152 mm) of door height. Provide dust-proof strikes at each bottom flush bolt.

## 2.07 COORDINATORS

- A. Manufacturers:
  - 1. Scheduled Manufacturer: Ives.
  - 2. Acceptable Manufacturers: Rockwood, Trimco.
- B. Requirements:
  - 1. Where pairs of doors are equipped with automatic flush bolts, an astragal, or other hardware that requires synchronized closing of the doors, provide bar-type coordinating device, surface applied to underside of stop at frame head.
  - 2. Provide filler bar of correct length for unit to span entire width of opening, and appropriate brackets for parallel arm door closers, surface vertical rod exit device strikes or other stop mounted hardware. Factory-prepared coordinators for vertical rod devices as specified.

## 2.08 MORTISE LOCKS

- A. Manufacturers and Products:

1. Scheduled Manufacturer and Product: Schlage L9000 series.
2. Acceptable Manufacturers and Products: No Substitutions – Facility Standard.

**B. Requirements:**

1. Provide mortise locks conforming to ANSI/BHMA A156.13 Series 1000, Grade 1, and UL Listed for 3 hour fire doors.
2. Indicators: Where specified, provide indicator window measuring a minimum 2 inch x 1/2 inch with 180 degree visibility. Provide messages color-coded with full text and/or symbols, as scheduled, for easy visibility.
  - a. Inside Security Indicator: Provide indicator above cylinder or thumbturn for visibility during lockdown that identifies the outside trim as locked/unlocked status of the door.
  - b. Outside Status Indicator: Provide indicator above cylinder for visibility that identifies the outside trim as locked/unlocked status of the door.
  - c. Outside Occupancy Indicator: Provide indicator above cylinder or emergency release for visibility while operating the lock that identifies an occupied/unoccupied status of the lock or latch.
3. Provide locks manufactured from heavy gauge steel, containing components of steel with a zinc dichromate plating for corrosion resistance.
4. Provide lock case that is multi-function and field reversible for handing without opening case. Cylinders: Refer to "KEYING" article, herein.
5. Verify lock functions with owner prior to ordering.
6. Install thumb turns so they are in vertical position when doors are unlocked and in horizontal position when doors are locked.
7. Install thumb turns so they are in vertical position when doors are unlocked and in horizontal position when doors are locked.
8. Provide locks with standard 2-3/4 inches (70 mm) backset with full 3/4 inch (19 mm) throw stainless steel mechanical anti-friction latchbolt. Provide deadbolt with full 1 inch (25 mm) throw, constructed of stainless steel.
9. Provide standard ASA strikes unless extended lip strikes are necessary to protect trim.
10. Provide electrified options as scheduled in the hardware sets. Where scheduled, provide switches and sensors integrated into the locks and latches.
11. Provide motor based electrified locksets with electrified options as scheduled in the hardware sets and comply with the following requirements:
  - a. Universal input voltage – single chassis accepts 12 or 24V DC to allow for changes in the field without changing lock chassis.
  - b. Fail Safe/Fail Secure – changing mode between electrically locked (fail safe) and electrically unlocked (fail secure) is field selectable without opening the lock case
  - c. Low maximum current draw – maximum 0.4 amps to allow for multiple locks on a single power supply.
  - d. Low holding current – maximum 0.01 amps to produce minimal heat, eliminate "hot levers" in electrically locked applications, and to provide reliable operation in wood doors that provide minimal ventilation and air flow.
  - e. Request to Exit Switch (RX) –
    - 1) Modular Design – provide electrified locks capable of using, adding, or changing a modular RX switch without opening the lock case.
    - 2) Monitoring – where scheduled, provide a request to exit (RX) switch that detects rotation of the inside lever.
  - f. Door Position Sensor (DPS) –

- 1) Monitoring – where scheduled, provide a door position sensor (DPS) switch that detects the position of the door in relation to the frame.
- g. Connections – provide quick-connect Molex system standard.
12. Lever Trim: Solid brass, bronze, or stainless steel, cast or forged in design specified, with wrought roses and external lever spring cages. Provide thru-bolted levers with 2-piece spindles.
  - a. Lever Design: Schlage 06N
  - b. Tactile Warning (Knurling): Where required by authority having jurisdiction. Provide on levers on exterior (secure side) of doors serving rooms considered to be hazardous.

## 2.09 CYLINDRICAL LOCKS – GRADE 1

### A. Manufacturers and Products:

1. Scheduled Manufacturer and Product: Schlage ND series.
- ~~2. Acceptable Manufacturers and Products: No Substitutions – Facility Standard.~~

### B. Requirements:

1. Provide cylindrical locks conforming to ANSI/BHMA A156.2 Series 4000, Grade 1, and UL Listed for 3 hour fire doors.
2. Cylinders: Refer to “KEYING” article, herein.
3. Verify lock functions with owner prior to ordering.
4. Provide locks with standard 2-3/4 inches (70 mm) backset, unless noted otherwise, with 1/2 inch latch throw. Provide proper latch throw for UL listing at pairs.
5. Provide locksets with separate anti-rotation thru-bolts, and no exposed screws.
6. Provide independently operating levers with two external return spring cassettes mounted under roses to prevent lever sag.
7. Provide standard ASA strikes unless extended lip strikes are necessary to protect trim.
8. Lever Trim: Solid cast levers without plastic inserts and wrought roses on both sides.
  - a. Lever Design: Schlage Rhodes
  - b. Tactile Warning (Knurling): Where required by authority having jurisdiction. Provide on levers on exterior (secure side) of doors serving rooms considered to be hazardous.

## 2.10 AUXILIARY LOCKS

### A. Deadlocks:

1. Manufacturers and Products:
  - a. Scheduled Manufacturer and Product: Schlage L400 series.
  - b. Acceptable Manufacturers and Products: No Substitutions – Facility Standard.
2. Requirements:

- a. Provide mortise deadlock series conforming to ANSI/BHMA A156 and function as specified.
- b. Cylinders: Refer to "KEYING" article, herein.
- c. Provide deadlocks with standard 2-3/4 inches (70 mm) backset. Provide deadbolt with full 1 inch (25 mm) throw, constructed of stainless steel.
- d. Provide manufacturer's standard strike.

## 2.11 EXIT DEVICES

### A. Manufacturers and Products:

1. Scheduled Manufacturer and Product: Von Duprin 99/33A series.
2. Acceptable Manufacturers and Products: No Substitutions – Facility Standard.

### B. Requirements:

1. Provide exit devices tested to ANSI/BHMA A156.3 Grade 1 and UL listed for Panic Exit or Fire Exit Hardware.
2. Cylinders: Refer to "KEYING" article, herein.
3. Verify exit device functions with owner prior to ordering.
4. Provide touchpad type exit devices, fabricated of brass, bronze, stainless steel, or aluminum, plated to standard architectural finishes to match balance of door hardware.
5. Touchpad must extend a minimum of one half of door width. No plastic inserts are allowed in touchpads.
6. Provide exit devices with deadlatching feature for security and for future addition of alarm kits and/or other electrified requirements.
7. Provide flush end caps for exit devices.
8. Provide exit devices with manufacturer's approved strikes.
9. Provide exit devices cut to door width and height. Install exit devices at height recommended by exit device manufacturer, allowable by governing building codes, and approved by Architect.
10. Mount mechanism case flush on face of doors, or provide spacers to fill gaps behind devices. Where glass trim or molding projects off face of door, provide glass bead kits.
11. Provide cylinder or hex-key dogging as specified at non fire-rated openings.
12. Removable Mullions: 2 inches (51 mm) x 3 inches (76 mm) steel tube. Where scheduled as keyed removable mullion, provide type that can be removed by use of a keyed cylinder, which is self-locking when re-installed.
13. Provide factory drilled weep holes for exit devices used in full exterior application, highly corrosive areas, and where noted in hardware sets.
14. Provide electrified options as scheduled.
15. Concealed Vertical Cable Exit Devices: provide cable-actuated concealed vertical latch system in two-point for non-rated or fire rated wood doors up to a 90 minute rating and less bottom latch (LBL) configuration for non-rated or fire rated wood doors up to 20 minute rating. Vertical rods not permitted.
  - a. Cable: Stainless steel with abrasive resistant coating. Conduit and core wire ends snap into latch and center slides without use of tools.
  - b. Wood Door Prep: Maximum 1 inch x 1.1875 inch x 3.875 inches top latch pocket and 1 inch x 1.1875 inch x 5 inches bottom latch pocket which does not require the use of a metal wrap or edge for non-rated or fire rated wood doors up to a 45 minute rating.
  - c. Latchbolts and Blocking Cams: Manufactured from sintered metal low carbon copper-infiltrated steel, with molybdenum disulfide low friction coating.



- d. Top Latchbolt: Minimum 0.38 inch (10 mm) and greater than 90 degree engagement with strike to prevent door and frame separation under high static load.
  - e. Bottom Latchbolt: Minimum of 0.44 inch (11 mm) engagement with strike.
  - f. Product Cycle Life: 1,000,000 cycles.
  - g. Latch Operation: Top and bottom latch operate independently of each other. Top latch fully engages top strike even when bottom latch is compromised. Separate trigger mechanisms not permitted.
  - h. Latch release does not require separate trigger mechanism.
  - i. Cable and latching system characteristics:
    - 1) Installed independently of exit device installation, and capable of functioning on door prior to device and trim installation.
    - 2) Connected to exit device at single point in steel and aluminum doors, and two points for top and bottom latches in wood doors.
    - 3) Bottom latch height adjusted, from single point for steel and aluminum doors and two points for wood doors, after system is installed and connected to exit device, while door is hanging
    - 4) Bottom latch position altered up and down minimum of 2 inches (51 mm) in steel and aluminum doors without additional adjustment. Bottom latch deadlocks in every adjustment position in wood doors.
    - 5) Top and bottom latches in steel and aluminum doors and top latch in wood doors may be removed while door is hanging.
16. Top latch mounting: double or single tab mount for steel doors, face mount for aluminum doors eliminating requirement of tabs, and double tab mount for wood doors.
17. Provide exit devices with optional trim designs to match other lever and pull designs used on the project.
- a. Tactile Warning (Knurling): Where required by authority having jurisdiction. Provide on levers on exterior (secure side) of doors serving rooms considered to be hazardous.

## 2.12 ELECTRIC STRIKES

### A. Manufacturers and Products:

- 1. Scheduled Manufacturer and Product: Von Duprin 6000 Series.
- 2. Acceptable Manufacturers and Products: Folger Adam 300 Series, HES 1006 Series.

### B. Requirements:

- 1. Provide electric strikes designed for use with type of locks shown at each opening.
- 2. Provide electric strikes UL Listed as burglary-resistant.
- 3. Where required, provide electric strikes UL Listed for fire doors and frames.
- 4. Provide transformers and rectifiers for each strike as required. Verify voltage with electrical contractor.

## 2.13 PASSIVE INFRARED MOTION SENSORS

### A. Manufacturers and Products:

- 1. Scheduled Manufacturer and Product: Schlage SCAN II Series.

2. Acceptable Manufacturers and Products: RCI 915 Series, Securitron XMS Series, Security Door Controls MD-31D Series.

B. Requirements:

1. Provide motion sensors as specified in hardware groups.

## 2.14 POWER SUPPLIES

A. Manufacturers and Products:

1. Scheduled Manufacturer and Product: Schlage or Von Duprin PS900 series
2. Acceptable Manufacturers and Products: No Substitutions

B. Requirements:

1. Provide power supplies, recommended and approved by manufacturer of electrified locking component, for operation of electrified locks, electrified exit devices, magnetic locks, electric strikes, and other components requiring power supply.
2. Provide appropriate quantity and size of power supplies necessary for proper operation of electrified locking components as recommended by manufacturer of electrified locking components with consideration for each electrified component using power supply, location of power supply, and approved wiring diagrams. Locate power supplies as directed by Architect.
3. Provide appropriate option boards for power supplies necessary for proper operation of the electrified locking components as recommended by the manufacturer of the electrified locking components with consideration for each electrified component used in the system.
4. Provide regulated and filtered 24 VDC power supply and UL class 2 listed.
5. Options:
  - a. Provide power supply, where specified, with internal capability of charging sealed backup batteries 24 VDC, in addition to operating DC load.
  - b. Provide sealed batteries for battery back-up at each power supply where specified.
  - c. Provide keyed power supply cabinet.
6. Provide power supply in an enclosure, complete, and requiring 120VAC to fused input.
7. Provide power supply with emergency release terminals, where specified, that allow release of all devices upon activation of fire alarm system complete with fire alarm input for initiating "no delay" exiting mode.

## 2.15 CYLINDERS

A. Manufacturers:

1. Scheduled Manufacturer: Schlage
2. Acceptable Manufacturers: No Substitutions – Facility Standard

B. Requirements:

1. Provide cylinders/cores, from the same manufacturer of locksets, compliant with ANSI/BHMA A156.5; latest revision, Section 12, Grade 1; permanent cylinders; cylinder

- face finished to match lockset, manufacturer's series as indicated. Refer to "KEYING" article, herein.
2. Provide cylinders in the below-listed configuration(s), distributed throughout the Project as indicated.
    - a. Match owner's existing system.
    - b. Cylinder/Core Type: Large Format or Full Size Interchangeable Core (LFIC/FSIC).
  3. Nickel silver bottom pins.
  4. Replaceable Construction Cores.
    - a. Provide temporary construction cores replaceable by permanent cores, furnished in accordance with the following requirements.
      - 1) 2 construction control keys.
      - 2) 12 construction change (day) keys.

## 2.16 KEYING

- A. Provide a factory registered keying system, complying with guidelines in ANSI/BHMA A156.28, incorporating decisions made at keying conference.
- B. Requirements:
  1. Provide keying system capable of multiplex masterkeying.
  2. Permanent cylinders/cores keyed by the manufacturer according to the following key system.
    - a. Keying system as directed by the Owner.
    - b. Match Owner's existing system.
    - c. (Great)Grand Master Key System: Cylinders/cores operated by change (day) keys and subsequent masters (including grand/great grand) keys.
  3. Forward bitting list and keys separately from cylinders, by means as directed by Owner. Failure to comply with forwarding requirements shall be cause for replacement of cylinders/cores involved at no additional cost to Owner.
  4. Provide keys with the following features:
    - a. Material: Nickel silver; minimum thickness of .107-inch (2.3mm).
  5. Identification:
    - a. Mark permanent cylinders/cores and keys with applicable blind code per DHI publication "Keying Systems and Nomenclature" for identification. Blind code marks shall not include actual key cuts.
    - b. Identification stamping provisions must be approved by the Architect and Owner.
    - c. Stamp keys with Owner's unique key system facility code as established by the manufacturer; key symbol and embossed or stamped with "DO NOT DUPLICATE".
    - d. Failure to comply with stamping requirements shall be cause for replacement of keys involved at no additional cost to Owner.
    - e. Verify with owner if permanent cylinders/cores and/or keys are to be shipped directly to Owner or to Contractor.
  6. Quantity: Furnish in the following quantities.

- a. Change (Day) Keys: 3 per cylinder/core.
- b. Permanent Control Keys: 3 (if required).
- c. Master Keys: 6 per master.
- d. Unused balance of key blanks shall be furnished to Owner with the cut keys.

## 2.17 DOOR CLOSERS

### A. Manufacturers and Products:

1. Scheduled Manufacturer and Product: LCN 4040XP series.
2. Acceptable Manufacturers and Products: No Substitutions – Facility Standard.

### B. Requirements:

1. Provide door closers conforming to ANSI/BHMA A156.4 Grade 1 requirements by BHMA certified independent testing laboratory. ISO 9000 certify closers. Stamp units with date of manufacture code.
2. Provide door closers with fully hydraulic, full rack and pinion action with high strength cast iron cylinder, and full complement bearings at shaft.
3. Cylinder Body: 1-1/2 inch (38 mm) diameter with 3/4 inch (19 mm) diameter double heat-treated pinion journal.
4. Hydraulic Fluid: Fireproof, passing requirements of UL10C, and requiring no seasonal closer adjustment for temperatures ranging from 120 degrees F to -30 degrees F.
5. Spring Power: Continuously adjustable over full range of closer sizes, and providing reduced opening force as required by accessibility codes and standards.
6. Hydraulic Regulation: By tamper-proof, non-critical valves, with separate adjustment for latch speed, general speed, and backcheck.
7. Provide closers with solid forged steel main arms and factory assembled heavy-duty forged forearms for parallel arm closers.
8. Pressure Relief Valve (PRV) Technology: Not permitted.
9. Finish for Closer Cylinders, Arms, Adapter Plates, and Metal Covers: Powder coating finish which has been certified to exceed 100 hours salt spray testing as described in ANSI Standard A156.4 and ASTM B117, or has special rust inhibitor (SRI).
10. Provide special templates, drop plates, mounting brackets, or adapters for arms as required for details, overhead stops, and other door hardware items interfering with closer mounting.

## 2.18 ELECTRO-HYDRAULIC AUTOMATIC OPERATORS

### A. Manufacturers and Products:

1. Scheduled Manufacturer and Product: LCN 4600 series.
2. Acceptable Manufacturers and Products: No Substitutions – Facility Standard.

### B. Requirements:

1. Provide low energy automatic operator units with hydraulic closer complying with ANSI/BHMA A156.19.
2. Hydraulic Fluid: Fireproof, passing requirements of UL10C, and requiring no seasonal closer adjustment for temperatures ranging from 120 degrees F to -30 degrees F.

3. Provide units with conventional door closer opening and closing forces unless power operator motor is activated. Provide door closer assembly with adjustable spring size, back-check, and opening and closing speed adjustment valves to control door
4. Provide units with on/off switch for manual operation, motor start up delay, vestibule interface delay, electric lock delay, and door hold open delay.
5. Provide units with conventional door closer opening and closing forces unless power operator motor is activated. Provide door closer assembly with adjustable spring size, back-check valve, sweep valve, latch valve to control door.
6. Provide drop plates, brackets, or adapters for arms as required for details.
7. Provide hard-wired actuator switches for operation as specified.
8. Provide weather-resistant actuators at exterior applications.
9. Provide key switches with LED's, recommended and approved by manufacturer of automatic operator as required for function described in operation description of hardware group below. Cylinders: Refer to "KEYING" article, herein.
10. Provide complete assemblies of controls, switches, power supplies, relays, and parts/material recommended and approved by manufacturer of automatic operator for each individual leaf. Actuators control both doors simultaneously at pairs. Sequence operation of exterior and vestibule doors with automatic operators to allow ingress or egress through both sets of openings as directed by Architect. Locate actuators, key switches, and other controls as directed by Architect.
11. Provide units with vestibule inputs that allow sequencing operation of two units, and SPDT relay for interfacing with latching or locking devices.

## 2.19 DOOR TRIM

### A. Manufacturers:

1. Scheduled Manufacturer: Ives.
2. Acceptable Manufacturers: Rockwood, Trimco.

### B. Requirements:

1. Provide push plates 4 inches (102 mm) wide by 16 inches (406 mm) high by 0.050 inch (1 mm) thick and beveled 4 edges. Where width of door stile prevents use of 4 inches (102 mm) wide plate, adjust width to fit.
2. Provide push bars of solid bar stock, diameter and length as scheduled. Provide push bars of sufficient length to span from center to center of each stile. Where required, mount back to back with pull.
3. Provide offset pulls of solid bar stock, diameter and length as scheduled. Where required, mount back to back with push bar.
4. Provide flush pulls as scheduled. Where required, provide back-to-back mounted model.
5. Provide pulls of solid bar stock, diameter and length as scheduled. Where required, mount back to back with push bar.
6. Provide pull plates 4 inches (102 mm) wide by 16 inches (406 mm) high by 0.050 inch (1 mm) thick, beveled 4 edges, and prepped for pull. Where width of door stile prevents use of 4 inches (102 mm) wide plate, adjust width to fit.
7. Provide wire pulls of solid bar stock, diameter and length as scheduled.
8. Provide decorative pulls as scheduled. Where required, mount back to back with pull.

## 2.20 PROTECTION PLATES

### A. Manufacturers:

1. Scheduled Manufacturer: Ives.
2. Acceptable Manufacturers: Rockwood, Trimco.

### B. Requirements:

1. Provide kick plates, mop plates, and armor plates minimum of 0.050 inch (1 mm) thick, beveled four edges as scheduled. Furnish with sheet metal or wood screws, finished to match plates.
2. Sizes of plates:
  - a. Kick Plates: 10 inches (254 mm) high by 2 inches (51 mm) less width of door on single doors, 1 inch (25 mm) less width of door on pairs
  - b. Mop Plates: 4 inches (102 mm) high by 2 inches (51 mm) less width of door on single doors, 1 inch (25 mm) less width of door on pairs
  - c. Armor Plates: 36 inches (914 mm) high by 2 inches (51 mm) less width of door on single doors, 1 inch (25 mm) less width of door on pairs

## 2.21 OVERHEAD STOPS AND OVERHEAD STOP/HOLDERS

### A. Manufacturers:

1. Scheduled Manufacturers: Glynn-Johnson.
2. Acceptable Manufacturers: ABH, Dorma.

### B. Requirements:

1. Provide heavy duty concealed mounted overhead stop or holder as specified for exterior and interior vestibule single acting doors.
2. Provide heavy duty concealed mounted overhead stop or holder as specified for double acting doors.
3. Provide heavy or medium duty and concealed or surface mounted overhead stop or holder for interior doors as specified. Provide medium duty surface mounted overhead stop for interior doors and at any door that swings more than 140 degrees before striking wall, open against equipment, casework, sidelights, and where conditions do not allow wall stop or floor stop presents tripping hazard.
4. Where overhead holders are specified provide friction type at doors without closer and positive type at doors with closer.

## 2.22 DOOR STOPS AND HOLDERS

### A. Manufacturers:

1. Scheduled Manufacturer: Ives.
2. Acceptable Manufacturers: Rockwood, Trimco.

### B. Provide door stops at each door leaf:

1. Provide wall stops wherever possible. Provide convex type where mortise type locks are used and concave type where cylindrical type locks are used.
2. Where a wall stop cannot be used, provide universal floor stops for low or high rise options.
3. Where wall or floor stop cannot be used, provide medium duty surface mounted overhead stop.

## 2.23 THRESHOLDS, SEALS, DOOR SWEEPS, AUTOMATIC DOOR BOTTOMS, AND GASKETING

### A. Manufacturers:

1. Scheduled Manufacturer: Zero International.
2. Acceptable Manufacturers: National Guard, Reese.

### B. Requirements:

1. Provide thresholds, weather-stripping (including door sweeps, seals, and astragals) and gasketing systems (including smoke, sound, and light) as specified and per architectural details. Match finish of other items.
2. Smoke- and Draft-Control Door Assemblies: Where smoke- and draft-control door assemblies are required, provide door hardware that meets requirements of assemblies tested according to UL 1784 and installed in compliance with NFPA 105.
3. Size of thresholds:
  - a. Saddle Thresholds: 1/2 inch (13 mm) high by jamb width by door width
  - b. Bumper Seal Thresholds: 1/2 inch (13 mm) high by 5 inches (127 mm) wide by door width
4. Provide door sweeps, seals, astragals, and auto door bottoms only of type where resilient or flexible seal strip is easily replaceable and readily available.

## 2.24 SILENCERS

### A. Manufacturers:

1. Scheduled Manufacturer: Ives.
2. Acceptable Manufacturers: Rockwood, Trimco.

### B. Requirements:

1. Provide "push-in" type silencers for hollow metal or wood frames.
2. Provide one silencer per 30 inches (762 mm) of height on each single frame, and two for each pair frame.
3. Omit where gasketing is specified.

## 2.25 DOOR POSITION SWITCHES

### A. Manufacturers:

1. Scheduled Manufacturer: Schlage.
2. Acceptable Manufacturers: GE-Interlogix.

B. Requirements:

1. Provide recessed or surface mounted type door position switches as specified.
2. Coordinate door and frame preparations with door and frame suppliers. If switches are being used with magnetic locking device, provide minimum of 4 inches between switch and magnetic locking device.

2.26 FINISHES

- A. Provide finish for each item as indicated in the sets.

PART 3 - EXECUTION

3.01 EXAMINATION

- A. Prior to installation of hardware, examine doors and frames, with Installer present, for compliance with requirements for installation tolerances, labeled fire-rated door assembly construction, wall and floor construction, and other conditions affecting performance.
- B. Field verify existing doors and frames receiving new hardware and existing conditions receiving new openings. Verify that new hardware is compatible with existing door and frame preparation and existing conditions.
- C. Examine roughing-in for electrical power systems to verify actual locations of wiring connections before electrified door hardware installation.
- D. Proceed with installation only after unsatisfactory conditions have been corrected.

3.02 PREPARATION

- A. Where on-site modification of doors and frames is required:
1. Carefully remove existing door hardware and components being reused. Clean, protect, tag, and store in accordance with storage and handling requirements specified herein.
  2. Field modify and prepare existing door and frame for new hardware being installed.
  3. When modifications are exposed to view, use concealed fasteners, when possible.
  4. Prepare hardware locations and reinstall in accordance with installation requirements for new door hardware and with:
    - a. Steel Doors and Frames: For surface applied door hardware, drill and tap doors and frames according to ANSI/SDI A250.6.
    - b. Wood Doors: DHI WDHS.5 "Recommended Hardware Reinforcement Locations for Mineral Core Wood Flush Doors."
    - c. Doors in rated assemblies: NFPA 80 for restrictions on on-site door hardware preparation.



### 3.03 INSTALLATION

- A. Mount door hardware units at heights to comply with the following, unless otherwise indicated or required to comply with governing regulations.
  - 1. Standard Steel Doors and Frames: ANSI/SDI A250.8.
  - 2. Custom Steel Doors and Frames: HMMA 831.
  - 3. Wood Doors: DHI WDHS.3, "Recommended Locations for Architectural Hardware for Wood Flush Doors."
  - 4. Installation Guide for Doors and Hardware: DHI TDH-007-20
- B. Install each hardware item in compliance with manufacturer's instructions and recommendations, using only fasteners provided by manufacturer.
- C. Do not install surface mounted items until finishes have been completed on substrate. Protect all installed hardware during painting.
- D. Set units level, plumb and true to line and location. Adjust and reinforce attachment substrate as necessary for proper installation and operation.
- E. Drill and countersink units that are not factory prepared for anchorage fasteners. Space fasteners and anchors according to industry standards.
- F. Install operating parts so they move freely and smoothly without binding, sticking, or excessive clearance.
- G. Hinges: Install types and in quantities indicated in door hardware schedule but not fewer than quantity recommended by manufacturer for application indicated or one hinge for every 30 inches (750 mm) of door height, whichever is more stringent, unless other equivalent means of support for door, such as spring hinges or pivots, are provided.
- H. Lock Cylinders: Install construction cores to secure building and areas during construction period.
  - 1. Replace construction cores with permanent cores as indicated in keying section.
- I. Wiring: Coordinate with Division 26, ELECTRICAL sections for:
  - 1. Conduit, junction boxes and wire pulls.
  - 2. Connections to and from power supplies to electrified hardware.
  - 3. Connections to fire/smoke alarm system and smoke evacuation system.
  - 4. Connection of wire to door position switches and wire runs to central room or area, as directed by Architect.
  - 5. Testing and labeling wires with Architect's opening number.
  - 6. Connections to panel interface modules, controllers and gateways
- J. Key Control System: Tag keys and place them on markers and hooks in key control system cabinet, as determined by final keying schedule.
- K. Door Closers: Mount closers on room side of corridor doors, inside of exterior doors, and stair side of stairway doors from corridors. Mount closers so they are not visible in corridors, lobbies and other public spaces unless approved by Architect.

- L. Closer/Holders: Mount closer/holders on room side of corridor doors, inside of exterior doors, and stair side of stairway doors.
- M. Power Supplies: Locate power supplies as indicated or, if not indicated, above accessible ceilings or in equipment room, or alternate location as directed by Architect.
- N. Thresholds: Set thresholds in full bed of sealant complying with requirements specified in Division 07 Section "Joint Sealants."
- O. Stops: Provide floor stops for doors unless wall or other type stops are indicated in door hardware schedule. Do not mount floor stops where they may impede traffic or present tripping hazard.
- P. Perimeter Gasketing: Apply to head and jamb, forming seal between door and frame.
- Q. Meeting Stile Gasketing: Fasten to meeting stiles, forming seal when doors are closed.
- R. Door Bottoms and Sweeps: Apply to bottom of door, forming seal with threshold when door is closed.

#### 3.04 FIELD QUALITY CONTROL

- A. Architectural Hardware Consultant: Engage qualified independent Architectural Hardware Consultant to perform inspections and to prepare inspection reports.
  - 1. Architectural Hardware Consultant will inspect door hardware and state in each report whether installed work complies with or deviates from requirements, including whether door hardware is properly installed and adjusted.

#### 3.05 FIELD INSPECTIONS:

- A. Fire Door Assembly Inspection and Testing: Provide functional testing and inspection of fire door assemblies in accordance with NFPA 80-2007/2010. Inspections shall be performed by individuals certified by Intertek as a Fire Door Assembly Inspector, using reporting forms provided by the Door and Hardware Institute (DHI). Alternatively, inspections may be performed by individuals acceptable to the Architect, who have knowledge and understanding of the operating components of the applicable door type, and who have experience in preparing written reports of testing and inspection results.
  - 1. Schedule fire door assembly inspection within 90 days of Substantial Completion of the Project.
  - 2. Submit a signed, written final report as specified in Paragraph 1.4: Submittals.
  - 3. Contractor shall correct all deficiencies and schedule a reinspection of fire door assemblies which were noted as deficient on the inspection report.
  - 4. Inspector shall reinspect fire door assemblies after repairs are made.
  - 5. Additional reinspections which are required due to incomplete repairs will be performed by the inspector at the expense of the Contractor.
- B. Provide inspection of required egress door assemblies by a qualified person in accordance with NFPA 101.

1. Schedule egress door assembly inspection within 90 days of Substantial Completion of the Project for the required openings.
2. Submit a signed, written final report as specified in Paragraph 1.03.E.2.
3. Correct all deficiencies and schedule a reinspection of egress door assemblies noted as deficient on the inspection report.
4. Inspector to reinspect required egress door assemblies after repairs are made.

### 3.06 ADJUSTING

- A. Initial Adjustment: Adjust and check each operating item of door hardware and each door to ensure proper operation or function of every unit. Replace units that cannot be adjusted to operate as intended. Adjust door control devices to compensate for final operation of heating and ventilating equipment and to comply with referenced accessibility requirements.
  1. Electric Strikes: Adjust horizontal and vertical alignment of keeper to properly engage lock bolt.
  2. Door Closers: Adjust sweep period to comply with accessibility requirements and requirements of authorities having jurisdiction.
- B. Occupancy Adjustment: Approximately three to six months after date of Substantial Completion, Installer's Architectural Hardware Consultant must examine and readjust each item of door hardware, including adjusting operating forces, as necessary to ensure function of doors and door hardware.

### 3.07 CLEANING AND PROTECTION

- A. Clean adjacent surfaces soiled by door hardware installation.
- B. Clean operating items as necessary to restore proper function and finish.
- C. Provide final protection and maintain conditions that ensure door hardware is without damage or deterioration at time of Substantial Completion.

### 3.08 DEMONSTRATION

- A. Provide training for Owner's maintenance personnel to adjust, operate, and maintain door hardware and door hardware finishes. Refer to Division 01 Section "Demonstration and Training."

### 3.09 DOOR HARDWARE SCHEDULE

- A. The intent of the hardware specification is to specify the hardware for interior and exterior doors, and to establish a type, continuity, and standard of quality. However, it is the door hardware supplier's responsibility to thoroughly review existing conditions, schedules, specifications, drawings, and other Contract Documents to verify the suitability of the hardware specified.
- B. Discrepancies, conflicting hardware, and missing items are to be brought to the attention of the architect with corrections made prior to the bidding process. Omitted items not included in

a hardware set should be scheduled with the appropriate additional hardware required for proper application

- C. Hardware items are referenced in the following hardware. Refer to the above-specifications for special features, options, cylinders/keying, and other requirements.

D. Hardware Sets:

68390 OPT0250754 Version 1

HARDWARE GROUP NO. 01

For use on Door #(s):  
H-109A

Provide each OPENING with the following:

| QTY |    | DESCRIPTION | CATALOG NUMBER                | FINISH | MFR |
|-----|----|-------------|-------------------------------|--------|-----|
| 3   | EA | HINGE       | 5BB1 4.5 X 4.5 (NRP AS REQ'D) | 639    | IVE |
| 1   | EA | PASSAGE SET | L9010 06N                     | 612    | SCH |
| 1   | EA | OH STOP     | 90S                           | 612    | GLY |
| 3   | EA | SILENCER    | SR64                          | GRY    | IVE |

HARDWARE GROUP NO. 02

For use on Door #(s):  
E-111A          F-131A

Provide each OPENING with the following:

| QTY |    | DESCRIPTION | CATALOG NUMBER                | FINISH | MFR |
|-----|----|-------------|-------------------------------|--------|-----|
| 3   | EA | HINGE       | 5BB1 4.5 X 4.5 (NRP AS REQ'D) | 639    | IVE |
| 1   | EA | PASSAGE SET | L9010 06N                     | 612    | SCH |
| 1   | EA | WALL STOP   | WS401/402CVX                  | 612    | IVE |
| 3   | EA | SILENCER    | SR64                          | GRY    | IVE |

HARDWARE GROUP NO. 03

For use on Door #(s):

A-105A                      A-107A

Provide each OPENING with the following:

| QTY |    | DESCRIPTION         | CATALOG NUMBER                               | FINISH | MFR |
|-----|----|---------------------|--|--------|-----|
| 1   | EA | CONT. HINGE         | 112XY  | 628    | IVE |
| 1   | EA | CLASSROOM DEAD LOCK | L463T  | 626    | SCH |
| 1   | EA | PERMANENT CORE      | MATCH EXISTING KEYING SYSTEM                 | 626    | SCH |
| 1   | EA | PUSH PLATE          | 8300 10" 4" X 16"                            | 630    | IVE |
| 1   | EA | PULL PLATE          | 8302 10" 4" X 16"                            | 630    | IVE |
| 1   | EA | OH STOP             | 100S   | 630    | GLY |
| 1   | EA | SURFACE CLOSER      | 4040XP RW/PA<br>(MOUNT ON PULL SIDE OF DOOR) | 689    | LCN |
| 1   |    |                     | WEATHERSTRIP BY<br>DOOR/FRAME SUPPLIER       |        |     |
| 1   | EA | THRESHOLD           | 65A  | A      | ZER |

NOTE: DOORS REQUIRE SPECIAL 3/8" INCH UNDERCUT FOR ADA TYPE THRESHOLD.

HARDWARE GROUP NO. 04

For use on Door #(s):

E-120A

Provide each OPENING with the following:

| QTY |    | DESCRIPTION    | CATALOG NUMBER                | FINISH | MFR |
|-----|----|----------------|-------------------------------|--------|-----|
| 3   | EA | HINGE          | 5BB1 4.5 X 4.5 (NRP AS REQ'D) | 639    | IVE |
| 1   | EA | PUSH PLATE     | 8300 10" 4" X 16"             | US10   | IVE |
| 1   | EA | PULL PLATE     | 8302 10" 4" X 16"             | US10   | IVE |
| 1   | EA | SURFACE CLOSER | 4040XP RW/PA MC WMS           | US10   | LCN |
| 1   | EA | KICK PLATE     | 8400 10" X 1 1/2" LDW B-CS    | US10   | IVE |
| 1   | EA | WALL STOP      | WS401/402CVX                  | 612    | IVE |
| 3   | EA | SILENCER       | SR64                          | GRY    | IVE |

HARDWARE GROUP NO. 05

For use on Door #(s):

|        |        |        |        |        |        |
|--------|--------|--------|--------|--------|--------|
| D-105A | D-106A | F-128A | F-129A | G-121A | G-122A |
| H-123A | H-124A | J-119A | J-120A |        |        |

Provide each OPENING with the following:

| QTY |    | DESCRIPTION    | CATALOG NUMBER                | FINISH | MFR |
|-----|----|----------------|-------------------------------|--------|-----|
| 3   | EA | HINGE          | 5BB1 4.5 X 4.5 (NRP AS REQ'D) | 639    | IVE |
| 1   | EA | PRIVACY LOCK   | L9040 06N L583-363            | 612    | SCH |
| 1   | EA | OH STOP        | 90S                           | 612    | GLY |
| 1   | EA | SURFACE CLOSER | 4040XP RW/PA MC WMS           | US10   | LCN |
| 1   | EA | KICK PLATE     | 8400 10" X 1 1/2" LDW B-CS    | US10   | IVE |
| 1   | EA | GASKETING      | 488SCL PSA                    | CL     | ZER |

HARDWARE GROUP NO. 06

For use on Door #(s):

|        |        |        |        |
|--------|--------|--------|--------|
| A-102A | A-110A | D-139A | D-146A |
|--------|--------|--------|--------|

Provide each OPENING with the following:

| QTY |    | DESCRIPTION    | CATALOG NUMBER                | FINISH | MFR |
|-----|----|----------------|-------------------------------|--------|-----|
| 3   | EA | HINGE          | 5BB1 4.5 X 4.5 (NRP AS REQ'D) | 639    | IVE |
| 1   | EA | PRIVACY LOCK   | L9040 06N L583-363            | 612    | SCH |
| 1   | EA | SURFACE CLOSER | 4040XP SCUSH MC WMS           | US10   | LCN |
| 1   | EA | KICK PLATE     | 8400 10" X 1 1/2" LDW B-CS    | US10   | IVE |
| 1   | EA | GASKETING      | 488SCL PSA                    | CL     | ZER |

HARDWARE GROUP NO. 07

For use on Door #(s):

|        |        |        |        |        |
|--------|--------|--------|--------|--------|
| E-107A | E-108A | E-119A | K-124A | K-125A |
|--------|--------|--------|--------|--------|

Provide each OPENING with the following:

| QTY |    | DESCRIPTION    | CATALOG NUMBER                | FINISH | MFR |
|-----|----|----------------|-------------------------------|--------|-----|
| 3   | EA | HINGE          | 5BB1 4.5 X 4.5 (NRP AS REQ'D) | 639    | IVE |
| 1   | EA | PRIVACY LOCK   | L9040 06N L583-363            | 612    | SCH |
| 1   | EA | SURFACE CLOSER | 4040XP RW/PA MC WMS           | US10   | LCN |
| 1   | EA | KICK PLATE     | 8400 10" X 1 1/2" LDW B-CS    | US10   | IVE |
| 1   | EA | WALL STOP      | WS401/402CVX                  | 612    | IVE |
| 1   | EA | GASKETING      | 488SCL PSA                    | CL     | ZER |

#### HARDWARE GROUP NO. 08

For use on Door #(s):

F-106A              F-119A              H-104A

Provide each OPENING with the following:

| QTY |    | DESCRIPTION       | CATALOG NUMBER                | FINISH | MFR |
|-----|----|-------------------|-------------------------------|--------|-----|
| 3   | EA | HINGE             | 5BB1 4.5 X 4.5 (NRP AS REQ'D) | 639    | IVE |
| 1   | EA | OFFICE/ENTRY LOCK | L9050T 06N L583-363           | 612    | SCH |
| 1   | EA | PERMANENT CORE    | MATCH EXISTING KEYING SYSTEM  | 613    | SCH |
| 1   | EA | OH STOP           | 90S                           | 612    | GLY |
| 3   | EA | SILENCER          | SR64                          | GRY    | IVE |

#### HARDWARE GROUP NO. 09

For use on Door #(s):

A-101A              A-109A              C-106A              D-107A              D-108A              D-111A  
D-119A              D-138A              D-143A              D-145A              E-121A              F-104A  
F-108A              H-105A              H-107A              K-118A              K-121A              K-122A

Provide each OPENING with the following:

| QTY |    | DESCRIPTION       | CATALOG NUMBER                | FINISH | MFR |
|-----|----|-------------------|-------------------------------|--------|-----|
| 3   | EA | HINGE             | 5BB1 4.5 X 4.5 (NRP AS REQ'D) | 639    | IVE |
| 1   | EA | OFFICE/ENTRY LOCK | L9050T 06N L583-363           | 612    | SCH |
| 1   | EA | PERMANENT CORE    | MATCH EXISTING KEYING SYSTEM  | 613    | SCH |
| 1   | EA | WALL STOP         | WS401/402CVX                  | 612    | IVE |
| 3   | EA | SILENCER          | SR64                          | GRY    | IVE |

#### HARDWARE GROUP NO. 10

For use on Door #(s):

D-104A              D-104B

Provide each OPENING with the following:

| QTY |    | DESCRIPTION       | CATALOG NUMBER                | FINISH | MFR |
|-----|----|-------------------|-------------------------------|--------|-----|
| 3   | EA | HINGE             | 5BB1 4.5 X 4.5 (NRP AS REQ'D) | 639    | IVE |
| 1   | EA | OFFICE/ENTRY LOCK | L9050T 06N L583-363           | 612    | SCH |
| 1   | EA | PERMANENT CORE    | MATCH EXISTING KEYING SYSTEM  | 613    | SCH |
| 1   | EA | SURFACE CLOSER    | 4040XP RW/PA MC WMS           | US10   | LCN |
| 1   | EA | KICK PLATE        | 8400 10" X 1 1/2" LDW B-CS    | US10   | IVE |
| 1   | EA | WALL STOP         | WS401/402CVX                  | 612    | IVE |
| 3   | EA | SILENCER          | SR64                          | GRY    | IVE |

HARDWARE GROUP NO. 11

For use on Door #(s):

A-118A

Provide each OPENING with the following:

| QTY |    | DESCRIPTION       | CATALOG NUMBER                      | FINISH | MFR |
|-----|----|-------------------|-------------------------------------|--------|-----|
| 1   | EA | CONT. HINGE       | 112XY                               | 628    | IVE |
| 1   | EA | CORRIDOR LOCK     | L9456T 06N L583-363                 | 626    | SCH |
| 1   | EA | PERMANENT CORE    | MATCH EXISTING KEYING SYSTEM        | 626    | SCH |
| 1   | EA | SURFACE CLOSER    | 4040XP SCUSH                        | 689    | LCN |
| 1   | EA | MOUNTING PLATE    | 4040XP-18PA AS REQ'D                | 689    | LCN |
| 1   | EA | CUSH SHOE SUPPORT | 4040XP-30 AS REQ'D                  | 689    | LCN |
| 1   | EA | BLADE STOP SPACER | 4040XP-61 AS REQ'D                  | 689    | LCN |
| 1   |    |                   | WEATHERSTRIP BY DOOR/FRAME SUPPLIER |        |     |
| 1   | EA | DOOR SWEEP        | 39A                                 | A      | ZER |
| 1   | EA | THRESHOLD         | 65A                                 | A      | ZER |

NOTE: DOORS REQUIRE SPECIAL 3/8" INCH UNDERCUT FOR ADA TYPE THRESHOLD.

HARDWARE GROUP NO. 12

For use on Door #(s):

D-131A      H-103B      H-131A      H-131B

Provide each OPENING with the following:

| QTY |    | DESCRIPTION    | CATALOG NUMBER                | FINISH | MFR |
|-----|----|----------------|-------------------------------|--------|-----|
| 3   | EA | HINGE          | 5BB1 4.5 X 4.5 (NRP AS REQ'D) | 639    | IVE |
| 1   | EA | CLASSROOM LOCK | L9070T 06N                    | 612    | SCH |
| 1   | EA | PERMANENT CORE | MATCH EXISTING KEYING SYSTEM  | 613    | SCH |
| 1   | EA | OH STOP        | 90S                           | 612    | GLY |
| 3   | EA | SILENCER       | SR64                          | GRY    | IVE |



HARDWARE GROUP NO. 13

For use on Door #(s):  
F-109A

Provide each OPENING with the following:

| QTY |    | DESCRIPTION    | CATALOG NUMBER                | FINISH | MFR |
|-----|----|----------------|-------------------------------|--------|-----|
| 3   | EA | HINGE          | 5BB1 4.5 X 4.5 (NRP AS REQ'D) | 639    | IVE |
| 1   | EA | CLASSROOM LOCK | L9070T 06N                    | 612    | SCH |
| 1   | EA | PERMANENT CORE | MATCH EXISTING KEYING SYSTEM  | 613    | SCH |
| 1   | EA | OH STOP        | 90S                           | 612    | GLY |
| 3   | EA | SILENCER       | SR64                          | GRY    | IVE |

NOTE: VERIFY/COORDINATE PREPS ON EXISTING FRAMES. PROVIDE CORRECT STRIKES, REINFORCEMENTS, FIELD MODIFICATIONS AND/OR FILLERS TO EXISTING FRAMES AS NECESSARY TO ACCEPT NEW SPECIFIED HARDWARE AND COVER EXPOSED HOLES.

HARDWARE GROUP NO. 14

For use on Door #(s):

|        |        |        |        |        |        |
|--------|--------|--------|--------|--------|--------|
| D-122A | D-123A | D-142A | E-109A | E-125A | E-126A |
| F-103A | F-130A | G-133A | G-133B | H-110A | H-111A |
| H-117A | H-117B | J-126A | J-126B | J-130A | J-130B |
| K-117B | K-126A | K-127A |        |        |        |

Provide each OPENING with the following:

| QTY |    | DESCRIPTION    | CATALOG NUMBER                | FINISH | MFR |
|-----|----|----------------|-------------------------------|--------|-----|
| 3   | EA | HINGE          | 5BB1 4.5 X 4.5 (NRP AS REQ'D) | 639    | IVE |
| 1   | EA | CLASSROOM LOCK | L9070T 06N                    | 612    | SCH |
| 1   | EA | PERMANENT CORE | MATCH EXISTING KEYING SYSTEM  | 613    | SCH |
| 1   | EA | WALL STOP      | WS401/402CVX                  | 612    | IVE |
| 3   | EA | SILENCER       | SR64                          | GRY    | IVE |

#### HARDWARE GROUP NO. 15

For use on Door #(s):

C-108A      C-109A      C-110A      D-112A      D-113A      D-120A  
D-121A

Provide each OPENING with the following:

| QTY |    | DESCRIPTION    | CATALOG NUMBER  | FINISH | MFR |
|-----|----|----------------|---|--------|-----|
| 1   | EA | CONT. HINGE    | 224HD (CUSTOM FINISH - SATIN BRONZE, CONSULT FACTORY) |        | IVE |
| 1   | EA | CLASSROOM LOCK | L9070T 06N  | 612    | SCH |
| 1   | EA | PERMANENT CORE | MATCH EXISTING KEYING SYSTEM                          | 613    | SCH |
| 1   | EA | WALL STOP      | WS401/402CVX  | 612    | IVE |
| 1   | EA | GASKETING      | 870AA   | AA     | ZER |
| 1   | EA | DOOR BOTTOM    | 355AA   | AA     | ZER |
| 1   | EA | THRESHOLD      | 545A  | A      | ZER |

#### HARDWARE GROUP NO. 16

For use on Door #(s):

E-122A

Provide each OPENING with the following:

| QTY |    | DESCRIPTION    | CATALOG NUMBER                | FINISH | MFR |
|-----|----|----------------|-------------------------------|--------|-----|
| 3   | EA | HINGE          | 5BB1HW 5 X 4.5 (NRP AS REQ'D) | 639    | IVE |
| 1   | EA | CLASSROOM LOCK | L9070T 06N                    | 612    | SCH |
| 1   | EA | PERMANENT CORE | MATCH EXISTING KEYING SYSTEM  | 613    | SCH |
| 1   | EA | WALL STOP      | WS401/402CVX                  | 612    | IVE |
| 3   | EA | SILENCER       | SR64                          | GRY    | IVE |

#### HARDWARE GROUP NO. 17

For use on Door #(s):

J-127A

Provide each OPENING with the following:

| QTY |    | DESCRIPTION    | CATALOG NUMBER                | FINISH | MFR |
|-----|----|----------------|-------------------------------|--------|-----|
| 3   | EA | HINGE          | 5BB1 4.5 X 4.5 (NRP AS REQ'D) | 639    | IVE |
| 1   | EA | CLASSROOM LOCK | L9070T 06N                    | 612    | SCH |
| 1   | EA | PERMANENT CORE | MATCH EXISTING KEYING SYSTEM  | 613    | SCH |
| 1   | EA | OH STOP        | 90S                           | 612    | GLY |
| 1   | EA | SURFACE CLOSER | 4040XP RW/PA MC WMS           | US10   | LCN |
| 1   | EA | KICK PLATE     | 8400 10" X 1 1/2" LDW B-CS    | US10   | IVE |
| 3   | EA | SILENCER       | SR64                          | GRY    | IVE |

#### HARDWARE GROUP NO. 18

For use on Door #(s):

F-101A K-119B

Provide each OPENING with the following:

| QTY |    | DESCRIPTION         | CATALOG NUMBER                                | FINISH | MFR |
|-----|----|---------------------|---|--------|-----|
| 3   | EA | HINGE               | 5BB1 4.5 X 4.5 (NRP AS REQ'D)                 | 652    | IVE |
| 1   | EA | CLASSROOM X STORERM | ND70X80CD RHO XN12-006                        | 626    | SCH |
| 2   | EA | PERMANENT CORE      | MATCH EXISTING KEYING SYSTEM                  | 626    | SCH |
| 1   | EA | ELECTRIC STRIKE     | 6211 FSE                                      | 630    | VON |
| 1   | EA | OH STOP             | 100S  | 630    | GLY |
| 1   | EA | SURFACE CLOSER      | 4040XP RW/PA                                  | 689    | LCN |
| 1   | EA | DESK MOUNT BUTTON   | 660-PB  | 628    | SCE |
| 1   | EA | DOOR CONTACT        | 7764  | 628    | SCE |
| 1   | EA | POWER SUPPLY        | PS902 900-4R [COORDINATE WITH ACCESS CONTROL] | LGR    | SCE |
| 1   | EA | DIAGRAM             | ELEVATION                                     |        | DLR |
| 1   | EA | DIAGRAM             | POINT TO POINT                                |        | DLR |

OPERATION: DOOR CLOSED AND ALWAYS LOCKED FROM RECEPTION SIDE. DOOR UNLOCKED FROM CORRIDOR SIDE DURING SCHOOL HOURS AND LOCKED FROM CORRIDOR SIDE AFTER HOURS AND ON WEEKENDS.

PUSH BUTTON AT RECEPTION DESK MOMENTARILY UNLOCKS DOOR ALLOWING ENTRY. DOOR REMAINS LOCKED UPON LOSS OF POWER. DOOR CONTACT TO MONITOR DOOR POSITION. MOTION SENSOR ON PUSH SIDE SHUNTS DOOR CONTACT FOR VALID EGRESS.

#### HARDWARE GROUP NO. 19

For use on Door #(s):

A-117A C-107A D-125A D-132A

Provide each OPENING with the following:

| QTY |    | DESCRIPTION         | CATALOG NUMBER                | FINISH | MFR |
|-----|----|---------------------|-------------------------------|--------|-----|
| 6   | EA | HINGE               | 5BB1 4.5 X 4.5 (NRP AS REQ'D) | 639    | IVE |
| 1   | EA | CONST LATCHING BOLT | FB51T/FB61T AS REQ'D          | 612    | IVE |
| 1   | EA | CLASSROOM LOCK      | L9070T 06N                    | 612    | SCH |
| 1   | EA | PERMANENT CORE      | MATCH EXISTING KEYING SYSTEM  | 613    | SCH |
| 2   | EA | OH STOP             | 90S                           | 612    | GLY |
| 2   | EA | SILENCER            | SR64                          | GRY    | IVE |

#### HARDWARE GROUP NO. 20

For use on Door #(s):

H-102A H-103A

Provide each OPENING with the following:

| QTY |    | DESCRIPTION        | CATALOG NUMBER                | FINISH | MFR |
|-----|----|--------------------|-------------------------------|--------|-----|
| 3   | EA | HINGE              | 5BB1 4.5 X 4.5 (NRP AS REQ'D) | 639    | IVE |
| 1   | EA | CLASSROOM SECURITY | L9071T 06N                    | 612    | SCH |
| 2   | EA | PERMANENT CORE     | MATCH EXISTING KEYING SYSTEM  | 613    | SCH |
| 1   | EA | OH STOP            | 90S                           | 612    | GLY |
| 3   | EA | SILENCER           | SR64                          | GRY    | IVE |

#### HARDWARE GROUP NO. 21

For use on Door #(s):

|        |        |        |        |        |        |
|--------|--------|--------|--------|--------|--------|
| F-118A | F-127A | F-132A | G-101A | G-102A | G-103A |
| G-108A | G-110A | G-118A | G-118B | H-106A | H-119A |
| H-120A | H-121A | J-103A | J-104A | J-105A | J-109A |
| J-121A | J-121B | J-122A | J-123A | J-129A | K-101A |
| K-102A | K-103A | K-104A | K-105A | K-111A | K-112A |
| K-113A | K-117A | K-130A | K-131A | K-132A | K-133A |
| K-134A | L-104A | L-105A | L-106A | L-109A | L-110A |
| L-111A | L-113A | L-114A | L-116A | L-117A | L-122A |
| L-123A |        |        |        |        |        |

Provide each OPENING with the following:

| QTY |    | DESCRIPTION        | CATALOG NUMBER                | FINISH | MFR |
|-----|----|--------------------|-------------------------------|--------|-----|
| 3   | EA | HINGE              | 5BB1 4.5 X 4.5 (NRP AS REQ'D) | 639    | IVE |
| 1   | EA | CLASSROOM SECURITY | L9071T 06N                    | 612    | SCH |
| 2   | EA | PERMANENT CORE     | MATCH EXISTING KEYING SYSTEM  | 613    | SCH |
| 1   | EA | WALL STOP          | WS401/402CVX                  | 612    | IVE |
| 3   | EA | SILENCER           | SR64                          | GRY    | IVE |

#### HARDWARE GROUP NO. 22

For use on Door #(s):

F-117A F-122A

Provide each OPENING with the following:

| QTY |    | DESCRIPTION        | CATALOG NUMBER                | FINISH | MFR |
|-----|----|--------------------|-------------------------------|--------|-----|
| 3   | EA | HINGE              | 5BB1 4.5 X 4.5 (NRP AS REQ'D) | 652    | IVE |
| 1   | EA | CLASSROOM SECURITY | L9071T 06N                    | 626    | SCH |
| 2   | EA | PERMANENT CORE     | MATCH EXISTING KEYING SYSTEM  | 626    | SCH |
| 1   | EA | WALL STOP          | WS401/402CVX                  | 626    | IVE |

HARDWARE GROUP NO. 23

For use on Door #(s):  
D-133A

Provide each OPENING with the following:

| QTY |    | DESCRIPTION         | CATALOG NUMBER  | FINISH | MFR |
|-----|----|---------------------|---|--------|-----|
| 2   | EA | CONT. HINGE         | 224HD (CUSTOM FINISH - SATIN BRONZE, CONSULT FACTORY) |        | IVE |
| 1   | EA | CONST LATCHING BOLT | FB51T/FB61T AS REQ'D                                  | 612    | IVE |
| 1   | EA | CLASSROOM SECURITY  | L9071T 06N  | 612    | SCH |
| 2   | EA | PERMANENT CORE      | MATCH EXISTING KEYING SYSTEM                          | 613    | SCH |
| 2   | EA | WALL STOP           | WS401/402CVX  | 612    | IVE |
| 1   | EA | MEETING STILE       | 328AA-S   | AA     | ZER |
| 1   | EA | GASKETING           | 870AA   | AA     | ZER |
| 2   | EA | DOOR BOTTOM         | 364AA   | AA     | ZER |
| 1   | EA | THRESHOLD           | 545A  | A      | ZER |

HARDWARE GROUP NO. 24

For use on Door #(s):  
E-127A L-102A

Provide each OPENING with the following:

| QTY |    | DESCRIPTION    | CATALOG NUMBER                | FINISH | MFR |
|-----|----|----------------|-------------------------------|--------|-----|
| 3   | EA | HINGE          | 5BB1 4.5 X 4.5 (NRP AS REQ'D) | 639    | IVE |
| 1   | EA | STOREROOM LOCK | L9080T 06N                    | 612    | SCH |
| 1   | EA | PERMANENT CORE | MATCH EXISTING KEYING SYSTEM  | 613    | SCH |
| 1   | EA | OH STOP        | 90S                           | 612    | GLY |
| 3   | EA | SILENCER       | SR64                          | GRY    | IVE |

#### HARDWARE GROUP NO. 25

For use on Door #(s):

D-114A                  D-115A

Provide each OPENING with the following:

| QTY |    | DESCRIPTION    | CATALOG NUMBER                  | FINISH | MFR |
|-----|----|----------------|---------------------------------|--------|-----|
| 3   | EA | HINGE          | 5BB1 4.5 X 4.5 (NRP AS REQ'D)   | 639    | IVE |
| 1   | EA | STOREROOM LOCK | L9080T 06N                      | 612    | SCH |
| 1   | EA | PERMANENT CORE | MATCH EXISTING KEYING<br>SYSTEM | 613    | SCH |
| 1   | EA | OH STOP        | 90S                             | 612    | GLY |
| 3   | EA | SILENCER       | SR64                            | GRY    | IVE |

NOTE: VERIFY/COORDINATE PREPS ON EXISTING FRAMES. PROVIDE CORRECT STRIKES, REINFORCEMENTS, FIELD MODIFICATIONS AND/OR FILLERS TO EXISTING FRAMES AS NECESSARY TO ACCEPT NEW SPECIFIED HARDWARE AND COVER EXPOSED HOLES.

#### HARDWARE GROUP NO. 26

For use on Door #(s):

|        |        |        |        |        |        |
|--------|--------|--------|--------|--------|--------|
| A-116A | D-134A | E-130A | G-107A | G-111A | G-119A |
| G-120A | G-124A | H-122A | H-125A | H-126A | J-108A |
| J-108B | J-116A | J-117A | K-107A | K-108A | K-120A |
| L-103A | L-118A | L-121A |        |        |        |

Provide each OPENING with the following:

| QTY |    | DESCRIPTION    | CATALOG NUMBER                  | FINISH | MFR |
|-----|----|----------------|---------------------------------|--------|-----|
| 3   | EA | HINGE          | 5BB1 4.5 X 4.5 (NRP AS REQ'D)   | 639    | IVE |
| 1   | EA | STOREROOM LOCK | L9080T 06N                      | 612    | SCH |
| 1   | EA | PERMANENT CORE | MATCH EXISTING KEYING<br>SYSTEM | 613    | SCH |
| 1   | EA | WALL STOP      | WS401/402CVX                    | 612    | IVE |
| 3   | EA | SILENCER       | SR64                            | GRY    | IVE |

#### HARDWARE GROUP NO. 27

For use on Door #(s):

D-135A

Provide each OPENING with the following:

| QTY |    | DESCRIPTION    | CATALOG NUMBER                | FINISH | MFR |
|-----|----|----------------|-------------------------------|--------|-----|
| 3   | EA | HINGE          | 5BB1 4.5 X 4.5 (NRP AS REQ'D) | 639    | IVE |
| 1   | EA | STOREROOM LOCK | L9080T 06N                    | 612    | SCH |
| 1   | EA | PERMANENT CORE | MATCH EXISTING KEYING SYSTEM  | 613    | SCH |
| 1   | EA | WALL STOP      | WS401/402CVX                  | 612    | IVE |
| 3   | EA | SILENCER       | SR64                          | GRY    | IVE |

NOTE: VERIFY/COORDINATE PREPS ON EXISTING FRAMES. PROVIDE CORRECT STRIKES, REINFORCEMENTS, FIELD MODIFICATIONS AND/OR FILLERS TO EXISTING FRAMES AS NECESSARY TO ACCEPT NEW SPECIFIED HARDWARE AND COVER EXPOSED HOLES.

#### HARDWARE GROUP NO. 28

For use on Door #(s):

K-119A

Provide each OPENING with the following:

| QTY |    | DESCRIPTION       | CATALOG NUMBER  | FINISH | MFR |
|-----|----|-------------------|---|--------|-----|
| 1   | EA | CONT. HINGE       | 112XY EPT   | 628    | IVE |
| 1   | EA | POWER TRANSFER    | EPT10   | 689    | VON |
| 1   | EA | EU MORTISE LOCK   | L9092TEU 06N RX DPS   | 626    | SCH |
| 1   | EA | PERMANENT CORE    | MATCH EXISTING KEYING SYSTEM  | 626    | SCH |
| 1   | EA | SURFACE CLOSER    | 4040XP SCUSH  | 689    | LCN |
| 1   | EA | MOUNTING PLATE    | 4040XP-18PA AS REQ'D  | 689    | LCN |
| 1   | EA | CUSH SHOE SUPPORT | 4040XP-30 AS REQ'D  | 689    | LCN |
| 1   | EA | BLADE STOP SPACER | 4040XP-61 AS REQ'D  | 689    | LCN |
| 1   | EA | CREDENTIAL READER | MTB15 - BY ACCESS CONTROL PROVIDER (COORDINATE W/ HEAD END AND CREDENTIAL TYPE) | BLK    | SCE |
| 1   | EA | DESK MOUNT BUTTON | 660-PB  | 628    | SCE |
| 1   | EA | POWER SUPPLY      | PS902 900-4R [COORDINATE WITH ACCESS CONTROL]                                   | LGR    | SCE |
| 1   | EA | DIAGRAM           | ELEVATION   |        | DLR |
| 1   | EA | DIAGRAM           | POINT TO POINT  |        | DLR |

OPERATION: DOOR NORMALLY CLOSED AND LOCKED. VALID CREDENTIAL OR PUSH BUTTON AT RECEPTION DESK MOMENTARILY UNLOCKS DOOR ALLOWING ENTRY. DOOR REMAINS LOCKED UPON LOSS OF POWER. DOOR CONTACT TO MONITOR DOOR POSITION. RX SWITCH SHUNTS DOOR CONTACT FOR VALID EGRESS. FREE EGRESS AT ALL TIMES.

RX SWITCH AND DOOR CONTACT ARE INTEGRAL TO LOCK SET.

HARDWARE GROUP NO. 29

For use on Door #(s):

E-128A

Provide each OPENING with the following:

| QTY |    | DESCRIPTION       | CATALOG NUMBER  | FINISH | MFR |
|-----|----|-------------------|---|--------|-----|
| 1   | EA | CONT. HINGE       | 112XY EPT   | 628    | IVE |
| 1   | EA | POWER TRANSFER    | EPT10   | 689    | VON |
| 1   | EA | EU MORTISE LOCK   | L9092TEU 06N RX DPS   | 626    | SCH |
| 1   | EA | PERMANENT CORE    | MATCH EXISTING KEYING SYSTEM  | 626    | SCH |
| 1   | EA | SURFACE CLOSER    | 4040XP SCUSH  | 689    | LCN |
| 1   | EA | MOUNTING PLATE    | 4040XP-18PA AS REQ'D  | 689    | LCN |
| 1   | EA | CUSH SHOE SUPPORT | 4040XP-30 AS REQ'D  | 689    | LCN |
| 1   | EA | BLADE STOP SPACER | 4040XP-61 AS REQ'D  | 689    | LCN |
| 1   |    |                   | WEATHERSTRIP BY DOOR/FRAME SUPPLIER   |        |     |
| 1   | EA | DOOR SWEEP        | 39A   | A      | ZER |
| 1   | EA | THRESHOLD         | 65A   | A      | ZER |
| 1   | EA | CREDENTIAL READER | MTB15 - BY ACCESS CONTROL PROVIDER (COORDINATE W/ HEAD END AND CREDENTIAL TYPE) | BLK    | SCE |
| 1   | EA | POWER SUPPLY      | PS902 900-4R [COORDINATE WITH ACCESS CONTROL]                                   | LGR    | SCE |
| 1   | EA | DIAGRAM           | ELEVATION   |        | DLR |
| 1   | EA | DIAGRAM           | POINT TO POINT  |        | DLR |

OPERATION: DOOR NORMALLY CLOSED AND LOCKED. VALID CREDENTIAL MOMENTARILY UNLOCKS DOOR ALLOWING ENTRY. DOOR REMAINS LOCKED UPON LOSS OF POWER. DOOR CONTACT TO MONITOR DOOR POSITION. RX SWITCH SHUNTS DOOR CONTACT FOR VALID EGRESS. FREE EGRESS AT ALL TIMES.

RX SWITCH AND DOOR CONTACT ARE INTEGRAL TO LOCK SET.

NOTE: DOORS REQUIRE SPECIAL 3/8" INCH UNDERCUT FOR ADA TYPE THRESHOLD.



HARDWARE GROUP NO. 30

For use on Door #(s):

A-106A

Provide each OPENING with the following:

| QTY |    | DESCRIPTION       | CATALOG NUMBER                      | FINISH | MFR |
|-----|----|-------------------|-------------------------------------|--------|-----|
| 1   | EA | CONT. HINGE       | 112XY                               | 628    | IVE |
| 1   | EA | STOREROOM LOCK    | L9080T 06N                          | 626    | SCH |
| 1   | EA | PERMANENT CORE    | MATCH EXISTING KEYING SYSTEM        | 626    | SCH |
| 1   | EA | SURFACE CLOSER    | 4041 DEL SCUSH                      | 689    | LCN |
| 1   | EA | MOUNTING PLATE    | 4040XP-18PA AS REQ'D                | 689    | LCN |
| 1   | EA | CUSH SHOE SUPPORT | 4040XP-30 AS REQ'D                  | 689    | LCN |
| 1   | EA | BLADE STOP SPACER | 4040XP-61 AS REQ'D                  | 689    | LCN |
| 1   |    |                   | WEATHERSTRIP BY DOOR/FRAME SUPPLIER |        |     |
| 1   | EA | DOOR SWEEP        | 39A                                 | A      | ZER |
| 1   | EA | THRESHOLD         | 65A                                 | A      | ZER |

NOTE: DOORS REQUIRE SPECIAL 3/8" INCH UNDERCUT FOR ADA TYPE THRESHOLD.

HARDWARE GROUP NO. 31

For use on Door #(s):

J-114A

Provide each OPENING with the following:

| QTY |    | DESCRIPTION    | CATALOG NUMBER                | FINISH | MFR |
|-----|----|----------------|-------------------------------|--------|-----|
| 3   | EA | HINGE          | 5BB1 4.5 X 4.5 (NRP AS REQ'D) | 639    | IVE |
| 1   | EA | STOREROOM LOCK | L9080T 06N                    | 612    | SCH |
| 1   | EA | PERMANENT CORE | MATCH EXISTING KEYING SYSTEM  | 613    | SCH |
| 1   | EA | SURFACE CLOSER | 4041 DEL RW/PA MC WMS         | US10   | LCN |
| 1   | EA | KICK PLATE     | 8400 10" X 1 1/2" LDW B-CS    | US10   | IVE |
| 1   | EA | WALL STOP      | WS401/402CVX                  | 612    | IVE |
| 3   | EA | SILENCER       | SR64                          | GRY    | IVE |

HARDWARE GROUP NO. 32

For use on Door #(s):

B-102A D-130A

Provide each OPENING with the following:

| QTY |    | DESCRIPTION         | CATALOG NUMBER                | FINISH | MFR |
|-----|----|---------------------|-------------------------------|--------|-----|
| 6   | EA | HINGE               | 5BB1 4.5 X 4.5 (NRP AS REQ'D) | 639    | IVE |
| 1   | EA | CONST LATCHING BOLT | FB51T/FB61T AS REQ'D          | 612    | IVE |
| 1   | EA | STOREROOM LOCK      | L9080T 06N                    | 612    | SCH |
| 1   | EA | PERMANENT CORE      | MATCH EXISTING KEYING SYSTEM  | 613    | SCH |
| 2   | EA | OH STOP             | 90S                           | 612    | GLY |
| 2   | EA | SILENCER            | SR64                          | GRY    | IVE |

HARDWARE GROUP NO. 33

For use on Door #(s):

E-131A

Provide each OPENING with the following:

| QTY |    | DESCRIPTION         | CATALOG NUMBER                | FINISH | MFR |
|-----|----|---------------------|-------------------------------|--------|-----|
| 6   | EA | HINGE               | 5BB1 4.5 X 4.5 (NRP AS REQ'D) | 639    | IVE |
| 1   | EA | CONST LATCHING BOLT | FB51T/FB61T AS REQ'D          | 612    | IVE |
| 1   | EA | STOREROOM LOCK      | L9080T 06N                    | 612    | SCH |
| 1   | EA | PERMANENT CORE      | MATCH EXISTING KEYING SYSTEM  | 613    | SCH |
| 1   | EA | COORDINATOR         | COR X FL (MB AS REQ'D)        | 628    | IVE |
| 2   | EA | OH STOP             | 90S                           | 612    | GLY |
| 2   | EA | SURFACE CLOSER      | 4040XP RW/PA MC WMS           | US10   | LCN |
| 2   | EA | KICK PLATE          | 8400 10" X 1" LDW B-CS        | US10   | IVE |
| 2   | EA | SILENCER            | SR64                          | GRY    | IVE |

HARDWARE GROUP NO. 34

For use on Door #(s):

E-129A

Provide each OPENING with the following:

| QTY |    | DESCRIPTION         | CATALOG NUMBER                | FINISH | MFR |
|-----|----|---------------------|-------------------------------|--------|-----|
| 6   | EA | HINGE               | 5BB1 4.5 X 4.5 (NRP AS REQ'D) | 639    | IVE |
| 1   | EA | CONST LATCHING BOLT | FB51T/FB61T AS REQ'D          | 612    | IVE |
| 1   | EA | STOREROOM LOCK      | L9080T 06N                    | 612    | SCH |
| 1   | EA | PERMANENT CORE      | MATCH EXISTING KEYING SYSTEM  | 613    | SCH |
| 1   | EA | COORDINATOR         | COR X FL (MB AS REQ'D)        | 628    | IVE |
| 2   | EA | SURFACE CLOSER      | 4040XP SCUSH MC WMS           | US10   | LCN |
| 2   | EA | KICK PLATE          | 8400 10" X 1" LDW B-CS        | US10   | IVE |
| 2   | EA | SILENCER            | SR64                          | GRY    | IVE |

HARDWARE GROUP NO. 35

For use on Door #(s):

E-127B

Provide each OPENING with the following:

| QTY |    | DESCRIPTION       | CATALOG NUMBER                      | FINISH | MFR |
|-----|----|-------------------|-------------------------------------|--------|-----|
| 2   | EA | CONT. HINGE       | 112XY                               | 628    | IVE |
| 1   | EA | AUTO FLUSH BOLT   | FB31P/FB41P AS REQ'D                | 630    | IVE |
| 1   | EA | DUST PROOF STRIKE | DP2                                 | 626    | IVE |
| 1   | EA | STOREROOM LOCK    | L9080T 06N                          | 626    | SCH |
| 1   | EA | PERMANENT CORE    | MATCH EXISTING KEYING SYSTEM        | 626    | SCH |
| 1   | EA | COORDINATOR       | COR X FL (MB AS REQ'D)              | 628    | IVE |
| 2   | EA | SURFACE CLOSER    | 4040XP SCUSH                        | 689    | LCN |
| 1   | EA | MOUNTING PLATE    | 4040XP-18PA AS REQ'D                | 689    | LCN |
| 1   | EA | CUSH SHOE SUPPORT | 4040XP-30 AS REQ'D                  | 689    | LCN |
| 1   | EA | BLADE STOP SPACER | 4040XP-61 AS REQ'D                  | 689    | LCN |
| 1   | EA | RAIN DRIP         | 142AA                               | AA     | ZER |
| 1   |    |                   | WEATHERSTRIP BY DOOR/FRAME SUPPLIER |        |     |
| 2   | EA | DOOR SWEEP        | 39A                                 | A      | ZER |
| 1   | EA | THRESHOLD         | 65A                                 | A      | ZER |

NOTE: DOORS REQUIRE SPECIAL 3/8" INCH UNDERCUT FOR ADA TYPE THRESHOLD.

HARDWARE GROUP NO. 36

For use on Door #(s):

E-105A          E-105B          E-110A

Provide each OPENING with the following:

| QTY |    | DESCRIPTION    | CATALOG NUMBER                | FINISH | MFR |
|-----|----|----------------|-------------------------------|--------|-----|
| 3   | EA | HINGE          | 5BB1 4.5 X 4.5 (NRP AS REQ'D) | 639    | IVE |
| 1   | EA | PANIC HARDWARE | 99-L-2-06                     | 612    | VON |
| 2   | EA | RIM HOUSING    | 20-079                        | 612    | SCH |
| 2   | EA | PERMANENT CORE | MATCH EXISTING KEYING SYSTEM  | 613    | SCH |
| 1   | EA | SURFACE CLOSER | 4040XP CUSH MC WMS            | US10   | LCN |
| 1   | EA | KICK PLATE     | 8400 10" X 1 1/2" LDW B-CS    | US10   | IVE |
| 3   | EA | SILENCER       | SR64                          | GRY    | IVE |

HARDWARE GROUP NO. 37

For use on Door #(s):

G-100B          G-106B          J-100B          J-106B          K-100B          L-107B

Provide each OPENING with the following:

| QTY |    | DESCRIPTION        | CATALOG NUMBER       | FINISH | MFR |
|-----|----|--------------------|----------------------|--------|-----|
| 2   | EA | CONT. HINGE        | 112XY                | 628    | IVE |
| 2   | EA | DUMMY PUSH BAR     | 350                  | 626    | VON |
| 2   | EA | 90 DEG OFFSET PULL | 8190HD 12" O         | 630    | IVE |
| 2   | EA | SURFACE CLOSER     | 4040XP SCUSH         | 689    | LCN |
| 2   | EA | MOUNTING PLATE     | 4040XP-18PA AS REQ'D | 689    | LCN |
| 2   | EA | CUSH SHOE SUPPORT  | 4040XP-30 AS REQ'D   | 689    | LCN |
| 2   | EA | BLADE STOP SPACER  | 4040XP-61 AS REQ'D   | 689    | LCN |

HARDWARE GROUP NO. 38

For use on Door #(s):

E-100A                  H-100B                  H-101B

Provide each OPENING with the following:

| QTY |    | DESCRIPTION        | CATALOG NUMBER                      | FINISH | MFR |
|-----|----|--------------------|-------------------------------------|--------|-----|
| 1   | EA | CONT. HINGE        | 112XY                               | 628    | IVE |
| 1   | EA | PANIC HARDWARE     | CD-99-EO                            | 626    | VON |
| 1   | EA | MORTISE CYLINDER   | 26-094 XQ11-948 36-083              | 626    | SCH |
| 1   | EA | PERMANENT CORE     | MATCH EXISTING KEYING SYSTEM        | 626    | SCH |
| 1   | EA | 90 DEG OFFSET PULL | 8190HD 12" O                        | 630    | IVE |
| 1   | EA | SURFACE CLOSER     | 4040XP CUSH                         | 689    | LCN |
| 1   | EA | MOUNTING PLATE     | 4040XP-18PA AS REQ'D                | 689    | LCN |
| 1   | EA | CUSH SHOE SUPPORT  | 4040XP-30 AS REQ'D                  | 689    | LCN |
| 1   | EA | BLADE STOP SPACER  | 4040XP-61 AS REQ'D                  | 689    | LCN |
| 1   |    |                    | WEATHERSTRIP BY DOOR/FRAME SUPPLIER |        |     |
| 1   | EA | DOOR SWEEP         | 39A                                 | A      | ZER |
| 1   | EA | THRESHOLD          | 65A                                 | A      | ZER |

OPERATION: DOOR NORMALLY CLOSED AND LOCKED. DOORS CAN BE LEFT UNLOCKED AS PROGRAMMED BY ACCESS CONTROL. WHEN LOCKED: VALID CREDENTIAL MOMENTARILY RETRACTS ELECTRIC LATCH ALLOWING ENTRY. DOOR CONTACT TO MONITOR DOOR POSITION. RX SWITCH IN EXIT DEVICE PUSH PAD SHUNTS DOOR CONTACT FOR VALID EGRESS. FREE EGRESS AT ALL TIMES.

NOTE: DOORS REQUIRE SPECIAL 3/8" INCH UNDERCUT FOR ADA TYPE THRESHOLD.

HARDWARE GROUP NO. 39

For use on Door #(s):

D-100A

Provide each OPENING with the following:

| QTY |    | DESCRIPTION         | CATALOG NUMBER  | FINISH | MFR |
|-----|----|---------------------|---|--------|-----|
| 2   | EA | CONT. HINGE         | 112XY EPT   | 628    | IVE |
| 2   | EA | POWER TRANSFER      | EPT10   | 689    | VON |
| 1   | EA | REMOVABLE MULLION   | KR4954  | 689    | VON |
| 2   | EA | ELEC PANIC HARDWARE | RX-QEL-99-EO 24 VDC                                     | 626    | VON |
| 1   | EA | MORTISE CYLINDER    | 26-094  | 626    | SCH |
| 1   | EA | PERMANENT CORE      | MATCH EXISTING KEYING SYSTEM                            | 626    | SCH |
| 2   | EA | 90 DEG OFFSET PULL  | 8190HD 12" O  | 630    | IVE |
| 2   | EA | SURFACE CLOSER      | 4040XP SCUSH  | 689    | LCN |
| 2   | EA | MOUNTING PLATE      | 4040XP-18PA AS REQ'D                                    | 689    | LCN |
| 2   | EA | CUSH SHOE SUPPORT   | 4040XP-30 AS REQ'D                                      | 689    | LCN |
| 2   | EA | BLADE STOP SPACER   | 4040XP-61 AS REQ'D                                      | 689    | LCN |
| 1   | EA | MULLION SEAL        | 8780NBK   | BK     | ZER |
| 1   |    |                     | WEATHERSTRIP BY DOOR/FRAME SUPPLIER                     |        |     |
| 2   | EA | DOOR SWEEP          | 39A   | A      | ZER |
| 1   | EA | THRESHOLD           | 65A   | A      | ZER |
| 2   | EA | DOOR CONTACT        | 7764  | 628    | SCE |
| 1   | EA | POWER SUPPLY        | PS904 900-2RS [COORDINATE WITH ACCESS CONTROL PROVIDER] |        | VON |
| 1   | EA | DIAGRAM             | ELEVATION   |        | DLR |
| 1   | EA | DIAGRAM             | POINT TO POINT  |        | DLR |

OPERATION: DOORS NORMALLY CLOSED AND LOCKED. DOORS IN VESTIBULE D-100 ARE UNLOCKED AS PROGRAMMED BY ACCESS CONTROL DURING SCHOOL BUS DROP-OFF AND PICK-UP HOURS. DOOR CONTACTS TO MONITOR DOOR POSITION. RX SWITCH IN EXIT DEVICE PUSH PADS SHUNT DOOR CONTACT FOR VALID EGRESS. FREE EGRESS AT ALL TIMES.

NOTE: DOORS REQUIRE SPECIAL 3/8" INCH UNDERCUT FOR ADA TYPE THRESHOLD.

HARDWARE GROUP NO. 40

For use on Door #(s):

F-100B L-100A

Provide each OPENING with the following:

| QTY |    | DESCRIPTION         | CATALOG NUMBER  | FINISH | MFR |
|-----|----|---------------------|---|--------|-----|
| 2   | EA | CONT. HINGE         | 112XY EPT   | 628    | IVE |
| 2   | EA | POWER TRANSFER      | EPT10   | 689    | VON |
| 1   | EA | REMOVABLE MULLION   | KR4954  | 689    | VON |
| 2   | EA | ELEC PANIC HARDWARE | RX-QEL-99-EO 24 VDC                                     | 626    | VON |
| 1   | EA | MULLION STORAGE KIT | MT54  | 689    | VON |
| 1   | EA | MORTISE CYLINDER    | 26-094  | 626    | SCH |
| 1   | EA | PERMANENT CORE      | MATCH EXISTING KEYING SYSTEM                            | 626    | SCH |
| 2   | EA | 90 DEG OFFSET PULL  | 8190HD 12" O  | 630    | IVE |
| 2   | EA | SURFACE CLOSER      | 4040XP SCUSH  | 689    | LCN |
| 2   | EA | MOUNTING PLATE      | 4040XP-18PA AS REQ'D                                    | 689    | LCN |
| 2   | EA | CUSH SHOE SUPPORT   | 4040XP-30 AS REQ'D                                      | 689    | LCN |
| 2   | EA | BLADE STOP SPACER   | 4040XP-61 AS REQ'D                                      | 689    | LCN |
| 1   | EA | MULLION SEAL        | 8780NBK   | BK     | ZER |
| 1   |    |                     | WEATHERSTRIP BY DOOR/FRAME SUPPLIER                     |        |     |
| 2   | EA | DOOR SWEEP          | 39A   | A      | ZER |
| 1   | EA | THRESHOLD           | 65A   | A      | ZER |
| 2   | EA | DOOR CONTACT        | 7764  | 628    | SCE |
| 1   | EA | POWER SUPPLY        | PS904 900-2RS [COORDINATE WITH ACCESS CONTROL PROVIDER] |        | VON |
| 1   | EA | DIAGRAM             | ELEVATION   |        | DLR |
| 1   | EA | DIAGRAM             | POINT TO POINT  |        | DLR |

OPERATION: DOORS NORMALLY CLOSED AND LOCKED. DOORS CAN BE LEFT UNLOCKED AS PROGRAMMED BY ACCESS CONTROL. DOOR CONTACTS TO MONITOR DOOR POSITION. RX SWITCH IN EXIT DEVICE PUSH PADS SHUNT DOOR CONTACT FOR VALID EGRESS. FREE EGRESS AT ALL TIMES.

NOTE: DOORS REQUIRE SPECIAL 3/8" INCH UNDERCUT FOR ADA TYPE THRESHOLD.

HARDWARE GROUP NO. 41

For use on Door #(s):  
D-100C

Provide each OPENING with the following:

| QTY |    | DESCRIPTION         | CATALOG NUMBER  | FINISH | MFR |
|-----|----|---------------------|---|--------|-----|
| 2   | EA | CONT. HINGE         | 112XY EPT   | 628    | IVE |
| 2   | EA | POWER TRANSFER      | EPT10   | 689    | VON |
| 1   | EA | REMOVABLE MULLION   | KR4954  | 689    | VON |
| 2   | EA | ELEC PANIC HARDWARE | RX-QEL-99-EO 24 VDC                                     | 626    | VON |
| 1   | EA | MORTISE CYLINDER    | 26-094  | 626    | SCH |
| 1   | EA | PERMANENT CORE      | MATCH EXISTING KEYING SYSTEM                            | 626    | SCH |
| 2   | EA | 90 DEG OFFSET PULL  | 8190HD 12" O  | 630    | IVE |
| 2   | EA | SURFACE CLOSER      | 4040XP SCUSH  | 689    | LCN |
| 2   | EA | MOUNTING PLATE      | 4040XP-18PA AS REQ'D                                    | 689    | LCN |
| 2   | EA | CUSH SHOE SUPPORT   | 4040XP-30 AS REQ'D                                      | 689    | LCN |
| 2   | EA | BLADE STOP SPACER   | 4040XP-61 AS REQ'D                                      | 689    | LCN |
| 1   | EA | MULLION SEAL        | 8780NBK   | BK     | ZER |
| 2   | EA | DOOR CONTACT        | 7764  | 628    | SCE |
| 1   | EA | POWER SUPPLY        | PS904 900-2RS [COORDINATE WITH ACCESS CONTROL PROVIDER] |        | VON |
| 1   | EA | DIAGRAM             | ELEVATION   |        | DLR |
| 1   | EA | DIAGRAM             | POINT TO POINT  |        | DLR |

OPERATION: DOORS NORMALLY CLOSED AND LOCKED. DOORS IN VESTIBULE D-100 ARE UNLOCKED AS PROGRAMMED BY ACCESS CONTROL DURING SCHOOL BUS DROP-OFF AND PICK-UP HOURS. DOOR CONTACTS TO MONITOR DOOR POSITION. RX SWITCH IN EXIT DEVICE PUSH PADS SHUNT DOOR CONTACT FOR VALID EGRESS. FREE EGRESS AT ALL TIMES.



HARDWARE GROUP NO. 42

For use on Door #(s):

F-100D L-100C

Provide each OPENING with the following:

| QTY |    | DESCRIPTION         | CATALOG NUMBER  | FINISH | MFR |
|-----|----|---------------------|---|--------|-----|
| 2   | EA | CONT. HINGE         | 112XY EPT   | 628    | IVE |
| 2   | EA | POWER TRANSFER      | EPT10   | 689    | VON |
| 1   | EA | REMOVABLE MULLION   | KR4954  | 689    | VON |
| 2   | EA | ELEC PANIC HARDWARE | RX-QEL-99-EO 24 VDC                                     | 626    | VON |
| 1   | EA | MULLION STORAGE KIT | MT54  | 689    | VON |
| 1   | EA | MORTISE CYLINDER    | 26-094  | 626    | SCH |
| 1   | EA | PERMANENT CORE      | MATCH EXISTING KEYING SYSTEM                            | 626    | SCH |
| 2   | EA | 90 DEG OFFSET PULL  | 8190HD 12" O  | 630    | IVE |
| 2   | EA | SURFACE CLOSER      | 4040XP SCUSH  | 689    | LCN |
| 2   | EA | MOUNTING PLATE      | 4040XP-18PA AS REQ'D                                    | 689    | LCN |
| 2   | EA | CUSH SHOE SUPPORT   | 4040XP-30 AS REQ'D                                      | 689    | LCN |
| 2   | EA | BLADE STOP SPACER   | 4040XP-61 AS REQ'D                                      | 689    | LCN |
| 1   | EA | MULLION SEAL        | 8780NBK   | BK     | ZER |
| 2   | EA | DOOR CONTACT        | 7764  | 628    | SCE |
| 1   | EA | POWER SUPPLY        | PS904 900-2RS [COORDINATE WITH ACCESS CONTROL PROVIDER] |        | VON |
| 1   | EA | DIAGRAM             | ELEVATION   |        | DLR |
| 1   | EA | DIAGRAM             | POINT TO POINT  |        | DLR |

OPERATION: DOORS NORMALLY CLOSED AND LOCKED. DOORS CAN BE LEFT UNLOCKED AS PROGRAMMED BY ACCESS CONTROL. DOOR CONTACTS TO MONITOR DOOR POSITION. RX SWITCH IN EXIT DEVICE PUSH PADS SHUNT DOOR CONTACT FOR VALID EGRESS. FREE EGRESS AT ALL TIMES.

HARDWARE GROUP NO. 43

For use on Door #(s):  
K-114B

Provide each OPENING with the following:

| QTY |    | DESCRIPTION    | CATALOG NUMBER                                  | FINISH | MFR |
|-----|----|----------------|---|--------|-----|
| 1   | EA | CONT. HINGE    | 112XY   | 628    | IVE |
| 1   | EA | PANIC HARDWARE | 99-L-06-WH                                      | 626    | VON |
| 1   | EA | RIM HOUSING    | 20-079  | 626    | SCH |
| 1   | EA | PERMANENT CORE | MATCH EXISTING KEYING<br>SYSTEM                 | 626    | SCH |
| 1   | EA | OH STOP        | 100S  | 630    | GLY |
| 1   | EA | SURFACE CLOSER | 4040XPT ST-3182<br>(MOUNT ON PULL SIDE OF DOOR) | 689    | LCN |
| 1   | EA | RAIN DRIP      | 11A<br>(MOUNT ON PUSH SIDE OF<br>DOOR)          | A      | ZER |
| 1   | EA | RAIN DRIP      | 142AA<br>(MOUNT ON PUSH SIDE OF<br>DOOR)        | AA     | ZER |
| 1   |    |                | WEATHERSTRIP BY<br>DOOR/FRAME SUPPLIER          |        |     |
| 1   | EA | THRESHOLD      | 65A   | A      | ZER |

NOTE: DOORS REQUIRE SPECIAL 3/8" INCH UNDERCUT FOR ADA TYPE THRESHOLD.

HARDWARE GROUP NO. 44

For use on Door #(s):  
F-123A

Provide each OPENING with the following:

| QTY |    | DESCRIPTION       | CATALOG NUMBER                                  | FINISH | MFR |
|-----|----|-------------------|---|--------|-----|
| 2   | EA | CONT. HINGE       | 112XY   | 628    | IVE |
| 1   | EA | REMOVABLE MULLION | KR4954  | 689    | VON |
| 1   | EA | PANIC HARDWARE    | 99-EO-WH  | 626    | VON |
| 1   | EA | PANIC HARDWARE    | 99-L-06-WH                                      | 626    | VON |
| 1   | EA | RIM HOUSING       | 20-079  | 626    | SCH |
| 1   | EA | MORTISE CYLINDER  | 26-094  | 626    | SCH |
| 2   | EA | PERMANENT CORE    | MATCH EXISTING KEYING<br>SYSTEM                 | 626    | SCH |
| 2   | EA | OH STOP           | 100S  | 630    | GLY |
| 2   | EA | SURFACE CLOSER    | 4040XPT ST-3182<br>(MOUNT ON PULL SIDE OF DOOR) | 689    | LCN |
| 1   | EA | RAIN DRIP         | 11A<br>(MOUNT ON PUSH SIDE OF<br>DOOR)          | A      | ZER |
| 1   | EA | RAIN DRIP         | 142AA<br>(MOUNT ON PUSH SIDE OF<br>DOOR)        | AA     | ZER |
| 1   | EA | MULLION SEAL      | 8780NBK   | BK     | ZER |
| 1   |    |                   | WEATHERSTRIP BY<br>DOOR/FRAME SUPPLIER          |        |     |
| 1   | EA | THRESHOLD         | 65A   | A      | ZER |

NOTE: DOORS REQUIRE SPECIAL 3/8" INCH UNDERCUT FOR ADA TYPE THRESHOLD.

HARDWARE GROUP NO. 45

For use on Door #(s):

C-102A              C-103A              C-105A

Provide each OPENING with the following:

| QTY |    | DESCRIPTION         | CATALOG NUMBER  | FINISH | MFR |
|-----|----|---------------------|---|--------|-----|
| 2   | EA | CONT. HINGE         | 224HD (CUSTOM FINISH - SATIN BRONZE, CONSULT FACTORY) |        | IVE |
| 1   | EA | REMOVABLE MULLION   | KR4954  | 689    | VON |
| 1   | EA | PANIC HARDWARE      | 99-EO   | 612    | VON |
| 1   | EA | PANIC HARDWARE      | 99-L-2-06   | 612    | VON |
| 1   | EA | MULLION STORAGE KIT | MT54  | 689    | VON |
| 2   | EA | RIM HOUSING         | 20-079  | 612    | SCH |
| 1   | EA | MORTISE CYLINDER    | 26-094  | 626    | SCH |
| 3   | EA | PERMANENT CORE      | MATCH EXISTING KEYING SYSTEM                          | 613    | SCH |
| 2   | EA | SURFACE CLOSER      | 4040XP SCUSH MC WMS                                   | US10   | LCN |
| 2   | EA | KICK PLATE          | 8400 10" X 1" LDW B-CS                                | US10   | IVE |
| 1   | EA | MEETING STILE       | 328AA-S   | AA     | ZER |
| 1   | EA | GASKETING           | 870AA   | AA     | ZER |
| 1   | EA | MULLION SEAL        | 8780NBK   | BK     | ZER |
| 2   | EA | DOOR BOTTOM         | 364AA   | AA     | ZER |
| 1   | EA | THRESHOLD           | 545A  | A      | ZER |

HARDWARE GROUP NO. 46

For use on Door #(s):

A-100A                      A-108A

Provide each OPENING with the following:

| QTY |    | DESCRIPTION         | CATALOG NUMBER  | FINISH | MFR |
|-----|----|---------------------|---|--------|-----|
| 1   | EA | CONT. HINGE         | 112XY EPT   | 628    | IVE |
| 1   | EA | POWER TRANSFER      | EPT10   | 689    | VON |
| 1   | EA | ELEC PANIC HARDWARE | RX-QEL-99-NL 24 VDC   | 626    | VON |
| 1   | EA | RIM HOUSING         | 20-079  | 626    | SCH |
| 1   | EA | PERMANENT CORE      | MATCH EXISTING KEYING SYSTEM  | 626    | SCH |
| 1   | EA | SURFACE CLOSER      | 4040XP CUSH   | 689    | LCN |
| 1   | EA | MOUNTING PLATE      | 4040XP-18PA AS REQ'D  | 689    | LCN |
| 1   | EA | CUSH SHOE SUPPORT   | 4040XP-30 AS REQ'D  | 689    | LCN |
| 1   | EA | BLADE STOP SPACER   | 4040XP-61 AS REQ'D  | 689    | LCN |
| 1   |    |                     | WEATHERSTRIP BY DOOR/FRAME SUPPLIER   |        |     |
| 1   | EA | DOOR SWEEP          | 39A   | A      | ZER |
| 1   | EA | THRESHOLD           | 65A   | A      | ZER |
| 1   | EA | CREDENTIAL READER   | MTB15 - BY ACCESS CONTROL PROVIDER (COORDINATE W/ HEAD END AND CREDENTIAL TYPE) | BLK    | SCE |
| 1   | EA | DOOR CONTACT        | 7764  | 628    | SCE |
| 1   | EA | POWER SUPPLY        | PS902 900-4R [COORDINATE WITH ACCESS CONTROL]                                   | LGR    | SCE |
| 1   | EA | DIAGRAM             | ELEVATION   |        | DLR |
| 1   | EA | DIAGRAM             | POINT TO POINT  |        | DLR |

OPERATION: DOOR NORMALLY CLOSED AND LOCKED. DOORS CAN BE LEFT UNLOCKED AS PROGRAMMED BY ACCESS CONTROL. WHEN LOCKED: VALID CREDENTIAL MOMENTARILY RETRACTS ELECTRIC LATCH ALLOWING ENTRY. DOOR CONTACT TO MONITOR DOOR POSITION. RX SWITCH IN EXIT DEVICE PUSH PAD SHUNTS DOOR CONTACT FOR VALID EGRESS. FREE EGRESS AT ALL TIMES.

NOTE: DOORS REQUIRE SPECIAL 3/8" INCH UNDERCUT FOR ADA TYPE THRESHOLD.

HARDWARE GROUP NO. 47

For use on Door #(s):  
F-100A

Provide each OPENING with the following:

| QTY |    | DESCRIPTION         | CATALOG NUMBER  | FINISH | MFR |
|-----|----|---------------------|---|--------|-----|
| 2   | EA | CONT. HINGE         | 112XY EPT   | 628    | IVE |
| 2   | EA | POWER TRANSFER      | EPT10   | 689    | VON |
| 1   | EA | REMOVABLE MULLION   | KR4954  | 689    | VON |
| 1   | EA | ELEC PANIC HARDWARE | RX-QEL-99-EO 24 VDC   | 626    | VON |
| 1   | EA | ELEC PANIC HARDWARE | RX-QEL-99-NL-OP-110MD 24 VDC  | 626    | VON |
| 1   | EA | RIM HOUSING         | 20-079  | 626    | SCH |
| 1   | EA | MORTISE CYLINDER    | 26-094  | 626    | SCH |
| 2   | EA | PERMANENT CORE      | MATCH EXISTING KEYING SYSTEM  | 626    | SCH |
| 2   | EA | 90 DEG OFFSET PULL  | 8190HD 12" O  | 630    | IVE |
| 1   | EA | SURFACE CLOSER      | 4040XP SCUSH  | 689    | LCN |
| 1   | EA | SURF. AUTO OPERATOR | 4642 TBWMS  | 689    | LCN |
| 1   | EA | MOUNTING PLATE      | 4040XP-18PA AS REQ'D  | 689    | LCN |
| 1   | EA | CUSH SHOE SUPPORT   | 4040XP-30 AS REQ'D  | 689    | LCN |
| 1   | EA | BLADE STOP SPACER   | 4040XP-61 AS REQ'D  | 689    | LCN |
| 1   | EA | ACTUATOR, TOUCH     | 8310-818T   | 630    | LCN |
| 1   | EA | ACTUATOR, TOUCH     | 8310-853T   | 630    | LCN |
| 1   | EA | MULLION SEAL        | 8780NBK   | BK     | ZER |
| 1   |    |                     | WEATHERSTRIP BY DOOR/FRAME SUPPLIER   |        |     |
| 2   | EA | DOOR SWEEP          | 39A   | A      | ZER |
| 1   | EA | THRESHOLD           | 65A   | A      | ZER |
| 1   | EA | CREDENTIAL READER   | MTB15 - BY ACCESS CONTROL PROVIDER (COORDINATE W/ HEAD END AND CREDENTIAL TYPE) | BLK    | SCE |
| 2   | EA | DOOR CONTACT        | 7764  | 628    | SCE |
| 1   | EA | POWER SUPPLY        | PS904 900-4RL [COORDINATE WITH ACCESS CONTROL PROVIDER]                         | LGR    | SCE |
| 1   | EA | DIAGRAM             | ELEVATION   |        | DLR |
| 1   | EA | DIAGRAM             | POINT TO POINT  |        | DLR |

OPERATION: DOORS NORMALLY CLOSED AND LOCKED. DOORS CAN BE LEFT UNLOCKED AS PROGRAMMED BY ACCESS CONTROL. DOOR CONTACTS TO MONITOR DOOR POSITION. RX SWITCH IN EXIT DEVICE PUSH PADS SHUNT DOOR CONTACT FOR VALID EGRESS. FREE EGRESS AT ALL TIMES.

UNLOCKED HOURS: PRESSING EITHER ACTUATOR CYCLES AUTOMATIC OPERATOR AND MOMENTARILY OPENS DOOR.

LOCKED HOURS: VALID CREDENTIAL MOMENTARILY UNLOCKS DOOR AND ACTIVATES EXTERIOR ACTUATOR. WHEN ACTIVE, PRESSING EXTERIOR ACTUATOR CYCLES AUTOMATIC OPERATOR AND MOMENTARILY OPENS DOOR. INTERIOR ACTUATOR ALWAYS ACTIVE.

NOTE: DOORS REQUIRE SPECIAL 3/8" INCH UNDERCUT FOR ADA TYPE THRESHOLD.

HARDWARE GROUP NO. 48

For use on Door #(s):  
L-100B

Provide each OPENING with the following:

| QTY |    | DESCRIPTION         | CATALOG NUMBER  | FINISH | MFR |
|-----|----|---------------------|---|--------|-----|
| 2   | EA | CONT. HINGE         | 112XY EPT   | 628    | IVE |
| 2   | EA | POWER TRANSFER      | EPT10   | 689    | VON |
| 1   | EA | REMOVABLE MULLION   | KR4954  | 689    | VON |
| 1   | EA | ELEC PANIC HARDWARE | RX-QEL-99-EO 24 VDC   | 626    | VON |
| 1   | EA | ELEC PANIC HARDWARE | RX-QEL-99-NL-OP-110MD 24 VDC  | 626    | VON |
| 1   | EA | RIM HOUSING         | 20-079  | 626    | SCH |
| 1   | EA | MORTISE CYLINDER    | 26-094  | 626    | SCH |
| 2   | EA | PERMANENT CORE      | MATCH EXISTING KEYING SYSTEM  | 626    | SCH |
| 2   | EA | 90 DEG OFFSET PULL  | 8190HD 12" O  | 630    | IVE |
| 1   | EA | SURFACE CLOSER      | 4040XP SCUSH  | 689    | LCN |
| 1   | EA | SURF. AUTO OPERATOR | 4642 TBWMS  | 689    | LCN |
| 1   | EA | MOUNTING PLATE      | 4040XP-18PA AS REQ'D  | 689    | LCN |
| 1   | EA | CUSH SHOE SUPPORT   | 4040XP-30 AS REQ'D  | 689    | LCN |
| 1   | EA | BLADE STOP SPACER   | 4040XP-61 AS REQ'D  | 689    | LCN |
| 1   | EA | ACTUATOR, TOUCH     | 8310-818T   | 630    | LCN |
| 1   | EA | ACTUATOR, TOUCH     | 8310-853T   | 630    | LCN |
| 1   | EA | MULLION SEAL        | 8780NBK   | BK     | ZER |
| 1   |    |                     | WEATHERSTRIP BY DOOR/FRAME SUPPLIER   |        |     |
| 2   | EA | DOOR SWEEP          | 39A   | A      | ZER |
| 1   | EA | THRESHOLD           | 65A   | A      | ZER |
| 1   | EA | CREDENTIAL READER   | MTB15 - BY ACCESS CONTROL PROVIDER (COORDINATE W/ HEAD END AND CREDENTIAL TYPE) | BLK    | SCE |
| 1   | EA | AI PHONE            | BY ACCESS CONTROL PROVIDER  |        |     |
| 2   | EA | DOOR CONTACT        | 7764  | 628    | SCE |
| 1   | EA | POWER SUPPLY        | PS904 900-4RL [COORDINATE WITH ACCESS CONTROL PROVIDER]                         | LGR    | SCE |
| 1   | EA | DIAGRAM             | ELEVATION   |        | DLR |
| 1   | EA | DIAGRAM             | POINT TO POINT  |        | DLR |



OPERATION: DOORS NORMALLY CLOSED AND LOCKED. DOORS CAN BE LEFT UNLOCKED AS PROGRAMMED BY ACCESS CONTROL. DOOR CONTACTS TO MONITOR DOOR POSITION. RX SWITCH IN EXIT DEVICE PUSH PADS SHUNT DOOR CONTACT FOR VALID EGRESS. FREE EGRESS AT ALL TIMES.

UNLOCKED HOURS: PRESSING EITHER ACTUATOR CYCLES AUTOMATIC OPERATOR AND MOMENTARILY OPENS DOOR.

LOCKED HOURS: VALID CREDENTIAL OR AI PHONE MOMENTARILY UNLOCKS DOOR AND ACTIVATES EXTERIOR ACTUATOR. WHEN ACTIVE, PRESSING EXTERIOR ACTUATOR CYCLES AUTOMATIC OPERATOR AND MOMENTARILY OPENS DOOR. INTERIOR ACTUATOR ALWAYS ACTIVE.

NOTE: DOORS REQUIRE SPECIAL 3/8" INCH UNDERCUT FOR ADA TYPE THRESHOLD.

HARDWARE GROUP NO. 49

For use on Door #(s):

F-100C

Provide each OPENING with the following:

| QTY |    | DESCRIPTION         | CATALOG NUMBER  | FINISH | MFR |
|-----|----|---------------------|---|--------|-----|
| 2   | EA | CONT. HINGE         | 112XY EPT   | 628    | IVE |
| 2   | EA | POWER TRANSFER      | EPT10   | 689    | VON |
| 1   | EA | REMOVABLE MULLION   | KR4954  | 689    | VON |
| 1   | EA | ELEC PANIC HARDWARE | RX-QEL-99-EO 24 VDC                                     | 626    | VON |
| 1   | EA | ELEC PANIC HARDWARE | RX-QEL-99-NL-OP-110MD 24 VDC                            | 626    | VON |
| 1   | EA | RIM HOUSING         | 20-079  | 626    | SCH |
| 1   | EA | MORTISE CYLINDER    | 26-094  | 626    | SCH |
| 2   | EA | PERMANENT CORE      | MATCH EXISTING KEYING SYSTEM                            | 626    | SCH |
| 2   | EA | 90 DEG OFFSET PULL  | 8190HD 12" O  | 630    | IVE |
| 1   | EA | SURFACE CLOSER      | 4040XP SCUSH  | 689    | LCN |
| 1   | EA | SURF. AUTO OPERATOR | 4642 TBWMS  | 689    | LCN |
| 1   | EA | MOUNTING PLATE      | 4040XP-18PA AS REQ'D                                    | 689    | LCN |
| 1   | EA | CUSH SHOE SUPPORT   | 4040XP-30 AS REQ'D                                      | 689    | LCN |
| 1   | EA | BLADE STOP SPACER   | 4040XP-61 AS REQ'D                                      | 689    | LCN |
| 2   | EA | ACTUATOR, TOUCH     | 8310-853T   | 630    | LCN |
| 1   | EA | MULLION SEAL        | 8780NBK   | BK     | ZER |
| 2   | EA | DOOR CONTACT        | 7764  | 628    | SCE |
| 1   | EA | POWER SUPPLY        | PS904 900-4RL [COORDINATE WITH ACCESS CONTROL PROVIDER] | LGR    | SCE |
| 1   | EA | DIAGRAM             | ELEVATION   |        | DLR |
| 1   | EA | DIAGRAM             | POINT TO POINT  |        | DLR |

OPERATION: DOORS NORMALLY CLOSED AND LOCKED. DOORS CAN BE LEFT UNLOCKED AS PROGRAMMED BY ACCESS CONTROL. DOOR CONTACTS TO MONITOR DOOR POSITION. RX SWITCH IN EXIT DEVICE PUSH PADS SHUNT DOOR CONTACT FOR VALID EGRESS. FREE EGRESS AT ALL TIMES.

UNLOCKED HOURS: PRESSING EITHER ACTUATOR CYCLES AUTOMATIC OPERATOR AND MOMENTARILY OPENS DOOR.

HARDWARE GROUP NO. 50

For use on Door #(s):  
L-100D

Provide each OPENING with the following:

| QTY |    | DESCRIPTION         | CATALOG NUMBER  | FINISH | MFR |
|-----|----|---------------------|---|--------|-----|
| 2   | EA | CONT. HINGE         | 112XY EPT   | 628    | IVE |
| 2   | EA | POWER TRANSFER      | EPT10   | 689    | VON |
| 1   | EA | REMOVABLE MULLION   | KR4954  | 689    | VON |
| 1   | EA | ELEC PANIC HARDWARE | RX-QEL-99-EO 24 VDC   | 626    | VON |
| 1   | EA | ELEC PANIC HARDWARE | RX-QEL-99-NL-OP-110MD 24 VDC  | 626    | VON |
| 1   | EA | RIM HOUSING         | 20-079  | 626    | SCH |
| 1   | EA | MORTISE CYLINDER    | 26-094  | 626    | SCH |
| 2   | EA | PERMANENT CORE      | MATCH EXISTING KEYING SYSTEM  | 626    | SCH |
| 2   | EA | 90 DEG OFFSET PULL  | 8190HD 12" O  | 630    | IVE |
| 1   | EA | SURFACE CLOSER      | 4040XP SCUSH  | 689    | LCN |
| 1   | EA | SURF. AUTO OPERATOR | 4642 TBWMS  | 689    | LCN |
| 1   | EA | MOUNTING PLATE      | 4040XP-18PA AS REQ'D  | 689    | LCN |
| 1   | EA | CUSH SHOE SUPPORT   | 4040XP-30 AS REQ'D  | 689    | LCN |
| 1   | EA | BLADE STOP SPACER   | 4040XP-61 AS REQ'D  | 689    | LCN |
| 2   | EA | ACTUATOR, TOUCH     | 8310-818T   | 630    | LCN |
| 1   | EA | MULLION SEAL        | 8780NBK   | BK     | ZER |
| 1   | EA | CREDENTIAL READER   | MTB15 - BY ACCESS CONTROL PROVIDER (COORDINATE W/ HEAD END AND CREDENTIAL TYPE) | BLK    | SCE |
| 2   | EA | DOOR CONTACT        | 7764  | 628    | SCE |
| 1   | EA | POWER SUPPLY        | PS904 900-4RL [COORDINATE WITH ACCESS CONTROL PROVIDER]                         | LGR    | SCE |
| 1   | EA | DIAGRAM             | ELEVATION   |        | DLR |
| 1   | EA | DIAGRAM             | POINT TO POINT  |        | DLR |

OPERATION: DOORS NORMALLY CLOSED AND LOCKED. DOORS CAN BE LEFT UNLOCKED AS PROGRAMMED BY ACCESS CONTROL. DOOR CONTACTS TO MONITOR DOOR POSITION. RX SWITCH IN EXIT DEVICE PUSH PADS SHUNT DOOR CONTACT FOR VALID EGRESS. FREE EGRESS AT ALL TIMES.

UNLOCKED HOURS: PRESSING EITHER ACTUATOR CYCLES AUTOMATIC OPERATOR AND MOMENTARILY OPENS DOOR.

LOCKED HOURS: VALID CREDENTIAL MOMENTARILY UNLOCKS DOOR AND ACTIVATES EXTERIOR ACTUATOR. WHEN ACTIVE, PRESSING EXTERIOR ACTUATOR CYCLES AUTOMATIC OPERATOR AND MONETARILY OPENS DOOR. INTERIOR ACTUATOR ALWAYS ACTIVE.

HARDWARE GROUP NO. 51

For use on Door #(s):

E-100B          H-100C          H-101C

Provide each OPENING with the following:

| QTY |    | DESCRIPTION         | CATALOG NUMBER  | FINISH | MFR |
|-----|----|---------------------|---|--------|-----|
| 1   | EA | CONT. HINGE         | 112XY EPT   | 628    | IVE |
| 1   | EA | POWER TRANSFER      | EPT10   | 689    | VON |
| 1   | EA | ELEC PANIC HARDWARE | RX-QEL-99-NL-OP-110MD 24 VDC  | 626    | VON |
| 1   | EA | RIM HOUSING         | 20-079  | 626    | SCH |
| 1   | EA | PERMANENT CORE      | MATCH EXISTING KEYING SYSTEM  | 626    | SCH |
| 1   | EA | 90 DEG OFFSET PULL  | 8190HD 12" O  | 630    | IVE |
| 1   | EA | SURFACE CLOSER      | 4040XP CUSH   | 689    | LCN |
| 1   | EA | MOUNTING PLATE      | 4040XP-18PA AS REQ'D  | 689    | LCN |
| 1   | EA | CUSH SHOE SUPPORT   | 4040XP-30 AS REQ'D  | 689    | LCN |
| 1   | EA | BLADE STOP SPACER   | 4040XP-61 AS REQ'D  | 689    | LCN |
| 1   |    |                     | WEATHERSTRIP BY DOOR/FRAME SUPPLIER   |        |     |
| 1   | EA | DOOR SWEEP          | 39A   | A      | ZER |
| 1   | EA | THRESHOLD           | 65A   | A      | ZER |
| 1   | EA | CREDENTIAL READER   | MTB15 - BY ACCESS CONTROL PROVIDER (COORDINATE W/ HEAD END AND CREDENTIAL TYPE) | BLK    | SCE |
| 1   | EA | DOOR CONTACT        | 7764  | 628    | SCE |
| 1   | EA | POWER SUPPLY        | PS902 900-4R [COORDINATE WITH ACCESS CONTROL]                                   | LGR    | SCE |
| 1   | EA | DIAGRAM             | ELEVATION   |        | DLR |
| 1   | EA | DIAGRAM             | POINT TO POINT  |        | DLR |

OPERATION: DOOR NORMALLY CLOSED AND LOCKED. DOORS CAN BE LEFT UNLOCKED AS PROGRAMMED BY ACCESS CONTROL. WHEN LOCKED: VALID CREDENTIAL MOMENTARILY RETRACTS ELECTRIC LATCH ALLOWING ENTRY. DOOR CONTACT TO MONITOR DOOR POSITION. RX SWITCH IN EXIT DEVICE PUSH PAD SHUNTS DOOR CONTACT FOR VALID EGRESS. FREE EGRESS AT ALL TIMES.

NOTE: DOORS REQUIRE SPECIAL 3/8" INCH UNDERCUT FOR ADA TYPE THRESHOLD.

HARDWARE GROUP NO. 52

For use on Door #(s):  
H-112A

Provide each OPENING with the following:

| QTY |    | DESCRIPTION       | CATALOG NUMBER                  | FINISH | MFR |
|-----|----|-------------------|---------------------------------|--------|-----|
| 6   | EA | HINGE             | 5BB1 4.5 X 4.5 (NRP AS REQ'D)   | 652    | IVE |
| 1   | EA | PANIC HARDWARE    | CD-9949-EO-LBL                  | 626    | VON |
| 1   | EA | PANIC HARDWARE    | CD-9949-NL-OP-110MD-LBL         | 626    | VON |
| 2   | EA | TRIM              | 550-DT                          | 626    | VON |
| 1   | EA | RIM HOUSING       | 20-079                          | 626    | SCH |
| 2   | EA | MORTISE CYLINDER  | 26-094 XQ11-948 36-083          | 626    | SCH |
| 3   | EA | PERMANENT CORE    | MATCH EXISTING KEYING<br>SYSTEM | 626    | SCH |
| 2   | EA | SURFACE CLOSER    | 4040XP SCUSH                    | 689    | LCN |
| 2   | EA | MOUNTING PLATE    | 4040XP-18PA AS REQ'D            | 689    | LCN |
| 2   | EA | CUSH SHOE SUPPORT | 4040XP-30 AS REQ'D              | 689    | LCN |
| 2   | EA | BLADE STOP SPACER | 4040XP-61 AS REQ'D              | 689    | LCN |
| 1   | EA | MULLION SEAL      | 8780NBK                         | BK     | ZER |

HARDWARE GROUP NO. 53

For use on Door #(s):

D-117A D-124A

Provide each OPENING with the following:

| QTY |    | DESCRIPTION         | CATALOG NUMBER  | FINISH | MFR |
|-----|----|---------------------|---|--------|-----|
| 1   | EA | CONT. HINGE         | 112XY EPT   | 628    | IVE |
| 1   | EA | POWER TRANSFER      | EPT10   | 689    | VON |
| 1   | EA | ELEC PANIC HARDWARE | RX-QEL-99-NL-OP-110MD 24 VDC  | 626    | VON |
| 1   | EA | RIM HOUSING         | 20-079  | 626    | SCH |
| 1   | EA | PERMANENT CORE      | MATCH EXISTING KEYING SYSTEM  | 626    | SCH |
| 1   | EA | 90 DEG OFFSET PULL  | 8190HD 12" O  | 630    | IVE |
| 1   | EA | SURFACE CLOSER      | 4040XP SCUSH  | 689    | LCN |
| 1   | EA | MOUNTING PLATE      | 4040XP-18PA AS REQ'D  | 689    | LCN |
| 1   | EA | CUSH SHOE SUPPORT   | 4040XP-30 AS REQ'D  | 689    | LCN |
| 1   | EA | BLADE STOP SPACER   | 4040XP-61 AS REQ'D  | 689    | LCN |
| 1   |    |                     | WEATHERSTRIP BY DOOR/FRAME SUPPLIER   |        |     |
| 1   | EA | DOOR SWEEP          | 39A   | A      | ZER |
| 1   | EA | THRESHOLD           | 65A   | A      | ZER |
| 1   | EA | CREDENTIAL READER   | MTB15 - BY ACCESS CONTROL PROVIDER (COORDINATE W/ HEAD END AND CREDENTIAL TYPE) | BLK    | SCE |
| 1   | EA | DOOR CONTACT        | 7764  | 628    | SCE |
| 1   | EA | POWER SUPPLY        | PS902 900-4R [COORDINATE WITH ACCESS CONTROL]                                   | LGR    | SCE |
| 1   | EA | DIAGRAM             | ELEVATION   |        | DLR |
| 1   | EA | DIAGRAM             | POINT TO POINT  |        | DLR |

OPERATION: DOOR NORMALLY CLOSED AND LOCKED. DOORS CAN BE LEFT UNLOCKED AS PROGRAMMED BY ACCESS CONTROL. WHEN LOCKED: VALID CREDENTIAL MOMENTARILY RETRACTS ELECTRIC LATCH ALLOWING ENTRY. DOOR CONTACT TO MONITOR DOOR POSITION. RX SWITCH IN EXIT DEVICE PUSH PAD SHUNTS DOOR CONTACT FOR VALID EGRESS. FREE EGRESS AT ALL TIMES.

NOTE: DOORS REQUIRE SPECIAL 3/8" INCH UNDERCUT FOR ADA TYPE THRESHOLD.

HARDWARE GROUP NO. 54

For use on Door #(s):

G-100A      G-106A      J-100A      J-106A      K-100A      L-107A

Provide each OPENING with the following:

| QTY |    | DESCRIPTION                         | CATALOG NUMBER  | FINISH | MFR |
|-----|----|-------------------------------------|---|--------|-----|
| 2   | EA | CONT. HINGE                         | 112XY EPT   | 628    | IVE |
| 2   | EA | POWER TRANSFER                      | EPT10   | 689    | VON |
| 1   | EA | REMOVABLE MULLION                   | KR4954  | 689    | VON |
| 1   | EA | ELEC PANIC HARDWARE                 | RX-QEL-99-EO 24 VDC   | 626    | VON |
| 1   | EA | ELEC PANIC HARDWARE                 | RX-QEL-99-NL-OP-110MD 24 VDC  | 626    | VON |
| 1   | EA | MULLION STORAGE KIT                 | MT54  | 689    | VON |
| 1   | EA | RIM HOUSING                         | 20-079  | 626    | SCH |
| 1   | EA | MORTISE CYLINDER                    | 26-094  | 626    | SCH |
| 2   | EA | PERMANENT CORE                      | MATCH EXISTING KEYING SYSTEM  | 626    | SCH |
| 2   | EA | 90 DEG OFFSET PULL                  | 8190HD 12" O  | 630    | IVE |
| 2   | EA | SURFACE CLOSER                      | 4040XP SCUSH  | 689    | LCN |
| 2   | EA | MOUNTING PLATE                      | 4040XP-18PA AS REQ'D  | 689    | LCN |
| 2   | EA | CUSH SHOE SUPPORT                   | 4040XP-30 AS REQ'D  | 689    | LCN |
| 2   | EA | BLADE STOP SPACER                   | 4040XP-61 AS REQ'D  | 689    | LCN |
| 1   | EA | MULLION SEAL                        | 8780NBK   | BK     | ZER |
| 1   |    | WEATHERSTRIP BY DOOR/FRAME SUPPLIER |   |        |     |
| 2   | EA | DOOR SWEEP                          | 39A   | A      | ZER |
| 1   | EA | THRESHOLD                           | 65A   | A      | ZER |
| 1   | EA | CREDENTIAL READER                   | MTB15 - BY ACCESS CONTROL PROVIDER (COORDINATE W/ HEAD END AND CREDENTIAL TYPE) | BLK    | SCE |
| 2   | EA | DOOR CONTACT                        | 7764  | 628    | SCE |
| 1   | EA | POWER SUPPLY                        | PS904 900-2RS [COORDINATE WITH ACCESS CONTROL PROVIDER]                         |        | VON |
| 1   | EA | DIAGRAM                             | ELEVATION   |        | DLR |
| 1   | EA | DIAGRAM                             | POINT TO POINT  |        | DLR |

OPERATION: DOORS NORMALLY CLOSED AND LOCKED. DOORS CAN BE LEFT UNLOCKED AS PROGRAMMED BY ACCESS CONTROL. WHEN LOCKED: VALID CREDENTIAL MOMENTARILY RETRACTS ELECTRIC LATCH ALLOWING ENTRY. DOOR CONTACTS TO MONITOR DOOR POSITION. RX SWITCH IN EXIT DEVICE PUSH PADS SHUNT DOOR CONTACT FOR VALID EGRESS. FREE EGRESS AT ALL TIMES.

NOTE: DOORS REQUIRE SPECIAL 3/8" INCH UNDERCUT FOR ADA TYPE THRESHOLD.

HARDWARE GROUP NO. 55

For use on Door #(s):

C-101A E-132A

Provide each OPENING with the following:

| QTY |    | DESCRIPTION         | CATALOG NUMBER  | FINISH | MFR |
|-----|----|---------------------|---|--------|-----|
| 2   | EA | CONT. HINGE         | 112XY EPT   | 628    | IVE |
| 2   | EA | POWER TRANSFER      | EPT10   | 689    | VON |
| 1   | EA | REMOVABLE MULLION   | KR4954  | 689    | VON |
| 1   | EA | ELEC PANIC HARDWARE | RX-QEL-99-DT 24 VDC   | 626    | VON |
| 1   | EA | ELEC PANIC HARDWARE | RX-QEL-99-NL 24 VDC   | 626    | VON |
| 1   | EA | RIM HOUSING         | 20-079  | 626    | SCH |
| 1   | EA | MORTISE CYLINDER    | 26-094  | 626    | SCH |
| 2   | EA | PERMANENT CORE      | MATCH EXISTING KEYING SYSTEM  | 626    | SCH |
| 2   | EA | SURFACE CLOSER      | 4040XP SCUSH  | 689    | LCN |
| 2   | EA | MOUNTING PLATE      | 4040XP-18PA AS REQ'D  | 689    | LCN |
| 2   | EA | CUSH SHOE SUPPORT   | 4040XP-30 AS REQ'D  | 689    | LCN |
| 2   | EA | BLADE STOP SPACER   | 4040XP-61 AS REQ'D  | 689    | LCN |
| 1   | EA | MULLION SEAL        | 8780NBK   | BK     | ZER |
| 1   |    |                     | WEATHERSTRIP BY DOOR/FRAME SUPPLIER   |        |     |
| 2   | EA | DOOR SWEEP          | 39A   | A      | ZER |
| 1   | EA | THRESHOLD           | 65A   | A      | ZER |
| 1   | EA | CREDENTIAL READER   | MTB15 - BY ACCESS CONTROL PROVIDER (COORDINATE W/ HEAD END AND CREDENTIAL TYPE) | BLK    | SCE |
| 2   | EA | DOOR CONTACT        | 7764  | 628    | SCE |
| 1   | EA | POWER SUPPLY        | PS904 900-2RS [COORDINATE WITH ACCESS CONTROL PROVIDER]                         |        | VON |
| 1   | EA | DIAGRAM             | ELEVATION   |        | DLR |
| 1   | EA | DIAGRAM             | POINT TO POINT  |        | DLR |

OPERATION: DOORS NORMALLY CLOSED AND LOCKED. DOORS CAN BE LEFT UNLOCKED AS PROGRAMMED BY ACCESS CONTROL. WHEN LOCKED: VALID CREDENTIAL MOMENTARILY RETRACTS ELECTRIC LATCH ALLOWING ENTRY. DOOR CONTACTS TO MONITOR DOOR POSITION. RX SWITCH IN EXIT DEVICE PUSH PADS SHUNT DOOR CONTACT FOR VALID EGRESS. FREE EGRESS AT ALL TIMES.

NOTE: DOORS REQUIRE SPECIAL 3/8" INCH UNDERCUT FOR ADA TYPE THRESHOLD.



HARDWARE GROUP NO. 56

For use on Door #(s):

D-100B

Provide each OPENING with the following:

| QTY |    | DESCRIPTION                         | CATALOG NUMBER  | FINISH | MFR |
|-----|----|-------------------------------------|---|--------|-----|
| 2   | EA | CONT. HINGE                         | 112XY EPT   | 628    | IVE |
| 2   | EA | POWER TRANSFER                      | EPT10   | 689    | VON |
| 1   | EA | REMOVABLE MULLION                   | KR4954  | 689    | VON |
| 1   | EA | ELEC PANIC HARDWARE                 | RX-QEL-99-EO 24 VDC                                     | 626    | VON |
| 1   | EA | ELEC PANIC HARDWARE                 | RX-QEL-99-NL-OP-110MD 24 VDC                            | 626    | VON |
| 1   | EA | MULLION STORAGE KIT                 | MT54  | 689    | VON |
| 1   | EA | RIM HOUSING                         | 20-079  | 626    | SCH |
| 1   | EA | MORTISE CYLINDER                    | 26-094  | 626    | SCH |
| 2   | EA | PERMANENT CORE                      | MATCH EXISTING KEYING SYSTEM                            | 626    | SCH |
| 2   | EA | 90 DEG OFFSET PULL                  | 8190HD 12" O  | 630    | IVE |
| 2   | EA | SURFACE CLOSER                      | 4040XP SCUSH  | 689    | LCN |
| 2   | EA | MOUNTING PLATE                      | 4040XP-18PA AS REQ'D                                    | 689    | LCN |
| 2   | EA | CUSH SHOE SUPPORT                   | 4040XP-30 AS REQ'D                                      | 689    | LCN |
| 2   | EA | BLADE STOP SPACER                   | 4040XP-61 AS REQ'D                                      | 689    | LCN |
| 1   | EA | MULLION SEAL                        | 8780NBK   | BK     | ZER |
| 1   |    | WEATHERSTRIP BY DOOR/FRAME SUPPLIER |   |        |     |
| 2   | EA | DOOR SWEEP                          | 39A   | A      | ZER |
| 1   | EA | THRESHOLD                           | 65A   | A      | ZER |
| 2   | EA | DOOR CONTACT                        | 7764  | 628    | SCE |
| 1   | EA | POWER SUPPLY                        | PS904 900-2RS [COORDINATE WITH ACCESS CONTROL PROVIDER] |        | VON |
| 1   | EA | DIAGRAM                             | ELEVATION   |        | DLR |
| 1   | EA | DIAGRAM                             | POINT TO POINT  |        | DLR |

OPERATION: DOORS NORMALLY CLOSED AND LOCKED. DOORS IN VESTIBULE D-100 ARE UNLOCKED AS PROGRAMMED BY ACCESS CONTROL DURING SCHOOL BUS DROP-OFF AND PICK-UP HOURS. DOOR CONTACTS TO MONITOR DOOR POSITION. RX SWITCH IN EXIT DEVICE PUSH PADS SHUNT DOOR CONTACT FOR VALID EGRESS. FREE EGRESS AT ALL TIMES.

NOTE: DOORS REQUIRE SPECIAL 3/8" INCH UNDERCUT FOR ADA TYPE THRESHOLD.

HARDWARE GROUP NO. 57

For use on Door #(s):  
D-100D

Provide each OPENING with the following:

| QTY |    | DESCRIPTION         | CATALOG NUMBER  | FINISH | MFR |
|-----|----|---------------------|---|--------|-----|
| 2   | EA | CONT. HINGE         | 112XY EPT   | 628    | IVE |
| 2   | EA | POWER TRANSFER      | EPT10   | 689    | VON |
| 1   | EA | REMOVABLE MULLION   | KR4954  | 689    | VON |
| 1   | EA | ELEC PANIC HARDWARE | RX-QEL-99-EO 24 VDC   | 626    | VON |
| 1   | EA | ELEC PANIC HARDWARE | RX-QEL-99-NL-OP-110MD 24 VDC                                  | 626    | VON |
| 1   | EA | MULLION STORAGE KIT | MT54  | 689    | VON |
| 1   | EA | RIM HOUSING         | 20-079  | 626    | SCH |
| 1   | EA | MORTISE CYLINDER    | 26-094  | 626    | SCH |
| 2   | EA | PERMANENT CORE      | MATCH EXISTING KEYING<br>SYSTEM                               | 626    | SCH |
| 2   | EA | 90 DEG OFFSET PULL  | 8190HD 12" O  | 630    | IVE |
| 2   | EA | SURFACE CLOSER      | 4040XP SCUSH  | 689    | LCN |
| 2   | EA | MOUNTING PLATE      | 4040XP-18PA AS REQ'D  | 689    | LCN |
| 2   | EA | CUSH SHOE SUPPORT   | 4040XP-30 AS REQ'D  | 689    | LCN |
| 2   | EA | BLADE STOP SPACER   | 4040XP-61 AS REQ'D  | 689    | LCN |
| 1   | EA | MULLION SEAL        | 8780NBK   | BK     | ZER |
| 2   | EA | DOOR CONTACT        | 7764  | 628    | SCE |
| 1   | EA | POWER SUPPLY        | PS904 900-2RS [COORDINATE<br>WITH ACCESS CONTROL<br>PROVIDER] |        | VON |
| 1   | EA | DIAGRAM             | ELEVATION   |        | DLR |
| 1   | EA | DIAGRAM             | POINT TO POINT  |        | DLR |

OPERATION: DOORS NORMALLY CLOSED AND LOCKED. DOORS IN VESTIBULE D-100 ARE UNLOCKED AS PROGRAMMED BY ACCESS CONTROL DURING SCHOOL BUS DROP-OFF AND PICK-UP HOURS. DOOR CONTACTS TO MONITOR DOOR POSITION. RX SWITCH IN EXIT DEVICE PUSH PADS SHUNT DOOR CONTACT FOR VALID EGRESS. FREE EGRESS AT ALL TIMES.

HARDWARE GROUP NO. 58

For use on Door #(s):

H-112B J-125A J-128A

Provide each OPENING with the following:

| QTY |    | DESCRIPTION    | CATALOG NUMBER                | FINISH | MFR |
|-----|----|----------------|-------------------------------|--------|-----|
| 3   | EA | HINGE          | 5BB1 4.5 X 4.5 (NRP AS REQ'D) | 639    | IVE |
| 1   | EA | PANIC HARDWARE | 99-L-2-06                     | 612    | VON |
| 2   | EA | RIM HOUSING    | 20-079                        | 612    | SCH |
| 2   | EA | PERMANENT CORE | MATCH EXISTING KEYING SYSTEM  | 613    | SCH |
| 1   | EA | SURFACE CLOSER | 4040XP SCUSH MC WMS           | US10   | LCN |
| 1   | EA | KICK PLATE     | 8400 10" X 1 1/2" LDW B-CS    | US10   | IVE |
| 3   | EA | SILENCER       | SR64                          | GRY    | IVE |

HARDWARE GROUP NO. 59

For use on Door #(s):

D-137B D-150A

Provide each OPENING with the following:

| QTY |    | DESCRIPTION    | CATALOG NUMBER                  | FINISH | MFR |
|-----|----|----------------|---------------------------------|--------|-----|
| 3   | EA | HINGE          | 5BB1HW 4.5 X 4.5 (NRP AS REQ'D) | 639    | IVE |
| 1   | EA | PANIC HARDWARE | 99-L-2-06                       | 612    | VON |
| 2   | EA | RIM HOUSING    | 20-079                          | 612    | SCH |
| 2   | EA | PERMANENT CORE | MATCH EXISTING KEYING SYSTEM    | 613    | SCH |
| 1   | EA | SURFACE CLOSER | 4040XP SCUSH MC WMS             | US10   | LCN |
| 1   | EA | KICK PLATE     | 8400 10" X 1 1/2" LDW B-CS      | US10   | IVE |
| 3   | EA | SILENCER       | SR64                            | GRY    | IVE |

HARDWARE GROUP NO. 60

For use on Door #(s):

|        |        |        |        |        |        |
|--------|--------|--------|--------|--------|--------|
| G-104A | G-105A | H-112C | H-116A | H-118A | H-130A |
| H-132A | J-101A | J-102A | J-125B | J-128B | K-114A |
| K-115A |        |        |        |        |        |

Provide each OPENING with the following:

| QTY |    | DESCRIPTION    | CATALOG NUMBER                | FINISH | MFR |
|-----|----|----------------|-------------------------------|--------|-----|
| 3   | EA | HINGE          | 5BB1 4.5 X 4.5 (NRP AS REQ'D) | 639    | IVE |
| 1   | EA | PANIC HARDWARE | 99-L-2-06                     | 612    | VON |
| 2   | EA | RIM HOUSING    | 20-079                        | 612    | SCH |
| 2   | EA | PERMANENT CORE | MATCH EXISTING KEYING SYSTEM  | 613    | SCH |
| 1   | EA | SURFACE CLOSER | 4040XP RW/PA MC WMS           | US10   | LCN |
| 1   | EA | KICK PLATE     | 8400 10" X 1 1/2" LDW B-CS    | US10   | IVE |
| 1   | EA | WALL STOP      | WS401/402CVX                  | 612    | IVE |
| 3   | EA | SILENCER       | SR64                          | GRY    | IVE |

HARDWARE GROUP NO. 61

For use on Door #(s):

F-116A

Provide each OPENING with the following:

| QTY |    | DESCRIPTION    | CATALOG NUMBER                | FINISH | MFR |
|-----|----|----------------|-------------------------------|--------|-----|
| 3   | EA | HINGE          | 5BB1 4.5 X 4.5 (NRP AS REQ'D) | 652    | IVE |
| 1   | EA | PANIC HARDWARE | 99-L-2-06                     | 626    | VON |
| 2   | EA | RIM HOUSING    | 20-079                        | 626    | SCH |
| 2   | EA | PERMANENT CORE | MATCH EXISTING KEYING SYSTEM  | 626    | SCH |
| 1   | EA | SURFACE CLOSER | 4040XP RW/PA                  | 689    | LCN |
| 1   | EA | WALL STOP      | WS401/402CVX                  | 626    | IVE |

HARDWARE GROUP NO. 62

For use on Door #(s):

A-100B      A-108B      D-128A      D-137A      D-144A

Provide each OPENING with the following:

| QTY |    | DESCRIPTION    | CATALOG NUMBER                  | FINISH | MFR |
|-----|----|----------------|---------------------------------|--------|-----|
| 3   | EA | HINGE          | 5BB1HW 4.5 X 4.5 (NRP AS REQ'D) | 639    | IVE |
| 1   | EA | PANIC HARDWARE | 99-L-2-06                       | 612    | VON |
| 2   | EA | RIM HOUSING    | 20-079                          | 612    | SCH |
| 2   | EA | PERMANENT CORE | MATCH EXISTING KEYING SYSTEM    | 613    | SCH |
| 1   | EA | SURFACE CLOSER | 4040XP RW/PA MC WMS             | US10   | LCN |
| 1   | EA | KICK PLATE     | 8400 10" X 1 1/2" LDW B-CS      | US10   | IVE |
| 1   | EA | WALL STOP      | WS401/402CVX                    | 612    | IVE |
| 3   | EA | SILENCER       | SR64                            | GRY    | IVE |

HARDWARE GROUP NO. 63

For use on Door #(s):

|        |        |        |        |        |        |
|--------|--------|--------|--------|--------|--------|
| A-101B | A-101C | A-109B | A-109C | D-138B | D-145B |
| E-100B | E-100D | E-114A | E-114B | E-121B | E-121C |
| F-100E | F-100F | F-101C | F-101D | F-108B | F-119B |
| F-123B | F-123C | F-123D | F-123X | H-100A | H-100D |
| H-101A | H-101D | K-122B |        |        |        |

Provide each OPENING with the following:


| QTY | DESCRIPTION | CATALOG NUMBER                       | FINISH | MFR |
|-----|-------------|--------------------------------------|--------|-----|
| EA  | NOTE        | NO HARDWARE REQUIRED (BORROWED LITE) |        |     |

END OF SECTION







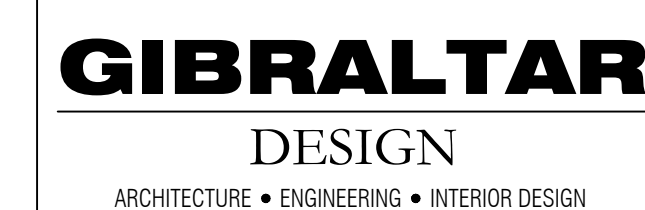

PROJECT

**WESTCHESTER  
INTERMEDIATE  
SCHOOL -  
ADDITIONS &  
RENOVATIONS**

DUNELAND SCHOOL CORPORATION  
CHESTERTON, INDIANA



|  |  |
|--|--|
| PROJECT<br>21-141<br>DATE<br>03/16/22<br>COORDINATED BY<br>AWM<br>DRAWN BY<br>BPL<br>CHECKED BY<br>AWM |  |
|--|--|


**COPYRIGHT NOTICE:**  
THE CONCEPTS, DESIGNS, PLANS, DETAILS, ETC., SHOWN ON THIS DOCUMENT ARE THE PROPERTY OF GIBRALTAR DESIGN AND WERE CREATED FOR USE ON THIS SPECIFIC PROJECT. NONE OF THIS INFORMATION SHALL BE USED BY ANY PERSON OR FIRM FOR ANY PURPOSE WITHOUT THE EXPRESS WRITTEN CONSENT OF GIBRALTAR DESIGN. THE OWNER MAY RETAIN COPIES FOR INFORMATION AND REFERENCE IN CONNECTION ONLY WITH THIS PROJECT.

[illegible]

DRAWING  
DEMOLITION PLAN 2

PROJECT  
WESTCHESTER IS -  
ADDITIONS & RENOVATIONS

© GIBRALTAR DESIGN  
SHEET  
**C-1.3**

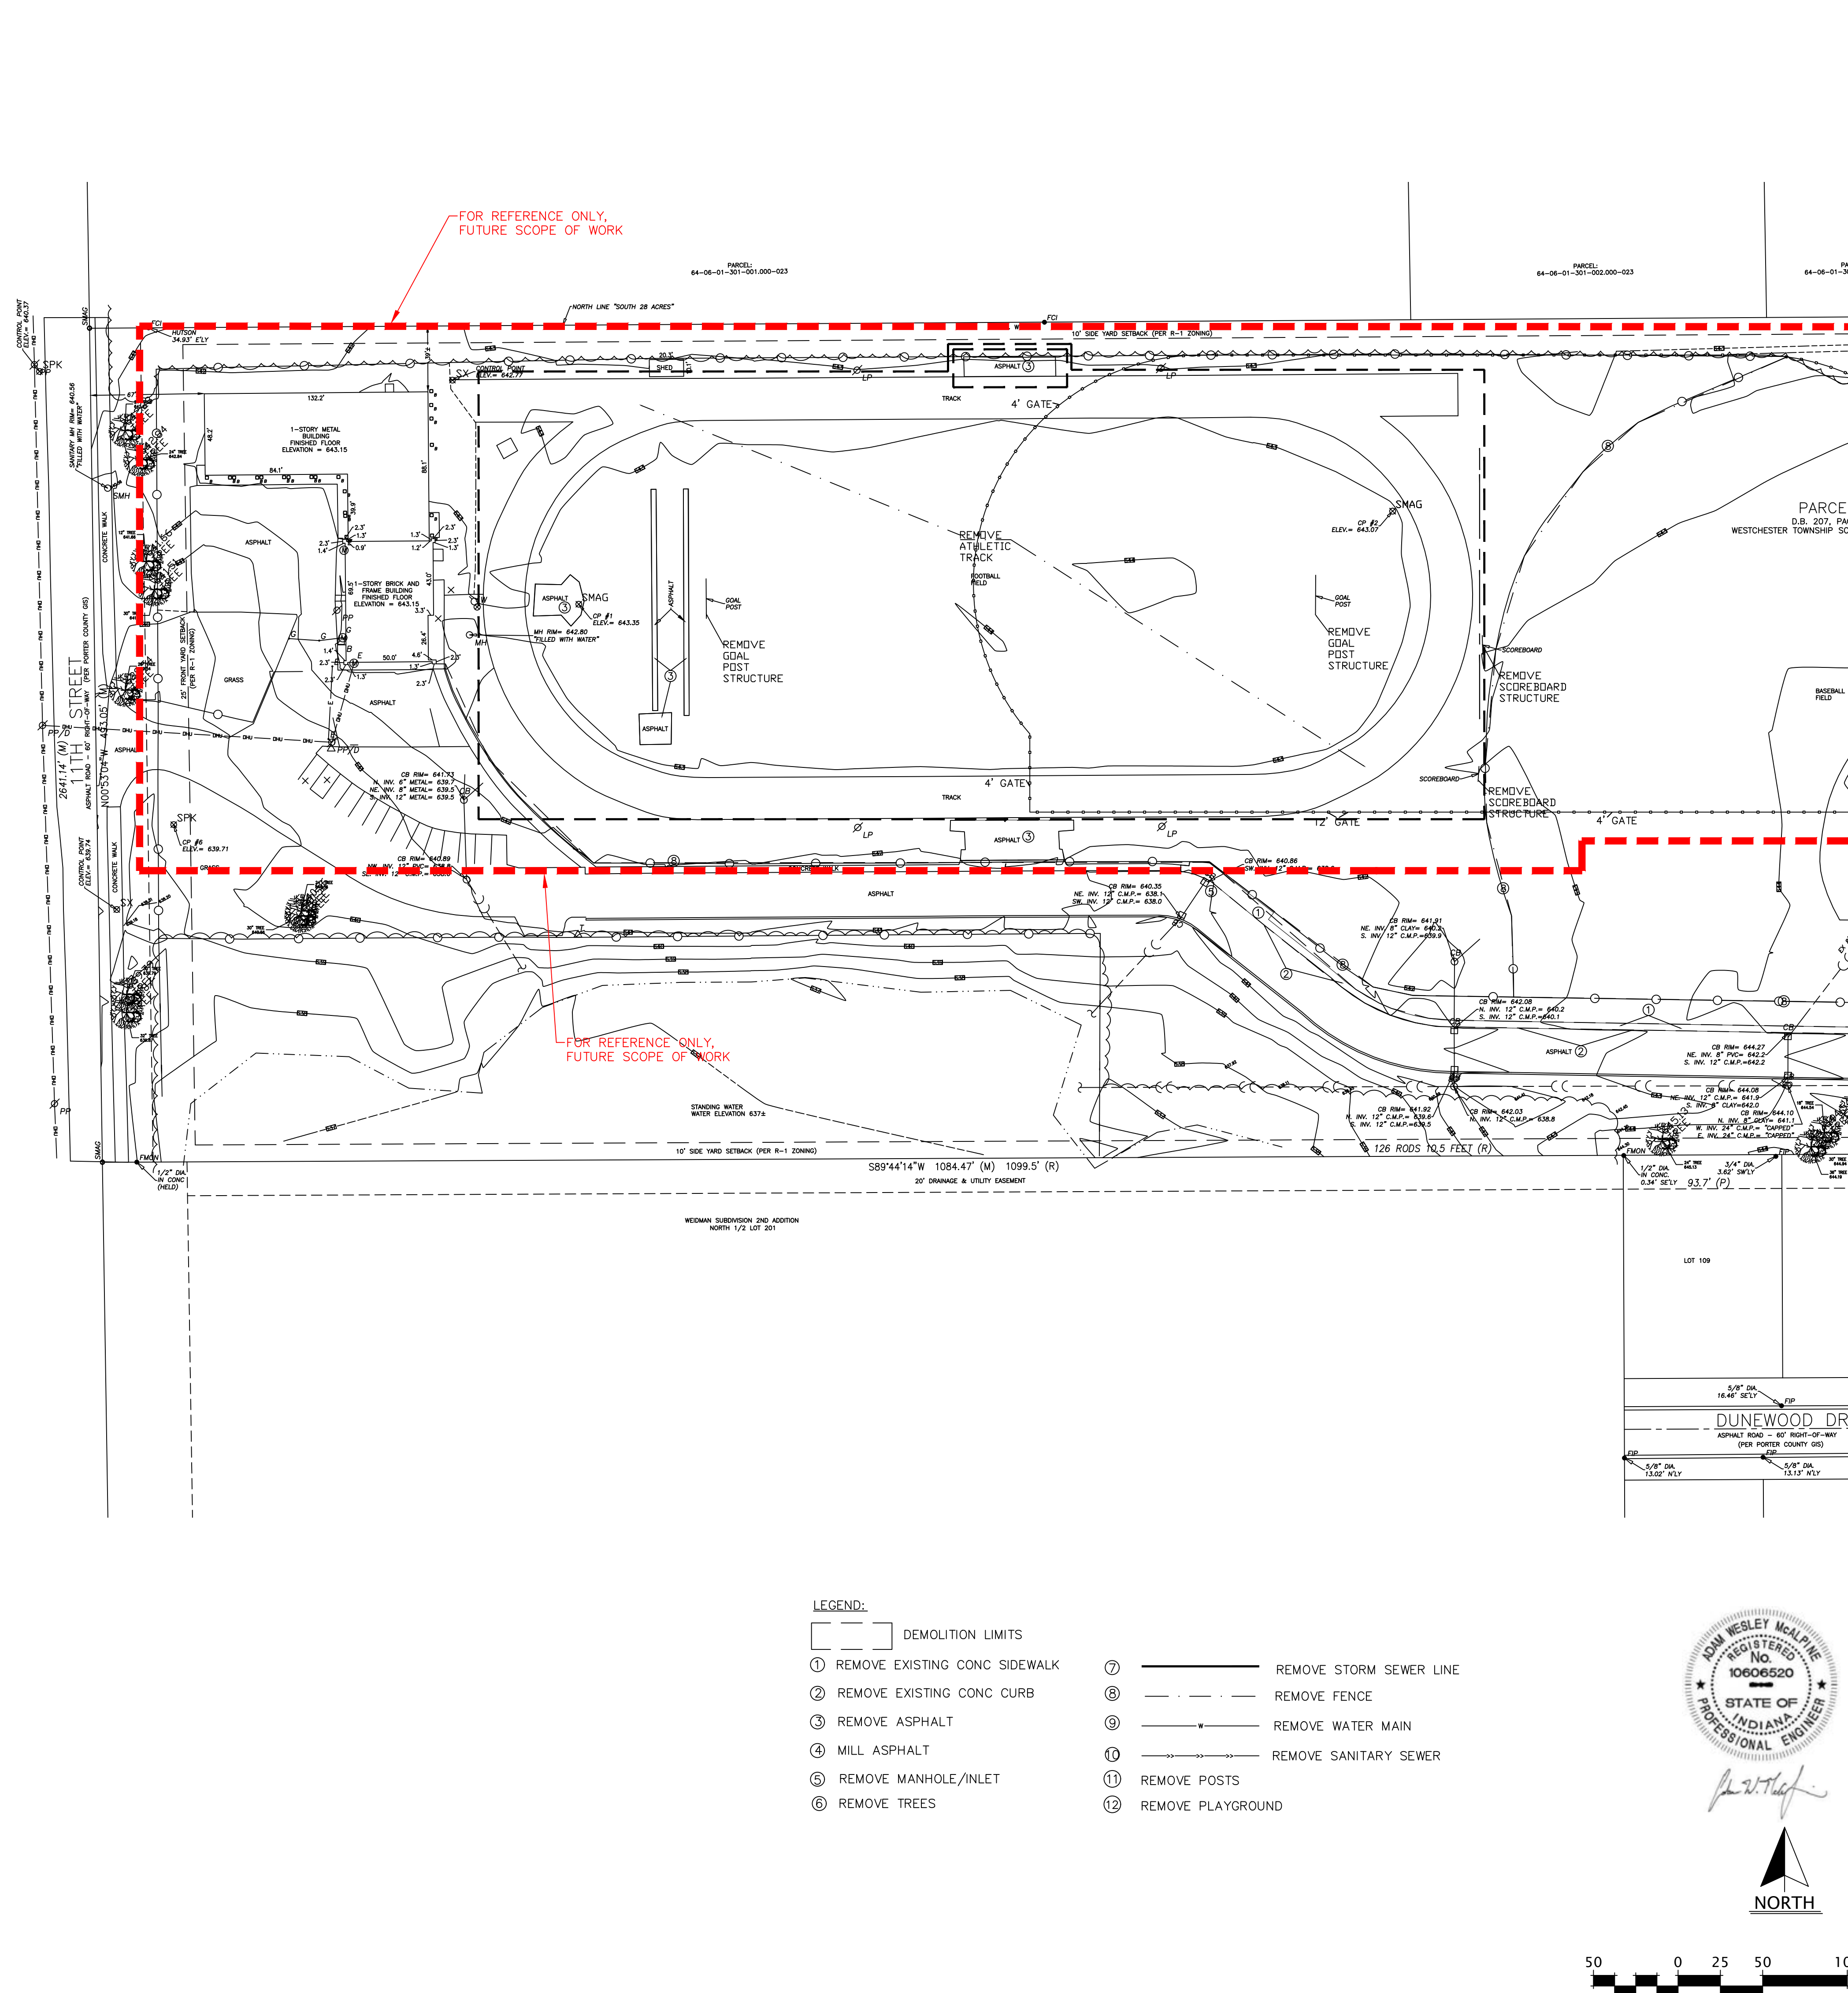






**GIBALTAR**  
DESIGN  
ARCHITECTURE • ENGINEERING • INTERIOR DESIGN

PROJECT  
**WESTCHESTER  
INTERMEDIATE  
SCHOOL -  
ADDITIONS &  
RENOVATIONS**  
DUNELAND SCHOOL CORPORATION  
CHESTERTON, INDIANA



MCALPINE CONSULTING LLC  
398 East 400 North  
Valparaiso, IN 46383  
Phone: 219.252.9647  
E-Mail: mcalpineconsulting@yahoo.com

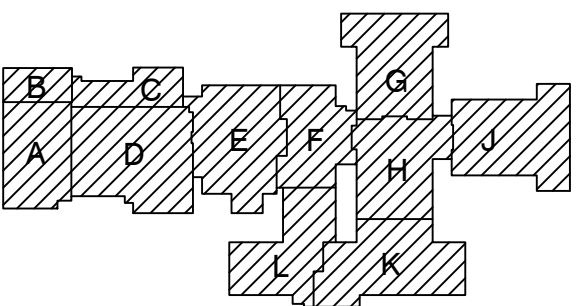

**GIBALTAR DESIGN**  
9102 N. Meridian St., Ste. 300  
Indianapolis, IN 46260  
Homepage: www.GibraltarDesign.com  
Email: info@GibraltarDesign.com  
Phone: 317.580.5777 Fax: 317.580.5778

PROJECT  
21-141  
DATE  
03/16/22  
COORDINATED BY  
AWM  
DRAWN BY  
BPL  
CHECKED BY  
AWM


COPYRIGHT NOTICE:  
THE CONCEPTS, DESIGNS, PLANS, DETAILS, ETC., SHOWN ON  
THIS DOCUMENT ARE THE PROPERTY OF GIBALTAR DESIGN AND  
WERE CREATED FOR USE ON THIS SPECIFIC PROJECT. NONE OF  
THIS INFORMATION SHALL BE USED BY ANY PERSON OR FIRM  
FOR ANY PURPOSE WITHOUT THE EXPRESS WRITTEN CONSENT  
OF GIBALTAR DESIGN. THE OWNER MAY RETAIN COPIES FOR  
INFORMATION AND REFERENCE IN CONNECTION ONLY WITH THIS  
PROJECT.

REVISIONS  
MARK DATE ISSUED FOR  
AD-1 03/16/22 ADDENDUM NO. 1

DRAWING  
**GEOMETRIC LAYOUT PLAN 1**

PROJECT  
**WESTCHESTER IS -  
ADDITIONS & RENOVATIONS**

© GIBALTAR DESIGN SHEET  
**C-2.0**

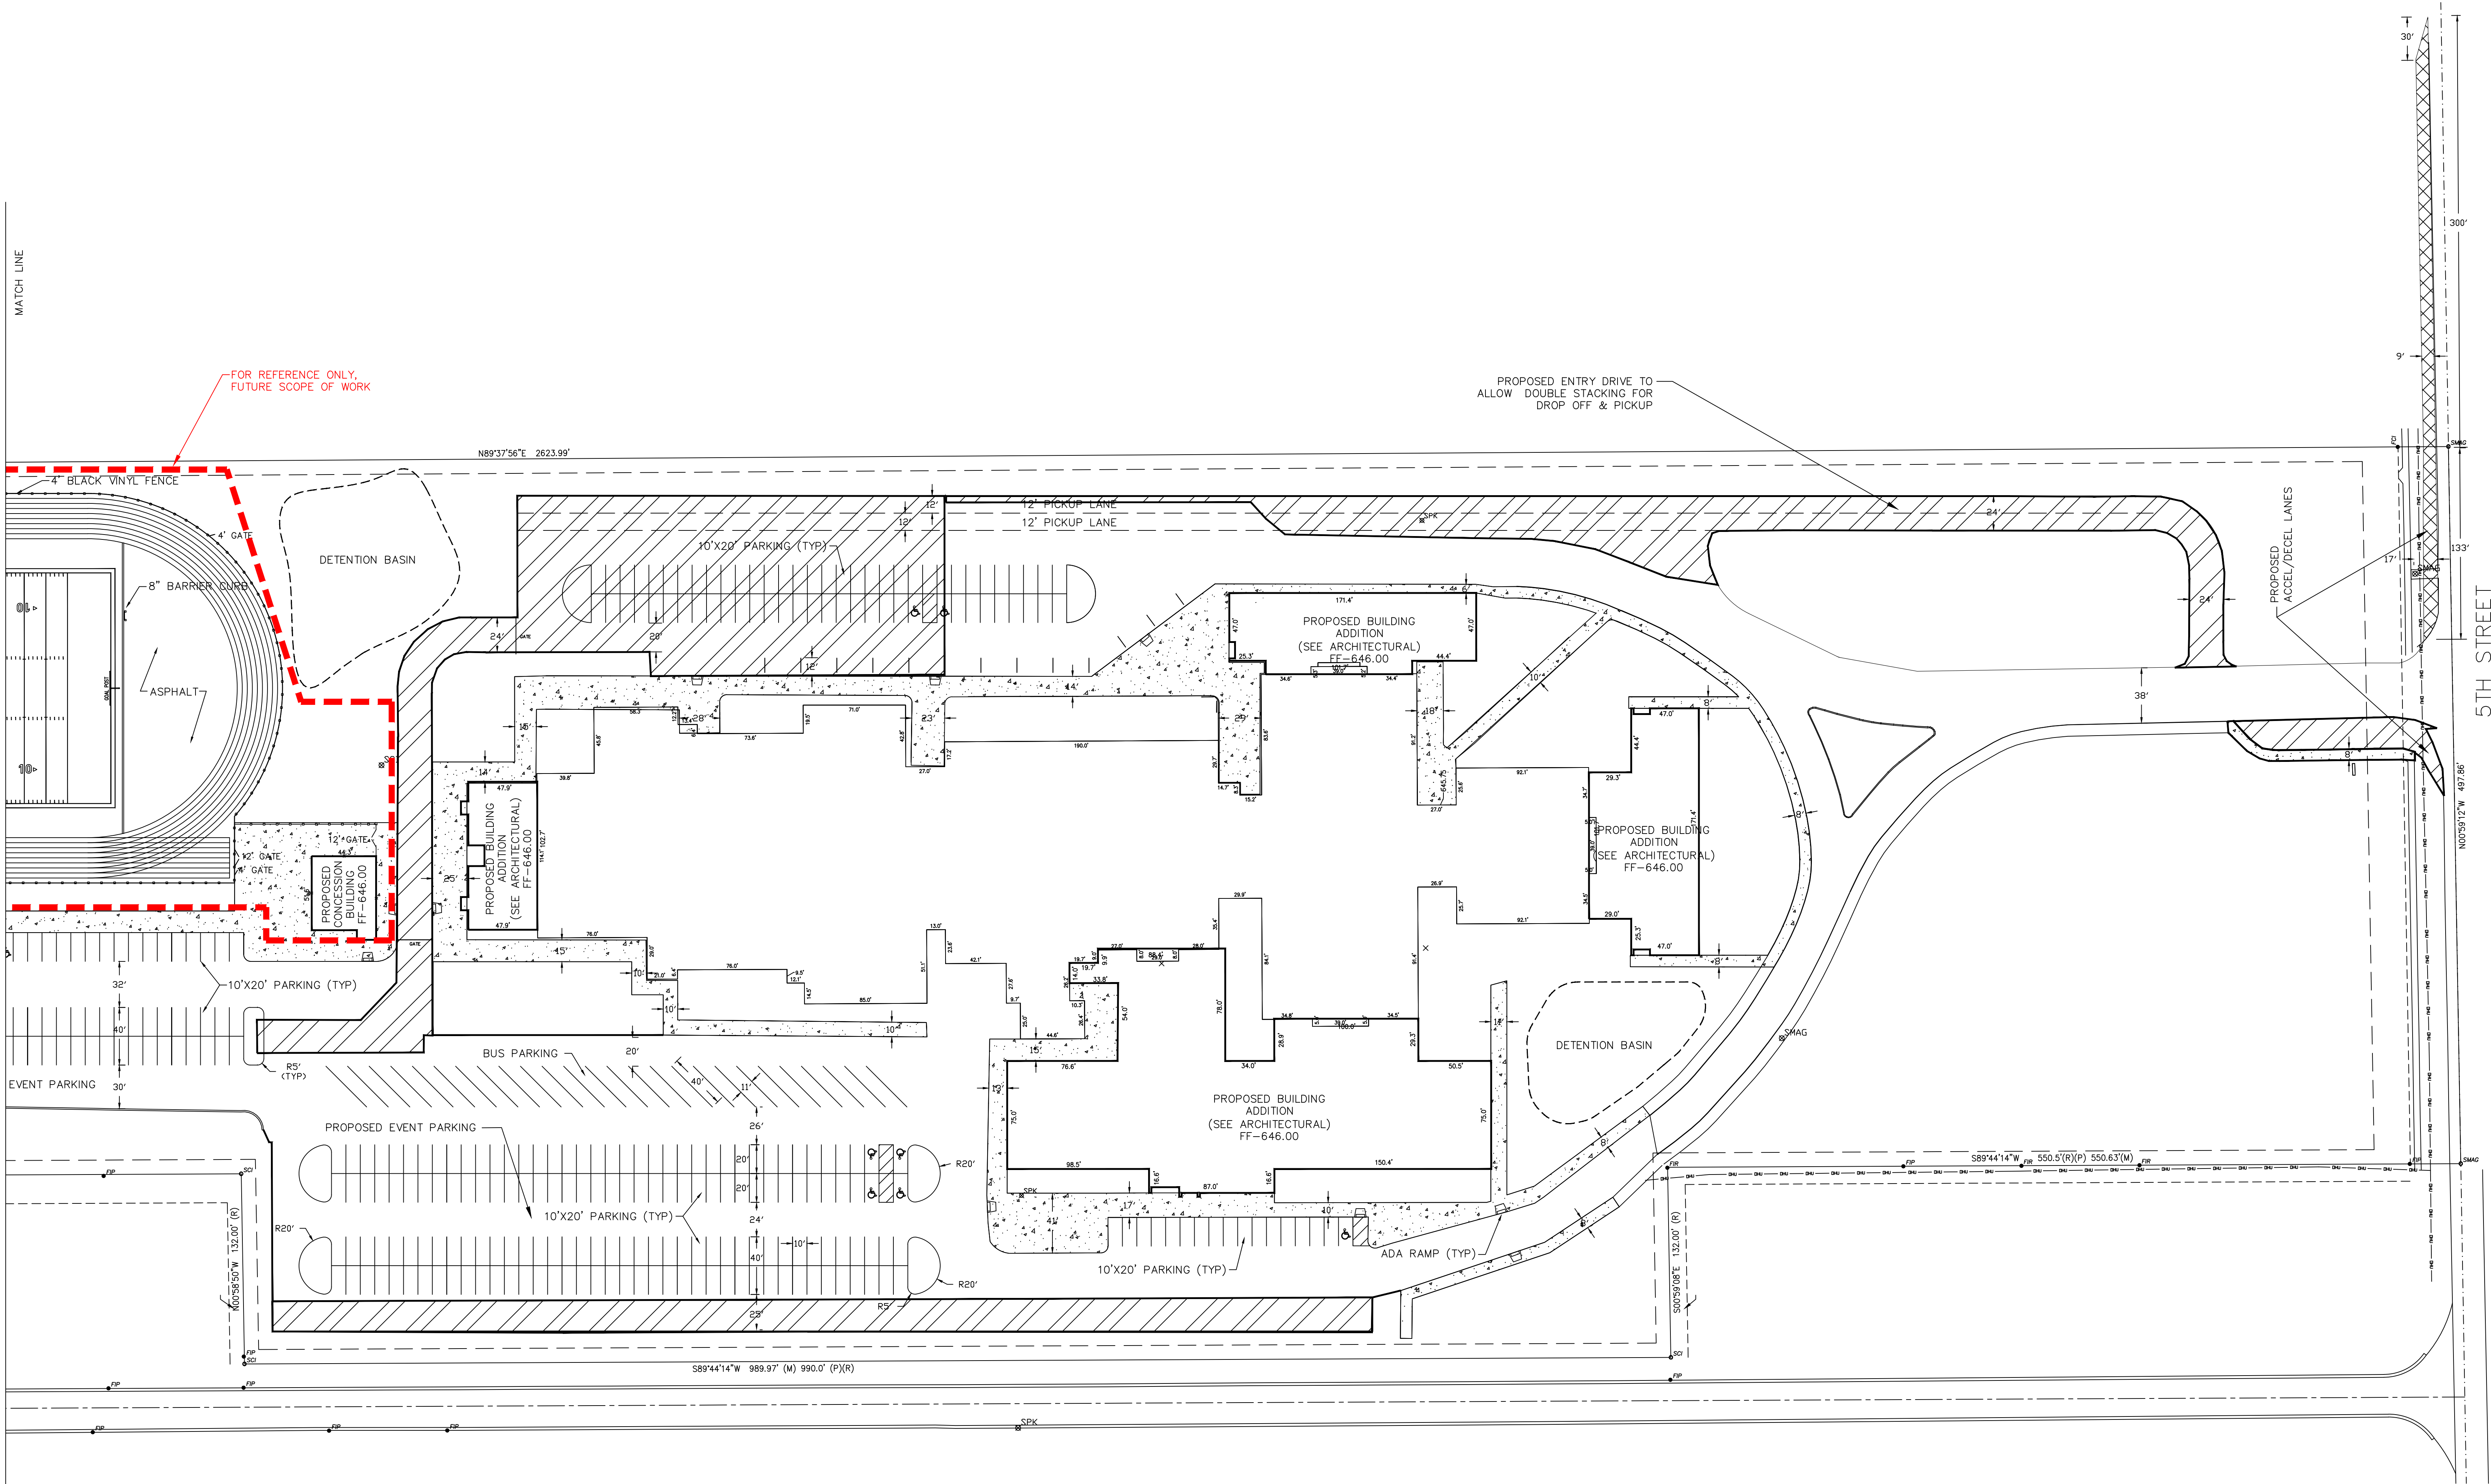


- LEGEND:
- CONCRETE
  - STANDARD PAVEMENT
  - HEAVY DUTY PAVEMENT
  - HANDICAP SPACE
  - SIDEWALK RAMP

PARKING PROVIDED:  
REGULAR SPACES - 311  
ADA SPACES - 9




NOTE: ALL EXISTING PAVEMENT AREAS TO BE MILLED AND RESURFACED.

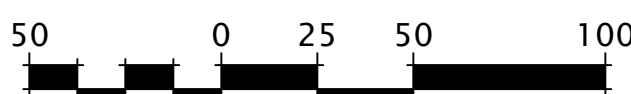

**ADDENDUM #1**





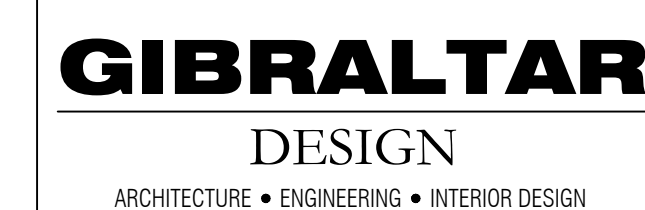

PROJECT

**WESTCHESTER  
INTERMEDIATE  
SCHOOL -  
ADDITIONS &  
RENOVATIONS**

DUNELAND SCHOOL CORPORATION  
CHESTERSTON, INDIANA

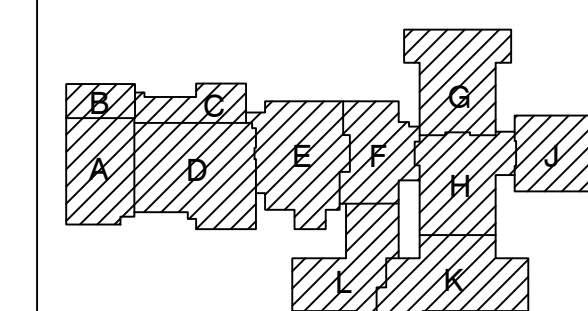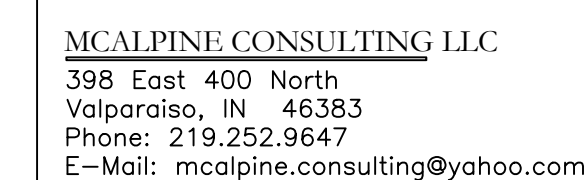

**GIBRALTAR DESIGN**  
9102 N. Meridian St., Ste. 300  
Indianapolis, IN 46260  
Homepage [www.GibraltarDesign.com](http://www.GibraltarDesign.com)  
Email [info@GibraltarDesign.com](mailto:info@GibraltarDesign.com)  
Phone 317.580.5777 Fax 317.580.5778

|         |          |
|---------|----------|
| PROJECT | 21-141   |
| DATE    | 03/16/22 |

COORDINATED BY  
AWM

DRAWN BY  
BPL

CHECKED BY  
AWM

**COPYRIGHT NOTICE:**  
THE CONCEPTS, DESIGNS, PLANS, DETAILS, ETC., SHOWN ON  
THIS DOCUMENT ARE THE PROPERTY OF GIBRALTAR DESIGN AND  
WERE CREATED FOR USE ON THIS SPECIFIC PROJECT. NONE OF  
THIS INFORMATION SHALL BE USED BY ANY PERSON OR FIRM  
FOR ANY PURPOSE WITHOUT THE EXPRESS WRITTEN CONSENT  
OF GIBRALTAR DESIGN. THE OWNER MAY RETAIN COPIES FOR  
INFORMATION AND REFERENCE IN CONNECTION ONLY WITH THIS  
PROJECT.


| REVISIONS |          |                |
|-----------|----------|----------------|
| MARK      | DATE     | ISSUED FOR     |
| AD-1      | 03/16/22 | ADDENDUM NO. 1 |

[illegible]

DRAWING  
GEOMETRIC LAYOUT PLAN 2

PROJECT  
WESTCHESTER IS -  
ADDITIONS & RENOVATIONS


|                    |                       |
|--------------------|-----------------------|
| © GIBRALTAR DESIGN | SHEET<br><b>C-2.1</b> |
|--------------------|-----------------------|

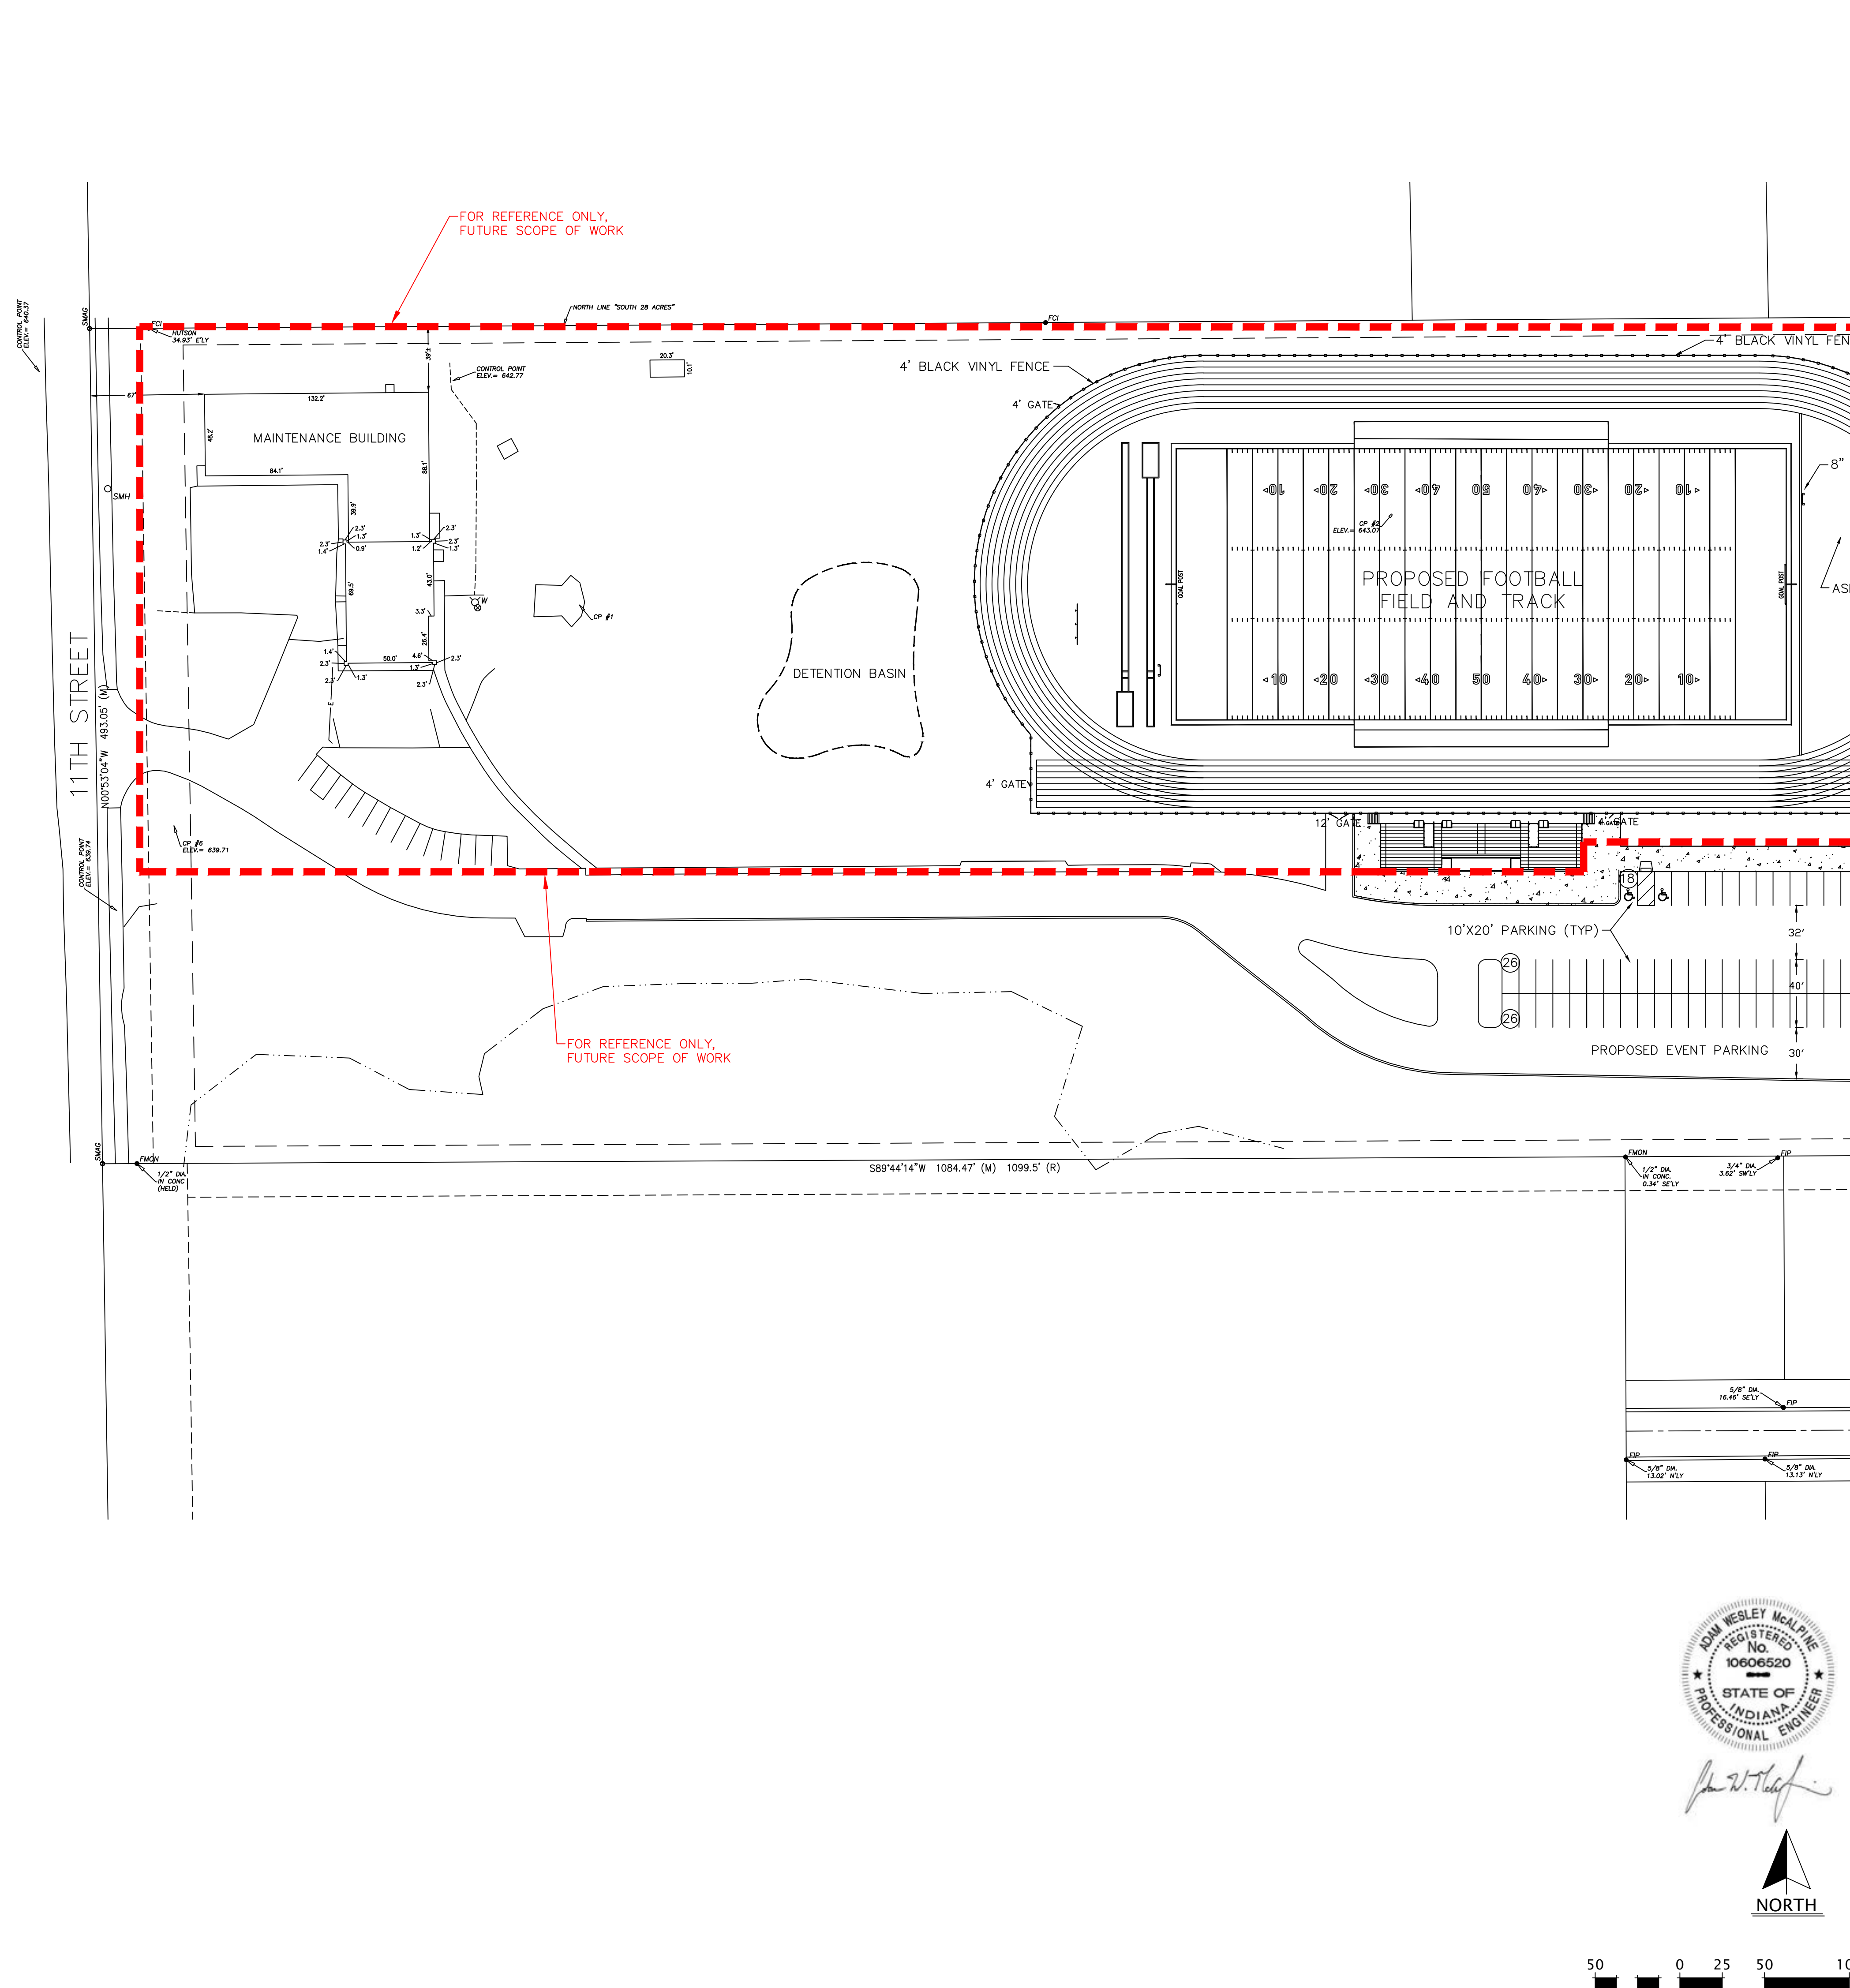

## ADDENDUM #1

C-2.1





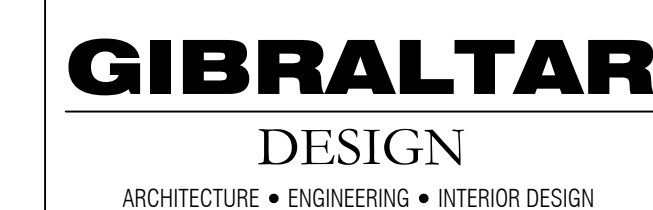

PROJECT

**WESTCHESTER  
INTERMEDIATE  
SCHOOL -  
ADDITIONS &  
RENOVATIONS**

DUNELAND SCHOOL CORPORATION  
CHESTERTON, INDIANA

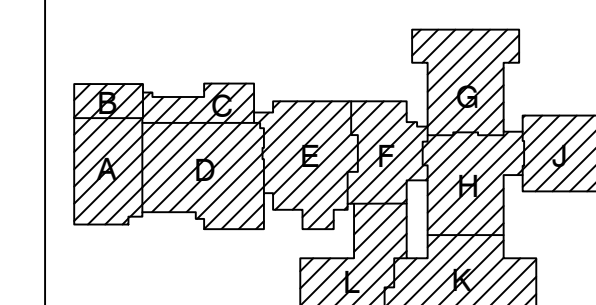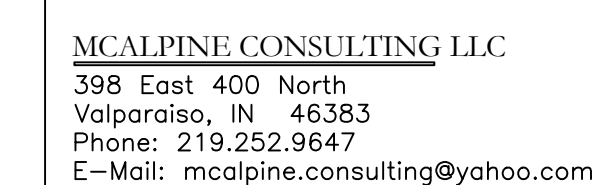

**GIBRALTAR DESIGN**  
9102 N. Meridian St., Ste. 300  
Indianapolis, IN 46260  
Homepage [www.GibraltarDesign.com](http://www.GibraltarDesign.com)  
Email [info@GibraltarDesign.com](mailto:info@GibraltarDesign.com)  
Phone 317.580.5777 Fax 317.580.5778

|  |  |
|--|--|
| PROJECT<br>21-141<br>DATE<br>03/16/22<br>COORDINATED BY<br>AWM<br>DRAWN BY<br>BPL<br>CHECKED BY<br>AWM |  |
|--|--|


**COPYRIGHT NOTICE:**  
THE CONCEPTS, DESIGNS, PLANS, DETAILS, ETC., SHOWN ON THIS DOCUMENT ARE THE PROPERTY OF GILBRALD DESIGN AND WERE CREATED FOR USE ON THIS SPECIFIC PROJECT. NONE OF THIS INFORMATION SHALL BE USED BY ANY PERSON OR FIRM FOR ANY PURPOSE WITHOUT THE EXPRESS WRITTEN CONSENT OF GILBRALD DESIGN. THE OWNER MAY RETAIN COPIES FOR INFORMATION AND REFERENCE IN CONNECTION ONLY WITH THIS PROJECT.

[illegible]

DRAWING  
STORM SEWER AND  
GRADING PLAN 1

PROJECT  
WESTCHESTER IS -  
ADDITIONS & RENOVATIONS


|                    |                       |
|--------------------|-----------------------|
| © GIBRALTAR DESIGN | SHEET<br><b>C-3.0</b> |
|--------------------|-----------------------|

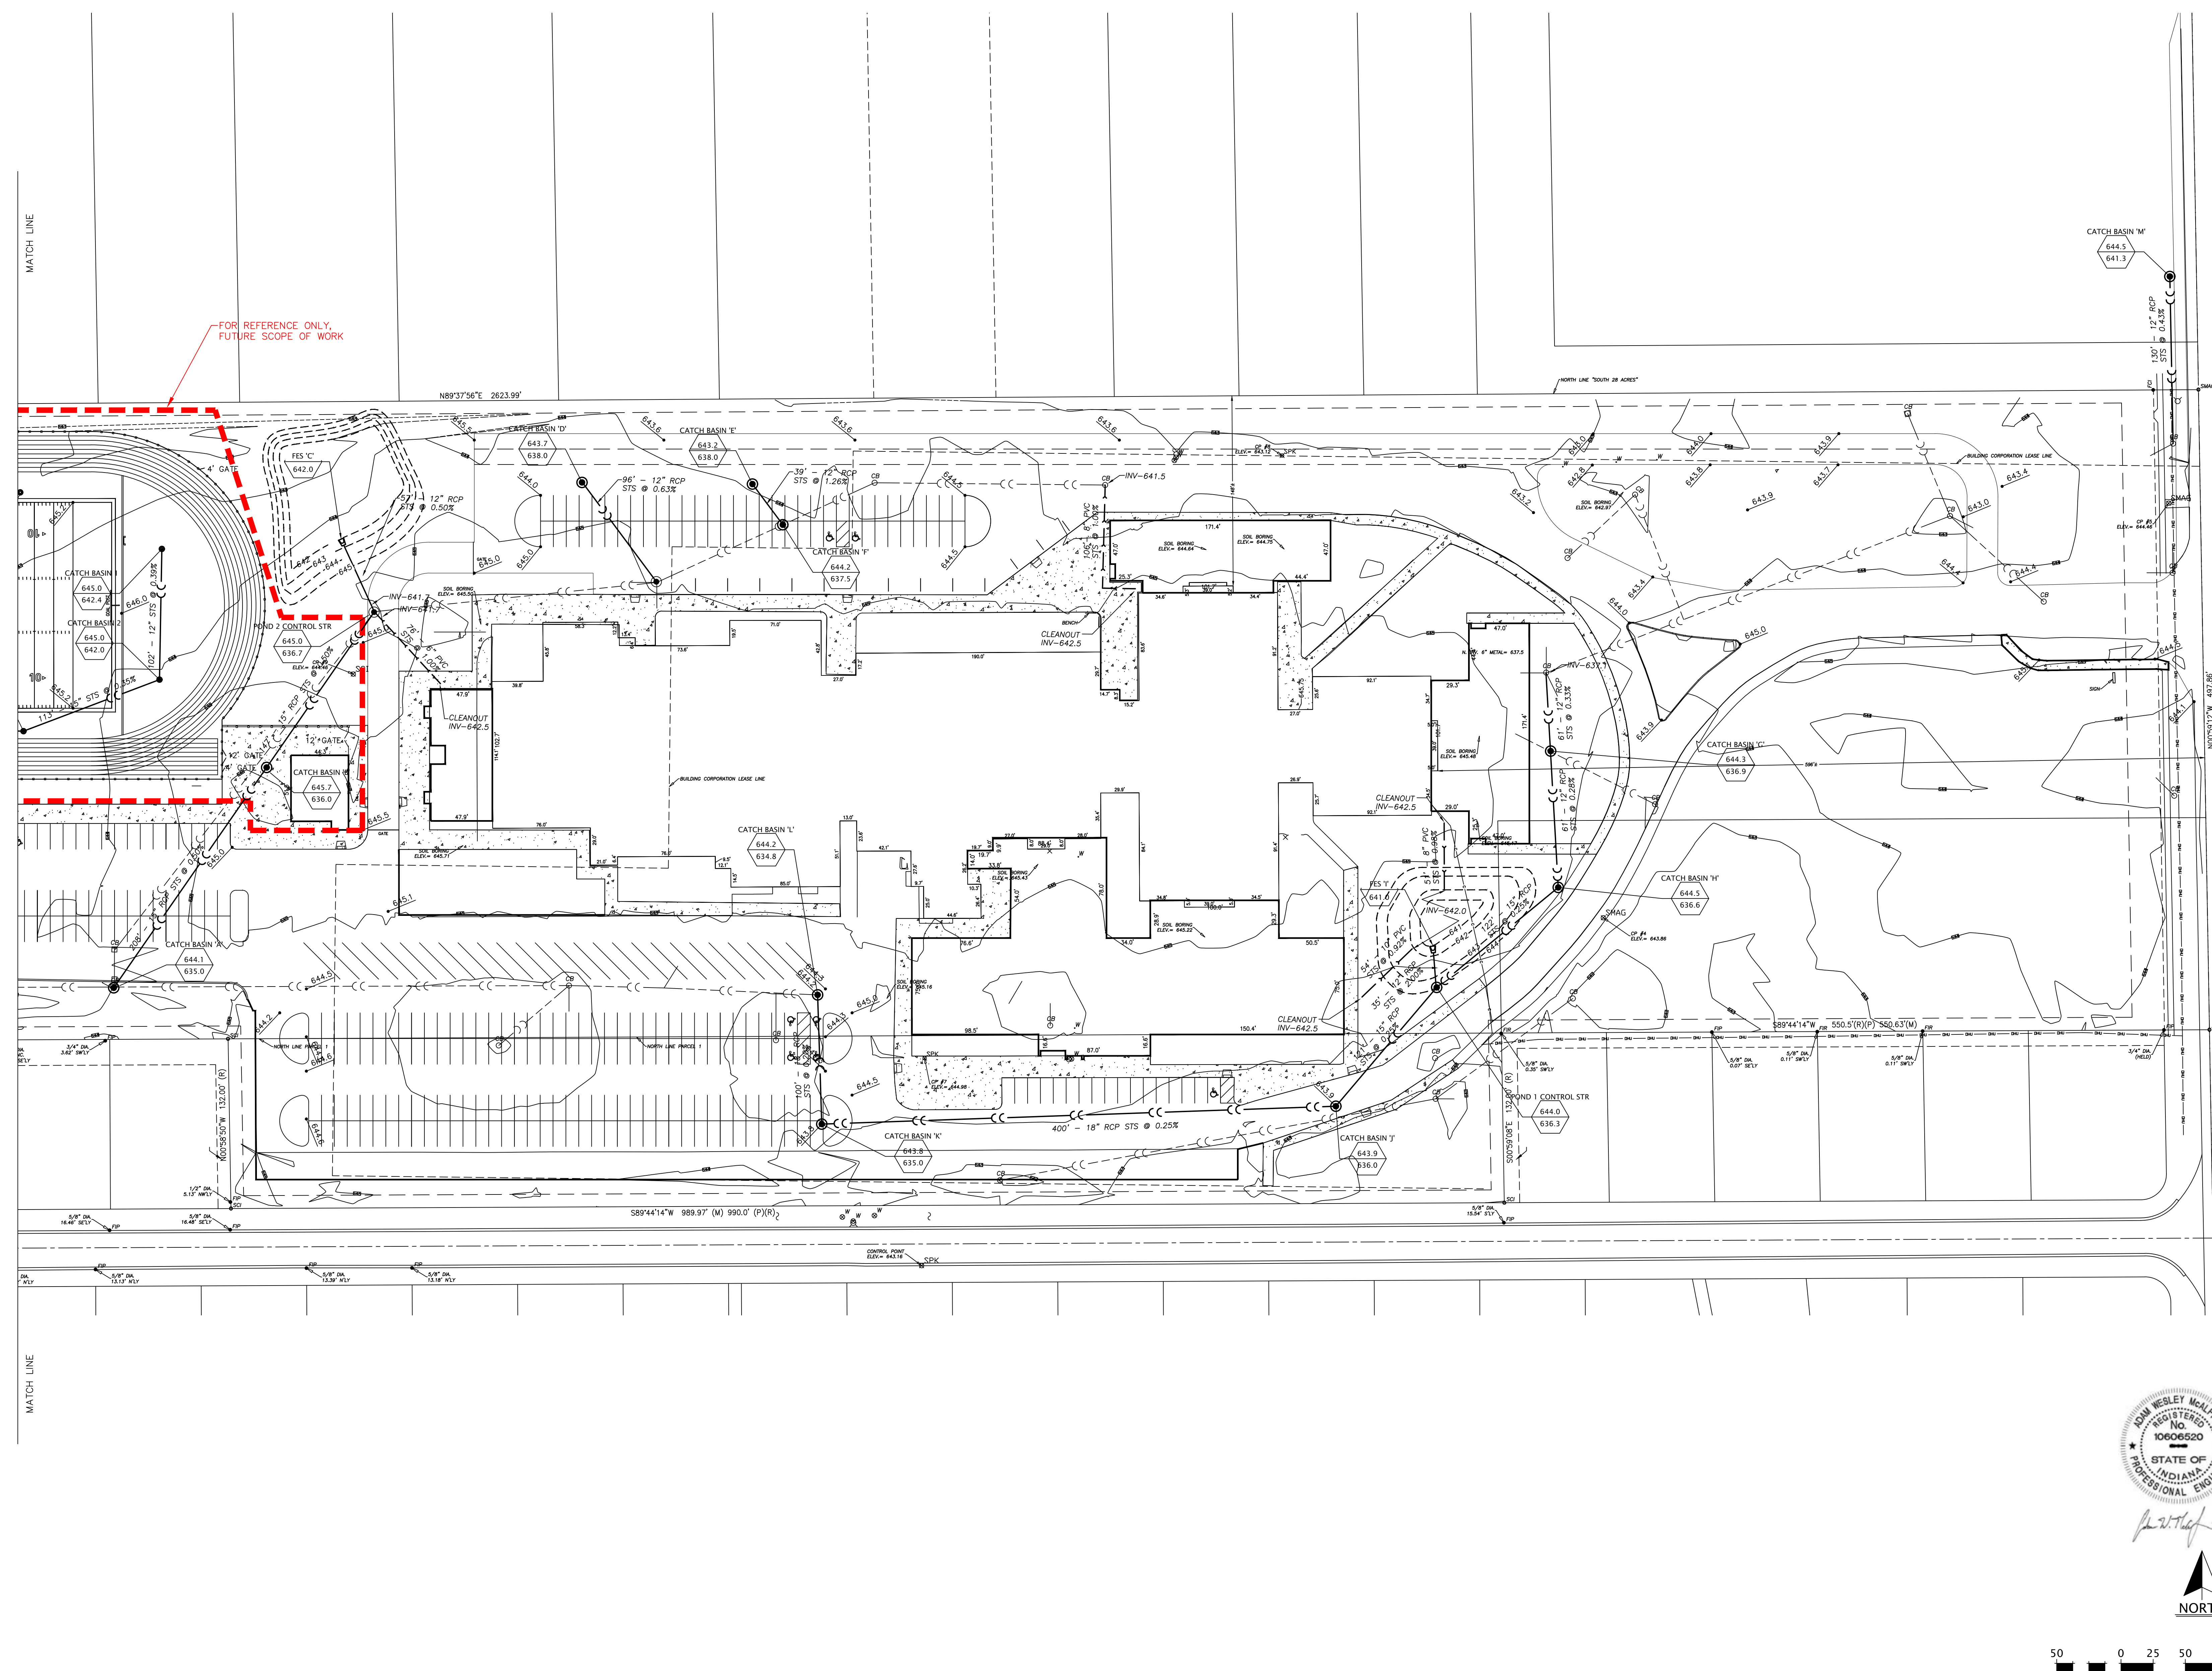

## ADDENDUM #1

C-3.0





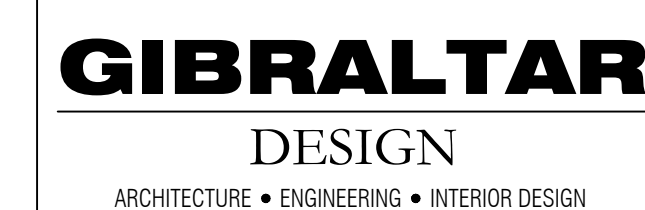

PROJECT

**WESTCHESTER  
INTERMEDIATE  
SCHOOL -  
ADDITIONS &  
RENOVATIONS**

DUNELAND SCHOOL CORPORATION  
CHESTERSTON, INDIANA

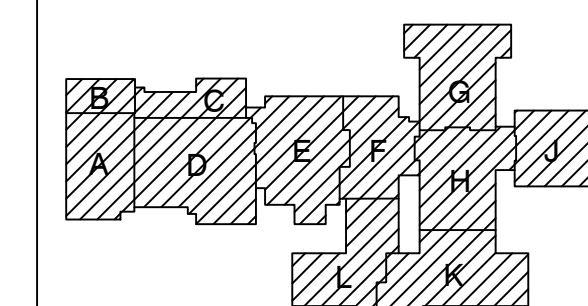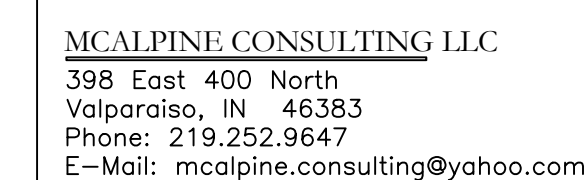

**GIBRALTAR DESIGN**  
9102 N. Meridian St., Ste. 300  
Indianapolis, IN 46260  
Homepage [www.GibraltarDesign.com](http://www.GibraltarDesign.com)  
Email [info@GibraltarDesign.com](mailto:info@GibraltarDesign.com)  
Phone 317.580.5777 Fax 317.580.5778

|  |  |
|--|--|
| PROJECT<br>21-141<br>DATE<br>03/16/22<br>COORDINATED BY<br>AWM<br>DRAWN BY<br>BPL<br>CHECKED BY<br>AWM |  |
|--|--|


**COPYRIGHT NOTICE:**  
THE CONCEPTS, DESIGNS, PLANS, DETAILS, ETC., SHOWN ON  
THIS DOCUMENT ARE THE PROPERTY OF GIBRALTAR DESIGN AND  
WERE CREATED FOR USE ON THIS SPECIFIC PROJECT. NONE OF  
THIS INFORMATION SHALL BE USED BY ANY PERSON OR FIRM  
FOR ANY PURPOSE WITHOUT THE EXPRESS WRITTEN CONSENT  
OF GIBRALTAR DESIGN. THE OWNER MAY RETAIN COPIES FOR  
INFORMATION AND REFERENCE IN CONNECTION ONLY WITH THIS  
PROJECT.

[illegible]

DRAWING  
STORM SEWER AND  
GRADING PLAN 2

PROJECT  
WESTCHESTER IS -  
ADDITIONS & RENOVATIONS

|                    |                       |
|--------------------|-----------------------|
| © GIBRALTAR DESIGN | SHEET<br><b>C-3.1</b> |
|--------------------|-----------------------|

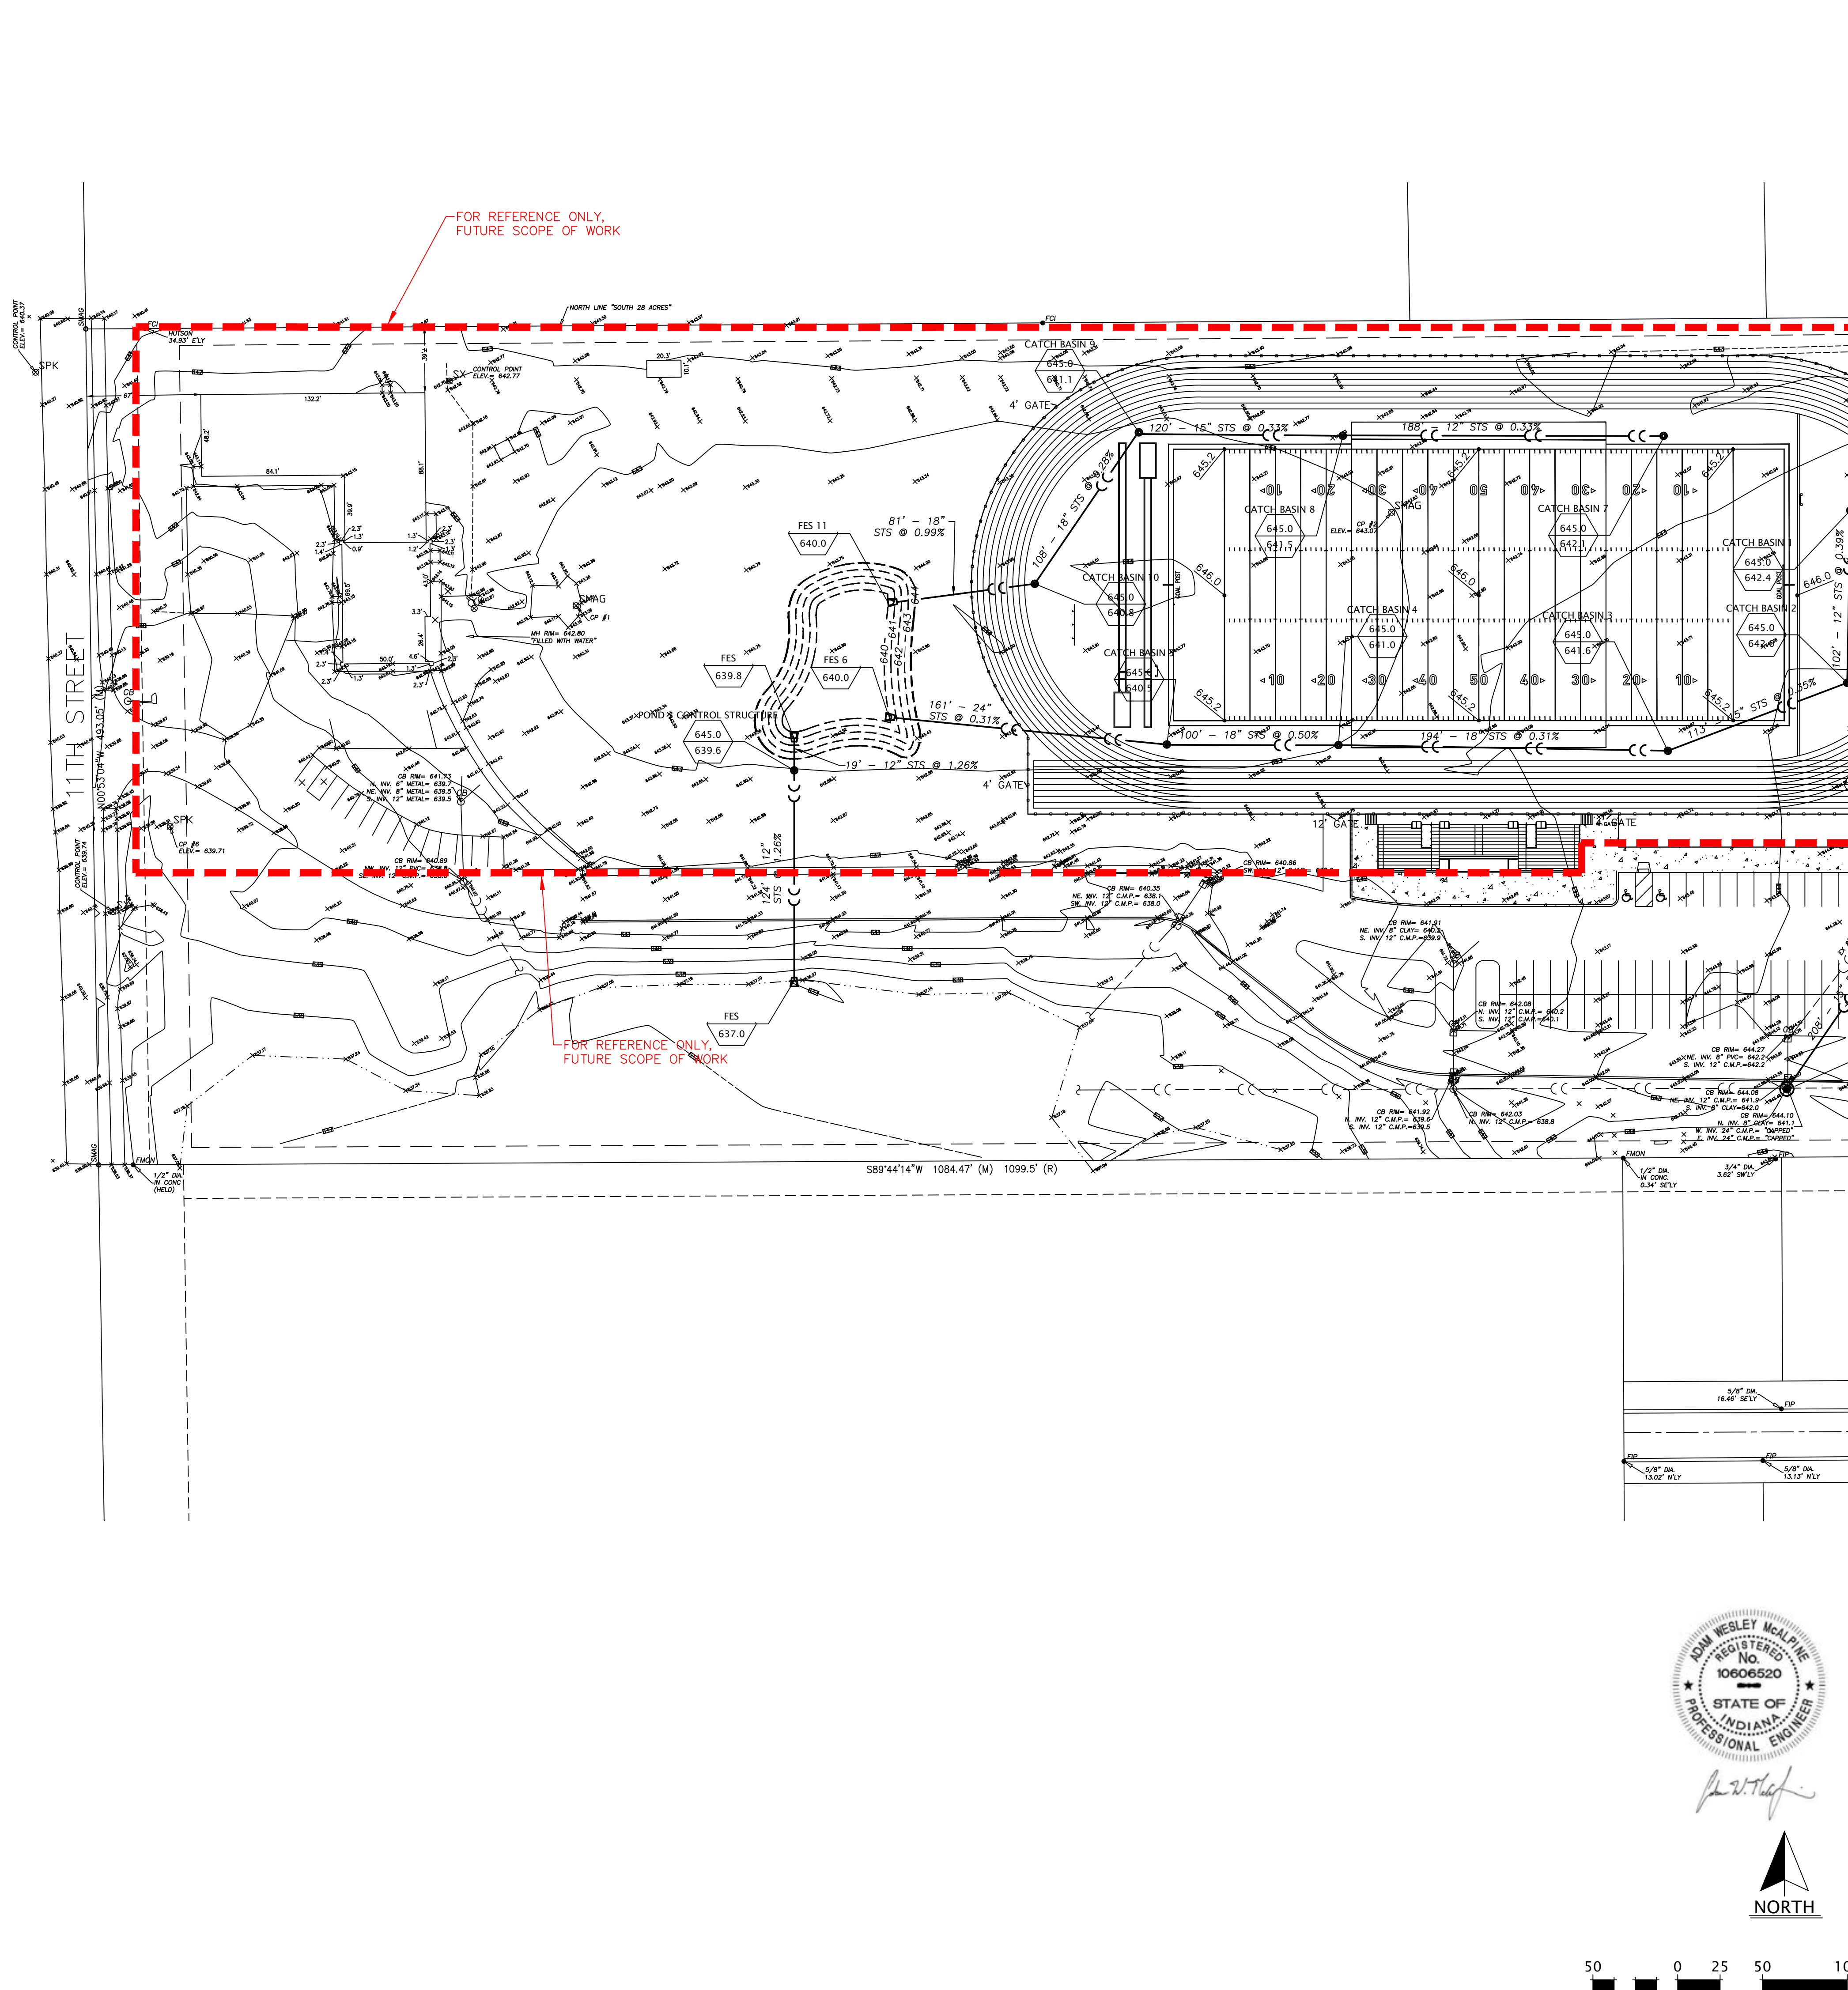


## ADDENDUM #1

SHEET

**C-3.1**





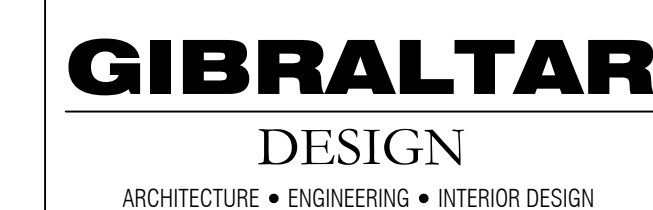

PROJECT

**WESTCHESTER  
INTERMEDIATE  
SCHOOL -  
ADDITIONS &  
RENOVATIONS**

DUNELAND SCHOOL CORPORATION  
CHESTERTON, INDIANA

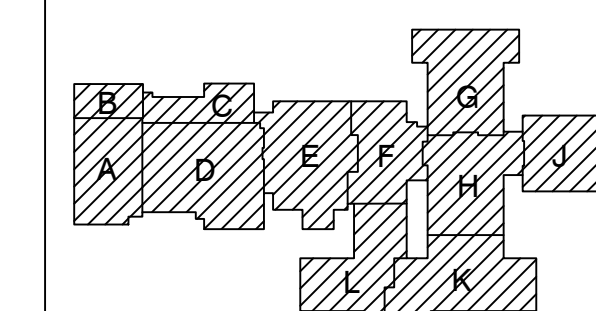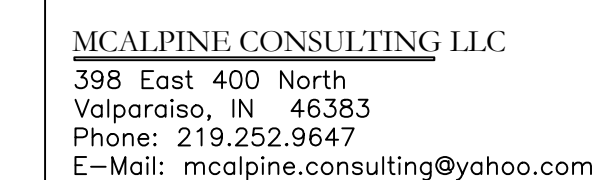

**GIBRALTAR DESIGN**  
9102 N. Meridian St., Ste. 300  
Indianapolis, IN 46260  
Homepage [www.GibraltarDesign.com](http://www.GibraltarDesign.com)  
Email [info@GibraltarDesign.com](mailto:info@GibraltarDesign.com)  
Phone 317.580.5777 Fax 317.580.5778


|                       |  |
|-----------------------|--|
| PROJECT<br>21-141     |  |
| DATE<br>03/16/22      |  |
| COORDINATED BY<br>AWM |  |
| DRAWN BY<br>BPL       |  |
| CHECKED BY<br>AWM     |  |


**COPYRIGHT NOTICE:**  
THE CONCEPTS, DESIGNS, PLANS, DETAILS, ETC., SHOWN ON THIS DOCUMENT ARE THE PROPERTY OF GIBRALTAR DESIGN AND WERE CREATED FOR USE ON THIS SPECIFIC PROJECT. NONE OF THIS INFORMATION SHALL BE USED BY ANY PERSON OR FIRM FOR ANY PURPOSE WITHOUT THE EXPRESS WRITTEN CONSENT OF GIBRALTAR DESIGN. THE OWNER MAY RETAIN COPIES FOR INFORMATION AND REFERENCE IN CONNECTION ONLY WITH THIS PROJECT.

[illegible]

DRAWING  
SANITARY SEWER AND  
WATER MAIN PLAN 1

PROJECT  
WESTCHESTER IS -  
ADDITIONS & RENOVATIONS


|  |       |
|--|-------|
|  GIBRALTAR DESIGN | SHEET |
|  | C-3.2 |

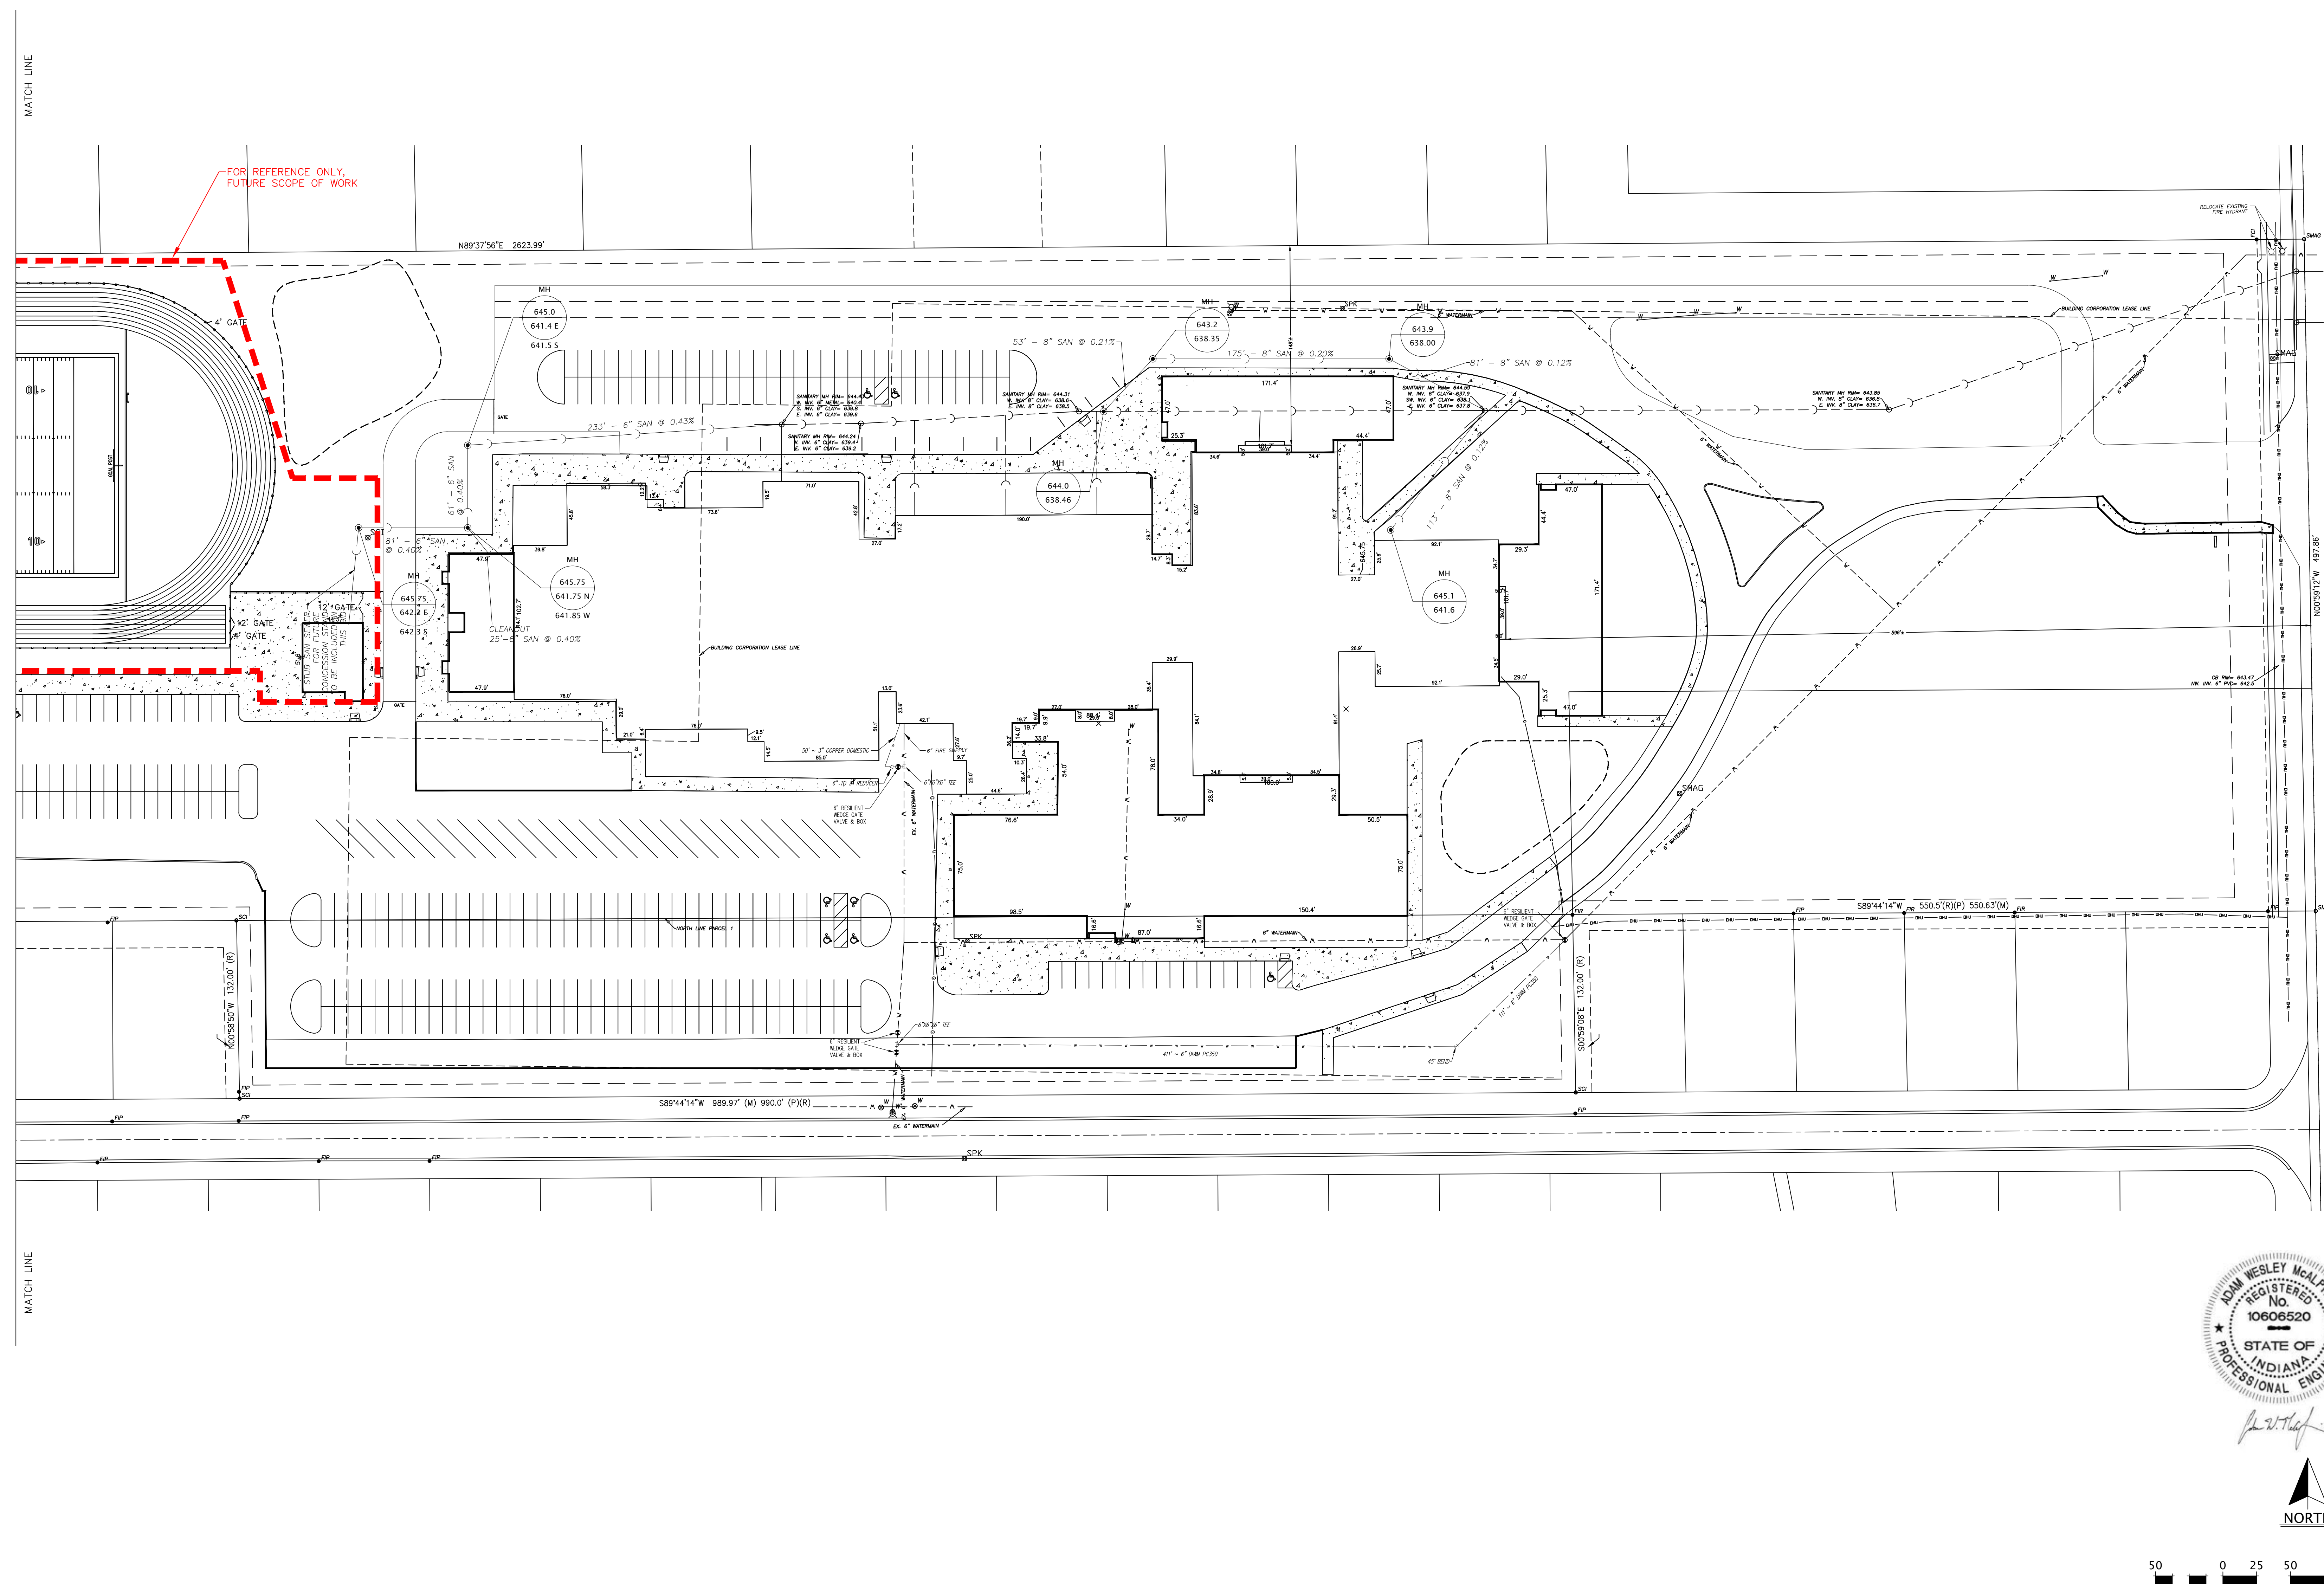

## ADDENDUM #1

C-3.2





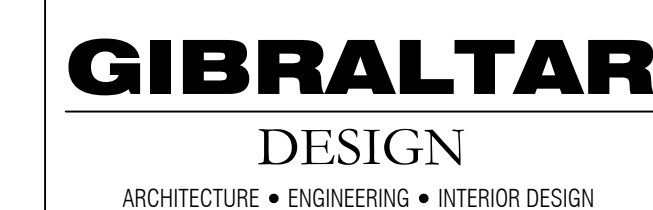

PROJECT

**WESTCHESTER  
INTERMEDIATE  
SCHOOL -  
ADDITIONS &  
RENOVATIONS**

DUNELAND SCHOOL CORPORATION  
CHESTERTON, INDIANA

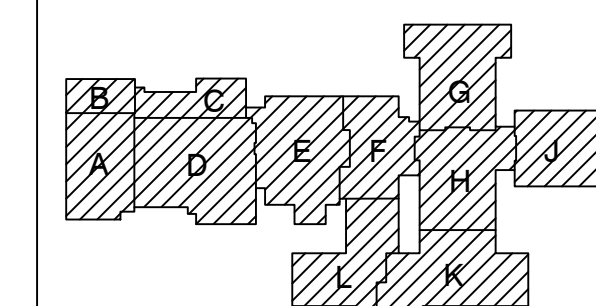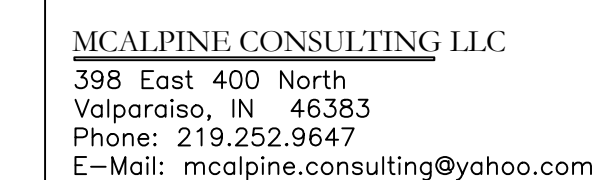

**GIBRALTAR DESIGN**  
9102 N. Meridian St., Ste. 300  
Indianapolis, IN 46260  
Homepage [www.GibraltarDesign.com](http://www.GibraltarDesign.com)  
Email [info@GibraltarDesign.com](mailto:info@GibraltarDesign.com)  
Phone 317.580.5777 Fax 317.580.5778

|                       |  |
|-----------------------|--|
| PROJECT<br>21-141     |  |
| DATE<br>03/16/22      |  |
| COORDINATED BY<br>AWM |  |
| DRAWN BY<br>BPL       |  |
| CHECKED BY<br>AWM     |  |


**COPYRIGHT NOTICE:**  
THE CONCEPTS, DESIGNS, PLANS, DETAILS, ETC., SHOWN ON THIS DOCUMENT ARE THE PROPERTY OF GIBRILAR DESIGN AND WERE CREATED FOR USE ON THIS SPECIFIC PROJECT. NONE OF THIS INFORMATION SHALL BE USED BY ANY PERSON OR FIRM FOR ANY PURPOSE WITHOUT THE EXPRESS WRITTEN CONSENT OF GIBRILAR DESIGN. THE OWNER MAY RETAIN COPIES FOR INFORMATION AND REFERENCE IN CONNECTION ONLY WITH THIS PROJECT.

[illegible]


DRAWING  
SANITARY SEWER AND  
WATER MAIN PLAN 2

PROJECT  
WESTCHESTER IS -  
ADDITIONS & RENOVATIONS

|                    |                       |
|--------------------|-----------------------|
| © GIBRALTAR DESIGN | SHEET<br><b>C-3.3</b> |
|--------------------|-----------------------|

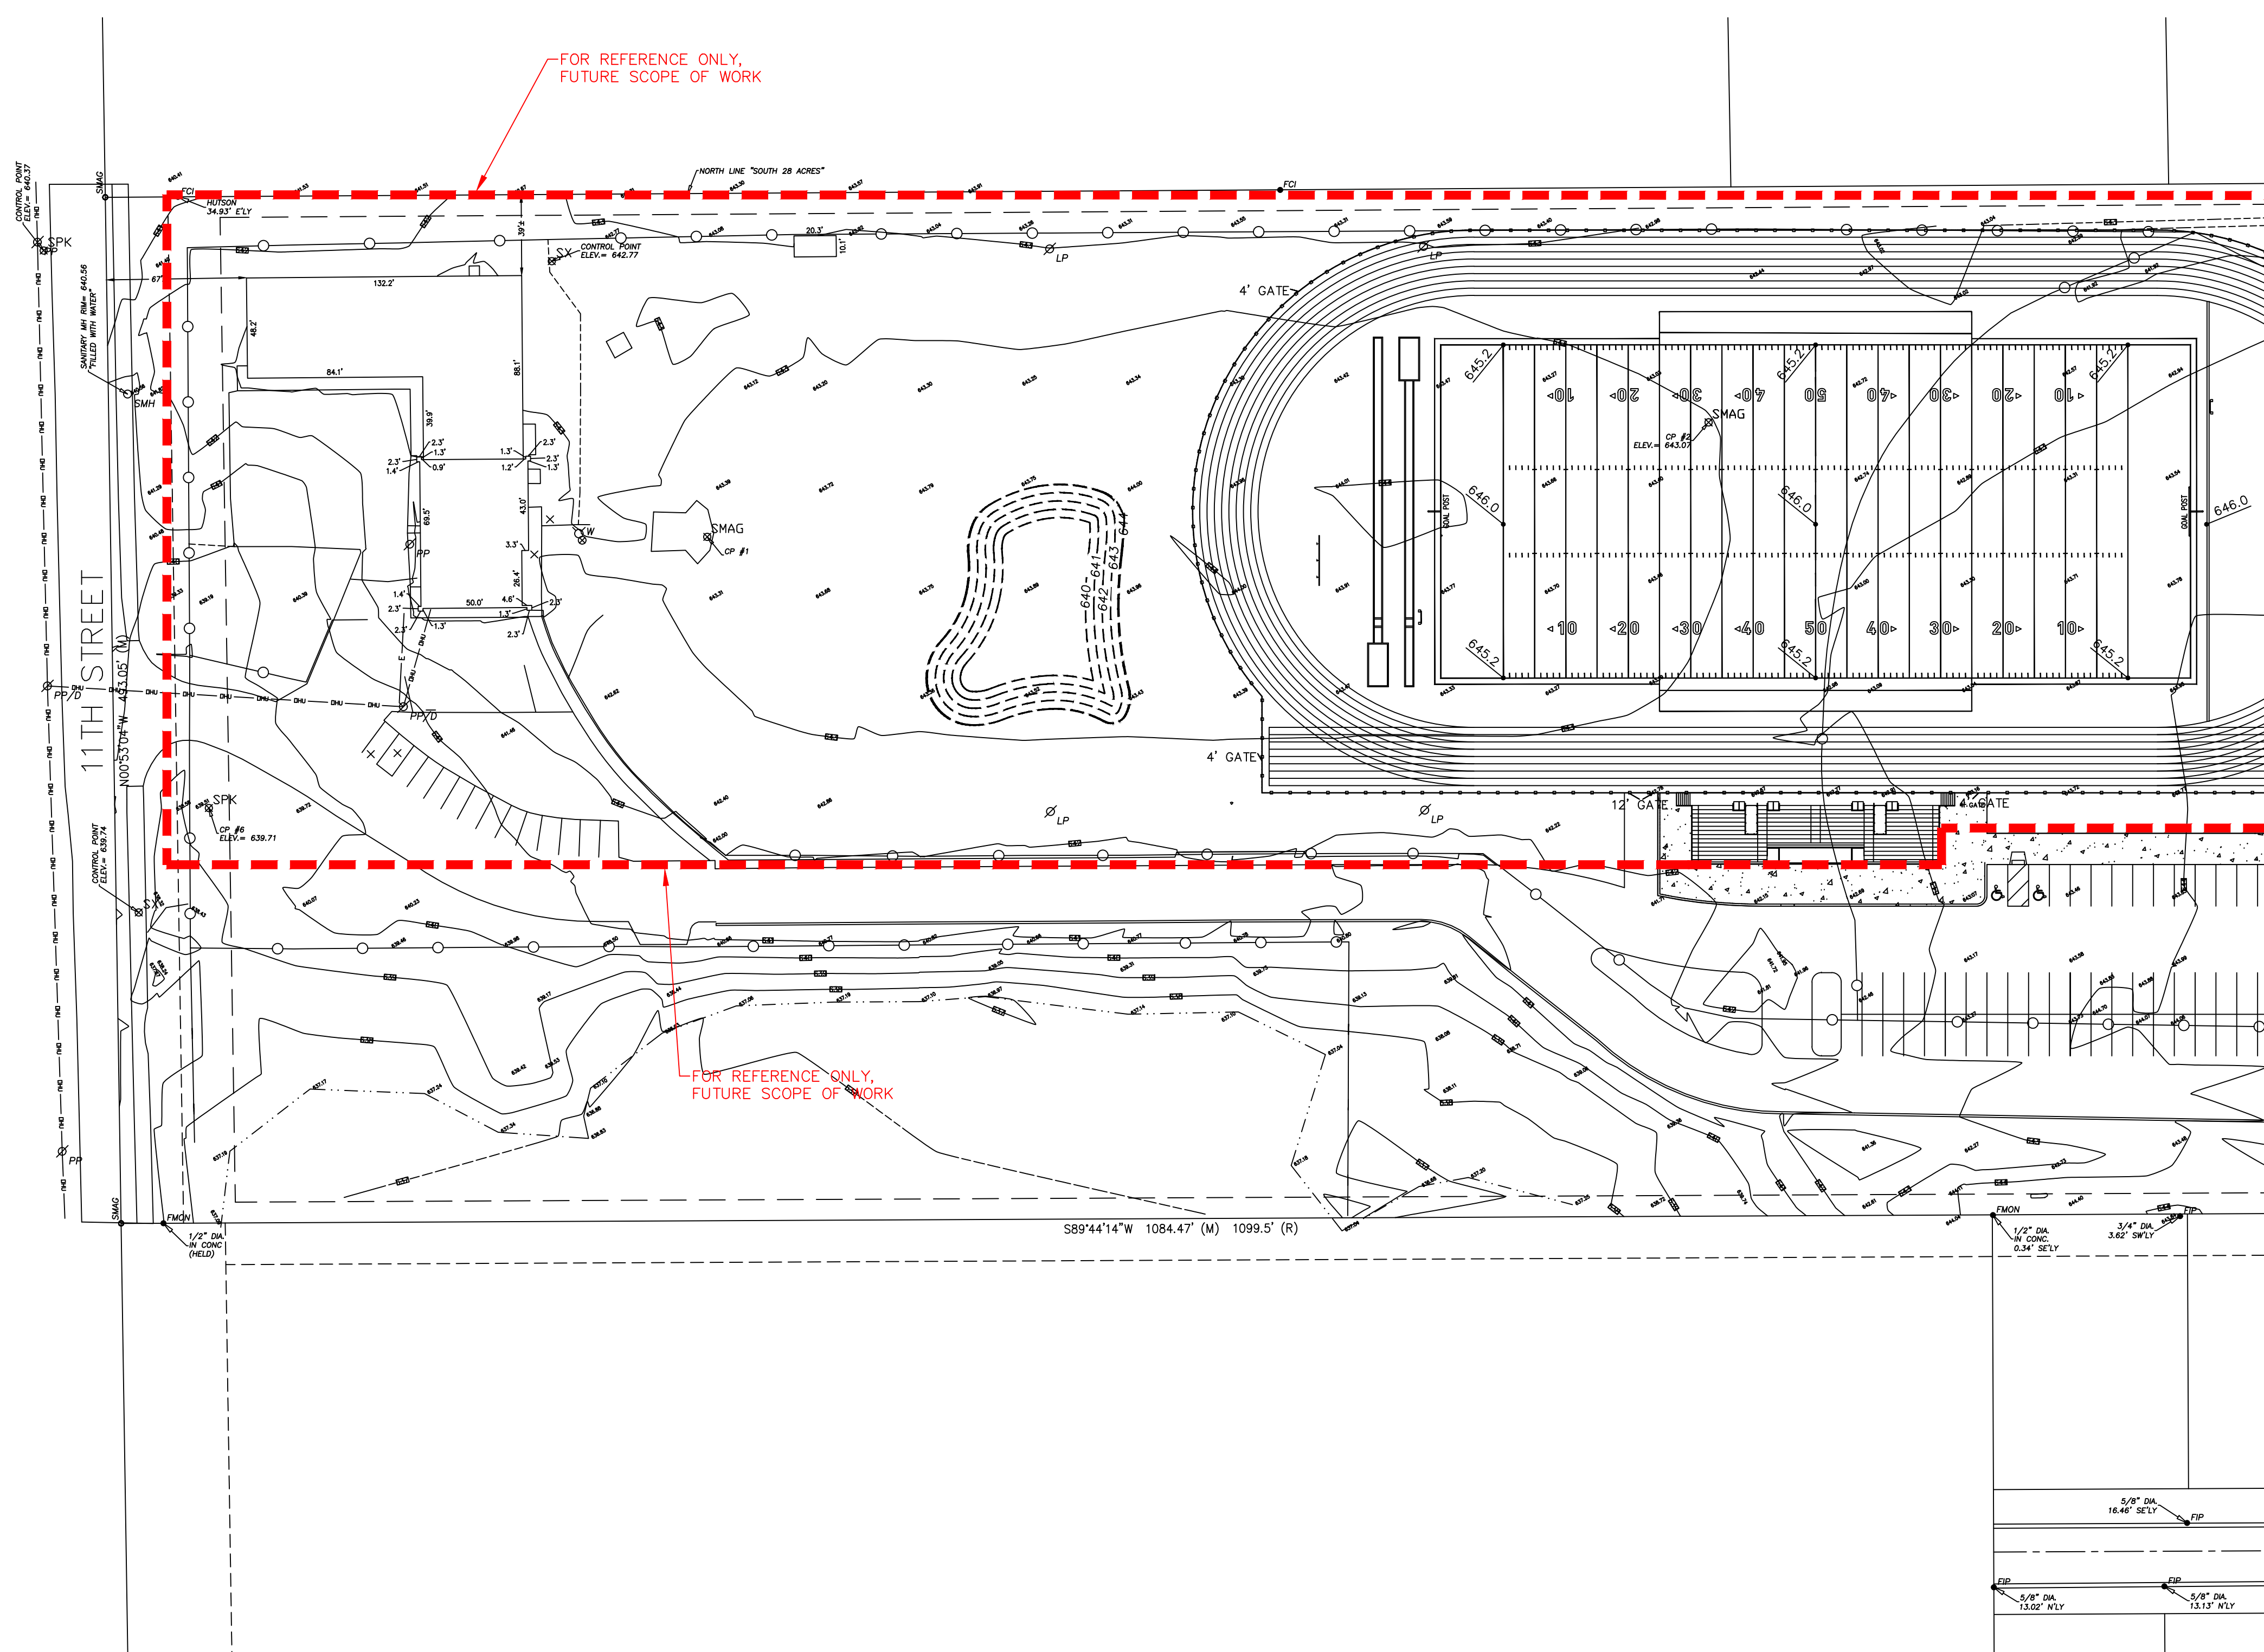


John W. Thayer.

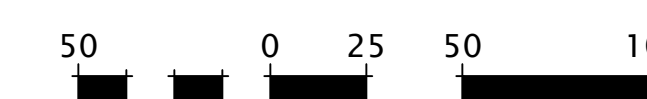

## ADDENDUM #1


C-3.3



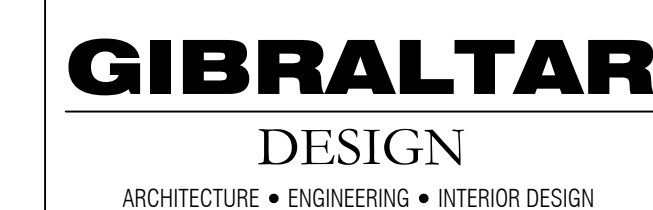

PROJECT  
WESTCHESTER  
INTERMEDIATE  
SCHOOL -  
ADDITIONS &  
RENOVATIONS

DUNELAND SCHOOL CORPORATION  
CHESTERTON, INDIANA

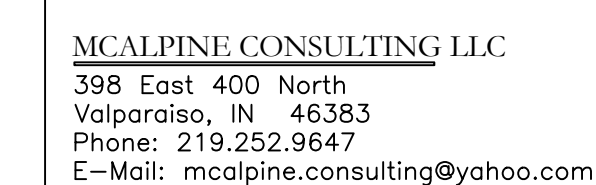

|  |  |
|--|--|
| PROJECT<br>21-141<br>DATE<br>03/16/22<br>COORDINATED BY<br>AWM<br>DRAWN BY<br>BPL<br>CHECKED BY<br>AWM |  |
|--|--|


**COPYRIGHT NOTICE:**  
THE CONCEPTS, DESIGNS, PLANS, DETAILS, ETC., SHOWN ON THIS DOCUMENT ARE THE PROPERTY OF GILBRALD DESIGN AND WERE CREATED FOR USE ON THIS SPECIFIC PROJECT. NONE OF THIS INFORMATION SHALL BE USED BY ANY PERSON OR FIRM FOR ANY PURPOSE WITHOUT THE EXPRESS WRITTEN CONSENT OF GILBRALD DESIGN. THE OWNER MAY RETAIN COPIES FOR INFORMATION AND REFERENCE IN CONNECTION ONLY WITH THIS PROJECT.

[illegible]

DRAWING  
EROSION CONTROL PLAN 1


PROJECT  
WESTCHESTER IS -  
ADDITIONS & RENOVATIONS

|                    |                       |
|--------------------|-----------------------|
| © GIBRALTAR DESIGN | SHEET<br><b>C-4.0</b> |
|--------------------|-----------------------|

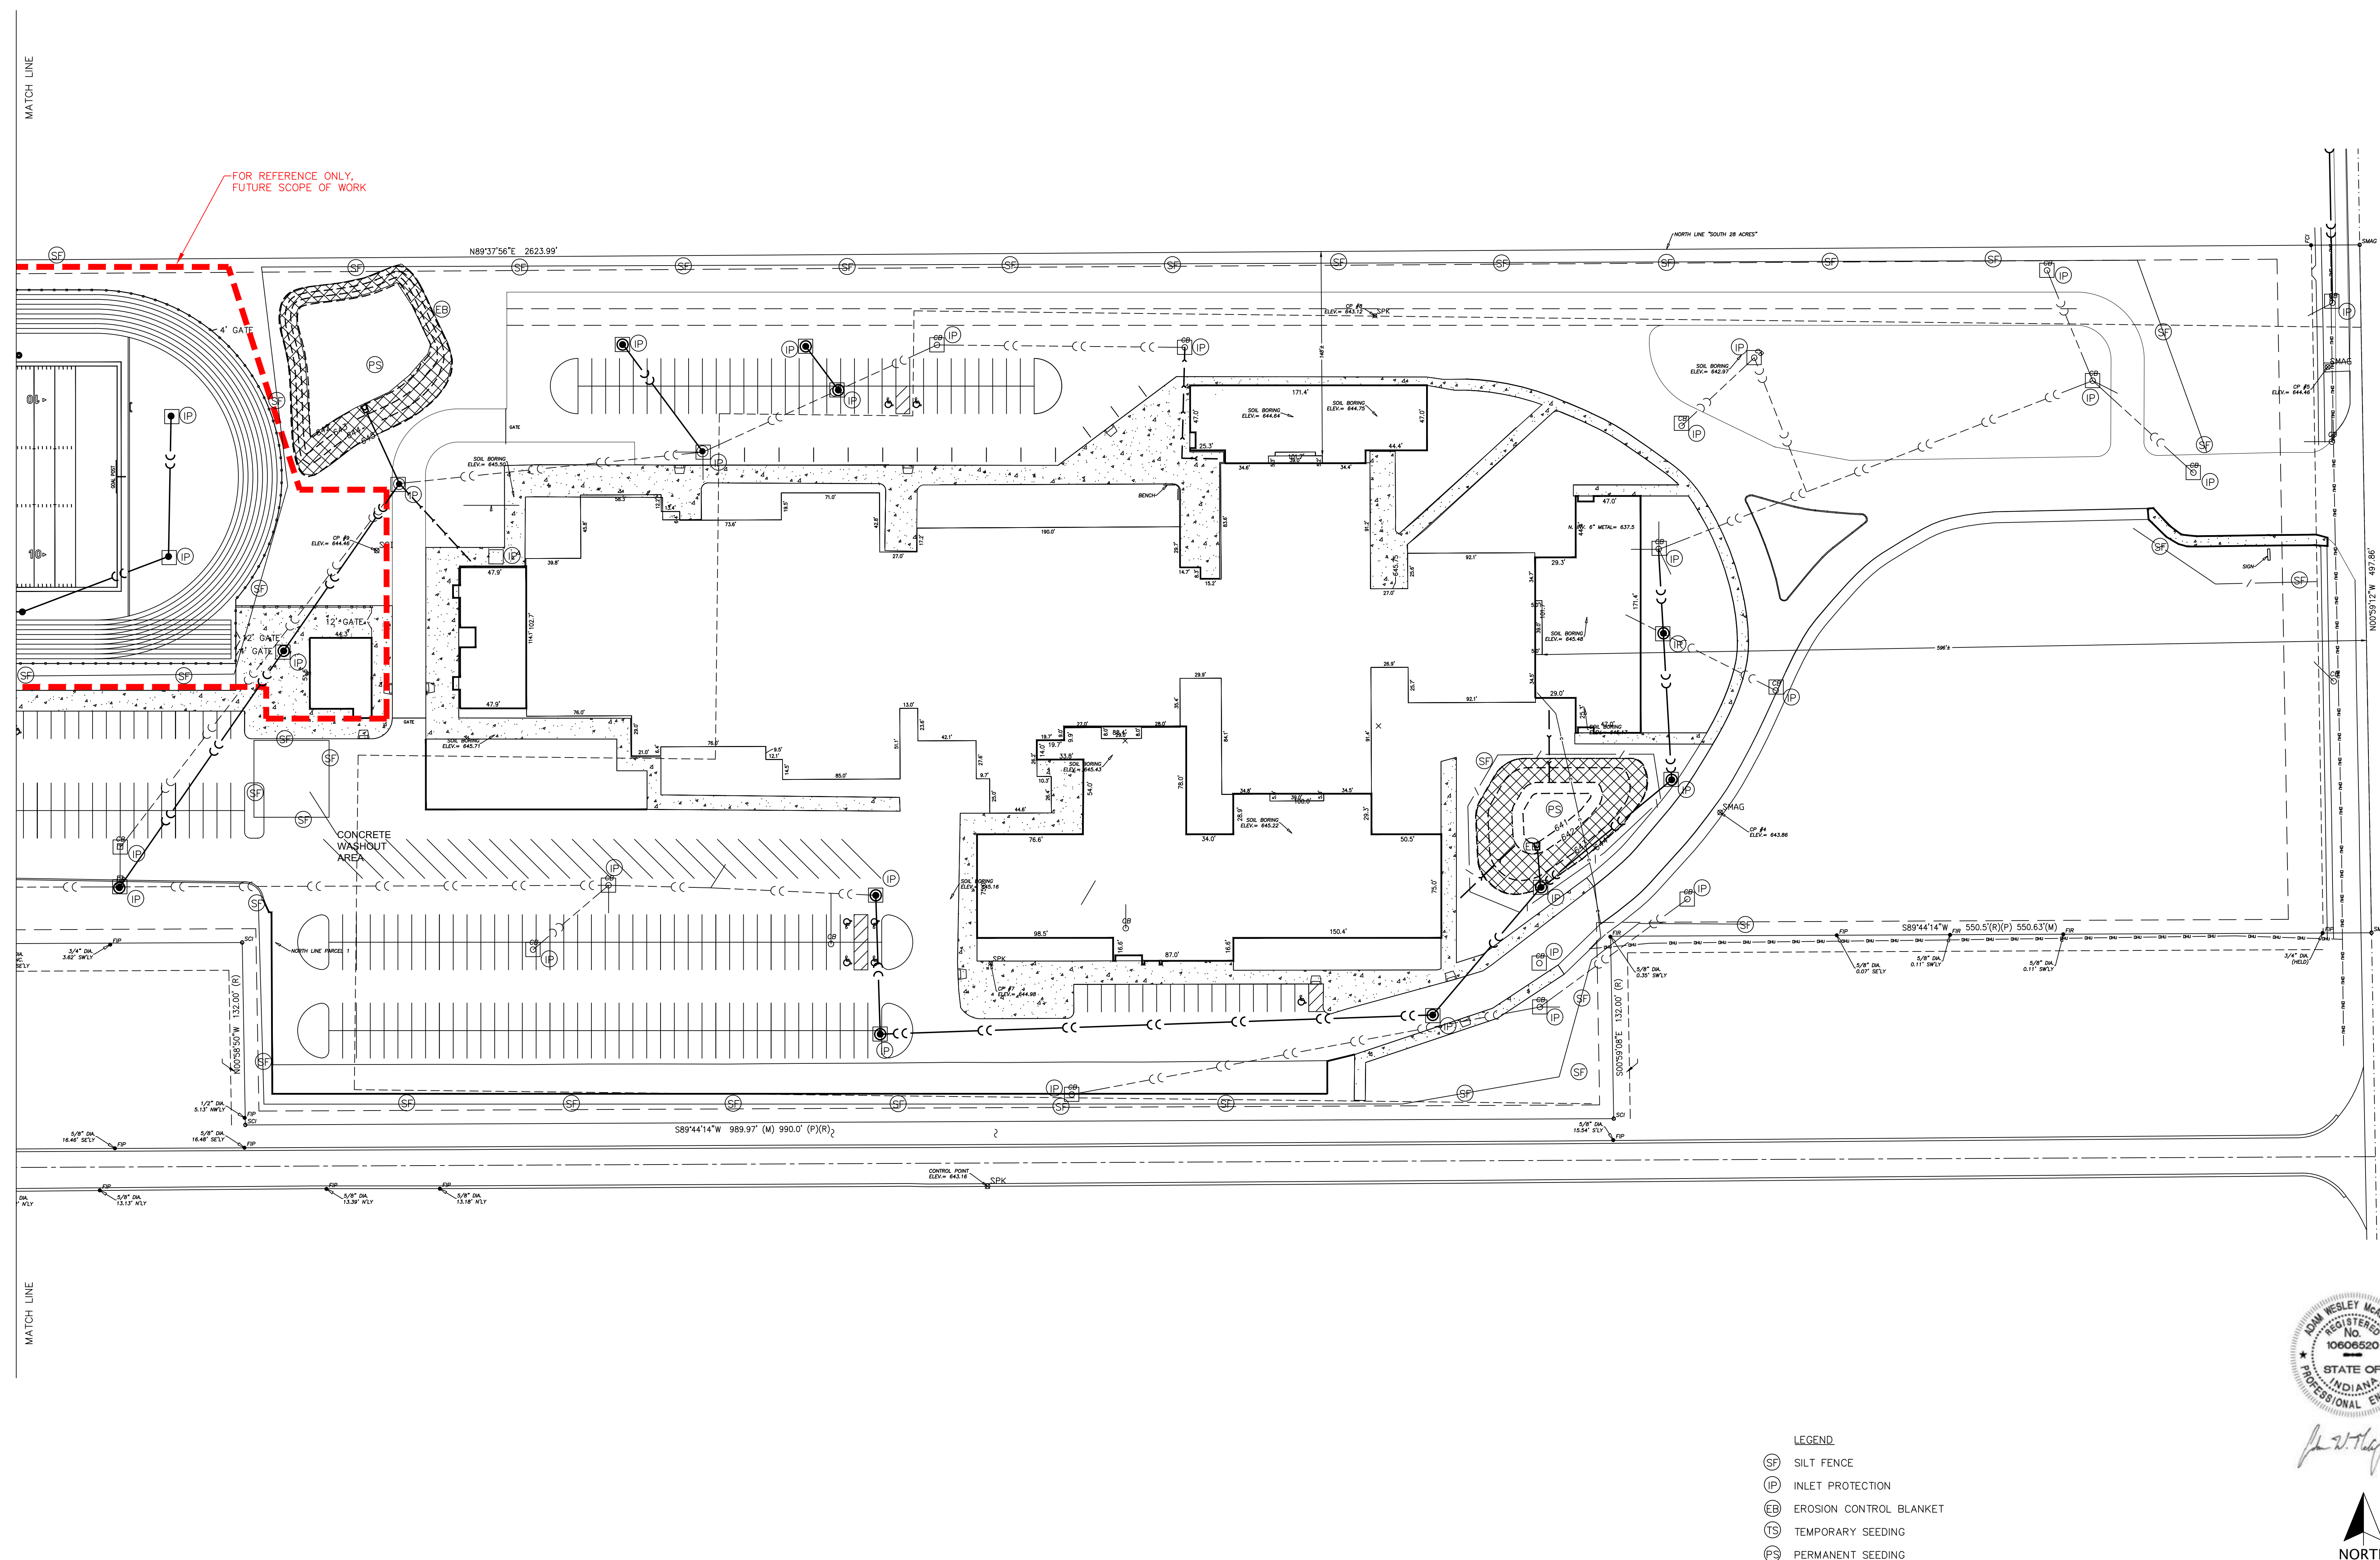

**LEGEND**

(SF) SILT FENCE  
(IP) INLET PROTECTION  
(EB) EROSION CONTROL BLANKET  
(TS) TEMPORARY SEEDING  
(PS) PERMANENT SEEDING

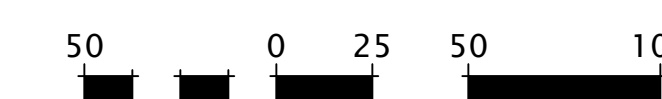


## ADDENDUM #1

SHEET

C-4.0





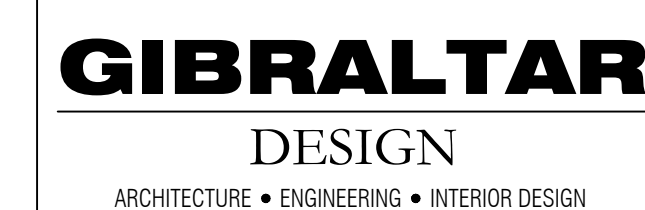

PROJECT

**WESTCHESTER  
INTERMEDIATE  
SCHOOL -  
ADDITIONS &  
RENOVATIONS**

DUNELAND SCHOOL CORPORATION  
CHESTERSTON, INDIANA

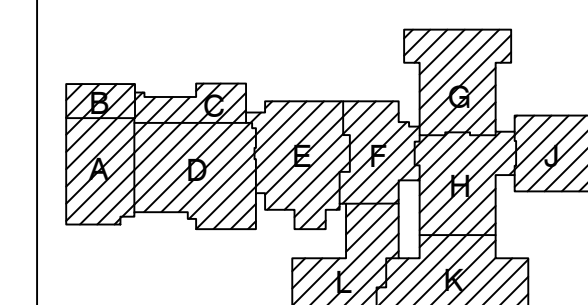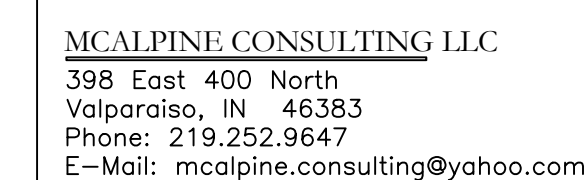

**GIBRALTAR DESIGN**  
9102 N. Meridian St., Ste. 300  
Indianapolis, IN 46260  
Homepage [www.GibraltarDesign.com](http://www.GibraltarDesign.com)  
Email [info@GibraltarDesign.com](mailto:info@GibraltarDesign.com)  
Phone 317.580.5777 Fax 317.580.5778

|  |  |
|--|--|
| PROJECT<br>21-141<br>DATE<br>03/16/22<br>COORDINATED BY<br>AWM<br>DRAWN BY<br>BPL<br>CHECKED BY<br>AWM |  |
|--|--|


**COPYRIGHT NOTICE:**  
THE CONCEPTS, DESIGNS, PLANS, DETAILS, ETC., SHOWN ON  
THIS DOCUMENT ARE THE PROPERTY OF GIBRALTAR DESIGN AND  
WERE CREATED FOR USE ON THIS SPECIFIC PROJECT. NONE OF  
THIS INFORMATION SHALL BE USED BY ANY PERSON OR FIRM  
FOR ANY PURPOSE WITHOUT THE EXPRESS WRITTEN CONSENT  
OF GIBRALTAR DESIGN. THE OWNER MAY RETAIN COPIES FOR  
INFORMATION AND REFERENCE IN CONNECTION ONLY WITH THIS  
PROJECT.

[illegible]

DRAWING  
EROSION CONTROL PLAN 2

PROJECT  
WESTCHESTER IS -  
ADDITIONS & RENOVATIONS

|                    |                       |
|--------------------|-----------------------|
| © GIBRALTAR DESIGN | SHEET<br><b>C-4.1</b> |
|--------------------|-----------------------|

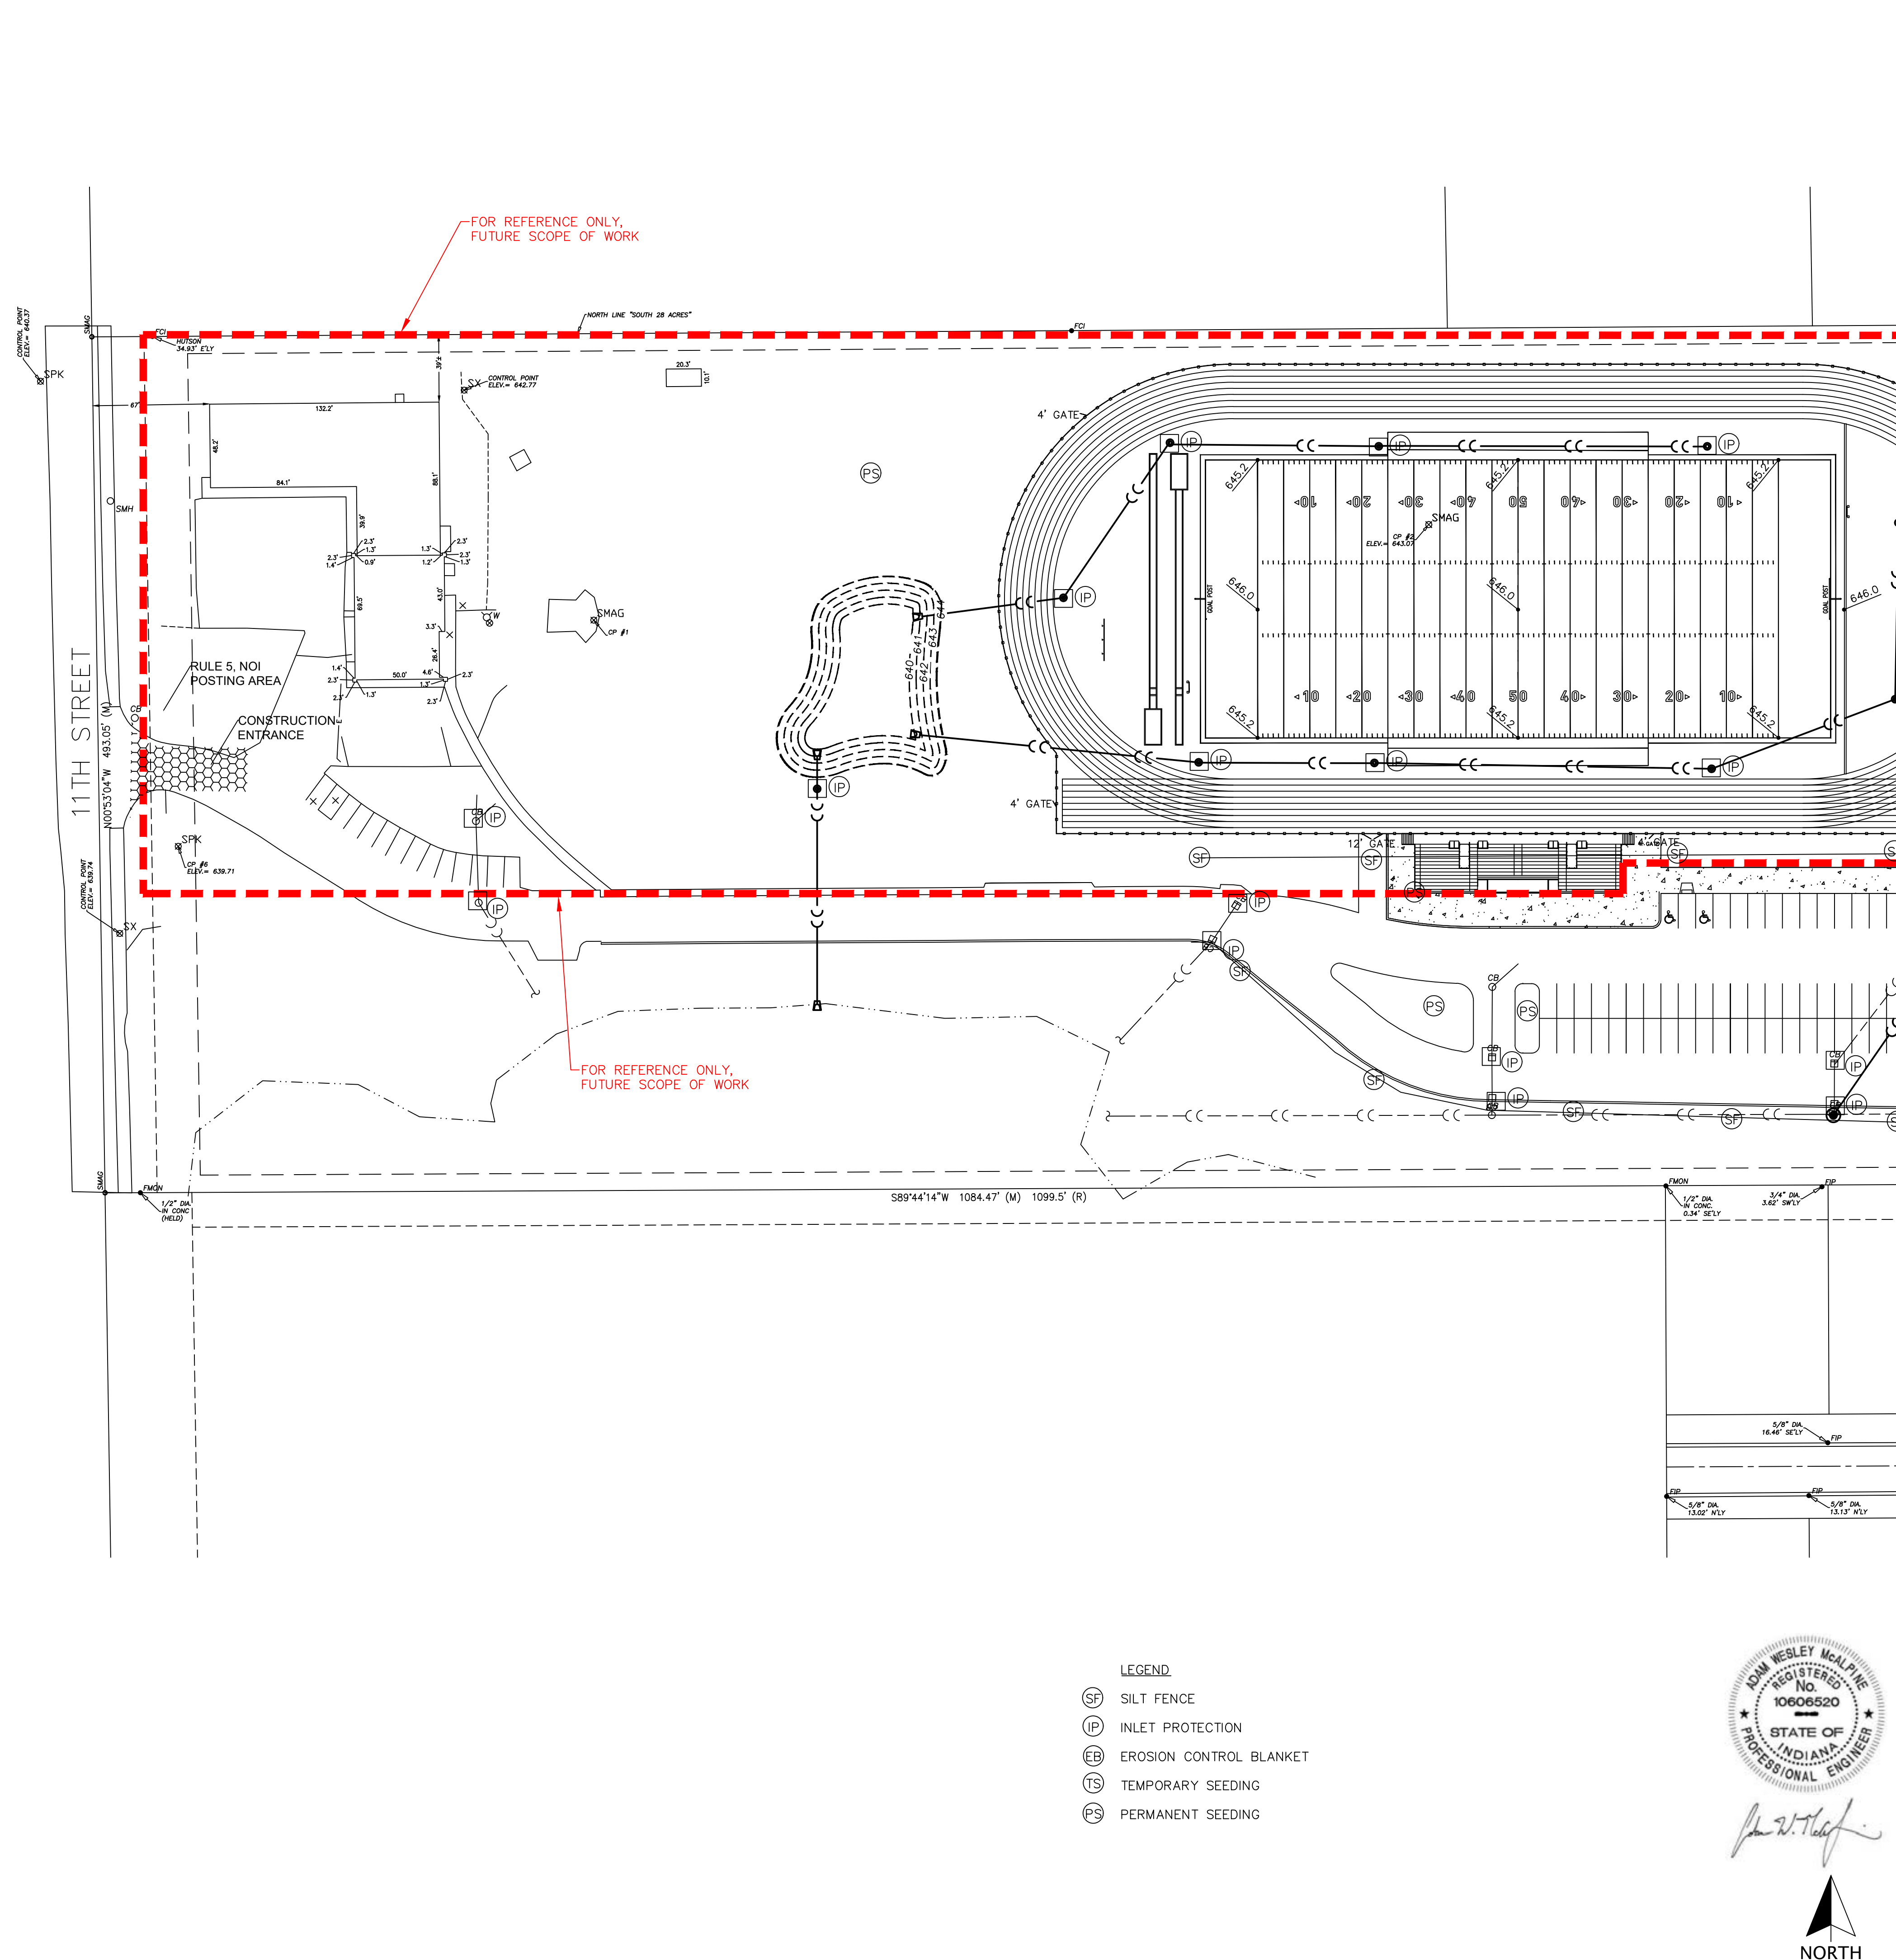

50 0 25 50 100

ADDENDUM #1

C-4.1

[illegible]





# WESTCHESTER INTERMEDIATE SCHOOL - ADDITIONS & RENOVATIONS



|                       |  |
|-----------------------|--|
| PROJECT<br>21-141     |  |
| DATE<br>03/16/22      |  |
| COORDINATED BY<br>AWM |  |
| DRAWN BY<br>BPL       |  |
| CHECKED BY<br>ΔWM     |  |

[illegible]

|                    |       |
|--------------------|-------|
| © GIBRALTAR DESIGN | SHEET |
|--------------------|-------|

## ADDENDUM #1

## 1 | Page


2 | Page

3 | Page

4 | Page


5 | Page

The final topography of the development site is illustrated on the grading plan. The site will drain south into a detention basin via storm sewer pipes and grass swales.

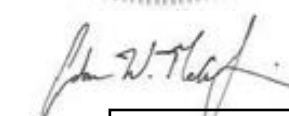

© GIBALTAR DESIGN



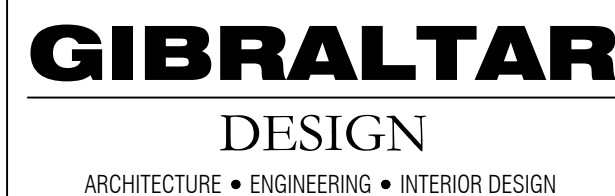

# WESTCHESTER INTERMEDIATE SCHOOL - ADDITIONS & RENOVATIONS



|  |  |
|--|--|
| PROJECT<br>21-141<br>DATE<br>03/16/22<br>COORDINATED BY<br>AWM<br>DRAWN BY<br>BPL<br>CHECKED BY<br>AWM |  |
|--|--|

REVISIONS

DRAWING  
EROSION CONTROL  
NARRATIVE 2

|                      |       |
|----------------------|-------|
|----------------------|-------|

## 7 | Page













- 8 | Page

Maintenance guidelines for all post-construction water quality measures are described in the O&M manual.


C-4.4





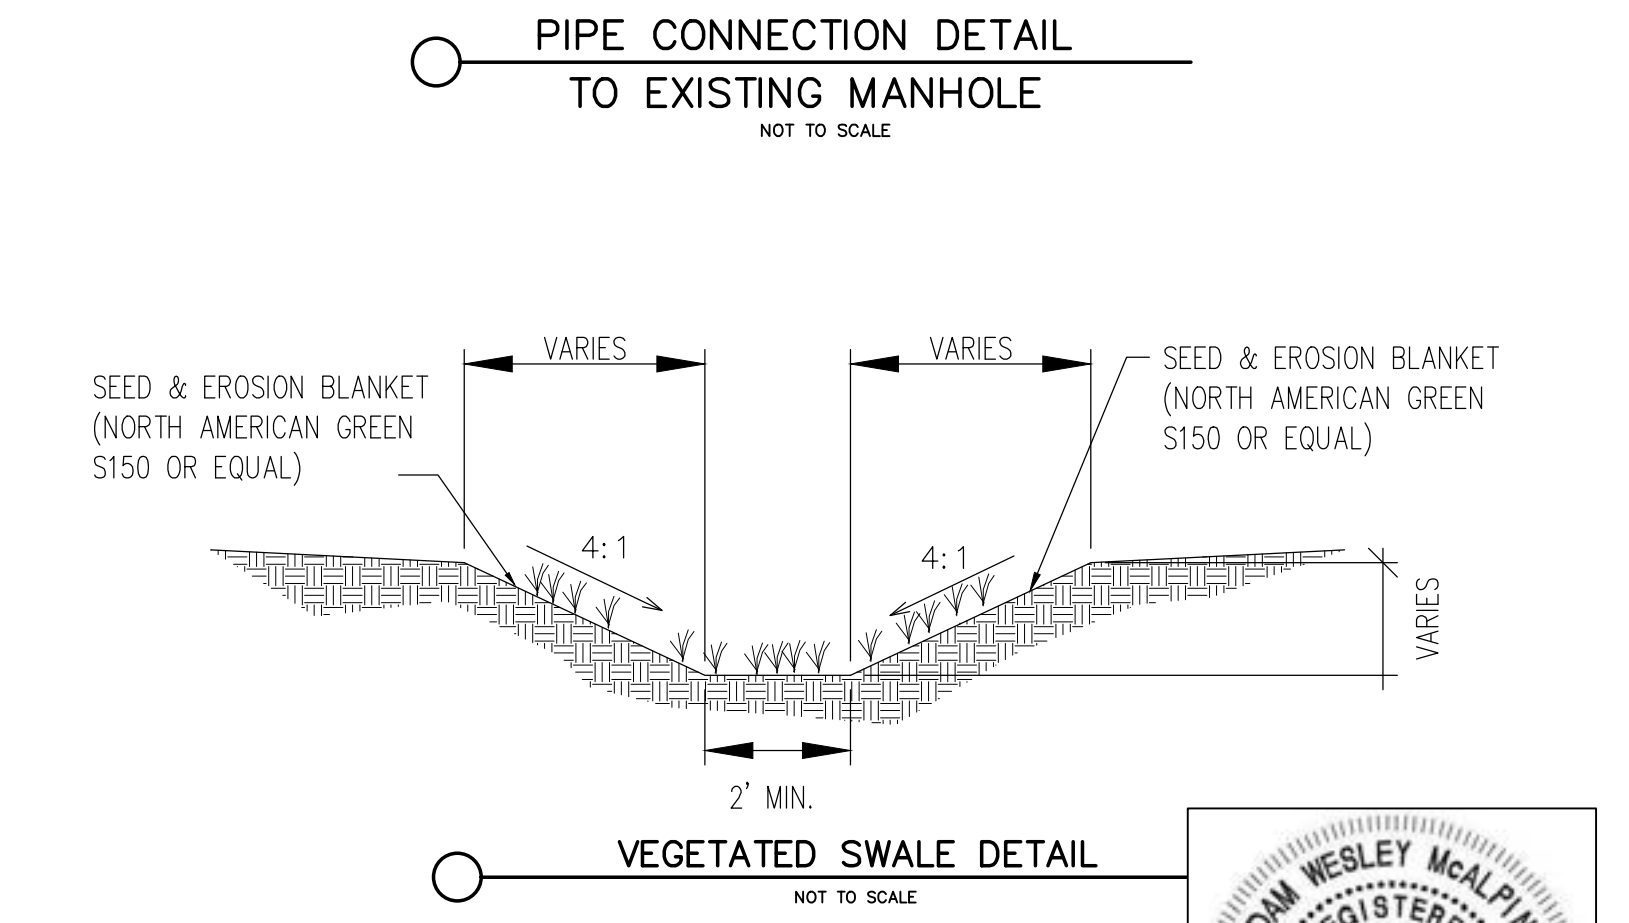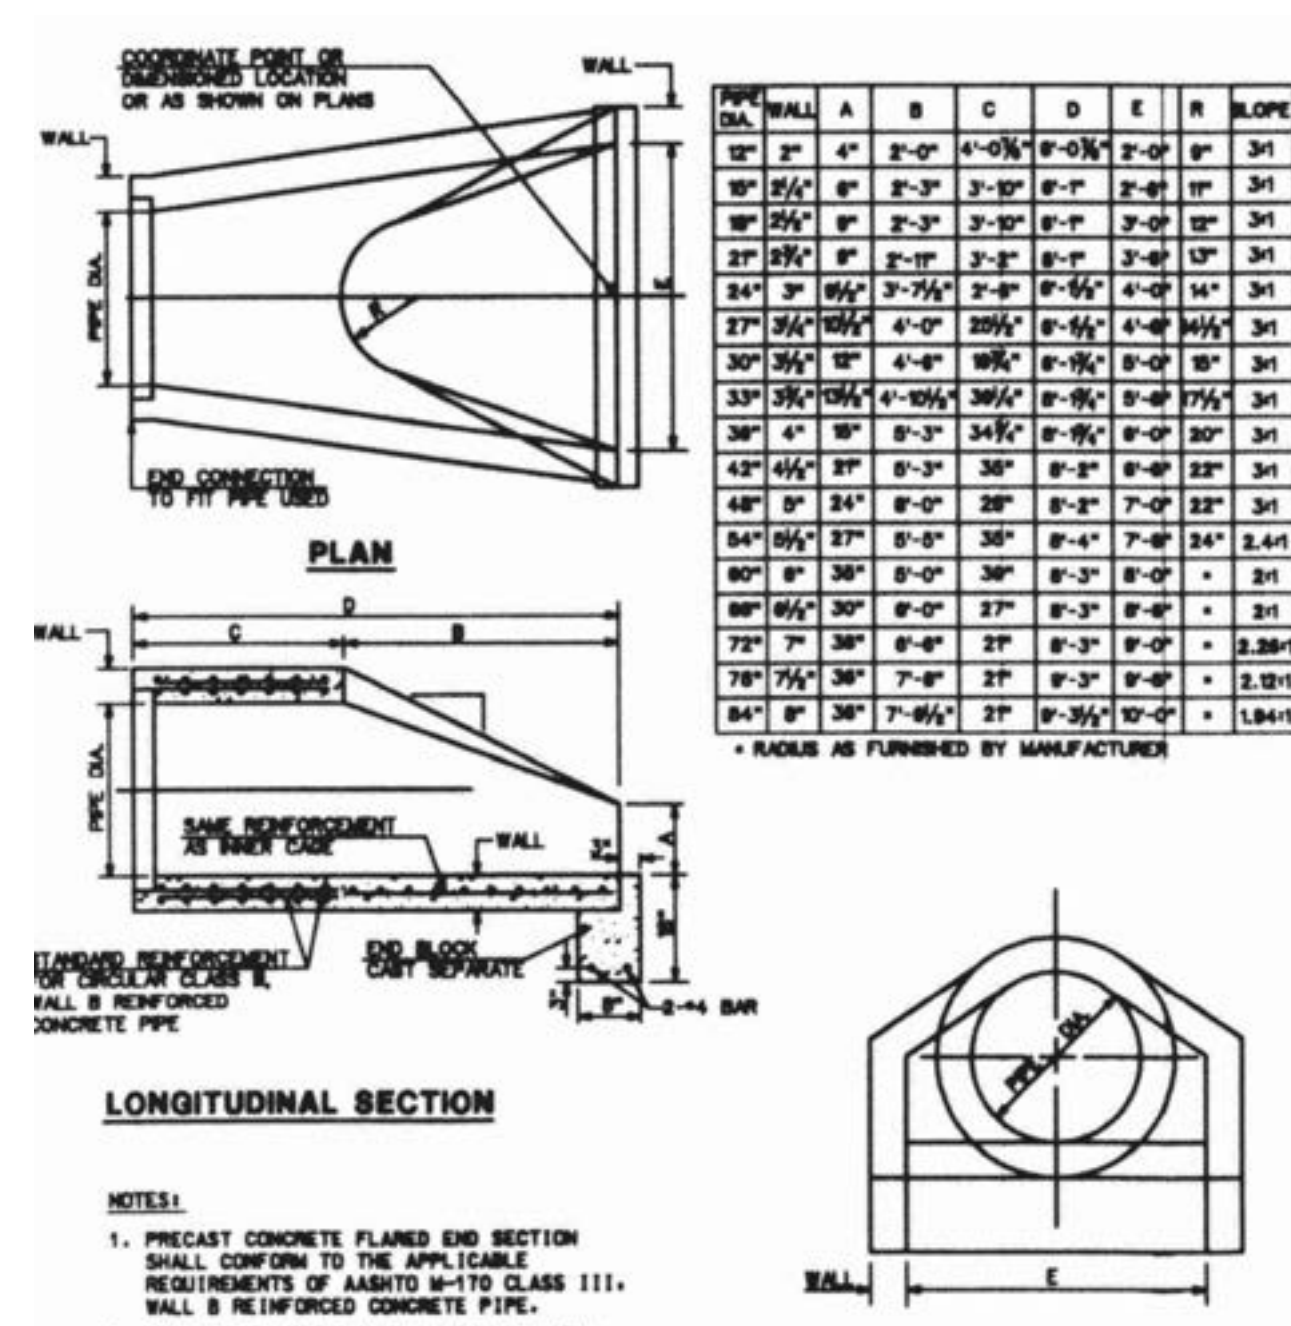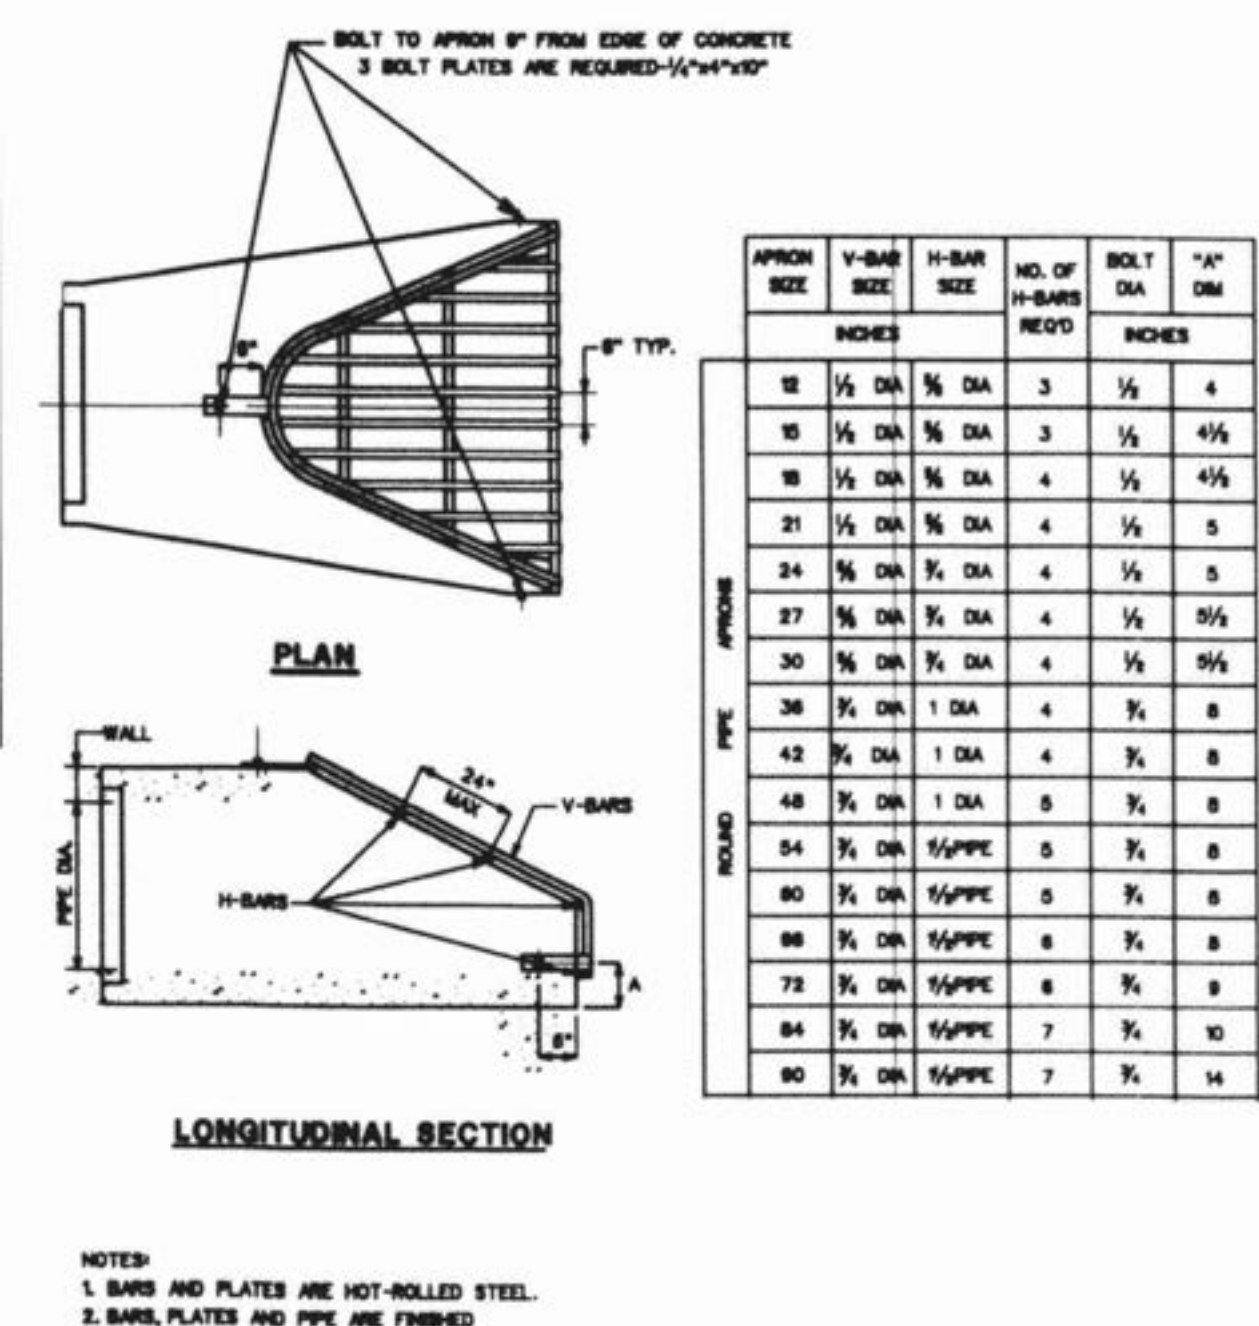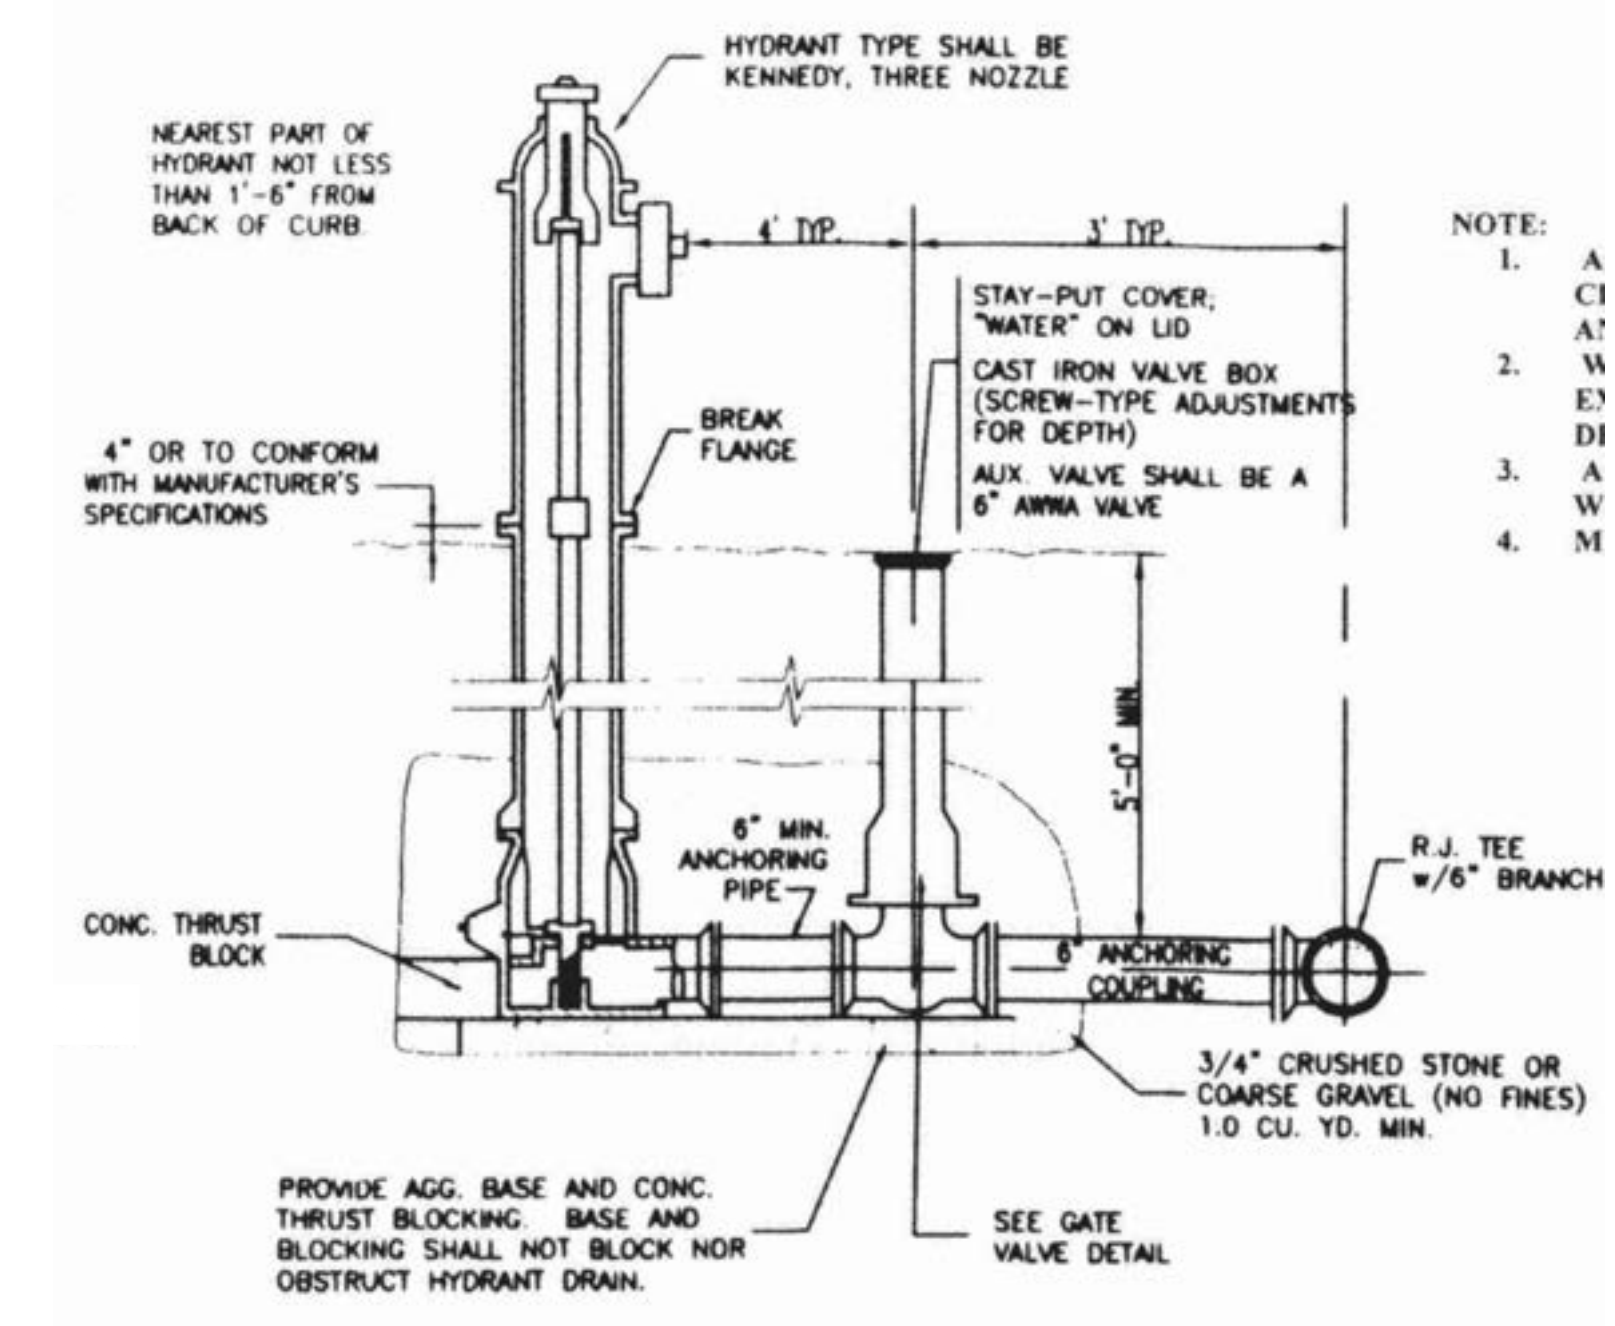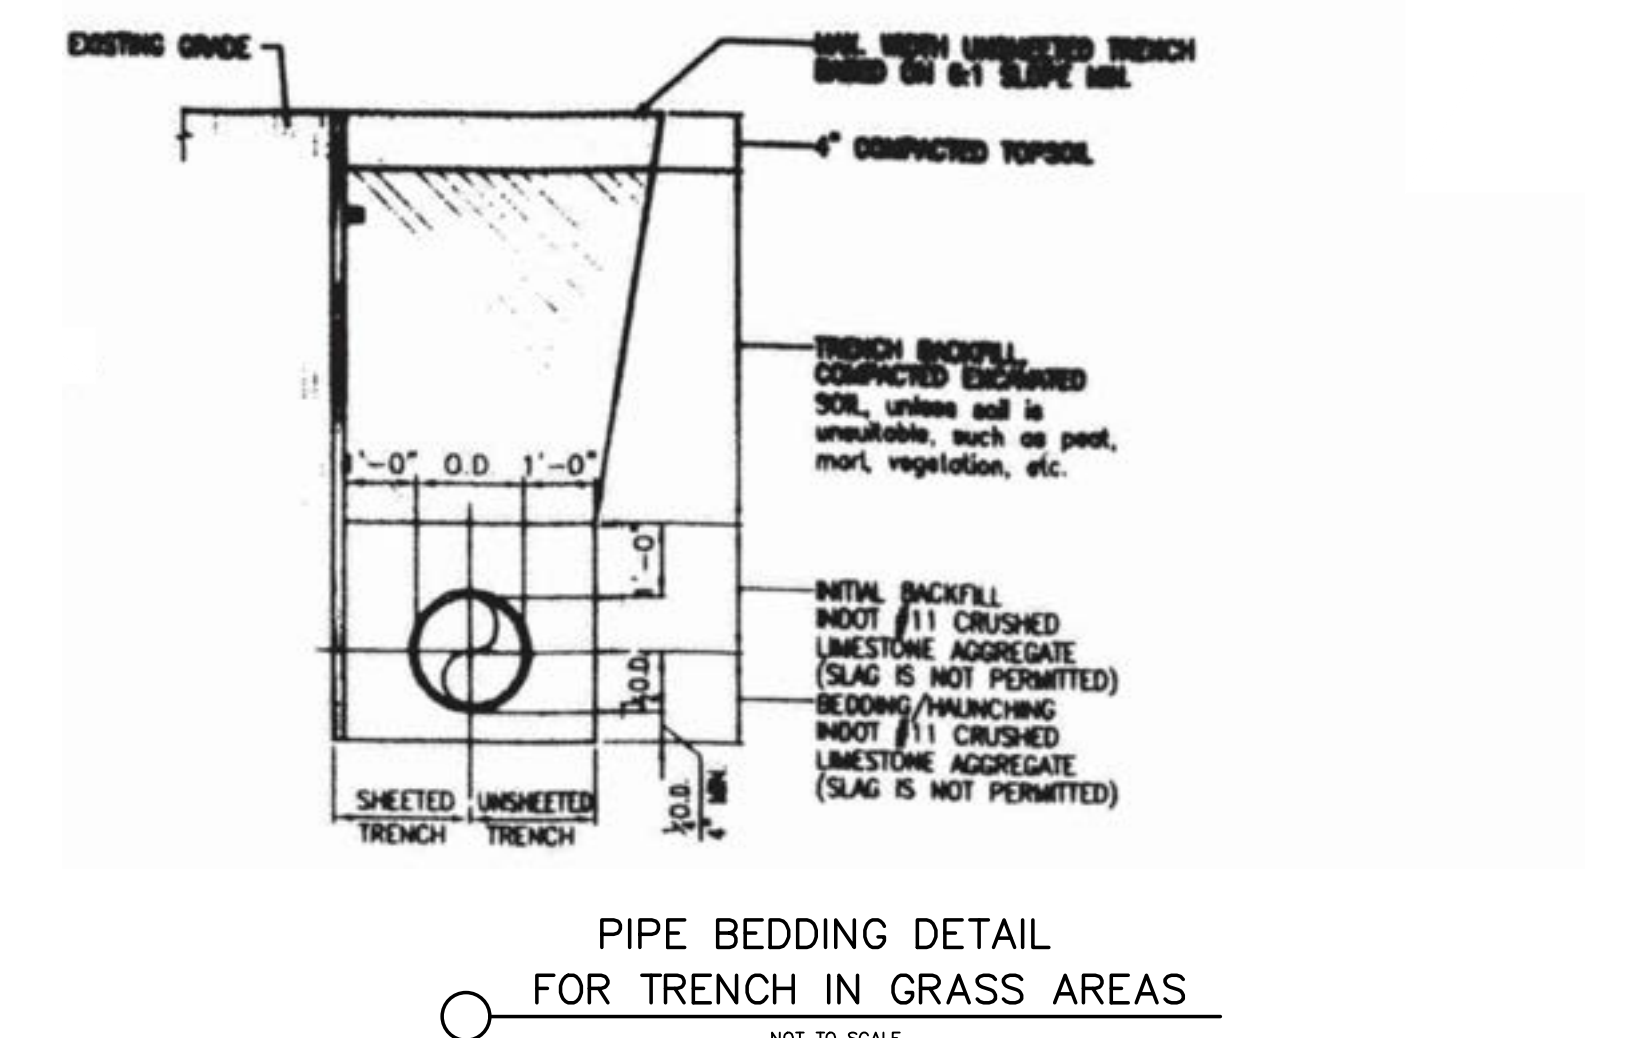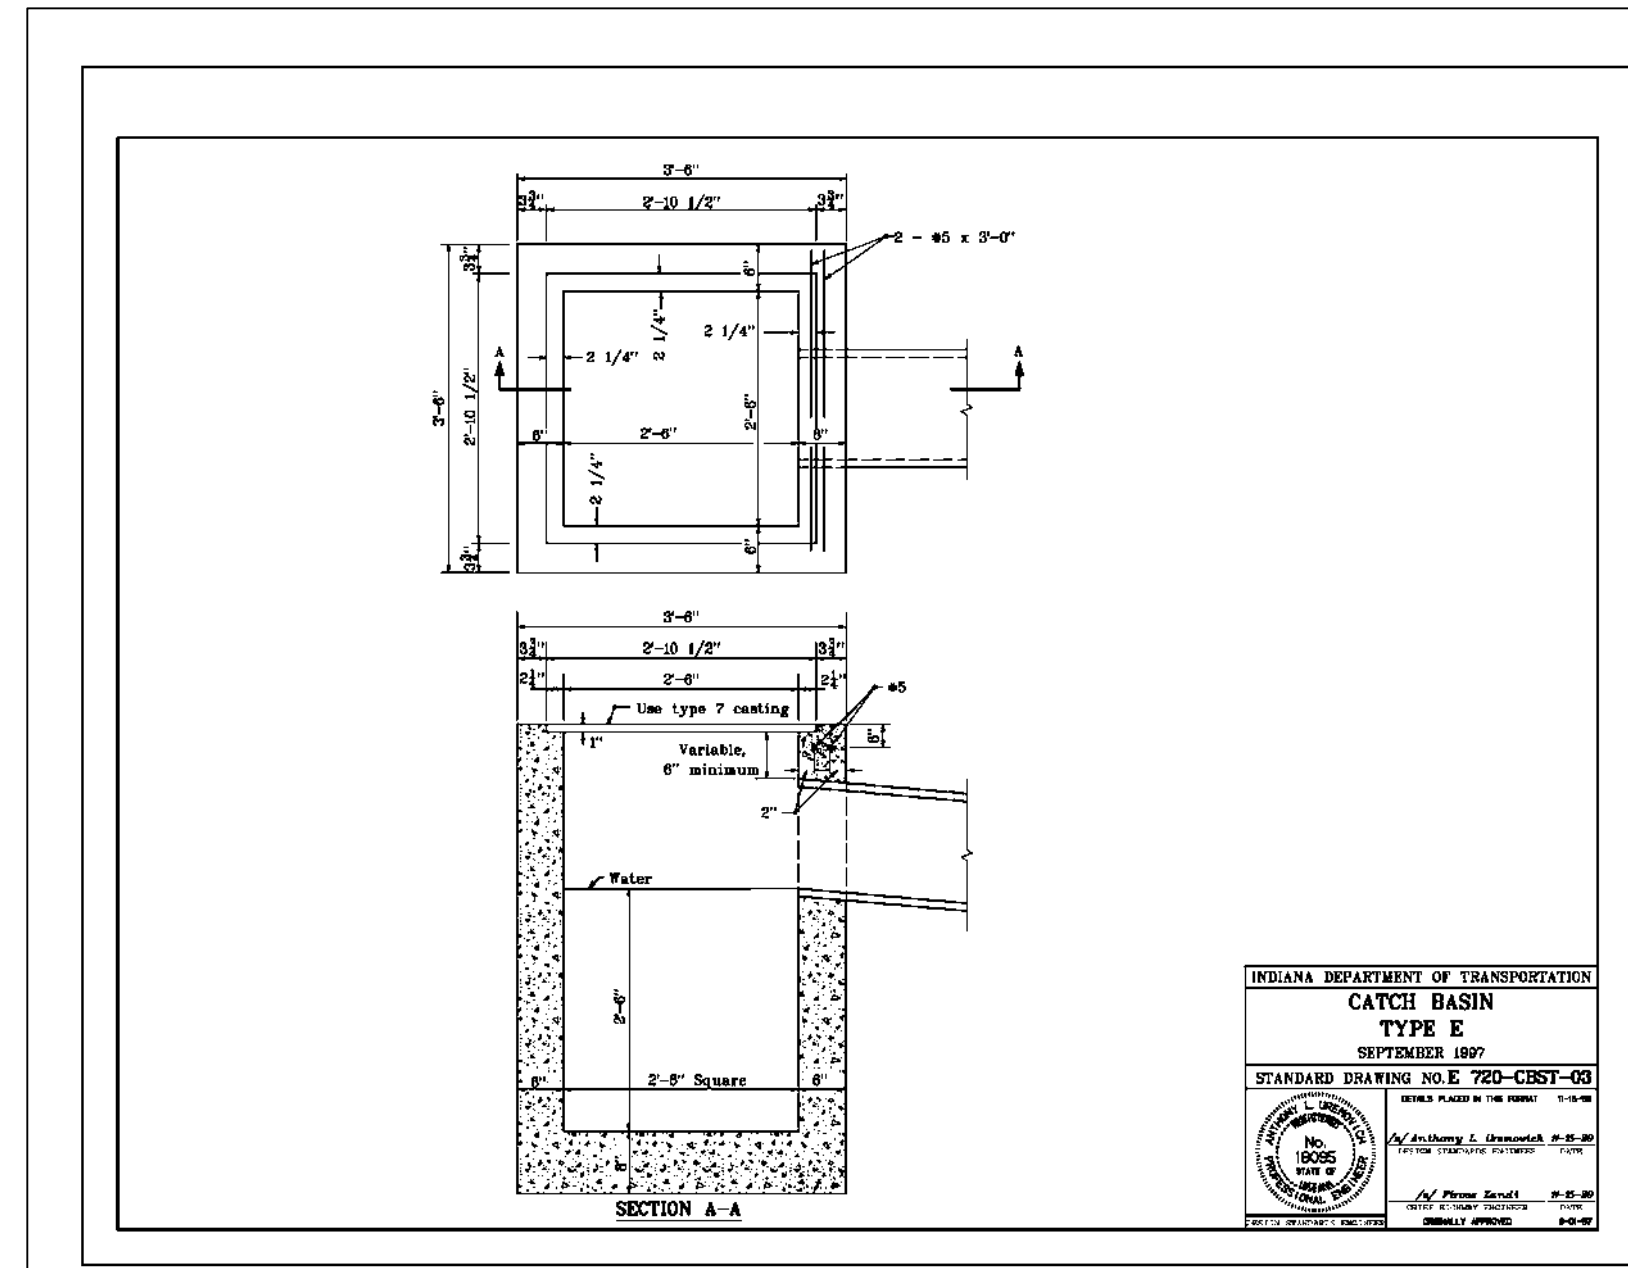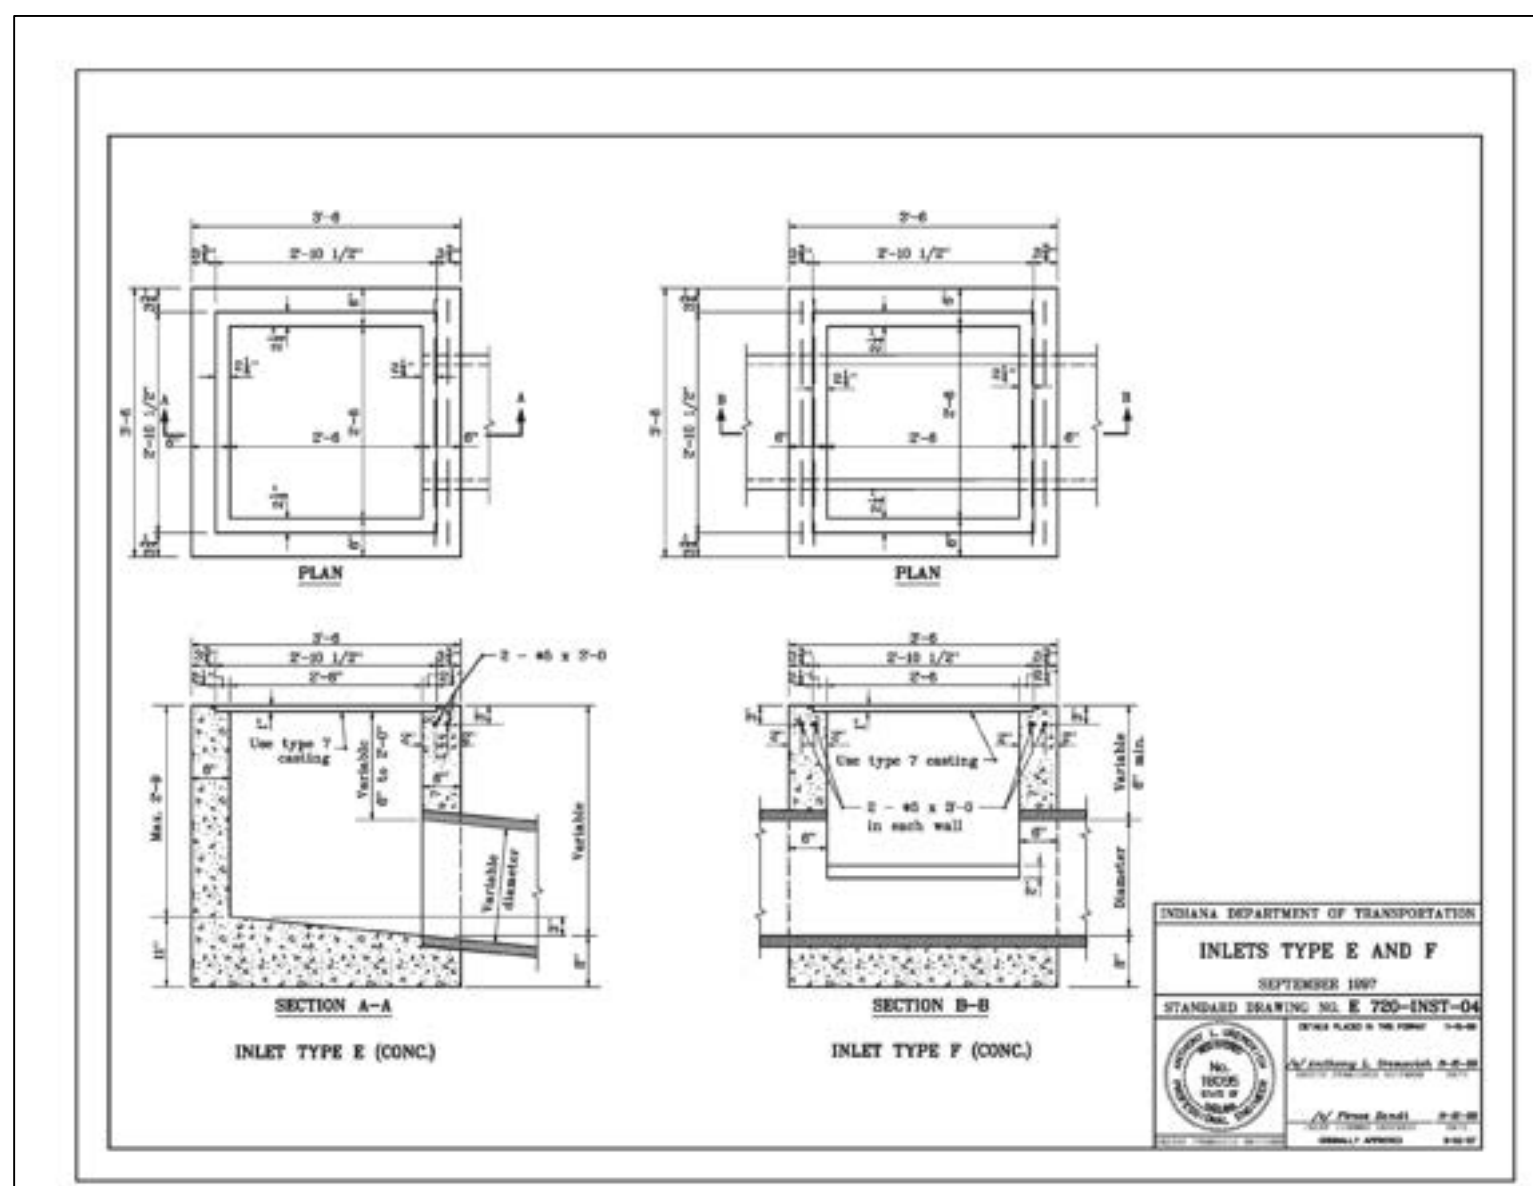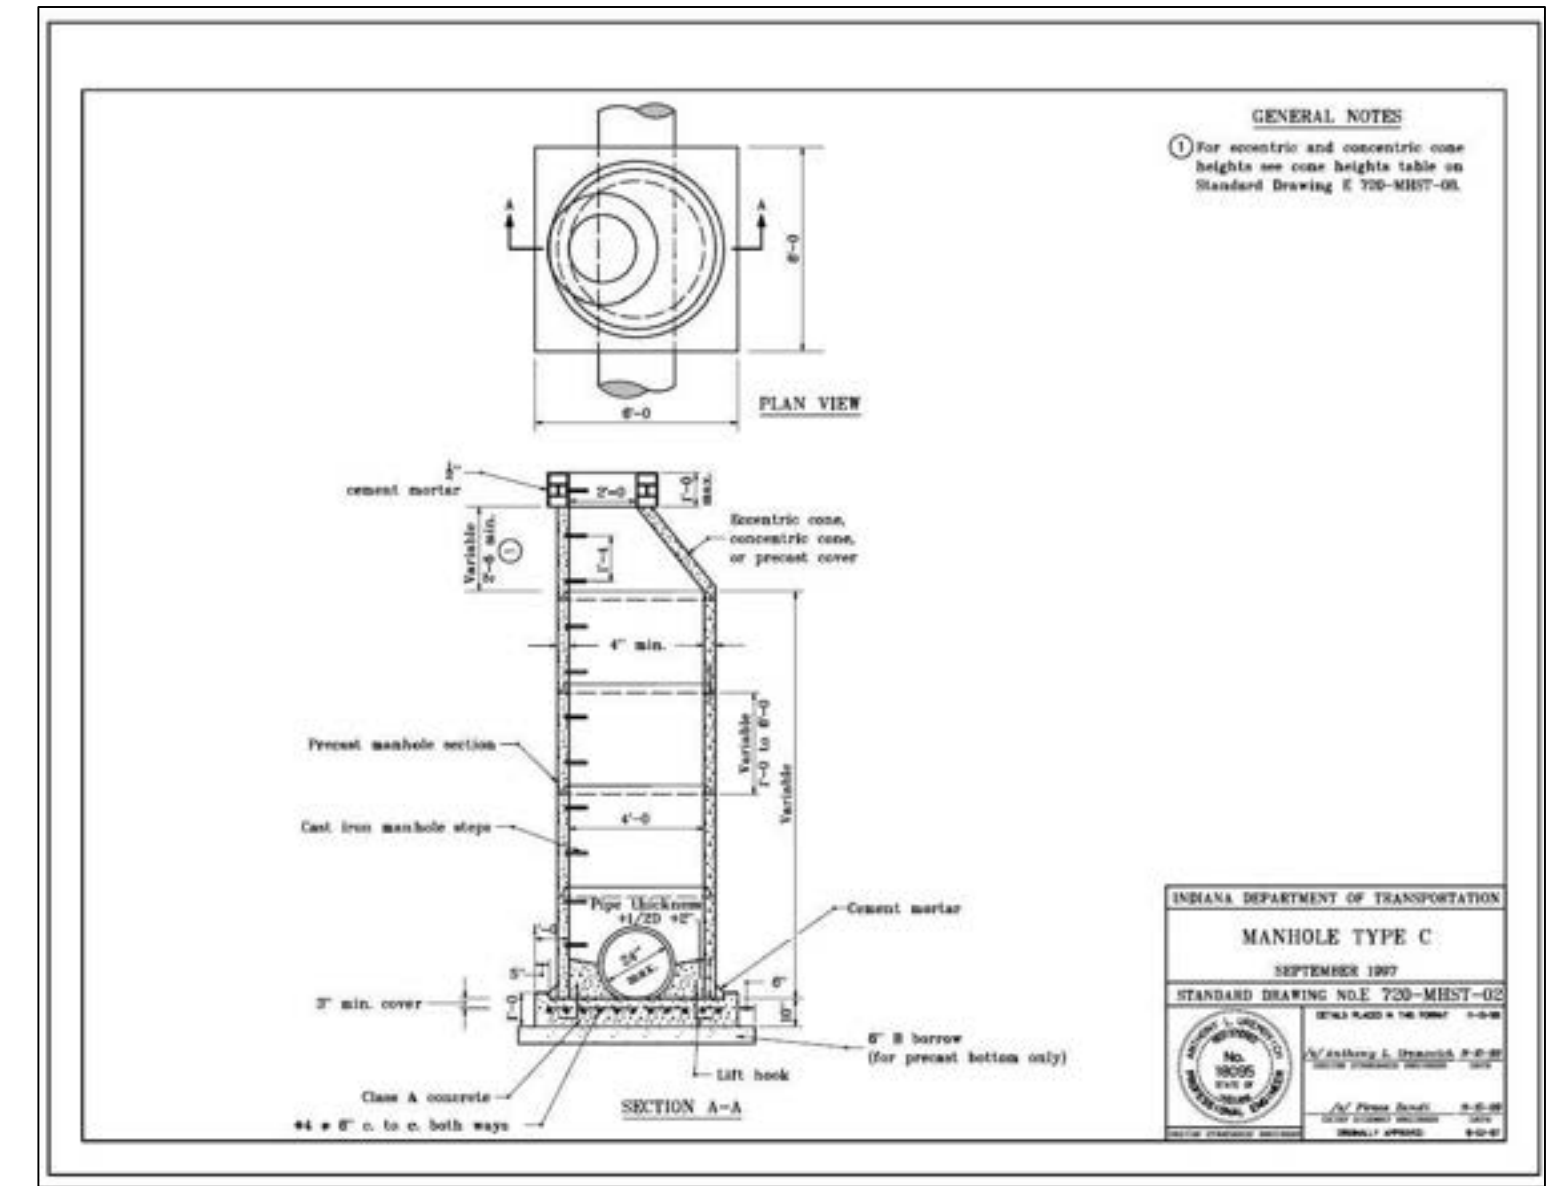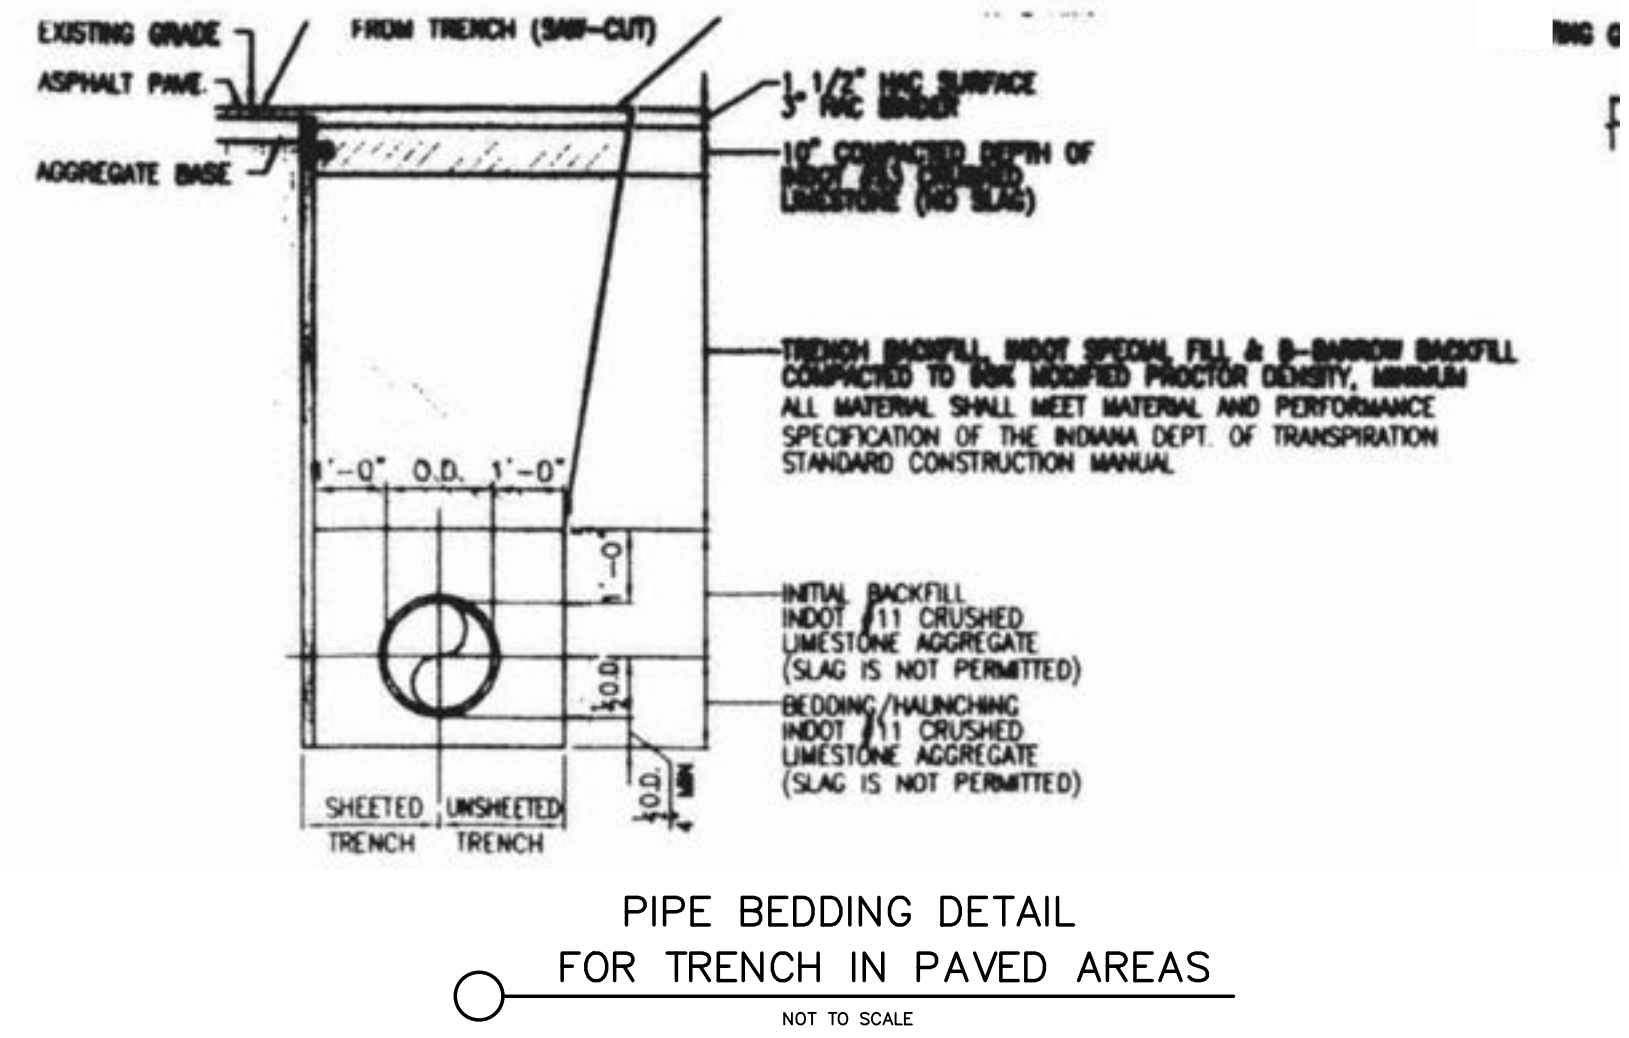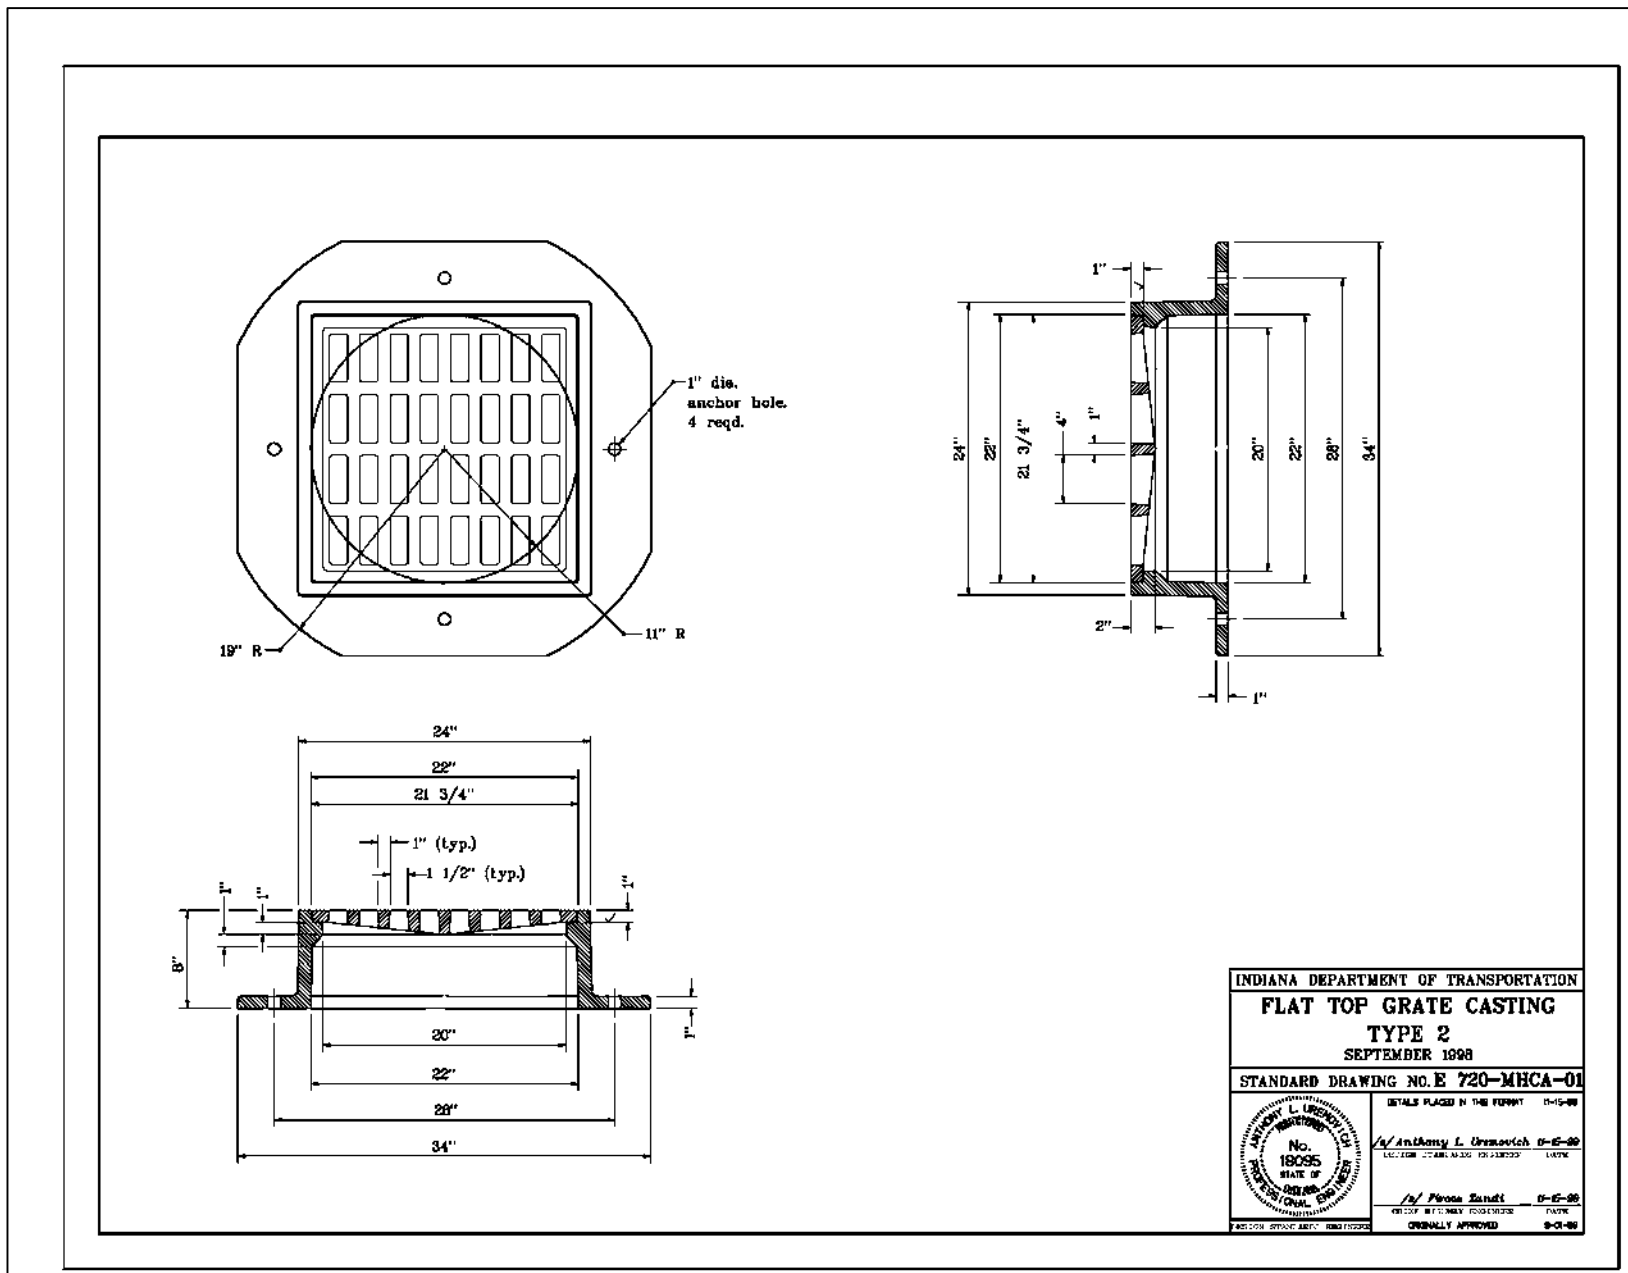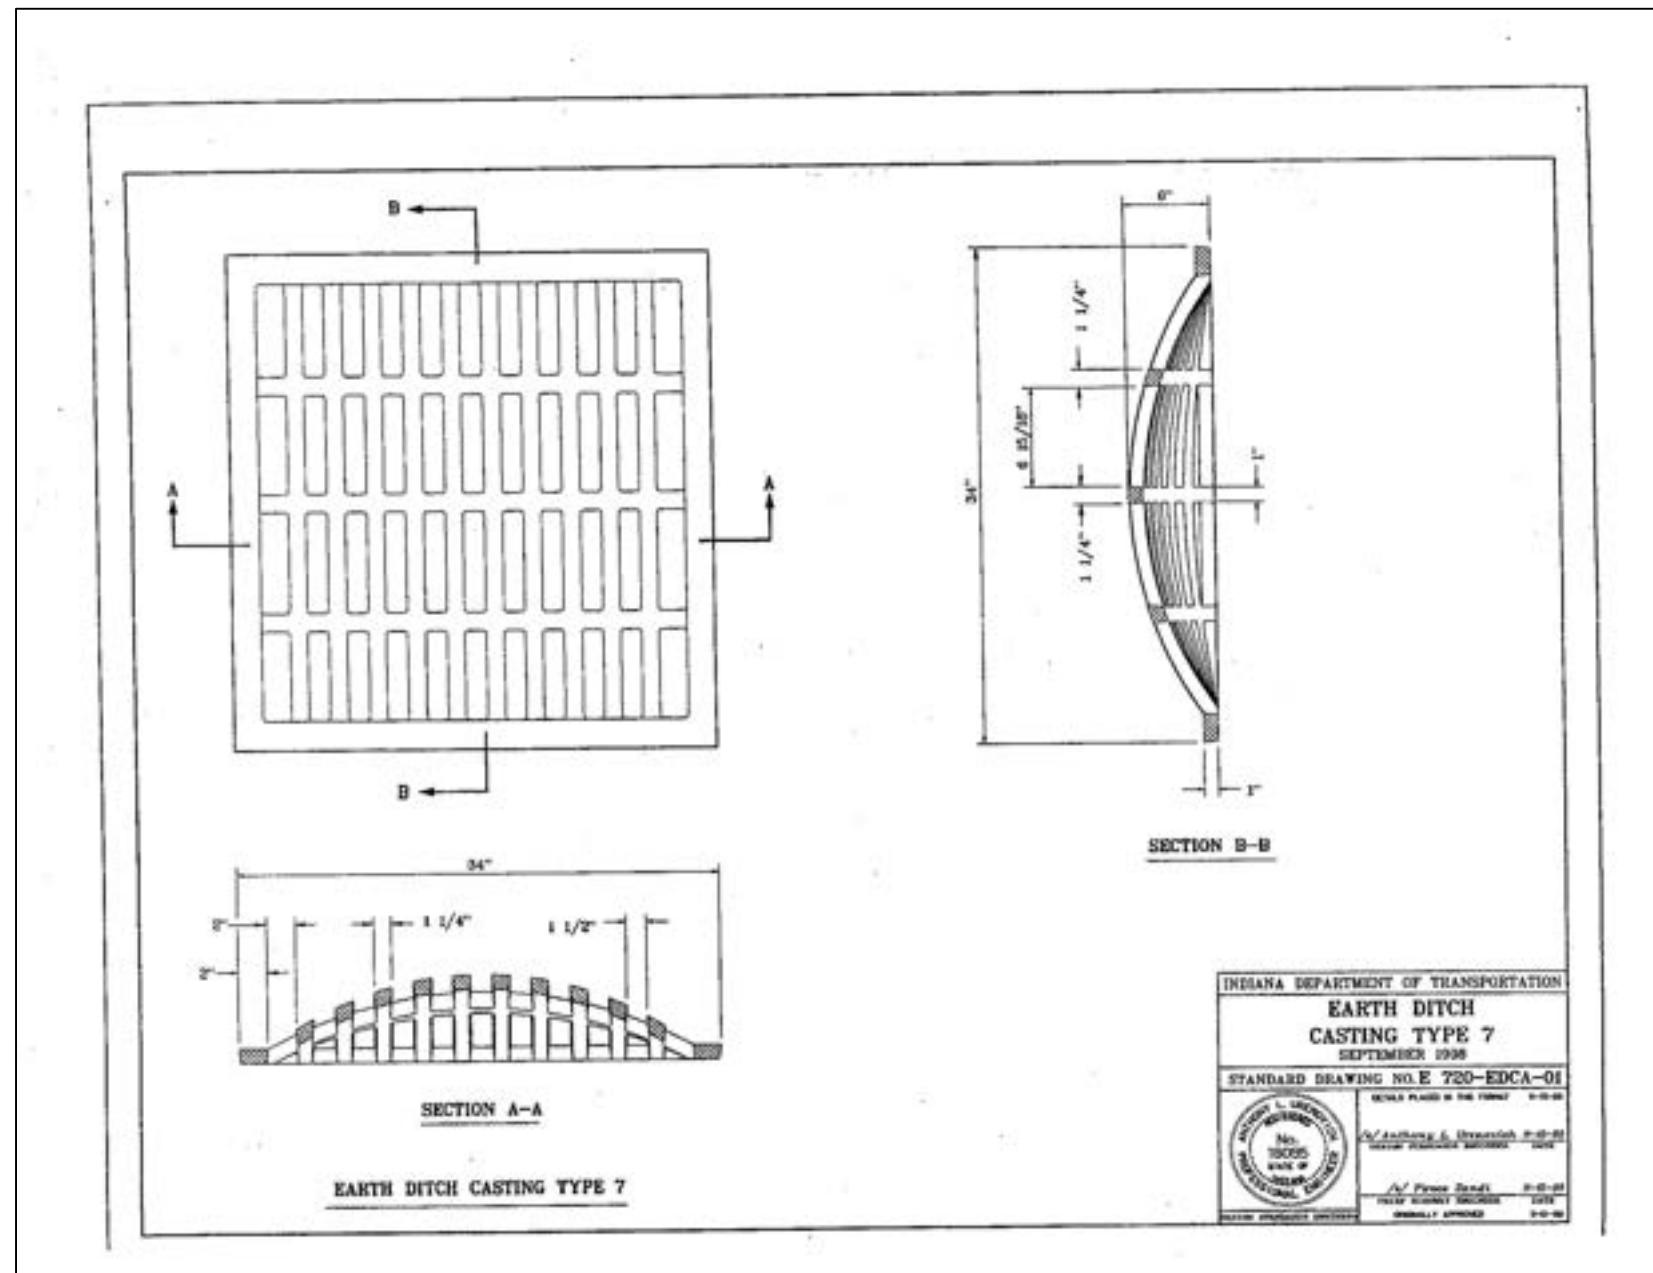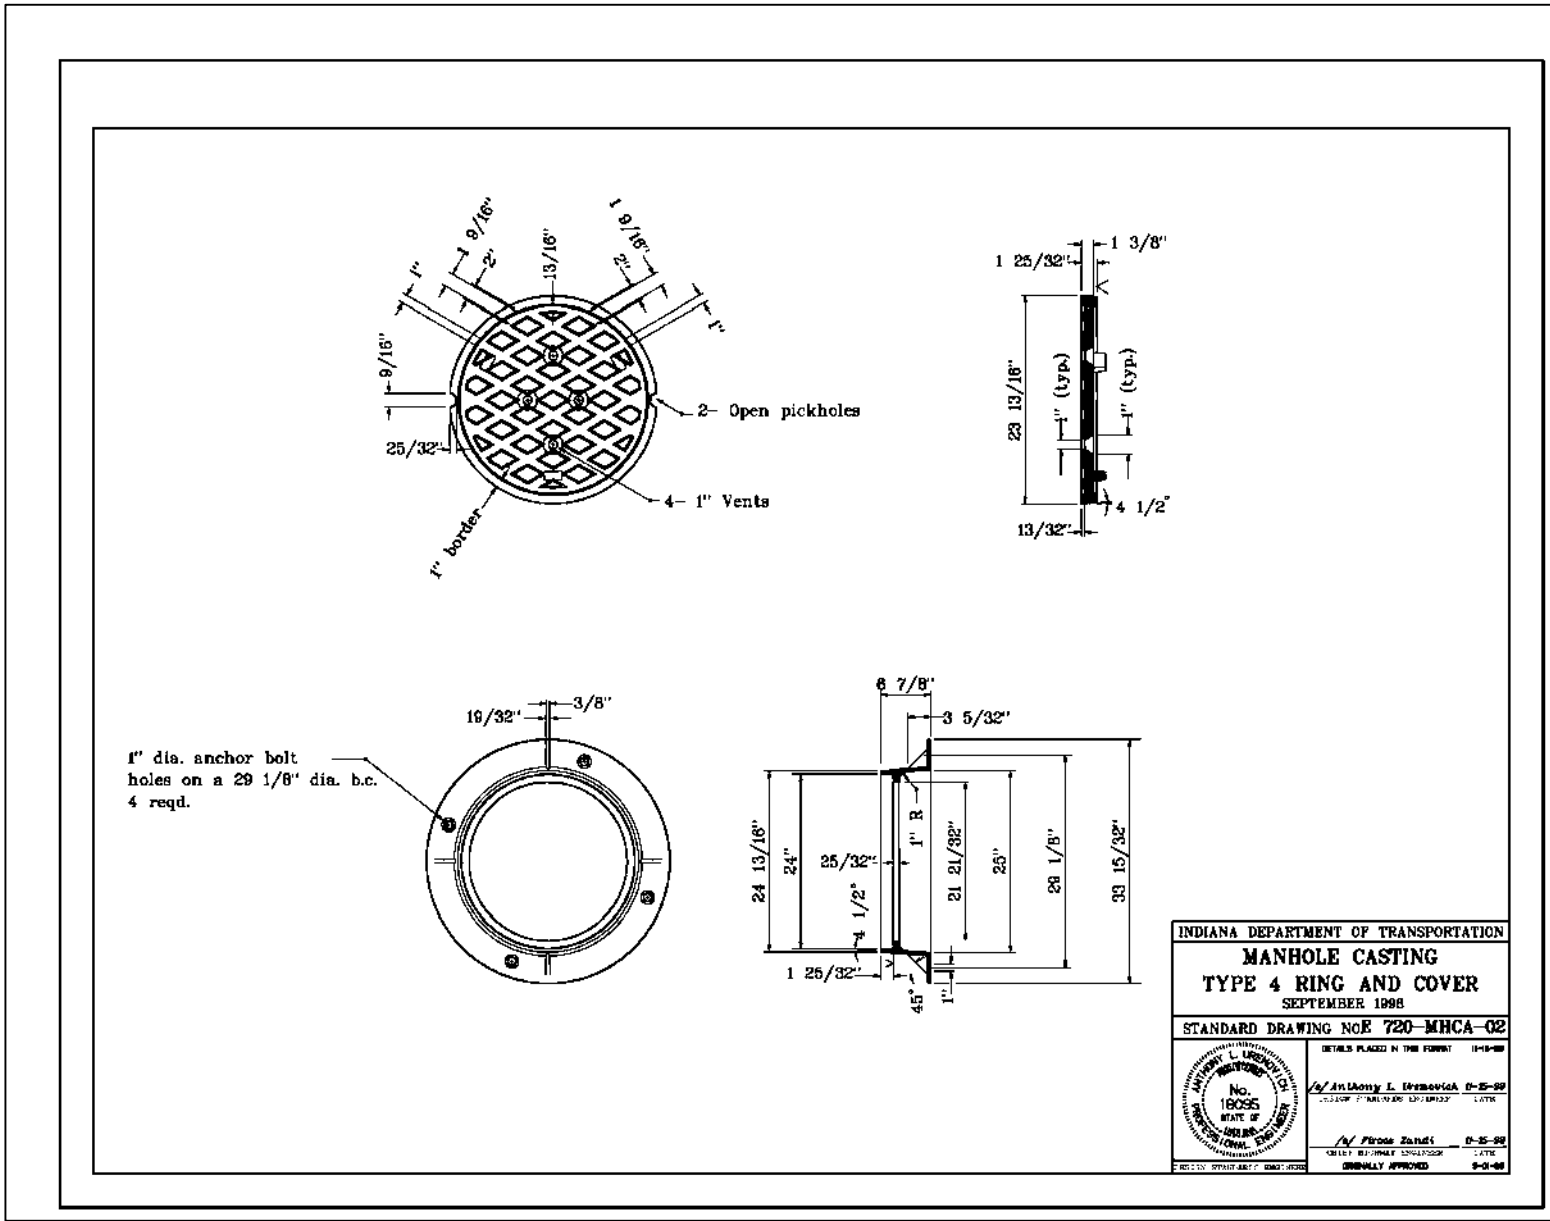

PROJECT  
**WESTCHESTER  
INTERMEDIATE  
SCHOOL -  
ADDITIONS &  
RENOVATIONS**  
DUNELAND SCHOOL CORPORATION  
CHESTERTON, INDIANA

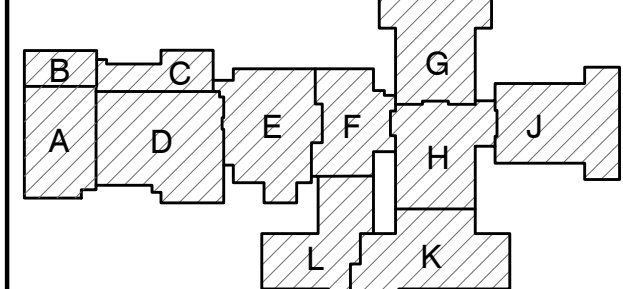

9102 N. Meridian St., Ste. 300  
Indianapolis, IN 46260  
Homepage: www.GibraltarDesign.com  
Email: info@GibraltarDesign.com  
Phone: 317.580.5777 Fax: 317.580.5778

PROJECT  
21-141  
DATE  
03/16/22  
COORDINATED BY  
AWM  
DRAWN BY  
BPL  
CHECKED BY  
AWM

COPYRIGHT NOTICE:  
THE CONCEPTS, DESIGNS, PLANS, DETAILS, ETC., SHOWN ON THIS DOCUMENT ARE THE PROPERTY OF GIBRALTAR DESIGN AND WERE CREATED FOR USE ON THIS SPECIFIC PROJECT. NONE OF THIS INFORMATION SHALL BE USED BY ANY PERSON OR FIRM FOR ANY PURPOSE WITHOUT THE EXPRESS WRITTEN CONSENT OF GIBRALTAR DESIGN. THE OWNER MAY RETAIN COPIES FOR INFORMATION AND REFERENCE IN CONNECTION ONLY WITH THIS PROJECT.

REVISIONS

| MARK | DATE     | ISSUED FOR     |
|------|----------|----------------|
| AD-1 | 03/16/22 | ADDENDUM NO. 1 |

DRAWING  
**DETAILS & SPECIFICATIONS 2**

PROJECT  
**WESTCHESTER IS -  
ADDITIONS & RENOVATIONS**

© GIBRALTAR DESIGN SHEET  
**C-5.1**

**ADDENDUM #1**



1. All cold-formed steel framing members, their design, fabrication, and erection shall conform to the "SPECIFICATION FOR THE DESIGN OF COLD-FORMED STEEL STRUCTURAL MEMBERS" of the latest edition of the AISI.

- and attachment to adjoining work.
- 2) For cold-formed metal framing to comply with design loads, include structural analysis data signed and sealed by the qualified professional engineer (SPE) responsible for their preparation.
- 3) Structural Performance: Provide cold-formed metal framing capable of withstanding design loads within limits and under end conditions including:
- A) Design Loads: Reference the Design Criteria Notes.
  - B) Deflection Limits: Design framing systems to withstand design loads without deflections greater than the following:
    - 1) Wall Framing: Horizontal deflection of 1/240 of the wall height for walls with flexible finishes e.g. metal siding, wood siding, EIFS, etc.
    - 2) Wall Framing: Horizontal deflection of 1/360 of the wall height for walls with cementitious finishes, e.g. cement plaster.
    - 3) Wall Framing: Horizontal deflection of 1/60 of the wall height for walls with masonry veneer finishes.
    - 4) Floor Joist Framing: Vertical deflection of 1/480 of the span under live load. Limit deflection under total load (dead + live) to 1/360 of the span.
    - 5) Roof Framing: Vertical deflection of 1/240 of the span under live/load load. Limit deflection under total load (dead + live/load) to 1/360 of the span.
- 4) Design framing systems to provide for movement of framing members without damage or overstress. Sheathing loads, wind loads, and seismic loads and/or other elemental effects when subjected to an ambient temperature change of not less than 120 degrees F.
- 5) Design framing system to maintain clearances at openings, to allow for construction tolerances, and to accommodate live load deflection of primary building structure as follows: Upward and downward movements.
- 6) Design exterior non-load bearing curtain wall framing to accommodate horizontal deflection without regard for contribution or sheathing materials.

A **Specialty Structural Engineer** is defined as a Professional Engineer licensed in the State of Indiana, not the Structural Engineer of Record, who performs Structural Engineering functions necessary for the structure to be completed and who has shown experience and/or training in this specific specialty.

It is the Specialty Structural Engineer's responsibility to review the Construction Drawings and Specifications to determine the appropriate scope of engineering.

When reviewing the Drawings and Specifications, the Specialty Structural Engineer (SSE) must obtain the following information from the Structural Engineer of Record (SEER) to perform his design and analysis. If the SSE determines there are details, features, or unanticipated project limits which conflict with the engineering requirements as described in the project documents, the SSE shall in a timely manner, contact the Structural Engineer of Record for resolution of conflicts.

It is the Specialty Structural Engineer (SSE) shall forward documents to the Structural Engineer of Record for review. Such documents shall bear the stamp of the SSE and include:

- A Specialty Structural Engineer is defined as a Professional Engineer licensed in the State of India, not the Structural Engineer of Record, who performs Structural Engineering functions necessary for the structure to be completed and who has shown experience and/or training in the specific specialty.
- The Specialty Structural Engineer shall be responsible for the following Construction Drawings and Specifications to determine the appropriate scope of engineering:
- It is the intent of the Drawings and Specifications to provide sufficient information for the Specialty Structural Engineer (SSE) to perform his design and analysis. If the SSE determines there are details, conditions or circumstances not shown or specified in the drawings and specifications as described in the project documents, the SSE shall in a timely manner, contact the Structural Engineer of Record for resolution of conflicts.
- The Specialty Structural Engineer (SSE) shall forward documents to the Structural Engineer of Record for review. Those documents shall bear the stamp of the SSE and include:
- Drawings indicating engineering input, such as defining the configuration or structural capacity of specialty components and/or their assembly into structural systems.
  - Calculations.
  - Computer printouts which are an acceptable substitute for manual calculations provided they are accompanied by specialty design assumptions and identified input and output information to permit their proper evaluation. This information shall bear the stamp of the Specialty Engineer as well as the Professional Engineer.

- 3 All steel metal fabrication, fabrication and installation shall conform to the Steel Deck Institute "SDI FORM SPECIFICATIONS" and "SDI CODE OF STANDARD PRACTICE," current edition, unless noted.
- 2. Provide minimum deck support at all of the following locations:
  - 3 All deck shall be provided in a minimum of 5-span lengths where possible.
  - 4 All welding of steel deck shall be in accordance with AWS Specification D3.1. Provide welding wherever the floor deck is less than 22 gauge in thickness.
  - 5 Mechanical fasteners may be used in lieu of welding, providing fasteners meet, or exceed the strength of specified welds. Submit fastener design data to the Structural Engineer of Record for review.
  - 6 Deck shall be installed in accordance with the Steel Deck Institute's "SDI CODE OF STANDARD PRACTICE," current edition, unless noted.
  - 7 Do not support any items, such as ductwork, mechanical and electrical fixtures, ceilings, etc. from steel deck.
  - 8 Roof deck fasteners shall be attached at ends of cantilevers and at a maximum spacing 12" o.c. from ends of cantilever roof deck ends. The roof deck must be able to support the loads and all of the sideclips above it until a load is applied to the cantilever.
  - 9 Submit shop drawing for review of general confirmation to design concept in accordance with the design intent. The shop drawing shall show type of deck, all supports and all access method of attachment, edge details, deck openings and reinforcement, and sequence of installation.
  - 10 Installation holes shall be sealed with a closure plate 2 gauge thicker than deck and mechanically fastened to the deck with 2" diameter bolts to be specified. Deck shall not be bent, warped, damaged or any other work which would impair the strength and appearance of the deck shall be removed from the site.
  - 11 Where cantilevers are indicated, supply plate (purlins) designed to meet, or exceed the gages listed in the SDI Purlinout Selection Table (pg. 18) as required for design, concrete weight, and cantilever distance, unless noted otherwise.
  - 12 Deck shall be delivered galvanized (galvalume) roof panels and joists with open metal and induced cantilever for deck bearing.

1. Typical beam-to-beam and beam-to-column connections shall be bearing type using A325 bolts, unless

- | WELD INSPECTION SCHEDULE     |      |     |      |    |     |                             |
|------------------------------|------|-----|------|----|-----|-----------------------------|
| WELD TYPE                    | VT   | MT  | UT   | PT | CRT | COMMENTS                    |
| FILLET (SINGLE PASS)         | 25%  | -   | -    | -  | -   | ROOT PASS AND FINISHED WELD |
| FILLET (MULTIPLE PASS)       | 50%  | 25% | -    | -  | -   |                             |
| FLARE BEVEL/<br>FLARE V      | 25%  | -   | -    | -  | -   |                             |
| GROOVE (PARTIAL PENETRATION) | 100% | -   | 100% | -  | -   | REFERENCE NOTE 'E' BELOW    |
| GROOVE (FULL PENETRATION)    | 100% | -   | 100% | -  | -   | ALL FULL PENETRATION WELDS  |

- UT = Ultrasonic Test; ASTM E164
- RT = Radiographic Test; ASTM E34 and ASTM E166, min. quality level 2/21.
- Acceptance standards in AWS D-1 shall be followed for each test procedure.
- Test procedures may be substituted to meet feasibility requirements of test based upon weld geometry or other factors with the approval of the Structural Engineer of Record.
- Samples shall cover a random locations; additional tests may be required at locations noted on the Drawings.
- Groove welds include square, bevel, V, U, and J grooves including single and double bevel types. Partial penetration square groove welds at all locations and partial tubular members do not require inspection.
- Weld Procedures Specifications (WPS) shall be produced and maintained in accordance with AWS D-1.
- The Independent Testing Agency shall have access to all WPS's during the course of testing and inspection.
- For high-strength welded joints, especially in thick plates and/or heavy structural shapes, details welds that show shrinkage occur as much as possible in the direction the weld was rolled. Refer to AWS Manual for preferred welded-joint arrangements that reduce the possibility for lamellar tearing.
- Members subjected to reactive high-strength connections shall be tested by the Independent Testing Agency by Ultrasonic. Requirements prior to commencing welding.
- In addition to inspection requirements for fillet welds in Table above, 100% of field welding of diagonal bracing members to gusset plates shall be visually inspected (VT).

1. All steel joists shall be designed, fabricated, and erected in accordance with SJI Standard Specifications.
2. Joist bridging (if shown) is schematically indicated. Provide all bridging necessary to conform to Specifications.
3. The ends of all bridging lines terminating at walls or beams shall be anchored to the wall or beam.
4. Joist bridging and connections shall be completely installed prior to placing any construction load on the joists. Construction loading shall not exceed the joist design load.
5. All roof piers shall be capable of resisting the net uplift a noted on the Structural Drawings (min. net). Provide an additional row of continuous horizontal bottom chord bridging at the first panel location at each end of all roof joists.

- A) Roof with supported eaves: L240
- B) Roof with suspended eaves: L360
- C) Floor: L360


9. Joists on column centerlines shall have extended bottom chords between the connections for erection stability, unless otherwise noted. Do not connect bottom chord extensions, unless otherwise noted or by other drawings.

10. Joists on, or near column centerlines shall have field-bolted connections for erection stability, unless otherwise noted.

11. The Joint Manufacturer shall coordinate with the Structural Steel Fabricator for the design of all connections to support columns, beams, bearing seats, etc., prior to submittal of shop drawings.

12. Where a joint is part of a moment-resisting frame, define the connection of the bottom chord to the column as a full depth, full length, full width, full depth gusset plate welded connection. In all resisting frames shall be inspected per AWS and AISC requirements.

13. The Joint Manufacturer shall furnish evidence that the peak moment or exceeds the specified minimum moment of inertia (I<sub>y</sub>) listed on the Plans. Where a minimum value is not specified, the specified minimum value shall be used to meet the specified strength and deflection criteria.

14. All steel joists shall be finished with standard SJS Camber, unless noted otherwise.

15. All items purchased from the joists such as catwalks, basketball goals, operation platforms, etc. shall be installed after all steel joists in roofing, floorings, etc. are installed.

16. All joists shall be shop primed in accordance with SJS requirements, unless otherwise noted. Cold chime structural steel primers, paint, and sealants shall be applied.

17. Provide sloped bearing stiffeners where joist stops exceeds 14" per foot.

18. Do not field cut or alter joists without the written approval of the Joint Manufacturer.

1. Refer to the Design Criteria notes for live load and handrail requirements.
2. All stair designs will be provided by the Stair Manufacturer/Fabricator's Specialty Structural Engineer and shall be stamped by a Professional Engineer registered in the State of Indiana. Stair designs shall be in accordance with all applicable code provisions of the IBC.
3. The Stair Manufacturer/Fabricator's Specialty Structural Engineer shall provide the Structural Engineer of Record with drawings showing location, direction and magnitudes of all stair load reactions on the building structure for approval, prior to fabrication.
4. The Stair Manufacturer/Fabricator shall coordinate the transition between the supported structural slab and the stair structure with the Structural Steel Fabricator, prior to fabrication.
5. Refer to the Architectural Drawings for stair width, rise, run, tread and riser geometry, handrail and guardrail design, shaft wall construction, etc.

1. The Contractor shall be responsible for complying with all safety precautions and regulations during the

- | MINIMUM COVER FOR REINFORCEMENT   |               |
|---|---------------|
|   | MINIMUM COVER |
| SUSPENDED SLABS AND JOISTS  |               |
| TOP & BOTTOM BARS FOR DRY CONDITIONS:   |               |
| #11 BARS & SMALLER  | 3/4"          |
| #14 & #16 BARS  | 1 1/2"        |
| FORMED CONCRETE SURFACES EXPOSED TO EARTH, WATER, OR WEATHER, AND OVER OR IN CONTACT WITH SEWAGE AND FOR BOTTOMS BEARING ON WORKMAN, OR SLABS SUPPORTING EARTH COVER. |               |
| #5 BARS & SMALLER   | 1 1/2"        |

|  |               |
|--|---------------|
| STIRRUPS, SPIRALS & TIES   | 1 1/2"        |
| PRINCIPAL REINFORCEMENT  | 2"            |
| EXPOSED TO EARTH, WATER, SEWAGE, OR WEATHER:   |               |
| STIRRUPS & TIES  | 2"            |
| PRINCIPAL REINFORCEMENT  | 2 1/2"        |
| WALLS  |               |
| FOR DRY CONDITIONS:  |               |
| #11 BARS & SMALLER   | 3/4"          |
| #14 & #18 BARS   | 1 1/2"        |
| FORMED CONCRETE SURFACES EXPOSED TO EARTH, WATER, SEWAGE, WEATHER, OR IN CONTACT WITH GROUND |               |
| FOOTINGS & BASE SLABS  |               |
| AT FORMED SURFACES & BOTTOMS BEARING ON CONCRETE WORK MAT                                    | 2"            |
| AT UNFORMED SURFACES & BOTTOMS IN CONTACT WITH EARTH   | 3"            |
| TOP OF FOOTINGS  | SAME AS SLABS |
| OVER TOP OF PILES  | 2"            |

1. All reinforcing steel and threaded rod anchors to be installed in a 2-part chemical anchoring system shall be tested as follows:
  - A. Drill holes larger than bar or rod to be embedded. Coordinate hole diameter with Manufacturer's recommendations.
  - B. Holes must be cleaned and prepared in accordance with Manufacturer's recommendations.
  - C. When reinforcing steel is encountered during drilling for installation of anchors, stop drilling, use sensor to locate the reinforcing in the surrounding area and install anchor(s) as close as possible to original location. Contact the Structural Engineer of Record (SER) for direction when the reinforcement is more than 2" from the original location, or when the original location of the reinforcement is significantly altered. When in doubt, contact the SER for direction.

1. **DESIGN STANDARDS:** The intended design standards and/or criteria are as follows:

- | DESIGN STANDARDS  |   |                                 |  |
|---|---|---------------------------------|--|
| General   |   |                                 |  |
|   | The intended design standards and/or codes are as follows:                                      |                                 |  |
|   | The 2014 Indiana Building Code (2012 International Building Code (IBC) with Indiana Amendments) |                                 |  |
| Concrete  |   |                                 |  |
| Massing   | ACI 318   |                                 |  |
| Steel   | ACSC Manual, Allowable Stress Design (ASD)  |                                 |  |
| Slabs/Joists/Girders  | ACI 318   |                                 |  |
| Steel Deck  | Steel Deck Institute  |                                 |  |
| Cold Formed Metal   | ASD   |                                 |  |
| Wood Framing  | NDS   |                                 |  |
| Wood Trusses  | Timber  |                                 |  |
| Glass/Clam Contribution   |   |                                 |  |
|   | ASCE 7  |                                 |  |
| The following design standards and codes are used as ASTM numbers, are for the editions of the publications referenced in the Building Code listed above, unless otherwise noted.   |   |                                 |  |
| GC01: Gravity Loads. Gravity Dead loads in the design of the structure are as computed for the materials incorporated into the building, and shall not be limited to loads for floors, ceilings, walls, fixed partitions, fixtures, and other similar architectural and structural items, as well as for equipment, piping, ductwork, and furniture, and material handling and device service equipment, including the weight of cranes.                                      |   |                                 |  |
| LIVE LOADS: Gravity live loads used in the design of the structure meet, or exceed the following table (BC-2012, 1601.7):   |   |                                 |  |
| OCCUPANCY OR USE  | UNIFORM (PSF)   | CONCENTRATED (LB)<br>[Point #1] |  |
| A. Classrooms   | 40  |                                 |  |
| 1. Stairs   | 100   |                                 |  |
| 2. Floor Corridors  | 40  |                                 |  |
| 3. Corridors Above First Floor  | 80  |                                 |  |
| Note #1: Unless otherwise noted, the concentrated load has been assumed to be a single point load distributed over an area of 3' x 3'.  |   |                                 |  |
| LIVE LOAD REDUCTION: Live load reductions in accordance with BC-1607.9 have been used with the following exceptions:  |   |                                 |  |
| A. Heavy live loads in excess of 100 PSF have not been reduced except for members supporting 2 or more floors have been reduced by a maximum of 20%.  |   |                                 |  |
| B. Live load in passenger cars and other vehicles has not been reduced except for members supporting 2 or more floors have been reduced by a maximum of 20%.  |   |                                 |  |
| C. Live loads of 100 PSF or less in public assembly occupancies have not been reduced.  |   |                                 |  |
| D. Live load for roof members has not been reduced.   |   |                                 |  |
| E. Live loads for the design of one-way slabs have not been reduced.  |   |                                 |  |
| PARTITION ALLOWANCE: A uniform partition allowance of 15 PSF has been used in accordance with the following:  |   |                                 |  |
| A. Live load partitions located in addition to the specified live loads in addition to 10 PSF for COLLECTOR LOADS. Unless otherwise noted, a minimum uniform collector load of 10 PSF has been used in addition to the specified live loads.  |   |                                 |  |
| B. Live load partitions located in addition to the specified live loads in addition to 10 PSF for weight of mechanical units, larger piping (greater than 4" diameter) and suspended fixtures or equipment that have been specifically accounted for in the design.   |   |                                 |  |
| C. LIVE LOADS IN ADDITION TO SPECIFIED LIVE LOADS: Minimum Uniform Allowance: A minimum uniform load of 20 PSF has been used to account for large ductwork, sprinkler mains, concentrations of piping and electrical distribution above corridors and mechanical rooms. The collector loads in addition to the specified live loads, and larger piping, ductwork, and mechanical and suspended fixtures or equipment that have been specifically accounted for in the design. |   |                                 |  |
| D. CONCENTRATED LOADS:  |   |                                 |  |
| A. Live loads of the lower chord of exposed roof trusses or any point along the primary structural members supporting roofs over manufacturing, commercial storage and warehousing, and commercial garage floors that be capable of carrying a suspended concentrated load of not less than 2000 lbs. shall be used.  |   |                                 |  |
| B. All single panel points of the lower chord of exposed roof trusses or any point along the primary structural members over all other buildings shall be capable of carrying a single concentrated load of not less than 2000 lbs. shall be used in addition to dead load, and except for a single   |   |                                 |  |

4. Displacement, either from cold-chamber tests for sulfate and/or the freeze-thaw test, shall have no effect on the test results.

1. Reinforcement other than cold drawn wire for spirals and welded wire fabric, shall have deformation markings on the surface.
2. Reinforcing steel shall conform to ASTM A618, Grade 60.
3. Welded wire fabric shall conform to ASTM A954, welded.
4. Where laps are indicated on drawings, lap length shall be 48" for CRCS for all bars unless other hook dimensions are shown on the plans and be continuous.
5. Where bars are not noted otherwise, lap length shall be 48".
6. Reinforcement shall be stored and secured against displacement in accordance with the CRSI Manual of Standard Practice.
7. Reinforcement shall be fabricated and placement shall conform to ACI 315 Details and Detailing of Concrete Reinforcement and ACI 315R Manual of Engineering and Placing Drawings for Reinforced Concrete Structures, unless otherwise indicated.
8. Reinforcement shall be placed in the formwork in the following order: walls and sills; walls, where possible, and where bar spacing will not exceed 15 times the nominal spacing. Discontinue bars at all lap openings where necessary, and provide areas of reinforcement, equal to the interrupted bars, in the remaining wall length.
9. Reinforcement shall be placed in the formwork in the following order: top of wall opening and temperature reinforcement, lateral design, and (2) #5 in both dimensions + 4" on each side of the opening. Provide #5 + 4" long interrupted bars in opening, each, at corner of openings.
10. Provide standards for the support of top reinforcement for footings, pile caps, and slabs.
11. Provide individual high chairs with top bars, as required for the support of top reinforcement.
12. Provide standards for the support of bottom reinforcement.
13. Provide snap-on plastic sheets where to maintain required concrete cover for the vertical wall reinforcement.
14. Where shown on column footings, provide dowels for the wall. Dowels shall be same size and spacing as the vertical wall reinforcement, unless footings otherwise, with lap splice as shown on the application sheets. Install dowels in the footing forms before concrete is placed. Do NOT show dowels and stirrups after concrete is placed.
15. Field bending of reinforcing steel is prohibited, unless noted on drawings.
16. Reinforcement shall conform over reinforcing steel shall be as follows, unless noted otherwise on plan section or note.

The Contractor shall coordinate and check all dimensions relating to Architectural Finishes, mechanical equipment and openings, elevator shafts and overruns, etc. and notify the Architect/Engineer of any discrepancies before proceeding with any work in the area under question.

The Contractor shall be responsible for obtaining all necessary permits, codes, rules, regulations and Specifications. The Contractor shall verify the requirements of their trades as to sizes, classes, ranges, materials, anchors, and other items to be placed or cut in the Structural Work.

Do not make any vertical or horizontal sleeve holes, or holes cut or drilled in any beam or column unless approved by the Structural Engineer in writing in the Structural Engineer of Record.

Mechanical and electrical openings through supported slabs and walls. If diameter is larger than the Structural Drawings must be approved by the Structural Engineer of Record (SER). Openings less than 12" shall be drilled at least 1'-2" below the top of the slab.

Verify locations and sizes of all mechanical and electrical openings, unless approved in writing by the Structural Engineer of Record.

Do not cut through the Structural Drawings with the Mechanical and Electrical openings and walls down on the Structural Drawings.

Do not install conduit in supported slabs, slates on grade, or concrete walls unless explicitly shown or approved on the Structural Drawings.

Do not cut through any items, such as ductwork, mechanical/electrical conduits, ceilings, etc. from steel roof deck or roof steel sheathing.

The Mechanical Contractor shall verify that mechanical units supported by the steel framing are capable of spanning the distance between the most supporting members indicated on the Structural Drawings.

Do not cut through any items, such as ductwork, mechanical/electrical conduits, ceilings, etc. from steel roof deck or roof steel sheathing.

Drawings and specifications are in conflict, the most stringent restrictions and requirements shall govern.

The Contractor shall verify field the dimensions, elevations, etc. necessary for the proper construction and alignment of the new portions of the work to the existing work. The Contractor shall make all necessary measurements for fabrication and erection of the structural members. Any discrepancy shall be immediately brought to the attention of the Structural Engineer of Record.

Before proceeding with any work within the existing facility, the Contractor shall familiarize himself with existing structure and other conditions. Any showing shown or noted on the Plans is a part of the information furnished to the Contractor. The Contractor shall be responsible to provide all necessary bracing, shoring, and other safeguards to maintain all parts of the work in a safe condition during the process of demolition and construction, and to protect from damage those portions of the existing work which are to remain. Shoring shall be in place until the structure work is complete, has been approved by the Testing Agency, and is certified by the Testing Agency as safe to remove without Contractor's responsibility.

The Contractor shall be responsible for the safety of all persons on the project. This responsibility includes, but not limited to, plans, sections, details, notes, description of proposed sequence of work, or calculations prepared by, or under the supervision of a Specialty Structural Engineer (SSE). The SSE is registered in the State where the project is located.

Workers and visitors entering the working areas must wear hard hats and safety glasses.

Profiled slabs on grade areas with a medium-weight or other suitable equipment to check for pockets of soft material hidden beneath a thin crust of better soil. Any unsuitable materials must be exposed and removed or replaced with compacted, engineered fill as outlined in the Specifications. Profiled operations shall be monitored by the Geotechnical Testing Agency.

All engineered fill beneath slabs and over footings should be compacted to a dry density of at least 95% (ASTM D 1557) and all compacted fill beneath slabs and over footings should be compacted to a dry density of at least 95% (ASTM D 1557). The maximum allowable void ratio for the fill shall be 0.95. The maximum allowable moisture content shall be approved granular materials compacted to a dry density of at least 95% (ASTM D 1557). Coordinate all fill and compaction operations with the Specifications and the Subsurface Investigation.

Compaction shall be accomplished by placing fill in approximate 8" lifts and mechanically compacting each lift to at least the specified minimum dry density. For large areas of fill, field density tests shall be performed at 3,000 square feet of building area for each lift as necessary to insure adequate compaction is being achieved.

8. Bracing: Providing stability against unintended movement or motion.
9. Building Component Safety Information (BCSI): The jointly produced WTCA/TCI "Guide to Good Practice for Handling, Installing, and Bracing of Metal Plate Connected Wood Trusses".
10. Building Component Safety Information (BCSI): The jointly produced WTCA/TCI "Guide to Good Practice for Handling, Installing, and Bracing of Metal Plate Connected Wood Trusses".
11. Building Structural System: The completed combination of Structural Elements, trusses, connections and systems, which serve to support the building's self weight, the applicable live loads, and environmental loads such as wind, snow, and seismic loads.
12. Building Structural System Design Documents: Written, graphic and pictorial architectural design documents, specifications and addenda prepared and assembled for the overall structural design of a building Structural System, which may change over time, until and after construction.
13. Ceiling Designation: The horizontal or sloped structural system defined by the ceiling plane acting to transfer lateral forces to vertical resisting elements.
14. Critical Nail: A nail selected to be longer than the member it is driven through and which is sent back to the manufacturer to access length.
15. Connectors and Connections: Fasteners that join two or more members together, including nails, metal plates or truss plates, truss and joist hangers, screws, and bolts.
16. Construction Documents: Written, graphic and pictorial documents prepared or assembled for describing the design, location and character of the building and its components, including architectural, structural, mechanical, electrical, and plumbing drawings and specifications.
17. Construction Loading: The loads from workers and building materials on an unframed structure, for example, when building studs hundreds of feet overhead or gypsom board on trusses for temporary storage.
18. Continuous Lateral Bracing: Members installed at right angles to or in the plane of a member's truss to resist lateral movement. The members are placed in the plane of the member's truss to resist the loads from workers and the accumulation of buckling forces. See Lateral Bracing.

- Structural steel construction shall conform to the American Institute of Steel Construction (AISC) Specification for Structural Steel Buildings.
- 2. All structural wide flange members shall be ASTM A992, Fy=50 ksi
- 3. All plates, channels, bars, angles and rods shall be ASTM A36, Fy=50 ksi
- 4. All structural steel members shall be ASTM A572, Fy=50 ksi or Fy=58 ksi unless noted.
- 5. All round structural tube members shall be ASTM A513, Grade C, Fy=48 ksi unless noted.
- 6. All structural pipe members shall be ASTM A453 Grade B, Fy=58 ksi unless noted.
- 7. Details of design, fabrication and erection of all structural steel shall be in accordance with AISC Standards, unless otherwise specified.
- 8. Provide temporary erection guying and bracing as required.
- 9. Unless otherwise noted or noted on the Drawings, provide 100% minimum bearing each end for all loose end connections.
- 10. For tension lines, masonry shelf angles and other items generally not shown on the Structural Drawings, refer to the Architectural Drawings. See general notes on linings for their sizes, types, and details.
- 11. Steel columns below grade shall be encased in a minimum of 4" concrete per panel with 2 coats of epoxy/paint, unless otherwise shown.
- 12. Fabricate encasements and provide epoxy noted to receive camber to shift after erection, any minor camber due to rolling or shop assembly as required.
- 13. Refer to the Division 5 Structural Steel Specification of the Project Manual for structural steel details.
- 14. The Erector shall install panels parallel to rods and joints with differential mill and prime cambers to level deck bearing.
- 15. Provide 100% minimum plate to deck offset, open ends for all tubular members, unless noted. See wall with partial penetration groove welds for watertight condition.

### CAST-IN-PLACE CONCRETE

- ## REPAIRS TO CAST-IN PLACE CONCRETE
- Details of fabrication or reinforcement, handling and placing of the concrete, construction of form placement and removal must comply with the provisions of ACI 308 Specifications, as well as the ACI Code requirements of the latest revised date.
- A cold water concrete shall be in accordance with ASTM C639. Cold weather is defined as a period where there is a successive 3-day average temperature below 40°F, or more below 40°F and below 50°F. The Contractor shall maintain a cure of this publication site.
- Hot weather concreting shall be in accordance with ACI 308. Hot weather is defined as any time during which following conditions that leads to concrete curing too heavily under the specified concrete: high ambient temperature, high concrete temperature, low relative humidity, wind speed greater than 10 mph. The Contractor shall maintain a cure of this publication on site.
- The Contractor shall also adhere to the following specifications: standard testing including measurement of sun, air, temperature, concrete cylinder testing, etc. to ensure conformance with Contract Documents. Submit reports to Architect/Engineer.
- Successful bidders are expected to provide all the above mentioned documents have been completed, a final finish as indicated below, and as described in Division 3 Part I Place Concrete Section of the Project Manual.
- |   |                    |
|---|--------------------|
| A. Floor Slabs  | Hard Finish        |
| B. Chases & Sidelights  | Brush Finish       |
| C. Surfaces to Receive Topping Slab   | Form Finish        |
| D. Surfaces to receive direct-mortar<br>beds or other cementitious treatments | Float Finish       |
| E. Ceiling Surfaces   | Rough Split Finish |
- Sample Finishes: See Specifications for sample and mockup requirements, if any.
- For Tolerances: See the Specifications for specified F and V tolerances. Final F and P testing shall performed by the Testing Agency according with ASTM E-115, Results, including accuracy verification will be provided to the project engineer at least 7 days prior to start of work. At 48-hour cure delay. Remedies for out-of-tolerance work shall be in accordance with the Specification. When approved by the Structural Engineer of Record, measurement of the gage obtained a 104-hour cure delay may be used in the F and P Testing. Approval must be obtained with written beginning of construction.
- F. Finishing of Formwork: Finish formed surfaces as indicated below, and as described in Division 3 Part I Place Concrete Section of the Project Manual:
- |  |                    |
|--|--------------------|
| A. Side of Footings & Pipe Caps        | Rough Form Finish  |
| B. Side of Grade Beams                 | Rough Form Finish  |
| C. Surfaces not exposed to public view | Rough Form Finish  |
| D. Surfaces exposed to public view     | Smooth Form Finish |
- The Contractor shall consult with the Structural Engineer of Record before starting concrete work establish a scheduling/placing schedule and to determine the location of construction joints so minimize the effects of shrinkage in the floor system.
- G. Shrinkage Control: Contraction Joints shall be placed in slabs on grade. For a framed slab, joints shall be located on all column lines. If the column spacing exceeds 20'-0" provide perimeter joints. Exterior sills, and interior sills without columns shall have joints spanning a maximum of 10'-0". All exterior walls shall have maximum joint spans into side of slabs of 10'-0" (does not exceed wall height).
- H. Where vinyl composition tiles, vinyl sheet goods, thin-set epoxy toppings, or other similar material specified finish floor material, the Contractor shall coordinate the locations of contraction joints with the Finish Contractor. Submit a dimensioned plan showing joint locations and proposed sequence of four pours.
- I. Unless specifically noted on the Plans, composite and non-composite supported slabs on metal deck shall require in-place concrete curing compound.
- J. Joint sealants to finished a smooth face may remain unfilled, unless required by the finish contractor. All exposed slabs shall be filled with sealant specified in Division 7, or as follows: All industrial, manufacturing, or warehouse applications subject to wheeled traffic shall be filled with polyurethane sealant. All other applications shall be filled with polysulfide sealant. Delay filling is allowed for a definite period, preferably a minimum of 4 to 6 weeks after the slabs have been cured. Prior to the end of this period, the joints, if filled in accordance with the manufacturer's recommendation, shall be removed from the job.

|  |               |
|--|---------------|
| FOOTINGS, FOUNDATION WALLS, PIERS, & GRADE BEAMS             |               |
| COMPRESSIVE STRENGTH   | 4000 PSI      |
| MAXIMUM WATER/CEMENT RATIO                                   | 0.45          |
| AIR CONTENT  | 0 - 3 PERCENT |
| WATER-REDUCING ADMIXTURE                                     | REQUIRED      |
| SLUMP  | 5" TO 6 1/2"  |
| INTERIOR CONCRETE SLABS                                      |               |
| COMPRESSIVE STRENGTH   | 4000 PSI      |
| MINIMUM CEMENTITIOUS MATERIAL CONTENT                        | 514 LB/CU YD  |
| AIR CONTENT  | 0 - 3 PERCENT |
| WATER-REDUCING ADMIXTURE                                     | REQUIRED      |
| SLUMP  | 5" TO 6 1/2"  |
| PROVIDE ELEMENT 5 SYSTEM (INTERNAL CURE & CATALYST) PER PLAN |               |
| NOTE ON FOUNDATION PLAN                                      |               |
| EXTERIOR CONCRETE SUBJECT TO FREEZE-THAW                     |               |
| COMPRESSIVE STRENGTH   | 4500 PSI      |
| MINIMUM CEMENTITIOUS MATERIAL CONTENT                        | 564 LB/CU YD  |
| AIR CONTENT  | 6 ± 1 PERCENT |
| WATER-REDUCING ADMIXTURE                                     | REQUIRED      |
| SLUMP  | 5" TO 6 1/2"  |
| COARSE AGGREGATE   | CRUSHED STONE |

PROJECT

**WESTCHESTER  
INTERMEDIATE  
SCHOOL -  
ADDITIONS &  
RENOVATIONS**

DUNELAND SCHOOL CORPORATION  
CHESTERTON, INDIANA

9102 N. Meridian St., Ste. 300  
Indianapolis, IN 46260  
Homepage [www.GibraltarDesign.com](http://www.GibraltarDesign.com)  
Email [info@GibraltarDesign.com](mailto:info@GibraltarDesign.com)  
Phone 317.580.5777 Fax 317.580.5778

DATE  
3-3-2022  
COORDINATED BY  
JMS  
DRAWN BY  
JMS  
CHECKED BY  
SAC

SCOTT CLORE  
REGISTERED  
PE10606154  
STATE OF  
INDIANA  
PROFESSIONAL ENGINEER  
*SAC*

THE CONCEPTS, DESIGNS, PLANS, DETAILS, ETC., SHOWN ON THIS DOCUMENT ARE THE PROPERTY OF GIBRALTAR DESIGN AND WERE CREATED FOR USE ON THIS SPECIFIC PROJECT. NONE OF THIS INFORMATION SHALL BE USED BY ANY PERSON OR FIRM FOR ANY PURPOSE WITHOUT THE EXPRESS WRITTEN CONSENT OF GIBRALTAR DESIGN. THE OWNER MAY RETAIN COPIES FOR INFORMATION AND REFERENCE IN CONNECTION ONLY WITH THIS PROJECT.

[illegible][illegible]

|                  |  |
|------------------|--|
| STRUCTURAL NOTES |  |
| PROJECT          | WESTCHESTER IS - ADDITIONS & RENOVATIONS |





WESTCHESTER  
INTERMEDIATE  
SCHOOL -  
ADDITIONS &  
RENOVATIONS

| WALL FOOTING SCHEDULE |              |       |                     |                       |
|-----------------------|--------------|-------|---------------------|-----------------------|
| FTG.                  | FOOTING SIZE |       | FOOTING REINFORCING |                       |
| MARK                  | WIDTH        | DEPTH | LONGITUDINAL        | TRANSVERSE            |
| WF24                  | 2'-0"        | 1'-0" | (2) #5 x CONTINUOUS | #4 x 1'-6" @ 96" O.C. |
| WF30                  | 2'-6"        | 1'-2" | (3) #5 x CONTINUOUS | #4 x 2'-0" @ 96" O.C. |
| WF40                  | 3'-6"        | 1'-2" | (4) #5 x CONTINUOUS | #5 x 3'-0" @ 12" O.C. |

1. CENTER FOOTINGS BENEATH WALLS, U.O.C.

1. REFER: S301 FOR STRUCTURAL NOTATIONS, DESIGN DATA & SCHEDULES
2. ALL FOUNDATIONS ARE REQUIRED TO COORDINATE THEIR WORK WITH ALL DISCIPLINES TO AVOID CONFLICTS. THE MECHANICAL, ELECTRICAL, AND PLUMBING ASPECTS ARE NOT THE SCOPE OF THESE DRAWINGS. THEREFORE, ALL REQUIRED MATERIALS AND WORKMANSHIP ARE NOT INDICATED.
3. COORDINATE EXACT SITE & LOCATION OF ALL MECHANICAL OPENINGS IN FOUNDATION WALLS WITH THE MECHANICAL, ELECTRICAL & PLUMBING CONTRACTORS
4. ALL ELEVATIONS ARE REFERENCED FROM THE FIRST FLOOR FINISH FLOOR ELEVATION OF 0 (+0.05) S.M.F. REFER: CIV.DWG.
5. REFER ARCH. DRAWINGS FOR ALL DIMENSIONS NOT SHOWN. CONTRACTOR SHALL VERIFY ALL DIMENSIONS PRIOR TO CONSTRUCTION AND IMMEDIATELY NOTIFY ARCHITECT/ENGINEER OF ANY DISCREPANCIES.
6. REFER S400 & S401 FOR TYPICAL FOUNDATION DETAILS.
7. NOTE: PERIMETER WALL & FOUNDATION SLAB SHALL BE LOWERED AND/OR SLEVED TO ACCOMMODATE DRIVING LINES (I.E. SANITARY & AIR STOP/STOPS), WATER LINES (E.T.) SHOWN ON THE PLUMBING DRAWINGS. PROVIDE FOOTING STEPS AS REQUIRED PER THE TYPICAL DETAILS S400.
8. PROVIDE REINFORCING BARS TO BE LOCATED PER THE ARCHITECTURAL DRAWINGS. COORDINATE DEPTHS OF ALL SLAB RECESSES WITH THE ARCHITECTURAL DRAWINGS, AND THE FINISH SURFACE.
9. COORDINATE REINFORCING DOVELS FOR CMU VERTICAL REINFORCING WITH REIN. NOTES ON CMU PARTS & SECTIONS.
10. GROUP ALL CORES OF CMU BELOW FINISH FLOOR SLID.
11. COLLUM FOOTINGS SUPPORTING MORE THAN ONE COLLUM SHALL BE CENTERED AT THE MIDPOINT BETWEEN THE COLLUMS, UNLESS NOTED OTHERWISE ON PLAN.
12. FOUNDATIONS, TRENCH FOOTINGS AND WALL FOOTINGS SHALL BE APPROVED TO SUPPORT ALL SUELTS TO SUITABLE BEARING MATERIALS, AS DETERMINED BY THE GEOLOGICAL, TESTING AGENCY. REFER: TYPICAL FOOTING UNDERCUT DETAILS S400. UNDERCUTTING TO SUITABLE BEAR. MATERIAL IS NOT REQUIRED FOR GRADE BEAMS. REINFORCING IS REQUIRED IN BEARING COLUMNS TO PROVIDE APPROXIMATE ELEVATION TO SUITABLE BEARING STRATA TO BE USED FOR BIDDING PURPOSES.
13. PROVIDE CONTROL JOINTS @ 8' x 8' V. V. CURBES CONCRETE CURB ON ACROUSTIC ISOLATION SLABS IN MECHANICAL ROOMS. VARIES TO SURROUND ALL PENETRATIONS THRU SLAB INCLUDING COLLUMS, PUMPS, SUMP PITS, ETC.
14. ALL EX. CONSTRUCTION SHOWN IN PLAN AND ANNOTATION WAS DERIVED FROM EXISTING TOPOGRAPHY. ALL EX. CONSTRUCTION IS TO BE REFINED TO RESIDE WITH THE THICKENED BETWEEN INFO. SHOWN ON THE DRAWINGS AND ACTUAL CONDITIONS IMMEDIATELY CONTACT ARCHITECT/ENGINEER FOR DIRECTION BEFORE PROCEEDING WITH THE WORK.
15. PROVIDE THICKENED SLAB UNDER ALL INTERIOR CMU WALLS WITHOUT FOOTINGS. SEE DETAILS ON S400 FOR THICKENED SLAB DETAIL. WALL THICKENED SLABS ON DIMENSIONS ON THE ARCHITECTURE PLAN.
16. PROVIDE CONTROL/CONTRACT JOINTS IN SLABS ON GRADE (REFER THE TYPICAL DETAIL S400). PROVIDE CONTROL JOINTS TO RESIDE WITH THE THICKENED (TERRAZZO, CERAMIC OR PORCELAIN TILE, VINYL-COMPOSITE TILE (VCT) OR VINYL SHEET GOODS, EPoxy OR SIMILAR THIN-FILM FINISH FLOORING) SHALL BE CAREFULLY COORDINATED WITH THE PLUMBING CONTRACTOR. PROVIDE CONTROL JOINTS TO RESIDE WITH SLAB JOINT LAYOUT TO ARCHITECT/ENGINEER FOR REVIEW PRIOR TO PLACING SLABS.
17. WHERE SPERS OCCUR WITHIN A LARGER ARCH. PLASTER OR CMU SLAB ENCLOSEMENT (FOR EG. P24s WITH 40' SQUARE CANOPY PLASTER) PROVIDE PER REIN. CAGE CENTERED ON THE GRID INTERSECTION. FORM OVERALL PER TO PROFILE OF THE ARCHITECTURAL DRAWINGS. PROVIDE REINFORCING BARS TO BE LOCATED PER DIMENSIONS ON THE ARCHITECTURAL PLANS & DETAILS.
18. FOR ARCHITECTURAL PLASTER NOT SUPPORTING SUELT COLLUMS, CONSTRUCT AS FULLY-GROUTED MASONRY SPERS OR CAST-IN-PLACE CONCRETE SPERS PERIN W/ IS VERTICAL REINFORCING AT 2' O.C. ALL PLACES. AT CONTRACTORS OPTION.
19. AT ALL LOCATIONS WHERE NEW FOOTINGS ARE TO BE INSTALLED IN EXISTING SPACES, THE EXISTING CONCRETE SHALL BE REMOVED TO EXPOSE THE EXISTING FOOTING. ALL FOOTINGS ARE TO BE REMOVED TO EXISTING PER DETAIL S401.

F.F. DENOTES FINISH FLOOR

T/X DENOTES TOP OF FTG. GRADE BEAM, SLAB, PIER, ETC.

B/X DENOTES BOTTOM OF FTG. GRADE BEAM, ETC.

C.J. DENOTES SLAB ON GRADE CONTROL/CONTRACTION JOINT

WFO-30'-0" DENOTES NEW FOOTING MARK 30' TOP OF FOOTING ELEVATION (SEE WALL FOOTING SCHEDULE)

S1 DENOTES NEW 1" CONC. SLAB W/ "FIBERCONCRETE 300" FIBERS @ 15 LB/CY. (OR EQUAL) &  
E5 INTERNAL CURVE ADMITTURE @ 4' DOWN &  
E5 CATALYST SPRAYED ON BETWEEN 300' & 1000' SFICAL OVER 15"ML VAPOR BARRIER OVER F COMPACTED GRANULAR FILL, NO. 55 STONE OR APPROVED EQUIVALENT), T/CING = 0'-0" U.N.O.

S2 DENOTES NEW 1" CONC. SLAB W/ NEW CONC. SLAB W/ 6" W2W3W2W3 W/F &  
E5 INTERNAL CURVE ADMITTURE @ 4' DOWN &  
E5 CATALYST SPRAYED ON BETWEEN 300' & 1000' SFICAL OVER 15"ML VAPOR BARRIER OVER F COMPACTED GRANULAR FILL, NO. 55 STONE OR APPROVED EQUIVALENT), T/CING = 0'-0" U.N.O.

S3 DENOTES NEW 4" CONC. SLAB W/ "FIBERCONCRETE 300" FIBERS @ 15 LB/CY. (OR EQUAL) OVER 15"ML VAPOR BARRIER T/CING = MATCH EXISTING

S4 DENOTES EXISTING SLAB ON GRADE

Denotes PIPE PENETRATION THROUGH FOUNDATION WALL COORDINATE EXACT LOCATION & INVERT ELEVATION W/ APPROPRIATE TRADE. LOWER BOTTOM OF FOOTING & PROVIDE SLEEVE THROUGH FOUNDATION WALL PER TYPICAL DETAIL ON S400

Denotes WALL FOOTING WITH STEPS, REF. TYP. DETAIL ON S400

| FOOTING MARK | FOOTING SIZE |        |        | REINFORCING (EACH WAY) |
|--------------|--------------|--------|--------|------------------------|
|              | WIDTH        | LENGTH | DEPTH  |                        |
| F3.0         | 3'-0"        | 3'-0"  | 1'-2"  | (4) #5 x 2'-6"         |
| F4.0         | 4'-0"        | 4'-0"  | 1'-2"  | (4) #5 x 3'-6"         |
| F5.0         | 5'-0"        | 5'-0"  | 1'-2"  | (5) #5 x 4'-6"         |
| F6.0         | 6'-0"        | 6'-0"  | 1'-2"  | (6) #5 x 5'-6"         |
| F7.0         | 7'-0"        | 7'-0"  | 1'-2"  | (7) #5 x 6'-6"         |
| F8.0         | 8'-0"        | 8'-0"  | 1'-2"  | (7) #6 x 7'-6"         |
| F12.0        | 12'-0"       | 12'-0" | 1'-10" | (10) #7 x 11'-6"       |
| F13.0        | 13'-0"       | 13'-0" | 2'-0"  | (12) #7 x 12'-6"       |

1. CENTER FOOTINGS BENEATH COLUMNS, U.N.O.
2. ALL FOOTINGS MUST BE BOARD-FORMED, UNLESS APPROVED.
3. INCREASE FOOTING DEPTH WHERE REQ'D TO ENCASE COLUMN ANCHOR RODS

Diagram illustrating the layout of a rectangular floor slab. The slab is divided into sections by beams. Labels include "DEPTH PER SCHED." for the slab thickness, "F.F." for finished floor, "LENGTH PER SCHED." for the slab length, and "WIDTH PER SCHED." for the slab width. Arrows point to "SEE NOTE #3" and "SEE NOTE #2".

GIBRALTAR DESIGN

9102 N. Meridian St., Ste. 300  
Indianapolis, IN 46260  
Homepage [www.GibraltarDesign.com](http://www.GibraltarDesign.com)  
Email [info@GibraltarDesign.com](mailto:info@GibraltarDesign.com)  
Phone 317.580.5777 Fax 317.580.5778

|                       |  |
|-----------------------|--|
| PROJECT<br>21116      |  |
| DATE<br>3-3-2022      |  |
| COORDINATED BY<br>JMS |  |
| DRAWN BY<br>JMS       |  |
| CHECKED BY<br>SAC     |  |

**COPYRIGHT NOTICE:**  
THE CONCEPTS, DESIGNS, PLANS, DETAILS, ETC., SHOWN ON THIS DOCUMENT ARE THE PROPERTY OF GIBALDAR DESIGN AND WERE CREATED FOR USE ON THIS SPECIFIC PROJECT. NONE OF THIS INFORMATION SHALL BE USED BY ANY PERSON OR FIRM FOR ANY PURPOSE WITHOUT THE EXPRESS WRITTEN CONSENT OF GIBALDAR DESIGN. THE OWNER MAY RETAIN COPIES FOR INFORMATION AND REFERENCE IN CONNECTION ONLY WITH THIS PROJECT.

[illegible]

PROJECT  
WESTCHESTER IS - ADDITIONS &  
RENOVATIONS

SHEET

|   |      |
|---|------|
| E | S103 |
|---|------|

**1** FOUNDATION PLAN - UNIT E  
1/8" = 1'-0"




**GIBALTAR**  
DESIGN  
ARCHITECTURE • ENGINEERING • INTERIOR DESIGN

PROJECT

**WESTCHESTER  
INTERMEDIATE  
SCHOOL -  
ADDITIONS &  
RENOVATIONS**

DUNELAND SCHOOL CORPORATION  
CHESTERTON, INDIANA

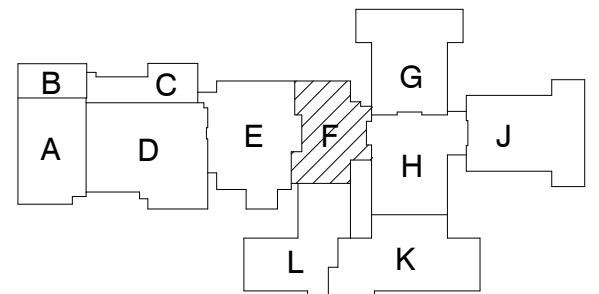

KEY PLAN

**GIBALTAR DESIGN**

9102 N. Meridian St., Ste. 300  
Indianapolis, IN 46260  
Homepage: www.GibraltarDesign.com  
Email: info@GibraltarDesign.com  
Phone: 317.580.5777 Fax: 317.580.5778

PROJECT

21116

DATE

3-3-2022

COORDINATED BY

JMS

DRAWN BY

JMS

CHECKED BY

SAC



CONTRACT NOTICE:  
THE CONCEPTS, DESIGN, PLANS, DETAILS, ETC. SHOWN ON THIS DOCUMENT ARE THE PROPERTY OF GIBALTAR DESIGN AND WERE CREATED FOR USE ON THIS SPECIFIC PROJECT. NONE OF THIS INFORMATION SHALL BE USED BY ANY PERSON OR FIRM FOR ANY PURPOSE WITHOUT THE EXPRESS WRITTEN CONSENT OF GIBALTAR DESIGN. THE OWNER MAY RETAIN COPIES FOR INFORMATION AND REFERENCE IN CONNECTION ONLY WITH THIS PROJECT.

REVISIONS

MARK DATE ISSUED FOR

AD-0.1 3/16/2022 ADDENDUM #1

DRAWING

FOUNDATION PLAN - UNIT F

PROJECT

WESTCHESTER IS - ADDITIONS &  
RENOVATIONS

© GIBALTAR DESIGN

SHEET

F

S104

### CONCRETE PIER SCHEDULE

| PIER MARK | PIER SIZE     | PIER REINFORCING |                              |        |                 |
|-----------|---------------|------------------|------------------------------|--------|-----------------|
|           |               | VERTICALS        | TIES-SIZE & SPA <sup>1</sup> | DETAIL | CRITICAL HEIGHT |
| P24       | 2'-0" x 2'-0" | (8) #6           | #4 @ 12" O.C.                | B      | ≤ 2'-8"         |
|           |               | (4) #8           | #4 @ 12" O.C.                | A      | > 2'-8"         |
| P24 x 44  | 2'-0" x 3'-8" | (12) #7          | #4 @ 12" O.C.                | C      | ≤ 2'-8"         |
|           |               | (8) #9           | #4 @ 12" O.C.                | E      | > 2'-8"         |

1. PROVIDE MIN. 1 1/2" CLEAR TO PIER TIES.

2. CRITICAL HEIGHT DENOTES THE HEIGHT ABOVE WHICH LARGER DIAMETER VERTICALS WITH FEWER TIES MAY BE USED. REF. FOUNDATION PLAN(S) FOR TOP OF PIER & FOOTING ELEVATIONS.

3. REF. TYPICAL CONCRETE PIER REINFORCING ON FOUNDATION DETAIL SHEET FOR FURTHER INFORMATION ON TIE SPACING.

4. VERTICAL DOWELS ARE TO FUNCTION AS PIER VERTICALS FOR PIERS LESS THAN OR EQUAL TO 5'-0" HIGH. PROVIDE SEPARATE DOWELS & VERTICALS FOR PIERS GREATER THAN OR EQUAL TO 5'-0" HIGH, UNLESS APPROVED.

5. CONTACT THE STRUCTURAL ENGINEER FOR DIRECTION IF COLUMN ANCHOR RODS FOUL WITH PIER TIES OR VERTICALS.

6. MIN. HEIGHT OF PIERS: #6 VERTICALS = 2'-0", #7 VERTICALS = 2'-8".

|            |            |                 |            |            |
|------------|------------|-----------------|------------|------------|
| DETAIL "A" | DETAIL "B" | ALT. DETAIL "B" | DETAIL "C" | DETAIL "E" |
| (1) SET    | (2) SETS   | (3) SETS        | (3) SETS   | (2) SETS   |

### WALL FOOTING SCHEDULE


| FTG. MARK | FOOTING SIZE |       | FOOTING REINFORCING |                       |
|-----------|--------------|-------|---------------------|-----------------------|
|           | WIDTH        | DEPTH | LONGITUDINAL        | TRANSVERSE            |
| WF24      | 2'-0"        | 1'-0" | (2) #5 x CONTINUOUS | #4 x 1'-0" @ 90° O.C. |
| WF30      | 2'-0"        | 1'-2" | (3) #5 x CONTINUOUS | #4 x 2'-0" @ 90° O.C. |
| WF42      | 3'-0"        | 1'-2" | (4) #5 x CONTINUOUS | #5 x 3'-0" @ 12" O.C. |

1. CENTER FOOTINGS BENEATH WALLS, U.N.O.

### FOUNDATION PLAN NOTES

- REF. S401 FOR STRUCTURAL NOTES, DESIGN DATA & SCHEDULES.
- ALL CONTRACTORS ARE REQUIRED TO COORDINATE THEIR WORK WITH ALL DISCIPLINES TO AVOID CONFLICTS. THE MECHANICAL, ELECTRICAL, AND PLUMBING ASPECTS ARE NOT IN THE SCOPE OF THESE DRAWINGS. THEREFORE, ALL REQUIRED MATERIALS AND WORK MAY NOT BE INDICATED.
- COORDINATE EXACT SIZE & LOCATION OF ALL MECHANICAL OPENINGS IN FOUNDATION WALLS WITH THE MECHANICAL, ELECTRICAL & PLUMBING CONTRACTORS.
- ALL ELEVATIONS ARE REFERENCED FROM THE FIRST FLOOR FINISH FLOOR ELEVATION 0'-0" (U.S.G.S. 646.0). REF. CIVIL DWGS.
- REF. ARCH. DRAWINGS FOR ALL DIMENSIONS NOT SHOWN. CONTRACTOR SHALL VERIFY ALL DIMENSIONS PRIOR TO CONSTRUCTION AND IMMEDIATELY NOTIFY ARCHITECT/ENGINEER OF ANY DISCREPANCIES.
- REF. S403 & S401 FOR TYPICAL FOUNDATION DETAILS.
- NOTE: PERIMETER WALL AND COLUMN FOOTINGS SHALL BE LOWERED AND/OR SLEEVED TO PASS BELOW PLUMBING LINES (IE. SANITARY & STORM SEWERS, WATER LINES, ETC.) SHOWN ON THE PLUMBING DRAWINGS. PROVIDE FOOTING STEPS AS REQUIRED PER THE TYPICAL DETAILS ON S400.
- ALL SLAB RECESSES SHALL BE LOCATED PER THE ARCHITECTURAL DRAWINGS. COORDINATE DEPTHS OF ALL SLAB RECESSES WITH THE ARCHITECTURAL DRAWINGS AND/OR THE FLOORING SUPPLIER.
- COORDINATE REINFORCING DOWELS FOR CMU VERTICAL REINFORCING WITH REINF. NOTED ON PLANS & SECTIONS.
- GROUT ALL CORES OF CMU BELOW FINISH FLOOR SOLID.
- COLUMN FOOTINGS SUPPORTING MORE THAN ONE COLUMN SHALL BE CENTERED AT THE MIDPOINT BETWEEN THE COLUMNS, UNLESS NOTED OTHERWISE ON PLAN.
- COLUMN FOOTINGS, TRENCH FOOTINGS AND WALL FOOTINGS SHALL BEAR ON APPROVED SOIL. UNDERCUT AS REQUIRED TO SUITABLE BEARING MATERIAL AS DETERMINED BY THE GEOTECHNICAL TESTING AGENCY. REF. TYPICAL FOOTING UNDERCUT DETAILS S400. UNDERCUTTING TO SUITABLE BRG. MATERIAL IS NOT REQUIRED FOR GRADE BEAMS. REFERENCE ELEVATIONS IN PARENTHESES (XXX'-X") FOR APPROXIMATE ELEVATION TO SUITABLE BEARING STRATA TO BE USED FOR BIDDING PURPOSES.
- PROVIDE CONTINUOUS 4" H. x W. VARIES CONCRETE CURB ON ACOUSTIC ISOLATION SLABS IN MECHANICAL ROOMS. CURBS TO SURROUND ALL PENETRATIONS THRU SLAB INCLUDING COLUMNS, PIPES, SUMP PITS, ETC.
- ALL EX. CONSTRUCTION SHOWN IN PLAN AND/OR SECTION WAS DERIVED FROM EXISTING DRAWINGS AND MUST BE FIELD VERIFIED. IF ANY DISCREPANCIES ARE DISCOVERED BETWEEN INFO. SHOWN ON THE DRAWINGS AND ACTUAL CONDITIONS IMMEDIATELY CONTACT ARCHITECT/ENGINEER FOR DIRECTION BEFORE PROCEEDING WITH THE WORK.
- PROVIDE THICKENED SLAB UNDER ALL INTERIOR CMU WALLS WITHOUT FOOTINGS. SEE DETAILS ON S401 FOR THICKENED SLAB DETAIL. LAYOUT THICKENED SLABS FROM DIMENSIONS ON THE ARCHITECT FLOOR PLANS.
- PROVIDE CONTROL/CONTRACTION JOINTS IN SLABS ON GRADE (REF. THE TYPICAL DETAILS ON SHEET S400). ALL JOINTS IN SLABS TO RECEIVE THIN OR THICK-SET TERRAZZO, CERAMIC OR PORCELAIN TILE, VINYL COMPOSITION TILE (VCT) OR VINYL SHEET GOODS. EPoxy OR SIMILAR THIN-FILM FINISH FLOORING SHALL BE CAREFULLY COORDINATED WITH THE FLOORING CONTRACTOR. THE CONTRACTOR SHALL SUBMIT SLAB JOINT LAYOUT TO ARCHITECT/ENGINEER FOR REVIEW PRIOR TO PLACING SLABS.
- WHERE PIERS OCCUR WITHIN A LARGER ARCH. PLASTER OR COLUMN ENCLOSURE (FOR EG. P24s WITHIN 40" SQUARE CANOPY PLASTERS) PROVIDE PIER REINF. CAGE CENTERED ON THE GRID INTERSECTION. FORM OVERALL PIER TO PROFILE OF THE ARCHITECTURAL PLASTER OR COLUMN ENCLOSURE. LAYOUT PLASTERS FROM DIMENSIONS ON THE ARCHITECTURAL PLANS & DETAILS.
- FOR ARCHITECTURAL PLASTERS NOT SUPPORTING STEEL COLUMNS, CONSTRUCT AS FULLY-GROUTED MASONRY PIERS OR CAST-IN-PLACE CONCRETE PIERS REINF'D W/ #5 VERTICAL REINFORCING AT 12" O.C. ALL FACES. AT CONTRACTORS OPTION.
- AT ALL LOCATIONS WHERE NEW FOOTINGS ARE TO BE INSTALLED IN EXISTING SPACES REMOVE EXISTING CONCRETE SLABS AND/OR FOUNDATION WALLS/ WALL FOOTINGS AS REQUIRED. NEW SLABS TO BE DOWELED TO EXISTING PER DETAIL 6S401.

20. PLAN LEGEND:
- F.F. DENOTES FINISH FLOOR
- T/X DENOTES TOP OF FTG., GRADE BEAM, SLAB, PIER, ETC.
- B/X DENOTES BOTTOM OF FTG., GRADE BEAM, ETC.
- C.J. DENOTES SLAB ON GRADE CONTROL/CONTRACTION JOINT
- WF30 -20'-0" DENOTES WALL FOOTING MARK & TOP OF FOOTING ELEVATION (SEE WALL FOOTING SCHEDULE)
- S1 DENOTES NEW 4" CONC. SLAB w/ FIBERFORCE 300 FIBERS @ 15 LBS/Y. (OR EQ. VAL.) & ES INTERNAL CURE ADMIXTURE @ 4 OZ/CWT & ES CATALYST SPRAYED ON BETWEEN 800-1,000 SF/GAL OVER 15-MIL VAPOR BARRIER OVER 6" COMPACTED GRANULAR FILL (NO. 53 STONE OR APPROVED EQUIVALENT), T/C CONC. = 0'-0" U.N.O.
- S2 DENOTES NEW 6" CONC. SLAB w/ NEW CONC. SLAB w/ 666 W/ 20M22.5 W/ F.F. & ES INTERNAL CURE ADMIXTURE @ 4 OZ/CWT & ES CATALYST SPRAYED ON BETWEEN 800-1,000 SF/GAL OVER 15-MIL VAPOR BARRIER OVER 6" COMPACTED GRANULAR FILL (NO. 53 STONE OR APPROVED EQUIVALENT), T/C CONC. = 0'-0" U.N.O.
- S3 DENOTES NEW 4" CONC. SLAB w/ FIBERFORCE 300 FIBERS @ 15 LBS/Y. (OR EQ. VAL.) OVER 15-MIL VAPOR BARRIER T/C CONC. = MATCH EXISTING
- SE DENOTES EXISTING SLAB ON GRADE
- Denotes PIPE PENETRATION THROUGH FOUNDATION WALL. COORDINATE EXACT LOCATION & INVERT ELEVATION w/ APPROPRIATE TRADE. LOWER BOTTOM OF FOOTING & PROVIDE SLEEVE THROUGH FOUNDATION WALL PER TYPICAL DETAIL ON S400.
- Denotes WALL FOOTING WITH STEPS, REF. TYP. DETAIL ON S400

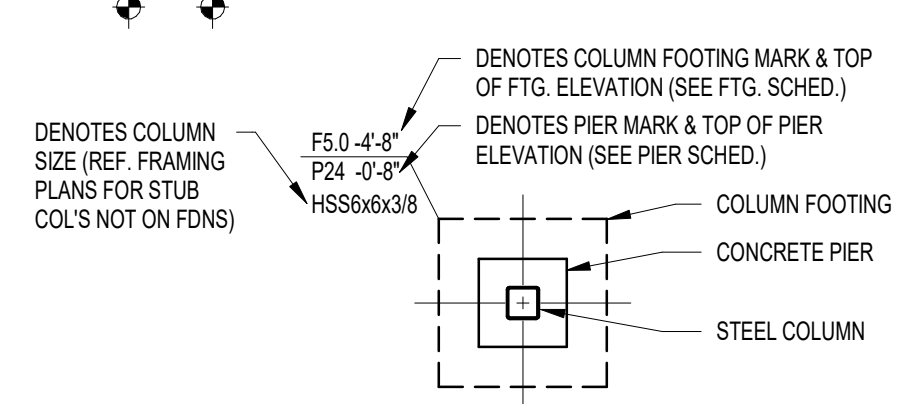


### COLUMN FOOTING SCHEDULE

| FOOTING MARK | FOOTING SIZE |        |        | REINFORCING (EACH WAY) |
|--------------|--------------|--------|--------|------------------------|
|              | WIDTH        | LENGTH | DEPTH  |                        |
| F3.0         | 3'-0"        | 3'-0"  | 1'-2"  | (4) #5 x 2'-0"         |
| F4.0         | 4'-0"        | 4'-0"  | 1'-2"  | (4) #5 x 3'-0"         |
| F5.0         | 5'-0"        | 5'-0"  | 1'-2"  | (5) #5 x 4'-0"         |
| F6.0         | 6'-0"        | 6'-0"  | 1'-2"  | (6) #5 x 5'-0"         |
| F7.0         | 7'-0"        | 7'-0"  | 1'-2"  | (7) #5 x 6'-0"         |
| F8.0         | 8'-0"        | 8'-0"  | 1'-2"  | (7) #6 x 7'-0"         |
| F12.0        | 12'-0"       | 12'-0" | 1'-10" | (10) #7 x 11'-0"       |
| F13.0        | 13'-0"       | 13'-0" | 2'-0"  | (12) #7 x 12'-0"       |


#### NOTES

- CENTER FOOTINGS BENEATH COLUMNS, U.N.O.
  - ALL FOOTINGS MUST BE BOARD-FORMED, UNLESS APPROVED.
  - INCREASE FOOTING DEPTH WHERE REQ'D TO ENCASE COLUMN ANCHOR RODS
- NOTE: WF STEEL COLUMN SHOWN, TUBES, PIPES, C.I.P. CONCRETE, PRECAST & MASONRY COLUMNS SIM.

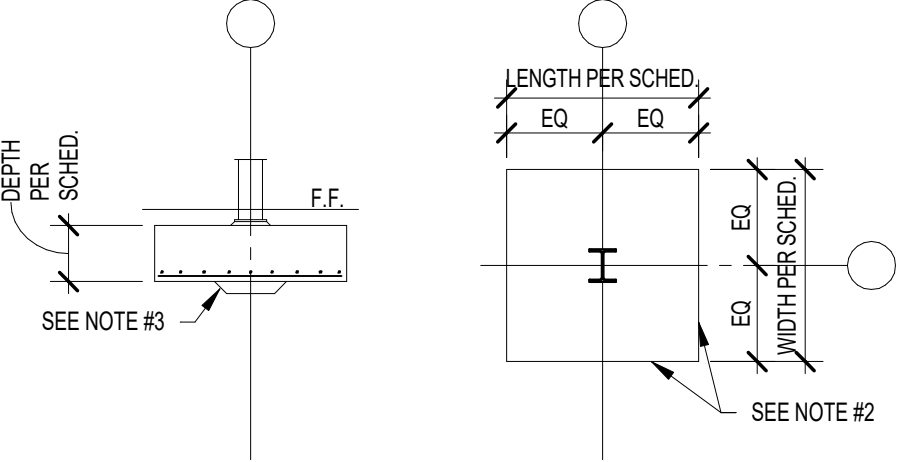

### 1 FOUNDATION PLAN - UNIT F


1/8" = 1'-0"

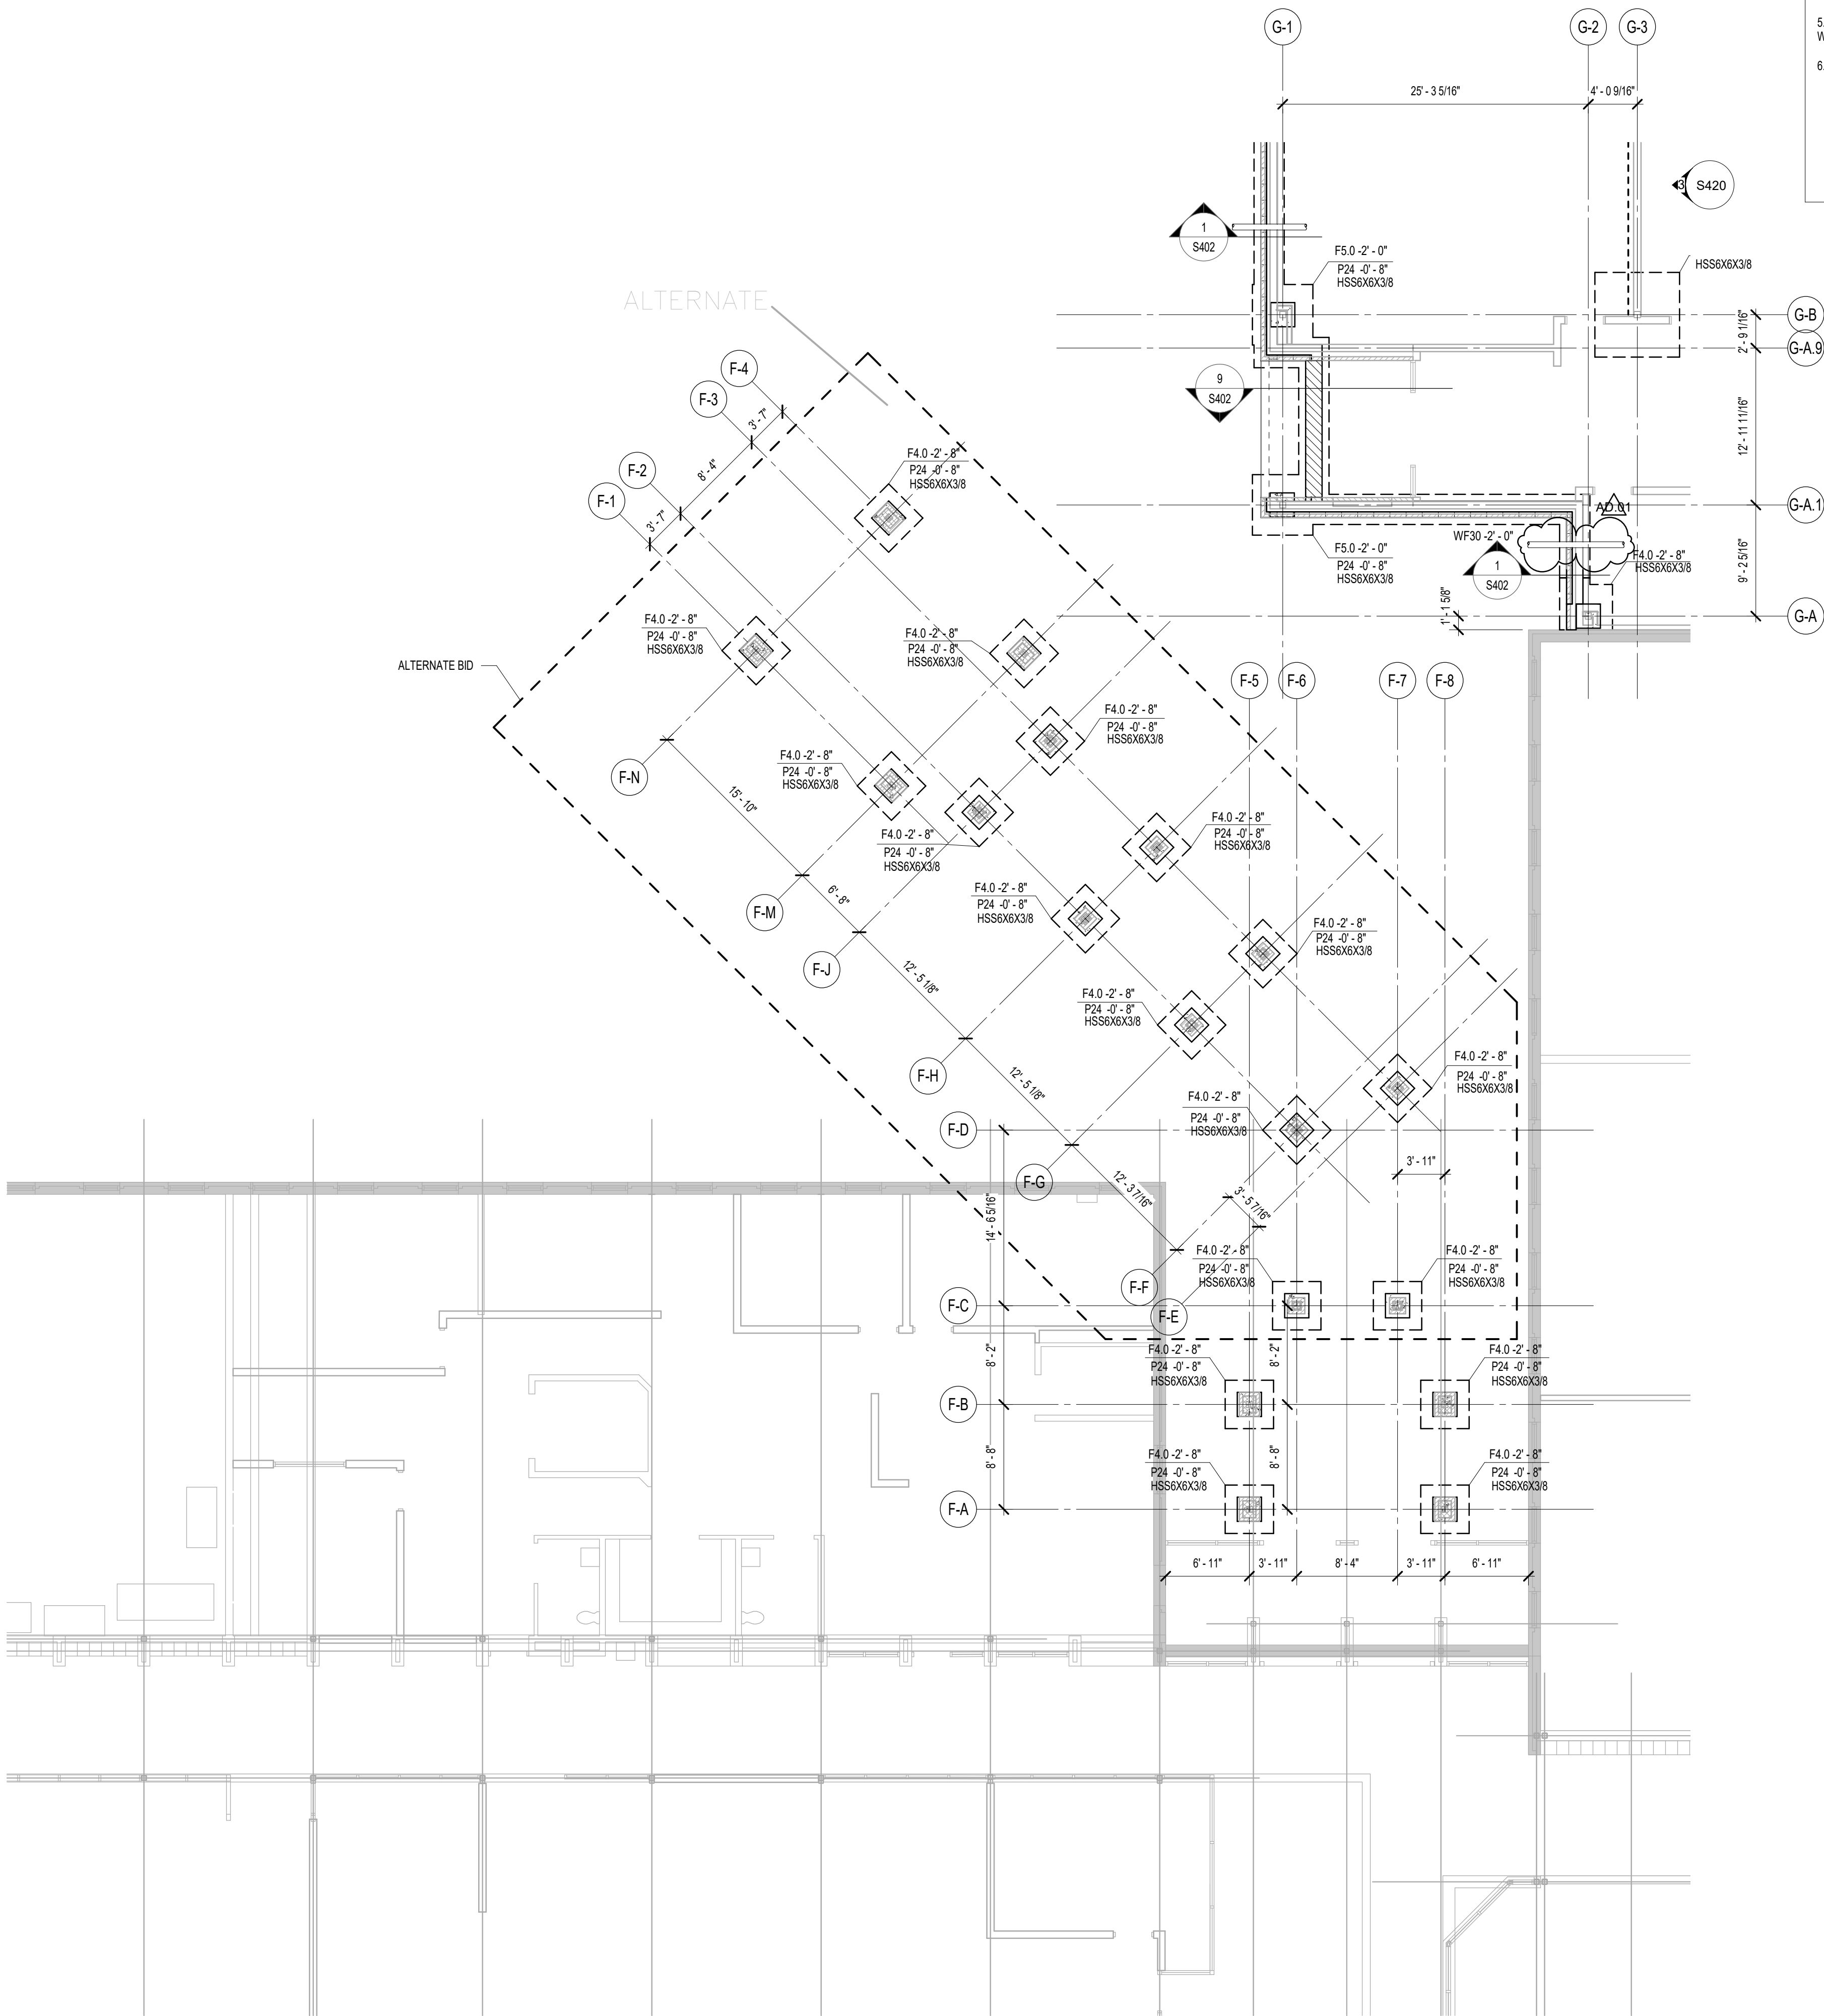







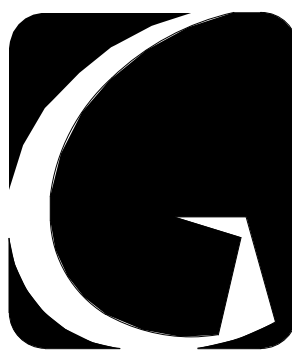


**GIBRALTAR**  
DESIGN  
ARCHITECTURE • ENGINEERING • INTERIOR DESIGN

PROJECT

**WESTCHESTER  
INTERMEDIATE  
SCHOOL -  
ADDITIONS &  
RENOVATIONS**

DUNELAND SCHOOL CORPORATION  
CHESTERTON, INDIANA

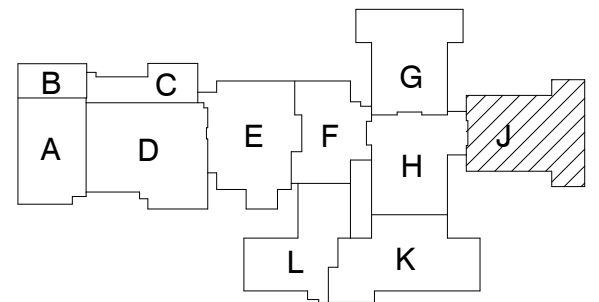

KEY PLAN

**GIBRALTAR DESIGN**

9102 N. Meridian St., Ste. 300  
Indianapolis, IN 46260  
Homepage: www.GibraltarDesign.com  
Email: info@GibraltarDesign.com  
Phone: 317.580.5777 Fax: 317.580.5778

PROJECT

21116

DATE

3-3-2022

COORDINATED BY

JMS

DRAWN BY

JMS

CHECKED BY

SAC



COMPILED NOTICE:  
THE CONCEPTS, DESIGN, PLANS, DETAILS, ETC. SHOWN ON THIS DOCUMENT ARE THE PROPERTY OF GIBRALTAR DESIGN AND WERE CREATED FOR USE ON THIS SPECIFIC PROJECT. NONE OF THIS INFORMATION SHALL BE USED BY ANY PERSON OR FIRM FOR ANY PURPOSE WITHOUT THE EXPRESS WRITTEN CONSENT OF GIBRALTAR DESIGN. THE OWNER MAY RETAIN COPIES FOR INFORMATION AND REFERENCE IN CONNECTION ONLY WITH THIS PROJECT.

REVISIONS

MARK DATE ISSUED FOR

AD-0.1 3/16/2022 ADDENDUM #1

DRAWING

FOUNDATION PLAN - UNIT J

PROJECT

WESTCHESTER IS - ADDITIONS &  
RENOVATIONS

© GIBRALTAR DESIGN

SHEET

J

S107

### CONCRETE PIER SCHEDULE

| PIER MARK | PIER SIZE     | PIER REINFORCING |                               |                        |
|-----------|---------------|------------------|-------------------------------|------------------------|
|           |               | VERTICALS        | TIES-SIZE & SPA. <sup>1</sup> | DETAIL CRITICAL HEIGHT |
| P24       | 2'-0" x 2'-0" | (8) #6           | #4 @ 12" O.C.                 | B ≤ 2'-8"              |
|           |               | (4) #8           | #4 @ 12" O.C.                 | A > 2'-8"              |
| P24 & 44  | 2'-0" x 3'-8" | (12) #7          | #4 @ 12" O.C.                 | C ≤ 2'-8"              |
|           |               | (8) #9           | #4 @ 12" O.C.                 | E > 2'-8"              |

1. PROVIDE MIN. 1 1/2" CLEAR TO PIER TIES.

2. CRITICAL HEIGHT DENOTES THE HEIGHT ABOVE WHICH LARGER DIAMETER VERTICALS WITH FEWER TIES MAY BE USED. REF. FOUNDATION PLAN(S) FOR TOP OF PIER & FOOTING ELEV.

3. REF. TYPICAL CONCRETE PIER REINFORCING ON FOUNDATION DETAIL SHEET FOR FURTHER INFORMATION ON THE SPACING.

4. VERTICAL DOWELS ARE TO FUNCTION AS PIER VERTICALS FOR PIERS LESS THAN OR EQUAL TO 5'-0" HIGH. PROVIDE SEPARATE DOWELS & VERTICALS FOR PIERS GREATER THAN OR EQUAL TO 5'-0" HIGH, UNLESS APPROVED.

5. CONTACT THE STRUCTURAL ENGINEER FOR DIRECTION IF COLUMN ANCHOR RODS FOUL WITH PIER TIES OR VERTICALS.

6. MIN. HEIGHT OF PIERS: #6 VERTICALS = 2'-0", #7 VERTICALS = 2'-8".

|            |            |                 |            |            |
|------------|------------|-----------------|------------|------------|
| DETAIL "A" | DETAIL "B" | ALT. DETAIL "B" | DETAIL "C" | DETAIL "E" |
| (1) SET    | (2) SETS   | (3) SETS        | (3) SETS   | (2) SETS   |

### WALL FOOTING SCHEDULE

| FTG. MARK | FOOTING SIZE |       | FOOTING REINFORCING |                       |
|-----------|--------------|-------|---------------------|-----------------------|
|           | WIDTH        | DEPTH | LONGITUDINAL        | TRANSVERSE            |
| WF24      | 2'-0"        | 1'-0" | (2) #5 x CONTINUOUS | #4 x 1'-0" @ 90° O.C. |
| WF30      | 2'-6"        | 1'-2" | (3) #5 x CONTINUOUS | #4 x 2'-0" @ 90° O.C. |
| WF42      | 3'-8"        | 1'-2" | (4) #5 x CONTINUOUS | #5 x 3'-0" @ 12" O.C. |


1. CENTER FOOTINGS BENEATH WALLS, U.N.O.

### FOUNDATION PLAN NOTES

- REF. S001 FOR STRUCTURAL NOTES, DESIGN DATA & SCHEDULES.
- ALL CONTRACTORS ARE REQUIRED TO COORDINATE THEIR WORK WITH ALL DISCIPLINES TO AVOID CONFLICTS. THE MECHANICAL, ELECTRICAL, AND PLUMBING ASPECTS ARE NOT IN THE SCOPE OF THESE DRAWINGS. THEREFORE, ALL REQUIRED MATERIALS AND WORK MAY NOT BE INDICATED.
- COORDINATE EXACT SIZE & LOCATION OF ALL MECHANICAL OPENINGS IN FOUNDATION WALLS WITH THE MECHANICAL, ELECTRICAL & PLUMBING CONTRACTORS.
- ALL ELEVATIONS ARE REFERENCED FROM THE FIRST FLOOR FINISH FLOOR ELEVATION 0'-0" (U.S.G.S. 646.0). REF. CIVIL DWGS.
- REF. ARCH. DRAWINGS FOR ALL DIMENSIONS NOT SHOWN. CONTRACTOR SHALL VERIFY ALL DIMENSIONS PRIOR TO CONSTRUCTION AND IMMEDIATELY NOTIFY ARCHITECT/ENGINEER OF ANY DISCREPANCIES.
- REF. S403 & S401 FOR TYPICAL FOUNDATION DETAILS.
- NOTE: PERIMETER WALL AND COLUMN FOOTINGS SHALL BE LOWERED AND/OR SLEEVED TO PASS BELOW PLUMBING LINES (I.E. SANITARY & STORM SEWERS, WATER LINES, ETC.) SHOWN ON THE PLUMBING DRAWINGS. PROVIDE FOOTING STEPS AS REQUIRED PER THE TYPICAL DETAILS ON S400.
- ALL SLAB RECESSES SHALL BE LOCATED PER THE ARCHITECTURAL DRAWINGS. COORDINATE DEPTHS OF ALL SLAB RECESSES WITH THE ARCHITECTURAL DRAWINGS AND/OR THE FLOORING SUPPLIER.
- COORDINATE REINFORCING DOWELS FOR CMU VERTICAL REINFORCING WITH REINF. NOTED ON PLANS & SECTIONS.
- GROUT ALL CORES OF CMU BELOW FINISH FLOOR SOLID.
- COLUMN FOOTINGS SUPPORTING MORE THAN ONE COLUMN SHALL BE CENTERED AT THE MIDPOINT BETWEEN THE COLUMNS, UNLESS NOTED OTHERWISE ON PLAN.
- COLUMN FOOTINGS, TRENCH FOOTINGS AND WALL FOOTINGS SHALL BEAR ON APPROVED SOIL. UNDERCUT AS REQUIRED TO SUITABLE BEARING MATERIAL AS DETERMINED BY THE GEOTECHNICAL TESTING AGENCY. REF. TYPICAL FOOTING UNDERCUT DETAILS S400. UNDERCUTTING TO SUITABLE BRG. MATERIAL IS NOT REQUIRED FOR GRADE BEAMS. REFERENCE ELEVATIONS IN PARENTHESES (XXX-X") FOR APPROXIMATE ELEVATION TO SUITABLE BEARING STRATA TO BE USED FOR BIDDING PURPOSES.
- PROVIDE CONTINUOUS 4" H. x W. VARIES CONCRETE CURB ON ACOUSTIC ISOLATION SLABS IN MECHANICAL ROOMS. CURBS TO SURROUND ALL PENETRATIONS THRU SLAB INCLUDING COLUMNS, PIPES, SUMP PITS, ETC.
- ALL EX. CONSTRUCTION SHOWN IN PLAN AND/OR SECTION WAS DERIVED FROM EXISTING DRAWINGS AND MUST BE FIELD VERIFIED. IF ANY DISCREPANCIES ARE DISCOVERED BETWEEN INFO. SHOWN ON THE DRAWINGS AND ACTUAL CONDITIONS IMMEDIATELY CONTACT ARCHITECT/ENGINEER FOR DIRECTION BEFORE PROCEEDING WITH THE WORK.
- PROVIDE THICKENED SLAB UNDER ALL INTERIOR CMU WALLS WITHOUT FOOTINGS. SEE DETAILS ON S401 FOR THICKENED SLAB DETAIL. LAYOUT THICKENED SLABS FROM DIMENSIONS ON THE ARCHITECT FLOOR PLANS.
- PROVIDE CONTROL CONTRACTION JOINTS IN SLABS ON GRADE (REF. THE TYPICAL DETAILS ON SHEET S400). ALL JOINTS IN SLABS TO RECEIVE THIN OR THICK-SET TERRAZZO, CERAMIC OR PORCELAIN TILE, VINYL COMPOSITION TILE (VCT) OR VINYL SHEET GOODS. EPOXY OR SIMILAR THIN-FILM FINISH FLOORING SHALL BE CAREFULLY COORDINATED WITH THE FLOORING CONTRACTOR. THE CONTRACTOR SHALL SUBMIT SLAB JOINT LAYOUT TO ARCHITECT/ENGINEER FOR REVIEW PRIOR TO PLACING SLABS.
- WHERE PIERS OCCUR WITHIN A LARGER ARCH. PLASTER OR COLUMN ENCLOSURE (FOR EG. P24'S WITHIN 40' SQUARE CANOPY PLASTERS) PROVIDE PIER REINF. CAGE CENTERED ON THE GRID INTERSECTION. FORM OVERALL PIER TO PROFILE OF THE ARCHITECTURAL PLASTER OR COLUMN ENCLOSURE. LAYOUT PLASTERS FROM DIMENSIONS ON THE ARCHITECTURAL PLANS & DETAILS.
- FOR ARCHITECTURAL PLASTERS NOT SUPPORTING STEEL COLUMNS, CONSTRUCT AS FULLY-GROUTED MASONRY PIERS OR CAST-IN-PLACE CONCRETE PIERS REINF'D W/ #5 VERTICAL REINFORCING AT 12" O.C. ALL FACES. AT CONTRACTOR'S OPTION.
- AT ALL LOCATIONS WHERE NEW FOOTINGS ARE TO BE INSTALLED IN EXISTING SPACES REMOVE EXISTING CONCRETE SLABS AND/OR FOUNDATION WALLS. WALL FOOTINGS AS REQUIRED. NEW SLABS TO BE DOWELED TO EXISTING PER DETAIL 6S401.

#### 20. PLAN LEGEND:

- F.F. DENOTES FINISH FLOOR
- T/X DENOTES TOP OF FTG., GRADE BEAM, SLAB, PIER, ETC.
- B/X DENOTES BOTTOM OF FTG., GRADE BEAM, ETC.
- C.J. DENOTES SLAB ON GRADE CONTROL CONTRACTION JOINT
- WF30-2'-0" DENOTES WALL FOOTING MARK & TOP OF FOOTING ELEVATION (SEE WALL FOOTING SCHEDULE)
- S1 DENOTES NEW 4" CONC. SLAB w/ "FIBERFORCE 300" FIBERS @ 15 LBS/Y. (OR EQ.) VAL. & ES INTERNAL CURE ADMIXTURE @ 4 OZ/CWT & ES CATALYST SPRAYED ON BETWEEN 800-1,000 SF/GAL OVER 15-MIL VAPOR BARRIER OVER 6" COMPACTED GRANULAR FILL (NO. 53 STONE OR APPROVED EQUIVALENT), T/CONC = 0'-0" U.N.O.
- S2 DENOTES NEW 6" CONC. SLAB w/ NEW CONC. SLAB w/ 6x6 W/2-DW/2 IN W/F. & ES INTERNAL CURE ADMIXTURE @ 4 OZ/CWT & ES CATALYST SPRAYED ON BETWEEN 800-1,000 SF/GAL OVER 15-MIL VAPOR BARRIER OVER 6" COMPACTED GRANULAR FILL (NO. 53 STONE OR APPROVED EQUIVALENT), T/CONC = 0'-0" U.N.O.
- S3 DENOTES NEW 4" CONC. SLAB w/ "FIBERFORCE 300" FIBERS @ 15 LBS/Y. (OR EQ.) VAL. OVER 15-MIL VAPOR BARRIER T/CONC = MATCH EXISTING
- SE DENOTES EXISTING SLAB ON GRADE
- Denotes PIPE PENETRATION THROUGH FOUNDATION WALL. COORDINATE EXACT LOCATION & INVERT ELEVATION w/ APPROPRIATE TRADE. LOWER BOTTOM OF FOOTING & PROVIDE SLEEVE THROUGH FOUNDATION WALL PER TYPICAL DETAIL ON S400.
- Denotes WALL FOOTING WITH STEPS. REF. TYP. DETAIL ON S400


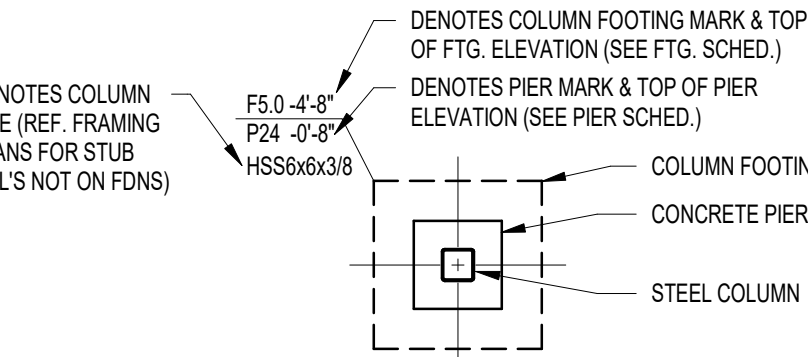


### COLUMN FOOTING SCHEDULE

| FOOTING MARK | FOOTING SIZE |        |        | REINFORCING (EACH WAY) |
|--------------|--------------|--------|--------|------------------------|
|              | WIDTH        | LENGTH | DEPTH  |                        |
| F3.0         | 3'-0"        | 3'-0"  | 1'-2"  | (4) #5 x 2'-6"         |
| F4.0         | 4'-0"        | 4'-0"  | 1'-2"  | (4) #5 x 3'-6"         |
| F5.0         | 5'-0"        | 5'-0"  | 1'-2"  | (5) #5 x 4'-6"         |
| F6.0         | 6'-0"        | 6'-0"  | 1'-2"  | (6) #5 x 5'-6"         |
| F7.0         | 7'-0"        | 7'-0"  | 1'-2"  | (7) #5 x 6'-6"         |
| F8.0         | 8'-0"        | 8'-0"  | 1'-2"  | (7) #6 x 7'-6"         |
| F12.0        | 12'-0"       | 12'-0" | 1'-10" | (10) #7 x 11'-6"       |
| F13.0        | 13'-0"       | 13'-0" | 2'-0"  | (12) #7 x 12'-6"       |

#### NOTES:


- CENTER FOOTINGS BENEATH COLUMNS, U.N.O.
  - ALL FOOTINGS MUST BE BOARD-FORMED, UNLESS APPROVED.
  - INCREASE FOOTING DEPTH WHERE REQ'D TO ENCASE COLUMN ANCHOR RODS
- NOTE: WF STEEL COLUMN SHOWN. TUBES, PIPES, C.I.P. CONCRETE, PRECAST & MASONRY COLUMNS SIM.

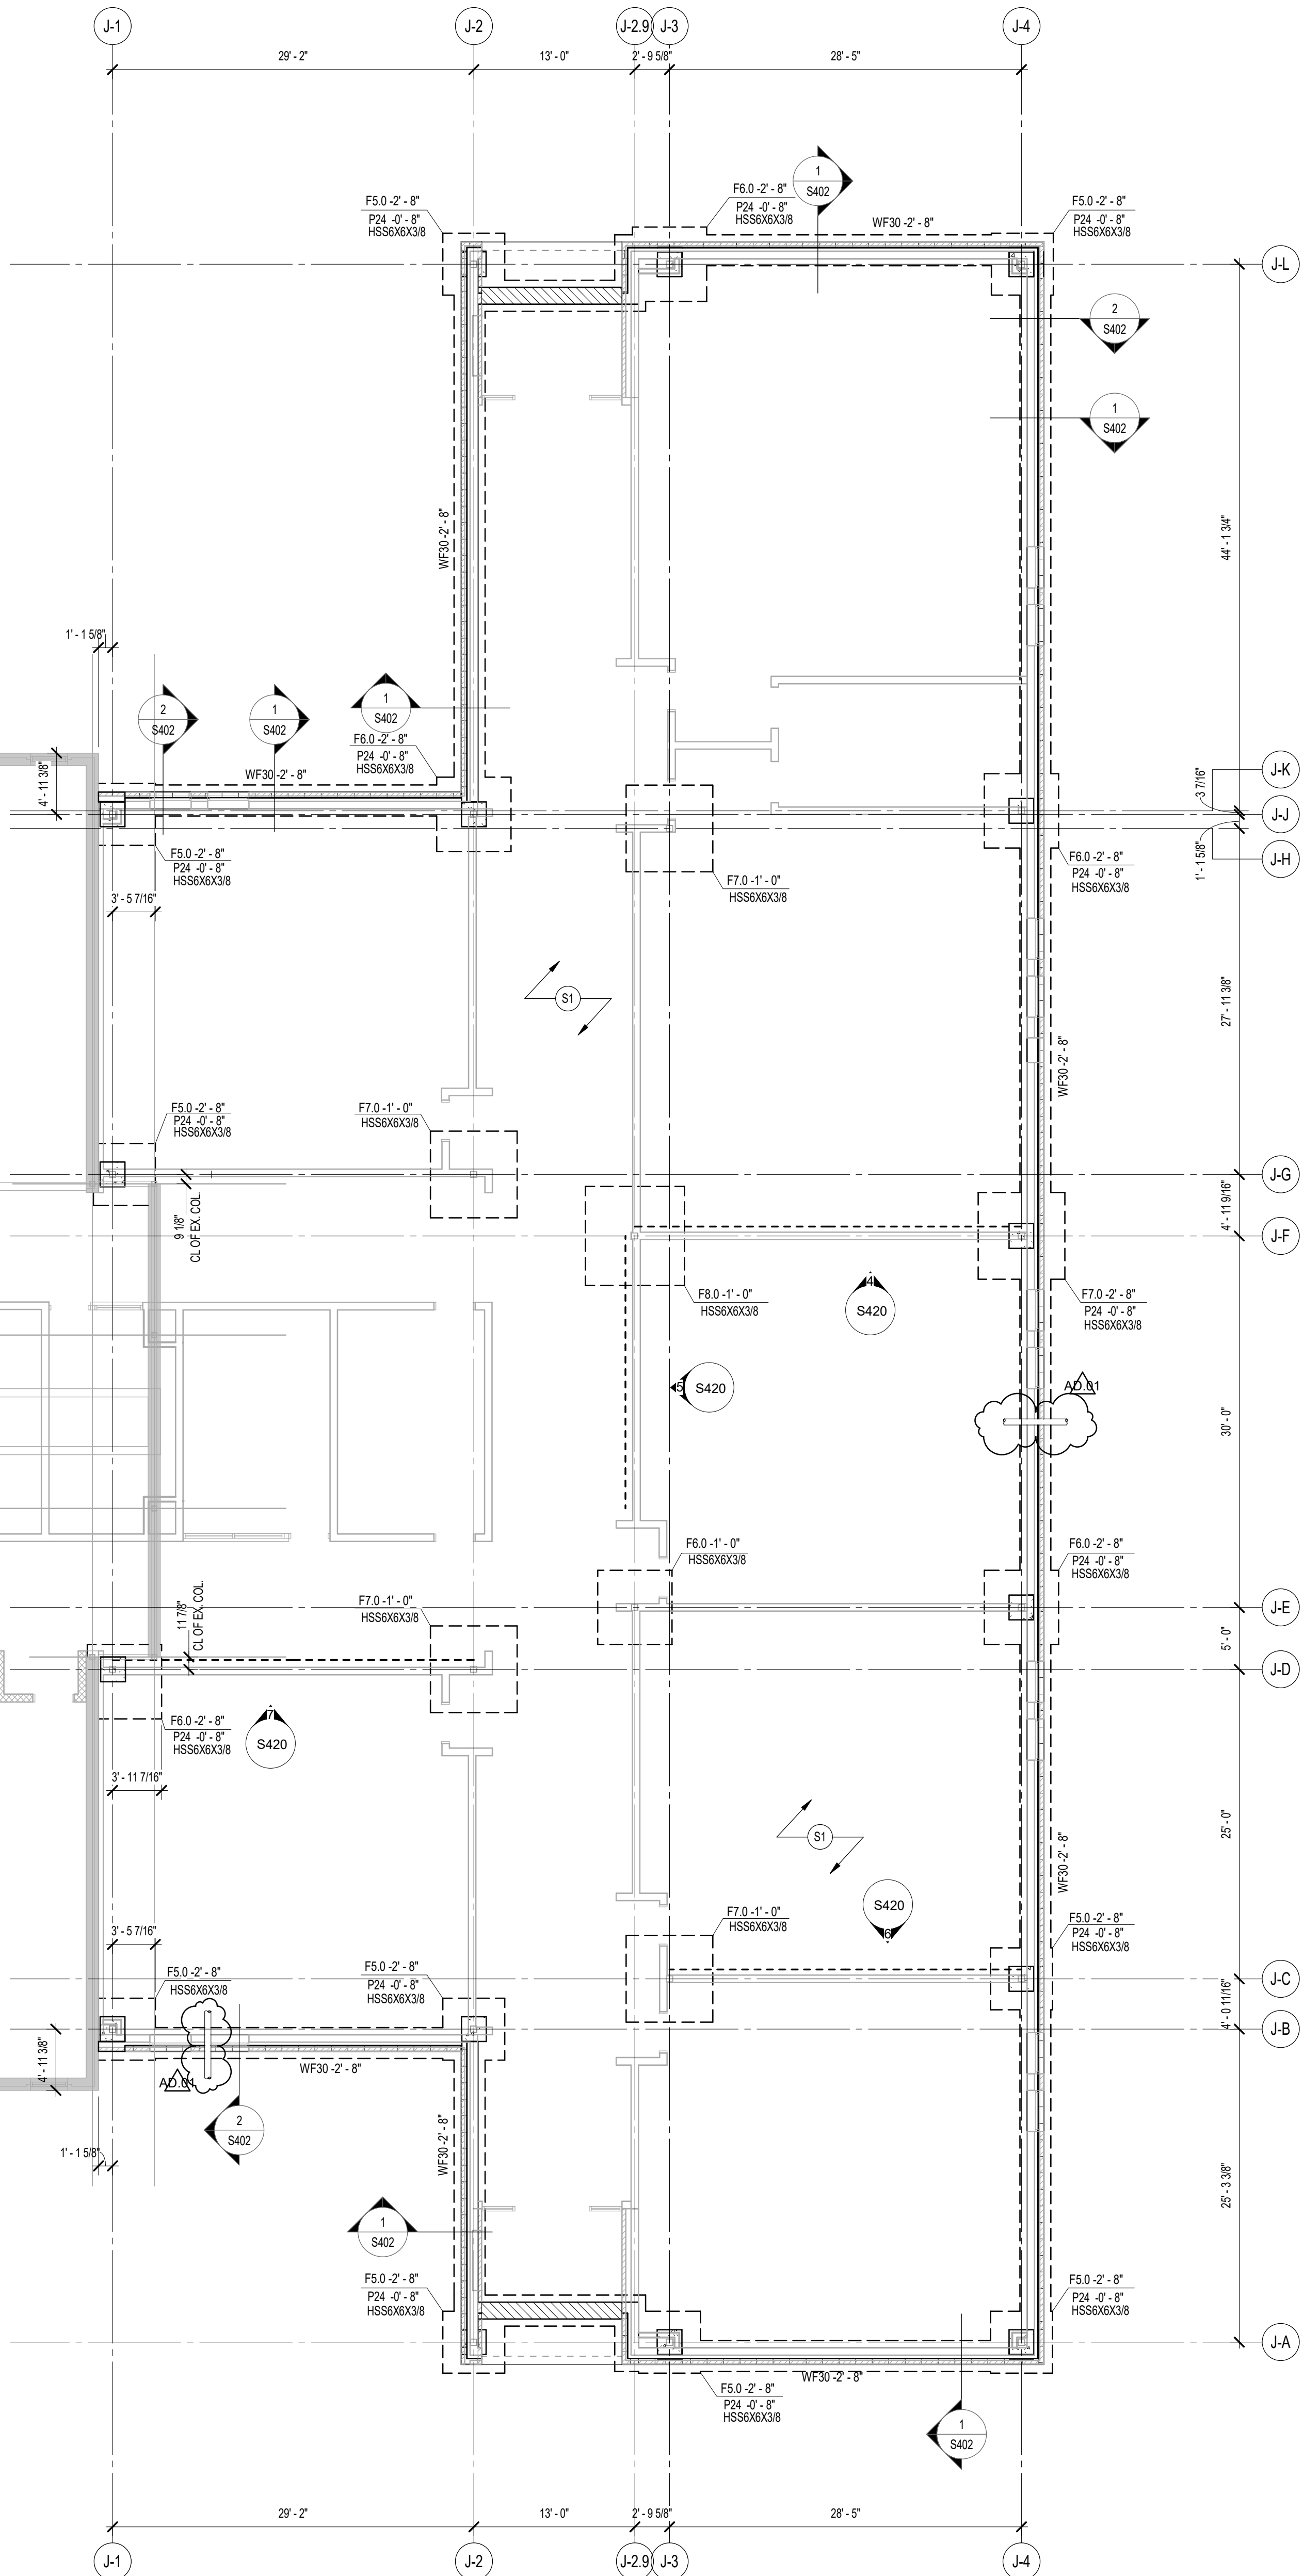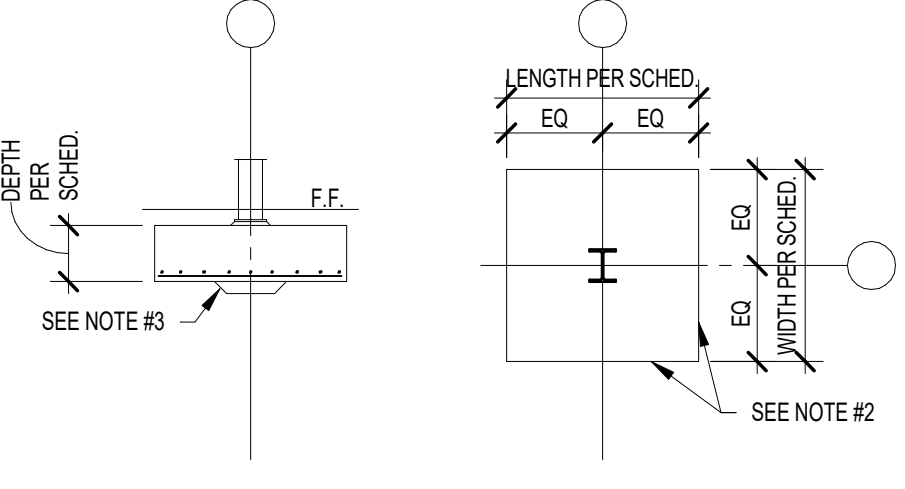






1/8" = 1'-0"



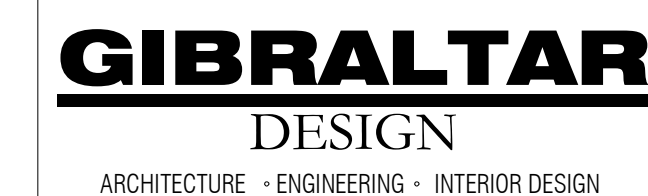

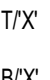

WESTCHESTER  
INTERMEDIATE  
SCHOOL -  
ADDITIONS &  
RENOVATIONS
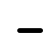
| FRAMING PLAN NOTES  |  |
|---|--|
| 1.  | REF. S001 & S002 FOR STRUCTURAL NOTES, DESIGN DATA, SCHEDULES & LEGENDS.   |
| 2.  | REF. THE S410 & S430 SERIES FOR TYPICAL FRAMING AND MASONRY DETAILS.   |
| 3.  | ALL CONTRACTORS ARE REQUIRED TO COORDINATE THEIR WORK WITH ALL DISCIPLINES TO AVOID CONFLICTS. THE MECHANICAL, ELECTRICAL, AND PLUMBING ASPECTS ARE NOT IN THE SCOPE OF THESE DRAWINGS. THEREFORE, ALL REQUIRED MATERIALS AND WORK MAY NOT BE INDICATED.   |
| 4.  | ALL ELEVATIONS ARE REFERENCED FROM THE FIRST FLOOR FIN. FLOOR ELEVATION =+0.00. USSES ELEVATION WITH CIVL DWGS.  |
| 5.  | SEE FOUNDATION PLANS FOR SIZES OF STEEL COLUMNS SUPPORTED ON FOUNDATIONS.  |
| 6.  | INSTALL CONTINUOUS JOIST AT ALL PERIMETER ROOF EDGES. SEE DETAIL 136-410 FOR ATTACHMENT TO BEAM AND FOR ALL CONDITIONS NOT SPECIFICALLY DEFINED IN FRAMING SECTIONS.   |
| 7.  | ALL WALLS SHALL BE LAID OUT FROM THE ARCHITECTURAL DRAWINGS.   |
| 8.  | REF. ARCH. DRAWINGS FOR ALL DIMENSIONS NOT SHOWN. CONTRACTOR SHALL VERIFY ALL DIMENSIONS PRIOR TO CONSTRUCTION AND IMMEDIATELY NOTIFY ARCHITECT OF ANY DISCREPANCIES.  |
| 9.  | COORDINATE EXACT SIZE & LOCATION OF ANY MECHANICAL OPENINGS IN FLOOR SLAB, ROOF DECK, OR WALLS WITH THE MEP CONTRACTORS. LOCATION & SIZE OF ALL DUCT OPENINGS, GRILLES, ETC. SHALL BE VERIFIED PRIOR TO CONSTRUCTION.  |
| 10.   | ALL ELEVATIONS SHOWN ON PLAN INDICATE TOP OF STEEL BEAM UNLESS NOTED OTHERWISE.  |
| 11.   | PROVIDE FRAMES AT ALL ROOF DRAINS, ROOF HATCHES & OTHER ROOF OPENINGS PER TYPICAL DETAILS IN S410. COORD. EXACT NUMBER, LOCATIONS & DIMENSIONS WITH THE APPROPRIATE CONTRACTORS & THE ARCH. & MEP DWGS.  |
| 12.   | PROVIDE CMU REINFORCING AS NOTED ON PLANS. IF NOT SHOWN ON PLANS OR DETAIL, MINIMUM CMU WALL REINFORCING TO BE #5 BARS @ 48" OC. PROVIDE OPEN-CORR BOND BEAMS AT TOPS OF WALLS & AT CHANGES IN CMU THICKNESS, AND WHERE INTERUPTED IN PLANS & SECTIONS (10" C/C MAX VERTICAL SPACING). PROVIDE 12 OF INTERRUPTED VERTICALS AT JAMS OF OPENINGS TO PROVIDE ADDITIONAL VERTS AT ENDS OF WALLS. |
| 13.   | ALL MASONRY BOND BEAMS, OTHER THAN BOND BEAM UNITS OVER OPENINGS, SHALL BE "OPEN-CORR" BOND BEAMS TO ALLOW VERTICAL REINFORCING TO PASS THROUGH, WITHOUT NOTED OTHERWISE.  |
| 14.   | REF. ARCH. DWGS. FOR MASONRY CONTROL & EXPANSION JOINT LOCATIONS.  |
| 15.   | ALL HORIZONTAL AND DIAGONAL BRIDGING FOR STEEL JOISTS SHALL BE DESIGNED, LOCATED & PROVIDED BY THE JOIST SUPPLIER REF. S31 SPECIFICATIONS.   |
| 16.   | FOR ESTIMATING AND BIDDING PURPOSES ONLY, ASSUME AN AVERAGE 12" THICKNESS OF CONCRETE WILL BE NECESSARY FOR ALL ELEVATED SLABS ON METAL DECK. THE NATURE OF THIS REQUIREMENT IS TO ACCOUNT FOR ANTICIPATED DEAD LOAD FROM CONCRETE SLAB, FINISHES, PARTITION WALLS, ETC. THE MINIMUM SLAB FINISHES REQUIREMENTS DEFINED IN THE SPECIFICATION.  |
| 17.   | ALL EXISTING FRAMING JOIST SUPPORT BY LOAD BEARING WALLS. CMU ABOVE NEW OPENINGS, ETC. IS TO BE REMOVED. THE CONTRACTOR OF EXISTING CONSTRUCTION AND INSTALLATION OF ALL NEW CONSTRUCTION. CONTRACTOR IS RESPONSIBLE FOR ALL REMOVING DESIGN AND IMPLEMENTATION.   |
| 18.   | PLAN SCHEDULED.  |
| F.F.  | DENOTES FIN. FLOOR   |
| T/X   | DENOTES TOP OF STEEL SLAB, ETC.  |
| B/X   | DENOTES BOTTOM OF UNITEL, ETC.   |
|    | DENOTES 180° TO 261 GA. GALV. & PRIME-PANDED W/BE STEEL ROOF DECK. REF. DETAIL 250-044.  |
|    | DENOTES BEAM-TO-COLUMN MOMENT CONNECTION. REF. DETAILS S405.   |
|    | DENOTES BEAM-THRU-BEAM MOMENT CONNECTION. REF. DETAILS ON S404.  |
|    | DENOTES BRACED FRAME OR KICKER LOCATION.   |
|    | DENOTES APPROX. LOCATION OF OPENING IN DECK/SLAB. REF. DETAILS ON S410 FOR TYPICAL TREATING METHODS. FOR MULTIPLE CLOSELY SPACED OPENINGS, TRUSS AS ONE LARGE OPENING.   |
| 19.   | WIDE-FLANGE BEAM & GIRDER NOTATION:  |
| BEAM REACTIONS SHOWN IN KIPS TO BE USED FOR DESIGN OF SHEAR CONNECTION BY STEEL FABRICATOR'S SEE (ALLOWABLE STEEL DESIGN LOADS UNIFORMED).                      |  |
| THE STEEL CONNECTION NOTES ON S303 FOR DESIGN OF CONNECTIONS AT BEAMS & GIRDERS WITH NO REACTION SHOWN. THE MIN. SHEAR CONNECTION DESIGN LOAD SHALL BE 15 KIPS. |  |



9102 N. Meridian St., Ste. 300  
Indianapolis, IN 46260  
Homepage [www.GibraltarDesign.com](http://www.GibraltarDesign.com)  
Email [info@GibraltarDesign.com](mailto:info@GibraltarDesign.com)  
Phone 317.580.5777 Fax 317.580.5778

COPYRIGHT NOTICE:  
THE CONCEPTS, DESIGNS, PLANS, DETAILS, ETC., SHOWN ON THIS DOCUMENT ARE THE PROPERTY OF GIBRALTAR DESIGN AND WERE CREATED FOR USE ON THIS SPECIFIC PROJECT. NONE OF THIS INFORMATION SHALL BE USED BY ANY PERSON, OR FIRM, FOR ANY PURPOSE WITHOUT THE EXPRESS WRITTEN CONSENT OF GIBRALTAR DESIGN. THE OWNER MAY RETAIN COPIES FOR INFORMATION AND REFERENCE IN CONNECTION ONLY WITH THIS PROJECT.


[illegible]

© GIBRALTAR DESIGN

SHEET

A

S200

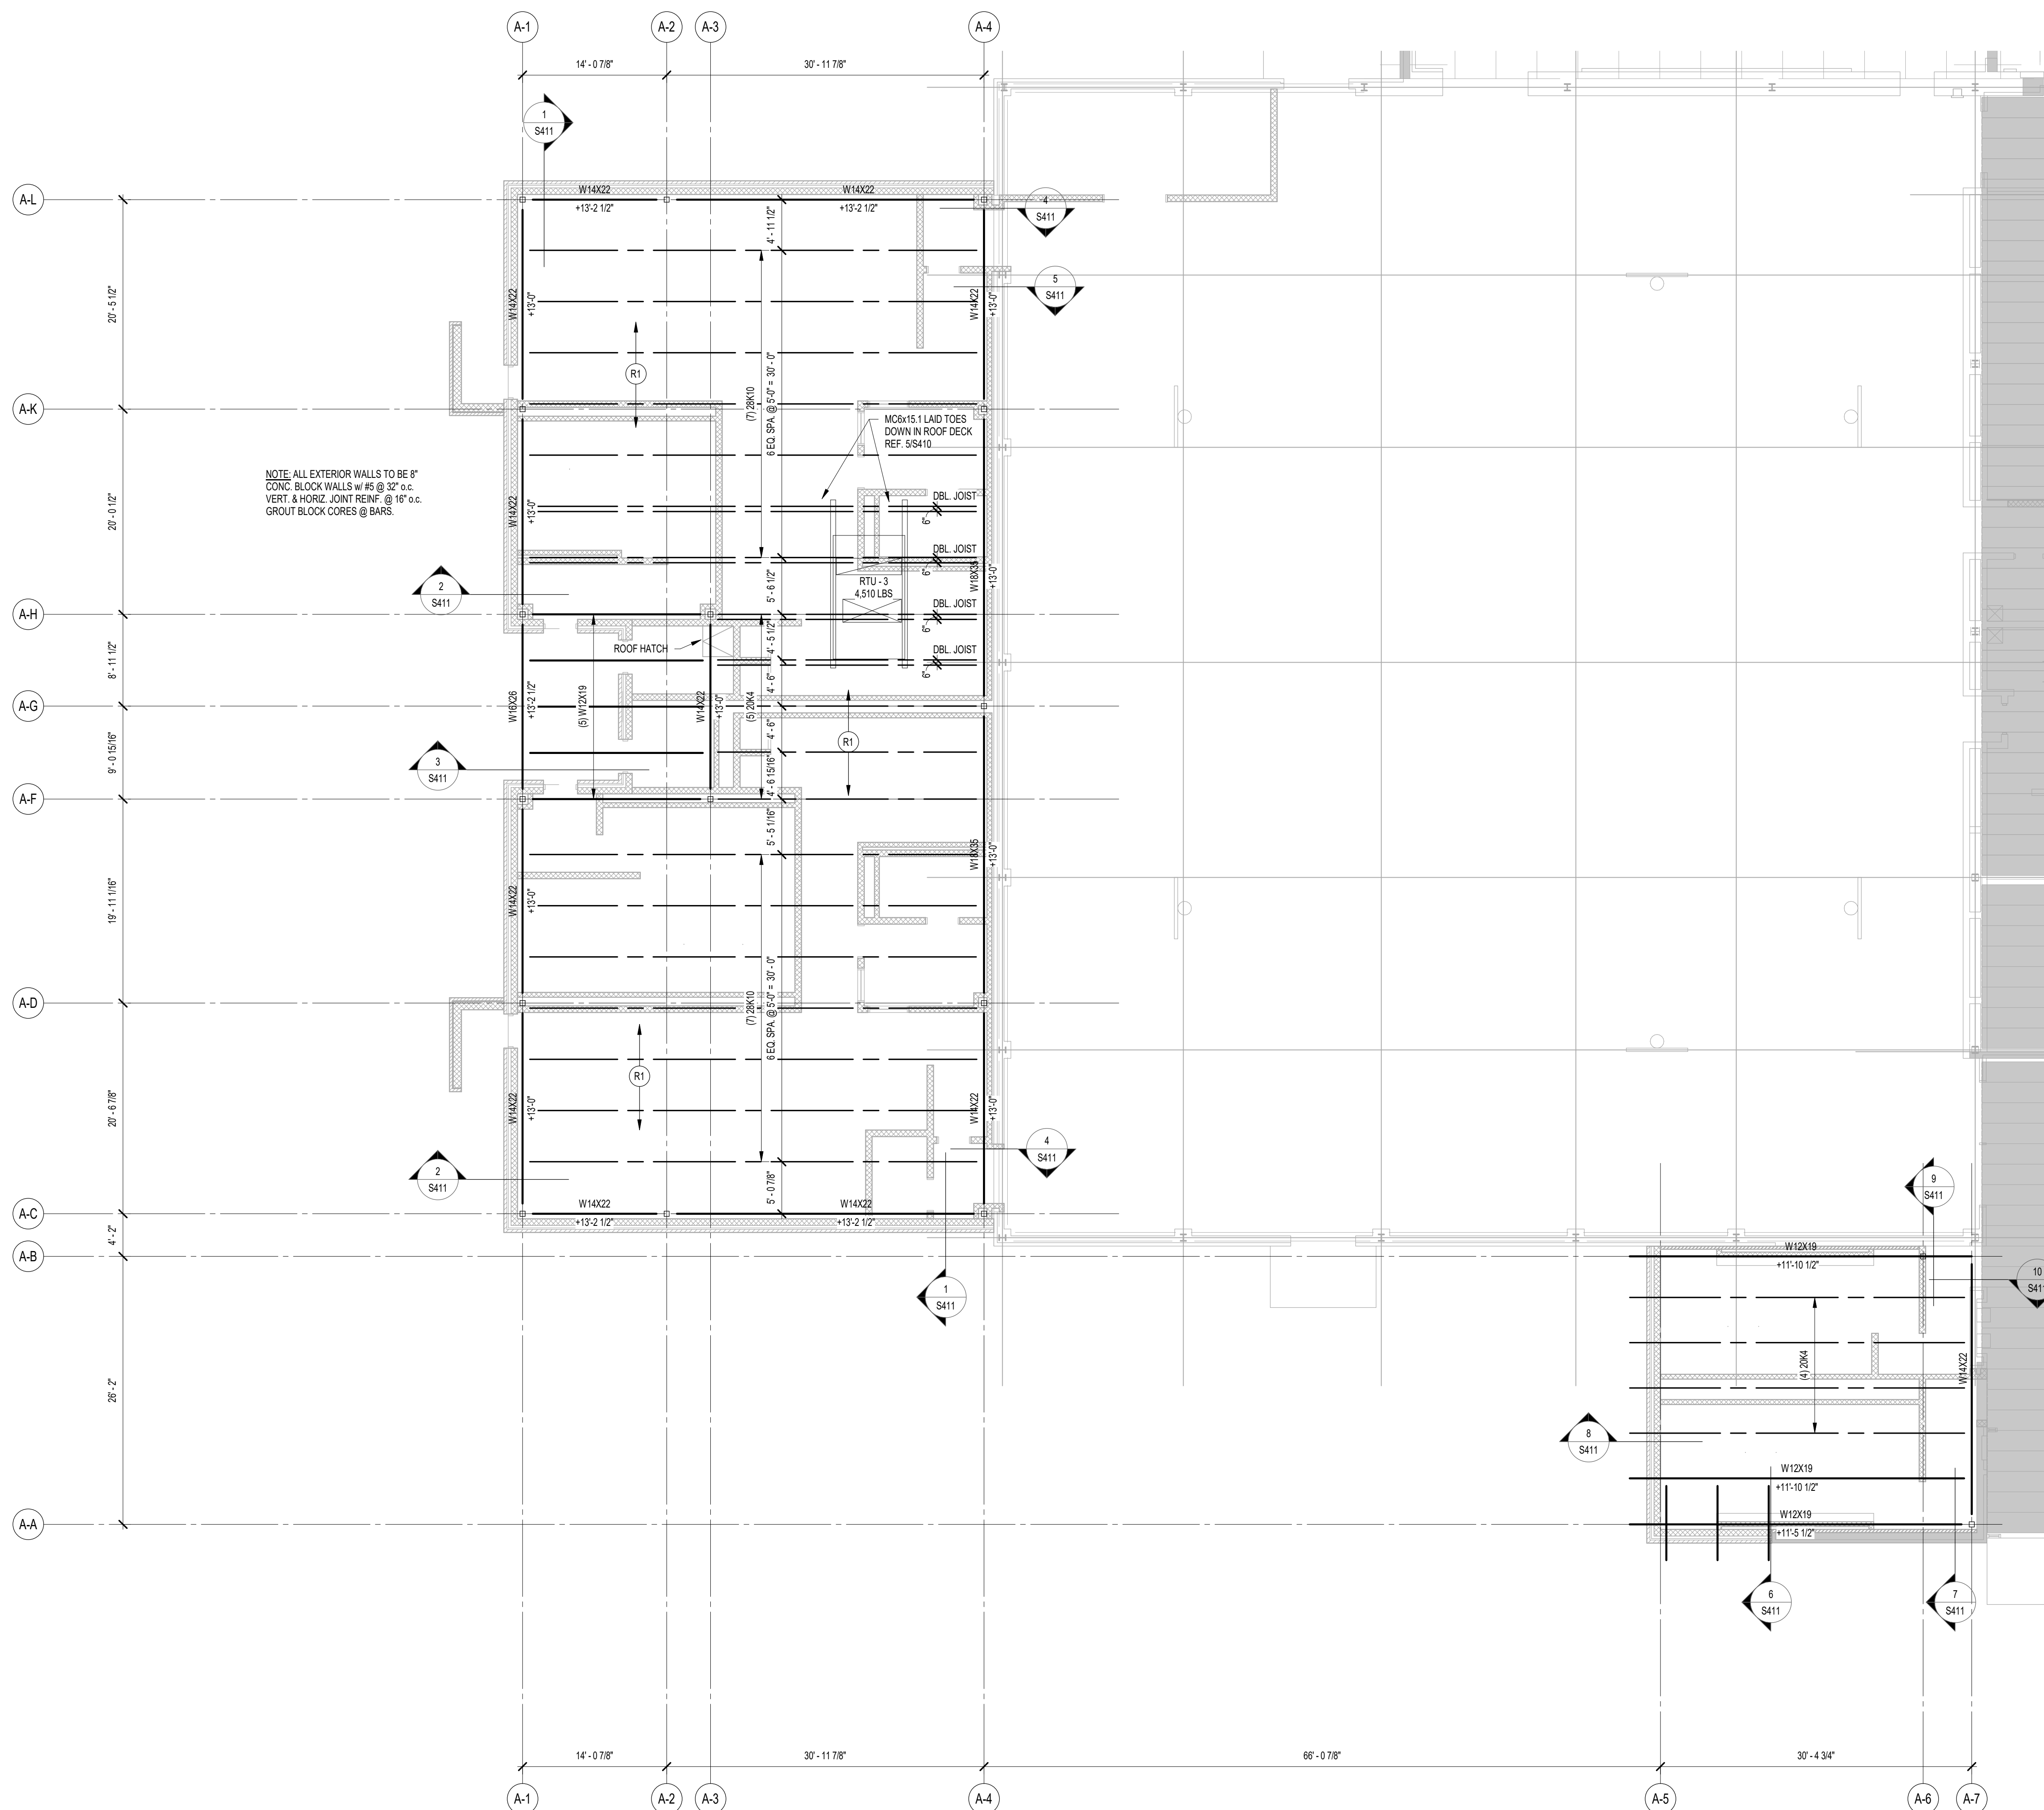


1 ROOF FRAMING PLAN - UNIT A  
1/8" = 1'-0"




WESTCHESTER  
INTERMEDIATE  
SCHOOL -  
ADDITIONS &  
RENOVATIONS

| FRAMING PLAN NOTES  |   |
|---|---|
| 1.  | REF. S001 & S002 FOR STRUCTURAL NOTES, DESIGN DATA, SCHEDULES & LEGENDS.  |
| 2.  | REF. THE S410 & S430 SERIES FOR TYPICAL FRAMING AND MASONRY DETAILS.  |
| 3.  | ALL CONTRACTORS ARE REQUIRED TO COORDINATE THEIR WORK WITH ALL DISCIPLINES TO AVOID CONFLICTS. THE MECHANICAL, ELECTRICAL, AND PLUMBING ASPECTS ARE NOT IN THE SCOPE OF THESE DRAWINGS. THEREFORE, ALL REQUIRED MATERIALS AND WORK MAY NOT BE INDICATED.  |
| 4.  | ALL ELEVATIONS ARE REFERENCED FROM THE FIRST FLOOR FIN. FLOOR ELEVATION =+0.00. USSES ELEVATION WITH CIVL DWGS.   |
| 5.  | SEE FOUNDATION PLANS FOR SIZES OF STEEL COLUMNS SUPPORTED ON FOUNDATIONS.   |
| 6.  | INSTALL CONTINUOUS JOIST AT ALL PERIMETER ROOF EDGES. SEE DETAIL 136-410 FOR ATTACHMENT TO BEAM AND FOR ALL CONDITIONS NOT SPECIFICALLY DEFINED IN FRAMING SECTIONS.  |
| 7.  | ALL WALLS SHALL BE LAID OUT FROM THE ARCHITECTURAL DRAWINGS.  |
| 8.  | REF. ARCH. DRAWINGS FOR ALL DIMENSIONS NOT SHOWN. CONTRACTOR SHALL VERIFY ALL DIMENSIONS PRIOR TO CONSTRUCTION AND IMMEDIATELY NOTIFY ARCHITECT OF ANY DISCREPANCIES.   |
| 9.  | COORDINATE EXACT SIZE & LOCATION OF ANY MECHANICAL OPENINGS IN FLOOR SLAB, ROOF DECK, OR WALLS WITH THE MEP CONTRACTORS. LOCATION & SIZE OF ALL DUCT OPENINGS, GRILLES, ETC. SHALL BE VERIFIED PRIOR TO CONSTRUCTION.   |
| 10.   | ALL ELEVATIONS SHOWN ON PLAN INDICATE TOP OF STEEL BEAM UNLESS NOTED OTHERWISE.   |
| 11.   | PROVIDE FRAMES AT ALL ROOF DRAINS, ROOF HATCHES & OTHER ROOF OPENINGS PER TYPICAL DETAILS IN S410. COORD. EXACT NUMBER, LOCATIONS & DIMENSIONS WITH THE APPROPRIATE CONTRACTORS & THE ARCH. & MEP DWGS.   |
| 12.   | PROVIDE CMU REINFORCING AS NOTED ON PLANS. IF NOT SHOWN ON PLANS OR DETAIL MINIMUM CMU WALL REINFORCING TO BE #5 BARS @ 48" OC. PROVIDE OPEN-CORR BOND BEAMS AT TOPS OF WALLS & AT CHANGES IN CMU THICKNESS, AND WHERE INTERUPTED ON PLANS & SECTIONS (10" C/C MAX VERTICAL SPACING). PROVIDE 12 OF INTERRUPTED VERTICALS AT JAMS OF OPENINGS TO PROVIDE ADDITIONAL VERTS AT ENDS OF WALLS. |
| 13.   | ALL MASONRY BOND BEAMS, OTHER THAN BOND BEAM UNTELS OVER OPENINGS, SHALL BE "OPEN-CORR" BOND BEAMS TO ALLOW VERTICAL REINFORCING TO PASS THROUGH, WITHOUT NOTED OTHERWISE.  |
| 14.   | REF. ARCH. DWGS. FOR MASONRY CONTROL & EXPANSION JOINT LOCATIONS.   |
| 15.   | ALL HORIZONTAL AND DIAGONAL BRIDGING FOR STEEL JOISTS SHALL BE DESIGNED, LOCATED & PROVIDED BY THE JOIST SUPPLIER REF. S31 SPECIFICATIONS.  |
| 16.   | FOR ESTIMATING AND BIDDING PURPOSES ONLY, ASSUME AN AVERAGE 12" THICKNESS OF CONCRETE WILL BE NECESSARY FOR ALL ELEVATED SLABS ON METAL DECK. THE NATURE OF THIS REQUIREMENT IS TO ACCOUNT FOR ANTICIPATED DEAD LOAD FROM FINISHES, PARTITION WALLS, ETC. THE FINISHED SURFACIAL WEIGHTS & FINISHES REQUIREMENTS ARE DEFINED IN THE SPECIFICATION.  |
| 17.   | ALL EXISTING FRAMING JOISTS SUPPORTED BY LOAD BEARING WALLS, CMU ABOVE NEW OPENINGS, ETC. IS TO BE MAINTAINED. THE LOCATION OF EXISTING CONSTRUCTION AND INSTALLATION OF ALL NEW STRUCTURE, CONTRACTOR IS RESPONSIBLE FOR ALL PLANNING DESIGN AND IMPLEMENTATION.   |
| 18.   | BEAM SCHEDULED.   |
| F.F.  | DENOTES FIN. FLOOR  |
| T/X   | DENOTES TOP OF STEEL SLAB, ETC.   |
| B/X   | DENOTES BOTTOM OF UNTEL, ETC.   |
| → R1  | DENOTES 17" 20 GA. GALV. & PRIME-PAINTED W/BE STEEL ROOF DECK. REF. DETAIL 250-04.  |
| ▢   | DENOTES BEAM-TO COLUMN MOMENT CONNECTION. REF. DETAILS S405.  |
| ●   | DENOTES BEAM-THRU-BEAM MOMENT CONNECTION. REF. DETAILS S404.  |
| ---   | DENOTES BRACED FRAME OR KICKER CONNECTION.  |
| □ □ □ □   | DENOTES APPROX. LOCATION OF OPENING IN DECK/SLAB. REF. DETAILS S410 FOR SIZES OF TYPICAL TRIMMING FRAMES. FOR MULTIPLE CLOSELY SPACED OPENINGS, TREAT AS ONE LARGE OPENING.   |
| 18.   | WIDE-FLANGE BEAM & GIRDER NOTATION:   |
| BEAM REACTIONS SHOWN IN KIPS TO BE USED FOR DESIGN OF SHEAR CONNECTION BY STEEL FABRICATOR'S SEE (ALLOWABLE STEEL DESIGN LOADS UNFACTORED)                      |   |
| THE STEEL CONNECTION NOTES ON S301 FOR DESIGN OF CONNECTIONS AT BEAMS & GIRDERS WITH NO REACTION SHOWN. THE MIN. SHEAR CONNECTION DESIGN LOAD SHALL BE 15 KIPS. |   |

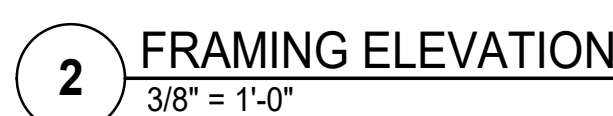

9102 N. Meridian St., Ste. 300  
Indianapolis, IN 46260  
Homepage [www.GibraltarDesign.com](http://www.GibraltarDesign.com)  
Email [info@GibraltarDesign.com](mailto:info@GibraltarDesign.com)  
Phone 317.580.5777 Fax 317.580.5778



THE CONCEPTS, DESIGNS, PLANS, DETAILS, ETC., SHOWN ON THIS DOCUMENT ARE THE PROPERTY OF GIBRALTAR DESIGN AND WERE CREATED FOR USE ON THIS SPECIFIC PROJECT. NONE OF THIS INFORMATION SHALL BE USED BY ANY PERSON OR FIRM FOR ANY PURPOSE WITHOUT THE EXPRESS WRITTEN CONSENT OF GIBRALTAR DESIGN. THE OWNER MAY RETAIN COPIES FOR INFORMATION AND REFERENCE IN CONNECTION ONLY WITH THIS PROJECT.

© GIBRALTAR DESIGN





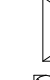
C

SHEET

S201

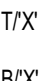

## WESTCHESTER INTERMEDIATE SCHOOL - ADDITIONS & RENOVATIONS

| FRAMING PLAN NOTES  |   |
|---|---|
| 1.  | REF: S001 & S002 FOR STRUCTURAL NOTES, DESIGN DATA, SCHEDULES & LEGENDS.  |
| 2.  | REF: THE S410 & S430 SERIES FOR TYPICAL FRAMING AND MASONRY DETAILS.  |
| 3.  | ALL CONTRACTORS ARE REQUIRED TO COORDINATE THEIR WORK WITH ALL DISCIPLINES TO AVOID CONFLICTS. THE MECHANICAL, ELECTRICAL, AND PLUMBING ASPECTS ARE NOT IN THE SCOPE OF THESE DRAWINGS. THEREFORE, ALL REQUIRED MATERIALS AND WORK MAY NOT BE INDICATED.  |
| 4.  | ALL ELEVATIONS ARE REFERENCED FROM THE FIRST FLOOR FIN. FLOOR ELEVATION =+0.00. USSES ELEVATION WITH CIVL DWGS.   |
| 5.  | SEE FOUNDATION PLANS FOR SIZES OF STEEL COLUMNS SUPPORTED ON FOUNDATIONS.   |
| 6.  | INSTALL CONTINUOUS JOIST AT ALL PERIMETER ROOF EDGES. SEE DETAIL 136-410 FOR ATTACHMENT TO BEAM AND FOR ALL CONDITIONS NOT SPECIFICALLY DEFINED IN FRAMING SECTIONS.  |
| 7.  | ALL WALLS SHALL BE LAID OUT FROM THE ARCHITECTURAL DRAWINGS.  |
| 8.  | REF: ARCH. DRAWINGS FOR ALL DIMENSIONS NOT SHOWN. CONTRACTOR SHALL VERIFY ALL DIMENSIONS PRIOR TO CONSTRUCTION AND IMMEDIATELY NOTIFY ARCHITECT OF ANY DISCREPANCIES.   |
| 9.  | COORDINATE EXACT SIZE & LOCATION OF ANY MECHANICAL OPENINGS IN FLOOR SLAB, ROOF DECK, OR WALLS WITH THE MEP CONTRACTORS. LOCATION & SIZE OF ALL DUCT OPENINGS, GRILLES, ETC. SHALL BE VERIFIED PRIOR TO CONSTRUCTION.   |
| 10.   | ALL ELEVATIONS SHOWN ON PLAN INDICATE TOP OF STEEL BEAM UNLESS NOTED OTHERWISE.   |
| 11.   | PROVIDE FRAMES AT ALL ROOF DRAINS, ROOF HATCHES & OTHER ROOF OPENINGS PER TYPICAL DETAILS IN S410. COORD. EXACT NUMBER, LOCATIONS & DIMENSIONS WITH THE APPROPRIATE CONTRACTORS & THE ARCH. & MEP DWGS.   |
| 12.   | PROVIDE CMU REINFORCING AS NOTED ON PLANS. IF NOT SHOWN ON PLANS OR DETAIL MINIMUM CMU WALL REINFORCING TO BE #5 BARS @ 48" OC. PROVIDE OPEN-CORR BOND BEAMS AT TOPS OF WALLS & AT CHANGES IN CMU THICKNESS, AND WHERE INTERUPTED ON PLANS & SECTIONS (10" C/C MAX VERTICAL SPACING). PROVIDE 12 OF INTERRUPTED VERTICALS AT JAMS OF OPENINGS TO PROVIDE ADDITIONAL VERTS AT ENDS OF WALLS. |
| 13.   | ALL MASONRY BOND BEAMS, OTHER THAN BOND BEAM UNITS OVER OPENINGS, SHALL BE "OPEN-CORR" BOND BEAMS TO ALLOW VERTICAL REINFORCING TO PASS THROUGH, WITHOUT NOTED OTHERWISE.   |
| 14.   | REF: ARCH. DWGS. FOR MASONRY CONTROL & EXPANSION JOINT LOCATIONS.   |
| 15.   | ALL HORIZONTAL AND DIAGONAL BRIDGING FOR STEEL JOISTS SHALL BE DESIGNED, LOCATED & PROVIDED BY THE JOIST SUPPLIER REF S33 SPECIFICATIONS.   |
| 16.   | FOR ESTIMATING AND BIDDING PURPOSES ONLY, ASSUME AN AVERAGE 12" THICKNESS OF CONCRETE WILL BE NECESSARY FOR ALL ELEVATED SLABS ON METAL DECK. THE NATURE OF THIS REQUIREMENT IS TO ACCOUNT FOR ANTICIPATED DEAD LOAD FROM FINISHES, PARTITION WALLS, ETC. THE THICKNESS OF CONCRETE AND FINISHES REQUIREMENTS ARE DEFINED IN THE SPECIFICATION.   |
| 17.   | ALL EXISTING FRAMING JOISTS SUPPORTED BY LOAD BEARING WALLS, CMU ABOVE NEW OPENINGS, ETC. (E.I. TO BE REMOVED) ARE TO BE REMOVED. PROVIDE EXISTING CONSTRUCTION AND INSTALLATION OF ALL NEW CONSTRUCTION. CONTRACTOR IS RESPONSIBLE FOR ALL SHORING DESIGN AND IMPLEMENTATION.  |
| 18.   | PLAN MARKING:   |
| F.F.  | DENOTES FIN. FLOOR  |
| T/X   | DENOTES TOP OF STEEL SLAB, ETC.   |
| B/X   | DENOTES BOTTOM OF UNITEL, ETC.  |
|    | DENOTES 12" TO 24 GA. GALV. & PRIME-PANDED W/BE STEEL ROOF DECK. REF. DETAIL 250-04.  |
|    | DENOTES BEAM-TO-COLUMN MOMENT CONNECTION. REF. DETAILS OF S405.   |
|    | DENOTES BEAM-THRU-BEAM MOMENT CONNECTION. REF. DETAILS ON S404.   |
|    | DENOTES BRACED FRAME OR KICKER LOCATION.  |
|    | DENOTES APPROX. LOCATION OF OPENING IN DECK/SLAB. REF. DETAILS ON S410 FOR TYPICAL TREATING METHODS. FOR MULTIPLE CLOSELY SPACED OPENINGS, TRUSS AS ONE LARGE OPENING.  |
| 19.   | WIDE-FLANGE BEAM & GIRDER NOTATION:   |
| BEAM REACTIONS SHOWN IN KIPS TO BE USED FOR DESIGN OF SHEAR CONNECTION BY STEEL FABRICATOR'S SEE (ALLOWABLE STEEL DESIGN LOADS UNFACTORED)                      |   |
| THE STEEL CONNECTION NOTES ON S303 FOR DESIGN OF CONNECTIONS AT BEAMS & GIRDERS WITH NO REACTION SHOWN. THE MIN. SHEAR CONNECTION DESIGN LOAD SHALL BE 15 KIPS. |   |



9102 N. Meridian St., Ste. 300  
Indianapolis, IN 46260  
Homepage [www.GibraltarDesign.com](http://www.GibraltarDesign.com)  
Email [info@GibraltarDesign.com](mailto:info@GibraltarDesign.com)  
Phone 317.580.5777 Fax 317.580.5778

THE CONCEPTS, DESIGNS, PLANS, DETAILS, ETC., SHOWN ON THIS DOCUMENT ARE THE PROPERTY OF CIBRALTA DESIGN AND WERE CREATED FOR USE ON THIS SPECIFIC PROJECT. NO PART OF THIS INFORMATION MAY BE USED BY ANY PERSON OR FIRM FOR ANY PURPOSE WITHOUT THE EXPRESS WRITTEN CONSENT OF CIBRALTA DESIGN. THE OWNER MAY RETAIN COPIES FOR INFORMATION AND REFERENCE IN CONNECTION ONLY WITH THIS PROJECT.


DRAWING  
ROOF FRAMING PLAN - UNIT  
D

© GIBRALTAR DESIGN

SHEET



D


S202

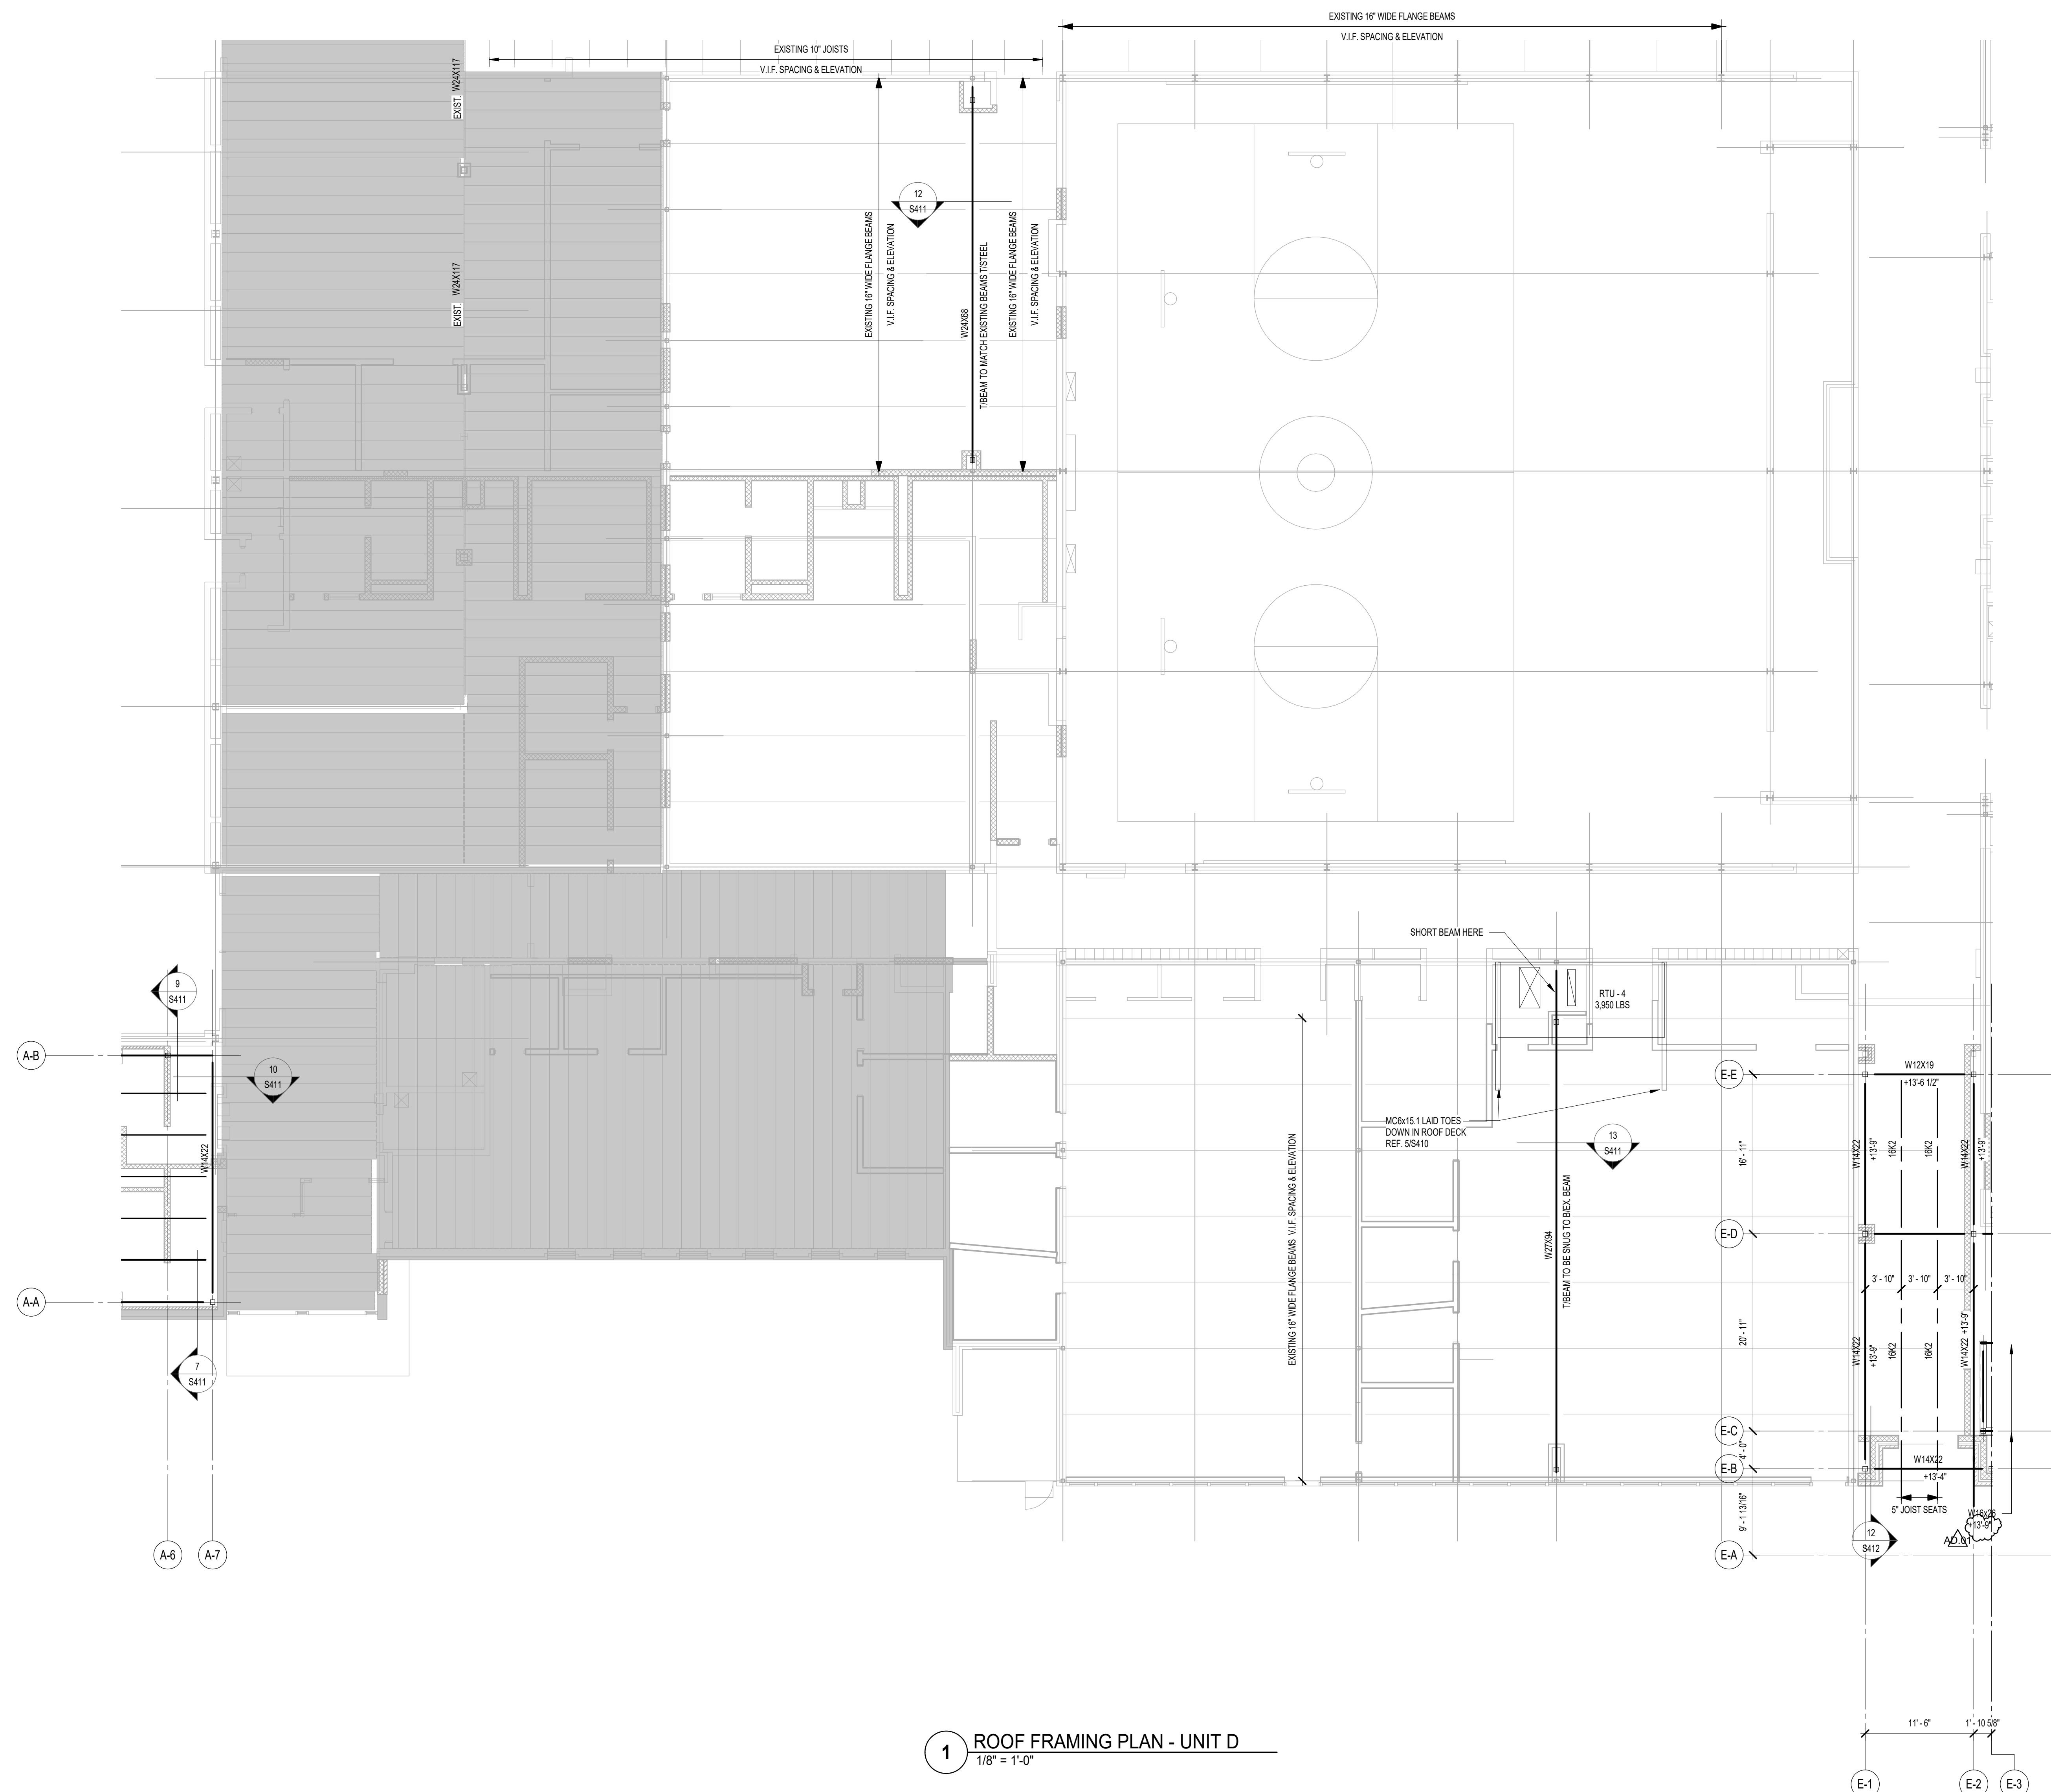

1 ROOF FRAMING PLAN - UNIT D  
1/8" = 1'-0"



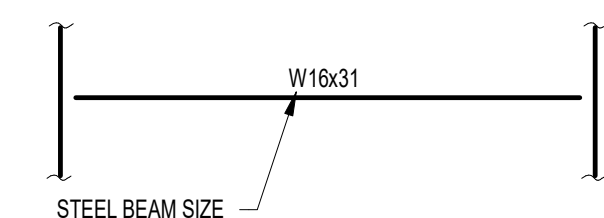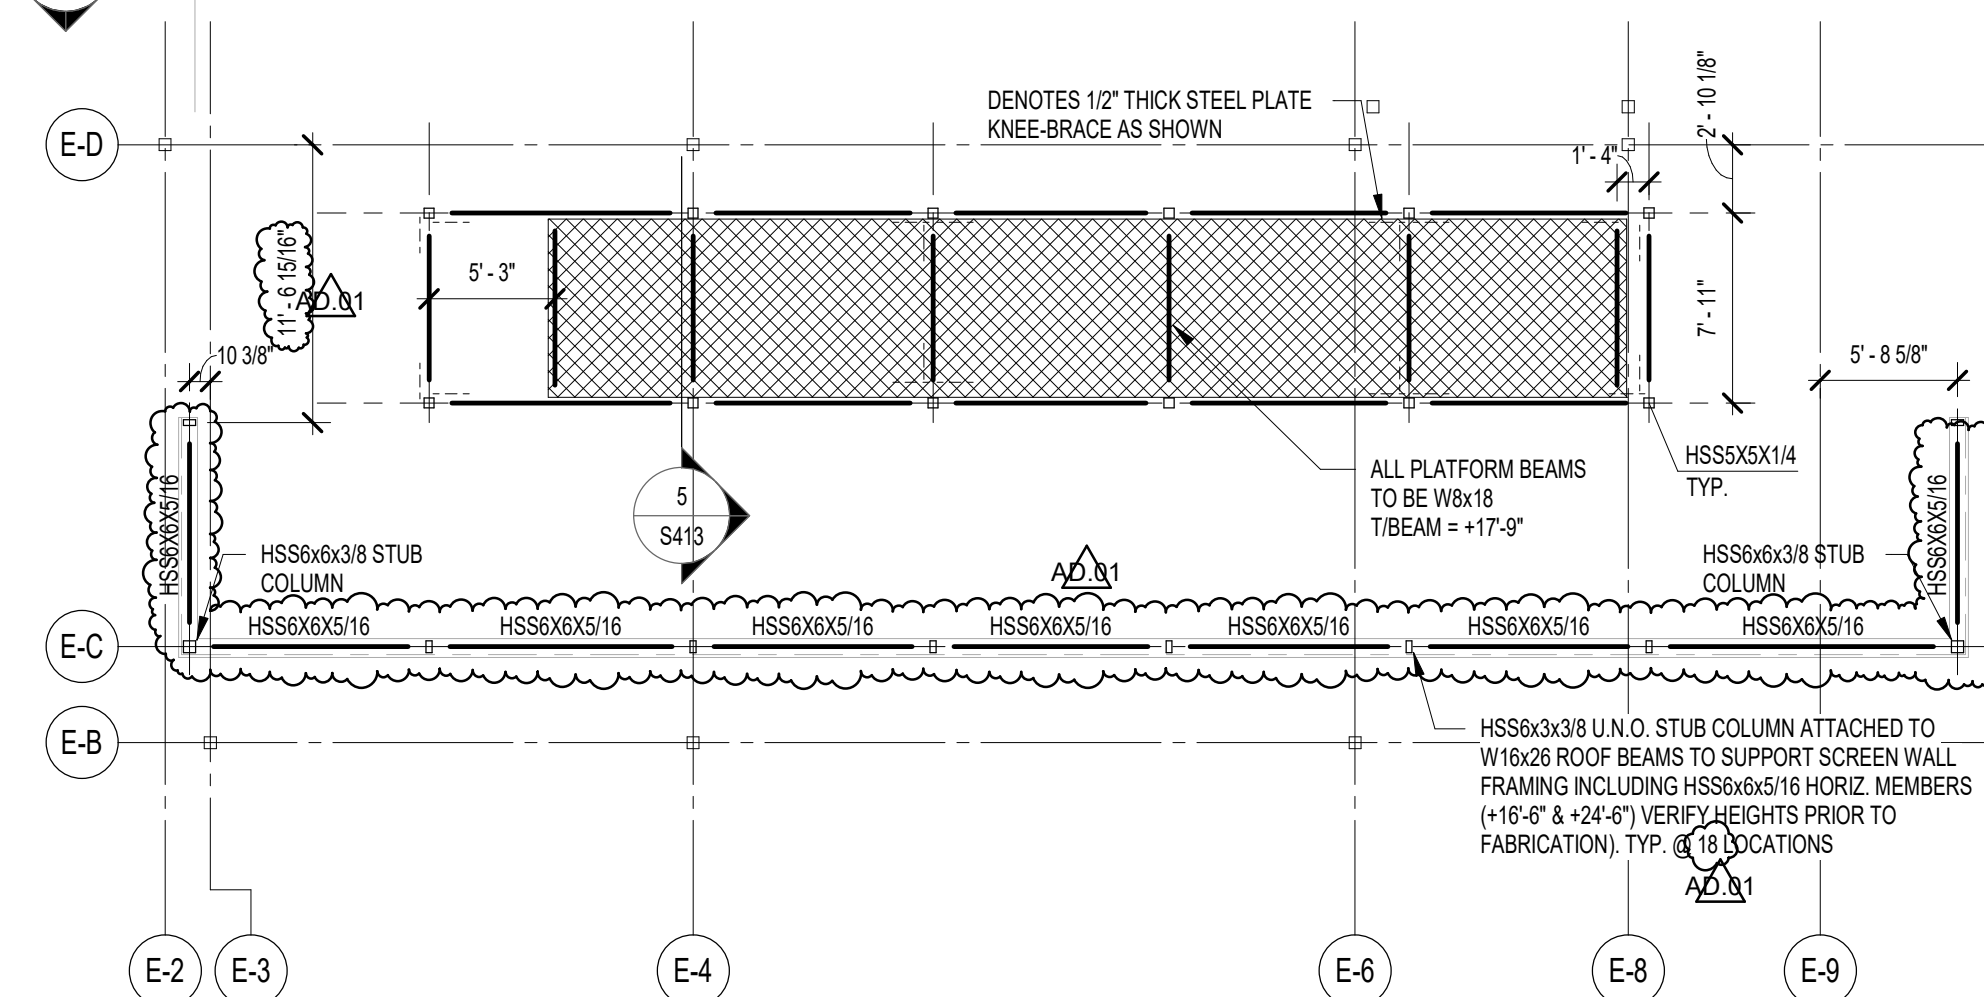

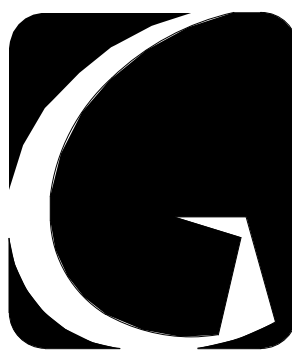


**GIBRALTAR**  
DESIGN  
ARCHITECTURE • ENGINEERING • INTERIOR DESIGN

PROJECT

**WESTCHESTER  
INTERMEDIATE  
SCHOOL -  
ADDITIONS &  
RENOVATIONS**

DUNELAND SCHOOL CORPORATION  
CHESTERTON, INDIANA

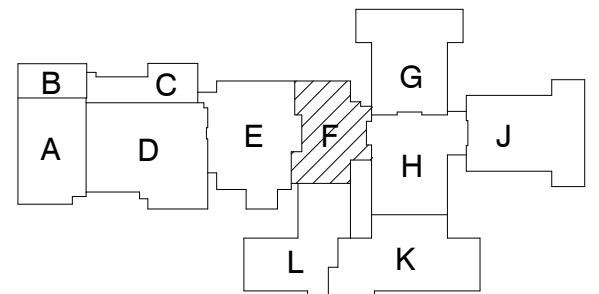

KEY PLAN

**GIBRALTAR DESIGN**

9102 N. Meridian St., Ste. 300  
Indianapolis, IN 46260  
Homepage: www.GibraltarDesign.com  
Email: info@GibraltarDesign.com  
Phone: 317.580.5777 Fax: 317.580.5778

PROJECT

21116

DATE

3-3-2022

COORDINATED BY

JMS

DRAWN BY

JMS

CHECKED BY

SAC



COPYRIGHT NOTICE:  
THE CONCEPTS, DESIGN, PLANS, DETAILS, ETC. SHOWN ON THIS DOCUMENT ARE THE PROPERTY OF GIBRALTAR DESIGN AND WERE CREATED FOR USE ON THIS SPECIFIC PROJECT. NONE OF THIS INFORMATION SHALL BE USED BY ANY PERSON OR FIRM FOR ANY PURPOSE WITHOUT THE EXPRESS WRITTEN CONSENT OF GIBRALTAR DESIGN. THE OWNER MAY RETAIN COPIES FOR INFORMATION AND REFERENCE IN CONNECTION ONLY WITH THIS PROJECT.

REVISIONS

MARK DATE ISSUED FOR

AD-0.1 3/16/2022 ADDENDUM #1

DRAWING

ROOF FRAMING PLAN - UNIT F

PROJECT

**WESTCHESTER IS - ADDITIONS &  
RENOVATIONS**

© GIBRALTAR DESIGN

SHEET

F

S204

## FRAMING PLAN NOTES

- REF. S001 & S002 FOR STRUCTURAL NOTES, DESIGN DATA, SCHEDULES & LEGENDS.
- REF. THE S410 & S430 SERIES FOR TYPICAL FRAMING AND MASONRY DETAILS.
- ALL CONTRACTORS ARE REQUIRED TO COORDINATE THEIR WORK WITH ALL DISCIPLINES TO AVOID CONFLICTS. THE MECHANICAL, ELECTRICAL, AND PLUMBING ASPECTS ARE NOT IN THE SCOPE OF THESE DRAWINGS. THEREFORE, ALL REQUIRED MATERIALS AND WORK MAY NOT BE INDICATED.
- ALL ELEVATIONS ARE REFERENCED FROM THE FIRST FLOOR FIN. FLOOR ELEVATION +0'-0". COORD. USGS ELEVATION WITH CIVIL DWGS.
- SEE FOUNDATION PLANS FOR SIZES OF STEEL COLUMNS SUPPORTED ON FOUNDATIONS.
- INSTALL CONTINUOUS ANGLES AT ALL PERIMETER ROOF EDGES. SEE DETAIL 3/S-410 FOR ATTACHMENT TO BEAM AND FOR ALL CONDITIONS NOT SPECIFICALLY DEFINED IN FRAMING SECTIONS.
- ALL WALLS SHALL BE LAID OUT FROM THE ARCHITECTURAL DRAWINGS.
- REF. ARCH. DRAWINGS FOR ALL DIMENSIONS NOT SHOWN. CONTRACTOR SHALL VERIFY ALL DIMENSIONS PRIOR TO CONSTRUCTION AND IMMEDIATELY NOTIFY ARCHITECT/ENGINEER OF ANY DISCREPANCIES.
- COORDINATE EXACT SIZE & LOCATION OF ANY MECHANICAL OPENINGS IN FLOOR SLAB, ROOF DECK, OR WALLS WITH THE MEP CONTRACTORS. LOCATION & SIZE OF ALL DUCT OPENINGS, GRILLES, ETC. SHALL BE VERIFIED PRIOR TO CONSTRUCTION.
- ALL ELEVATIONS SHOWN ON PLAN INDICATE TOP OF STEEL BEAM UNLESS NOTED OTHERWISE.
- PROVIDE FRAMES AT ALL ROOF DRAINS, ROOF HATCHES & OTHER ROOF OPENINGS PER TYPICAL DETAILS ON S410. COORD. EXACT NUMBER, LOCATION & DIMENSIONS WITH THE APPROPRIATE CONTRACTORS & THE ARCH. & MEP DWGS.
- PROVIDE CMU REINFORCING AS NOTED ON PLANS. IF NOT SHOWN ON PLANS OR DETAILS, MINIMUM CMU WALL REINFORCING TO BE #6 VERTS @ 48" O.C. PROVIDE OPEN-CORE BOND BEAMS AT TOPS OF WALLS, AT CHANGES IN CMU THICKNESS, AND WHERE INDICATED ON PLANS & SECTIONS (10'-0" O.C. MAX VERTICAL SPACING). PROVIDE 1/2" OF INTERRUPTED VERTICALS AT JAMBS OF OPENINGS AND PROVIDE ADDITIONAL VERTS AT ENDS OF WALLS.
- ALL MASONRY BOND BEAMS, OTHER THAN BOND BEAM LINTELS OVER OPENINGS, SHALL BE "OPEN-CORE" BOND BEAMS TO ALLOW VERTICAL REINFORCING TO PASS THROUGH, UNLESS NOTED OTHERWISE.
- REF. ARCH. DWGS. FOR MASONRY CONTROL & EXPANSION JOINT LOCATIONS.
- ALL HORIZONTAL AND DIAGONAL BRIDGING FOR STEEL JOISTS SHALL BE DESIGNED, LOCATED & PROVIDED BY THE JOIST SUPPLIER PER SJ SPECIFICATIONS.
- FOR ESTIMATING AND BIDDING PURPOSES ONLY. ASSUME AN ADDITIONAL 1/2" THICKNESS OF CONCRETE WILL BE NECESSARY FOR ALL ELEVATED SLABS ON METAL DECK. THE INTENT OF THIS REQUIREMENT IS TO ACCOUNT FOR ANTICIPATED DEAD LOAD DEFLECTION IN THE SUPPORTING STRUCTURE. THE PINKED SLABS SHALL MEET THE FLAMMABILITY REQUIREMENTS DEFINED IN THE SPECIFICATION.
- ALL EXISTING FRAMING (JOIST SUPPORTED BY LOAD-BEARING WALLS, CMU ABOVE NEW OPENINGS, ETC.) IS TO BE SHORED DURING DEMOLITION OF EXISTING CONSTRUCTION AND INSTALLATION OF ALL NEW CONSTRUCTION. CONTRACTOR IS RESPONSIBLE FOR ALL SHORING DESIGN AND IMPLEMENTATION.

AD-0.1

18. FLAMING LEGEND

F.F. DENOTES FIN. FLOOR

T/X DENOTES TOP OF STEEL, SLAB, ETC.

B/X DENOTES BOTTOM OF LINTEL, ETC.

(R) DENOTES 11", 20 GA. GALV. & PRIME-PAINTED WIDE RIB STEEL ROOF DECK. REF. DETAIL 2/S404.

— DENOTES BEAM-TO-COLUMN MOMENT CONNECTION. REF. DETAILS ON S405.

— DENOTES BEAM-THRU-BEAM MOMENT CONNECTION. REF. DETAILS ON S404.

— DENOTES BRACED FRAME OR KICKER LOCATION

— DENOTES APPROX. LOCATION OF OPENING IN DECK/SLAB. REF. DETAILS ON S410 FOR TYPICAL OPENING FRAMES. FOR MULTIPLE CLOSELY SPACED OPENINGS, TREAT AS ONE LARGE OPENING.

1 ROOF FRAMING PLAN - UNIT F  
1/8" = 1'-0"




**GIBRALTAR**  
DESIGN  
ARCHITECTURE • ENGINEERING • INTERIOR DESIGN

PROJECT

**WESTCHESTER  
INTERMEDIATE  
SCHOOL -  
ADDITIONS &  
RENOVATIONS**

DUNELAND SCHOOL CORPORATION  
CHESTERTON, INDIANA

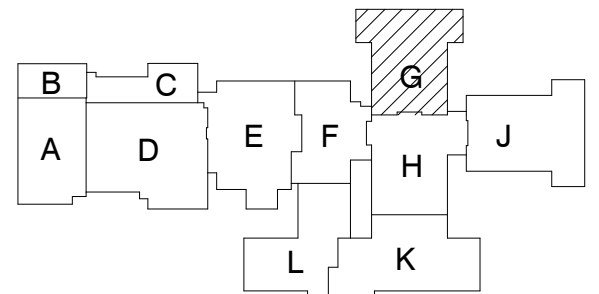

KEY PLAN

**GIBRALTAR DESIGN**

9102 N. Meridian St., Ste. 300  
Indianapolis, IN 46260  
Homepage: www.GibraltarDesign.com  
Email: info@GibraltarDesign.com  
Phone: 317.580.5777 Fax: 317.580.5778

PROJECT

21116

DATE

3-3-2022

COORDINATED BY


JMS

DRAWN BY

JMS

CHECKED BY

SAC

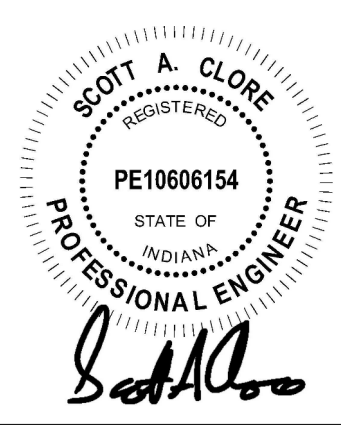

COPYRIGHT NOTICE:  
THE CONCEPTS, DESIGN, PLANS, DETAILS, ETC. SHOWN ON THIS DOCUMENT ARE THE PROPERTY OF GIBRALTAR DESIGN AND WERE CREATED FOR USE ON THIS SPECIFIC PROJECT. NONE OF THIS INFORMATION SHALL BE USED BY ANY PERSON OR FIRM FOR ANY PURPOSE WITHOUT THE EXPRESS WRITTEN CONSENT OF GIBRALTAR DESIGN. THE OWNER MAY RETAIN COPIES FOR INFORMATION AND REFERENCE IN CONNECTION ONLY WITH THIS PROJECT.

REVISIONS

MARK DATE ISSUED FOR

AD-0.1 3/16/2022 ADDENDUM #1

DRAWING

ROOF FRAMING PLAN - UNIT G

PROJECT

WESTCHESTER IS - ADDITIONS &  
RENOVATIONS

© GIBRALTAR DESIGN

SHEET

G


S205

## FRAMING PLAN NOTES

- REF. S001 & S002 FOR STRUCTURAL NOTES, DESIGN DATA, SCHEDULES & LEGENDS.
- REF. THE S410 & S430 SERIES FOR TYPICAL FRAMING AND MASONRY DETAILS.
- ALL CONTRACTORS ARE REQUIRED TO COORDINATE THEIR WORK WITH ALL DISCIPLINES TO AVOID CONFLICTS. THE MECHANICAL, ELECTRICAL, AND PLUMBING ASPECTS ARE NOT IN THE SCOPE OF THESE DRAWINGS. THEREFORE, ALL REQUIRED MATERIALS AND WORK MAY NOT BE INDICATED.
- ALL ELEVATIONS ARE REFERENCED FROM THE FIRST FLOOR FIN. FLOOR ELEVATION +0'-0". COORD. USGS ELEVATION WITH CIVIL DWGS.
- SEE FOUNDATION PLANS FOR SIZES OF STEEL COLUMNS SUPPORTED ON FOUNDATIONS.
- INSTALL CONTINUOUS ANGLES AT ALL PERIMETER ROOF EDGES. SEE DETAIL 3S-410 FOR ATTACHMENT TO BEAM AND FOR ALL CONDITIONS NOT SPECIFICALLY DEFINED IN FRAMING SECTIONS.
- ALL WALLS SHALL BE LAID OUT FROM THE ARCHITECTURAL DRAWINGS.
- REF. ARCH. DRAWINGS FOR ALL DIMENSIONS NOT SHOWN. CONTRACTOR SHALL VERIFY ALL DIMENSIONS PRIOR TO CONSTRUCTION AND IMMEDIATELY NOTIFY ARCHITECT/ENGINEER OF ANY DISCREPANCIES.
- COORDINATE EXACT SIZE & LOCATION OF ANY MECHANICAL OPENINGS IN FLOOR SLAB, ROOF DECK, OR WALLS WITH THE MEP CONTRACTORS. LOCATION & SIZE OF ALL DUCT OPENINGS, GRILLES, ETC. SHALL BE VERIFIED PRIOR TO CONSTRUCTION.
- ALL ELEVATIONS SHOWN ON PLAN INDICATE TOP OF STEEL BEAM UNLESS NOTED OTHERWISE.
- PROVIDE FRAMES AT ALL ROOF DRAINS, ROOF HATCHES & OTHER ROOF OPENINGS PER TYPICAL DETAILS ON S410. COORD. EXACT NUMBER, LOCATIONS & DIMENSIONS WITH THE APPROPRIATE CONTRACTORS & THE ARCH. & MEP DWGS.
- PROVIDE CMU REINFORCING AS NOTED ON PLANS. IF NOT SHOWN ON PLANS OR DETAILS, MINIMUM CMU WALL REINFORCING TO BE #5 VERTS @ 48" O.C. PROVIDE OPEN-CORE BOND BEAMS AT TOPS OF WALLS, AT CHANGES IN CMU THICKNESS, AND WHERE INDICATED ON PLANS & SECTIONS (10'-0" O.C. MAX VERTICAL SPACING). PROVIDE 1/2" OF INTERRUPTED VERTICALS AT JAMBS OF OPENINGS AND PROVIDE ADDITIONAL VERTS AT ENDS OF WALLS.
- ALL MASONRY BOND BEAMS, OTHER THAN BOND BEAM LINTELS OVER OPENINGS, SHALL BE "OPEN-CORE" BOND BEAMS TO ALLOW VERTICAL REINFORCING TO PASS THROUGH, UNLESS NOTED OTHERWISE.
- REF. ARCH. DWGS. FOR MASONRY CONTROL & EXPANSION JOINT LOCATIONS.
- ALL HORIZONTAL AND DIAGONAL BRIDGING FOR STEEL JOISTS SHALL BE DESIGNED, LOCATED & PROVIDED BY THE JOIST SUPPLIER PER S4 SPECIFICATIONS.
- FOR ESTIMATING AND BIDDING PURPOSES ONLY. ASSUME AN ADDITIONAL 1/2" THICKNESS OF CONCRETE WILL BE NECESSARY FOR ALL ELEVATED SLABS ON METAL DECK. THE INTENT OF THIS REQUIREMENT IS TO ACCOUNT FOR ANTICIPATED DEAD LOAD DEFLECTION IN THE SUPPORTING STRUCTURE. THE FINISHED SLABS SHALL MEET THE FLATNESS REQUIREMENTS DEFINED IN THE SPECIFICATION, Y.
- ALL EXISTING FRAMING (JOIST SUPPORTED BY LOAD-BEARING WALLS, CMU ABOVE NEW OPENINGS, ETC.) IS TO BE SHORED DURING DEMOLITION OF EXISTING CONSTRUCTION AND INSTALLATION OF ALL NEW CONSTRUCTION. CONTRACTOR IS RESPONSIBLE FOR ALL SHORING DESIGN AND IMPLEMENTATION.

### 18. FLAM LEGEND

- F.F. DENOTES FIN. FLOOR
- T/X DENOTES TOP OF STEEL, SLAB, ETC.
- B/X DENOTES BOTTOM OF LINTEL, ETC.
- (R) DENOTES 11/2" 20 GA. GALV. & PRIME-PAINTED WIDE RIB STEEL ROOF DECK. REF. DETAIL 2S404.
- △ DENOTES BEAM-TO-COLUMN MOMENT CONNECTION. REF. DETAILS ON S405.
- DENOTES BEAM-THRU-BEAM MOMENT CONNECTION. REF. DETAILS ON S404.
- DENOTES BRACED FRAME OR KICKER LOCATION
- ⊠ DENOTES APPROX. LOCATION OF OPENING IN DECK/SLAB. REF. DETAILS ON S410 FOR TYPICAL OPENING FRAMES. FOR MULTIPLE CLOSELY SPACED OPENINGS, TREAT AS ONE LARGE OPENING.
- ⊠ ⊠ ⊠ ⊠
18. WIDE-FLANGE BEAM & GIRDER NOTATION:
- BEAM REACTIONS SHOWN IN KIPS TO BE USED FOR DESIGN OF SHEAR CONNECTION BY STEEL FABRICATOR'S SEE (ALLOWABLE STRESS DESIGN / LOADS UNFACTORED).
- REF. THE STEEL CONNECTION NOTES ON S001 FOR DESIGN OF CONNECTIONS AT BEAMS & GIRDERS WITH NO REACTION SHOWN. THE MIN. SHEAR CONNECTION DESIGN LOAD SHALL BE 15 KIPS.

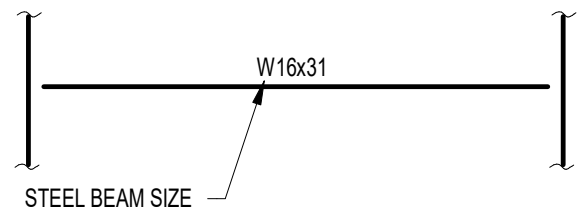
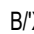

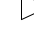



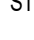

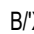

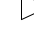



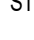

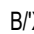

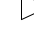



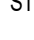


1 ROOF FRAMING PLAN - UNIT G  
1/8" = 1'-0"





WESTCHESTER  
INTERMEDIATE  
SCHOOL -  
ADDITIONS &  
RENOVATIONS

| FRAMING PLAN NOTES   |  |   |                    |   |                                 |   |                                |   |   |   |   |   |   |   |  |   |  |
|--|--|---|--------------------|---|---------------------------------|---|--------------------------------|---|---|---|---|---|---|---|--|---|--|
| 1.   | REF. S001 & S002 FOR STRUCTURAL NOTES, DESIGN DATA, SCHEDULES & LEGENDS.   |   |                    |   |                                 |   |                                |   |   |   |   |   |   |   |  |   |  |
| 2.   | REF. THE S410 & S430 SERIES FOR TYPICAL FRAMING AND MASONRY DETAILS.   |   |                    |   |                                 |   |                                |   |   |   |   |   |   |   |  |   |  |
| 3.   | ALL CONTRACTORS ARE REQUIRED TO COORDINATE THEIR WORK WITH ALL DISCIPLINES TO AVOID CONFLICTS. THE MECHANICAL, ELECTRICAL, AND PLUMBING ASPECTS ARE NOT IN THE SCOPE OF THESE DRAWINGS. THEREFORE, ALL REQUIRED MATERIALS AND WORK MAY NOT BE INDICATED.   |   |                    |   |                                 |   |                                |   |   |   |   |   |   |   |  |   |  |
| 4.   | ALL ELEVATIONS ARE REFERENCED FROM THE FIRST FLOOR FIN. FLOOR ELEVATION OF 0'-0" COORD. USGS ELEVATION WITH CIVIL DWGS.  |   |                    |   |                                 |   |                                |   |   |   |   |   |   |   |  |   |  |
| 5.   | SEE FOUNDATION PLANS FOR SIZES OF STEEL COLUMNS SUPPORTING ON FOUNDATIONS.   |   |                    |   |                                 |   |                                |   |   |   |   |   |   |   |  |   |  |
| 6.   | INSTALL CONTINUOUS ANCHORS AT ALL PERIMETER ROOF EDGES. SEE DETAIL S5-40 FOR ATTACHMENT TO BEAM AND FOR ALL CONDITIONS NOT SPECIFICALLY DEFINED IN FRAMING SECTIONS.   |   |                    |   |                                 |   |                                |   |   |   |   |   |   |   |  |   |  |
| 7.   | ALL WALLS SHALL RELIABLY CLUT FROM THE ARCHITECTURAL DRAWINGS.   |   |                    |   |                                 |   |                                |   |   |   |   |   |   |   |  |   |  |
| 8.   | REF. ARCH. DRAWINGS. FOR ALL DIMENSIONS NOT SHOWN, CONTRACTOR SHALL VERIFY ALL DIMENSIONS PRIOR TO CONSTRUCTION AND IMMEDIATELY NOTIFY ARCHITECT/ENGINEER OF ANY DISCREPANCY.  |   |                    |   |                                 |   |                                |   |   |   |   |   |   |   |  |   |  |
| 9.   | COORDINATE EXACT SIZE & LOCATION OF ANY MECHANICAL OPENINGS IN FLOOR SLAB, ROOF DECK OR WALLS WITH THE MEP CONTRACTORS'. LOCATION & SIZE OF ALL DUCT OPENINGS, GRILLES, ETC. SHALL BE VERIFIED PRIOR TO CONSTRUCTION.  |   |                    |   |                                 |   |                                |   |   |   |   |   |   |   |  |   |  |
| 10.  | ALL ELEVATIONS SHOWN ON PLAN INDICATE TOP OF STEEL BEAM UNLESS NOTED OTHERWISE.  |   |                    |   |                                 |   |                                |   |   |   |   |   |   |   |  |   |  |
| 11.  | PROVIDE FRAMES AT ALL ROOF DRAINING, ROOF HATCHES & OTHER ROOF PENINGS PER TYPICAL DETAILS IN S410. COORD. EXACT NUMBER, LOCATIONS & DIMENSIONS WITH THE APPROPRIATE CONTRACTORS & THE ARCH. & MEP DWGS.   |   |                    |   |                                 |   |                                |   |   |   |   |   |   |   |  |   |  |

| 14.  | REF. ARCH. DWGS. FOR MASONRY CONTROL & EXPANSION JOINT LOCATIONS.  |   |                    |   |                                 |   |                                |   |   |   |   |   |   |   |  |   |  |
| 15.  | ALL HORIZONTAL AND DIAGONAL BRIDGING FOR STEEL JOISTS SHALL BE DESIGNED, LOCATED & PROVIDED BY THE JOIST SUPPLIER PER SA'S SPECIFICATIONS.   |   |                    |   |                                 |   |                                |   |   |   |   |   |   |   |  |   |  |


| 18.  | PLAN LEGEND:   |   |                    |   |                                 |   |                                |   |   |   |   |   |   |   |  |   |  |
| <table> <tr> <td></td><td>DENOTES FIN. FLOOR</td></tr> <tr> <td></td><td>DENOTES TOP OF STEEL SLAB, ETC.</td></tr> <tr> <td></td><td>DENOTES BOTTOM OF Lintel, ETC.</td></tr> <tr> <td></td><td>DENOTES BEAM-THRU-BEAM MOMENT CONNECTION. REF. DETAILS ON S404.</td></tr> <tr> <td></td><td>DENOTES BRACED FRAME OR KICKER LOCATION.</td></tr> <tr> <td></td><td>DENOTES APPROX. LOCATION OF OPENING IN DECK/SLAB. REF. DETAILS ON S410 FOR TYPICAL OPENING FRAMES. FOR MULTIPLE CLOSELY SPACED OPENINGS, TREAT AS ONE LARGE OPENING.</td></tr>
| REF. THE STEEL CONNECTION NOTES ON S001 FOR DESIGN OF CONNECTIONS AT BEAMS & GIRDERS WITH NO REINCTION SHOWN. THE MIN. SHEAR CONNECTION DESIGN LOAD SHALL BE 15 KIPS.  |  |   |                    |   |                                 |   |                                |   |   |   |   |   |   |   |  |   |  |



9102 N. Meridian St., Ste. 300  
Indianapolis, IN 46260  
Homepage [www.GibraltarDesign.com](http://www.GibraltarDesign.com)  
Email [info@GibraltarDesign.com](mailto:info@GibraltarDesign.com)  
Phone 317.580.5777 Fax 317.580.5778


**COPYRIGHT NOTICE:**  
THE CONCEPTS, DESIGNS, PLANS, DETAILS, ETC., SHOWN ON  
THIS DOCUMENT ARE THE PROPERTY OF GIBRALTAR DESIGN AND  
WERE CREATED FOR USE ON THIS SPECIFIC PROJECT. NONE OF  
THIS INFORMATION SHALL BE USED BY ANY PERSON OR FIRM  
FOR ANY PURPOSE WITHOUT THE EXPRESS WRITTEN CONSENT OF  
GIBRALTAR DESIGN. THE OWNER MAY RETAIN COPIES FOR  
INFORMATION AND REFERENCE IN CONNECTION ONLY WITH THIS  
PROJECT.

[illegible]

SHEET



J

S206

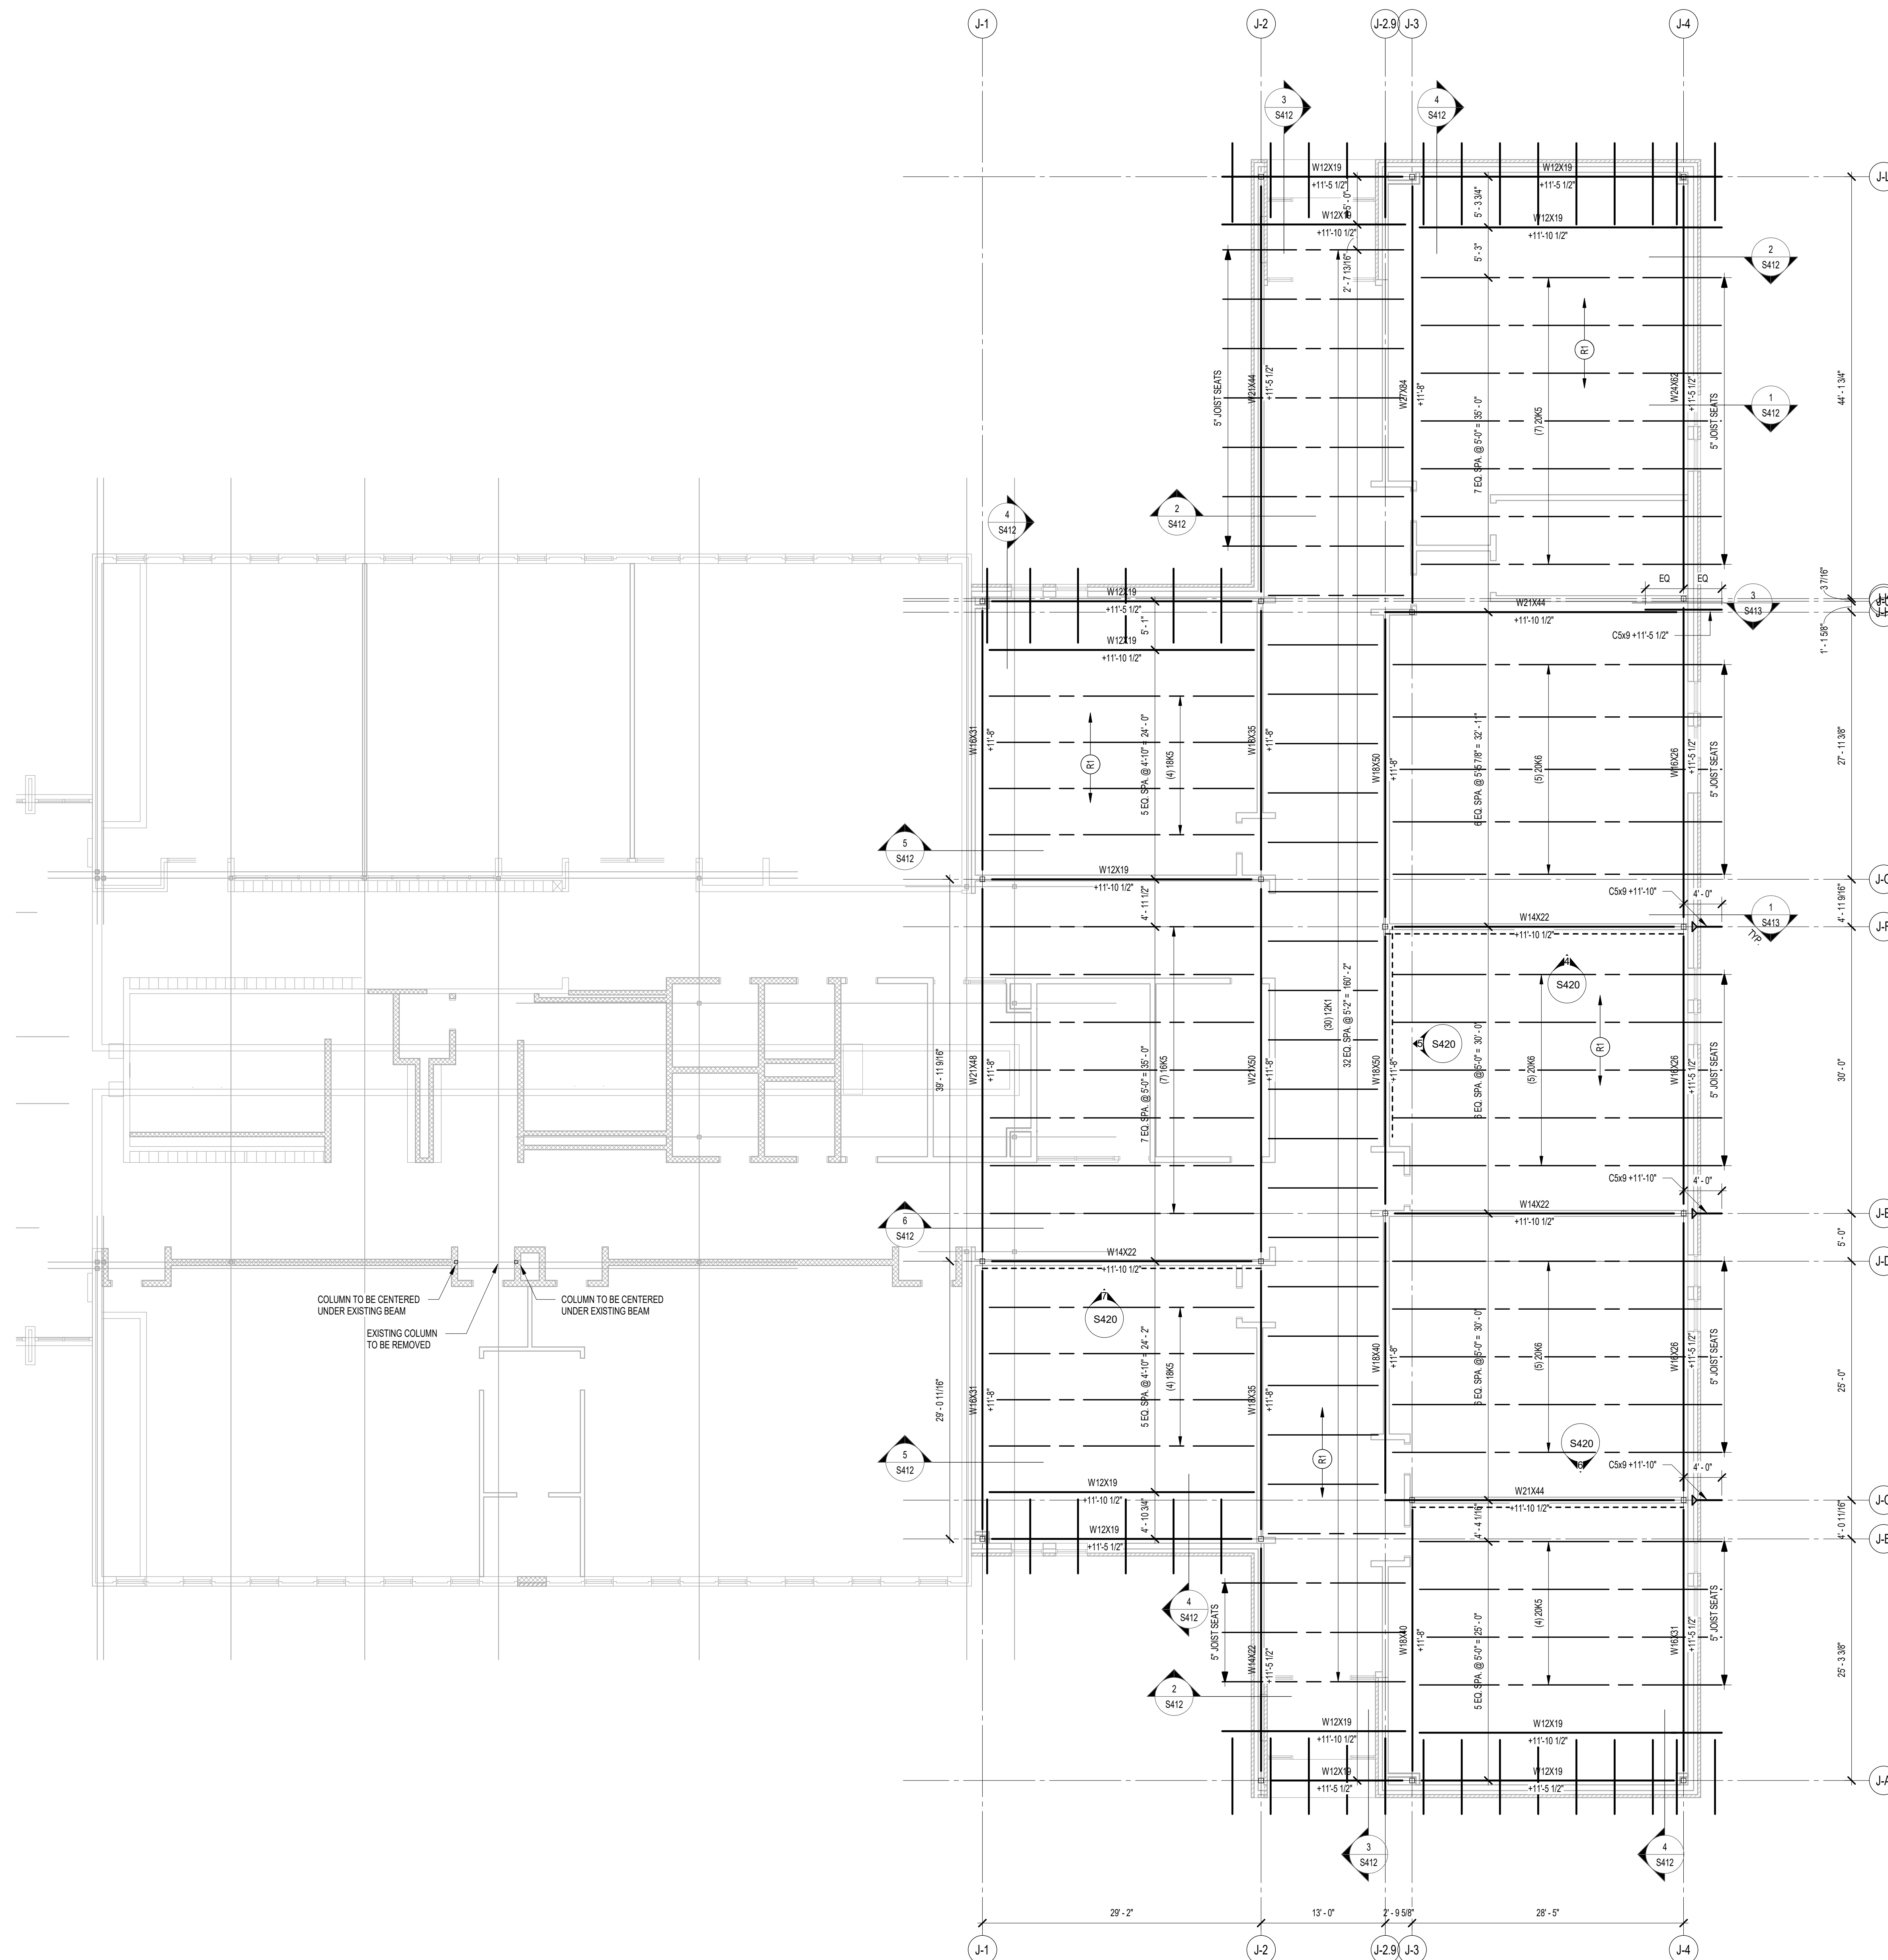

1 ROOF FRAMING PLAN - UNIT J  
1/8" = 1'-0"




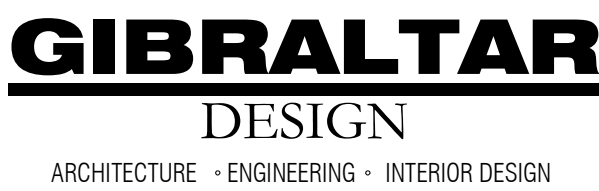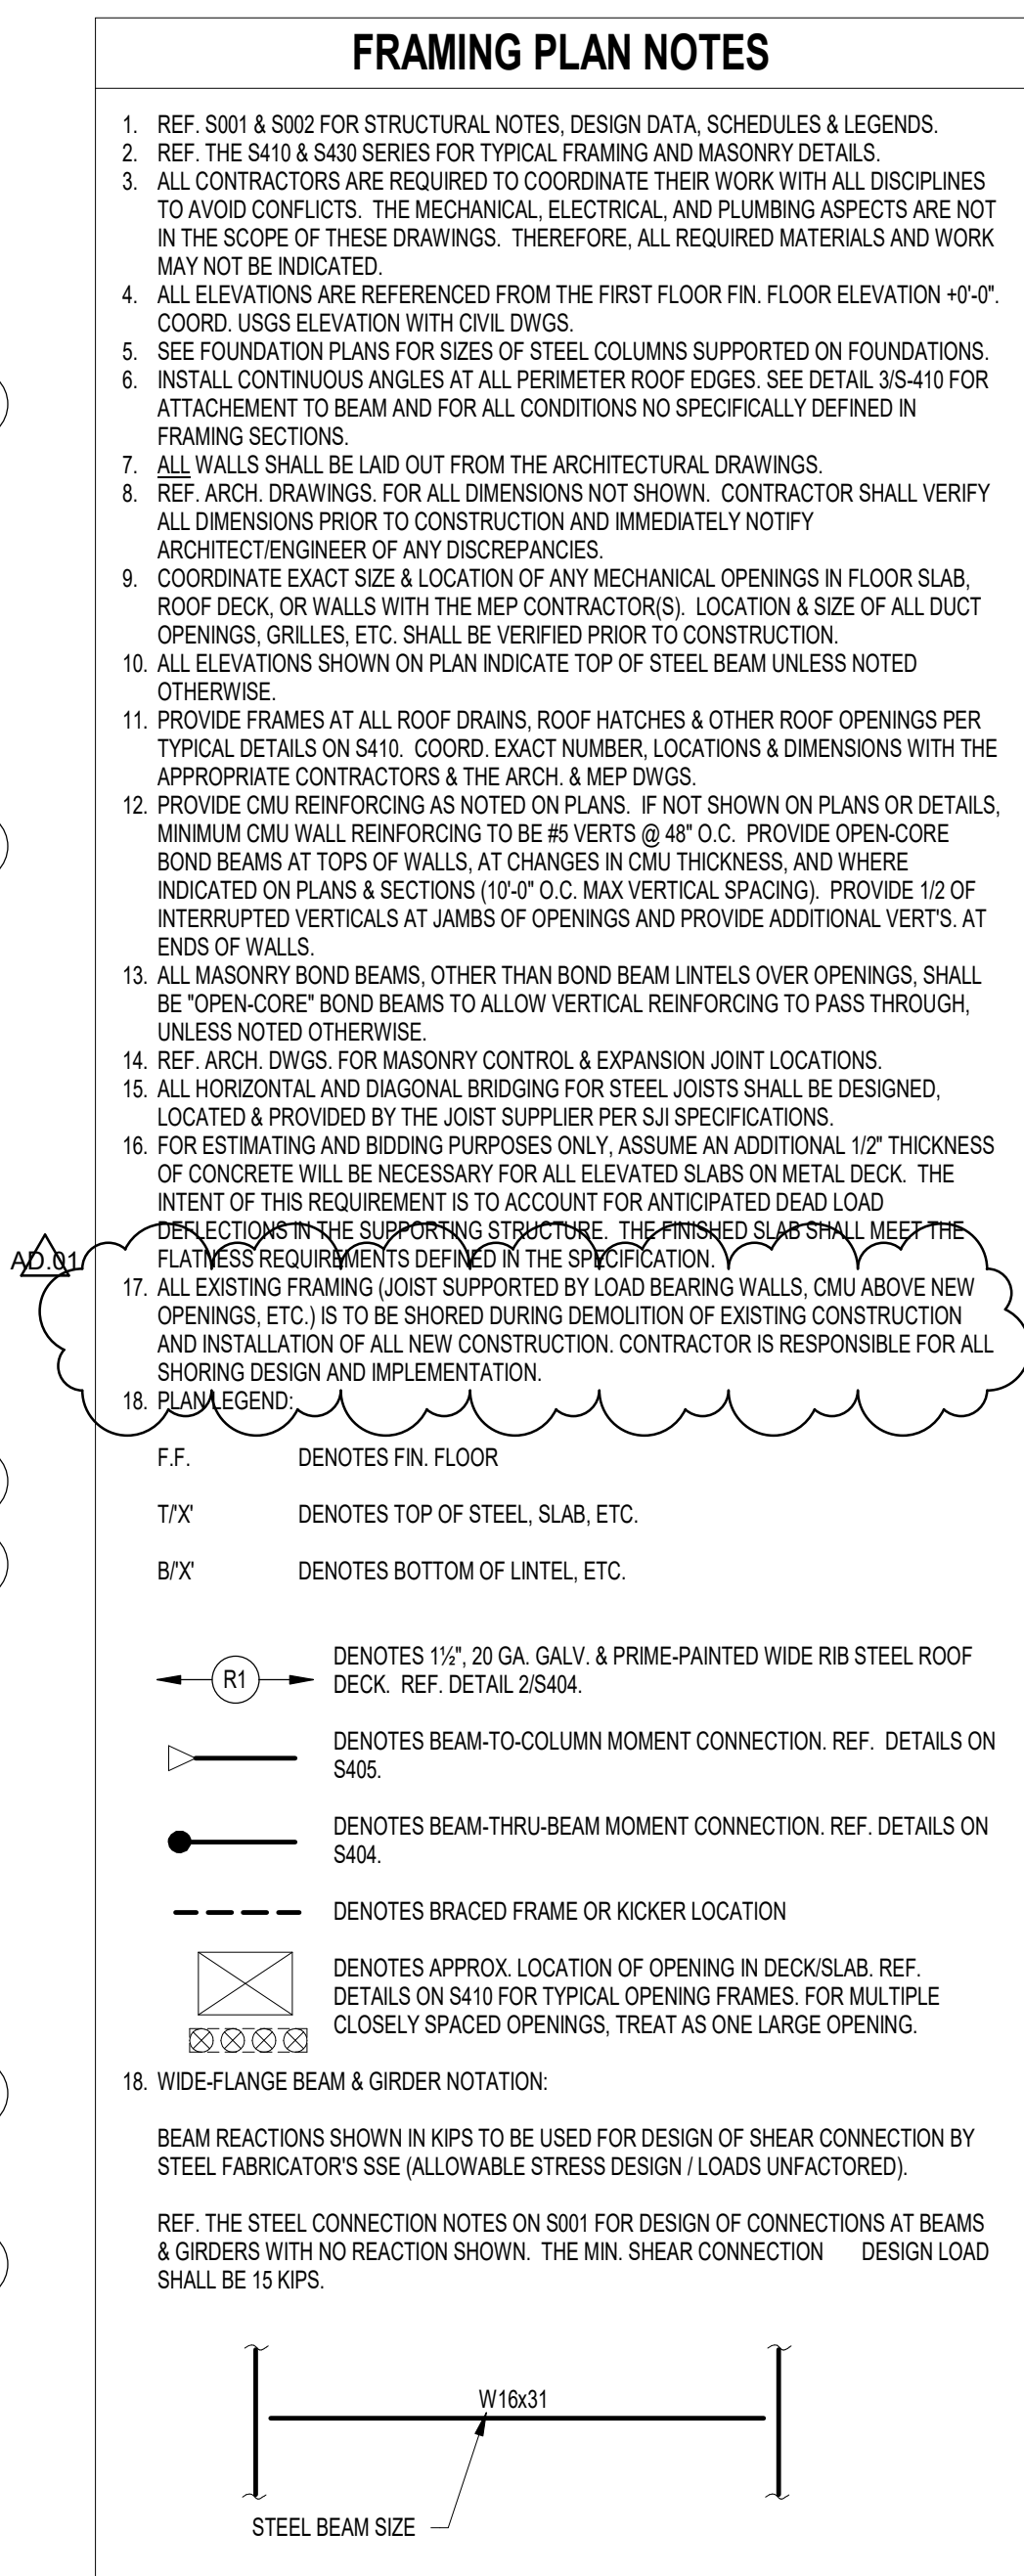

PROJECT

**WESTCHESTER  
INTERMEDIATE  
SCHOOL -  
ADDITIONS &  
RENOVATIONS**


DUNELAND SCHOOL CORPORATION  
CHESTERTON, INDIANA

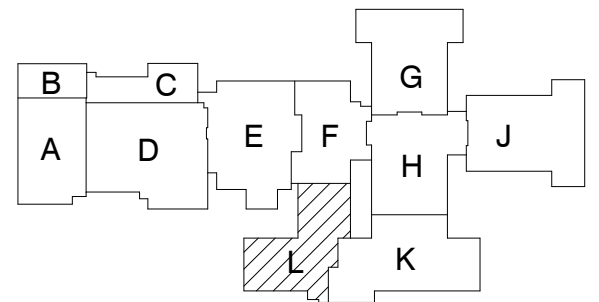

### KEY PLAN

GIBRALTAR DESIGN

9102 N. Meridian St., Ste. 300  
Indianapolis, IN 46260  
Homepage [www.GibraltarDesign.com](http://www.GibraltarDesign.com)  
Email [info@GibraltarDesign.com](mailto:info@GibraltarDesign.com)  
Phone 317.580.5777 Fax 317.580.5778

|                  |   |
|------------------|---|
| PROJECT<br>21116 |  |
| DATE<br>3-3-2022 |   |
| COORDINATED BY   |   |
| JMS              |   |
| DRAWN BY         |   |
| JMS              |   |
| CHECKED BY       |   |
| SAC              |   |

COPYRIGHT NOTICE:  
THE CONCEPTS, DESIGNS, PLANS, DETAILS, ETC., SHOWN ON  
THIS DOCUMENT ARE THE PROPERTY OF GIBRALTAR DESIGN AND  
WERE CREATED FOR USE ON THIS SPECIFIC PROJECT. NONE OF  
THIS INFORMATION SHALL BE USED BY ANY PERSON OR FIRM  
FOR ANY PURPOSE WITHOUT THE EXPRESS WRITTEN CONSENT OF  
GIBRALTAR DESIGN. THE OWNER MAY RETAIN COPIES FOR  
INFORMATION AND REFERENCE IN CONNECTION ONLY WITH THIS  
PROJECT.

[illegible]

DRAWING  
ROOF FRAMING PLAN - UNIT  
L

PROJECT  
WESTCHESTER IS - ADDITIONS &  
RENOVATIONS

© GIBRALTAR DESIGN

SHEET

**L**

# S208














# WESTCHESTER INTERMEDIATE SCHOOL - ADDITIONS & RENOVATIONS

DUNELAND SCHOOL CORPORATION  
CHESTERTON, INDIANA



9102 N. Meridian St., Ste. 300  
Indianapolis, IN 46260  
Homepage [www.GibraltarDesign.com](http://www.GibraltarDesign.com)  
Email [info@GibraltarDesign.com](mailto:info@GibraltarDesign.com)  
Phone 317.580.5777 Fax 317.580.5778

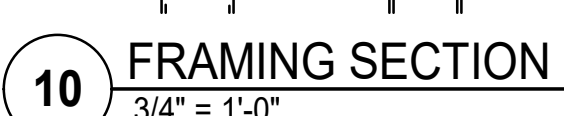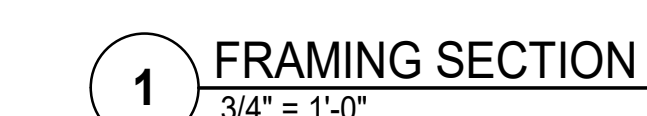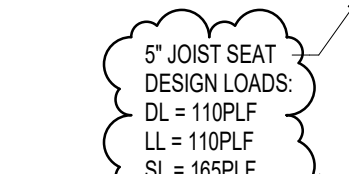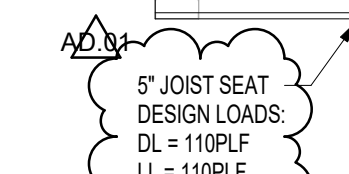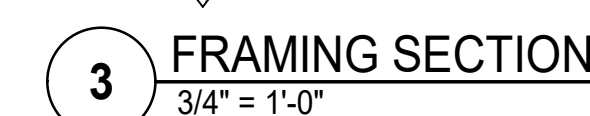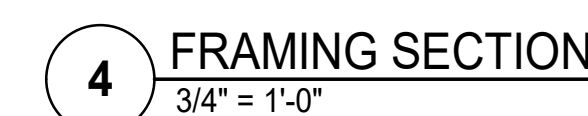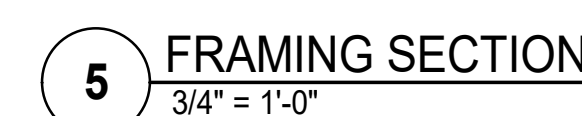








**WESTCHESTER  
INTERMEDIATE  
SCHOOL -  
ADDITIONS &  
RENOVATIONS**

DUNELAND SCHOOL CORPORATION  
CHESTERTON, INDIANA



9102 N. Meridian St., Ste. 300  
Indianapolis, IN 46260  
Homepage [www.GibraltarDesign.com](http://www.GibraltarDesign.com)  
Email [info@GibraltarDesign.com](mailto:info@GibraltarDesign.com)  
Phone 317.580.5777 Fax 317.580.5778



**COPYRIGHT NOTICE:**  
THE CONCEPTS, DESIGNS, PLANS, DETAILS, ETC., SHOWN ON THIS DOCUMENT ARE THE PROPERTY OF GIBRALTAR DESIGN AND WERE CREATED FOR USE ON THIS SPECIFIC PROJECT. NONE OF THIS INFORMATION SHALL BE USED BY ANY PERSON OR FIRM FOR ANY PURPOSE WITHOUT THE EXPRESS WRITTEN CONSENT OF GIBRALTAR DESIGN. THE OWNER MAY RETAIN COPIES FOR INFORMATION AND REFERENCE IN CONNECTION ONLY WITH THIS PROJECT.

## DRAWING STEEL FRAMING ELEVATIONS

© GIBRALTAR DESIGN

SHEE

S420






© GIBALTAR DESIGN

SHEET


S421

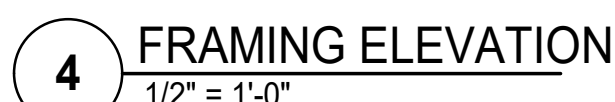

## GIBRALTAR DESIGN

9102 N. Meridian St., Ste. 300  
Indianapolis, IN 46260  
Homepage [www.GibraltarDesign.com](http://www.GibraltarDesign.com)  
Email [info@GibraltarDesign.com](mailto:info@GibraltarDesign.com)  
Phone 317.580.5777 Fax 317.580.5778

|             |          |
|-------------|----------|
| PROJECT     | 21116    |
| DATE        | 3-3-2022 |
| COORDINATOR | Designer |
| DRAWN BY    | Author   |
| CHECKED BY  | Checker  |

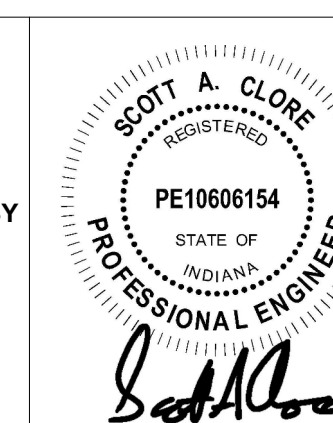

COPYRIGHT NOTICE:  
THE CONCEPTS, DESIGNS, PLANS, DETAILS, ETC., SHOWN ON THIS DOCUMENT ARE THE PROPERTY OF GIBRALTAR DESIGN AND WERE CREATED FOR USE ON THIS SPECIFIC PROJECT. NONE OF THIS INFORMATION SHALL BE USED BY ANY PERSON OR FIRM FOR ANY PURPOSE WITHOUT THE EXPRESS WRITTEN CONSENT OF GIBRALTAR DESIGN. THE OWNER MAY RETAIN COPIES FOR INFORMATION AND REFERENCE IN CONNECTION ONLY WITH THIS PROJECT.

REVISIONS

[illegible]

**DRAWING**  
**STEEL FRAMING**  
**ELEVATIONS**

PROJECT  
WESTCHESTER IS - ADDITIONS &  
RENOVATIONS

© GIBALTAR DESIGN

SHEET





PROJECT  
WESTCHESTER  
INTERMEDIATE  
SCHOOL -  
ADDITIONS &  
RENOVATIONS

DUNELAND SCHOOL CORPORATION  
CHESTERTON, INDIANA



GIBRALTAR DESIGN

9102 N. Meridian St., Ste. 300  
Indianapolis, IN 46260  
Homepage [www.GibraltarDesign.com](http://www.GibraltarDesign.com)  
Email [info@GibraltarDesign.com](mailto:info@GibraltarDesign.com)  
Phone 317.580.5777 Fax 317.580.5778

|                      |  |
|----------------------|--|
| PROJECT<br>21-141    |  |
| DATE<br>02/28/22     |  |
| COORDINATED BY<br>JC |  |
| DRAWN BY<br>AUTHOR   |  |
| CHECKED BY<br>D.J.   |  |


COPYRIGHT NOTICE:  
 THE CONCEPTS, DESIGNS, PLANS, DETAILS, ETC., SHOWN ON  
 THIS DOCUMENT ARE THE PROPERTY OF GIBRALTAR DESIGN AND  
 WERE CREATED FOR USE ON THIS SPECIFIC PROJECT. NONE OF  
 THIS INFORMATION SHALL BE USED BY ANY PERSON OR FIRM  
 FOR ANY PURPOSE WITHOUT THE EXPRESS WRITTEN CONSENT  
 OF GIBRALTAR DESIGN. THE OWNER MAY RETAIN COPIES FOR  
 INFORMATION AND REFERENCE IN CONNECTION WITH THIS

[illegible]


DRAWING  
UNIT "H" PLUMBING  
TUNNEL DEMOLITION  
PLAN


PROJECT  
WESTCHESTER IS -  
ADDITIONS & RENOVATIONS

|                    |       |
|--------------------|-------|
| © GIBRALTAR DESIGN | SHEET |
| H                  | PD005 |

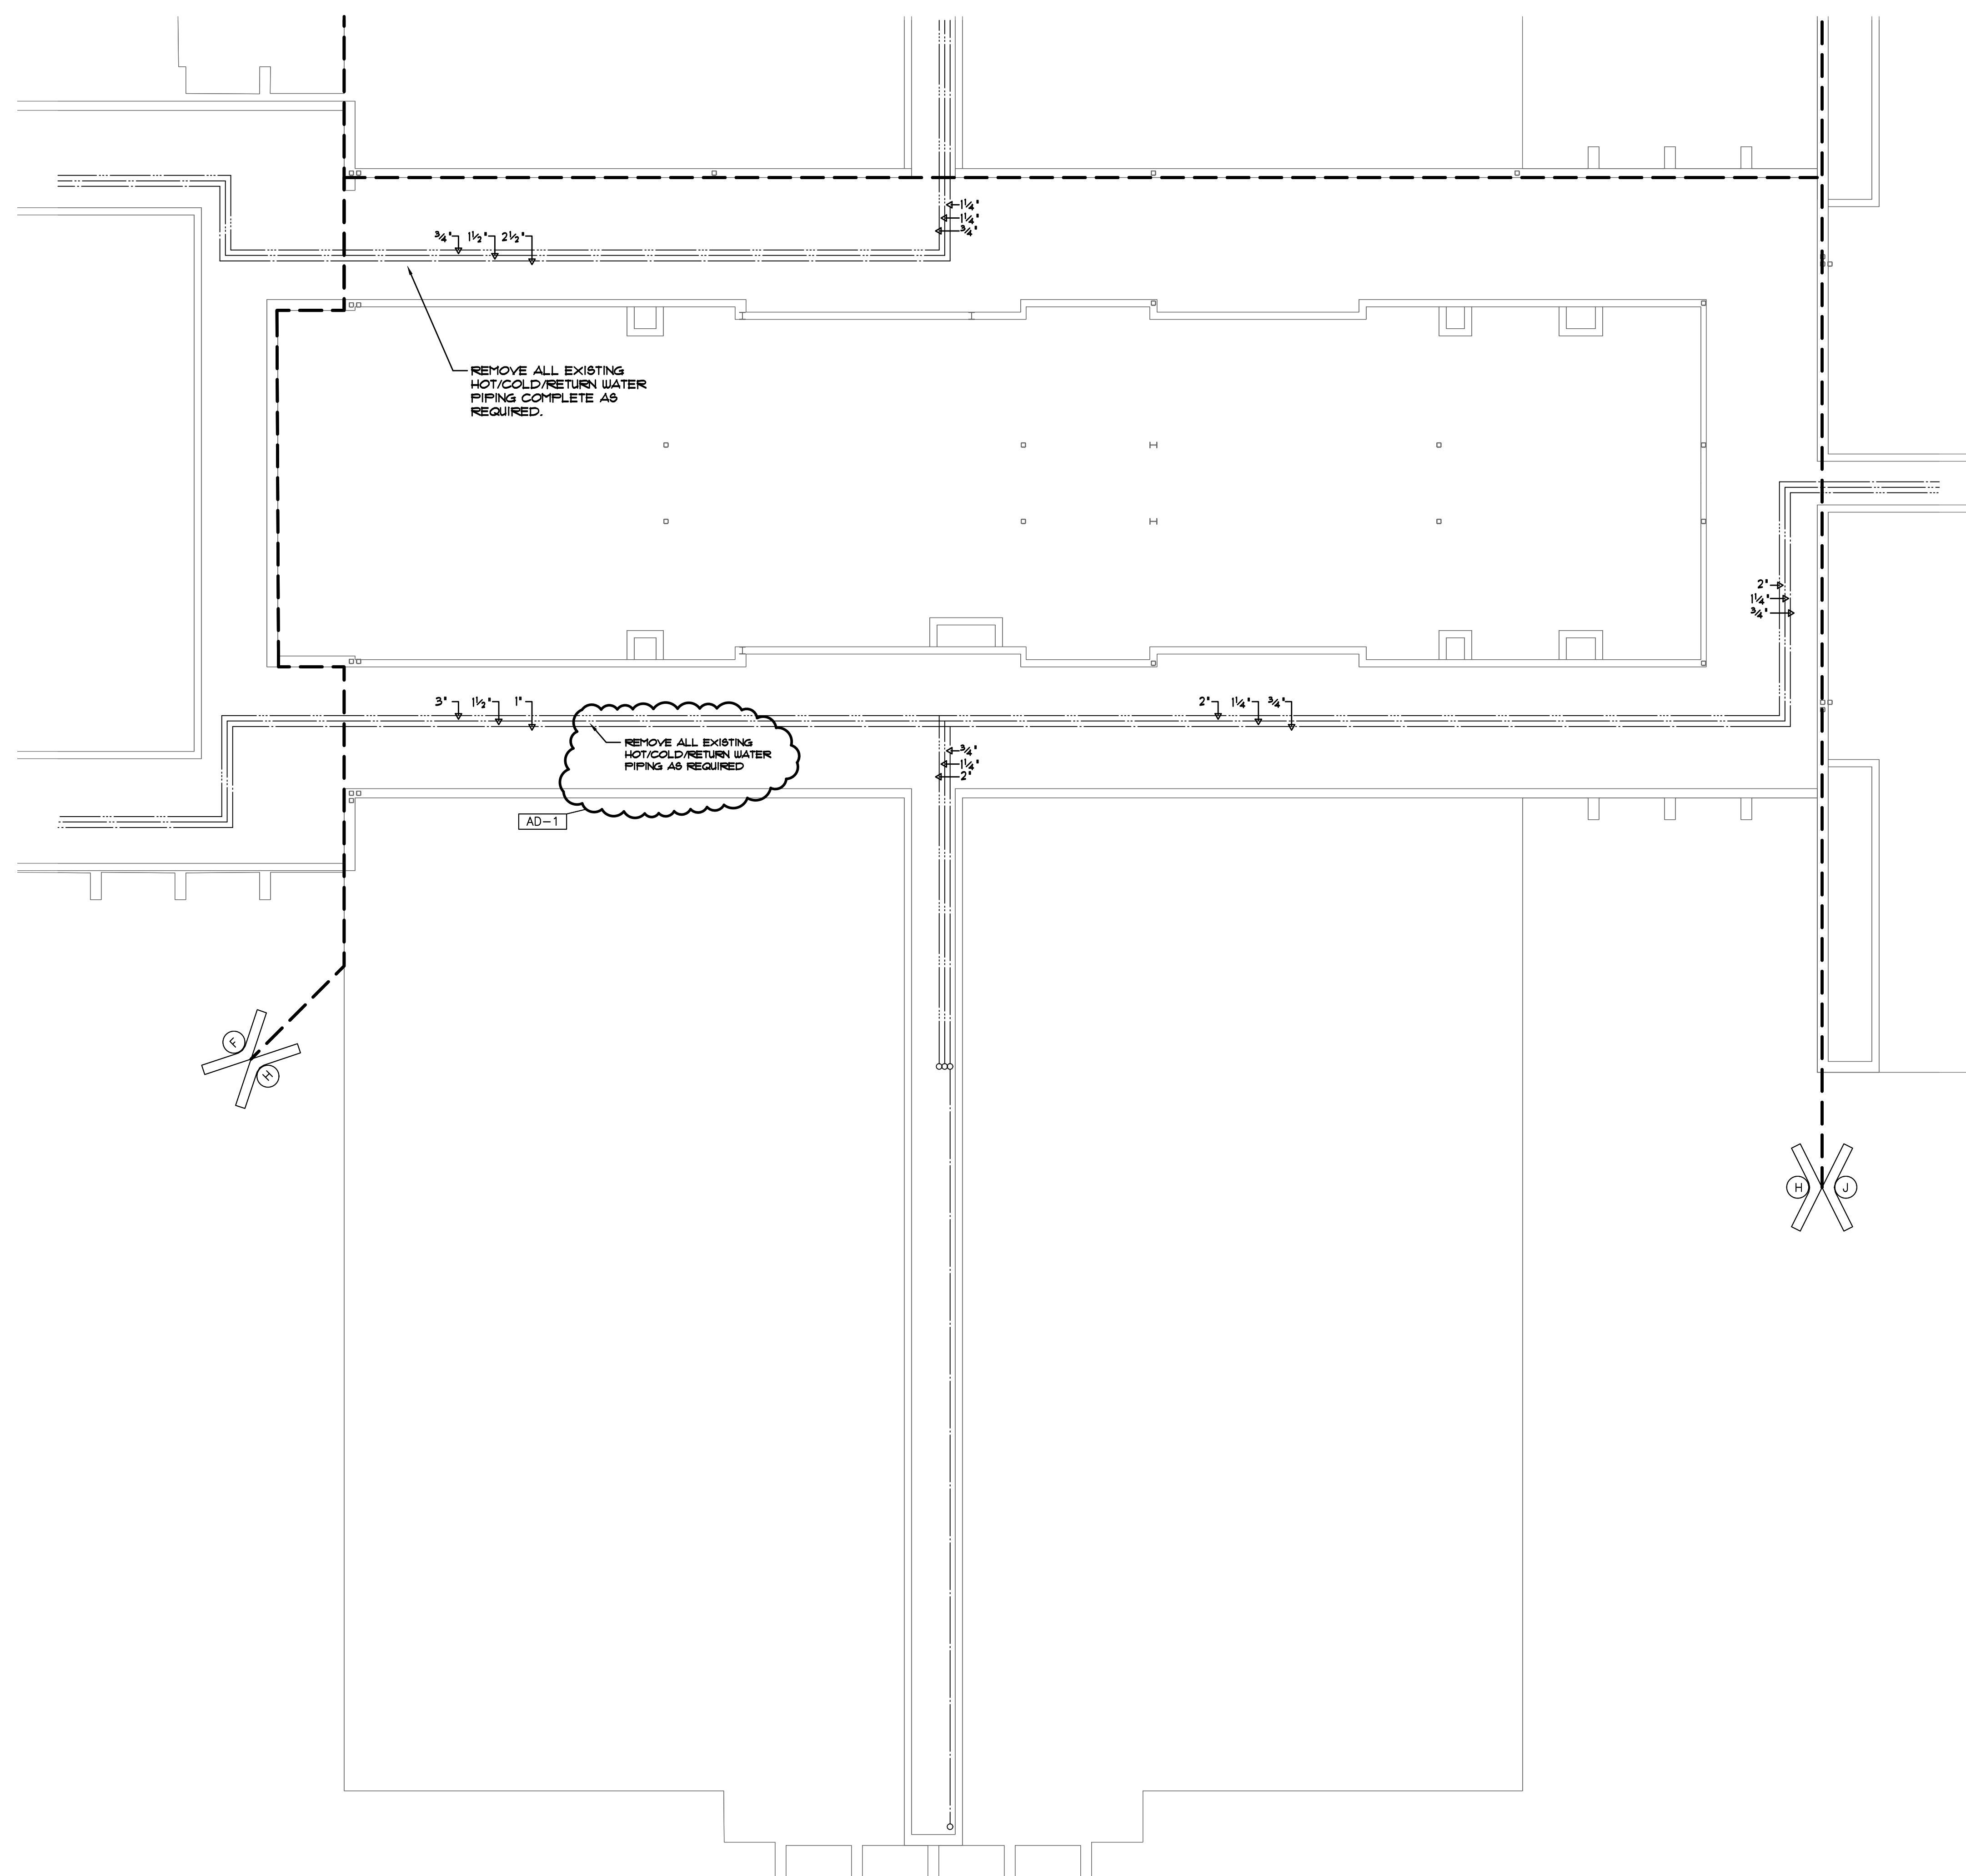

**UNIT "H" PLUMBING TUNNEL DEMOLITION PLAN**  
SCALE: 1/8" = 1'-0"

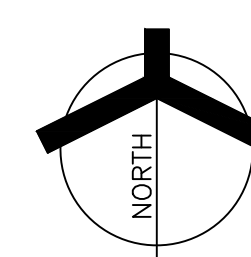

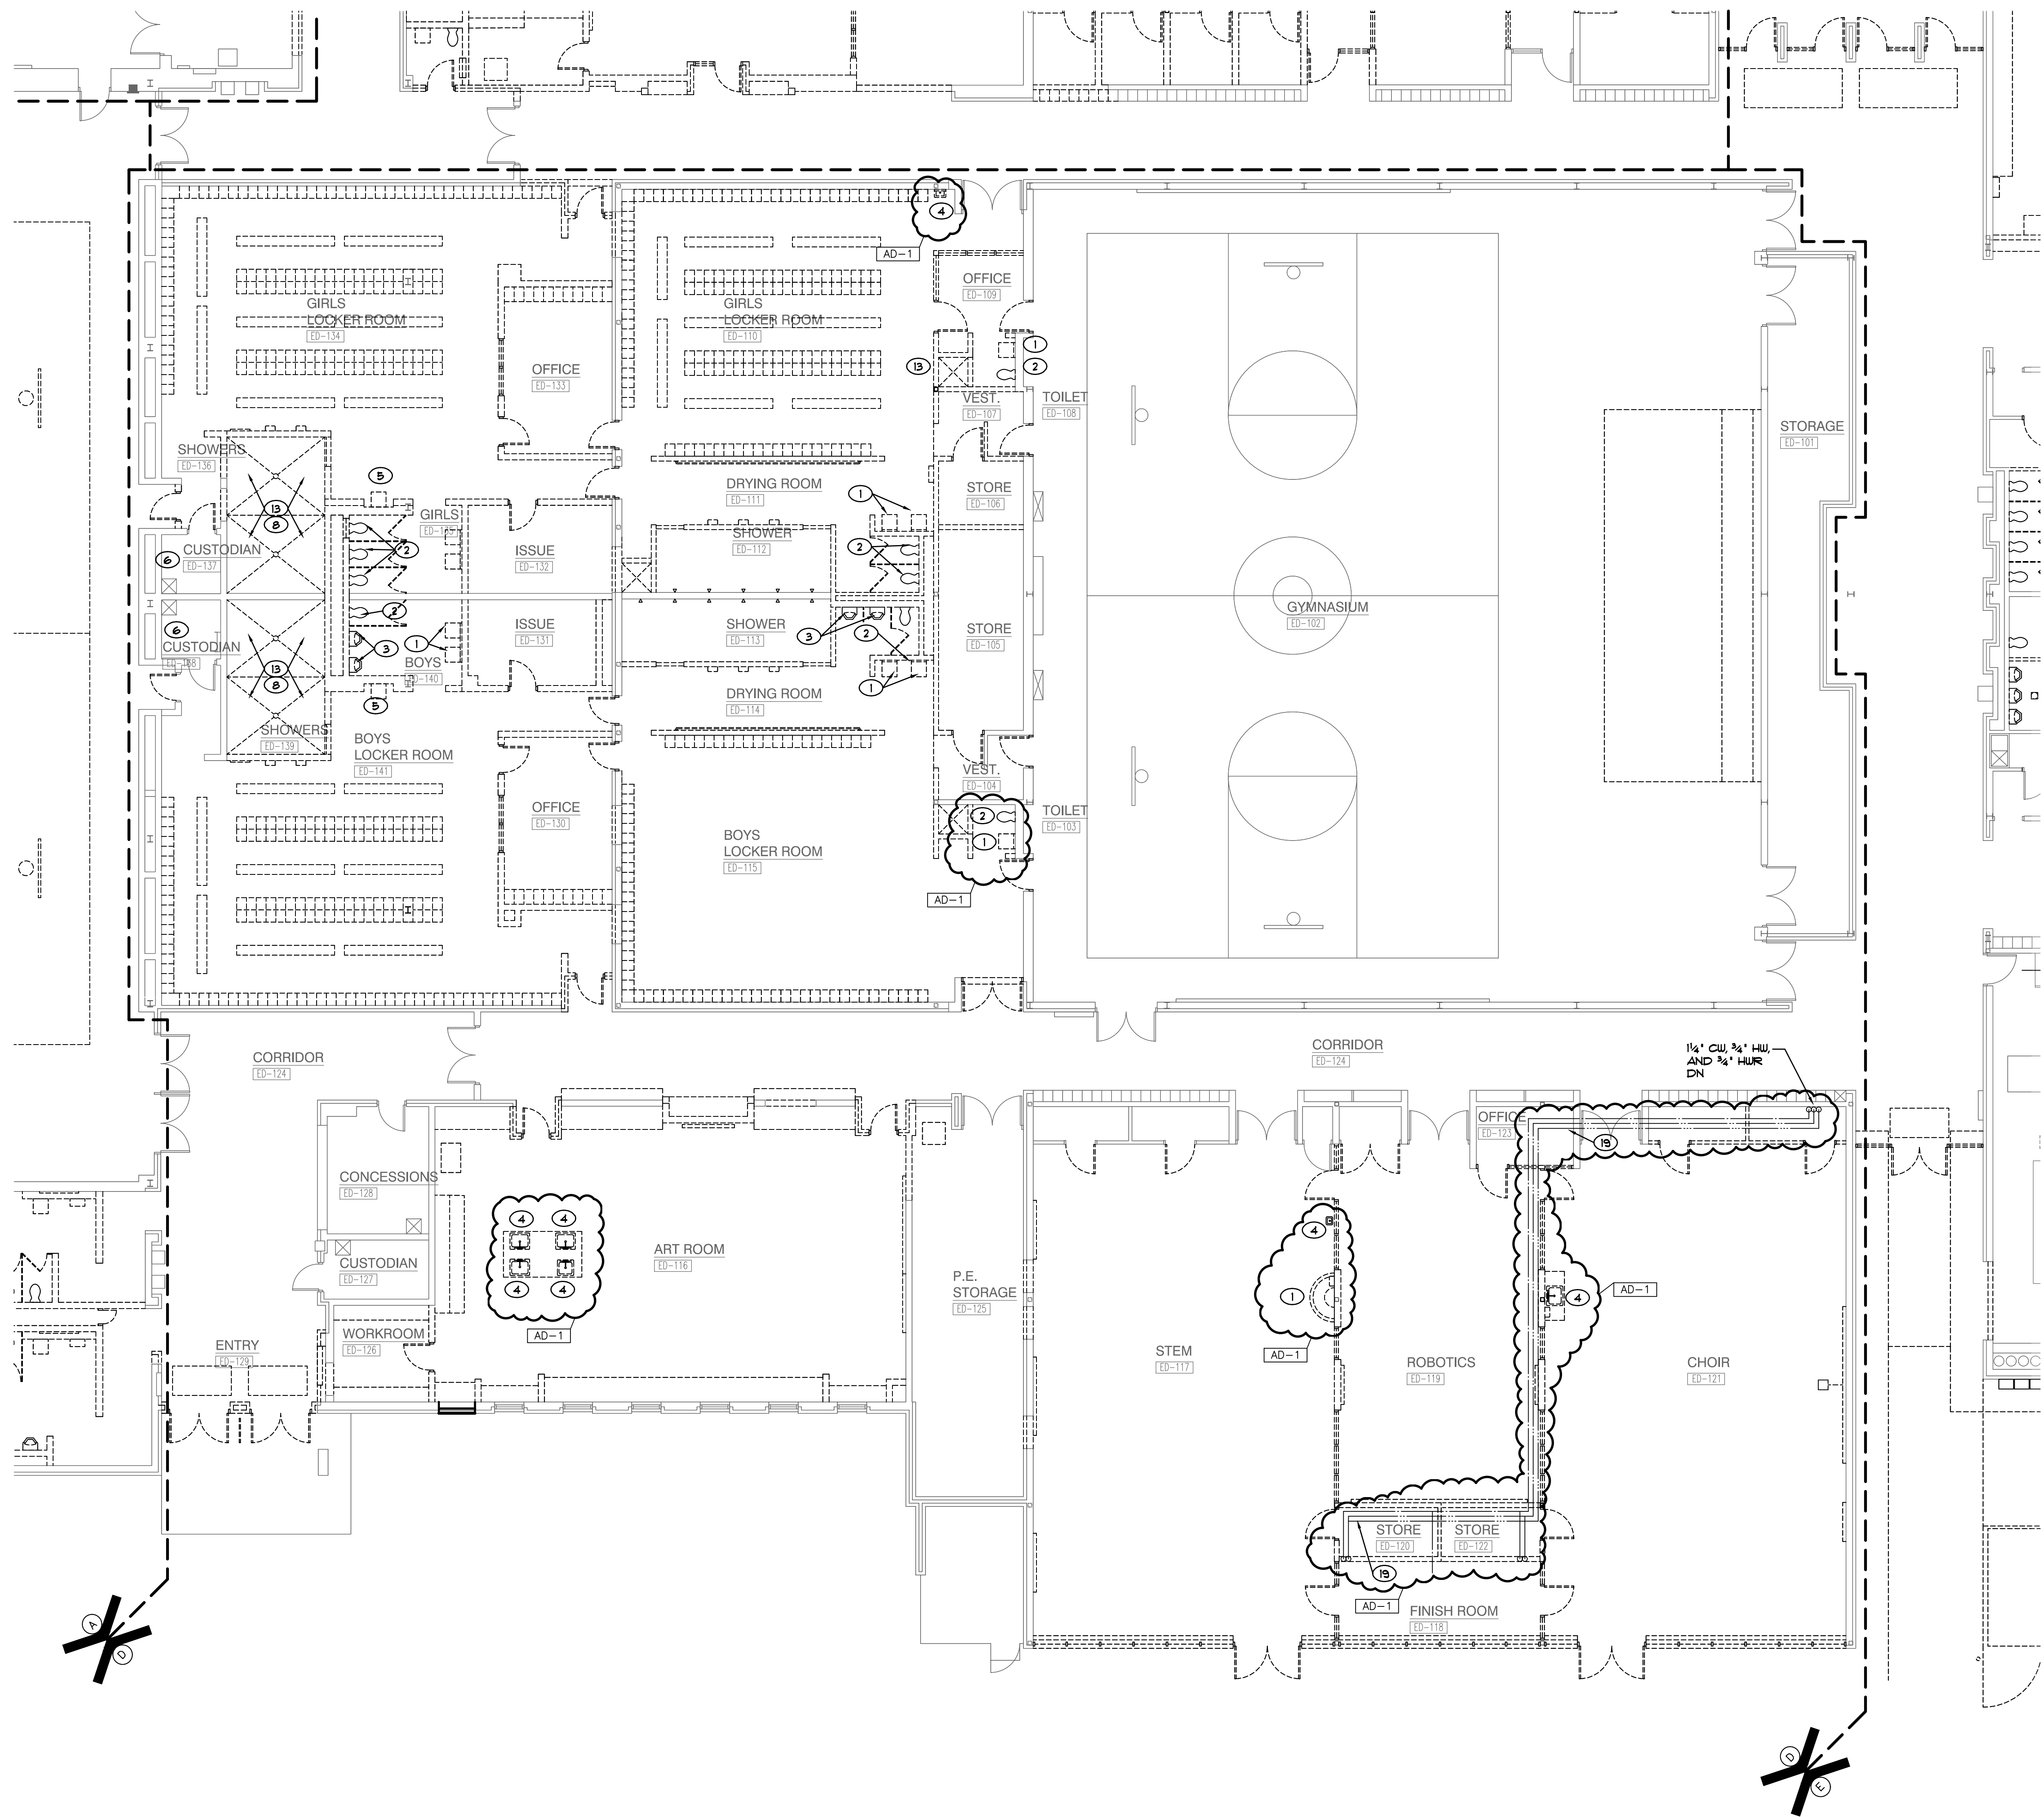

## SHEET NOTES

1. REMOVE EXISTING LAVATORY AND FAUCET AND ALL ASSOCIATED HOT/COLD WATER, SANITARY AND VENT PIPING COMPLETE AS REQUIRED.
2. REMOVE EXISTING WATER CLOSET AND FLUSH VALVE AND ALL ASSOCIATED COLD WATER, SANITARY AND VENT PIPING COMPLETE AS REQUIRED.
3. REMOVE EXISTING URINAL AND FLUSH VALVE AND ALL ASSOCIATED COLD WATER, SANITARY AND VENT PIPING COMPLETE AS REQUIRED.
4. REMOVE EXISTING SINK AND FAUCET AND ALL ASSOCIATED HOT/COLD WATER, SANITARY AND VENT PIPING COMPLETE AS REQUIRED.
5. REMOVE EXISTING ELECTRIC WATER COOLER AND ALL ASSOCIATED COLD WATER, SANITARY AND VENT PIPING COMPLETE AS REQUIRED.
6. REMOVE EXISTING MOP BASIN AND FAUCET AND ALL ASSOCIATED HOT/COLD WATER, SANITARY AND VENT PIPING COMPLETE AS REQUIRED.
7. REMOVE EXISTING SILLCOCK AND ALL ASSOCIATED COLD WATER PIPING COMPLETE AS REQUIRED.
8. REMOVE EXISTING FLOOR DRAIN AND ALL ASSOCIATED VENT PIPING AND CAP EXISTING SANITARY BELOW FLOOR AIR/WATERTIGHT COMPLETE AS REQUIRED.
9. REMOVE EXISTING FLOOR SINK AND ALL ASSOCIATED VENT PIPING AND CAP EXISTING SANITARY BELOW FLOOR AIR/WATERTIGHT COMPLETE AS REQUIRED.
10. REMOVE EXISTING GAS WATER HEATER AND ALL ASSOCIATED COLD/HOT/RETURN WATER PIPING, FLUES, GAS PIPING, ELECTRICAL CONNECTIONS, ETC. COMPLETE AS REQUIRED.
11. REMOVE EXISTING ELECTRIC HOT WATER RETURN PUMP AND ALL ASSOCIATED ELECTRICAL CONNECTIONS, VALVES, ETC. COMPLETE AS REQUIRED.
12. REMOVE EXISTING TEMPERED WATER MIXING VALVE AND ALL ASSOCIATED HOT/COLD/TEMPERED WATER PIPING COMPLETE AS REQUIRED.
13. REMOVE EXISTING SHOWER AND FAUCET AND ALL ASSOCIATED HOT/COLD WATER, SANITARY AND VENT PIPING COMPLETE AS REQUIRED.
14. REMOVE EXISTING ROOF DRAIN AND ALL ASSOCIATED STORM PIPING COMPLETE AS REQUIRED.
15. REMOVE EXISTING ROOF DRAIN OVERFLOW AND ALL ASSOCIATED OVERFLOW STORM PIPING COMPLETE AS REQUIRED.
16. REMOVE GREASE TRAP AND ALL ASSOCIATED VENT PIPING AND CAP EXISTING SANITARY BELOW FLOOR AIR/WATERTIGHT COMPLETE AS REQUIRED.
17. REMOVE EXISTING EMERGENCY SHOWER/EYEWASH AND MIXING VALVE AND ALL ASSOCIATED HOT/COLD WATER, SANITARY AND VENT PIPING COMPLETE AS REQUIRED.
18. REMOVE, PROTECT AND REINSTALL EXISTING ELECTRIC WATER COOLER. ALL ASSOCIATED COLD WATER, SANITARY AND VENT PIPING COMPLETE AS REQUIRED.
19. REMOVE EXISTING ALL HOT/COLD/RETURN WATER PIPING COMPLETE AS REQUIRED.

AD-1



**GIBALTAR**  
DESIGN

ARCHITECTURE • ENGINEERING • INTERIOR DESIGN




MILLIES  
ENGINEERING GROUP  
9791 924-8400  
www.milliesengineeringgroup.com

PROJECT

**WESTCHESTER  
INTERMEDIATE  
SCHOOL -  
ADDITIONS &  
RENOVATIONS**

DUNELAND SCHOOL CORPORATION  
CHESTERTON, INDIANA

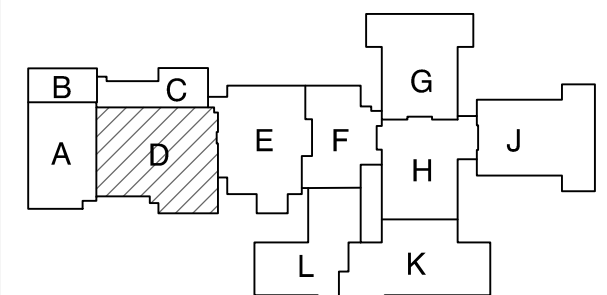

KEY PLAN

**GIBALTAR DESIGN**

9102 N. Meridian St., Ste. 300  
Indianapolis, IN 46260  
Homepage: www.GibraltarDesign.com  
Email: info@GibraltarDesign.com  
Phone: 317.580.5777 Fax: 317.580.5778

PROJECT

21-141

DATE

02/28/22

COORDINATED BY

JC

DRAWN BY

MDG/JM

CHECKED BY

DJ

**DAVID G. JANNE**  
REGISTERED  
NO. 10302590  
STATE OF INDIANA  
PROFESSIONAL ENGINEER

COPYRIGHT NOTICE:  
THE CONCEPTS, DESIGNS, PLANS, DETAILS, ETC. SHOWN ON  
THIS DOCUMENT ARE THE PROPERTY OF GIBALTAR DESIGN AND  
FOR ANY PURPOSE WITHOUT THE EXPRESS WRITTEN CONSENT  
OF GIBALTAR DESIGN, THE OWNER MAY RETAIN COPIES FOR  
INFORMATION AND REFERENCE IN CONNECTION ONLY WITH THIS  
PROJECT.


REVISIONS

MARK DATE ISSUED FOR

AD-1 03/16/22 ADDENDUM NO. 1

UNIT "D" PLUMBING FIRST FLOOR DEMOLITION PLAN

SCALE: 1/8" = 1'-0"

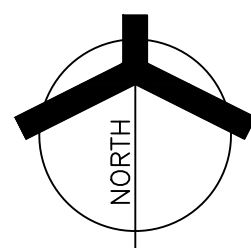

DRAWING

UNIT "D" PLUMBING FIRST

FLOOR DEMOLITION PLAN

PROJECT

WESTCHESTER IS -

ADDITIONS & RENOVATIONS

© GIBALTAR DESIGN SHEET

D


PD103

Copyright © 2022 Millies Engineering Group







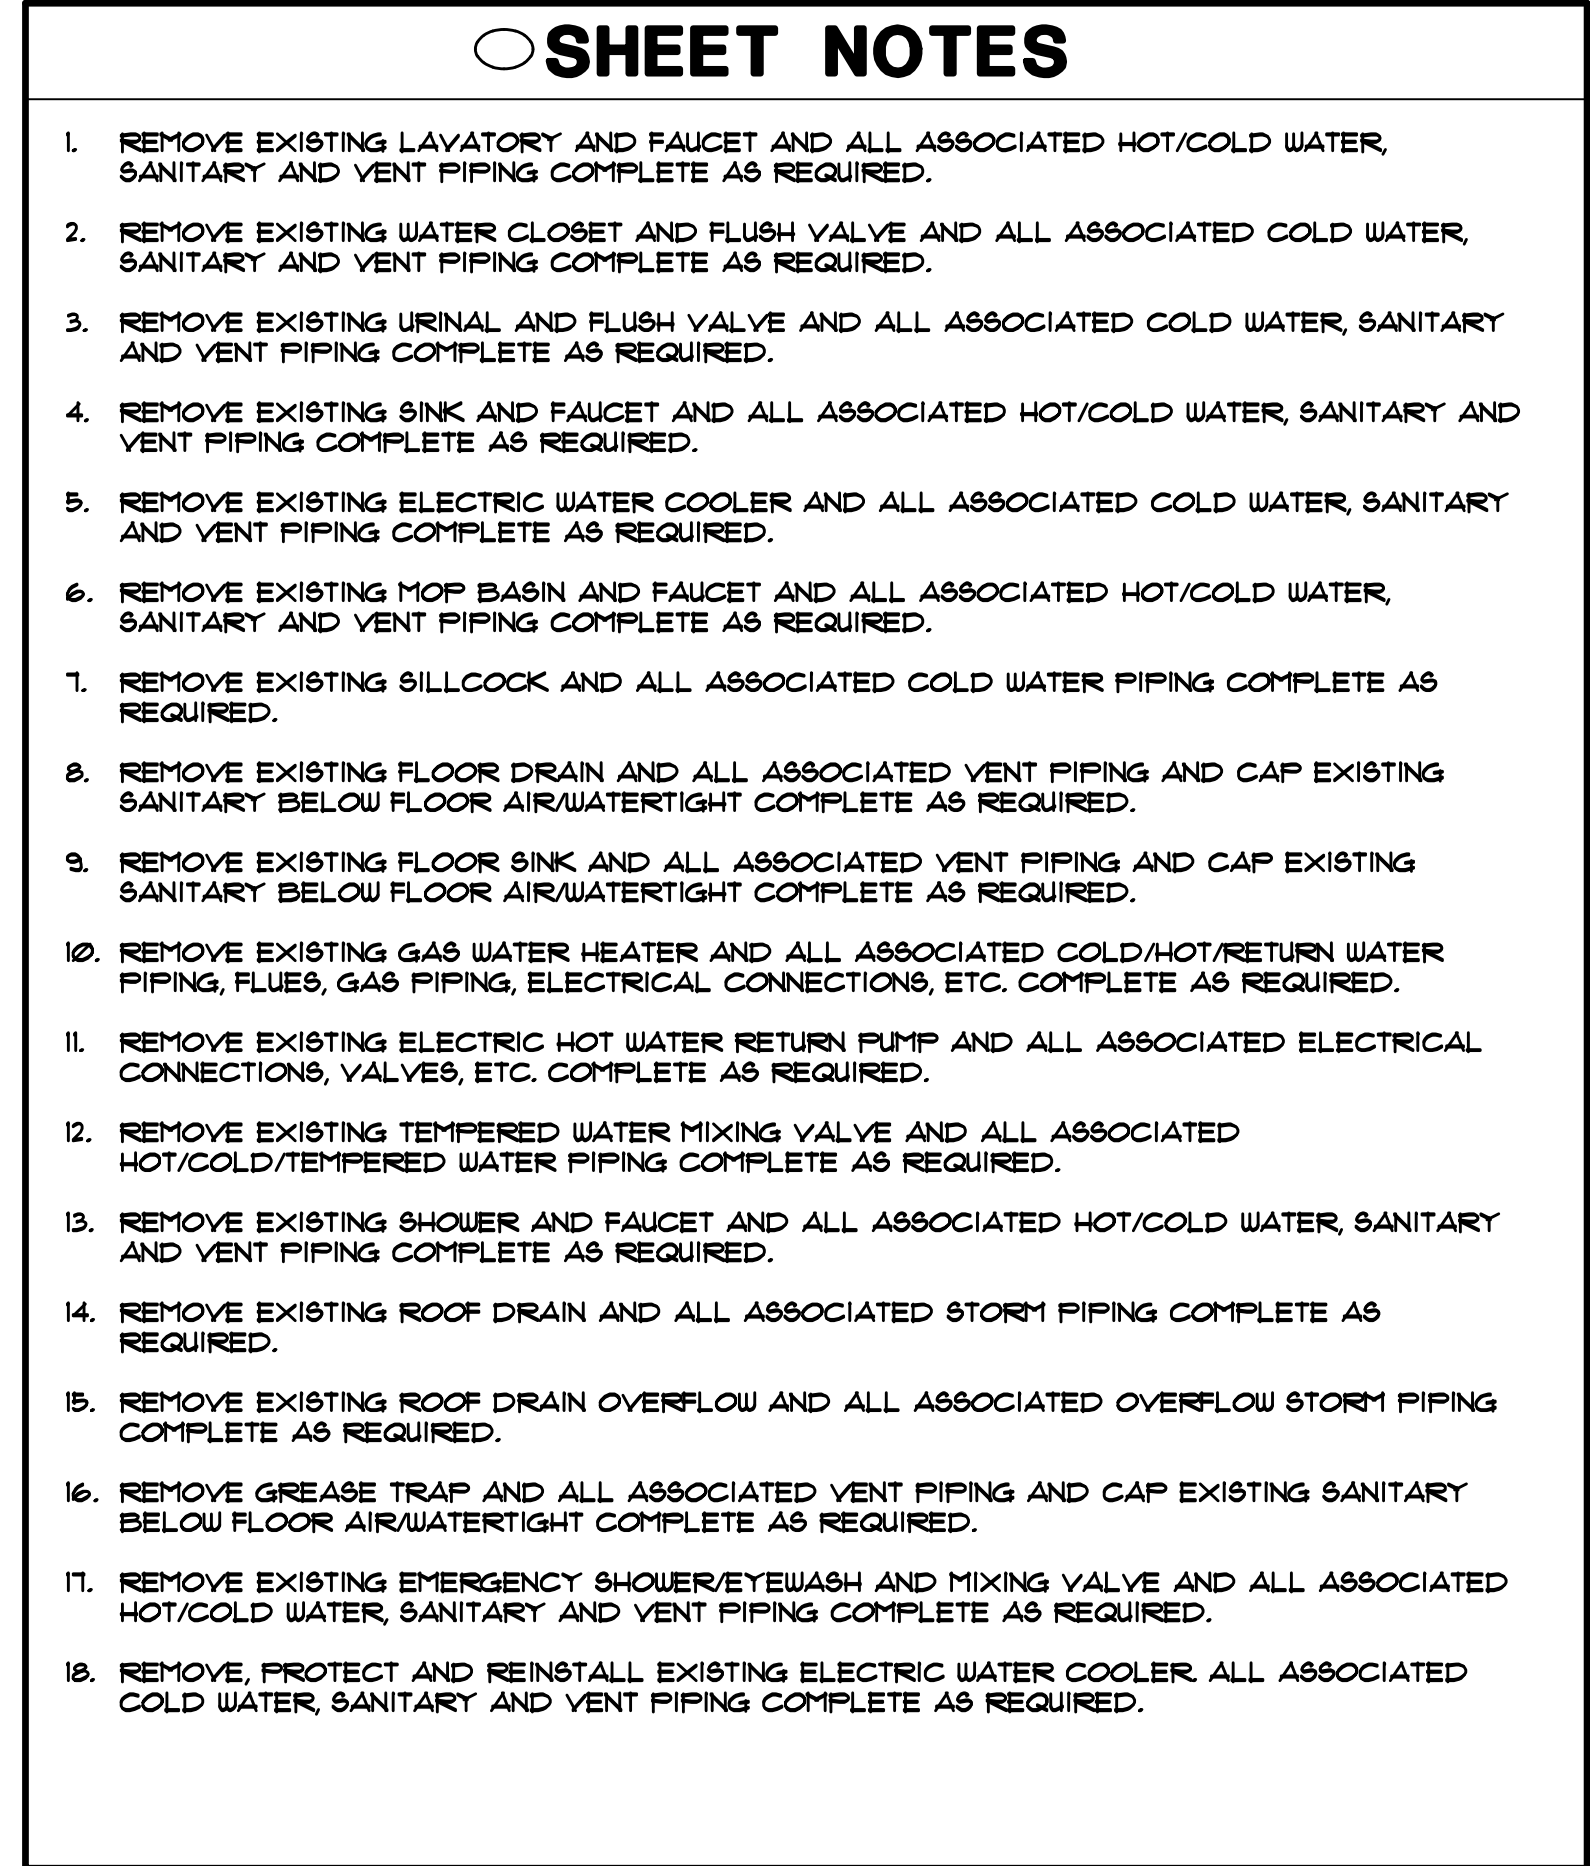





SCALE:  $1/8" = 1'-0"$















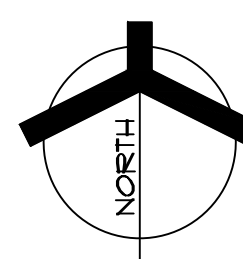





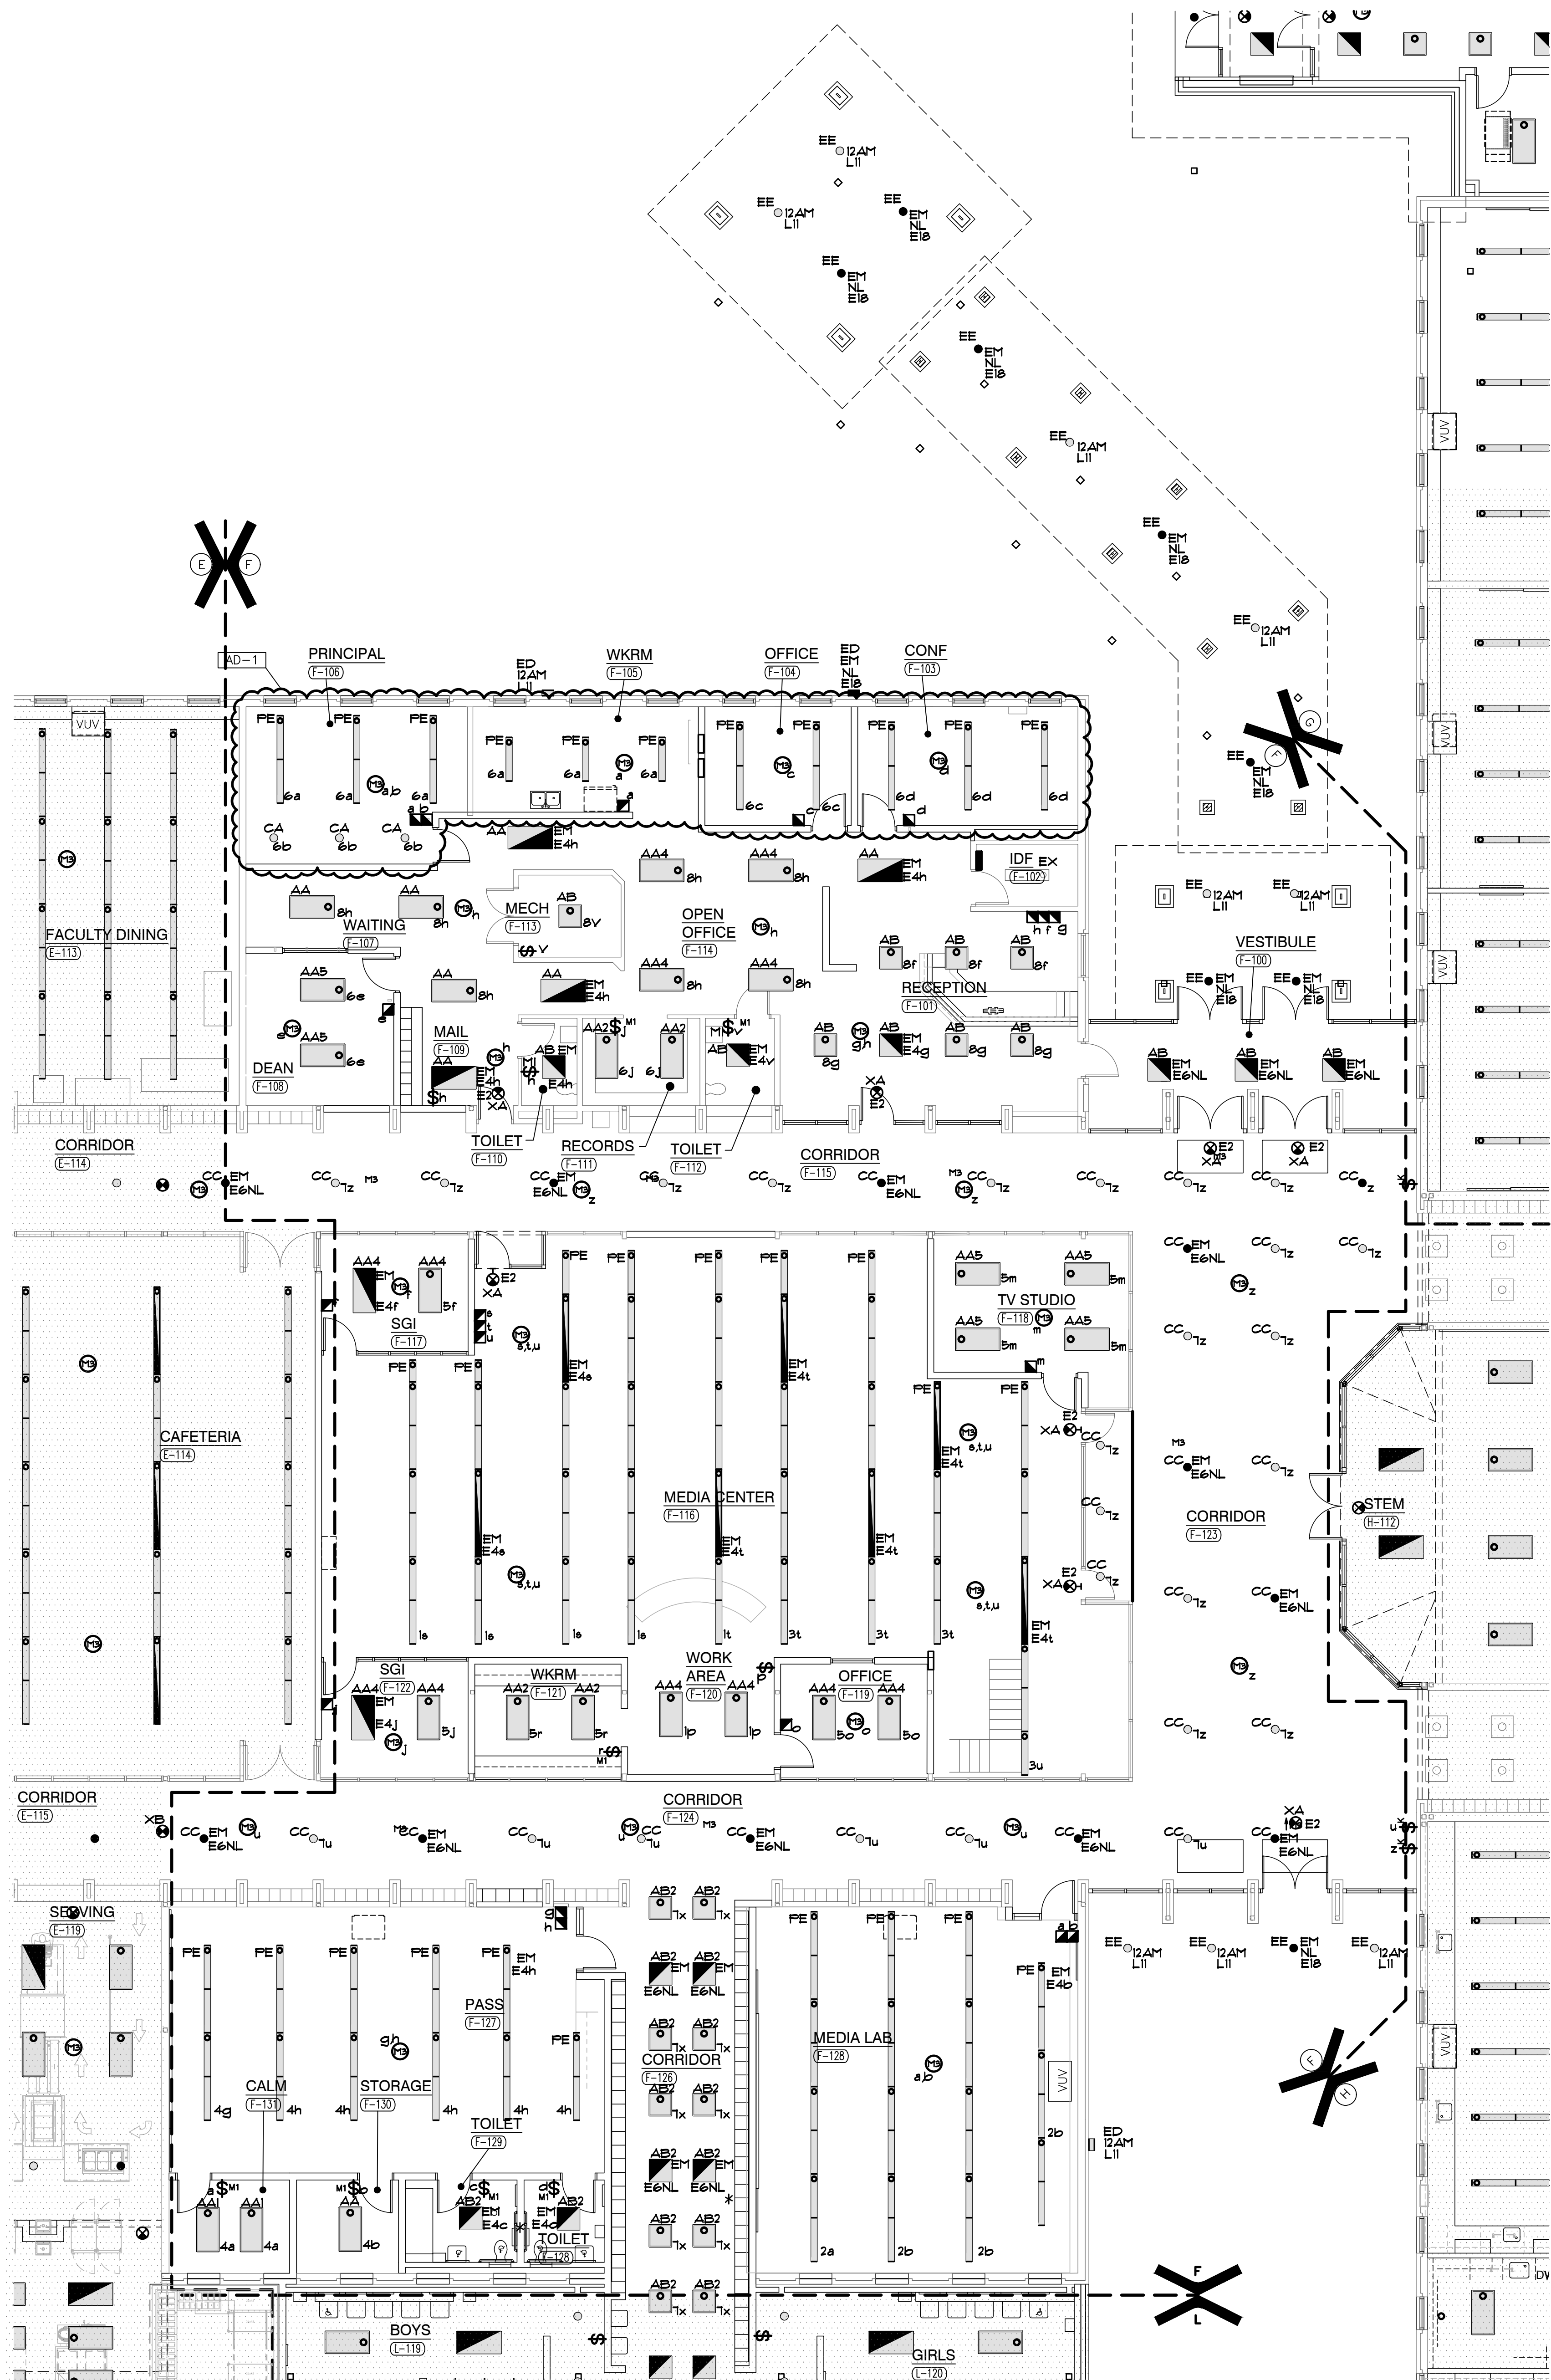


UNIT "F" ELECTRICAL FIRST FLOOR LIGHTING PLAN  
SCALE: 1/8" = 1'-0"

GENERAL NOTES

1. CIRCUIT ALL NORMAL LIGHTING FIXTURES TO PANEL LP-1 UNLESS OTHERWISE NOTED.
2. SHADED FIXTURES, FIXTURES WITH 'EM' TAGS AND EXIT SIGNS SHALL BE PROVIDED WITH AN EMERGENCY LIFE SAFETY POWER SOURCE.
3. EXIT SIGNS SHALL BE CONNECTED TO CIRCUIT INDICATED IN EMERGENCY LIFE SAFETY PANEL EM-1.
4. FIXTURES WITH A 'NL' TAG SHALL BE CONNECTED TO THE NIGHT LIGHT CIRCUIT INDICATED IN EMERGENCY LIFE SAFETY PANEL EM-1.
5. CIRCUIT TAGS WITH AN 'E' PREFIX SHOWN WITH A SWITCH LEG SHALL BE A SWITCHED EMERGENCY FIXTURE CONNECTED TO PANEL EM-1. THE FIXTURE SHALL BE PROVIDED WITH A UL924 RATED BYPASS DEVICE TO ALLOW THE FIXTURE TO BE CONTROLLED ALONG WITH THE NORMAL FIXTURES IN THE ROOM. UPON LOSS OF POWER, THE FIXTURE SHALL BE IMMEDIATELY POWERED TO 100% REGARDLESS OF SWITCH POSITION.
6. CIRCUIT ALL NORMAL EXTERIOR LIGHTING FIXTURES ACCORDING TO PANEL 11 VIA TIMECLOCK, PHOTOCELL AND CONTACTORS.
7. EXTERIOR LIGHTING FIXTURES WITH AN 'E' PREFIX SHOWN SHALL BE ROUTED TO LIFE SAFETY PANEL 11 VIA TIMECLOCK, CONTACTORS, PHOTOCELL, AND UL924 BYPASS DEVICES AS REQUIRED TO ALLOW FIXTURE TO OPERATE AND SWITCH ALONG WITH ADJACENT NORMAL LIGHTING. UPON LOSS OF POWER, THE FIXTURE SHALL BE IMMEDIATELY POWERED TO 100% REGARDLESS OF SWITCH POSITION.
8. EMERGENCY SENSING LEADS SHALL BE CONNECTED TO CONSTANT HOT FEEDS FROM NORMAL LIGHTING IN ROOM. THIS FEED SHALL BE TAKEN AHEAD OF ANY EMERGENCY SHUTDOWNS, RELAYS, CONTACTORS OR SWITCHES.
9. REFER TO ARCHITECTURAL REFLECTED CEILING PLAN FOR EXACT LOCATION OF ALL CEILING MOUNTED LIGHT FIXTURES.
10. ROUTE CONDUIT AS TIGHT TO THE EXPOSED CEILING AND STRUCTURE AS POSSIBLE TO MAXIMIZE CEILING SPACE.
11. VERIFY TEACHING SURFACE WITH OWNER'S REPRESENTATIVE IN FIELD PRIOR TO INSTALLATION AND ADJUST SWITCHING TO PROPERLY ILLUMINATE TEACHING SURFACE. CAREFULLY COORDINATE FINAL SWITCHING WITH FINAL FURNITURE PLANS AND TEACHING WALL LOCATIONS.




PROJECT  
**WESTCHESTER  
INTERMEDIATE  
SCHOOL -  
ADDITIONS &  
RENOVATIONS**  
DUNELAND SCHOOL CORPORATION  
CHESTERTON, INDIANA

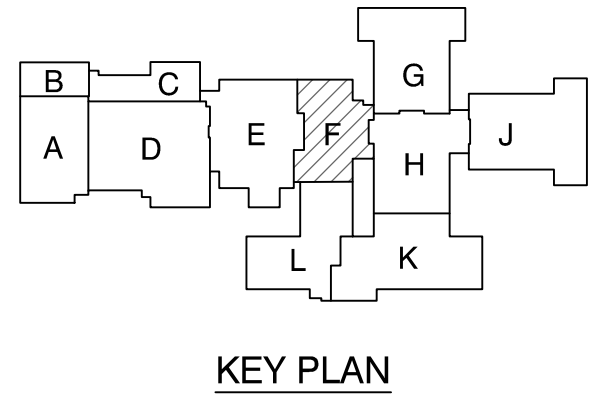

**GIBRALTAR DESIGN**  
9102 N. Meridian St., Ste. 300  
Indianapolis, IN 46260  
Homepage: www.GibraltarDesign.com  
Email: info@GibraltarDesign.com  
Phone: 317.580.5777 Fax: 317.580.5778

PROJECT: 21-141  
DATE: 02/28/22  
COORDINATED BY: JC  
DRAWN BY: MS  
CHECKED BY: DJ

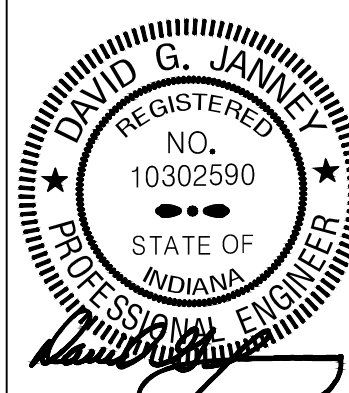

COPYRIGHT NOTICE:  
THE CONCEPTS, DESIGNS, PLANS, DETAILS, ETC., SHOWN ON THIS DOCUMENT ARE THE PROPERTY OF GIBRALTAR DESIGN AND WERE CREATED FOR USE ON THIS SPECIFIC PROJECT. NONE OF THIS INFORMATION SHALL BE USED BY ANY PERSON OR FIRM FOR ANY PURPOSE WITHOUT THE EXPRESS WRITTEN CONSENT OF GIBRALTAR DESIGN. THE OWNER MAY RETAIN COPIES FOR INFORMATION AND REFERENCE IN CONNECTION ONLY WITH THIS PROJECT.

| REVISIONS |          |                |
|-----------|----------|----------------|
| MARK      | DATE     | ISSUED FOR     |
| AD-1      | 03/15/22 | ADDENDUM NO. 1 |

DRAWING  
**UNIT "F" ELECTRICAL  
FIRST FLOOR LIGHTING  
PLAN**

PROJECT  
**WESTCHESTER IS -  
ADDITIONS & RENOVATIONS**

© GIBRALTAR DESIGN SHEET  
**F EL105**







