

October 6, 2023

Carmel High School Polytechnic Addition & Renovation 520 East Main Street Carmel, IN 46032

TO: ALL BIDDERS OF RECORD

This Addendum forms a part of and modifies the Bidding Requirements, Contract Forms, Contract Conditions, the Specifications and the Drawings dated August 31, 2023, by Fanning Howey Associates. Acknowledge receipt of the Addendum in the space provided on the Bid Form. Failure to do so may subject the Bidder to disqualification.

This Addendum consists of Pages ADD 2-1 through ADD 2-4, Exterior Logistics Plan (Page 1) and attached Fanning Howey Associates Addendum No. 2, dated October 5, 2023, consisting of 11 items and 3 pages; Addendum No. 2, 11 items, 3 pages

New Project Manual Section: 09 21 16.23 – Gypsum Board Shaft Wall Assemblies, 23 11 13 – Facility Fuel-Oil Piping, 23 13 23 – Facility Above Ground Fuel-Oil Storage Tanks, 27 13 23 TM – Manufacturer's Material List, and 27 15 53 TM – Manufacturer's Material List, Revised Project Manual Sections: Sections 12 93 00 – Site Furnishings and Amenities, 23 80 61 – Fume Collection Systems, 27 11 00 TM – Manufacturer's Material List, 27 15 15 TM – Manufacturer's Material List, 27 15 17 – Communications Copper Horizontal Cabling (Augmented CAT 6A) and 33 41 00 – Storm Utility Drainage Piping, Revised Drawing Sheets: Index A, Index B, GD1.1, G1.1, G1.3, G2.1, G3.3, G4.1, G4.2, G5.1, G5.2, SU1.1, SU2.1, SU3.3, S1.01, S1.02, S1.03, S2.01, S2.02, S2.03, S3.01, S4.01, S5.02, S5.03, A0.01, AD1.01, AD3.01, A1.01, A1.02, A1.03, A1.05, A2.01, A2.02, A4.01, A5.01, A5.02, A5.04, A5.05, A7.01, A7S.01, A8.01, A8.03, A8.04, A8.08, A8S.01, A9.01, A9.03, A10.01, A10.02, P2.01, P3.01, P4.01, P4.02, M2.01, M2.02, M4.01, M5.01, M5.07, E3.01, E3.04, E5.01, E5.02, E6.01, TD.01, TD.02, T1.03, and T3.01.

A. <u>SPECIFICATION SECTION 01 12 00 - MULTIPLE CONTRACT SUMMARY</u>

Paragraph 3.03 BID CATEGORIES

A. BID CATEGORY NO. 1 - GENERAL TRADES

Add the following General Clarifications:

- 19. Bid Category No. 1 General Trades contractor is responsible for all slab cutting and pour backs identified on the architectural demo sheets.
- 20. Material within the concrete vault/tanks will be removed by the owner prior to demo operations.
- 21. Bid Category No. 5 contractor to be responsible for roofing demo shown on sheet AD2.01 in regard to roofing materials only. Bid Category No. 10 contractor responsible for demo and removal of mechanical equipment and roof drains on sheet AD2.01.
- 22. Acrylic panel with graphic shown on sheet A7.01 Plan Note 22 to be provided by Bid Category No. 1 General Trades within the base bid.
- 23. All equipment pads shown on sheet G1.1 are the responsibility of the Bid Category No. 1 General Trades contractor. Coordinate with the mechanical drawings and the Bid Category No. 10 Mechanical and Plumbing contractor prior to placing.
- 24. In regard to the Vocational Shop Equipment Schedule Table shown in 11 57 00 the Hunter Alignment Lift and Installation is by the owner. The Hunter Alignment Cabinet is by the owner.
- 25. Relocating and reinstalling any wood top metal framed workbenches is by the Bid Category No. 1 General Trades contractor.

Add the following Specification Section:

Section 07 91 00 - Preformed Joint Seals

Delete the following Specification Sections:

Section 06 10 00 - Rough Carpentry Section 06 61 16 - Solid Surface Fabrications

B. BID CATEGORY NO. 2 – MASONRY

Delete the following Specification Section:

Section 07 91 00 Preformed Joint Seals

Add the following General Clarification:

6. Installation of tube steel above and below windows to be supplied by the Bid Category No. 3 contractor but installed by the Bid Category No. 2 Masonry contractor.

C. BID CATEGORY NO. 3 STRUCTURAL STEEL

Add the following General Clarification:

4. Installation of tube steel above and below windows to be supplied by this contractor and to be installed by the Bid Category No. 2 Masonry contractor.

D. BID CATEGORY NO. 4 - METAL STUDS, DRYWALL, CEILINGS

Add the following General Clarification:

- 6. Bid Category No. 5 Roofing Contractor to be responsible for exterior wood blocking from the parapet down to the roof where wood blocking interfaces with the roofing system.
- 7. On the finish plans if within the finish box for a room when 1 material is listed that material extends to the full height of the walls and is on all walls of the room unless other materials are listed or otherwise indicated.

Add the following Specification Section:

Section 09 21 16.23 - Gypsum Board Shaft Wall Assemblies

E. <u>BID CATEGORY NO. 5 – ROOFING</u>

Replace the following General Clarifications:

- 2. Provide all wood blocking and plywood sheathing that interfaces with the roofing system. This includes any wood blocking associated with MEP curbs. In general, this means from the top of the parapet down to the roof.
- 3. Bid Category No. 5 contractor responsible for roofing demo shown on sheet AD2.01 in regard to roofing materials only. Bid Category No. 10 Contractor responsible for demo of mechanical equipment and roof drains on sheet AD2.01.

H. BID CATEGORY NO. 8 – CASEWORK

Add the following sections:

Section 06 61 16 Solid Surface Fabrications

J. BID CATEGORY NO. 10 - MECHANICAL AND PLUMBING

Add the following General Clarification:

- 4. Bid Category No. 1 General Trades Contractor is responsible for all existing slab cutting and pour backs identified on the architectural demo sheets.
- 5. All equipment pads shown on sheet G1.1 are the responsibility of the Bid Category No. 1 General Trades contractor. Coordinate with the mechanical drawings and the Bid Category No. 10 Mechanical and Plumbing contractor prior to placing.

Add the following Specifications Sections:

Section 23 11 13 - Facility Fuel-Oil Piping Section 23 13 23 - Facility Above Ground Fuel-Oil Storage Tanks

I. <u>BID CATEGORY NO. 11 – ELECTRICAL AND TECHNOLOGY</u>

Add the following Specification Section:

Section 27 13 23 - TM-Manufacturer's Material List

Add the following General Clarifications:

- 8. Existing Carmel High School intercom system is Carehawk.
- 9. Panel C2 on sheet E5.02 this is a 120v/208 v main lug only panelboard with 30 circuits. It is fed from Panel WDPL-1.
- 10. The 200-amp spare in the existing 480v switch gear that feeds SPH1 does not appear to be a spare.

B. SPECIFICATION SECTION 01 21 00 - ALLOWANCES


Paragraph 3.01 Product Allowance <u>Add:</u> B. Bid Category No. 11 Electrical 200 amp Eused Switch in Exist.

B. Bid Category No. 11 Electrical – 200 amp Fused Switch in Existing 480v Gear \$3500

C. <u>SPECIFICATION SECTION 01 32 00 – SCHEDULES</u>

Delete the following:

Delete the attached incorrect sheet of the Exterior Logistics Plan (Page 1).

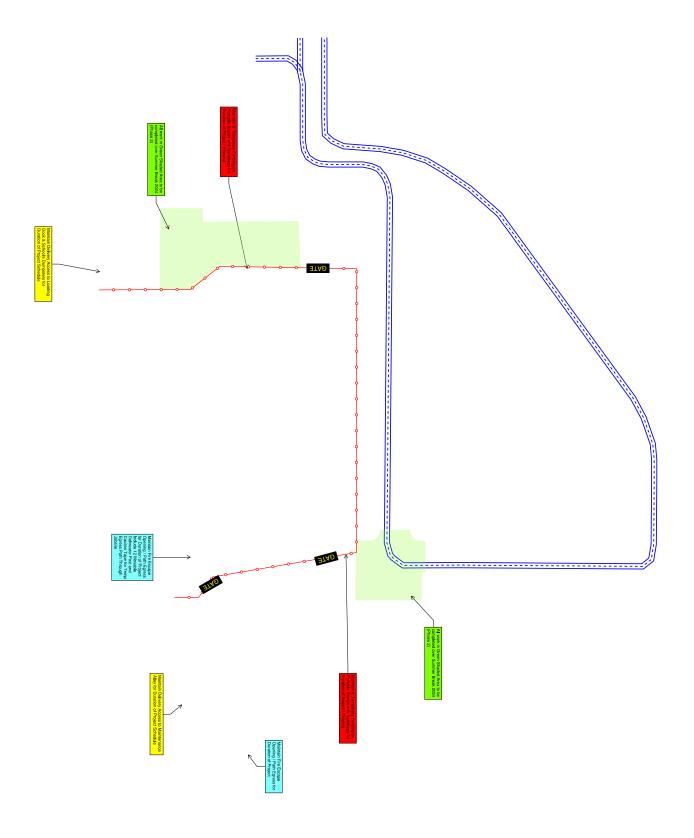

ADDENDUM NO.2

Carmel High School Polytechnic Addition and Renovation

Project No. 221165.01

Carmel Clay Schools Carmel, Indiana

Index of Contents

Addendum No. 2, 11 items, 3 pages


New Project Manual Section: 09 21 16.23 - Gypsum Board Shaft Wall Assemblies, 23 11 13 - Facility Fuel-Oil Piping, 23 13 23 - Facility Above Ground Fuel-Oil Storage Tanks, 27 13 23 TM - Manufacturer's Material List, and 27 15 53 TM - Manufacturer's Material List

Revised Project Manual Sections: Sections 12 93 00 - Site Furnishings and Amenities, 23 80 61 - Fume Collection Systems, 27 11 00 TM – Manufacturer's Material List, 27 15 15 TM – Manufacturer's Material List, 27 15 17 - Communications Copper Horizontal Cabling (Augmented CAT 6A) and 33 41 00 - Storm Utility Drainage Piping

Revised Drawing Sheets: Index A, Index B, GD1.1, G1.1, G1.3, G2.1, G3.3, G4.1, G4.2, G5.1, G5.2, SU1.1, SU2.1, SU3.3, S1.01, S1.02, S1.03, S2.01, S2.02, S2.03, S3.01, S4.01, S5.02, S5.03, A0.01, AD1.01, AD3.01, A1.01, A1.02, A1.03, A1.05, A2.01, A2.02, A4.01, A5.01, A5.02, A5.04, A5.05, A7.01, A7S.01, A8.01, A8.03, A8.04, A8.08, A8S.01, A9.01, A9.03, A10.01, A10.02, P2.01, P3.01, P4.01, P4.02, M2.01, M2.02, M4.01, M5.01, M5.07, E3.01, E3.04, E5.01, E5.02, E6.01, TD.01, TD.02, T1.03, and T3.01

Date: October 5, 2023

FANNING/HOWEY ASSOCIATES, INC. ARCHITECTS/ENGINEERS/CONSULTANTS

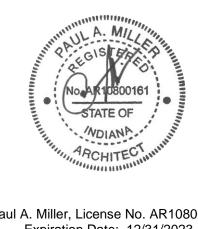

Paul A. Miller, License No. AR10800161 Expiration Date: 12/31/2023

TO: ALL BIDDERS OF RECORD

ADDENDUM NO. 2 to Drawings and Project Manual, dated August 31, 2023 for Carmel High School Polytechnic Addition and Renovations for Carmel Clay Schools, 5201 East Main Street, Carmel, Indiana 46033; as prepared by Fanning/Howey Associates, Inc., Indianapolis, Indiana.

This Addendum shall hereby be and become a part of the Contract Documents the same as if originally bound thereto.

The following clarifications, amendments, additions, revisions, changes, and modifications change the original Contract Documents only in the amount and to the extent hereinafter specified in this Addendum.

Each bidder shall acknowledge receipt of this Addendum in his proposal or bid.

NOTE: Bidders are responsible for becoming familiar with every item of this Addendum. (This includes miscellaneous items at the very end of this Addendum.)

RE: ALL BIDDERS

ITEM NO. 1. PROJECT MANUAL, TABLE OF CONTENTS

- A. Book 2, Page 00 00 20-3, DIVISION 09: Add Section 09 21 16.23 Gypsum Board Shaft Wall Assemblies.
- B. Book 2, Page 00 00 20-5, DIVISION 23: Add Sections 23 11 13 Facility Fuel-Oil Piping and 23 13 23 Facility Above Ground Fuel-Oil Storage Tanks.
- C. Book 3, Page 00 00 20-6, Division 27: Add Sections 27 13 23 TM Manufacturer's Material List, and 27 15 53 TM Manufacturer's Material List.

ITEM NO. 2. <u>NEW PROJECT MANUAL SECTION(S)</u>

A. New Project Manual Section 09 21 16.23 – Gypsum Board Shaft Wall Assemblies, 23 11 13 – Facility Fuel-Oil Piping, 23 13 23 – Facility Above Ground Fuel-Oil Storage Tanks, 27 13 23 TM – Manufacturer's Material List, and 27 15 53 TM – Manufacturer's Material List are included with and hereby made a part of this Addendum.

ITEM NO. 3. REVISED PROJECT MANUAL SECTIONS

A. Sections 12 93 00 – Site Furnishings and Amenities, 23 80 61 – Fume Collection Systems, 27 11 00 TM – Manufacturer's Material List, 27 15 15 TM – Manufacturer's Material List, 27 15 17 – Communications Copper Horizontal Cabling (Augmented CAT 6A) and 33 41 00 – Storm Utility Drainage Piping have been revised, dated 10/5/23, and are included with and hereby made a part of this Addendum.

ITEM NO. 4. PROJECT MANUAL, SECTION 04 20 00 – UNIT MASONRY

- A. Replace 2.4, C., 2., as follows:
 - "2. Owner to provide Ground Face Masonry Units from Owner's attic stock."
- B. Delete 2.4, C., 3., 4., and 6., in their entirety.

Note: Paragraph No. 5 remains, adding the Acrylic Coating to Owner supplied Ground Frace Masonry Units is required as part of this Work.

ITEM NO. 5. PROJECT MANUAL, SECTION 07 01 50.91 – ROOFING RESTORATION

- A. Add 1.10, B., 3., as follows:
 - "3. New material installed at intersection of roof coating and new membrane roofing to integrate new roof coating with new construction shall be covered under Manufacturer Warranty described herein."
- B. Add 3.2, C., as follows:
 - "C. All new membrane materials must be sanded to develop suitable profile and cleaned per manufacturer's written instructions.
 - 1. Cleaning shall utilize manufacturer's recommended cleaning solution and thoroughly rinse with fresh water.
 - 2. Apply manufacturer's recommended primer to new membrane before proceeding with roof coating materials.

ITEM NO. 6. PROJECT MANUAL, SECTION 07 54 00 – THERMOPLASTIC MEMBRANE ROOFING

- A. Replace 2.3, A., 1., a., 1), as follows:
 - "1) Roof NAV #269163-0-0"
- B. Replace 2.5, B., as follows:
 - "B. Vapor Retarder/Barrier Laminate Sheet: Roof Membrane Manufacturer's standard product of same or similar material and performance specified that is part of the tested assembly."

ITEM NO. 7. PROJECT MANUAL, SECTION 11 57 00.01 – VOCATIONAL SHOP EQUIPMENT SCHEDULE

A. Item No. SAA-100: In the "Item Name/Description" column delete the Model Number "SLW210UOTO". Model number in the Model Number column and specification is correct.

ITEM NO. 8. PROJECT MANUAL, SECTION 26 24 16 - PANELBOARDS

- A. Add 2.1, A., 4., as follows:
 - "4. Existing Equipment: GE equipment to match existing may be utilized for new parts within that existing equipment only."

ITEM NO. 9. ACCEPTABLE MANUFACTURERS

The following manufacturers are to be considered acceptable manufacturers (suppliers and fabricators) for the Sections of the Specifications listed. Listed manufacturers are required to bid on products equal in type and design, size, function, and quality to that originally specified. Final decision as to equality of products specified versus those proposed shall be made by the Architect.

Section 08 91 19 – Fixed Louvers - Pottorff, Fort Worth, Texas

Section 10 51 13 – Metal Lockers - Lockers MFG, Como Mississippi Section 23 34 23 - HVAC Power Ventilators

- Canarm Ltd. (Article 2.1 A.)
- Canarm Ltd. (Article 2.2 A.)

Section 23 36 00 – Variable Air Volume Terminals

- Krueger (Article 2.1 A.)
- Metalaire (Article 2.1 A.)

Section 23 37 23 - HVAC Gravity Ventilators

- Acme (Article 2.3 A.)

Section 23 41 00 - Particulate Air Filtration

- IAP Air Products (Article 2.1 A.)

Section 23 73 13 - Modular Indoor Central Station Air-Handling Units

- VTS America (Article 2.1 A.)

Section 23 80 54 - Dust Collection System

- AQC Dust (Article 2.1 A.)
- Imperial Systems (Article 2.1 A.)
- Nederman (Article 2.1 A.)
- Boss Products LLC (Article 2.1 B.)
- Nederman (Article 2.1 B.)
- US Duct (Article 2.2 A 1.)

Section 23 80 54 – Vehicle Exhaust Systems

- Nederman (Article 2.05 A.)

ITEM NO. 10. REVISED DRAWING SHEETS

A. Drawing Sheets: Index A, Index B, GD1.1, G1.1, G1.3, G2.1, G3.3, G4.1, G4.2, G5.1, G5.2, SU1.1, SU2.1, SU3.3, S1.01, S1.02, S1.03, S2.01, S2.02, S2.03, S3.01, S4.01, S5.02, S5.03, A0.01, AD1.01, AD3.01, A1.01, A1.02, A1.03, A1.05, A2.01, A2.02, A4.01, A5.01, A5.02, A5.04, A5.05, A7.01, A7S.01, A8.01, A8.03, A8.04, A8.08, A8S.01, A9.01, A9.03, A10.01, A10.02, P2.01, P3.01, P4.01, P4.02, M2.01, M2.02, M4.01, M5.01, M5.07, E3.01, E3.04, E5.01, E5.02, E6.01, TD.01, TD.02, T1.03, and T3.01 have been revised, dated 10/5/22 and are included with and hereby made a part of this Addendum. These Drawings supersede the original documents.

ITEM NO. 11. DRAWING SHEET A8.03

A. Room No. C124, add the following note adjacent to the "PSP-1" designation:

"PSP-1 shall extend from floor base to bottom of ceiling."

END OF ADDENDUM

PART 1 - GENERAL

1.1 SUMMARY

- A. This Section includes gypsum board shaft-wall assemblies for the following:
 - 1. Shaft-wall enclosures.
 - 2. Horizontal enclosures.
- B. Related Sections include the following:
 - 1. Division 07 Section "Penetration Firestopping" for head-of-wall assemblies that incorporate gypsum board shaft-wall assemblies.
 - 2. Division 09 Section "Gypsum Board Assemblies" for finish requirements.
- 1.2 ACTION SUBMITTALS
 - A. Product Data: For each gypsum board shaft-wall assembly indicated.
- 1.3 QUALITY ASSURANCE
 - A. Fire-Resistance Ratings: Provide materials and construction identical to those of assemblies with fire-resistance ratings determined according to ASTM E 119 by a testing and inspecting agency.
- 1.4 DELIVERY, STORAGE, AND HANDLING
 - A. Deliver materials in original packages, containers, and bundles bearing brand name and identification of manufacturer or supplier.
 - B. Store materials inside under cover and keep them dry and protected against damage from weather, direct sunlight, surface contamination, corrosion, construction traffic, and other causes.
 - C. Stack panels flat on leveled supports off floor or slab to prevent sagging.

1.5 FIELD CONDITIONS

- A. Environmental Limitations: Comply with ASTM C 840 requirements or with gypsum board manufacturer's written recommendations, whichever are more stringent.
- B. Do not install interior products until installation areas are enclosed and conditioned.
- C. Do not install panels that are wet, moisture damaged, or mold damaged.
 - 1. Indications that panels are wet or moisture damaged include, but are not limited to, discoloration, sagging, and irregular shape.
 - 2. Indications that panels are mold damaged include, but are not limited to, fuzzy or splotchy surface contamination and discoloration.

PART 2 - PRODUCTS

2.1 MANUFACTURERS

- A. Basis-of-Design Product: Subject to compliance with requirements, provide the product indicated in Gypsum Board Shaft-Wall Assembly Schedule at the end of Part 3 or a comparable product by one of the following:
 - 1. American Gypsum Company.
 - 2. CertainTeed Gypsum, Inc.

- 3. G-P Gypsum.
- 4. Continental Building Products, LLC (fka Lafarge).
- 5. National Gypsum Company.
- 6. PABCO Gypsum.
- 7. Temple-Inland Forest Products Corporation.
- 8. USG Corporation.
- B. Products of other manufacturers will be considered for acceptance provided they equal or exceed the material requirements and functional qualities of the specified product. Requests for Architect/Engineer's approval must be accompanied by the "Substitution Request Form" and complete technical data for evaluation. All materials for evaluation must be received by the Project Manager and Specification Department at least 10 days prior to bid due date. Additional approved manufacturers will be issued by Addendum.
- 2.2 GYPSUM BOARD SHAFT-WALL ASSEMBLIES, GENERAL
 - A. Provide materials and components complying with requirements of fire-resistance-rated assemblies indicated.
 - 1. Provide panels in maximum lengths available to eliminate or minimize end-to-end butt joints.
 - 2. Provide auxiliary materials complying with gypsum board shaft-wall assembly manufacturer's written recommendations.

2.3 PANEL PRODUCTS

- A. Gypsum Shaft Liner Panels: Comply with ASTM C 1396.
 - 1. Moisture- and Mold-Resistant Type X: ASTM C 1396, manufacturer's proprietary liner panels with moisture- and mold-resistant core and surfaces; comply with ASTM D 3273, score of 10 as rated according to ASTM D 3274.
 - a. Core: 1 inch thick.
 - b. Long Edges: Double bevel.
 - c. Mold Resistance: ASTM D 3273, score 10 as rated according to ASTM D 3274.
- B. Gypsum Board: As specified in Division 09 Section "Gypsum Board Assemblies".
- 2.4 NON-LOAD-BEARING STEEL FRAMING
 - A. Framing Members: Comply with ASTM C 645 for conditions indicated.
 - B. Steel Sheet Components: Comply with ASTM C 645 requirements for metal, unless otherwise indicated.
 - 1. Protective Coating: Coating with equivalent corrosion resistance of ASTM A 653, G40, hot-dip galvanized, unless otherwise indicated.
 - C. Firestop Tracks: Top runner manufactured to allow partition heads to expand and contract with movement of the structure while maintaining continuity of fire-resistance-rated assembly indicated; in thickness not less than indicated for studs and in width to accommodate depth of studs.
 - 1. Products: Subject to compliance with requirements, provide one of the following:
 - a. Fire Trak Corp.; Fire Trak System.
 - b. Grace Construction Products; FlameSafe FlowTrak System.
 - c. Metal-Lite, Inc.; The System.
 - d. Steel Network Inc. (The); VertiClip SLD or VertiTrack VTD.

2.5 AUXILIARY MATERIALS

A. General: Provide auxiliary materials that comply with referenced product standards and manufacturer's written recommendations.

- B. Trim Accessories: Cornerbead, edge trim, and control joints of material and shapes specified in Division 09 Section "Gypsum Board Assemblies" that comply with gypsum board shaft-wall assembly manufacturer's written recommendations for application indicated.
- C. Gypsum Board Joint-Treatment Materials: As specified in Division 09 Section "Gypsum Board Assemblies."
- D. Steel Drill Screws: ASTM C 1002, unless otherwise indicated.
- E. Track Fasteners: Power-driven fasteners of size and material required to withstand loading conditions imposed on shaft-wall assemblies without exceeding allowable design stress of track, fasteners, or structural substrates in which anchors are embedded.
 - 1. Expansion Anchors: Fabricated from corrosion-resistant materials, with capability to sustain, without failure, a load equal to 5 times design load, as determined by testing per ASTM E 488 conducted by a qualified testing agency.
- F. Sound Attenuation Blankets: ASTM C 665, Type I (blankets without membrane facing), produced by combining thermosetting resins with mineral fibers manufactured from glass, slag wool, or rock wool.
 - 1. Fire-Resistance-Rated Assemblies: Comply with mineral-fiber requirements of assembly.
 - 2. Sustainability Requirements: Glass fiber blanket insulation used on this project shall be tested according to ASTM D5116 and shown to emit less than 13.5-ppb formaldehyde.

PART 3 - EXECUTION

3.1 EXAMINATION

- A. Examine substrates to which gypsum board shaft-wall assemblies attach or abut, with Installer present, including hollow-metal frames, elevator hoistway door frames, cast-in anchors, and structural framing. Examine for compliance with requirements for installation tolerances and other conditions affecting performance.
- B. Examine panels before installation. Reject panels that are wet, moisture damaged, or mold damaged.
- C. Proceed with installation only after unsatisfactory conditions have been corrected.

3.2 INSTALLATION

- A. General: Install gypsum board shaft-wall assemblies to comply with requirements of fireresistance-rated assemblies indicated, manufacturer's written installation instructions, and the following:
 - 1. ASTM C 754 for installing steel framing except comply with framing spacing indicated.
 - 2. Division 09 Section "Gypsum Board Assemblies" for applying and finishing panels.
- B. Do not bridge architectural or building expansion joints with shaft-wall assemblies; frame both sides of expansion joints with furring and other support.
- C. Install supplementary framing in gypsum board shaft-wall assemblies around openings and as required for blocking, bracing, and support of gravity and pullout loads of fixtures, equipment, services, heavy trim, furnishings, and similar items that cannot be supported directly by shaft-wall assembly framing.
- D. At penetrations in shaft wall, maintain fire-resistance rating of shaft-wall assembly by installing supplementary steel framing around perimeter of penetration and fire protection behind boxes containing wiring devices, elevator call buttons, elevator floor indicators, and similar items.

- E. Isolate perimeter of gypsum panels from building structure to prevent cracking of panels, while maintaining continuity of fire-rated construction.
- F. Firestop Tracks: Install to maintain continuity of fire-resistance-rated assembly indicated.
- G. Control Joints: Install control joints according to ASTM C 840 and in specific locations approved by A/E, while maintaining fire-resistance rating of gypsum board shaft-wall assemblies.
- H. Installation Tolerance: Install each framing member so fastening surfaces vary not more than 1/8 inch from the plane formed by faces of adjacent framing.

3.3 PROTECTION

- A. Protect installed products from damage from weather, condensation, direct sunlight, construction, and other causes during remainder of the construction period.
- B. Remove and replace panels that are wet, moisture damaged, or mold damaged.
 - 1. Indications that panels are wet or moisture damaged include, but are not limited to, discoloration, sagging, and irregular shape.
 - 2. Indications that panels are mold damaged include, but are not limited to, fuzzy or splotchy surface contamination and discoloration.

3.4 GYPSUM BOARD SHAFT-WALL ASSEMBLY SCHEDULE

- A. Gypsum Board Shaft-Wall Assembly SWGB-1: Where this designation is indicated, provide assembly complying with the following:
 - 1. Horizontal and vertical orientation.
 - 2. Fire Resistance Rated Assembly (1 hour):
 - a. Products:
 - 1) One hour assembly (WP-755): National Gypsum Co.
 - 2) Cavity shaft-wall gypsum drywall (UL Des U469): United States Gypsum Co.
 - 3) One hour rated finished one side (WP 7000): Georgia Pacific.
 - b. Option: UL I504 (HM 101): National Gypsum.
 - 3. Stud Depth: As indicated or as required to comply with tested assembly.
 - 4. Stud and Track Base Metal Thickness
 - a. Minimum Base-Metal Thickness: 0.0329 inch.
 - 5. Room Side Finish: Per Division 09 Section "Gypsum Board Assemblies".
 - 6. Shaft Side Finish: As indicated by fire resistance rated assembly design designation above.

END OF SECTION 09 21 16.23

1.1 RELATED DOCUMENTS

A. Drawings and general provisions of the Contract, including General and Supplementary Conditions and Division 01 Specification Sections, apply to this Section.

1.2 SUMMARY

- A. This Section includes the following:
 - 1. Screen Wall and Gates
 - 2. Trash Dumpster Gates
 - 3. Pipe Bollards and Covers
- B. Related sections include the following:
 - 1. Division 03 Section "Cast-in-Place Concrete" for installation of pipe sleeves cast or anchor bolts cast in concrete footings.
 - 2. Division 31 Section "Earth Moving" for excavation for installation of concrete footings.

1.3 SUBMITTALS

- A. Samples for Initial Selection: For units with factory-applied color finishes.
- B. Samples for Verification: For each type of exposed finish required, prepared on Samples of size indicated below.
 - 1. Size: Not less than 6-inch-long linear components and 4-inch-square sheet components.
- C. Quality Assurance/Control Submittals
 - 1. Product Data: For each type of product indicated.
- D. Closeout Submittals
 - 1. Maintenance Data: For site furnishings to include in maintenance manuals.

PART 2 - PRODUCTS

2.1 MATERIALS

- A. Aluminum: Alloy and temper recommended by aluminum producer and finisher for type of use and finish indicated; free of surface blemishes and complying with the following:
 - 1. Rolled or Cold-Finished Bars, Rods, and Wire: ASTM B 211.
 - 2. Extruded Bars, Rods, Wire, Profiles, and Tubes: ASTM B 221.
 - 3. Structural Pipe and Tube: ASTM B 429.
 - 4. Sheet and Plate: ASTM B 209.
 - 5. Castings: ASTM B 26.
- B. Steel and Iron: Free of surface blemishes and complying with the following:
 - 1. Plates, Shapes, and Bars: ASTM A 36.
 - 2. Steel Pipe: Standard-weight steel pipe complying with ASTM A 53, or electric-resistancewelded pipe complying with ASTM A 135.
 - 3. Tubing: Cold-formed steel tubing complying with ASTM A 500.
 - 4. Mechanical Tubing: Cold-rolled, electric-resistance-welded carbon or alloy steel tubing complying with ASTM A 513, or steel tubing fabricated from steel complying with ASTM A 1011 and complying with dimensional tolerances in ASTM A 500; zinc coated internally and externally.
 - 5. Sheet: Commercial steel sheet complying with ASTM A 1011.
 - 6. Perforated Metal: From steel sheet not less than 0.0897-inch nominal thickness; manufacturer's standard perforation pattern.
 - 7. Expanded Metal: Carbon-steel sheets, deburred after expansion, and complying with ASTM F 1267.

- 8. Malleable-Iron Castings: ASTM A 47, grade as recommended by fabricator for type of use intended.
- 9. Gray-Iron Castings: ASTM A 48, Class 200.
- 10. Welded metal grid
- C. Stainless Steel: Free of surface blemishes and complying with the following:
 - 1. Sheet, Strip, Plate, and Flat Bars: ASTM A 666.
 - 2. Pipe: Schedule 40 steel pipe complying with ASTM A 312.
 - 3. Tubing: ASTM A 554.
- D. Anchors, Fasteners, Fittings, and Hardware: Manufacturer's standard, corrosion-resistantcoated or non-corrodible materials; commercial quality, tamperproof, vandal and theft resistant, or concealed, recessed, and capped or plugged. Provide one of the following:
 - 1. Angle Anchors: For inconspicuously bolting legs of site furnishings to on-grade substrate; one per leg, unless otherwise noted.
 - 2. Antitheft Hold-Down Brackets: For securing site furnishings to substrate; minimum two per unit or as required by manufacturer.
- E. Erosion-Resistant Anchoring Cement: Factory-packaged, non-shrink, non-staining, hydrauliccontrolled expansion cement formulation for mixing with potable water at Project site to create pourable anchoring, patching, and grouting compound; resistant to erosion from water exposure without needing protection by a sealer or waterproof coating; recommended in writing by manufacturer, for exterior applications.
- F. Galvanizing: Where indicated for steel and iron components, provide the following protective zinc coating applied to components after fabrication:
 - 1. Zinc-Coated Tubing: External, zinc with organic overcoat, consisting of a minimum of 0.9 oz./sq. ft. of zinc after welding, a chromate conversion coating, and a clear, polymer film. Internal, same as external or consisting of 81 percent zinc pigmented coating, not less than 0.3 mil thick.
 - 2. Hot-Dip Galvanizing: According to ASTM A 123, ASTM A 153, or ASTM A 924.

2.2 SCREEN WALL AND GATES

- A. Screen Wall / Fencing
 - 1. CityScapes Architectural innovations, Covrit System (Cellular PVC Vertical Plank with standard stiffener infill Madison Style with woodgrain surface on two-sides)
 - 2. Color selection by Owner.
 - 3. Height shall be 8'-0". Width of planks, per manufacturer to withstand local wind load codes.
 - 4. Posts: Shall be part of the Plank system and surface mounted on new concrete or a new concrete pier foundation.
 - a. Posts shall be mounted with Hilti epoxy anchors.
 - b. Post cap shall be a metal powder-coated shallow hip style.
- B. Swing Gates at Screen Wall System
 - 1. CityScapes Architectural innovations, ToughGate PVC Vertical Plank Infill Series Madison Style)
 - 2. Height shall be 7'-9", leaving a 3" gap at the bottom.
 - 3. Width: Opening is per Plan and allow for two 5" diameter gate posts, as required.
 - 4. Gate Posts: Steel powder coated in ground posts (5" diameter) Color selection by Owner.
 - 5. Latch: Powder-coated steel. (lock by Owner). Color selection by Owner.
 - 6. Drop Pin: Powder-coated steel or Stainless Steel (1/2" diameter) with adjustable mounting hardware.
 - 7. Handle: Powder-coated aluminum "Bridge" style handle on both gates. Color selection by Owner.
 - 8. Man-gate shall be a 5' wide single swing gate.
 - a. Provide door hardware with lock on the on the "Un-secure", west side.
 - b. Provide weather-proof panic hardware (Detex or similar) with local alarm on the "secure" east side, with contact switch at post.

- C. Rolling or Sliding Gates
 - 1. CityScapes Architectural innovations, ToughGate PVC Vertical Plank Infill Series Madison Style)
 - 2. Height shall be 7'-8", leaving a 4" gap at the bottom.
 - 3. Width: Opening is 12'-0" between masonry.
 - 4. Gate Frame: Steel, powder coated to be designed by the wall system manufacturer to support vertical planks.
 - 5. Gate support system shall be steel, powder coated to be designed by the wall system manufacturer.
 - 6. Rollers (3 minimum shall have steel powder coated axles and springs as required, with flexible wheels.
 - 7. Latch: Powder-coated steel. (Lock by Owner). Color selection by Owner.
 - 8. Handle: Powder-coated aluminum "Bridge" style handle on both gates. Color selection by Owner.
- D. Trash Dumpster Gates.
 - 1. CityScapes Architectural innovations, ToughGate PVC Vertical Plank Infill Series Madison Style) Wood grain on two sides.
 - 2. Height shall be 7'-9", leaving a 3" gap at the bottom.
 - 3. Width: Opening is 12'-0" between masonry, and allow for two 5" diameter gate posts.
 - 4. Double Swing Gates
 - 5. Gate Posts: Steel powder coated in ground posts (5: diameter) Color selection by Owner.
 - 6. Hinges: Powder-coated steel. Color selection by Owner.
 - 7. Latch: Powder-coated steel. (Lock by Owner). Color selection by Owner.
 - 8. Drop Pin: Powder-coated steel or stainless steel (1/2" diameter) with adjustable mounting hardware.
 - 9. Handle: Powder-coated aluminum "Bridge" style handle on both gates. Color selection by Owner.

2.3 BOLLARDS

- A. Steel Bollards
 - 1. Pipe materials
 - a. Size shall be 4" or 6" diameter and 48" tall, per plan and details.
 - b. Schedule 40 galvanized steel pipe.
 - c. Concrete filled.
 - d. Powder coated finish, unless receiving a bollard cover.
 - 2. Foundations and mounting
 - a. Direct buried with 3,500 psi Concrete Foundations, 36" minimum depth
 - b. Surface mounted with $1/2^{"}$ (min) base plates and four $\frac{1}{2}^{"}$ diameter x 6" long galvanized anchor bolts.
- B. Bollard Covers
 - 1. HDPE, Wall thickness ¼".
 - 2. Color shall be as indicated on the Plans.
 - 3. Sealant caulking (1/8" min) to be applied between bollard cover and foundation.
 - Manufacturers:
 - a. Ideal Sheild
 - b. ULine
- 2.4 FABRICATION

4.

- A. Metal Components: Form to required shapes and sizes with true, consistent curves, lines, and angles. Separate metals from dissimilar materials to prevent electrolytic action.
- B. Welded Connections: Weld connections continuously. Weld solid members with full-length, full-penetration welds and hollow members with full-circumference welds. At exposed

connections, finish surfaces smooth and blended so no roughness or unevenness shows after finishing and welded surface matches contours of adjoining surfaces.

- C. Pipes and Tubes: Form simple and compound curves by bending members in jigs to produce uniform curvature for each repetitive configuration required; maintain cylindrical cross section of member throughout entire bend without buckling, twisting, cracking, or otherwise deforming exposed surfaces of handrail and railing components.
- D. Exposed Surfaces: Polished, sanded, or otherwise finished; all surfaces smooth, free of burrs, barbs, splinters, and sharpness; all edges and ends rolled, rounded, or capped.
- E. Factory Assembly: Assemble components in the factory to greatest extent possible to minimize field assembly. Clearly mark units for assembly in the field.
- 2.5 FINISHES, GENERAL
 - A. Comply with NAAMM's "Metal Finishes Manual for Architectural and Metal Products" for recommendations for applying and designating finishes.
 - B. Appearance of Finished Work: Variations in appearance of abutting or adjacent pieces are acceptable if they are within one-half of the range of approved Samples. Noticeable variations in the same piece are not acceptable. Variations in appearance of other components are acceptable if they are within the range of approved Samples and are assembled or installed to minimize contrast.
 - C. All exposed metal surfaces on tables, seating, and trash receptacles shall be coated with a Panguard II powder-coat finish.
- 2.6 STEEL AND GALVANIZED STEEL FINISHES
 - A. Powder-Coat Finish: Manufacturer's standard, baked, polyester, powder-coat finish complying with finish manufacturer's written instructions for surface preparation, including pretreatment, application, baking, and minimum dry film thickness.
- PART 3 EXECUTION
- 3.1 EXAMINATION
 - A. Examine areas and conditions, with Installer present, for compliance with requirements for correct and level finished grade, mounting surfaces, installation tolerances, and other conditions affecting performance.
 - 1. Proceed with installation only after unsatisfactory conditions have been corrected.
- 3.2 INSTALLATION, GENERAL
 - A. Comply with manufacturer's written installation instructions unless more stringent requirements are indicated. Complete field assembly of site furnishings where required.
 - B. Install all site furnishings with embedment type mounting prior to paving and landscaping. All other surface style mounted site furnishings to be installed after landscaping and paving have been completed.
 - C. Install site furnishings level, plumb, true, and securely anchored at locations indicated on Drawings.
 - D. Post Setting: Set cast-in or embedment type support posts in concrete footing with smooth top, shaped to shed water to depths as required by manufacturer. Protect portion of posts above footing from concrete splatter. Verify that posts are set plumb or at correct angle and are

aligned and at correct height and spacing. Hold posts in position during placement and finishing operations until concrete is sufficiently cured.

E. Store and Install Apex Inverted Bike Parking Racks per manufacture's written instructions.

3.3 CLEANING

A. After completing site furnishing installation, inspect components. Remove spots, dirt, and debris. Repair damaged finishes to match original finish or replace component.

END OF SECTION 116833

SECTION 231113 - FACILITY FUEL-OIL PIPING

PART 1 - GENERAL

1.1 SUMMARY

- A. Section Includes:
 - 1. Double-containment pipe and fittings.
 - 2. Piping specialties.
 - 3. Joining materials.
 - 4. Specialty valves.
 - 5. Mechanical leak-detection valves.
 - 6. Leak-detection and monitoring system.
 - 7. Labels and identification.

1.2 ACTION SUBMITTALS

- A. Product Data:
 - 1. Double-containment pipe and fittings.
 - 2. Piping specialties.
 - 3. Joining materials.
 - 4. Specialty valves.
 - 5. Mechanical leak-detection valves.
 - 6. Leak-detection and monitoring system.
 - 7. Labels and identification.
- B. Product Data Submittals:
 - 1. Include construction details, material descriptions, and dimensions of individual components and profiles.
 - 2. Include rated capacities, pressure ratings, operating characteristics, electrical characteristics, settings, and furnished specialties and accessories.
- C. Shop Drawings: For fuel-oil piping.
 - 1. Include plans, elevations sections, hangers, and supports for multiple pipes.
 - 2. Include details of location of anchors, alignment guides, and expansion joints and loops.
 - 3. Scale: 1/4 inch per foot.

1.3 INFORMATIONAL SUBMITTALS

A. Coordination Drawings:

- 1. Plans and details, drawn to scale, on which fuel-oil piping and tanks are shown and coordinated with other installations, using input from installers of the items involved.
- B. Field quality-control reports.
- C. Sample Warranty: For special warranty.

1.4 CLOSEOUT SUBMITTALS

- A. Operation and Maintenance Data: For fuel-oil equipment and accessories.
 - 1. Indicate actual installed items by marking submittals with an arrow or box.

1.5 MAINTENANCE MATERIAL SUBMITTALS

1.6 QUALITY ASSURANCE

- A. Delegated Design Engineer Qualifications: A professional engineer who is legally qualified to practice in Indiana where Carmel High School is located and who is experienced in providing engineering services of the type indicated.
- B. Steel Support Welding Qualifications: Qualify procedures and personnel in accordance with AWS D1.1/D1.1M, "Structural Welding Code Steel."
- C. Pipe Welding Qualifications: Qualify procedures and personnel in accordance with ASME Boiler and Pressure Vessel Code.

1.7 DELIVERY, STORAGE, AND HANDLING

- A. Lift and support fuel-oil storage tanks only at designated lifting or supporting points, as indicated on Shop Drawings. Do not move or lift tanks unless empty.
- B. Deliver pipes and tubes with factory-applied end caps. Maintain end caps through shipping, storage, and handling to prevent pipe end damage and to prevent entrance of dirt, debris, and moisture.
- C. Store PE and PE-coated pipes, tubes, and valves in manner to avoid damaging the coating and to protect from direct sunlight.

1.8 FIELD CONDITIONS

- A. Interruption of Existing Fuel-Oil Service: Do not interrupt fuel-oil service to facilities occupied by Owner or others unless permitted under the following conditions and then only after arranging to provide temporary fuel-oil supply in accordance with requirements indicated:
 - 1. Notify Construction Manager/Owner no fewer than **two** days in advance of proposed interruption of fuel-oil service.

2. Do not proceed with interruption of fuel-oil service without Construction Manager's/ Owner's written permission.

1.9 WARRANTY

- A. Special Warranty: Manufacturer agrees to repair or replace components of flexible, doublecontainment piping and related equipment that fail in materials or workmanship within specified warranty period.
 - 1. Failures include those due to defective materials or workmanship for materials including piping, dispenser sumps, watertight sump entry boots, terminations, and other end fittings.
 - 2. Warranty Period: 10 years from date of Substantial Completion.

PART 2 - PRODUCTS

2.1 PERFORMANCE REQUIREMENTS

- A. Electrical Components, Devices, and Accessories: Listed and labeled as defined in NFPA 70, by an NRTL, and marked for intended location and use.
- B. Comply with ASME B31.9, "Building Services Piping," for fuel-oil piping materials, installation, testing, and inspecting.
- C. Fuel-Oil Valves: Comply with UL 842 and have service mark initials "WOG" permanently marked on valve body.
- D. Comply with requirements of the EPA and of state and local authorities having jurisdiction.
- E. Maximum Operating-Pressure Ratings: 3 psig fuel-oil supply pressure at oil-fired appliances.

2.2 DOUBLE-CONTAINMENT PIPE AND FITTINGS

- A. Double-Containment Piping Flexible, Nonmetallic:
 - 1. Source Limitations: Obtain double-containment piping flexible, nonmetallic, from single manufacturer.
 - 2. Standard: Comply with UL 971.
 - 3. Pipe Materials: PVDF complying with ASTM D3222 for carrier pipe with mechanical couplings to seal carrier, and PE pipe complying with ASTM D4976 for containment piping.
 - 4. Sumps: PE.
 - 5. Watertight sump entry boots, pipe adapters with test ports and tubes, coaxial fittings, and couplings.
 - 6. Minimum Operating Pressure Rating: 10 psig
 - 7. Plastic to Steel Pipe Transition Fittings: Factory-fabricated fittings with plastic end matching or compatible with carrier piping, and steel pipe end complying with ASTM A53/A53M, black steel, Schedule 40, Type E or S, Grade B.

- 8. Include design and fabrication of double-containment pipe and fitting assemblies with provision for field installation of cable leak-detection system in annular space between carrier and containment piping.
- 9. Leak-Detection System: Include design and fabrication of double-containment pipe and fitting assemblies with provision for field installation of cable leak-detection system in annular space between carrier and containment piping.
- B. Double-Containment Piping Flexible, Metallic:
 - 1. Source Limitations: Obtain double-containment piping flexible, metallic, from single manufacturer.
 - 2. Standard: Comply with UL 971A.
 - 3. Pipe Materials:
 - a. Metallic Lining: ASTM A240/A240M, Type 304, corrugated stainless steel tubing.
 - b. Carrier Pipe: Fluoropolymer tube.
 - c. Jacket: UV stabilized.
 - 4. Watertight sump entry boots, pipe adapters with test ports and tubes, coaxial fittings, and couplings.
 - 5. Minimum Operating Pressure Rating: 10 psig
 - 6. Plastic to Steel Pipe Transition Fittings: Factory-fabricated fittings with plastic end matching or compatible with carrier piping, and steel pipe end complying with ASTM A53/A53M, black steel, Schedule 40, Type E or S, Grade B.
 - 7. Include design and fabrication of double-containment pipe and fitting assemblies with provision for field installation of cable leak-detection system in annular space between carrier and containment piping.
 - 8. Leak-Detection System: Include design and fabrication of double-containment pipe and fitting assemblies with provision for field installation of cable leak-detection system in annular space between carrier and containment piping.
- C. Double-Containment Piping Rigid:
 - 1. Source Limitations: Obtain double-containment piping rigid, from single manufacturer.
 - 2. Standard: Comply with UL 971.
 - 3. RTRP: ASTM D2996 or ASTM D2997 carrier and containment piping and mechanical couplings to seal carrier and containment piping or individually bonded joints.
 - a. Minimum Operating-Pressure Rating for RTRP NPS 2 and NPS 3 (DN 50 and DN 80): 150 psig
 - b. Minimum Operating-Pressure Rating for RTRP NPS 4 and NPS 6 (DN 100 and DN 150): 125 psig. Compliance with UL 971 is not required for NPS 6 (DN 150) and larger piping.
 - c. Fittings: RTRF complying with ASTM D2996 or ASTM D2997 and made by RTRP manufacturer; watertight sump entry boots, termination, or other end fittings.
 - 4. Leak-Detection System: Include design and fabrication of double-containment pipe and fitting assemblies with provision for field installation of cable leak-detection system in annular space between carrier and containment piping.

2.3 PIPING SPECIALTIES

- A. Flexible Connectors Metallic:
 - 1. Source Limitations: Obtain flexible connectors metallic, from single manufacturer.
 - 2. Listed and labeled for aboveground and underground applications by an NRTL acceptable to authorities having jurisdiction.
 - 3. Stainless steel bellows with woven, flexible, bronze or stainless steel, wire-reinforcing protective jacket.
 - 4. Minimum Operating Pressure: 150 psig
 - 5. End Connections: Socket, flanged, or threaded end to match connected piping.
 - 6. Maximum Length: 30 inches
 - 7. Swivel end, 50 psig maximum operating pressure.
 - 8. Factory-furnished anode for connection to cathodic protection.
- B. Flexible Connectors Nonmetallic:
 - 1. Source Limitations: Obtain flexible connectors nonmetallic, from single manufacturer.
 - 2. Listed and labeled for underground applications by an NRTL acceptable to authorities having jurisdiction.
 - 3. PFTE bellows with woven, flexible, bronze or stainless steel, wire-reinforcing protective jacket.
 - 4. Minimum Operating Pressure: 150 psig
 - 5. End Connections: Socket, flanged, or threaded end to match connected piping.
 - 6. Maximum Length: 30 inches
 - 7. Swivel end, 50 psig maximum operating pressure.
 - 8. Factory-furnished anode.
- C. Strainers Y-Pattern:
 - 1. Body: ASTM A126, Class B, cast iron with bolted cover and bottom drain connection.
 - 2. End Connections: Threaded ends for NPS 2 and smaller; flanged ends for NPS 2-1/2 and larger.
 - 3. Strainer Screen: 80-mesh startup strainer and perforated stainless steel basket with 50 percent free area.
 - 4. CWP Rating: 125 psig.
- D. Strainers Basket:
 - 1. Body: ASTM A126, Class B, high-tensile cast iron with bolted cover and bottom drain connection.
 - 2. End Connections: Threaded ends for NPS 2 and smaller; flanged ends for NPS 2-1/2 and larger.
 - 3. Strainer Screen: 80-mesh startup strainer and perforated stainless steel basket with 50 percent free area.
 - 4. CWP Rating: 125 psig.
- E. Strainers T-Pattern:
 - 1. Body: Ductile or malleable iron with removable access coupling and end cap for strainer maintenance.
 - 2. End Connections: Grooved ends.

- 3. Strainer Screen: 80-mesh startup strainer and perforated stainless steel basket with 57 percent free area.
- 4. CWP Rating: 750 psig
- F. Air Vents Manual:
 - 1. Body: Bronze.
 - 2. Internal Parts: Nonferrous.
 - 3. Operator: Screwdriver or thumbscrew.
 - 4. Inlet Connection: NPS 1/2
 - 5. Discharge Connection: NPS 1/8
 - 6. CWP Rating: 150 psig
 - 7. Maximum Operating Temperature: 225 deg F

2.4 JOINING MATERIALS

- A. Joint Compound and Tape for Threaded Joints: Suitable for fuel oil.
- B. Welding Filler Metals: Comply with AWS D10.12/D10.12M for welding materials appropriate for wall thickness and chemical analysis of steel pipe being welded.
- C. Brazing Filler Metals: Alloy with melting point greater than 1000 deg F complying with AWS A5.8/A5.8M. Brazing alloys containing more than 0.05 percent phosphorus are prohibited.
- D. Bonding Adhesive for RTRP and RTRF: As recommended by piping and fitting manufacturer.

2.5 SPECIALTY VALVES

- A. Pressure Relief Valves:
 - 1. Source Limitations: Obtain pressure relief valves from single manufacturer.
 - 2. Listed and labeled for fuel-oil service by an NRTL acceptable to authorities having jurisdiction.
 - 3. Body: Brass, bronze, or cast steel.
 - 4. Springs: Stainless steel, interchangeable.
 - 5. Seat and Seal: NBR.
 - 6. Orifice: Stainless steel, interchangeable.
 - 7. Factory-Applied Finish: Baked enamel.
 - 8. Maximum Inlet Pressure: **150 psig**
 - 9. Relief Pressure Setting: **60 psig**
- B. Oil Safety Valves:
 - 1. Source Limitations: Obtains oil safety valves from single manufacturer.
 - 2. Listed and labeled for fuel-oil service by an NRTL acceptable to authorities having jurisdiction.
 - 3. Body: Brass, bronze, or cast steel.
 - 4. Springs: Stainless steel.
 - 5. Seat and Diaphragm: NBR.
 - 6. Orifice: Stainless steel, interchangeable.

- 7. Factory-Applied Finish: Baked enamel.
- 8. Manual override port.
- 9. Maximum Inlet Pressure: 60 psig.
- 10. Maximum Outlet Pressure: 3 psig
- C. Emergency Shutoff Valves:
 - 1. Source Limitations: Obtain emergency shutoff valves from single manufacturer.
 - 2. Listed and labeled for fuel-oil service by an NRTL acceptable to authorities having jurisdiction.
 - 3. [Single] [Double] poppet valve.
 - 4. Body: ASTM A126, cast iron.
 - 5. Disk: FPM.
 - 6. Poppet Spring: Stainless steel.
 - 7. Stem: Plated brass.
 - 8. O-Ring: FPM.
 - 9. Packing Nut: PTFE-coated brass.
 - 10. Fusible link to close valve at 165 deg F
 - 11. Thermal relief to vent line pressure buildup due to fire.
 - 12. Air test port.
 - 13. Maximum Operating Pressure: 0.5 psig

2.6 MECHANICAL LEAK-DETECTION VALVES

- A. Source Limitations: Obtain mechanical leak-detection valves from single manufacturer.
- B. Listed and labeled for fuel-oil service by an NRTL acceptable to authorities having jurisdiction.
- C. Body: ASTM A126, cast iron.
- D. O-Rings: Elastomeric compatible with fuel oil.
- E. Piston and Stem Seals: PTFE.
- F. Stem and Spring: Stainless steel.
- G. Piston Cylinder: Burnished brass.
- H. Indicated Leak Rate: Maximum 3 gph at 10 psig
- I. Leak Indication: Reduced flow.

2.7 LEAK-DETECTION AND MONITORING SYSTEM

- A. Cable and Sensor Leak-Detection Monitoring System:
 - 1. Source Limitations: Obtain cable and sensor leak-detection monitoring system from single manufacturer.
 - 2. Standard: Comply with UL 1238.
 - 3. Calibrated leak-detection and monitoring system with probes and other sensors and remote alarm panel for fuel-oil piping.

4. Include fittings and devices required for testing.

2.8 LABELS AND IDENTIFICATION

A. Detectable Warning Tape: Acid- and alkali-resistant PE-film warning tape manufactured for marking and identifying underground utilities, minimum of 6 inches wide and 4 mils thick, continuously inscribed with description of utility, with metallic core encased in a protective jacket for corrosion protection, and detectable by metal detector when tape is buried up to 30 inches deep; colored yellow.

PART 3 - EXECUTION

3.1 EXAMINATION

- A. Examine areas for compliance with requirements for installation tolerances and other conditions affecting performance of fuel-oil piping.
- B. Examine installation of fuel-burning equipment and fuel-handling and storage equipment to verify actual locations of piping connections before installing fuel-oil piping.
- C. Proceed with installation only after unsatisfactory conditions have been corrected.

3.2 EARTHWORK

A. Comply with requirements in Section 312000 "Earth Moving" for excavating, trenching, and backfilling.

3.3 PREPARATION

- A. Close equipment shutoff valves before turning off fuel oil to premises or piping section.
- B. Comply with NFPA 30 and NFPA 31 requirements for prevention of accidental ignition.

3.4 INSTALLATION OF OUTDOOR PIPING

- A. Underground Fuel-Oil Piping Burial Depth:
 - 1. Under Compacted Backfill: 18 inches below finished grade.
 - 2. Under Asphalt 2 Inches (51 mm) Thick: 8 inches below bottom of asphalt.
 - 3. Under 4 Inches (102 mm) of Reinforced Concrete in Areas Subject to Vehicle Traffic: 4 inches below bottom of concrete.
 - 4. Comply with requirements in Section 312000 "Earth Moving" for excavating, trenching, and backfilling.
- B. Steel Piping with Protective Coating:

- 1. Apply joint cover kits to pipe after joining, to cover, seal, and protect joints.
- 2. Repair damage to PE coating on pipe, complying with protective coating manufacturer's written instructions. Review protective coating damage with Architect prior to repair.
- 3. Replace pipe having damaged PE coating with new pipe.
- C. Install double-containment, fuel-oil pipe at a minimum slope of 1 percent downward toward fuel-oil storage tank sump.
- D. Install vent pipe at a minimum slope of 2 percent downward toward fuel-oil storage tank sump.
- E. Assemble and install entry boots for pipe penetrations through sump sidewalls for liquidtight joints.
- F. Install metal pipes and tubes, fittings, valves, and flexible connectors at piping connections to aboveground storage tanks and underground storage tanks.
- G. Install fittings for changes in direction in rigid pipe.
- H. Install system components with pressure rating equal to or greater than system operating pressure.

3.5 INSTALLATION OF VALVES

- A. Install valves in accessible locations.
- B. Install pressure relief valves in distribution piping between the supply and return lines.
- C. Install one-piece, bronze ball valve with hose end connection at low points in fuel-oil piping. Comply with requirements in Section 230523.12 "Ball Valves for HVAC Piping."
- D. Install manual air vents at high points in fuel-oil piping.

3.6 PIPING JOINT CONSTRUCTION

- A. Ream ends of pipes and tubes and remove burrs.
- B. Remove scale, slag, dirt, and debris from inside and outside of pipe and fittings before assembly.
- C. Threaded Joints: Thread pipe with tapered pipe threads in accordance with ASME B1.20.1. Cut threads full and clean using sharp dies. Ream threaded pipe ends to remove burrs and restore full ID. Join pipe fittings and valves as follows:
 - 1. Apply appropriate tape or thread compound to external pipe threads unless dry seal threading is specified.
 - 2. Damaged Threads: Do not use pipe or pipe fittings with threads that are corroded or damaged. Do not use pipe sections that have cracked or open welds.
- D. Welded Joints: Construct joints in accordance with AWS D10.12/D10.12M, using qualified processes and welding operators in accordance with "Quality Assurance" Article.

- 1. Bevel plain ends of steel pipe.
- 2. Patch factory-applied protective coating as recommended in writing by manufacturer at field welds and where damage to coating occurs during construction.
- E. Brazed Joints: Construct joints in accordance with AWS's "Brazing Handbook," Ch. 35, "Pipe and Tubing."
- F. Flanged Joints: Install gasket material, size, type, and thickness for service application. Install gasket concentrically positioned.
- G. Flared Joints: Comply with SAE J513. Tighten finger tight, and then use wrench in accordance with fitting manufacturer's written instructions. Do not overtighten.
- H. Fiberglass-Bonded Joints: Prepare pipe ends and fittings, apply adhesive, and join in accordance with pipe manufacturer's written instructions.

3.7 INSTALLATION OF LEAK-DETECTION AND MONITORING SYSTEM

- A. Install leak-detection and monitoring system. Install alarm panel inside building where indicated.
- B. Double-Containment, Fuel-Oil Piping: Install leak-detection sensor cable probes in interstitial space of double-containment piping.

3.8 PIPING CONNECTIONS

- A. Where installing piping adjacent to equipment, allow space for service and maintenance.
- B. Install unions, in piping NPS 2 and smaller, adjacent to each valve and at final connection to each piece of equipment having threaded pipe connection.
- C. Install flanges, in piping NPS 2-1/2 and larger, adjacent to flanged valves and at final connection to each piece of equipment having flanged pipe connection.
- D. Connect piping to equipment with shutoff valve and union. Install union between valve and equipment.
- E. Install flexible piping connectors at final connection to burners, oil-fired appliances, and day tanks.

3.9 LABELING AND IDENTIFYING

- A. Nameplates, pipe identification, valve tags, and signs are specified in Section 230553 "Identification for HVAC Piping and Equipment."
- B. Install detectable warning tape directly above buried fuel-oil piping, 6 inches below subgrade under pavements and slabs. Terminate tracer wire in an accessible area, and identify as "tracer wire" for future use with plastic-laminate sign.

1. Piping: Over underground fuel-oil distribution piping.

3.10 FIELD QUALITY CONTROL

- A. Testing Agency: Engage a qualified testing agency to perform tests and inspections.
- B. Manufacturer Field Services: Engage a factory-authorized service representative to support/ supervise field tests and inspections.
- C. Tests and Inspections:
 - 1. Piping Pressure Test: Minimum hydrostatic or pneumatic test-pressures measured at highest point in system.
 - a. Fuel-Oil Distribution Piping:
 - 1) Hydrostatic: Minimum 150 percent of maximum anticipated pressure or 5 psig
 - 2) Pneumatic: Minimum 110 percent of maximum anticipated pressure.
 - 3) Pressure to be maintained while complete visual inspection of all joints and connections is conducted.
 - 4) In no case is test pressure to be less than a gauge pressure of 5 psi measured at the highest point of the system.
 - 5) In no case is test pressure to be maintained for less than 10 minutes.
 - b. Fuel-Oil, Double-Containment Piping:
 - 1) Carrier Pipe: Same as "Fuel-Oil Distribution Piping" Subparagraph above.
 - 2) Containment Conduit: Minimum 5 psig for minimum 60 minutes.
 - c. Suction Piping: Minimum 20 in. Hg for minimum 30minutes.
 - d. Isolate storage tanks if test pressure in piping will cause pressure in storage tanks to exceed 10 psig.
- D. Inspect and test fuel-oil piping in accordance with NFPA 31, "Tests of Piping" Paragraph; and in accordance with requirements of authorities having jurisdiction.
- E. Test leak-detection and monitoring system for accuracy by manually operating sensors and checking against alarm panel indication.
- F. Test and adjust controls and safeties. Replace damaged and malfunctioning controls and equipment.
- G. Bleed air from fuel-oil piping using manual air vents.
- H. Fuel-oil piping and equipment will be considered defective if they do not pass tests and inspections.
- I. Prepare test and inspection reports.

3.11 OUTDOOR PIPING SCHEDULE

- A. All underground fuel-oil piping is to be installed in containment piping.
- B. Underground Fuel-Oil Piping: Flexible/Rigid, double-containment piping. Size indicated is carrier-pipe size.
- C. Underground fuel-oil-tank fill and vent piping to be the following:
 - 1. NPS 2 (DN 50) Pipe Size and Smaller: Steel pipe, steel or malleable-iron threaded fittings, and threaded joints. Coat pipe and fittings with protective coating for steel piping.
 - 2. NPS 2-1/2 (DN 65) Pipe Size and Larger: Steel pipe, steel welding fittings, and welded joints. Coat pipe and fittings with protective coating for steel piping.
- D. Containment Conduit: Steel pipe with wrought-steel fittings and welded joints. Coat pipe and fittings with protective coating for steel piping.
- E. Aboveground fuel-oil piping to be the following:
 - 1. NPS 2 (DN 50) Pipe Size and Smaller: Steel pipe, steel or malleable-iron threaded fittings, and threaded joints.
 - 2. NPS 2-1/2 (DN 65) Pipe Size and Larger: Steel pipe, steel welding fittings, and welded joints.
 - 3. Stainless steel pipe with grooved joints.

3.12 SHUTOFF VALVE SCHEDULE

- A. Valves for aboveground distribution piping NPS 2 (DN 50) and smaller to be the following:
 - 1. One-piece, bronze ball valve with bronze trim.
 - 2. Two-piece, full-port, bronze ball valves with bronze trim.
- B. Distribution piping valves for pipe NPS 2-1/2 (DN 65) and larger to be the following:
 - 1. Two-piece, full-port, bronze ball valves with bronze trim.
 - 2. Bronze, lubricated plug valve.
- C. Valves in branch piping for single appliance to be the following:
 - 1. One-piece, bronze ball valve with bronze trim.
 - 2. Two-piece, full-port, bronze ball valves with bronze trim.

END OF SECTION 231113

SECTION 231323 - FACILITY ABOVEGROUND FUEL-OIL STORAGE TANKS

PART 1 - GENERAL

1.1 SUMMARY

A. Section Includes:

- 1. Aboveground fuel-oil storage tanks, horizontal, steel.
- 2. Aboveground fuel-oil storage tank accessories.
- 3. Fuel-oil-level gauge system.
- 4. Fuel-oil leak-detection and monitoring systems.
- 5. Fuel oil.

1.2 ACTION SUBMITTALS

- A. Product Data: For each type of product.
 - 1. Include construction details, material descriptions, and dimensions of individual components and profiles.
 - 2. Include rated capacities, operating characteristics, electrical characteristics, and furnished specialties and accessories.
 - 3. Fuel-oil storage tank accessories.
 - 4. Fuel-oil leak-detection and monitoring system.
- B. Shop Drawings: For aboveground fuel-oil storage tanks.
 - 1. Include plans, elevations, sections, concrete bases, anchors, and lifting or supporting points.
 - 2. Indicate details of equipment assemblies. Indicate dimensions, components, and location and size of each field connection.
 - 3. Shop Drawing Scale: 1/4 inch per foot

1.3 INFORMATIONAL SUBMITTALS

- A. Site Survey: Plans, drawn to scale, on which fuel-oil storage tanks are indicated and coordinated with other services and utilities.
- B. Seismic Qualification Data: Certificates for aboveground fuel oil storage tanks, accessories, and components, from manufacturer.
 - 1. Basis for Certification: Indicate whether withstand certification is based on actual test of assembled components or on calculation.
 - 2. Dimensioned Outline Drawings of Equipment Unit: Identify center of gravity and locate and describe mounting and anchorage provisions.
 - 3. Detailed description of equipment anchorage devices on which the certification is based and their installation requirements.

- C. Welding certificates.
- D. Field quality-control reports.
- E. Sample Warranty: For special warranty.

1.4 CLOSEOUT SUBMITTALS

A. Operation and Maintenance Data: For fuel-oil equipment and accessories to include in emergency, operation, and maintenance manuals.

1.5 QUALITY ASSURANCE

A. Steel Support Welding Qualifications: Qualify procedures and personnel in accordance with AWS D1.1/D1.1M, "Structural Welding Code - Steel."

1.6 DELIVERY, STORAGE, AND HANDLING

A. Lift and support fuel-oil storage tanks only at designated lifting or supporting points, as shown on Shop Drawings. Do not move or lift tanks unless empty.

1.7 WARRANTY

- A. Special Warranty: Manufacturer agrees to repair or replace components of fuel-oil storage tanks that fail in materials or workmanship within specified warranty period.
 - 1. Storage Tanks:
 - a. Failures include, but are not limited to, the following when used for storage of fuel oil at temperatures not exceeding 150 deg F.
 - 1) Structural failures including cracking, breakup, and collapse.
 - 2) Corrosion failure including external and internal corrosion of steel tanks.

PART 2 - PRODUCTS

2.1 ABOVEGROUND FUEL-OIL STORAGE TANKS, HORIZONTAL, STEEL

- A. Source Limitations: Obtain horizontal, steel, aboveground fuel-oil storage tanks from single manufacturer.
- B. Description:
 - 1. UL 142, double-wall, horizontal steel tank; with primary- and secondary-containment walls and interstitial space.

- C. Construction: Fabricated with welded carbon steel; suitable for operation at atmospheric pressure and for storing fuel oil with specific gravity up to 1.1 and with maintained temperature up to 150 deg F.
- D. Supports:
 - 1. Manufacturer's standard structural steel welded to tank.
 - 2. Number of Supports: 2.
- E. Capacities and Characteristics:
 - 1. Capacity: 750 gal.
 - 2. Diameter: <**Insert feet (m)**>.
 - 3. Length: <**Insert feet (m)**>.
 - 4. Connection Sizes:
 - a. Fill Line: 2" NPS
 - b. Vent Line: 2" NPS
 - c. Outlet: 2" NPS
 - d. Return: 2" NPS
 - e. Gauge: NPS
 - 5. Manholes:
 - a. Number Required: <Insert number>.
 - b. Diameter: <**Insert inches (mm)**>.
 - 6. Fuel: Fuel Oil.

2.2 ABOVEGROUND FUEL-OIL STORAGE TANK ACCESSORIES

- A. Threaded pipe connection fittings on top of tank, for fill, supply, return, vent, sounding, and gauging. Include cast-iron plugs for shipping.
- B. Threaded pipe connection fittings on top or sides of tank as indicated, for fill, supply, return, vent, sounding, and gauging. Include cast-iron plugs for shipping.
- C. Striker Plates: Inside tank, on bottom below fill, vent, sounding, gauge, and other tube openings.
- D. Lifting Lugs: For handling and installation.
- E. Supply Tube: Extension of supply piping fitting into tank, terminating 6 inches above tank bottom and cut at a 45-degree angle.
- F. Sounding and Gauge Tubes: Extension of fitting into tank, terminating 6 inches above tank bottom and cut at a 45-degree angle.

2.3 FUEL-OIL-LEVEL GAUGE SYSTEM

A. Source Limitations: Obtain fuel-oil-level gauge system from single manufacturer.

- B. Description: Calibrated fuel-oil-level gauge system complying with UL 180 with floats & UL 1238 with probes or other sensors and remote annunciator panel.
- C. Annunciator Panel: With visual and audible, high-tank-level and low-tank-level alarms; fuel indicator with registration in gallons; and overfill alarm. Include gauge volume range that covers fuel-oil storage capacity.
- D. Controls: Electrical, operating on 120V ac.

2.4 FUEL-OIL LEAK-DETECTION AND MONITORING SYSTEMS

- A. Fuel-Oil Leak Detection and Monitoring, Cable and Sensor System: Comply with UL 1238.
 - 1. Source Limitations: Obtain cable-and-sensor fuel-oil leak-detection and monitoring system from single manufacturer.
 - 2. Calibrated fuel-oil leak-detection and monitoring system with probes and other sensors and remote alarm panel for fuel-oil storage tanks and fuel-oil piping.
 - 3. Include fittings and devices required for testing.
 - 4. Controls: Electrical, operating on 120V ac.
- 2.5 FUEL OIL
 - A. Fuel Oil: ASTM D396, Grade No. 2.

2.6 SOURCE QUALITY CONTROL

- A. Pressure test and inspect fuel-oil storage tank, after fabrication and before shipment, in accordance with ASME and the following:
 - 1. Horizontal, Double-Wall Steel Aboveground Fuel-Oil Storage Tanks: UL 142, STI F921, and STI R931.
- B. Affix standards organization's code stamp.

PART 3 - EXECUTION

3.1 EXAMINATION

- A. Examine roughing-in for aboveground fuel-oil storage tanks to verify actual locations.
- B. Proceed with installation only after unsatisfactory conditions have been corrected.

3.2 EARTHWORK

A. Comply with requirements in Section 312000 "Earth Moving" for excavating, trenching, and backfilling.

3.3 INSTALLATION OF ABOVEGROUND FUEL-OIL STORAGE TANKS

- A. Install tank in accordance with NFPA 30 and 31 by a tank-manufacturer-trained and -certified contractor.
- B. Install tank supports.
- C. Concrete Bases: Anchor aboveground fuel oil storage tank to concrete base in accordance with equipment manufacturer's written instructions and in accordance with seismic codes at Project.
 - 1. Construct concrete bases of dimensions indicated, but not less than 4 inches larger in both directions than supported unit.
 - 2. Install dowel rods to connect concrete base to concrete floor. Unless otherwise indicated, install dowel rods on **18-inch** centers around the full perimeter of the base.
 - 3. Install epoxy-coated anchor bolts for supported equipment that extend through concrete base, and anchor into structural concrete floor.
 - 4. Place and secure anchorage devices. Use supported equipment manufacturer's setting drawings, templates, diagrams, instructions, and directions furnished with items to be embedded.
 - 5. Install anchor bolts to elevations required for proper attachment to supported equipment.
 - 6. Use 3000-psig, 28-day, compressive-strength concrete and reinforcement as specified in Section 033000 "Cast-in-Place Concrete."
- D. Connect piping and vent fittings.
- E. Install ground connections.
- F. Install tank leak-detection and monitoring devices.
- G. Install steel aboveground fuel-oil storage tanks in accordance with STI R912.
- H. Fill storage tanks with fuel oil.

3.4 INSTALLATION OF FUEL-OIL-LEVEL GAUGE SYSTEM

A. Install liquid-level gauge system. Install panel where indicated on Drawings.

3.5 INSTALLATION OF LEAK-DETECTION AND MONITORING SYSTEM

- A. Install leak-detection and monitoring system. Install alarm panel where indicated on Drawings.
 - 1. Double-Wall, Fuel-Oil Storage Tanks: Install probes in interstitial space.
 - 2. Double-Containment Fuel-Oil Piping: Install leak-detection sensor probes in fuel-oil storage tank containment sumps and at low points in piping; cable probes in interstitial space of double-containment piping.
 - 3. Install liquid-level gauge.

3.6 LABELING AND IDENTIFYING

A. Nameplates, pipe identification, and signs are specified in Section 230553 "Identification for HVAC Piping and Equipment."

3.7 FIELD QUALITY CONTROL

- A. Manufacturer's Field Service: Engage a factory-authorized service representative to test and inspect components, assemblies, and equipment installations, including connections.
- B. Perform the following tests and inspections with the assistance of a factory-authorized service representative:
 - 1. Tanks: Minimum hydrostatic or compressed-air test pressures for fuel-oil storage tanks that have not been factory tested and do not bear the ASME code stamp or a listing mark acceptable to authorities having jurisdiction:
 - a. Double-Wall Tanks:
 - 1) Inner Tanks: Minimum 3 psig and maximum 5 psig
 - 2) Interstitial Space: Minimum 3 psig and maximum 5 psig, or 5.3-in. Hg vacuum.
 - b. Where vertical height of fill and vent pipes is such that the static head imposed on the bottom of the tank is greater than 10 psig, hydrostatically test the tank and fill and vent pipes to a pressure equal to the static head thus imposed.
 - c. Maintain the test pressure for one hour.
- C. Aboveground fuel-oil storage tanks will be considered defective if they do not pass tests and inspections.
- D. Prepare test and inspection reports.

END OF SECTION 231323

221165.01

PART 1 GENERAL

1.1 RELATED DOCUMENTS

A. Drawings and general provisions of the Contract, including General and Supplementary Conditions and Division 01 Specification Sections, apply to this Section.

1.2 SUMMARY

- A. The Contractor shall provide the labor, materials, equipment, appliances, services and transportation, and perform operations in connection with the construction and installation of the Work. Work to be as herein specified and as denoted on the accompanying Drawings.
- B. This Section of the Work includes the providing the filtration unit and exhaust fan, including air cleaners, plenums, ductwork, flexible hose, source capture devices, and other related items necessary to bring the fumes generated by the welding process within the OSHA Air Quality Standards at the welder's breathing zone.
- C. Related Work by Others
 - 1. Motor starter, safety disconnect switch, and starting controls shall be by the unit manufacturer.
- D. Refer to the Details and Schedules on the Drawings for additional requirements.

1.3 ACTION SUBMITTALS

- A. The Contractor shall submit to the Design Engineer a copy of submittal data from the manufacturer which specifies unit parameters as follows:
 - 1. CFM
 - 2. Horsepower
 - 3. Blower type
 - 4. Static pressure
 - 5. Electrical requirements
 - 6. Outlet velocity
- B. Refer to Division 01 Section "Submittal Procedures" for submittal requirements.

1.4 QUALITY ASSURANCE

- A. Air cleaning equipment shall be manufactured by a bona fide manufacturer of the type of equipment specified. The manufacturer must be able to establish his credentials and the credentials of equipment to be sold by providing proof that said equipment is presently in use and performing successfully in similar applications.
- B. The manufacturer shall have a field service network to perform service and maintenance on the equipment. A factory representative shall perform field start-up of equipment.

1.5 WARRANTY

A. Warranty: The unit shall carry a 1 year parts and labor warranty following the date of Substantial Completion.

2.1 ACCEPTABLE MANUFACTURERS

- A. In other Part 2 articles where subparagraph titles below introduce lists, the following requirements apply for product selection:
 - 1. Basis-of-Design Manufacturers: Subject to compliance with requirements, provide either the product named or a comparable product by one of the other manufacturers specified.
 - 2. Available Manufacturers: Subject to compliance with requirements, manufacturers offering products that may be incorporated into the Work include, but are not limited to, the manufacturers specified.
 - 3. Manufacturers: Subject to compliance with requirements, provide products by the manufacturers specified.
- B. Products of other manufacturers will be considered for acceptance provided they equal or exceed the material requirements and functional qualities of the specified product. Requests for A/E's approval must be accompanied by the "Substitution Request Form" and complete technical data for evaluation. All materials for evaluation must be received by the Construction Manager. Construction Manager will then forward to A/E for approval.

2.2 DOWN FLOW CARTRIDGE COLLECTORS

- A. Basis-of-Design Collector: Donaldson-Torit. Subject to compliance with requirements, provide either the product named or a comparable product by one of the other manufacturers specified.
 - 1. American Air Filter Company, Inc.
 - 2. United Air Specialists
 - 3. Nederman
 - 4. AQC Dust
 - 5. Camfil APC
- B. The collector shall be a down flow cartridge filter collector designed for welding exhaust systems.
- C. Cabinet shall be constructed of heavy gauge steel with welded seams and shall be rated to -25" w.g.
- D. The cabinet shall be finished in a durable, multi-coat liquid or powder finish that meets ASTM B117 salt spray test of 2,000 hours. The exterior shall be finished in a custom color as selected by A/E. The interior of the unit shall be primed with a durable liquid or powder primer.
- E. The unit shall be provided with an air management module with multiple connections to an extended dirty air plenum. Airflow shall be directed into a dropout zone for reduced filter loading. Each dedicated duct connection shall be provided with an electronic or pneumatic actuated blast gate that shall be opened and closed based on the usage of the system as determined by the unit control panel. The blast gates shall be constructed of heavy duty aluminum or galvanized steel construction, and shall be rated for the design system pressure.
- F. The unit shall be equipped with a heavy gauge welded ledgeless hopper with single outlet. The unit shall be provided with a drum cover pack with slide gate and locking latches, including hose, clamps and 55 gallon drum cover to provide air-tight seal a the hopper discharge. The slide gate shall allow drum change without shutting down the system.
- G. The unit shall be supported by structural steel legs designed to meet IBC requirements for wind and snow loads. The unit shall be installed with 48" clearance below hopper outlet.

- H. The collector shall be provided with filters equal to Donaldson Torit Ultra-Web Flame Retardant cartridge filters complete with galvanized steel end caps and expanded metal inner and outer liners. Filters shall be replaceable without the use of tools. The filters shall be provided with compressed air pulse cleaning. The filter media shall be designed for pulse cleaning and shall have a minimum of MERV 15 with 0.3 micron, 0.2% 0.5% moisture absorption, a maximum operating temperature of 180 degrees F., and be flame retardant as specified in TAPPI T461.
- I. The clean air plenum shall be lined with minimum 3/4" silencing foam liner.

2.3 BACKWARD-INCLINED CENTRIFUGAL FAN

- A. Manufacturers: Subject to compliance with requirements, provide products by one of the following:
 - 1. Greenheck
 - 2. Loren Cook Company.
 - 3. Penn Ventilation
 - 4. Twin City Fan
 - 5. Nederman
 - 6. AQC Dust
- B. Description: Factory-fabricated, -assembled, -tested, and -finished, belt- or direct-driven centrifugal fans consisting of housing, wheel, fan shaft, bearings, motor, drive assembly, and support structure.
- C. Housings: Fan housings shall be heavy gauge, continuously welded construction.
 - 1. Panel Bracing: Steel angle- or channel-iron member supports for mounting and supporting fan scroll, wheel, motor, and accessories.
 - 2. Discharge flanges for rigidity and duct connection.
 - 3. Aerodynamically designed inlet or shrouds for stable flow and rigidity.
- D. Backward-Inclined Wheels: Single-width-single-inlet construction with curved inlet flange, back plate, backward-inclined blades fully welded to rim and backplate. Wheels shall be statically and dynamically balanced. The complete fan assembly shall be balanced at the design operating speed.
- E. Shafts: Statically and dynamically balanced and selected for continuous operation at maximum rated fan speed and motor horsepower, with final alignment and belt adjustment made after installation.
 - 1. Turned, ground, and polished hot-rolled steel with keyway. Ship with a protective coating of lubricating oil.
 - 2. Designed to operate at no more than 70 percent of first critical speed at top of fan's speed range.
- F. Grease-Lubricated Shaft Bearings: Heavy-Duty, anti-friction, self-aligning, pillow-block-type, ball bearings with adapter mount and two-piece, cast-iron housing.
 - 1. Ball-Bearing Rating Life: AFBMA L50 at 200,000 hours.
- G. Belt Drives: Factory mounted, with final alignment and belt adjustment made after installation. 1. Service Factor Based on Fan Motor Size: 1.5.
 - 2. Fan Pullevs: Cast iron: dynamically balanced at factory.
 - 3. Motor Pulleys: Cast iron, fixed pitch.
 - 4. Provide pulleys changes as required to obtain design airflow and static pressure.
 - 5. Belts: Oil resistant, nonsparking, and nonstatic; matched sets for multiple belt drives.
 - 6. Belt Guards: Fabricate to comply with OSHA and SMACNA requirements for outdoor installation, prime coated, and finish painted. Secure to fan or fan supports without short circuiting vibration isolation. Include provisions for adjustment of belt tension, lubrication, and use of tachometer with guard in place.
 - 7. Motor Mount: Adjustable for belt tensioning.

- H. Accessories:
 - 1. Access Door: Bolted, gasketed door allowing access to fan scroll, of same material as housing.
 - 2. Scroll Drain Connection: NPS 1 steel pipe coupling welded to low point of fan scroll complete with plug.
 - 3. Companion Flanges: Rolled flanges for duct connections of same material as housing.
 - 4. Shaft Seals: Airtight seals installed around shaft on drive side of single-width fans.
 - 5. Weather Cover: Enameled-steel sheet with ventilation slots, bolted to housing.
 - 6. Vibration Isolation: Minimum 1" deflection.
- I. Motors: Comply with requirements in Division 23 Section "Common Motor Requirements for HVAC Equipment."
 - 1. Enclosure Type: Totally enclosed, fan cooled.
- 2.4 ADJUSTABLE FUME COLLECTION ARM Type WA
 - A. Basis-of-Design Extraction Arm: Plymovent T-Flex/CW. Subject to compliance with requirements, provide either the product named or a comparable product by one of the other manufacturers specified.
 - 1. Lincoln Électric LTA 2.0-CW
 - 2. Nederman
 - 3. AQC Dust
 - B. Extraction arm designed to collect fumes at source with adjusted joints to be easily positioned at any point within the working area.
 - C. Counter-weighted, telescopic extraction arm. Extends from 5 feet to 8.2 feet, 360 degree swivel elbow, support flange, internal support, pre-set joints with wear discs, wire reinforced PVC hose, 8 inch diameter, rotating hood with inlet screen, handle for positioning hood, internal baffle for regulating airflow damper.
 - D. Maximum operating temperature 176 degrees F.
 - E. Hanging weight 60 pounds.
- 2.5 SLOTTED PLENUM HOOD Type WH
 - A. Basis-of-Design Slotted Plenum Hood: KEES Incorporated. Subject to compliance with requirements, provide either the product named or a comparable product by one of the other manufacturers specified.
 - 1. Monoxivent
 - B. Slotted plenum hood designed to collect fumes at source with hood that sits on the table top and exhausts air through slots prior to reaching the breathing zone.
 - C. Constructed of all welded 18 gauge galvanized steel. Size and dimensions as indicated on the drawings.
- 2.6 SPARK ARRESTORS
 - A. Basis-of-Design Spark Arrestor: Quality Air Management Quencher. Subject to compliance with requirements, additional manufacturers may be considered for acceptance if a Substitution Request Form is submitted as noted below.
 - B. The spark arrestors shall be static devices with no moving parts or electrical controls. The fixed overlapping curved blade assembly shall be designed to produce turbulent airflow and strip the oxygen away from and cool embers in the air stream.

- C. The spark arrestors shall be constructed of hot rolled steel and shall comply with SMACNA industrial duct construction standards.
- D. The spark arrestors shall not rely on the injection of water or chemicals.

2.7 SILENCERS

- A. Basis-of-Design Silencer: VAW VRDS. Subject to compliance with requirements, provide either the product named or a comparable product by one of the other manufacturers specified.
 - 1. Industrial Noise Control, Inc.
 - 2. McGill AirFlow LLC.
 - 3. Ruskin Company.
 - 4. Vibro-Acoustics.
 - 5. Price
 - 6. Nederman
- B. General Requirements:
 - 1. Factory fabricated industrial duty silencer.
 - 2. Fire-Performance Characteristics: Adhesives, sealants, packing materials, and accessory materials shall have flame-spread index not exceeding 25 and smoke-developed index not exceeding 50 when tested according to ASTM E 84.
- C. Shape:
 - 1. Rectangular fan discharge.
- D. Rectangular Silencer Outer Casing: Mild steel, primed and finished in manufacturers standard finish system for exterior application.
- E. Inner Casing and Baffles: ASTM A 653/A 653M, G90 galvanized sheet metal.
- F. Special Construction:
 - 1. Suitable for outdoor use.
 - 2. Maximum pressure drop: 0.5" w.c.
 - 3. Criteria Level: 75 dbA
 - 4. Criteria Position: Position 3
- G. Connection Sizes: Match fan discharge and connecting ductwork unless otherwise indicated.
- H. Principal Sound-Absorbing Mechanism:
 - 1. Controlled impedance membranes and broadly tuned resonators without absorptive media.
 - 2. Dissipative or film-lined type with fill material.
- I. Fill Material: Inert and vermin-proof fibrous material, packed under not less than 5 percent compression.
 - 1. Erosion Barrier: Polymer bag enclosing fill, and heat sealed before assembly.
 - 2. Lining: Fiberglass cloth.
- J. Fabricate silencers to form rigid units that will not pulsate, vibrate, rattle, or otherwise react to system pressure variations. Do not use mechanical fasteners for unit assemblies.
 - 1. Flange connections.
 - 2. Reinforcement: Cross or trapeze angles for rigid suspension.
- K. Accessories:
 - 1. Factory-installed end caps to prevent contamination during shipping.
- 2.8 CONTROL PANEL
 - A. Provide NEMA 12 control panel to house all operating controls for the fume collection system.

- 1. Main Disconnect
- 2. 460/3/60 incoming power
- 3. Variable Frequency Controller (VFC) for fan motor
- 4. Control voltage transformer
- 5. Microprocessor based controller
- 6. Circuit breakers/fuses
- 7. Individual zone start/stop
- 8. Individual zone status
- 9. Relays, solenoids, etc.
- 10. Velocity control
- 11. Filter differential pressure
- 12. Pulse cleaning

2.

- 13. Zone 1 and Zone 2 control damper status and control open/close with system Zone 1 and Zone 2 operation.
- B. The control panel shall provide for the system to operate with any of the following zones signally or in combination:
 - 1. Zone 1 (welding booths in Auto Lab Area)
 - a. Zone 1 control damper open/close.
 - Zone 2 (welding booths in Advanced MFG Innovation Lab)
 - a. Zone 2 control damper open/close.
 - 3. Zone 3 (welding booths in Auto Lab Area and Advanced MFG Innovation Lab)
 - a. Zone 1 control damper open/close.
 - b. Zone 2 control damper open/close.
- C. The following controls shall be door mounted:
 - 1. Zone 1 start/stop
 - 2. Zone 2 start/stop
 - 3. Zone 3 start/stop
 - 4. Fan run indicator
- D. Push-Button Stations, Pilot Lights, and Selector Switches: NEMA ICS 2, heavy-duty type.
- 2.9 ROUND SPIRAL DUCTWORK FOR MEDIUM AND HIGH VELOCITY FUME COLLECTION SYSTEMS SHALL BE AS FOLLOWS:
 - A. Round duct shall be manufactured of galvanized steel and complying with SMACNA requirements for the pressure class required by the system or by the following methods and gauges listed as a minimum.

DIAMETER	MINIMUM GAUGE	METHOD OF MANUFACTURE
3 through 14 inches	26 ga.	Spiral Lockseam
15 through 26 inches	24 ga.	Spiral Lockseam
27 through 36 inches	22 ga.	Spiral Lockseam

- B. The spiral duct shall have locked seams so made to eliminate any leakage under the pressure for which the system has been designed.
- C. Spiral duct shall be provided in 10 foot lengths for accurate fitting.
- 2.10 DUCT FITTINGS FOR ABOVE MENTIONED FUME COLLECTION SYSTEMS SHALL BE AS FOLLOWS:
 - A. Fittings and couplings shall be made of minimum 20 gauge galvanized steel, or as required by SMACNA for the pressure class required by the system.

- B. Fittings are to have continuous welds along all seams. All divided flow fittings (laterals) are to be manufactured as separate fittings, not as tap collars welded into spiral duct sections. Galvanized areas that have been damaged by welding shall be coated with corrosion resistant aluminum paint.
- C. 90 degree tees and 45 degree laterals (wyes) up to and including 12 inch diameter tap size shall have a radiused entrance into the tap, produced by machine or press forming. The entrance shall be free of weld build-up burrs or irregularities.
- D. Elbows in diameters 3 inches through 8 inches shall be two section stamped elbows. Other elbows shall be gored construction with seams continuous/welded. Elbows shall be fabricated to a centerline radius of 1.5 times the cross-section diameter. Elbows, not die-stamped, shall be fabricated according to the following schedule:

ELBOW ANGLE	NUMBER OF GORES
Less than 35 degrees	2
36 degrees through 71 degrees	3
Over 71 degrees	5

- E. Couplings for round high pressure duct pipe-to-pipe joints in diameters to 60 inches shall be by the use of sleeve couplings, reinforced by rolled beads.
- F. Pipe-to-fitting joints in diameters to 60 inches shall be slip-fit of projecting collar of the fitting into the pipe.
- G. Insertion length of sleeve coupling and fitting collar shall be 2 inches.

PART 3 EXECUTION

3.1 INSTALLATION

- A. Refer to Drawings for general location of the dust collector and extraction equipment. Proper clearances must be maintained for component access, electrical access, bottom working clearance, and air discharge against walls or other obstructions must be considered.
- B. The dust collector shall be installed on concrete pad of size and strength required by unit manufacturer. Refer to manufacturer's installation instructions.
- C. Fume extraction arms or slotted plenum hoods to be located as denoted on drawing plans. Secure mounting bracket for each unit to wall for extraction arms and from welding booth walls for slotted plenum hoods. Follow manufacturer's recommendations for installation.

3.2 DEMONSTRATION

A. Engage a factory-authorized service representative to train Owner's maintenance personnel to adjust, operate, and maintain centrifugal fans. Refer to Division 01 Section "Demonstration and Training."

END OF SECTION 23 80 61



PROJECT NAME	Carmel High School F	Carmel High School Performing Arts Additions and Renovations	is and Renovations								
PROJECT NO.	221165.01				DATE	3/8/2021					
271100 Communications Equipment Room Fittings (Items in bold are standard of quality and performance)	om Fittings (Items in bold are	e standard of quality and per	formance)								
Deckal/Cabinata											
	Panduit	Middle Atlantic		Hoffman	Hubbell	Leviton	Belden	B-Line	Lowell	Emerson (Liebert)	Siemon
24"W x 36"D x 7' H Cabinet	S6519B	WMRK 4536		PS1C2179B			XH2M451140000	V452436ACVXTNNSB	LGR-4436		V61B-0AB121-45
24"W × 42"D × 7" H Cabinet 24"W × 48"D × 7" H Cabinet	S6519B S6529B	WMRK 4542 WMRK 4548	GF-2A320-CB GF-2A520-CB	PS1S21611B PS1S21612B	H3N4242 H3N4248		XH3M451140000 XH4M451140000	V452442ACVXTNNSB V452448ACVXTNNSB		F8611 K8612	V61B-0AB121-45 V62B-0AB121-45
30"W x 36"D x 7'H Cabinets	S8512B SERIES	DRK19-44-36		PS1C2189B				V452936BCNSSNN1B &		1	V81A-2AB111-45
30"W x 42"D x 7'H Cabinets	S8512B SERIES	DRK19-44-42	GF-2B320-CB	PS1C21810B			XH7M451220100	V452942BCNSSNN1B &		F8811	V81Δ-24B111-45
					10111110			VVCMC45FB			
/ Cabinet Fans/Guards Free-Standing 4' Fouinment Cahinet		FAN-10/GUAKD-10		A6AXFNPG/AFLIR6LD	H3F1110		Included in above XHM	VIP188			/P-FAN
22"W x 25"D x 51" H Cabinet		ERK-2725					XMF282413022				
22"W x 25"D x 41" H Cabinet		ERK-2125		PS1C1278B			XMF212413012				
ZZ"W X Z5"D X 30" H Cabinet Cabinet Fans/Guards		EKK-1825 FAN/GLIARD					XMF192413012 Included in above XMF				
							cabinets				
Wall-Mount Hinged Sectional									000 0 mm		
35U spaces, 24"W 26"D x 68"H	S7229B	DWR-35-26PD	13495-772						LWR-2423		101 (V)404 24
24U Spaces, 24 W 20 U X 49 H 18H snares 24"// 26"D v 30"H	PZWMC18P	DWR-24-20FU	736	2423	HS/13626		X1MM-3624-GD-3				VC3-(X)101-24 VC3-(X)101-18
12U spaces, 24"W 26"D x 28"H	PZWMC12P	DWR-12-26PD	24	2425	HSQ2426		XWM-2424-GD-3	VLWM2425PB		202637G2	VC3-(X)101-12
Wall Mt Fan/Guards	PZCFK	DWR-FK26	12804-701 & 12805-701		HWKF120		XWM-9312-1600	VLWMFKB			VP-FAN
21U spaces, 24"W x 22"D x 44"H		DWR-21-22		425			XWM-4824-SD-3	VLWM4820PB			VC2-(X)101-24
16U spaces, 24"W x 22"D x 35"H	PZC12S	DWR-16-22	736	EWMW362425			XWM-3624-SD-3	VLWM3620PB			VC2-(X)101-18
100 spaces, 24"W X 22"U X 25"H Wall Mt Fan/Guards	PZCFK	DWR-10-22 DWR-FK22	11900-724 12804-701 & 12805-701	EWMVZ4Z4Z5			XVVIN-2424-SU-3 XVVIA-0312-1600	VL WMZ4 ZUPB			VVCZ-(X)101-12
Hinged Floor Cabinet		7711-1117					0001-7100-1414				
40U, Space, 24"W × 32"D × 90 3/4"H		SR-40-32	13496-772				N/A		LWBR-4032		
Hinged Floor Cabinet	070EV	SR-24-32	13496-772		100171000		N/A		LWBR-4032		
Millingeu Capitiet Faris/Guarus Wall Mit Ean/Guards	PZCEK		12804-701 12804-701								
Technology Equipment Rack			1200-1-01								
2-post Equipment Racks	R2P	RLA19-1245B	55053-703		HPW84RR19	NB191-BLU SERIES	BHRR194	SB556084XUFB	LRR-4515		RS1-07-S
4-post Adjustable Comm Racks	ER4P29	R4XX-XXXB	15218-703	E4DR19FM45U	SF841942T		XDR8419-3102836	SB838084DFB			RSQ1-07-S
4-post Adjustable Server Racks	R4PCN	WMRK-4236SVR	15214-703	E4DRS19FM45U	SF841942		XH2M421121220 w/ (1)	SB838086BFB			RSQ1-07C-S
Square Funched, 19 WX42 DX64 F		SEB 30.34	11701 710				MVINP 4040 40				CDU & /Acc - 42" hoidht
vvali ivounted swing kack Hardware Kit	CNWS1224-C	BFR-20-24 HP	11/91-/18 12639-001				XWR-4819-18 (2) 8915-0100				ыын-о (4ea = 4.2° neignt)
Low Profile Wall Cabinet		WRP-6		DBS242412G	RE4X		N/A				
Adjustable Vented Shelf	SRM19FM1	VDS		ESHVA19			N/A				V-SHV1-01-1U
Heavy Duty Adjustable Vented Shelf	SRM19X18A1	VSA-2744		P19VSH810B	CKTSD		N/A		VDS-2		V-SHV2-01-1U
Sliding Shelf		SS	12338-719	P19SHP68B/ P19SHP810B			9013-1924	SB742M19FB	RSD-116	535809G1	
Vertical Wire Mangement	WMPVHC45E	CK-45	13911-703	EC6D7	VS76H	4980L-VFR	BHVH006	SB86166DFB		10200078	VCM-6D
Horizontal Wire Mangement	NMF2	HCM-2		DCHD2	HM277C	0	9511-1902	SB87019D2FB			HCM-4-2U-D
Vertical Power Strips	CMRPSV20	PDT-20xxC-NS	12848-705	DP1N622420	PR20620		9BG1-201004			35351051	8BV01-AA20Z-K1A
Horizoniai Power Surps Licht Duty Rack Shalf	SRM19FM2	PD-915K			MCCCS19	L 102 I-120	9DF 1-10 1002 9012-1018	SR747S1015SFR	11S-114		SH-S10-01
Vented Light Duty Rack Shelf	SRM19CMV3	RC-3	11231-719		CKSSD		9011-1918	E2SHH4P1930FB	RMK3-14 SERIES		6H-S19V-01
Ground Strip	RGS134-1Y	BB-44-1	40172-001	DG72	HBBBVR76KT		N/A	SBVB72		_	VP-GRD
Ladder Tray 10" Cable Tray	MG42B140	CI vv cariae			HI CU612E		BI DC260, 12B	CD171110DED			
Waterfall Accessory	WGBTMWFBL	CLH-EDxx	12100-712		HLCD12		BLRRD100-12B	SB212912FB			
Rack Mounting Kit	WGSTRKTBL	MK-LA		LRRMPBLK12	HLMPK19		BLRTR595-9B	SB213312FB			
SdN										Emerson (Liebert)	
16001/0							Xtreme			GXT3-1500RT-120	
2000VA					SRT2200RMXLA		P90-2000			GXT3-2000RT-120 GXT3-3000RT-120	
3000VA		UPS-OL3000R	ED3000RM2U	SU3000TRXL2U	SRT3000RMXLA	OL3000RTXL2U	P90-3000				
External Battery										GXT3-48VBATT	
2000 VA		UPS-EBPR	EDBP48XL	2U	SURTA48RMXLBP	BP72V60ART2U				GXT3-72VBATT	
3000VA		103002830-0581	EUBP/2XL		SUK 1192KMXLBP3U	BP12VOUAR12U					

MANUFACTURERS MATERIAL LIST

The bidder is responsible to verify that all part numbers meet the specifications. The bidder shall notify the Architect of any specification or part number discrepancies prior to bid date PLEASE NOTE: Not all products are used, see plans and specifications for more information. 271100TM-1



												I
PROJECT NAME	Carmel City Schools Polytechnic	s Polytechnic										
PROJECT NO.	221165.01					DATE	8/29/2023					
271323 Communications Fiber Optical Backbone Cabling (Items in bold are standard of quality and performance)	al Backbone Cabling (Ite	ms in bold are standard of	f quality and performance)									
Fiber Optic Cable	Panduit	Corning	Belden	Mohawk	BerkTek	Hitachi	General	Superior	Hubbell	Siemon		
R etreed Multimode (50mm)	EODP706V	006T 88-31100-20	ENDOGED	EN DOVEDO	DDD006ER3010/E6	61868_6	BLOOG1 DNI L	AA006DG01	HEC D1006D4	ORB5D006D-T512A		
12 strand Multimode (50um)	FODPZ12Y	012788-33190-29	FI4D012P9	F4D012P9	PDP012FB3010/F5	61868-12	BI 0121 PNU	44012PG01	HFCD1012P4	9BB5P012G-T512A		
6 strand Singlemode	FSDP906Y	006E88-31131-29	FISD006P9	FISD006P9	PDP006AB0707	60029-6	AP0061PNU	4406K101	HFCD1006PS	9BB8P006D-E205A		
12 strand Singlemode	FSDP912Y	012E88-33131-29	FISD012P9	FISD012P9	PDP012AB0707	60029-12	AP0121PNU	44024KK01	HFCD1012PS	9BB8P012G-E205A		
Retrand Multimode (50mm)	FOPP706V	006T88-31190-A3	FIADORAG	FUDDRAG	PDPK006FR3010/F5	61807_6	RI OD61 PNI LII PA	1 4006P401	HECD15006P4	aRC5P006D-T512A		ſ
12 strand Multimode (50um)	FOPPZ12Y	012T88-33190-A3	F14D012A9	FI4D012A9	PDPK012FB3010/F5	61897-12	BL0121PNU-IL PA	L 4012P401	HFCD15012P4	9BC5P012G-T512A		
6 strand Singlemode	FSPP906Y	006E88-31131-A3	FISD006A9	FISD006A9	PDPK006AB0707	61955-6	AP0061PNU-ILPA	L4006K401	HFCD15006PS	9BC8P006D-E205A		
12 strand Singlemode	FSPP912Y	012E88-33131-A3	FISD012A9	FISD012A9	PDPK012AB0707	61955-12	AP0121PNU-ILPA	L4012KK1Q	HFCD15012PS	9BC8P012G-E205A		
Non-Plenum Outdoor												
6 strand Multimode (50um)	FOINZ06	006104-14790020	FS4L006NF	FS4L006NF	OPR006FB30100/F5	61900-6	BL0064M1A-D1	110062601		9PE5C006D-1501A		
12 strand Multimode (50um)	FOTNZ12	012TU4-T4790D20	FS4L012NF	FS4L012NF	OPR012FB3010/F5	61900-12	BL0124M1A-DT	11012PG01		9PE5C012G-T501A		
6 strand Singlemode	FSTN906	006EU4-T4701D20	FSSL006NF	FSSL006NF	OPR006AB0403	60720-6	HB0064M1A-DT	110063101		9PE8C006D-E205A		
12 strand Singlemode	FSTN912	012ZU4-T4F22D20	FSSL012NG	FSSL012NG	OPR012AB0403	60721-12	HB0124M1A-DT	110123101		9PE8P012G-E205A		
Plenum Rated Indoor/Outdoor												
6 strand Multimode (50um)	FOCPZ06Y	006TSP-T4190D20	FD4D006P9	FD4D006P9	LTP006FB3010/F5	62068-6	BL0061ANU.BK	W4006PG01	HFCD14006P4	9GD5P006D-T501A		
12 strand Multimode (50um)	FOCPZ12Y	012TSP-T4190D20	FD4D012P9	FD4D012P9	LTP012FB3010/F5	62068-12	BL0121ANU.BK	W4012PG01	HFCD14012P4	9GD5P012G-T501A		
6 strand Singlemode	FSCP906Y	006ESP-T4101D20	FDSD006P9	FDSD006P9	LTP006AB0403	61579-6	AP0061ANU.BK	W4006K101	HFCD14012PS	9GD8P006D-E201A		
12 strand Singlemode	FSCP912Y	012ESP-T4101D20	FDSD012P9	FDSD012P9	LTP012AB0403	61579-12	AP0124ANU.BK	W4012K101	HFCD14012PS	9GD8P012G-E201A		
Mising Boom	Donaluit	Cambra C	Doldos	e e e e e e e e e e e e e e e e e e e			linddau	Hollowmon Titon				
Fiber Ontic Wall Moured Enclosure		WCH-04P	lianiag			EWMED-040	ECW/ASP				OP-815SMEC-24D	Ortronics SMEC_24D
12 Port Fiher Ontic Patch Panel	ECE11	CCH-011	ECX-01U	FCP3-DWR		5R11IM-F03	FPR3SP				OR-615SMFC-1 X-12F	FC-I X-12P
24 Port Fiber Optic Patch Panel	FCE1U	CCH-01U	ECX-01U	FCP3-DWR		5R1UM-F03	FCR2U6SP				FC01U-C	1
36 Port Fiber Optic Patch Panel	FCE2U	CCH-02U	ECX-02U	RIC3-24-01 or RIC3-36-01		5R2UM-S06	FCR2U6SP				FC02U-C	
72 Port Fiber Optic Patch Panel	FCE4U	CCH-04U	ECX-04U	RIC3-72-(XX)		5R3UM-F12	FRC3U12SP				FC04U-C	
6 Duplex LC Coupling Pnl (MM)	FAP6WAQDLCZ	CCH-CP12-E4	FF3X06LD	RIC-F-LCQ12-01C		5F100-2QL	FSPLCDM6AQ				OR-OFP-LCD12LC	CD12LC
6 Duplex LC Coupling Pnl (SM)	FAP6WBUDLCZ	CCH-CP12-A9	FFSX06LD			5F100-2LL	FSPLCDS6xx			_	OR-OFP-LCD12AC	CD12AC
Multimode LC Connectors	FLCSMCXAQY	95-050-99-X	FT3LC900FS01 OR AX105202-S1			49991-LLC	FCLC900K50GM12				OR-205KAS9GA-501	S9GA-50T
Singlemode LC Connectors	FLCSSCBUY	95-200-99	FTSLC900FS01 OR AX105252-S1			49991-SLC	FCLC900KSM12				OR-205KAS9GA-09	S9GA-09
3M Duplex LC-LC Ptch Cbl (SM)	F92ERLNLNSNM003	040402G5120003M	FPSLDLD003M	FJ2-LCULCUL-03		UPDLC-S03	DFPCLCLCS3SM					
3M Duplex LC-LC Ptch Cbl (MM)	FZ2ERLNLNSNM003	050502Q5120003M	FP4LDLD003MR2XA	FJ2-LCLC5V-03AQ		5LDLC-M03	DFPCLCLCE3MM					
MURIMOGE LC PIGTAIS	FZ1BN1NNNSNM001	000301Q4190003F	F14LC900PS011MA	FP1B-LC5V-01AQ		5LPLC-MU3	FPLCE3MM					
Singlemode LC Pigtails		000201G4131003F	FTSLC900PS013MW	FP1B-LCUL-01		UPPLC-S03	FPLCS3SM					
Innerduct	EASTERN	IPEX	Carlon	Endot								
1 [*] Indoor Plenum Coorigated	PDPU1000F1000R	KPPW100TR	A5D2S1JNNB1000	PR100XX177								
1" Outdoor Ribbed	PDVN1000		A5B4N1JNNBX	IDU 131								

The bidder is responsible to verify that all part numbers meet the specifications. The bidder shall notify the Architect of any specification or part number discrepancies prior to bid date. PLEASE NOTE: Not all products are used, see plans and specifications for more information.

27 13 23TM

MANUFACTURERS MATERIAL LIST



221165.0 ons Copper Horizon										
271515 Communications Copper Horizont	Ŧ				DATE	8/29/2023				
Cable F	ntal Cabling, Category	6 (Items in bold are standard	l of quality and performance)							
	Panduit	BerkTek	Mohawk	General	Superior	Belden	Hitachi	Hubbell	Siemon	
Cat. 6-4 pair Plenum PUP6004xx-		10032094	M57193	7131900		3613	30025-8	C6RPB	9C6P4-E3-06-RXA	
Cat 6 - 4 Pair OSP PUO6C04xx-U		10139885	M57562	7136100	04-001-58	OSP6U	30180-8		9C6O4-E1	
Connectors	Panduit		Siemon	Hubbell	Leviton	Belden				
RJ45 Jacks NK688Mxx			MX6-F(XX)	(XX)9CXH	61110-RW5	RV6MJKUEW-S1 OR AX101320	11320			
Bezel NKHF2Mxx-X	X-X			IM2K1XX	41291-2Q*	AX102737				
Single Gang Faceplates CBEXXY			MX-FP-S-(XX)-(YY)	IMF1xx	N	AX101747				
Double Gang Faceplates CBExx-2GY	λ		МХ-FP-D-(XX)-(YY)	IMF2xx	41290-DMW	AX101871				
Stainless Steel Faceplate NKF4S			MX-FP-S-04-SS-L	IMSS1 & IMSS2	43080-2S*	AX104234				
Weather proof cover plate				TWPF1GY		AX104687				
Surface Box NK2BXxx-A	A		MX-SM2-(XX)	ISB2-xx	41089-1×P	AX102652				
Telephone Faceplate KWPY			MX-WP-(XX)-SS	SP6R	40223-S	AX104126				
Duplex Outlet Froame (106) NK4106MFxx	XX.		()	Q106*	41087-Q*P	AX104124				
Blank Insert NKBMxx-X			MX-BL-(XX)	SFBx10	41084-Bx	AX101759				
Wiring Rooms						AX102261				
	Panduit		Siemon	Hubbell	Leviton	Belden				
12 Port Mod. Patch Panels NKFP12W				UDX1289	49255-Q89 + 40089-00D	N/A				
24 Port Mod. Patch Panels NKPP24FMY	١٢			UDX24E	49255-H24	AX103114				
48 Port Mod. Patch Panels NKPP48FMY	1 Υ		MX-PNL-48	UDX48E	49255-H48	AX103115				
12 Port Punchdown Patch Panels NK6PPG12WY	AWY		HD6-89D-12	HP612LI	69586-1112					
Dunchdown Dotoh			HD6 24	0 - 0 -		A V1000E0				
24 Fort Funchdown Patch NK6PP24P Panels			HD6-24	HP6E24	69586-U24	AX103253				
48 Port Punchdown Patch NK6PP48P			HD6-48		69586-U48	AX103255				
				HP6E48						
	Panduit		Siemon	Hubbell	eviton	Belden				
3' RJ-45 Patch Cables NK6PC3Y			MC6-03-(XX)	HC6xx03	62460-03*	C601106003				
5' RJ-45 Patch Cables NK6PC5Y			MC6-05-(XX)	HC6xx05	62460-05*	C601106005				
7' RJ-45 Patch Cables NK6PC7Y			MC6-07-(XX)	HC6xx07	62460-07*	C601106007				
9' RJ-45 Patch Cables NK6PC9Y			MC6-09-(XX)	HC6xx10	62460-10*	C601106009				
15' RJ-45 Patch Cables NK6PC15Y			MC6-15-(XX)	HC6xx15	62460-15*	C601106015				
	Circa		Marconni	Cvlix	Emerson					
Cat 6 Protector 4B1FS			R4C1S	CAT 6-PPC	R4C1S					

The bidder is responsible to verify that all part numbers meet the specifications. The bidder shall PLEASE NOTE: Not all products are used, see plans and specifications for more information.

MANUFACTURERS MATERIAL LIST

SECTION 27 15 17 - COMMUNICATIONS COPPER HORIZONTAL CABLING (Augmented Category 6 Cable)

PART 1 - GENERAL

1.1 RELATED DOCUMENTS

A. Drawings and general provisions of the Contract, including General and Supplementary Conditions and other Division 01 Specification Sections, apply to this Section.

1.2 SUMMARY

- A. Section includes, but is not limited to the following:
 - 1. Local area network
 - 2. Horizontal cabling
 - 3. Patch panels compatible with the structured cabling system
 - 4. Patch cords compatible with the structured cabling system
 - 5. Modular jacks
 - 6. Termination of all horizontal cabling
 - 7. Testing of all horizontal cabling
- B. Related section includes the following:
 - 1. Division 01 All Sections
 - 2. Division 26 Electrical
 - 3. Division 27 Communications Sections

1.3 DESCRIPTION OF WORK

- A. Provide labor, material, equipment, terminations, and accessories necessary for a complete and operational communications copper horizontal cabling system as indicated on the Drawings and specified herein. The contractor shall furnish the equipment, accessories and necessary material as described herein.
- B. All Wireless Access Point locations will receive two (2) white plenum Cat6A cables per device. All other data, camera, access and any other locations will receive Cat6 with the quantity marked on the print with colors indicated below.

	TELECOMMUN	ICATIONS	COLOR LEGEND	
SYSTEM	TERMINATION (RJ45)	CABLE	PATCH CABLE (PATCH PANEL)	PATCH CABLE (STATION)
DATA	BLUE	BLUE	BLUE	BLACK
WIRELESS	WHITE	WHITE	WHITE	WHITE
CAMERA	PURPLE	PURPLE	PURPLE	PURPLE
ACCESS	YELLOW	YELLOW	YELLOW	YELLOW
HVAC	RED	RED	RED	RED

- C. Provide communications copper horizontal cabling from each communication jack to each TR/MC/ER as described here and as shown on the drawings.
- D. The maximum allowable horizontal cable length is 295 feet. This maximum allowable length does not include an allowance for the length of 16 feet to the workstation equipment or in the horizontal cross-connect.
- E. The modular computer/data eight-position jack shall match the color scheme of EIA-568 B as follows:

- 1. Pair 1: Pin 4 Blue; Pin 5 White-Blue
- 2. Pair 2: Pin 1 White-Orange; Pin 2 Orange
- 3. Pair 3: Pin 3 White-Green; Pin 6 Green
- 4. Pair 4: Pin 7 White-Brown; Pin 8 Brown
- F. Contractor shall coordinate the extension of the electrical service from the electrical junction box located in the room to each communications cabinets/rack with the Site Electrical Contractor.

1.4 QUALITY ASSURANCE

- A. Communications cabling system components and equipment shall be listed by Underwriters Laboratories, Inc. for Computer use, and the components shall bear the UL label.
- B. The system shall be installed in accordance with requirements set by ANSI/NFPA-70 National Electric Code.
- C. All equipment shall comply with the latest ANSI-J-STD-607 grounding and bonding standards.
- D. All equipment and installation practices shall comply with latest BICSI (TDMM) standards.
- E. All equipment shall comply with the latest ANSI/TIA/EIA-568, 569, 60, 607, and 862 standards, as applicable.
- F. Cables shall be installed in accordance with ANSI/EIA/TIA and BISCI standards.
- G. Provide labeling per ANSI/EIA/TIA-606 requirement and in accordance with the Owner and the Technology Consultant.
- H. All cabling shall be tested in accordance with the ANSI/TIA/EIA-568-B2 standards with the required testing equipment.
- I. See section "Common Work Results for Communications".

1.5 CERTIFICATION

- A. Cabling Contractor shall provide the services of a component manufacturer and provide equipment listed by Underwriters Laboratories, Inc. The Contractor shall issue a equipment certification stating that the equipment and connected wiring and devices which form the specified system, together with installation have a 20-year Application Assurance and 20-year Extended Product Warranty on Registered Installation, and are in compliance with the requirements established by TIA/EIA 568, 569, and BICSI Standards. Also this Contractor shall submit with his/her bid a letter from the manufacturer indicating that his/her installation will be certified for a 20-year Application Assurance and 20-year Extended Product Warranty on Registered System Installation.
 - 1. See Manufacturer Material List for approved manufacturers with part numbers.

1.6 SUBMITTALS / RECORD DRAWINGS / MAINTENANCE MANUALS

- A. Shop Drawings
 - 1. Provide complete and comprehensive shop drawings with labeling to the Architect/Engineer for approval.
 - 2. Drawings shall be provided in AutoCAD Release 2002 format or higher.
- B. See front end submittals section for more information.
- C. See Common Work Results For Communications section 270500 for more submittal requirements.

- D. Provide record drawings and maintenance manual, per section "Operation and Maintenance of Communications Systems".
- E. Contractor shall include the following with their submittal:
 - 1. Manufacturer's Certificate stating each testing device used on the project and shall contain the most current revision of software.
 - 2. Manufacturer's Certificate stating that each testing device used on the project has been calibrated within the last 12 months.

1.7 WARRANTY

A. Components, parts, and assemblies supplied by the Communications Contractor/manufacturer shall be guaranteed against defects in materials and workmanship for a period as specified in section – Demonstration, Training, and Warranty of Communications Systems, commencing upon system start-up. Warranty services shall be provided by an installer certified by the equipment manufacturer during normal working hours. The manufacturer's statement of warranty shall be included in the submittals.

1.8 CHANNEL WARRANTY FOR HORIZONTAL CABLING SYSTEM

- A. The channel ACR performance warranty: 19 dB at 100 MHz.
- B. The link ACR performance warranty: 22 dB at 100 MHz.
- C. Application systems supports: 10 Gig at 500 MHz.

1.9 TRAINING

A. Provide training as specified in the section titled "Demonstration, Training, and Warranty of Communications Systems.

PART 2 - PRODUCTS

2.1 VOICE AND DATA CABLE AND COMPONENT PRODUCTS

- A. Contractors must provide a system where the component and cable manufacture have formed a partnership to create a complete channel solution. This solution shall be warranted by the component manufacturer.
- B. See Manufacturers List Section 27 15 17TM for approved manufacturers and part numbers.

2.2 VOICE AND DATA JACKS

- A. Provide a flush mounted modular data jack RJ-45 to fit in a one or two gang 3-1/2 inch deep box and/or to fit in the surface mounted raceway or floor boxes as shown on the Drawings and as specified herein.
- B. Data jacks shall be 8-position configurations and shall meet all the transmission performance of the specified cable.
- C. The data jacks shall be UL listed and must meet TIA/EIA 568B.2-AD10 requirements.
- D. The data jacks to be wired to TIA/EIA 568B .2-AD10 color scheme.
- E. Modular data jacks shall be mounted in modular wall plates for one, two, three, four, five, and/or six modular opening.
- F. See Manufacturers List Section 27 15 17TM for approved manufacturers and part numbers.

2.3 MODULAR COVER PLATES (TWO GANG)

- A. Provide decorative modular cover plates with number of modular data jack as shown on the drawing and (minimum one each) as specified in this section.
- B. Provide modular mounting frames for all jacks in the exposed surface raceway only (Panduit CFG4 Series).
- C. Provide floor cover plate to match receptacle cover plates (verify with site electrical contractor).
- D. Wall jacks shall be mounted on a stainless steel plate (Panduit KWP6P or equal).
- E. Cover plate shall be adjustable either in field or by factory (1/4 inch minimum).
- F. Provide blanks for wall and floor boxes.
- G. Cover plate:
 - 1. See Manufacturers List Section 27 15 17TM for approved manufacturers and part numbers.
- H. Wall adapter:
 - 1. See Manufacturers List Section 27 15 17TM for approved manufacturers and part numbers.
- I. Surface boxes:
 - 1. See Manufacturers List Section 27 15 17TM for approved manufacturers and part numbers.
- 2.4 STAINLESS STEEL COVER PLATES
 - A. Provide stainless steel cover plates to fit the modular jacks as shown on the Drawings.
 - B. Stainless steel cover plate shall be double gang.
 - C. Provide stainless steel cover plates in all areas.
 - D. See Manufacturers List Section 27 15 17TM for approved manufacturers and part numbers.

2.5 COPPER PATCH PANELS

- A. Provide 24 port RJ45 patch panels for termination of all UTP cable with 24-RJ45 jacks.
- B. Provide 48 port RJ45 patch panels for termination of all UTP cables with front and back cable management with 48-RJ45 jacks.
- C. Patch panels shall meet or exceed all transmission performance for augmented category 6 as outlined in TIA/EIA-568B.2-10.
- D. Each RJ45 jacks shall be terminated with 4 pair of UTP wire and shall be wired to meet TIA/EIA 568B color scheme.
- E. Provide three (3) extra wire management for data switches in each rack/cabinet.
- F. See Manufacturers List Section 27 15 17TM for approved manufacturers and part numbers.
- 2.6 PATCH CORDS
 - A. Provide patch cords with modular RJ45 at each end. UL listed, 3 foot (1m), 5 foot (1.5m), 7 foot (2.1m), 10 foot (3m), and 15 foot (4.6m) long.

221165.01

- B. Patch cord manufacturer must match connector/patch panel manufacturer.
- C. See Manufacturers List Section 27 15 17TM for approved manufacturers and part numbers.
- D. Patch cable quantity
 - 1. Furnish one blue patch cord for each data jack (within patch panel) with 20% spare; provide 50% three (3) foot patch cables, 50% five (5) foot patch cables.
 - 2. Furnish one green patch cord for each wireless access point jack (within patch panel) with 20% spare cables; provide 50% three (3) foot patch cables, 50% five (5) foot patch cables.
 - 3. Provide one fifteen (15) foot green station patch cable at the Wireless Access point location plus 20% spare.

2.7 COMPUTER/DATA CABLE (AUGMENTED CATEGORY 6)

- A. The computer/data cable shall be four unshielded twisted pair (UTP), 23 AWG, solid bare copper.
- B. The insulated conductors shall be twisted in pairs and shall be insulated with FEP material, and all 4 insulated pairs shall be laid into an insulated plastic jacket.
- C. UL listed CMP with transmission characteristics that meet or exceed those of FCC-68/ TIA /EIT, 568A-5 and TIA /EIT TSB-95 performance and NEMA low loss, extended frequency, jacket shall be sequentially marked at 2 foot intervals and must be plenum rated. UL listed 1459 and 1863.
- D. Pair twisting shall be maintained to meet the cable performance, but maximum cable, untwisting allows is one half (1/2) inch.
- E. Cable shall meet ANSI/TIA/EIA-658-B2-AD10 transmission performance specifications for 4 pair UTP augmented category 6 cabling.
- F. Design bandwidth 500 MHZ, cable bandwidth 500+ MHZ, standard data rate 10 Gig.

G.	Color Code =	Pair #1 - White/Blue and Blue
		Pair #2 - White/Orange and Orange
		Pair #3 - White/Green and Green
		Pair #4 - White/Brown and Brown

H. Cable Electrical Specifications

- 1. Maximum operating voltage:
- 2. Nominal capacitance at 1 Khz:
- 3. Nominal velocity of propagation: 72 percent plenum
- 4. Nominal capacitance unbalance:
- 5. Maximum capacitance unbalance: PF/100M 66.00 PF/M
- I. See Manufacturers List Section 27 15 17TM for approved manufacturers and part numbers.

2.8 WIRELESS ACCESS POINTS LOCATIONS

- A. Cable Connection
 - 1. Provide two ports UL listed surface mount box to terminate the RJ45 jack and cable.
 - a. See Manufacturers List Section 27 15 17TM for approved manufacturers and part numbers.

300V RMS

15 PF/FT

PF/100M - 25.00 PF/M

- 2. Provide 5 foot patch cord and/or as required.
- 3. Patch the wireless access point to the data jack in the box above the ceiling.
- 4. Provide one 4 inch square box with cover plate as shown for CEILING mounted devices.
- 5. Mount the biscuit in a 4 square junction box with cover plate and mounting hardware to attach to the ceiling grid, box to be mounted with face up.

PART 3 - EXECUTION

3.1 INSTALLATION

- A. Provide communications copper horizontal cabling, connectors, jacks, cover plate, blank inserts, patch panels, cords, etc., as specified here and as shown on the drawings.
- B. Cabling at patch panels shall be terminated in numerical order, so as to provide a logical pattern that will provide the end user the greatest ease in the system administration.
- C. See labeling details for more information.
- 3.2 UNSHIELDED TWISTED PAIR CABLE (UTP)
 - A. Provide the following additional UTP runs:
 - 1. Provide one (1) 4-pair UTP to the telephone headend equipment and also to the telephone back-up power supply in same room.
 - 2. Provide two (2) 4-pair UTP to each file server from MC/ER.
 - 3. Provide 20 additional 4-pair UTP cables, jacks, labeling, testing, etc (180 feet each) to the nearest telecommunications rooms. (Install as directed by the Architect/Engineer.)
 - B. Maximum pulling force shall be as recommended by the manufacturers and the maximum bending radius shall be (10) times the cable diameter.
 - C. Outdoor computer/data cable shall be used in all floor box locations where concrete is slab on grade.
 - D. Terminate the data jacks per the manufacturer's recommendations and ensure the termination bar is positioned as close as possible to the cable jacket edge.

3.3 CABLE PULLING

- A. Cable rollers shall be used when pulling cable. Cable pulleys must be used when pulling cable around bends and corners of wireways. Pulleys shall have a minimum diameter of 6 inches.
- B. Contractor shall use basket grips wherever possible and exercise care while pulling cable as not to exceed the maximum allowable pulling tension of the cable.
- C. Cable rollers used for pulling cable in cable tray shall be mounted close to wireway supports and shall be placed at the beginning of the run and spaced every 25 feet along the run.
- D. Provide 3 foot service loop at each jack.
- E. Provide 25 foot service loop in each TR and MC/ER.
- F. Support service loop above ceiling properly.
- 3.4 LABELING AND MARKING
 - A. See Drawings for Technology Schedules for more information.
 - B. Contractor shall install labels as follows:
 - 1. One label at each end of each cable at the end of the cable sheath, after stripping.
 - 2. One label on the outside of each face plate in the space provided.
 - 3. Label as shown on drawings.
 - 4. All markings shall be carefully done so as to present a neat, professional appearance.
 - 5. Cross connect color coded shall be as follows:
 - a. Green circuits from the central office/RBOC/Telco
 - b. Purple circuits from the switch ports

- c. Yellow circuits from the auxiliary cabinet
- d. Blue wiring from the work station information outlets
- e. White house pairs from riser cable between the equipment room and satellite closets.
- f. Orange wiring originating from electronic equipment
- g. Grey Tie cables between satellite closets.

3.5 CABLE SEPARATION FROM POWER WIRING

- A. Between the cabling system and any fluorescent, neon, incandescent, or high intensity discharge lamp fixtures, the minimum distance shall be 5 inches.
- B. Cable may be installed closer to lighting and convenience outlet power cable (single phase, 120V, 20A maximum), in metal cable channels for limited distances if the following guidelines are observed:
 - 1. Coincident (parallel) runs of no more than 15 feet are permissible if a 1 inch separation between the power cable and the cabling system cable is maintained by separators or suitable retention hardware. If necessary, the separation may be less than 1 inch for a run of up to 6 inches if no contact between the cabling system cable and the power cable occur.
 - 2. Coincident runs of no more than 30 feet are permissible if a 2 inch separation is maintained. The separation may be less than 2 inches for a run of up to 12 inches, if no contact occurs between the cabling system cable and the power cable.

Wire Pair	Color	8-Position T568A	8-Position T568B
1 Tip	White - Blue	5	5
1 Ring	Blue	4	4
2 Tip	White - Orange	3	1
2 Ring	Orange	6	2
3 Тір	White - Green	1	3
3 Ring	Green	2	6
4 Tip	White - Brown	7	7
4 Ring	Brown	8	8

3.6 WIRING COLOR SCHEME

3.7 TESTING

- A. The Cabling Contractor shall be responsible for testing each horizontal cable run, patch panel, and patch cables to verify the performance of the channel warranty for the horizontal cabling system as defined in TIA/EIA TSB-67.
- B. The contractor shall configure the tester for the cable and connectors used in the installation.
- C. The contractor shall calibrate the tested to the newest software.
- D. The contractor shall use the same tester(s) from the same manufacturer for the entire project(s).
- E. All test reports shall look the same and all test reports shall be done with the same manufacture tester to assure all test results have the same appearance.

- F. The contractor shall turn in all tests, partial or quick tests shall NOT be accepted, all test results shall be in an electronic format and shall be accessible with a cable test management software available free from the tester manufacture when submitted with the close out documents.
- G. System and Wiring Testing, Checking, and Reports:
 - 1. Cabling Contractor shall provide necessary technical personnel and testing instruments as required to perform complete testing of all systems installed by Contractor and coordinate this testing activity with the Architect/Engineer and Owner's representative.
 - 2. All wiring, terminations, equipment, etc. shall be checked and tested by qualified field representative or equipment vendor. A report shall be submitted to Architect/Engineer and Commissioning Agent by vendor representative and/or Contractor indicating results of such final check-out and testing processes. Final payment will not be approved until such report is submitted and any "failure" results are corrected.
 - 3. Cabling Contractor shall conduct such other tests and make necessary adjustments of equipment and installation infrastructure required by Architect/Engineer and/or Commissioning Agent, as requested or necessary to verify performance requirements. Submit all data gathering information taken during such tests to Architect/Engineer and Commissioning Agent.
 - 4. Cabling Contractor must input the specified cable parameters, manufacturers' name and number in the tester. (Test results will not be accepted with generic cable type.)
 - 5. Reporting to be done in compliance with standards and schedules published by authority and agencies defined in the Specifications.
- H. Cable test results shall be stored and presented to the architect/engineers in an electronic format for approval, and cable tester records designations shall match the associated cable labels and associated patch panel label designations.
- I. Submit one complete cable test results in electronic format and 1 complete set of paper format in a 3-ring binder.
- 3.8 MAIN CROSS CONNECT/EQUIPMENT ROOM
 - A. See section "Communications Equipment Room Fittings" for more information.
 - B. The cables shall be terminated on RJ45 copper patch panels with modular inserts for jacks.

END OF SECTION 27 15 17



PROJECT NAME	0								
PROJECT NO.	0.00			DATE	June 2019				
271553 Miscellanous Communicaitons Audio/Video Cabling (Items in bold are standard of quality and per	aitons Audio/Video Cabi	ling (Items in bold are s	tandard of quality and per	formance)					
Cable	Belden	BerkTek	Mohawk	General	West Penn	West Penn			
RG-6	633938		M71002	C3524	25841	25841			
RS-232/RS-485 Cable	82504								
Power Cables									
3/C #16 Unshielded plenum	6201UE			E3043S	AQ246	AQ246			
3/C #16 Unshielded Outdoor	5201UE			E1043S	AQ3245	AQ3245			
Connectors	Panduit	Ortronics	Siemon	Hubbell	Leviton	Belden	Belden	HellermannTyton	
					40000-D(X) T		AA103333-EW		
Red RCA Inserts	NKRPMRxx	OR-KSRCAR	MX-F-RC-(xx)		40830-B(x)R	AX100999 (1RED,1BLK) AX105337-EW) AX105337-EW		
White RCA Inserts	NKRPMWxx	OR-KSRCAW	MX-F-RC-(xx)	SFRCW110	40830-B(x)E		AX105338-EW		
F-Connector Inserts	NKFXX	OR-KSFCN	MX-F-FA-(xx)		41084-F(x)F	AX100995	AX102904		
Blank Insert	NKBMxx-X	OR-KSB10-XX	MX-BL-(xx)		41084-Bx		AX102262		
3.5mm Insert	NK35MSSxx	OR-KS35STST		SF35SJ(xx)	40839-SWS		AX105335-EW		
VGA Inserts	CMD15HDCxxY		MX-D4F-15-(xx)	N	41295-HDW (MOS)	AC300285	AX101887		
HDMI Inserts	NKHDMIxx	OR-KSHDMI	MX-HD-(xx)	SFHC14(xx)	40834-W		AX105345-EW		
Angled Bezel Insert	NKHS2xx-X			IM2KA15(xx)	41294-2Q(x) (MOS)				
USB Insert	NKUSBAAxx	OR-KSUSB		SFUSBAA(xx)	40835-W		AX105342-EW		
Shielded Cabling and Connectors	Panduit	Mohawk	Belden	General	Hubbell	Leviton	Siemon		
Category 5E Shielded Cable	PFP5504RD-UY	M57364	1213F	2131774E			9A5P4-E1-03-R1A		
Category 6 Shielded Cable	PFP6X04RD-UG	M58181	2413F	6131790	C6FTSPB		9A6P4-A5-03-R1A		
Category 5E RJ45 Shielded Jack	CJS5E88TGY		AX104595		SJ5E2A	5ESJK-xx5	Z5-S04		
Category 6 RJ45 Shielded Jack	CJS688TGY		AX104596		SJ6	61SJK-xx6	Z6A-S04		
VGA Cables		TecNec	Covid	Liberty					
Plenum VGA Cable Assem.		P/D15HDM-F-x	CVD-3917-xx-IST	G-VGAM-F-xx					

The bidder is responsible to verify that all part numbers meet the specifications. The bidder shall notify the Architect of any specification or part number discrepancies prior to bid date.
PLEASE NOTE: Not all products are used, see plans and specifications for more information.
* Per the manufacturers recommendations.
* Coordinate color with owner.

MANUFACTURERS MATERIAL LIST

SECTION 33 41 00 - STORM UTILITY DRAINAGE PIPING

PART 1 - GENERAL

1.1 DESCRIPTION OF WORK

- A. Section Includes:
 - 1. Pipe and fittings.
 - 2. Cleanouts.
 - 3. Manholes.
 - 4. Catch basins.
 - 5. Storm water inlets.
 - 6. Pipe outlets.
 - 7. Water quality structures.
 - 8. Trench Drains

1.2 RELATED DOCUMENTS

- A. Drawings and general provisions of the Contract, including General and Supplementary Conditions and Division 01 Specification Sections, apply to this Section.
- B. Related Specification Sections
 - 1. Earth Moving Specification Section 33 20 00.
 - 2. Subdrainage Specification Section 33 46 00.

1.3 SUBMITTALS

- A. Submittal procedures and requirements shall comply with Division 01 Specification Sections.
- B. Product Data: For each type of product indicated.
- C. Shop Drawings:
 - 1. Manholes: Include plans, elevations, sections, details, frames, and covers.
 - 2. Catch Basins and Inlets: Include plans, elevations, sections, details, frames, covers and grates.
 - 3. Water quality structures: Include plans, elevations, sections, details, frames, and covers.

1.4 INFORMATIONAL SUBMITTALS

- A. Coordination Drawings: Show pipe sizes, locations, and elevations. Show other piping in same trench and clearances from storm drainage system piping. Indicate interface and spatial relationship between manholes, piping, and proximate structures.
- B. Field quality-control reports.

1.5 PROJECT CONDITIONS

- A. Interruption of Existing Storm Drainage Service: Do not interrupt service to facilities occupied by Owner or others unless permitted under the following conditions and then only after arranging to provide temporary service according to requirements indicated:
 - 1. Notify Owner no fewer than two days in advance of proposed interruption of service.
 - 2. Do not proceed with interruption of service without Owner's written permission.

PART 2 - PRODUCTS

- 2.1 CONCRETE PIPE AND FITTINGS
 - A. Reinforced-Concrete Sewer Pipe and Fittings: ASTM C 76.
 - 1. Bell-and-spigot ends and gasketed joints with ASTM C 443, rubber gaskets
 - 2. Class III, Wall type B.

2.2 HDPE PIPE AND FITTINGS

- A. Corrugated Polyethylene (PE) Pipe and Fittings NPS12 to NPS60: AASHTO M294M, Type S, with smooth waterway for coupling joints.
 - 1. Silt-tight Couplings: PE sleeve with ASTM D 1056, Type 2, Class A, Grade 2 gasket material that mates with pipe and fittings.
 - 2. Soil-tight Couplings: AASHTO M294M, corrugated, matching pipe and fittings.

2.3 PVC PIPE AND FITTINGS

- A. PVC Type PSM Sewer Piping:
 - 1. Pipe: ASTM D 3034, SDR 26, PVC Type PSM sewer pipe with bell-and-spigot ends for gasketed joints.
 - 2. Fittings: ASTM D 3034, PVC with bell ends.
 - 3. Gaskets: ASTM F 477, elastomeric seals.

2.4 NONPRESSURE TRANSITION COUPLINGS

- A. Comply with ASTM C 1173, elastomeric, sleeve-type, reducing or transition coupling, for joining underground non-pressure piping. Include ends of same sizes as piping to be joined, and corrosion-resistant-metal tension band and tightening mechanism on each end.
- B. Sleeve Materials:
 - 1. For Plastic Pipes: ASTM F 477, elastomeric seal or ASTM D 5926, PVC.
 - 2. For Dissimilar Pipes: ASTM D 5926, PVC or other material compatible with pipe materials being joined.
- C. Unshielded, Flexible Couplings:
 - 1. Manufacturers: Subject to compliance with requirements, available manufacturers offering products that may be incorporated into the Work include, but are not limited to, the following:
 - a. Fernco Inc.
 - b. NDS Inc.
 - c. Plastic Oddities; a division of Diverse Corporate Technologies, Inc.
 - 2. Description: Elastomeric sleeve with stainless-steel shear ring and corrosion-resistantmetal tension band and tightening mechanism on each end.

2.5 CLEANOUTS

- A. Cast-Iron Cleanouts:
 - 1. Description: ASME A112.36.2M, round, gray-iron housing with clamping device and round, secured, scoriated, gray-iron cover. Include gray-iron ferrule with inside calk or spigot connection and countersunk, tapered-thread, brass closure plug.
 - 2. Top-Loading Classification(s): Medium Duty (non-paved areas) or Heavy Duty (paved areas).
 - 3. Sewer Pipe Fitting and Riser to Cleanout: ASTM A 74, Service class, cast-iron soil pipe and fittings.
- B. Plastic Cleanouts:
 - 1. Description: PVC body with PVC threaded plug. Include PVC sewer pipe fitting and riser to cleanout of same material as sewer piping.
 - 2. Manufacturers: Subject to compliance with requirements, available manufacturers offering products that may be incorporated into the Work include, but are not limited to, the following:
 - a. IPS Corporation.
 - b. NDS Inc.

- c. Plastic Oddities; a division of Diverse Corporate Technologies, Inc.
- d. Sioux Chief Manufacturing Company, Inc.
- e. Zurn Light Commercial Products Operation; Zurn Plumbing Products Group.

2.6 MANHOLES

- A. Standard Precast Concrete Manholes:
 - 1. Description: ASTM C 478, precast, reinforced concrete, of depth indicated, with provision for sealant joints.
 - 2. Diameter: 48 inches minimum unless otherwise indicated.
 - 3. Ballast: Increase thickness of precast concrete sections or add concrete to base section as required to prevent flotation.
 - 4. Base Section: 6-inch minimum thickness for floor slab and 5-inch minimum thickness for walls and base riser section, and separate base slab or base section with integral floor.
 - 5. Riser Sections: 5-inch minimum thickness, and lengths to provide depth indicated.
 - 6. Top Section: Eccentric-cone type unless concentric-cone or flat-slab-top type is indicated, and top of cone of size that matches grade rings.
 - 7. Joint Sealant: ASTM C 990, bitumen or butyl rubber.
 - 8. Resilient Pipe Connectors: ASTM C 923, cast or fitted into manhole walls, for each pipe connection.
 - 9. Steps: Individual FRP steps wide enough to allow worker to place both feet on one step and designed to prevent lateral slippage off step. Cast or anchor steps into sidewalls at 12- to 16-inch intervals. Omit steps if total depth from floor of manhole to finished grade is less than 48".
 - 10. Adjusting Rings: Interlocking HDPE rings with level or sloped edge in thickness and diameter matching manhole frame and cover, and of height required to adjust manhole frame and cover to indicated elevation and slope. Include sealant recommended by ring manufacturer.
 - 11. Grade Rings: Reinforced-concrete rings, 3-inch to a 12-inch total thickness, to match diameter of manhole frame and cover, and height as required to adjust manhole frame and cover to indicated elevation and slope.
- B. Manhole Frames and Covers:
 - 1. Description: Ferrous; 24-inch ID by 7- to 9-inch riser with 4-inch- minimum width flange and 26-inch- diameter cover, unless otherwise specified. Include indented top design with lettering cast into cover, using wording equivalent to "STORM SEWER."
 - 2. Material: ASTM A 536, Grade 60-40-18 ductile iron unless otherwise indicated.

2.7 CATCH BASINS AND INLETS

- A. Standard Precast Concrete Catch Basins:
 - 1. Description: ASTM C 478, precast, reinforced concrete, of depth indicated, with provision for sealant joints.
 - 2. Base Section: 6-inch minimum thickness for floor slab and 6-inch minimum thickness for walls and base riser section, and separate base slab or base section with integral floor.
 - 3. Riser Sections: 6-inch minimum thickness, riser dimensions to match structure dimensions, and lengths to provide depth indicated.
 - 4. Joint Sealant: ASTM C 990, bitumen or butyl rubber.
 - 5. Adjusting Rings: Interlocking rings with level or sloped edge in thickness and shape matching catch basin frame and grate. Include sealant recommended by ring manufacturer.
 - 6. Grade Rings: Include two or three reinforced-concrete rings, of 3- to 9-inch total thickness, that match structure, frame and grate.
 - 7. Pipe Connectors: ASTM C 923, resilient, of size required, for each pipe connecting to base section.
- B. Frames and Grates: ASTM A 536, Grade 60-40-18, ductile iron designed for A-16, structural loading. Include flat grate with small square or short-slotted drainage openings.
 - 1. Size: 24 by 24 inches minimum, unless otherwise indicated.
 - 2. Grate Free Area: Approximately 50 percent, unless otherwise indicated.

2.8 CONCRETE

- A. General: Cast-in-place concrete according to ACI 318, and the following:
 - 1. Cement: ASTM C 150, Type II.
 - 2. Fine Aggregate: ASTM C 33, sand.
 - 3. Coarse Aggregate: ASTM C 33, crushed gravel.
 - 4. Water: Potable.
- B. Manhole Channels and Benches: Factory or field formed from concrete. Portland cement design mix, 4000 psi minimum, with 0.45 maximum water/cementitious materials ratio. Include channels and benches in manholes.
 - 1. Channels: Concrete invert, formed to same width as connected piping, with height of vertical sides to 80% of pipe diameter. Form curved channels with smooth, uniform radius and slope.
 - a. Invert Slope: 1.0 percent through manhole.
 - 2. Benches: Concrete, sloped to drain into channel.

a. Slope: 4.0 percent.

2.9 WATER QUALITY STRUCTURES

A. General: Contech Engineered Solutions Cascade CS-5 BMP Unit. The BMP unit should be staged so as to minimize UV exposure until burial.

2.10 POLYMER-CONCRETE TRENCH DRAIN-CHANNEL SYSTEMS

- A. General Requirements for Polymer-Concrete, Channel Drainage Systems: Modular system of precast, polymer-concrete channel sections, grates, and appurtenances; designed so grates fit into channel recesses without rocking or rattling. Include quantity of units required to form total lengths indicated.
- B. Manufacturers: Subject to compliance with requirements, available manufacturers offering products that may be incorporated into the Work include, but are not limited to, the following:
 - 1. ACO Drain
 - 2. PolyDrain
 - 3. J.R. Smith
- C. Sloped-Invert, Polymer-Concrete Systems:
 - 1. Channel Sections:
 - a. Interlocking-joint, precast, modular units with end caps.
 - b. 4-inch inside width and deep, rounded bottom, with built-in invert slope of a minimum 0.50 percent and with outlets in quantities, sizes, and locations indicated.
 - c. Extension sections necessary for required depth.
 - d. Frame: Include gray-iron or steel frame for grate.
 - 2. Grates:
 - a. Manufacturer's designation "Heavy Duty," with slots or perforations that fit recesses in channels.
 - b. Material: Galvanized steel or Gray iron as indicated on plans.
 - 3. Covers: Solid gray iron if indicated.
 - 4. Locking Mechanism: Manufacturer's standard device for securing grates to channel sections.
- D. Drainage Specialties: Precast, polymer-concrete units.
 - 1. Catch Basins:
 - a. Size: 24-by-12-inch polymer-concrete body, with outlets in quantities and sizes indicated.
 - b. Gray-iron slotted grate.
 - c. Frame: Include gray-iron or steel frame for grate.
- E. Supports, Anchors, and Setting Devices: Manufacturer's standard unless otherwise indicated.
- F. Channel-Section Joining and Fastening Materials: As recommended by system manufacturer.

PART 3 - EXECUTION

3.1 EARTHWORK

A. Excavation, trenching, and backfilling are specified in Section 31 20 00 "Earth Moving."

3.2 PIPING INSTALLATION

- A. General Locations and Arrangements: Drawing plans and details indicate general location and arrangement of underground storm drainage piping. Location and arrangement of piping layout take into account design considerations. Install piping as indicated, to extent practical. Where specific installation is not indicated, follow piping manufacturer's written instructions.
- B. Install piping beginning at low point, true to grades and alignment indicated with unbroken continuity of invert. Place bell ends of piping facing upstream. Install gaskets, seals, sleeves, and couplings according to manufacturer's written instructions for use of lubricants, cements, and other installation requirements.
- C. Install manholes for changes in direction unless fittings are indicated. Use fittings for branch connections unless direct tap into existing sewer is indicated.
- D. Install proper size increasers, reducers, and couplings where different sizes or materials of pipes and fittings are connected. Reducing size of piping in direction of flow is prohibited.
- E. When installing pipe under streets or other obstructions that cannot be disturbed, use pipejacking process of microtunneling.
- F. Install gravity-flow, nonpressure drainage piping according to the following:
 - 1. Install piping pitched down in direction of flow.
 - 2. Install piping with 24" minimum cover.
 - 3. Install PVC sewer piping according to ASTM D 2321 and ASTM F 1668.
 - 4. Install reinforced-concrete sewer piping according to ASTM C 1479 and ACPA's "Concrete Pipe Installation Manual."

3.3 PIPE JOINT CONSTRUCTION

- A. Join gravity-flow, nonpressure drainage piping according to the following:
 - 1. Join PVC sewer piping according to ASTM D 2321 and ASTM D 3034 for elastomericseal joints or ASTM D 3034 for elastomeric-gasketed joints.
 - 2. Join reinforced-concrete sewer piping according to ACPA's "Concrete Pipe Installation Manual" for rubber-gasketed joints.
 - 3. Join dissimilar pipe materials with nonpressure-type flexible couplings.

3.4 CLEANOUT INSTALLATION

- A. Install cleanouts and riser extensions from sewer pipes to cleanouts at grade. Use cast-iron soil pipe fittings in sewer pipes at branches for cleanouts and cast-iron soil pipe for riser extensions to cleanouts. Install piping so cleanouts open in direction of flow in sewer pipe.
 - 1. Use Medium-Duty, top-loading classification cleanouts in non-paved areas.
 - 2. Use Heavy-Duty, top-loading classification cleanouts in vehicle-traffic service areas.
- B. Set cleanout frames and covers in earth in cast-in-place concrete block, 18 by 18 by 12 inches deep. Set with tops 1 inch above surrounding earth grade.
- C. Set cleanout frames and covers in concrete pavement and roads with tops flush with pavement surface.

3.5 MANHOLE INSTALLATION

- A. General: Install manholes, complete with appurtenances and accessories indicated.
- B. Install precast concrete manhole sections with sealants according to ASTM C 891.
- C. Where specific manhole construction is not indicated, follow manhole manufacturer's written instructions.
- D. Set tops of frames and covers flush with finished surface of manholes, unless otherwise indicated.

3.6 CATCH BASIN AND INLET INSTALLATION

- A. Construct catch basins to sizes and shapes indicated.
- B. Set frames and grates to elevations indicated.

3.7 WATER QUALITY STRUCTURE INSTALLATION

- A. Stub outs and internal components shall be supplied by manufacturer and MIG welded using welding practices and thickness as approved by the Town.
- B. Manufacturer shall supply direct access to BMP Unit via 30-inch ID riser(s). If necessary to accommodate field adjustments, Contractor may cut riser to match finish grade. The exposed metal of the cut riser must be recoated to 12 mil thickness using the touch up kit supplied with each BMP unit. If necessary to extend riser, Contractor can use adjusting rings to bring top of structure to grade.
- C. Contractor shall supply pipe couplings to and from BMP Unit, which shall be Mar-Mac, Fernco, or Mission style flexible boot with stainless steel tension bands and shear guard. Manufacturer shall supply minimum 12" long inlet/outlet stub-outs (≤Ø10" shall be smooth rolled and ≥Ø12" shall be corrugated (with re-rolled ends)).
- D. Contractor shall prepare excavation and off-load BMP Unit. Contractor is responsible for bedding and backfill around the BMP Unit and Diversion structure as detailed on site utility plan and details. Contractor should inspect BMP for any exposed material (scratches or other

damage to the polymer coating). This must be recoated to 12 mil thickness using the touch up kit supplied with each unit prior to installation or placement of backfill.

- E. Manufacturer shall supply standard manhole frame(s) and cover(s) (Traffic rated HS-25).
- F. Where traffic loading (HS-25) is required or anticipated, a 4-foot diameter, 14-inch thick reinforced concrete pad must be placed over the BMP Unit to support and level the manhole frame. The top of riser pipe must be wrapped with compressible expansion joint material to a minimum 1/2-inch thickness to allow transfer of wheel loads from manhole cover to concrete slab. Manhole cover shall bear on concrete slab and not on riser pipe. The concrete slab shall have a minimum strength of 3,000 psi and be reinforced with #4 reinforcing steel (per drawing). Minimum cover over reinforcing steel shall be 1-inch. Top of manhole cover and concrete slab shall be level with finish grade.
- G. Where high groundwater elevations are present or anticipated, Contractor shall supply concrete anti-floatation pad poured integral with the Contech Unit to prevent buoyancy and base plate deflection (details, if necessary, available upon request).
- H. <u>Excavation and Bedding</u> The trench and trench bottom shall be constructed in accordance with ASTM A 798 Sections 5, 6, and 7. The PCS Aqua-Swirl shall be installed on a stable base consisting of at least 6-inches of Class 1 stone materials (Class I #8 crushed stone, angular, large void content; contains little or no fines) as defined by ASTM D 2321, Section 5, Materials, and compacted to 95% proctor density. Bedding shall not contain stones retained on a 3-inch ring, frozen lumps, highly plastic clay, organic material, corrosive material, or other deleterious foreign materials. All required safety precautions for Aqua-Swirl installation are the responsibility of the Contractor and shall be per OSHA approved methods.
- I. <u>Backfill Requirements</u> Backfill materials shall be Class 1 stone materials (Class I #8 crushed stone, angular, large void content; contains little or no fines) as defined by ASTM D 2321, Section 5, Materials, and compacted to 90% proctor density. Backfilling shall conform to ASTM A 798, Section 10. Backfill shall be placed in 6 to 12 inch layers or "lifts" and compacted before adding the next lift. Backfill shall extend at least 18 inches outward from Aqua-Swirl and for the full height of the Aqua-Swirl (including riser(s)) extending laterally to undisturbed soils.

3.8 CONNECTIONS

- A. Connect non-pressure, gravity-flow drainage piping in building's storm building drains specified in Section 22 14 13 "Facility Storm Drainage Piping."
- B. Make connections to existing piping and underground manholes.
 - 1. Use commercially manufactured wye fittings for piping branch connections. Remove section of existing pipe; install wye fitting into existing piping; and encase entire wye fitting, plus 6-inch overlap, with not less than 6 inches of concrete with 28-day compressive strength of 3000 psi.
 - 2. Make branch connections from side into existing piping, NPS 4 to NPS 20. Remove section of existing pipe, install wye fitting into existing piping, and encase entire wye with not less than 6 inches of concrete with 28-day compressive strength of 3000 psi.
 - 3. Make branch connections from side into existing piping, NPS 21 or larger, or to underground manholes and structures by cutting into existing unit and creating an opening large enough to allow 3 inches of concrete to be packed around entering connection. Cut end of connection pipe passing through pipe or structure wall to conform to shape of and be flush with inside wall unless otherwise indicated. On outside of pipe,

manhole, or structure wall, encase entering connection in 6 inches of concrete for minimum length of 12 inches to provide additional support of collar from connection to undisturbed ground.

- a. Use concrete that will attain a minimum 28-day compressive strength of 3000 psi unless otherwise indicated.
- b. Use epoxy-bonding compound as interface between new and existing concrete and piping materials.
- 4. Protect existing piping, manholes, and structures to prevent concrete or debris from entering while making tap connections. Remove debris or other extraneous material that may accumulate.
- C. Pipe couplings, expansion joints, and deflection fittings with pressure ratings at least equal to piping rating may be used in applications below unless otherwise indicated.
 - 1. Use nonpressure-type flexible couplings where required to join gravity-flow, nonpressure sewer piping unless otherwise indicated.
 - a. Unshielded flexible couplings for same or minor difference OD pipes.
 - b. Unshielded, increaser/reducer-pattern, flexible couplings for pipes with different OD.
 - c. Ring-type flexible couplings for piping of different sizes where annular space between smaller piping's OD and larger piping's ID permits installation.
 - 2. Use pressure-type pipe couplings for force-main joints.

3.9 CLOSING ABANDONED STORM DRAINAGE SYSTEMS

- A. Abandoned Piping: Close open ends of abandoned underground piping indicated to remain in place. Include closures strong enough to withstand hydrostatic and earth pressures that may result after ends of abandoned piping have been closed. Use either procedure below:
 - 1. Close open ends of piping with at least 8-inch- thick, brick masonry bulkheads.
 - 2. Close open ends of piping with threaded metal caps, plastic plugs, or other acceptable methods suitable for size and type of material being closed. Do not use wood plugs.
- B. Abandoned Manholes and Structures: Excavate around manholes and structures as required and use one procedure below:
 - 1. Remove manhole or structure and close open ends of remaining piping.
 - 2. Remove top of manhole or structure down to at least 36 inches below final grade. Fill to within 12 inches of top with stone, rubble, gravel, or compacted dirt. Fill to top with concrete.
- C. Backfill to grade according to Section 31 20 00 "Earth Moving."

3.10 FIELD QUALITY CONTROL

- A. Inspect interior of piping to determine whether line displacement or other damage has occurred. Inspect after approximately 24 inches of backfill is in place, and again at completion of Project.
 - 1. Submit separate reports for each system inspection.
 - 2. Defects requiring correction include the following:
 - a. Alignment: Less than full diameter of inside of pipe is visible between structures.
 - b. Deflection: Flexible piping with deflection that prevents passage of ball or cylinder of size not less than 92.5 percent of piping diameter.
 - c. Damage: Crushed, broken, cracked, or otherwise damaged piping.
 - d. Infiltration: Water leakage into piping.
 - e. Exfiltration: Water leakage from or around piping.
 - 3. Replace defective piping using new materials, and repeat inspections until defects are within allowances specified.
 - 4. Reinspect and repeat procedure until results are satisfactory.
- B. Test new piping systems, and parts of existing systems that have been altered, extended, or repaired, for leaks and defects.
 - 1. Do not enclose, cover, or put into service before inspection and approval.
 - 2. Test completed piping systems according to requirements of authorities having jurisdiction.
 - 3. Schedule tests and inspections by authorities having jurisdiction with at least 24 hours' advance notice.
 - 4. Submit separate report for each test.
 - 5. Gravity-Flow Storm Drainage Piping: Test according to requirements of authorities having jurisdiction, UNI-B-6, and the following:
 - a. Exception: Piping with soiltight joints unless required by authorities having jurisdiction.
 - b. Option: Test plastic piping according to ASTM F 1417.
 - c. Option: Test concrete piping according to ASTM C 924.
- C. Leaks and loss in test pressure constitute defects that must be repaired.
- D. Replace leaking piping using new materials, and repeat testing until leakage is within allowances specified.

3.11 CLEANING

A. Clean interior of piping of dirt and superfluous materials. Flush with water.

END OF SECTION 33 41 00

ARCHITECTURAL/SITE ABBREVIATIONS ABBREVIATIONS USED ON THE CONTRACT DOCUMENTS, INCLUDE BUT ARE NOT LIMITED TO THOSE LISTED BELOW


	AT	Μ	METER		ASF
D NC NCT	AIR CONDITIONING ACOUSTICAL CEILING TILE	MAS MAT	MASONRY MATERIAL		
D	AREA DRAIN	MAX	MAXIMUM		EAR
DJ FF	ADJUSTABLE ABOVE FINISHED FLOOR	MB MECH	MARKER BOARD MECHANICAL	2000	2000000
FP GG	ACCORDION FOLDING PARTITION AGGREGATE	MEZZ MFR	MEZZANINE MANUFACTURER	00000	GRA
ALT AL	ALTERNATIVE ALUMINUM	MH MIN	MOP HOLDER MINIMUM		SAN
AP APROX	ACCESS PANEL APPROXIMATE	MISC	MISCELLANEOUS MILLIMETER		SAN OF S
AR	ACID RESISTANT	MO	MASONRY OPENING	1	
ARCH ASPH	ARCHITECT(URAL) ASPHALT	MTL	METAL		CON
AV AWG	AUDIO-VISUAL AMERICAN WIRE GUAGE	N NIC	NORTH NOT IN CONTRACT		TER
AWT	ACCOUSTICAL WALL TREATMENT	NO/#	NUMBER		
- x	ANGLE AND	NOM NTS	NOMINAL NOT TO SCALE		CUT
IT	BITUMINOUS	OC	ON CENTER		
BLDG BLKG	BUILDING BLOCKING	OD OPNG	OUTSIDE DIAMETER OPENING	5+	MAF
3M	BENCH MARK / BEAM	OPP	OPPOSITE		
9.0. 90S	BOTTOM OF BOTTOM OF STEEL	0.H. O TO O	OPPOSITE HAND OUT TO OUT	EEE	SLA
BOT BRG	BOTTOM BEARING	OW OZ	OPERABLE WALL OUNCE		
RK	BRICK BUILT-UP ROOF	P	PAINT		FAC
		PA	PUBLIC ADDRESS	777/777	
CAB CAR	CABINET CARPET	PERF PLAS	PERFORATED PLASTIC		GLA
CAT CB	CATALOG CHALKBOARD / CATCH BASIN	PL PLBG	PLASTIC LAMINATE PLUMBING		СОМ
FM	CUBIC FEET PER MINUTE	PLYWD	PLYWOOD		
CH Cl	CABINET HEATER CAST IRON	PREFAB PS	PREFABRICATED PROJECTION SCREEN		
J	CONTROL JOINT CENTERLINE	PSF PSI	POUNDS PER SQUARE FOOT POUNDS PER SQUARE INCH		
LR	CLEAR	PSS	PENCIL SHARPENER SUPPORT		
CLG CMP	CEILING CORRUGATED METAL PIPE	PT PVC	PORCELAIN TILA POLYVINYL CHLORIDE		
CMT CMU	CERAMIC MOSAIC TILE CONCRETE MASONRY UNIT	PVMT	PAVEMENT		CON (SOI
0	CLEANOUT	QT	QUARRY TILE		
ol omp	COLUMN COMPACTED	R	RISER		-
CONC	CONCRETE CONSTRUCTION	RA RAD/R	RETURN AIR RADIUS		SPR
ONT	CONTINUOUS/CONTINUE	RB	RESILIENT BASE		
ONTR ORR	CONTRACTOR CORRUGATED	RCP RD	REINFORCED CONCRETE PIPE ROOF DRAIN		
T TOC	CERAMIC TILE CENTER TO CENTER	REF REFR	REFERENCE REFRIGERATOR		
SK	COUNTER SINK	REINF	REINFORCING		
CU FT/CF CU IN/CI	CUBIC FEET CUBIC INCH	REQ'D REV	REQUIRED REVISION(S)		
CU YD/CY CUSP	CUBIC YARD CUSPIDOR	RM R.O.	ROOM ROUGH OPENING		DRAWI
CW	COLD WATER	ROW	RIGHT-OF-WAY		
CWF	CEMENTITIOUS WOOD FIBER	S	SOUTH	SIM 1	
)	PENNY (NAILS, ETC.) DEPTH/DEEP	SA SAN	SUPPLY AIR SANITARY		
	DEGREE	SCHED	SCHEDULE		CALLOUT
DC DEPT	DISPLAY CASE DEPT	SD SECT	STORM DRAIN / SMOKE DETECTOR SECTION		
DET DF	DETAIL DRINKING FOUNTAIN	SEW SGFT	SEWER STRUCTURAL GLAZED FACING TILE		
DIA/Ø	DIAMETER	SHT	SHEET		
DIM DIV	DIMENSION DIVISION	SIM SP	SIMILAR SPACE		
DL DWG	DEAD LOAD DRAWING	SPEC(S) SPKR	SPECIFICATION(S) SPEAKER		
DS	DOWNSPOUT	SQ	SQUARE		
OWC	DRINKING WATER COOLER	SQ FT/SF SQ IN/SI	SQUARE FEET SQUARE INCHES	XX'-XX"	CEILING TAC
E EA	EAST EACH	SQ YD/SY SS	SQUARE YARDS STAINLESS STEEL		
ΞF	EACH FACE	ST	STORM/STREET		KEY NOTE T
EJ EL	EXPANSION JOINT ELEVATION	STD STL	STANDARD STEEL		KETNOTET
ELEC ELEV	ELECTRIC(AL) ELEVATOR	STRUCT SUSP	STRUCTURAL SUSPENDED		
ENGR	ENGINEER	SW	SHORT WAY / SIDEWALK	(XXXX)	DOOR TAG
EP EQ	ELECTRICAL PANELBOARD EQUAL	SYMM SYNTH	SYMMETRY(ICAL) SYNTHETIC	X	
QUIP W	EQUIPMENT EACH WAY	т	TREAD		EXTERIOR
FS (or DEFS)	DIRECT APPLIED EXTERIOR FINISH SYSTEM	T&B	TOP AND BOTTOM	X AX.XX X	ELEVATION
EIFS EXH	EXTERIOR INSULATION FINISH SYSTEM EXHAUST	T&G TA	TONGUE AND GROOVE TOILET ACCESSORY(IES)		
EXIST EXP	EXISTING EXPANSION	TB TC	TACKBOARD TOP OF CURB	Х	
ХT	EXTERIOR	TEL	TELEPHONE	X Ref	
XTN	EXTENSION	TERR T.O.	TERRAZZO TOP OF		
D HC	FLOOR DRAIN FIRE HOSE CABINET	TOC TOF	TOP OF CONCRETE TOP OF FOOTING	X Ref	INTERIOR ELEVATION
IN	FINISH	TOM	TOP OF MASONRY		
IN FL LR	FINISH FLOOR FLOOR	TOS TV	TOP OF STEEL TELEVISION	X Ref	
DN SR	FOUNDATION FLEXIBLE SHEET ROOFING	TYP TWS	TYPICAL TACKABLE WALL SURFACE		GRID HEAD
SSK	FLOOR SERVICE SINK			(x)	
T TG	FEET FOOTING	UNO UV	UNLESS NOTED OTHERWISE UNIT VENTILATOR		
E EC	FIRE EXTINGUISHER FIRE EXTINGUISHER CABINET	UR	URINAL		
		VCT	VINYL COMPOSITE TILE		LEVEL LINE
SA SALV	GAUGE GALVANIZED(D)	VCGWB VERT	VINYL COVERED GYPSUM WALLBOARD VERTICAL	EL XXX'-XX" Y	
B FCMU	GRAB BAR GROUND FACE CONCRETE MASONRY UNIT	VFWC	VINYL FABRIC WALLCOVERING VERIFY IN FIELD		
FRGU	GLASS FIBER REINFORCED GYPSUM UNIT	VIT	VITREOUS		
il WB	GLASS GYPSUM WALLBOARD	VOL VR	VOLUME VAPOR RETARDER		
		VRB	VENTED RESILIENT BASE		
I IB	HEIGHT/HIGH HOSE BIB	VS VT	VENT STACK VINYL STACK		
IDWE IM	HARDWARE HOLLOW METAL	W	WEST / WIDE / WIDTH		
IORIZ	HORIZONTAL	W/	WITH		
IPT IS	HIGH POINT HIGH STRENGTH	W/O WA	WITHOUT WARDROBE ACCESSORIES		
ITG IVAC	HEATING HEATING/VENTILATING/AIR CONDITIONING	WB WC	WOOD BASE WATER CLOSET / WIND COLUMN		
łW	HOT WATER	WD	WOOD		
łWY -	HIGHWAY	WH WP	WATER HEATER WORKING POINT		
C N	INSIDE DIAMETER INCH	WSSK WWF	WALL SERVICE SINK WELDED WIRE FABRIC		
NCL	INCLUDE(D), (ING)				
NFO NSUL	INFORMATION INSULATION	YD	YARD / YARD DRAIN		
NTR	INTERIOR				
NV	INVERT				
S ST	JOIST SUBSTITUTE JOIST				
T	JOINT				
ίT	KITCHEN				
AM	LENGTH LAMINATE(D)				
AV B/#	LAVATORY POUND				
KR	LOCKER				
.L .LH	LIVE LOAD LONG LEG HORIZONTAL				
	LONG LEG VERTICAL				
_LV _VR	LOUVER				

MATERIAL SYMBOLS LEGEND MATERIAL SYMBOLS USED ON THE CONTRACT DOCUMENTS, INCLUDE BUT ARE NOT LIMITED TO THOSE LISTED BELOW

	ASPHALT		
	EARTH	—X—X—	WIRE FENCE OR PARTITION
003002003 00000000000000000000000000000	GRAVEL, STONE, OR DRAINAGE FILL		METAL ROOF DECK
	SAND, GROUT, PLASTER, GWB, OR PLAN VIEW OF SIDEWALK		LAMINATED WOOD BEAM (SMALL SCALE, SECTION)
	CONCRETE		BATT INSULATION
	TERRAZZO		RIGID INSULATION
	CUT STONE		ROUGH WOOD
5AA	MARBLE		FINISH WOOD
	SLATE		WOOD OTHER THAN NOMINAL
	FACE BRICK (PLAN)	$\underbrace{\longleftrightarrow}$	PLYWOOD
	GLAZED BRICK		GYPSUM WALLBOARD (LARGE SCALE)
	CONCRETE MASONRY UNIT (PLAN)		STUD WALL (PLAN) - DIMENSIONS TAKEN TO FINISH FACE OF WALL - SEE WALL TYPES
	CONCRETE MASONRY UNIT (SECTION)		SOLID PANEL FOLDING PARTITION OR OPERABLE WALL
		<u> </u>	FABRIC ACCORDION FOLDING PARTITION
	CONCRETE MASONRY UNIT (SOLID, IN SECTION)	L	ACOUSTICAL TILE CEILING
			EXTERIROR INSULATION FINISH SYSTEM

SPRAY-ON INSULATION OR FIRE PROTECTION

DRAWING SYMBOLS LEGEND

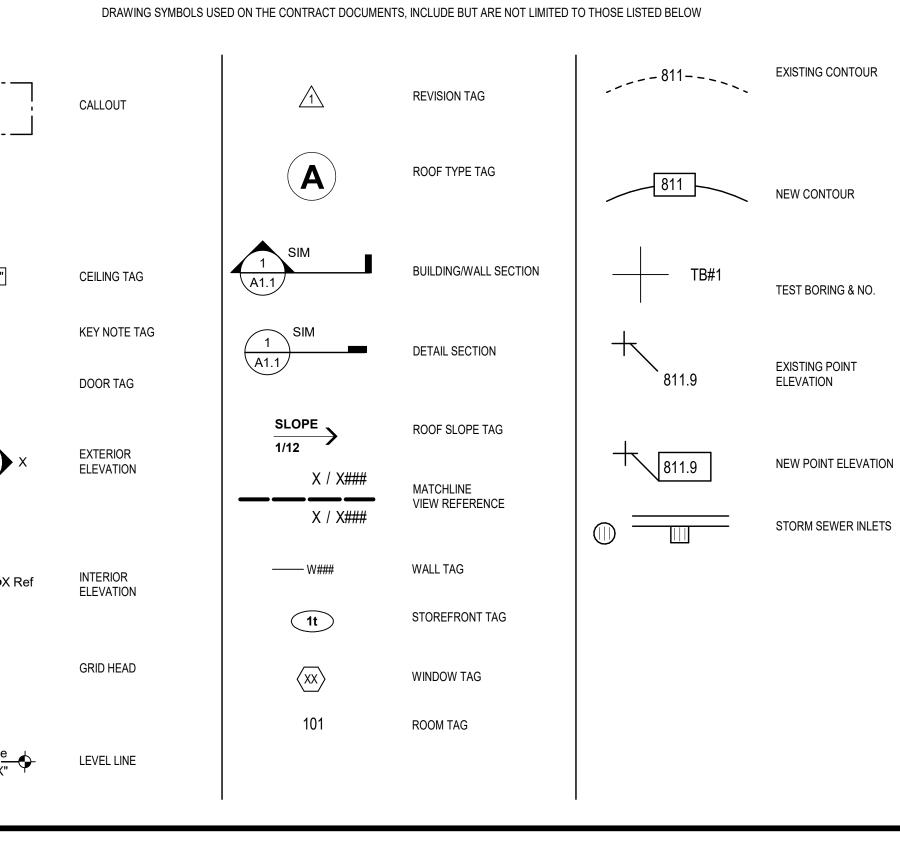

		SHEET INDEX	
	VOLUME A		VOLUME B
	ATIONS AND INDEX		ATIONS AND INDEX
01 CIVIL			SERVICE
GD0.1	GENERAL NOTES	FS1.0	FOODSERVICE NOTES, SYMBOLS & LEGENDS
GD0.2 BNDRY1	MASTER PARKING PLAN BOUNDARY RETRACEMENT SURVEY	FS1.1 FS1.2	FOODSERVICE EQUIPMENT LAYOUT & SCHEDULE FOODSERVICE EQUIPMENT SPECIAL CONDITIONS
BNDRY2	BOUNDARY RETRACEMENT SURVEY	FS2.0	FOODSERVICE EQUIPMENT SPECIAL CONDITIONS
TOPO	TOPOGRAPHIC SURVEY	FS2.1	FOODSERVICE EQUIPMENT SPOT LOCATION LAYOUT
GD1.1	DEMOLITION PLAN	FS3.0	WALK IN COOLER/ FREEZER DRAWING
G1.1 G1.2	SITE PLAN STRIPING & SIGNAGE PLAN	FS4.0 FS4.1	EXHAUST VENTILATION SYSTEM DRAWING EXHAUST VENTILATION SYSTEM DRAWING
G1.2 G1.3	CONCRETE JOINTING PLAN	FS5.0	FOODSERVICE EQUIPMENT DETAILS & ELEVATIONS
G2.1	GRADING PLAN	FS5.1	FOODSERVICE EQUIPMENT DETAILS & ELEVATIONS
G3.1	PRE-DEVELOPED EROSION CONTROL PLAN		
G3.2 G3.3	EROSION CONTROL PLAN STORMWATER POLLUTION PREVENTION PLAN	05 PLUMI P1.01	BING & FIRE PROTECTION SYMBOLS & ABBREVIATIONS
G3.4	EROSION CONTROL DETAILS	PD.01	UNIT A - FIRST FLOOR PLUMBING DEMOLITION PLAN
G4.1	SITE DETAILS	PD.02	UNIT B - FIRST FLOOR PLUMBING DEMOLITION PLAN
G4.2 G5.1	SITE DETAILS ENLARGED SITE PLAN	P2.00 P2.01	UNIT A - FOUNDATION PLUMBING PLAN UNIT A - FIRST FLOOR PLUMBING PLAN
G5.1 G5.2	ENLARGED SITE PLAN	P2.01 P2.02	UNIT A - PIRST FLOOR FLOMBING FLAN UNIT A - MEZZANINE PLUMBING FLAN
SU1.1	UTILITY PLAN	P2.03	UNIT B - FOUNDATION AND FIRST FLOOR PLUMBING PLANS
SU2.1	SITE UTILITY DETAILS	P2.04	EXISTING MECHANICAL ROOM PLUMBING PLANS
SU2.2 SU3.1	SITE UTILITY DETAILS STORM SEWER PLAN AND PROFILES	P3.01 P3.02	PLUMBING SCHEDULES AND DETAILS PLUMBING ISOMETRICS
SU3.2	SANITARY SEWER PLAN AND PROFILES	P3.02 P4.01	ENLARGED AUTOMOTIVE LABS PLUMBING PLAN
SU3.3	UTILITY PLAN AND PROFILES	P4.02	ENLARGED NORTHEAST UTILITY YARD PLUMBING PLANS
L1.0	LANDSCAPE PLAN	P4.03	ENLARGED PLUMBING PLANS
L2.0	LANDSCAPE DETAILS	PFP.01 PFP.02	UNITS A & B - FIRST FLOOR FIRE PROTECTION PLAN UNIT C - FIRST FLOOR FIRE PROTECTION PLAN
02 STRUC	TURAL	FFF.02	UNIT C - FIRST FLOOR FIRE PROTECTION FLAN
S0.01	GENERAL NOTES	06 MECH	IANICAL
S1.01	UNIT A - FOUNDATION PLAN	M1.01	SYMBOLS & ABBREVIATIONS
S1.02 S1.03	UNIT A - SLAB AND MASONRY PLAN UNIT B - FOUNDATION PLAN / SLAB AND MASONRY PLAN	MD.01 MD.02	FIRST FLOOR DEMOLITION - UNIT A FIRST FLOOR DEMOLITION - UNIT B & C
S1.03	UNIT A - MEZZANINE FRAMING PLAN	M2.01	FIRST FLOOR VENTILATION PLAN - UNIT A
S2.02	UNIT A - ROOF FRAMING PLAN	M2.02	FIRST FLOOR VENTILATION PLAN - UNIT B & C
S2.03	UNIT B - ROOF FRAMING PLAN	M3.01	FIRST FLOOR HVAC PIPING PLAN - UNIT A
S3.01 S3.02	FOUNDATION DETAILS FOUNDATION DETAILS	M3.02 M4.01	FIRST FLOOR HVAC PIPING PLAN - UNIT C MECHANICAL MEZZANINES
S3.02	FOUNDATION AND SLAB DETAILS	M4.01 M5.01	MECHANICAL SCHEDULES
S3.04	SLAB DETAILS	M5.02	MECHANICAL SCHEDULES
S4.01	MASONRY DETAILS	M5.03	MECHANICAL DETAILS
S4.02 S4.03	MASONRY DETAILS MASONRY LINTELS	M5.04 M5.05	MECHANICAL DETAILS MECHANICAL DETAILS
S5.01	FRAMING DETAILS	M5.06	MECHANICAL DETAILS
S5.02	FRAMING DETAILS	M5.07	MECHANICAL SECTIONS
S5.03 S5.04	SECTIONS AND DETAILS SECTIONS AND DETAILS	M6.01 M6.02	TEMPERATURE CONTROL DIAGRAMS TEMPERATURE CONTROL DIAGRAMS
03 ARCHIT	FCTURAL	07 ELECT	TRICAL
A0.01	CODE PLAN	E1.01	ELECTRICAL SYMBOL LEGEND & DETAILS
AD1.01	UNIT A - FIRST FLOOR DEMOLITION PLAN	ED.01	UNIT A - ELECTRICAL DEMOLITION PLAN
AD2.01 AD3.01	ROOF DEMOLITION PLAN DEMOLITION ELEVATIONS	ED.02 ED2.01	UNIT B AND C - ELECTRICAL DEMOLITION PLANS ELECTRICAL DEMOLITION SITE PLAN
AD3.01 AD9.01	UNIT A - FIRST FLOOR DEMOLITION REFLECTED CEILING PLAN	ED2.01	ELECTRICAL DEMOLITION SITE PLAN ELECTRICAL SITE PLAN
A1.00	WALL TYPES AND DETAILS	E3.01	UNIT A - FIRST FLOOR TECHNOLOGY ROUGH-IN PLAN
A1.01	UNIT A - FIRST FLOOR ARCHITECTURAL PLAN	E3.02	UNIT B AND C - FIRST FLOOR TECHNOLOGY ROUGH-IN PLAN
A1.02	UNIT A - MEZZANINE ARCHITECTURAL PLAN	E3.03	UNIT A - MEZZANINE TECHNOLOGY ROUGH-IN PLAN
A1.03 A1.05	UNIT B AND C - DEMOLITION AND FIRST FLOOR ARCHITECTURAL PLAN ENLARGED PLANS	E3.04 E3.05	TECHNOLOGY ROUGH-IN DETAILS TECHNOLOGY ROUGH-IN DETAILS
A1.06	PLAN DETAILS AND TYPICAL MASONRY DETAILS	E4.01	UNIT A - LIGHTING PLAN
A1.07	MOUNTING HEIGHTS AND MISC. DETAILS	E4.02	UNIT B AND C - LIGHTING PLANS
A2.01	UNIT A - ROOF PLAN	E5.01	UNIT A - POWER PLAN
A2.02 A3.01	ROOF DETAILS UNIT A - BUILDING ELEVATIONS	E5.02 E6.01	UNIT B & C- POWER PLANS UNIT A - FIRE ALARM PLAN
A4.01	BUILDING SECTIONS	E6.02	UNIT B & C - FIRE ALARM PLANS
A5.01	WALL SECTIONS	E7.01	ELECTRICAL ONE-LINE DIAGRAMS
A5.02 A5.03	WALL SECTIONS WALL SECTIONS	E7.02 E8.01	UNIT A - MEZZANINE ELECTRICAL PLAN PANELBOARD SCHEDULES
A5.03 A5.04	WALL SECTIONS WALL SECTIONS	E0.UT	PANELDUARD SUREDULES
A5.05	SECTION DETAILS	<u>_</u>	NOLOGY //
A6.01	DOOR AND FRAME SCHEDULE AND ELEVATIONS	∑ TD.01	UNIT A - FIRST FLOOR TECHNOLOGY DEMOLITION PLAN
A6.02 A6.03	DOOR DETAILS WINDOW ELEVATIONS AND DETAILS	TD.02 T1.01	UNIT B - FIRST FLOOR TECHNOLOGY DEMOLITION PLAN TECHNOLOGY DETAILS
A6.03 A7.01	UNIT A - FIRST FLOOR EQUIPMENT PLAN	T1.01 T1.02	TECHNOLOGY DETAILS TECHNOLOGY DETAILS
A7.02	UNIT B AND C - FIRST FLOOR EQUIPMENT PLAN	T1.03	TECHNOLOGY DETAILS
A7S.01	EDUCATIONAL CASEWORK SCHEDULES, ELEVATIONS AND EQUIPMENT FINISHES	T3.01	UNIT A - FIRST FLOOR TECHNOLOGY PLAN
A8.01	UNIT A - FIRST FLOOR FINISH PLAN UNIT A - MEZZANINE FINISH PLAN	T3.02	UNIT B AND C - FIRST FLOOR TECHNOLOGY PLAN
A8.02 A8.03	UNIT A - MEZZANINE FINISH PLAN UNIT B AND C - FIRST FLOOR FINISH PLAN	Т3.03	UNIT A - MEZZANINE TECHNOLOGY PLAN
A8.04	INTERIOR ELEVATIONS	09 AUDIC	DVISUAL
A8.05	INTERIOR ELEVATIONS	AV0.01	AUDIOVISUAL INFRASTRUCTURE LEGENDS AND NOTES
A8.06	INTERIOR ELEVATIONS	AV0.02	AUDIOVISUAL INFRASTRUCTURE LEGENDS AND LEGEND NOTES
A8.07 A8.08	INTERIOR ELEVATIONS FLOORING TRANSITIONS & DETAILS	AV1.01 AV2.01	UNIT C - FIRST FLOOR AUDIOVISUAL INFRASTRUCTURE PLAN UNIT C - FIRST FLOOR AUDIOVISUAL INFRASTRUCTURE REFLECTED CEILING PLAN
A8S.01	LIST OF FINISHES	AV5.01	AUDIOVISUAL INFRASTRUCTURE ROOM RISERS
A9.01	UNIT A - FIRST FLOOR REFLECTED CEILING PLAN	AV7.01	AUDIOVISUAL INFRASTRUCTURE ELEVATIONS
A9.02	UNIT B AND C - DEMOLITION AND FIRST FLOOR REFLECTED CEILING PLAN CEILING DETAILS		
A9.03 A10.01	VERTICAL CIRCULATION		
A10.02	VERTICAL CIRCULATION		

SHEET INDEX



ARCHITECTURAL/SITE ABBREVIATIONS

ABE	ARCHITECTURAL/SITE	
@	AT	М
AC	AIR CONDITIONING	MA
ACT	ACOUSTICAL CEILING TILE	MA
AD	AREA DRAIN	MA
ADJ	ADJUSTABLE	MB
AFF	ABOVE FINISHED FLOOR	ME
AFP	ACCORDION FOLDING PARTITION	ME.
AGG	AGGREGATE	MFI
ALT	ALTERNATIVE	MH
AL	ALUMINUM	MIN
AP	ACCESS PANEL	MIS
APROX	APPROXIMATE	MM
AR	ACID RESISTANT	MO
ARCH	ARCHITECT(URAL)	MTI
ASPH AV AWG	ASPHALT AUDIO-VISUAL AMERICAN WIRE GUAGE	N NIC
AWT	ACCOUSTICAL WALL TREATMENT	NO/
L	ANGLE	NO
&	AND	NTS
BIT	BITUMINOUS	OC
BLDG	BUILDING	OD
BLKG	BLOCKING	OPI
BM	BENCH MARK / BEAM	OPI
B.O.	BOTTOM OF	0.H
BOS	BOTTOM OF STEEL	O T
BOT BRG BRK	BOTTOM BEARING BRICK	OW OZ
BUR	BUILT-UP ROOF	P PA
CAB	CABINET	PEF
CAR	CARPET	PLA
CAT	CATALOG	PL
CB	CHALKBOARD / CATCH BASIN	PLE
CFM	CUBIC FEET PER MINUTE	PLY
CH	CABINET HEATER	PRI
CI	CAST IRON	PS
CJ	CONTROL JOINT	PSF
CL	CENTERLINE	PSI
CLR	CLEAR	PSS
CLG	CEILING	PT
CMP CMT	CORRUGATED METAL PIPE CERAMIC MOSAIC TILE CONCRETE MASONIDY UNIT	PV(PVI
CMU CO COL	CONCRETE MASONRY UNIT CLEANOUT COLUMN	QT
COMP	COMPACTED	R
CONC	CONCRETE	RA
CONSTR	CONSTRUCTION	RAI
CONT	CONTINUOUS/CONTINUE	RB
CONTR	CONTRACTOR	RCI
CORR	CORRUGATED	RD
CT	CERAMIC TILE	REI
C TO C	CENTER TO CENTER	REI
CSK	COUNTER SINK	REI
CU FT/CF	CUBIC FEET	RE(
CU IN/CI	CUBIC INCH	RE [\]
CU YD/CY	CUBIC YARD	RM
CUSP	CUSPIDOR	R.C
CW	COLD WATER	RO'
CWF	CEMENTITIOUS WOOD FIBER	S
d	PENNY (NAILS, ETC.)	SA
D	DEPTH/DEEP	SAN
DC DEPT	DEGREE DISPLAY CASE DEPT	SCI SD SE(
DET	DETAIL	SE\
DF	DRINKING FOUNTAIN	SGI
DIA/ Ø	DIAMETER	SH ⁻
DIM	DIMENSION	SIM
DIV	DIVISION	SP
DL	DEAD LOAD	SPE
DWG	DRAWING	SPE
DS	DOWNSPOUT	SQ
DWC E	DRINKING WATER COOLER	SQ SQ SQ
EA	EACH	SS
EF	EACH FACE	ST
EJ	EXPANSION JOINT	STE
EL	ELEVATION	STL
ELEC	ELECTRIC(AL)	STF
ELEV	ELEVATOR É	SUS
ENGR	ENGINEER	SW
ep Eq Equip	ELECTRICAL PANELBOARD EQUAL EQUIPMENT	SYN SYN
EW	EACH WAY	T
EFS (or DEFS)	DIRECT APPLIED EXTERIOR FINISH SYSTEM	T&E
EIFS	EXTERIOR INSULATION FINISH SYSTEM	T&C
EXH	EXHAUST	TA
EXIST	EXISTING	TB
EXP	EXPANSION	TC
EXT	EXTERIOR	TEL
EXTN	EXTENSION	TEF
FD FHC	FLOOR DRAIN FIRE HOSE CABINET	T.O TO(TO
FIN	FINISH	TOI
FIN FL	FINISH FLOOR	TOS
FLR	FLOOR	TV
FDN	FOUNDATION	Tyf
FSR	FLEXIBLE SHEET ROOFING	Tw
FSSK FT FTG	FLOOR SERVICE SINK FEET FOOTING	UN UV
FE FEC	FIRE EXTINGUISHER FIRE EXTINGUISHER CABINET	UR
GA GALV	GAUGE GALVANIZED(D)	VC ⁻ VC(VEF
GB	GRAB BAR	VFV
GFCMU	GROUND FACE CONCRETE MASONRY UNIT	VIF
GFRGU	GLASS FIBER REINFORCED GYPSUM UNIT	VIT
GL	GLASS	VOI
GWB	GYPSUM WALLBOARD	VR
H HB	HEIGHT/HIGH HOSE BIB	VRI VS VT
HDWE	HARDWARE	W
HM	HOLLOW METAL	W/
HORIZ HPT HS	HORIZONTAL HIGH POINT HIGH STRENGTH	W/C WA
HTG	HEATING	WB
HVAC	HEATING/VENTILATING/AIR CONDITIONING	WC
HW	HOT WATER	WD
HWY	HIGHWAY	WH WP WS
ID IN INCL	INSIDE DIAMETER INCH INCLUDE(D), (ING)	WW
INFO INSUL INTR	INFORMATION INSULATION INTERIOR	YD
INV	INVERT	
JS JST JT	JOIST SUBSTITUTE JOIST JOINT	
KIT	KITCHEN	
L LAM	LENGTH LAMINATE(D)	
LAV LB/# LKR	LAVATORY POUND LOCKER	
LL LLH	LIVE LOAD LONG LEG HORIZONTAL	
LLV LVR LW	LONG LEG VERTICAL LOUVER LONG WAY	

BREV	/IATIONS
RE NOT LIMITE	ED TO THOSE LISTED BELOW
n Mas Mat Max MB MECH MEZZ MFR MFR MIN MISC MM MISC MM MO MTL	METER MASONRY MATERIAL MAXIMUM MARKER BOARD MECHANICAL MEZZANINE MANUFACTURER MOP HOLDER MINIMUM MISCELLANEOUS MILLIMETER MASONRY OPENING METAL
I IIC IO/# IOM ITS	NORTH NOT IN CONTRACT NUMBER NOMINAL NOT TO SCALE
)D)PNG)PP	ON CENTER OUTSIDE DIAMETER OPENING OPPOSITE OPPOSITE HAND OUT TO OUT OPERABLE WALL OUNCE
PERF PLAS PLBG PLYWD PREFAB PS PSF PSF PSS	PAINT PUBLIC ADDRESS PERFORATED PLASTIC PLASTIC LAMINATE PLUMBING PLYWOOD PREFABRICATED PROJECTION SCREEN POUNDS PER SQUARE FOOT POUNDS PER SQUARE INCH PENCIL SHARPENER SUPPORT PORCELAIN TILA POLYVINYL CHLORIDE PAVEMENT
RA RAD/R RB	QUARRY TILE RISER RETURN AIR RADIUS RESILIENT BASE REINFORCED CONCRETE PIPE
RD REF REFR REINF REQ'D	ROOF DRAIN REFERENCE REFRIGERATOR REINFORCING REQUIRED REVISION(S) ROOM ROUGH OPENING RIGHT-OF-WAY
SA SAN SCHED SD SECT SEW SGFT SHT SIM SP	SOUTH SUPPLY AIR SANITARY SCHEDULE STORM DRAIN / SMOKE DETECTOR SECTION SEWER STRUCTURAL GLAZED FACING TILE SHEET SIMILAR SPACE SPECIFICATION(S) SPEAKER SQUARE SQUARE FEET SQUARE FEET SQUARE INCHES SQUARE YARDS STAINLESS STEEL STORM/STREET STANDARD STEEL STRUCTURAL
SUSP SW SYMM SYNTH	SUSPENDED SHORT WAY / SIDEWALK SYMMETRY(ICAL) SYNTHETIC
&B &G A E E E E C O C O C O C O C O C O C O C O	TREAD TOP AND BOTTOM TONGUE AND GROOVE TOILET ACCESSORY(IES) TACKBOARD TOP OF CURB TELEPHONE TERRAZZO TOP OF TOP OF CONCRETE TOP OF FOOTING TOP OF FOOTING TOP OF STEEL TELEVISION TYPICAL
WS	TACKABLE WALL SURFACE

TACKABLE WALL SURFACE UNLESS NOTED OTHERWISE UNIT VENTILATOR URINAL VINYL COMPOSITE TILE VINYL COVERED GYPSUM WALLBOARD VERTICAL

TYP

TWS

UNO

UV

UR

VCT

VIF

VIT VOL

VR

VT

W/ W/O WA

WB

WC

WD

WH

WP

WSSK

WWF

YD

VRB VS

VCGWB VERT VFWC

VINYL FABRIC WALLCOVERING VERIFY IN FIELD VITREOUS VOLUME VAPOR RETARDER VENTED RESILIENT BASE VENT STACK

VINYL STACK WEST / WIDE / WIDTH WITH WITHOUT WARDROBE ACCESSORIES WOOD BASE WATER CLOSET / WIND COLUMN WOOD WATER HEATER WORKING POINT WALL SERVICE SINK

YARD / YARD DRAIN

WELDED WIRE FABRIC

	683003 68306 68306	20090 20000
	5A	Z
		\supset
SIM		DF
	<u> </u>	CALLO
Ĺ.		
XX'-XX"		CEILIN
		KEY NO
XXXX		DOOR
×		EXTER
X (AX.XX) X	► X	ELEVA
X Ref		
X Ref	Ref	INTERI ELEVA
X Ref		
(\mathbf{x})		GRID H
Name	~	
EL XXX'-XX"	- \$ -	LEVEL


LVR LW

MATERIAL SYMBOLS LEGEND MATERIAL SYMBOLS USED ON THE CONTRACT DOCUMENTS, INCLUDE BUT ARE NOT LIMITED TO THOSE LISTED BELOW

ASPHALT		
EARTH	—X—X—	WIRE FENCE OR PARTITION
GRAVEL, STONE, OR DRAINAGE FILL		METAL ROOF DECK
SAND, GROUT, PLASTER, GWB, OR PLAN VIEW OF SIDEWALK		LAMINATED WOOD BEAM (SMALL SCALE, SECTION)
CONCRETE		BATT INSULATION
TERRAZZO		RIGID INSULATION
CUT STONE		ROUGH WOOD
MARBLE		FINISH WOOD
SLATE		WOOD OTHER THAN NOMINAL
FACE BRICK (PLAN)	$\longleftarrow \longleftarrow \longleftarrow$	PLYWOOD
GLAZED BRICK		GYPSUM WALLBOARD (LARGE SCALE)
CONCRETE MASONRY UNIT (PLAN)		STUD WALL (PLAN) - DIMENSIONS TAKEN TO FINISH FACE OF WALL - SEE WALL TYPES
		SOLID PANEL FOLDING PARTITION OR OPERABLE WALL
CONCRETE MASONRY UNIT (SECTION)	~~~~	FABRIC ACCORDION FOLDING PARTITION
CONCRETE MASONRY UNIT (SOLID, IN SECTION)		ACOUSTICAL TILE CEILING
		EXTERIROR INSULATION FINISH SYSTEM


SPRAY-ON INSULATION OR FIRE PROTECTION

DRAWING SYMBOLS LEGEND DRAWING SYMBOLS USED ON THE CONTRACT DOCUMENTS, INCLUDE BUT ARE NOT LIMITED TO THOSE LISTED BELOW

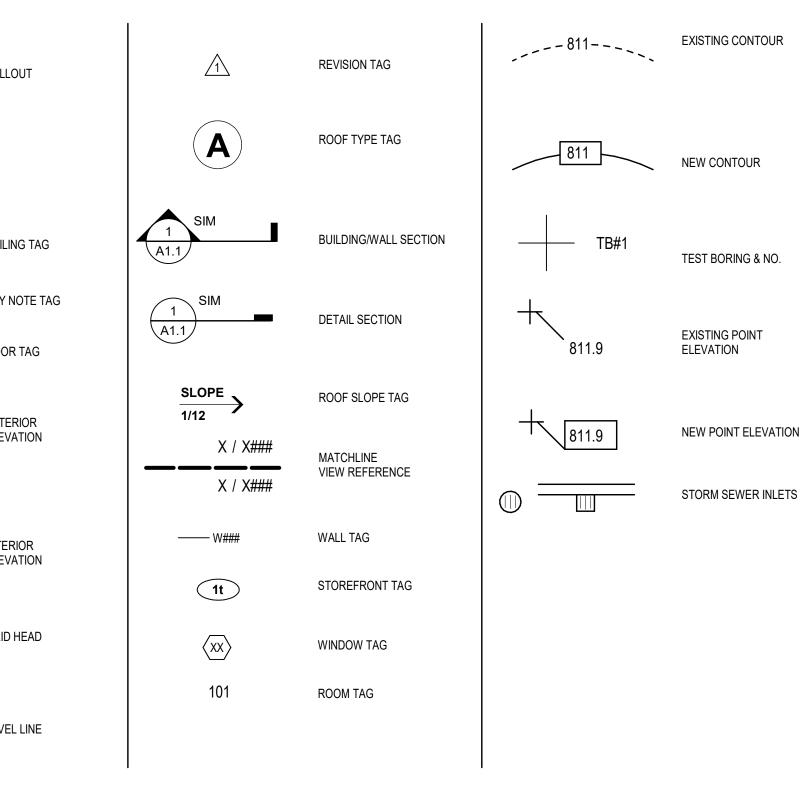


	<u>S</u>	SHEET INDEX	
	VOLUME A		VOLUME B
COVER	ATIONS AND INDEX		TIONS AND INDEX
01 CIVIL		04 FOOD S	
GD0.1	GENERAL NOTES	FS1.0	FOODSERVICE NOTES, SYMBOLS & LEGENDS
GD0.2	MASTER PARKING PLAN	FS1.1	FOODSERVICE EQUIPMENT LAYOUT & SCHEDULE
BNDRY1 BNDRY2	BOUNDARY RETRACEMENT SURVEY BOUNDARY RETRACEMENT SURVEY	FS1.2 FS2.0	FOODSERVICE EQUIPMENT SPECIAL CONDITIONS FOODSERVICE EQUIPMENT SPOT LOCATION LAYOUT
TOPO	TOPOGRAPHIC SURVEY	FS2.0	FOODSERVICE EQUIPMENT SPOT LOCATION LAYOUT
GD1.1	DEMOLITION PLAN	FS3.0	WALK IN COOLER/ FREEZER DRAWING
G1.1	SITE PLAN	FS4.0	EXHAUST VENTILATION SYSTEM DRAWING
G1.2	STRIPING & SIGNAGE PLAN	FS4.1	EXHAUST VENTILATION SYSTEM DRAWING
G1.3 G2.1	CONCRETE JOINTING PLAN GRADING PLAN	FS5.0 FS5.1	FOODSERVICE EQUIPMENT DETAILS & ELEVATIONS FOODSERVICE EQUIPMENT DETAILS & ELEVATIONS
G3.1	PRE-DEVELOPED EROSION CONTROL PLAN	100.1	
G3.2	EROSION CONTROL PLAN		ING & FIRE PROTECTION
G3.3	STORMWATER POLLUTION PREVENTION PLAN	P1.01	SYMBOLS & ABBREVIATIONS
G3.4 G4.1	EROSION CONTROL DETAILS SITE DETAILS	PD.01 PD.02	UNIT A - FIRST FLOOR PLUMBING DEMOLITION PLAN UNIT B - FIRST FLOOR PLUMBING DEMOLITION PLAN
G4.2	SITE DETAILS	P2.00	UNIT A - FOUNDATION PLUMBING PLAN
G5.1	ENLARGED SITE PLAN	P2.01	UNIT A - FIRST FLOOR PLUMBING PLAN
G5.2	ENLARGED SITE PLAN	P2.02	UNIT A - MEZZANINE PLUMBING PLAN
SU1.1 SU2.1	UTILITY PLAN SITE UTILITY DETAILS	P2.03 P2.04	UNIT B - FOUNDATION AND FIRST FLOOR PLUMBING PLANS EXISTING MECHANICAL ROOM PLUMBING PLANS
SU2.2	SITE UTILITY DETAILS	P3.01	PLUMBING SCHEDULES AND DETAILS
SU3.1	STORM SEWER PLAN AND PROFILES	P3.02	PLUMBING ISOMETRICS
SU3.2	SANITARY SEWER PLAN AND PROFILES	P4.01	ENLARGED AUTOMOTIVE LABS PLUMBING PLAN
SU3.3	UTILITY PLAN AND PROFILES	P4.02	ENLARGED NORTHEAST UTILITY YARD PLUMBING PLANS
L1.0 L2.0	LANDSCAPE PLAN LANDSCAPE DETAILS	P4.03 PFP.01	ENLARGED PLUMBING PLANS UNITS A & B - FIRST FLOOR FIRE PROTECTION PLAN
<u></u> V		PFP.02	UNIT C - FIRST FLOOR FIRE PROTECTION PLAN
02 STRUC	TURAL		
S0.01	GENERAL NOTES	06 MECHA	
S1.01 S1.02	UNIT A - FOUNDATION PLAN UNIT A - SLAB AND MASONRY PLAN	M1.01 MD.01	SYMBOLS & ABBREVIATIONS FIRST FLOOR DEMOLITION - UNIT A
S1.02	UNIT B - FOUNDATION PLAN / SLAB AND MASONRY PLAN	MD.02	FIRST FLOOR DEMOLITION - UNIT B & C
S2.01	UNIT A - MEZZANINE FRAMING PLAN	M2.01	FIRST FLOOR VENTILATION PLAN - UNIT A
S2.02	UNIT A - ROOF FRAMING PLAN	M2.02	FIRST FLOOR VENTILATION PLAN - UNIT B & C
S2.03	UNIT B - ROOF FRAMING PLAN	M3.01	FIRST FLOOR HVAC PIPING PLAN - UNIT A
S3.01 S3.02	FOUNDATION DETAILS FOUNDATION DETAILS	M3.02 M4.01	FIRST FLOOR HVAC PIPING PLAN - UNIT C MECHANICAL MEZZANINES
S3.03	FOUNDATION AND SLAB DETAILS	M5.01	MECHANICAL SCHEDULES
S3.04	SLAB DETAILS	M5.02	MECHANICAL SCHEDULES
S4.01	MASONRY DETAILS	M5.03	MECHANICAL DETAILS
S4.02 S4.03	MASONRY DETAILS MASONRY LINTELS	M5.04 M5.05	MECHANICAL DETAILS MECHANICAL DETAILS
S5.01	FRAMING DETAILS	M5.06	MECHANICAL DETAILS
S5.02	FRAMING DETAILS	M5.07	MECHANICAL SECTIONS
S5.03 S5.04	SECTIONS AND DETAILS SECTIONS AND DETAILS	M6.01 M6.02	TEMPERATURE CONTROL DIAGRAMS TEMPERATURE CONTROL DIAGRAMS
03 ARCHI	TECTURAL	07 ELECT	RICAL
A0.01	CODE PLAN	E1.01	ELECTRICAL SYMBOL LEGEND & DETAILS
AD1.01 AD2.01	UNIT A - FIRST FLOOR DEMOLITION PLAN ROOF DEMOLITION PLAN	ED.01 ED.02	UNIT A - ELECTRICAL DEMOLITION PLAN UNIT B AND C - ELECTRICAL DEMOLITION PLANS
AD2.01	DEMOLITION ELEVATIONS	ED2.01	ELECTRICAL DEMOLITION SITE PLAN
AD9.01	UNIT A - FIRST FLOOR DEMOLITION REFLECTED CEILING PLAN	E2.01	ELECTRICAL SITE PLAN
A1.00	WALL TYPES AND DETAILS	E3.01	UNIT A - FIRST FLOOR TECHNOLOGY ROUGH-IN PLAN
A1.01 A1.02	UNIT A - FIRST FLOOR ARCHITECTURAL PLAN UNIT A - MEZZANINE ARCHITECTURAL PLAN	E3.02 E3.03	UNIT B AND C - FIRST FLOOR TECHNOLOGY ROUGH-IN PLAN UNIT A - MEZZANINE TECHNOLOGY ROUGH-IN PLAN
A1.02	UNIT B AND C - DEMOLITION AND FIRST FLOOR ARCHITECTURAL PLAN	E3.03	TECHNOLOGY ROUGH-IN DETAILS
A1.05	ENLARGED PLANS	E3.05	TECHNOLOGY ROUGH-IN DETAILS
A1.06	PLAN DETAILS AND TYPICAL MASONRY DETAILS	E4.01	UNIT A - LIGHTING PLAN
A1.07	MOUNTING HEIGHTS AND MISC. DETAILS	E4.02	UNIT B AND C - LIGHTING PLANS
A2.01 A2.02	UNIT A - ROOF PLAN ROOF DETAILS	E5.01 E5.02	UNIT A - POWER PLAN UNIT B & C- POWER PLANS
A3.01	UNIT A - BUILDING ELEVATIONS	E6.01	UNIT A - FIRE ALARM PLAN
A4.01	BUILDING SECTIONS	E6.02	UNIT B & C - FIRE ALARM PLANS
A5.01	WALL SECTIONS	E7.01	ELECTRICAL ONE-LINE DIAGRAMS
A5.02 A5.03	WALL SECTIONS WALL SECTIONS	E7.02 E8.01	UNIT A - MEZZANINE ELECTRICAL PLAN PANELBOARD SCHEDULES
A5.03 A5.04	WALL SECTIONS WALL SECTIONS	20.01	
A5.05	SECTION DETAILS		
A6.01	DOOR AND FRAME SCHEDULE AND ELEVATIONS	∑ TD.01	UNIT A - FIRST FLOOR TECHNOLOGY DEMOLITION PLAN \int
A6.02 A6.03	DOOR DETAILS WINDOW ELEVATIONS AND DETAILS	TD.02 T1.01	UNIT B - FIRST FLOOR TECHNOLOGY DEMOLITION PLAN TECHNOLOGY DETAILS
A6.03 A7.01	UNIT A - FIRST FLOOR EQUIPMENT PLAN	T1.01 T1.02	TECHNOLOGY DETAILS TECHNOLOGY DETAILS
A7.01	UNIT B AND C - FIRST FLOOR EQUIPMENT PLAN	T1.03	TECHNOLOGY DETAILS
A7S.01	EDUCATIONAL CASEWORK SCHEDULES, ELEVATIONS AND EQUIPMENT FINISHES	T3.01	UNIT A - FIRST FLOOR TECHNOLOGY PLAN
A8.01	UNIT A - FIRST FLOOR FINISH PLAN	T3.02	UNIT B AND C - FIRST FLOOR TECHNOLOGY PLAN
A8.02 A8.03	UNIT A - MEZZANINE FINISH PLAN UNIT B AND C - FIRST FLOOR FINISH PLAN	Т3.03	UNIT A - MEZZANINE TECHNOLOGY PLAN
A8.04	INTERIOR ELEVATIONS	09 AUDIO	VISUAL
A8.05	INTERIOR ELEVATIONS	AV0.01	AUDIOVISUAL INFRASTRUCTURE LEGENDS AND NOTES
A8.06		AV0.02	AUDIOVISUAL INFRASTRUCTURE LEGENDS AND LEGEND NOTES
A8.07	INTERIOR ELEVATIONS ELOORING TRANSITIONS & DETAILS	AV1.01	UNIT C - FIRST FLOOR AUDIOVISUAL INFRASTRUCTURE PLAN
A8.08 A8S.01	FLOORING TRANSITIONS & DETAILS LIST OF FINISHES	AV2.01 AV5.01	UNIT C - FIRST FLOOR AUDIOVISUAL INFRASTRUCTURE REFLECTED CEILING PLAN AUDIOVISUAL INFRASTRUCTURE ROOM RISERS
A03.01 A9.01	UNIT A - FIRST FLOOR REFLECTED CEILING PLAN	AV3.01 AV7.01	AUDIOVISUAL INFRASTRUCTURE ELEVATIONS
A9.02	UNIT B AND C - DEMOLITION AND FIRST FLOOR REFLECTED CEILING PLAN		
A9.03			
A10.01 A10.02	VERTICAL CIRCULATION		
A10.02	VERTICAL CIRCULATION		



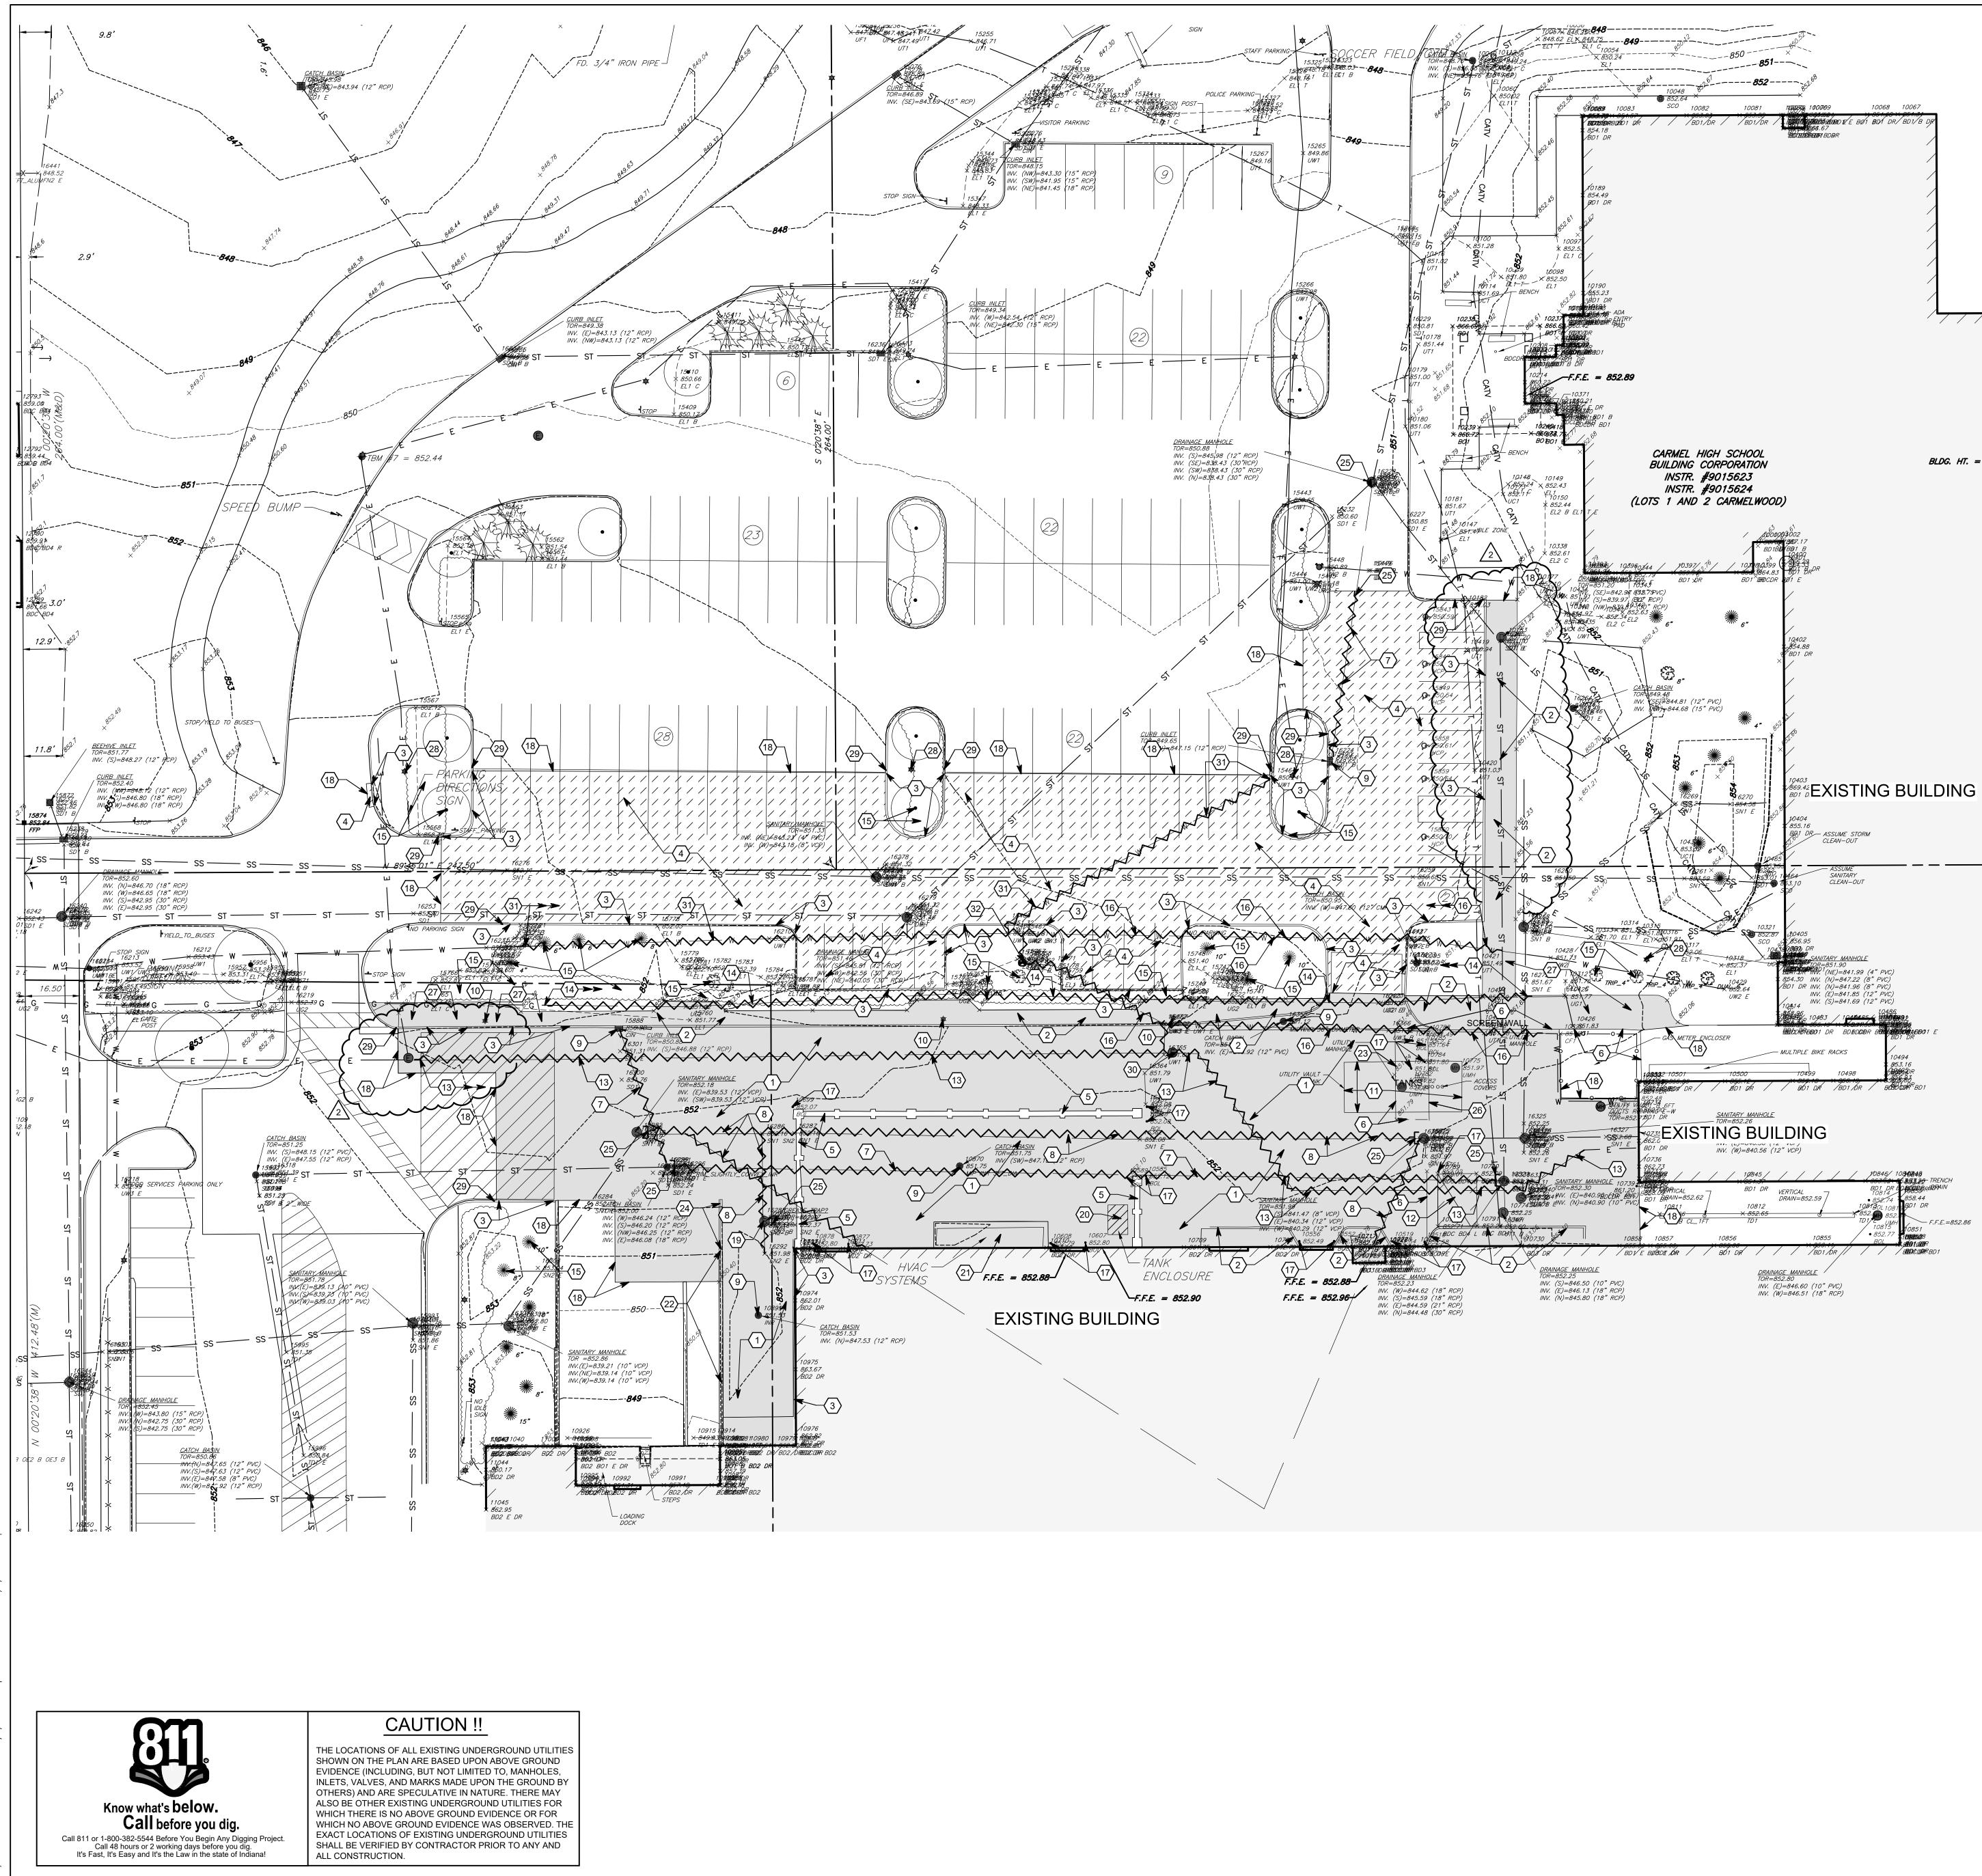

of 11 ime

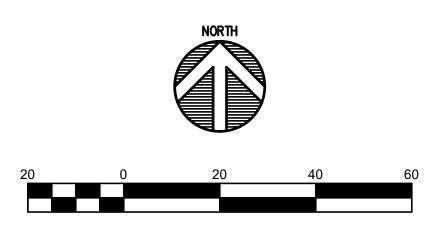

GENERAL NOTES

- 1. SEE DRAWING GD0.1 FOR GENERAL NOTES AND ADDITIONAL LEGEND. 2. TOPOGRAPHIC CONDITIONS AND EXISTING UTILITIES SHOWN WERE PROVIDED
- BY CEC CIVIL & ENVIRONMENTAL CONSULTANTS, INC DATED MAY 19, 2023. THE ENGINEER MAKES NO GUARANTEES THAT THE UNDERGROUND UTILITIES SHOWN COMPRISE ALL SUCH UTILITIES IN THE AREA, EITHER IN SERVICE OR ABANDONED.
- 3. CONTRACTOR SHALL VERIFY ALL EXISTING CONDITIONS IN THE PROJECT AREA INCLUDING UNDERGROUND UTILITY CONDITIONS, LOCATION AND DEPTH PRIOR TO ANY OTHER SITE CONSTRUCTION. REPORT ANY DISCREPANCIES TO THE ENGINEER.

\bigcirc DEMOLITION KEYNOTES

- 1. REMOVE CONCRETE PAVEMENT
- 2. REMOVE CONCRETE SIDEWALK & CURB
- 3. REMOVE CONCRETE CURB
- 4. REMOVE ASPHALT PAVEMENT
- 5. REMOVE MASONRY SCREEN WALL AND FOUNDATIONS
- 6. REMOVE METAL PANEL SCREEN WALL AND FOUNDATIONS.
- 7. REMOVE 18" RCP STORM SEWER
- 8. REMOVE 10" VCP SANITARY SEWER
- 9. REMOVE STORM STRUCTURE
- 10. REMOVE LIGHTPOLES (3 TOTAL)
- 11. EXISTING CONCRETE VAULT (INCLUDING CAP WALLS AND SLAB) & 20,000 FUEL TANK TO BE REMOVED, AND SOIL TO BE REMEDIATED AS REQUIRED BY OWNER/OTHERS. COORDINATE REMOVAL AND CAPPING OF EXISTING FUEL LINES WITH MEP PLANS.
- 12. REMOVE EXISTING BUILDING STRUCTURE. SEE ARCHITECTURAL PLANS
- 13. REMOVE ELECTRICAL LINES. COORDINATE WITH ELECTRICAL SITE PLANS. 14. REMOVE/RELOCATE EXISTING GAS LINE. COORDINATE REMOVALS WITH
- CENTERPOINTE ENERGY.
- 15. REMOVE TREES AND SHRUBS
- 16. REMOVE 8" DIP WATER LINE
- 17. REMOVE PIPE BOLLARDS AND FOUNDATIONS
- 18. PAVEMENT SAWCUT LINE
- 19. REMOVE EXISTING ABANDONED GREASE TRAP
- 20. REMOVE WASTE OIL/FREEZE TANK, CONCRETE SLAB AND FOUNDATION WALLS FULL DEPTH. REMOVE CANOPY STRUCTURE, SALVAGE AND RETURN TO OWNER. CAP EXISTING LINES AT 6" FROM FACE OF BUILDING. COORDINATE PIPING REMOVAL WITH MEP.
- 21. REMOVE CONCRETE EQUIPMENT PAD. SEE MEP PLANS FOR REMOVAL OF EQUIPMENT PAD.
- 22. REMOVE HANDRAIL. PROTECT EXISTING RETAINING WALL DURING CONSTRUCTION. COORDINATE WITH ARCHITECTURAL AND STRUCTURAL PLANS.
- 23. REMOVE SWING GATE
- 24. REMOVE SECTION OF EXISTING RETAINING WALL AND FOUNDATION. COORDINATE LIMITS OF REMOVAL WITH ARCHITECTURAL AND STRUCTURAL PLANS.
- 25. CAP EXISTING PIPE WITH MECHANICAL PLUG SEE DETAIL ON SU2.1
- 26. REMOVE SLIDING CHAINLINK FENCE, GATE, AND FOUNDATIONS.
- 27. REMOVE CONCRETE SIDEWALK
- 28. PROTECT LIGHT POLE TO REMAIN
- 29. PROTECT CURB TO REMAIN
- 30. REMOVE ELECTRICAL MANHOLE. COORDINATE REMOVALS WITH ELECTRICAL SITE PLAN.
- 31. REMOVE 10" DIP WATER LINE.
- 32. REMOVE POST INDICATOR VALVE.

DEMOLITION LEGEND

EXISTING BUILDING

APPROXIMATE LIMITS OF CONCRETE REMOVAL


APPROXIMATE LIMITS OF ASPHALT PAVEMENT REMOVAL


- st - st - EXISTING STORM LINE

- G G EXISTING GAS LINE
- w w EXISTING WATER LINE
 - EXISTING LIGHT POLE -Ö-
 - EXISTING SANITARY STRUCTURE
 - Ω EXISTING FIRE HYDRANT

APPROXIMATE LIMITS OF UTILITY LINE REMOVAL



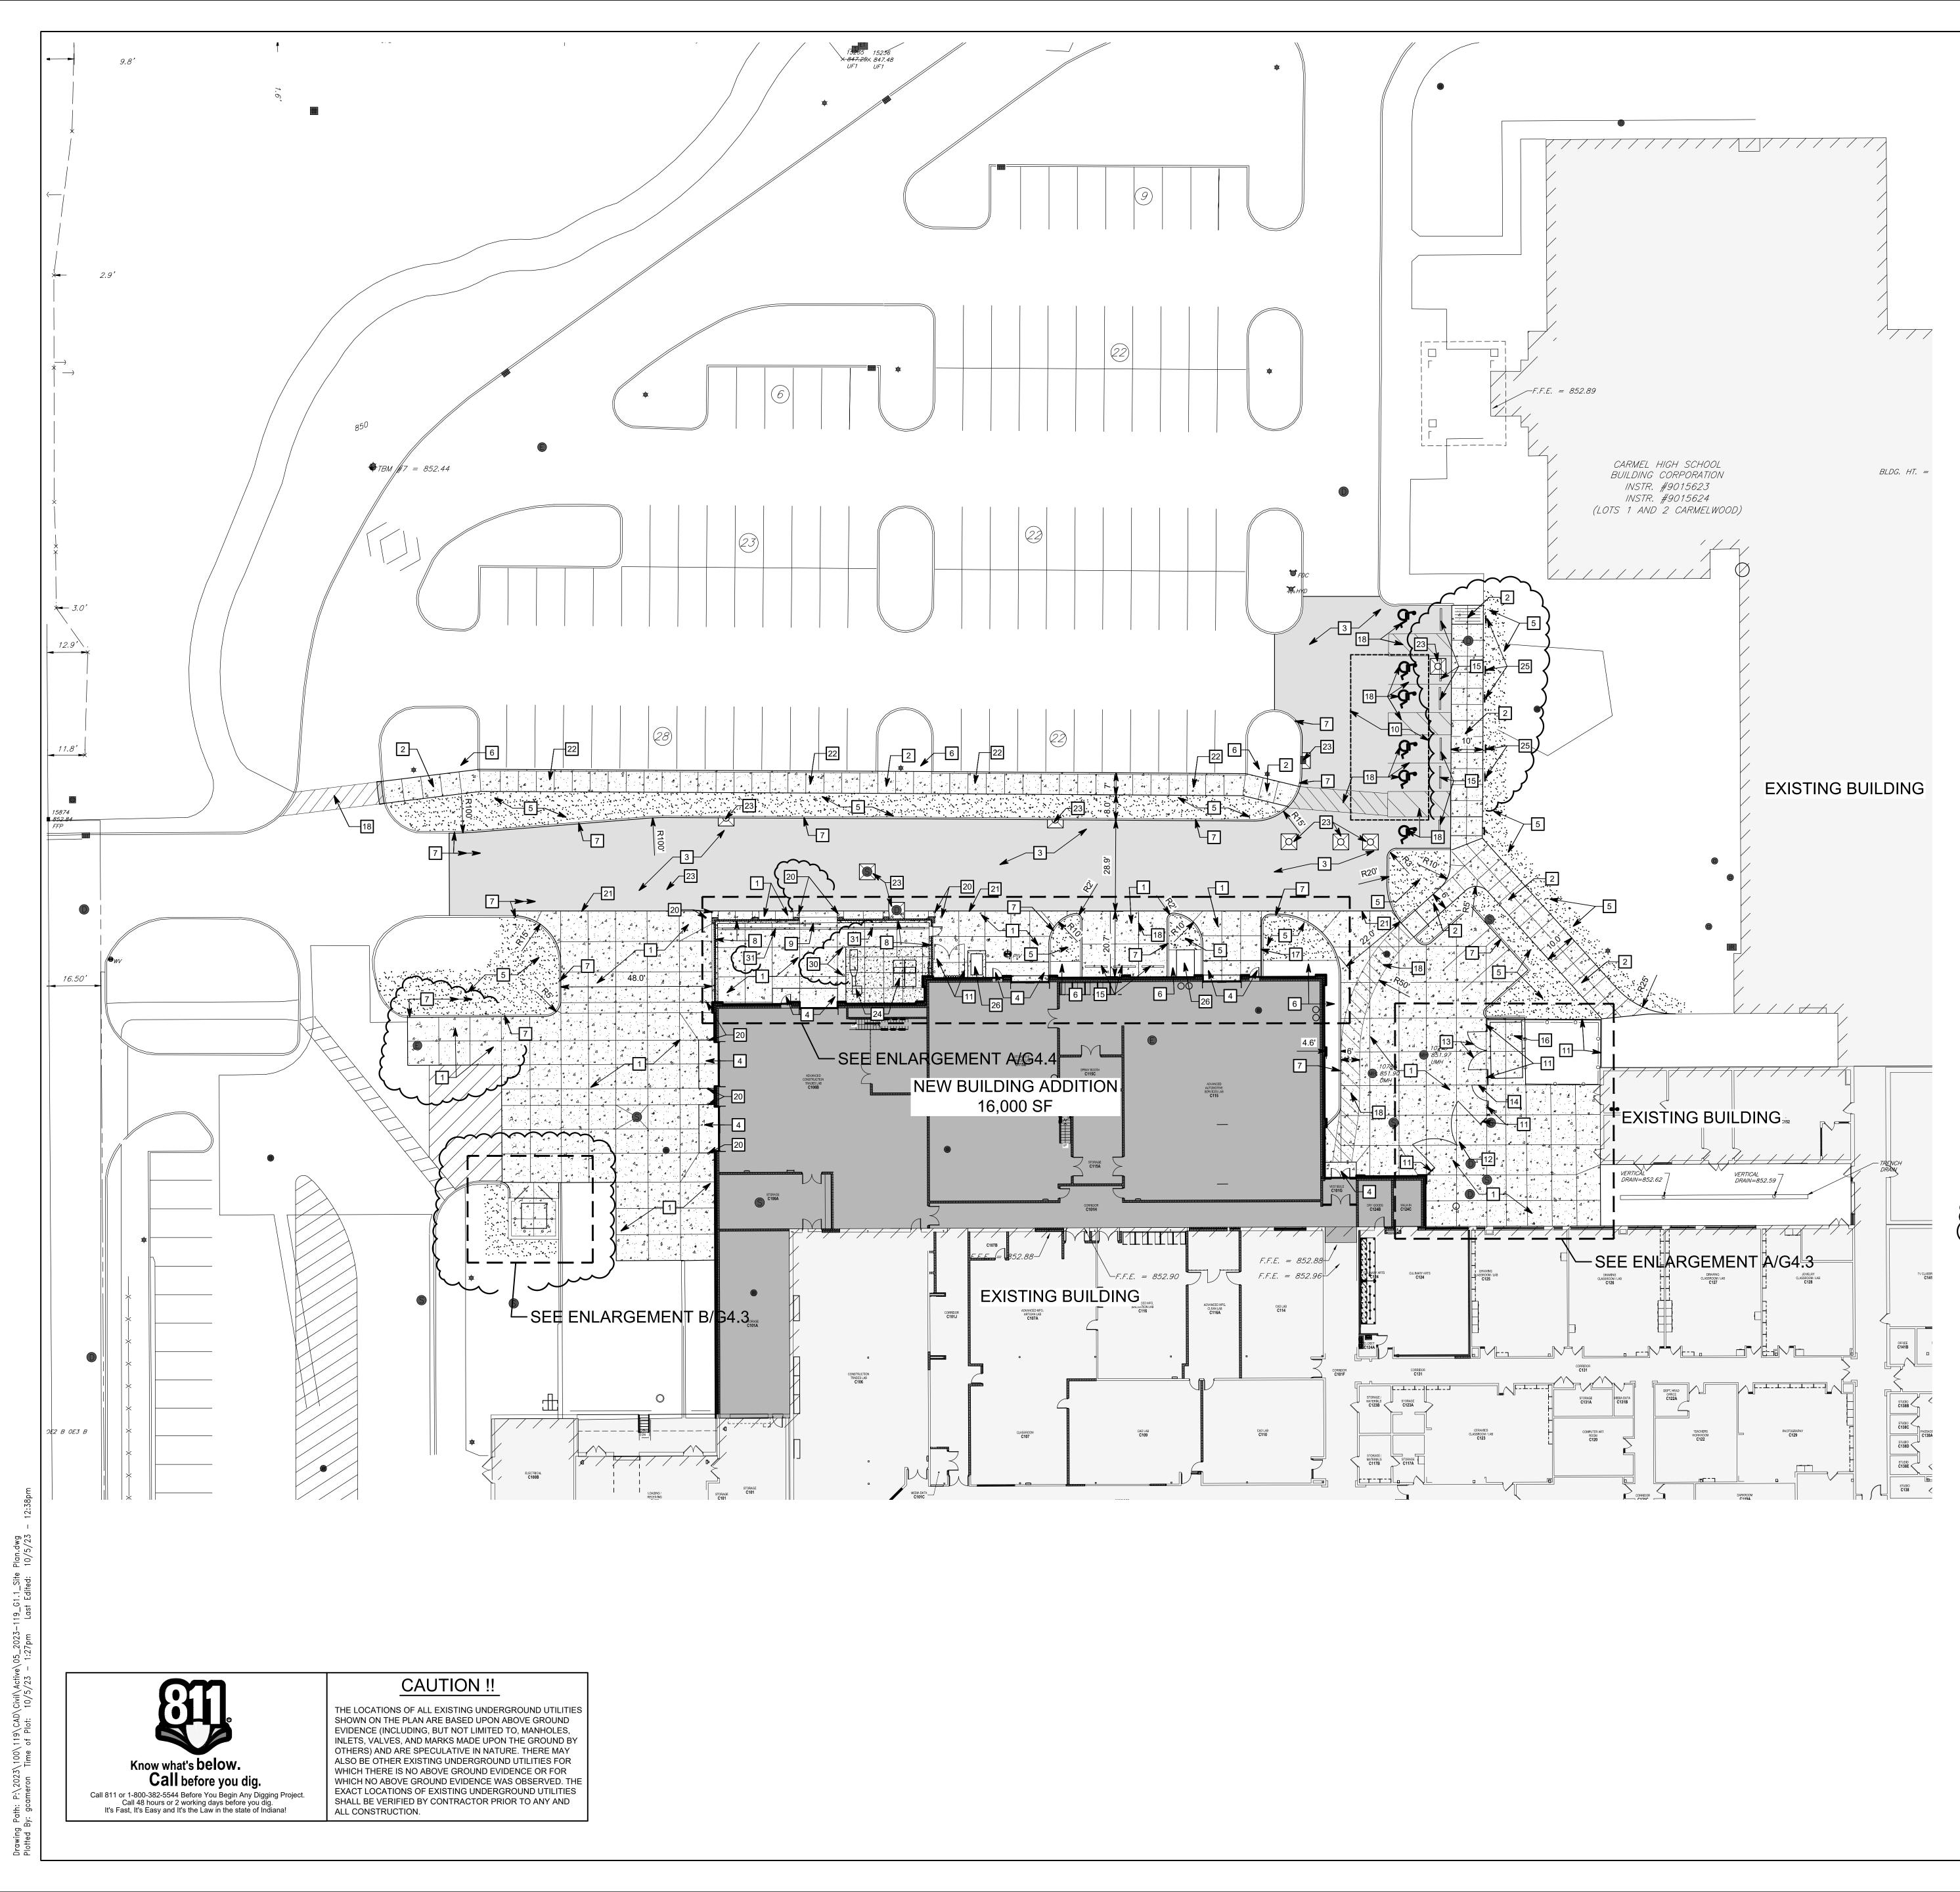

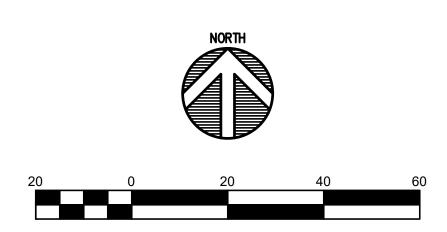

GENERAL NOTES

- 1. SEE DRAWING GD0.1 FOR GENERAL NOTES AND ADDITIONAL LEGEND.
- TOPOGRAPHIC CONDITIONS AND EXISTING UTILITIES SHOWN WERE PROVIDED BY CEC - CIVIL & ENVIRONMENTAL CONSULTANTS, INC DATED MAY 19, 2023. THE ENGINEER MAKES NO GUARANTEES THAT THE UNDERGROUND UTILITIES SHOWN COMPRISE ALL SUCH UTILITIES IN THE AREA, EITHER IN SERVICE OR ABANDONED.
- 3. CONTRACTOR SHALL VERIFY ALL EXISTING CONDITIONS IN THE PROJECT AREA INCLUDING UNDERGROUND UTILITY CONDITIONS, LOCATION AND DEPTH PRIOR TO ANY OTHER SITE CONSTRUCTION. REPORT ANY DISCREPANCIES TO THE ENGINEER.
- 4. SEE SHEET G1.2 FOR STRIPING AND SIGNAGE PLAN.
- 5. SEE SHEET G1.3 FOR CONCRETE JOINTING PLAN.

SITE KEYNOTES

- 1 CONCRETE PAVEMENT SEE DETAIL D/G4.1
- 2 CONCRETE SIDEWALK SEE DETAIL A/G4.1
- 3 ASPHALT PAVEMENT SEE DETAIL O/G4.1
- 4 CONCRETE STOOP SEE STRUCTURAL DRAWING
- 5 LAWN AREA SEE LANDSCAPE PLAN L1.0
- 6 SHREDDED HARDWOOD MULCH PLANTING BED SEE LANDSCAPE PLAN L1.0
- 7 CONCRETE CURB SEE DETAIL H/G4.1
- 8 EXTERIOR STORAGE MASONRY SCREEN WALL SEE ARCHITECTURAL PLANS
- 9 ROLLING GATE WITH CITY SCAPES TOUGHGATE (PVC VERTICAL PLANK INFILL SERIES MADISON STYLE) FOR A 12'-0" WIDE OPENING AND 8'-0" HEIGHT
- 10 UNDERGROUND STORMWATER DETENTION AREA - SEE DRAWING SU1.1 & SU2.1
- 8' HT. CITY SCAPES COVRIT SCREENWALL ENCLOSURE WITH VERTICAL PLANKS AND STANDARD STIFFENER, FENCE PANELS AND POSTS, DOUBLE SWING GATE
- 12 DOUBLE SWING GATE (TWO 10'-0" GATES) WITH CITY SCAPES TOUGHGATE (PVC VERTICAL PLANK INFILL SERIES - MADISON STYLE) 8'-0" HEIGHT
- 13 DOUBLE SWING GATE (2 - 6'-0" GATES) WITH CITY SCAPES - TOUGHGATE (PVC VERTICAL PLANK INFILL SERIES - MADISON STYLE) 8'-0" HEIGHT
- 5' WIDE SWING GATE WITH CITY SCAPES TOUGHGATE (PVC VERTICAL PLANK INFILL SERIES MADISON STYLE) 8'-0" HEIGHT WITH WEATHERPROOF PANIC
- HARDWARE MOUNTED TO DOOR
- 15 PRECAST PARKING BUMPER SEE DETAIL D/G4.2
- 16CONCRETE EQUIPMENT PAD (12' X 20') WITH ABOVE GROUM/G4.1 (REFER TO MEP PLANS FOR SIZE AND LOCATION) CONCRETE EQUIPMENT PAD (12' X 20') WITH ABOVE GROUND TANK - SEE DETAIL
- 17 ALUMINUM HANDRAIL SEE DETAIL E/G4.2
- 18PAVEMENT MARKING SEE STRIPING AND SIGNAGE PLAN G1.2
- 19 TRASH DUMPSTER ENCLOSURE - SEE ARCHITECTURAL PLANS & DWG 10/S3.01, PROVIDE TWO SWING GATES, CITY SCAPES - TOUGHGATE (PVC VERTICAL PLANK INFILL SERIES - MADISON STYLE)
- 20 STEEL BOLLARD PER DETAIL Q/G4.1
- 21 CONCRETE/ASPHALT INTERFACE DETAIL G/G4.1
- 22 MONOLITHIC CURB & WALK SEE DETAIL B/G4.1
- 23 CONCRETE COLLAR SEE DETAIL N/G4.1
- 24 CONCRETE EQUIPMENT PAD (±25'-0" X ±20'-0") FOR DUST COLLECTOR AND WELDING EXHAUST SEE DETAIL M/G4.1 (COORDINATE WITH MEP PLANS FOR SIZE AND
- LOCATION) 25 ADA PARKING SIGN - SEE STRIPING AND SIGNAGE PLAN G1.2
- 26 OIL CONTAINMENT TANK, CONCRETE PIT AND CANOPY, SEE SHEET G4.2 FOR ADDITIONAL LAYOUT INFORMATION AND STRUCTURAL DETAIL XX/S5.X
- 7] TAPER CURB FROM 6" TO 1"
- 6" PIPE BOLLARD SEE DETAIL 1/G4.1
- 31 NEW TRENCH DRAIN SEE DETAIL ON SHEET SU2.1
- m

PROPOSED SITE LEGEND

- EXISTING BUILDING
- PROPOSED BUILDING ADDITION
- PROPOSED CONCRETE PAVEMENT/SIDEWALK
- PROPOSED ASPHALT PAVEMENT
- PROPOSED LAWN AREA
- EXISTING LIGHT POLE
- EXISTING STORM STRUCTURE $\cap \blacksquare$ EXISTING SANITARY STRUCTURE
 - EXISTING FIRE HYDRANT
- PROPOSED STORM STRUCTURE 0 🛛


S


PROPOSED SANITARY STRUCTURE

PARKING SUMMARY		
PARKING SPACES REMOVED	34	
NEW PARKING SPACES	6	
NET LOSS	28	


HARD SURFA	CE

HARD SURFACE ADDED 2,355 SF

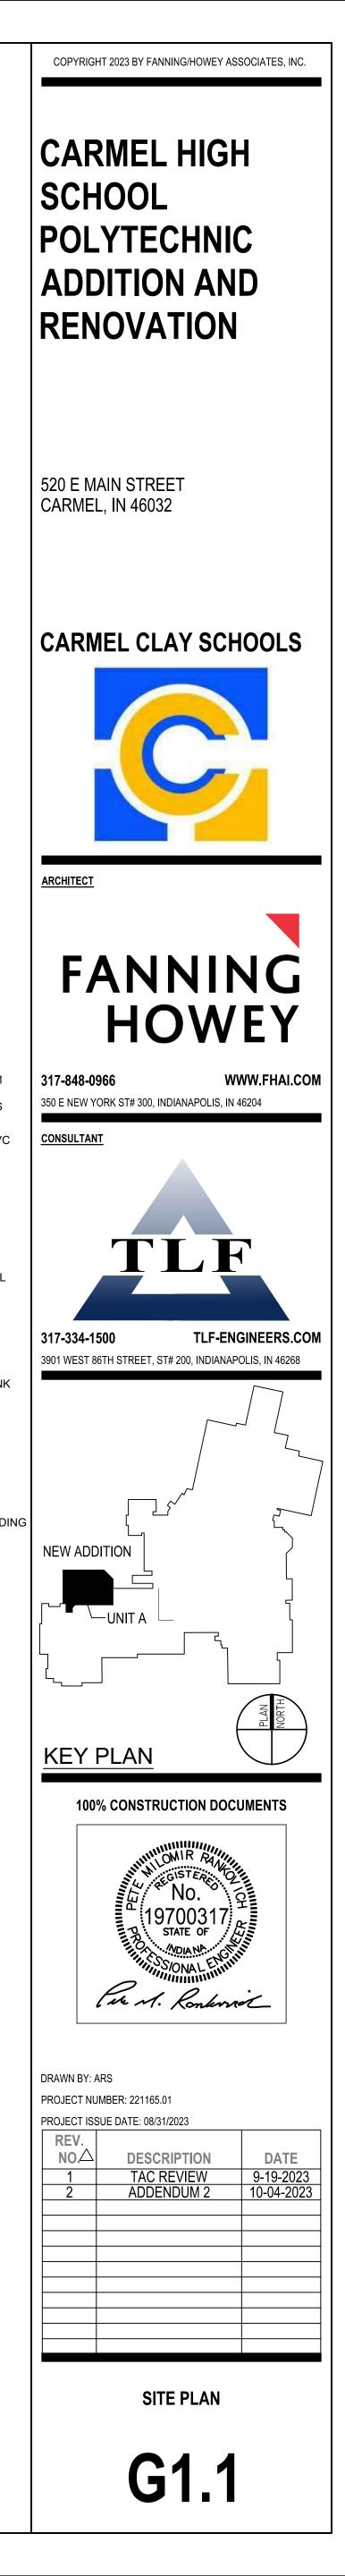

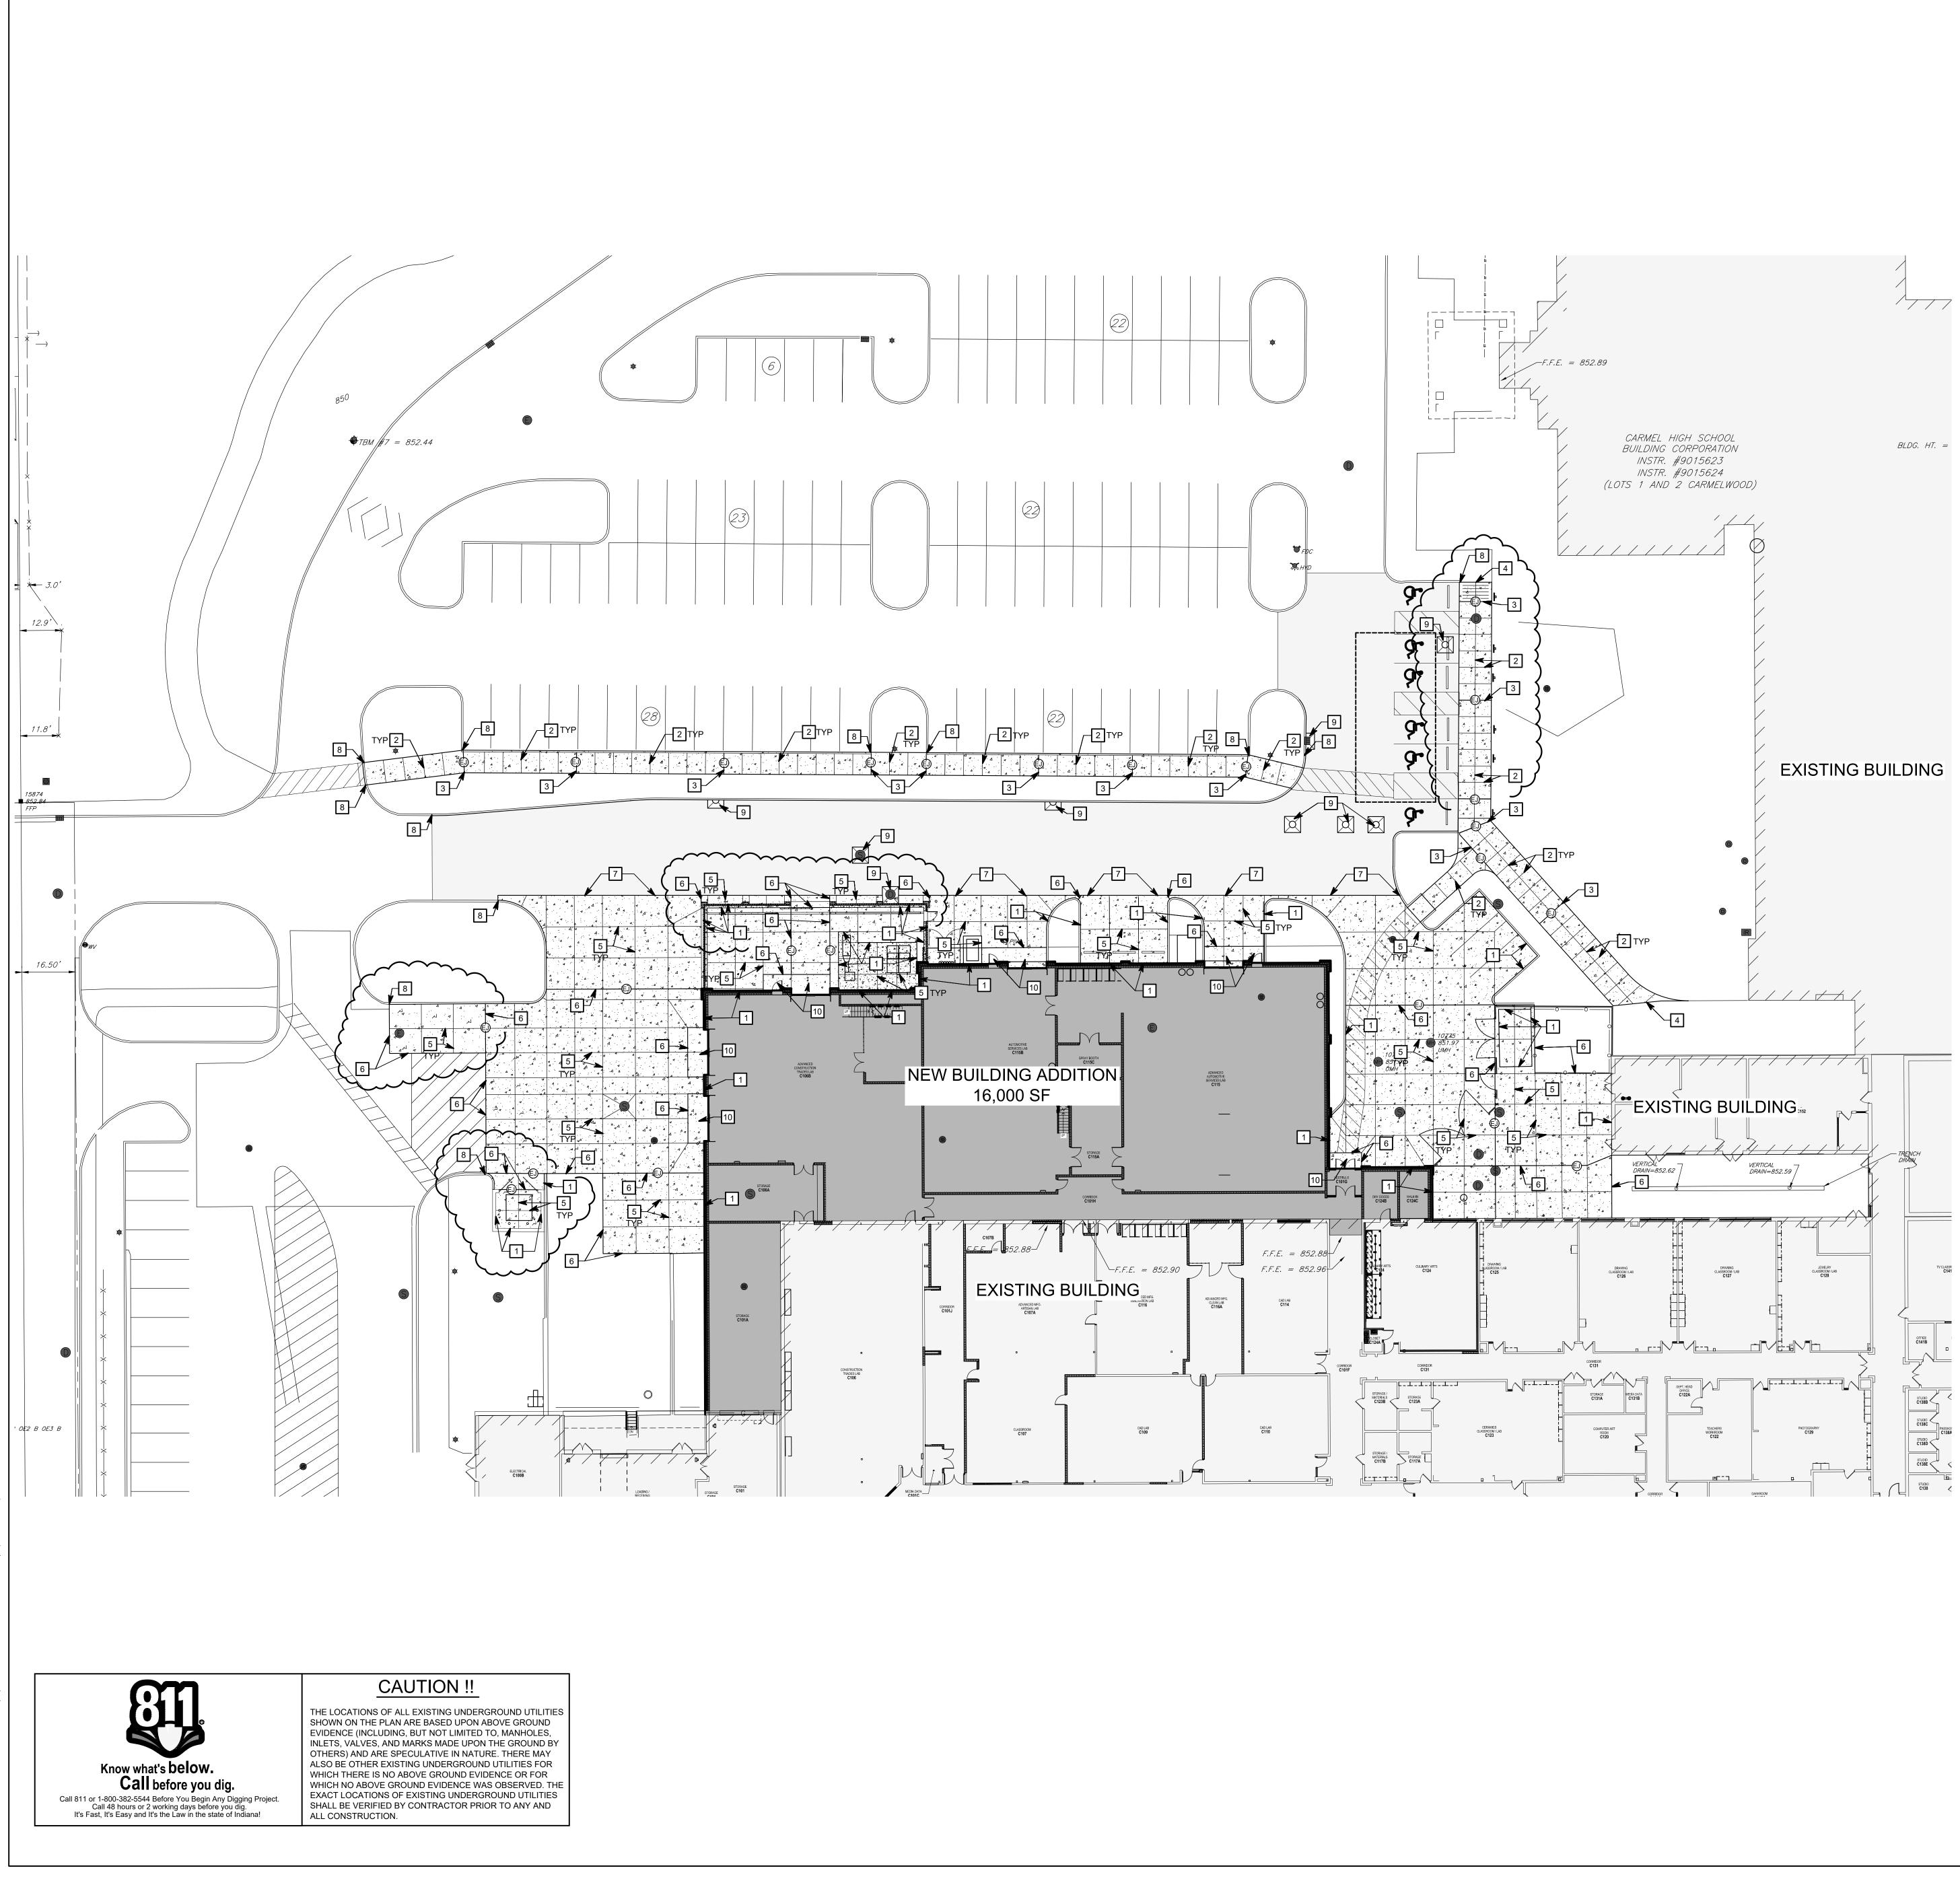

/ing Path: P:\2023\100\119\CAD\Civil\Active\07_2023-119_G1.3_Concrete Jointing Plan.d\ ed By: asheller Time of Plot: 10/4/23 - 10:48am Last Edited: 10/3/23 - 4:16pm

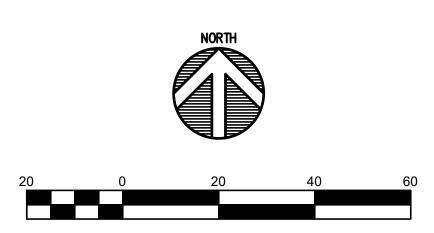

GENERAL NOTES


- 1. SEE DRAWING GD0.1 FOR GENERAL NOTES AND ADDITIONAL LEGEND.
- 2. TOPOGRAPHIC CONDITIONS AND EXISTING UTILITIES SHOWN WERE PROVIDED BY CEC - CIVIL & ENVIRONMENTAL CONSULTANTS, INC DATED MAY 19, 2023. THE ENGINEER MAKES NO GUARANTEES THAT THE UNDERGROUND UTILITIES SHOWN COMPRISE ALL SUCH UTILITIES IN THE AREA, EITHER IN SERVICE OR ABANDONED.
- 3. CONTRACTOR SHALL VERIFY ALL EXISTING CONDITIONS IN THE PROJECT AREA INCLUDING UNDERGROUND UTILITY CONDITIONS, LOCATION AND DEPTH PRIOR TO ANY OTHER SITE CONSTRUCTION. REPORT ANY DISCREPANCIES TO THE ENGINEER.

SITE KEYNOTES

- 1 ISOLATION JOINT SEE DETAIL L/G4.1
- 2 SIDEWALK CONTROL JOINT SEE DETAIL C/G4.1
- 3 SIDEWALK EXPANSION JOINT SEE DETAIL C/G4.1
- 4 NEW SIDEWALK TO EXISTING SIDEWALK CONNECTION SEE DETAIL F/G4.1
- 5 CONCRETE PAVEMENT CONTROL JOINT SEE DETAIL E/G4.1
- 6 CONCRETE PAVEMENT EXPANSION JOINT SEE DETAIL E/G4.1
- 7 ASPHALT PAVEMENT/CONCRETE PAVEMENT INTERFACE PER DETAIL G/4.1
- 8 CONCRETE CURB CONNECTION TO EXISTING CURB SEE DETAIL K/G4.1
- 9 CONCRETE COLLAR SEE DETAIL N/G4.1
- 10 CONCRETE STOOP/APRON SEE STRUCTURAL DRAWING

PROPOSED SITE LEGEND

EXISTING BUILDING

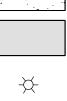





PROPOSED BUILDING ADDITION

PROPOSED ASPHALT PAVEMENT

- EXISTING LIGHT POLE
- EXISTING STORM STRUCTURE
- EXISTING SANITARY STRUCTURE
- EXISTING FIRE HYDRANT
- PROPOSED STORM STRUCTURE
- PROPOSED SANITARY STRUCTURE
- EXPANSION JOINT

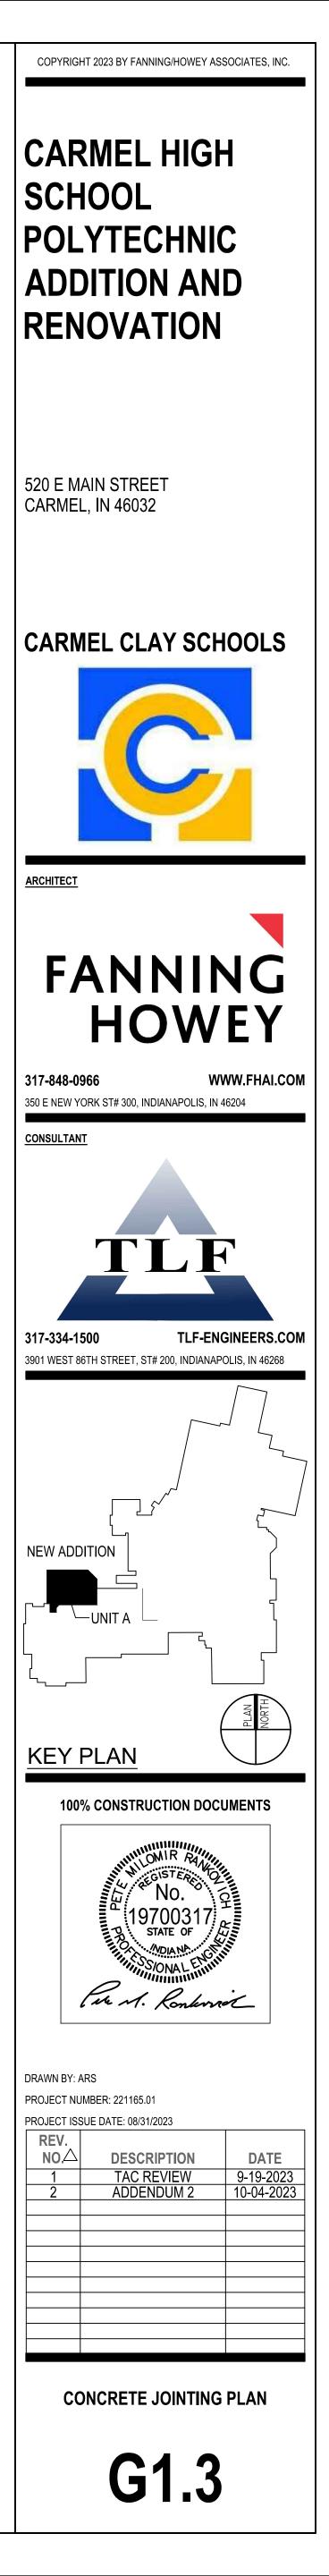

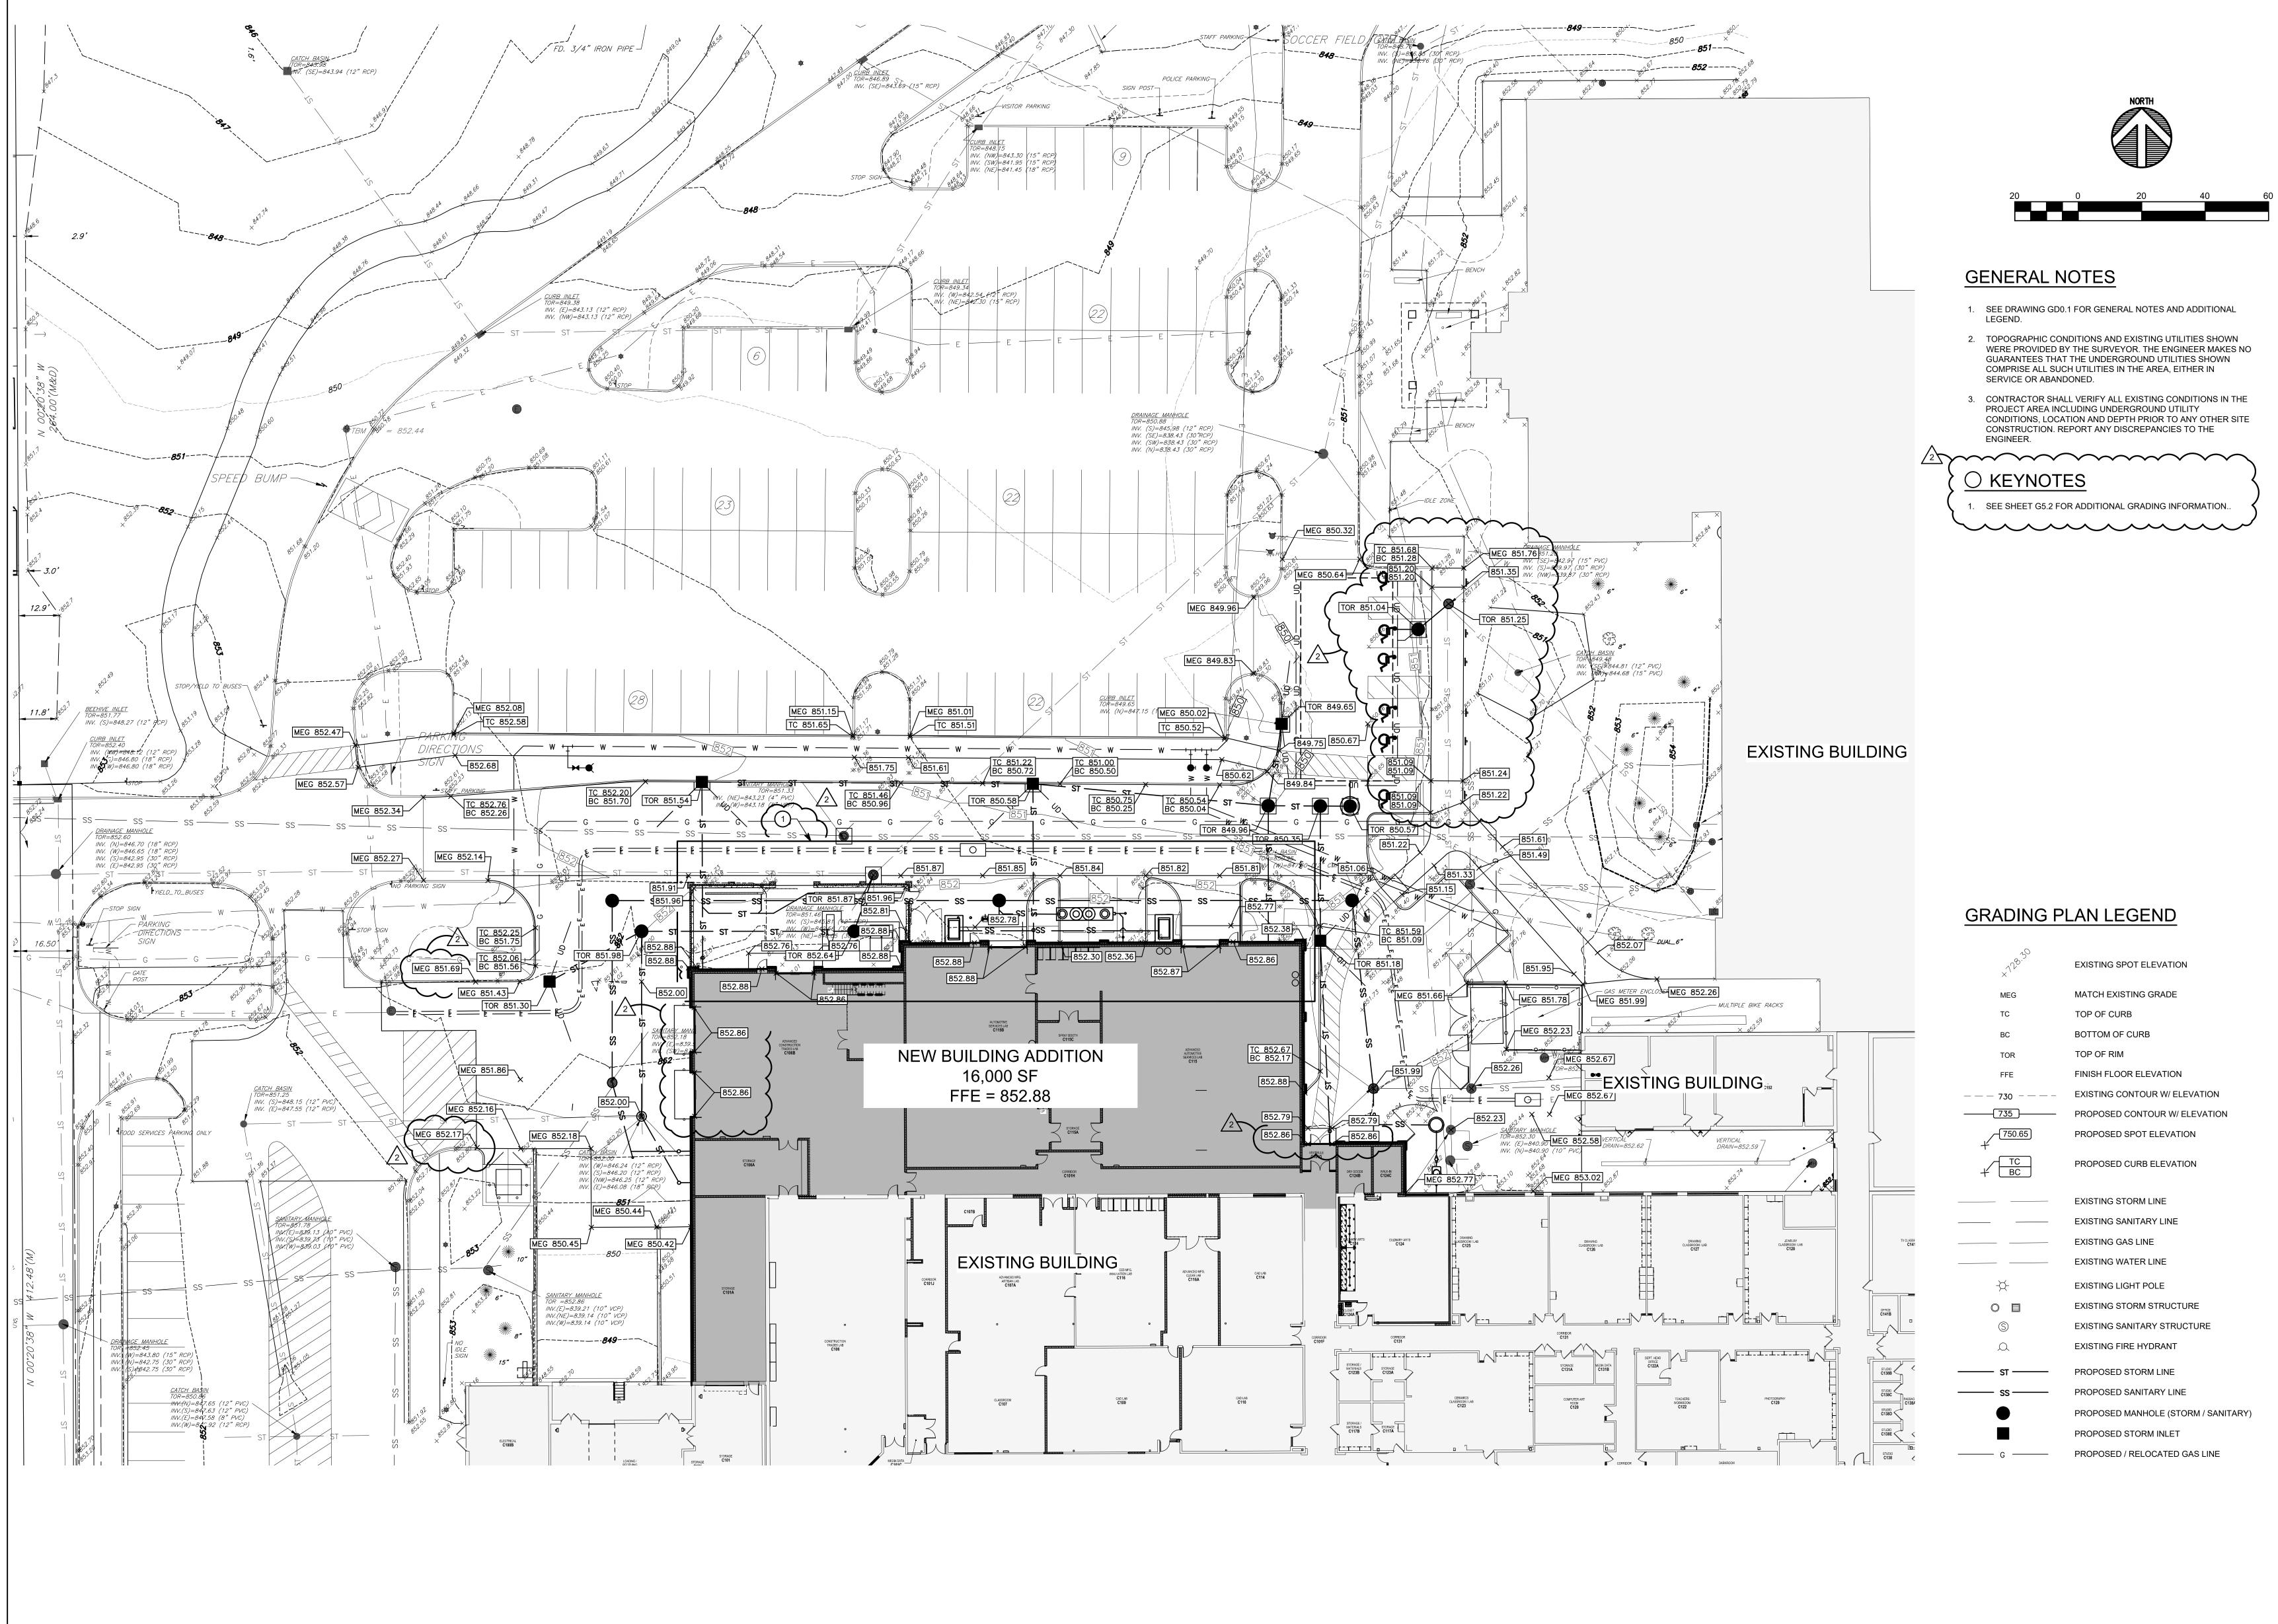




It's Fast, It's Easy and It's the Law in the state of Indiana!

CAUTION !!

SHOWN ON THE PLAN ARE BASED UPON ABOVE GROUND EVIDENCE (INCLUDING, BUT NOT LIMITED TO, MANHOLES, INLETS, VALVES, AND MARKS MADE UPON THE GROUND BY OTHERS) AND ARE SPECULATIVE IN NATURE. THERE MAY ALSO BE OTHER EXISTING UNDERGROUND UTILITIES FOR WHICH THERE IS NO ABOVE GROUND EVIDENCE OR FOR WHICH NO ABOVE GROUND EVIDENCE WAS OBSERVED. THE EXACT LOCATIONS OF EXISTING UNDERGROUND UTILITIES SHALL BE VERIFIED BY CONTRACTOR PRIOR TO ANY AND ALL CONSTRUCTION.

THE LOCATIONS OF ALL EXISTING UNDERGROUND UTILITIES

/ing Path: P:\2023\100\119\CAD\Civil\Active\08_2023-119_G2.1_Grading Plan.dwg ed By: gcameron Time of Plot: 10/4/23 - 12:09pm Last Edited: 10/4/23 - 9:4

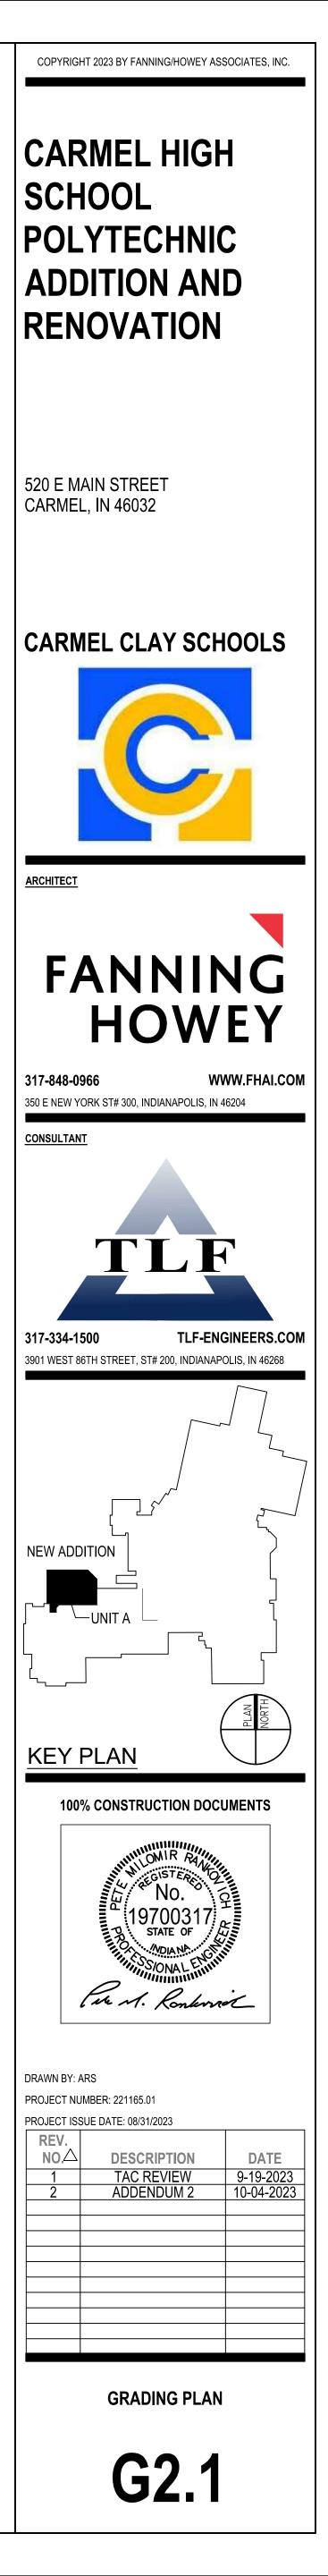

	AN INDEX			SESSME CTION A	NT OF CONST	RUCTION PLA
A1 PL	AN INDEX - SWPP PLAN SHEET		A2	VICINITY M		
A3 PF	CINITY MAP - SWPP PLAN SHEET ROJECT NARRATIVE - SWPP PLAN SHEET				' MAP IS LOCATED ON THI JTH OF AUDUBON DR. IN ⁻ ST.	
A5 LE	TITUDES AND LONGITUDE - SWPP PLAN SHEET GAL DESCRIPTION - SEE SURVEY SHEETS "X17" PLAN - SEPARATE DOCUMENT		A3		IARRATIVE	
A7 BC	OUNDARIES 100 YEAR FLOODPLAINS, FLOODWAY FRINGES AND OODWAYS - SURVEY SHEETS			THE EXISTING	G BUILDING, REVISIONS T INFRASTRUCTURE REVIS	O AN EXISTING ASPHAL
A9 IDI	DJACENT LAND USE - SWPP PLAN SHEET ENTIFICATION OF U.S. EPA APPROVED OR ESTABLISHED TMDL		A4		AND LONGITUDE 39° 58' 47.69"; LONGITUDE	W 86° 07' 10.00"
A11 IDI	ECEIVING WATERS ENTIFICATION OF DISCHARGES TO WATER ON 303(d) LIST		A5		CRIPTION T PROPERTY IS LOCATED	
A13 W	DIL MAP AND SOIL DESCRIPTION - SWPP PLAN SHEET ETLANDS, LAKES AND WATER COURSES - EROSION CONTROL PLANS TATE AND FEDERAL WQ PERMITS - NONE REQUIRED AT THIS TIME				L CAMPUS. (LEGAL DESCI	
A15 EX	ATE AND TEDERAL WAT EXAMINE THONE REQUIRED AT THIS TIME (ISTING VEGETATIVE COVER - SITE SURVEY SHEETS (ISTING SITE TOPOGRAPHY - SITE SURVEY SHEETS		A6	11 x 17 INCI REFER TO SI		
	ORMWATER DISCHARGE ENTERING SITE - GRADING PLANS ORMWATER DISCHARGE LEAVING SITE - GRADING PLANS		A7		ES OF 100 YEAR FLOO	DPLAINS, FLOODWA
A20 EX	CATION OF EXISTING STRUCTURES - SITE SURVEY PLANS			FLOODWAY	AINS, FLOODWAY FRINGE	S OR FLOODWAYS ARE
A21 ST	TE SURVEY SHEETS FORMWATER DISCHARGE TO GROUNDWATER - GRADING PLANS ROJECT AREA - SWPP PLAND AND SITE PLANS		A8	ADJACENT ADJACENT LA	LAND USE AND USE IS RESIDENTIAL	ON ALL SIDES.
A23 DI	STURBED AREA - EROSION CONTROL PLANS ROPOSED FINAL TOPOGRAPHY -GRADING PLANS		A9		TION OF U.S. EPA APF	
	CATION OF BOUNDARIES OF DISTURBED AREAS - EROSION CONTROL ANS		A10		WATERS NG WATER IS COOL CREE	
A27 LC	OCATION OF STORMWATER DRAINAGE SYSTEM - SITE UTILITY PLANS OCATION OF STORMWATER AND NON-STORMWATER DISCHARGE			ROW ROAD.		
A28 LC	OCATIONS - GRADING PLANS OCATION OF SITE IMPROVEMENTS - SITE PLANS OIL STOCKPILES - EROSION CONTROL PLANS		A11		TION OF DISCHARGES	
A30 CC	DNSTRUCTION SUPPORT ACTIVITIES - SWPP PLAN DCATION OF IN-STREAM ACTIVITIES - NONE		A12		AND SOIL DESCRIPTION	
-	DROLOGIC UNIT CODE - SWPP PLAN CONSTRUCTION AND POST CONSTRUCTION DISCHARGE -		A13	WETLANDS	, LAKES AND WATER	COURSES
	VPP PLAN			PROJECT SIT		
	DTENTIAL POLLUTION SOURCES - SWPP SHEET		A14	A CONSTRUC)/OR FEDERAL WATER CTION GENERAL STORMW ARTMENT OF ENVIRONME	ATER PERMIT WILL BE N
B2 CC	ONSTRUCTION ENTRANCE - EROSION CONTROL PLANS EMPORARY SURFACE STABILIZATION - EROSION CONTROL PLANS		A15	EXISTING V	EGETATIVE COVER	
FL	EDIMENT CONTROL MEASURES FOR CONCENTRATED OW - EROSION CONTROL PLANS				G SITE VEGETATION MAIN LAWN AREAS.	LY CONSISTS OF LANDS
FL	EDIMENT CONTROL MEASURES FOR SHEET OW - EROSION CONTROL PLANS		A16	THE EXISTING	SITE TOPOGRAPHY G SITE TOPOGRAPHY CAN SLOPES FROM SOUTH TO	
B7 ST	JNOFF CONTROL MEASURES - EROSION CONTROL PLANS FORM WATER OUTLET PROTECTION - EROSION CONTROL PLANS RADE STABILIZATION STRUCTURES - NONE		A17	STORMWA	TER DISCHARGE ENTE	RING SITE
B9 DE	EWATERING MANAGEMENT - EROSION CONTROL DETAIL SHEET EASURES IN WATERBODIES - NONE		A18		R DISCHARGE DOES NOT	
SV	ORMWATER QUALITY MEASURES MAINTENANCE GUIDELINES			STORMWATE	R DISCHARGE WILL LEAV AND PROPOSED STORM	E THE SITE VIA A STORI
B13 SE	ROSION AND SEDIMENT CONTROL MEASURES BUILDING LOTS - NONE EQUENCE OF STORM WATER QUALITY MEASURES - SWPP SHEET ATERIAL HANDLING AND SPILL PREVENTION - SWPP SHEET		A19		OF EXISTING STRUCT	
	ATERIAL HANDLING AND STORAGE PROCEDURES - SWPP SHEET		A20		F ALL EXISTING STRUCTU	
	VATER POLLUTION PREVENTION - POST CONSTRUCTION				NO EXISTING RETENTION M OF THE PROJECT SITE.	
SV	OTENTIAL POLLUTANTS ASSOCIATED WITH PROPOSE LAND USE VPP SHEET ROPOSED POST CONSTRUCTION STORM WATER QUALITY MEASURES		A21	THERE ARE N	TER DIRECT DISCHAR	SINKHOLES OR DRYWE
SV	VPP SHEET AN DETAIL FOR STORMWATER MEASURES - EROSION CONTROL	1	A22	PROJECT A		
PL	ANS DCATION, DIMENSION, SPECIFICATIONS AND DETAILS OF EACH	_ {		THE TOTAL P	ROJECT SITE AREA IS 1.8 N CONTROL PLANS	8± ACRES. THE PROJEC
	ORMWATER QUALITY MEASURE - EROSION CONTROL PLANS	2	A23	DISTURBED	O AREA DF DISTURBED AREA IS TO	BE 1.24± ACRES.
	JALITY MEASURES - SWPP SHEET		A24	PROPOSED	FINAL TOPOGRAPHY	
			A25	LOCATION	OF BOUNDARIES OF D	ISTURBED AREAS
GENERA	L EROSION CONTROL REQUIREMENT NOTES		A26		AREAS ARE NOTED ON TH	
THE	SONNEL ASSOCIATED WITH THE PROJECT MUST BE INFORMED OF TERMS AND CONDITIONS OF A CONSTRUCTION STORMWATER				R SYSTEMS ARE LOCATE	D ON THE WEST AND N
STOF	ERAL PERMIT (CGSP), THE REQUIREMENTS WITHIN THE RMWATER POLLUTION PREVENTION PLAN (SWP3) AND THE JIREMENTS OF THE EROSION CONTROL PLAN . THE PERMITTEE IS		A27	LOCATIONS		
NOT	JIRED TO DOCUMENT THIS PROCESS. PERSONNEL INCLUDE BUT ARE LIMITED TO: GENERAL CONTRACTORS, CONSTRUCTION				R COLLECTED BY STORM	
SUPF	AGEMENT FIRMS, GRADING/EXCAVATING CONTRACTORS, CONCRETE PLIERS, SWP3 RESPONSIBLE PERSONS AND THOSE RESPONSIBLE ADMINISTERING THE SELF-MONITORING PROGRAM (SMP).		A28		OF SITE IMPROVEMEN	
2. ADDI	TIONAL EROSION AND SEDIMENT CONTROL MEASURES AS DEEMED				HE SITE UTILITY PLANS. N	
NECE	ESSARY MAY BE REQUIRED BY IDEM OR THE CITY INSPECTOR.		A29		CKPILES WILL BE CREATE	
				APPROVED S		
CONSTR	UCTION SOLID WASTE MANAGEMENT		A30		CTION SUPPORT ACTIN EA FOR CONSTRUCTION L T AREA.	
DAILY	IDE CONTINUOUS SITE MONITORING AND CLEANUP. COLLECT TRASH ON A BASIS. PROVIDE AS MANY WASTE BINS AS NEEDED TO KEEP SITE CLEAN OF		A31	LOCATION OF	F IN-STREAM ACTIVITIES M ACTIVITY WILL BE USEI	
	R AND WASTE. DURING EXTENDED PERIODS OF RAINFALL, WASTE BINS MUST OVERED.		A32	HYDROLOGIC	C UNIT CODE	
BE PR	E MATERIALS RESULTING FROM THE CONSTRUCTION AND DEMOLITION SHALL COMPTLY REMOVED FROM THE SITE BY THE CONTRACTOR. WHEN		(A33	PRE-CONSTR	OGIC UNIT CODE FOR TH	TRUCTION PEAK DISCH
MATE	SSARY TO STORE CONSTRUCTION AND DEMOLITION DEBRIS ONSITE, THE RIALS SHALL BE CONCEALED IN COVERED DUMPSTERS OR STOCKPILED AND		CL_	Q PRE (10YR.	.) = 7.20 cfs Q POST (10 `	YR.) = 4.13 cfs
INLET	RED. LOCATE STOCK PILES SUFFICIENTLY FAR AWAY FROM DRAINAGE S (50 FT MINIMUM SEPARATION).					
	EGATE AND RECYCLE WASTE MATERIALS WHEN APPROPRIATE.		SHF	EET REFER	ENCE	
	NGE FOR REGULAR WASTE COLLECTION BY LICENSED TRASH HAULER.			PO (1 OF1)	TOPOGRAPH	
6. COMP	PLY WITH ALL STATE AND LOCAL SOLID WASTE DISPOSAL AND NUISANCE		G1.	. ,	SITE PLAN	
	IREMENTS.		G2.	1	GRADING PL	AN
	GEMENT PRACTICES.		G3.:		EROSION CO	NTROL PLAN
SANITAR	Y WASTE MANAGEMENT		G3.	-	SWPP PLAN	
	OT PLACE TEMPORARY FACILITIES (PORT-O-LETS) ON PAVED AREAS. LOCATE ORARY FACILITIES AT LEAST 50 FEET FROM STORM DRAINAGE INLETS.		G3.4 SU1		EROSION CO UTILITY PLAI	NTROL DETAILS
	EATED RAW WASTEWATER MAY NOT BE DISCHARGED TO LAND, THE STORM		SU2			
	I SYSTEM OR TO SURFACE WATER BODIES.		$\overline{}$			
	ARY/SEPTIC FACILITIES SHOULD BE MAINTAINED IN GOOD WORKING ORDER ICENSED SERVICE PROVIDER.					
4. ARRA	NGE REGULAR WASTE COLLECTION BY A LICENSED HAULER.					
		Г				
	\frown		1	Map Uni	t Legend	
			Mar YclA	o Unit Symbol	Map Unit Name Crosby silt loam, fine-loamy	Acres in AOI
			YmsB2		subsoil-Urban land complex, 0 to 2 percent slopes	3.
and	CALL BEFORE YOU DIG.				complex, 2 to 6 percent slopes, eroded	-
Call 811	or 800-382-5544 Before you Dig!		Totals for	Area of Interest		5.

Call 48 hours or 2 working days before you dig. It's Fast, It's Easy and It's the Law in the state of Indiana!


NSTRUCTION PLAN ELE	EMENT	s	ST DU
ON THIS SHEET. THE PROJECT LIES EA DR. IN THE CITY OF CARMEL - PROPERT			B1
CONSTRUCTION OF A NEW ADDITION, RI IONS TO AN EXISTING ASPHALT PARKIN E REVISIONS.			
GITUDE W 86° 07' 10.00"			B2
CATED IN HAMILTON COUNTY INDIANA DESCRIPTION UNDER SEPERATE COVI		RMEL	В3
			B4
FLOODPLAINS, FLOODWAY FRING		SITE	
ENTIAL ON ALL SIDES. PA APPROVED OR ESTABLISHED T	MDL		B5 B6
AN ESTABLISHED TMDL	E OF SMOK	EY	
ARGES TO WATER ON 303(d) LIST			B7
CRIPTION			B8
ATER COURSES KES OR WATER COURSES LOCATED WIT			B9
VATER QUALITY PERMITS ORMWATER PERMIT WILL BE NEEDED F RONMENTAL MANAGEMENT	ROM THE		B10
VER N MAINLY CONSISTS OF LANDSCAPE PL	ANTING AN	٧D	B11
HY HY CAN BE FOUND ON THE SITE SURVE JTH TO NORTH.	Y. THE SITI	E	
E ENTERING SITE ES NOT ENTER THE PROJECT SITE.			
E LEAVING SITE L LEAVE THE SITE VIA A STORM SYSTEI STORM PIPES AND STRUCTURES.	M COMPRIS	SED	
RUCTURES RUCTURES CAN BE FOUND ON THE SUF	VEY SHEE	TS.	B12 B13
TENTION / DETENTION FACILITIES NTION OR DETENTION FACILITIES LOCA T SITE.			БТЗ
CHARGE TO GROUNDWATER VELLS, SINKHOLES OR DRYWELLS CURF THE PROJECT SITE.	RENTLY		
A IS 1.88± ACRES. THE PROJECT AREA IS	S DEPICTEI	DON	
A IS TO BE 1.24± ACRES.			B14
ED ON THE GRADING PLANS.			
ON THE EROSION CONTROL PLAN.			
OCATED ON THE WEST AND NORTH SID ANS. ER AND NON-STORMWATER DISCH			B15
STORM STRUCTURES AND UNDERGROU RTH TO COOL CREEK. SEE SITE UTILITY	JND PIPES		
/EMENTS OUND ON THE SITE PLANS. SITE UTILITI ANS. NO OFFSITE IMPROVEMENTS ARE			
CREATED AS PART OF THIS PROJECT. REMOVED FROM SITE AND DISPOSED OI	F AT AN		(II P
ACTIVITIES	NORTH SID	E OF	PI
/ITIES SE USED ON THIS PROJECT			
FOR THIS PROJECT IS: 05120201090030	<u>}</u>		
ST (10 YR.) = 4.13 cfs	·		
	ſ	EROSION CO	
RAPHIC SURVEY		RESPONSIBI CONTACT IN CONTACT:	
AN		CONTACT: xxxx xxxx xxxx	
IG PLAN		xxxx xxxx	
ON CONTROL PLAN PLAN		xxxx EMAIL:	
		xxxxxxx Ph. No: xxx-xxx	-xxxx

	ORMWATER POLLUTION PREVENTION - RING CONSTRUCTION - SECTION B
1	POTENTIAL POLLUTANT SOURCES ASSOCIATED WITH CONSTRUCTION ACTVITIES THERE IS A POTENTIAL FOR POLLUTANTS ASSOCIATED WITH CONSTRUCTION MACHINERY INCLUDING DIESEL FUEL, HYDRAULIC FLUID, ENGINE OILS AND LUBRICANTS, ANTIFREEZE AND OTHER PETROLEUM PRODUCTS. SOIL AND SEDIMENT DISTURBED DURING EARTHWORK ACTIVITIES COULD BE BECOME POLLUTANTS IF THE TRANSPORT OF THESE MATERIALS BY WIND AND/OR WATER IS NOT MEDIATED BY EROSION CONTROL MEASURES. CONSTRUCTION VEHICLES NEED TO BE INSPECTED DAILY. CONTRACTOR SHALL HAVE SPILL CONTAINMENT TRAYS ALONG WITH A UNIVERSAL SPILL KIT ONSITE. ANY SPILL SHALL BE ADDRESSED IMMEDIATELY. CONTAMINATED SOIL / STONE SHALL BE REMOVED.
2	CONSTRUCTION ENTRANCE THE CONSTRUCTION ENTRANCE SHALL BE LOCATED AT THE ENTRANCE TO THE PROJECT. THE PLANNED LOCATION CAN BE FOUND ON THE EROSION CONTROL PLAN.
3	TEMPORARY SURFACE STABILIZATION TEMPORARY SURFACE STABILIZATION IS REQUIRED WHEN DISTURBED AREAS ARE EXPECTED TO REMAIN INACTIVE FOR A PERIOD EXCEEDING 7 DAYS. THESE AREAS ARE PLANNED FOR TEMPORARY SEEDING ACCORDING TO THE SEEDING TABLE PROVIDED ON THE EROSION CONTROL DETAIL SHEET.MULCH AND STONE MAY BE USED AS WELL TO STABILIZE BARE SOIL. STABILIZATION MUST BE COMPLETED 14 DAYS AFTER INITIATION.
4	SEDIMENT CONTROL MEASURES FOR CONCENTRATED FLOW EROSION CONTROL BLANKET SERVES AS CONCENTRATED FLOW SEDIMENT CONTROL MEASURES.THESE MEASURES ARE SHOWN ON THE EROSION CONTROL PLANS. DETAILS CAN BE FOUND ON THE EROSION CONTROL PLAN.
5	SEDIMENT CONTROL MEASURES FOR SHEET FLOW SILT FENCE SEDIMENT CONTROL MEASURES ARE SHOWN ON THE EROSION CONTROL PLANS. DETAILS CAN BE FOUND ON THE EROSION CONTROL PLAN.
6	RUNOFF CONTROL MEASURES RUNOFF CONTROL MEASURES INCLUDE SILT FENCE WHICH IS SHOWN ON THE EROSION CONTROL PLANS. DETAILS CAN BE FOUND ON THE EROSION CONTROL PLAN.
7	STORMWATER OUTLET PROTECTION STORM WATER OUTLETS ALL DISCHARGE DIRECTLY TO NEW STORM SEWER STRUCTURES. OUTLETS ARE SHOWN ON THE EROSION CONTROL PLANS.
8	GRADE STABILIZATION STRUCTURES RIP RAP APRONS AT OUTLETS WILL BE UTILIZED TO PREVENT GRADE DESTABILIZATION. SEE EROSION CONTROL PLANS FOR LOCATIONS. DETAILS CAN BE FOUND ON THE EROSION CONTROL PLANS.
)	DEWATERING MANAGEMENT SHOULD DEWATERING BE NECESSARY, WATER SHALL BE DIRECTED TO A SEDIMENT BASIN OR SEDIMENT TRAP PRIOR TO DISCHARGE. DEWATERING BAGS MAY ALSO BE INTRODUCED TO CONTROL SEDIMENT.
0	MEASURES IN WATERBODIES NO IN-STREAM WORK WILL BE REQUIRED ON THIS PROJECT.
11	STORMWATER QUALITY MEASURES MAINTENANCE GUIDELINES STORMWATER INLET CONTROL MEASURES CONSISTING OF TEMPORARY SEDIMENT BAGS ARE SHOWN ON THE EROSION CONTROL PLANS. DETAILS CAN BE FOUND ON THE EROSION CONTROL DETAIL SHEET. ANY DISCHARGE OF WATER FROM DEWATERING OR GROUND WATER FROM EXCAVATIONS, TRENCHES, FOUNDATIONS, ETC. MUST BE DIRECTED TO AN APPROPRIATE SEDIMENT CONTROL MEASURE OR SERIES OF EROSION CONTROL MEASURES THAT MINIMIZE THE DISCHARGE OF SEDIMENT. CONTRACTOR SHALL MONITOR ALL EROSION CONTROL MEASURES AND PERFORM MAINTENANCE AS OUTLINED IN THE MANUFACTURERS SPECIFICATIONS OR AS REQUIRED TO ENSURE PROPER WORKING ORDER OF EACH DEVICE. MONITORING AND MAINTENANCE GUIDELINES FOR EACH EROSION CONTROL BEST MANAGEMENT PRACTICE IS INCLUDED WITH THE DETAIL FOR THAT PRACTICE. EROSION CONTROL PRACTICE DETAILS ARE FOUND ON THE EROSION CONTROL PLAN. THE CONTRACTOR IS RESPONSIBLE FOR COMPLETING WEEKLY INSPECTION REPORTS FOR THE PURPOSE OF EVALUATING THE EFFECTIVENESS AND CONDITIONS OF THE INSTALLED PRACTICES. DAILY INSPECTIONS ARE REQUIRED DURING PERIODS OF RAINFALL EQUAL TO OR EXCEEDING 1/2". MEASURES FOUND TO BE DEFICIENT SHALL BE REPAIRED OR REPLACED.
12	EROSION AND SEDIMENT CONTROL MEASURES BUILDING LOTS THERE ARE NO INDIVIDUAL BUILDING LOTS CREATED AS PART OF THIS PROJECT.
13	SEQUENCE OF STORMWATER QUALITY MEASURE IMPLEMENTATION PRIOR TO MOBILIZING HEAVY EQUIPMENT, THE TEMPORARY STONE CONSTRUCTION ENTRANCE SHALL BE INSTALLED. IMMEDIATELY UPON MOBILIZING, THE CONTRACTOR SHALL POST THE NECESSARY PERMITS AND CONSTRUCTION GENERAL STORMWATER PERMIT DOCUMENTATION AT THE ENTRANCE TO THE SITE. PRIOR TO STARTING EARTHWORK OPERATIONS OR ANY OTHER SOIL DISTURBING ACTIVITY, ALL THE SILT FENCE SHALL BE INSTALLED. ALONG WITH THE SILT FENCE INSTALLATION, ALL EXISTING INLETS SHALL BE PROTECTED AS INDICATED ON THE PLAN.TEMPORARY SEEDING, EROSION CONTROL BLANKET AND RIPRAP SHALL BE INSTALLED AS EARTHWORK IS IMPLEMENTED. FINAL STABILIZATION SHALL INCLUDE REMOVAL OF ALL TEMPORARY CONTROL MEASURES, INSTALLATION OF TOPSOIL AND SEEDING IN AREAS TO RECEIVE PERMANENT SEEDING HAS BEEN ACHIEVED WITH 70% COVERAGE REALIZED, FINAL GRADES AND COMPACTION ARE COMPLETE, STORM STRUCTURES AND ROAD SURFACES HAVING BEEN CLEANED.
14	MATERIAL HANDLING AND SPILL PREVENTION SPILL PREVENTION SHALL BE ACCOMPLISHED BY UTILIZING SPILLGUARDS FOR EQUIPMENT FUELING. EQUIPMENT IN NEED OF REPAIR SHALL BE REMOVED FROM SITE FOR THE NECESSARY MAINTENANCE. NO EQUIPMENT SPILLGUARDS SHALL BE 3'X3'X6" AND SHALL BE CONSTRUCTED OF A MATERIAL RESISTANT TO PETROLEUM PRODUCTS. ON-SITE FUEL STORAGE TANKS SHALL HAVE EMERGENCY STORAGE CAPACITY DIRECTLY BELOW THE TANK IN CASE OF RUPTURE. ANY HAZARDOUS MATERIAL SPILLAGE SHALL BE COLLECTED AND/OR CLEANED IMMEDIATELY BY A TRAINED INDIVIDUAL AND DISPOSED OF IN ACCORDANCE WITH ALL FEDERAL, STATE AND LOCAL REGULATIONS.
15	MATERIAL HANDLING AND STORAGE PROCEDURES WASTE CONTAINERS (TRASH RECEPTACLES MUST BE MANAGED TO REDUCE THE DISCHARGE OF POLLUTANTS AND BLOWING OF DEBRIS. WASTE CONTAINERS MUST HAVE A COVER TO MINIMIZE EXPOSURE OF WASTE TO PRECIPITATION OR WASTE MUST BE REMOVED FROM THE SITE DAILY AND DISPOSED OF PROPERLY. CONCRETE WASHOUT OUT AREAS ARE OUTLINED ON THE PLANS. PROPER INSTALLATION, MAINTENANCE AND UTILIZATION SHALL BE OBSERVED TO CONTROL CONCRETE AND CEMENTITIOUS WATER. CONCRETE WASHOUT AREAS SHALL BE LEAK PROOF AND LOCATED AWAY FROM STORMWATER INLETS AND DISCHARGE POINTS. PROPER STORAGE AND HANDLING OF MATERIALS, SUCH AS FUELS OR HAZARDOUS WASTES MUST BE IMPLEMENTED TO MINIMIZE THE POTENTIAL FOR POLLUTANTS TO CONTAMINATE SURFACE OR GROUND WATER OR DEGRADE SOIL QUALITY.

- **IDEM EMERGENCY SPILL** PHONE INFORMATION PH: 1-888-233-7745 1-317-233-7745
- ONSITE CONTACT INFORMATION: CONTACT XXXX XXXX XXXX XXXX XXXX EMAIL: XXXXXX Ph. No: xxx-xxx-xxxx Ph. No: xxx-xxx-xxxx

IDEM AT	TAINS
WMP	COOL CREEK WMP
WATERSHED SPECIALIST	KRISTI TODD
PHONE	317-308-3376
EMAIL	kmtodd@idem.in.gov
AUID	INW01A1_05
AU NAME	COOL CREEK
CATEGORY	2
ASSESSED	YES
IMPAIRED	NO
THREATENED	NO
ON 303(d) LIST	NO
HAS TDML	NO
HAS 4B PLAN	NO
ALUS	FULLY SUPPORTING
FISH	NOT ASSESSED
RECR	FULLY SUPPORTING

Percent of AOI	Acres in AOI			
47.8%	2.8	y blex,		
52.2%	3.0			
100.0%	5.8			

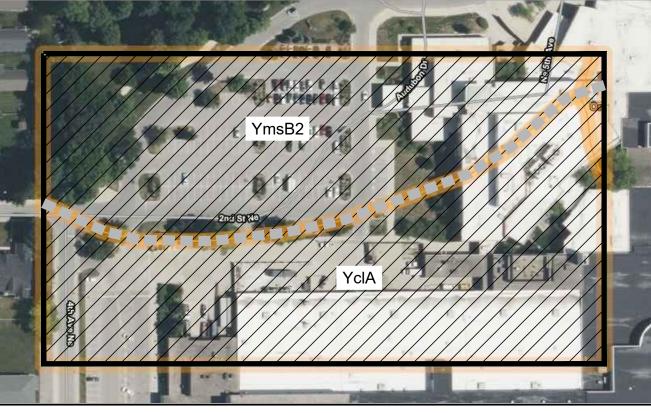

SOIL TYPES

SOILS MAP

	ORMWATER POLLUTION PREVENTION - ST CONSTRUCTION SECTON C
C1	POTENTIAL POLLUTANTS ASSOCIATED WITH PROPOSED LAND USE THE FUTURE USE OF THE IMPROVED AREAS INVOLVES THE DRIVING AND PARKING OF PRIVATE VEHICLES ON ASPHALT / STONE PAVED SURFACES. CONTAMINANTS TYPICALLY FOUND IN PARKING AREAS AND ON ROADS INCLUDE THE FOLLOWING; 1. OIL & GREASE 2. ANTIFREEZE 3. BRAKE FLUID & BRAKE DUST 4. RUBBER FRAGMENTS 5. GASOLINE, DIESEL FUEL AND OTHER HYDROCARBONS 6. METALS FROM VEHICLES 7. GRIT AND SEDIMENT FROM WEARING OF THE ROAD SURFACE 8. MATERIAL FALLING OR WASHING OFF OF VEHICLES 9. TRASH AND OTHER BIOLOGICAL AGENTS CONTAINED IN THE TRASH
C2	PROPOSED POST CONSTRUCTION STORMWATER QUALITY MEASURES <u>DRY DETENTION SYSTEM</u> THE EXISTING DRY DETENTION SYSTEM WILL TEMPORARILY HOLD, AND GRADUALLY RELEASE EXCESS STORMWATER FROM STORM EVENTS WHILE PERFORMING A SEDIMENT REMOVAL FUNCTION. DETENTION IS ACHIEVED THROUGH THE USE OF AN OUTLET STRUCTURE THAT REGULATES THE RATE OF STORMWATER OUTFLOW. THE EXISTING DRY DETENTION POND WILL REMAIN IN PLACE AS A PERMANENT FEATURE POST CONSTRUCTION.
	MECHANICAL BMP'S THE MECHANICAL BMP'S ARE LOCATED UPSTREAM OF THE EXISTING DRY DETENTION POND AND WILL REMAIN IN PLACE AS A PERMANENT FEATURE AFTER CONSTRUCTION IS COMPLETED. THE PURPOSE OF THIS MEASURE IS TO PROVIDE A SEDIMENT REMOVAL FUNCTION.
	SEDIMENT SUMP A SEDIMENT SUMP IS DESIGNED TO RETAIN GRIT AND DEBRIS BELOW THE POINT OF OVERFLOW.
	GOOD HOUSE KEEPING MEASURES GOOD HOUSEKEEPING MEASURES SUCH AS REGULAR STREET VACUUMING, INSTALLATION OF TRASH RECEPTACLES, AND REDUCTION IN FERTILIZER OVERSPRAY CAN BE INCORPORATED BY THE OWNER AND/OR OCCUPANT. VACUUM CLEAN ALL PAVED AREAS PRIOR TO REMOVING INLET PROTECTION.
	NATIVE VEGETATION NATIVE VEGETATION HELPS FILTER OUT POLLUTANTS AND INCREASE STORMWATER UPTAKE THROUGH THE PLANT ROOTS.
C3	PLAN DETAIL FOR STORMWATER MEASURES DETAILS FOR STORMWATER MEASURES ARE SHOWN ON THE EROSION CONTROL DETAIL SHEET
C4	SEQUENCE OF STORMWATER MEASURE IMPLEMENTATION AN EXISTING STORMWATER DRY DETENTION BASIN IS LOCATED AT THE SOUTHEAST CORNER OF THE SITE. THIS DRY BASIN WILL BE UTILIZED FROM THE OUTSET OF CONSTRUCTION. OBSERVATION OF THIS WILL BE CONDUCTED THROUGHOUT CONSTRUCTION AND A FINAL INSPECTION WILL BE CONDUCTED AT THE END OF CONSTRUCTION TO ADDRESS ANY SEDIMENT REMOVAL REQUIREMENTS.
C5	MAINTENANCE GUIDELINES OF POST CONSTRUCTION STORMWATER QUALITY MEASURES MAINTENANCE REQUIREMENTS FOR THE STORMWATER QUALITY MEASURES WHICH WILL REMAIN IN PLACE AFTER CONSTRUCTION IS COMPLETE, ARE DESCRIBED BELOW. REFER TO THE BMP OPERATIONS AND MAINTENANCE MANUAL FOR MORE DETAILED MAINTENANCE REQUIREMENTS.
	EXISTING DRY DETENTION POND INSPECT PERIODICALLY AS NEEDED AFTER EACH MAJOR RAINFALL EVENT OR AT LEAST EVERY SIX MONTHS. ANY TRASH OR DEBRIS ACCUMULATED WITHIN THE SYSTEM SHOULD BE REMOVED IMMEDIATELY. SEDIMENT AND TRASH DEBRIS SHALL BE DISPOSED OF OFF SITE IN ACCORDANCE WITH ALL APPLICABLE LAWS.
	MECHANICAL BMP'S FREQUENT INSPECTION AND CLEANING IS CRITICAL FOR PROPER OPERATION. RECOMMENDED INSPECTION AND MAINTANCE SCHEDULES VARY WITH MANUFACTURER.
	<u>SEDIMENT SUMP</u> FREQUENT INSPECTION AND CLEANING IS CRITICAL FOR PREVENTING/REDUCING SEDIMENT FROM ENTERING THE UNDERGROUND DETENTION SYSTEM. RECOMMEND INSPECTING AFTER EACH MAJOR RAINFALL EVENT.
C6	RESPONSIBLE ENTITY FOR POST CONSTRUCTION MEASURES

THE SKILLMAN GROUP JACOB BOWER 3834 SOUTH EMERSON AVENUE INDIANAPOLIS, IN. 46203

PHONE: 317-788-5142 EMAIL: jbower@skillman.com

EROSION CONTROL REQUIREMENT NOTE:

"I CERTIFY UNDER PENALTY OF LAW THAT I UNDERSTAND THE TERMS AND CONDITIONS OF THE CONSTRUCTION GENERAL STORMWATER PERMIT AND THE STORMWATER POLLUTION PREVENTION PLAN THAT AUTHORIZES THE STORMWATER DISCHARGE ASSOCIATED WITH ACTIVITIES FROM THE CONSTRUCTION SITE. A TRAINED INDIVIDUAL, AS DEFINED BY THE NPDES GENERAL PERMIT APPENDIX B, WILL BE USED FOR STORMWATER IMPLEMENTATION, SELF-MONITORING AND STORMWATER PROJECT MANAGEMENT.

CONTRACTOR SIGNATURE


SURVEYED LAND DESCRIPTION

PART OF THE EAST HALF OF THE NORTHWEST QUARTER OF SECTION 30, TOWNSHIP 18 NORTH, RANGE 4 EAST, OF THE SECOND PRINCIPAL MERIDIAN, CLAY TOWNSHIP, HAMILTON COUNTY, INDIANA, BEING MORE PARTICULARLY DESCRIBED BY TYLER J. THOMPSON, LS21400006 OF CIVIL & ENVIRONMENTAL CONSULTANTS, INC., AS PART OF PROJECT NUMBER 303-103.0014 ON MAY 19, 2023, AS FOLLOWS:


COMMENCING AT A HARRISON MONUMENT MARKING THE SOUTHEAST CORNER OF THE NORTHWEST QUARTER OF SAID SECTION 30; THENCE SOUTH 89 DEGREES 45 MINUTES 01 SECONDS WEST (INDIANA STATE PLANE EAST ZONE GRID BEARINGS) ALONG THE SOUTH LINE OF SAID NORTHWEST QUARTER A DISTANCE OF 168.60 FEET TO THE SOUTHERLY EXTENSION OF THE WEST LINE OF HARROWGATE ADDITION AS RECORDED IN PLAT BOOK 2, PAGES 203-205 IN THE OFFICE OF THE RECORDER OF HAMILTON COUNTY, INDIANA; THENCE NORTH 00 DEGREES 27 MINUTES 19 SECONDS WEST ALONG SAID SOUTHERLY EXTENSION A DISTANCE OF 50.00 FEET TO THE NORTH RIGHT-OF-WAY OF MAIN STREET; THENCE SOUTH 89 DEGREES 45 MINUTES 01 SECONDS WEST ALONG SAID RIGHT-OF-WAY A DISTANCE OF 493.49 FEET TO THE SOUTHWEST CORNER OF A PARCEL CONVEYED TO CARMEL-CLAY SCHOOL BUILDING CORPORATION IN DEED BOOK 215, PAGE 147 IN SAID RECORDER'S OFFICE AND BEING THE POINT OF BEGINNING; THENCE CONTINUING SOUTH 89 DEGREES 45 MINUTES 01 SECONDS WEST ALONG SAID RIGHT-OF-WAY A DISTANCE OF 291.08 FEET; THENCE NORTH 00 DEGREES 14 MINUTES 59 SECONDS WEST ALONG SAID RIGHT-OF-WAY A DISTANCE OF 2.00 FEET TO THE NORTH RIGHT-OF-WAY OF MAIN STREET PER ROAD PLANS PREPARED BY H.N.T.B. AS JOB NO. 8905-21-00 DATED APRIL 17, 1985; THENCE SOUTH 89 DEGREES 45 MINUTES 01 SECONDS WEST ALONG SAID RIGHT-OF-WAY A DISTANCE OF 331.37 FEET TO THE EAST RIGHT-OF-WAY OF 4TH AVENUE NE PER A RIGHT-OF-WAY PARCEL CONVEYED TO THE CITY OF CARMEL IN INSTRUMENT NUMBER 2021005901 IN SAID RECORDER'S OFFICE; THENCE ALONG SAID RIGHT-OF-WAY PARCEL FOR THE FOLLOWING FIVE (5) COURSES: 1) NORTH 44 DEGREES 56 MINUTES 58 SECONDS WEST A DISTANCE OF 17.82 FEET; 2) THENCE NORTH 00 DEGREES 24 MINUTES 34 SECONDS EAST A DISTANCE OF 44.74 FEET; 3) THENCE NORTH 00 DEGREES 22 MINUTES 10 SECONDS WEST A DISTANCE OF 56.58 FEET; 4) THENCE NORTH 01 DEGREES 51 MINUTES 04 SECONDS WEST A DISTANCE OF 44.83 FEET; 5) THENCE NORTH 86 DEGREES 11 MINUTES 16 SECONDS WEST A DISTANCE OF 24.47 FEET TO THE WEST LINE OF THE EAST HALF OF THE NORTHWEST QUARTER OF SAID SECTION 30; THENCE NORTH 00 DEGREES 20 MINUTES 38 SECONDS WEST ALONG SAID WEST LINE A DISTANCE OF 412.48 FEET TO THE SOUTHWEST CORNER OF A PARCEL CONVEYED TO CARMEL CLAY SCHOOLS IN INSTRUMENT NUMBER 200200073064 IN SAID RECORDER'S OFFICE; THENCE CONTINUING NORTH 00 DEGREES 20 MINUTES 38 SECONDS WEST ALONG SAID WEST LINE A DISTANCE OF 264.00 FEET TO THE SOUTHWEST CORNER OF LOT 15 IN CARMELWOOD AS RECORDED IN DEED BOOK 136, PAGE 365 IN SAID RECORDER'S OFFICE; THENCE NORTH 89 DEGREES 45 MINUTES 01 SECONDS EAST ALONG THE SOUTH LINES OF SAID LOT 15 AND LOT 16 IN CARMELWOOD A DISTANCE OF 200.27 FEET TO AN IRON PIPE MARKING THE SOUTHEAST CORNER OF SAID LOT 16; THENCE NORTH 00 DEGREES 14 MINUTES 59 SECONDS WEST ALONG THE EAST LINE OF SAID LOT 16 A DISTANCE OF 165.52 FEET TO THE SOUTH RIGHT-OF-WAY OF RE-LOCATED SYLVAN STREET PER INSTRUMENT NUMBER 200500083518 IN SAID RECORDER'S OFFICE, BEING A POINT ON A NON-TANGENT CURVE TO THE RIGHT HAVING A RADIUS OF 113.00 FEET, THE RADIUS POINT OF WHICH BEARS SOUTH 24 DEGREES 48 MINUTES 09 SECONDS EAST; THENCE ALONG SAID RIGHT-OF-WAY FOR THE FOLLOWING FIVE (5) COURSES: 1) EASTERLY ALONG SAID CURVE AN ARC DISTANCE OF 43.30 FEET TO A POINT WHICH BEARS NORTH 02 DEGREES 50 MINUTES 51 SECONDS WEST FROM SAID RADIUS POINT BEING A POINT ON A NON-TANGENT CURVE TO THE RIGHT HAVING A RADIUS OF 65.00 FEET, THE RADIUS POINT OF WHICH BEARS SOUTH 03 DEGREES 42 MINUTES 04 SECONDS EAST; 2) THENCE EASTERLY ALONG SAID CURVE AN ARC DISTANCE OF 44.29 FEET TO A POINT WHICH BEARS NORTH 35 DEGREES 20 MINUTES 28 SECONDS EAST FROM SAID RADIUS POINT BEING A POINT ON A NON-TANGENT CURVE TO THE LEFT HAVING A RADIUS OF 200.65 FEET. THE RADIUS POINT OF WHICH BEARS NORTH 35 DEGREES 19 MINUTES 35 SECONDS EAST; 3) THENCE EASTERLY ALONG SAID CURVE AN ARC DISTANCE OF 211.24 FEET TO A POINT WHICH BEARS SOUTH 24 DEGREES 59 MINUTES 37 SECONDS EAST FROM SAID RADIUS POINT BEING A POINT ON A NON-TANGENT CURVE TO THE LEFT HAVING A RADIUS OF 141.29 FEET, THE RADIUS POINT OF WHICH BEARS NORTH 30 DEGREES 22 MINUTES 42 SECONDS WEST; 4) THENCE NORTHEASTERLY ALONG SAID CURVE AN ARC DISTANCE OF 134.65 FEET TO A POINT WHICH BEARS SOUTH 84 DEGREES 58 MINUTES 50 SECONDS EAST FROM SAID RADIUS POINT; 5) THENCE NORTH 03 DEGREES 58 MINUTES 25 SECONDS EAST A DISTANCE OF 48.45 FEET TO THE SOUTHWEST CORNER OF LOT 5 IN SAID CARMELWOOD; THENCE NORTH 89 DEGREES 35 MINUTES 21 SECONDS EAST ALONG THE SOUTH LINE OF SAID LOT 5 A DISTANCE OF 101.58 FEET TO THE WEST LINE OF SAID PARCEL RECORDED IN DEED BOOK 215, PAGE 147; THENCE SOUTH 00 DEGREES 20 MINUTES 38 SECONDS

EAST ALONG SAID WEST LINE A DISTANCE OF 1,141.40 FEET TO THE POINT OF


BEGINNING, CONTAINING 14.572 ACRES OF LAND, MORE OR LESS.

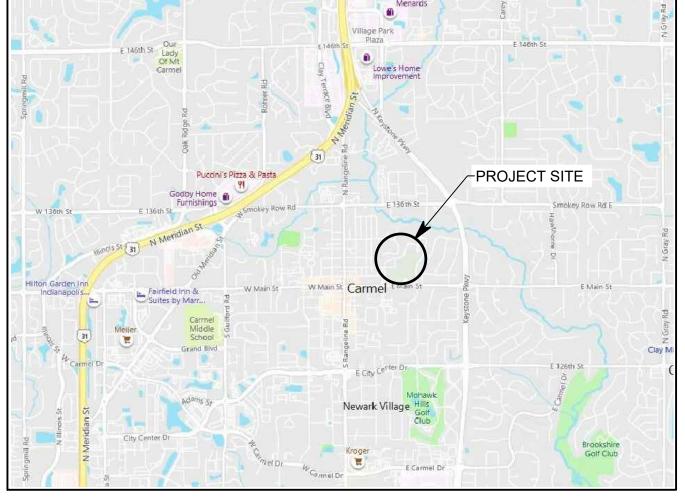


VICINITY MAP

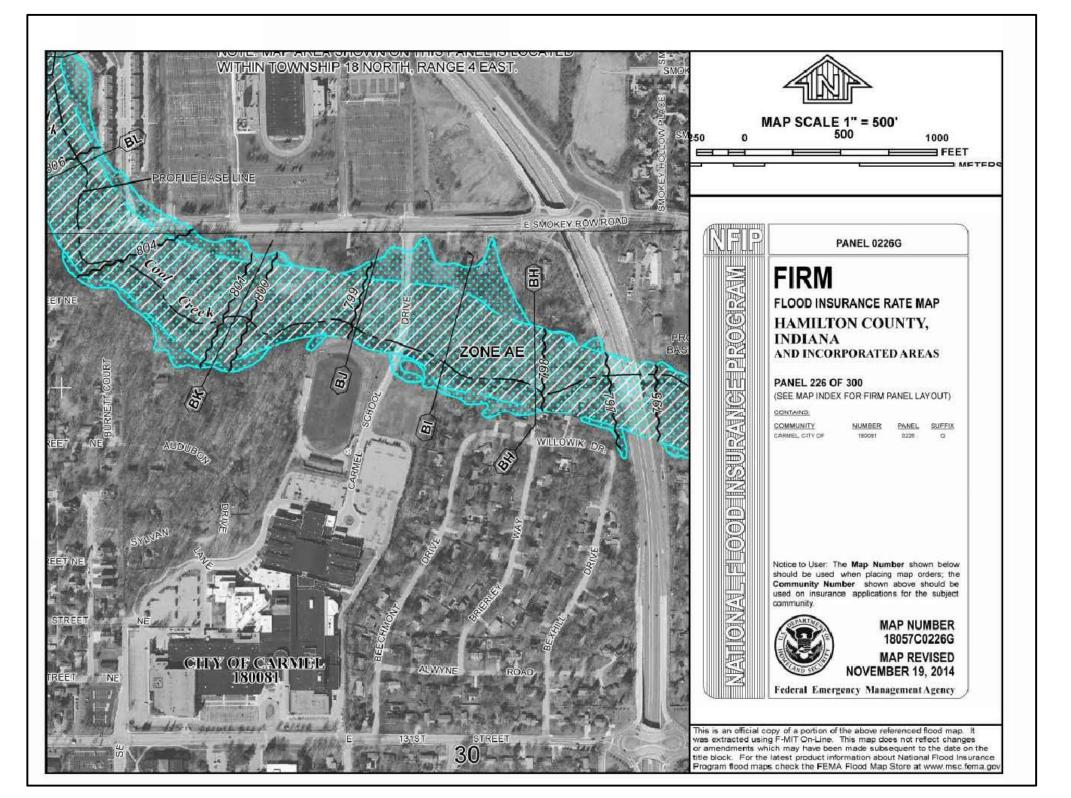





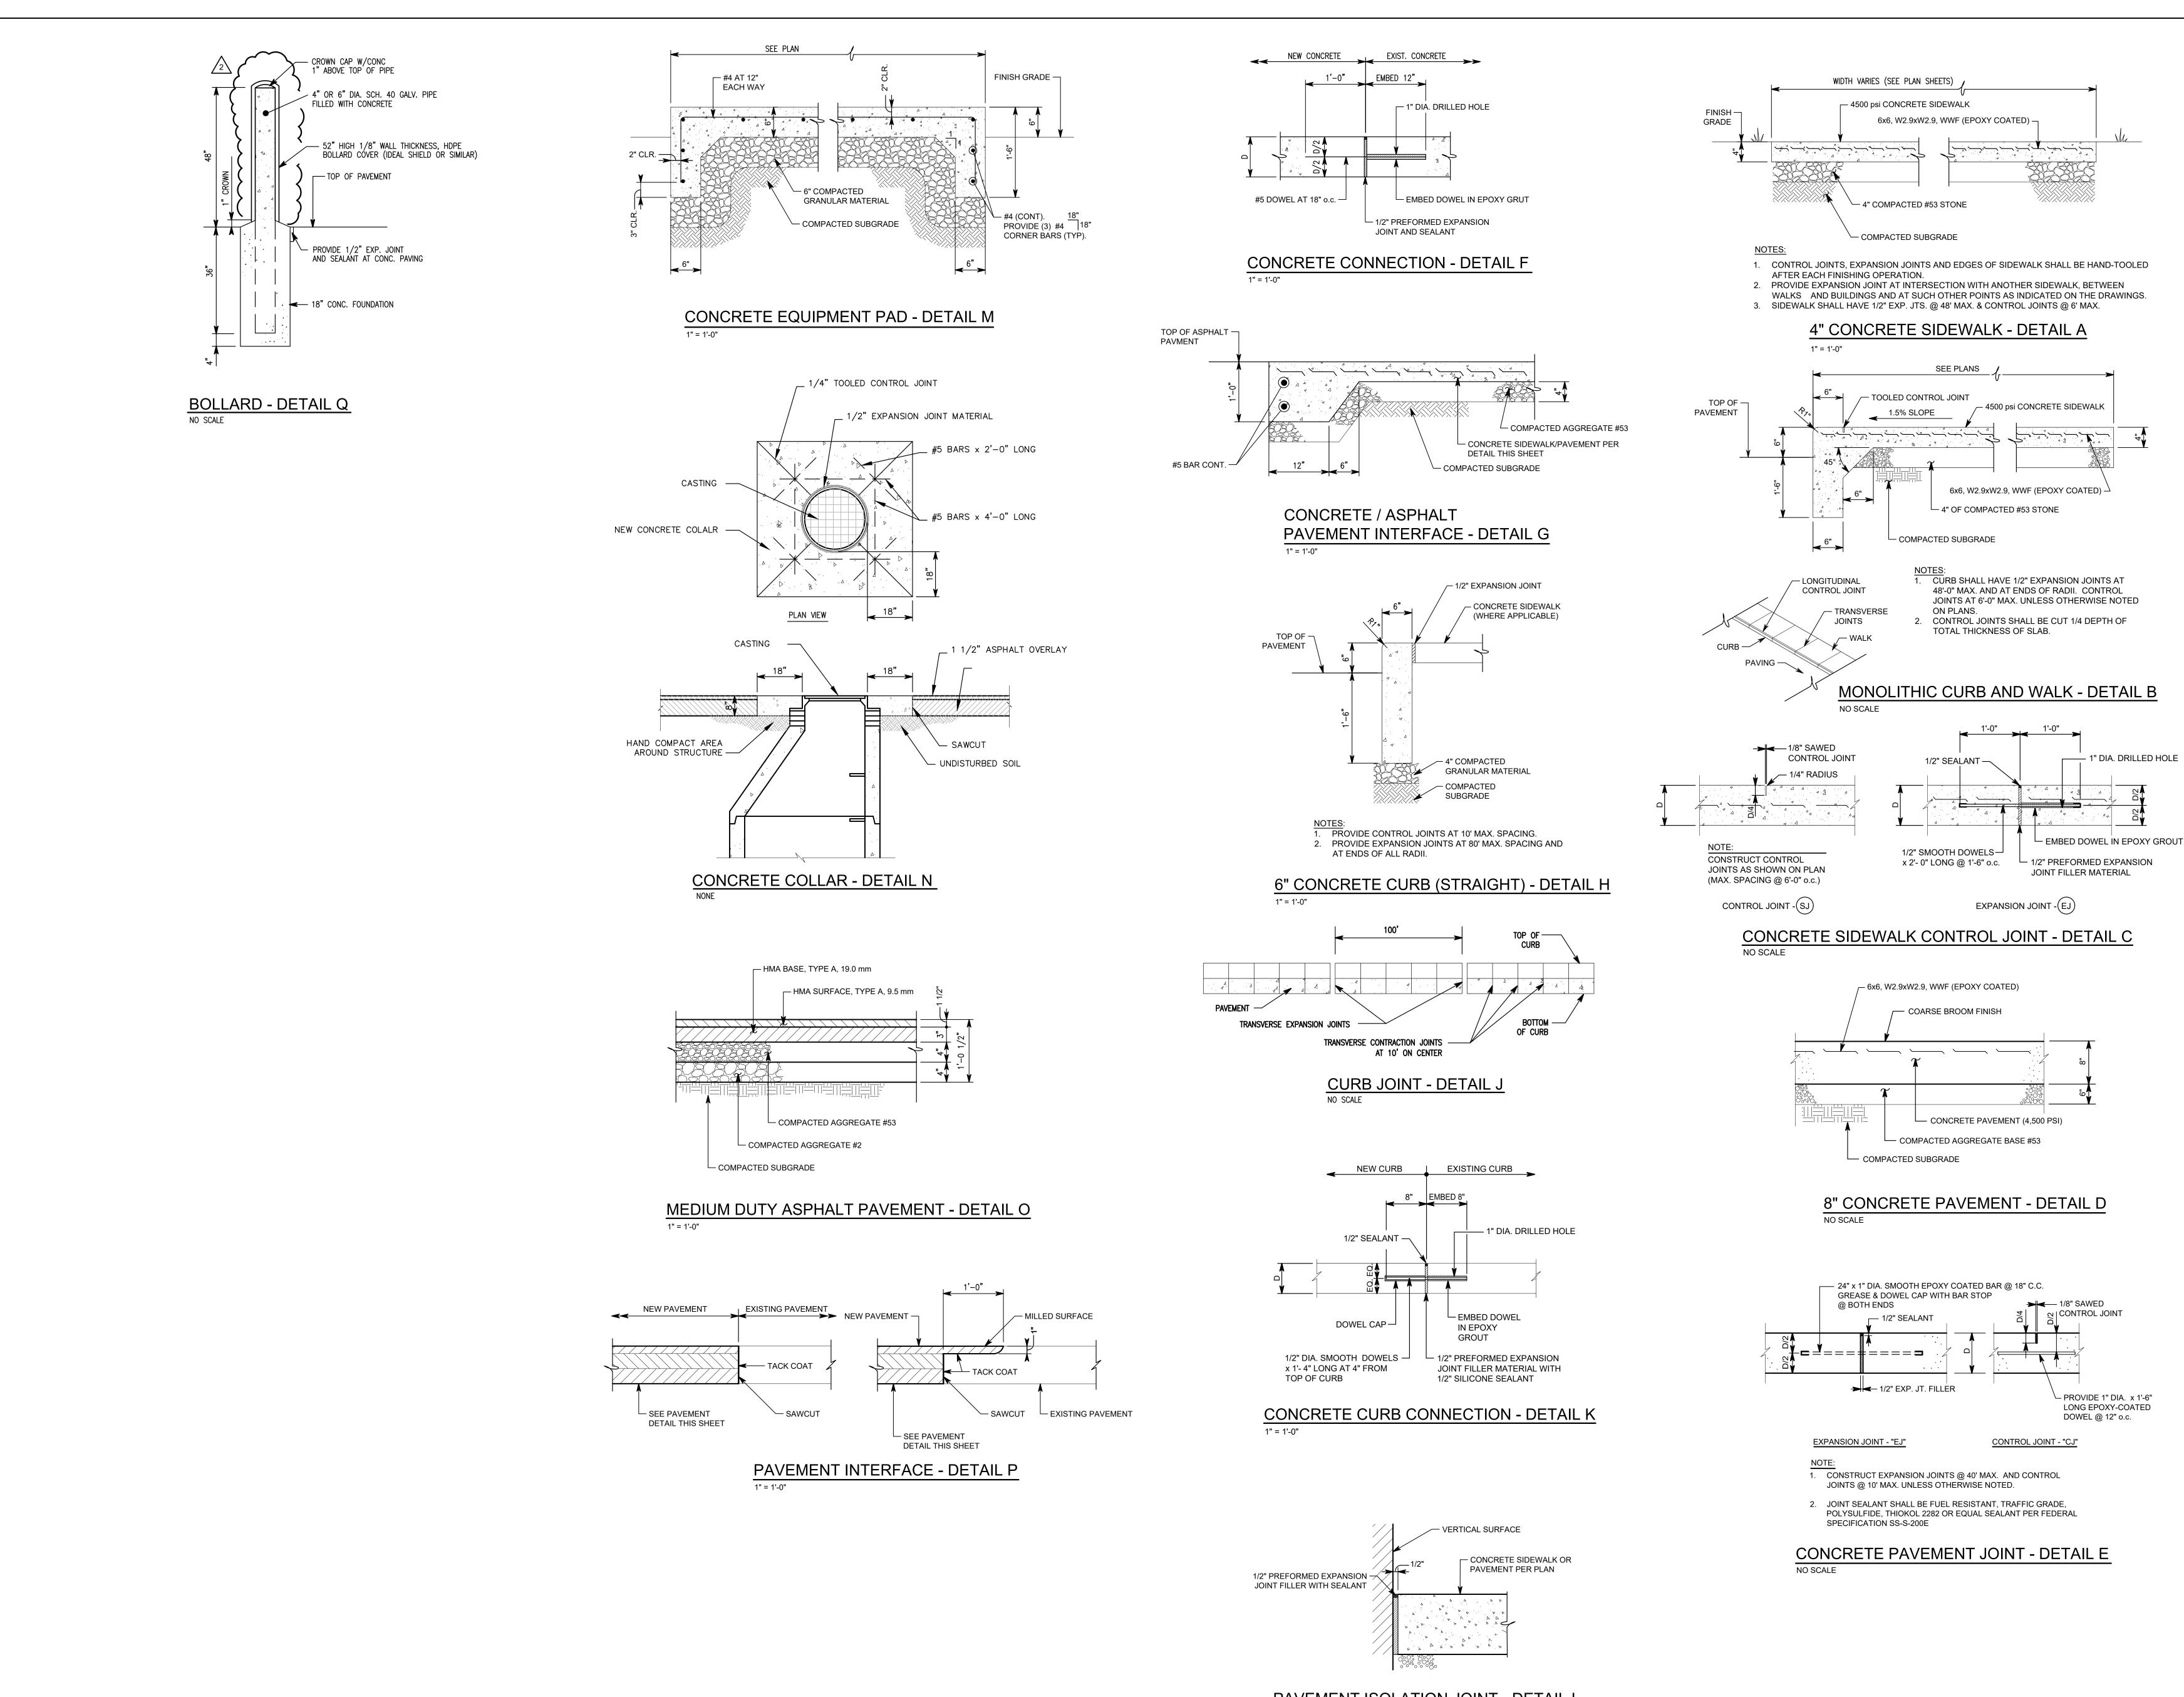



PAVEMENT ISOLATION JOINT - DETAIL L 1/2" = 1'-0"

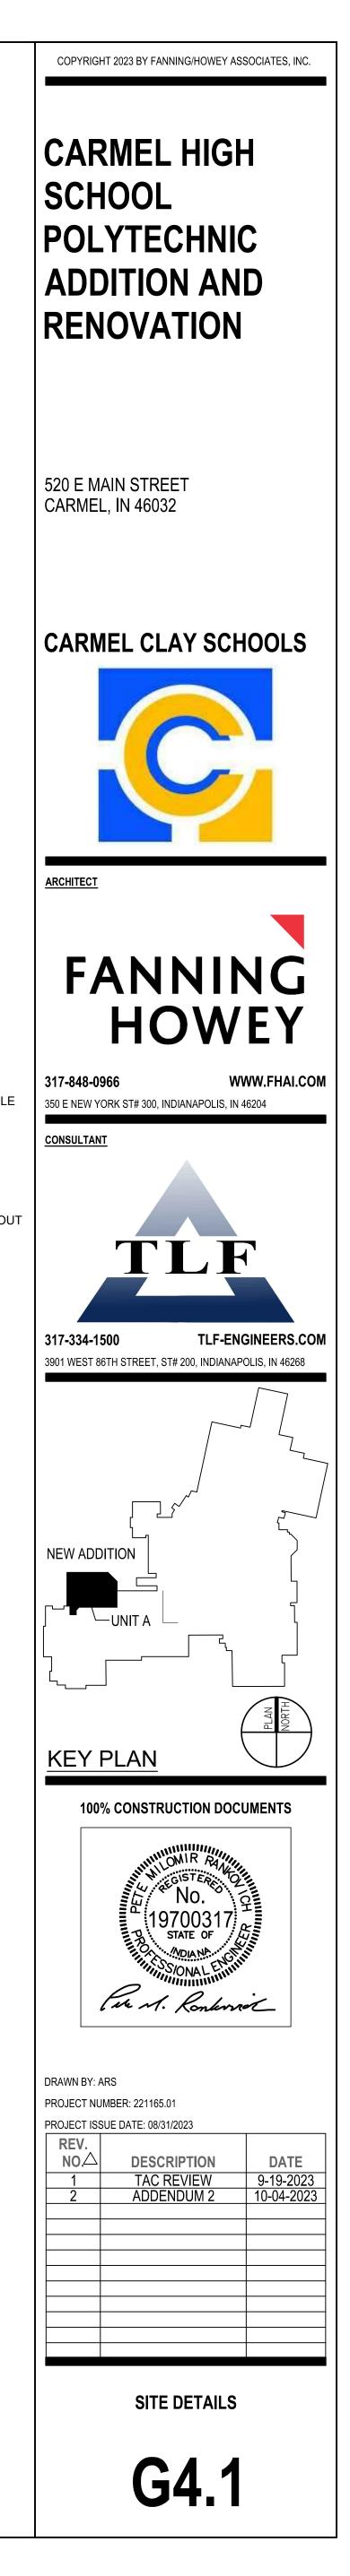

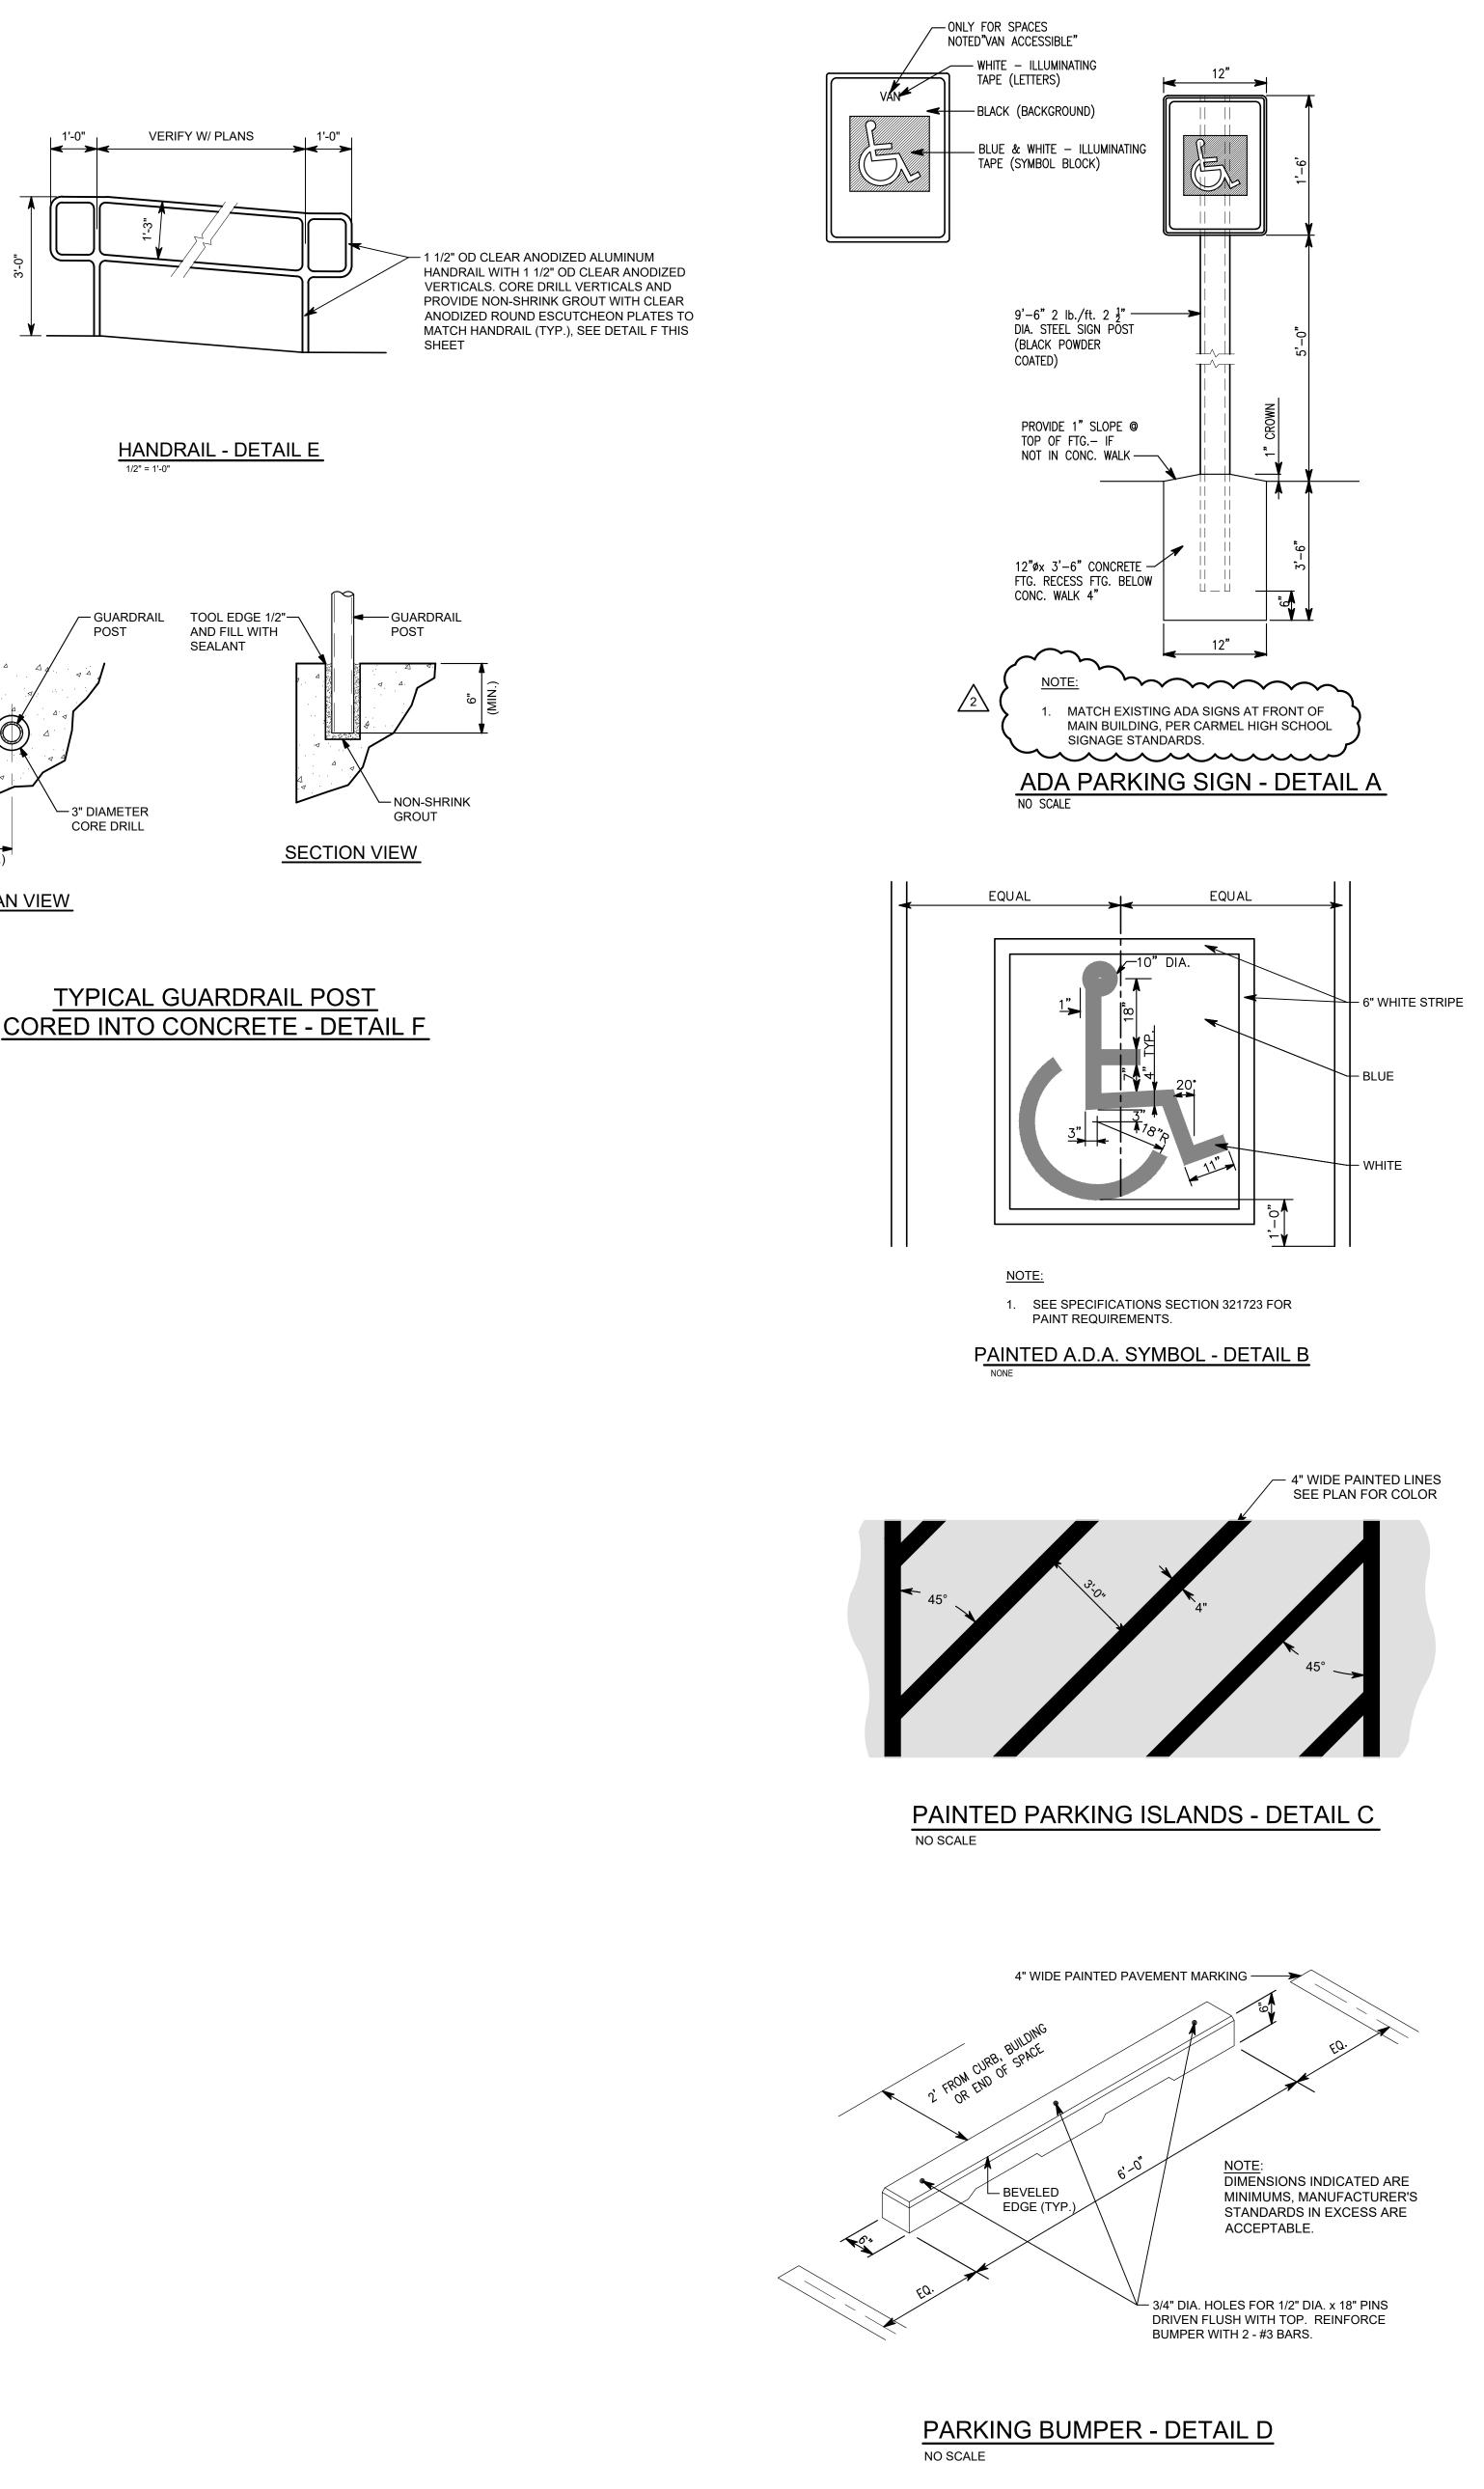

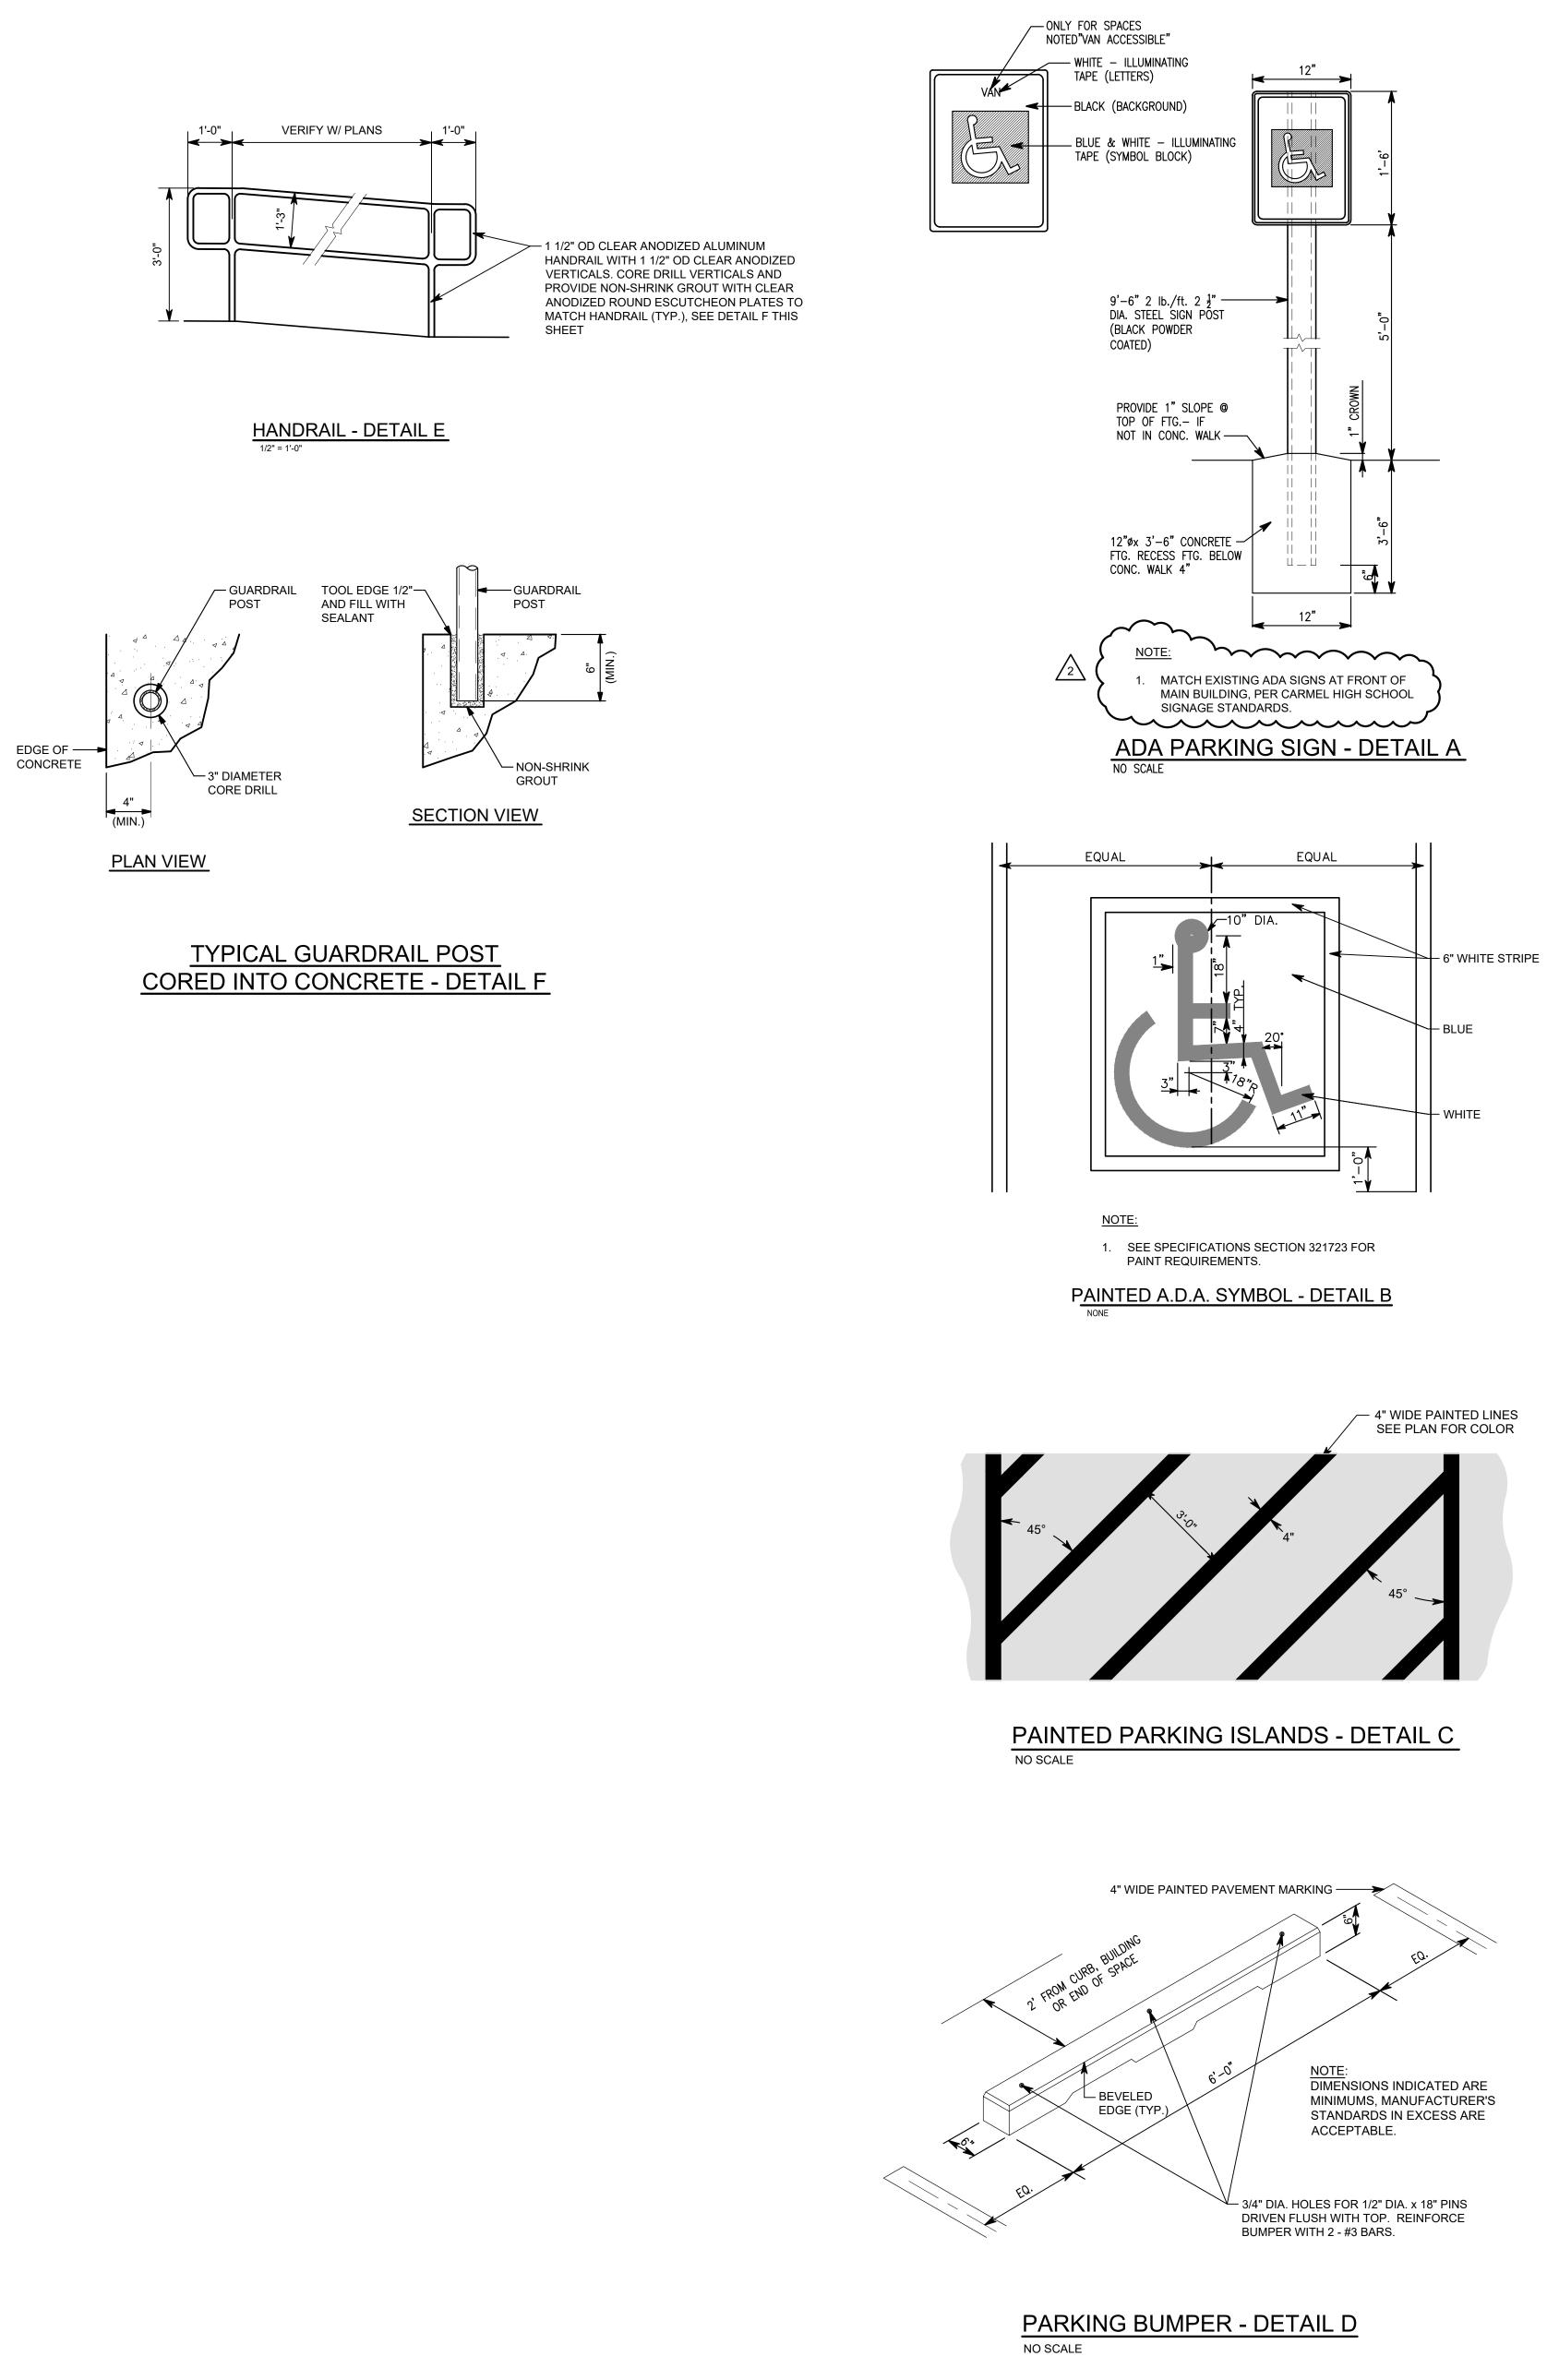

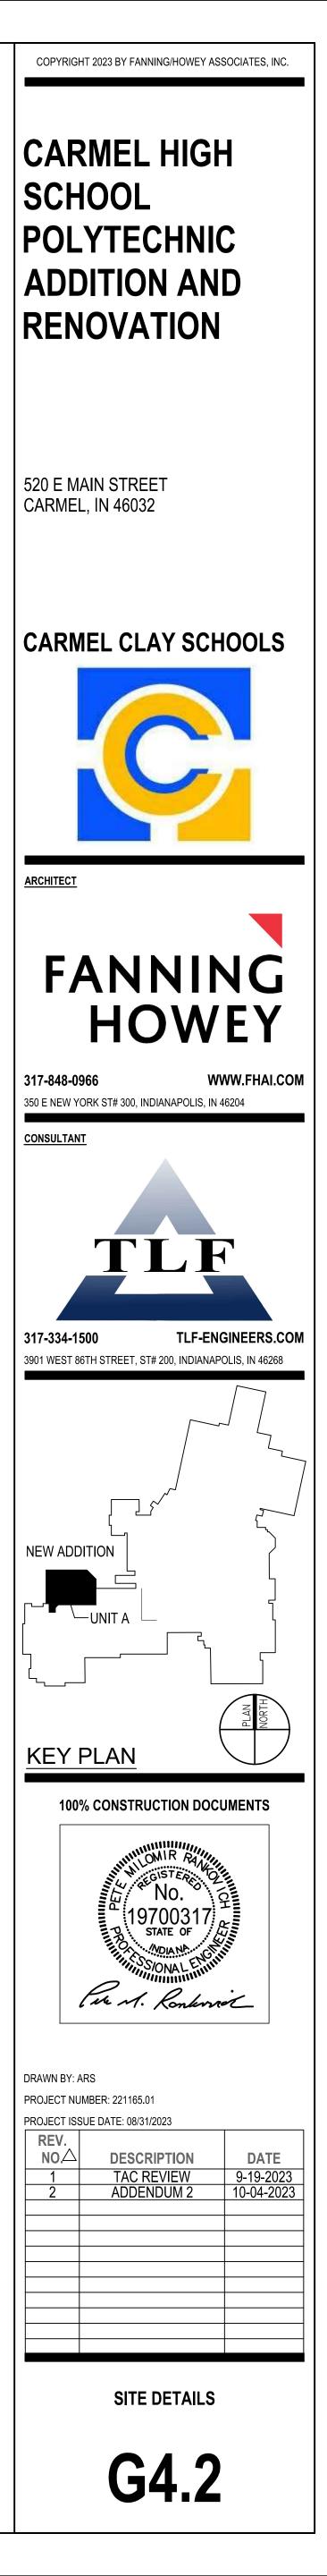

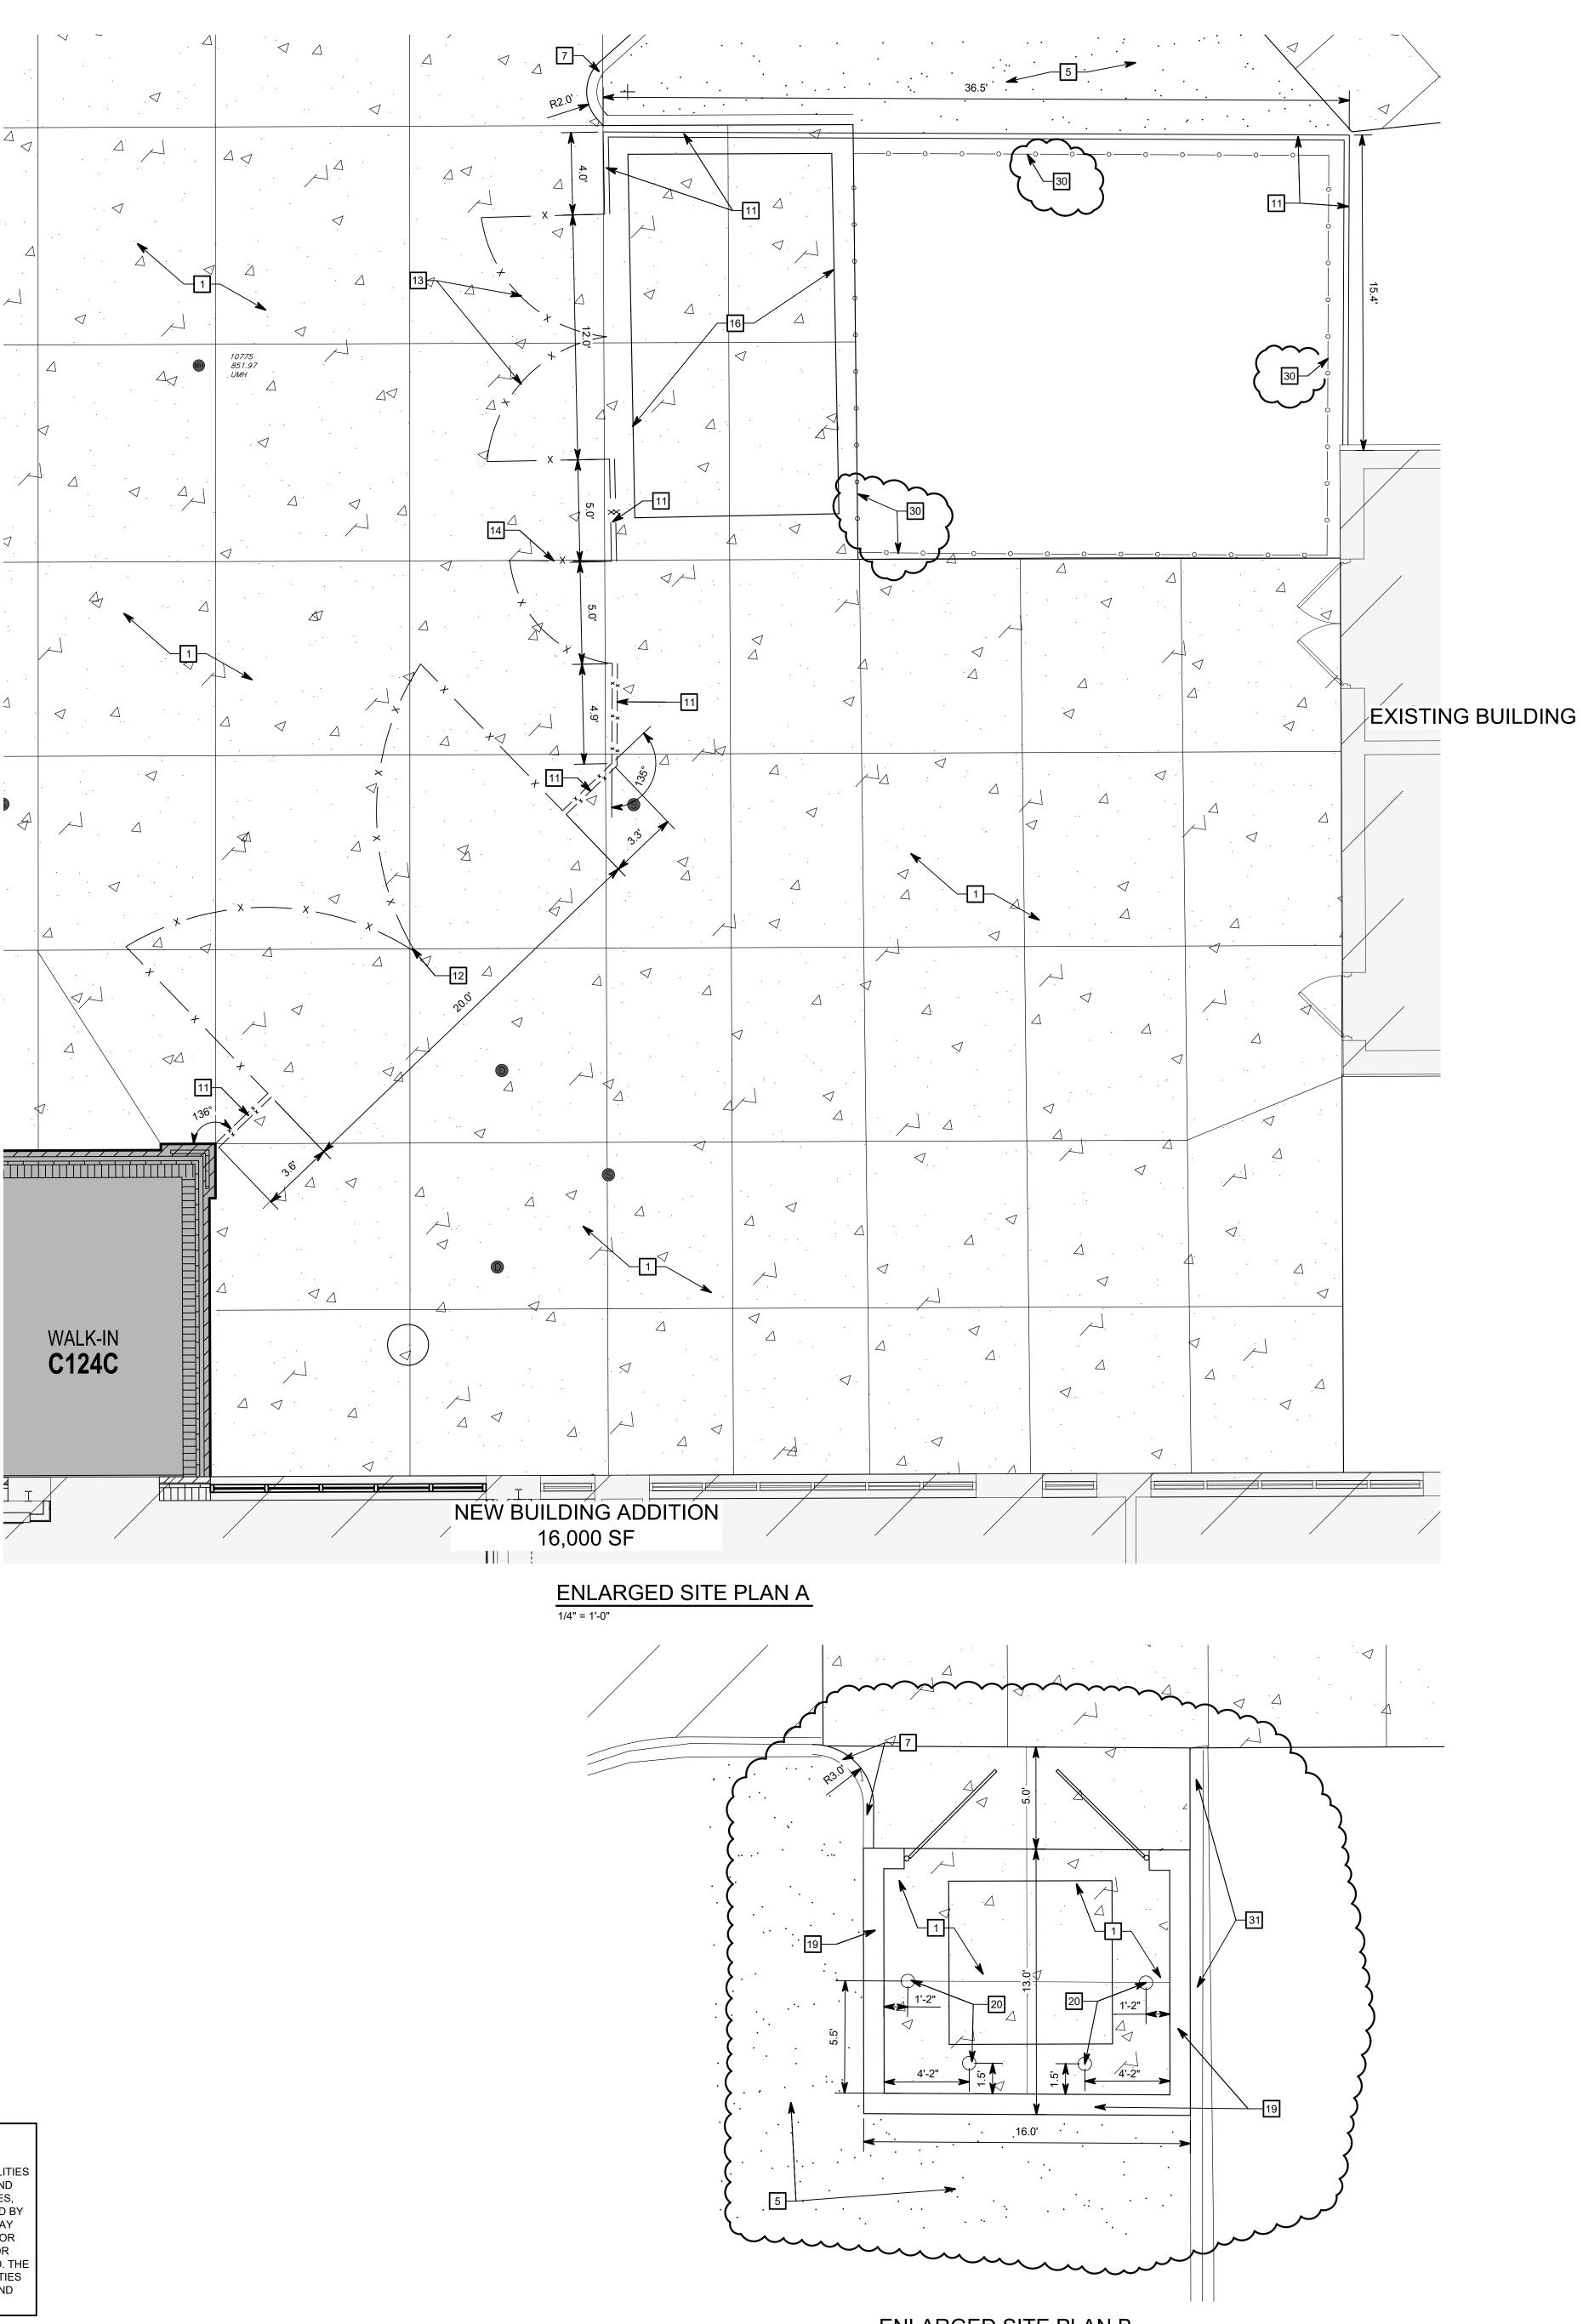




Call before you dig. Call 811 or 1-800-382-5544 Before You Begin Any Digging Project. Call 48 hours or 2 working days before you dig. It's Fast, It's Easy and It's the Law in the state of Indiana!

CAUTION !!

THE LOCATIONS OF ALL EXISTING UNDERGROUND UTILITIES SHOWN ON THE PLAN ARE BASED UPON ABOVE GROUND EVIDENCE (INCLUDING, BUT NOT LIMITED TO, MANHOLES, INLETS, VALVES, AND MARKS MADE UPON THE GROUND BY OTHERS) AND ARE SPECULATIVE IN NATURE. THERE MAY ALSO BE OTHER EXISTING UNDERGROUND UTILITIES FOR WHICH THERE IS NO ABOVE GROUND EVIDENCE OR FOR WHICH NO ABOVE GROUND EVIDENCE WAS OBSERVED. THE EXACT LOCATIONS OF EXISTING UNDERGROUND UTILITIES SHALL BE VERIFIED BY CONTRACTOR PRIOR TO ANY AND ALL CONSTRUCTION.

> ENLARGED SITE PLAN B 1/4" = 1'-0"

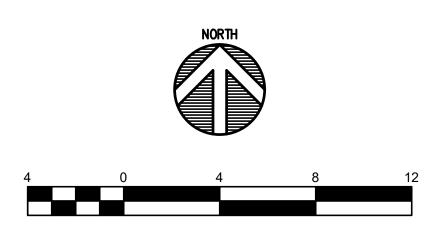

GENERAL NOTES

- 1. SEE DRAWING GD0.1 FOR GENERAL NOTES AND ADDITIONAL LEGEND.
- 2. TOPOGRAPHIC CONDITIONS AND EXISTING UTILITIES SHOWN WERE PROVIDED BY CEC - CIVIL & ENVIRONMENTAL CONSULTANTS, INC DATED MAY 19, 2023. THE ENGINEER MAKES NO GUARANTEES THAT THE UNDERGROUND UTILITIES SHOWN COMPRISE ALL SUCH UTILITIES IN THE AREA, EITHER IN SERVICE OR ABANDONED.
- 3. CONTRACTOR SHALL VERIFY ALL EXISTING CONDITIONS IN THE PROJECT AREA INCLUDING UNDERGROUND UTILITY CONDITIONS, LOCATION AND DEPTH PRIOR TO ANY OTHER SITE CONSTRUCTION. REPORT ANY DISCREPANCIES TO THE ENGINEER.
- 4. SEE SHEET G1.2 FOR STRIPING AND SIGNAGE PLAN.
- 5. SEE SHEET G1.3 FOR CONCRETE JOINTING PLAN.

SITE KEYNOTES

- 1 CONCRETE PAVEMENT SEE DETAIL D/G4.1
- 5 LAWN AREA - SEE LANDSCAPE PLAN L1.0
- 7 CONCRETE CURB SEE DETAIL H/G4.1
- 11 8' HT. CITY SCAPES COVRIT SCREENWALL ENCLOSURE WITH VERTICAL PLANKS AND STANDARD STIFFENER, FENCE PANELS AND POSTS, DOUBLE SWING GATE
- 12 DOUBLE SWING GATE (TWO 10'-0" GATES) WITH CITY SCAPES - TOUGHGATE (PVC VERTICAL PLANK INFILL SERIES - MADISON STYLE) 8'-0" HEIGHT
- 13 DOUBLE SWING GATE (2 - 6'-0" GATES) WITH CITY SCAPES - TOUGHGATE (PVC VERTICAL PLANK INFILL SERIES - MADISON STYLE) 8'-0" HEIGHT
- 5' WIDE SWING GATE WITH CITY SCAPES TOUGHGATE (PVC VERTICAL PLANK INFILL SERIES MADISON STYLE) 8'-0" HEIGHT WITH WEATHERPROOF PANIC HARDWARE MOUNTED TO DOOR
- CONCRETE EQUIPMENT PAD (12' X 20') WITH ABOVE GROUND TANK SEE DETAIL M/G4.1 (REFER TO MEP PLANS FOR SIZE AND LOCATION) 16 TRASH DUMPSTER ENCLOSURE - SEE ARCHITECTURAL PLANS & DWG 10/S3.01 PROVIDE TWO SWING GATES, CITY SCAPES - TOUGHGATE (PVC VERTICAL PLANK INFILL SERIES - MADISON STYLE) 19
- 20 STEEL BOLLARD PER DETAIL Q/G4.1
- 27 TAPER CURB FROM 6" TO 1"
- 30 EXISTING FENCE TO REMAIN
- 31 EXISTING CURB/WALL TO REMAIN

PROPOSED SITE LEGEND

EXISTING BUILDING

(
م م م	
ـــــــــــــــــــــــــــــــــــــ	 {-
\bigcirc	

Ο

S




PROPOSED CONCRETE PAVEMENT/SIDEWALK


PROPOSED ASPHALT PAVEMENT

PROPOSED LAWN AREA


EXISTING LIGHT POLE

- EXISTING STORM STRUCTURE
- EXISTING SANITARY STRUCTURE
- EXISTING FIRE HYDRANT
- PROPOSED STORM STRUCTURE
- PROPOSED SANITARY STRUCTURE

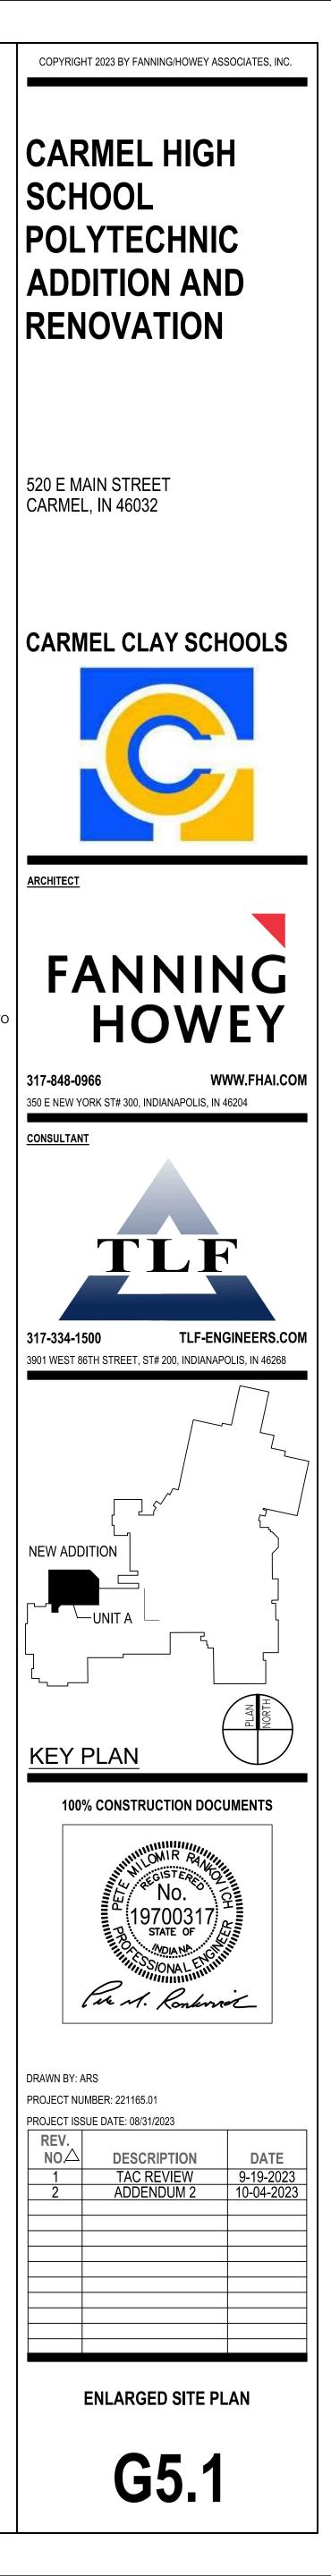

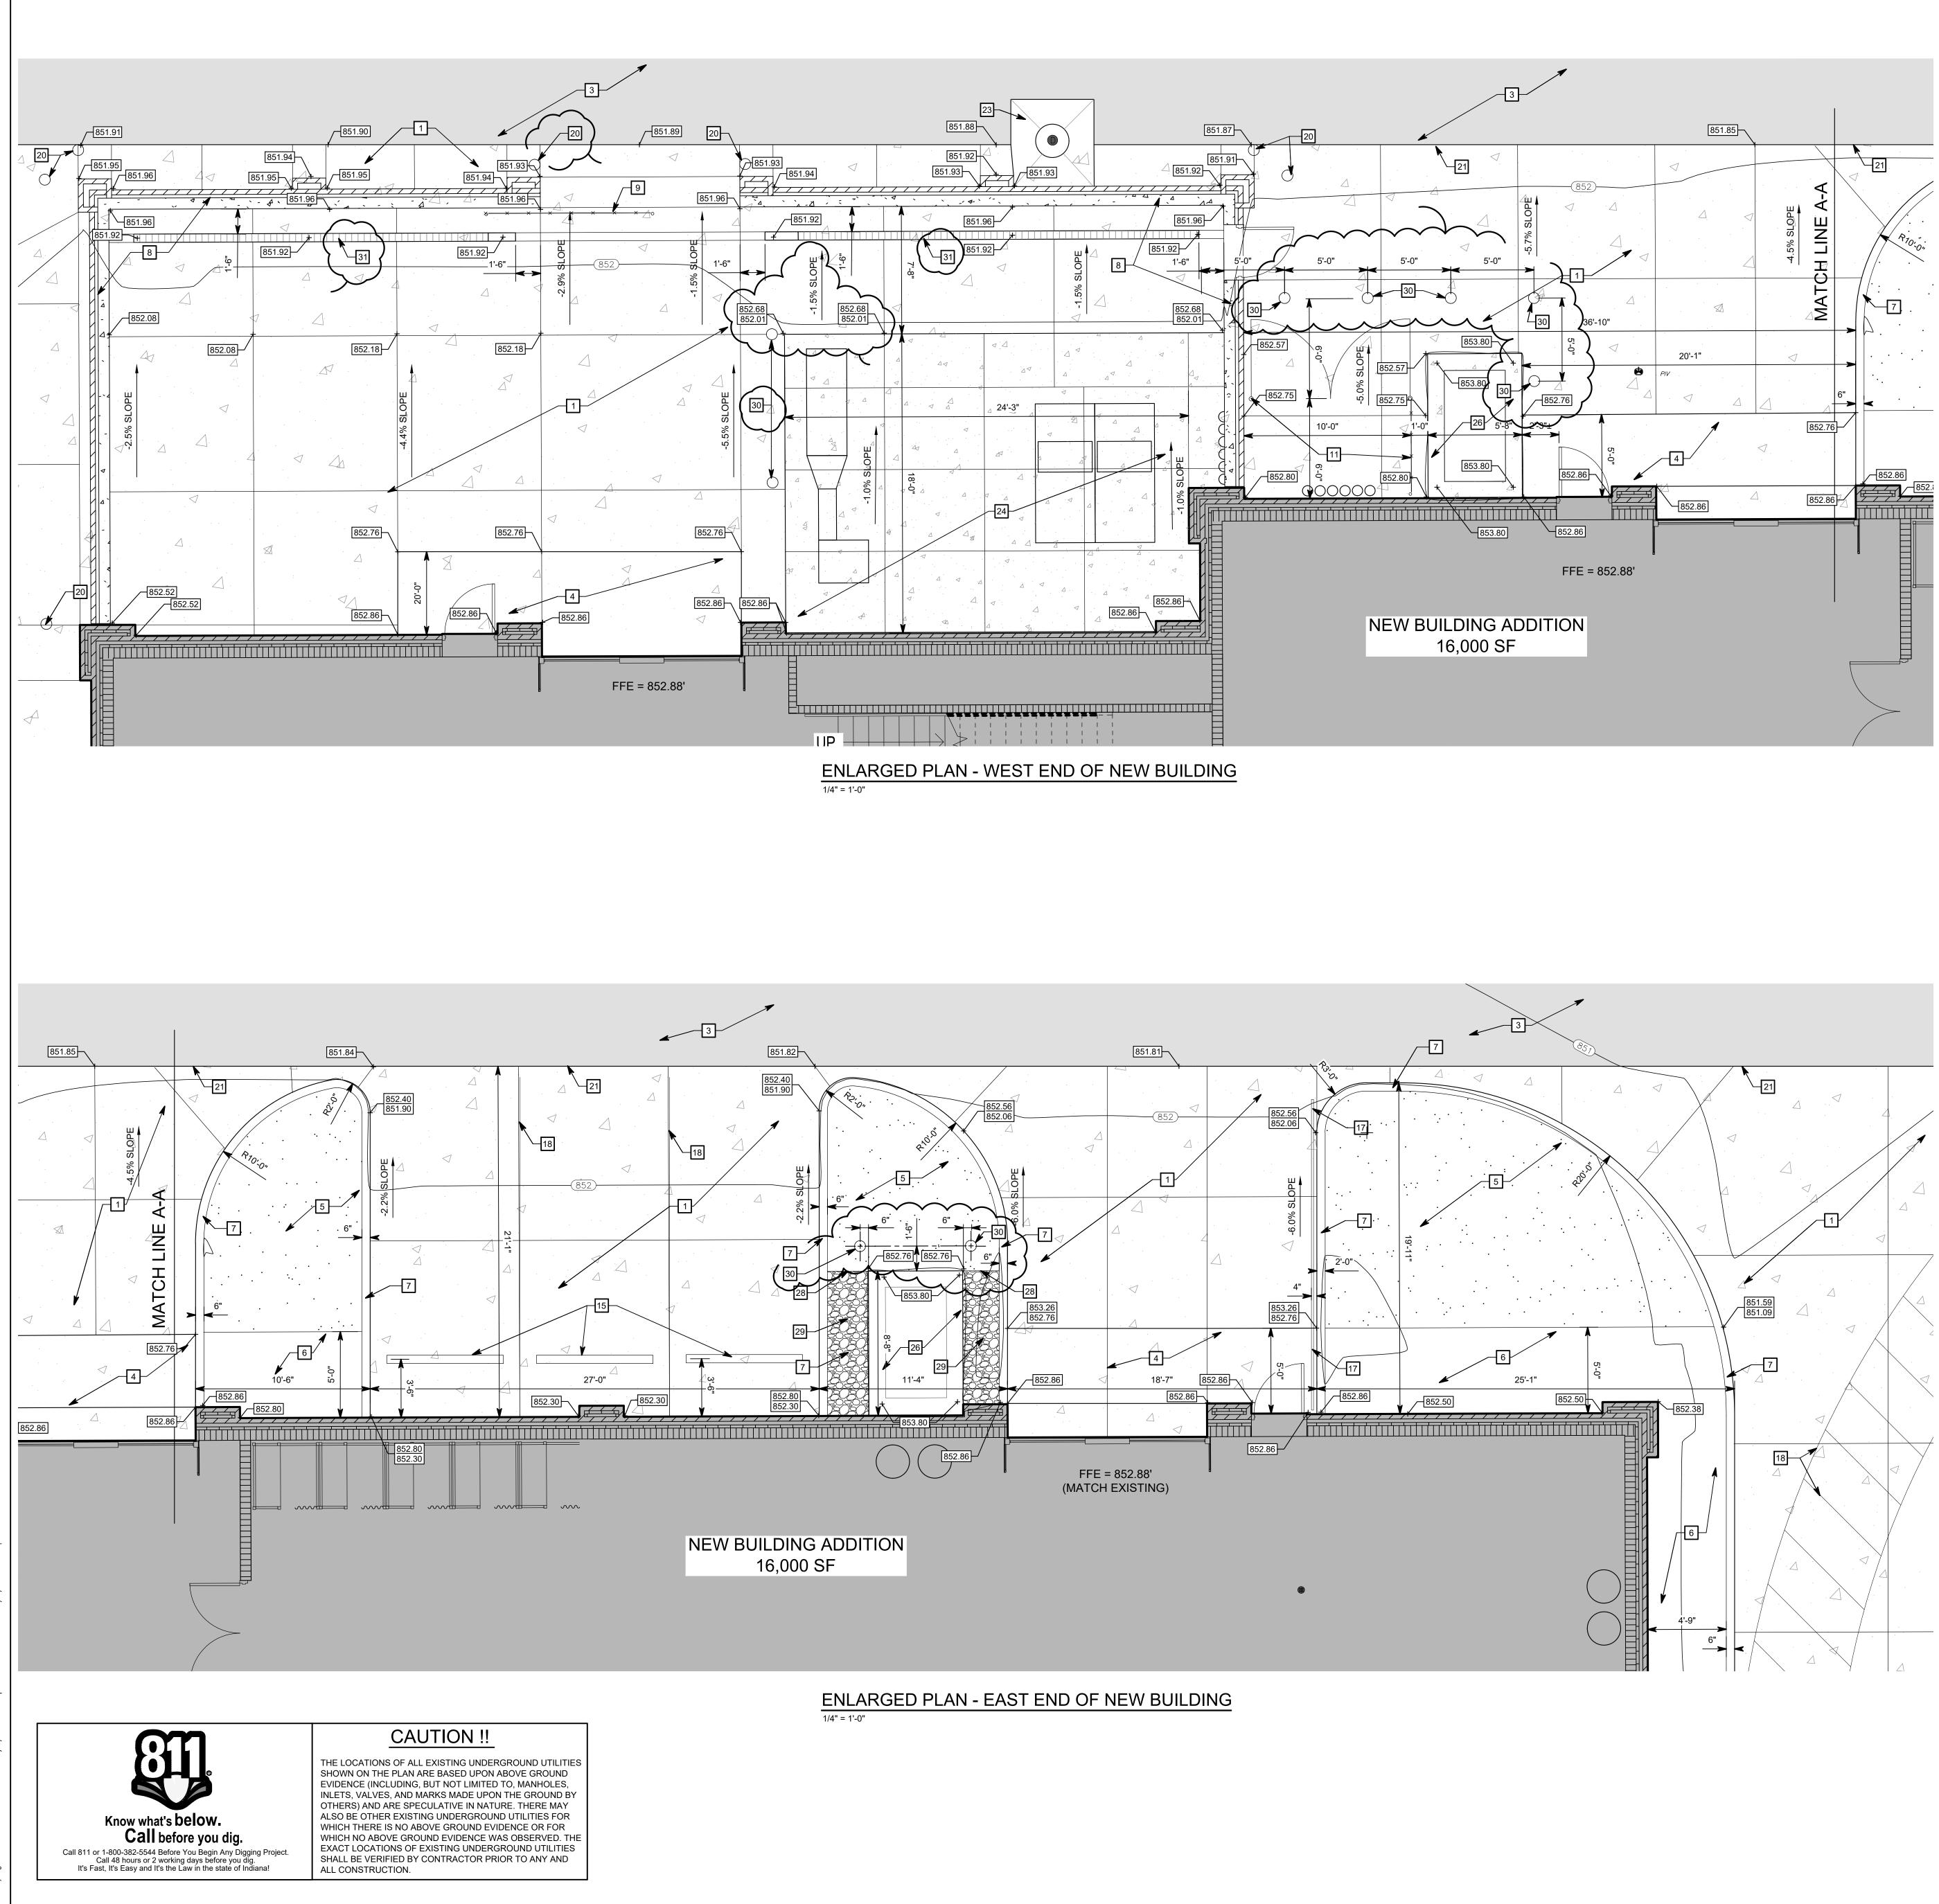

5.1. Edi √100\119\CAI Time of Plot: a X ed

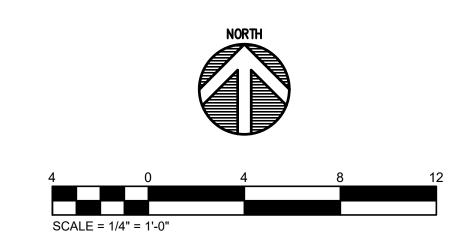

GENERAL NOTES

- 1. SEE DRAWING GD0.1 FOR GENERAL NOTES AND ADDITIONAL LEGEND.
- 2. TOPOGRAPHIC CONDITIONS AND EXISTING UTILITIES SHOWN WERE PROVIDED BY CEC - CIVIL & ENVIRONMENTAL CONSULTANTS, INC DATED MAY 19, 2023. THE ENGINEER MAKES NO GUARANTEES THAT THE UNDERGROUND UTILITIES SHOWN COMPRISE ALL SUCH UTILITIES IN THE AREA, EITHER IN SERVICE OR ABANDONED.
- CONTRACTOR SHALL VERIFY ALL EXISTING CONDITIONS IN THE PROJECT AREA INCLUDING UNDERGROUND UTILITY CONDITIONS, LOCATION AND DEPTH PRIOR TO ANY OTHER SITE CONSTRUCTION. REPORT ANY DISCREPANCIES TO THE ENGINEER.
- 4. SEE SHEET G1.2 FOR STRIPING AND SIGNAGE PLAN.
- 5. SEE SHEET G1.3 FOR CONCRETE JOINTING PLAN.

SITE KEYNOTES

- 1 CONCRETE PAVEMENT SEE DETAIL D/G4.1
- 3 ASPHALT PAVEMENT SEE DETAIL O/G4.1
- 4 CONCRETE STOOP/APRON SEE STRUCTURAL DRAWING
- 5 LAWN AREA SEE LANDSCAPE PLAN L1.0
- 6 SHREDDED HARDWOOD MULCH PLANTING BED SEE LANDSCAPE PLAN L1.0
- 7 CONCRETE CURB SEE DETAIL H/G4.1
- 8 EXTERIOR STORAGE MASONRY SCREEN WALL SEE ARCHITECTURAL PLANS
- ROLLING GATE WITH CITY SCAPES TOUGHGATE (PVC VERTICAL PLANK INFILL SERIES MADISON STYLE) FOR A 12'-0" WIDE OPENING AND 8'-0" HEIGHT 9
- 11 8' HT. CITY SCAPES COVRIT SCREENWALL ENCLOSURE WITH VERTICAL PLANKS AND STANDARD STIFFENER, FENCE PANELS AND POSTS, DOUBLE SWING GATE
- 15 PRECAST PARKING BUMPER - SEE DETAIL D/G4.2
- 17 ALUMINUM HANDRAIL - SEE DETAIL E/G4.2
- 18 PAVEMENT MARKING SEE STRIPING AND SIGNAGE PLAN G1.2
- 20 4" DIA. STEEL BOLLARD PER DETAIL Q/G4.1
- 21 CONCRETE/ASPHALT INTERFACE DETAIL G/G4.1
- 23 CONCRETE COLLAR - SEE DETAIL N/G4.1
- CONCRETE EQUIPMENT PAD (±25'-0" X ±20'-0") FOR DUST COLLECTOR AND WELDING EXHAUST SEE DETAIL M/G4.1 (COORDINATE WITH MEP PLANS FOR SIZE AND
- LOCATION)
- OIL CONTAINMENT TANK, CONCRETE PIT AND CANOPY, SEE SHEET G4.2 FOR ADDITIONAL LAYOUT INFORMATION AND STRUCTURAL DETAIL XX/S5.X
- 28 WASHED RIVER ROCK PER LANDSCAPE PLAN L2.0
- STEEL EDGING PER LANDSCAPE PLAN L2.0 29
- 6" DIA. PIPE BOLLARD SEE DETAIL Q/G4.1
- 31 TRENCH DRAIN - PER SHEET SU1.1 AND DETAIL ON SHEET SU2.1 ·····



EXISTING BUILDING PROPOSED BUILDING ADDITION PROPOSED CONCRETE PAVEMENT/SIDEWALK PROPOSED ASPHALT PAVEMENT -Q- $\circ \blacksquare$

 (\mathbb{S})


Ω

S

PROPOSED LAWN AREA EXISTING LIGHT POLE EXISTING STORM STRUCTURE EXISTING SANITARY STRUCTURE EXISTING FIRE HYDRANT PROPOSED STORM STRUCTURE

0 🛛 PROPOSED SANITARY STRUCTURE



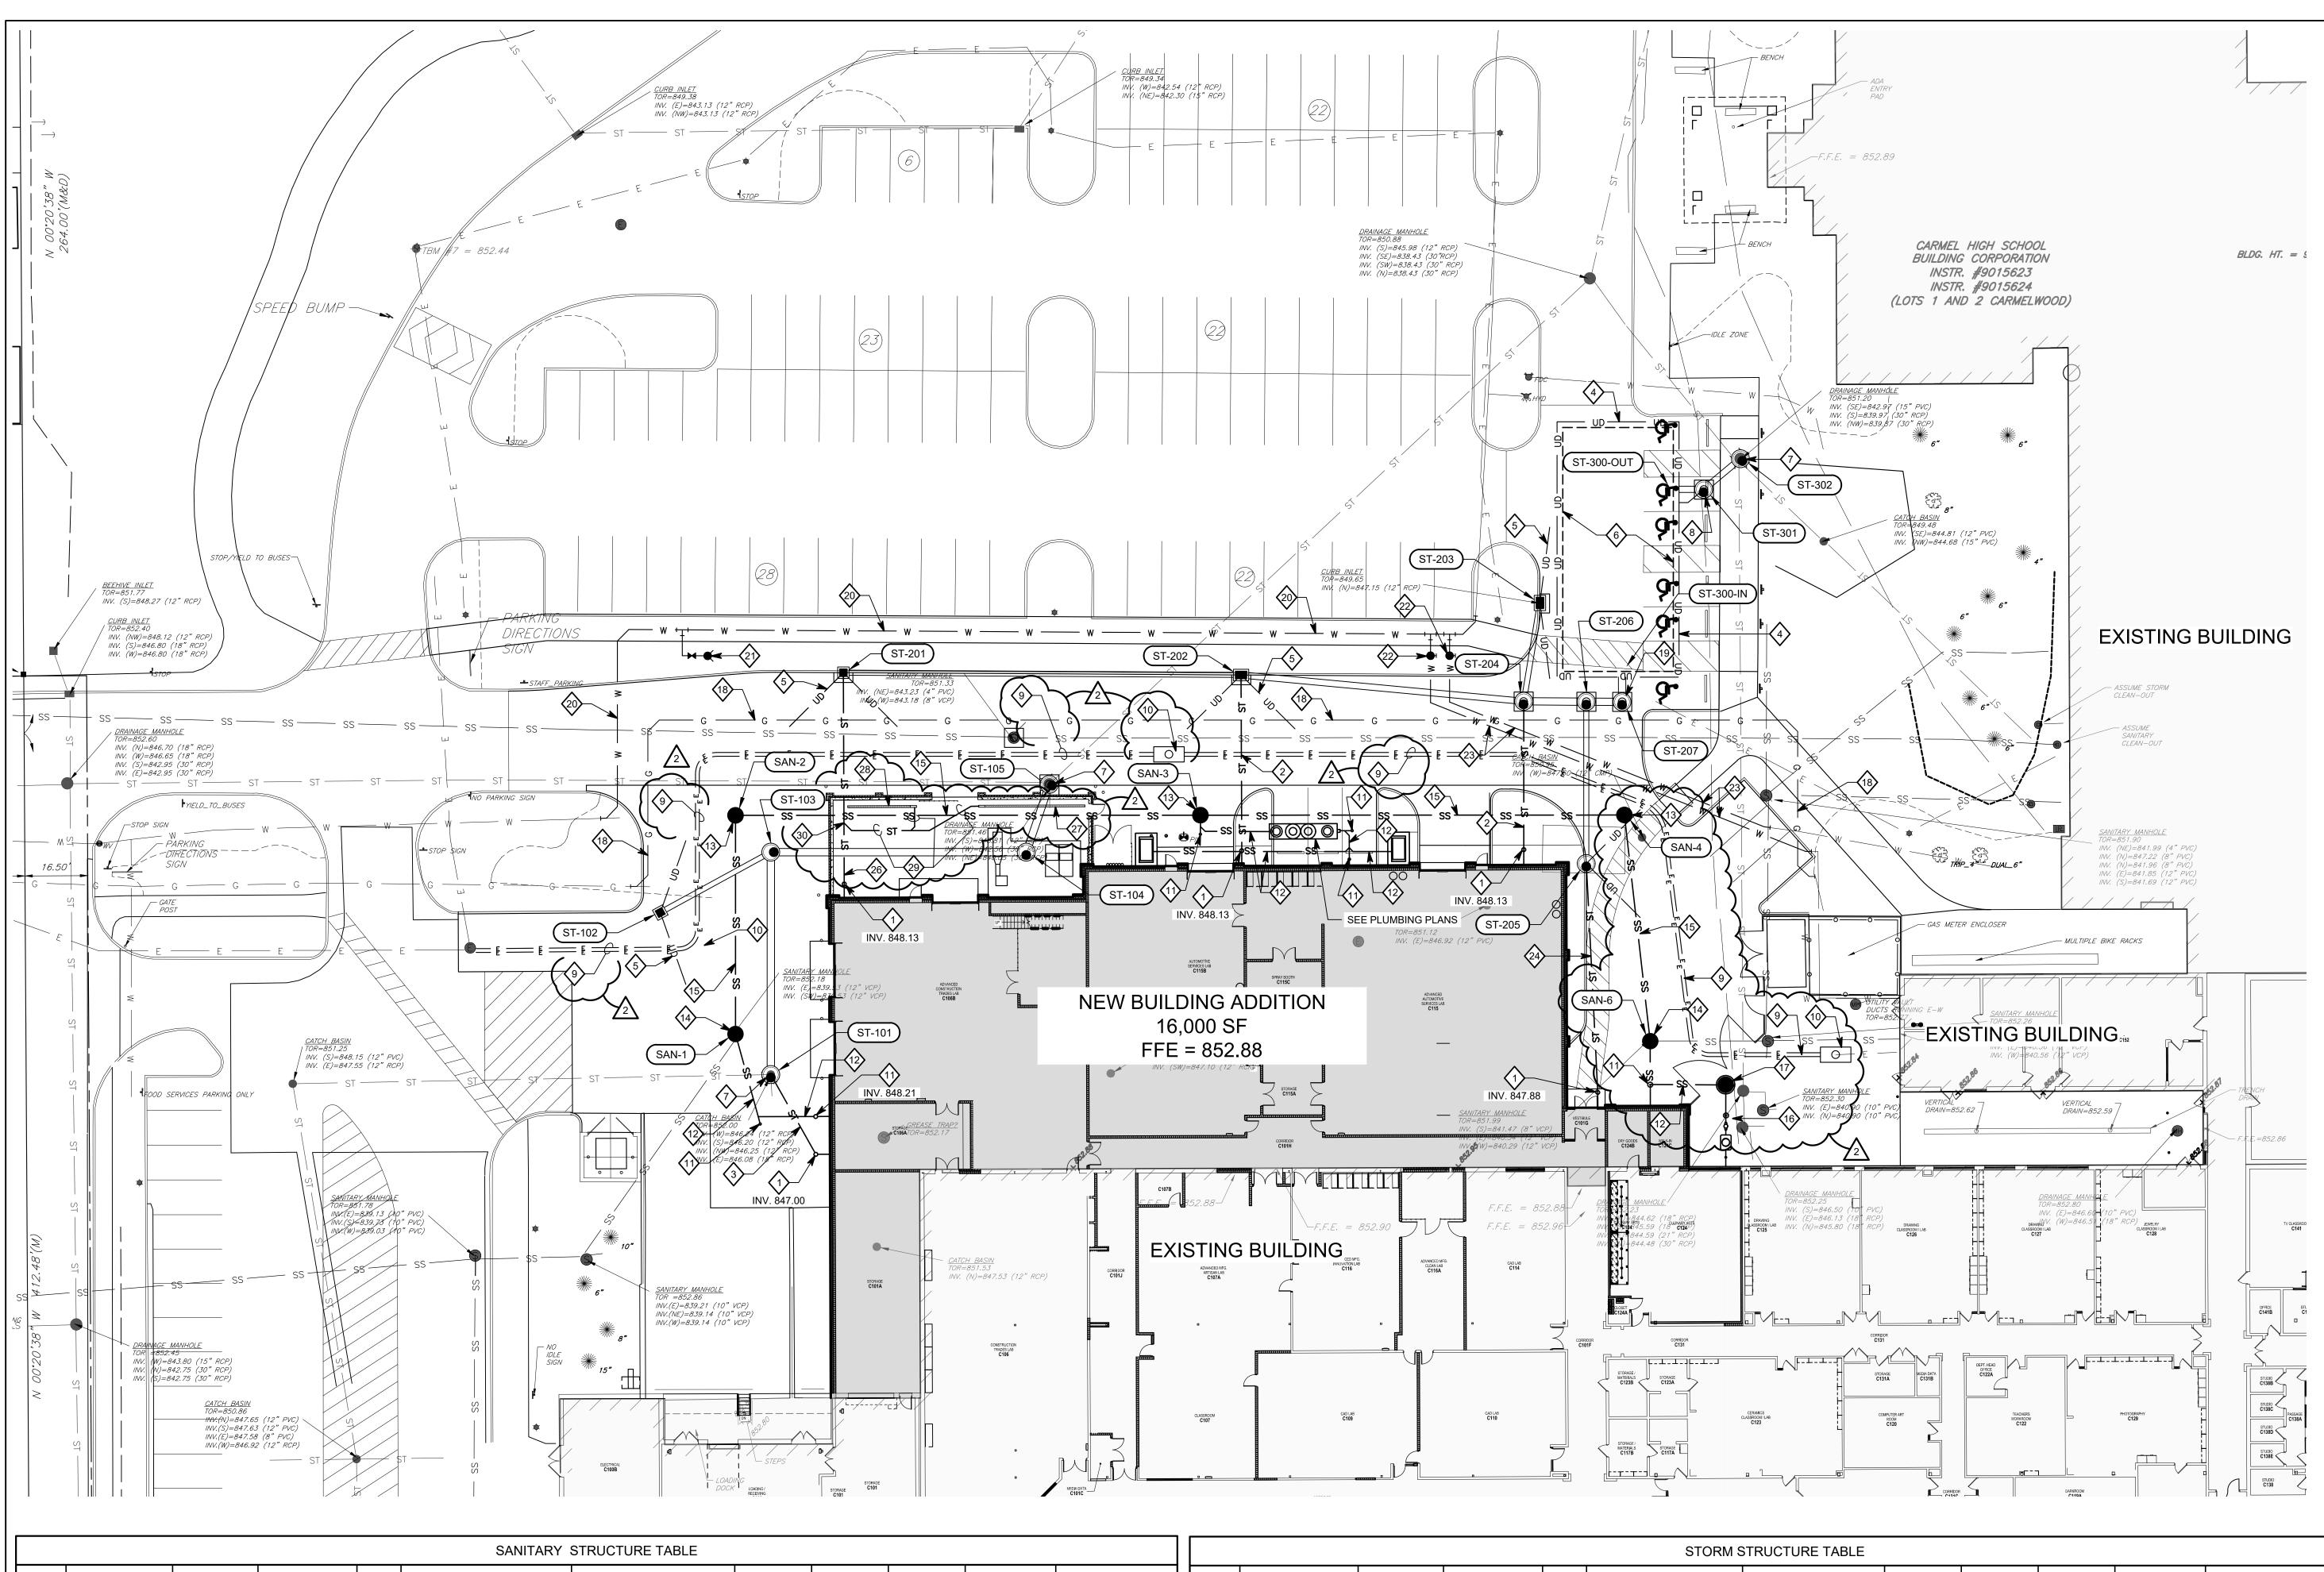


					SANITARY	STRUCTURE TABLE						STORM STRUCTURE TABLE											
STR NO.	STRUCTURE	STRUCTURE DETAIL CAST REFERENCE	ING TYPE F	RIM	INCOMING PIPE DATA (DIRECTION) [FROM STR]	OUTGOING PIPE D. (DIRECTION) [TO S		OUTGOING PIPE SIZE	OUTGOING GRADE	CONNECT TO STR.	REMARKS	STR. NO.	STRUCTURE	STRUCTURE DETAIL REFERENCE	CASTING TYPE	RIM	INCOMING PIPE DATA (DIRECTION) [FROM STR]	OUTGOING PIPE DATA (DIRECTION) [TO STR]	OUTGOING PIPE L.F.	OUTGOING PIPE SIZE	OUTGOING GRADE	CONNECT TO STR.	REMARKS
SAN-	1 48" SAN. MANHOLE	Sheet SU2.2 R·	-1642-A 85	51.82	12" PVC Pipe 839.55 (N) [SAN-2]	12" PVC Pipe 839.53 (S	W) [] 2'	12"	0.00%		-	101	Existing Manhole			952.00	12" RCP 846.24 (W) [] 12" RCP 846.20 (S) []	18"_RCP 846.08 (N) [103]	58'	18"	0.60%	102	CONNECT 10" ROOF DRAIN
SAN-	2 48" SAN. MANHOLE	Sheet SU2.2 R·	-1642-A 85	51.83	12" PVC Pipe 839.67 (E) [SAN-3]	12" PVC Pipe 839.67 (S) [SAN-1] 57'	12"	0.21%	SAN-1	-	101		-	-	852.00	10" PVC Pipe 846.58 (SE) []	2	56	10	0.00%	103	CONNECT TO ROOF DRAIN
SAN-	48" SAN. MANHOLE	Sheet SU2.2 R-	-1642-A 85	52.33	12" PVC Pipe 839.93 (E) [SAN-4]	12" PVC Pipe 839.93 (W)	SAN-2] 122'	12"	0.21%	SAN-2	-	102	Inlet Type "A"	Sheet SU2.1	R-3472	851.30		12" RCP 846.54 (NE) [103]	33'	12"	0.32%	103	-
SAN-	4 48" SAN. MANHOLE	Sheet SU2.2 R-				12" PVC Pipe 840.16 (W)	_	12"	0.21%	SAN-3		103	Type "C" Manhole	Sheet SU2.1	R-1772	851.98	18" RCP 845.73 (S) [101] 12" RCP 846.43 (SW) [102]	18" RCP 845.63 (E) [104]	67'	18"	0.70%	104	-
SAN-	Existing Manhole	-	- 85	ľ	12" PVC Pipe 840.34 (E) []		SAN-4] 60'	12"	0.20%	SAN-4	-	104	Type "C" Manhole	Sheet SU2.1	R-1772	852.64	18" RCP 845.16 (W) [103]	18" RCP 845.06 (N) [105]	19'	18"	0.70%	105	-
	\sum_{2}					$\langle \rangle_2$						105	Existing Manhole	-	-	851.87	18" RCP 844.93 (S) [104] 30" RCP 842.56 (W) []	30" RCP 840.05 (NE) []		30"			-
												201	Inlet Type "A"	Sheet SU2.1	R-3286-8V	851.54	8" PVC Pipe 847.10 (S) []	12" RCP 847.03 (E) [202]	104'	12"	0.32%	202	CONNECT 6" ROOF DRAIN
												202	Inlet Type "M"	Sheet SU2.1	R-3287-10V	850.58	12" RCP 846.70 (W) [201] 6" PVC Pipe 846.20 (S) []	15" RCP 846.20 (E) [204]	75'	15"	0.32%	204	CONNECT 6" ROOF DRAIN
· · · · · · · · · · · · · · · · · · ·												203	Inlet Type "M"	Sheet SU2.1	R-3287-SB10	849.65		12" RCP 845.96 (S) [204]	26'	12"	0.75%	204	-
												204	Type "C" Manhole	2	R-1772	849.96	15" RCP 845.96 (W) [202] 12" RCP 845.76 (N) [203] 6" PVC Pipe 846.00 (S) []	18" RCP 845.66 (E) [206]	16'	18"	0.40%	206	CONNECT 6" ROOF DRAIN
												205	Type "C" Manhole		R-3286-8V	851.18		12" RC 845.23 N) [206]	42'	12"	0.32%	206	-
-												206	Type "C" Manhole	Sheet SU2.1	R-1772	850.35	18" RCP 845.60 (W) [204] 12" RCP 845.10 (\$) [205]	18" RCP 841.10 (E) [207]	9'	18"	0.55%	207	-
												207	Aqua-Swirl XC-6	Sheet SU2.1	PER MAN.	850.57	18" RCP 841.04 (W) [206]	18" RCP 841.04 (N) [300-IN]	8'	18"	0.55%	300-IN	-
	(CAUTION !!							300-IN	Detention Chambers	Sheet SU2.1	-	850.45	18" RCP 841.00 (S) [207]						-
												300-OUT	Detention Chambers	Sheet SU2.1	-	850.84		15" RCP 841.00 (E) [301]	8'	15"	0.00%	301	-
			S⊦	HOWN OF	TIONS OF ALL EXISTING UNDERC N THE PLAN ARE BASED UPON A (INCLUDING, BUT NOT LIMITED T	BOVE GROUND						301	Outlet Control Structure	e Sheet SU2.1	R-1772	851.04	15" RCP 841.00 (W) [300-OUT]	15" RCP 840.25 (NE) [302]	13'	15"	0.00%	302	-
;	Knoww	hat's below	INI OT	ILETS, VA THERS) A	ALVES, AND MARKS MADE UPON AND ARE SPECULATIVE IN NATUR OTHER EXISTING UNDERGROUNE	THE GROUND BY RE. THERE MAY						302	Existing Manhole	-	-	851.19	15" RCP 840.25 (SW) [301] 30" RCP 839.97 (S) [] 15" RCP 842.97 (SE) []	30" RCP 839.87 (NW) []		30"			-



Call before you dig. Call 811 or 1-800-382-5544 Before You Begin Any Digging Project. Call 48 hours or 2 working days before you dig. It's Fast, It's Easy and It's the Law in the state of Indiana!

ALSO BE OTHER EXISTING UNDERGROUND UTILITIES FOR WHICH THERE IS NO ABOVE GROUND EVIDENCE OR FOR WHICH NO ABOVE GROUND EVIDENCE WAS OBSERVED. THE EXACT LOCATIONS OF EXISTING UNDERGROUND UTILITIES SHALL BE VERIFIED BY CONTRACTOR PRIOR TO ANY AND ALL CONSTRUCTION.

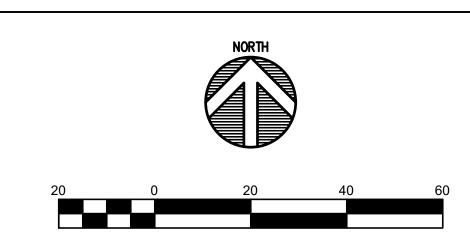

GENERAL NOTES

- 1. SEE DRAWING GD0.1 FOR GENERAL NOTES AND ADDITIONAL LEGEND.
- 2. TOPOGRAPHIC CONDITIONS AND EXISTING UTILITIES SHOWN WERE PROVIDED BY THE SURVEYOR. THE ENGINEER MAKES NO GUARANTEES THAT THE UNDERGROUND UTILITIES SHOWN COMPRISE ALL SUCH UTILITIES IN THE AREA, EITHER IN SERVICE OR ABANDONED.
- CONTRACTOR SHALL VERIFY ALL EXISTING CONDITIONS IN THE PROJECT AREA INCLUDING UNDERGROUND UTILITY CONDITIONS, LOCATION AND DEPTH PRIOR TO ANY OTHER SITE CONSTRUCTION. REPORT ANY DISCREPANCIES TO THE ENGINEER.

- 1. PROPOSED STORM CLEANOUT
- 2. PROPOSED 6" PVC STORM LATERAL @ 1.50% MIN. SLOPE
- 3. PROPOSED 10" PVC STORM LATERAL @ 1.50% MIN. SLOPE
- 4. PROPOSED 6" PERIMETER UNDERDRAIN, CONNECT TO ST-301.
- 5. PROPOSED PAVEMENT UNDERDRAIN, REQUIRED FOR EACH PROPOSED INLET.
- 6. PROPOSED UNDERGROUND DETENTION CHAMBER SYSTEM. STORM TECH, MC-3500 (32 CHAMBERS)
- 7. CONNECT PROPOSED STORM PIPE(S) TO EXISTING STRUCTURE. MODIFY OR REPLACE EXISTING STORM STRUCTURE AS NECESSARY. ADJUST TOP OF CASTING TO MATCH PROPOSED GRADE AS NECESSARY.
- 8. PROPOSED OUTLET CONTROL STORM MANHOLE $\sim 2^2$
- PLAN FOR ADDITIONAL INFORMATION. 10. PROPOSED PRECAST CONCRETE ELECTRICAL MANHOLE (8'x4'x6' DEPTH). SEE ELECTRICAL SITE PLAN FOR ADDITIONAL
- INFORMATION.
- 11. PROPOSED SANITARY CLEANOUT
- 12. PROPOSED 6" PVC SANITARY LATERAL @ 1.04% MIN. SLOPE
- 13. PROPOSED SANITARY MANHOLE
- 14. CONNECT PROPOSED SANITARY PIPE(S) TO EXISTING STRUCTURE. MODIFY EXISTING SANITARY STRUCTURE AS NECESSARY.
- 15. PROPOSED 12" PVC SANITARY SEWER
- 16. GREASE INTERCEPTOR (SEE PLUMBING PLANS)
- 17. MONITORING MANHOLE / SAMPLING PORT (SEE PLUMBING PLANS)
- 18. PROPOSED 4" GAS LINE (COORDINATE INSTALLATION WITH CENTERPOINT ENERGY)
- 19. PROPOSED AQUA-SWIRL XC-6 BMP STRUCTURE
- 20. PROPOSED 10" DUCTILE IRON PIPE WATER LINE
- 21. FIRE HYDRANT ASSEMBLY
- 22. POST INDICATOR VALVE (P.I.V.)
- 23. PROPOSED 8" DUCTILE IRON PIPE FIRE PROTECTION LINE
- 24. PROPOSED 8" PVC STORM LATERAL @ 1.50% MIN. SLOPE
- 25. CONNECT EXISTING 8" VCP SANITARY PIPE TO NEW 8" PVC PIPE WITH A FERNCO COUPLING
- 26. PROPOSED 8" PVC STORM LATERAL AT 1.80% SLOPE.
- 27. 26.24' OF ACO K100 TRENCH DRAIN (SEE ACO TRENCH DRAIN DETAIL ON SHEET SU2.1)
- 28. 23' OF ACO K100 TRENCH DRAIN (SEE ACO TRENCH DRAIN DETAIL ON SHEET SU2.1) FLOWING WEST TO EAST TO A K1 SERIES 900 INLINE CATCH BASIN. T/RIM ELEV. = 851.92'
- 29. 4" PVC STORM LATERAL @ 2.00% SLOPE


30. PROVIDE A PVC WYE FITTING 8"x8"x4"


UTILITY PLAN LEGEND


ST	EXISTING STORM LINE
SS	EXISTING SANITARY LIN
G	EXISTING GAS LINE
W	EXISTING WATER LINE
-X-	EXISTING LIGHT POLE
	EXISTING STORM STRU
S	EXISTING SANITARY STR
A	EXISTING FIRE HYDRAN
st	PROPOSED STORM LINE
SS	PROPOSED SANITARY L
	PROPOSED MANHOLE S
	PROPOSED STORM INLE
G	PROPOSED / RELOCATE


EXISTING SANITARY LINE EXISTING GAS LINE EXISTING WATER LINE EXISTING LIGHT POLE EXISTING STORM STRUCTURE EXISTING SANITARY STRUCTURE EXISTING FIRE HYDRANT PROPOSED STORM LINE PROPOSED SANITARY LINE PROPOSED MANHOLE STRUCTURE PROPOSED STORM INLET STRUCTURE


PROPOSED / RELOCATED GAS LINE

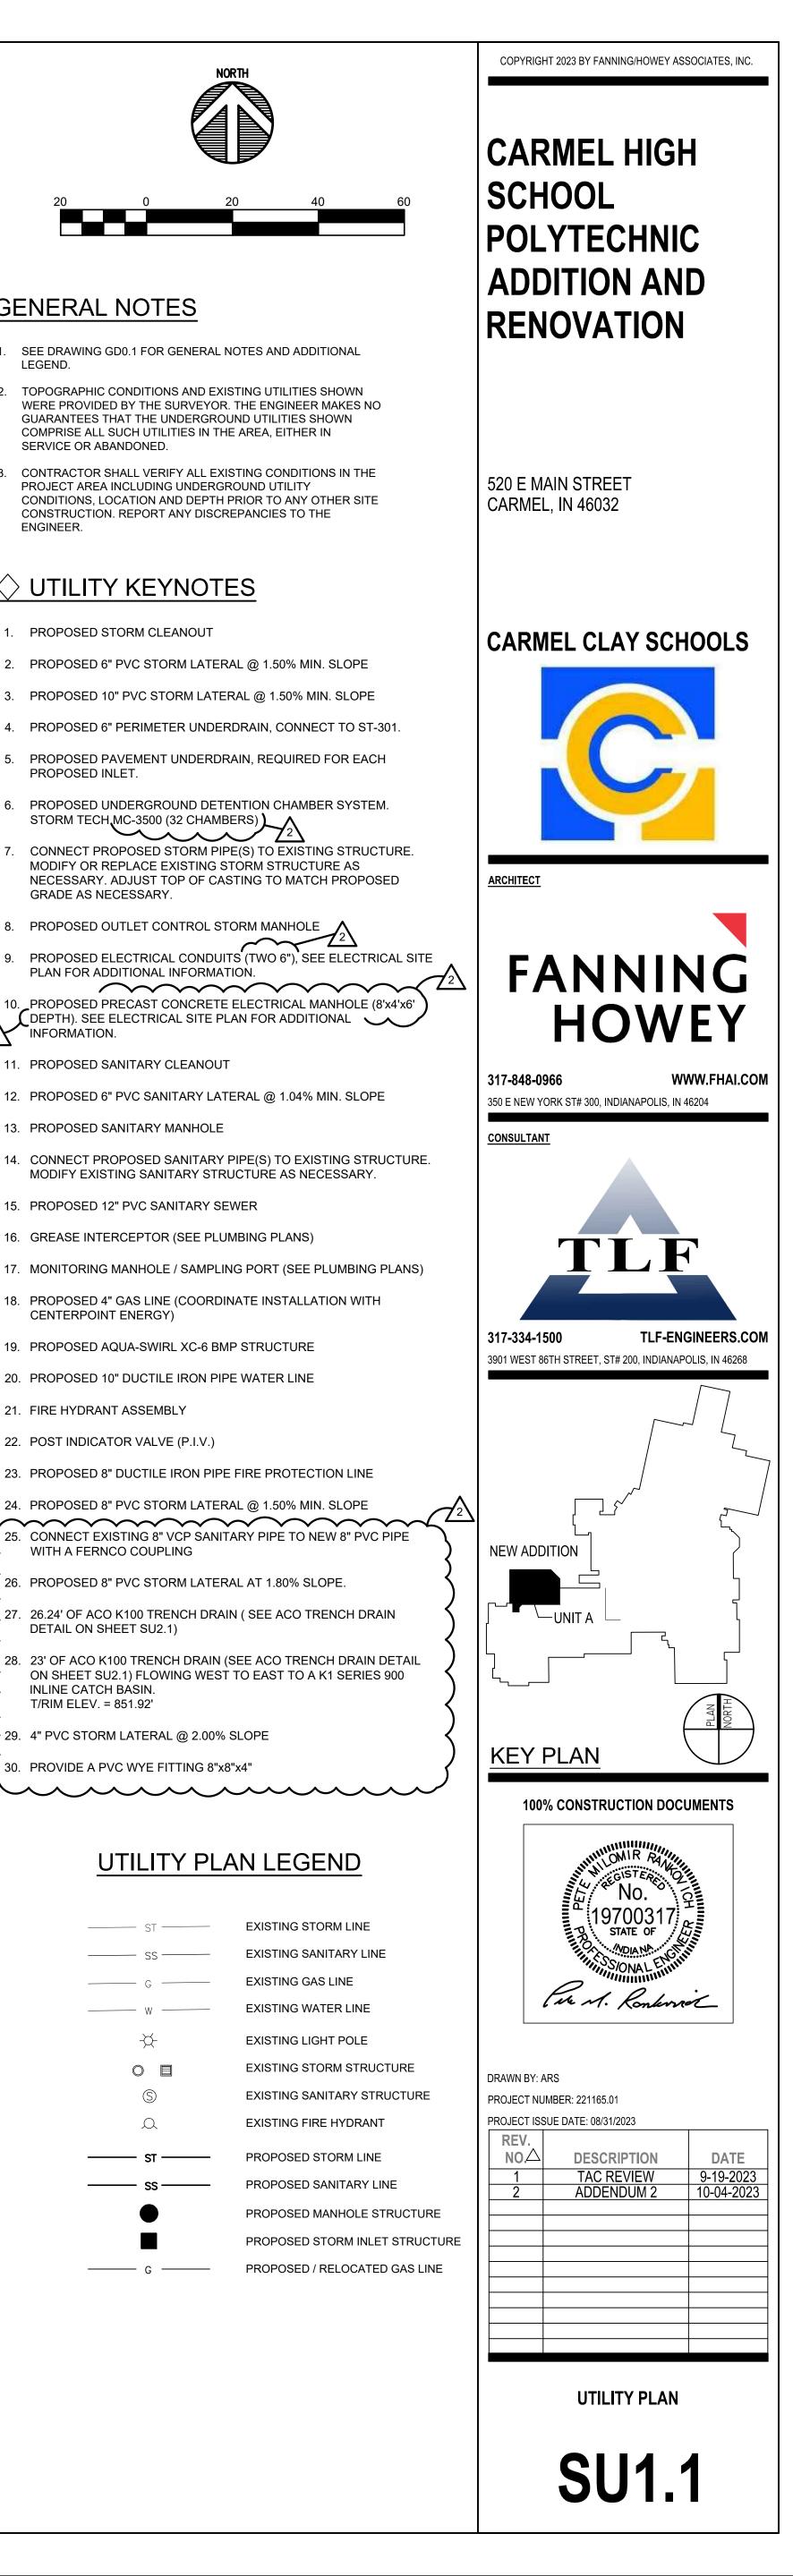

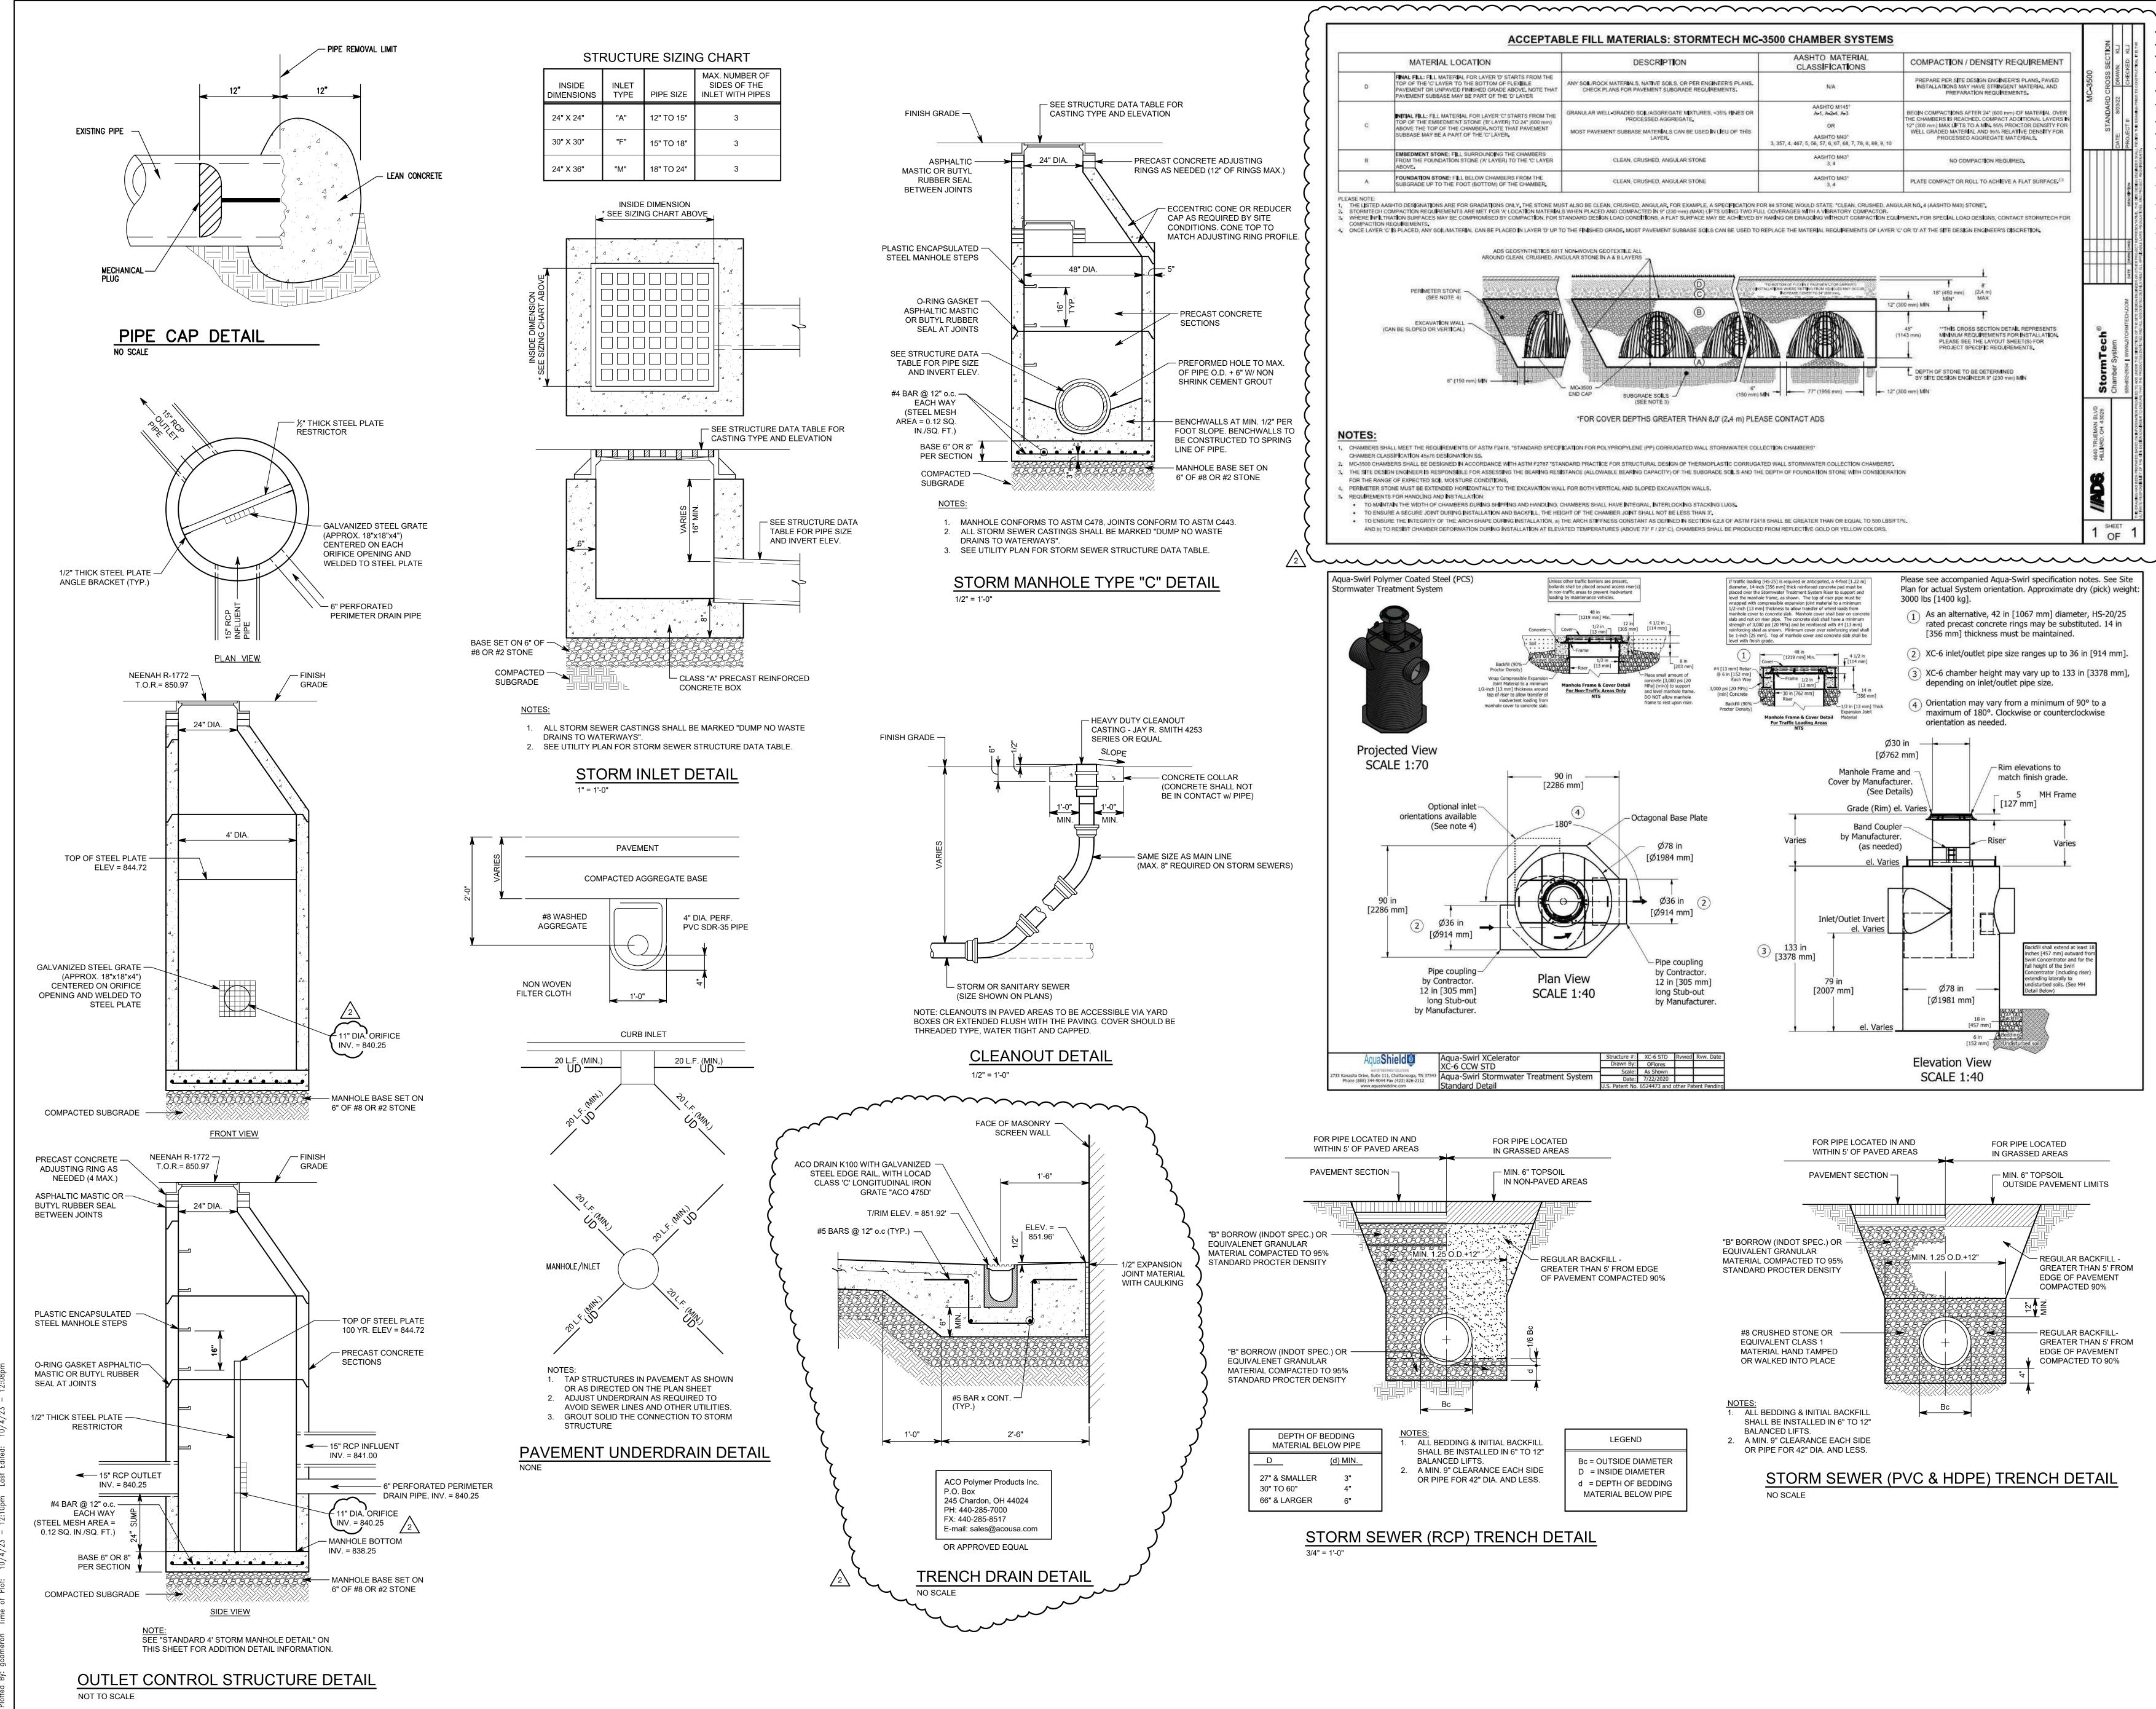

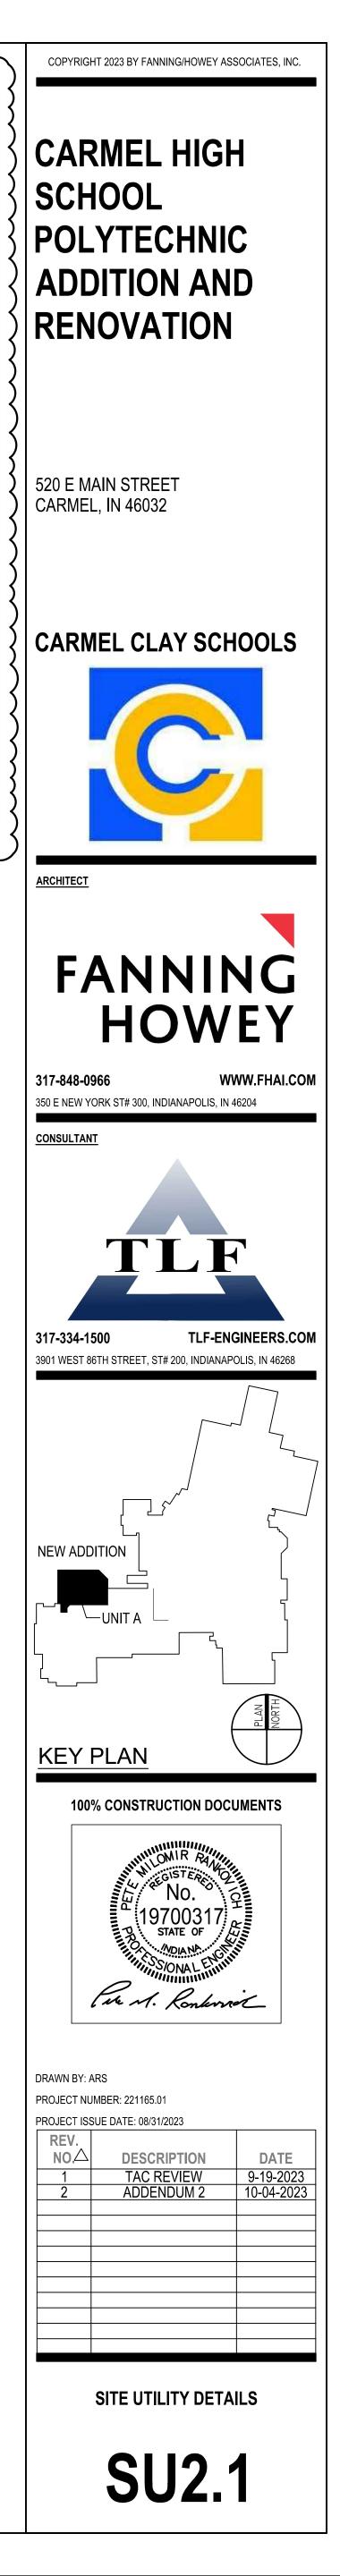


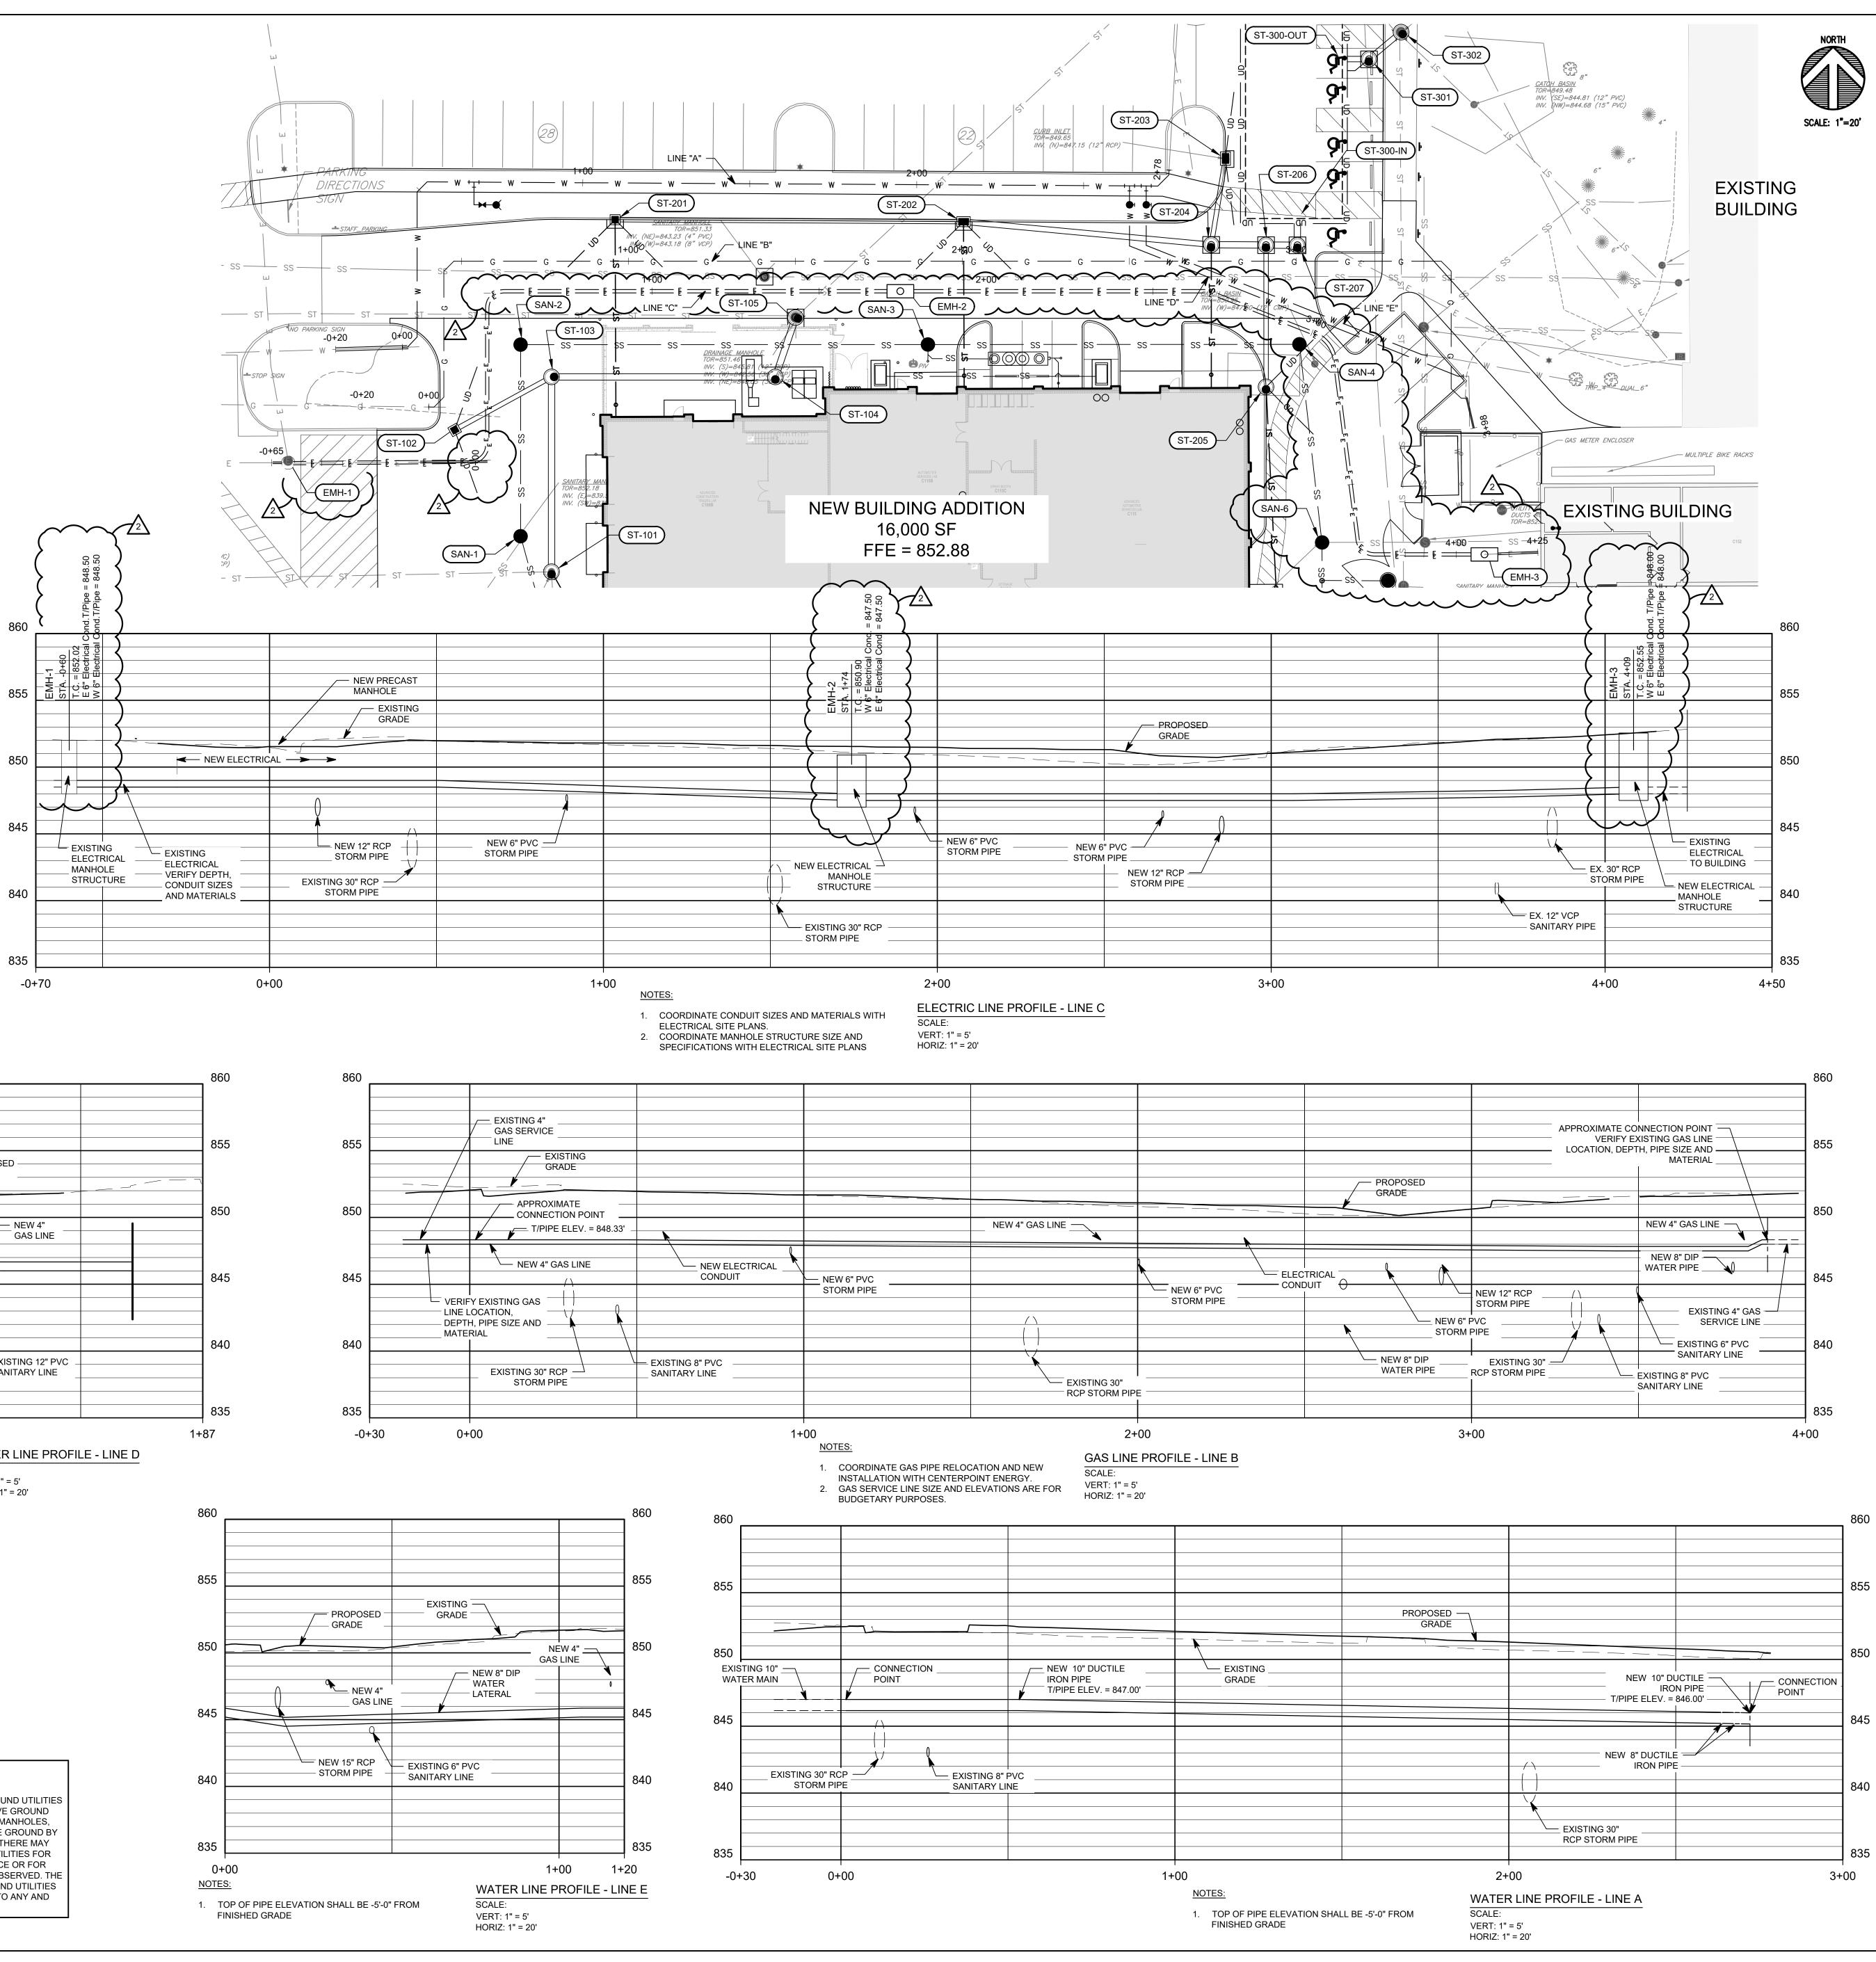

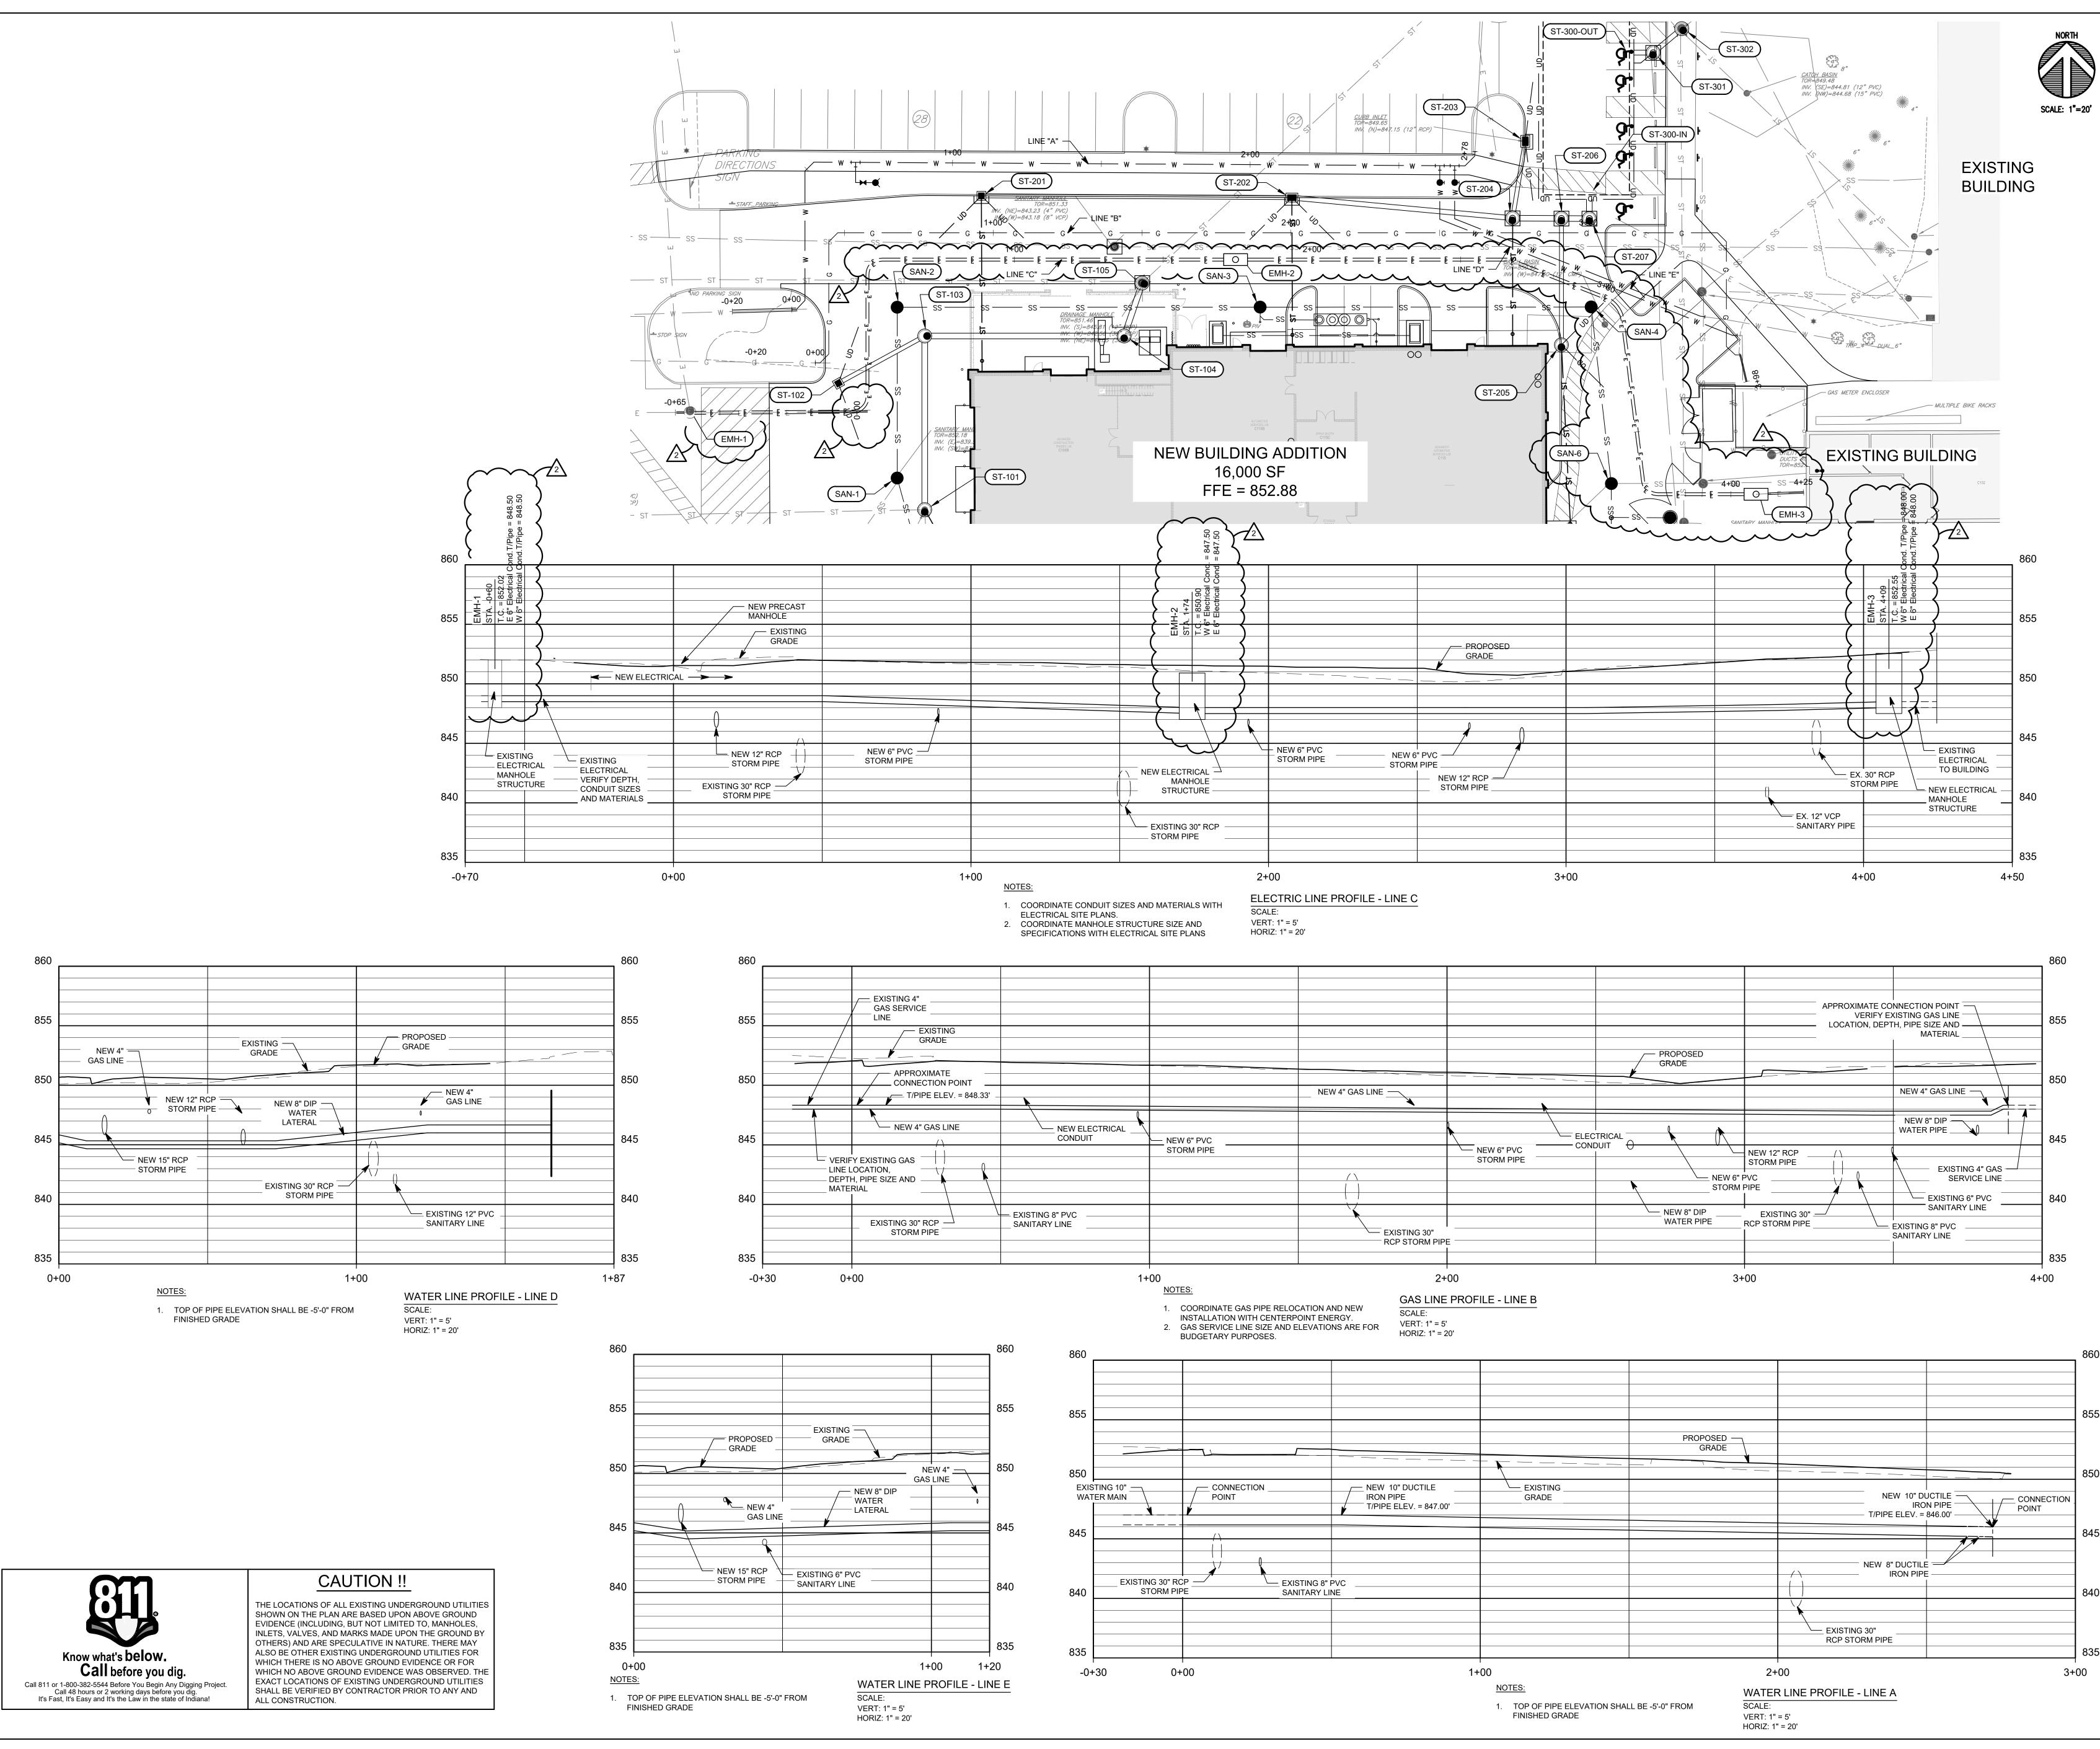

of 11 ime a X



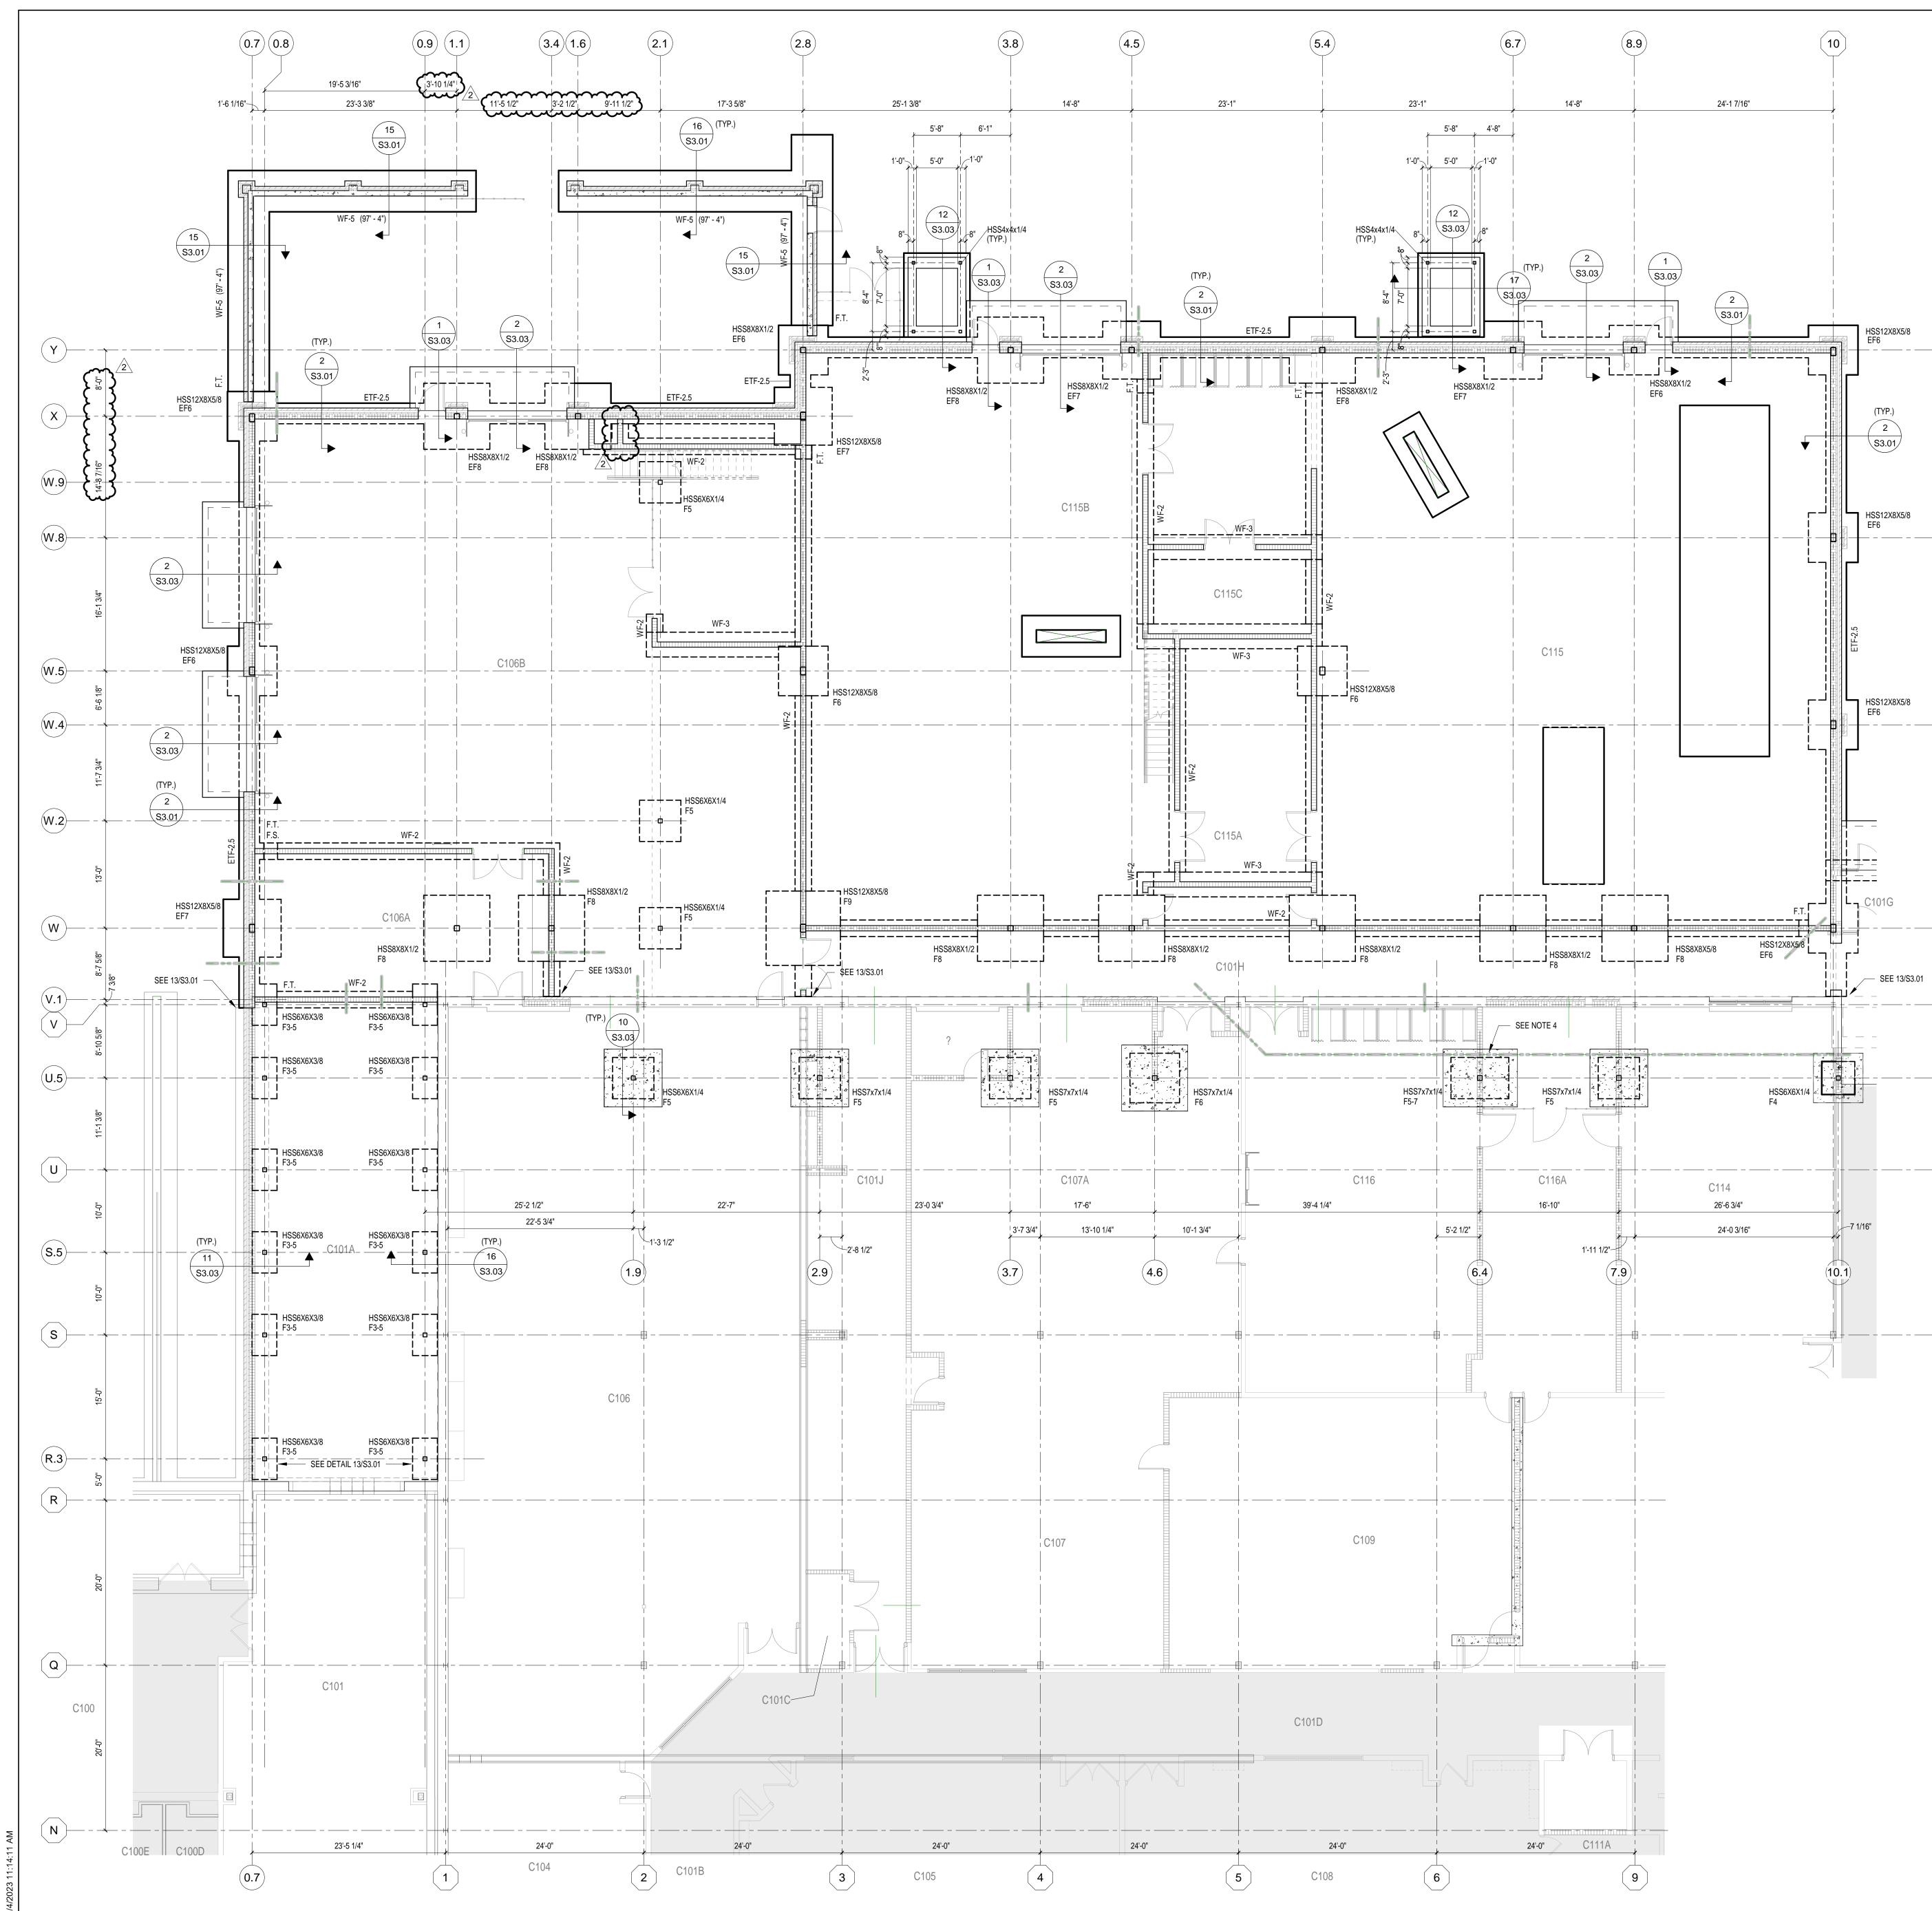

UNIT A - FOUNDATION PLAN



PLAN NOTES:

- REFERENCE ELEVATION = TOP OF EXISTING FINISH FLOOR = 100'-0" (852.88' U.S.G.S.).
- TOP OF FOOTING (T/FOOTING) ELEVATION = 98'-8" (U.O.N.).
- (XXX'-X") INDICATES TOP OF FOOTING OR PIER ELEVATION. TAKE CARE NOT TO CUT EXISTING 4" BELOW SLAB SANITARY LINE DURING DEMOLITION OF EXISTING SLAB ON GRADE. NOTIFY EOR IF EXISTING SANITARY IS WITHIN FOOTPRINT OF NEW FOOTING(S) SO SIZE/LOCATION OF FOOTINGS CAN BE REEAVLUATED FOR THE CONFLICT.

FOUNDATION PLAN NOTES

4.

6.

12.

13.

18.

19


20.


- SEE SHEET S0.01 FOR GENERAL NOTES.
- SEE S3.01 THROUGH S3.03 FOR FOUNDATION DETAILS. TYPICAL DETAILS MAY NOT BE CUT ON PLANS, BUT APPLY UNLESS OTHERWISE NOTED.
- CENTER WALL FOOTINGS UNDER WALLS UNLESS NOTED OTHERWISE.
- FX, EFX INDICATES INTERIOR FOUNDATION F"X" OR EXTERIOR FOUNDATION EF"X" SEE COLUMN FOOTING SCHEDULE ON S3.01.
- ETF-X INDICATES EXTERIOR TRENCH FOOTING ETF-"X". SEE TYPICAL EXTERIOR TRENCH FOOTING DETAIL ON \$3.01. 5.
- WF-X, INDICATES INTERIOR WALL FOOTING WF-"X". TYPICAL INTERIOR WALL FOOTING DETAIL ON \$3.01.
- RWFX INDICATES RETAINING WALL FOOTING RWF"X" SEE TYPICAL RETINING WALL DETAIL ON \$3.01.
- P1, P2, ETC. INDICATES CONCRETE PIER. SEE TYPICAL PIER DETAIL ON \$3.01. TOP OF PIER ELEVATION = 98'-8" (U.O.N.).
- MP1, MP2, ETC. INDICATES MASONRY PILASTER. SEE MASONRY PILASTER (MP).
- SEE S3.01 FOR TYPICAL INTERIOR COLUMN FOOTING DETAIL
- SEE 5-S3.01 FOR TYPICAL COLUMN BASE.
- SEE 3-S3.01 FOR TYPICAL COLUMN BASE PLATE.
- FOOTINGS MAY BE EARTH-FORMED WHERE COHESIVE SOILS EXIST AT FOUNDATION ELEVATION. REFER TO THE PROJECT MANUAL. THE CONTRACTOR SHALL INCLUDE IN THEIR BID FORMING OF FOOTINGS WHERE REVIEW OF THE GEOTECHNICAL ENGINEERING REPORT INDICATES EARTH-FORMING MAY NOT BE POSSIBLE.
- VERIFY LOCATION AND ELEVATION OF ALL UNDERGROUND PLUMBING LINES. SEE 14. SHEET S3.02 FOR REQUIREMENTS WHEN PLUMBING LINES CROSS FOUNDATIONS AT ALL ELEVATIONS.
- 15. SEE 6-S3.03 FOR TYPICAL SLAB ON GRADE.
- SEE 7-S3.03 FOR SLAB ISOLATIONS. 16.
- SEE ARCHITECTURAL PLANS FOR RAISED LOCKER BASES.
- F.T. INDICATES FOOTING TRANSITION. SEE 11-S3.01.
- F.S. INDICATES STEPPED FOOTING. SEE S3.01 FOR DETAILS

LEGEND:

INDICATES UNDERGROUND PLUMBING OR


UTILITY LINE. VERIFY LOCATION AND ELEVATIONS. SEE S3.02 FOR REQUIREMENTS WHEN PLUMBING LINES CROSS FOUNDATIONS AT ALL ELEVATIONS.

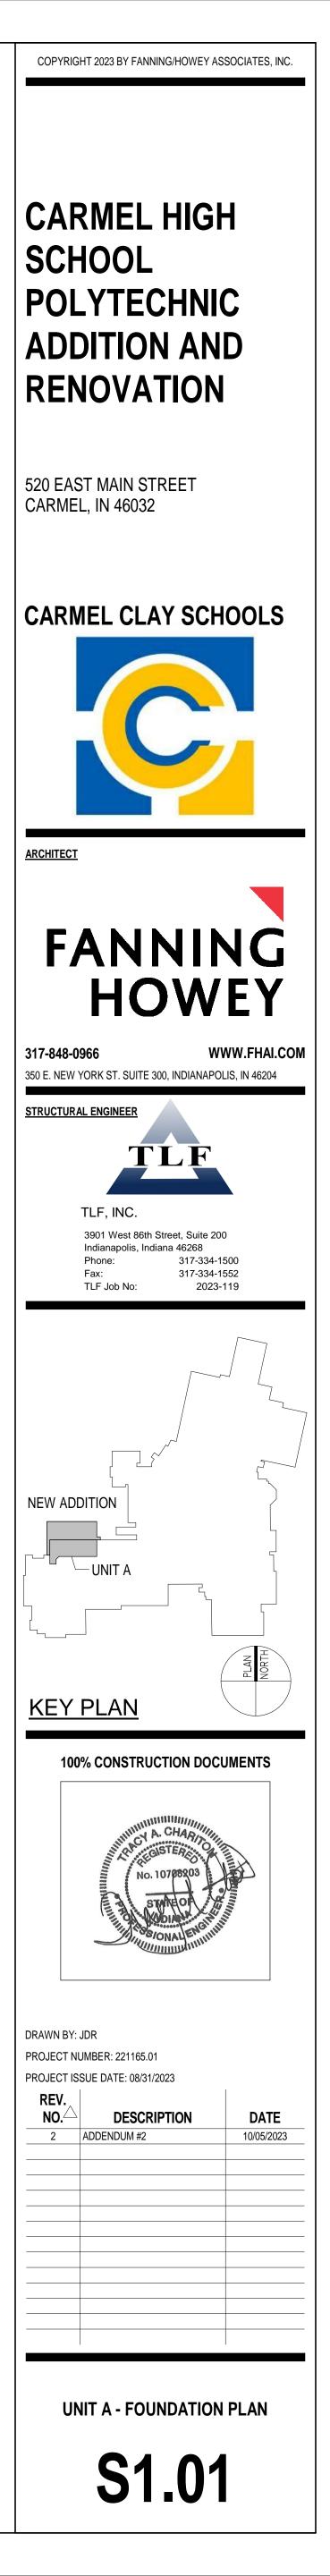

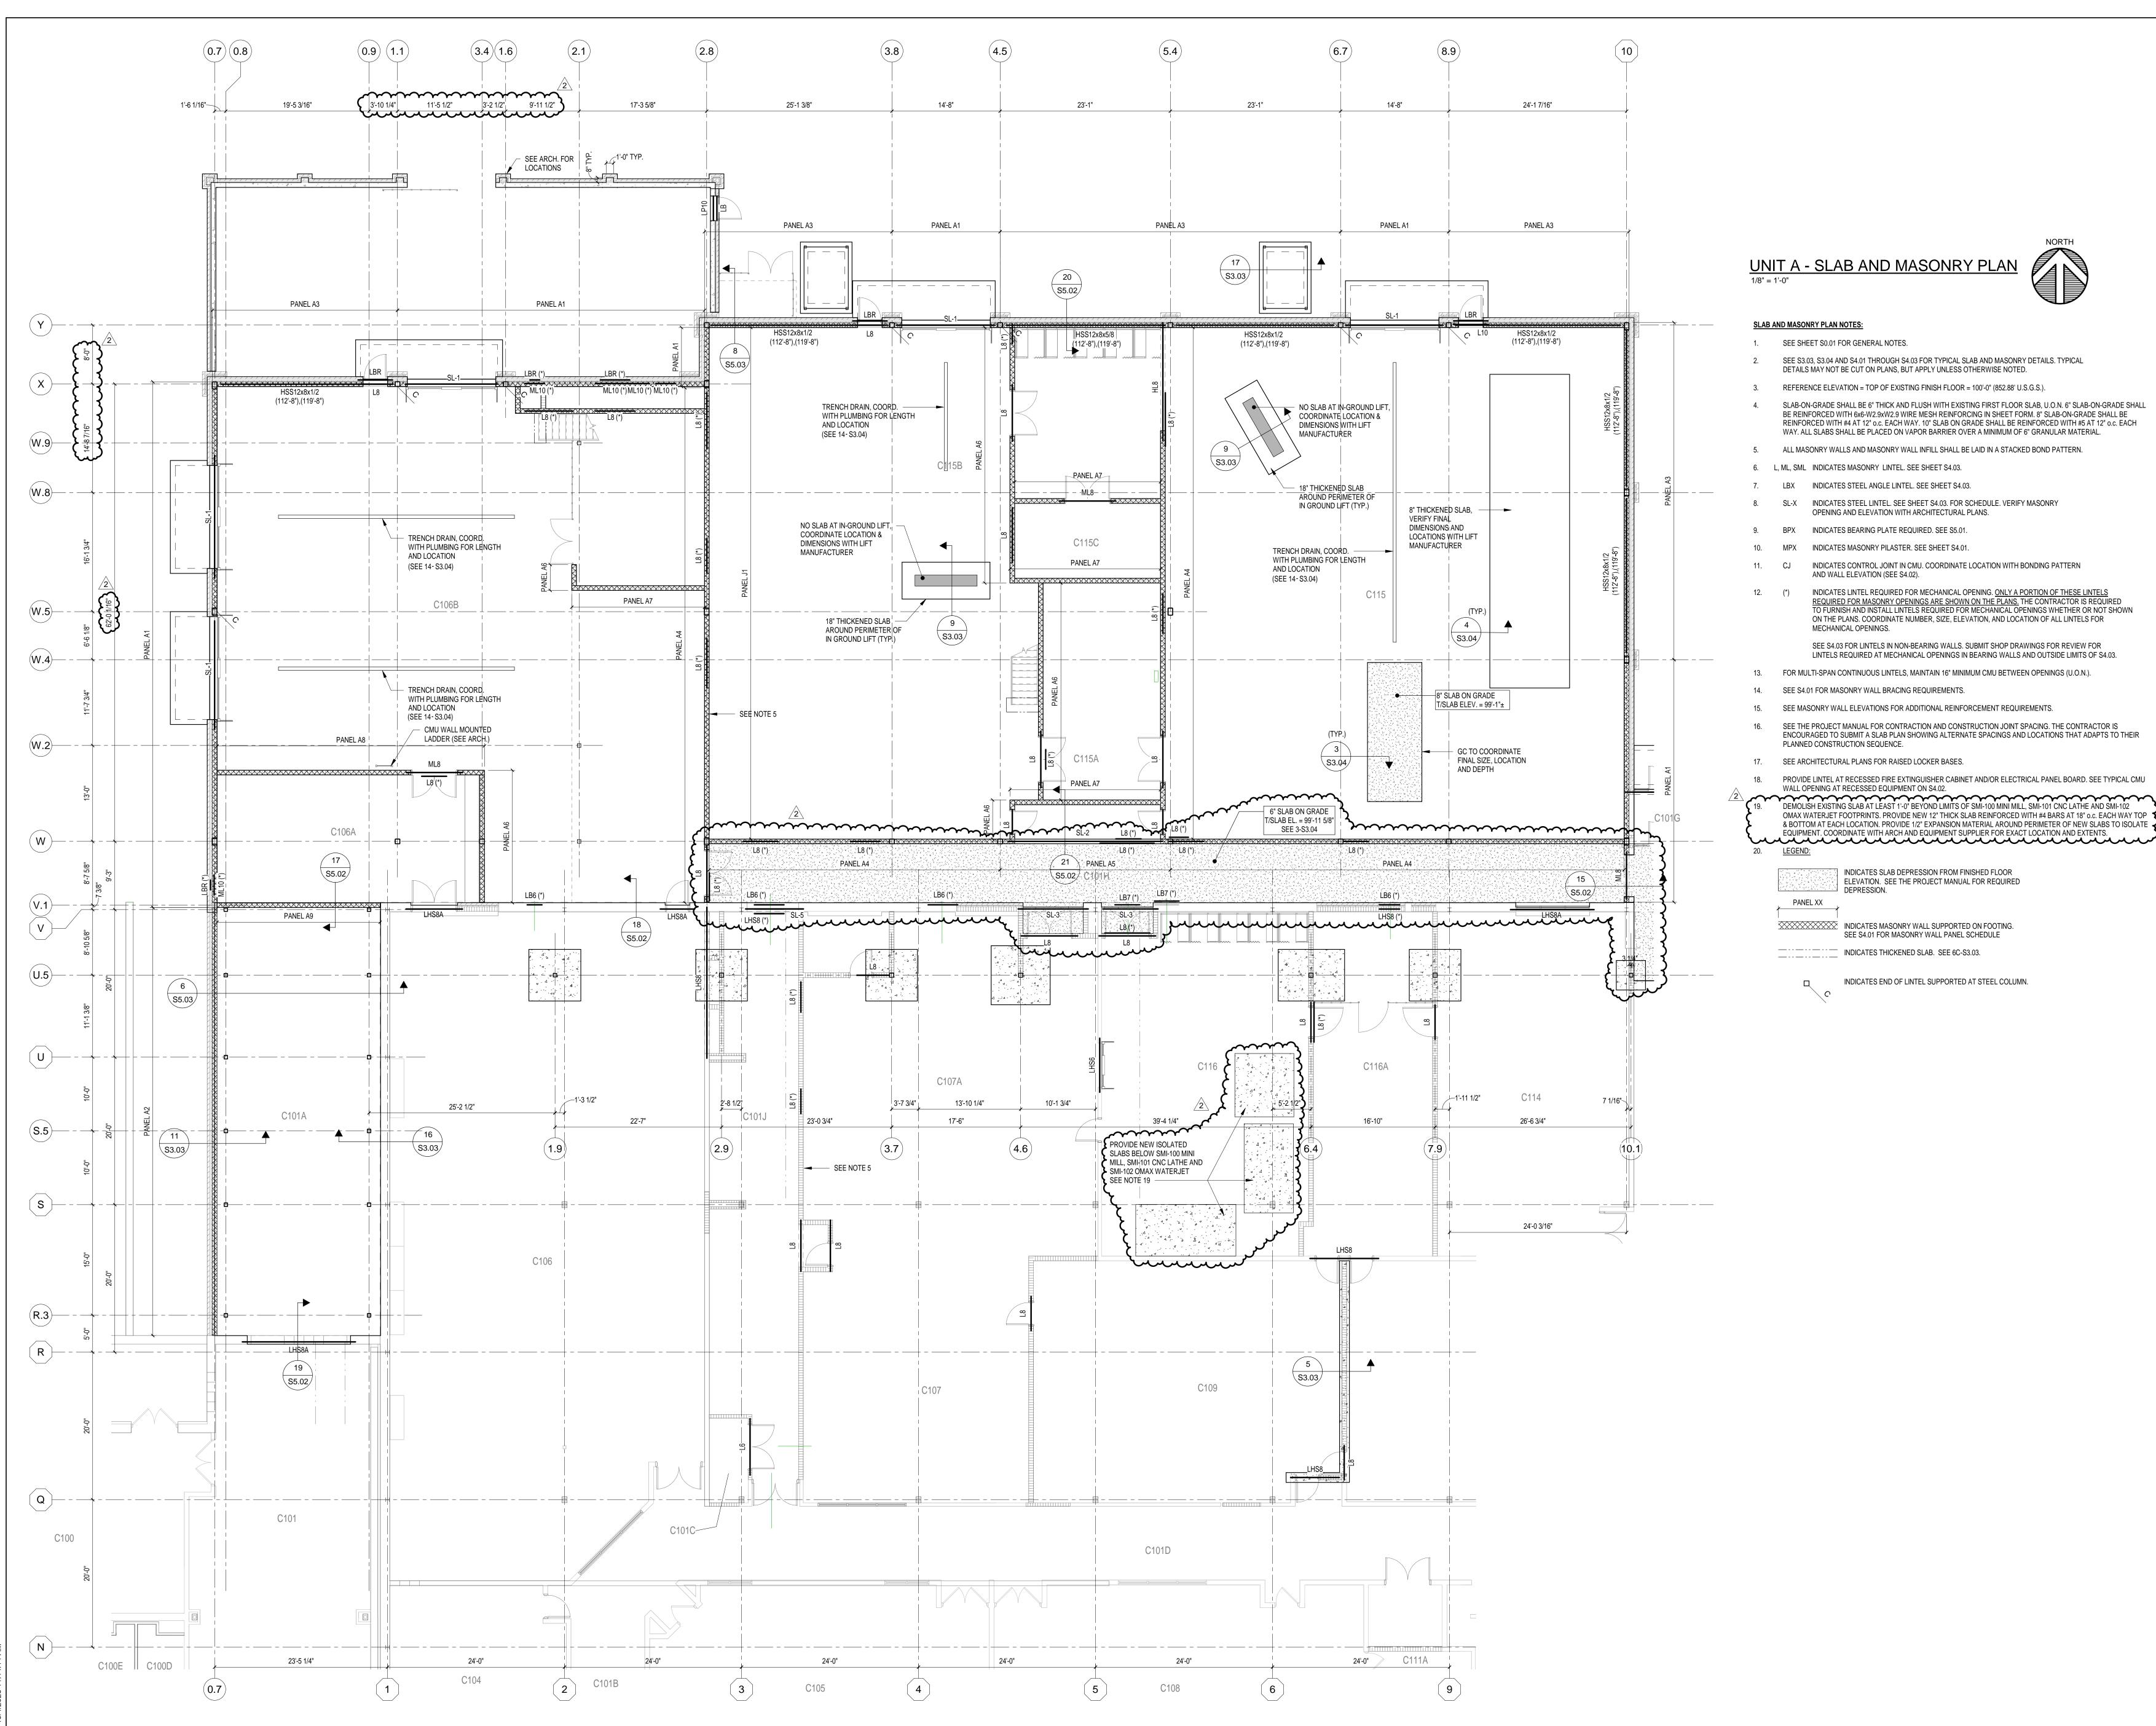


s\tchariton\Documents\2021_STRC_221165.01_Carmel HS Polytechnic_tcharitonCLENT.rvt

C:\Users\tcharito 10/4/2023 11·14·

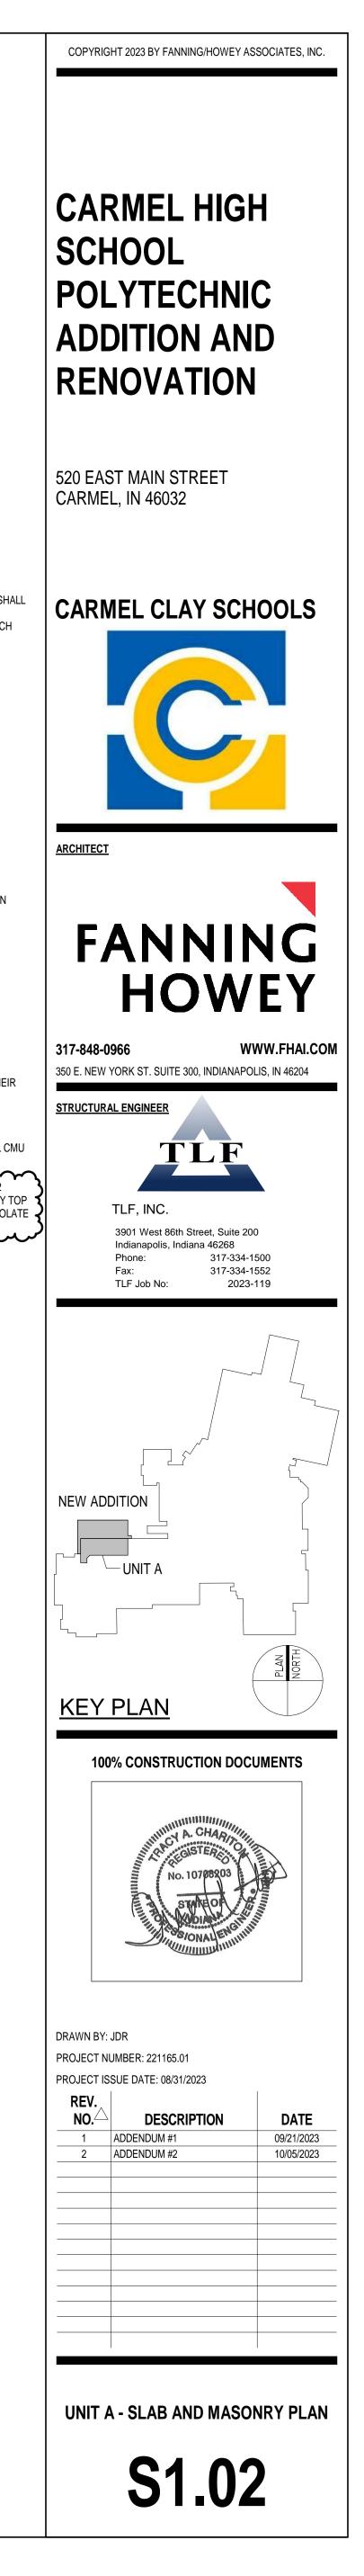

Users\tchariton\Documents\2021_STRC_221165.01_Carmel HS Polytechnic_tcharitonCLENT.rvt

0/4/2023 11:14:17 AM

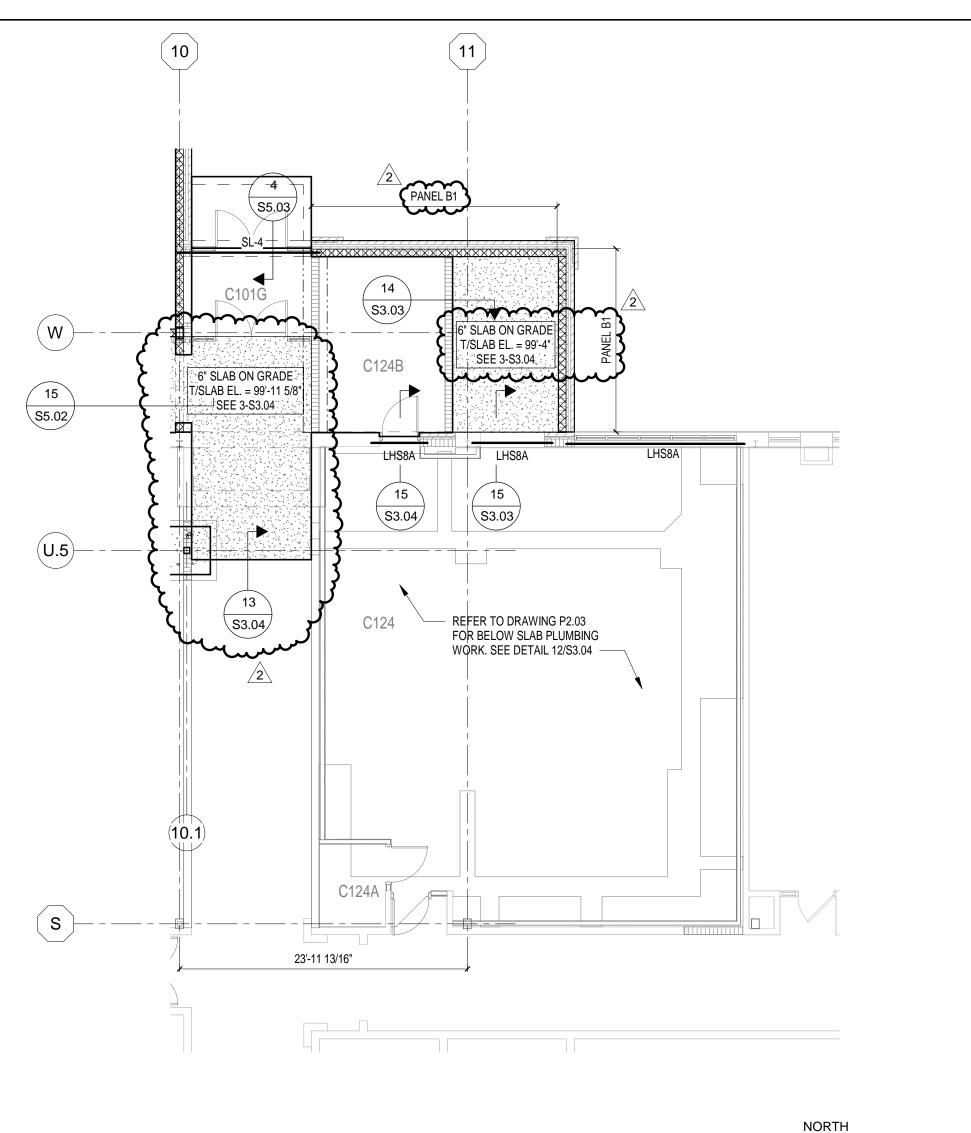

UNIT B - SLAB AND MASONRY PLAN



SLAB AND MASONRY PLAN NOTES:

4.

1. SEE SHEET S0.01 FOR GENERAL NOTES.

- 2. SEE S3.03, S3.04 AND S4.01 THROUGH S4.03 FOR TYPICAL SLAB AND MASONRY DETAILS. TYPICAL DETAILS MAY NOT BE CUT ON PLANS, BUT APPLY UNLESS OTHERWISE NOTED.
- 3. REFERENCE ELEVATION = TOP OF EXISTING FINISH FLOOR = 100'-0" (852.88' U.S.G.S.).
- SLAB-ON-GRADE SHALL BE 6" THICK AND FLUSH WITH EXISTING FIRST FLOOR SLAB, U.O.N. 6" SLAB-ON-GRADE SHALL BE REINFORCED WITH 6x6-W2.9xW2.9 WIRE MESH REINFORCING IN SHEET FORM. 8" SLAB-ON-GRADE SHALL BE REINFORCED WITH #4 AT 12" o.c. EACH WAY. 10" SLAB ON GRADE SHALL BE REINFORCED WITH #5 AT 12" o.c. EACH WAY. ALL SLABS SHALL BE PLACED ON VAPOR BARRIER OVER A MINIMUM OF 6" GRANULAR MATERIAL.
- 5. ALL MASONRY WALLS AND MASONRY WALL INFILL SHALL BE LAID IN A STACKED BOND PATTERN.
- 6. L, ML, SML INDICATES MASONRY LINTEL. SEE SHEET S4.03.
- 7. LBX INDICATES STEEL ANGLE LINTEL. SEE SHEET S4.03.
- 8. SL-X INDICATES STEEL LINTEL. SEE SHEET S4.03. FOR SCHEDULE. VERIFY MASONRY
- OPENING AND ELEVATION WITH ARCHITECTURAL PLANS.9. BPX INDICATES BEARING PLATE REQUIRED. SEE S5.01.
- 10. MPX INDICATES MASONRY PILASTER. SEE SHEET S4.01.
- 11. CJ INDICATES CONTROL JOINT IN CMU. COORDINATE LOCATION WITH BONDING PATTERN
- AND WALL ELEVATION (SEE S4.02).
- 12. (*) INDICATES LINTEL REQUIRED FOR MECHANICAL OPENING. <u>ONLY A PORTION OF THESE LINTELS</u> <u>REQUIRED FOR MASONRY OPENINGS ARE SHOWN ON THE PLANS.</u> THE CONTRACTOR IS REQUIRED TO FURNISH AND INSTALL LINTELS REQUIRED FOR MECHANICAL OPENINGS WHETHER OR NOT SHOWN ON THE PLANS. COORDINATE NUMBER, SIZE, ELEVATION, AND LOCATION OF ALL LINTELS FOR MECHANICAL OPENINGS.
 - SEE S4.03 FOR LINTELS IN NON-BEARING WALLS. SUBMIT SHOP DRAWINGS FOR REVIEW FOR LINTELS REQUIRED AT MECHANICAL OPENINGS IN BEARING WALLS AND OUTSIDE LIMITS OF S4.03.
- 13. FOR MULTI-SPAN CONTINUOUS LINTELS, MAINTAIN 16" MINIMUM CMU BETWEEN OPENINGS (U.O.N.).
- 14. SEE S4.01 FOR MASONRY WALL BRACING REQUIREMENTS.
- 15. SEE MASONRY WALL ELEVATIONS FOR ADDITIONAL REINFORCEMENT REQUIREMENTS.
- 16. SEE THE PROJECT MANUAL FOR CONTRACTION AND CONSTRUCTION JOINT SPACING. THE CONTRACTOR IS ENCOURAGED TO SUBMIT A SLAB PLAN SHOWING ALTERNATE SPACINGS AND LOCATIONS THAT ADAPTS TO THEIR PLANNED CONSTRUCTION SEQUENCE.
- 17. SEE ARCHITECTURAL PLANS FOR RAISED LOCKER BASES.

DEPRESSION.

- 18. PROVIDE LINTEL AT RECESSED FIRE EXTINGUISHER CABINET AND/OR ELECTRICAL PANEL BOARD. SEE TYPICAL CMU WALL OPENING AT RECESSED EQUIPMENT ON \$4.02.
- 19. DEMOLISH EXISTING SLAB AT LEAST 1'-0" BEYOND LIMITS OF SMI-100 MINI MILL, SMI-101 CNC LATHE AND SMI-102 OMAX WATERJET FOOTPRINTS. PROVIDE NEW 12" THICK SLAB REINFORCED WITH #4 BARS AT 18" o.c. EACH WAY TOP & BOTTOM AT EACH LOCATION. PROVIDE 1/2" EXPANSION MATERIAL AROUND PERIMETER OF NEW SLABS TO ISOLATE EQUIPMENT. COORDINATE WITH ARCH AND EQUIPMENT SUPPLIER FOR EXACT LOCATION AND EXTENTS.

20. <u>LEGEND:</u>

INDICATES SLAB DEPRESSION FROM FINISHED FLOOR ELEVATION. SEE THE PROJECT MANUAL FOR REQUIRED


PANEL XX

INDICATES MASONRY WALL SUPPORTED ON FOOTING. SEE S4.01 FOR MASONRY WALL PANEL SCHEDULE

INDICATES THICKENED SLAB. SEE 6C-S3.03.



INDICATES END OF LINTEL SUPPORTED AT STEEL COLUMN.

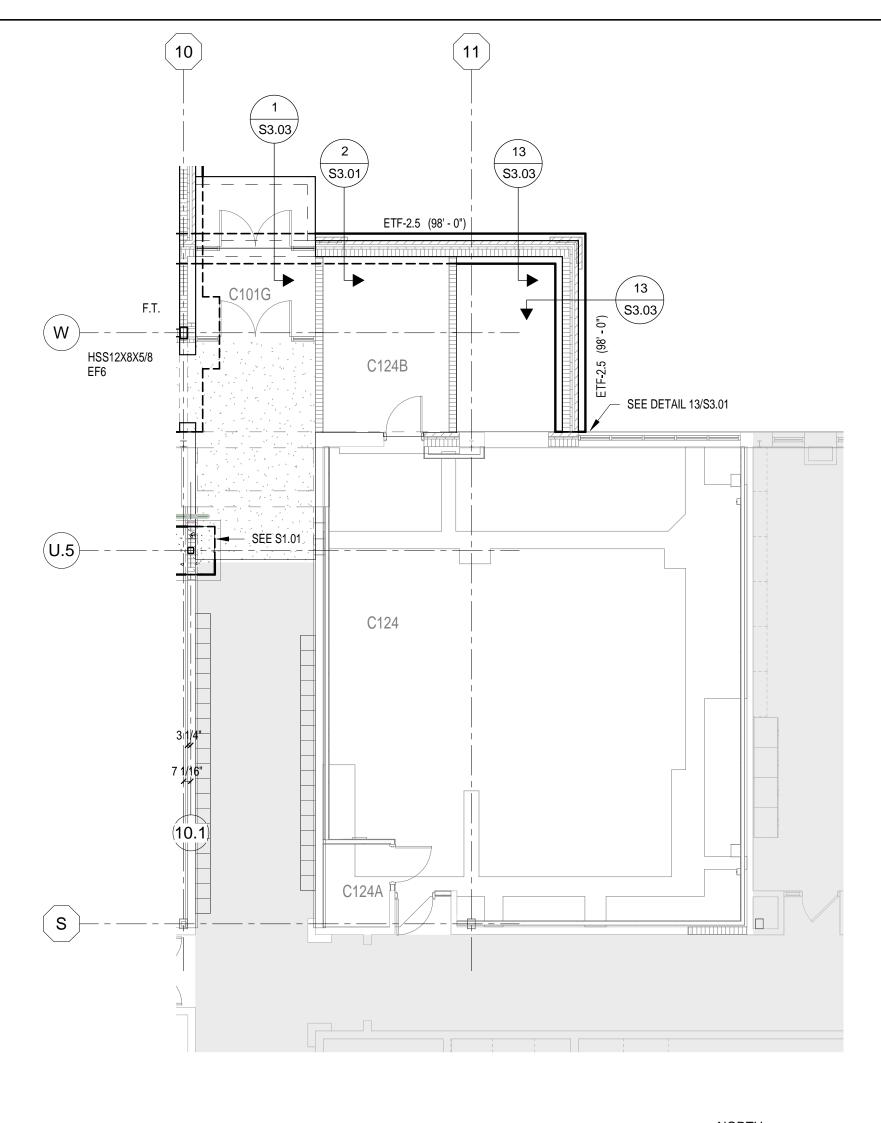

UNIT B - FOUNDATION PLAN





PLAN NOTES:


- 1. REFERENCE ELEVATION = TOP OF EXISTING FINISH FLOOR = 100'-0" (852.88' U.S.G.S.).
- 2. TOP OF FOOTING (T/FOOTING) ELEVATION = 98'-8" (U.O.N.).
- 3. (XXX'-X") INDICATES TOP OF FOOTING OR PIER ELEVATION.
- 4. TAKE CARE NOT TO CUT EXISTING 4" BELOW SLAB SANITARY LINE DURING DEMOLITION OF EXISTING SLAB ON GRADE. NOTIFY EOR IF EXISTING SANITARY IS WITHIN FOOTPRINT OF NEW FOOTING(S) SO SIZE/LOCATION OF FOOTINGS CAN BE REEAVLUATED FOR THE CONFLICT.


FOUNDATION PLAN NOTES:

- 1. SEE SHEET S0.01 FOR GENERAL NOTES.
- 2. SEE S3.01 THROUGH S3.03 FOR FOUNDATION DETAILS. TYPICAL DETAILS MAY NOT BE CUT ON PLANS, BUT APPLY UNLESS OTHERWISE NOTED.
- 3. CENTER WALL FOOTINGS UNDER WALLS UNLESS NOTED OTHERWISE.
- 4. FX, EFX INDICATES INTERIOR FOUNDATION F"X" OR EXTERIOR FOUNDATION EF"X". SEE COLUMN FOOTING SCHEDULE ON S3.01.
- 5. ETF-X INDICATES EXTERIOR TRENCH FOOTING ETF-"X". SEE TYPICAL EXTERIOR TRENCH FOOTING DETAIL ON \$3.01.
- 6. WF-X, INDICATES INTERIOR WALL FOOTING WF-"X". TYPICAL INTERIOR WALL
- FOOTING DETAIL ON \$3.01.7. RWFX INDICATES RETAINING WALL FOOTING RWF"X" SEE TYPICAL RETINING WALL
- DETAIL ON S3.01.
 P1, P2, ETC. INDICATES CONCRETE PIER. SEE TYPICAL PIER DETAIL ON S3.01.
- TOP OF PIER ELEVATION = 98'-8" (U.O.N.).
- 9. MP1, MP2, ETC. INDICATES MASONRY PILASTER. SEE MASONRY PILASTER (MP).
- 10. SEE S3.01 FOR TYPICAL INTERIOR COLUMN FOOTING DETAIL.
- 11. SEE 5-S3.01 FOR TYPICAL COLUMN BASE.
- 12. SEE 3-S3.01 FOR TYPICAL COLUMN BASE PLATE.
- 13. FOOTINGS MAY BE EARTH-FORMED WHERE COHESIVE SOILS EXIST AT FOUNDATION ELEVATION. REFER TO THE PROJECT MANUAL. THE CONTRACTOR SHALL INCLUDE IN THEIR BID FORMING OF FOOTINGS WHERE REVIEW OF THE GEOTECHNICAL ENGINEERING REPORT INDICATES EARTH-FORMING MAY NOT BE POSSIBLE.
- 14. VERIFY LOCATION AND ELEVATION OF ALL UNDERGROUND PLUMBING LINES. SEE SHEET S3.02 FOR REQUIREMENTS WHEN PLUMBING LINES CROSS FOUNDATIONS AT ALL ELEVATIONS.
- 15. SEE 6-S3.03 FOR TYPICAL SLAB ON GRADE.
- 16. SEE 7-S3.03 FOR SLAB ISOLATIONS.
- 17. SEE ARCHITECTURAL PLANS FOR RAISED LOCKER BASES.
- 18. F.T. INDICATES FOOTING TRANSITION. SEE 11-S3.01.
- 19. F.S. INDICATES STEPPED FOOTING. SEE \$3.01 FOR DETAILS
- 20. <u>LEGEND:</u>

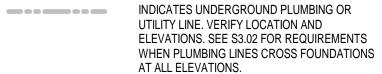

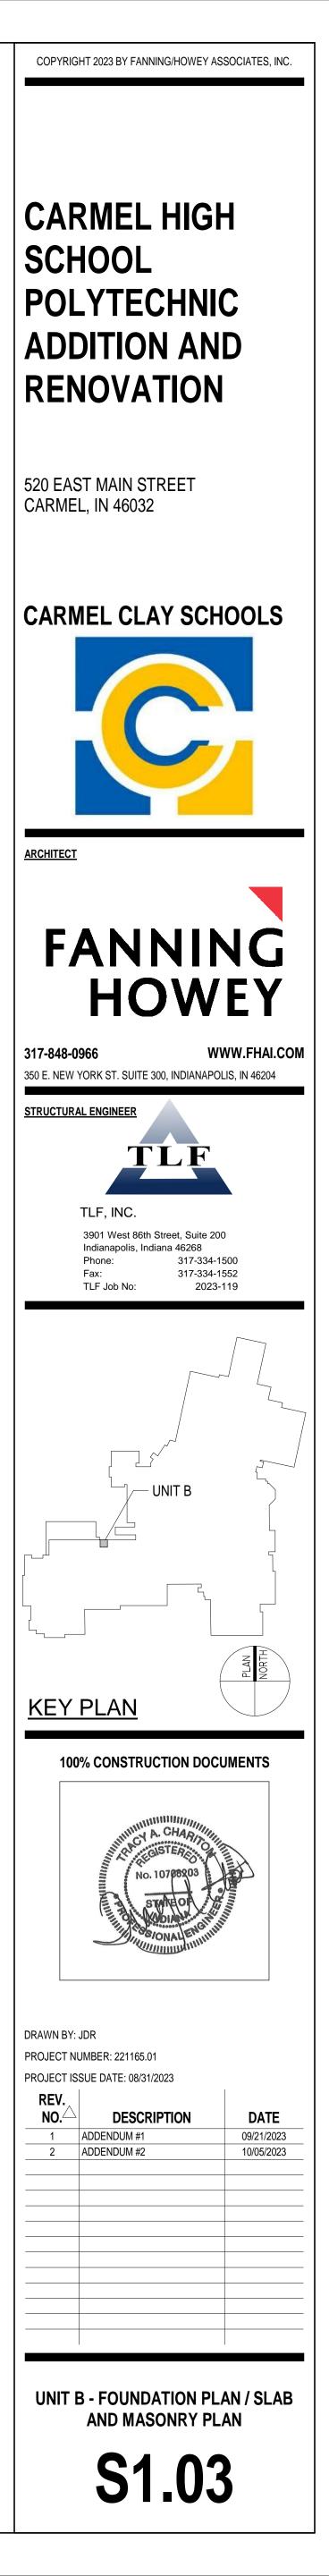

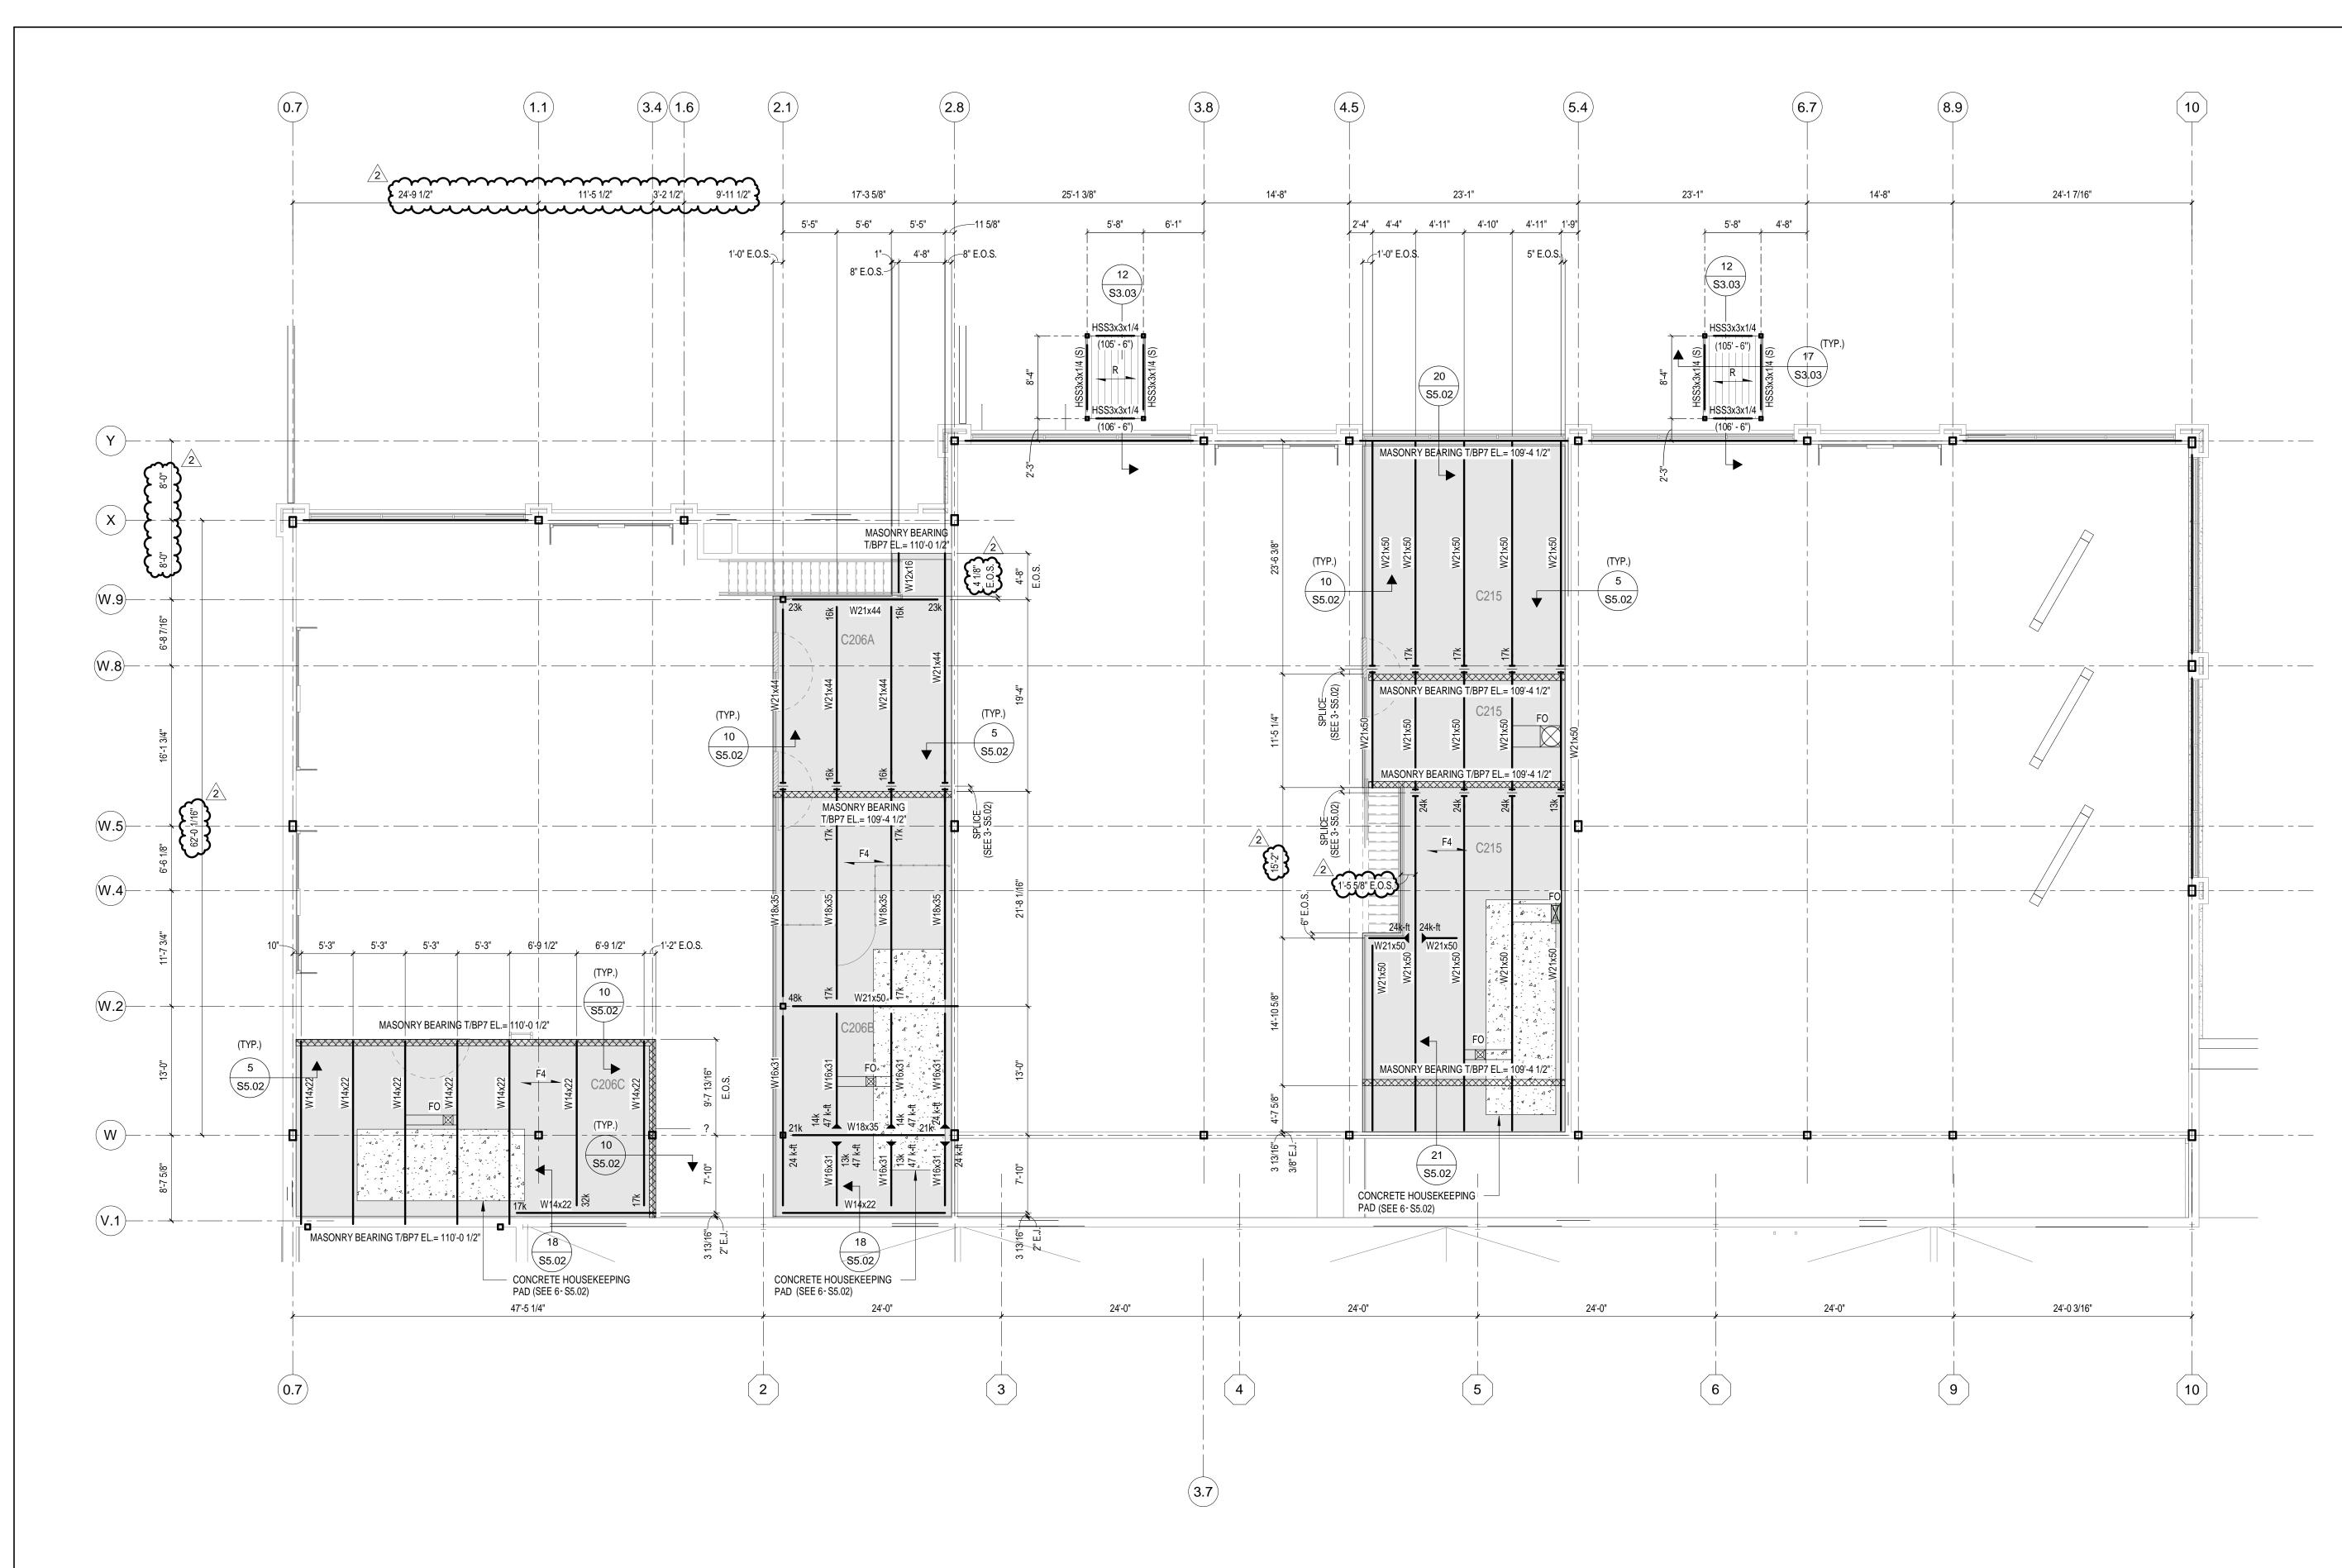

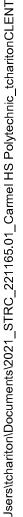

UNIT A - MEZZANINE FRAMING PLAN

NORTH



- REFERENCE ELEVATION = TOP OF EXISTING FINISH FLOOR = 100'-0" (852.88' U.S.G.S.). 1.
- TOP OF STEEL (T/STEEL) ELEVATION = 110'-8" (U.O.N.). 2.

FRAMING PLAN NOTES:

- SEE SHEET S0.01 FOR GENERAL NOTES. 1.
- SEE DRAWINGS S5.01 THROUGH S5.02 FOR STEEL FRAMING DETAILS. TYPICAL DETAILS MAY NOT BE CUT ON PLANS BUT APPLY UNLESS OTHERWISE NOTED.
- SEE S5.01 FOR TYPICAL STEEL FRAMING CONNECTIONS. 3.
- SEE S4.01 FOR MASONRY WALL BRACING REQUIREMENTS
- PROVIDE MINIMUM L3x3x1/4 (U.O.N.) ROOF EDGE SUPPORT ANGLES AT ALL ROOF EDGES AND ROOF EXPANSION JOINTS.


BEAM LEGEND:

- INDICATES DECK SUPPORT REQUIRED BETWEEN JOISTS. SEE EDGE OF DECK SUPPORT. (*)
- INDICATES SLOPED BEAM. ELEVATIONS AT ENDS ARE TOP OF SLOPED BEAM AT (S) CENTERLINE COLUMN OR AT INTERSECTION WITH OTHER BEAMS.
- INDICATES EXISTING FRAMING MEMBER. (E)
- INDICATES BEARING PLATE. SEE BEARING PLATE SCHEDULE. BP
- (TCX) INDICATES THAT THE TOP CHORD OF THE JOIST IS TO BE EXTENDED. (SEE PLAN FOR LENGTH)
- (DJB) INDICATES DEEP JOIST BEARING.
- INDICATES BOLTED CONNECTION AT JOIST BEARING. (BC)
- RV INDICATES FRAME REQUIRED FOR ROOF VENT. SEE TYP OPENING FRAME (RV). (VERIFY LOCATION WITH ROOF PLAN)
- INDICATES FRAME REQUIRED FOR ROOF DRAIN. SEE TYP OPENING FRAME (RD). RD (VERIFY LOCATION WITH ROOF PLAN)
- RH INDICATES FRAME REQUIRED FOR ROOF HATCH. SEE TYP OPENING FRAME (RH).
- FO INDICATES FRAME REQUIRED FOR FLOOR OPENING. SEE TYP OPENING FRAME (FO).
- PB INDICATES FRAME REQUIRED FOR POUR BOX OPENING.
- → INDICATES BEAM SPLICE. SEE TYPICAL STEEL FRAMING DETAIL S5.01-1F.

COLUMN.


- INDICATES DIRECTION OF FLOOR DECK SPAN (4" COMP. CONC., U.O.N.).
- R INDICATES DIRECTION OF 1 1/2" ROOF DECK SPAN (WR20, U.O.N.).
- INDICATES BEAM MOMENT CONNECTION.


INDICATES THAT THE W12x16 BEAM IS LEVEL WITH <u>10k W12x16 10k</u> THE TOP FLANGE AT ELEVATION 110'-8 1/2" WITH A 10 KIP REACTION AT EACH END.

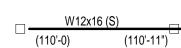

(110'-8 1/2")

INDICATES THAT THE W12x16 BEAM IS SLOPED WITH THE TOP OF ITS FLANGE AT ELEVATION 110'-0" AND ELEVATION 110'-11", RESPECTIVELY, AT THE CENTERLINE OF THE TWO COLUMNS. THE BEAM FRAMES OVER THE TOP OF THE RIGHT COLUMN AND INTO THE SIDE OF THE LEFT

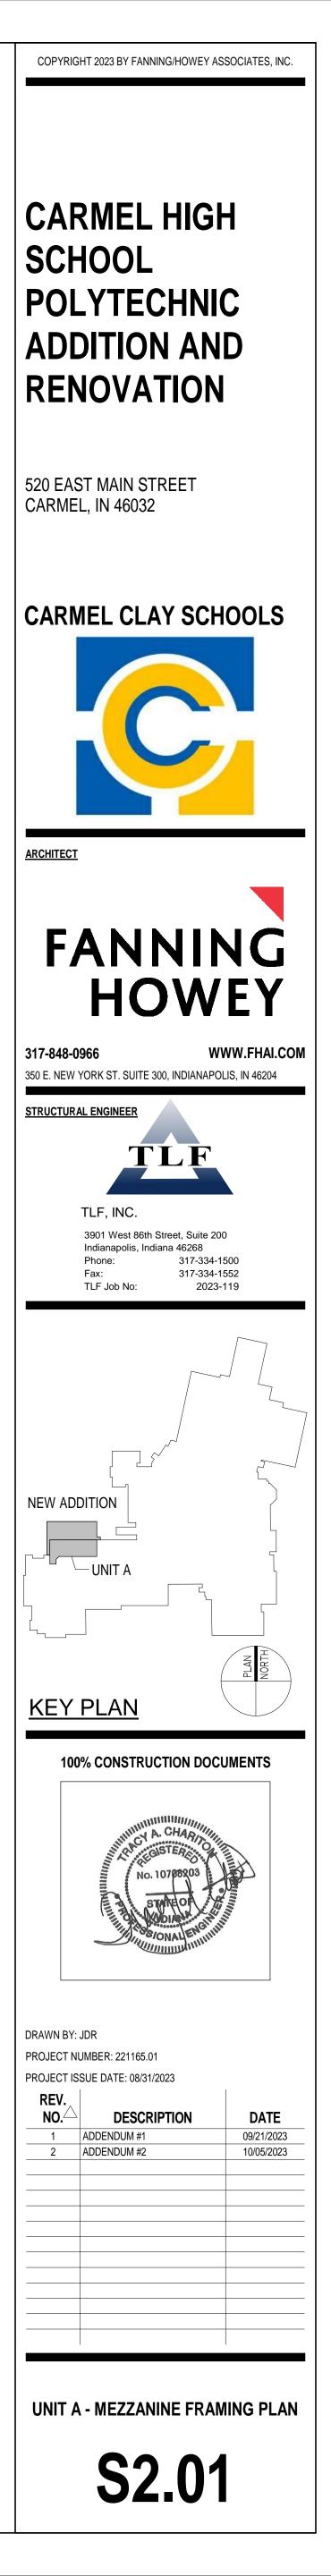

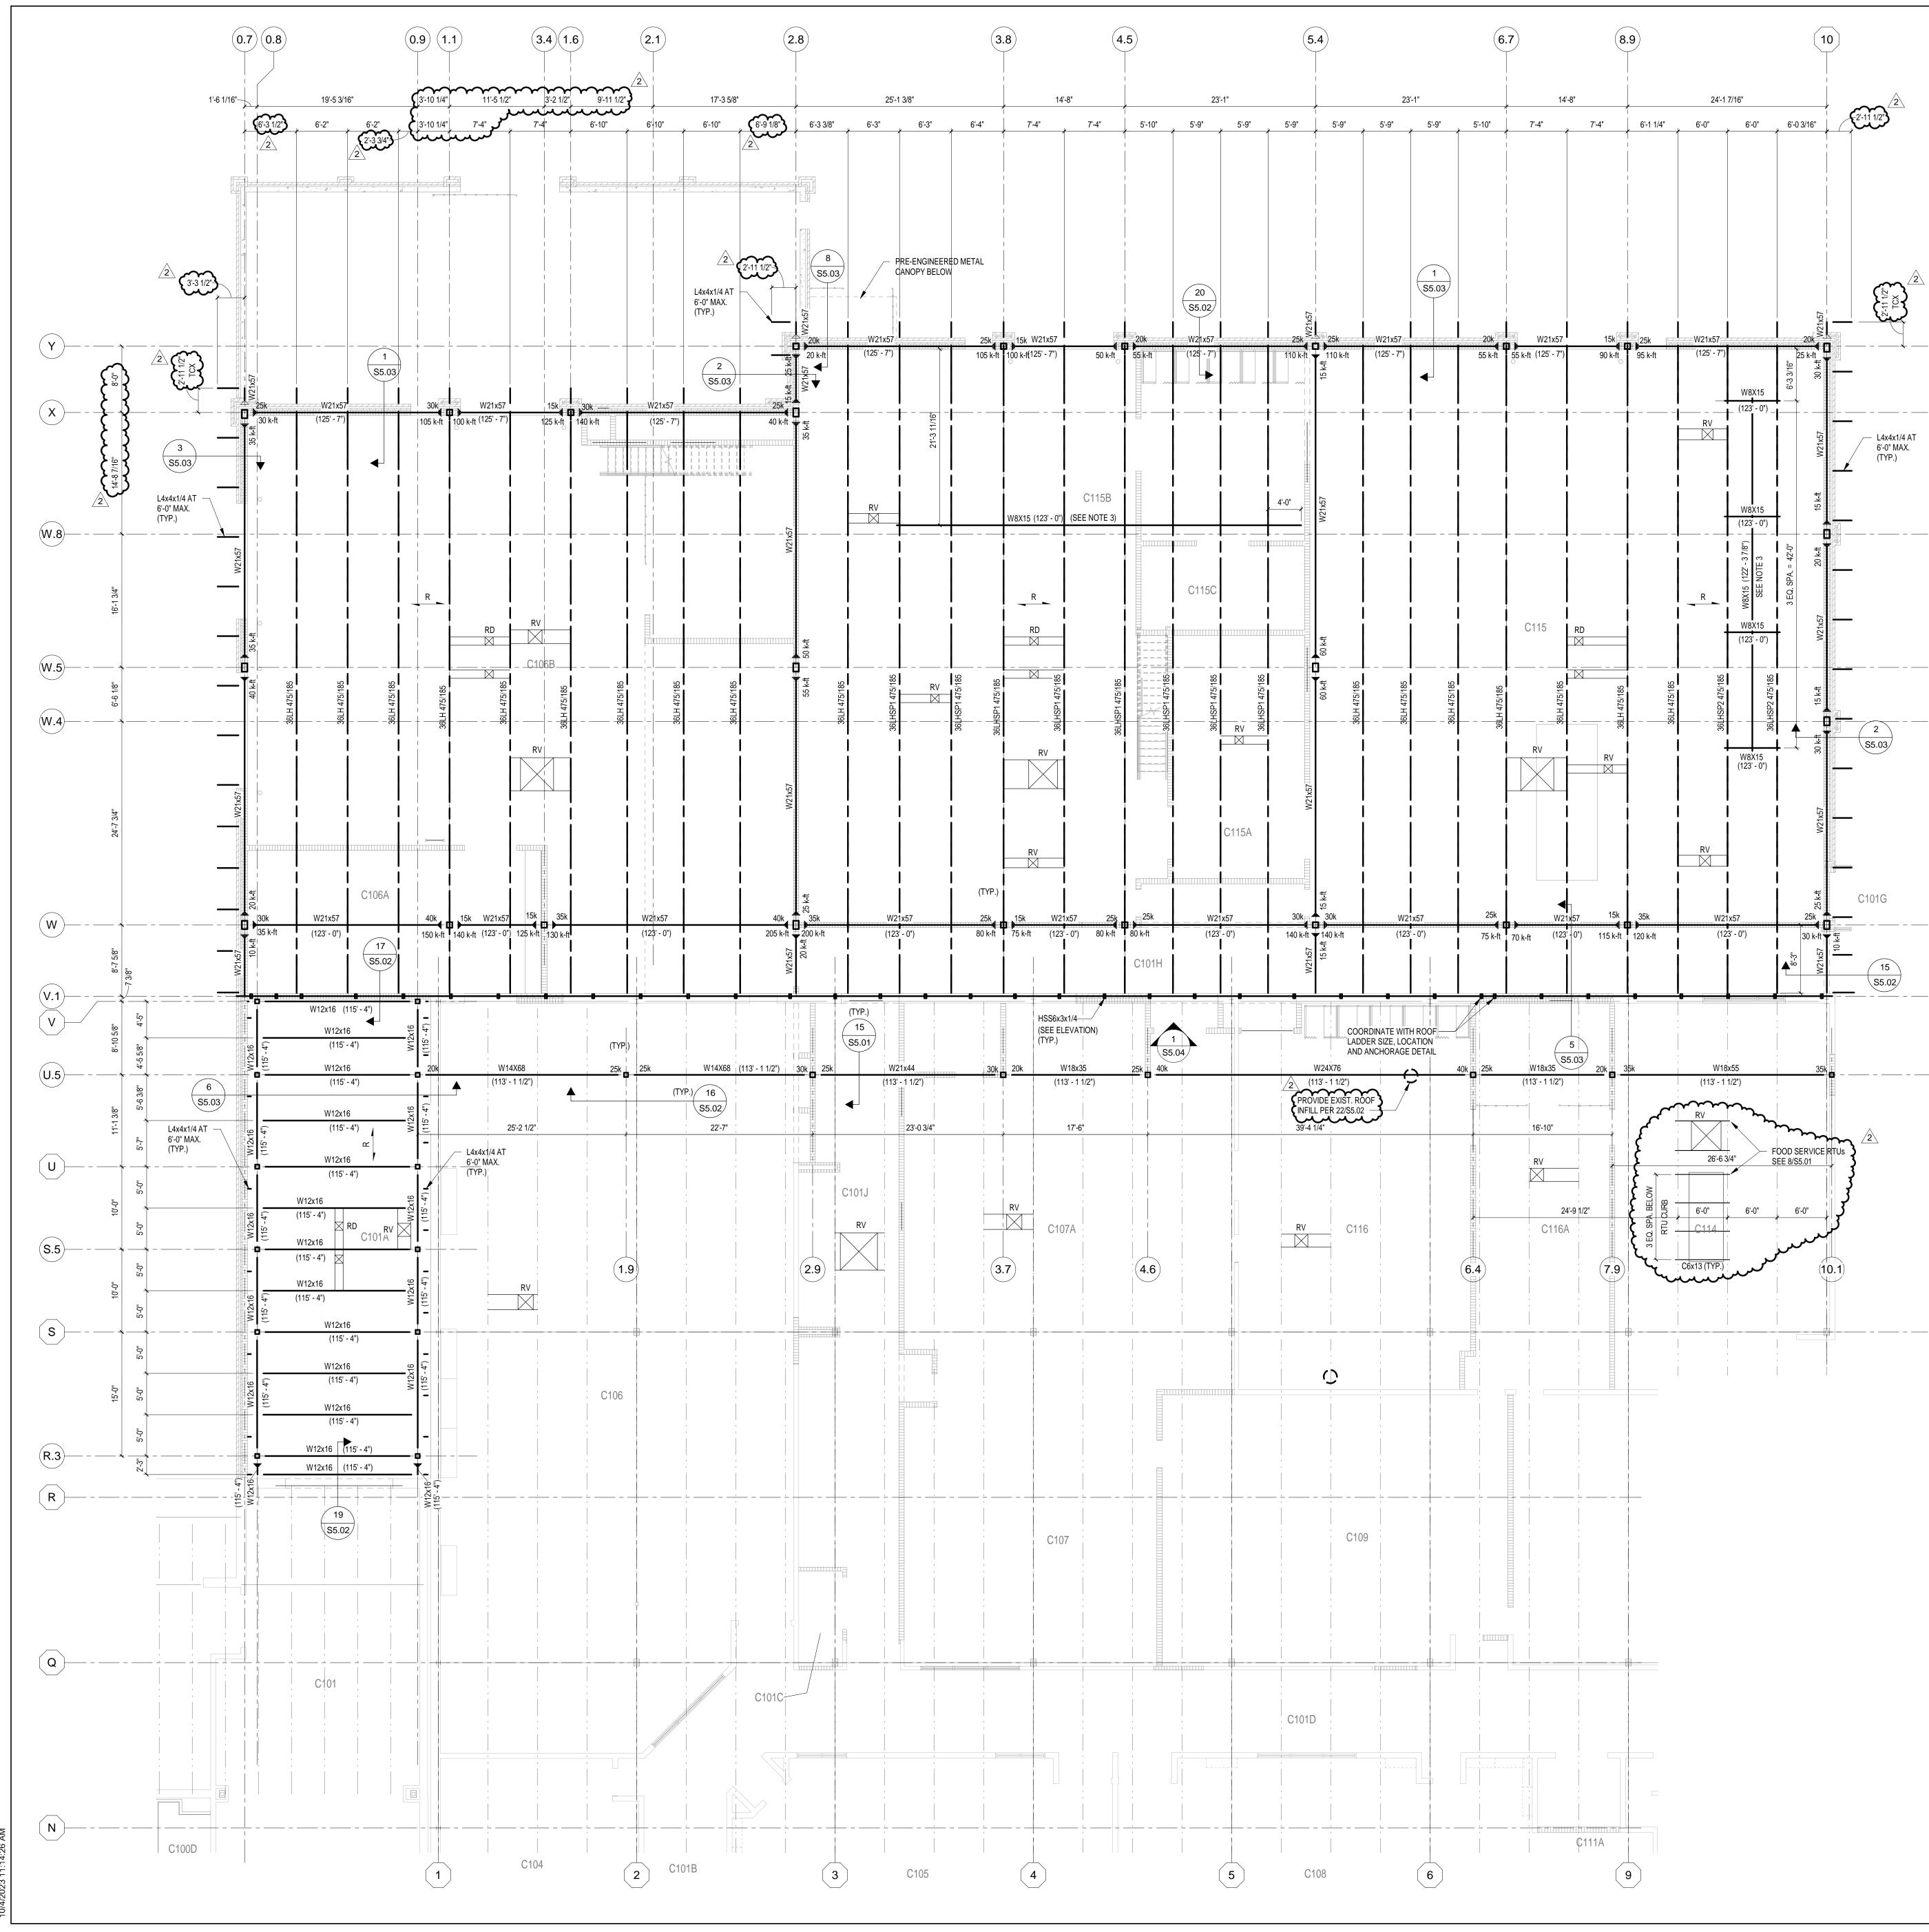

ers\tchariton\Documents\2021_STRC_221165.01_Carmel HS Polytechnic_tcharitonCLENT.rv

UNIT A - ROOF FRAMING PLAN



PLAN NOTES:

- 1. REFERENCE ELEVATION = TOP OF EXISTING FINISH FLOOR = 100'-0" (852.88' U.S.G.S.).
- 2. TOP OF STEEL (T/STEEL) ELEVATION = 126'-0" (U.O.N.).
- 3. COORDINATE LENGTH AND LOCATION OF HOIST SUPPORT BEAM WITH EQUIPMENT PROVIDER.

FRAMING PLAN NOTES:

- 1. SEE SHEET S0.01 FOR GENERAL NOTES.
- SEE DRAWINGS S5.01 THROUGH S5.02 FOR STEEL FRAMING DETAILS. TYPICAL DETAILS MAY NOT BE CUT ON PLANS BUT APPLY UNLESS OTHERWISE NOTED.
- 3. SEE S5.01 FOR TYPICAL STEEL FRAMING CONNECTIONS.
- 4. SEE S4.01 FOR MASONRY WALL BRACING REQUIREMENTS
- PROVIDE MINIMUM L3x3x1/4 (U.O.N.) ROOF EDGE SUPPORT ANGLES AT ALL ROOF EDGES AND ROOF EXPANSION JOINTS.

BEAM LEGEND:

- INDICATES DECK SUPPORT REQUIRED BETWEEN JOISTS. SEE EDGE OF DECK SUPPORT.
- (S) INDICATES SLOPED BEAM. ELEVATIONS AT ENDS ARE TOP OF SLOPED BEAM AT CENTERLINE COLUMN OR AT INTERSECTION WITH OTHER BEAMS.
 (E) INDICATES EXISTING FRAMING MEMBER.
- BP INDICATES BEARING PLATE. SEE BEARING PLATE SCHEDULE.
- (TCX) INDICATES THAT THE TOP CHORD OF THE JOIST IS TO BE EXTENDED. (SEE PLAN FOR LENGTH)
- (DJB) INDICATES DEEP JOIST BEARING.
- (BC) INDICATES BOLTED CONNECTION AT JOIST BEARING.
- RV INDICATES FRAME REQUIRED FOR ROOF VENT. SEE TYP OPENING FRAME (RV). (VERIFY LOCATION WITH ROOF PLAN)
- RD INDICATES FRAME REQUIRED FOR ROOF DRAIN. SEE TYP OPENING FRAME (RD). (VERIFY LOCATION WITH ROOF PLAN)

RH	INDICATES FRAME REQUIRED FOR ROOF HATCH. SEE TYP OPENING FRAME (RH).
FO	INDICATES FRAME REQUIRED FOR FLOOR OPENING. SEE TYP OPENING FRAME (FO).


- PB INDICATES FRAME REQUIRED FOR POUR BOX OPENING.
- F4 INDICATES DIRECTION OF FLOOR DECK SPAN (4" COMP. CONC., U.O.N.).
- R INDICATES DIRECTION OF 1 1/2" ROOF DECK SPAN (WR20, U.O.N.).


INDICATES BEAM MOMENT CONNECTION.

<u>10</u>	k W12x16 (110'-8 1/2")	<u>10k</u>	INDICATES THAT THE W12x16 BEAM IS LEVEL WITH THE TOP FLANGE AT ELEVATION 110'-8 1/2" WITH A 10 KIP REACTION AT EACH END.
□	W12x16 (S)		INDICATES THAT THE W12x16 BEAM IS SLOPED WITH

(110'-0) (110'-11") TOP OF ITS FLANG 110'-11", RESPECT TWO COLUMNS. T THE RIGHT COLUM

INDICATES THAT THE W12x16 BEAM IS SLOPED WITH THE TOP OF ITS FLANGE AT ELEVATION 110'-0" AND ELEVATION 110'-11", RESPECTIVELY, AT THE CENTERLINE OF THE TWO COLUMNS. THE BEAM FRAMES OVER THE TOP OF THE RIGHT COLUMN AND INTO THE SIDE OF THE LEFT COLUMN.

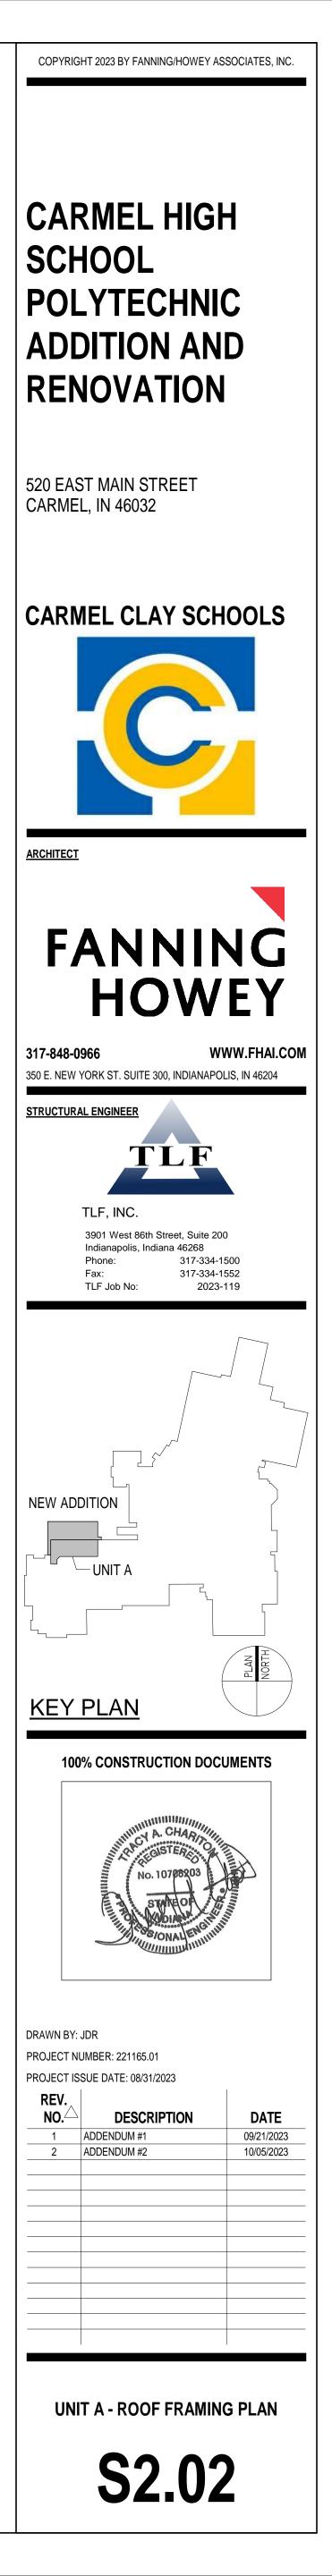

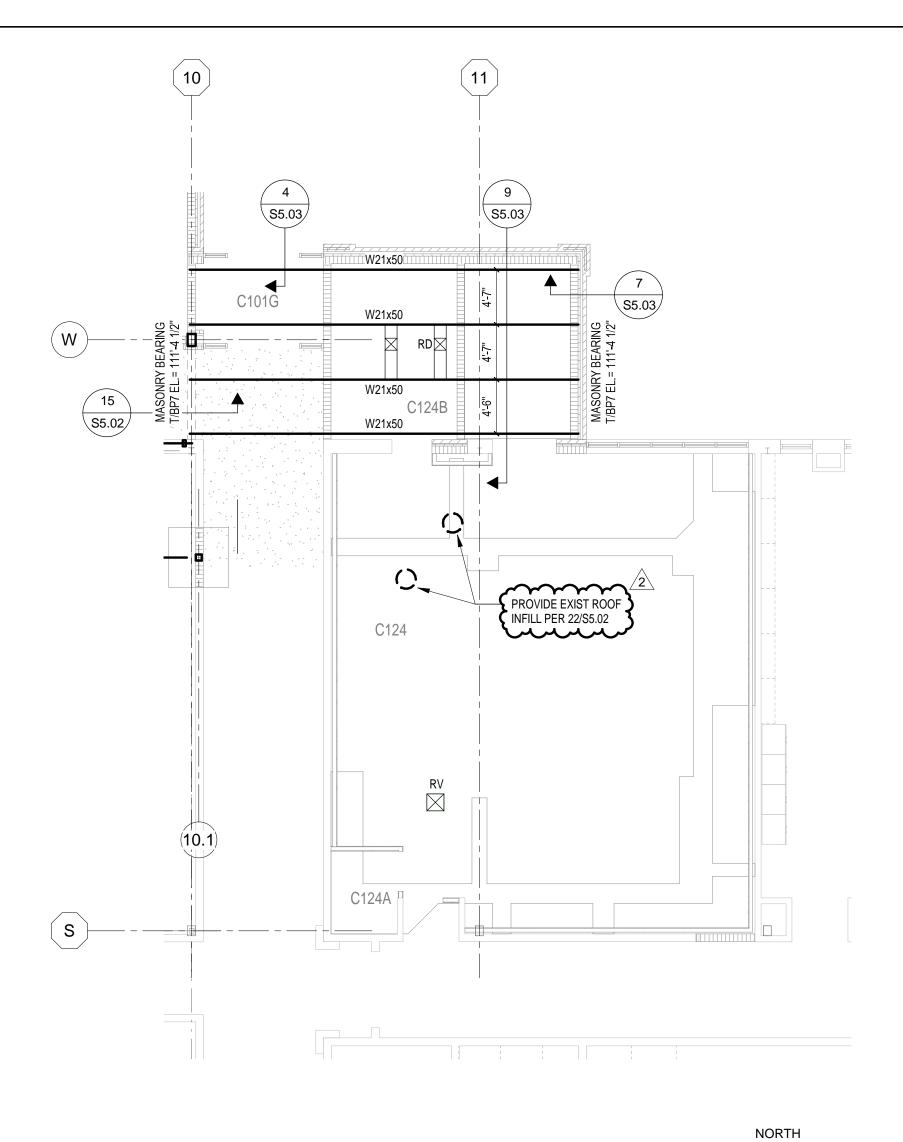

UNIT B - ROOF FRAMING PLAN 1/8" = 1'-0"

PLAN NOTES:


- 1. REFERENCE ELEVATION = TOP OF EXISTING FINISH FLOOR = 100'-0" (852.88' U.S.G.S.).
- 2. TOP OF STEEL (T/STEEL) ELEVATION = 113'-0" (U.O.N.).


FRAMING PLAN NOTES:

- 1. SEE SHEET S0.01 FOR GENERAL NOTES.
- 2. SEE DRAWINGS S5.01 THROUGH S5.02 FOR STEEL FRAMING DETAILS. TYPICAL DETAILS MAY NOT BE CUT ON PLANS BUT APPLY UNLESS OTHERWISE NOTED.
- 3. SEE S5.01 FOR TYPICAL STEEL FRAMING CONNECTIONS.
- 4. SEE S4.01 FOR MASONRY WALL BRACING REQUIREMENTS
- PROVIDE MINIMUM L3x3x1/4 (U.O.N.) ROOF EDGE SUPPORT ANGLES AT 5. ALL ROOF EDGES AND ROOF EXPANSION JOINTS.

BEAM LEGEND:

- (*) INDICATES DECK SUPPORT REQUIRED BETWEEN JOISTS. SEE EDGE OF DECK SUPPORT.
- (S) INDICATES SLOPED BEAM. ELEVATIONS AT ENDS ARE TOP OF SLOPED BEAM AT CENTERLINE COLUMN OR AT INTERSECTION WITH OTHER BEAMS.
- (E) INDICATES EXISTING FRAMING MEMBER.
- BP INDICATES BEARING PLATE. SEE BEARING PLATE SCHEDULE.
- (TCX) INDICATES THAT THE TOP CHORD OF THE JOIST IS TO BE EXTENDED. (SEE PLAN FOR LENGTH) (DJB) INDICATES DEEP JOIST BEARING.
- (BC) INDICATES BOLTED CONNECTION AT JOIST BEARING.
- RV INDICATES FRAME REQUIRED FOR ROOF VENT. SEE TYP OPENING FRAME (RV).
- (VERIFY LOCATION WITH ROOF PLAN)
- RD INDICATES FRAME REQUIRED FOR ROOF DRAIN. SEE TYP OPENING FRAME (RD). (VERIFY LOCATION WITH ROOF PLAN)
- RH INDICATES FRAME REQUIRED FOR ROOF HATCH. SEE TYP OPENING FRAME (RH).
- FO INDICATES FRAME REQUIRED FOR FLOOR OPENING. SEE TYP OPENING FRAME (FO).
- PB INDICATES FRAME REQUIRED FOR POUR BOX OPENING.
- → INDICATES BEAM SPLICE. SEE TYPICAL STEEL FRAMING DETAIL S5.01-1F.
- INDICATES DIRECTION OF FLOOR DECK SPAN (4" COMP. CONC., U.O.N.).
- R INDICATES DIRECTION OF 1 1/2" ROOF DECK SPAN (WR20, U.O.N.).
- INDICATES BEAM MOMENT CONNECTION.
- INDICATES THAT THE W12x16 BEAM IS LEVEL WITH 10k W12x16 10k THE TOP FLANGE AT ELEVATION 110'-8 1/2" WITH A
- (110'-8 1/2")
- 10 KIP REACTION AT EACH END.
- W12x16 (S) INDICATES THAT THE W12x16 BEAM IS SLOTED WITH THE TOP OF ITS FLANGE AT ELEVATION 110'-0" AND ELEVAT (110'-0) (110'-11") 10° OF 113 FEARSE AT ELEVATION TO A STATE OF THE TO A STATE OF T TWO COLUMNS. THE BEAM FRAMES OVER THE TOP OF THE RIGHT COLUMN AND INTO THE SIDE OF THE LEFT COLUMN.

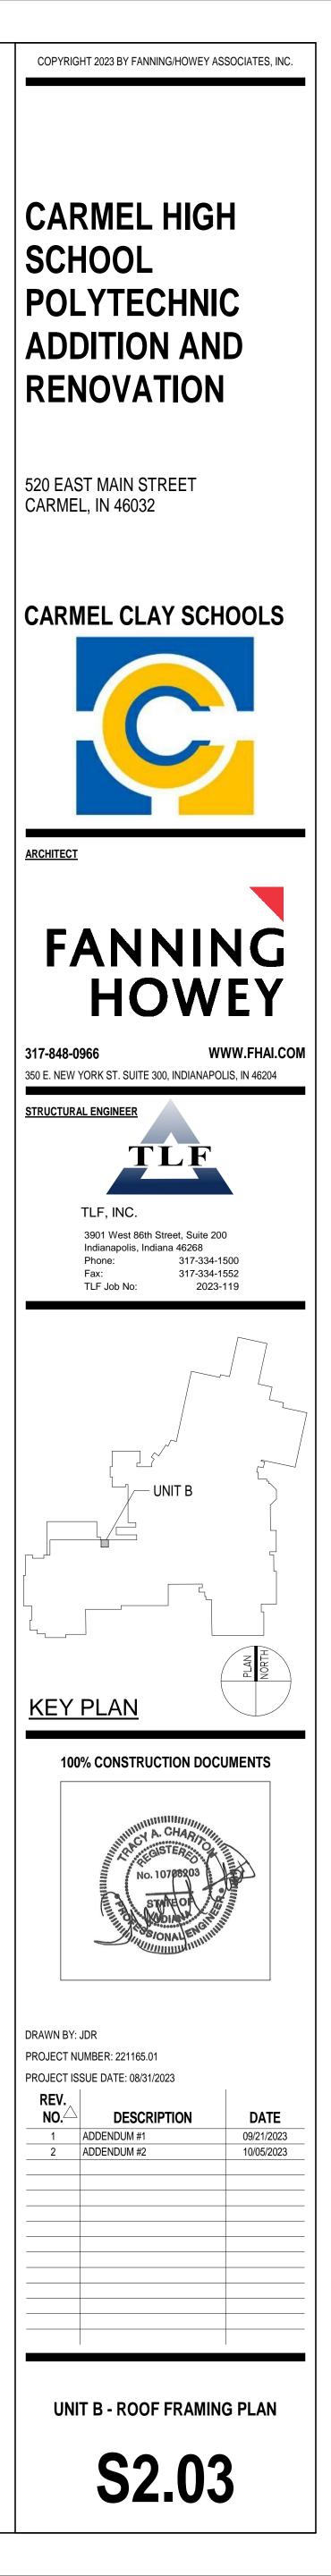

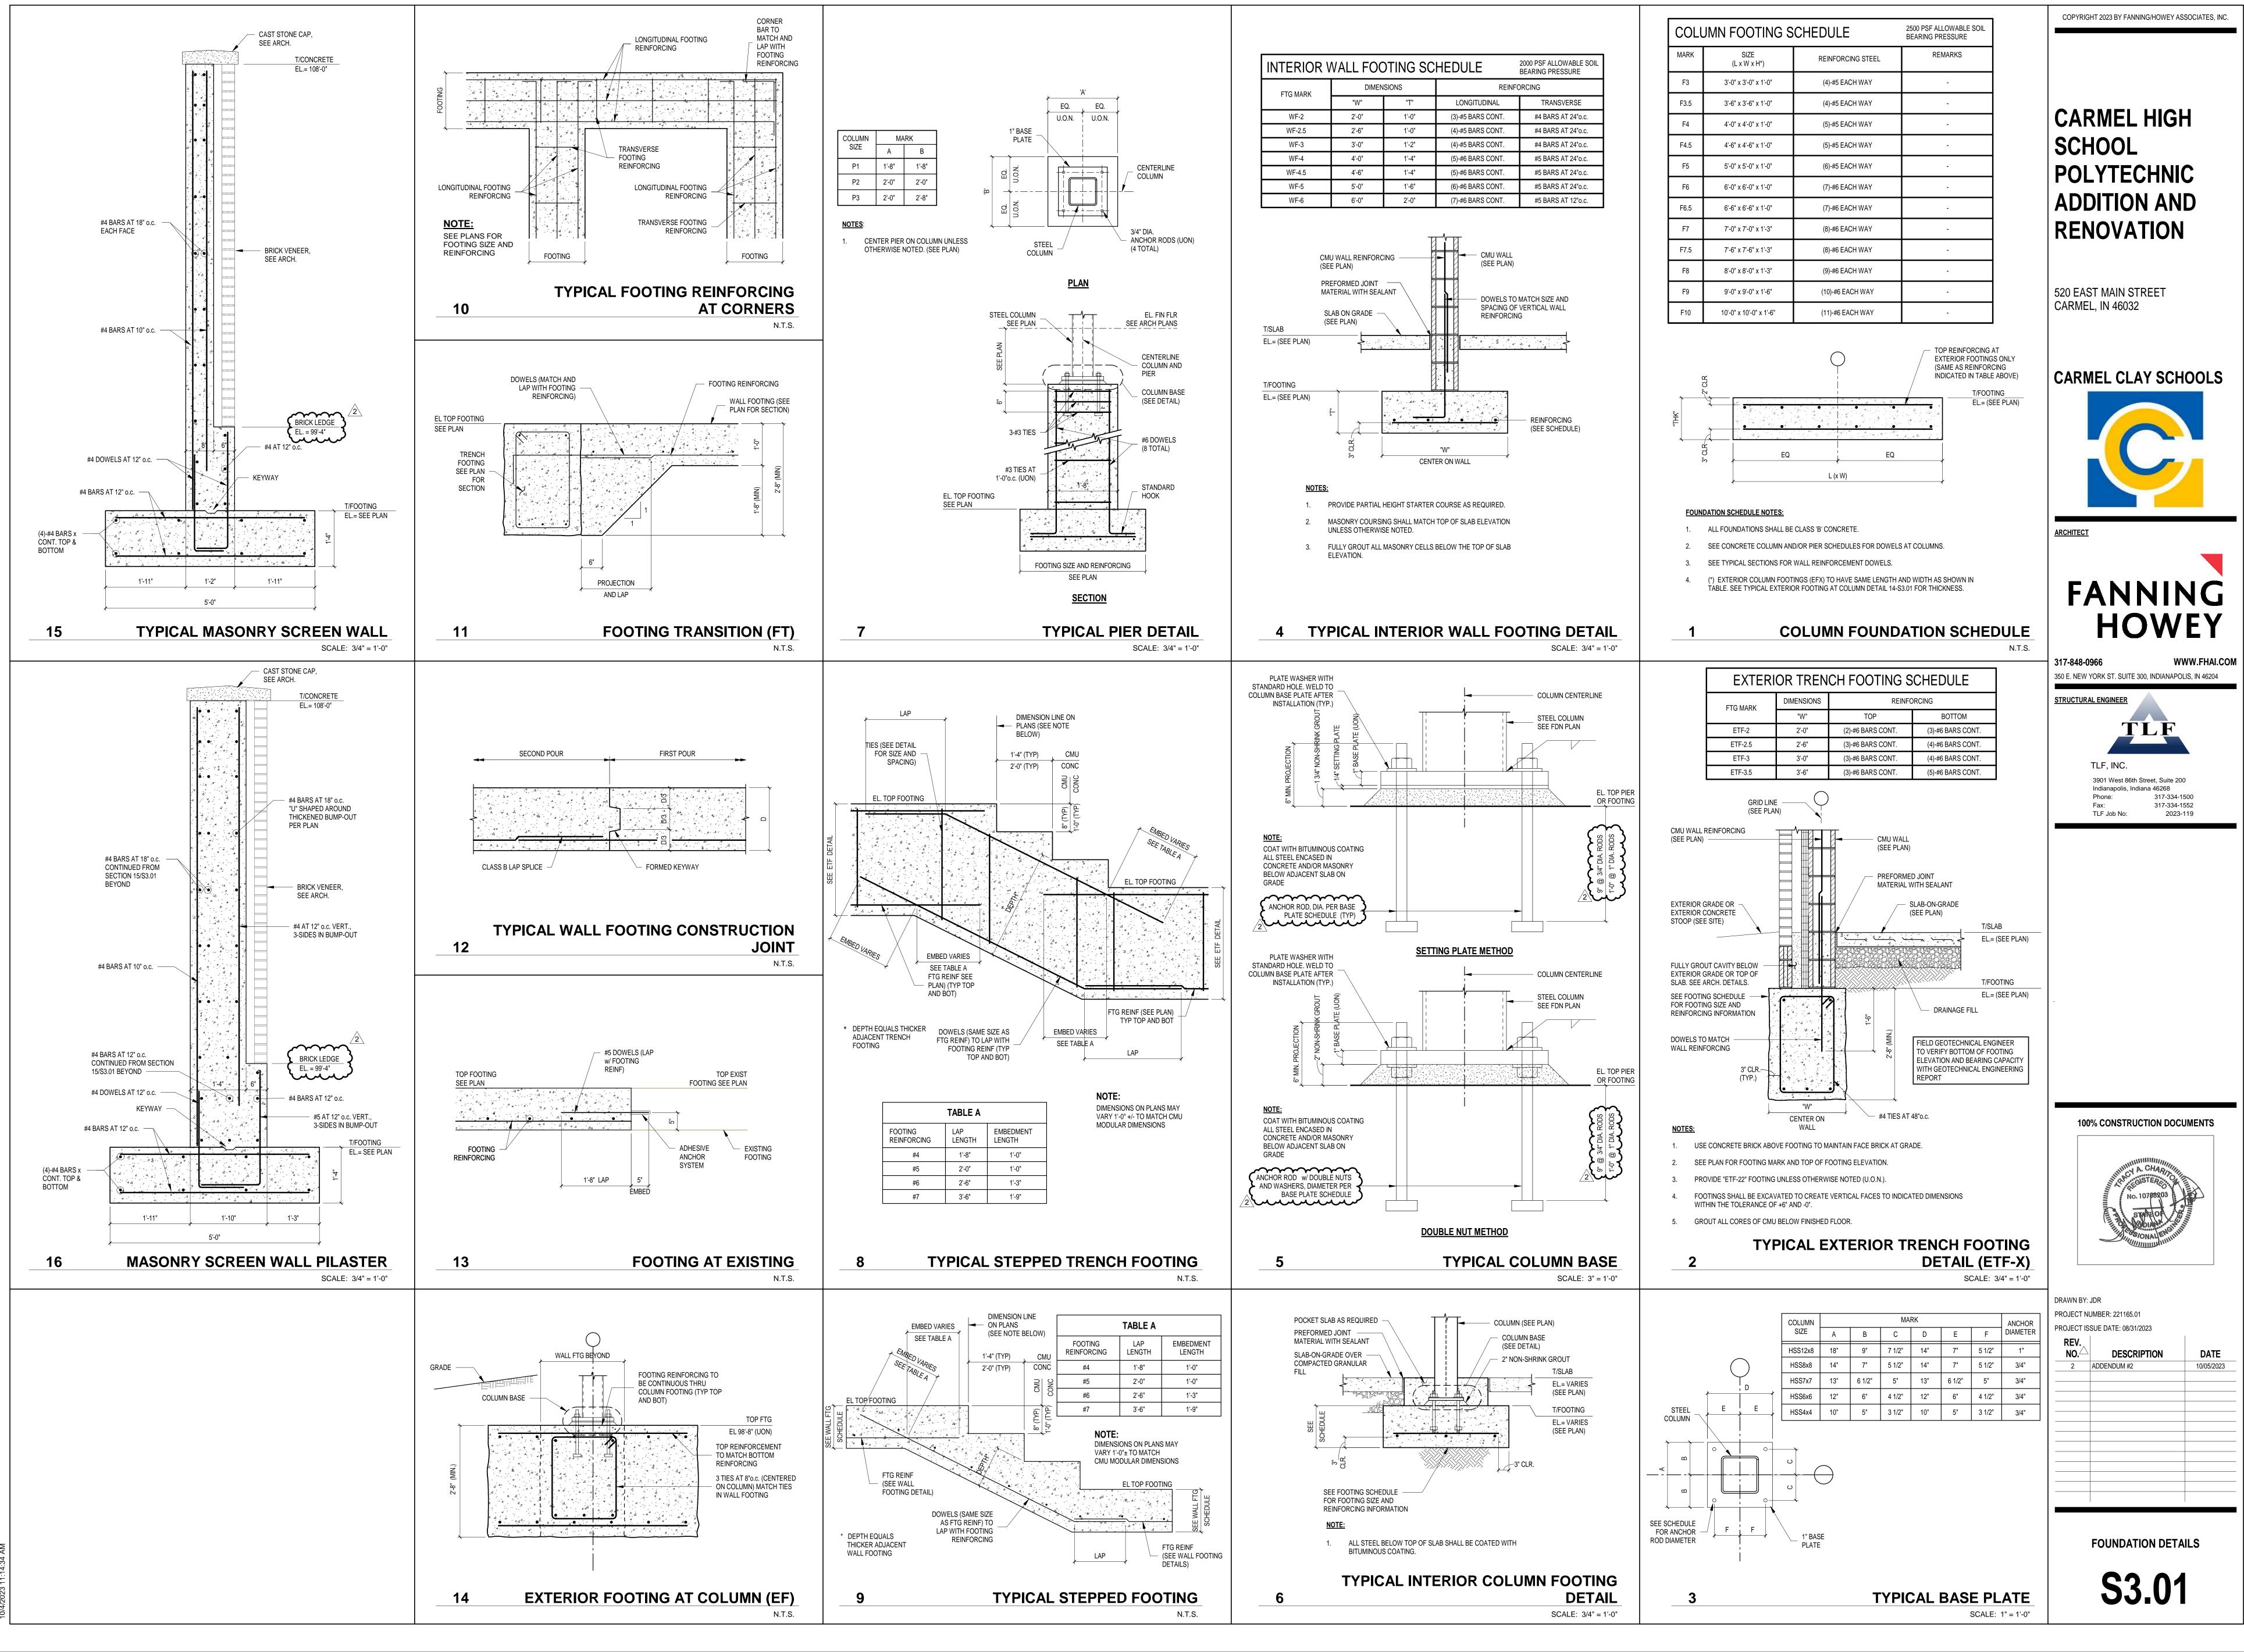


ers\tchariton\Documents\2021_STRC_221165.01_Carmel HS Polytechnic_tcharitonCLI


C:\Users\tcharit 10/4/2023 11:14

Carmel HS Polytechnic
21_STRC_221165.01_
s\tchariton\Documents\2021_


		/2023 11:14

L3x3x3/16 (TYP TOP
STEEL COLUMN
9 TORSION
<u>MP3</u> (12"x16")
<u>MP1</u> (8"x16") #6 (TYP) (2 TOTAL)
8" CMU (FULLY GROUTED) 1-4" NOM 10 M

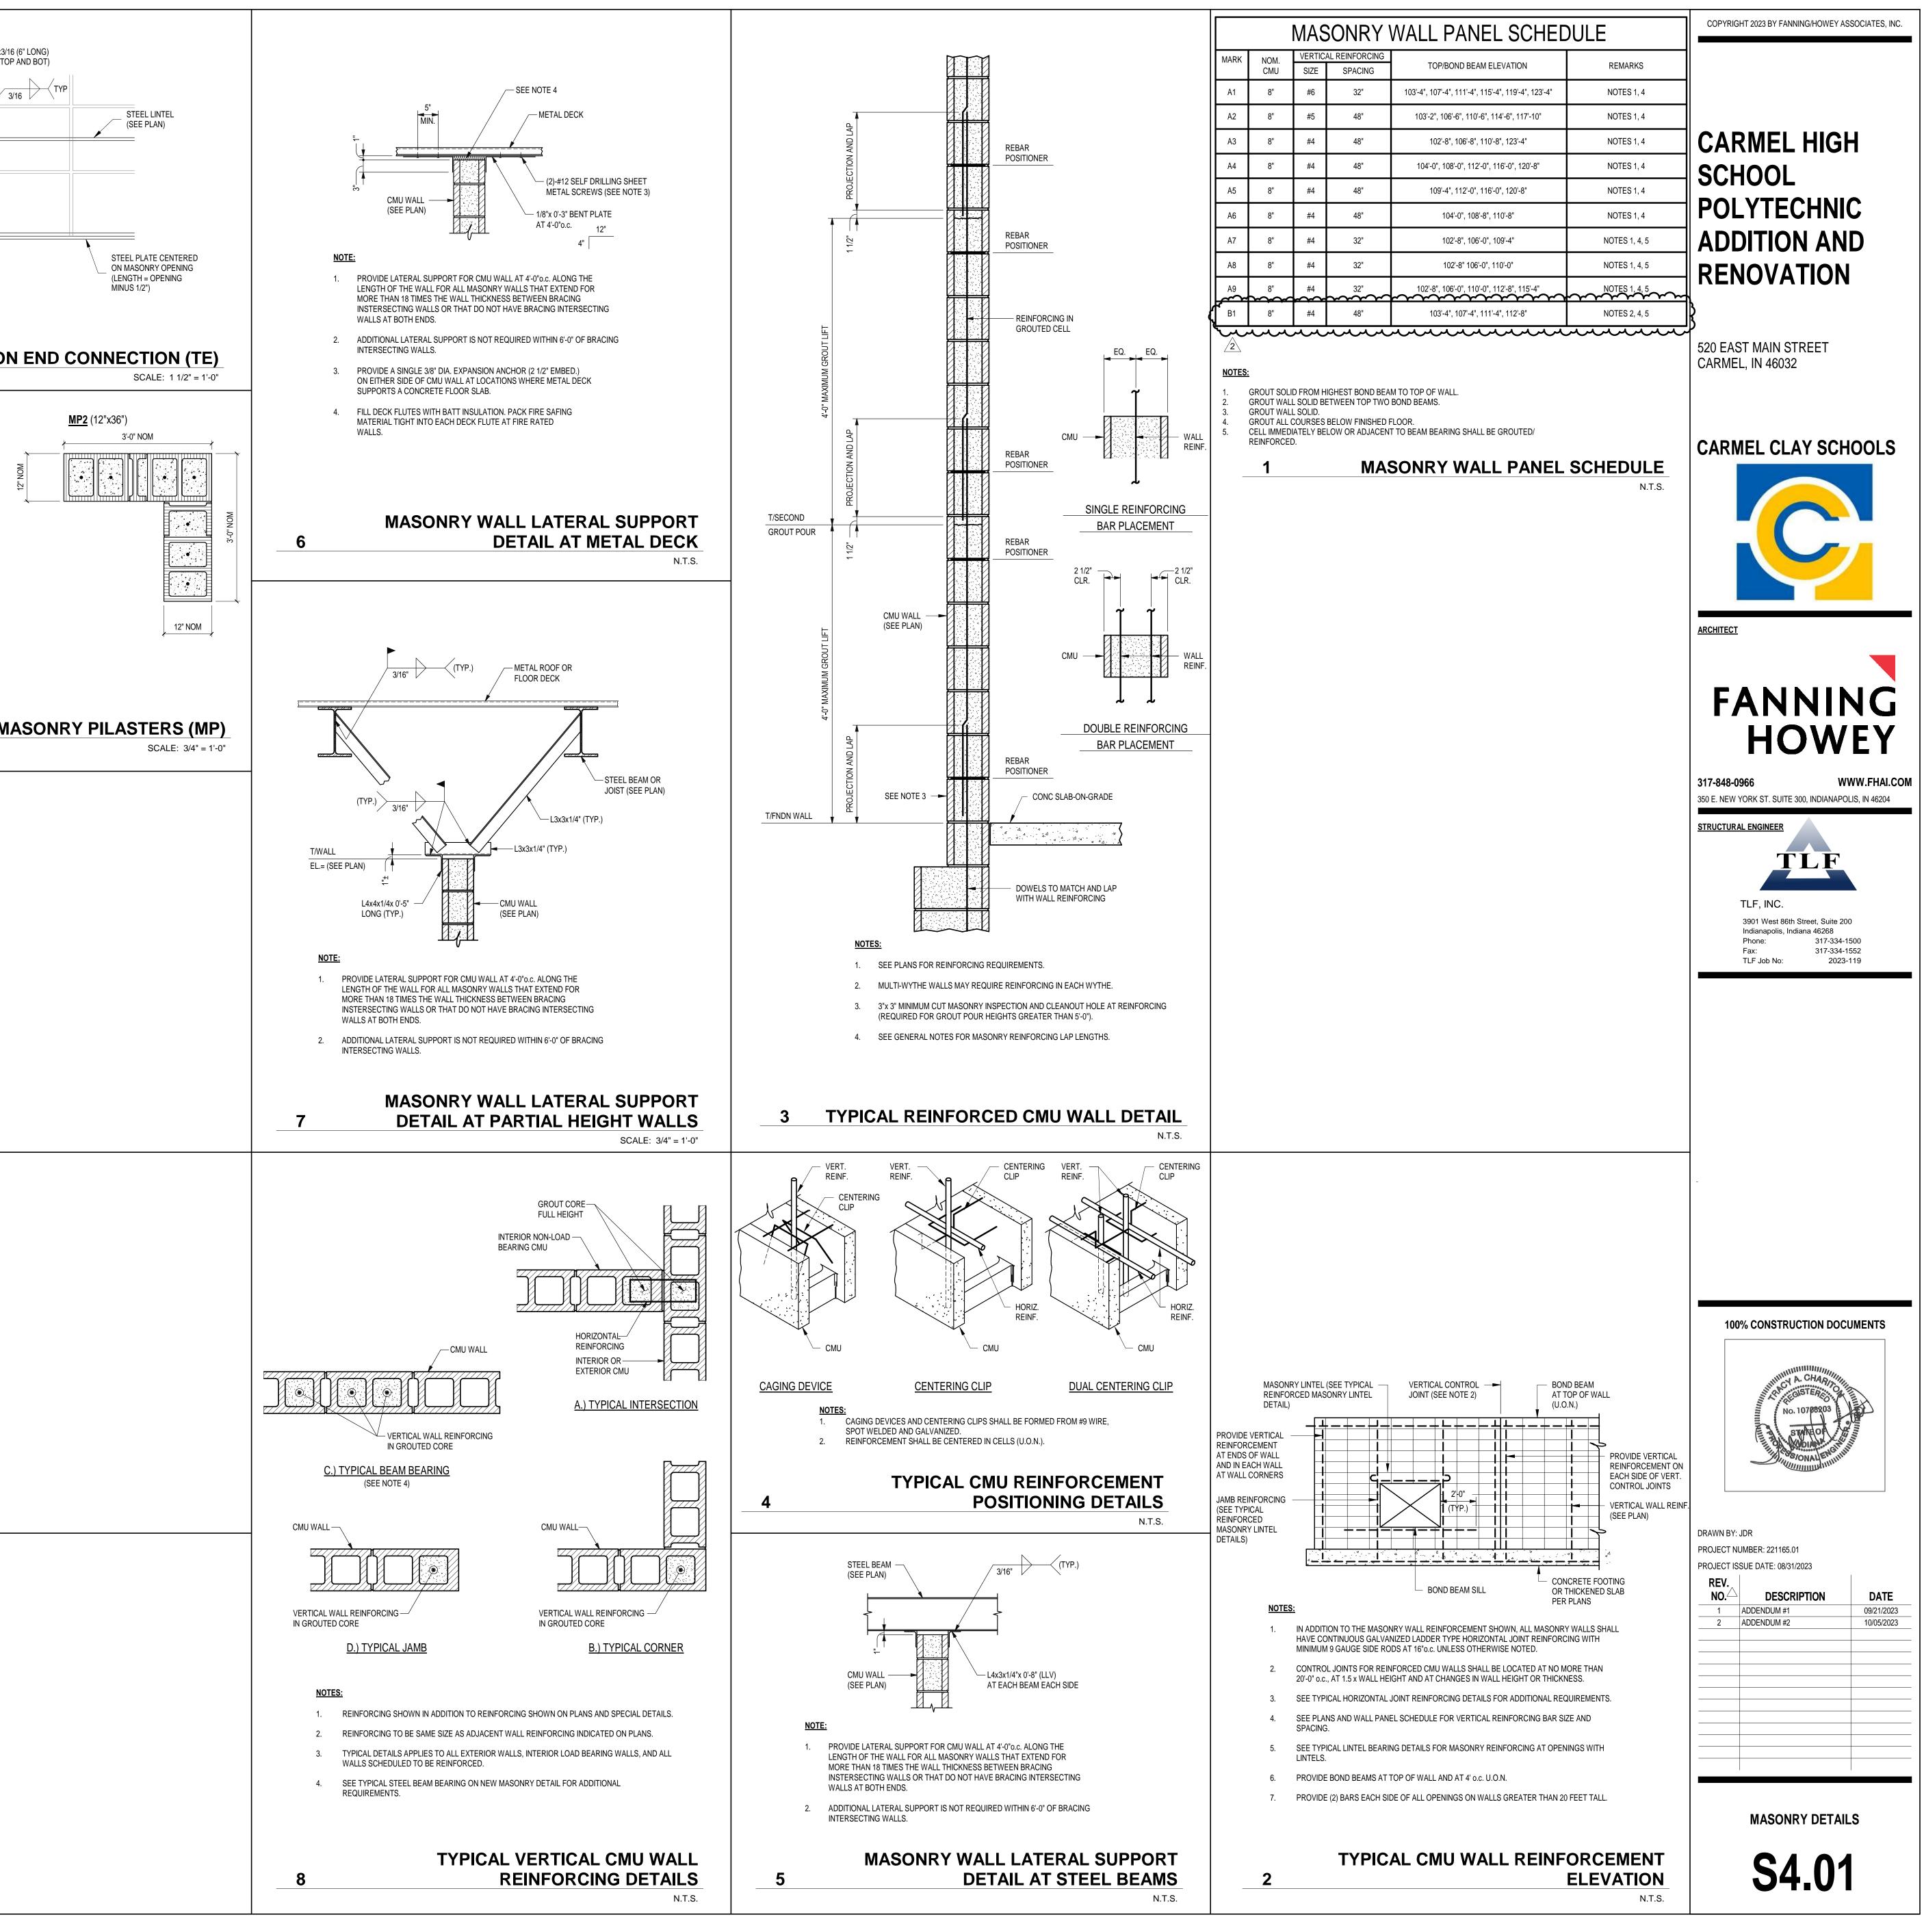

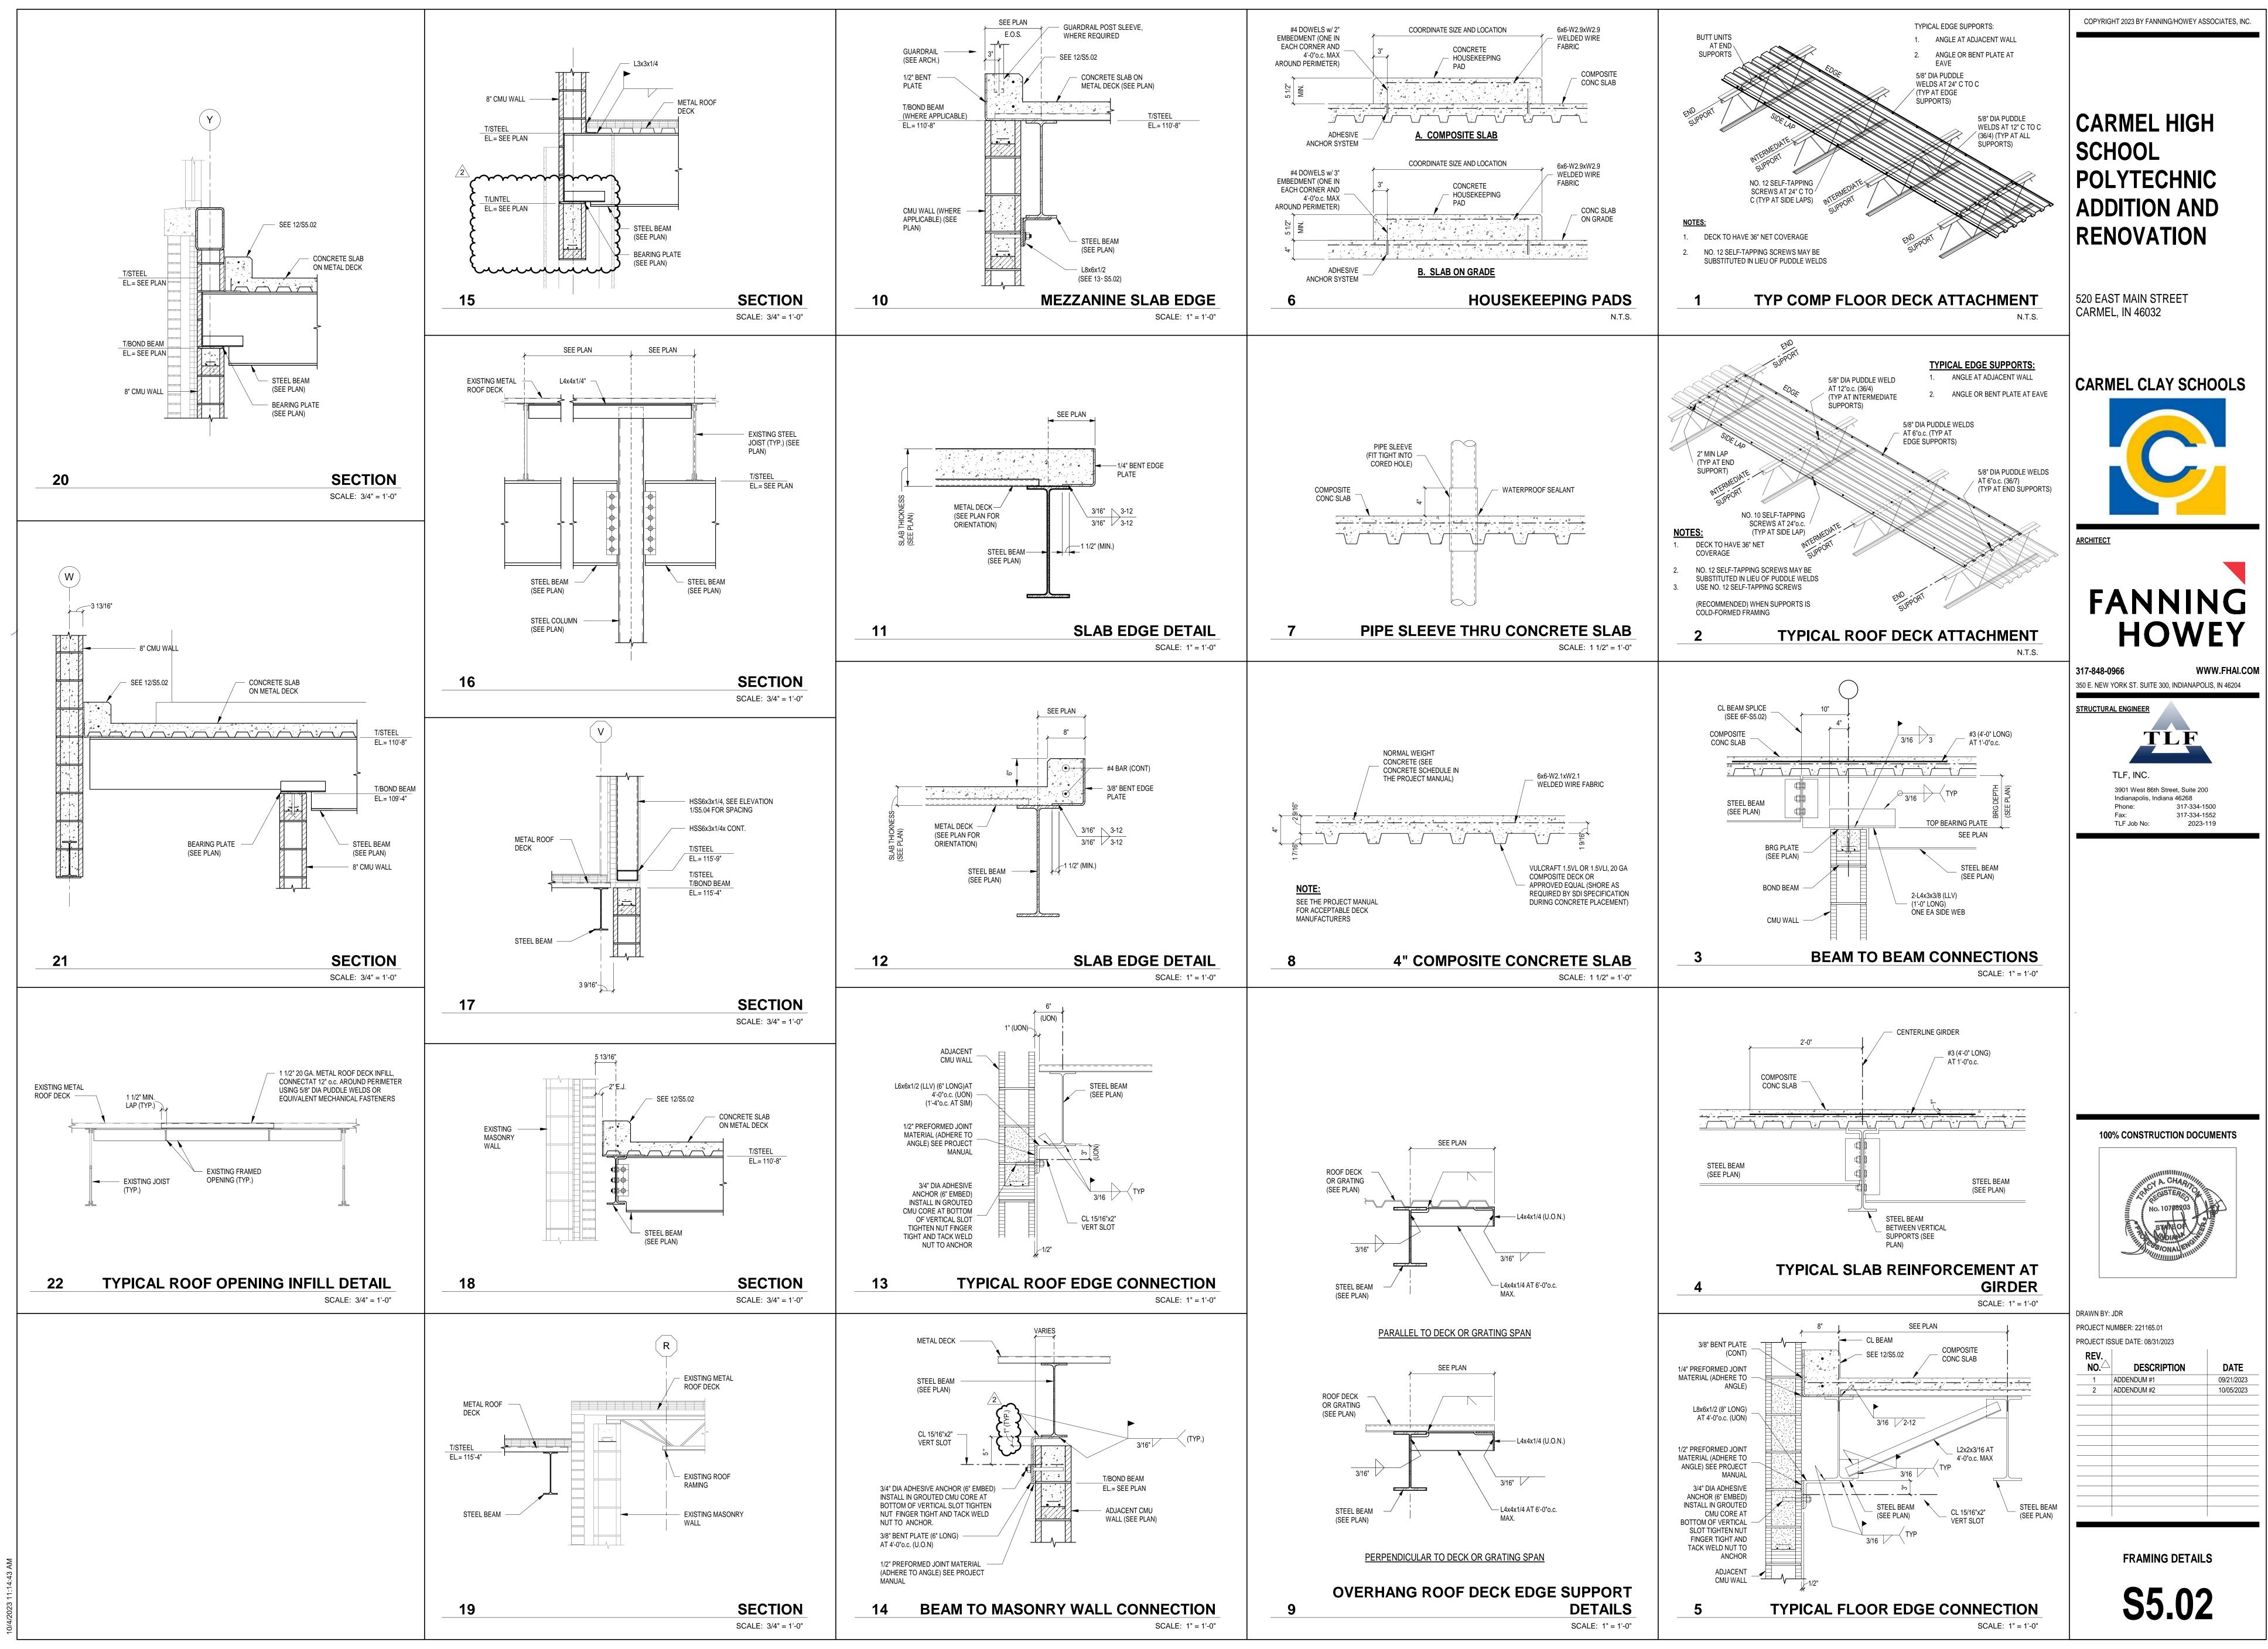



sers\tchariton\Documents\2021_STRC_221165.01_Carmel HS Polytechnic_tchar

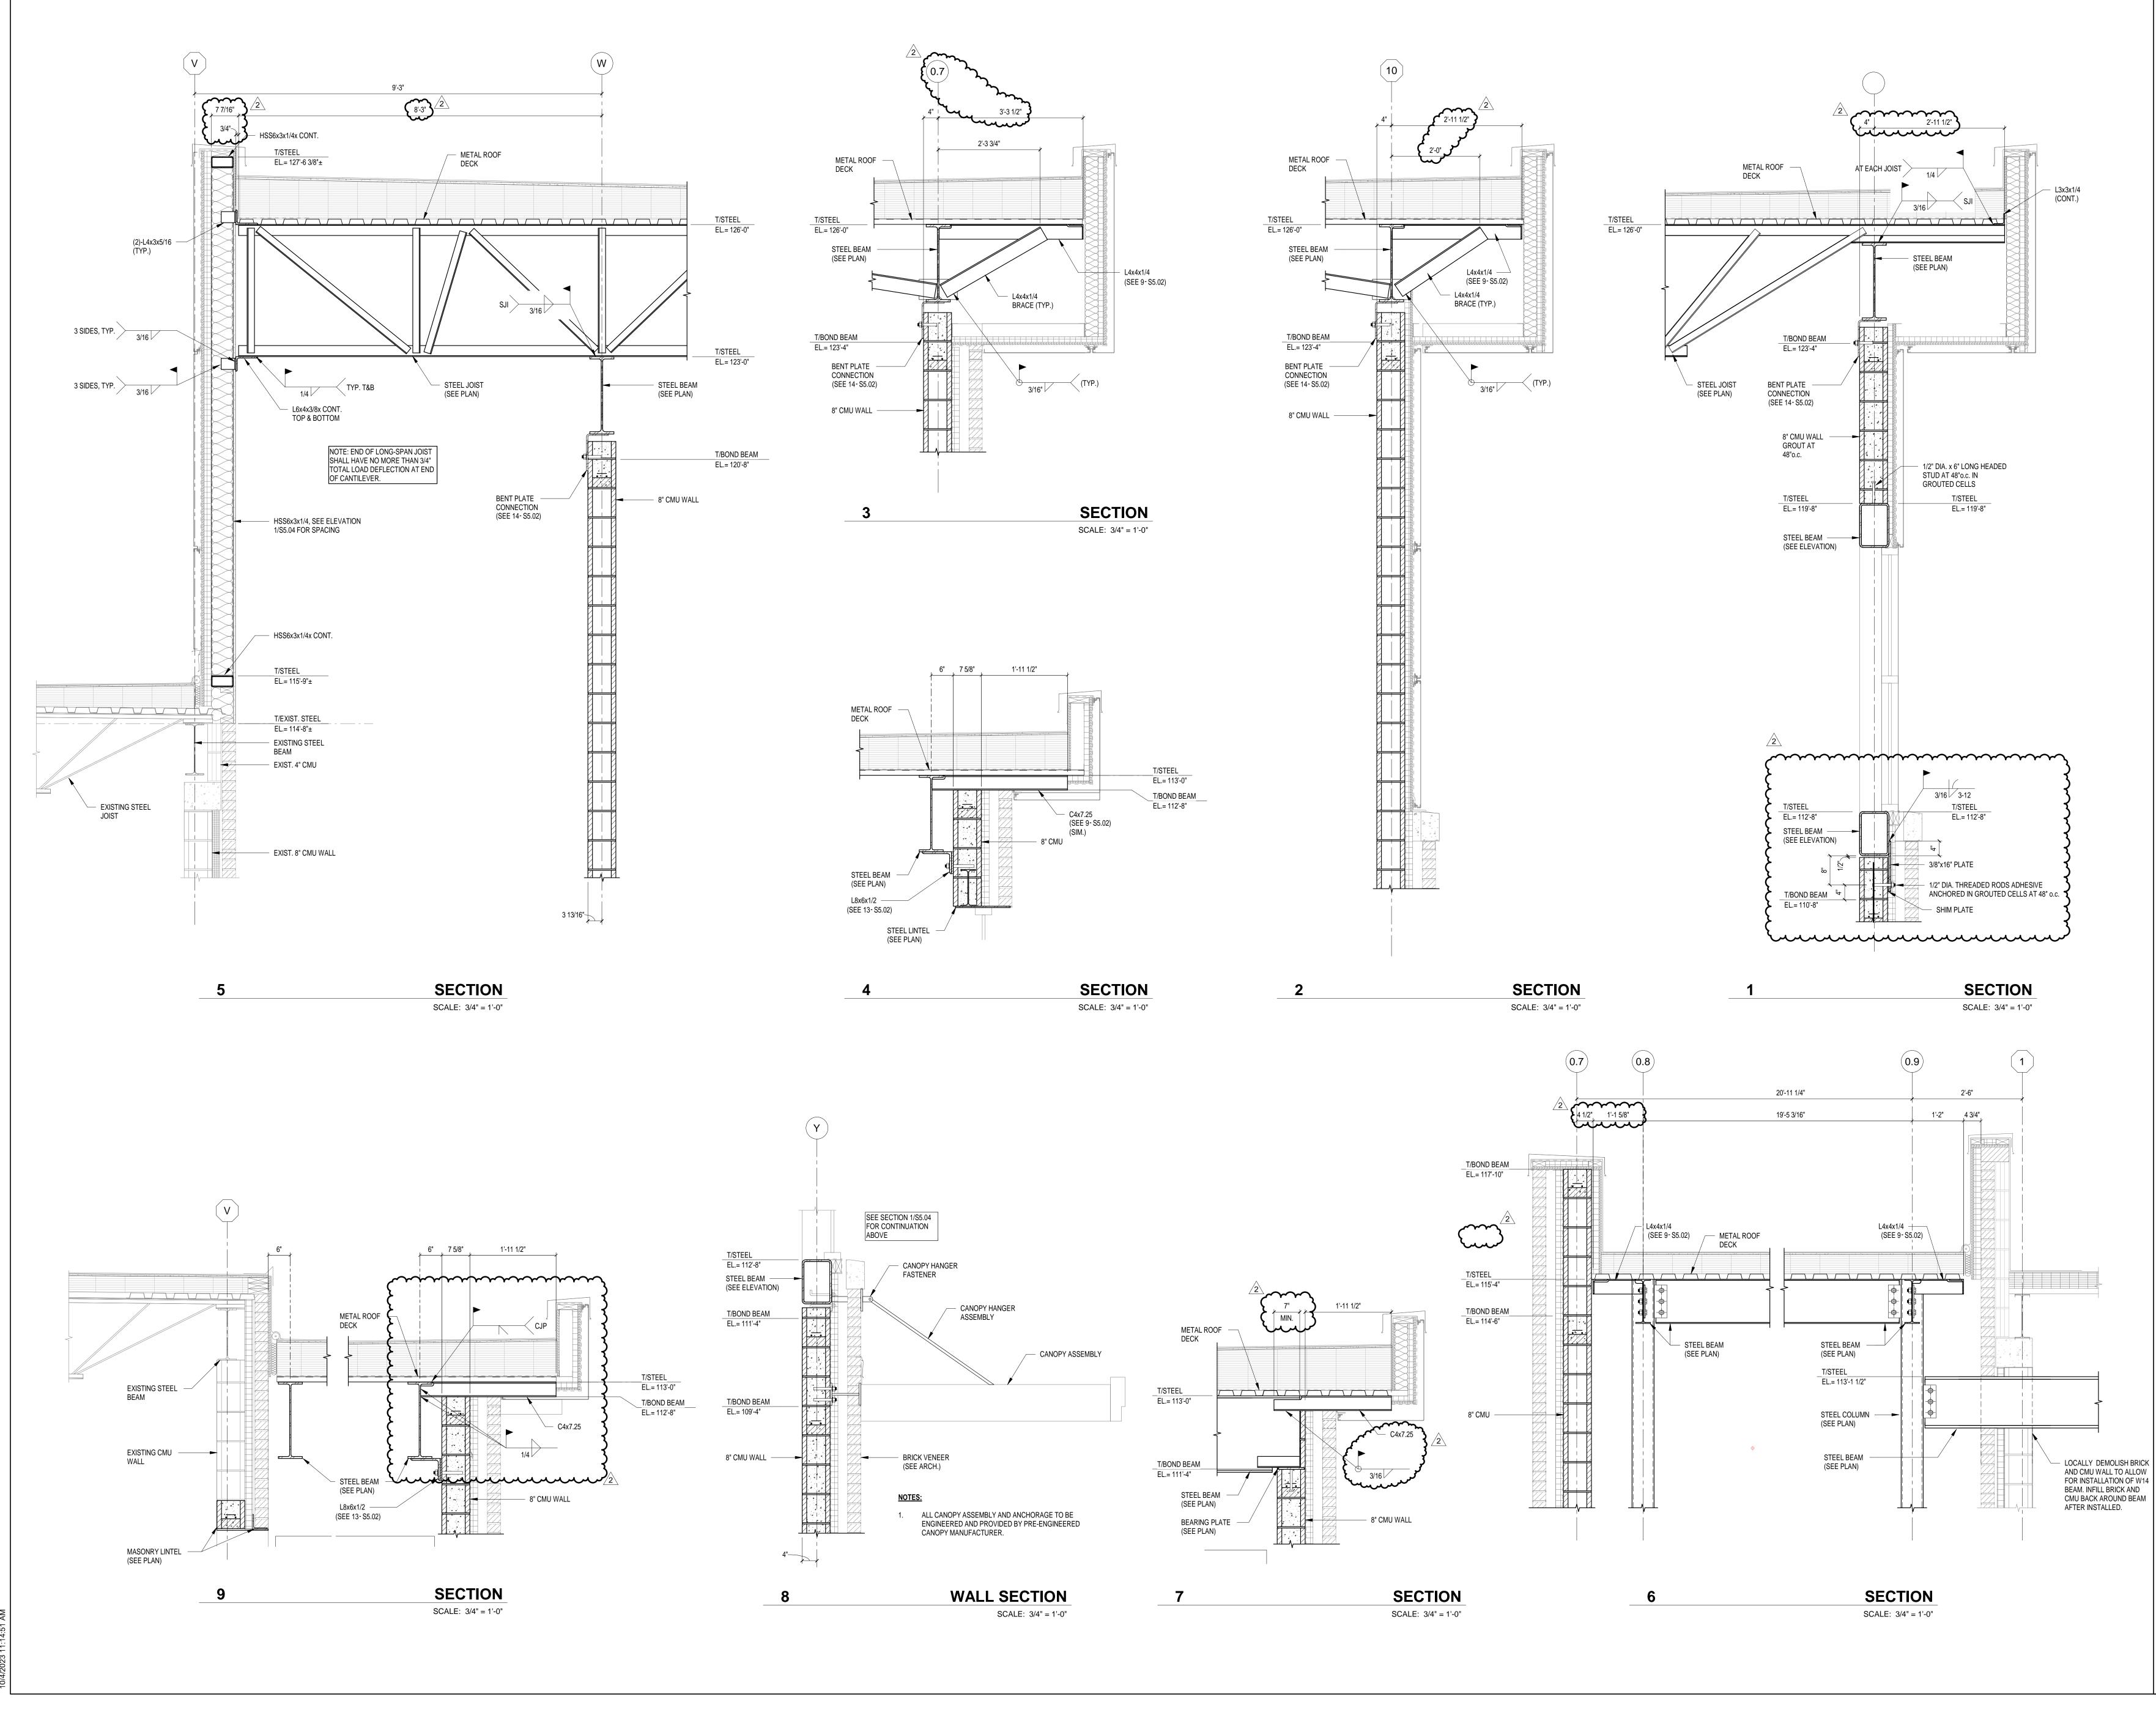

ers\tchariton\Documents\2021_STRC_221165.01_Carmel HS Polytechnic_tcharitonCLENT.vt

11.000311.

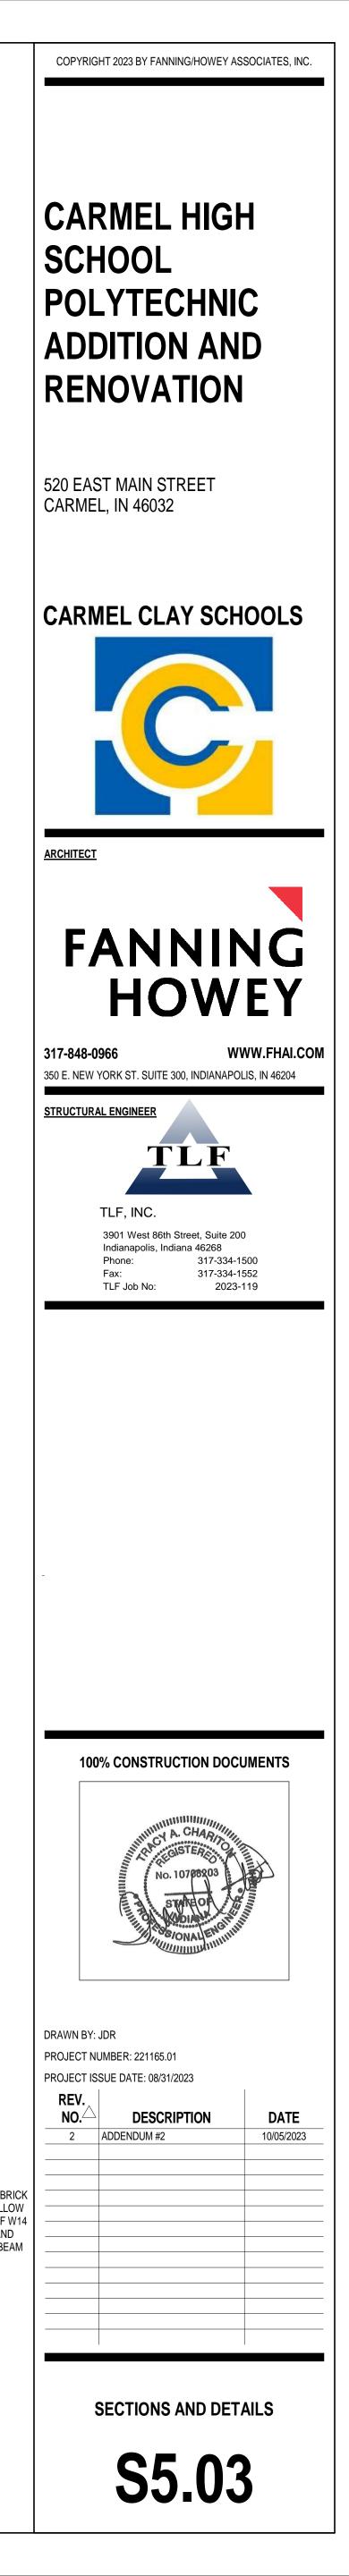


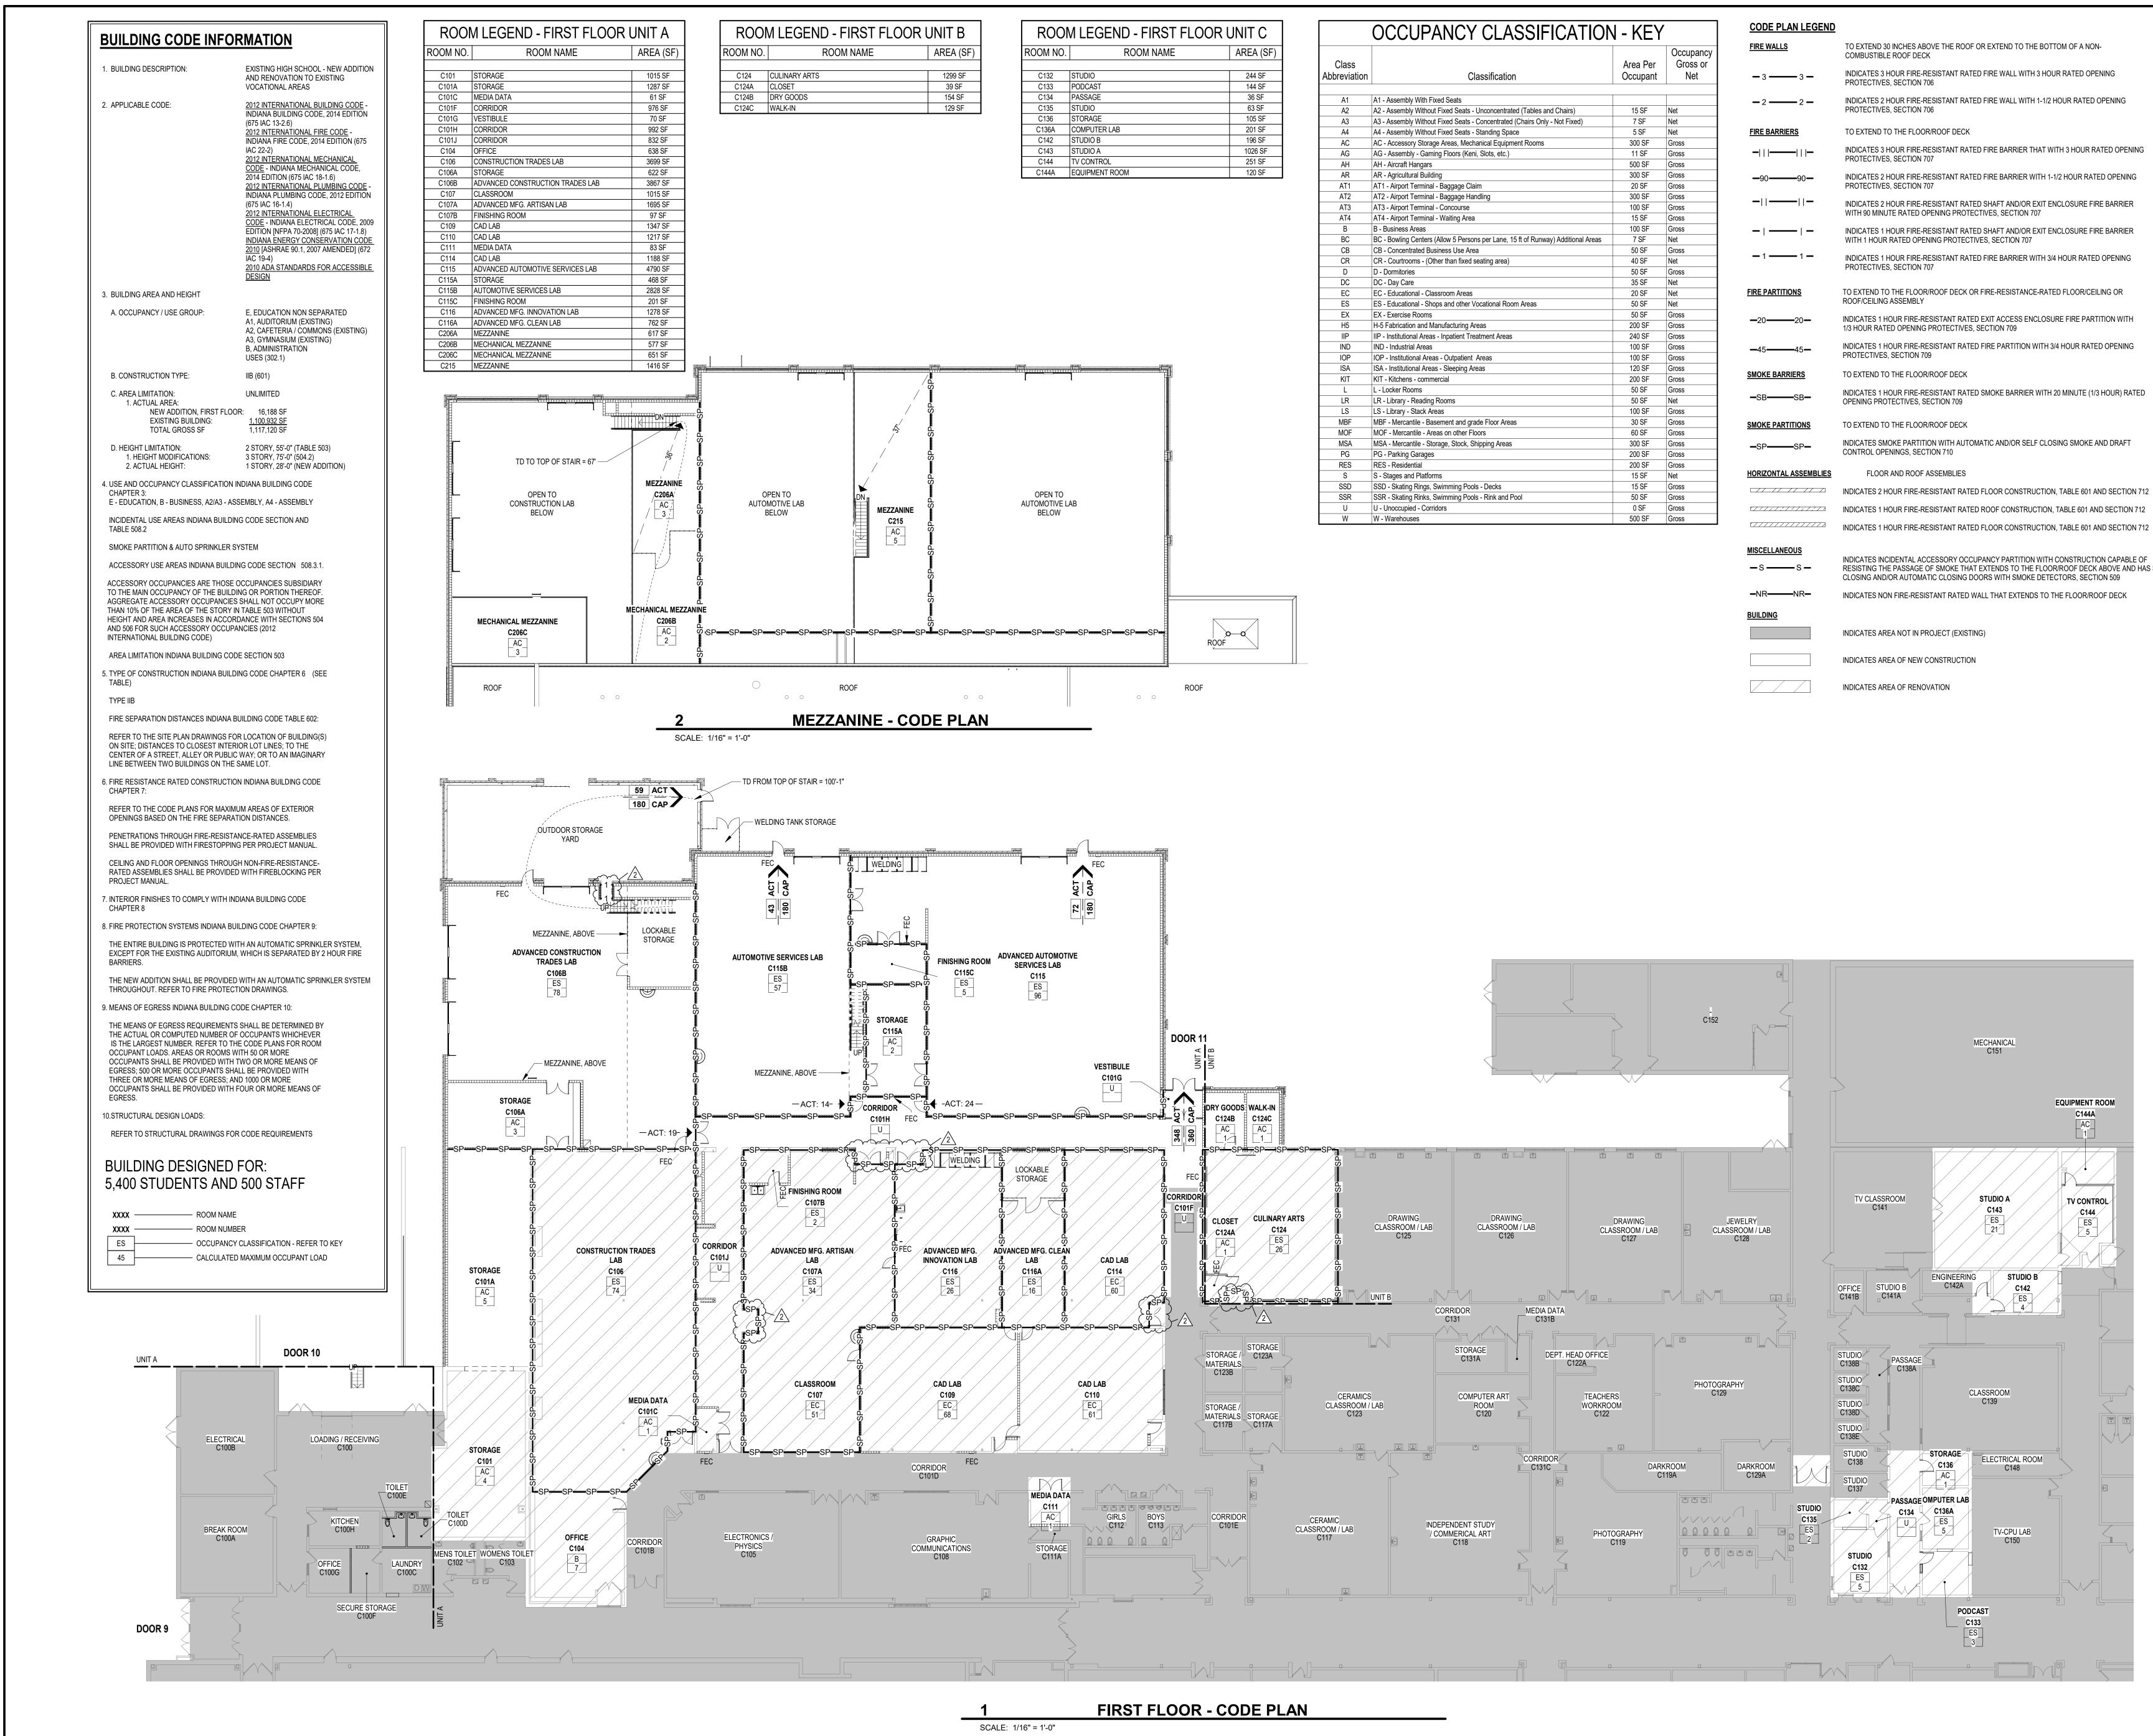


	OCCUPANCY CLASSIFICATION			FIRE WALLS	TO EXTEND 30 INCHES ABOVE THE ROOF OR EXTEND TO THE BO
		Area Per	Occupancy Gross or		COMBUSTIBLE ROOF DECK
n	Classification	Occupant	Net	<u>-3</u> <u>-3</u> <u>-</u>	INDICATES 3 HOUR FIRE-RESISTANT RATED FIRE WALL WITH 3 HO PROTECTIVES, SECTION 706
	A1 - Assembly With Fixed Seats			<u>-2</u> <u>-</u> 2 <u>-</u>	INDICATES 2 HOUR FIRE-RESISTANT RATED FIRE WALL WITH 1-1/2
	A2 - Assembly Without Fixed Seats - Unconcentrated (Tables and Chairs)	15 SF	Net	-2-2-	PROTECTIVES, SECTION 706
	A3 - Assembly Without Fixed Seats - Concentrated (Chairs Only - Not Fixed)	7 SF	Net		
	A4 - Assembly Without Fixed Seats - Standing Space	5 SF	Net	FIRE BARRIERS	TO EXTEND TO THE FLOOR/ROOF DECK
	AC - Accessory Storage Areas, Mechanical Equipment Rooms	300 SF	Gross		
	AG - Assembly - Gaming Floors (Keni, Slots, etc.)	11 SF	Gross	<u>- </u>	INDICATES 3 HOUR FIRE-RESISTANT RATED FIRE BARRIER THAT V
	AH - Aircraft Hangars	500 SF	Gross		PROTECTIVES, SECTION 707
	AR - Agricultural Building	300 SF	Gross	- 90 90 -	INDICATES 2 HOUR FIRE-RESISTANT RATED FIRE BARRIER WITH 1
	AT1 - Airport Terminal - Baggage Claim	20 SF	Gross		PROTECTIVES, SECTION 707
	AT2 - Airport Terminal - Baggage Handling	300 SF	Gross		
	AT3 - Airport Terminal - Concourse	100 SF	Gross	-	INDICATES 2 HOUR FIRE-RESISTANT RATED SHAFT AND/OR EXIT E
	AT4 - Airport Terminal - Waiting Area	15 SF	Gross		WITH 90 MINUTE RATED OPENING PROTECTIVES, SECTION 707
	B - Business Areas	100 SF	Gross	_ _	INDICATES 1 HOUR FIRE-RESISTANT RATED SHAFT AND/OR EXIT
	BC - Bowling Centers (Allow 5 Persons per Lane, 15 ft of Runway) Additional Areas	7 SF	Net	1 1	WITH 1 HOUR RATED OPENING PROTECTIVES, SECTION 707
	CB - Concentrated Business Use Area	50 SF	Gross		
	CR - Courtrooms - (Other than fixed seating area)	40 SF	Net	— 1 — 1 —	INDICATES 1 HOUR FIRE-RESISTANT RATED FIRE BARRIER WITH 3
	D - Dormitories	50 SF	Gross		PROTECTIVES, SECTION 707
	DC - Day Care	35 SF	Net		
	EC - Educational - Classroom Areas	20 SF	Net	FIRE PARTITIONS	TO EXTEND TO THE FLOOR/ROOF DECK OR FIRE-RESISTANCE-RAT
	ES - Educational - Shops and other Vocational Room Areas	50 SF	Net		ROOF/CEILING ASSEMBLY
	EX - Exercise Rooms	50 SF	Gross	20 20	INDICATES 1 HOUR FIRE-RESISTANT RATED EXIT ACCESS ENCLOS
	H-5 Fabrication and Manufacturing Areas	200 SF	Gross	-20-20-	1/3 HOUR RATED OPENING PROTECTIVES, SECTION 709
	IIP - Institutional Areas - Inpatient Treatment Areas	240 SF	Gross		
	IND - Industrial Areas	100 SF	Gross		INDICATES 1 HOUR FIRE-RESISTANT RATED FIRE PARTITION WITH
	IOP - Institutional Areas - Outpatient Areas	100 SF	Gross		PROTECTIVES, SECTION 709
	ISA - Institutional Areas - Sleeping Areas	120 SF	Gross		
	KIT - Kitchens - commercial	200 SF	Gross	SMOKE BARRIERS	TO EXTEND TO THE FLOOR/ROOF DECK
	L - Locker Rooms	50 SF	Gross		INDICATES 1 HOUR FIRE-RESISTANT RATED SMOKE BARRIER WITH
	LR - Library - Reading Rooms	50 SF	Net	-SB-SB-	OPENING PROTECTIVES, SECTION 709
	LS - Library - Stack Areas	100 SF	Gross		
	MBF - Mercantile - Basement and grade Floor Areas	30 SF	Gross	SMOKE PARTITIONS	TO EXTEND TO THE FLOOR/ROOF DECK
	MOF - Mercantile - Areas on other Floors	60 SF	Gross	<u></u>	
	MSA - Mercantile - Storage, Stock, Shipping Areas	300 SF	Gross	-SP-SP-	INDICATES SMOKE PARTITION WITH AUTOMATIC AND/OR SELF CLC
	PG - Parking Garages	200 SF	Gross		CONTROL OPENINGS, SECTION 710
	RES - Residential	200 SF	Gross		
	S - Stages and Platforms	15 SF	Net	HORIZONTAL ASSEMBLIES	FLOOR AND ROOF ASSEMBLIES
	SSD - Skating Rings, Swimming Pools - Decks	15 SF	Gross		INDICATES 2 HOUR FIRE-RESISTANT RATED FLOOR CONSTRUCTIO
	SSR - Skating Rinks, Swimming Pools - Rink and Pool	50 SF	Gross		
	U - Unoccupied - Corridors	0 SF	Gross	///////////////////////////////////////	INDICATES 1 HOUR FIRE-RESISTANT RATED ROOF CONSTRUCTION
	W - Warehouses	500 SF	Gross	(//////////////////////////////////////	INDICATES 1 HOUR FIRE-RESISTANT RATED FLOOR CONSTRUCTIO

CTION, TABLE 601 AND SECTION 712 INDICATES INCIDENTAL ACCESSORY OCCUPANCY PARTITION WITH CONSTRUCTION CAPABLE OF RESISTING THE PASSAGE OF SMOKE THAT EXTENDS TO THE FLOOR/ROOF DECK ABOVE AND HAS SELF



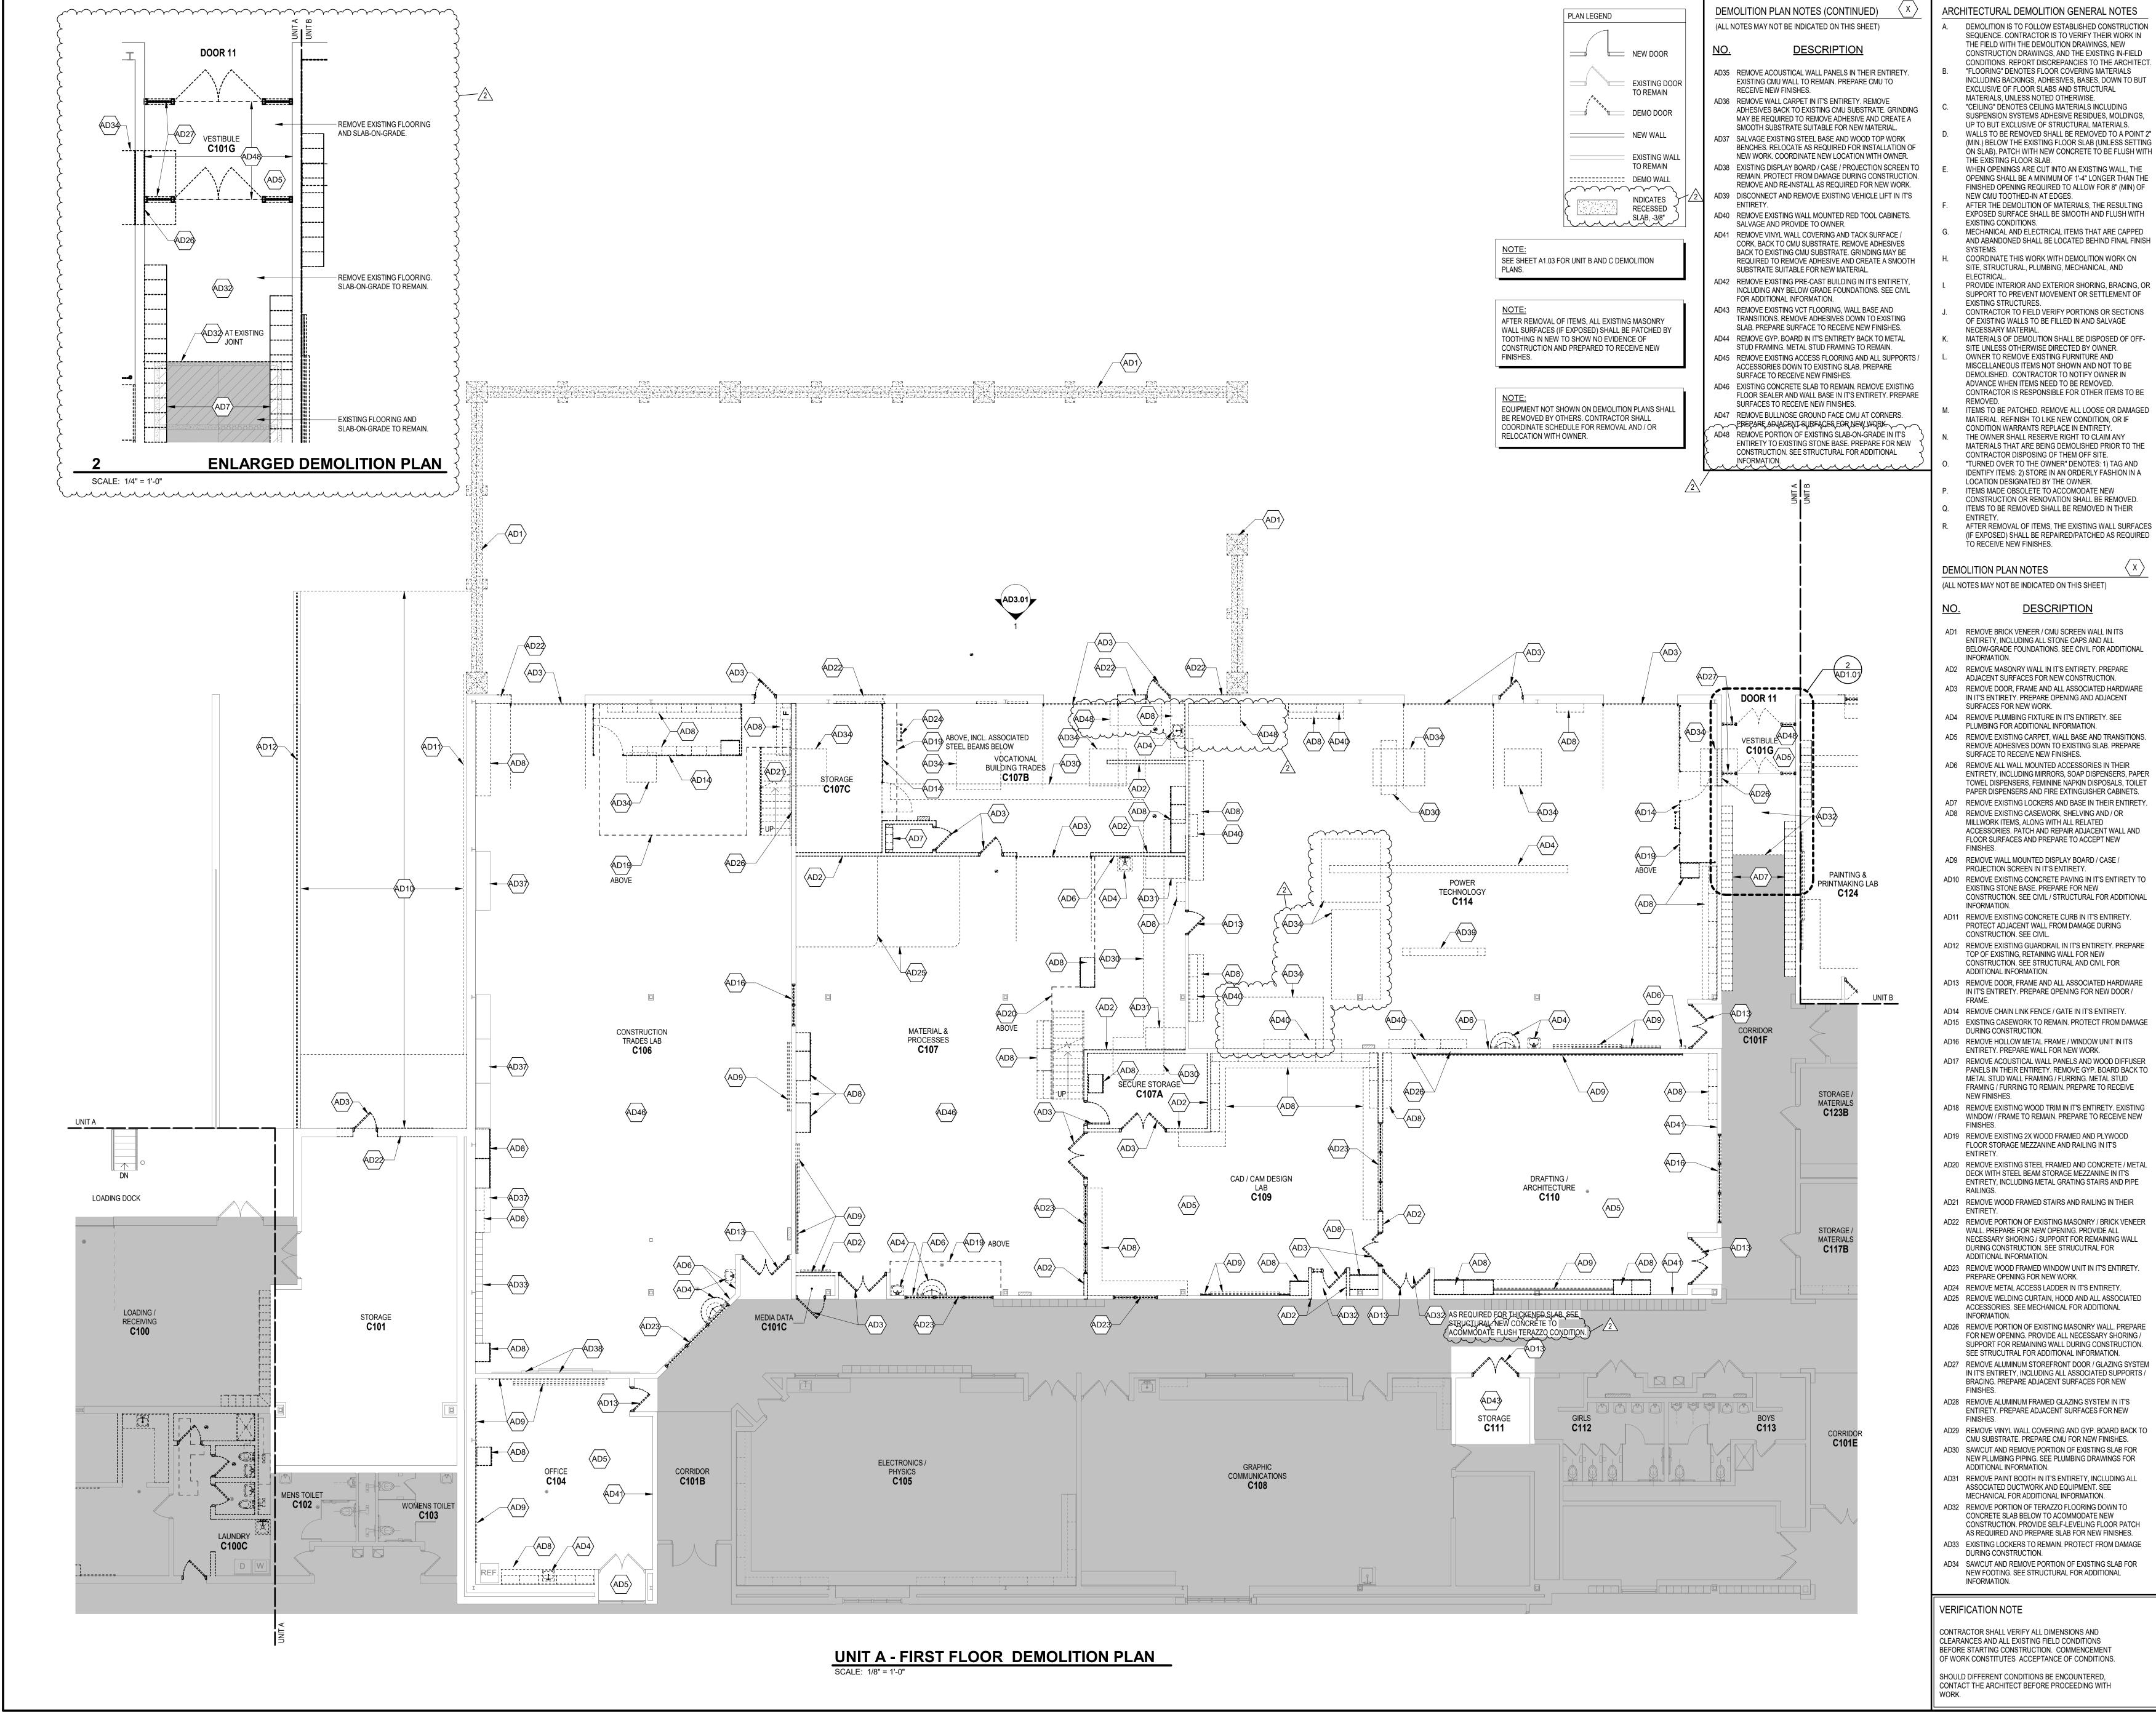

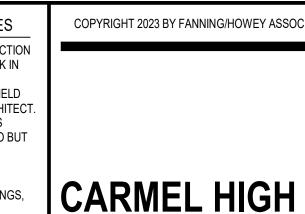

SCHOOL

POLYTECHNIC

ADDITION AND

RENOVATION

520 EAST MAIN STREET

CARMEL CLAY SCHOOLS

FANNING

350 E. NEW YORK ST. SUITE 300, INDIANAPOLIS, IN 46204

HOWEY

WWW.FHAI.COM

CARMEL, IN 46032

ARCHITECT

317-848-0966

NEW ADDITION

UNIT A

KEY PLAN

100% CONSTRUCTION DOCUMENTS

No AR10800161

STATE OF

DRAWN BY: DSR

REV.

NO.

PROJECT NUMBER: 221165.01

PROJECT ISSUE DATE: 08/31/2023

ADDENDUM #2

DESCRIPTION

DATE


10/05/2023


UNIT A - FIRST FLOOR DEMOLITION PLAN




COPYRIGHT 2023 BY FANNING/HOWEY ASSOCIATES, INC.




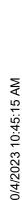

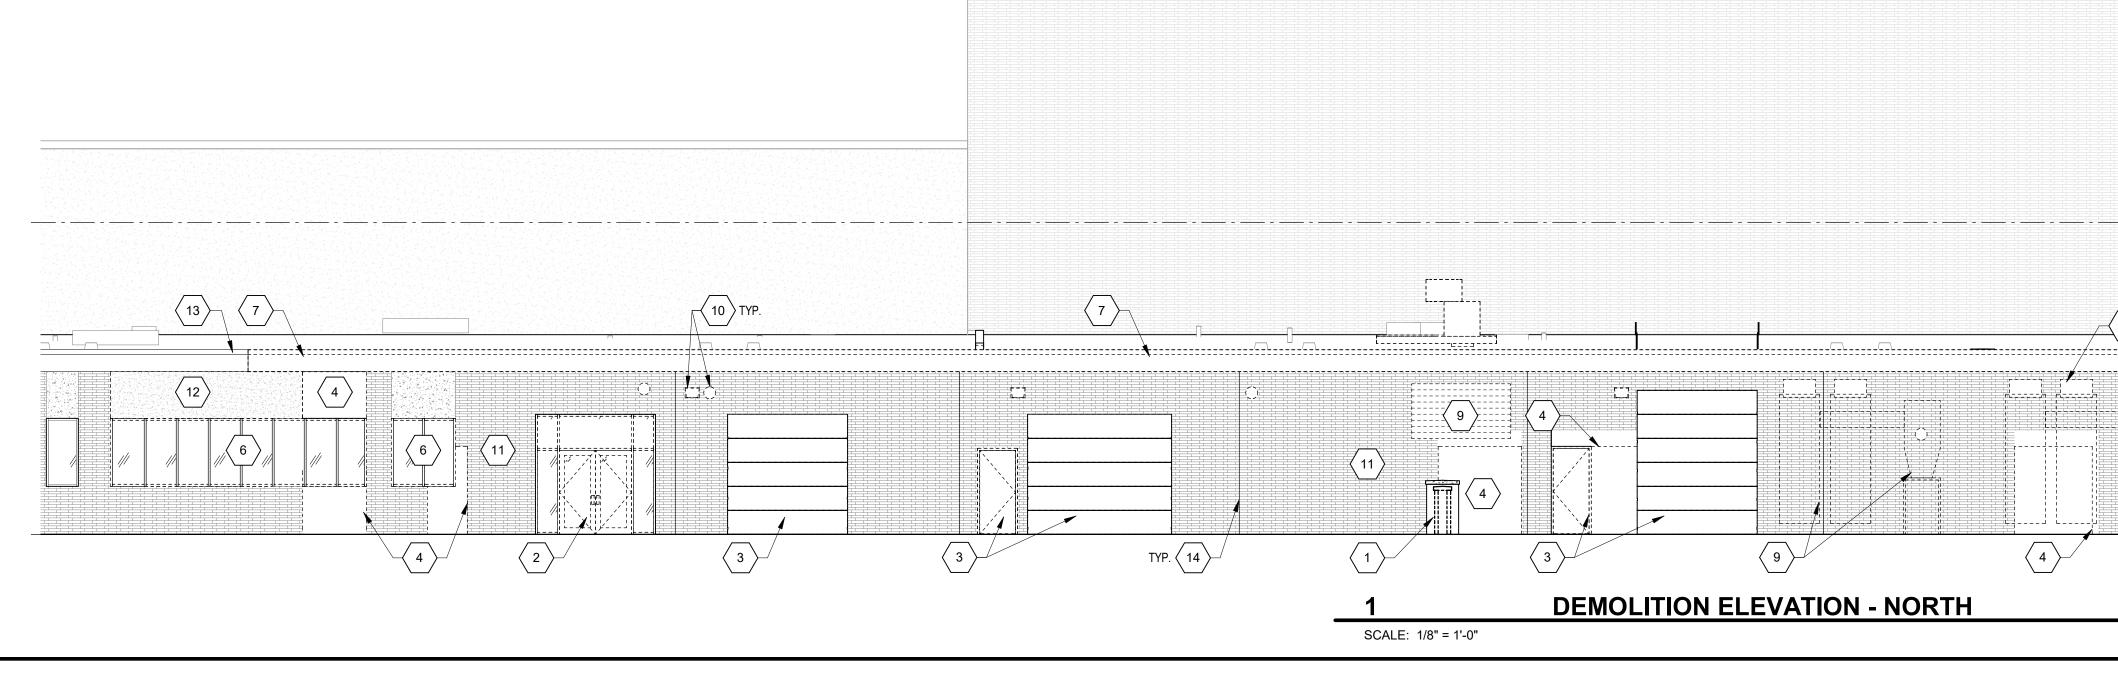




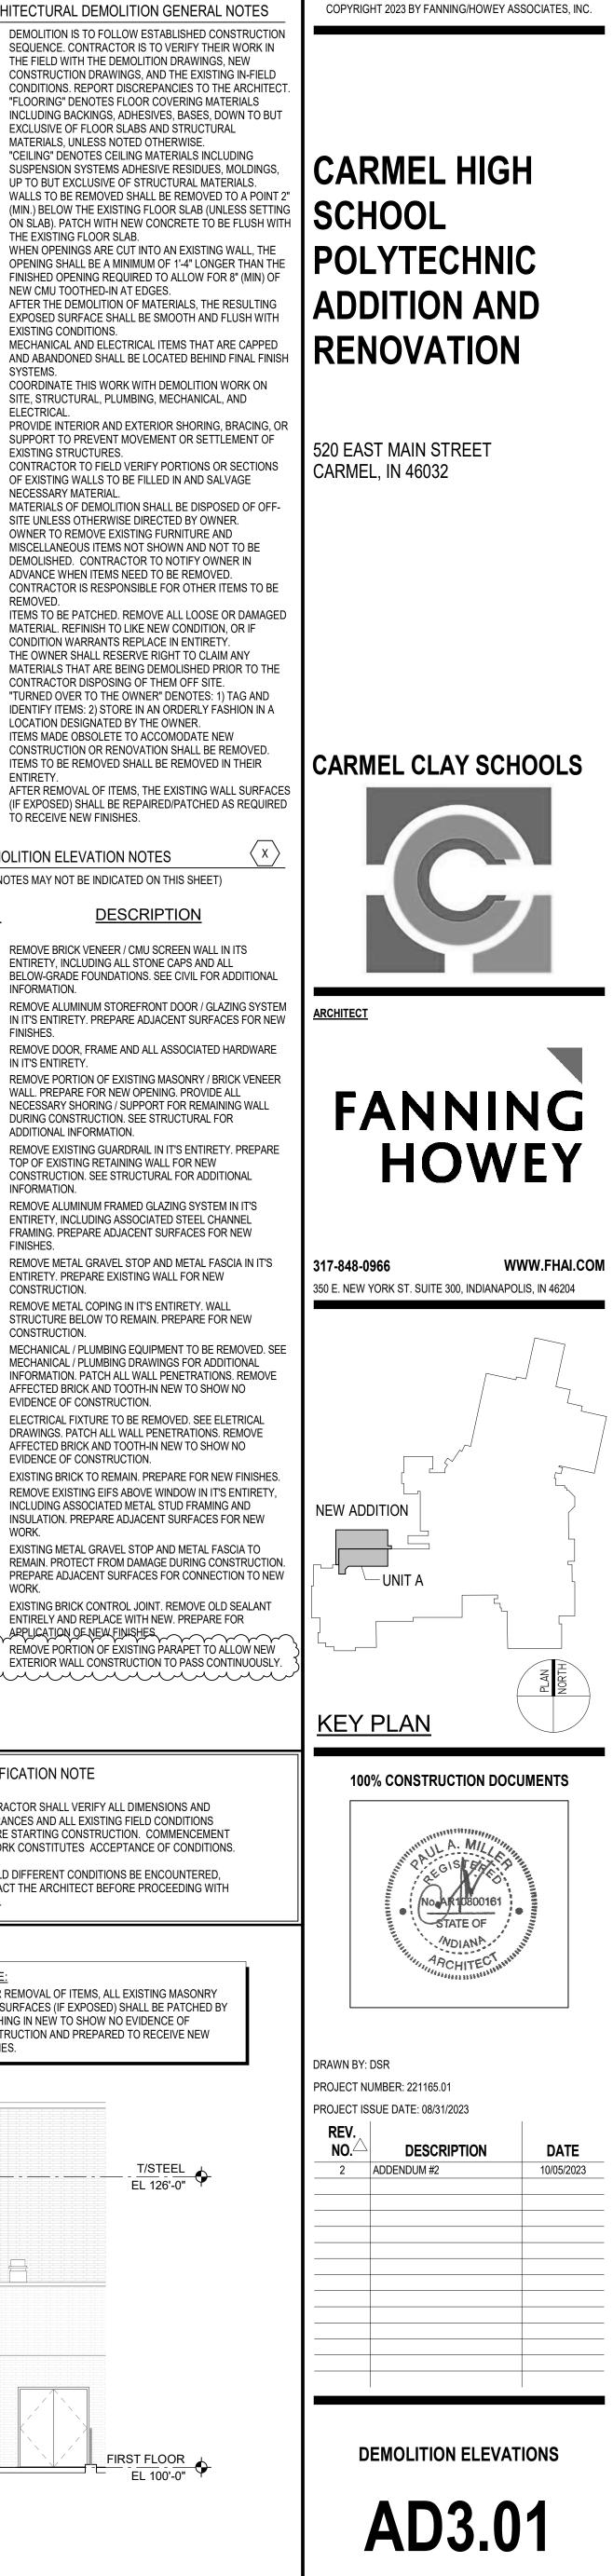

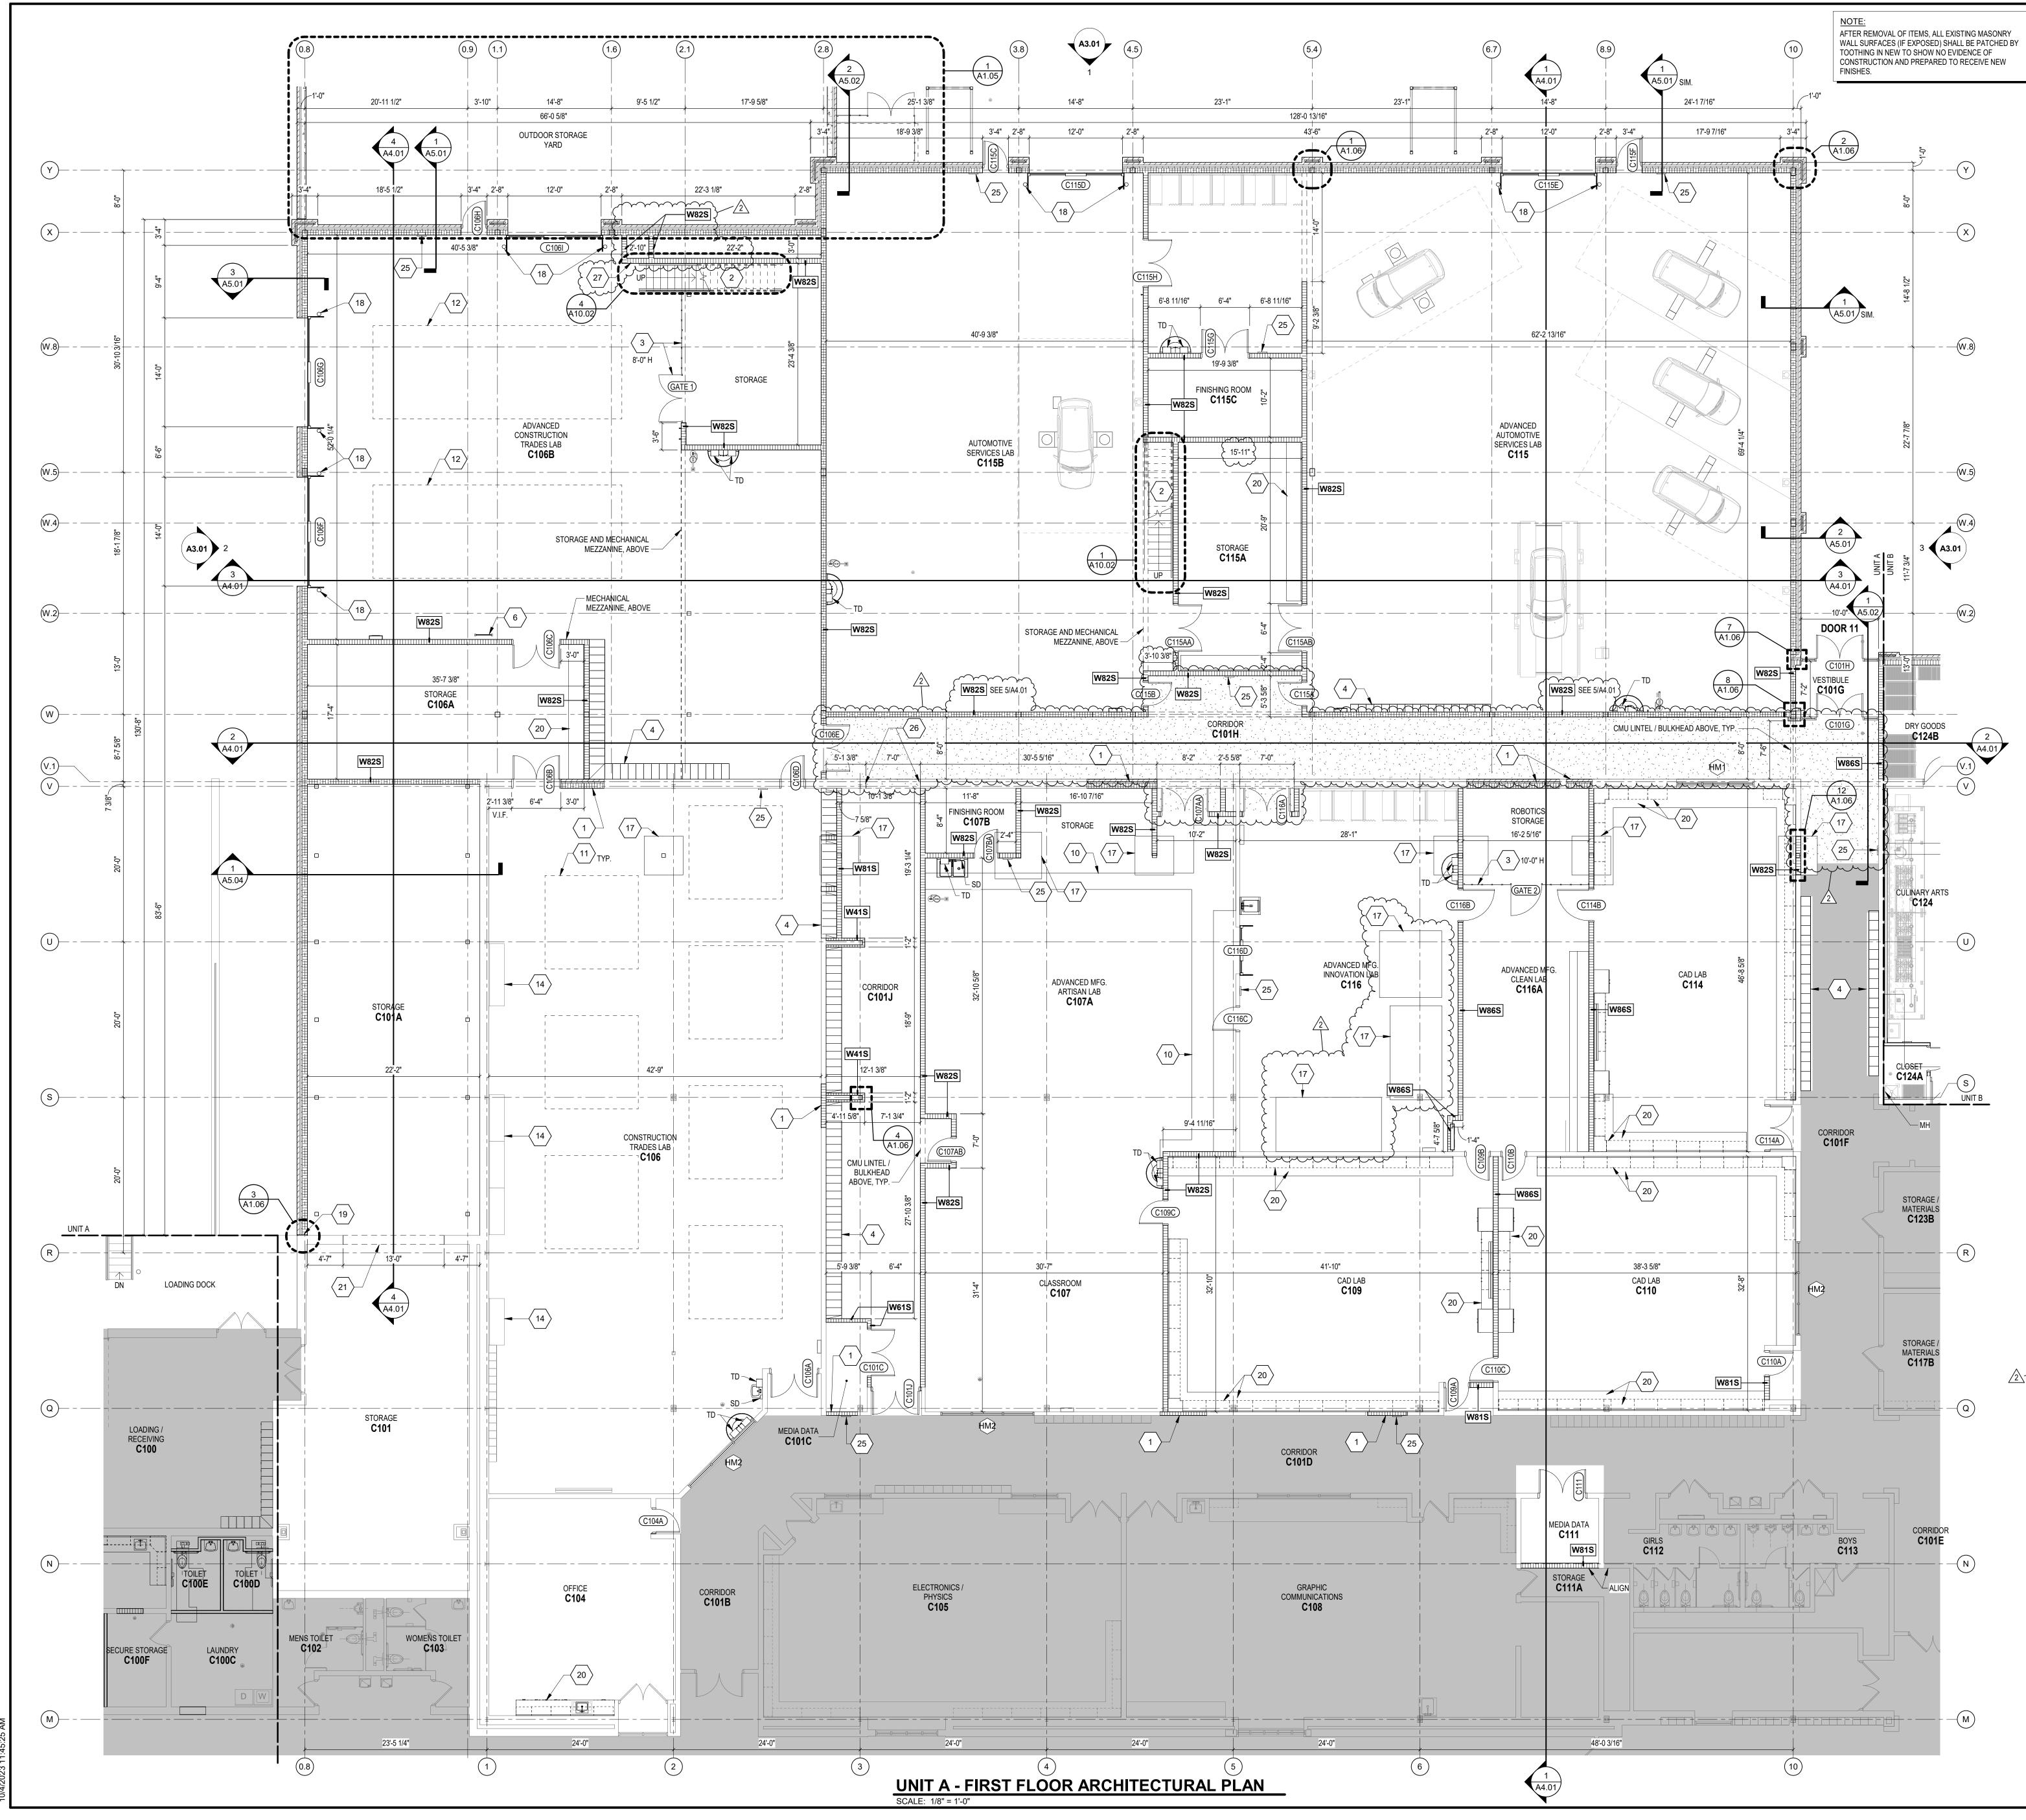

rs\droan\Documents\2021_ARCH_221165.01_droanR3Y2N

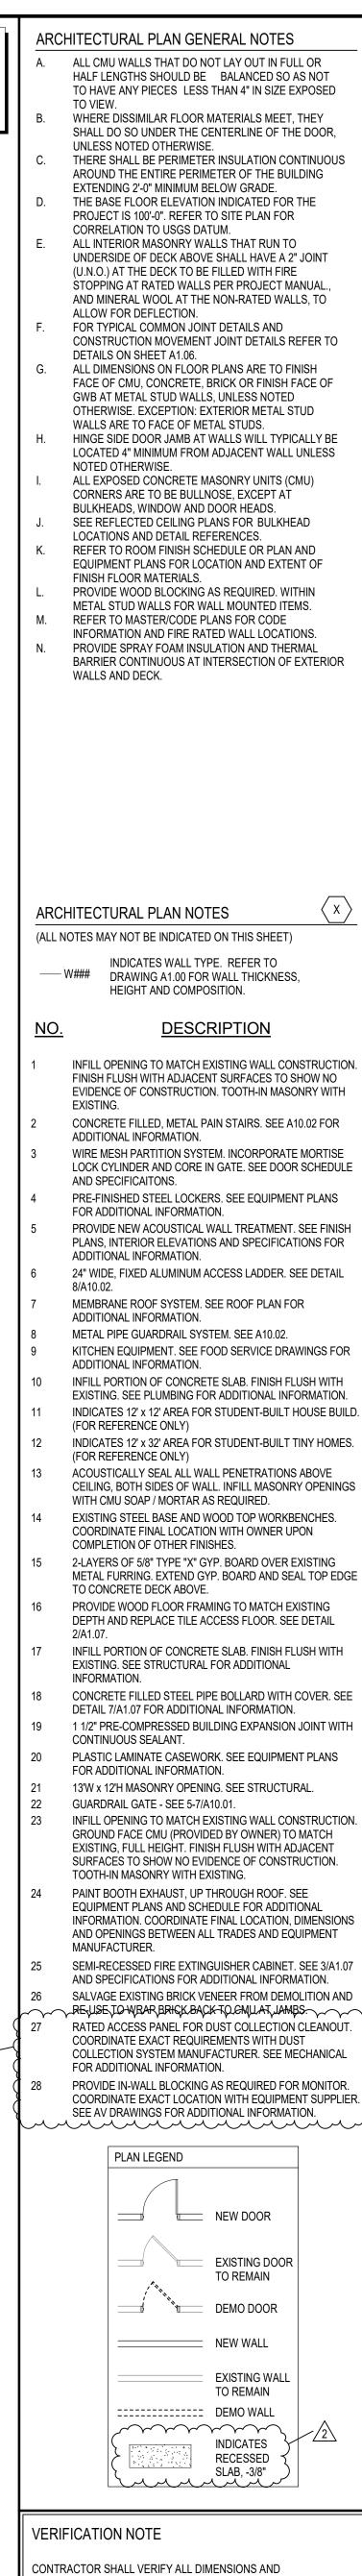


SHOULD DIFFERENT CONDITIONS BE ENCOUNTERED, CONTACT THE ARCHITECT BEFORE PROCEEDING WITH WORK.


CLEARANCES AND ALL EXISTING FIELD CONDITIONS

BEFORE STARTING CONSTRUCTION. COMMENCEMENT

OF WORK CONSTITUTES ACCEPTANCE OF CONDITIONS.

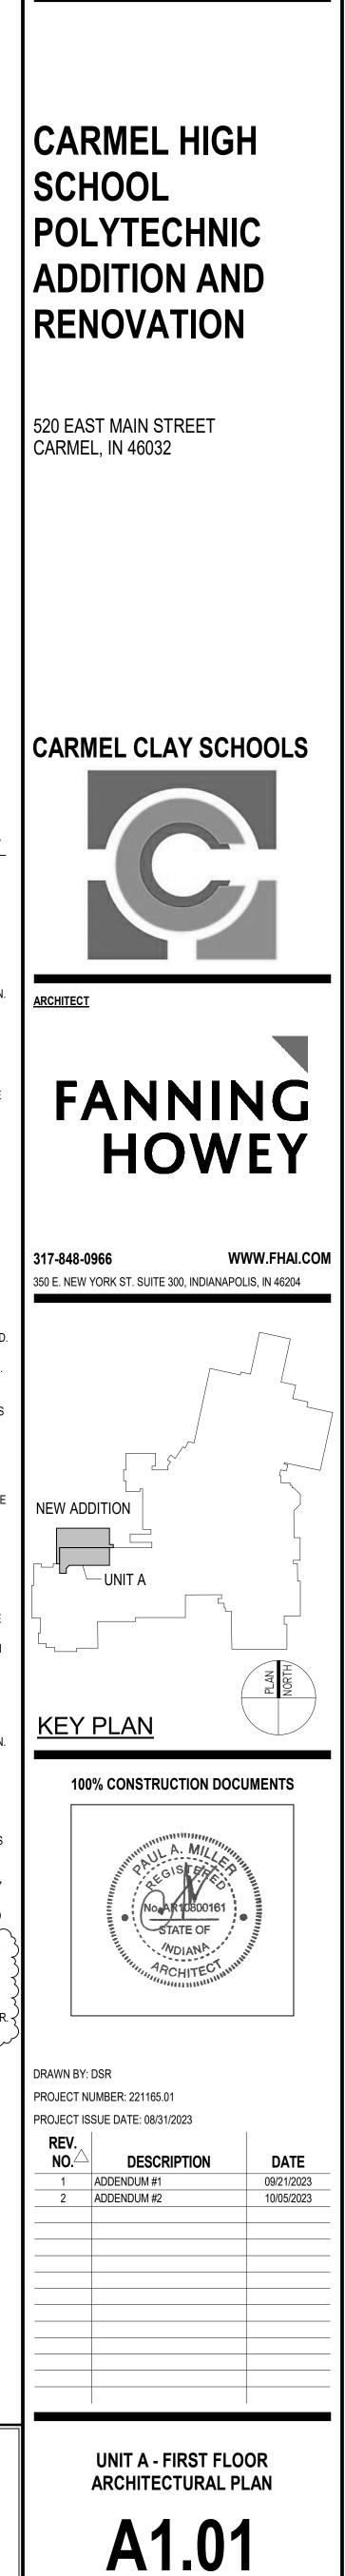

COPYRIGHT 2023 BY FANNING/HOWEY ASSOCIATES, INC.

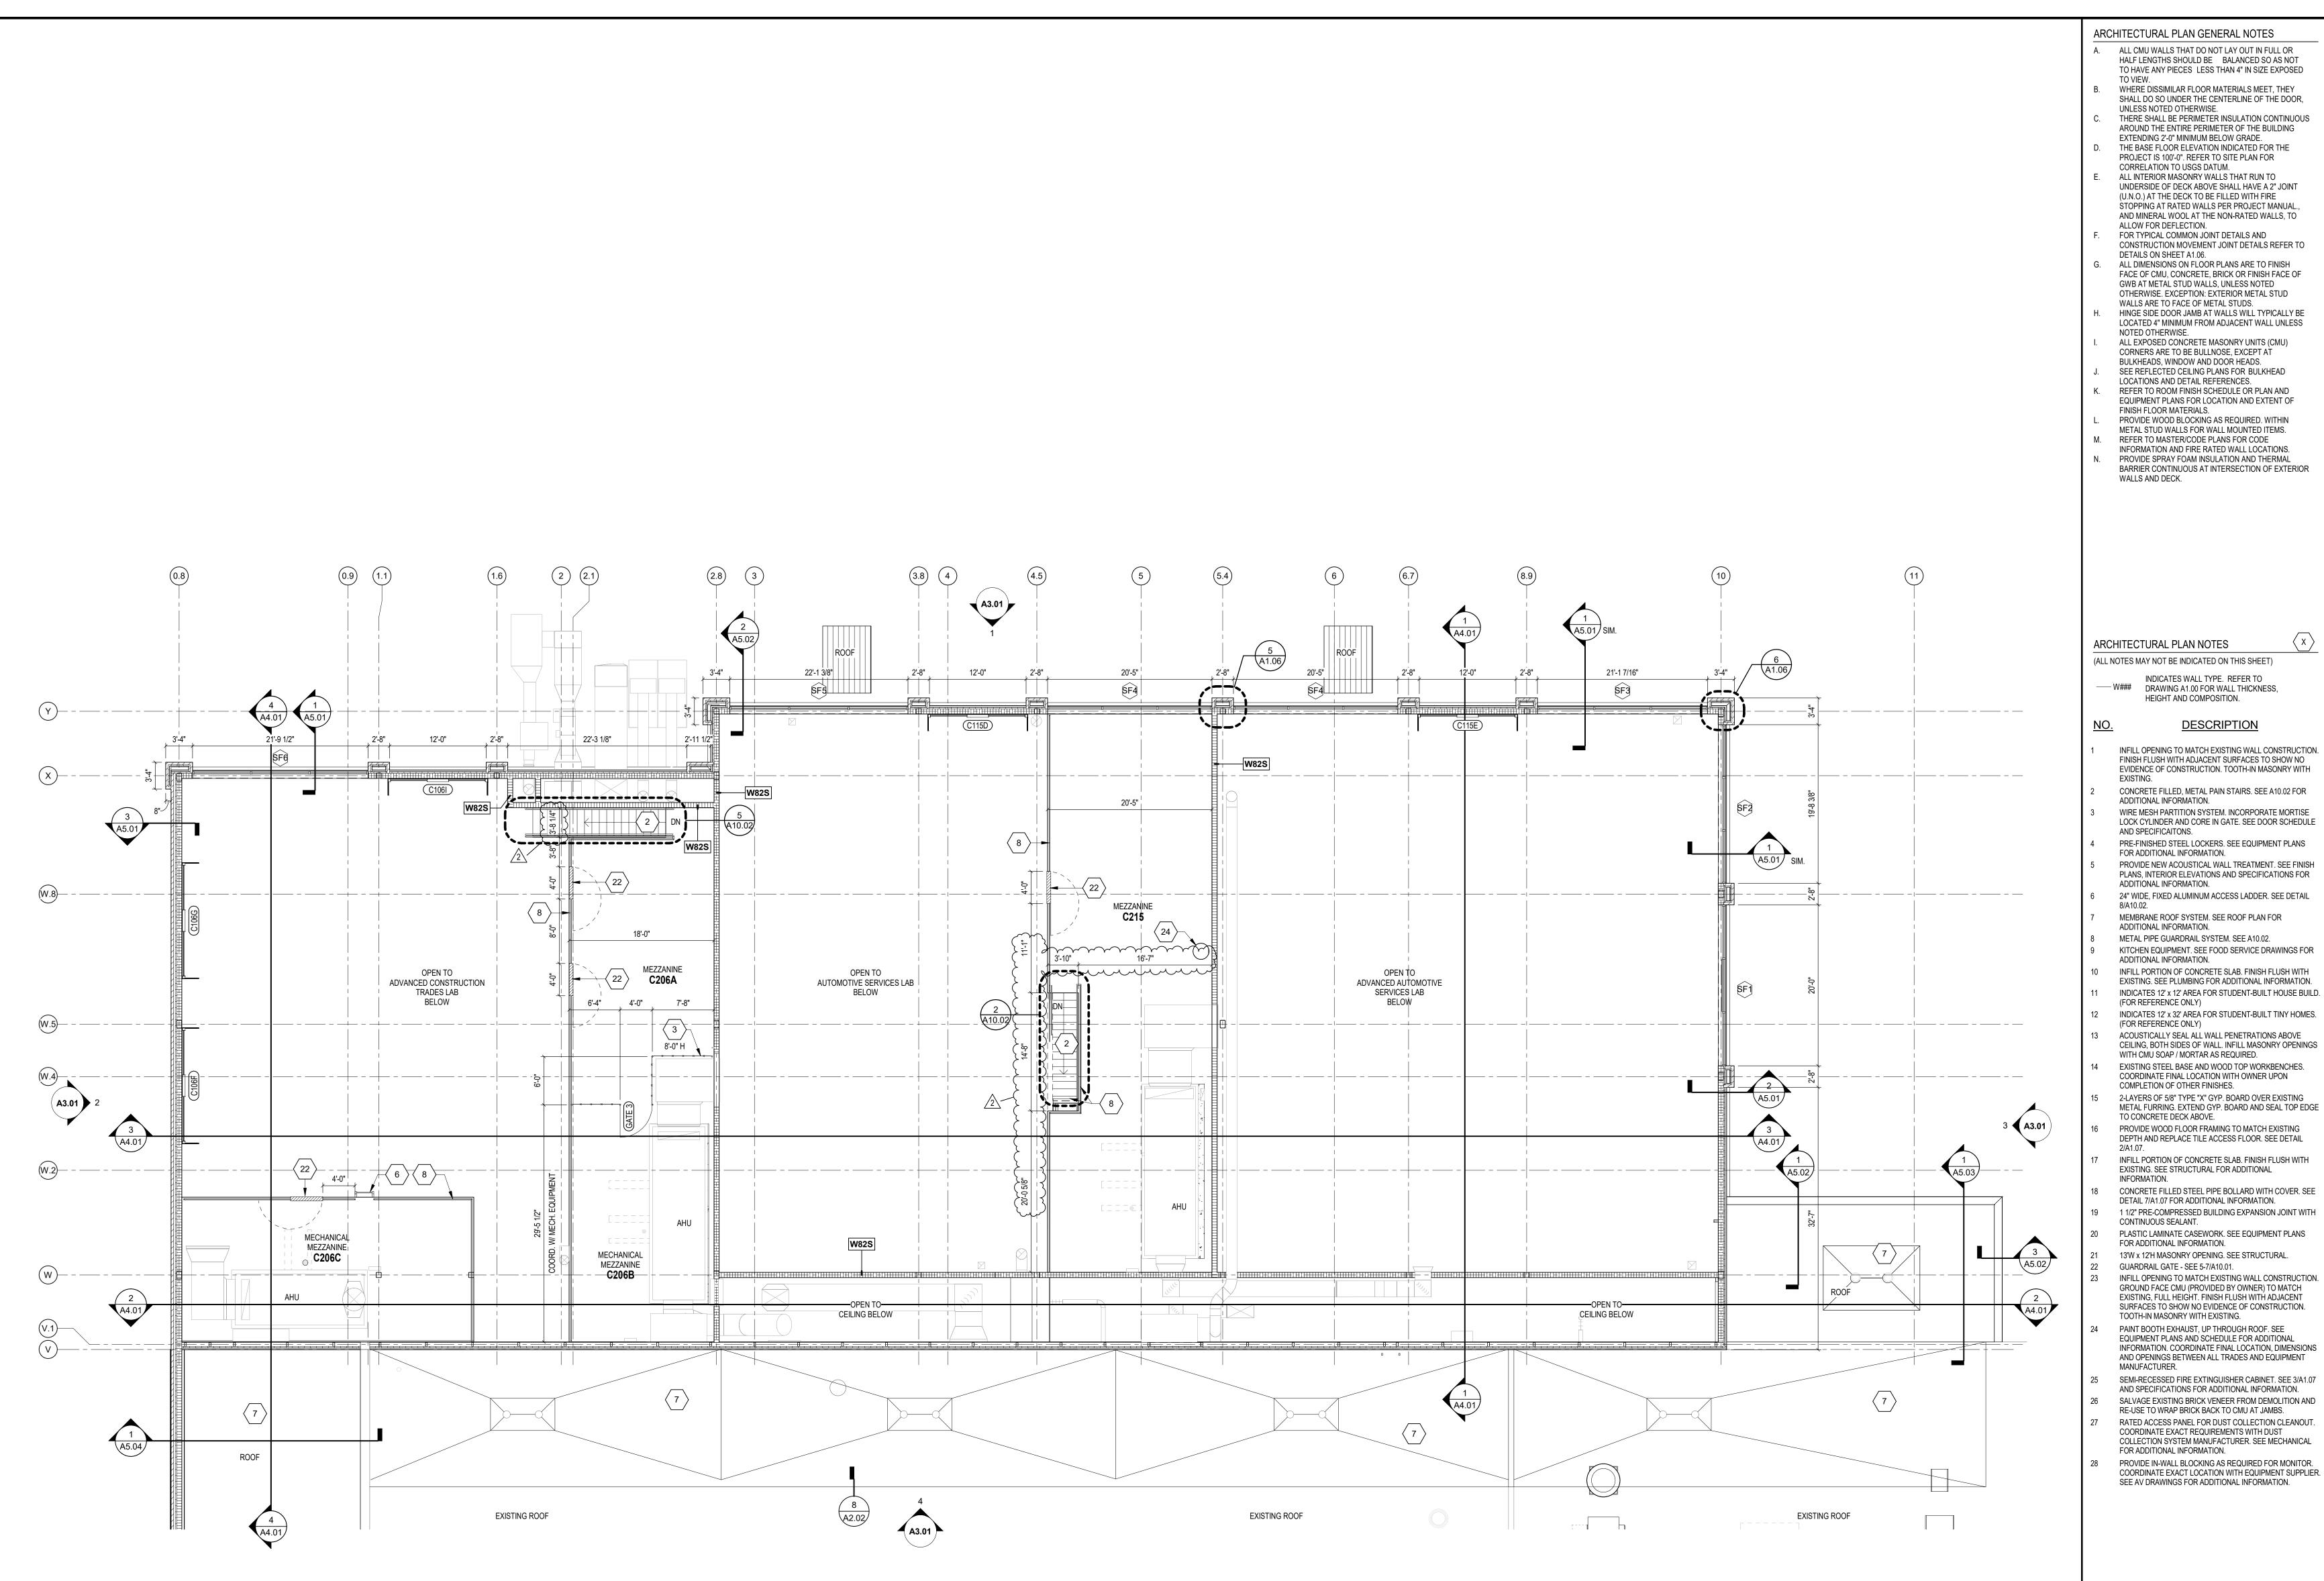




VERIFICATION NOTE

WORK.


CONTRACTOR SHALL VERIFY ALL DIMENSIONS AND CLEARANCES AND ALL EXISTING FIELD CONDITIONS BEFORE STARTING CONSTRUCTION. COMMENCEMENT OF WORK CONSTITUTES ACCEPTANCE OF CONDITIONS. SHOULD DIFFERENT CONDITIONS BE ENCOUNTERED, CONTACT THE ARCHITECT BEFORE PROCEEDING WITH





UNIT C - FIRST FLOOR DEMOLITION PLAN SCALE: 1/8" = 1'-0"

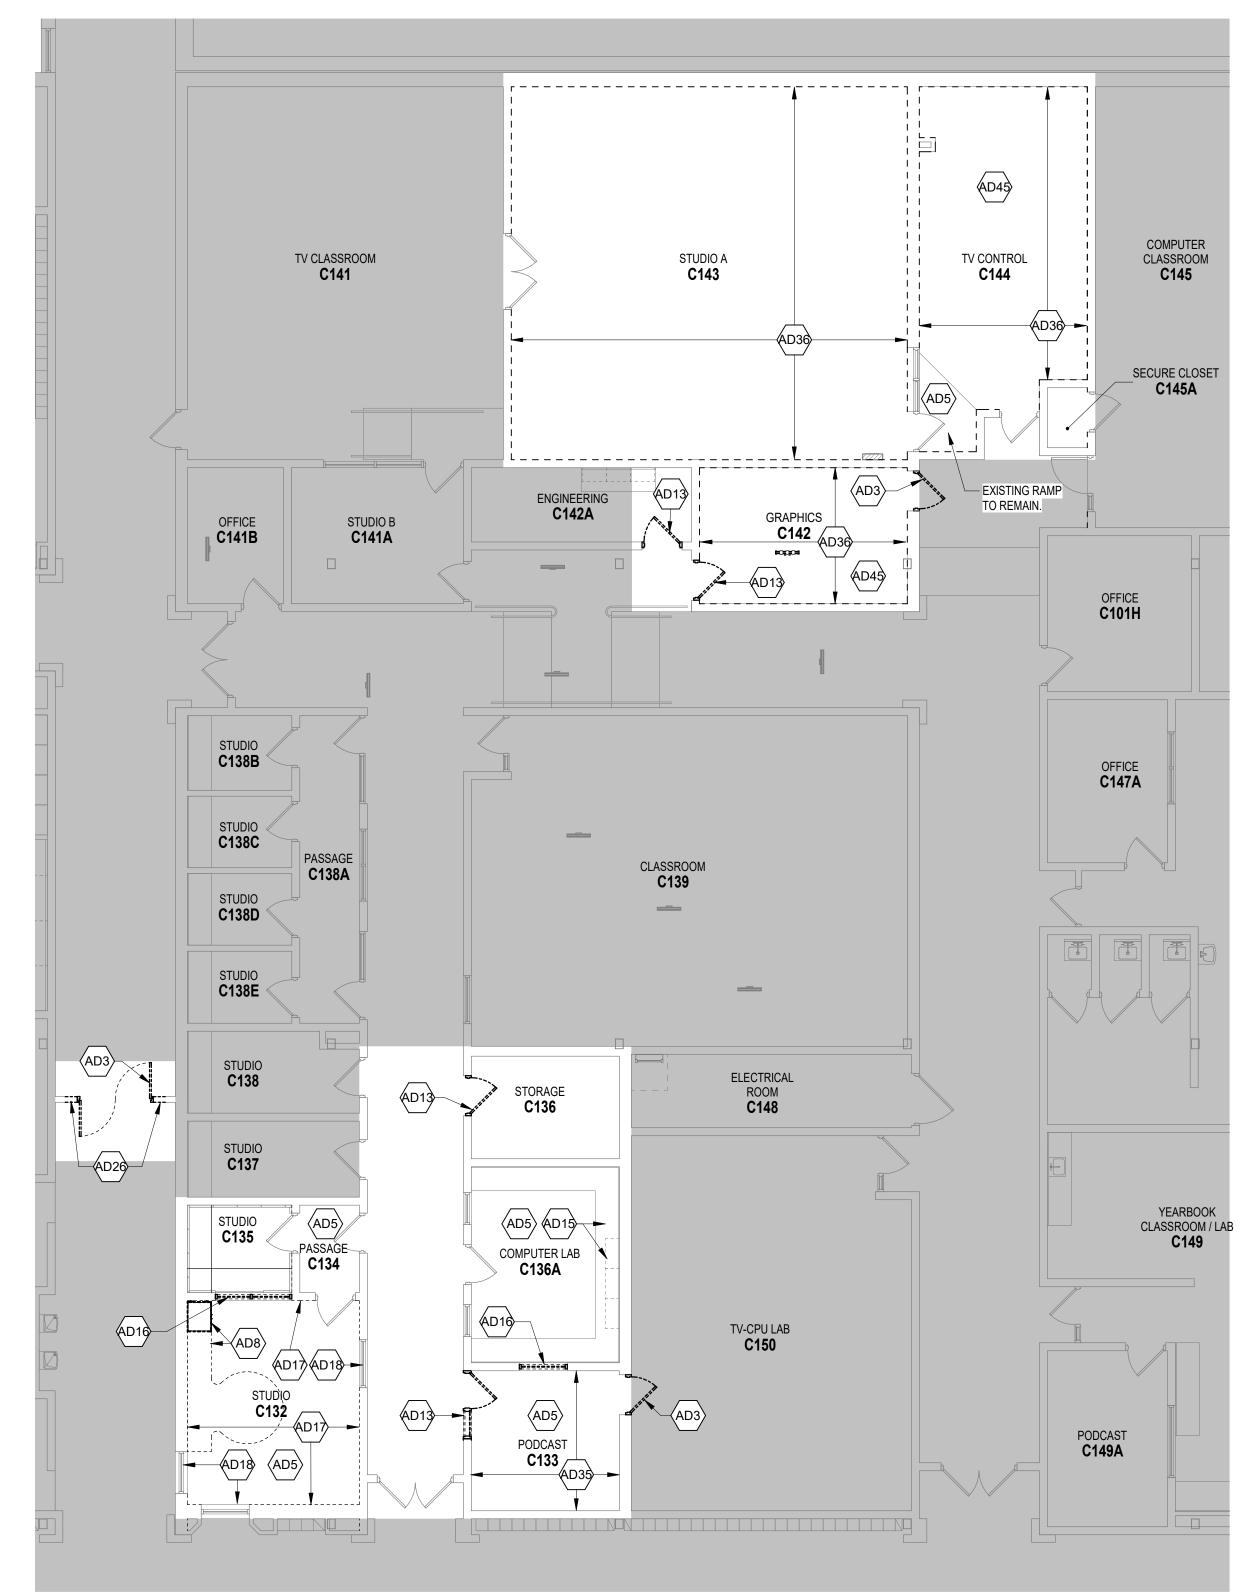



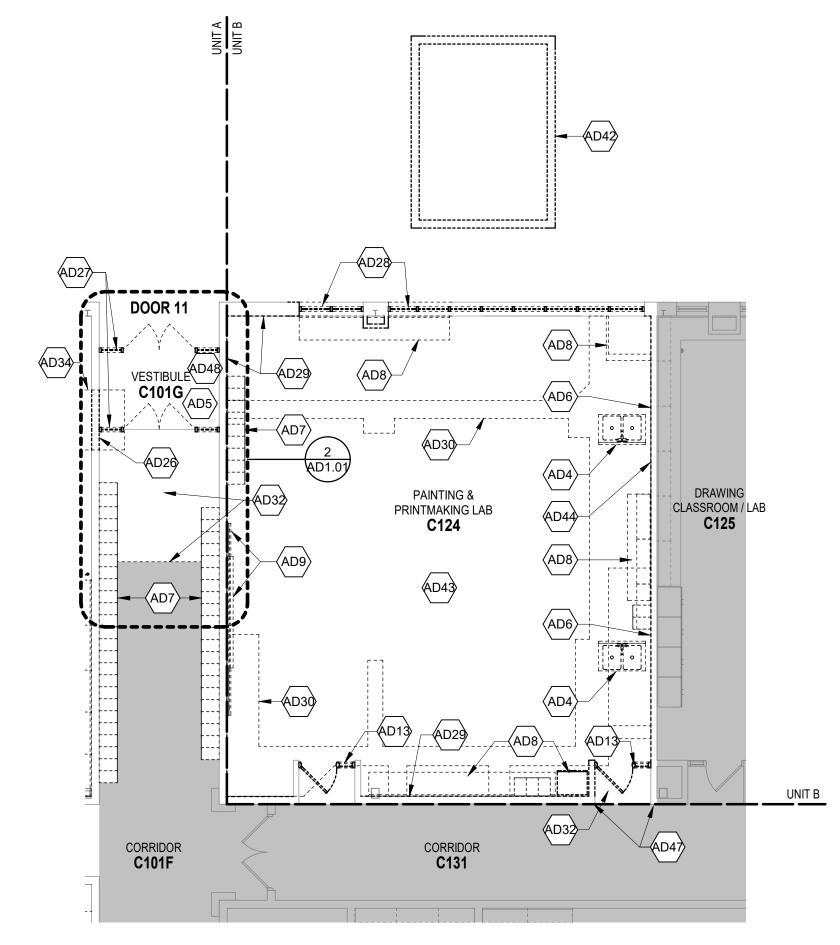

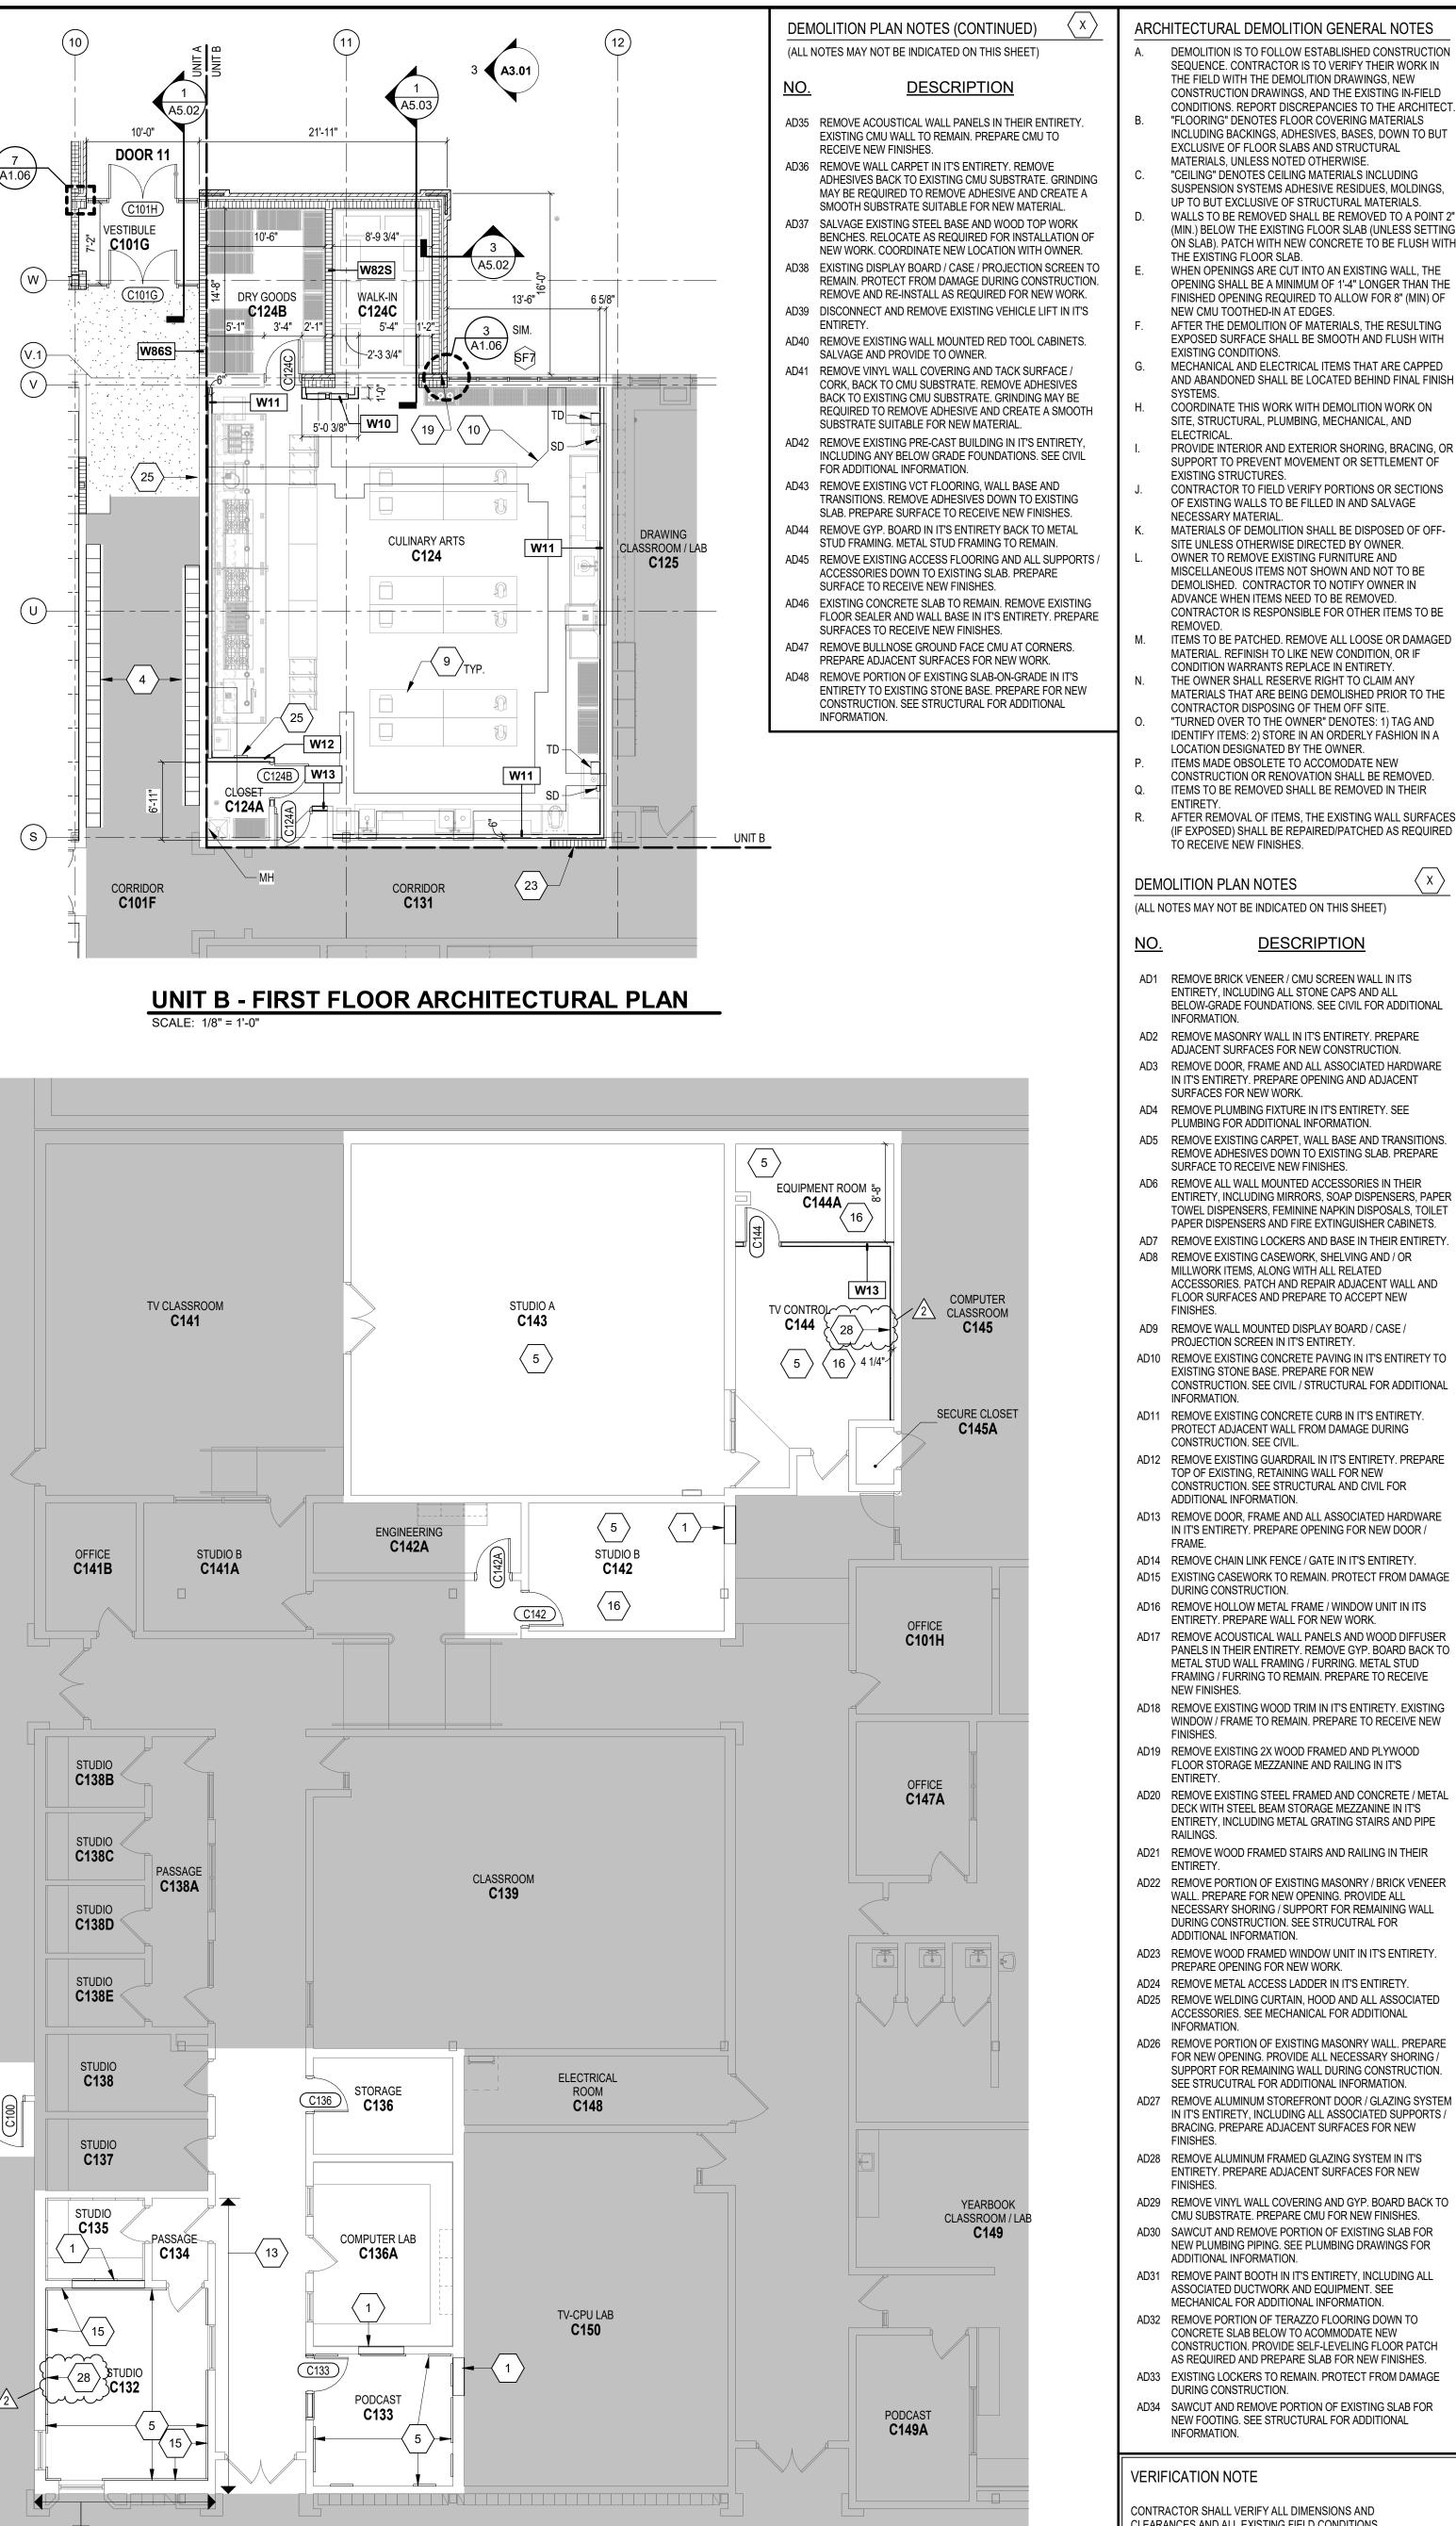

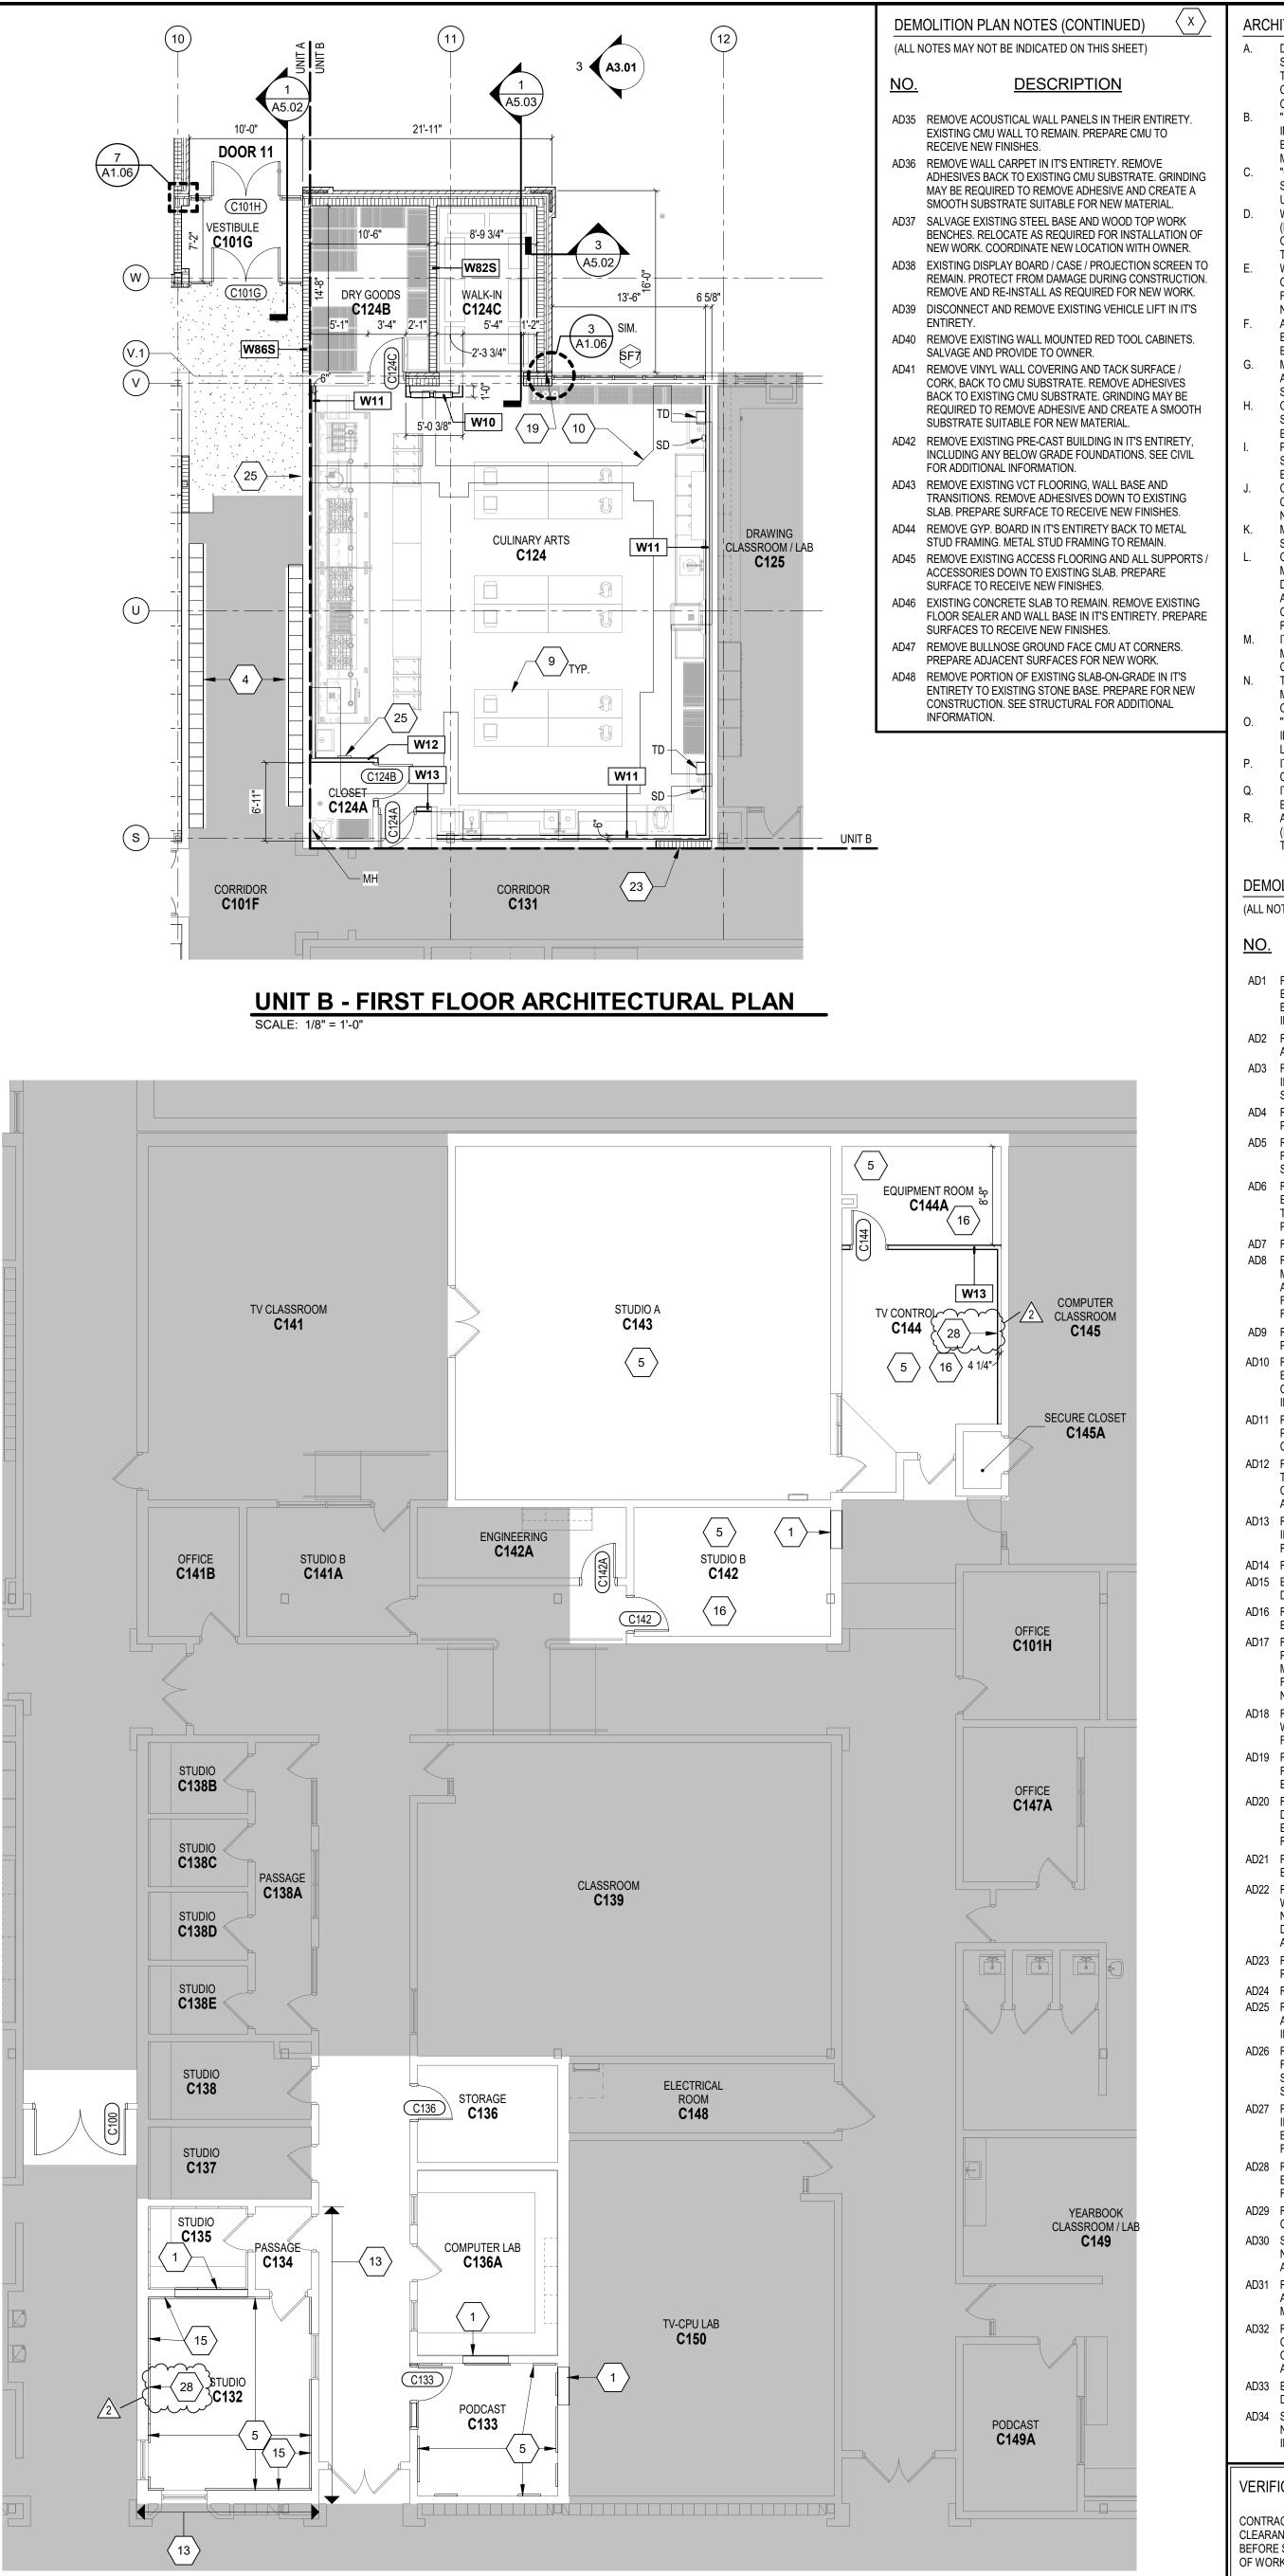

UNIT C - FIRST FLOOR ARCHITECTURAL PLAN SCALE: 1/8" = 1'-0"

	DEMOLITION IS TO FOLLOW ESTABLISHED CONSTRUCTION SEQUENCE. CONTRACTOR IS TO VERIFY THEIR WORK IN THE FIELD WITH THE DEMOLITION DRAWINGS, NEW CONSTRUCTION DRAWINGS, AND THE EXISTING IN-FIELD CONDITIONS. REPORT DISCREPANCIES TO THE ARCHITECT. "FLOORING" DENOTES FLOOR COVERING MATERIALS INCLUDING BACKINGS, ADHESIVES, BASES, DOWN TO BUT EXCLUSIVE OF FLOOR SLABS AND STRUCTURAL MATERIALS, UNLESS NOTED OTHERWISE. "CEILING" DENOTES CEILING MATERIALS INCLUDING SUSPENSION SYSTEMS ADHESIVE RESIDUES, MOLDINGS, UP TO BUT EXCLUSIVE OF STRUCTURAL MATERIALS. WALLS TO BE REMOVED SHALL BE REMOVED TO A POINT 2" (MIN.) BELOW THE EXISTING FLOOR SLAB (UNLESS SETTING ON SLAB). PATCH WITH NEW CONCRETE TO BE FLUSH WITH THE EXISTING FLOOR SLAB. WHEN OPENINGS ARE CUT INTO AN EXISTING WALL, THE OPENING SHALL BE A MINIMUM OF 1'-4" LONGER THAN THE FINISHED OPENING REQUIRED TO ALLOW FOR 8" (MIN) OF NEW CMU TOOTHED-IN AT EDGES. AFTER THE DEMOLITION OF MATERIALS, THE RESULTING EXPOSED SURFACE SHALL BE SMOOTH AND FLUSH WITH EXISTING CONDITIONS. MECHANICAL AND ELECTRICAL ITEMS THAT ARE CAPPED AND ABANDONED SHALL BE LOCATED BEHIND FINAL FINISH SYSTEMS. COORDINATE THIS WORK WITH DEMOLITION WORK ON SITE, STRUCTURAL, PLUMBING, MECHANICAL, AND ELECTRICAL. PROVIDE INTERIOR AND EXTERIOR SHORING, BRACING, OR SUPPORT TO PREVENT MOVEMENT OR SETTLEMENT OF EXISTING STRUCTURES. CONTRACTOR TO FIELD VERIFY PORTIONS OR SECTIONS OF EXISTING WALLS TO BE FILLED IN AND SALVAGE NECESSARY MATERIAL. MATERIALS OF DEMOLITION SHALL BE DISPOSED OF OFF- SITE UNLESS OTHERWISE DIRECTED BY OWNER. OWNER TO REMOVE EXISTING FLIEDINT URE AND	A. B. C. D. E. F. G. H. I. J. K.	ALL CMU WALLS THAT DO NOT LAY OUT IN FULL OR HALF LENGTHS SHOULD BE BALANCED SO AS NOT TO HAVE ANY PIECES LESS THAN 4" IN SIZE EXPOSED TO VIEW. WHERE DISSIMILAR FLOOR MATERIALS MEET, THEY SHALL DO SO UNDER THE CENTERLINE OF THE DOOR, UNLESS NOTED OTHERWISE. THERE SHALL BE PERIMETER INSULATION CONTINUOUS AROUND THE ENTIRE PERIMETER OF THE BUILDING EXTENDING 2'-0" MINIMUM BELOW GRADE. THE BASE FLOOR ELEVATION INDICATED FOR THE PROJECT IS 100'-0". REFER TO SITE PLAN FOR CORRELATION TO USGS DATUM. ALL INTERIOR MASONRY WALLS THAT RUN TO UNDERSIDE OF DECK ABOVE SHALL HAVE A 2" JOINT (U.N.O.) AT THE DECK TO BE FILLED WITH FIRE STOPPING AT RATED WALLS PER PROJECT MANUAL., AND MINERAL WOOL AT THE NON-RATED WALLS, TO ALLOW FOR DEFLECTION. FOR TYPICAL COMMON JOINT DETAILS AND CONSTRUCTION MOVEMENT JOINT DETAILS REFER TO DETAILS ON SHEET A1.06. ALL DIMENSIONS ON FLOOR PLANS ARE TO FINISH FACE OF CMU, CONCRETE, BRICK OR FINISH FACE OF GWB AT METAL STUD WALLS, UNLESS NOTED OTHERWISE. EXCEPTION: EXTERIOR METAL STUD WALLS ARE TO FACE OF METAL STUDS. HINGE SIDE DOOR JAMB AT WALLS WILL TYPICALLY BE LOCATED 4" MINIMUM FROM ADJACENT WALL UNLESS NOTED OTHERWISE. ALL EXPOSED CONCRETE MASONRY UNITS (CMU) CORNERS ARE TO BE BULLNOSE, EXCEPT AT BULKHEADS, WINDOW AND DOOR HEADS. SEE REFLECTED CEILING PLANS FOR BULKHEAD LOCATIONS AND DETAIL REFERENCES. REFER TO ROOM FINISH SCHEDULE OR PLAN AND EQUIPMENT PLANS FOR LOCATION AND EXTENT OF
	OWNER TO REMOVE EXISTING FURNITURE AND MISCELLANEOUS ITEMS NOT SHOWN AND NOT TO BE DEMOLISHED. CONTRACTOR TO NOTIFY OWNER IN ADVANCE WHEN ITEMS NEED TO BE REMOVED. CONTRACTOR IS RESPONSIBLE FOR OTHER ITEMS TO BE REMOVED. ITEMS TO BE PATCHED. REMOVE ALL LOOSE OR DAMAGED MATERIAL. REFINISH TO LIKE NEW CONDITION, OR IF CONDITION WARRANTS REPLACE IN ENTIRETY. THE OWNER SHALL RESERVE RIGHT TO CLAIM ANY MATERIALS THAT ARE BEING DEMOLISHED PRIOR TO THE CONTRACTOR DISPOSING OF THEM OFF SITE. "TURNED OVER TO THE OWNER" DENOTES: 1) TAG AND IDENTIFY ITEMS: 2) STORE IN AN ORDERLY FASHION IN A LOCATION DESIGNATED BY THE OWNER. ITEMS MADE OBSOLETE TO ACCOMODATE NEW CONSTRUCTION OR RENOVATION SHALL BE REMOVED. ITEMS TO BE REMOVED SHALL BE REMOVED IN THEIR ENTIRETY. AFTER REMOVAL OF ITEMS, THE EXISTING WALL SURFACES (IF EXPOSED) SHALL BE REPAIRED/PATCHED AS REQUIRED TO RECEIVE NEW FINISHES. DLITION PLAN NOTES.		FINISH FLOOR MATERIALS. PROVIDE WOOD BLOCKING AS REQUIRED. WITHIN METAL STUD WALLS FOR WALL MOUNTED ITEMS. REFER TO MASTER/CODE PLANS FOR CODE INFORMATION AND FIRE RATED WALL LOCATIONS. PROVIDE SPRAY FOAM INSULATION AND THERMAL BARRIER CONTINUOUS AT INTERSECTION OF EXTERIOR WALLS AND DECK. HITECTURAL PLAN NOTES OTES MAY NOT BE INDICATED ON THIS SHEET)
<u>10.</u> AD1	DESCRIPTION REMOVE BRICK VENEER / CMU SCREEN WALL IN ITS	ii	INDICATES WALL TYPE. REFER TO DRAWING A1.00 FOR WALL THICKNESS, HEIGHT AND COMPOSITION.
	ENTIRETY, INCLUDING ALL STONE CAPS AND ALL BELOW-GRADE FOUNDATIONS. SEE CIVIL FOR ADDITIONAL INFORMATION.	<u>NO.</u>	
AD2 AD3	REMOVE MASONRY WALL IN IT'S ENTIRETY. PREPARE ADJACENT SURFACES FOR NEW CONSTRUCTION. REMOVE DOOR, FRAME AND ALL ASSOCIATED HARDWARE IN IT'S ENTIRETY. PREPARE OPENING AND ADJACENT	1	INFILL OPENING TO MATCH EXISTING WALL CONSTRUCTION. FINISH FLUSH WITH ADJACENT SURFACES TO SHOW NO EVIDENCE OF CONSTRUCTION. TOOTH-IN MASONRY WITH EXISTING.
AD4	SURFACES FOR NEW WORK. REMOVE PLUMBING FIXTURE IN IT'S ENTIRETY. SEE PLUMBING FOR ADDITIONAL INFORMATION.	2	CONCRETE FILLED, METAL PAIN STAIRS. SEE A10.02 FOR ADDITIONAL INFORMATION. WIRE MESH PARTITION SYSTEM. INCORPORATE MORTISE
AD5	REMOVE EXISTING CARPET, WALL BASE AND TRANSITIONS. REMOVE ADHESIVES DOWN TO EXISTING SLAB. PREPARE SURFACE TO RECEIVE NEW FINISHES.	4	LOCK CYLINDER AND CORE IN GATE. SEE DOOR SCHEDULE AND SPECIFICAITONS. PRE-FINISHED STEEL LOCKERS. SEE EQUIPMENT PLANS
AD6 AD7	REMOVE ALL WALL MOUNTED ACCESSORIES IN THEIR ENTIRETY, INCLUDING MIRRORS, SOAP DISPENSERS, PAPER TOWEL DISPENSERS, FEMININE NAPKIN DISPOSALS, TOILET PAPER DISPENSERS AND FIRE EXTINGUISHER CABINETS. REMOVE EXISTING LOCKERS AND BASE IN THEIR ENTIRETY.	5	FOR ADDITIONAL INFORMATION. PROVIDE NEW ACOUSTICAL WALL TREATMENT. SEE FINISH PLANS, INTERIOR ELEVATIONS AND SPECIFICATIONS FOR ADDITIONAL INFORMATION. 24" WIDE, FIXED ALUMINUM ACCESS LADDER. SEE DETAIL
AD8	REMOVE EXISTING CASEWORK, SHELVING AND / OR MILLWORK ITEMS, ALONG WITH ALL RELATED ACCESSORIES. PATCH AND REPAIR ADJACENT WALL AND FLOOR SURFACES AND PREPARE TO ACCEPT NEW FINISHES.	7 8 9	8/A10.02. MEMBRANE ROOF SYSTEM. SEE ROOF PLAN FOR ADDITIONAL INFORMATION. METAL PIPE GUARDRAIL SYSTEM. SEE A10.02. KITCHEN EQUIPMENT. SEE FOOD SERVICE DRAWINGS FOR
AD9 AD10	REMOVE WALL MOUNTED DISPLAY BOARD / CASE / PROJECTION SCREEN IN IT'S ENTIRETY. REMOVE EXISTING CONCRETE PAVING IN IT'S ENTIRETY TO EXISTING STONE BASE. PREPARE FOR NEW CONSTRUCTION. SEE CIVIL / STRUCTURAL FOR ADDITIONAL INFORMATION.	10 11 12	ADDITIONAL INFORMATION. INFILL PORTION OF CONCRETE SLAB. FINISH FLUSH WITH EXISTING. SEE PLUMBING FOR ADDITIONAL INFORMATION. INDICATES 12' x 12' AREA FOR STUDENT-BUILT HOUSE BUILD (FOR REFERENCE ONLY) INDICATES 12' x 32' AREA FOR STUDENT-BUILT TINY HOMES.
	REMOVE EXISTING CONCRETE CURB IN IT'S ENTIRETY. PROTECT ADJACENT WALL FROM DAMAGE DURING CONSTRUCTION. SEE CIVIL. REMOVE EXISTING GUARDRAIL IN IT'S ENTIRETY. PREPARE TOP OF EXISTING, RETAINING WALL FOR NEW	13	(FOR REFERENCE ONLY) ACOUSTICALLY SEAL ALL WALL PENETRATIONS ABOVE CEILING, BOTH SIDES OF WALL. INFILL MASONRY OPENINGS WITH CMU SOAP / MORTAR AS REQUIRED. EXISTING STEEL BASE AND WOOD TOP WORKBENCHES.
D13	CONSTRUCTION. SEE STRUCTURAL AND CIVIL FOR ADDITIONAL INFORMATION. REMOVE DOOR, FRAME AND ALL ASSOCIATED HARDWARE IN IT'S ENTIRETY. PREPARE OPENING FOR NEW DOOR /	14	COORDINATE FINAL LOCATION WITH OWNER UPON COMPLETION OF OTHER FINISHES. 2-LAYERS OF 5/8" TYPE "X" GYP. BOARD OVER EXISTING
	FRAME. REMOVE CHAIN LINK FENCE / GATE IN IT'S ENTIRETY. EXISTING CASEWORK TO REMAIN. PROTECT FROM DAMAGE	16	METAL FURRING. EXTEND GYP. BOARD AND SEAL TOP EDGE TO CONCRETE DECK ABOVE. PROVIDE WOOD FLOOR FRAMING TO MATCH EXISTING DEPTH AND REPLACE TILE ACCESS FLOOR. SEE DETAIL
AD16 AD17	DURING CONSTRUCTION. REMOVE HOLLOW METAL FRAME / WINDOW UNIT IN ITS ENTIRETY. PREPARE WALL FOR NEW WORK. REMOVE ACOUSTICAL WALL PANELS AND WOOD DIFFUSER PANELS IN THEIR ENTIRETY. REMOVE GYP. BOARD BACK TO METAL STUD WALL FRAMING / FURRING. METAL STUD	17 18	2/A1.07. INFILL PORTION OF CONCRETE SLAB. FINISH FLUSH WITH EXISTING. SEE STRUCTURAL FOR ADDITIONAL INFORMATION. CONCRETE FILLED STEEL PIPE BOLLARD WITH COVER. SEE
D18	FRAMING / FURRING TO REMAIN. PREPARE TO RECEIVE NEW FINISHES. REMOVE EXISTING WOOD TRIM IN IT'S ENTIRETY. EXISTING	19 20	DETAIL 7/A1.07 FOR ADDITIONAL INFORMATION. 1 1/2" PRE-COMPRESSED BUILDING EXPANSION JOINT WITH CONTINUOUS SEALANT. PLASTIC LAMINATE CASEWORK. SEE EQUIPMENT PLANS
D19	WINDOW / FRAME TO REMAIN. PREPARE TO RECEIVE NEW FINISHES. REMOVE EXISTING 2X WOOD FRAMED AND PLYWOOD FLOOR STORAGE MEZZANINE AND RAILING IN IT'S	21 22	FOR ADDITIONAL INFORMATION. 13'W x 12'H MASONRY OPENING. SEE STRUCTURAL. GUARDRAIL GATE - SEE 5-7/A10.01.
AD20	ENTIRETY. REMOVE EXISTING STEEL FRAMED AND CONCRETE / METAL DECK WITH STEEL BEAM STORAGE MEZZANINE IN IT'S ENTIRETY, INCLUDING METAL GRATING STAIRS AND PIPE	23	INFILL OPENING TO MATCH EXISTING WALL CONSTRUCTION. GROUND FACE CMU (PROVIDED BY OWNER) TO MATCH EXISTING, FULL HEIGHT. FINISH FLUSH WITH ADJACENT SURFACES TO SHOW NO EVIDENCE OF CONSTRUCTION. TOOTH-IN MASONRY WITH EXISTING.
D21	RAILINGS. REMOVE WOOD FRAMED STAIRS AND RAILING IN THEIR ENTIRETY. REMOVE PORTION OF EXISTING MASONRY / BRICK VENEER	24	PAINT BOOTH EXHAUST, UP THROUGH ROOF. SEE EQUIPMENT PLANS AND SCHEDULE FOR ADDITIONAL INFORMATION. COORDINATE FINAL LOCATION, DIMENSIONS
	WALL. PREPARE FOR NEW OPENING. PROVIDE ALL NECESSARY SHORING / SUPPORT FOR REMAINING WALL DURING CONSTRUCTION. SEE STRUCUTRAL FOR ADDITIONAL INFORMATION.	25	AND OPENINGS BETWEEN ALL TRADES AND EQUIPMENT MANUFACTURER. SEMI-RECESSED FIRE EXTINGUISHER CABINET. SEE 3/A1.07 AND SPECIFICATIONS FOR ADDITIONAL INFORMATION.
AD23	PREPARE OPENING FOR NEW WORK.	26 27	SALVAGE EXISTING BRICK VENEER FROM DEMOLITION AND RE-USE TO WRAP BRICK BACK TO CMU AT JAMBS. RATED ACCESS PANEL FOR DUST COLLECTION CLEANOUT.
	REMOVE WELDING CURTAIN, HOOD AND ALL ASSOCIATED ACCESSORIES. SEE MECHANICAL FOR ADDITIONAL INFORMATION. REMOVE PORTION OF EXISTING MASONRY WALL. PREPARE	28	COORDINATE EXACT REQUIREMENTS WITH DUST COLLECTION SYSTEM MANUFACTURER. SEE MECHANICAL EOR ADDITIONAL-NEORMATION- PROVIDE IN-WALL BLOCKING AS REQUIRED FOR MONITOR. COORDINATE EXACT LOCATION WITH EQUIPMENT SUPPLIER
D27	IN IT'S ENTIRETY, INCLUDING ALL ASSOCIATED SUPPORTS /	L.	SEE AV DRAWINGS FOR ADDITIONAL INFORMATION.
D28	BRACING. PREPARE ADJACENT SURFACES FOR NEW FINISHES. REMOVE ALUMINUM FRAMED GLAZING SYSTEM IN IT'S ENTIRETY. PREPARE ADJACENT SURFACES FOR NEW FINISHES.		
D29	REMOVE VINYL WALL COVERING AND GYP. BOARD BACK TO CMU SUBSTRATE. PREPARE CMU FOR NEW FINISHES. SAWCUT AND REMOVE PORTION OF EXISTING SLAB FOR		
D30	NEW PLUMBING PIPING. SEE PLUMBING DRAWINGS FOR ADDITIONAL INFORMATION. REMOVE PAINT BOOTH IN IT'S ENTIRETY, INCLUDING ALL		
ND32	ASSOCIATED DUCTWORK AND EQUIPMENT. SEE MECHANICAL FOR ADDITIONAL INFORMATION. REMOVE PORTION OF TERAZZO FLOORING DOWN TO CONCRETE SLAB BELOW TO ACOMMODATE NEW CONSTRUCTION. PROVIDE SELF-LEVELING FLOOR PATCH		
D33	AS REQUIRED AND PREPARE SLAB FOR NEW FINISHES. EXISTING LOCKERS TO REMAIN. PROTECT FROM DAMAGE DURING CONSTRUCTION.		
AD34	SAWCUT AND REMOVE PORTION OF EXISTING SLAB FOR NEW FOOTING. SEE STRUCTURAL FOR ADDITIONAL INFORMATION.		
ERIF	ICATION NOTE	VERIF	FICATION NOTE
EARA	ACTOR SHALL VERIFY ALL DIMENSIONS AND ANCES AND ALL EXISTING FIELD CONDITIONS E STARTING CONSTRUCTION. COMMENCEMENT	CLEAR BEFOR	ACTOR SHALL VERIFY ALL DIMENSIONS AND ANCES AND ALL EXISTING FIELD CONDITIONS E STARTING CONSTRUCTION. COMMENCEMENT
	RK CONSTITUTES ACCEPTANCE OF CONDITIONS.		RK CONSTITUTES ACCEPTANCE OF CONDITIONS. D DIFFERENT CONDITIONS BE ENCOUNTERED,


ARCHITECTURAL PLAN GENERAL NOTES


COMMENCEMENT CE OF CONDITIONS. SHOULD DIFFERENT CONDITIONS BE ENCOUNTERED, CONTACT THE ARCHITECT BEFORE PROCEEDING WITH WORK.

SHOULD DIFFERENT CONDITIONS BE ENCOUNTERED, CONTACT THE ARCHITECT BEFORE PROCEEDING WITH


WORK.




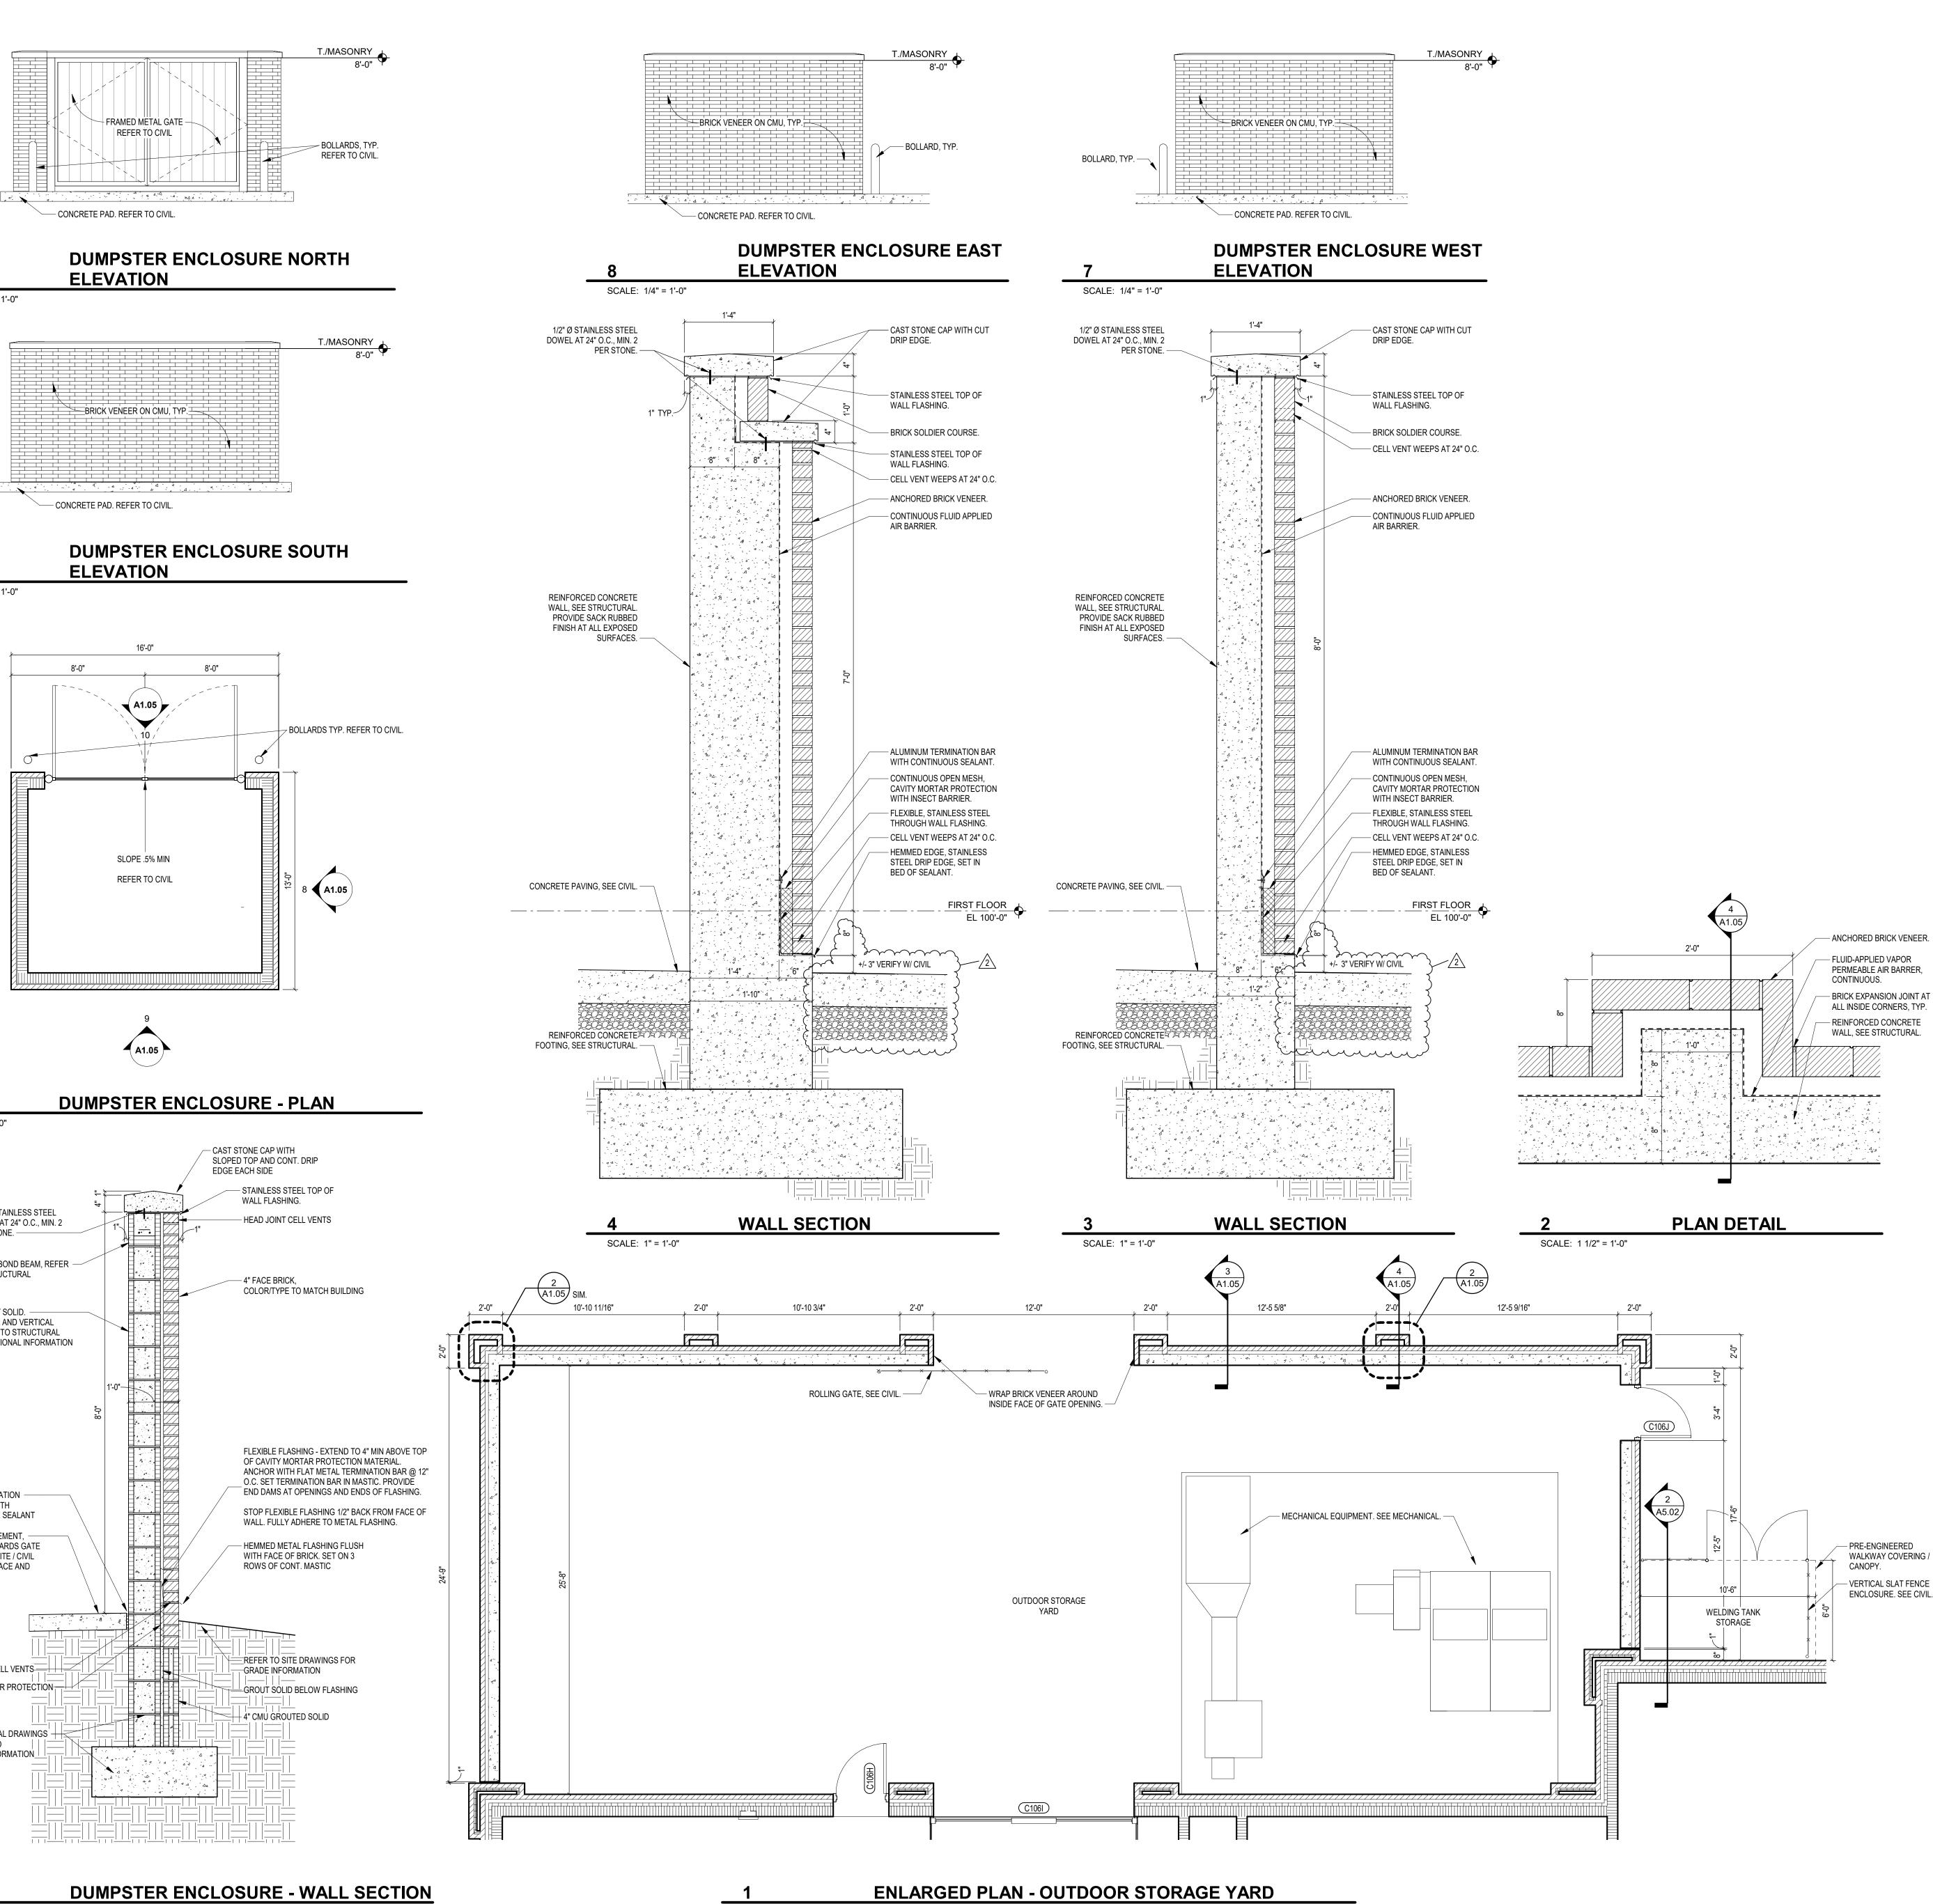

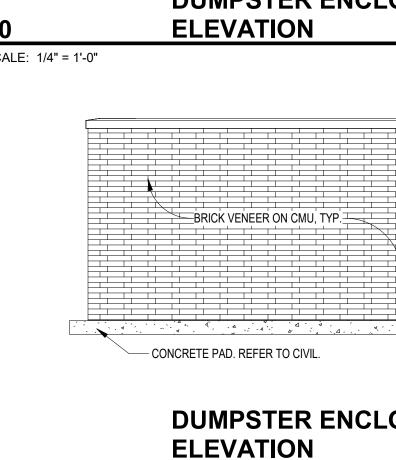


SCALE: 3/4" = 1'-0"

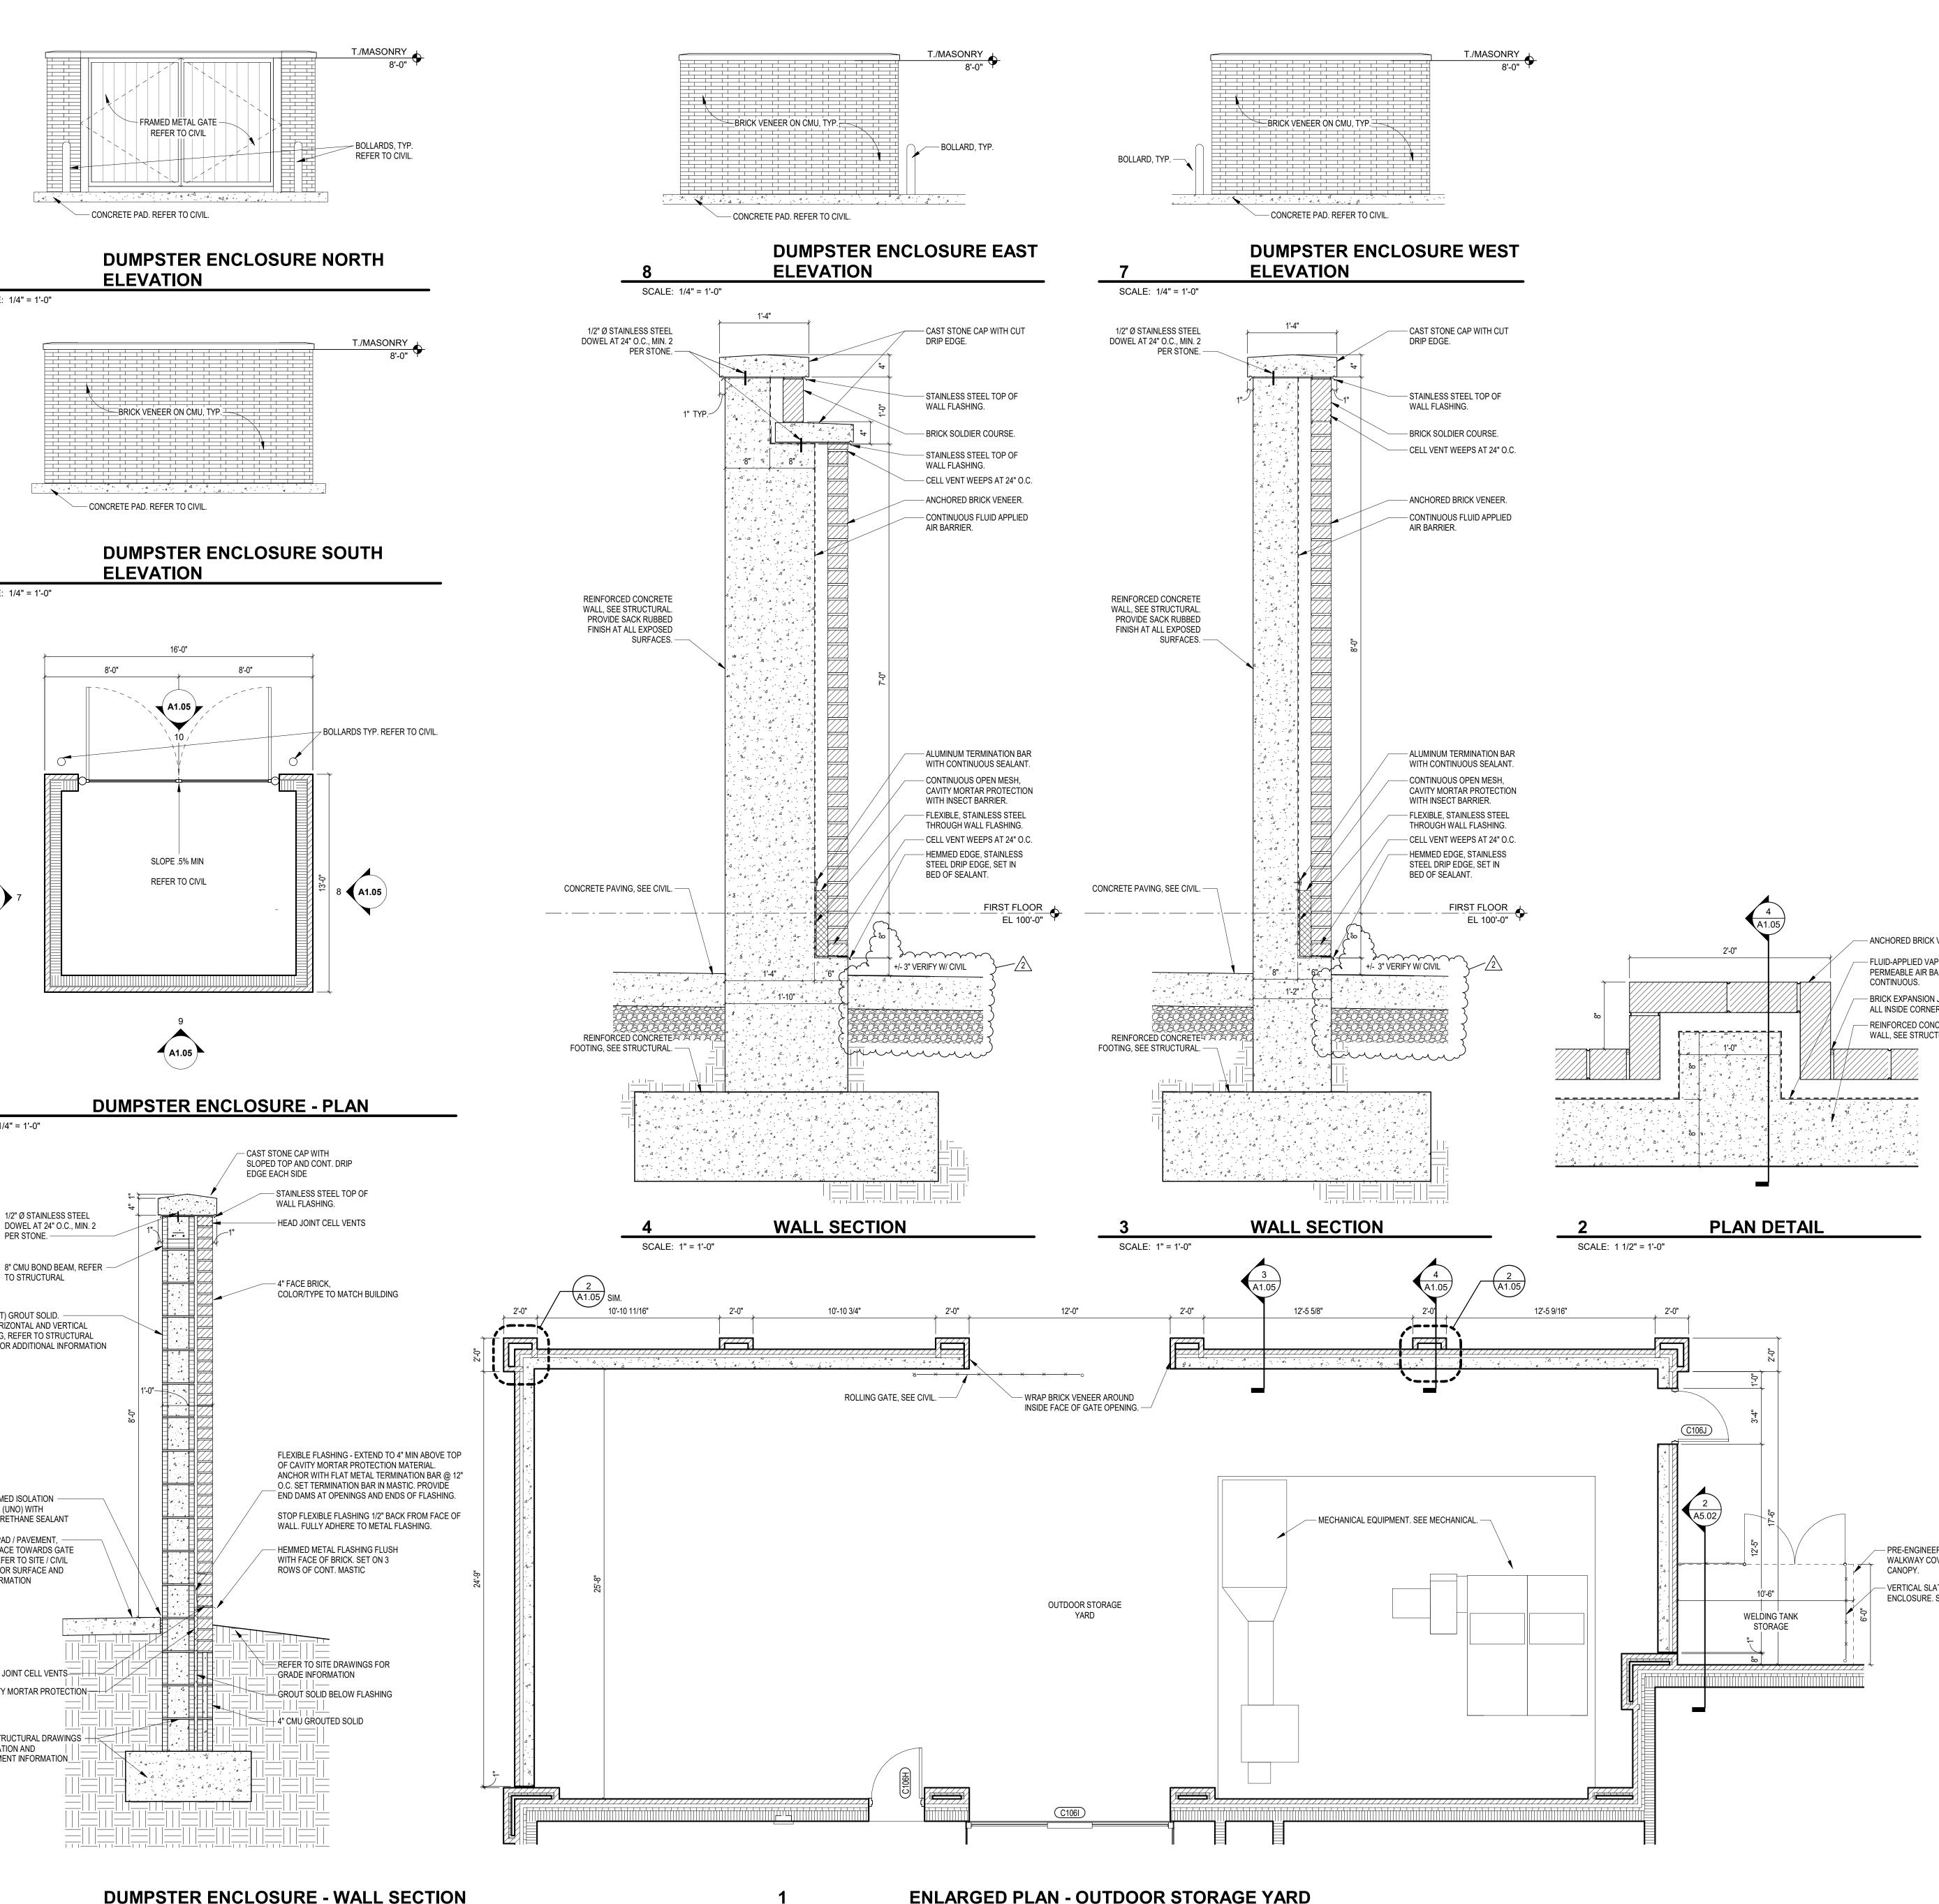

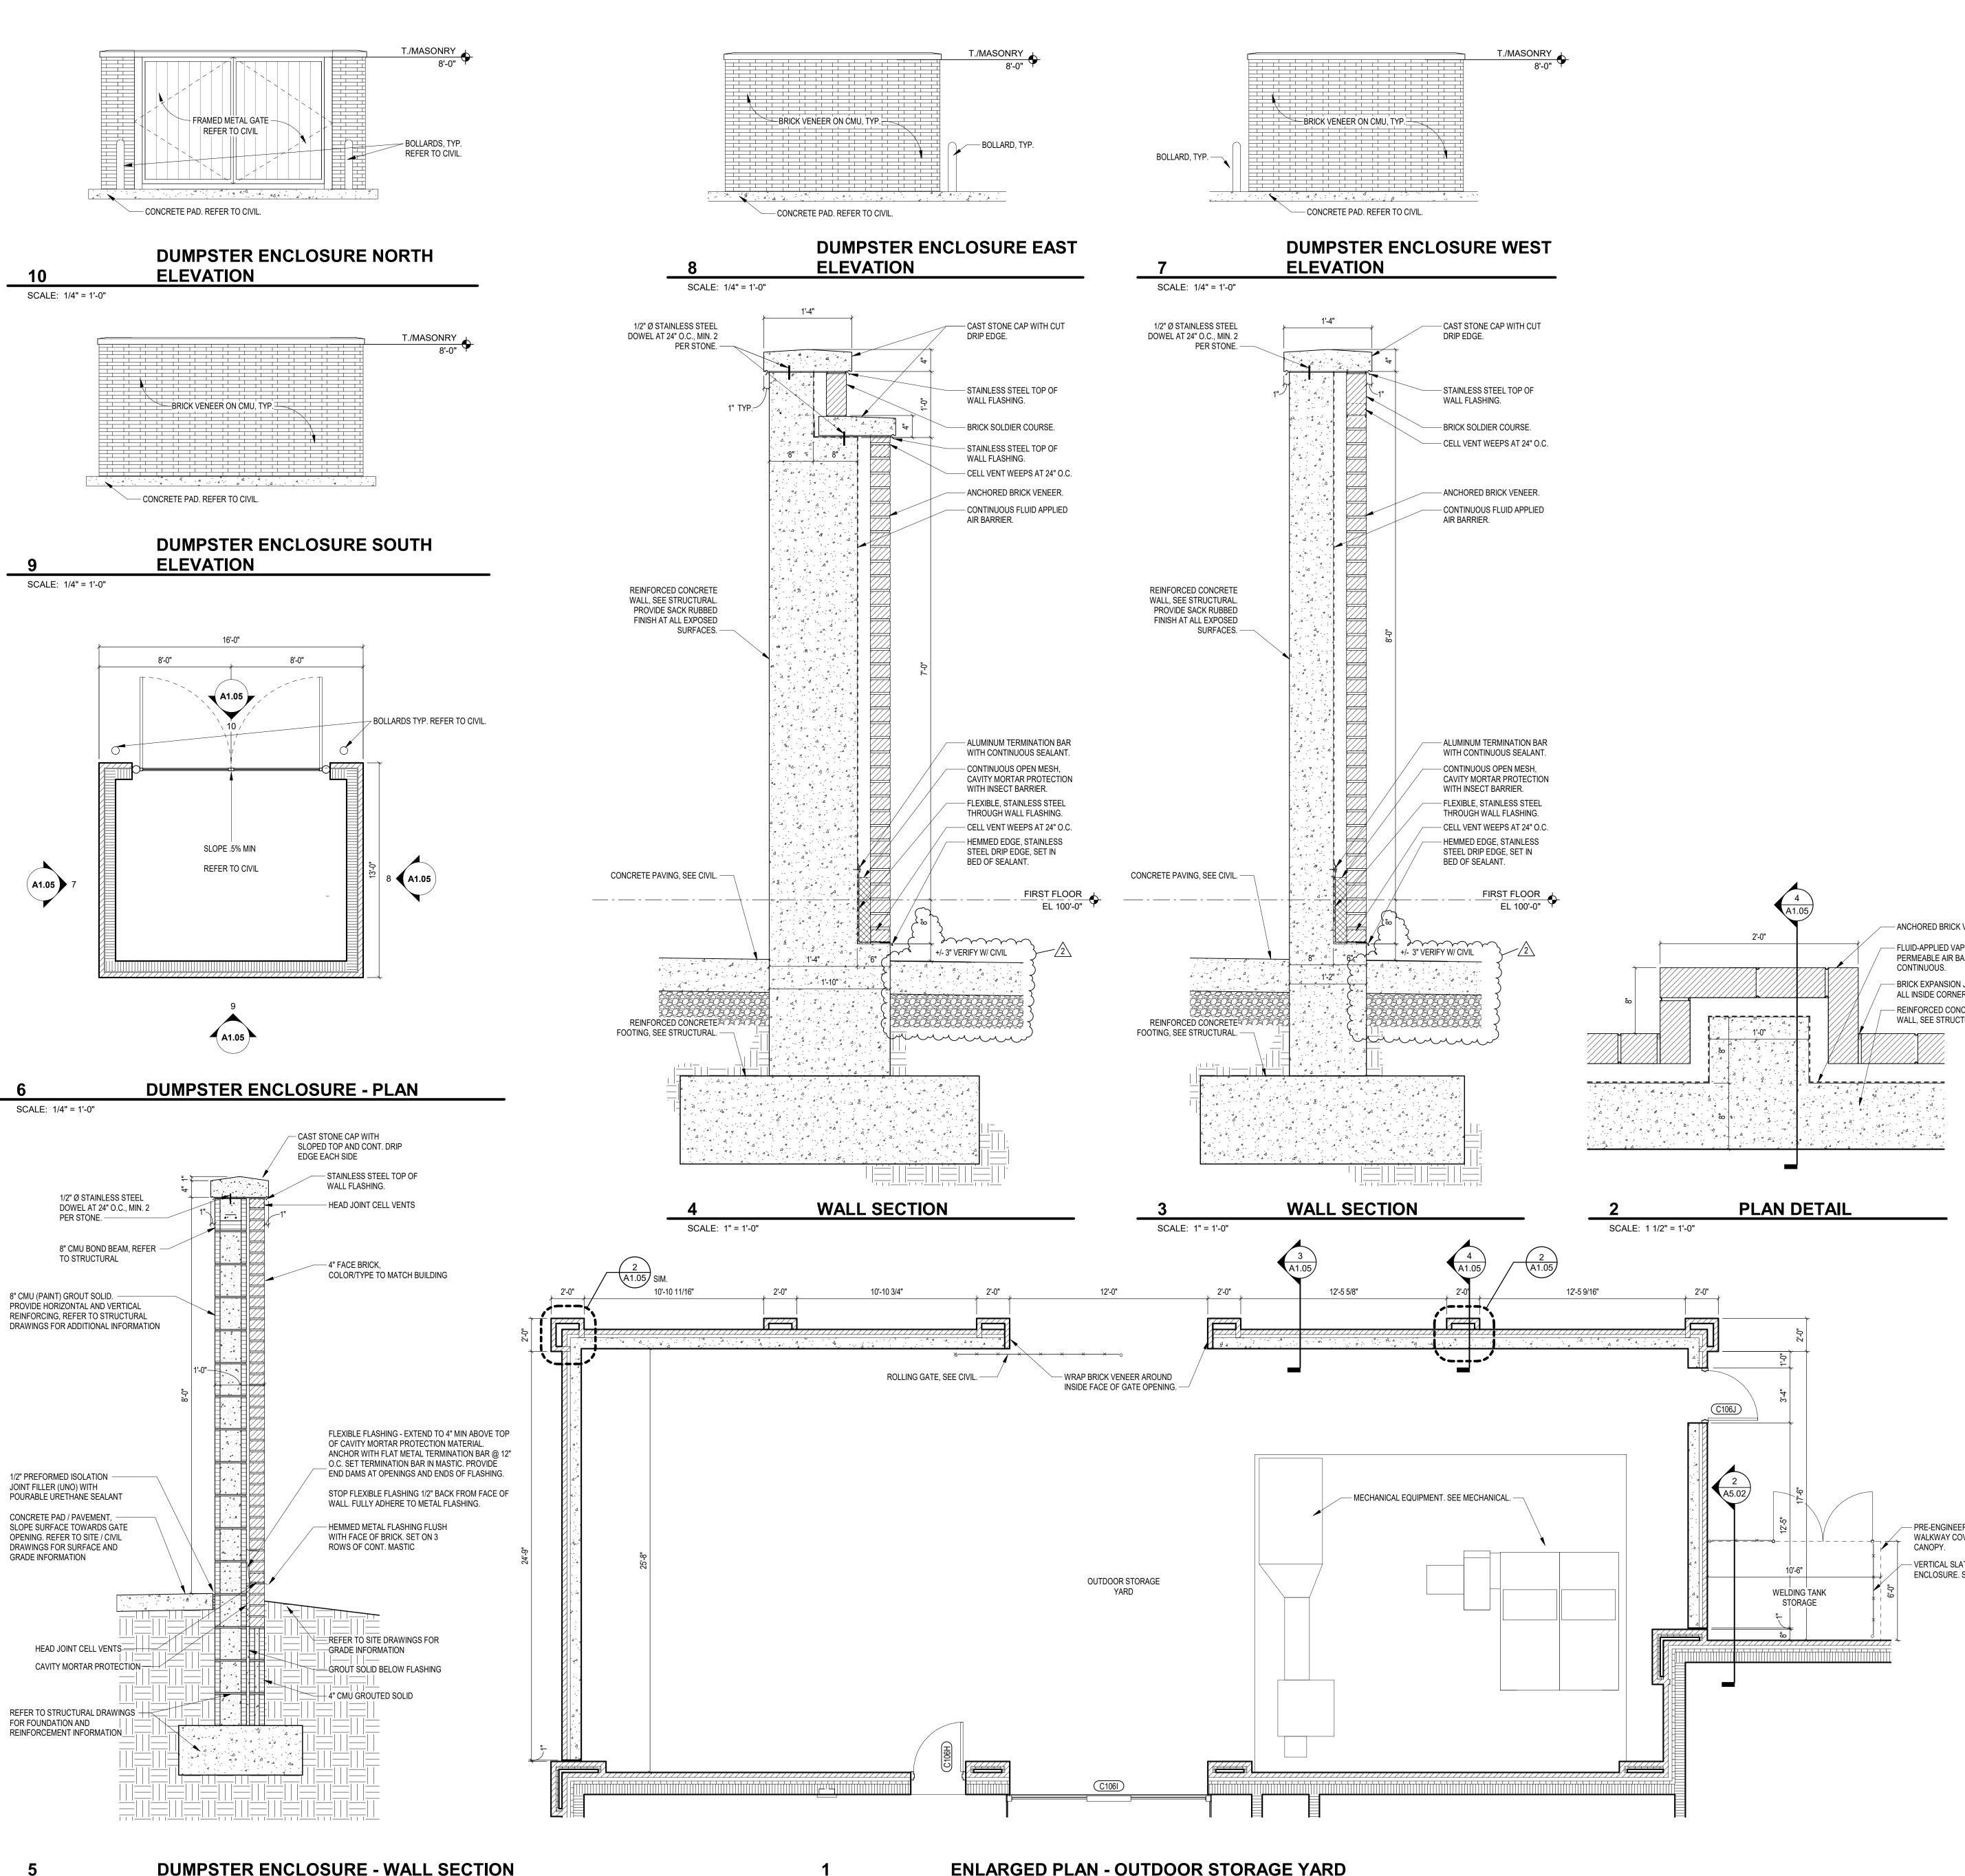

SCALE: 1/4" = 1'-0"



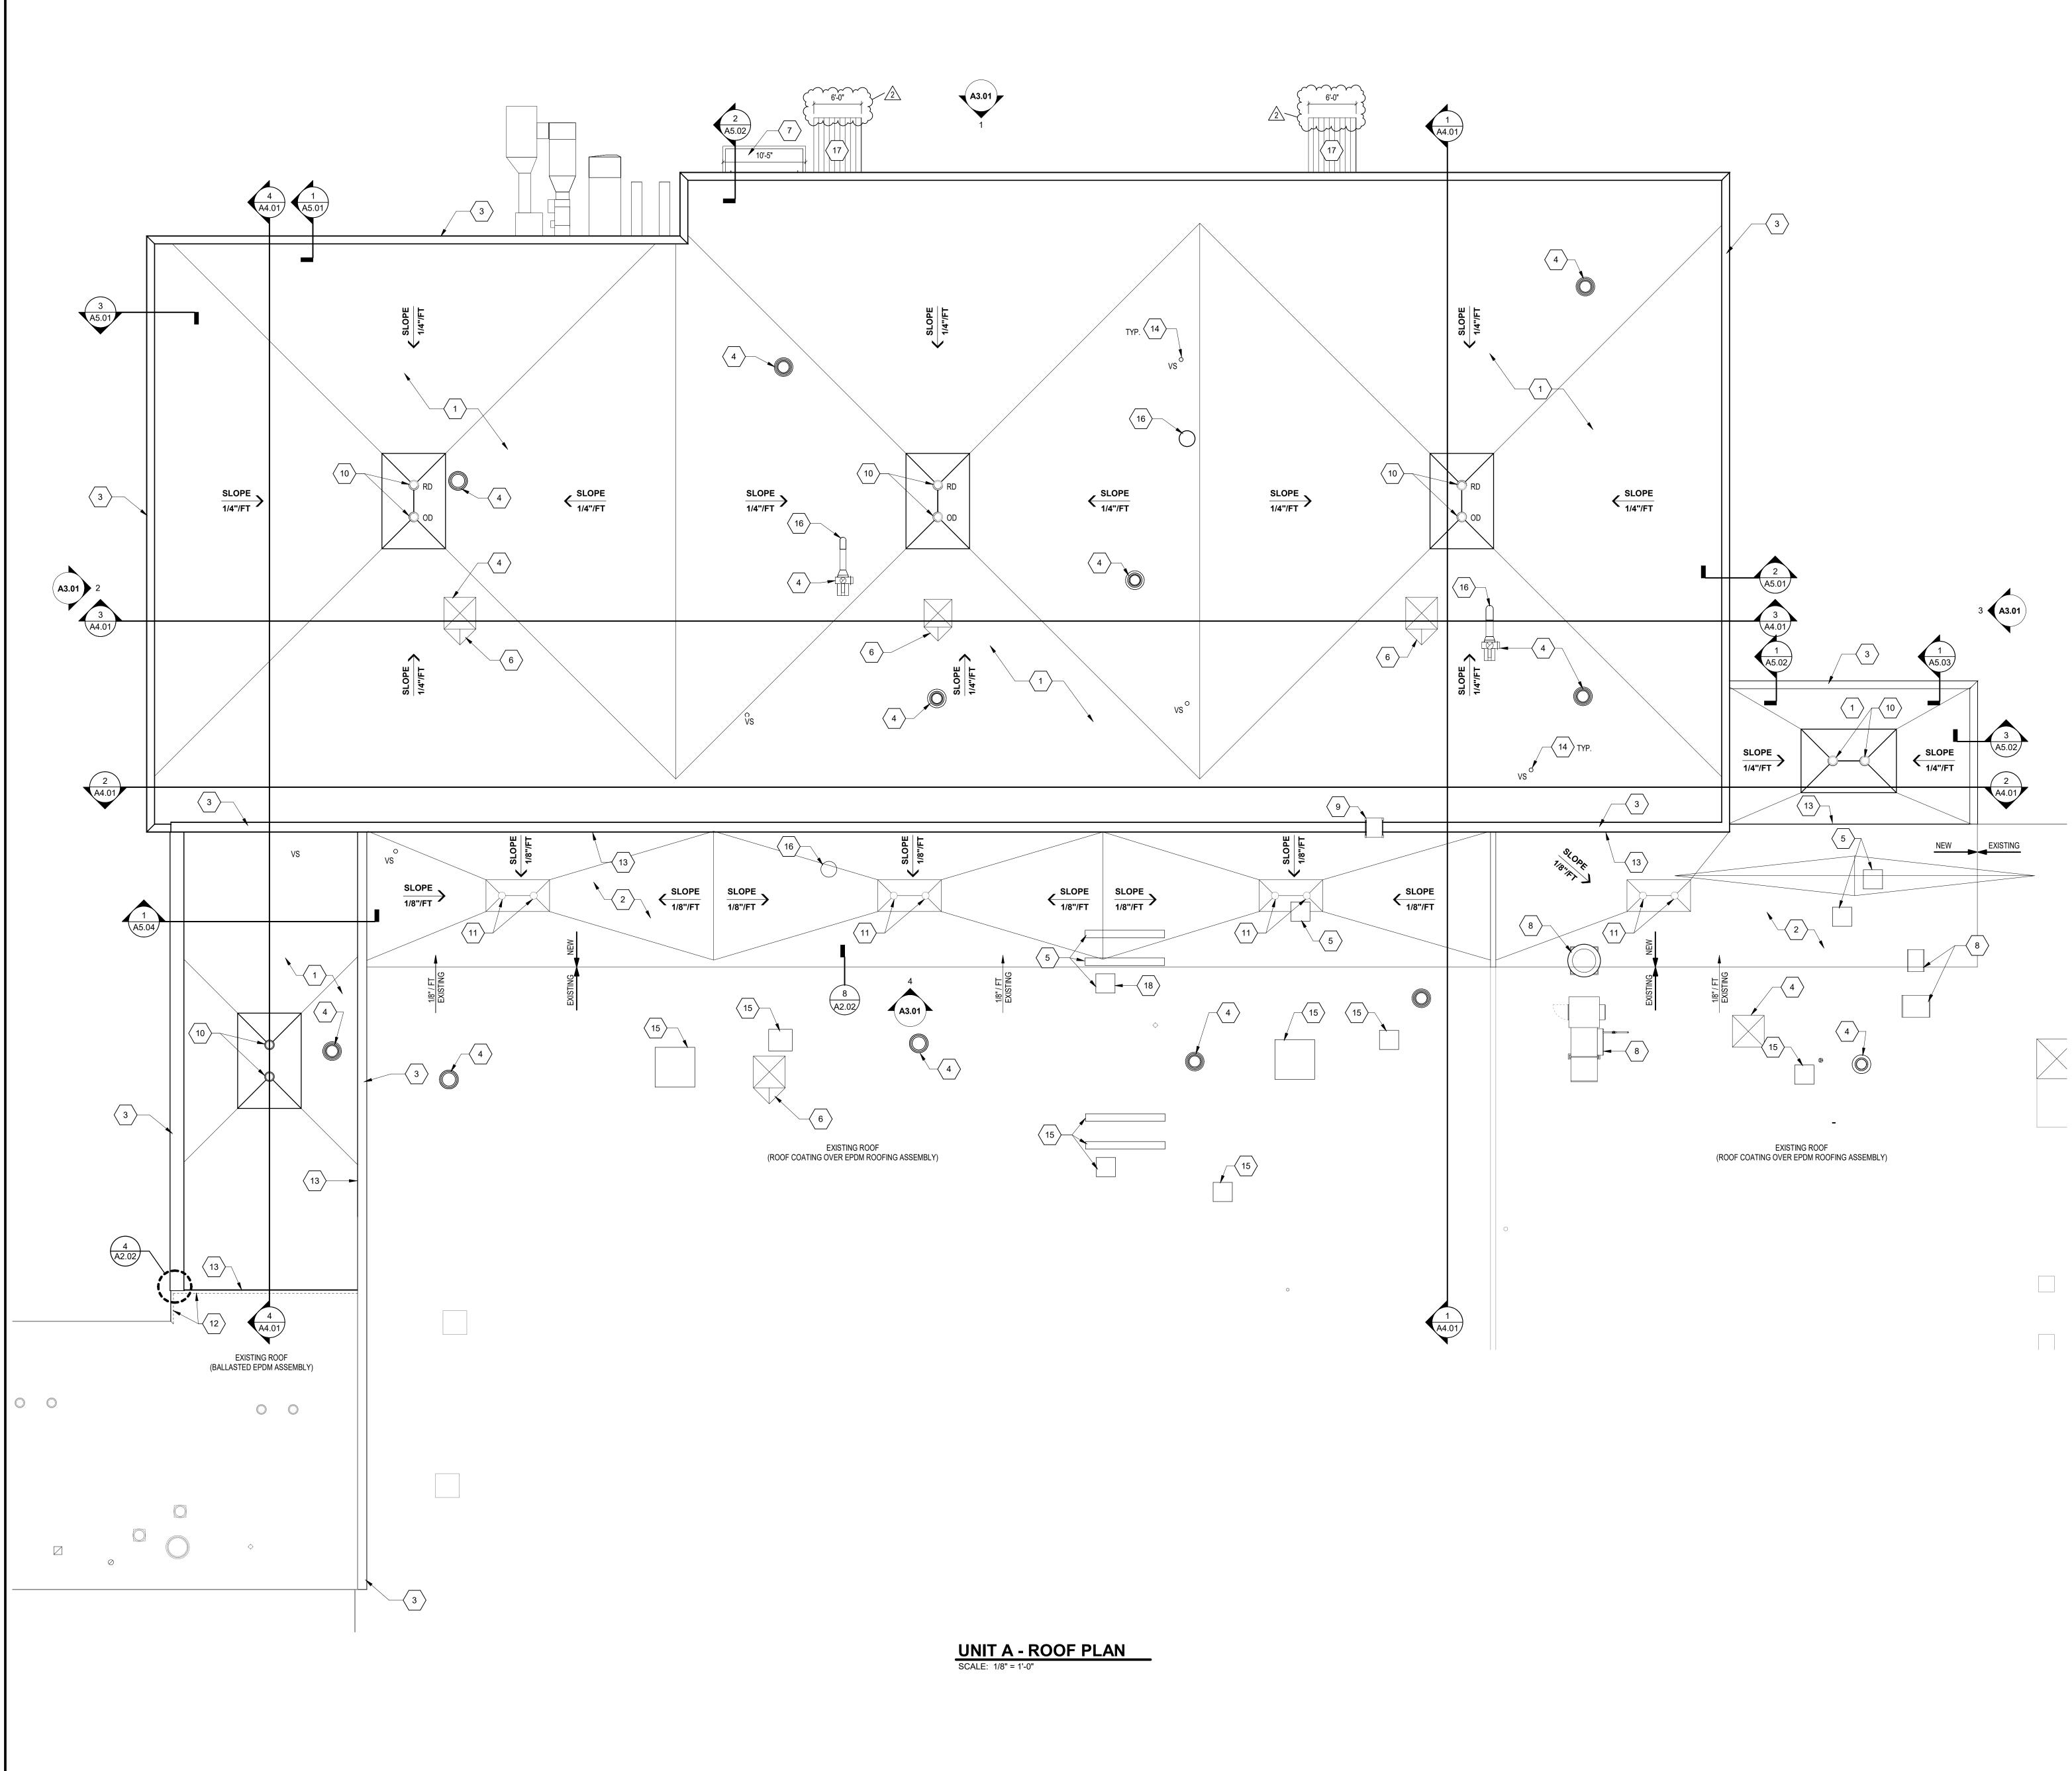


ROOF	PLAN	GENERAL	NOTES		
A.	ALL FINA RESPON	AILS SHOWN AL FLASHING ISIBILITY OF 1	CONDITIONS	S SHALL BE ISTALLER, A	THE AND SHAL
В.	ALL DET	PROVAL OF AIL MODIFICA GS APPROVA	TIONS MUS	T HAVE SHO)P
	AND VEF	RIFY ALL EXIS NCES, AND D RUCTION. COI	TING FIELD	CONDITION BEFORE ST	s, Arting
	CONSTI SHOULD	UTES ACCER	PTANCE OF	EXISTING CO S BE ENCOU	ONDITION INTERED,
C.	FURTHE	ST ARCHITEC R WORK. GS IN ROOF V	VILL BE CUT	BY ROOF	
	COORDI	CTOR. MECH NATE LOCAT ONTRACTOR	ION OF OPE	NING IN ROO	OF WITH
D.	CONTRA	NCAL CONTR CTOR. E FLASHING A			
E.	PROVIDI SADDLE	ED UNDER MI S AND TAPEF	ECHANICAL. RED INSULAT	TION SYMBC	OLS
	CONTRA FOR TAP	E DESIGN INT CTOR SHALL PERED INSUL	PROVIDE S	UBMITTAL C	RAWIING
F.	THE ROO	E SLOPE. DF CONTRAC SCUPPERS,			
	THE ROO	D DURING DE OF CONTRAC INS, SCUPPE	TOR SHALL	INSPECT AN	ND CLEAR
		TION OF WO			
	FNUFER	LT.			
ROOF	PLAN	NOTES			
*	INFORM	NICAL, ELECT ATION SHOW	'N ON THIS F	PLAN IS	
	DRAWIN	AL IN NATURE IGS FOR FUR ORDINATE AL	THER INFOR	RMATION	
	OPENIN	GS OR ROOF			
<u>NO.</u>		<u>D</u>	ESCRIP	TION	
1	BOARD (NE ROOFING OVER FLAT AN OVER VAPOR	ND TAPERÈD	ROOF INSU	LATION (1
2	MEMBRA BOARD (NE ROOFING	SYSTEM (AI ND TAPERED	DHERED) ON ROOF INSU	I 1/4" COV LATION T
3	PRE-FIN	EXISTING ROO SHED METAL	COPING SYS	STEM.	
4 5	AND 5/A2	IICAL EQUIPM 2.02. XISTING ROC			-
6	FOR ME	TAL DECK PAT TAPERED S/	TCHING DET	AILS / REQUI ECHANICAL	IREMENTS EQUIPME
7 8	WITH IN	GINEERED ME FEGRAL DOW	NSPOUTS.		
9	PROVIDE 24" WIDE	E INSULATED	CURB SYSTE	EM. SS LADDER V	NITH
10	503.	RM OVER PAF			
11	PLUMBIN RE-INST	IG DRAWINGS ALL EXISTING	FOR ADDIT	IONAL INFOR	RMATION. K-NASTAL
(COMPLE	HA2.01 FLUSH TION OF WOF SHED METAL	RK.		
12	AND COL	OR OF EXIST G, BALLASTED	ING BUILDIN	IG. FLASH IN	WITH
13	AND DET	EXPANSION AILS. ACK. SEE PLU			
14 15	PROVIDE	INSULATED, JRB. RE-FLAS	STAINLESS	STEEL CAP	OVER EXI
16	METAL C	FAS REQUIRE	SEE 7/A2.02		
17	COVERA	IG SEAM MET GE SELF-ADH STRATE BOAF	IERED SHEE	T UNDERLA	YMENT O
18	-	XISTING ROC		-	
	ROOF TH	IICKNESS / SL G AND RE-CO	OPE. ADHER	RE NEW MEN	/IBRANE T
ROOF	- PLAN	SYMBOL I	EGEND		
12'-0"					
(UNO)	(ONL	INDICATES F OVERFLOW (FLASH IN AC	DRAIN (OD). CCORDANCE	E WITH ROO	F
~~~~	<u></u>	MEMBRANE RECOMMEN	MANUFACTI	JRER'S	
⊖ V5	6				)
U VC		PLUMBING D	KAWINGS A	เทม 6/A2.02.	
() FL		INDICATES F MECHANICA			??


 $\frac{\text{SLOPE}}{?/12}$ INDICATES ROOF SLOPE INDICATES ROOF SADDLE - REFER TO PROJECT MANUAL.  $\triangleleft$ INDICATES EXPANSION JOINT - REFER TO ROOF PLAN AND WALL SECTIONS. - - - - - -INDICATES WALL LINE BELOW - REFER TO ARCHITECTURAL FLOOR PLANS INDICATES METAL DOWNSPOUT. REFER TO ROOF PLAN AND BUILDING ELEVATIONS FOR LOCATIONS DS INDICATES WALKWAY PADS -REFER TO PROJECT MANUAL INDICATES ICE AND WATER SHIELD MEMBRANE FLASHING -REFER TO PROJECT MANUAL

VERIFICATION NOTE


 $\bigcirc$ 


CONTRACTOR SHALL VERIFY ALL DIMENSIONS AND CLEARANCES AND ALL EXISTING FIELD CONDITIONS BEFORE STARTING CONSTRUCTION. COMMENCEMENT OF WORK CONSTITUTES ACCEPTANCE OF CONDITIONS. SHOULD DIFFERENT CONDITIONS BE ENCOUNTERED, CONTACT THE ARCHITECT BEFORE PROCEEDING WITH WORK.

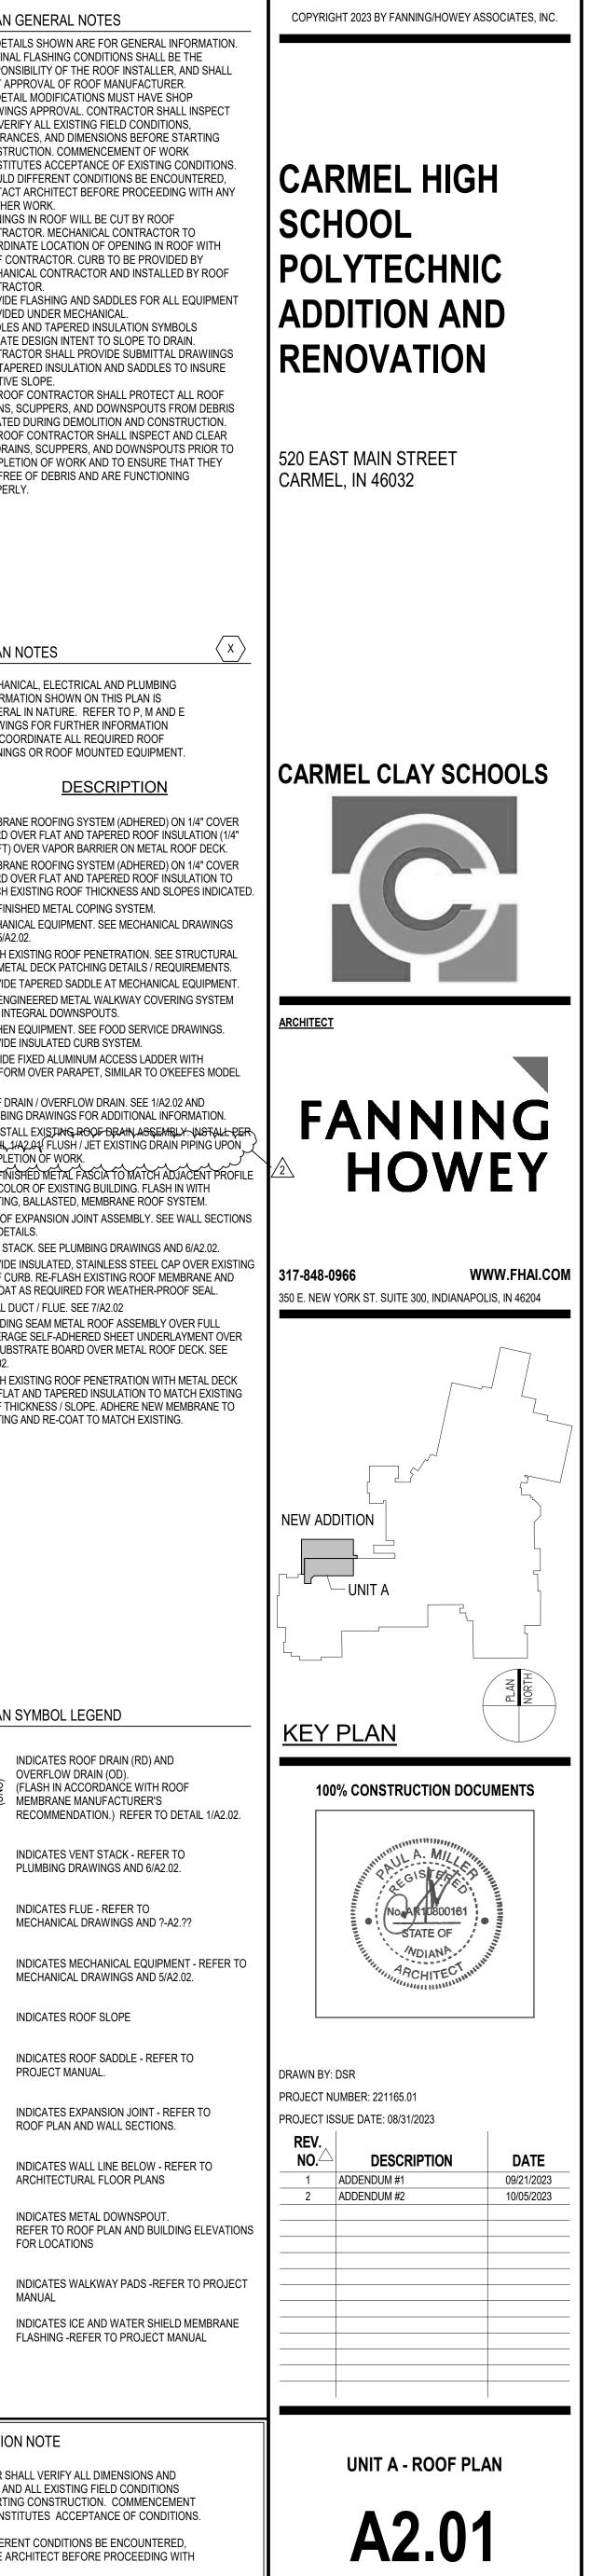


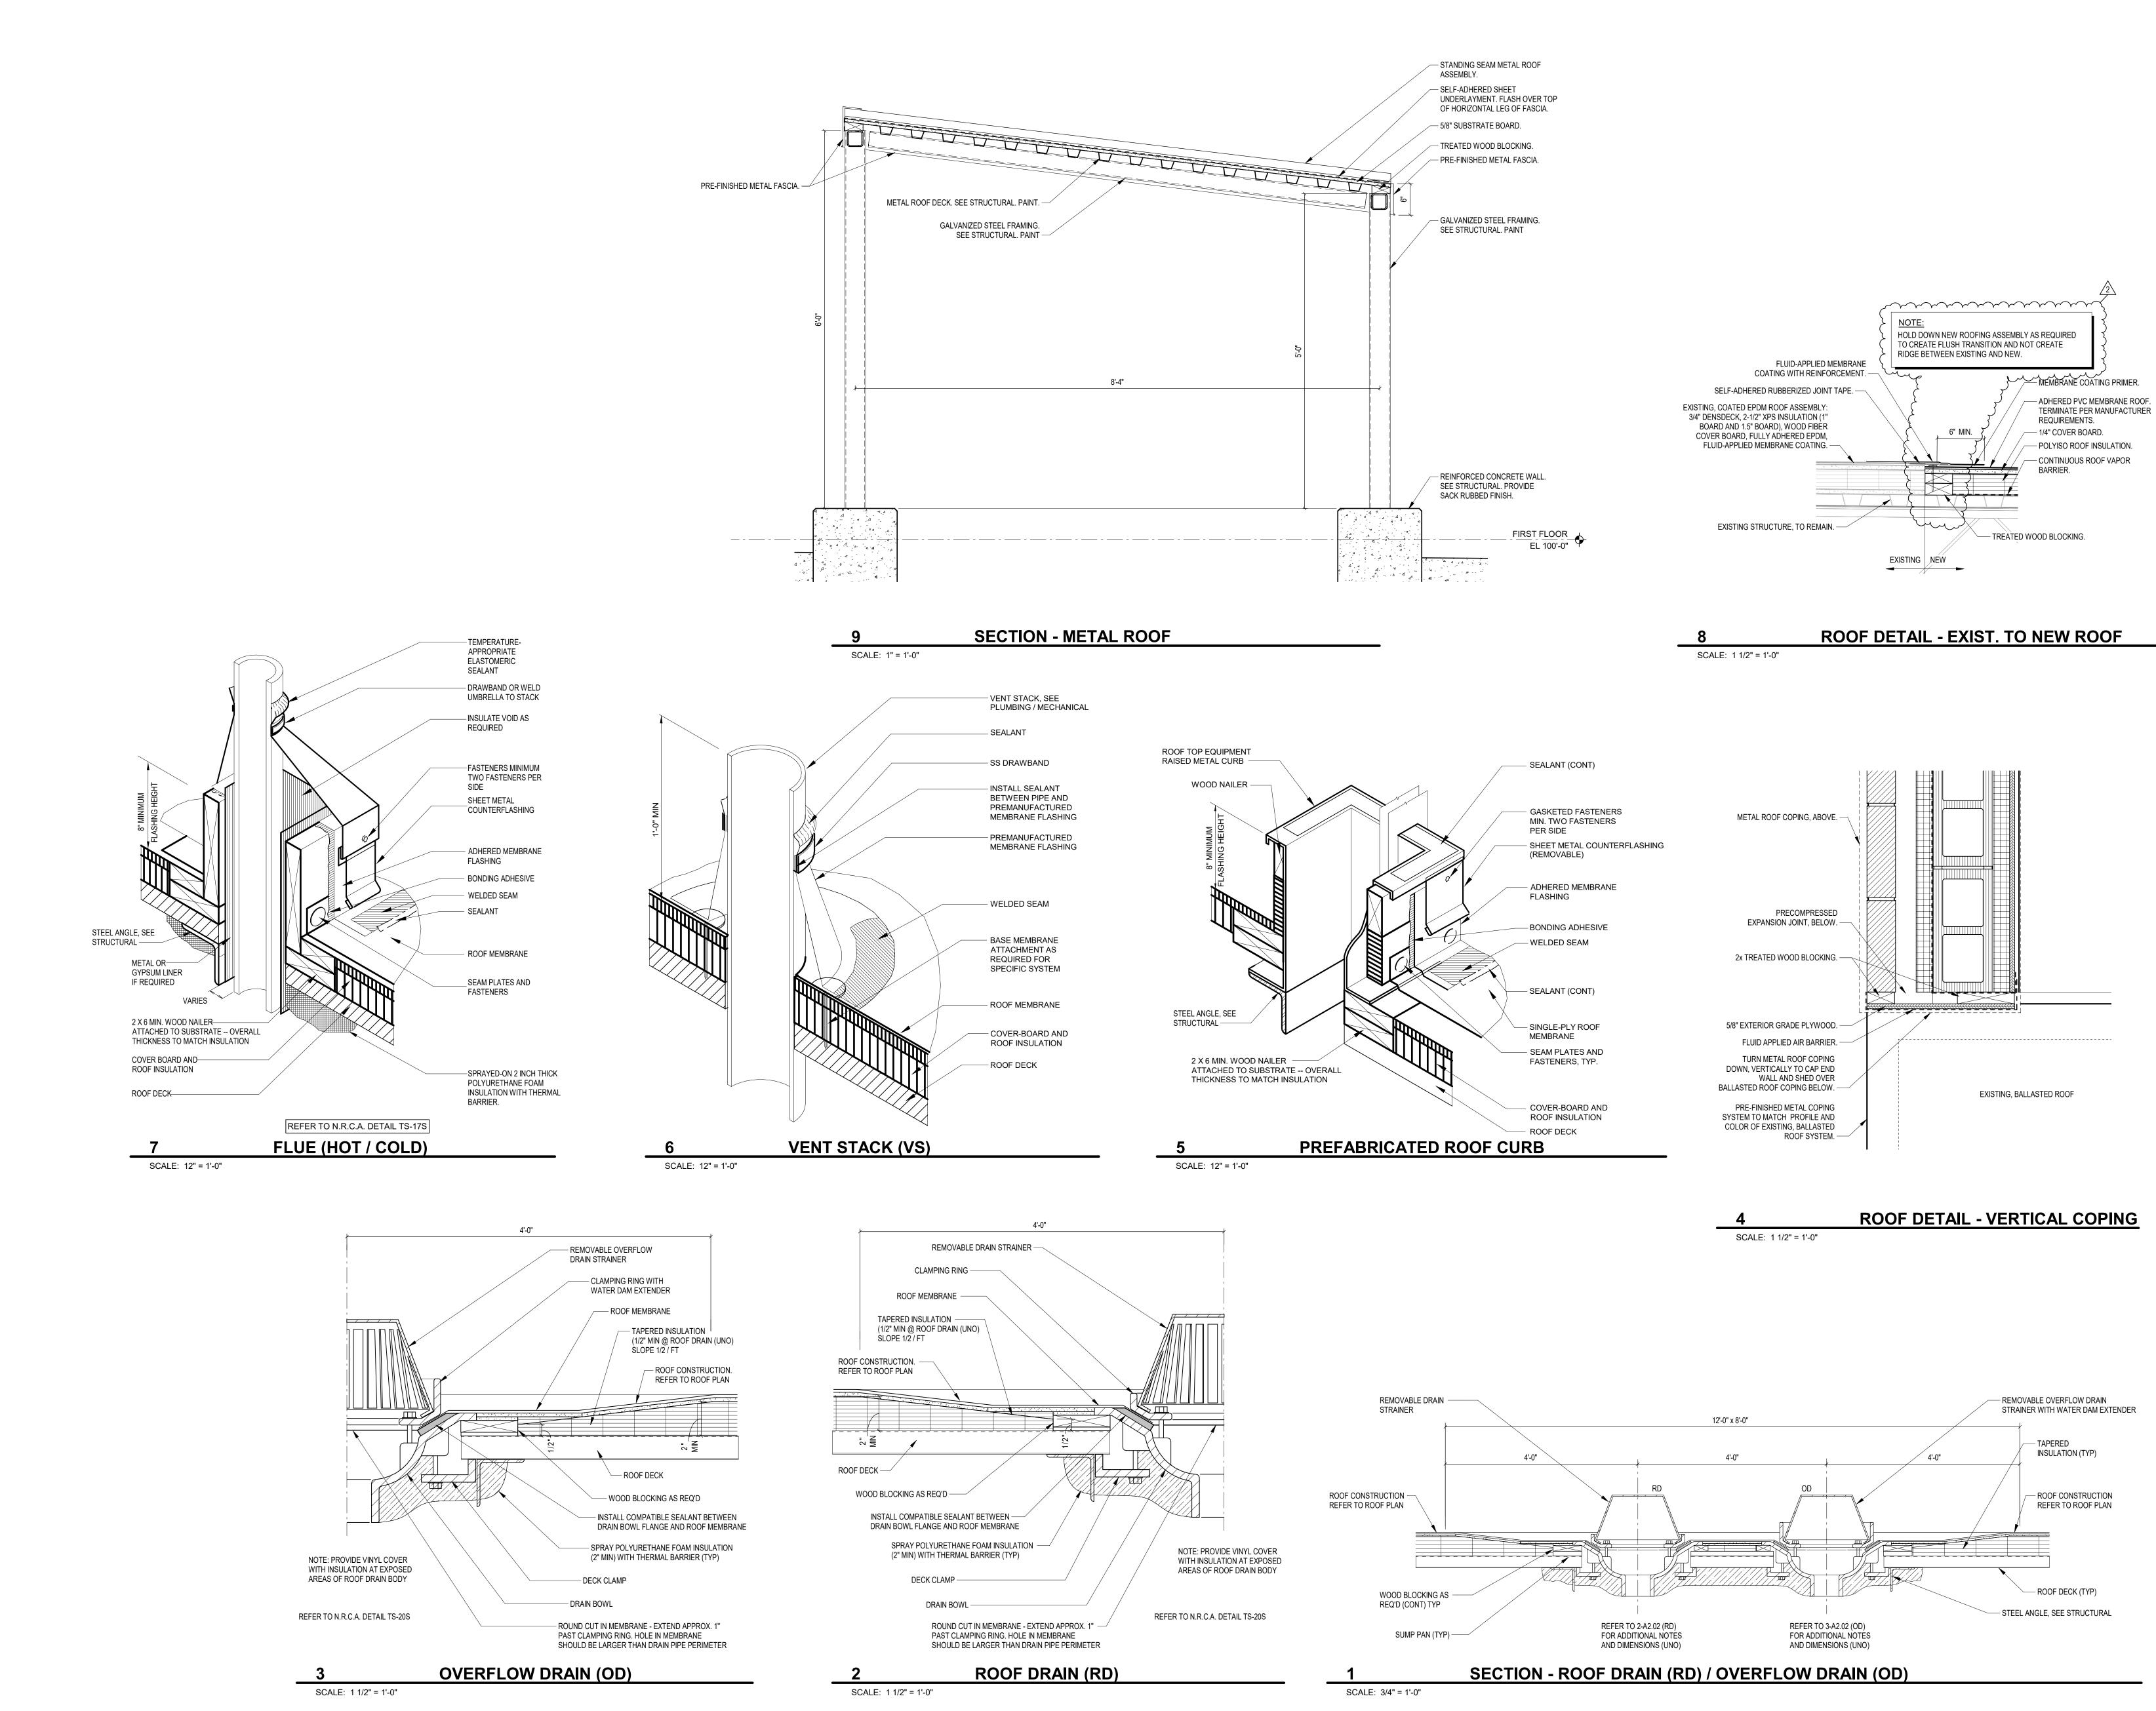




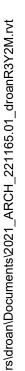

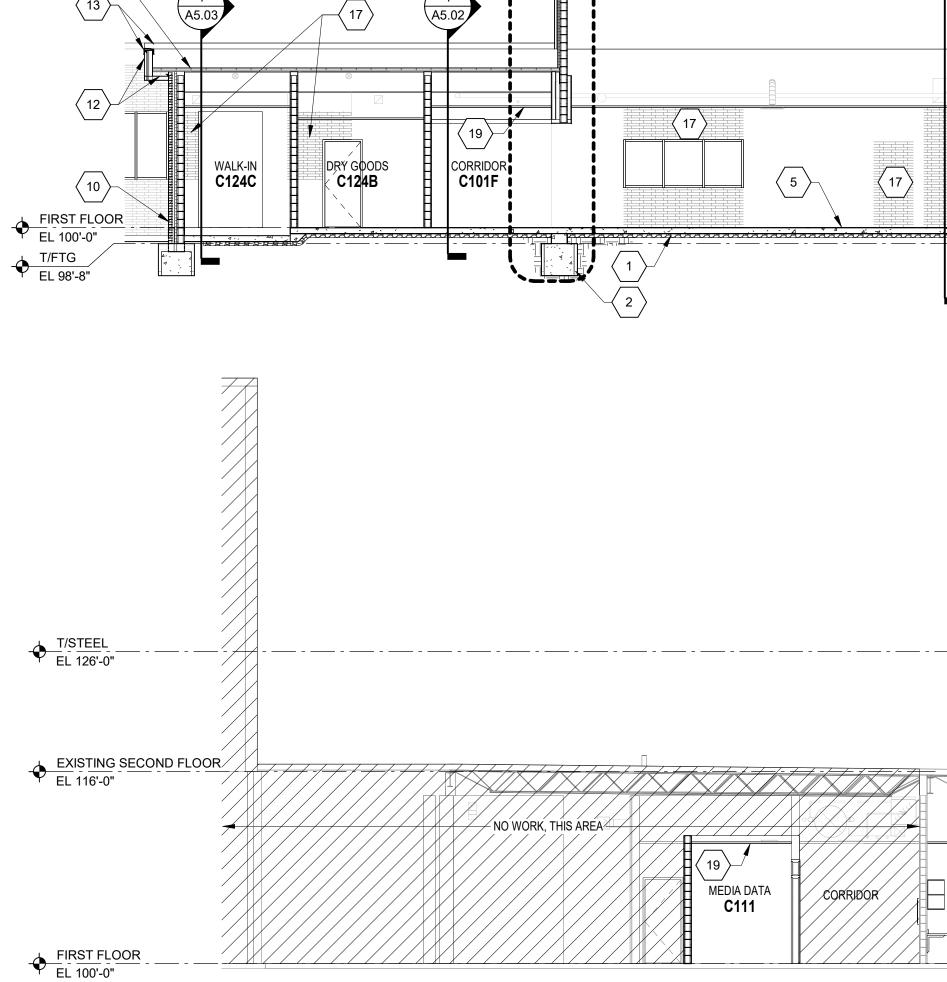

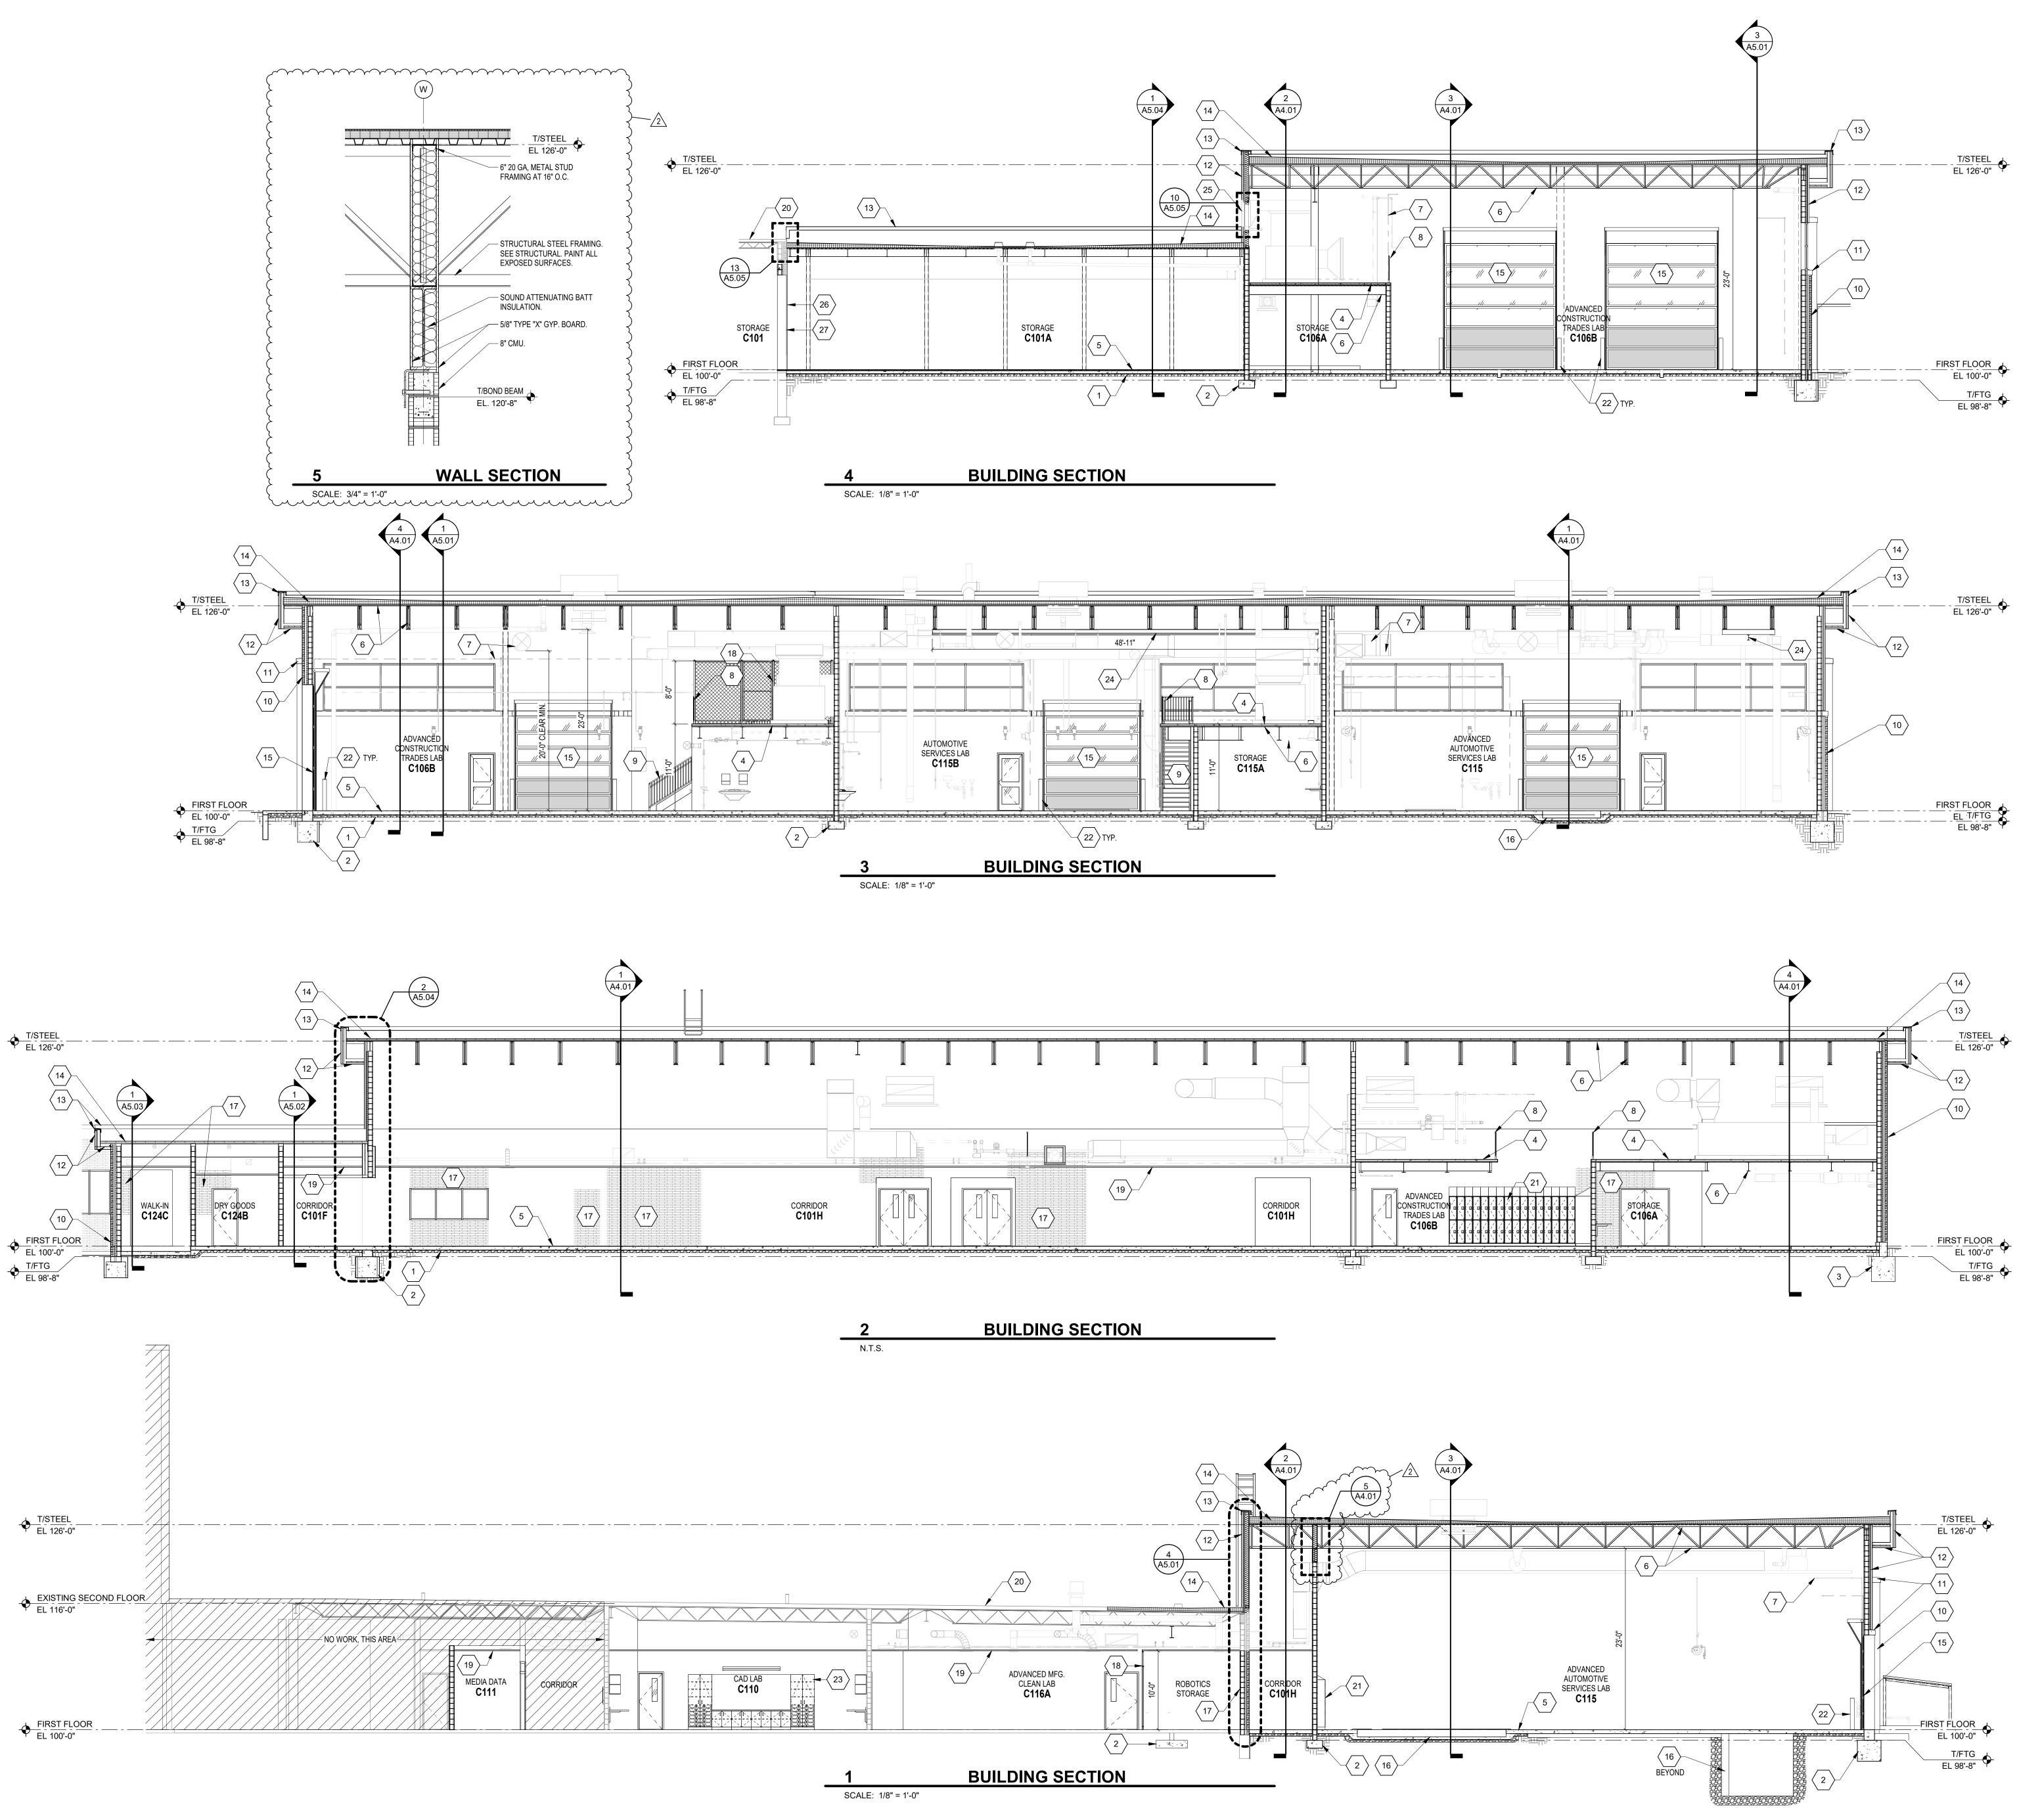

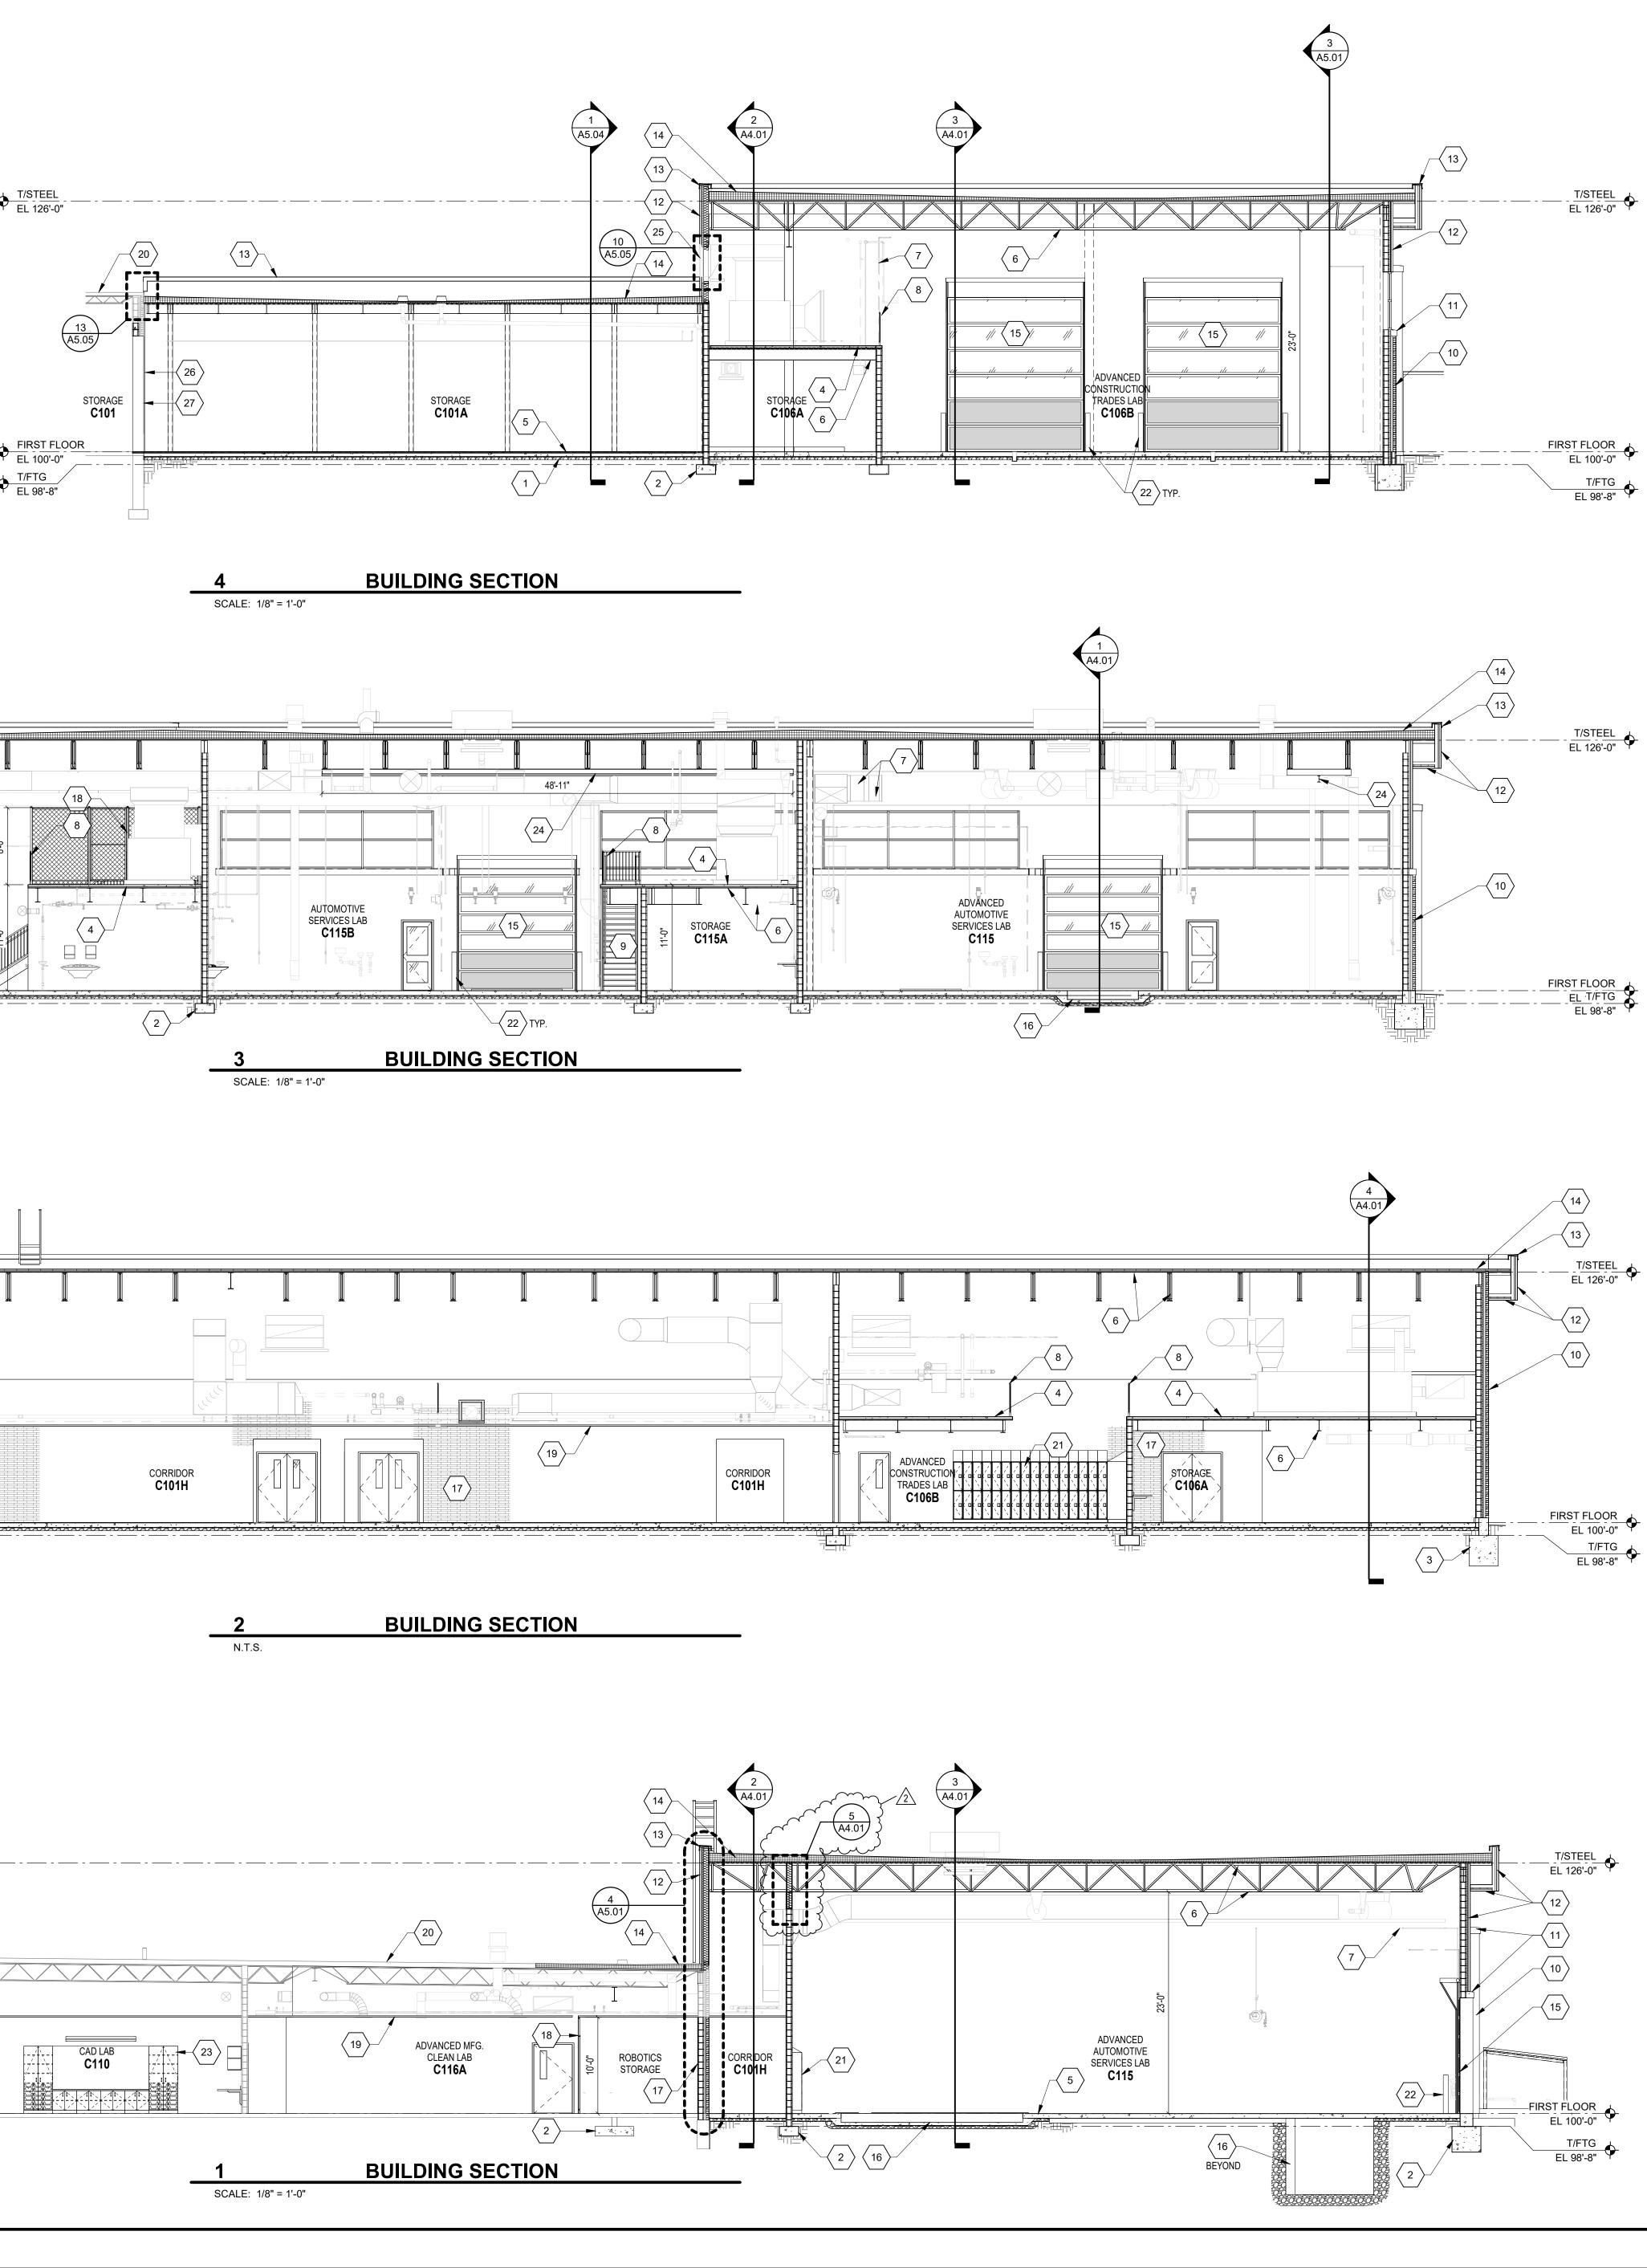

BUILDING SECTION NOTES	
ALL NOTES MAY NOT BE INDICATED ON THIS SHEE	ΞT

## **DESCRIPTION** <u>NO.</u> COMPACTED GRANULAR FILL. SEE STRUCTURAL. REINFORCED CONCRETE FOUNDATION. SEE STRUCTURAL. EXISTING CONCRETE FOUNDATION. SEE STRUCTURAL. REINFORCED CONCRETE SLAB ON METAL DECK. SEE STRUCTURAL. REINFORCED CONCRETE SLAB-ON-GRADE. SEE STRUCTURAL. PAINT ALL EXPOSED STRUCTURAL STEEL AND METAL DECK PAINT ALL EXPOSED DUCT, PIPING AND CONDUIT. METAL PIPE GUARDRAIL SYSTEM. CONCRETE FILLED, METAL PAN STAIRS. ANCHORED BRICK VENEER. CAST STONE BAND. METAL COMPOSITE MATERIAL (MCM) PANEL SYSTEM. METAL COPING SYSTEM. MEMBRANE ROOFING SYSTEM (ADHERED) ON 1/4" COVER BOARD OVER FLAT AND TAPERED ROOF INSULATION OVER METAL ROOF DECK. SEE ROOF PLANS FOR ADDITIONAL INFORMATION. GLAZED OVERHEAD DOOR SYSTEM. RECESSED EQUIPMENT. SEE STRUCTURAL AND EQUIPMENT PLANS FOR ADDITIONAL INFORMATION. INFILL OPENING TO MATCH EXISTING WALL CONSTRUCTION. FINISH FLUSH WITH ADJACENT SURFACES TO SHOW NO EVIDENCE OF CONSTRUCTION. WIRE MESH PARTITION SYSTEM. ACOUSTICAL CEILING SYSTEM. SEE REFLECTED CEILING PLANS FOR ADDITIONAL INFORMATION. EXISTING MEMBRANE ROOF SYSTE TO REMAIN. PROTECT FROM DAMAGE DURING CONSTRUCTION. PRE-FINISHED STEEL LOCKERS AND CMU BASE. SEE EQUIPMENT PLANS. STEEL PIPE BOLLARD.

PLASTIC LAMINATE CASEWORK. SEE EQUIPMENT PLANS.

PRE-FINISHED METAL LOUVER. SEE MECHANICAL. 1 1/2" PRE-COMPRESSED BUILDING EXPANSION JOINT.


13'W x 12'H MASONRY OPENING. SEE STRUCTURAL.


PLANS AND STRUCTURAL.


VERIFICATION NOTE


WORK.


CONTRACTOR SHALL VERIFY ALL DIMENSIONS AND CLEARANCES AND ALL EXISTING FIELD CONDITIONS BEFORE STARTING CONSTRUCTION. COMMENCEMENT OF WORK CONSTITUTES ACCEPTANCE OF CONDITIONS. SHOULD DIFFERENT CONDITIONS BE ENCOUNTERED, CONTACT THE ARCHITECT BEFORE PROCEEDING WITH

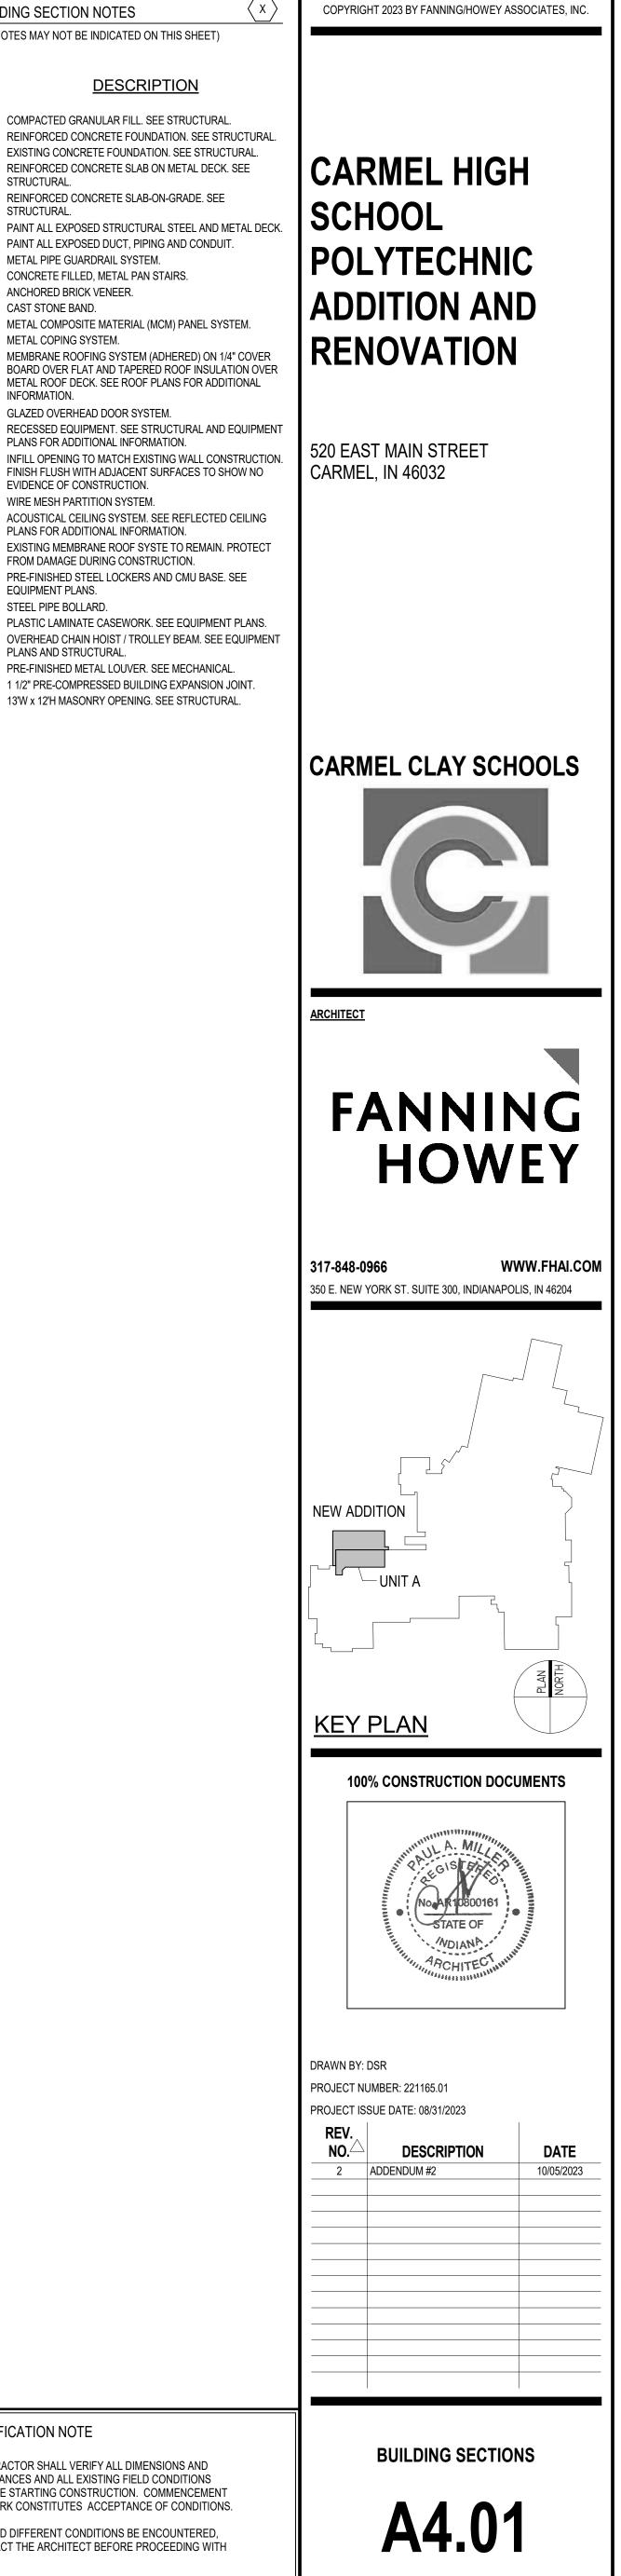


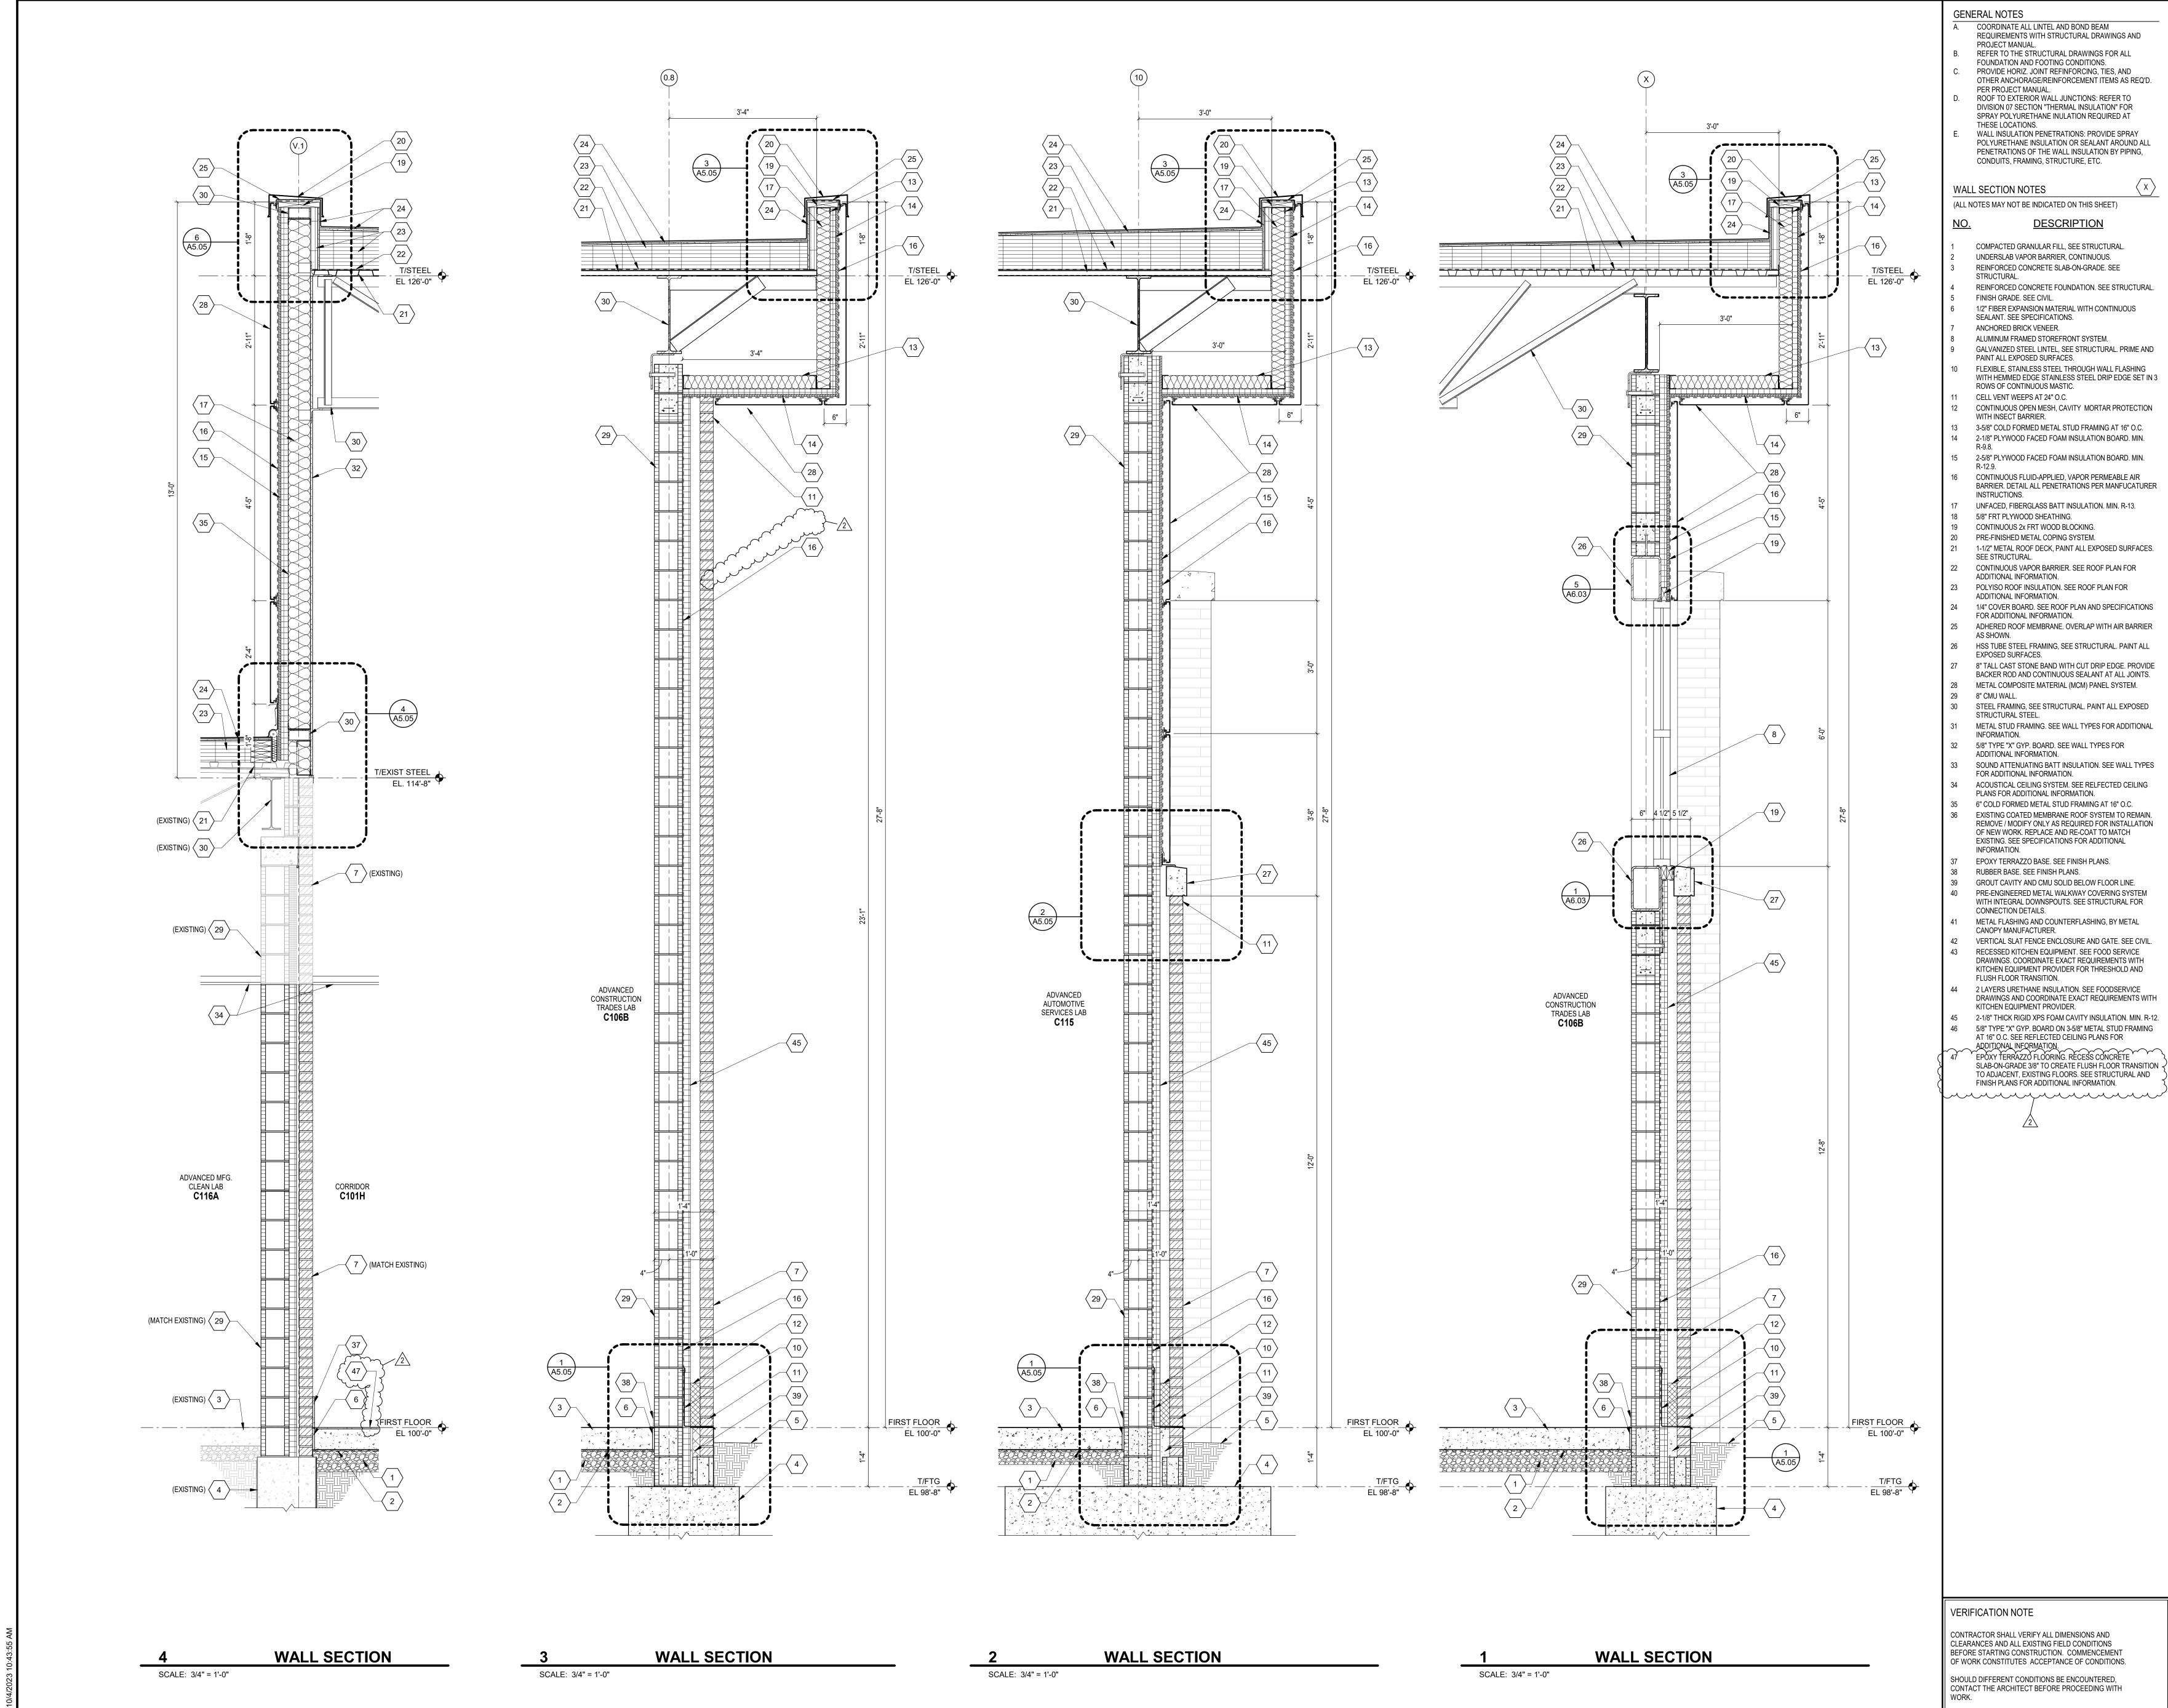

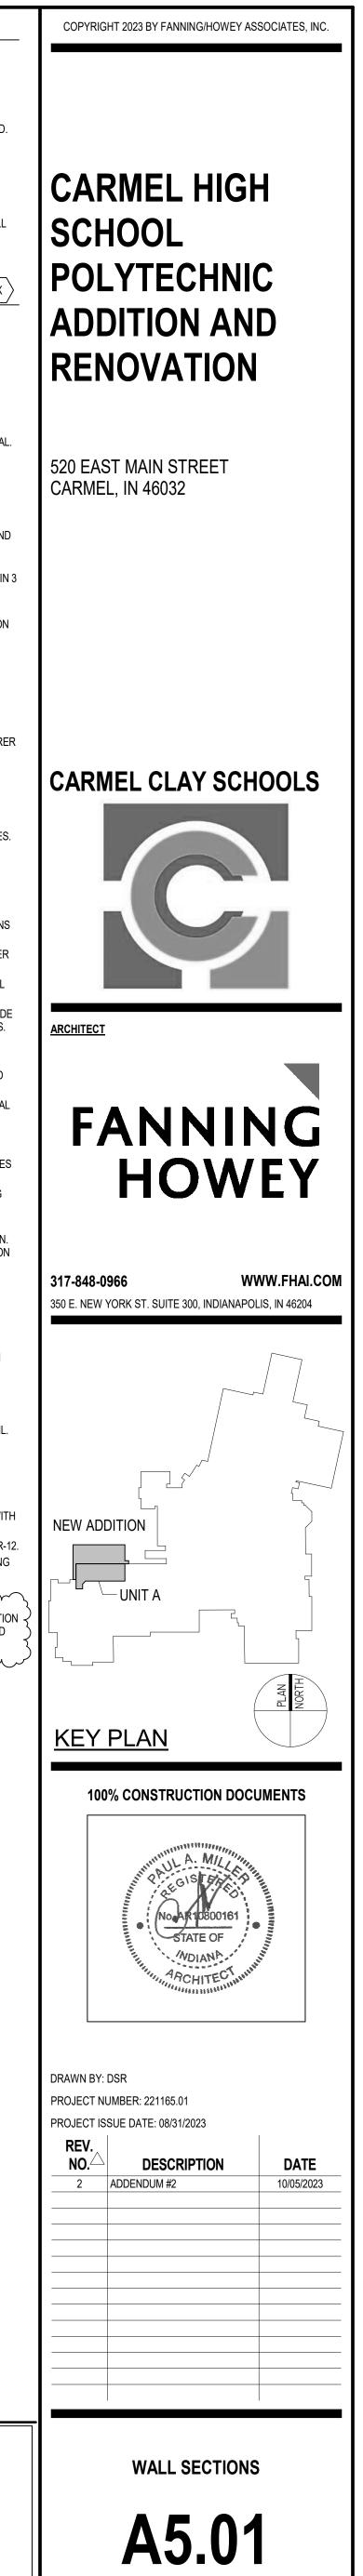

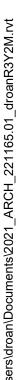

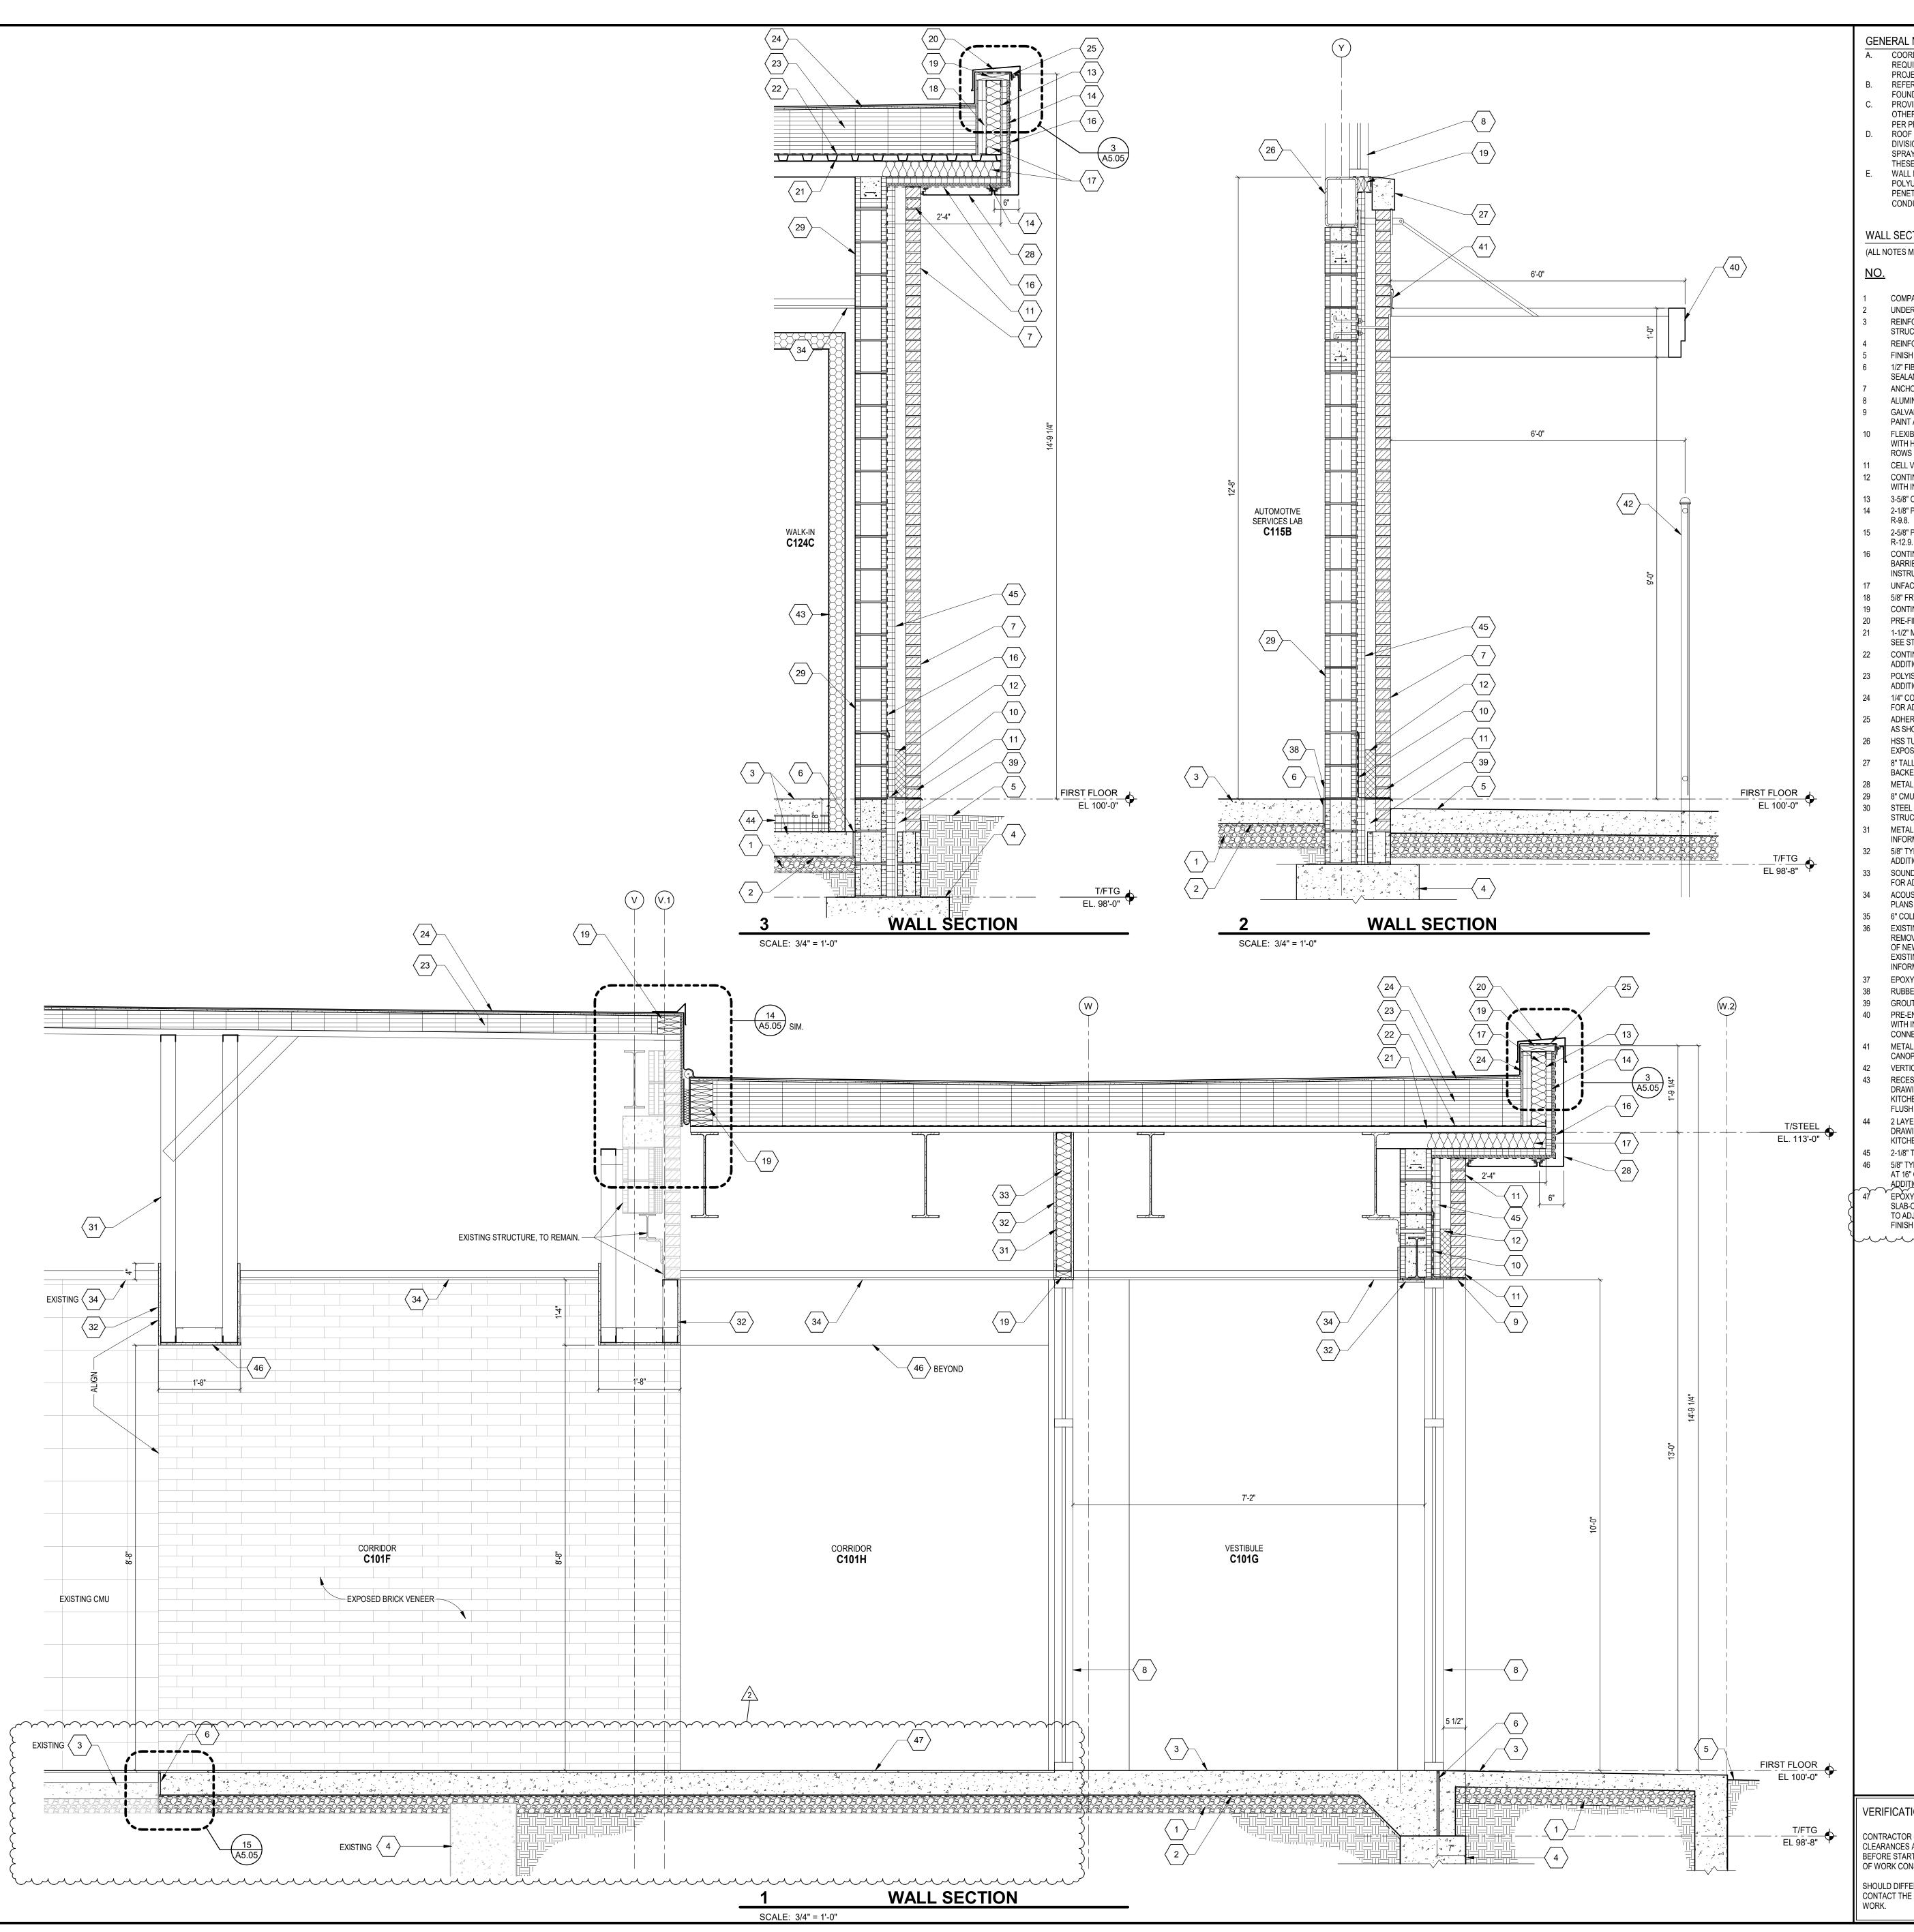

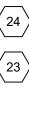



# GENERAL NOTES COORDINATE ALL LINTEL AND BOND BEAM REQUIREMENTS WITH STRUCTURAL DRAWINGS AND PROJECT MANUAL. REFER TO THE STRUCTURAL DRAWINGS FOR ALL FOUNDATION AND FOOTING CONDITIONS. PROVIDE HORIZ. JOINT REFINFORCING, TIES, AND OTHER ANCHORAGE/REINFORCEMENT ITEMS AS REQ'D. PER PROJECT MANUAL. ROOF TO EXTERIOR WALL JUNCTIONS: REFER TO DIVISION 07 SECTION "THERMAL INSULATION" FOR SPRAY POLYURETHANE INULATION REQUIRED AT THESE LOCATIONS. WALL INSULATION PENETRATIONS: PROVIDE SPRAY POLYURETHANE INSULATION OR SEALANT AROUND ALL PENETRATIONS OF THE WALL INSULATION BY PIPING, CONDUITS, FRAMING, STRUCTURE, ETC. WALL SECTION NOTES (ALL NOTES MAY NOT BE INDICATED ON THIS SHEET) DESCRIPTION COMPACTED GRANULAR FILL, SEE STRUCTURAL. UNDERSLAB VAPOR BARRIER, CONTINUOUS. REINFORCED CONCRETE SLAB-ON-GRADE. SEE STRUCTURAL. REINFORCED CONCRETE FOUNDATION. SEE STRUCTURAL. FINISH GRADE. SEE CIVIL. 1/2" FIBER EXPANSION MATERIAL WITH CONTINUOUS SEALANT. SEE SPECIFICATIONS. ANCHORED BRICK VENEER. ALUMINUM FRAMED STOREFRONT SYSTEM. GALVANIZED STEEL LINTEL, SEE STRUCTURAL. PRIME AND PAINT ALL EXPOSED SURFACES. FLEXIBLE, STAINLESS STEEL THROUGH WALL FLASHING WITH HEMMED EDGE STAINLESS STEEL DRIP EDGE SET IN 3 ROWS OF CONTINUOUS MASTIC. CELL VENT WEEPS AT 24" O.C. CONTINUOUS OPEN MESH, CAVITY MORTAR PROTECTION WITH INSECT BARRIER. 3-5/8" COLD FORMED METAL STUD FRAMING AT 16" O.C. 2-1/8" PLYWOOD FACED FOAM INSULATION BOARD. MIN. 2-5/8" PLYWOOD FACED FOAM INSULATION BOARD. MIN. R-12.9 CONTINUOUS FLUID-APPLIED, VAPOR PERMEABLE AIR BARRIER. DETAIL ALL PENETRATIONS PER MANFUCATURER INSTRUCTIONS. UNFACED, FIBERGLASS BATT INSULATION. MIN. R-13. 5/8" FRT PLYWOOD SHEATHING. CONTINUOUS 2x FRT WOOD BLOCKING. PRE-FINISHED METAL COPING SYSTEM. 1-1/2" METAL ROOF DECK, PAINT ALL EXPOSED SURFACES. SEE STRUCTURAL. CONTINUOUS VAPOR BARRIER. SEE ROOF PLAN FOR ADDITIONAL INFORMATION. POLYISO ROOF INSULATION. SEE ROOF PLAN FOR ADDITIONAL INFORMATION. 1/4" COVER BOARD. SEE ROOF PLAN AND SPECIFICATIONS FOR ADDITIONAL INFORMATION. ADHERED ROOF MEMBRANE. OVERLAP WITH AIR BARRIER AS SHOWN. HSS TUBE STEEL FRAMING, SEE STRUCTURAL. PAINT ALL EXPOSED SURFACES. 8" TALL CAST STONE BAND WITH CUT DRIP EDGE. PROVIDE BACKER ROD AND CONTINUOUS SEALANT AT ALL JOINTS. METAL COMPOSITE MATERIAL (MCM) PANEL SYSTEM. 8" CMU WALL. STEEL FRAMING, SEE STRUCTURAL. PAINT ALL EXPOSED STRUCTURAL STEEL. METAL STUD FRAMING. SEE WALL TYPES FOR ADDITIONAL INFORMATION. 5/8" TYPE "X" GYP. BOARD. SEE WALL TYPES FOR ADDITIONAL INFORMATION. SOUND ATTENUATING BATT INSULATION. SEE WALL TYPES FOR ADDITIONAL INFORMATION. ACOUSTICAL CEILING SYSTEM. SEE RELFECTED CEILING PLANS FOR ADDITIONAL INFORMATION. 6" COLD FORMED METAL STUD FRAMING AT 16" O.C. EXISTING COATED MEMBRANE ROOF SYSTEM TO REMAIN. REMOVE / MODIFY ONLY AS REQUIRED FOR INSTALLATION OF NEW WORK. REPLACE AND RE-COAT TO MATCH EXISTING. SEE SPECIFICATIONS FOR ADDITIONAL INFORMATION. EPOXY TERRAZZO BASE. SEE FINISH PLANS. RUBBER BASE. SEE FINISH PLANS. GROUT CAVITY AND CMU SOLID BELOW FLOOR LINE. PRE-ENGINEERED METAL WALKWAY COVERING SYSTEM WITH INTEGRAL DOWNSPOUTS. SEE STRUCTURAL FOR CONNECTION DETAILS. METAL FLASHING AND COUNTERFLASHING, BY METAL CANOPY MANUFACTURER. VERTICAL SLAT FENCE ENCLOSURE AND GATE. SEE CIVIL. RECESSED KITCHEN EQUIPMENT. SEE FOOD SERVICE DRAWINGS. COORDINATE EXACT REQUIREMENTS WITH KITCHEN EQUIPMENT PROVIDER FOR THRESHOLD AND FLUSH FLOOR TRANSITION. 2 LAYERS URETHANE INSULATION. SEE FOODSERVICE DRAWINGS AND COORDINATE EXACT REQUIREMENTS WITH KITCHEN EQUIPMENT PROVIDER. 2-1/8" THICK RIGID XPS FOAM CAVITY INSULATION. MIN. R-12. 5/8" TYPE "X" GYP. BOARD ON 3-5/8" METAL STUD FRAMING AT 16" O.C. SEE REFLECTED CEILING PLANS FOR ADDITIONAL INFORMATION. EPOXY TERRAZZÓ FLOORING. RÉCESS CONCRETE SLAB-ON-GRADE 3/8" TO CREATE FLUSH FLOOR TRANSITION TO ADJACENT, EXISTING FLOORS. SEE STRUCTURAL AND FINISH PLANS FOR ADDITIONAL INFORMATION. mmmmm

VERIFICATION NOTE


CONTRACTOR SHALL VERIFY ALL DIMENSIONS AND CLEARANCES AND ALL EXISTING FIELD CONDITIONS BEFORE STARTING CONSTRUCTION. COMMENCEMENT OF WORK CONSTITUTES ACCEPTANCE OF CONDITIONS. SHOULD DIFFERENT CONDITIONS BE ENCOUNTERED, CONTACT THE ARCHITECT BEFORE PROCEEDING WITH



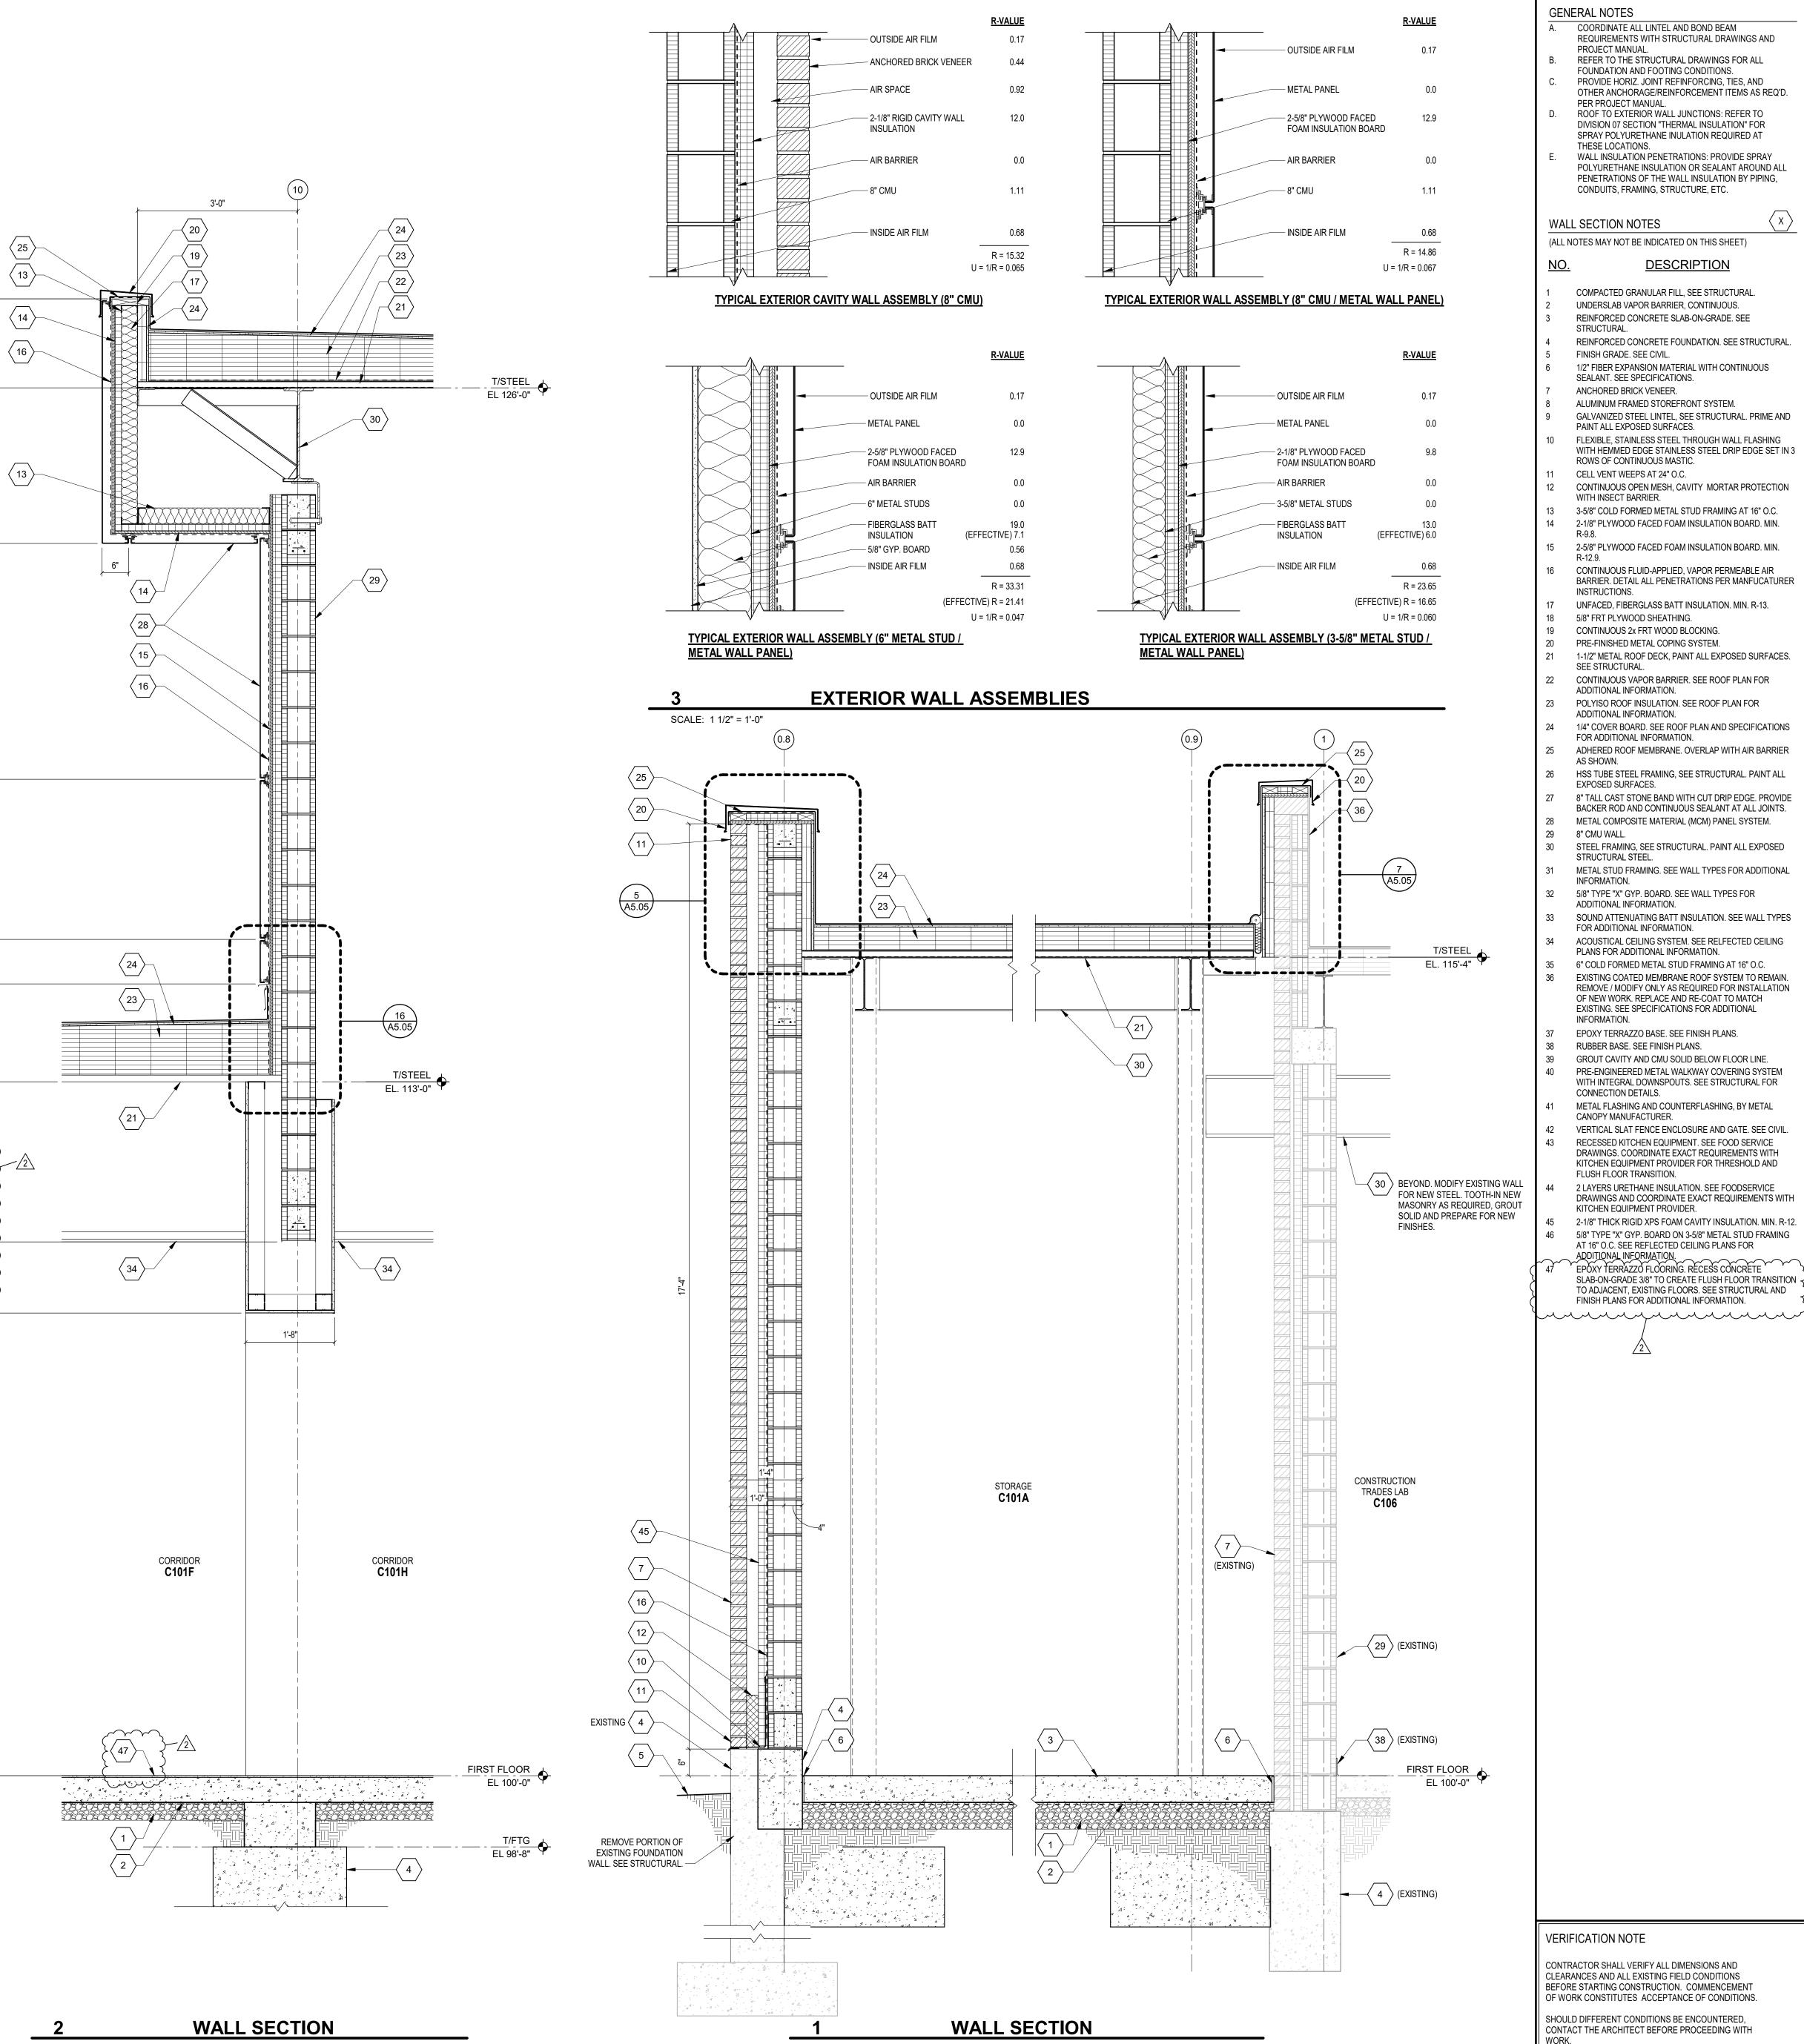

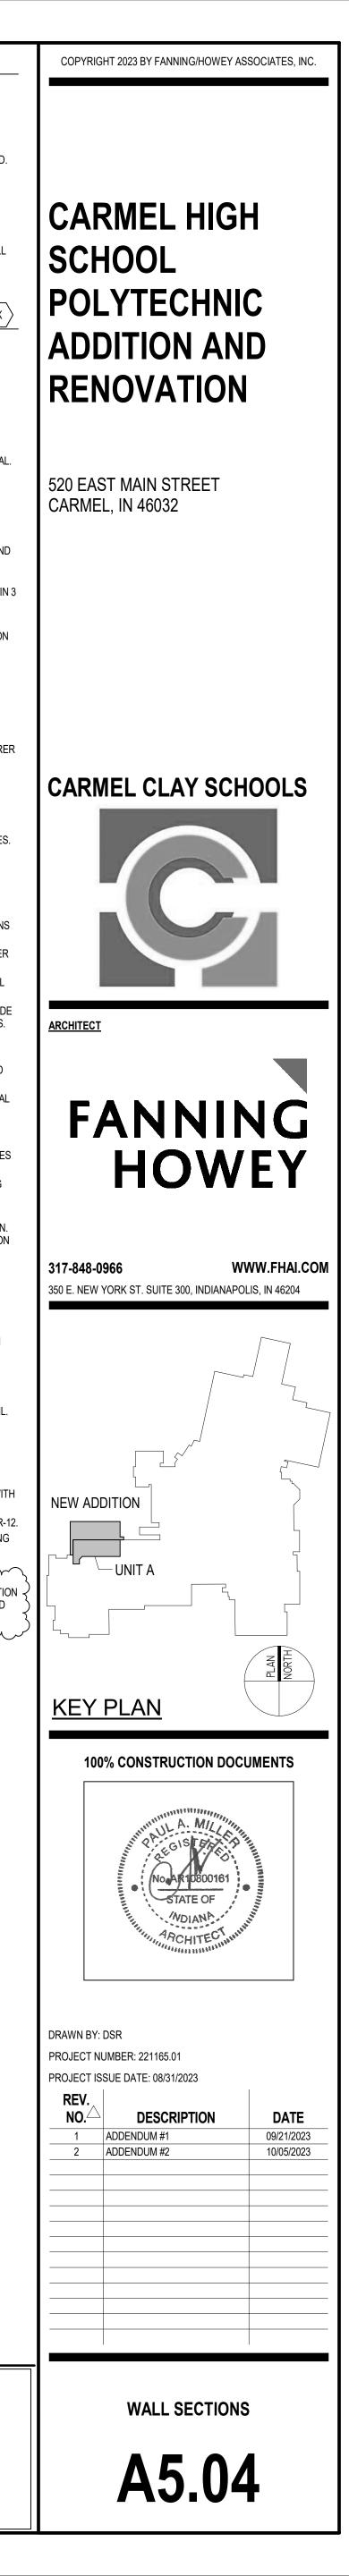


DESCRIPTION

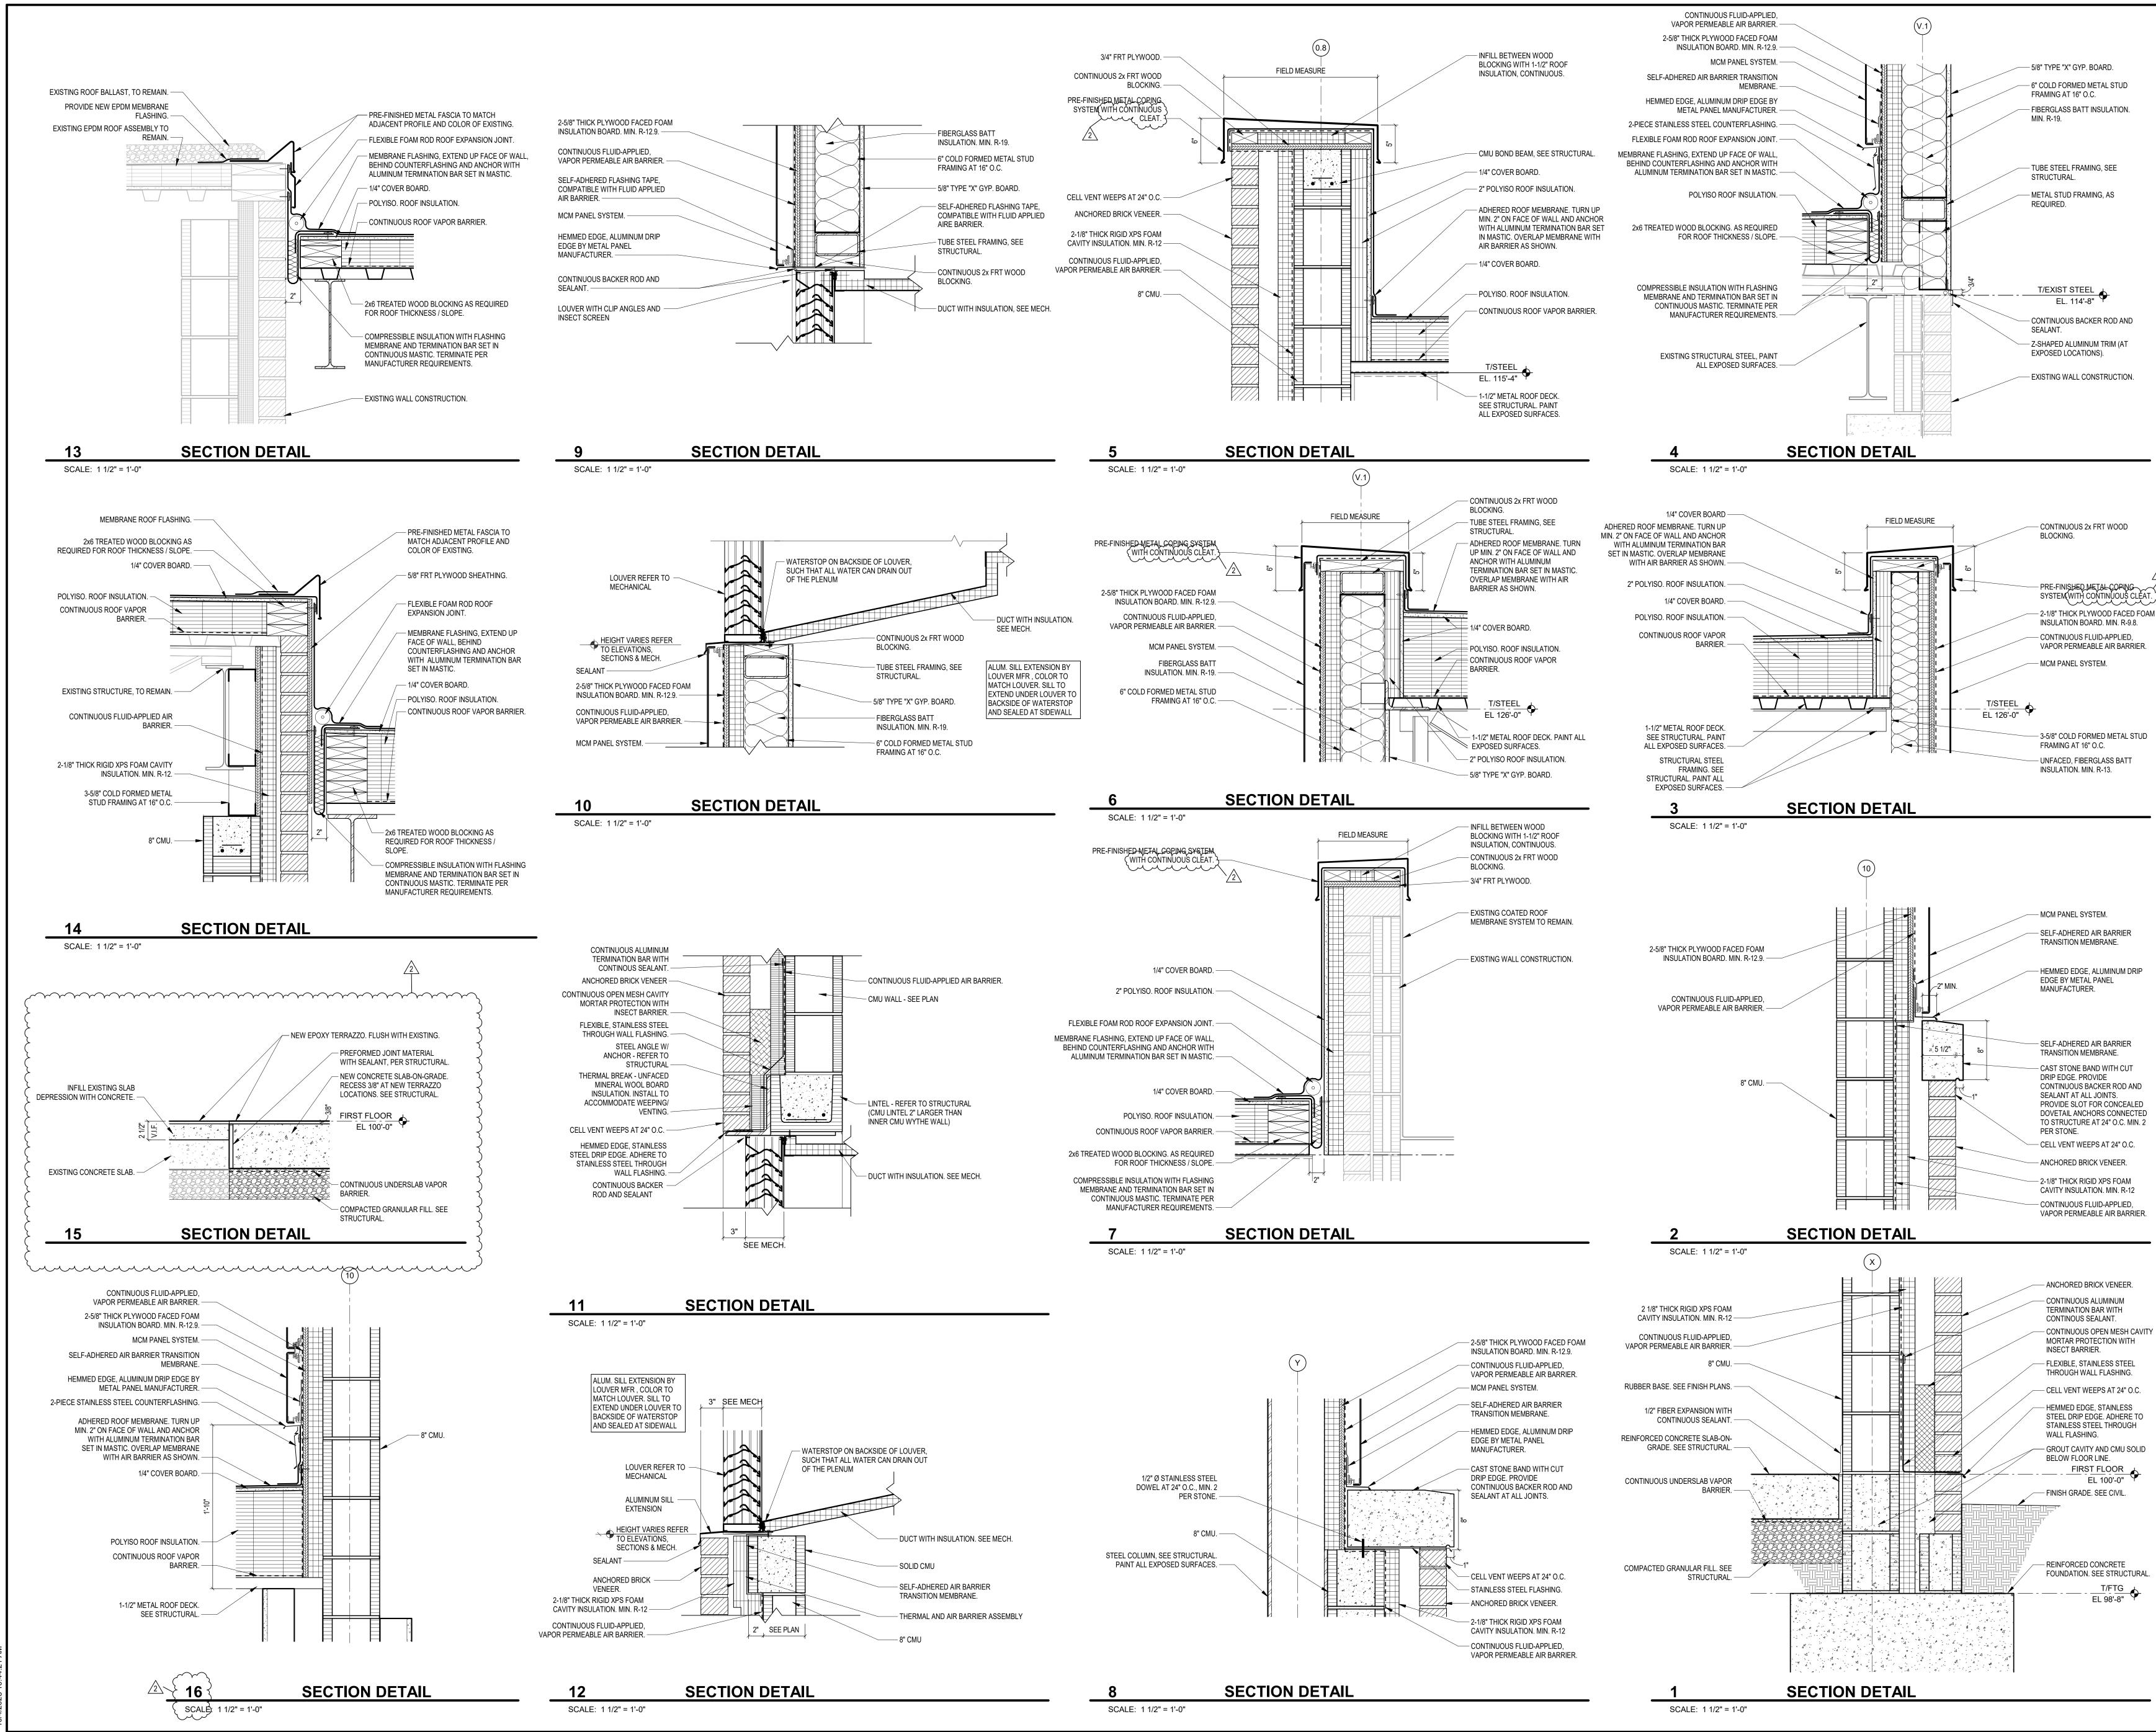







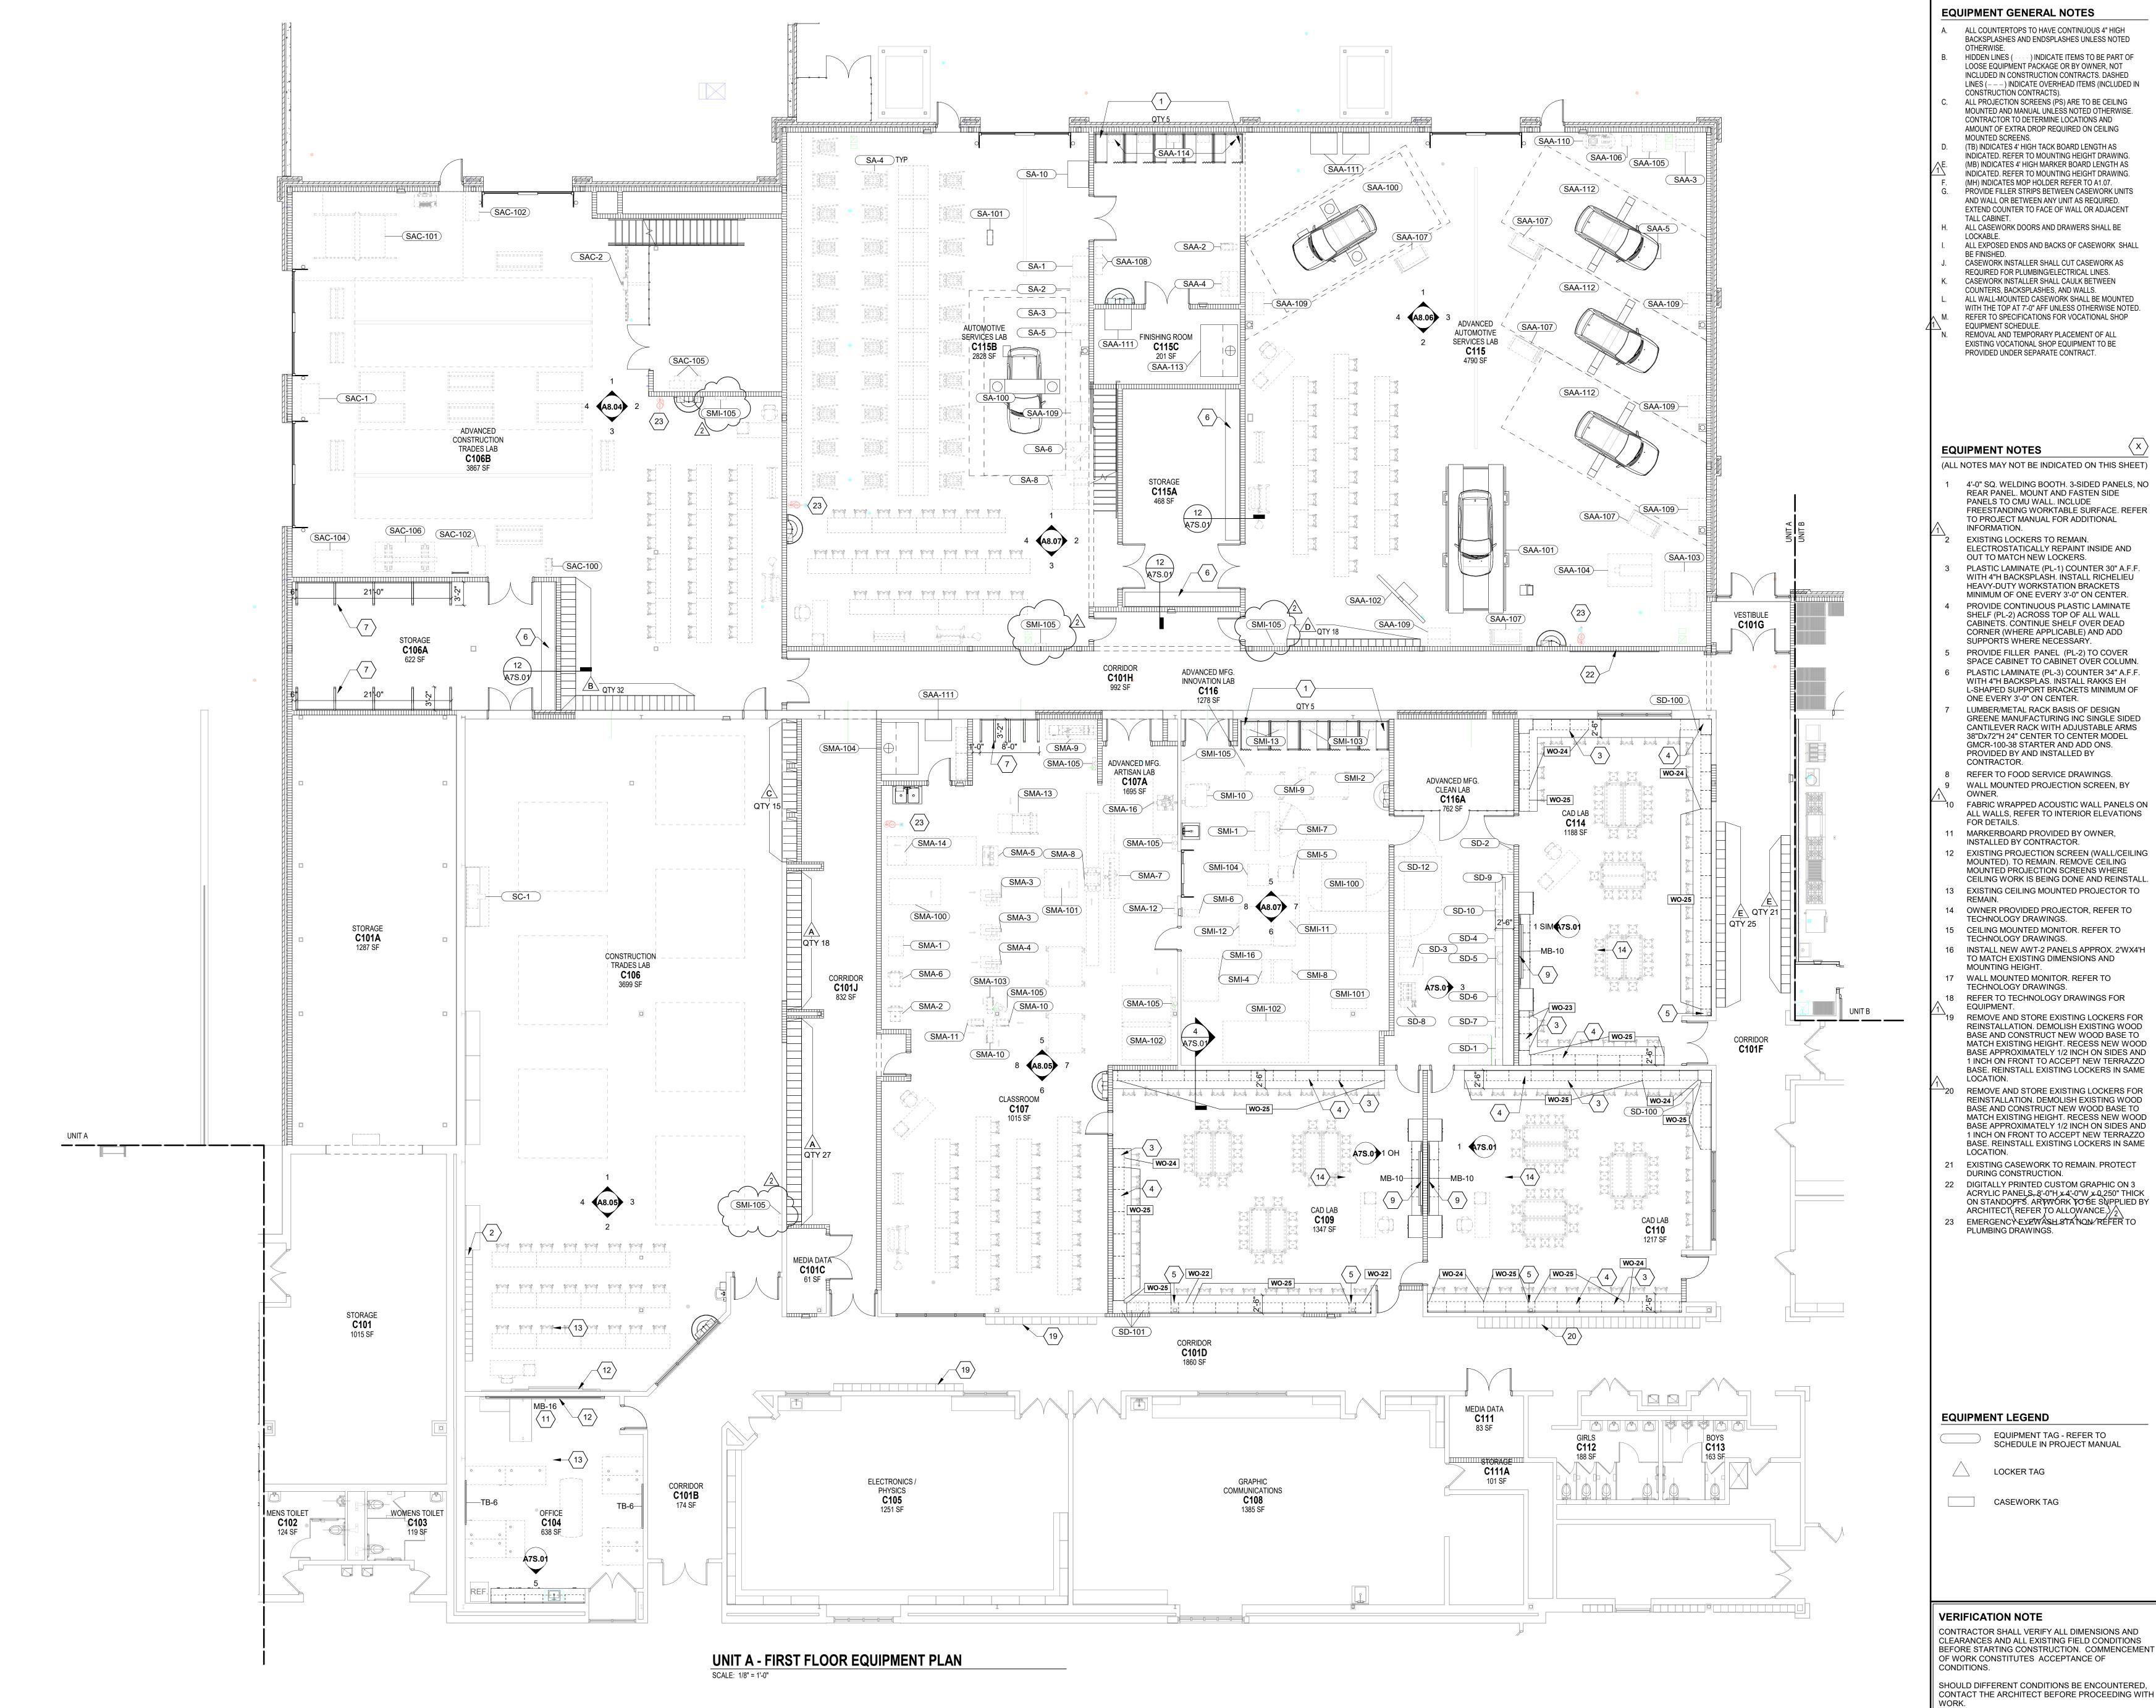



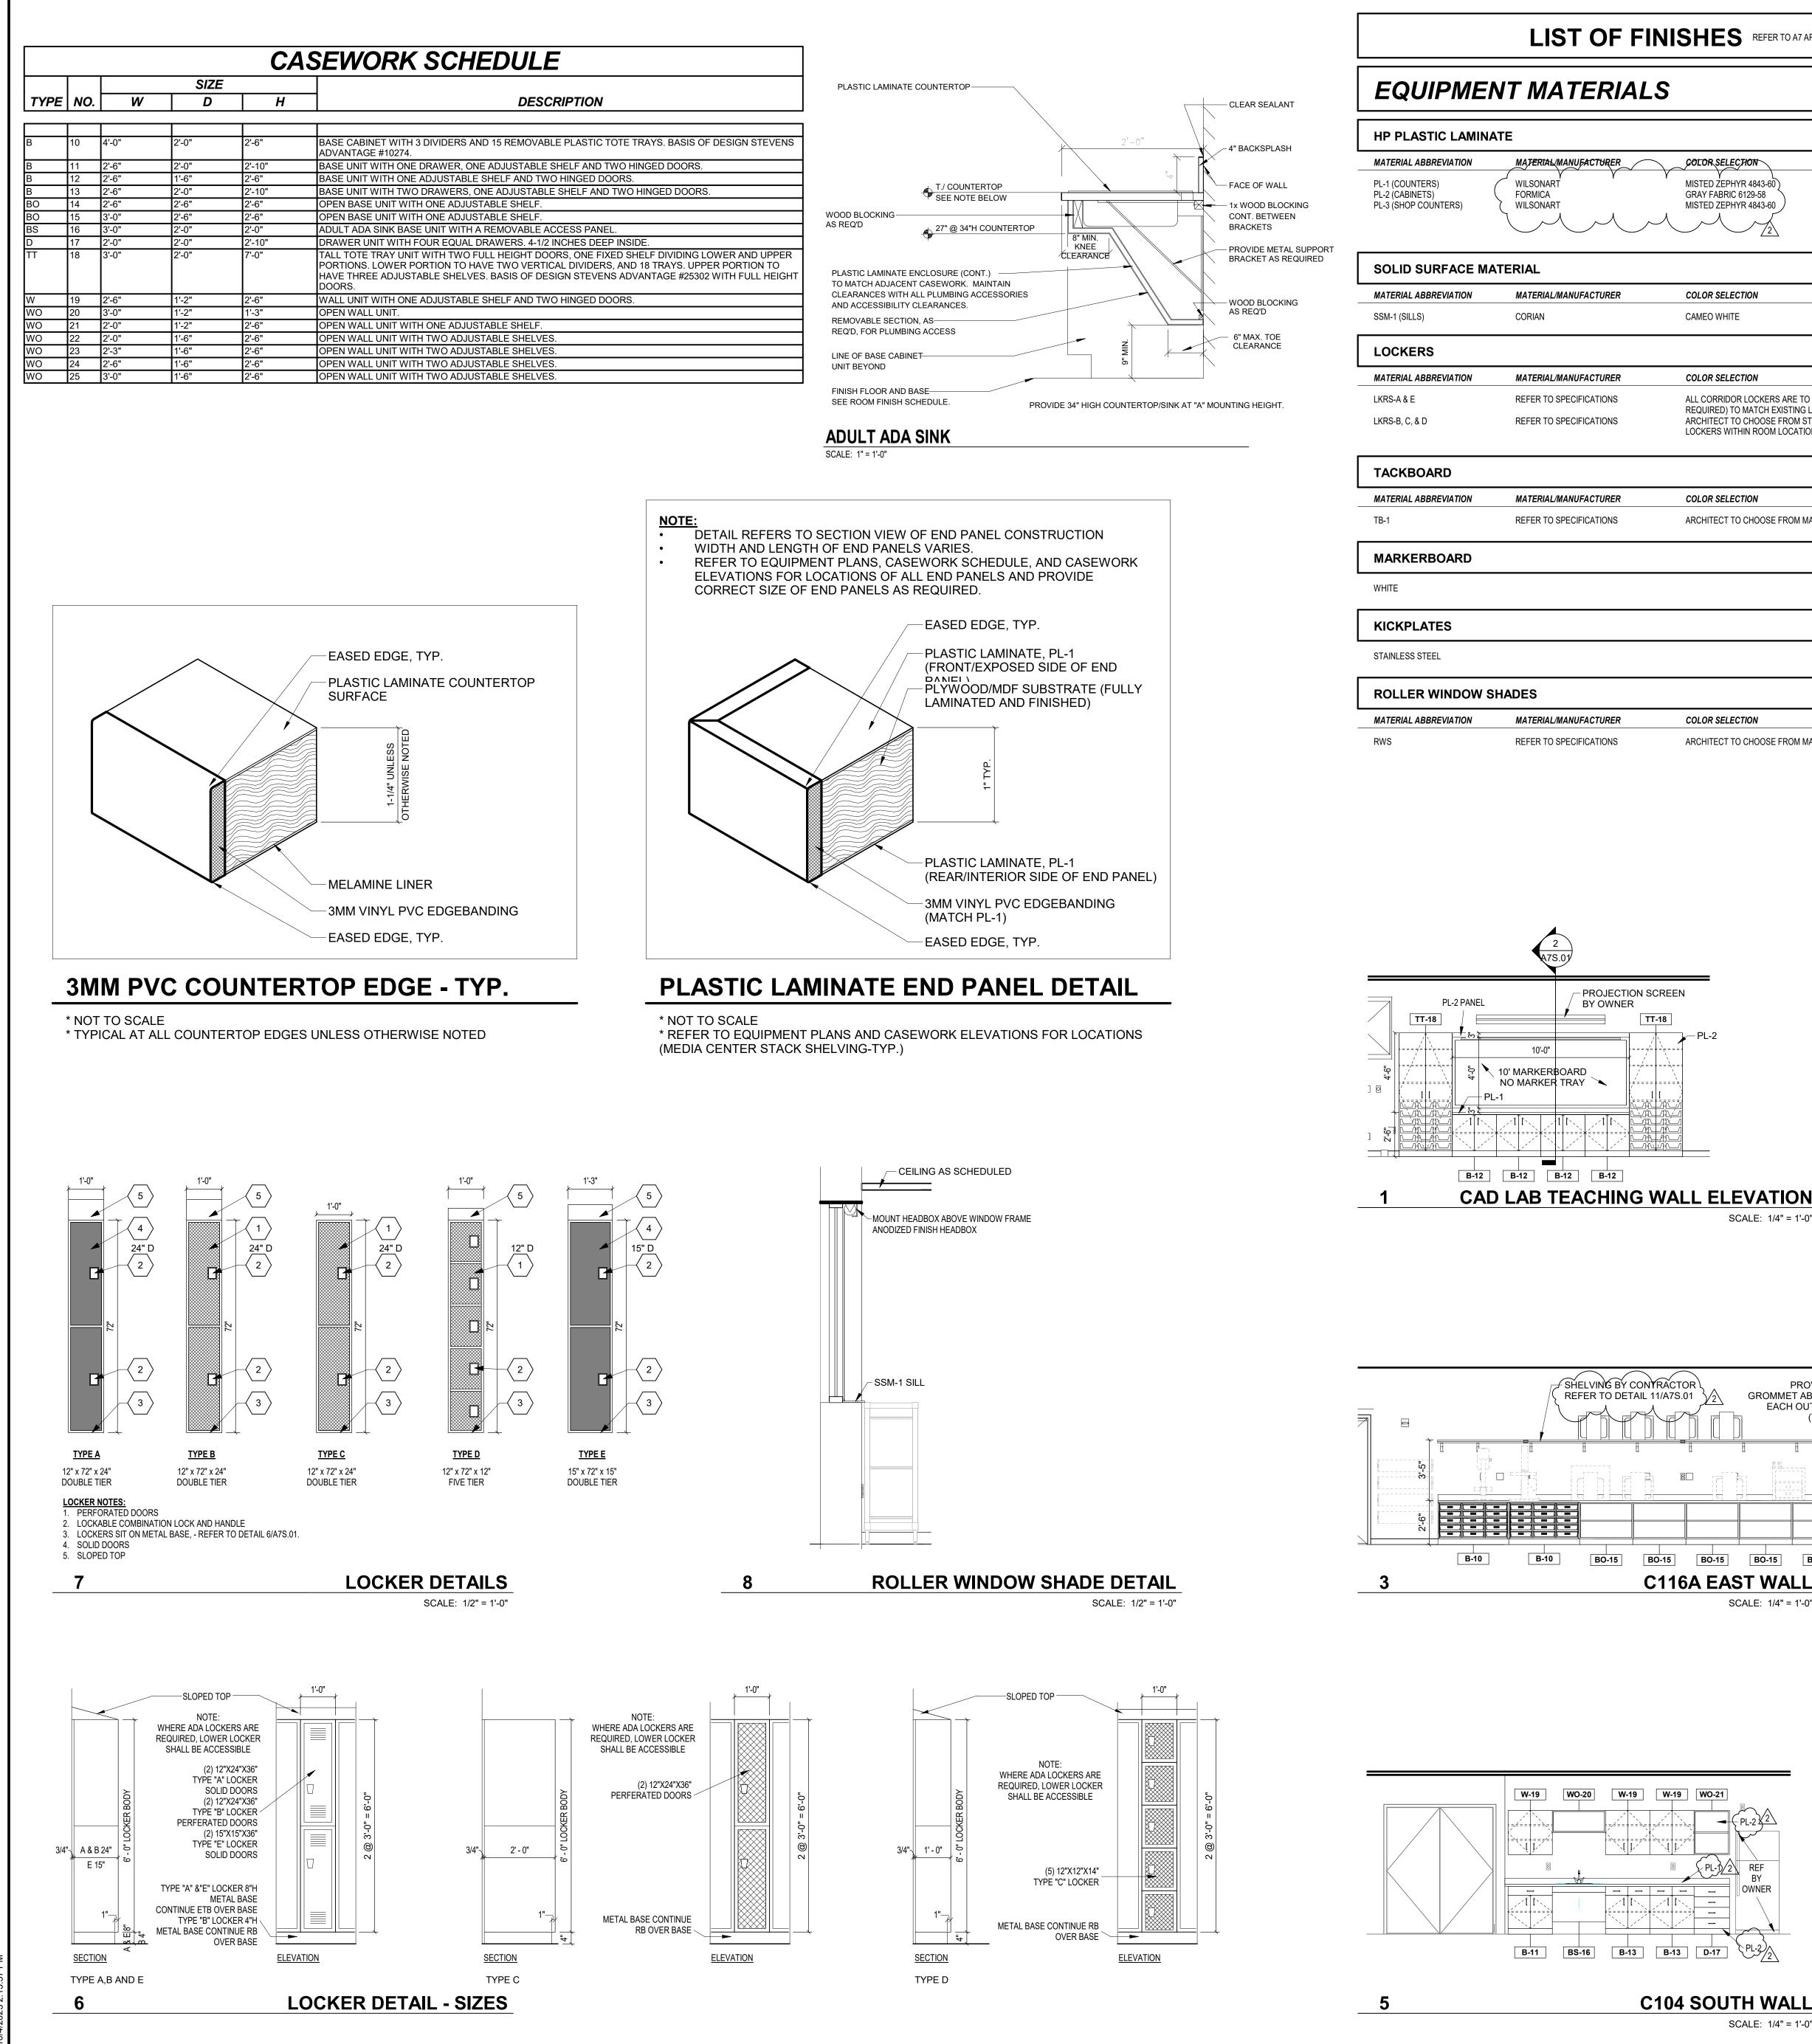

LIST OF FIN		
EQUIPMEI	NT MATERIALS	
HP PLASTIC LAMINA	ATE	
MATERIAL ABBREVIATION	MATERIALMANUFACTURER	
PL-1 (COUNTERS) PL-2 (CABINETS) PL-3 (SHOP COUNTERS)	WILSONART FORMICA WILSONART	
SOLID SURFACE MA	TERIAL	
MATERIAL ABBREVIATION	MATERIAL/MANUFACTURER	
SSM-1 (SILLS)	CORIAN	
LOCKERS		
MATERIAL ABBREVIATION	MATERIAL/MANUFACTURER	
LKRS-A & E	REFER TO SPECIFICATIONS	
LKRS-B, C, & D	REFER TO SPECIFICATIONS	
TACKBOARD		
MATERIAL ABBREVIATION	MATERIAL/MANUFACTURER	
TB-1	REFER TO SPECIFICATIONS	
MARKERBOARD		
WHITE		
KICKPLATES		
STAINLESS STEEL		
ROLLER WINDOW S	HADES	
MATERIAL ABBREVIATION	MATERIAL/MANUFACTURER	

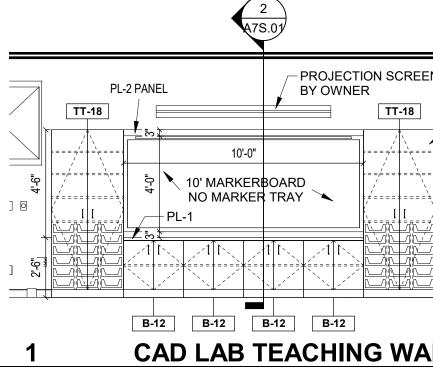

RFF

PL-2/2


SCALE: 1/4" = 1'-0"

(PL-1)/2

-

—


SHES REFER TO A7 ARCH. DWG. SHEETS	
	EQUIPMENT MATERIAL & FINISH GENERAL NOTE
	A. COLOR SELECTION OF ALL FINISHES FOR ARCHITECTURAL WOODWORK/CUSTOM CASEWORK ITEMS ARE NOTED ON CASEWORK ELEVATIONS AND DETAIL DRAWINGS.
COLOR SELECTION MISTED ZEPHYR 4843-60 GRAY FABRIC 6129-58 MISTED ZEPHYR 4843-60	<ul> <li>B. EDUCATION CASEWORK FINISHES ARE AS FOLLOWS:</li> <li>HIGH PRESSURE PLASTIC LAMINATE COUNTERTOPS AND WORKSURFACES ARE TO BE PL-1, UNLESS OTHERWISE NOTED.</li> <li>HIGH PRESSURE PLASTIC LAMINATE CABINETS/VERTICAL SURFACES ARE TO BE PL-2, UNLESS OTHERWISE NOTED.</li> <li>INTERIOR MELAMINE TO BE WHITE</li> <li>3MM AND 1MM PVC EDGES ON COUNTERTOPS AND WORKSURFACES ARE TO MATCH PL-1.</li> <li>3MM AND 1MM PVC EDGES ON CASEWORK ARE TO MATCH PL-2.</li> <li>HANDLES TO BE BRUSHED CHROME.</li> <li>HINGES TO BE BRUSHED CHROME.</li> <li>GROMMETS - SUBMIT SAMPLES FOR APPROVAL.</li> </ul>
COLOR SELECTION CAMEO WHITE	C. REFER TO ARCHITECTURAL SERIES FOR FIRE EXTINGUISHER CABINET PLACEMENTS (A1) AND DETAILS (A5).
	LAMINATE (BALANCED CONSTRUCTION) SEE SPECS. AS REQUIRED W/ RADIUS FRONT EDGE
	3MM PVC EDGING W/ BEVELED EDGE 3MM PVC EDGING W/ BEVELED EDGE 3MM PVC EDGING W/ BEVELED EDGE 3MM PVC EDGING W/ BEVELED EDGE 3/4" PARTICLEBOARD W/ LAMINATE (BALANCED CONSTRUCTION) SEE SPECS.
ALL CORRIDOR LOCKERS ARE TO BE A CUSTOM COLOR (IF REQUIRED) TO MATCH EXISTING LOCKERS. ARCHITECT TO CHOOSE FROM STANDARD FINISHES FOR LOCKERS WITHIN ROOM LOCATIONS.	BASE CABINET
COLOR SELECTION	BELOW TYPICAL COUNTERTOP TYPICAL COUNTERTOP
ARCHITECT TO CHOOSE FROM MANUF. STANDARDS	SCALE: 1"=1'-0" NOTE: PLASTIC LAMINATE SHELF SHALL BE BY EDUCATIONAL CASEWORK INSTALLER FASTEN SHELF AT BACK AND SIDES AS REQUIRED 1'-6" PLASTIC LAMINATE OVER 3/4" PARTICLE BOARD
COLOR SELECTION ARCHITECT TO CHOOSE FROM MANUF. STANDARDS	PLASTIC LAMINATE GUSSET BOARD (2'-0" O.C.) TO MATCH SHELF WITH PLASTIC LAMINATE WALL BRACKET TO MATCH GUSSET BOARD
Image: Constrained state stat	CLEAR SEALANT OPEN WALL CABINET WITH ONE ADJUSTABLE SHELF (PL-2) OPEN WALL CABINET WITH ONE ADJUSTABLE SHELF (PL-2) CLEAR SEALANT PROVIDE GROMMETS AT EACH KNEE SPACE OR AT 3:0° O.C. STEEL UNDERCOUNTER SUPPORT BRACKET AS REQUIPED TO BRACKET AS REQUIPED TO BRACKET SHALL BE WHITE WITH 9'X3° CLICAT SHALL SHALL BE WHITE WITH 9'X3° CLICAT SHALL SHAL
	4 TYPICAL CAD LAB WORKSTATION SCALE: 1/2" = 1'-0"

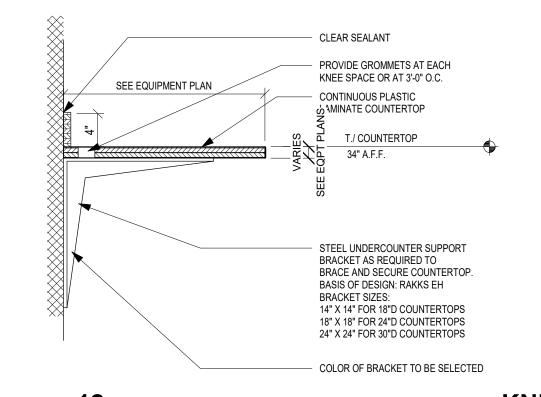





12 _____




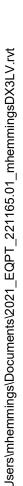


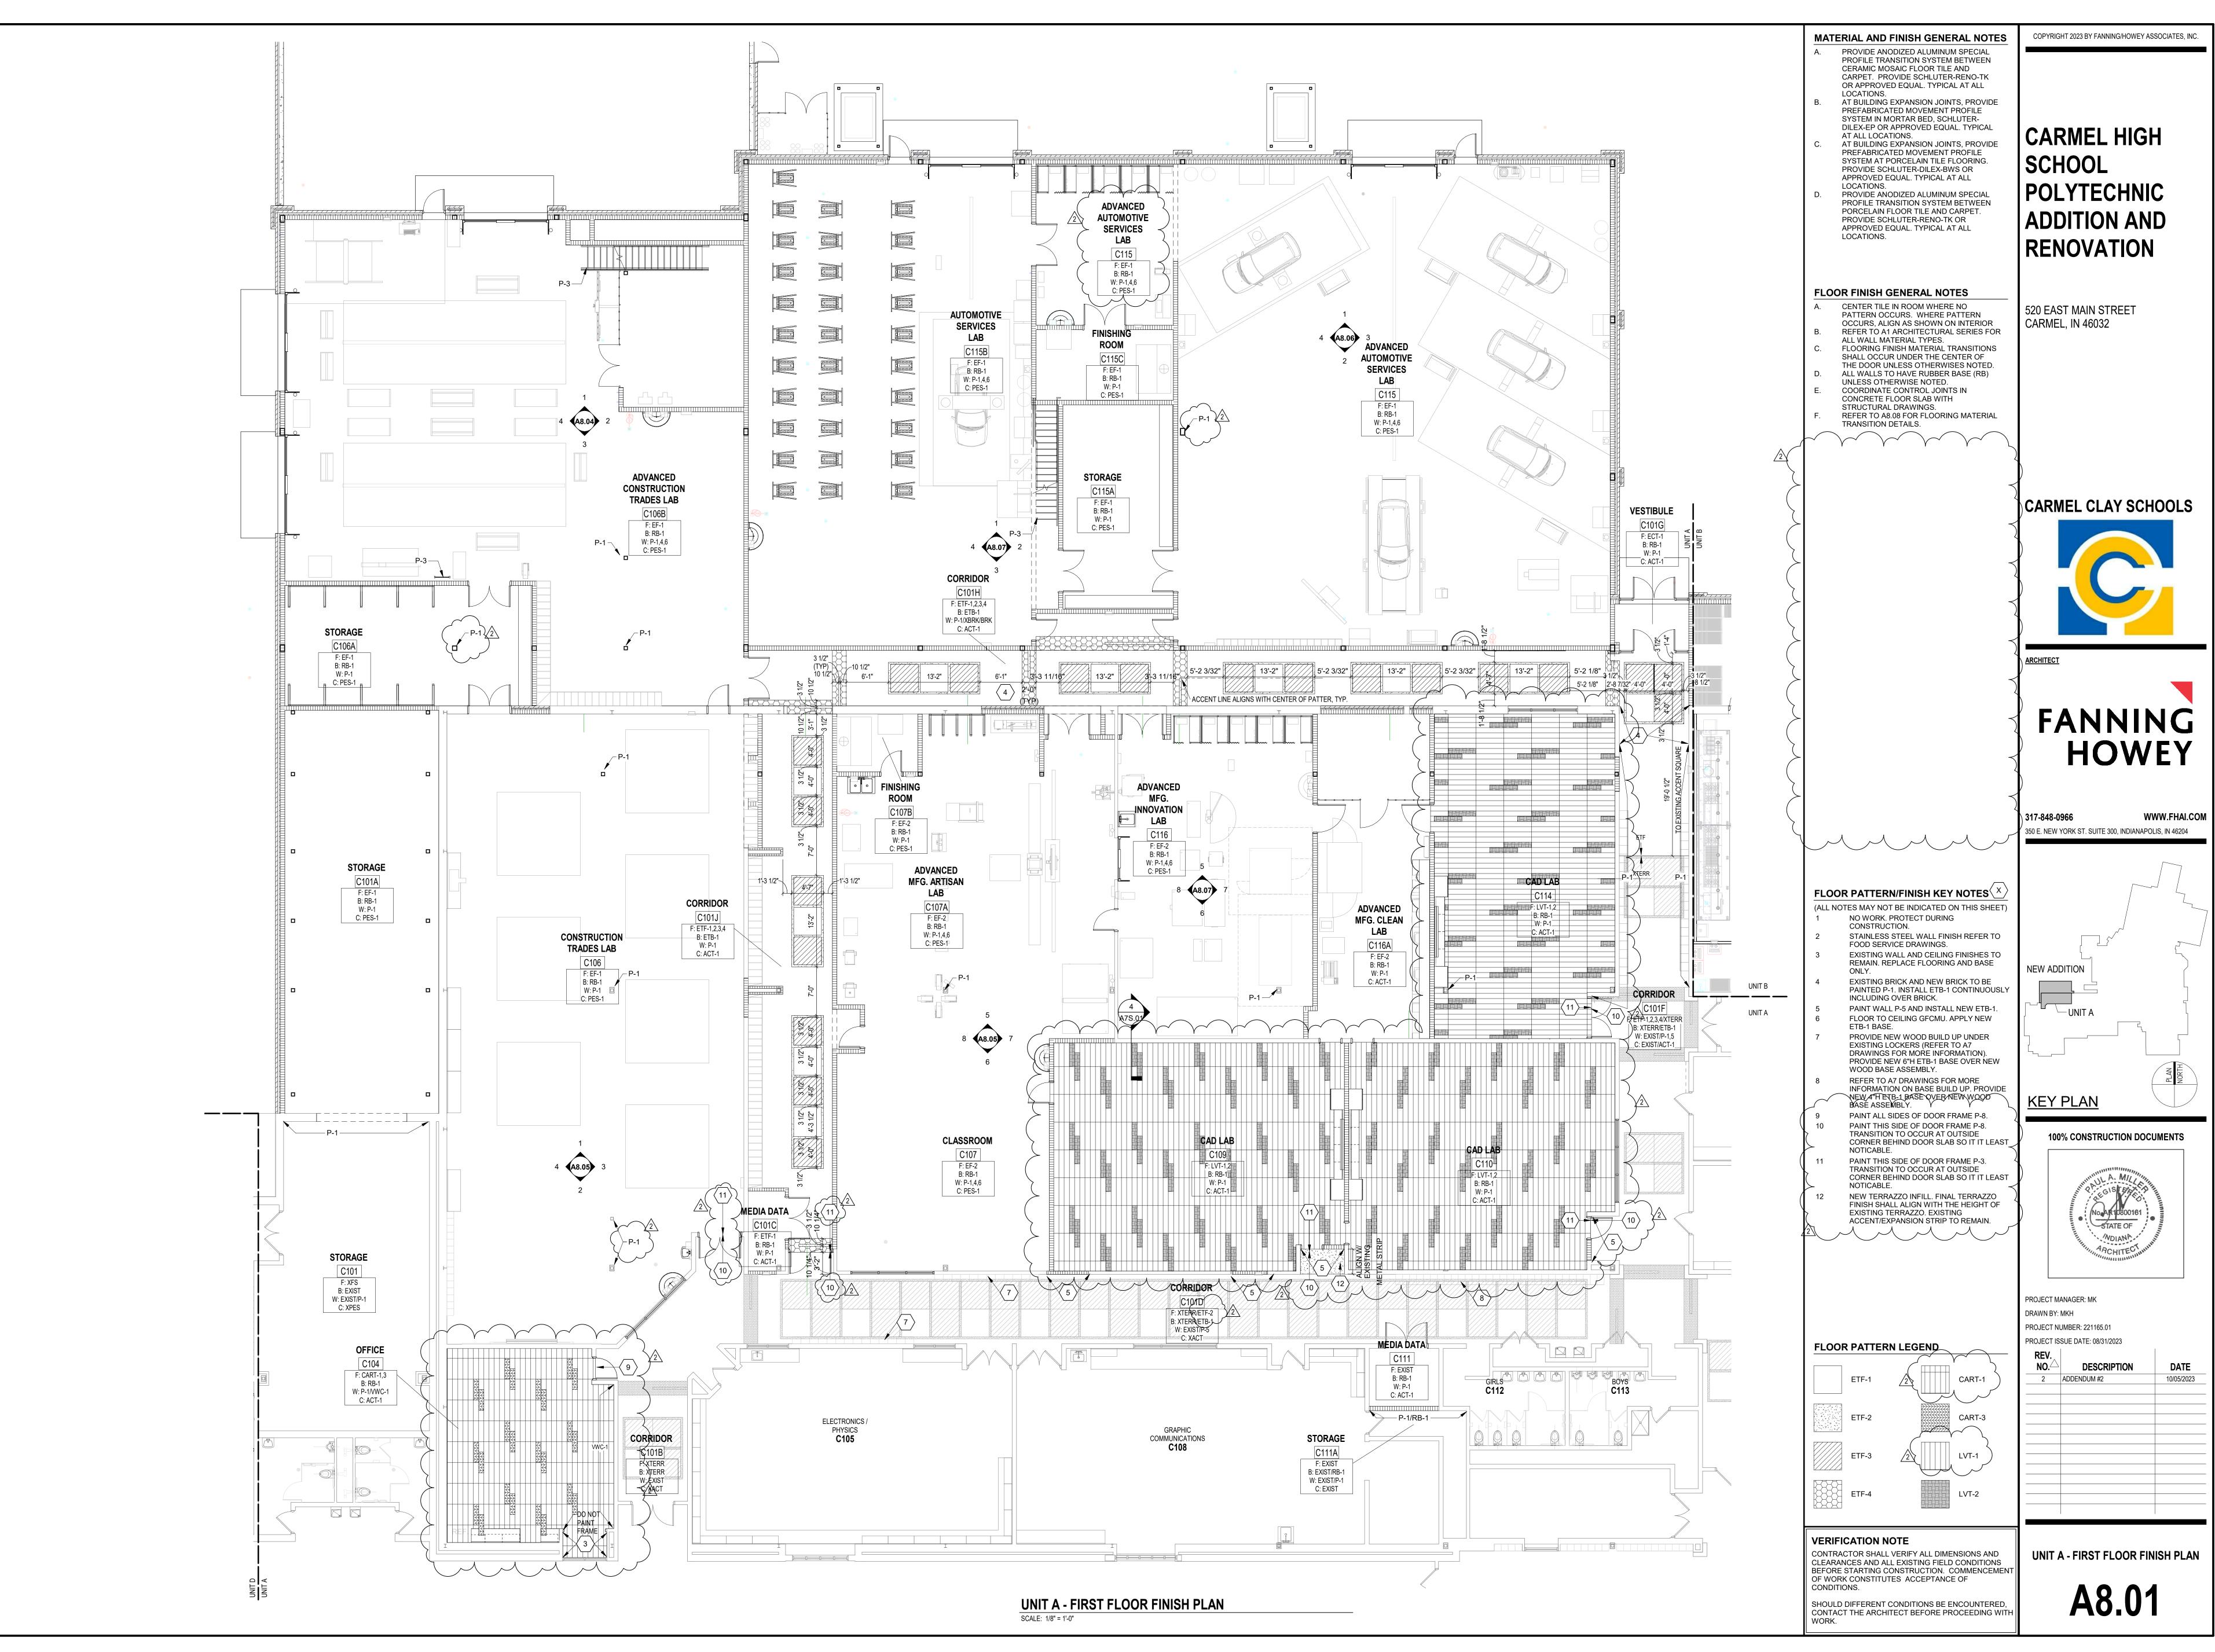

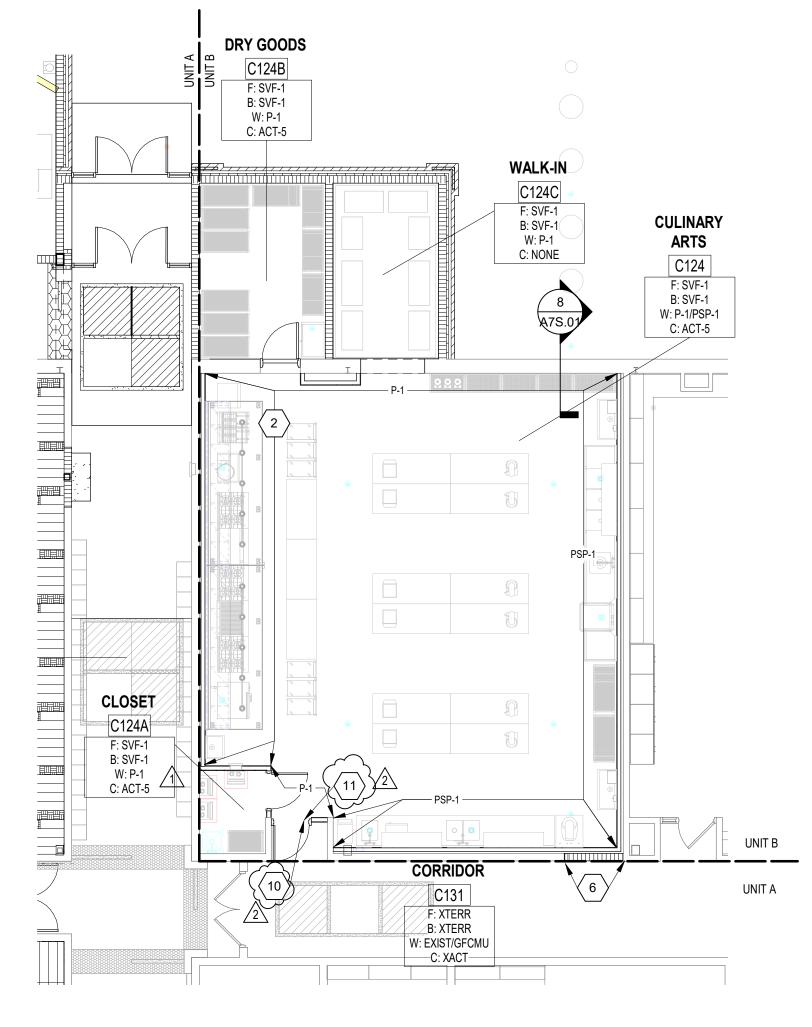


**UNIT B - FIRST FLOOR FINISH PLAN** SCALE: 1/8" = 1'-0"

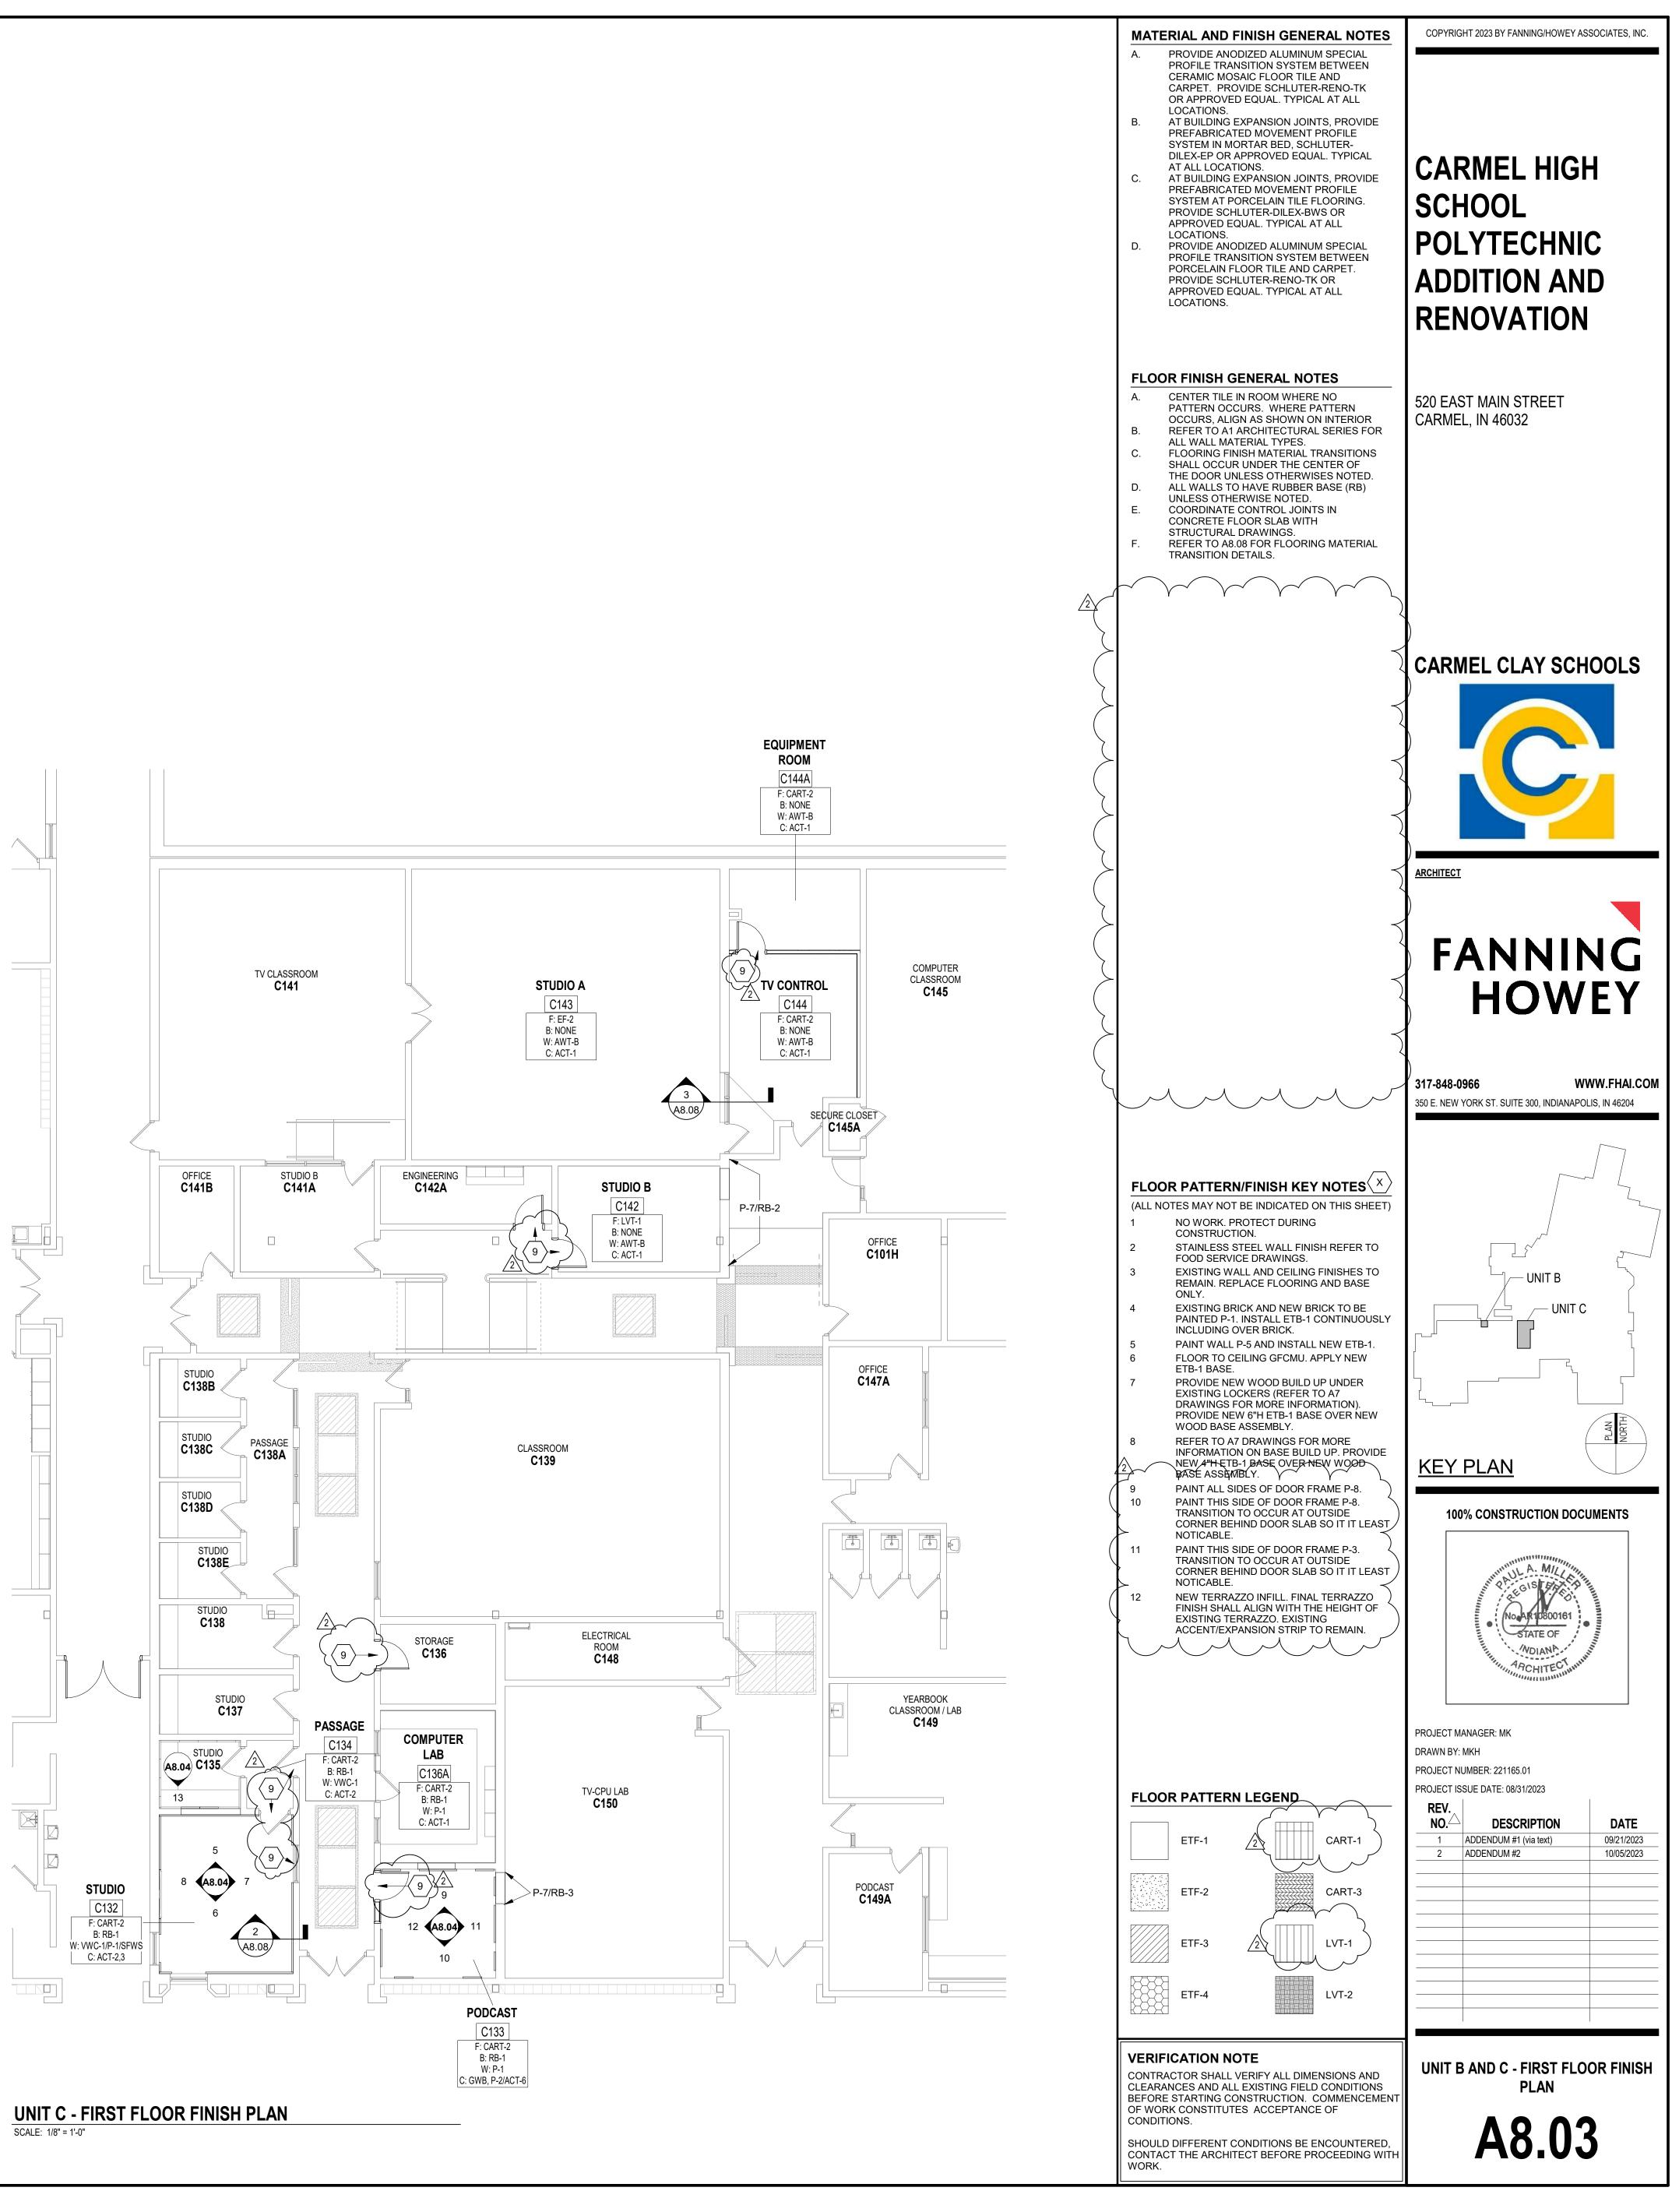


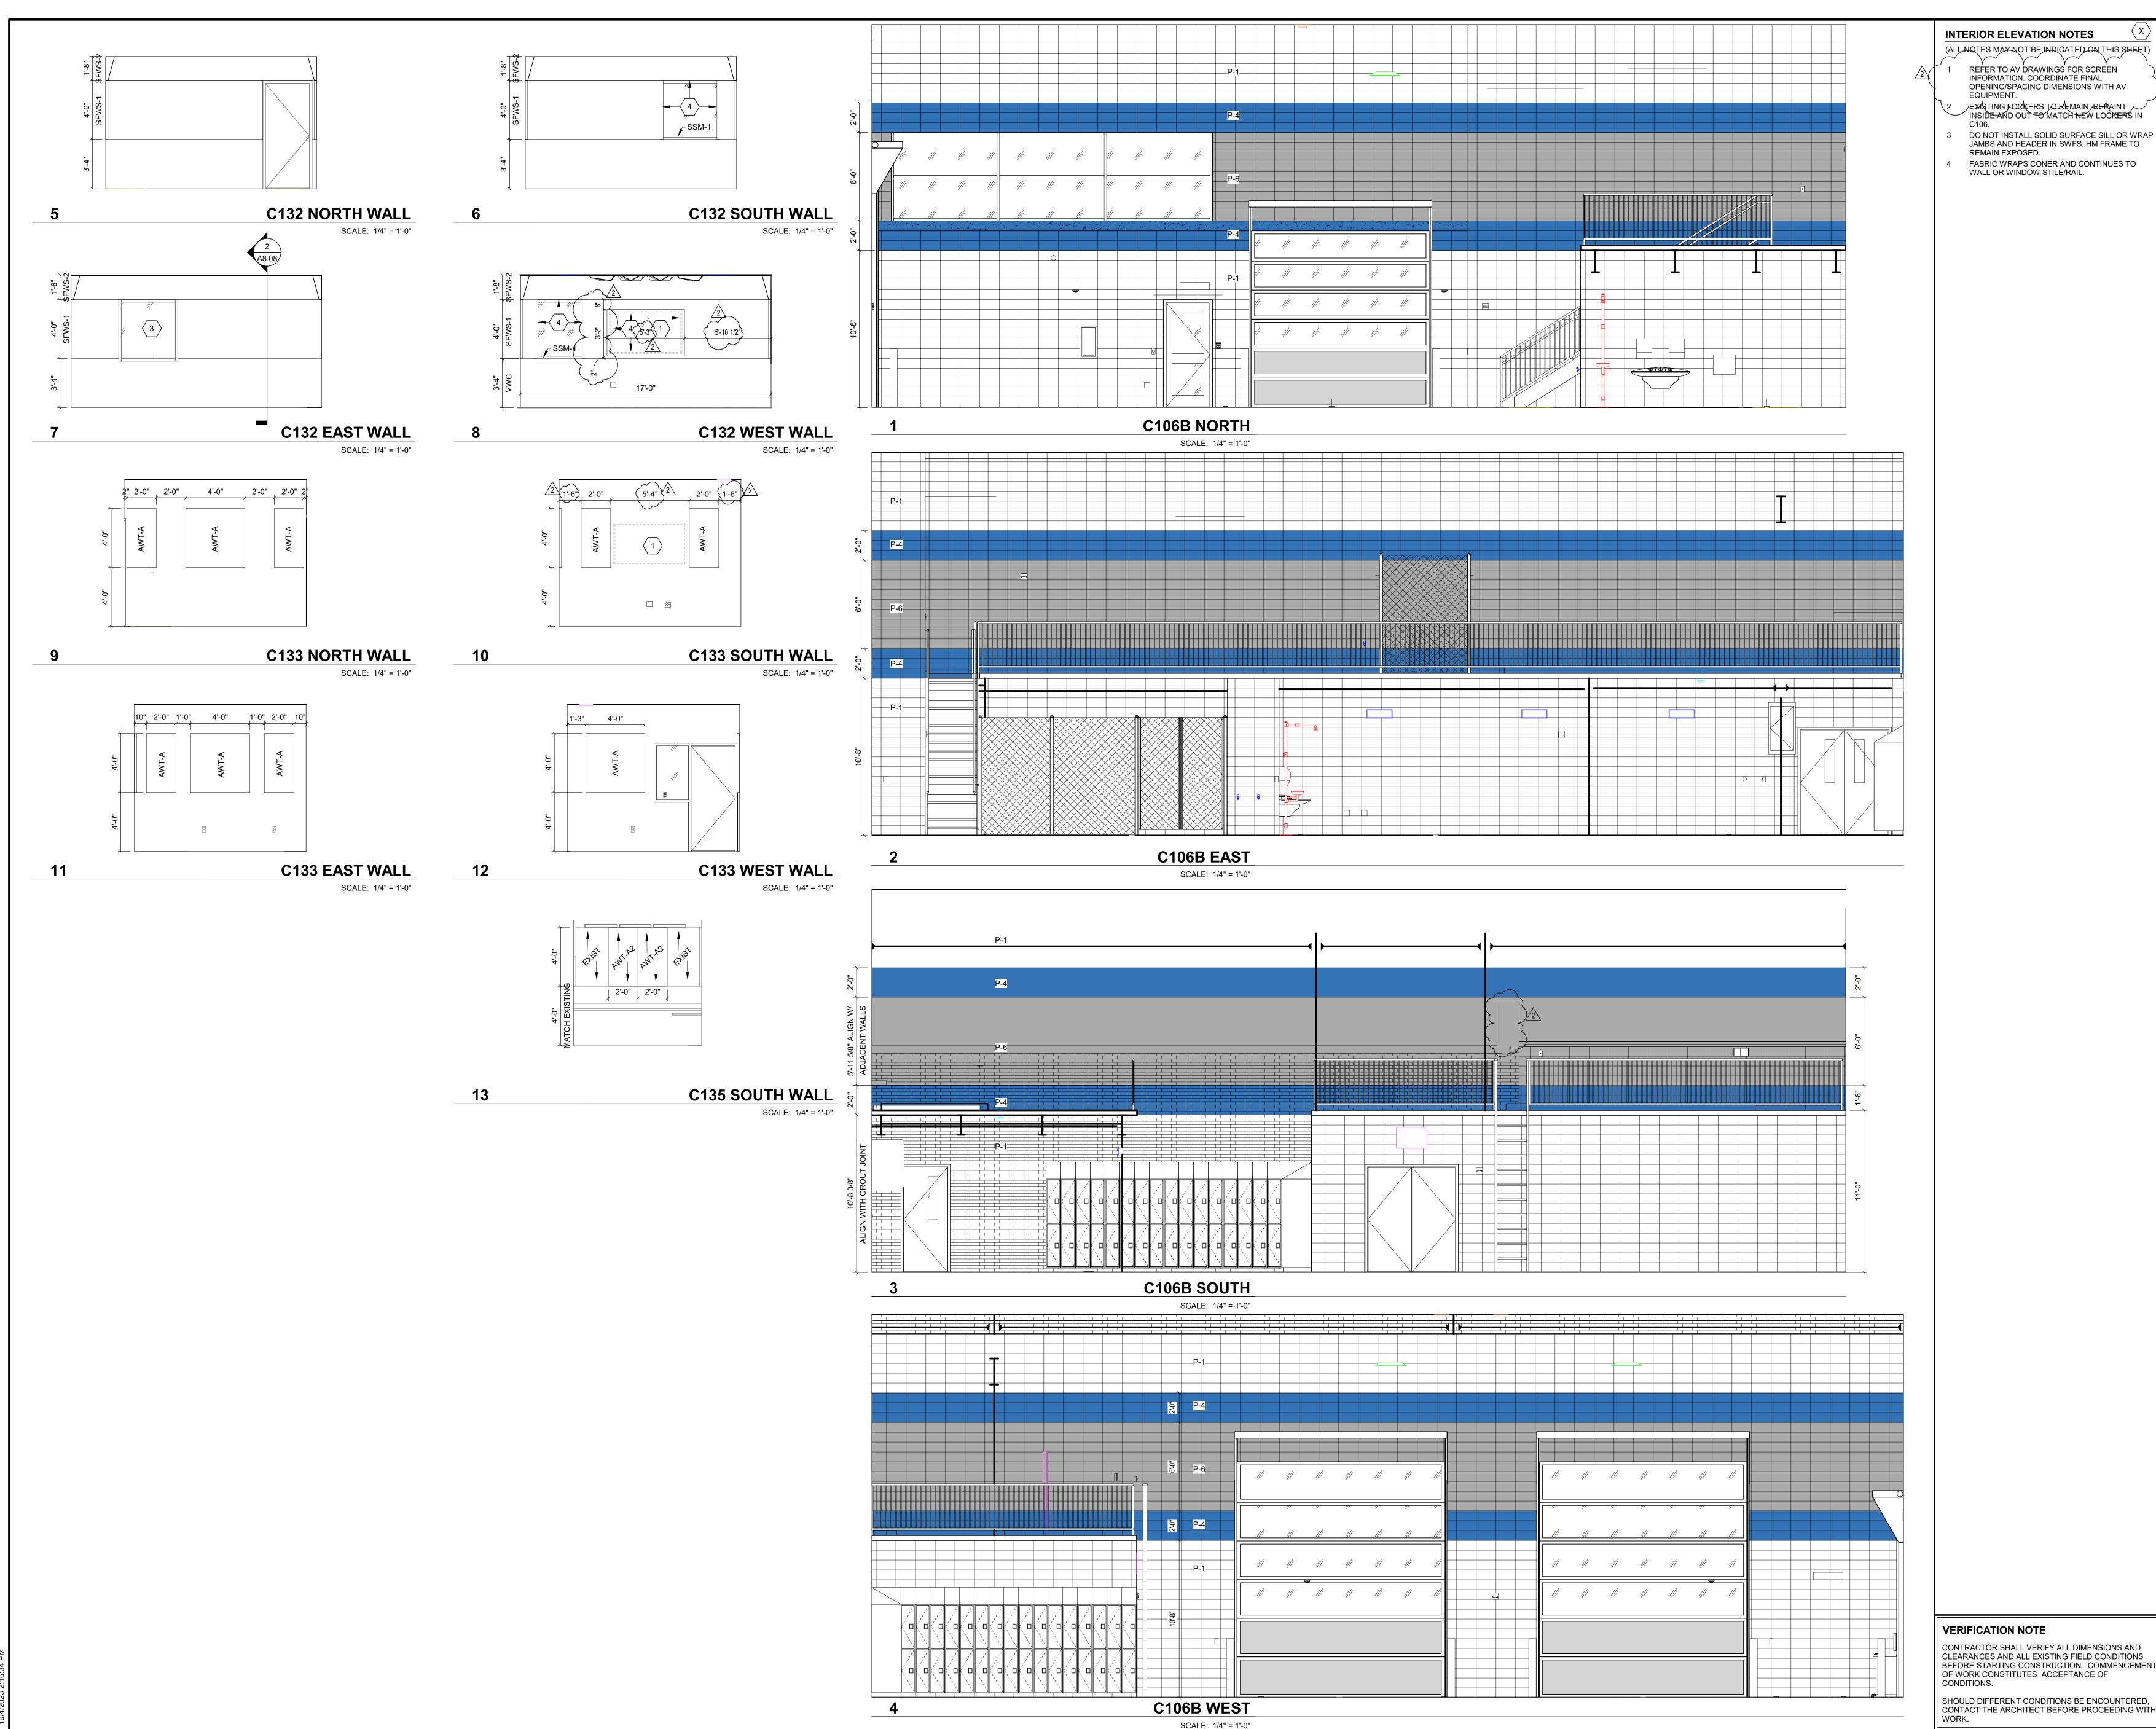

SHOULD DIFFERENT CONDITIONS BE ENCOUNTERED, CONTACT THE ARCHITECT BEFORE PROCEEDING WITH

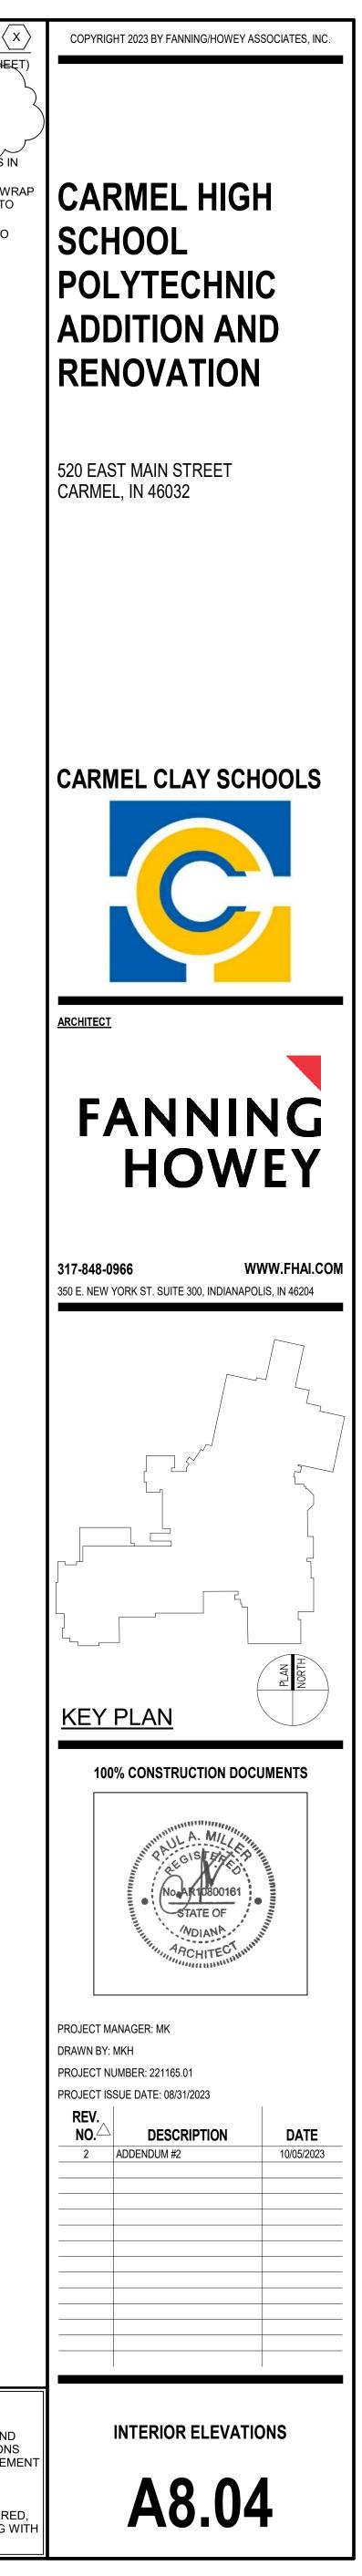

CONTRACTOR SHALL VERIFY ALL DIMENSIONS AND CLEARANCES AND ALL EXISTING FIELD CONDITIONS BEFORE STARTING CONSTRUCTION. COMMENCEMENT OF WORK CONSTITUTES ACCEPTANCE OF

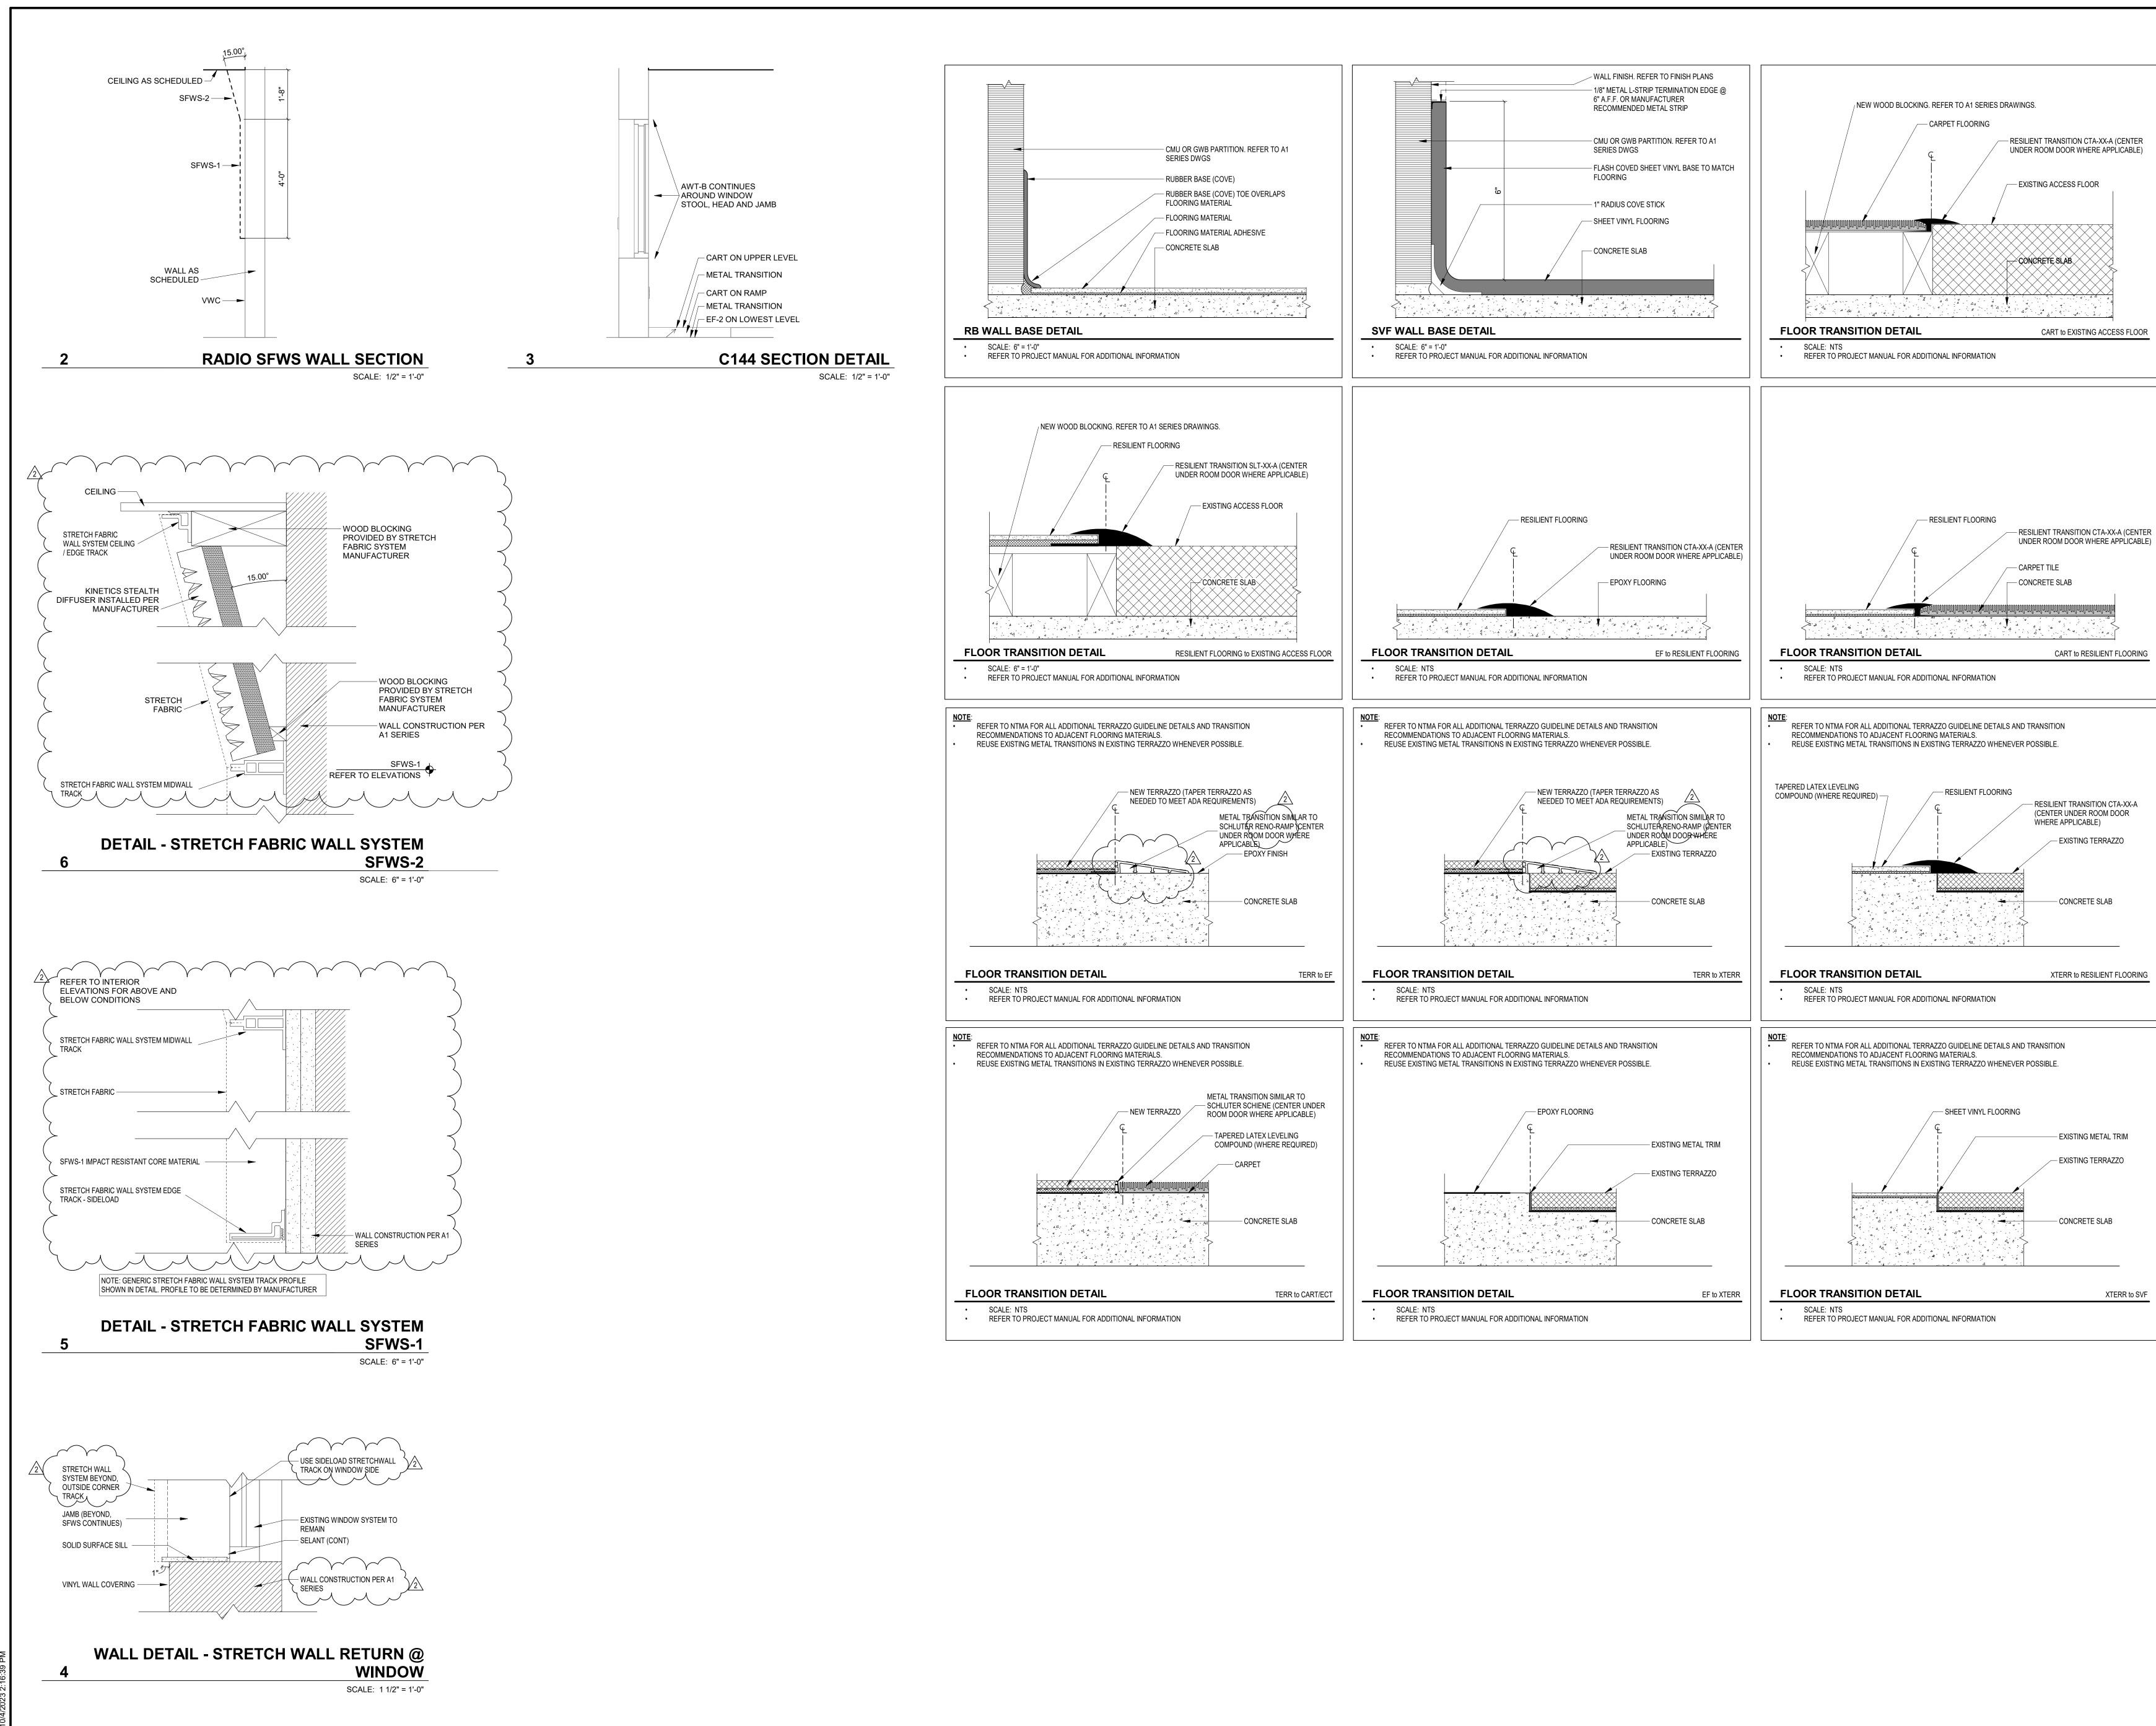




	FLOOR MA	TE
1	CARPET TILE	
	MATERIAL ABBREVIATION CART-1 CART-2 CART-3	MAT SHAV J+J - SHAV
/2	ALL SPECIFIED MANUFACT ALL CARPET BACKING TO F	
	ENTRY CARPET TILE	
I	MATERIAL ABBREVIATION ECT-1	MAT INTE
	EPOXY TERRAZZO FI	OOR
	MATERIAL ABBREVIATION ETF-1 (GRAY)	MAT REFE
	ETF-2 (BLUE)	REF
	ETF-3 (WHITE)	REF
	ETF-4 (RED)	REF
	<ul> <li>REFER TO SPECIFICATION</li> <li>MANUFACTURER TO SUBM</li> </ul>	
	EPOXY FLOORING	
	MATERIAL ABBREVIATION	MAT
	EF-1 EF-2	REFE REFE
	FLOOR SEALER	
	MATERIAL ABBREVIATION	MAT
1	FS-1	REF
	LUXURY VINYL TILE	
	MATERIAL ABBREVIATION	MAT
	LVT-1 LVT-2	JJ FL JJ FL

SHEET VINYL FLOO	RING
MATERIAL ABBREVIATION	МАТ
SVF-1	ALT


BASE	MA	7	Έ	F

EPOXY TERRAZZO E	BASE
MATERIAL ABBREVIATION	МА
ETB-1	REF
RESILIENT BASE	
MATERIAL ABBREVIATION	МА
RB-1 RB-2 RB-3	JOH JOH
SHEET VINYL FLOOF	RING
MATERIAL ABBREVIATION	МАТ
SVF-1	ALTF

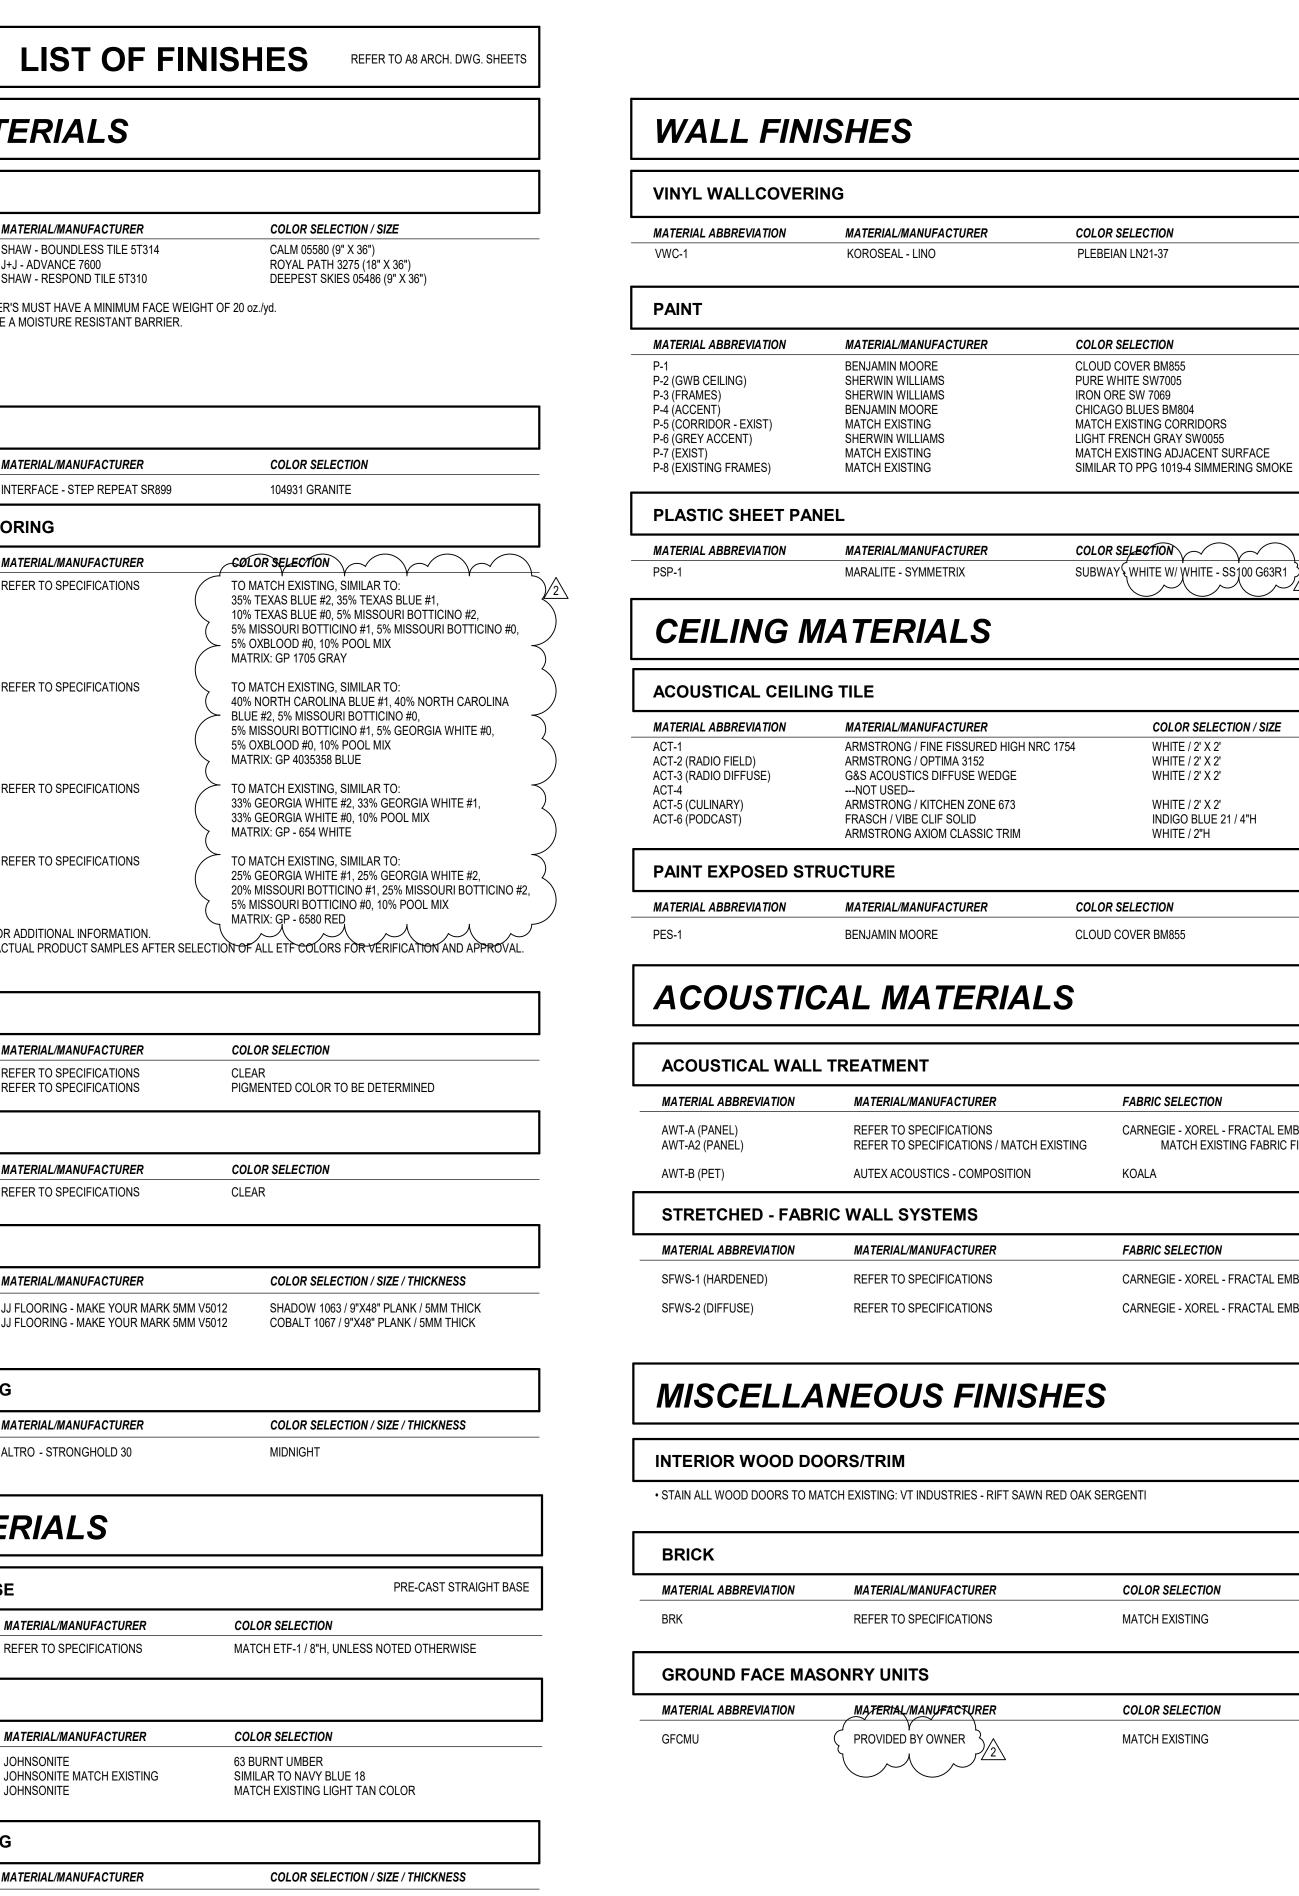

TRO - STRONGHOLD 30

MIDNIGHT, 6"H

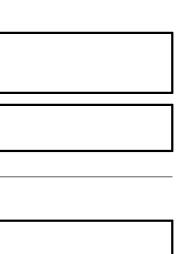

**COLOR SELECTION / SIZE** 

INDIGO BLUE 21 / 4"H

CARNEGIE - XOREL - FRACTAL EMBOSS 6261 W768 MATCH EXISTING FABRIC FINISH

CARNEGIE - XOREL - FRACTAL EMBOSS 6261 W768 CARNEGIE - XOREL - FRACTAL EMBOSS 6261 W768

# MATERIAL & FINISH GENERAL NOTES

GENERAL A. REFER TO FINISH PLAN DRAWINGS AND DETAILS (A8 SERIES) FOR MATERIALS, PATTERNS AND COLORS. B. REFER TO A7S.01 LIST OF FINISHES FOR ADDITIONAL FINISHES NOT NOTED ON THIS SHEET.

- **FLOORING** A. CENTER FLOORING TILE AND PATTERN IN ROOM UNLESS OTHERWISE INDICATED ON FINISH PLANS. ALIGN EDGE OF FINISHED FLOOR MATERIAL WITH EDGE OF WALL OR CASEWORK.
- FLOOR FINISH MATERIAL TRANSITIONS SHALL OCCUR UNDER THE CENTER OF THE DOOR UNLESS OTHERWISE INDICATED, WHERE THE FLOORING MATERIAL CHANGES FROM ROOM TO ROOM.
- EXTEND FLOOR MATERIAL AND PATTERN UNDER ALL OPEN TO THE FLOOR CASEWORK AND FURNITURE. COORDINATE CONTROL JOINTS IN CONCRETE SLAB WITH STRUCTURAL DRAWINGS AND FINISH FLOORING
- INSTALLER. REFER TO FLOOR PLANS, RESTROOM ENLARGED PLANS, PLUMBING DRAWINGS, ETC. FOR FLOOR DRAIN LOCATIONS.
- AT BUILDING EXPANSION JOINTS (IF APPLICABLE) PROVIDE PRE-FABRICATED MOVEMENT PROFILE SYSTEM IN G. MORTAR BED. PROVIDE SCHLUTER DILEX-EDP OR APPROVED EQUAL. TYPICAL AT ALL LOCATIONS.

**CARPET TILE** A. CART-1 & 3 TO BE INSTALLED IN BRICK PATTERN. CART-2 TO HAVE ASHLAR INSTALLATION.

ECT-1 TO BE INSTALLED QUARTER TURN.

LUXURY VINYL TILEA.LVT-1&2 TO BE INSTALLED IN 1/3 OVERLAP PATTERN PER MANUFACTURER'S GUIDELINES.

WALL BASEA.DO NOT INSTALL ANY WALL BASE ON NEW OR EXISTING BRICK WALLS, UNLESS NOTED OTHERWISE.

- PAINT & STAIN

   A.
   PAINT ALL WALLS UNLESS OTHERWISE INDICATED ON FINISH PLANS.

   B.
   PAINT ALL WALLS UNLESS OTHERWISE INDICATED ON FINISH PLANS.

   PAINT ONE MOCK-UP CLASSROOM TO RECEIVE ARCHITECT'S APPROVAL PRIOR TO ORDERING PAINT FOR THE
- ENTIRE PROJECT. DO NOT PAINT NEW OR EXISTING BRICK WALLS, UNLESS NOTED OTHERWISE. C.

# PAINT TYPE GENERAL NOTES


- UNDER SECTION 099123 INTERIOR PAINTING, PAINT EXPOSED PIPES, DUCTWORK, BREACHING, CONDUIT, INSULATED PIPES, CONDUIT HANGERS, SUPPORTS, BRACING, ETC., WHICH OCCURS IN SPACES DESIGNATED TO BE PAINTED IN PART OR WHOLE. ALL GYPSUM BOARD WALLS SHALL BE PAINTED WITH INTERIOR PAINT TYPE #9.23 (SEMI-GLOSS), UNLESS OTHERWISE INDICATED. ALL GYPSUM BOARD WALLS FROM 10'-0"A.F.F. TO CEILING SHALL BE PAINTED WITH INTERIOR PAINT TYPE #9.23 (SEMI-GLOSS)
- UNLESS OTHERWISE INDICATED. ALL GYPSUM BOARD CEILINGS AND SOFFITS SHALL BE PAINTED WITH PAINT TYPE #9.21 (FLAT) UNLESS OTHERWISE INDICATED. ALL GTPSOM BOARD CEILINGS AND SOFFTS SHALL BE PAINTED WITH PAINT TYPE #9.21 (PLAT) UNLESS OTHERWISE INDICA PAINT ALL NON-INTEGRALLY COLORED CMU WALLS WITH INTERIOR PAINT TYPE #4.14 (SEMI-GLOSS), UNLESS OTHERWISE
  - INDICATED. ALL EXPOSED STEEL COLUMNS SHALL BE PAINTED WITH PAINT CODE #5.221 (EPOXY-GLOSS). REFER TO SECTION 099600 - HIGH PERFORMANCE COATINGS.
  - ALL FERROUS METAL (EXCLUDING STRUCTURE) SHALL BE PAINTED INTERIOR PAINT TYPE #5.223 (GLOSS). ALL GALVANIZED METÀL (EXCLUDING STRUCTURE) SHALL BE PAINTED INTERIOR PAINT TYPE #5.322 (SEMI-GLOSS).
  - ALL EXPOSED STEEL (FERROUS) STRUCTURE SHALL BE PAINTED INTERIOR PAINT TYPE #5.11. ALL EXPOSED GALVANIZED-METAL STRUCTURE SHALL BE PAINTED INTERIOR PAINT TYRE #5.311. IN ALL ROOMS PAINT WITH PAINT CODE #4.14 (QMU WALLS, SEMI-GLOSS) OK #9.23 (GYPSVM BOARD WALLS, SEMI-GLOSS) IN ROOMS: C101, C106, C106A, C106B, C101J, C101D, C101F, C101H, C115A, C115B, C115C, C115, C101G, C107A, C107B, C116, C116A,
  - C124, C124A PAINT WITH PAINT CODE #4.223 (CMU SEMI-GLOSS), #4.122 (CLAY-MASONRY SEMI-GLOSS), #9.212 (GYPSUM BOARD AND PLASTER SEMI-GLOSS). REFER TO SECTION 099600 - HIGH PERFORMANCE COATINGS


PAINT COLOR GENERAL NOTES

- PAINT ALL GWB SOFFITS P-1 UNLESS OTHERWISE NOTED ON FINISH PLANS OR INTERIOR ELEVATIONS. PAINT ALL SIDES (HORIZ. AND VERT.) OF SOFFIT INDICATED COLOR, UNLESS OTHERWISE NOTED.
- ALL INTERIOR HOLLOW METAL FRAMES AND DOOR FRAMES TO BE PAINTED P-3 UNLESS OTHERWISE NOTED. ALL METAL HANDRAILS AND STAIR STRINGERS TO BE PAINTED P-3 UNLESS OTHERWISE NOTED. DO NOT PAINT ANODIZED ALUMINUM RAILINGS.
- PAINT ANY METAL COLUMNS THE COLOR OF ADJACENT WALL UNLESS OTHERWISE NOTED. PAINT ALL GYPSUM WALL BOARD CEILINGS P-2, UNLESS OTHERWISE NOTED.





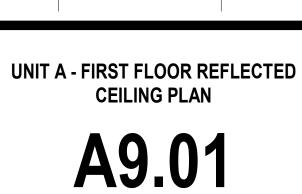

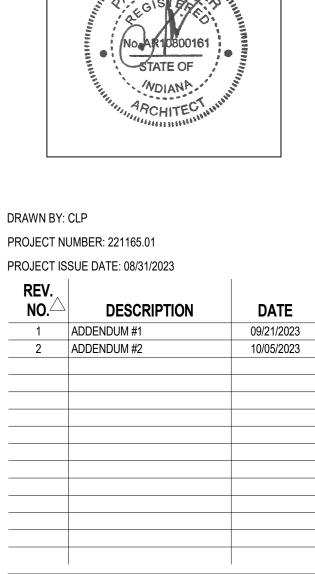

**100% CONSTRUCTION DOCUMENTS** 

NEW ADDITION

<u>KEY PLAN</u>

317-848-0966 WWW.FHAI.COM

350 E. NEW YORK ST. SUITE 300, INDIANAPOLIS, IN 46204



520 EAST MAIN STREET CARMEL, IN 46032

RENOVATION

POLYTECHNIC ADDITION AND


COPYRIGHT 2023 BY FANNING/HOWEY ASSOCIATES, INC.


CARMEL HIGH

SCHOOL


sers\droan\Documents\2021_ARCH_221165.01_droanR3Y2M.rvt

10/4/2023 10:44:48 AM

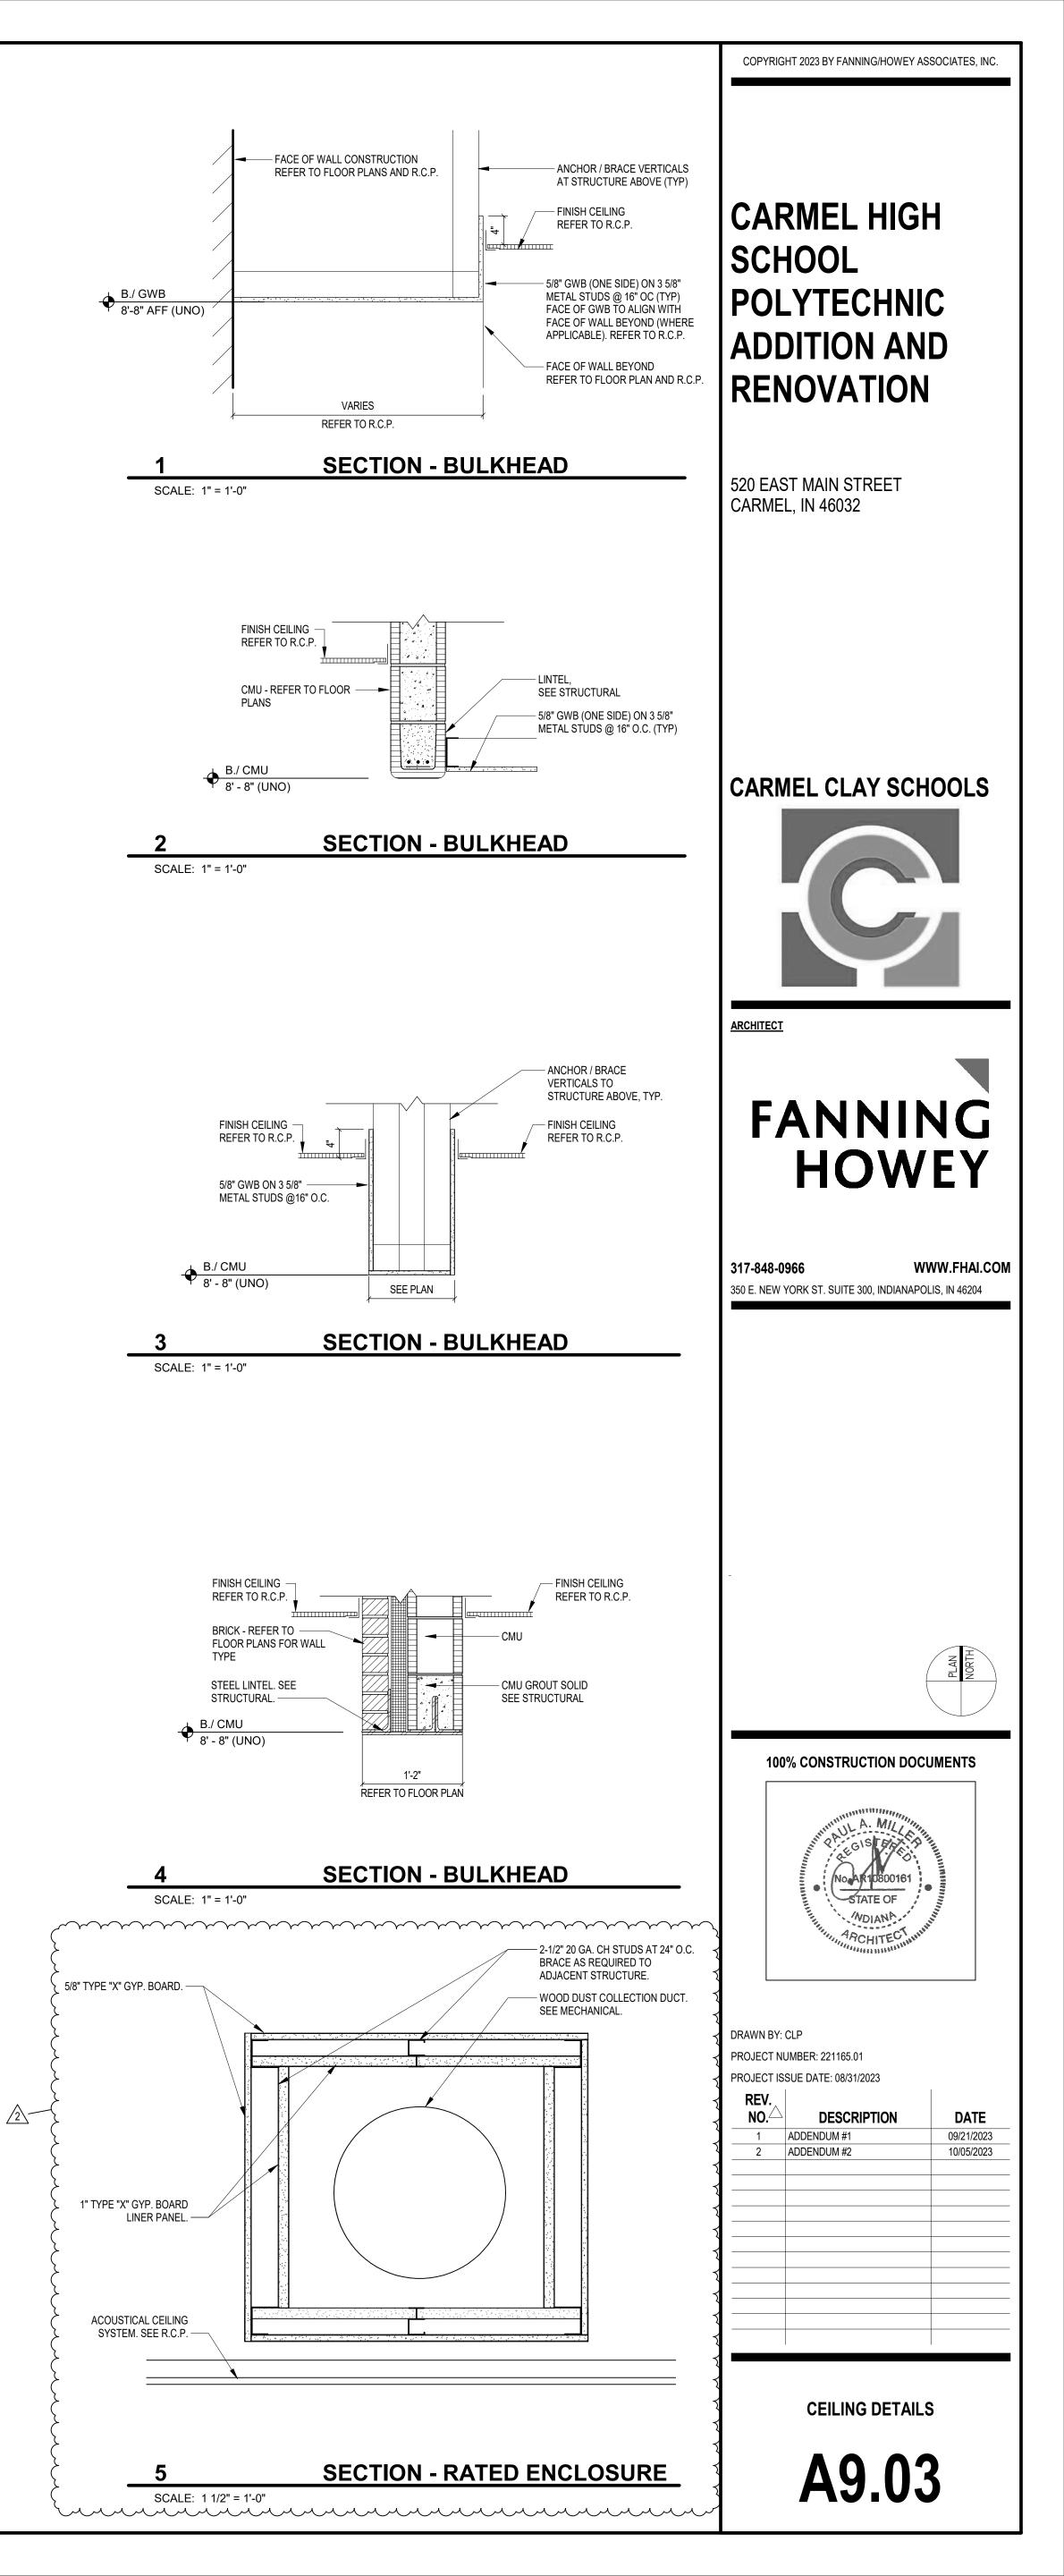

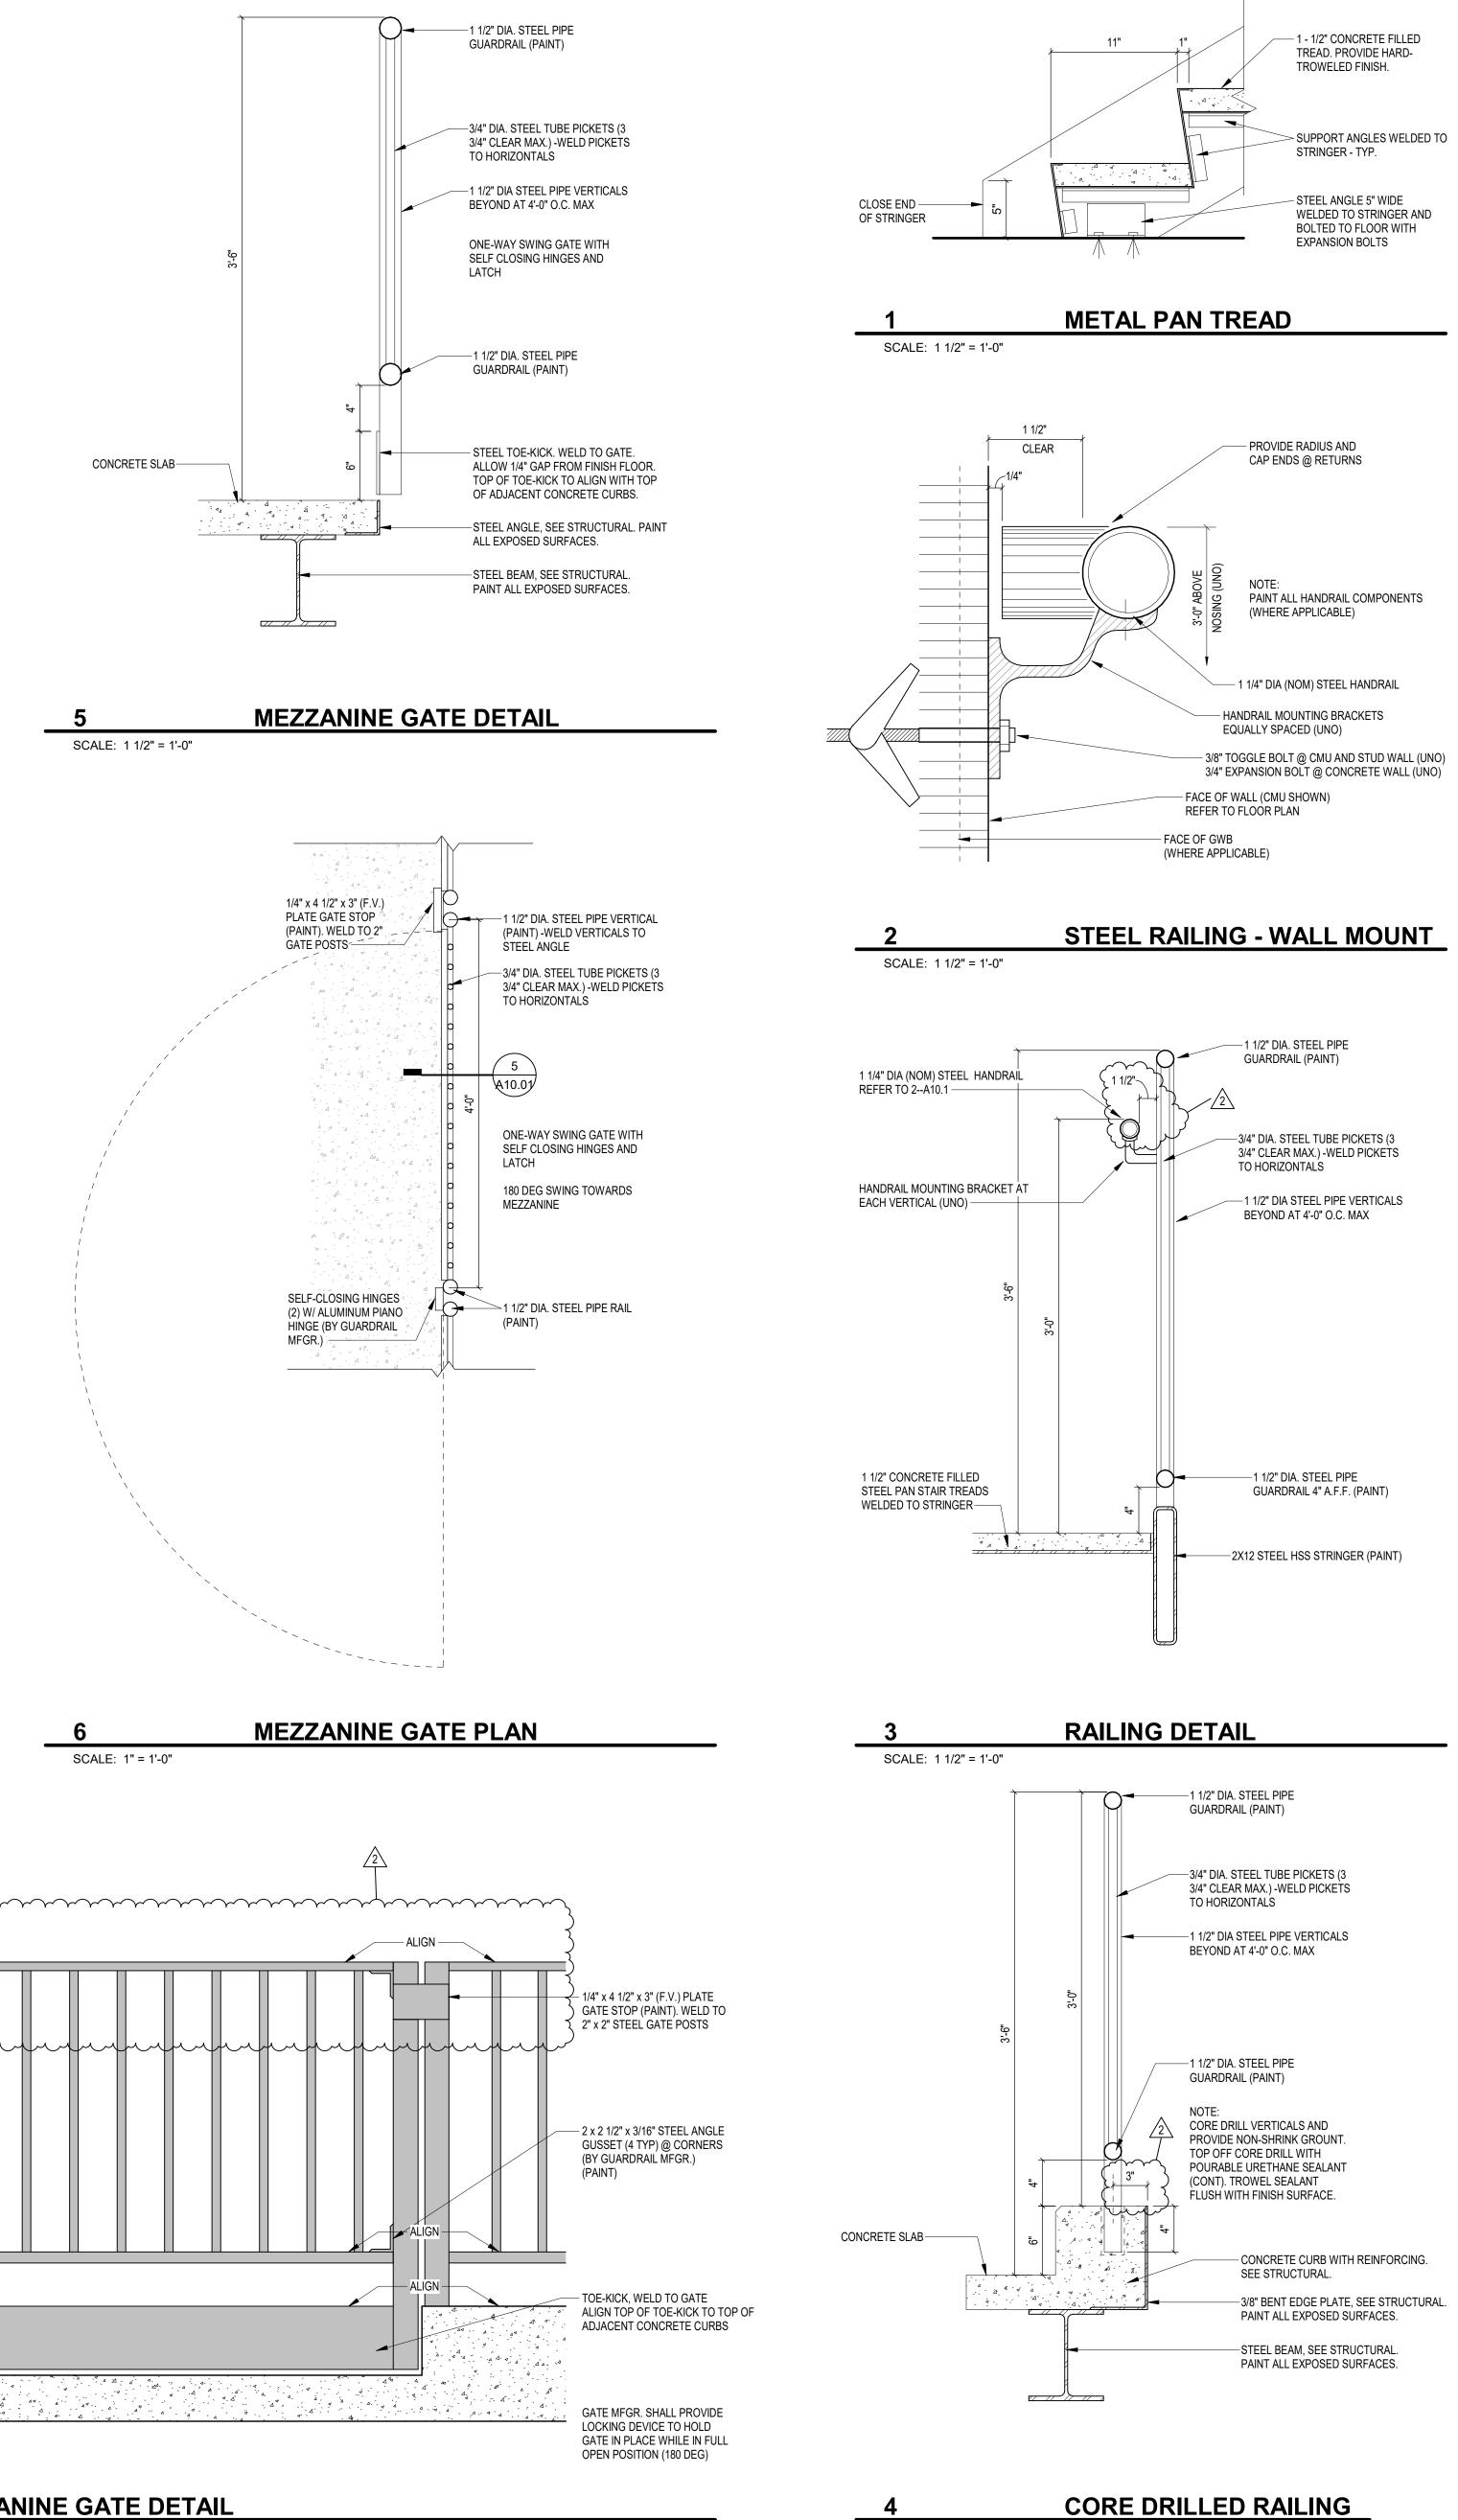


SCALE: 1 1/2" = 1'-0"

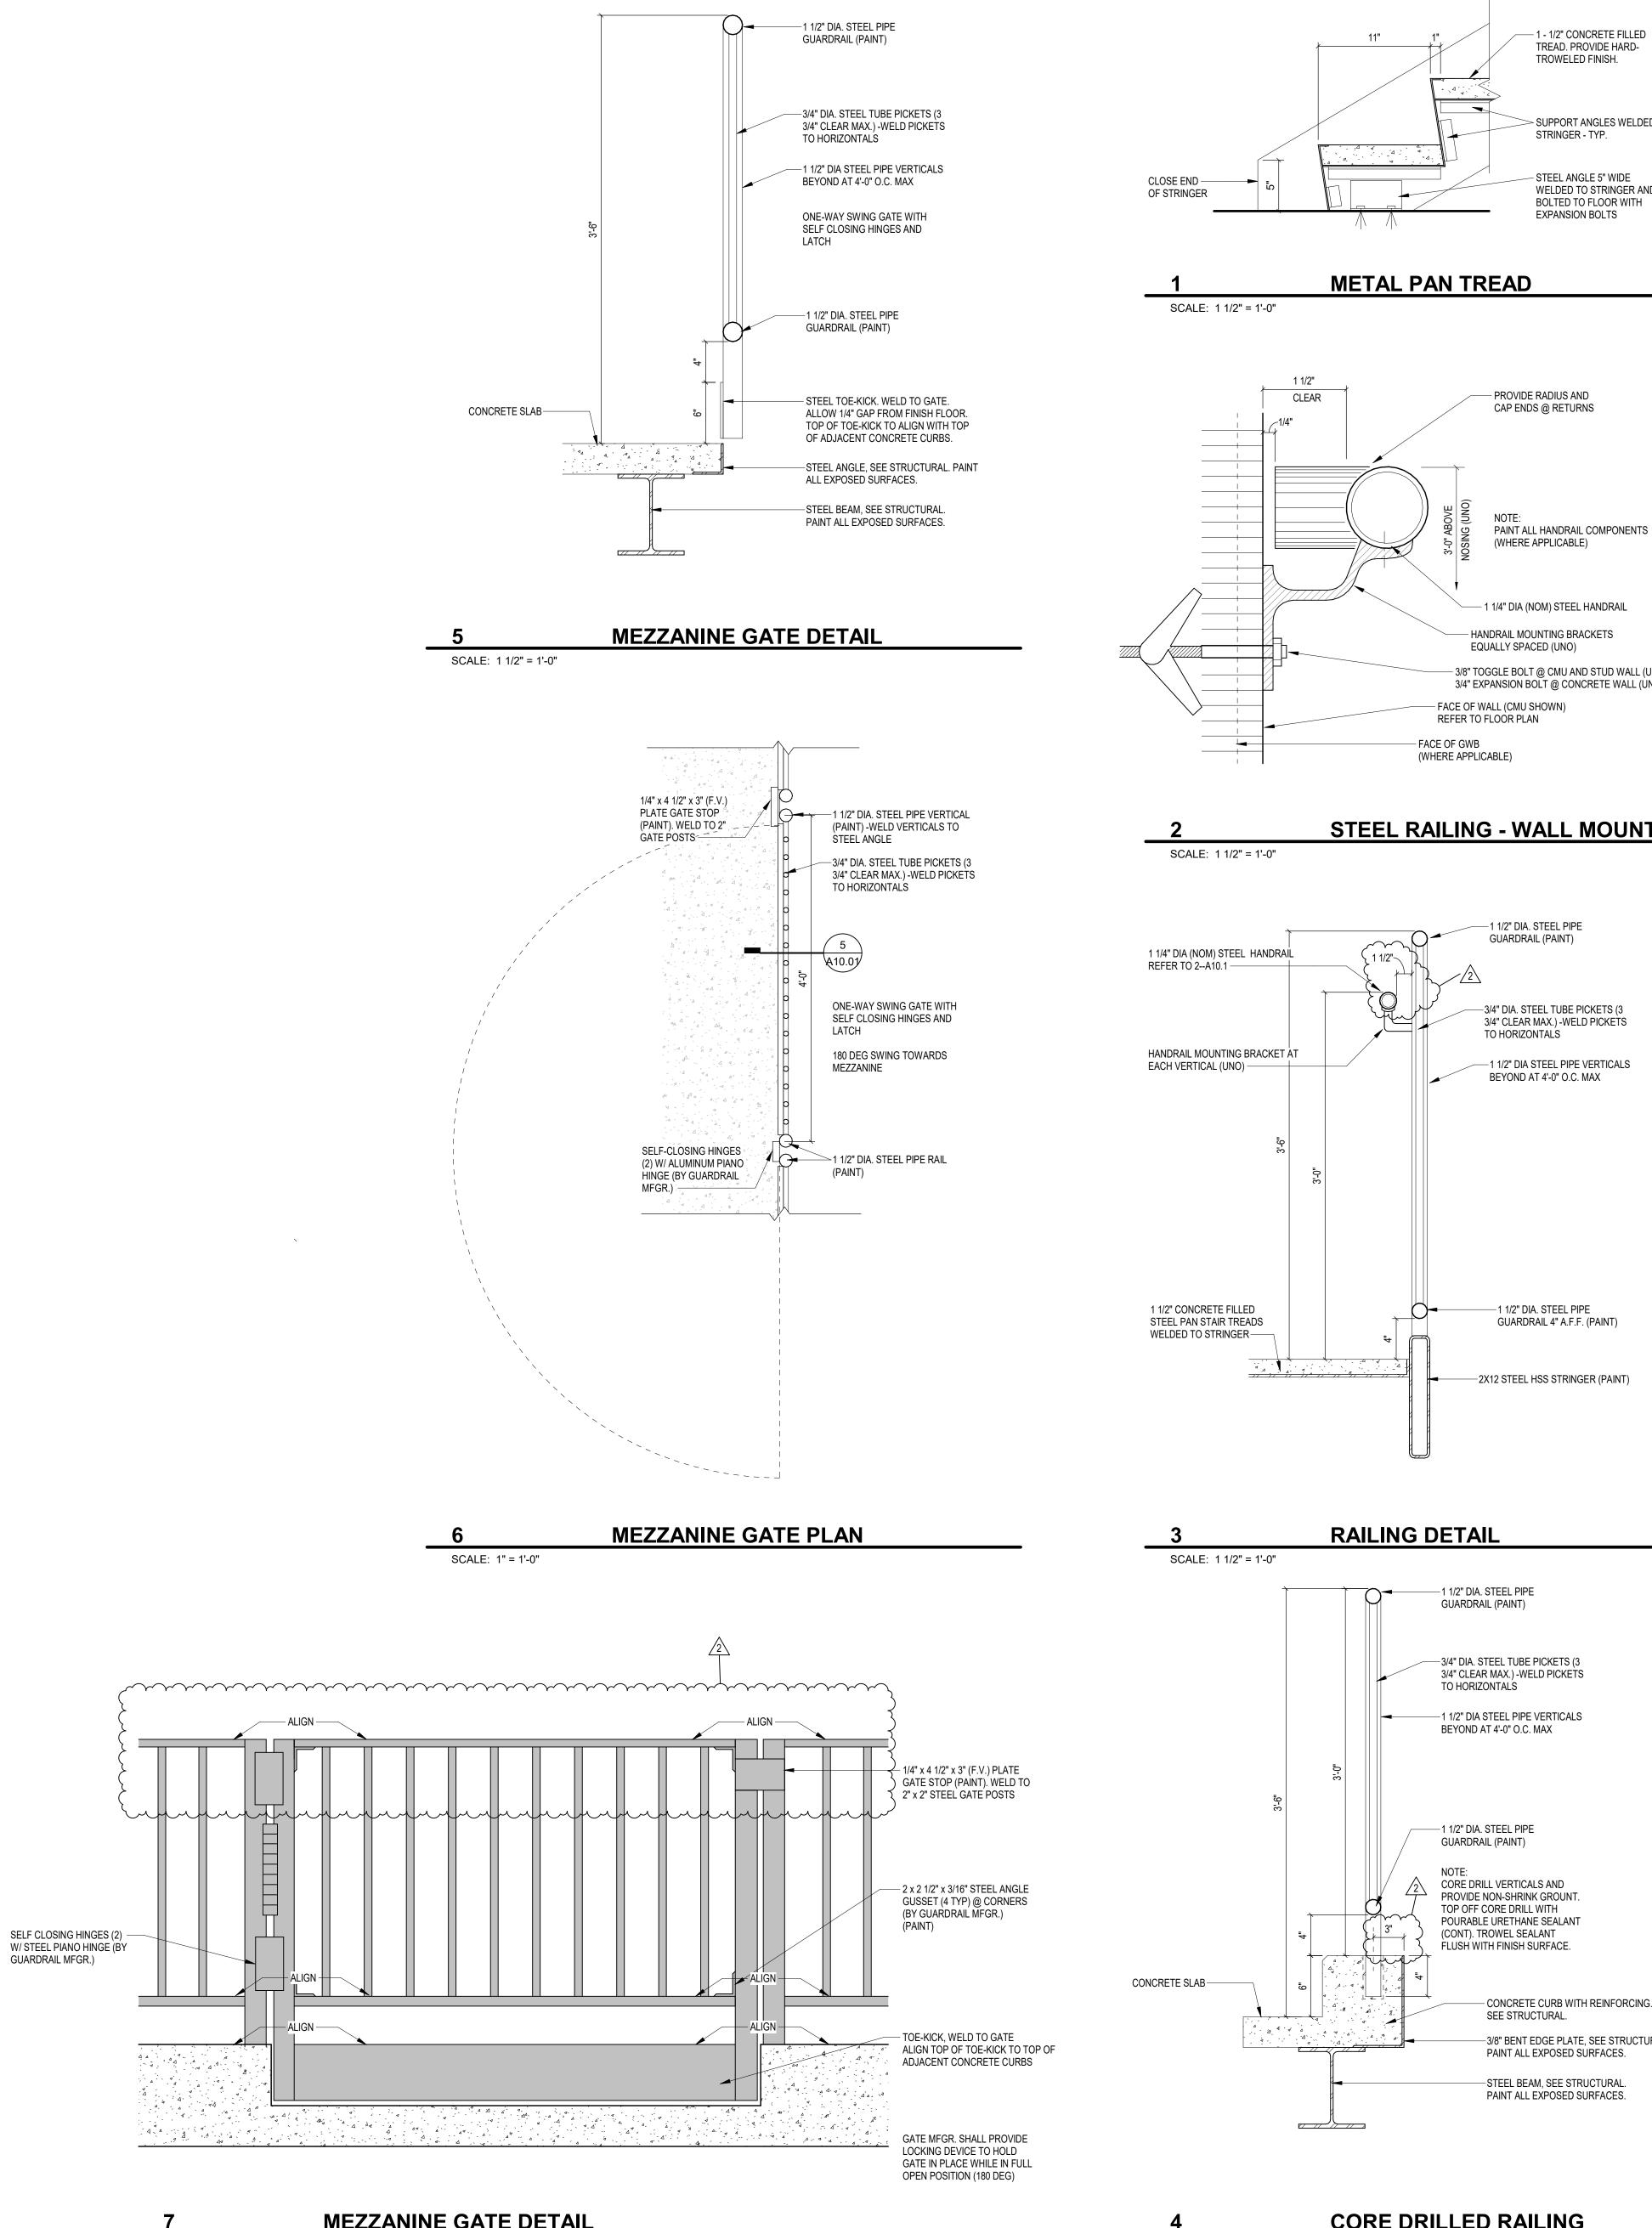


SCALE: 1 1/2" = 1'-0"


**MEZZANINE GATE DETAIL** 



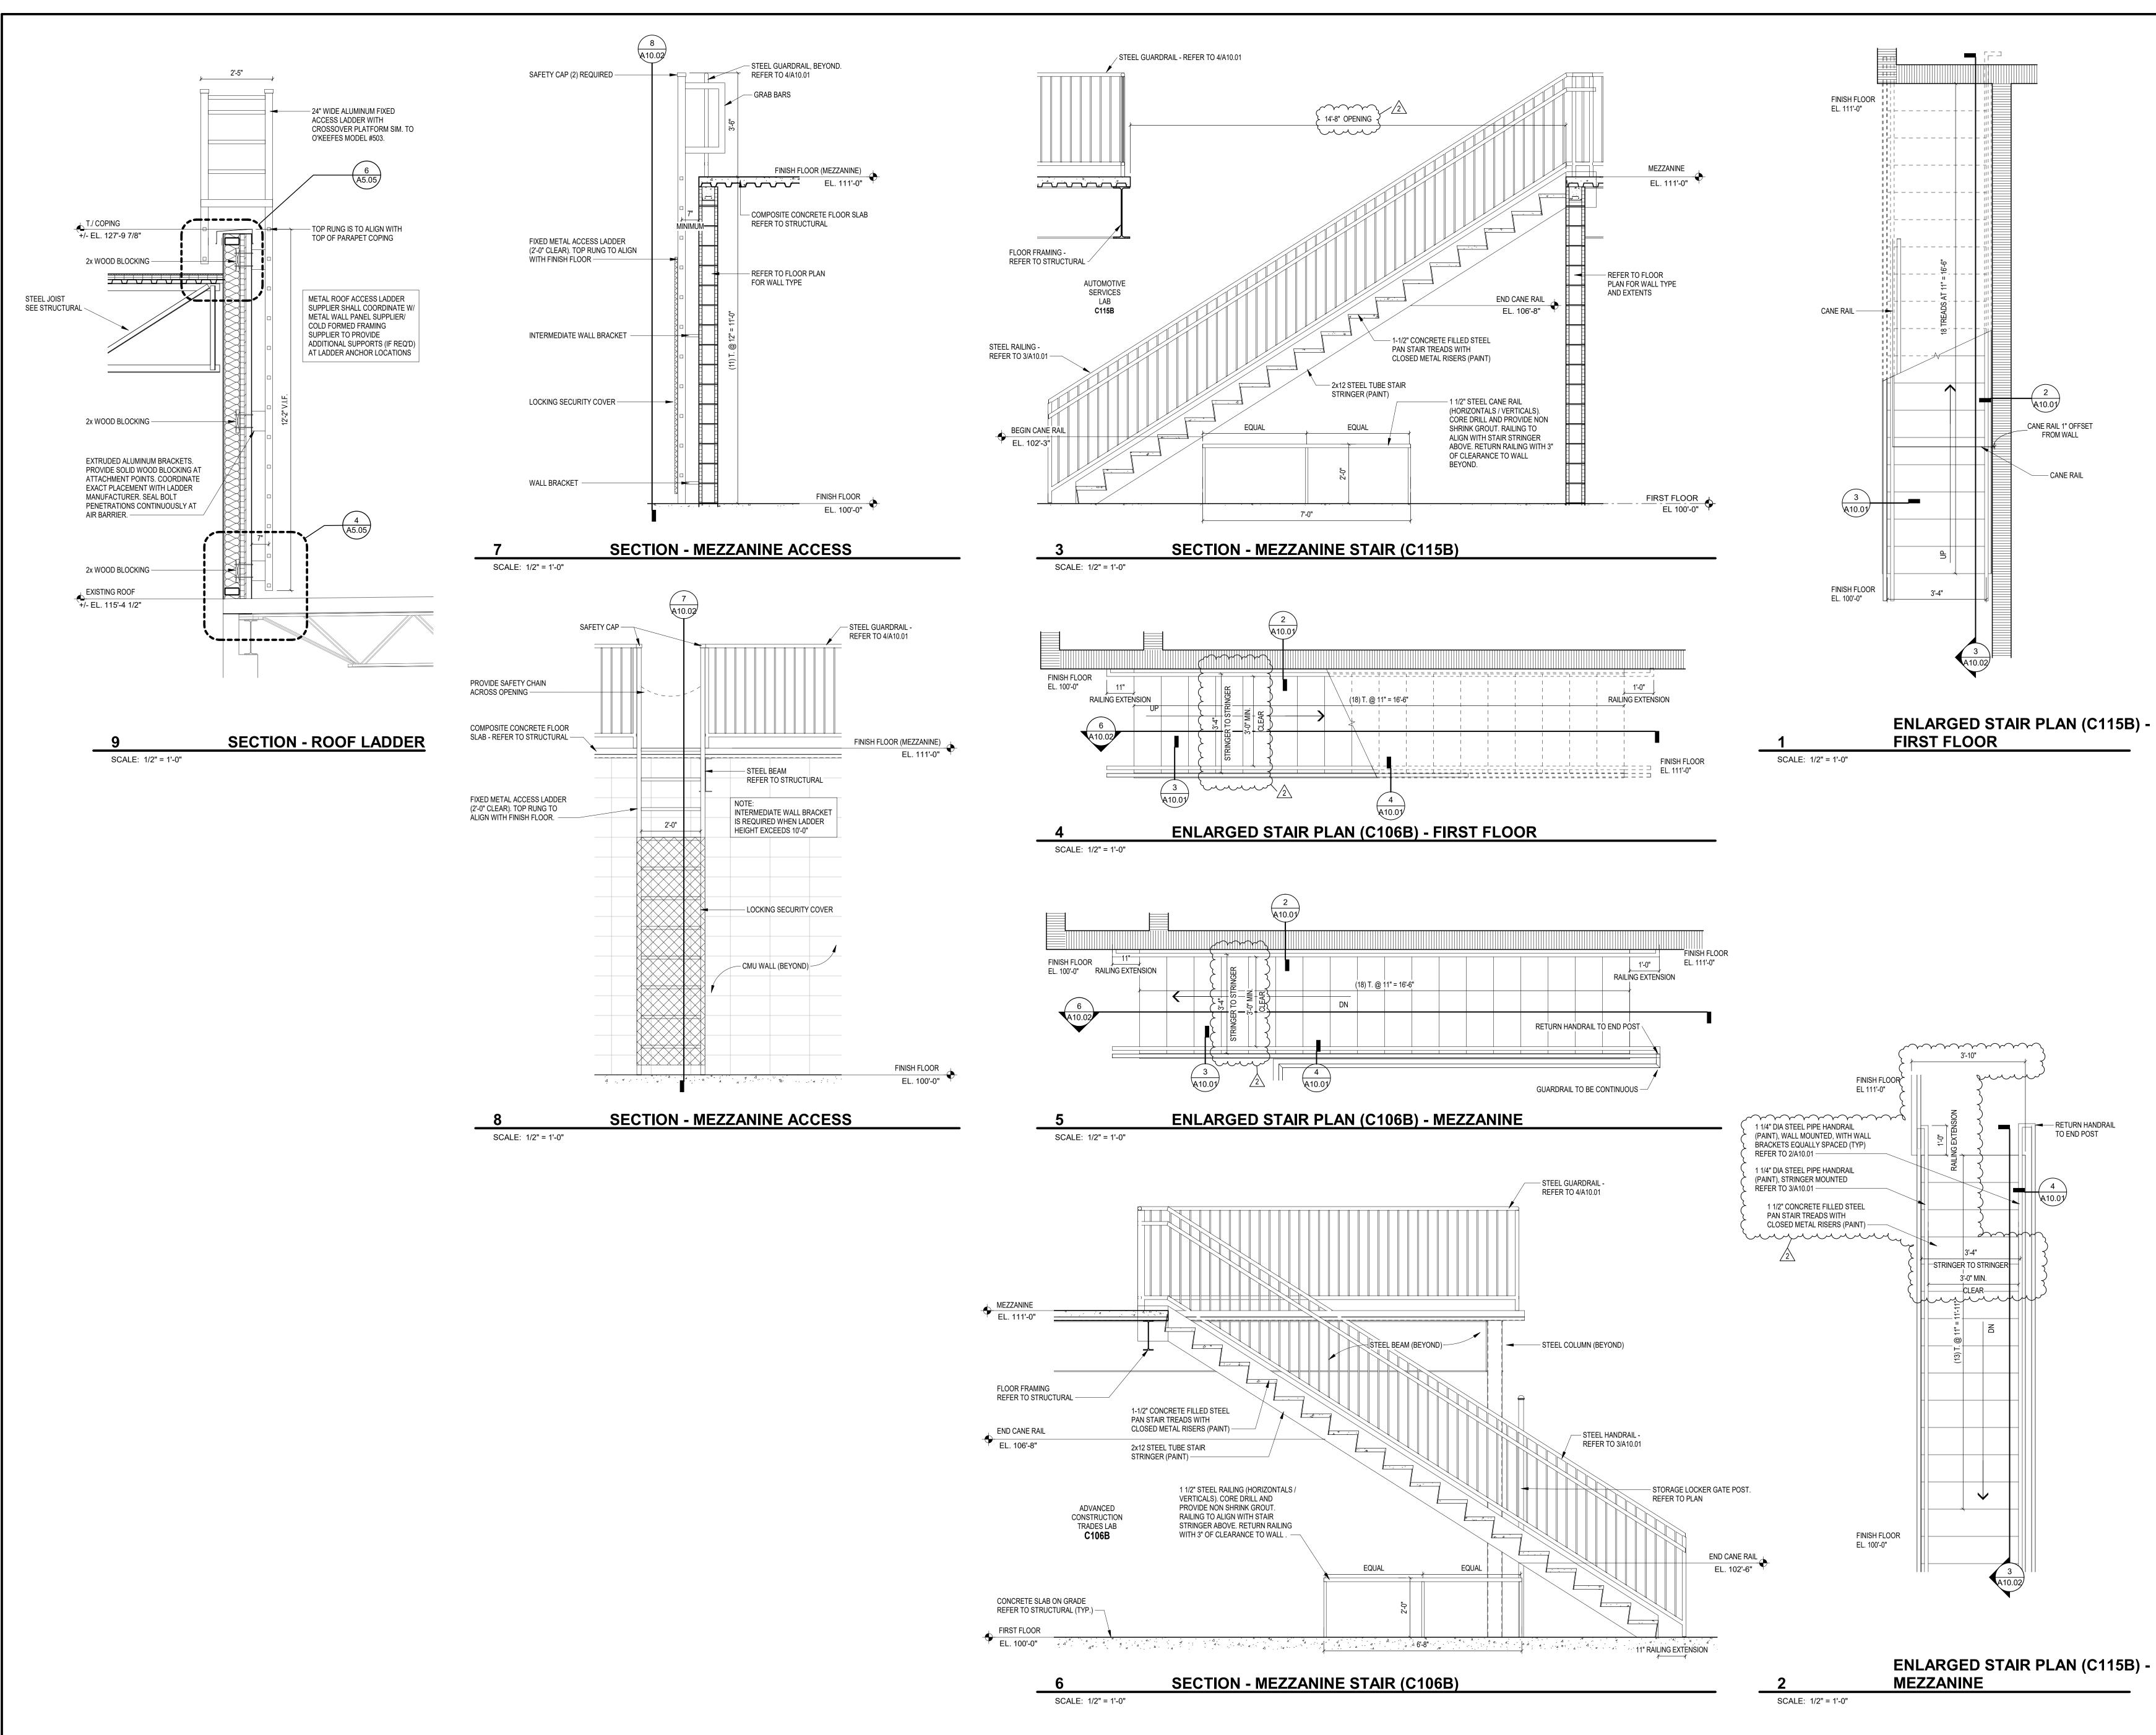

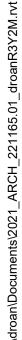



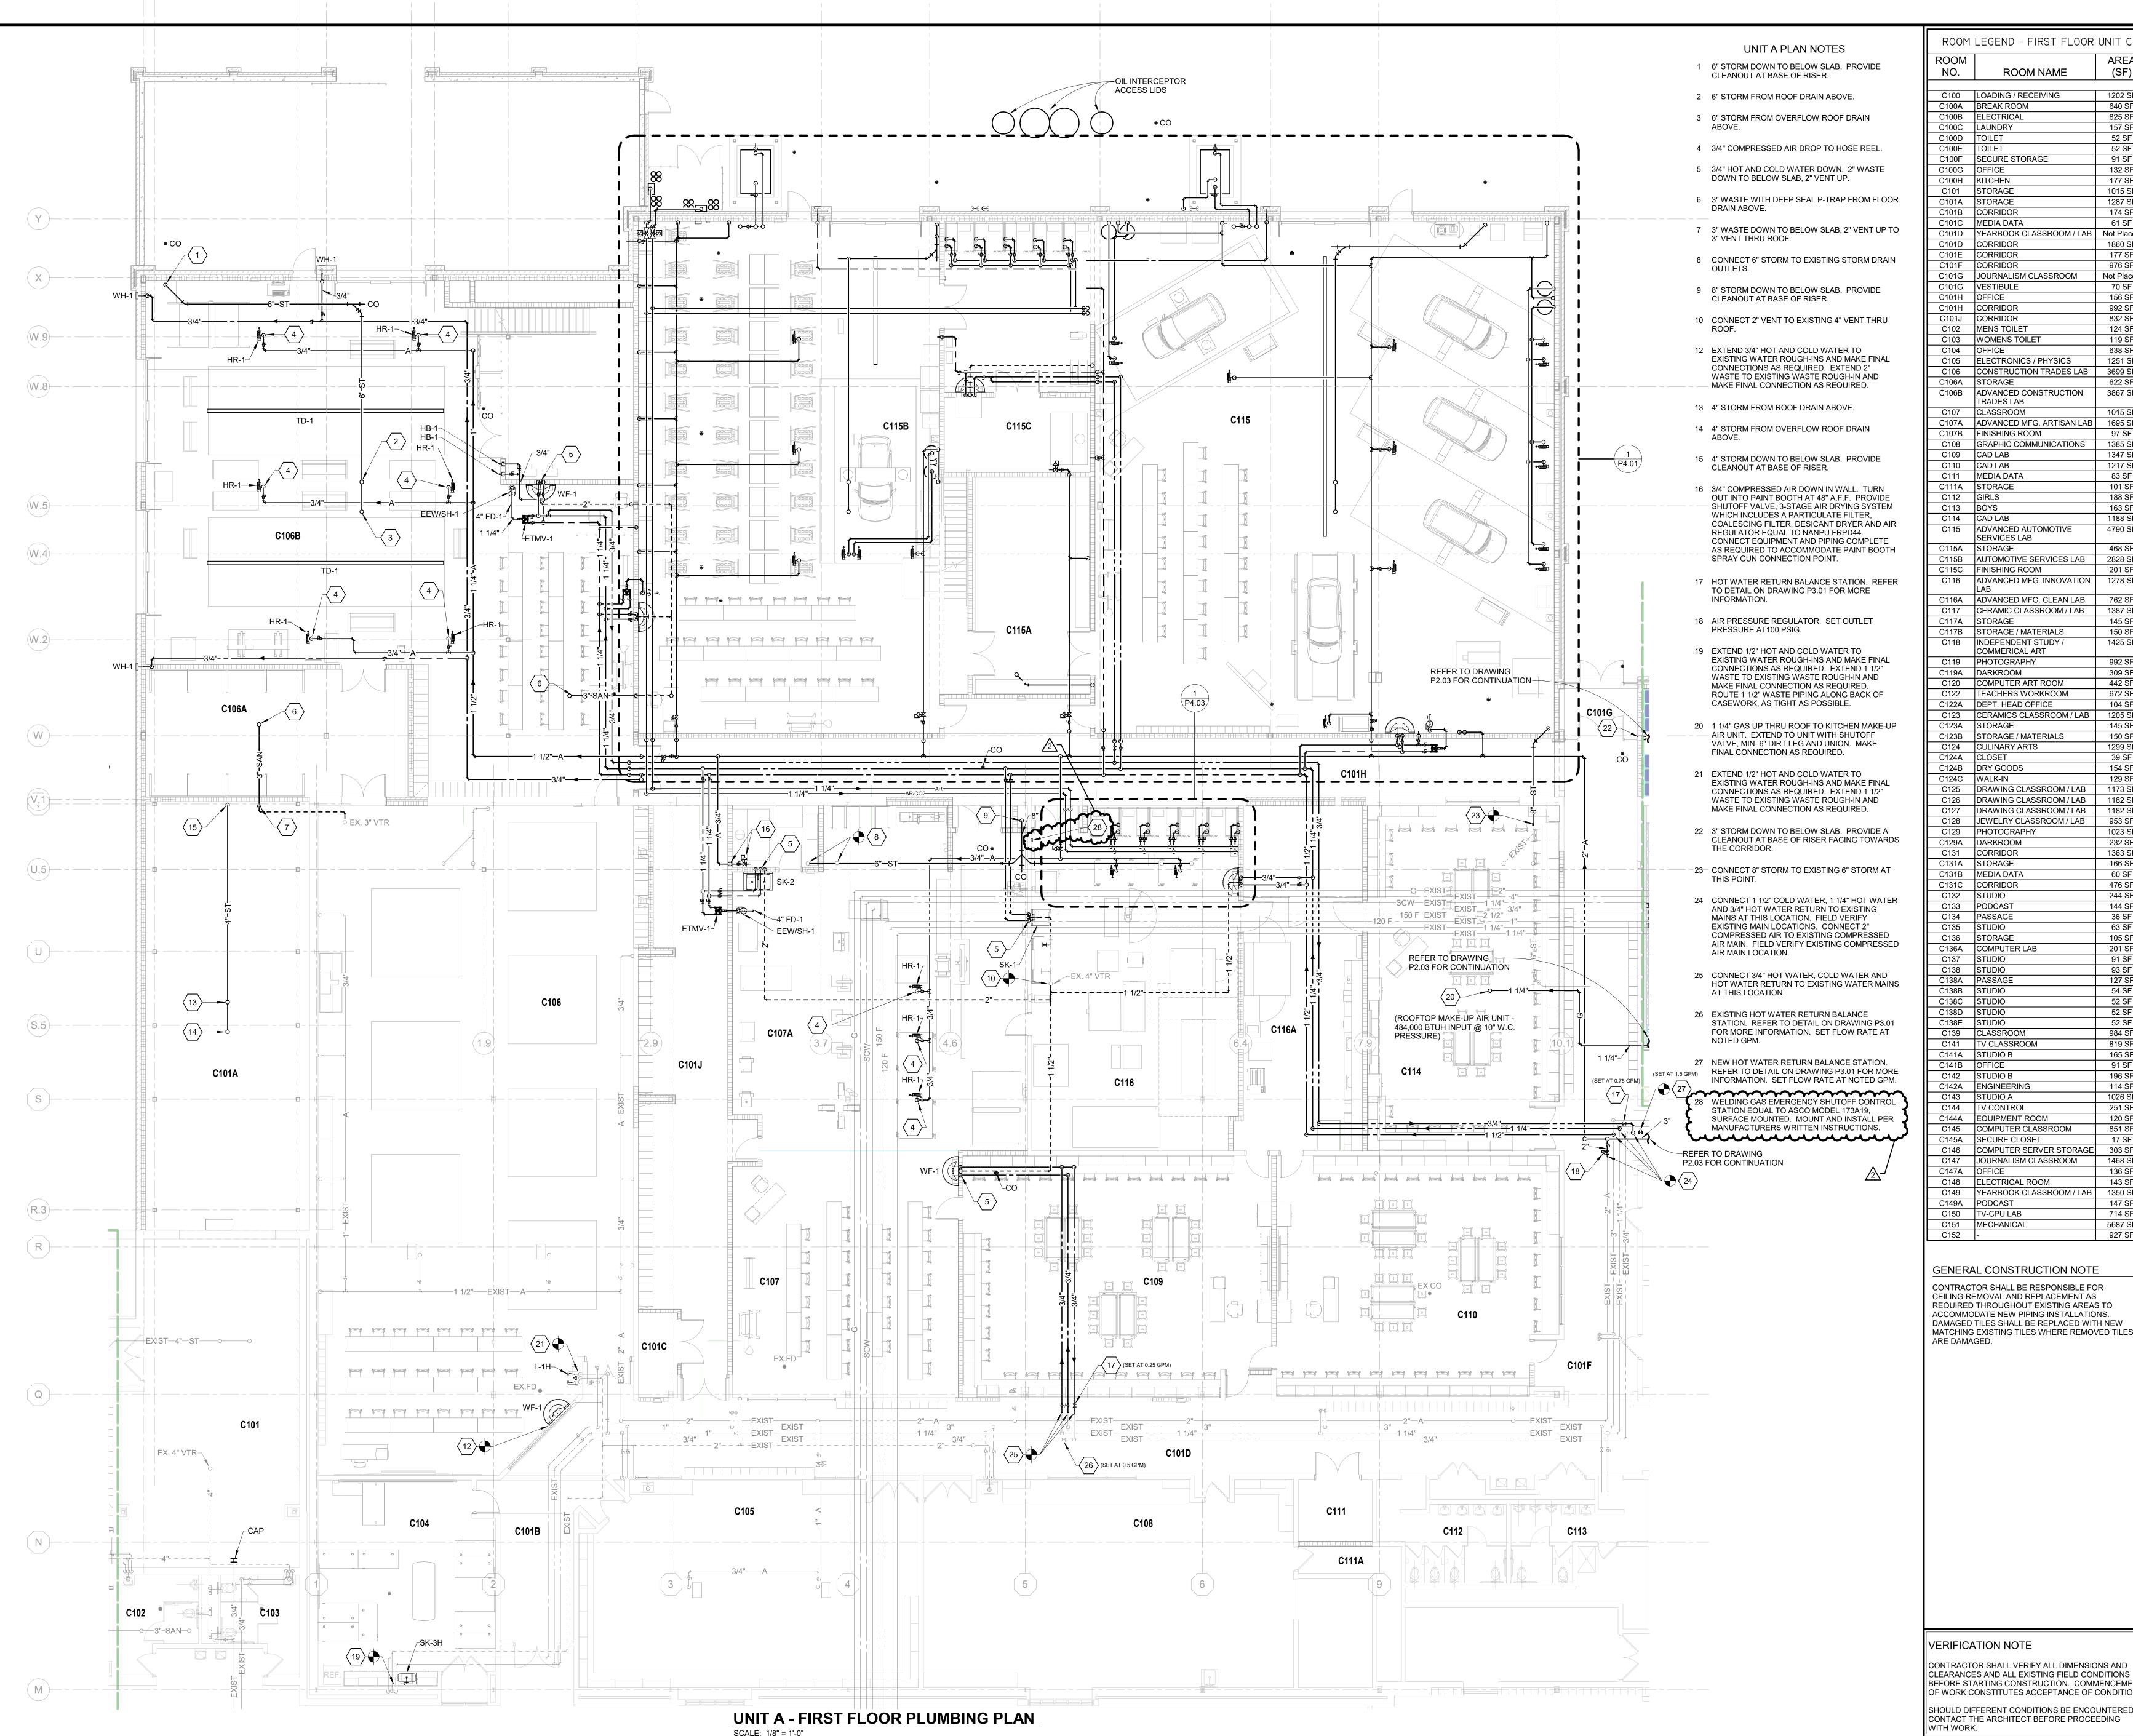



C100B ELECTRICAL 157 SF 52 SF 52 SF C100F SECURE STORAGE 91 SF 132 S C101A STORAGE C101B CORRIDOR C101C MEDIA DATA 61 SF YEARBOOK CLASSROOM / LAB Not Place CORRIDOR 1860 CORRIDOR CORRIDOR 976 S C101G JOURNALISM CLASSROOM Not Place C101G VESTIBULE C101H CORRIDOR C101J CORRIDOR C102 MENS TOILET 124 SF WOMENS TOILET 638 SI C105 ELECTRONICS / PHYSICS C106 CONSTRUCTION TRADES LAB C106A STORAGE C106B ADVANCED CONSTRUCTION 3867 SI TRADES LAB CLASSROOM C107A ADVANCED MFG. ARTISAN LAB 1695 SF C107B FINISHING ROOM C108 GRAPHIC COMMUNICATIONS 1385 SF C111 MEDIA DATA STORAGE C115 ADVANCED AUTOMOTIVE SERVICES LAB STORAGE 468 SI AUTOMOTIVE SERVICES LAB 2828 SI C115C FINISHING ROOM C116 ADVANCED MFG. INNOVATION 1278 SF C116A ADVANCED MFG. CLEAN LAB 762 SF CERAMIC CLASSROOM / LAB 1387 9 STORAGE C117B STORAGE / MATERIALS INDEPENDENT STUDY / COMMERICAL ART PHOTOGRAPHY 992 SF 309 SF C119A DARKROOM COMPUTER ART ROOM TEACHERS WORKROOM 672 SF C122A DEPT. HEAD OFFICE C123 CERAMICS CLASSROOM / LAB 1205 SF STORAGE / MATERIALS ULINARY ARTS DRY GOODS C125 DRAWING CLASSROOM / LAB 1173 SF C126 DRAWING CLASSROOM / LAB 1182 SF DRAWING CLASSROOM / LAB JEWELRY CLASSROOM / LAB PHOTOGRAPHY DARKROOM C131 CORRIDOR C131A STORAGE C131B MEDIA DATA C131C CORRIDOR C133 PODCAST C134 PASSAGE C136 STORAGE C136A COMPUTER LAB C139 CLASSROOM C141 TV CLASSROOM C141A STUDIO B 91 SF C142 STUDIO B C142A ENGINEERING C143 STUDIO A C144 TV CONTROL C144A EQUIPMENT ROOM C145 COMPUTER CLASSROOM C145A SECURE CLOSET 17 SF COMPUTER SERVER STORAGE 303 S JOURNALISM CLASSROOM 1468 S C148 ELECTRICAL ROOM C149 YEARBOOK CLASSROOM / LAB 1350 SF C149A PODCAST C150 TV-CPU LAB 5687

GENERAL CONSTRUCTION NOTE CONTRACTOR SHALL BE RESPONSIBLE FOR CEILING REMOVAL AND REPLACEMENT AS REQUIRED THROUGHOUT EXISTING AREAS TO ACCOMMODATE NEW PIPING INSTALLATIONS. DAMAGED TILES SHALL BE REPLACED WITH NEW MATCHING EXISTING TILES WHERE REMOVED TILES

VERIFICATION NOTE

CLEARANCES AND ALL EXISTING FIELD CONDITIONS BEFORE STARTING CONSTRUCTION. COMMENCEMENT OF WORK CONSTITUTES ACCEPTANCE OF CONDITIONS SHOULD DIFFERENT CONDITIONS BE ENCOUNTERED,

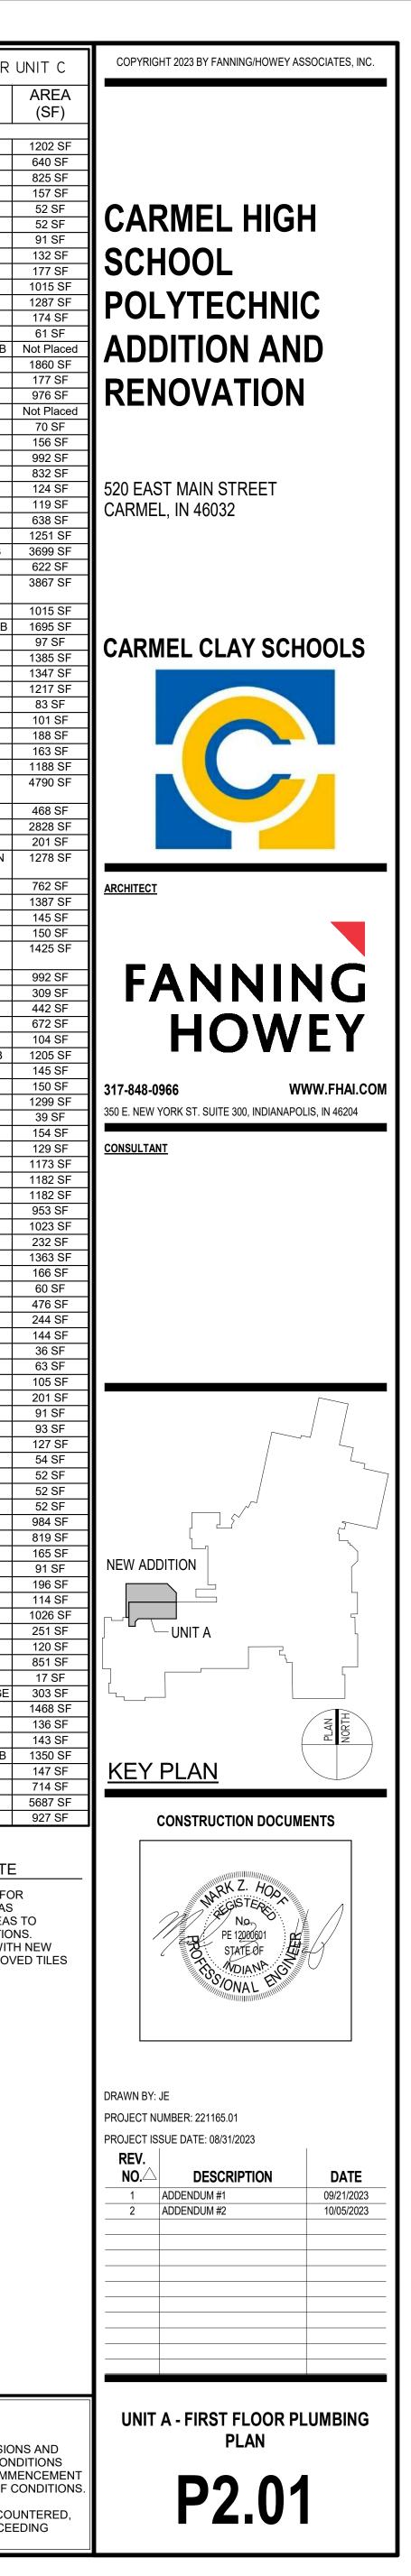

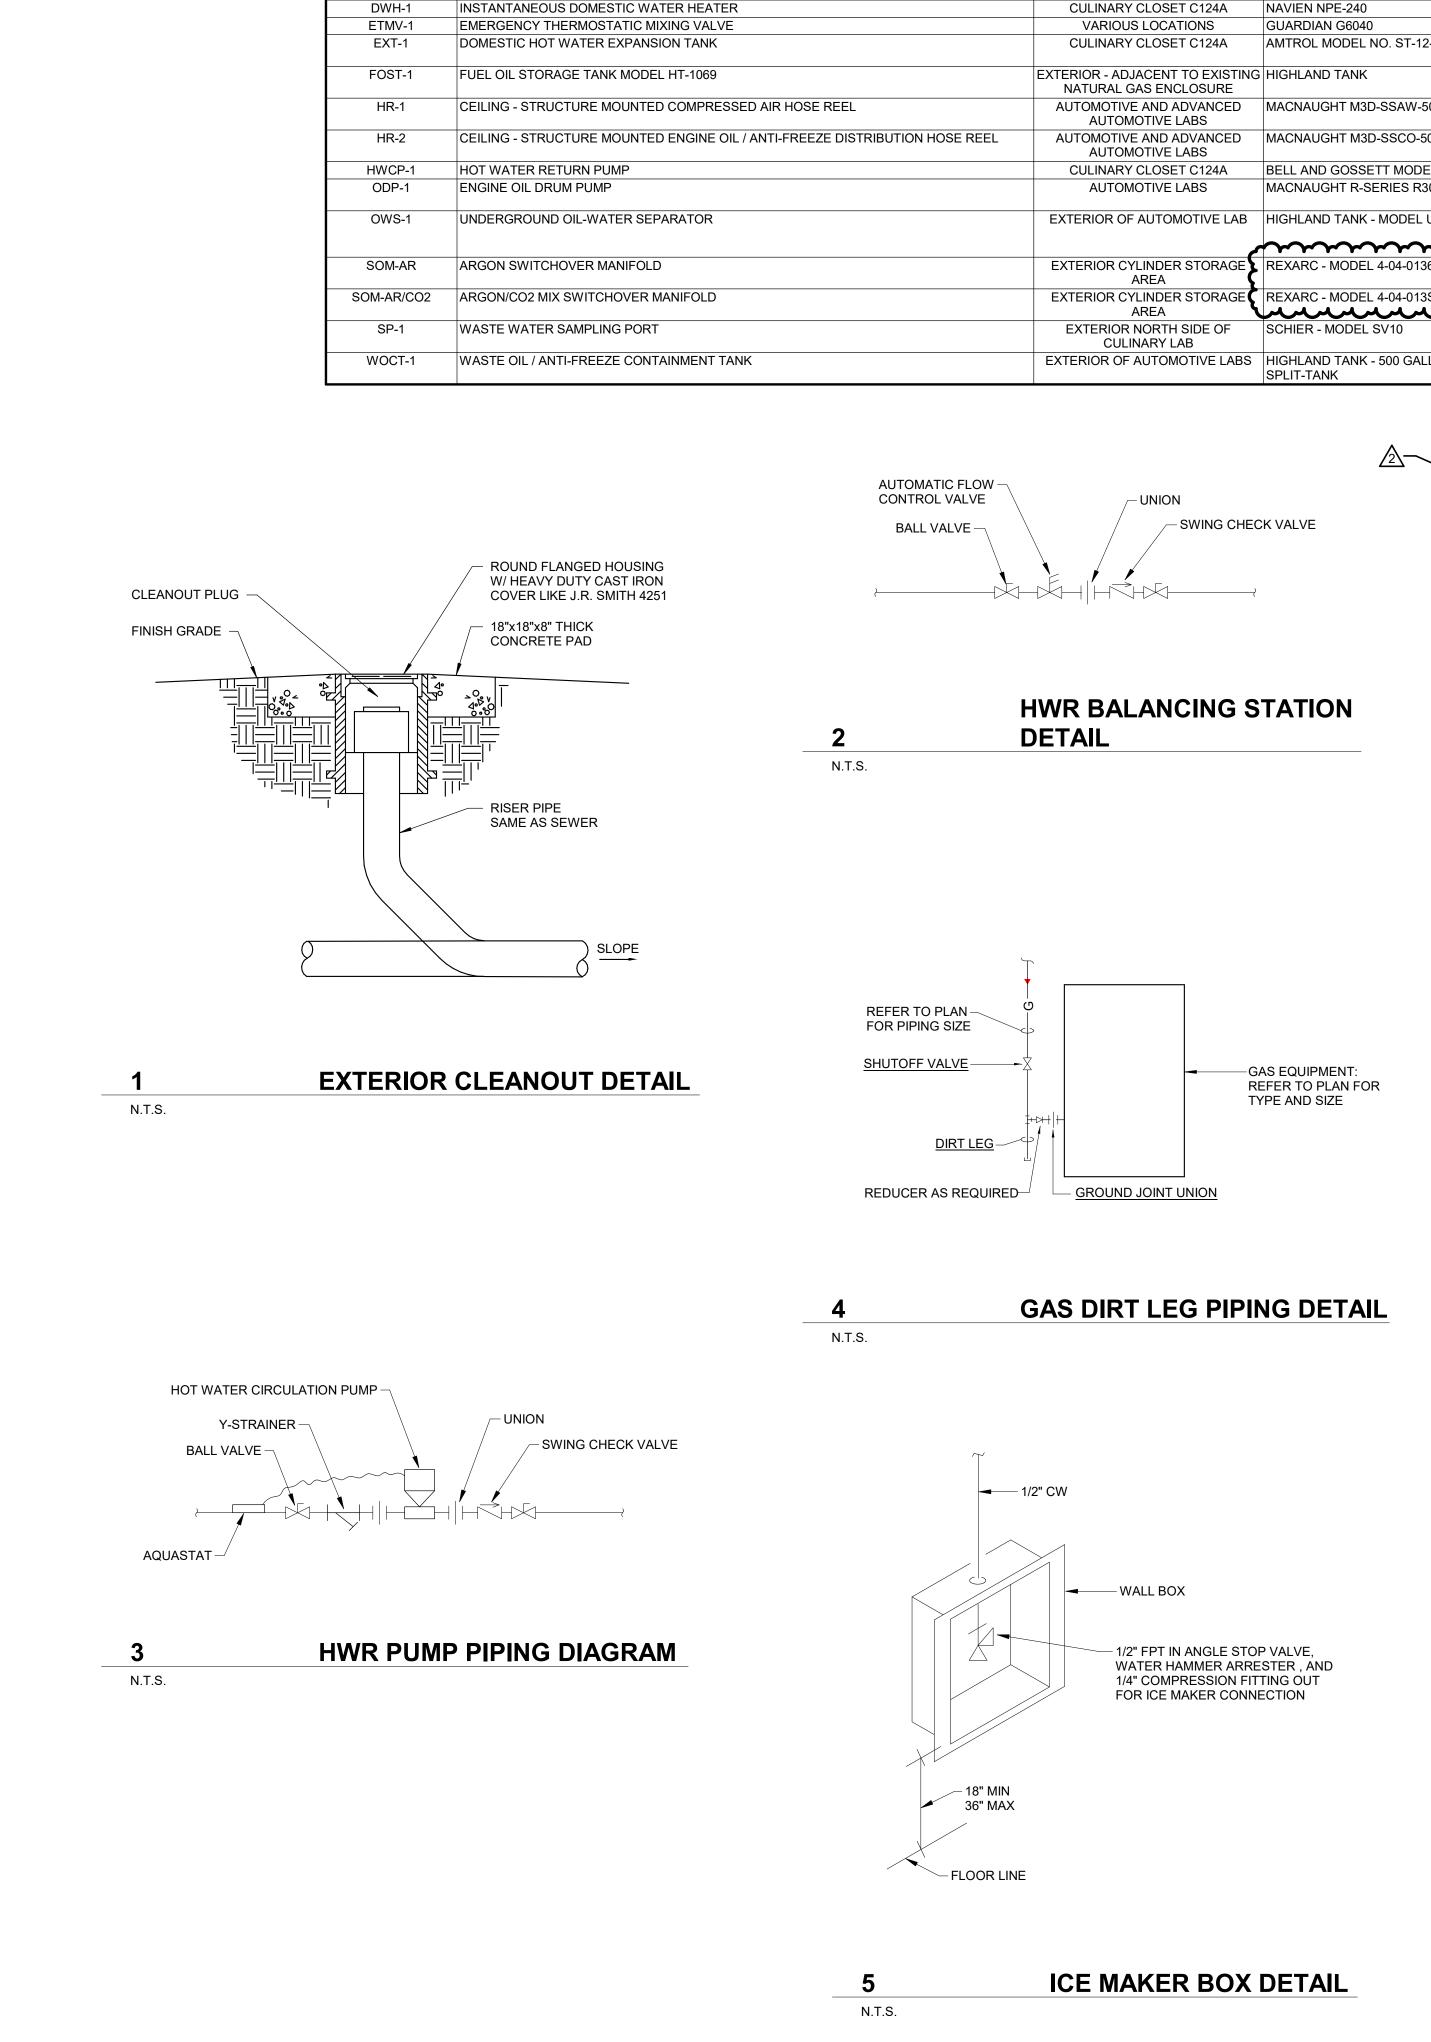

MARK EW/SH-1

DESCRIPTION

MARK

AC-1

AC-2

ADP-1

AR-1

AR/CO2-1

AIR COMPRESSOR

AIR COMPRESSOR


ARGON STATION DROP

ANTI-FREEZE/COOLANT DRUM PUMP

ARGON/CO2 MIX STATION DROP

							PLUMBING	FIXTURE SCHEDULE							
FIXTURE TRIM ACCESSORIES CONNECTIONS															
ITEM	MFGR	MODEL	MATERIAL	TYPE	COLOR	ITEM	MFGR	MODEL	ITEM	MFGR	MODEL	CW	HW	W	V         COMMENTS
EMERGENCY EYE WASH / SHOWER ASSEMBLY	GUARDIAN	GB1950	STAINLESS/POLYMER	FLOOR MOUNTED	-	-	-	-	EMERGENCY TMV	GUARDIAN	G6040	1 1/4"	1 1/4"	0"	0"
MOP SERVICE BASIN	FIAT	TSB-3000	TERAZZO	FLOOR MOUNTED	-	FAUCET	CHICAGO	897-CCP	-	-	-	3/4"	3/4"	3"	1 1/2" PROVIDE CHECK VALVES IN WATER SUPPLIES
GREASE INTERCEPTOR	SCHIER PRODUCTS	GB-500	POLYETHYLENE	BELOW GRADE										4"	4" INLET / OUTLET; 510 GAL. LIQUID CAPACITY; 1,859 LBS. GREASE CAPACIT 250 GPM; 128 GAL. SOLIDS; PROVIDE FCR2 RISER FOR ACCESS TO GRADE
HOSE BIBB	CHICAGO	387-E27CP	ROUGH BRONZE	WALL MOUNTED	-	-	-	-	-	-	-	3/4"	0"		
ICE MAKER SUPPLY BOX	GUY GRAY	MIB 1	STAINLESS	WALL MOUNTED	-	-	-	-	-	-	-	1/2"			
LAVATORY - ADA	AMERICAN STANDARD	0355.012	VIT. CHINA	WALL MOUNTED	WHITE	FAUCET	CHICAGO	420-E2805ABCP	POINT-OF-USE TMV	POWERS	LFG480	1/2"	1/2"	1 1/2"	1 1/2" SET POINT-OF-USE TMV OUTLET TEMP AT 105 DEG. F., SIZE TMV FOR 0.25 C
SOLIDS INTERCEPTOR	SCHIER PRODUCTS	SI-500	POLYETHYLENE	BELOW GRADE										4"	4" INLET / OUTLET; 510 GAL. LIQUID CAPACITY; 457 GAL. SOLIDS/SEDIMENT CAPACITY; PROVIDE FCR2 RISER FOR ACCESS TO GRADE
1-COMPARTMENT SERVICE SINK	ADVANCE TABCO	93-61-18	STAINLESS	FLOOR MOUNTED	-	FAUCET	T&S BRASS	S-0231	DRAIN	-	-	1/2"	1/2"	2"	2"
2-COMPARTMENT SERVICE SINK	ADVANCE TABCO	93-62-36	STAINLESS	FLOOR MOUNTED	-	FAUCET	T&S BRASS	S-0231	DRAIN	-	-	1/2"	1/2"	2"	2"
SINGLE COMP. SINK - ADA	ELKAY	LRAD1918-5.5	STAINLESS	COUNTERTOP	-	FAUCET	CHICAGO	201-AGN8AE2805FAB	-	-	-	1/2"	1/2"	2"	1 1/2" PROVIDE CENTERED REAR DRAIN TO ACCOMMODATE ADA APPROACH
54" SEMI-CIRCULAR WASHFOUNTAIN	BRADLEY	WF2704	STAINLESS	WALL MOUNTED	-	-	-	-	POINT-OF-USE TMV	POWERS	LFG480	3/4"	3/4"	2"	2" LESS SOAP AND TOWEL DISPENSER; SET POINT-OF-USE TMV OUTLET TEM 105 DEG. F.; SIZE TMV FOR 0.25 GPM
NON-FREEZE WALL HYDRANT	J.R. SMITH	5509QT	ROUGH BRONZE	WALL MOUNTED	-	-	-	-	-	-	-	3/4"			MOUNT AT 18" A.F.G.

			PLUMBING EQUIPMENT SC	CHEDULE						
						E	LECTRICAL DA	ГА		
	LOCATION	MANUFACTURER/MODEL NUMBER	CAPACITY	REMARKS	HP	KW	V	AMP	PH	COMMENTS
	-							-		
	MECHANICAL ROOM C151	KAESER - SK20 AIR CENTER	217 PSIG OPERATING PRESS.; 62.5 CFM CAPACITY AT OPERATING PRESS.	ROUTE RELIEF/DISCHARGE PIPING TO NEAREST FLOOR DRAIN WITH AIR GAP	20		460		3	ROTARY SCREW TYPE AIR COMPRESSOR - PRE-PACKAGED UNIT; PROVIDE KAESER OIL/WATER SEPARATOR FOR CONDENSATE DISCHARGE, KAESER MODEL KCF 50.
	MECHANICAL ROOM C151	KAESER - SK20 AIR CENTER	217 PSIG OPERATING PRESS.; 62.5 CFM CAPACITY AT OPERATING PRESS.	ROUTE RELIEF/DISCHARGE PIPING TO NEAREST FLOOR DRAIN WITH AIR GAP	20		460		3	ROTARY SCREW TYPE AIR COMPRESSOR - PRE-PACKAGED UNIT; PROVIDE KAESER OIL/WATER SEPARATOR FOR CONDENSATE DISCHARGE, KAESER MODEL KCF 50.
	AUTOMOTIVE LABS	MACNAUGHT R-SERIES R300S-01		AIR OPERATED ANTI-FREEZE PUMP; MOUNT TO ANTI-FREEZE DRUM						UNIT SUPPLIED WITH IN-LINE AIR LUBRICATOR; PROVIDE 5 MICRON AIR FILTER FOR AIR INLET TO PUMP
	WELDING BOOTH	REXARC - MODEL 2-04-1604A								
	WELDING BOOTH	REXARC - MODEL 2-04-1604AC								
	CULINARY CLOSET C124A	NAVIEN NPE-240	5.8 GPM @ 67 DEG. T.R.			.35 MAX	120		1	3" INTAKE - 3" EXHAUST FLUE
	VARIOUS LOCATIONS	GUARDIAN G6040	20 GPM @ 7 PSI PRESSURE DROP	1" INLETS / 1-1/4" OUTLETS	-	-	-	-	-	
	CULINARY CLOSET C124A	AMTROL MODEL NO. ST-12-C	3.2 GAL. MAX ACCEPT VOLUME 6.4 GAL. TOTAL VOLUME	A.S.M.E. RATED - SECTION VIII	-	-	-	-	-	
	EXTERIOR - ADJACENT TO EXISTIN NATURAL GAS ENCLOSURE	G HIGHLAND TANK	750 GALLONS							ABOVE GROUND, U.L. 142 LISTED, DOUBLE-WALL FUEL OIL STORAGE TANK
	AUTOMOTIVE AND ADVANCED AUTOMOTIVE LABS	MACNAUGHT M3D-SSAW-5050								PROVIDE 50' OF FLEXIBLE SUPPLY HOSE WITH QUICK-DISCONNECT FITTING
EL	AUTOMOTIVE AND ADVANCED AUTOMOTIVE LABS	MACNAUGHT M3D-SSCO-5050								PROVIDE 50' OF FLEXIBLE SUPPLY HOSE; PROVIDE OIL GUN
	CULINARY CLOSET C124A	BELL AND GOSSETT MODEL NO. PL-30B	2 GPM @ 24' T.D.H.	ALL BRONZE CONSTRUCTION	1/12	-	120	-	1	
	AUTOMOTIVE LABS	MACNAUGHT R-SERIES R300S-01		AIR OPERATED OIL PUMP; MOUNT TO OIL DRUM						UNIT SUPPLIED WITH IN-LINE AIR LUBRICATOR; PROVIDE 5 MICRON AIR FILTER FOR AIR INLET TO PUMP
	EXTERIOR OF AUTOMOTIVE LAB	HIGHLAND TANK - MODEL UL-HTC-H-1000-HG-SW	1000 GALLON - 100 GPM FLOW RATE	PROVIDE SUBMERSIBLE OIL PUMP AND SENSOR EQUIPMENT - PROVIDE WITH HIGH-LINK LEVEL SHEILD - HT-6117 'P' SERIES, WIRELESS	-	-	208	-	3	PROVIDE AND MOUNT PUMP CONTROLLER ON EXTERIOR WALL. PROVIDE NECESSARY CONDUIT FOR WIRING TO/FROM THE OWS
	EXTERIOR CYLINDER STORAGE AREA		200 PSIG DELIVERY PRESSURE; 550 SCFH	·						
	EXTERIOR CYLINDER STORAGE AREA	REXARC - MODEL 4-04-013SHPAC-8	200 PSIG DELIVERY PRESSURE; 550 SCFH						<u> </u>	
	EXTERIOR NORTH SIDE OF CULINARY LAB	SCHIER - MODEL SV10		PROVIDE SCHIER FIELD CUT RISER FCR10						4" INLET / OUTLET SIZE
	EXTERIOR OF AUTOMOTIVE LABS	HIGHLAND TANK - 500 GALLON, 48" DIA. AG DW HORIZONTAL SPLIT-TANK	. 250 GALLON FOR EACH SIDE - TOTAL 500 GALLON STORAGE	DOUBLE-WALL, ABOVEGROUND, UL 142 LISTED - SET IN DEPRESSED CONCRETE CONTAINMENT PIT						PROVIDE WITH HIGH-LINK LEVEL SHEILD - HT-6117 'P' SERIES, WIRELESS

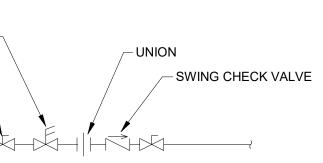





ENGINE OIL AND ANTI-FREEZE (ETHYLENE GLYCOL) DISTRIBUTION PIPING

- A. Hard Copper Tube: ASTM B88, Type K or L water tube, drawn temper
- 1. Cast-Copper Solder-Joint Fittings: ASME B16.22, pressure fittings.
- Wrought-Copper Solder-Joint Fittings: ASME B16.22, wrought-copper pressure fittings.
- 3. Copper Unions: MSS SP-125, cast-copper-alloy, hexagonal stock body, with ball and socket, metal-to-metal seating surfaces, and solder-joint or threaded ends.


Two-Piece, Full-Port, Bronze Ball Valves with Bronze Trim: MSS SP-110.

- 1. Manufacturers: Subject to compliance with requirements, provide products by one of the following:
- BrassCraft Manufacturing Company; a Masco company. а.
- Conbraco Industries, Inc.; Apollo Div. McDonald, A. Y. Mfg. Co.
- Body: Bronze, complying with ASTM B 584.
- Ball: Chrome-plated bronze. Stem: Bronze; blowout proof.
- Seats: Reinforced TFE; blowout proof.
- Packing: Threaded-body packnut design with adjustable-stem packing. Ends: Threaded, flared, or socket
- CWP Rating: 600 psig. Listing: Valves 1 inch and smaller shall be listed and labeled by an NRTL acceptable to authorities having jurisdiction. Service: Suitable for engine oil and ethylene glycol.


WASTE (USED) ENGINE OIL AND ANTI-FREEZE PIPING, FITTINGS AND VALVE SPECIFICATION WASTE ENGINE OIL AND ANTI-FREEZE (ETHYLENE GLYCOL) REMOVAL PIPING AND VALVES


Steel Pipe: ASTM A53/A53M, black steel, Schedule 40, Type E or S, Grade B. A.

- Malleable-Iron Threaded Fittings: ASME B16.3, Class 150, standard pattern. Wrought-Steel Welding Fittings: ASTM A234/A234M, for butt and socket welding. Unions: ASME B16.39, Class 150, malleable iron with brass-to-iron seat, ground joint,
- and threaded ends. 4. Forged-Steel Flanges and Flanged Fittings: ASME B16.5, minimum Class 150,
- including bolts, nuts, and gaskets of the following material group, end connections, and facings: a. Material Group: 1.1.
- End Connections: Threaded or butt welding to match pipe.
- Lapped Face: Not permitted underground.
- Gasket Materials: Asbestos free, ASME B16.20 metallic, or ASME B16.21 nonmetallic; gaskets compatible with fuel oil.
- e. Bolts and Nuts: ASME B18.2.1, zinc alloy-plated steel.
- Two-Piece, Full-Port, Bronze Ball Valves with Bronze Trim: MSS SP-110. В. 1. Manufacturers: Subject to compliance with requirements, provide products by one of the following:
- BrassCraft Manufacturing Company; a Masco company.
- Conbraco Industries, Inc.; Apollo Div. McDonald, A. Y. Mfg. Co.
- Body: Bronze, complying with ASTM B 584.
- Ball: Chrome-plated bronze. Stem: Bronze; blowout proof.
- Seats: Reinforced TFE; blowout proof.
- Packing: Threaded-body packnut design with adjustable-stem packing. Ends: Threaded, flared, or socket
- CWP Rating: 600 psig. Listing: Valves 1 inch and smaller shall be listed and labeled by an NRTL acceptable to authorities having jurisdiction.
- Service: Suitable for engine oil and ethylene glycol.

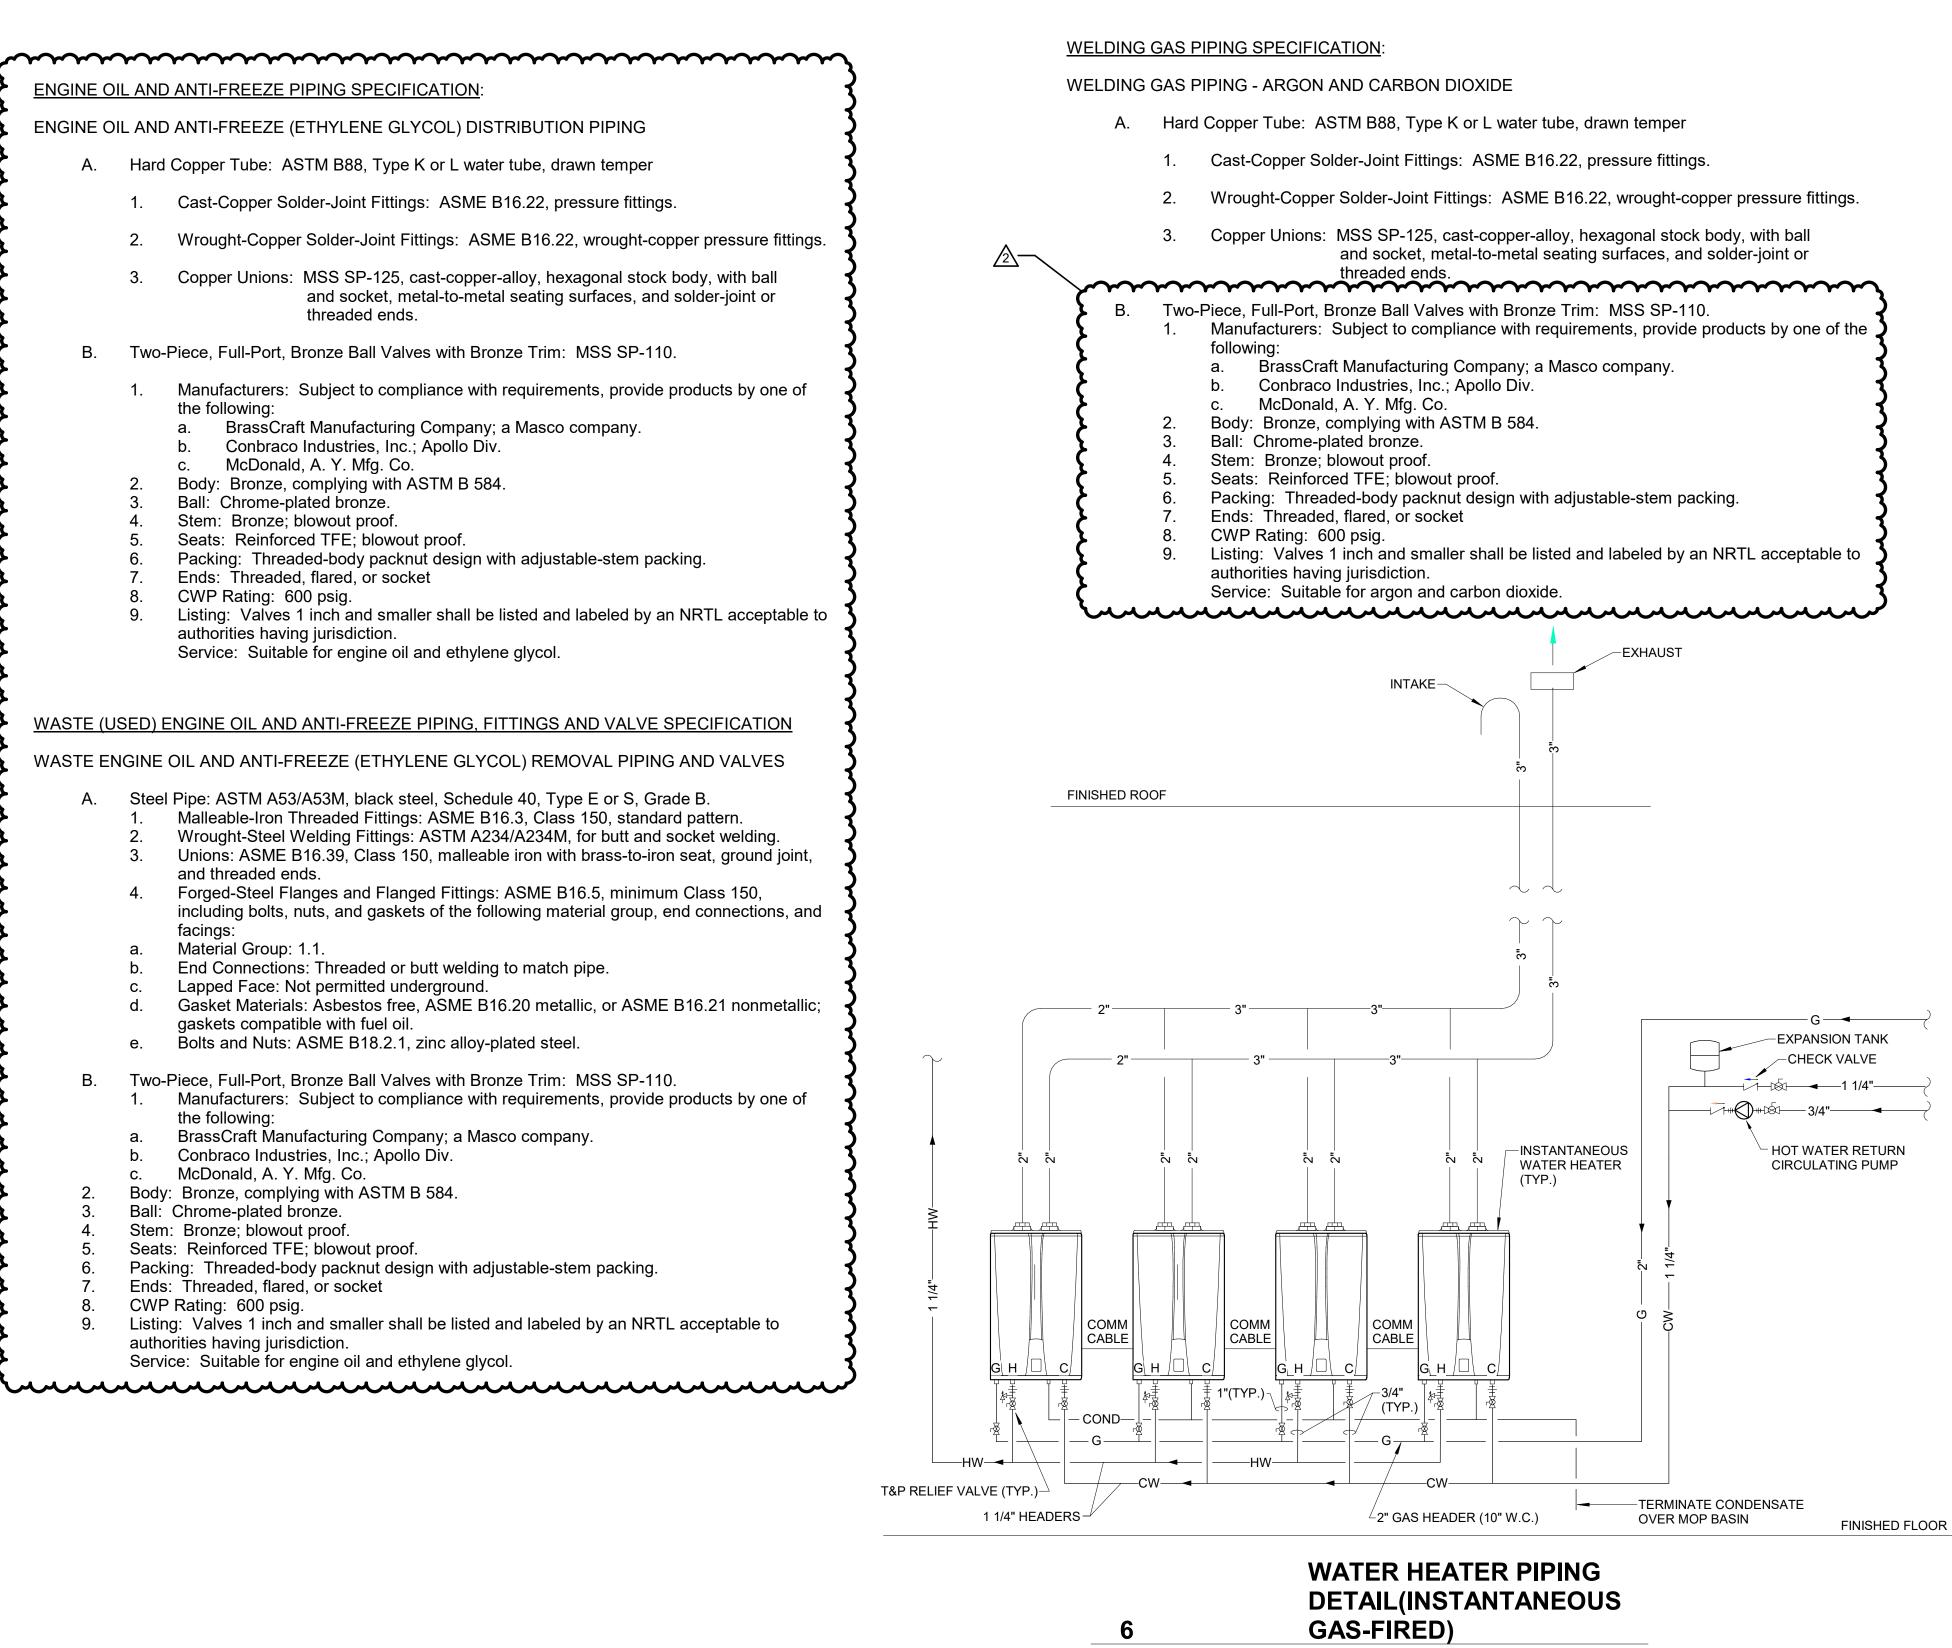



N.T.S.

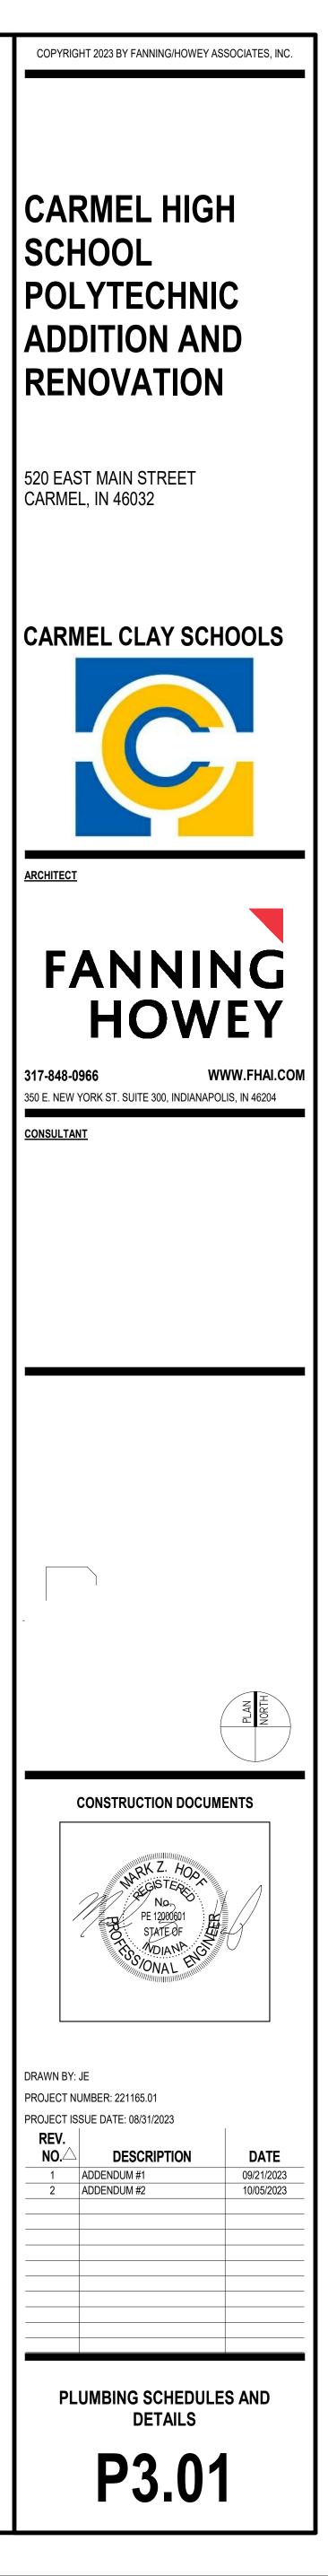

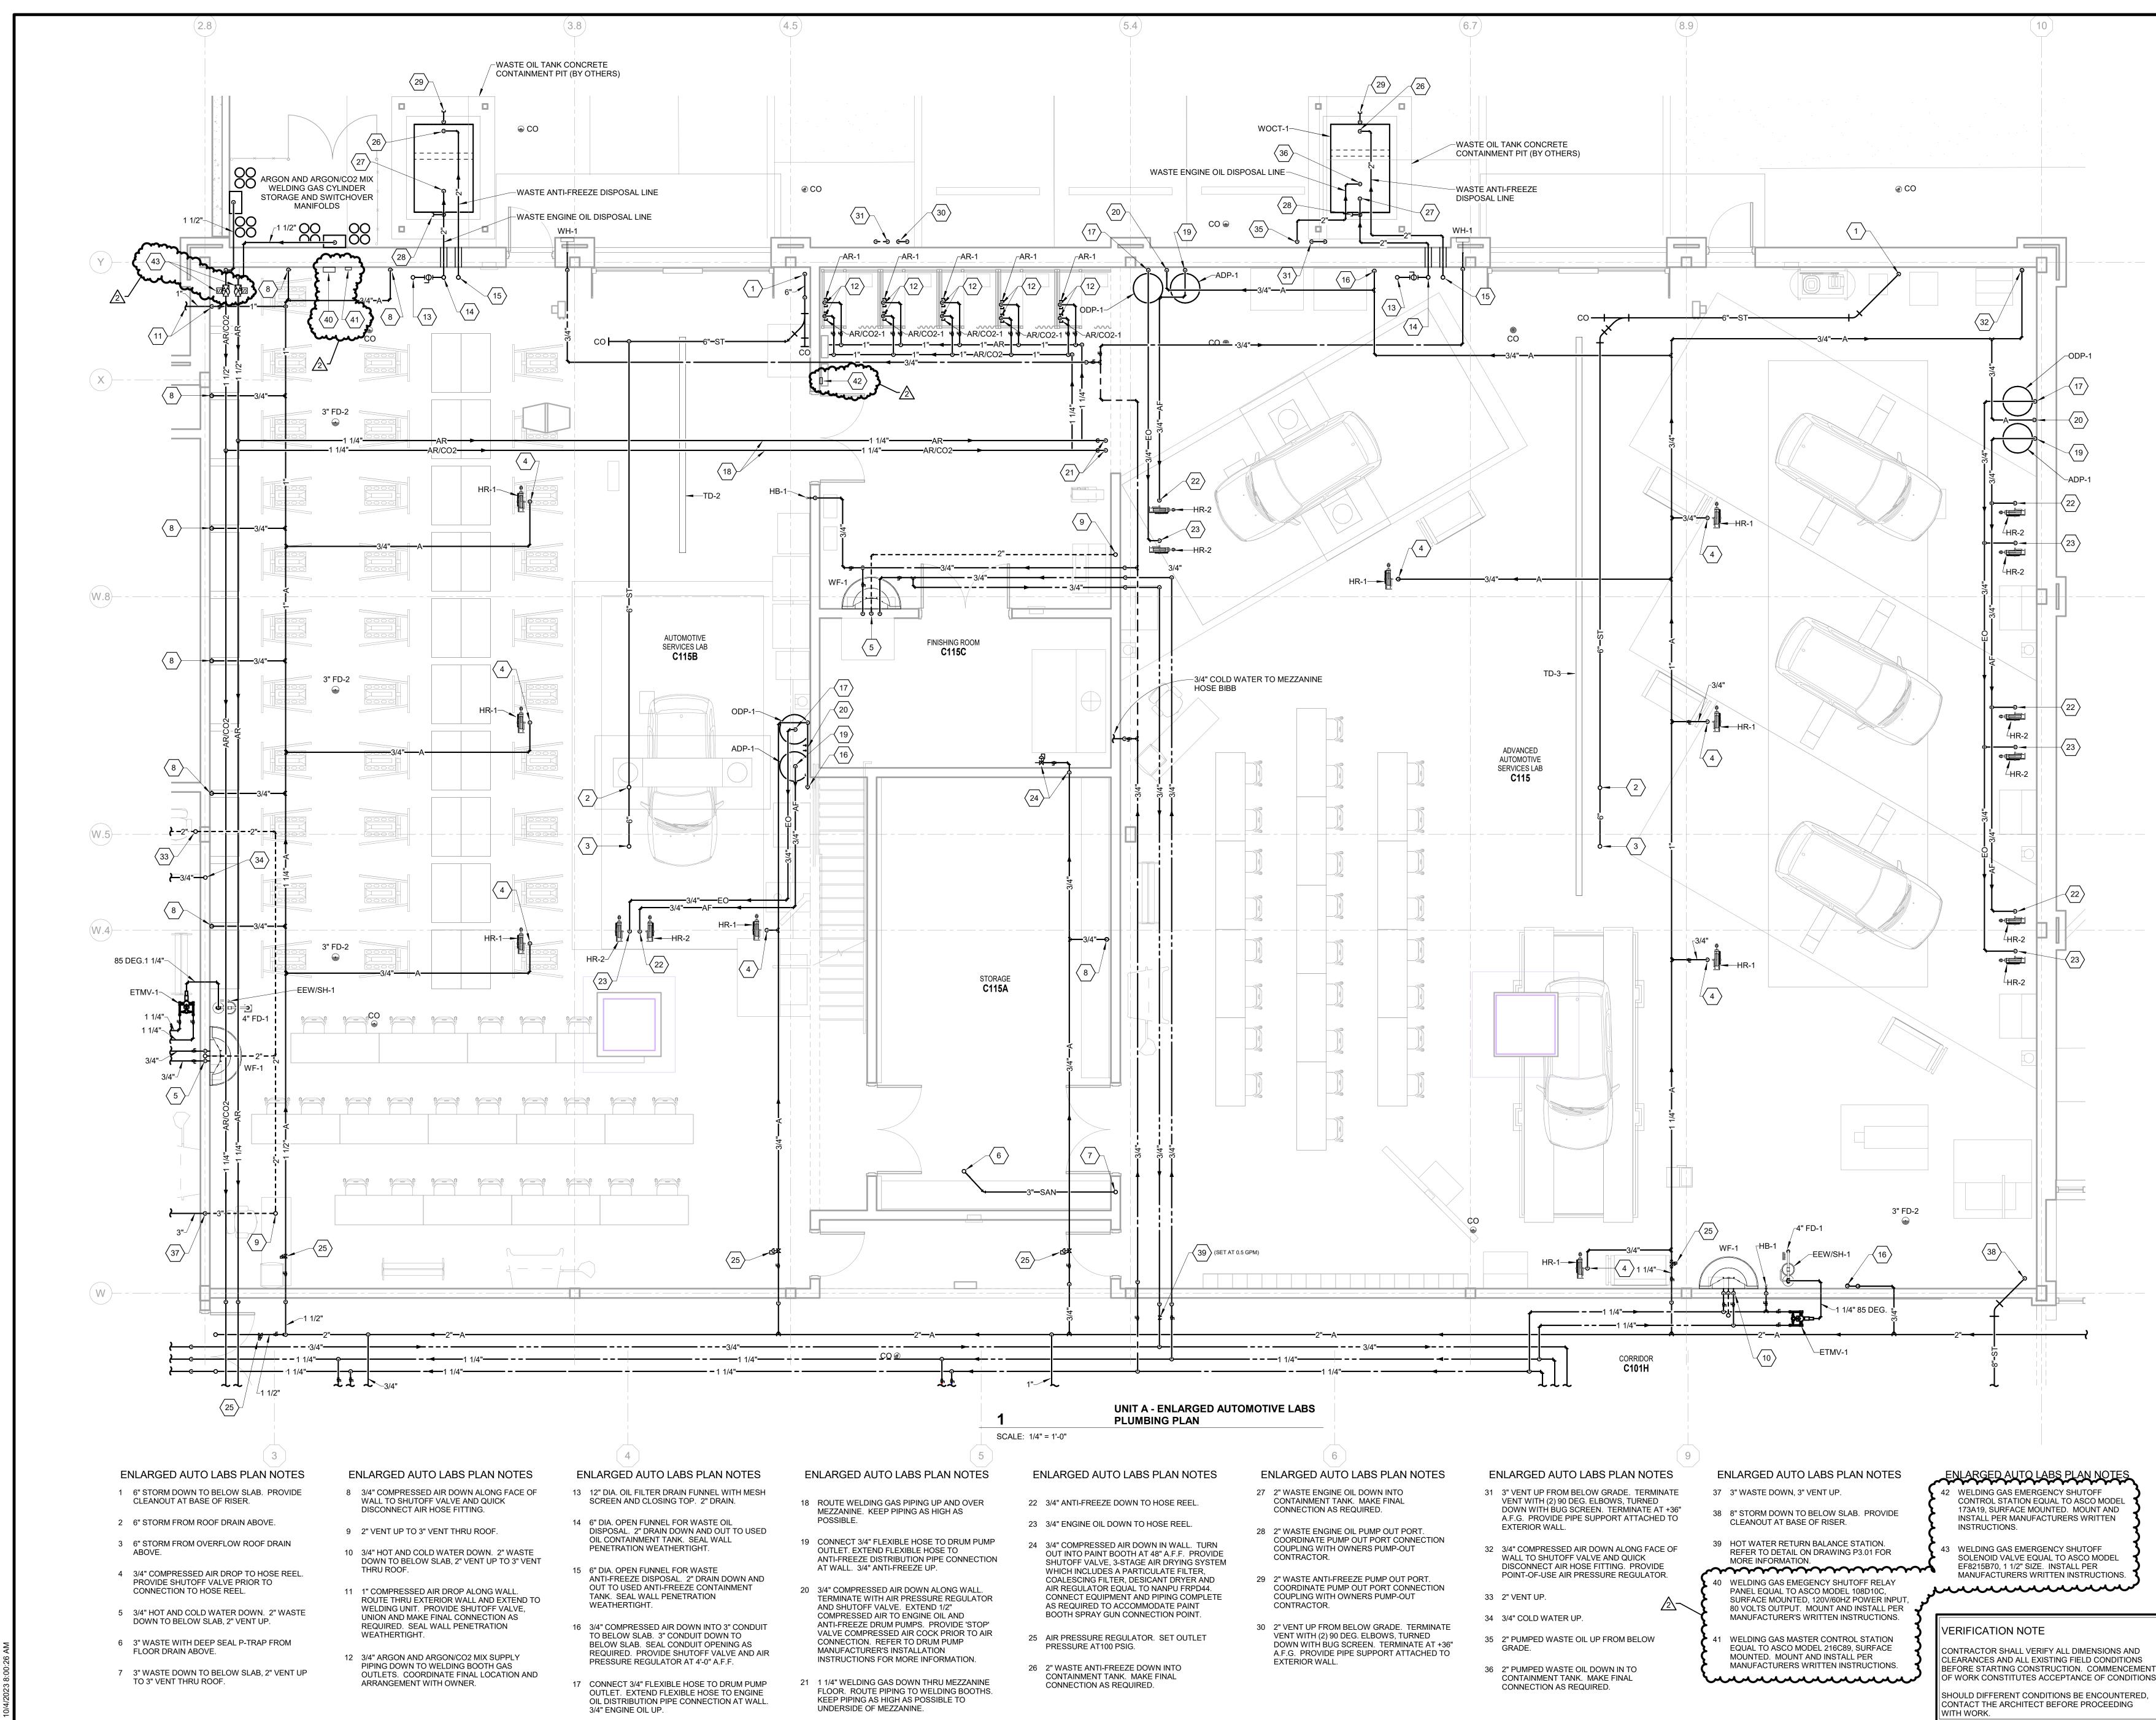



lsers\jelkins\Documents\2021_PLUM_221165.01_jelkinsHZQQL.r

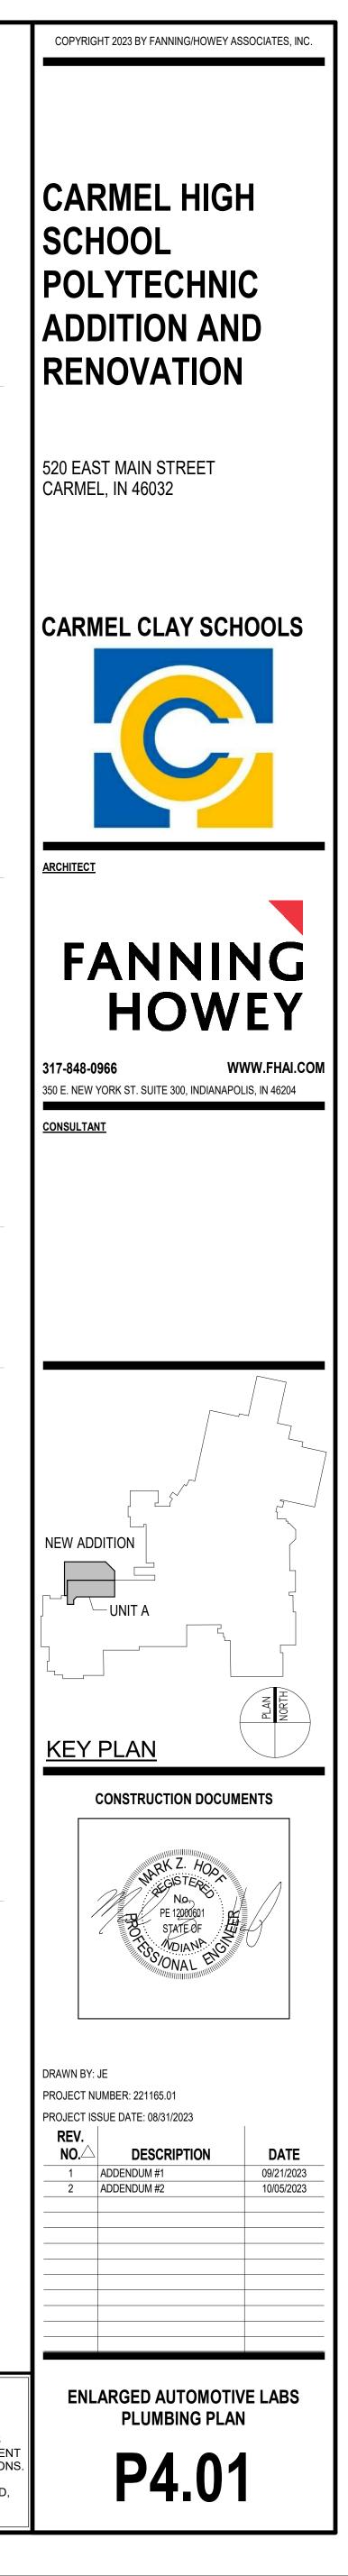

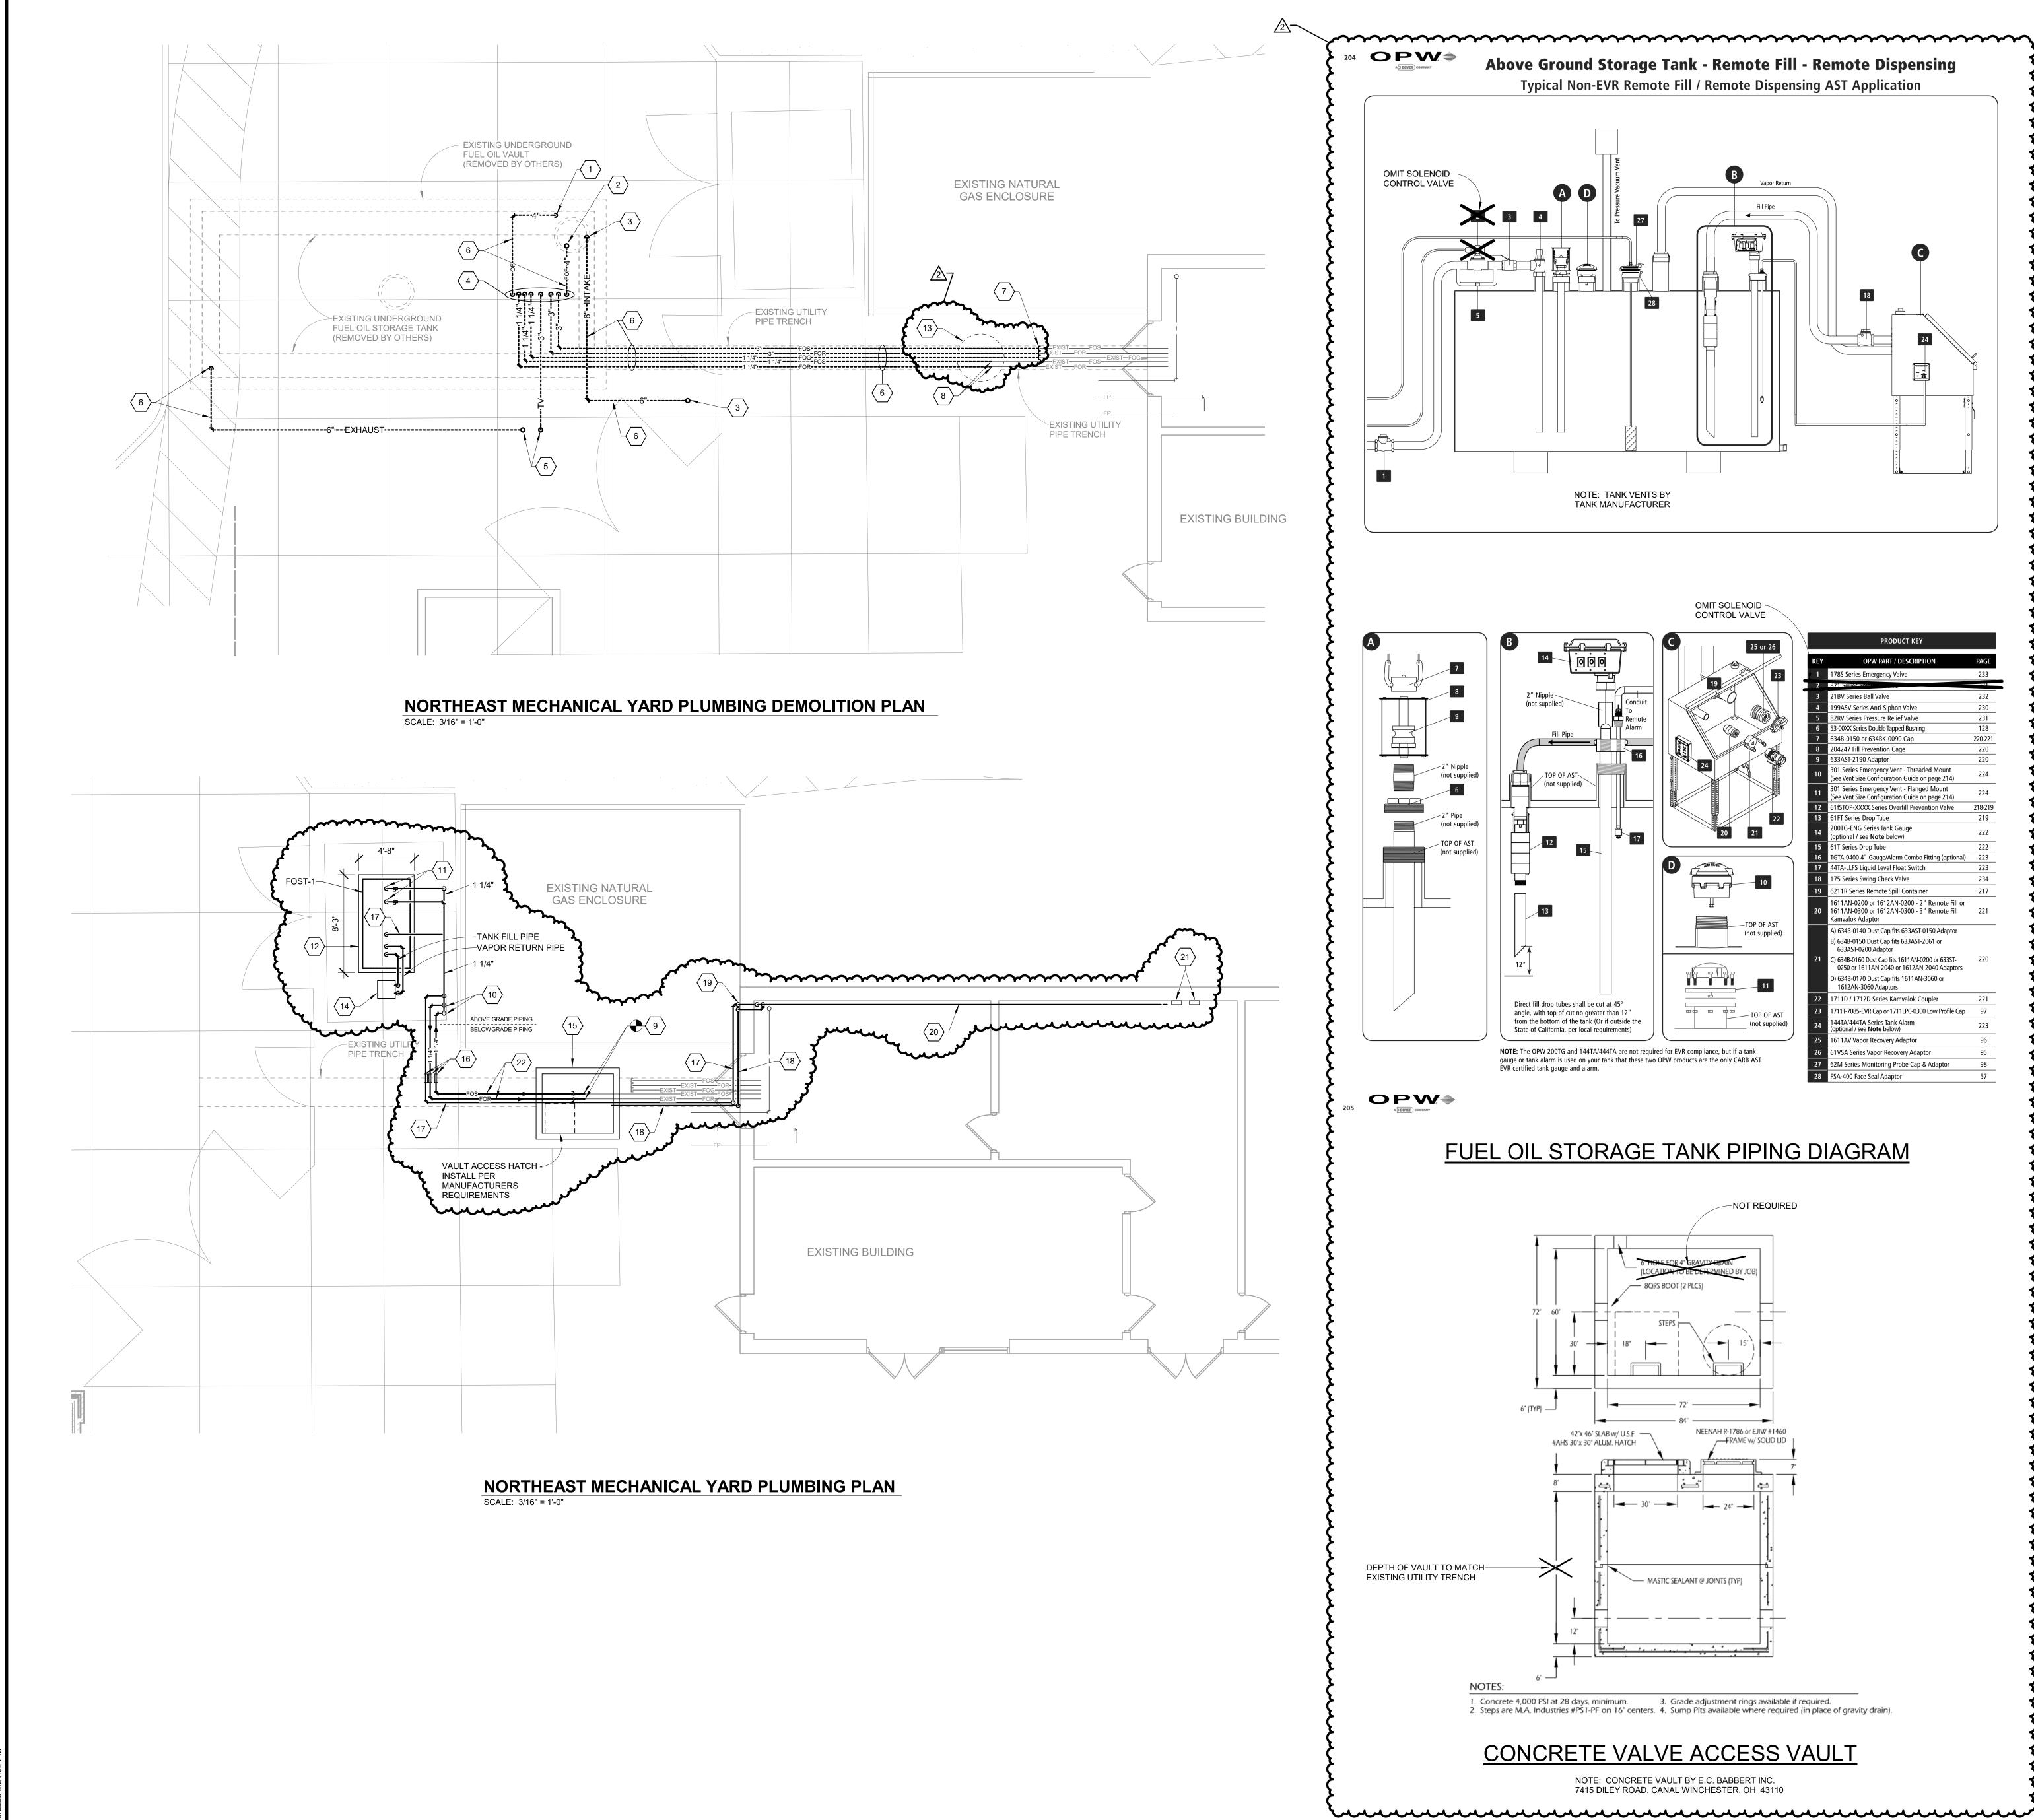

NORTHEAST UTILITY YARD PLAN NOTES 1 REMOVE 4" OVERFILL LINE COMPLETE INCLUDING SMALL PORTABLE SUMP PUMP.
<ul><li>2 REMOVE 4" FUEL OIL FILL LINE COMPLETE.</li><li>3 REMOVE 6" TANK VAULT AIR INTAKE PIPE</li></ul>
COMPLETE. 4 REMOVE ALL TANK PIPING CONNECTIONS
COMPLETE FOR TANK REMOVAL. TANK REMOVAL BY OTHERS. 5 REMOVE 6" TANK VAULT EXHAUST PIPE AND 3"
<ul><li>6 REMOVE PIPING COMPLETE.</li></ul>
7 REMOVE 3" FUEL OIL SUPPLY, FUEL OIL RETURN AND FUEL OIL GUAGE LINES BACK TO THIS POINT WITHIN THE FUEL OIL MANHOLE AND CAP.
8 REMOVE 1 1/4" FUEL OIL SUPPLY AND FUEL OIL RETURN LINES BACK TO THIS POINT WITHIN FUEL OIL MANHOLE AND PREPARE REMAINING RIPE FOR FOUNCETION TO NEW
9 CONNECT 1 1/4" FUEL OIL SUPPLY AND 1 1/4" FUEL OIL RETURN LINES TO EXISTING FUEL OIL LINES AT THIS POINT. PROVIDE ACCESSIBLE SHUTOFF VALVES WITHIN CONCRETE ACCESS VAULT.
10 1 1/4" FUEL OIL SUPPLY AND 1 1/4" FUEL OIL RETURN LINES UP TO ABOVE SLAB.
11 1 1/4" FUEL OIL SUPPLY AND 1 1/4" FUEL OIL RETURN LINES DOWN TO FUEL OIL STORAGE TANK. MAKE FINAL CONNECTIONS AS REQUIRED.
12 8" HIGH CONCRETE EQUIPMENT PAD. INSTALL PAD, ANCHORAGE AND CRADLE SUPPORTS PEF MANUFACTURERS REQUIREMENTS. PROVIDE AN ENGINEERED DELEGATED DESIGN TO ENSURE SUB-STRUCTURE IS ADEQUATE TO SUPPORT FULL LOAD OF FUEL OIL STORAGE TANK INCLUDING FUEL OIL.
13 REMOVE FUEL OIL MANHOLE AND ASSOCIATED PARTS COMPLETE.
14 REMOTE SPILL CONTAINMENT ASSEMBLY. REFER TO DIAGRAM ON THIS SHEET.
15 7'-0" X 6'-0" X 7'-0" DEEP CONCRETE VAULT. REFER TO DEAIL ON THIS SHEET FOR MORE INFORMATION. PROVIDE PIPE LEAK DETECTION SENSORS ON SECONDARY CONTAINMENT PIPING. INSTALL LEAK DETECTION SENSORS ALONG ENTIRE LENGTH OF NEW FUEL OIL PIPING PER MANUFACTURERS REQUIREMENTS.
16 PROVIDE LINK SEAL AT EXISTING UTILITY TRENCH PIPE PENETRATION LOCATION. ENSURE SEAL IS WATER TIGHT. PROVIDE SIZE OF PENETRATION TO ACCOMMODATE 1" SIGNAL CONDUIT.
17 1" TANK MONITORING SIGNAL CONDUIT. ROUTE PARALLEL TO FUEL OIL PIPING. REFER TO ELECTRICAL DRAWINGS FOR CONDUIT INFORMATION.
18 1" LEAK DETECTION SIGNAL CONDUIT. ROUTE PARALLEL TO FUEL OIL PIPING. REFER TO ELECTRICAL DRAWINGS FOR CONDUIT INFORMATION.
19 1" TANK MONITORING SIGNAL CONDUIT AND 1" LEAK DETECTION SIGNAL WIRING CONDUIT UP FROM BELOW GRADE. PENETRATE THRU EXISTING EXTERIOR BUILDING WALL TO INTERIOR. SEAL WALL PENETRATION WEATHERTIGHT. REFER TO ELECTRICAL DRAWINGS FOR CONDUIT INFORMATION.
20 1" TANK MONITORING SIGNAL CONDUIT AND 1" LEAK DETECTION SIGNAL WIRING CONDUIT MOUNTED VERTICALLY ON WALL AND ROUTED TO LEAK DETECTION AND TANK MONITORING CONTROL PANELS. REFER TO ELECTRICAL DRAWINGS FOR CONDUIT INFORMATION.
21 TANK MONITOR AND PIPE LEAK DETECTION CONTROL PANELS EQUAL TO OPW DOVER PROGAUGE MAGLINK LX PLUS. CONNECT AND MOUNT PER MANUFACTURERS REQUIREMENTS REFER TO ELECTRICAL DRAWINGS FOR POWER REQUIREMENTS. PROVIDE FLOAT SWITCH SYSTEM AT FUEL OIL STORAGE TANK.
22 PROVIDE COMPATABLE PIPE SUPPORTS IN EXISTING UTILITY TUNNEL PER MANUFACTURER'S REQUIREMENTS.
VERIFICATION NOTE CONTRACTOR SHALL VERIFY ALL DIMENSIONS AND CLEARANCES AND ALL EXISTING FIELD CONDITIONS BEFORE STARTING CONSTRUCTION. COMMENCEMI OF WORK CONSTITUTES ACCEPTANCE OF CONDITION SHOULD DIFFERENT CONDITIONS BE ENCOUNTERE
CONTACT THE ARCHITECT BEFORE PROCEEDING WITH WORK.

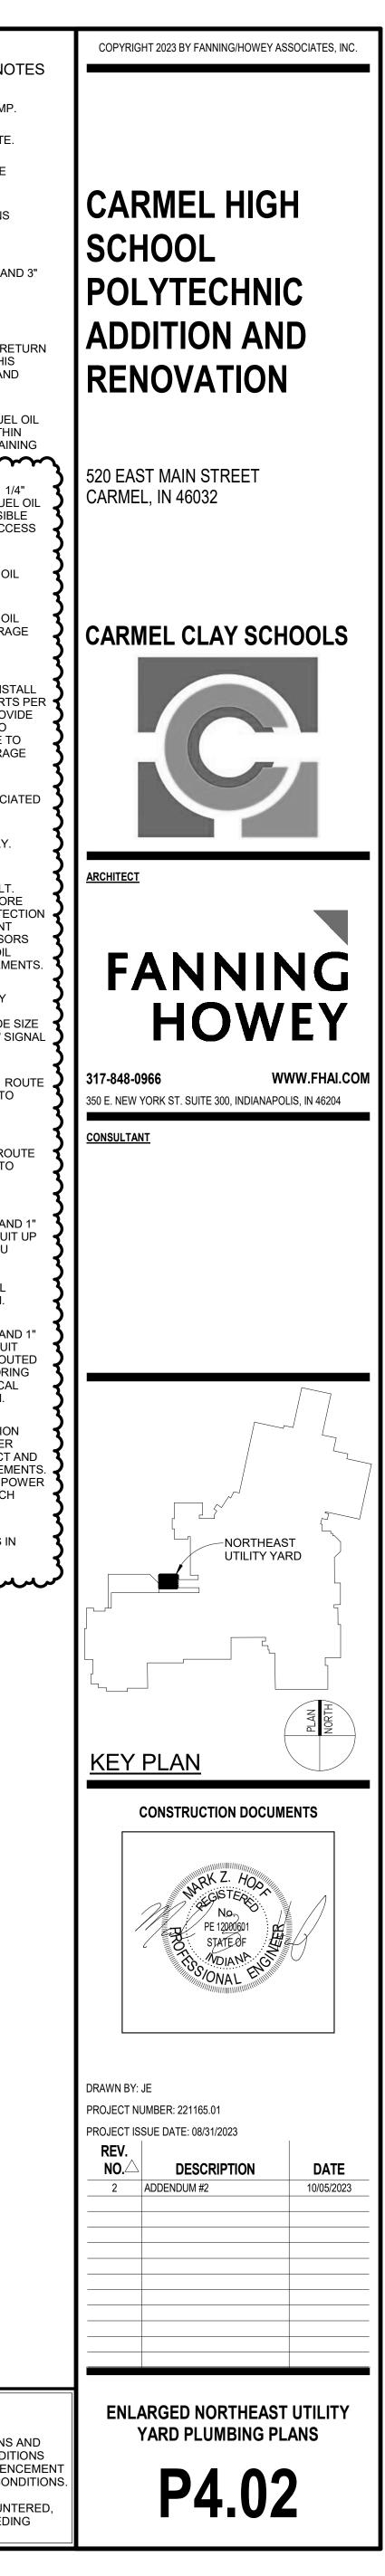

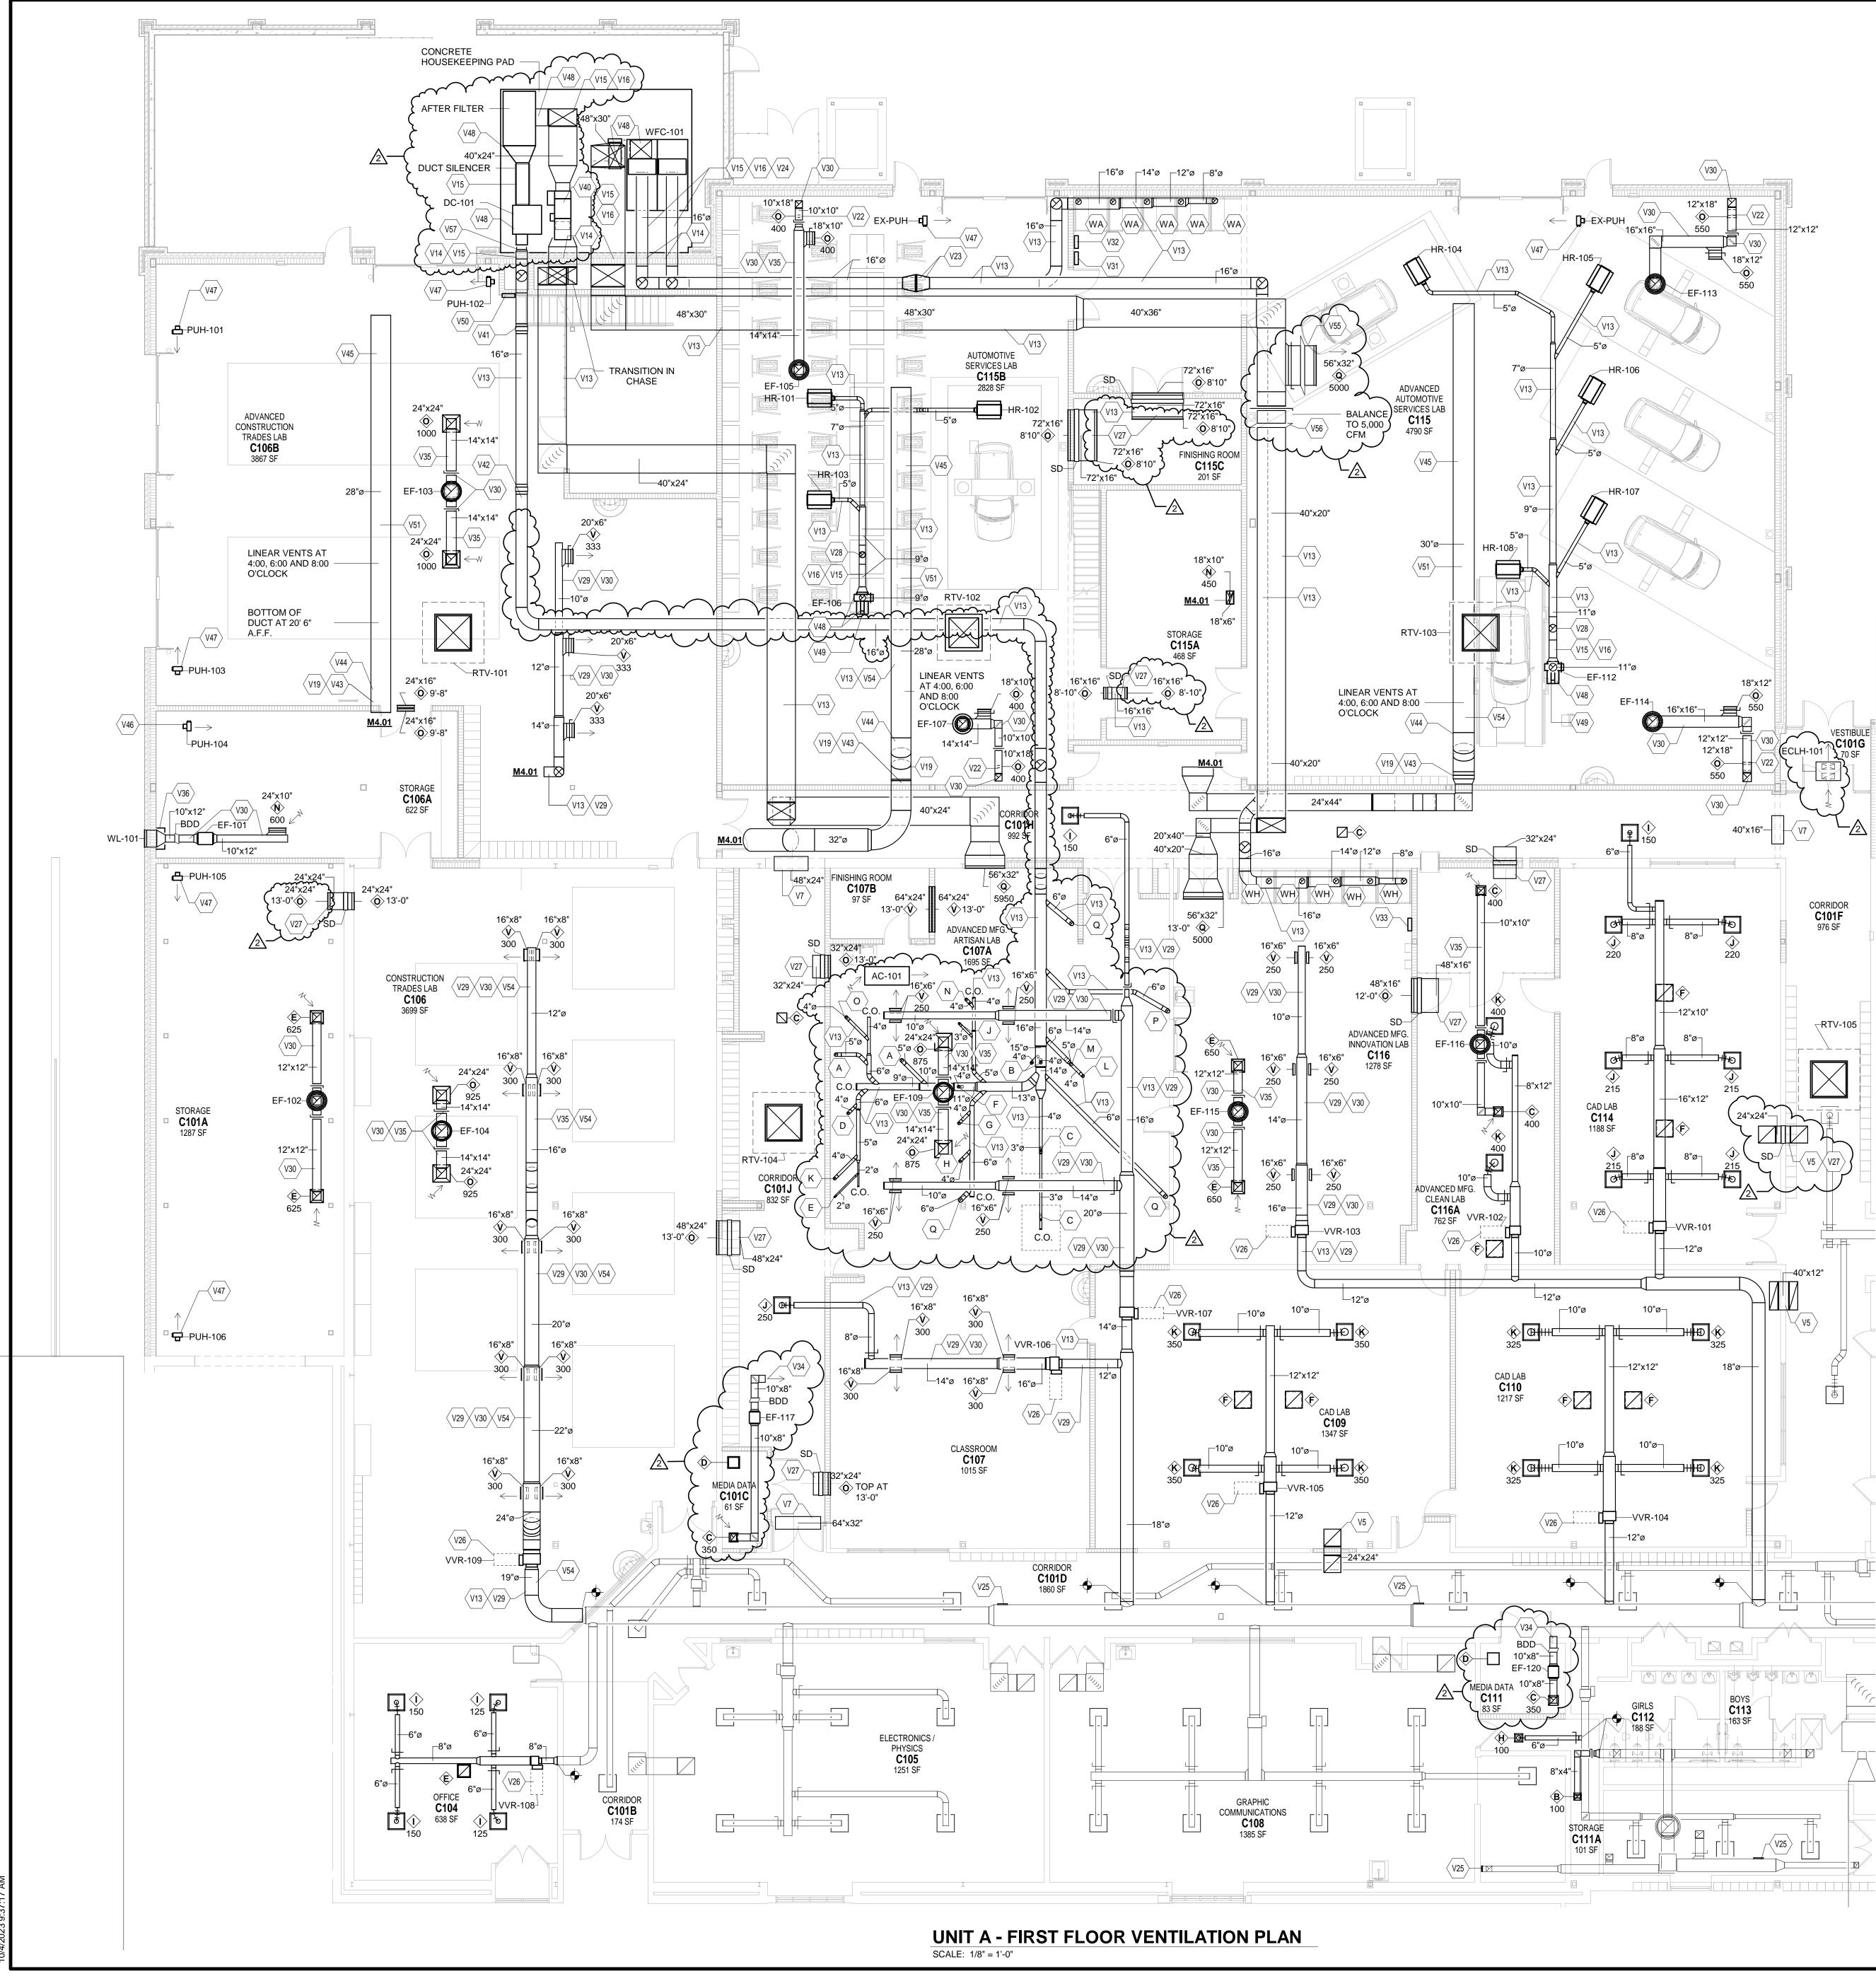



	FILATION PLAN NOTES       X         OTES MAY NOT BE INDICATED ON THIS SHEET)
<u>NO.</u>	DESCRIPTION
V5	ACOUSTICALLY LINED AIR TRANSFER SOUND
V7	TRAP. EXTEND DUCTWORK UP TO PROVIDE NO LINE OF SIGHT FROM OPENING TO OPENING. AIR TRANSFER WALL OPENING LOCATED
	ABOVE CEILING. COORDINATE EXACT LOCATION WITH ALL TRADES.
/13	EXPOSED DUCTWORK TO BE PAINTED. COORDINATE COLOR WITH ARCHITECT/ENGINEER. CLEAN AND PREPARE
	DUCTWORK TO ENSURE PAINT ADHERES TO DUCTWORK.
/14	ROUTE DUCTWORK THROUGH EXTERIOR WALL WITH APPROVED SLEEVE. SEAL ALL PENETRATIONS WATER-TIGHT.
/15	DUCTWORK SHALL BE INSULATED, WRAPPED WITH WATERPROOF MEMBRANE, AND THEN
	PAINTED. COORDINATE EXACT COLOR WITH ARCHITECT/ENGINEER. REFER TO SPECIFICATIONS.
V16 V19	DUCTWORK SHALL BE PROPERLY SUPPORTED. DUCTWORK PROVIDED WITH INTERNAL LINED
√22	INSULATION. MOUNT BOTTOM OF GRILLE AT 1'-4" AFF.
V23	WELDING SPARK ARRESTOR. REFER TO SPECIFICATIONS.
V24	APPROXIMATE LOCATION OF BLAST GATES FOR WELDING EXHAUST SYSTEMS. COORDINATE LOCATION WITH ALL TRADES. REFER TO
/25	SPECIFICATIONS. CAP EXISTING DUCT AT APPROXIMATE
V26	LOCATION. DASHED LINE INDICATES APPROXIMATE CLEARANCE REQUIRED IN FRONT OF UNIT
	CONTROL PANEL. COORDINATE LOCATION WITH ALL TRADES.
/27	INSTALL DUCTWORK SLEEVE AS REQUIRED FOR INSTALLATION OF DUCT MOUNTED SMOKE DETECTOR AND SMOKE DAMPER SMOKE
	DETECTOR AND SMOKE DAMPER. SMOKE DETECTOR PROVIDED AND INSTALLED BY THE ELECTRICAL CONTRACTOR. COORDINATE
/28	EXACT SIZE AND LOCATION WITH ALL TRADES. DUCTWORK SHALL PENETRATE THE ROOF.
	SEAL PENETRATION WATER-TIGHT. COORDINATE EXACT LOCATION WITH ALL TRADES.
/29	PROVIDE DOUBLE WALL INSULATED DUCTWORK.
/30	PAINT EXPOSED DUCTWORK AND ASSOCIATED AIR DEVICES TO COLOR SELECTED BY
V31	ARCHITECT/ENGINEER. WELDING EXHAUST SYSTEM MAIN CONTROLLER. COORDINATE EXACT LOCATION
√32	CONTROLLER. COORDINATE EXACT LOCATION WITH ALL TRADES. WELDING EXHAUST SYSTEM ON/OFF CONTROL
	PANEL FOR ZONE 1 CONTROL. COORDINATE EXACT LOCATION WITH ALL TRADES.
V33	WELDING EXHAUST SYSTEM ON/OFF CONTROL PANEL FOR ZONE 2 CONTROL. COORDINATE EXACT LOCATION WITH ALL TRADES.
V34	EXACT LOCATION WITH ALL TRADES. END OF DUCT OPEN TO THE PLENUM SPACE ABOVE THE CEILING. OPENING TO BE
<b>V</b> 35	PROTECTED WITH BIRD SCREEN. ROUTE DUCTWORK BETWEEN/THROUGH
	STRUCTURAL STEEL. COORDINATE WITH ALL TRADES.
√36	PROVIDE DRIP PAN UNDER WALL LOUVER. DRIF PAN SHALL EXTEND A MINIMUM OF 6" BEYOND DUCTWORK.
V40	HEAVY DUTY WELDED AND BOLTED FAST ACTING ABORT GATE WITH WEATHER HOOD.
	REFER TO SPECIFICATION SECTION 238054. SUPPORT AND TRANSITION DUCTWORK AS REQUIRED.
V41	DUST COLLECTION FIRE PROTECTION SYSTEM EXTINGUISHING SYSTEM COMPLETE WITH
	SOLENOID VALVE, DIRECTIONAL SIDEWALL NOZZLE(S), STRAINER, SHUT-OFF VALVE WITH
	LOCK STRAP AND STAINLESS STEEL MOUNTING ATTACHMENT. COORDINATE EXACT LOCATION WITH MANUFACTURERS INSTALLATION
V42	REQUIREMENTS AND WITH ALL TRADES. DUST COLLECTION SYSTEM FIRE PROTECTION
	SYSTEM SPARK DETECTOR(S) COMPLETE WITH MOUNTING HARDWARE. COORDINATE QUANTITIES AND EXACT LOCATION WITH
	MANUFACTURERS INSTALLATION REQUIREMENTS AND WITH ALL TRADES.
V43	PAINT EXPOSED SHEET METAL DUCTWORK TO MATCH FABRIC DUCT COLOR.
V44	TRANSITION SHEET METAL TO FABRIC DUCT. REFER TO DETAIL ON SHEET M5.04.
V45	INSTALL FABRIC DUCTWORK WITH 1-ROW SUSPENSION SYSTEM WITH INTERNAL HOOPS. REFER TO DETAIL AN SHEET M5.04.
V46	SUPPORT UNIT HEATER FROM STRUCTURE ABOVE WITH SUPPLEMENTAL STEEL AND
117	THREADED RODS AS REQUIRED. MOUNT BOTTOM OF UNIT AT 8'-0" AFF.
V47	SUPPORT UNIT HEATER FROM STRUCTURE ABOVE WITH SUPPLEMENTAL STEEL AND THREADED RODS AS REQUIRED. MOUNT
V48	BOTTOM OF UNIT AT 9'-0" AFF. TRANSITION DUCTWORK AS REQUIRED TO
V49	MAKE FINAL CONNECTION TO EXHAUST FAN. PROVIDE DUCTWORK FROM FAN OUTLET AND EXTEND VERTICALLY ARREQUIMATELY 5' 0"
	EXTEND VERTICALLY APPROXIMATELY 5'-0". TERMINATE WITH STACK HEAD VERTICAL DISCHARGE. PROVIDE GUY WIRE BRACING.
	REFER TO DETAIL ON DRAWING M5.04. PAINT DUCTWORK TO COLOR SELECTED BY
V50	ARCHITECT/ENGINEER. DUST COLLECTION SYSTEM FIRE PROTECTION SYSTEM CONTROL PANEL. SINGLE ZONE WITH
	ALARM, EMERGENCY BATTERY BACKUP, MAIN FIRE RELAY, MAIN FIRE FAULT RELAY AND
	DELAYED EQUIPMENT SHUT DOWN CAPABILITY CONTROL PANEL SHALL BE WALL MOUNTED. COORDINATE EXACT LOCATION WITH ALL
√51	TRADES. ADJUSTABLE AIRFLOW DEVICE BY THE FABRIC
v U I	ADJUSTABLE AIRFLOW DEVICE BY THE FABRIC DUCT MANUFACTURER. REFER TO DETAIL ON SHEET M5.04.
V54	DUCTWORK TO BE ROUTED AS HIGH AS POSSIBLE
/55	WELDING EXHAUST SYSTEM ZONE 1 CONTROL DAMPER AND TWO-POSITION OPERATOR TO BE PROVIDED BY THE TEMPERATURE CONTROL
	CONTRACTOR AND INSTALLED BY THE MECHANICAL CONTRACTOR. TEMPERATURE
	CONTROL CONTRACTOR TO PROVIDE INTER-CONNECTING CONTROL WIRING FROM CONTROL DAMPER TO WELDING EXHAUST
	SYSTEM CONTROL PANEL. CONTROL DAMPER TO OPEN AND CLOSE WITH ZONE 1 WELDING
/56	EXHAUST SYSTEM OPERATION. WELDING EXHAUST SYSTEM ZONE 2 CONTROL
	DAMPER AND TWO-POSITION OPERATOR TO BE PROVIDED BY THE TEMPERATURE CONTROL
	CONTRACTOR AND INSTALLED BY THR MECHANICAL CONTRACTOR. TEMPERATURE CONTROL CONTRACTOR TO PROVIDE
	INTER-CONNECTING CONTROL WIRING FROM CONTROL DAMPER TO WELDING EXHAUST
	SYSTEM CONTROL PANEL. CONTROL DAMPER TO OPEN AND CLOSE WITH ZONE 2 WELDING EXHAUST SYSTEM OPERATION.
V57	VIGIFLAP EXPLOSION INLET ISOLATION VALVE PROVIDED BY WOOD DUST COLLECTION
	SYSTEM UNIT MANUFACTURER AND INSTALLED BY THE MECHANICAL CONTRACTOR.

١	/ENTILATION PLAN GENERAL NOTES
A	CONCEALED ABOVE THE CEILING AND WITHIN WALLS,
B	UNLESS OTHERWISE NOTED. B. REFER TO THE SPECIFICATIONS FOR REQUIREMENTS RELATED TO EQUIPMENT QUALITY, CONSTRUCTION
C	AND FINISH OF MATERIALS. ARRANGE DUCTWORK, PIPING, ETC. TO ALLOW FOR
	EASY ACCESS TO COILS, VALVES, DAMPERS AND CONTROLS. KEEP AREAS ADJACENT TO ACCESS PANELS FREE AND CLEAR OF ANY OBSTRUCTIONS.
C	AND/OR WALLS IN ACCORDANCE WITH MECHANICAL
	CODE AND SMACNA REQUIREMENTS. SEAL DUCT PENETRATIONS THROUGH FIRE RATED FLOORS AND/OR WALLS WITH A MATERIAL HAVING SAME FIRE
E	RATING AS THE WALL AND/OR FLOOR. MECHANICAL CONTRACTOR IS RESPONSIBLE FOR HIS RESPECTIVE WORK FOR REPAIRING AND PATCHING TO
	MATCH EXISTING SURFACES, SIDEWALKS, STREETS, FLOORS, WALLS, ROOFS, CEILING AND PAVEMENT.
F	ALL RECTANGULAR SHEET METAL DUCT SIZES SHOWN ARE INSIDE FREE AREA DIMENSIONS. ALL ROUND DUCT SIZES SHOWN ARE INSIDE DIAMETERS.
G	B. PROVIDE BALANCING DAMPER AT EACH DUCT BRANCH, SERVING DIFFUSER, GRILLE AND REGISTER.
F	SENSORS, HUMIDISTATS, ETC. 44" ABOVE THE FINISH
I.	FLOOR IN ACCORDANCE WITH ADA REQUIREMENTS. COORDINATE ALL REQUIRED WALL, ROOF AND FLOOR OPENINGS (BOTH DIMENSIONS AND LOCATIONS) WITH
J	ALL OTHER TRADES. COORDINATE MECHANICAL SYSTEM INSTALLATION
	WITH STRUCTURE, PLUMBING, FIRE PROTECTION , TECHNOLOGY SYSTEMS, ELECTRIAL SYSTEMS, AND LIGHTING LAYOUT.
k	PROVIDE ALL NECESSARY TRANSITIONS TO EQUIPMENT FROM SIZES SHOWN ON PLAN.
L	. COORDINATE DIFFUSER AND GRILLE LOCATIONS WITH ARCHITECTURAL REFLECTED CEILING PLANS AND EQUIPMENT PLANS. DIFFUSER/GRILLES TO BE
N	CENTERED IN CEILING PADS. 1. MAIN SUPPLY AIR DUCTWORK TO BE MEDIUM
	PRESSURE RATED PER SMACNA REQUIREMENTS FROM AIR HANDLING UNITS TO TERMINAL UNITS. DUCTWORK
	BRANCES FROM TERMINAL UNITS TO AIR DEVICES SHALL BE LOW PRESSURE RATED PER SMACNA REQUIREMENTS.
Ν	PIPING, DUCTWORK, HANGERS, FIRE PROTECTION, ETC,
	SHALL BE INSULATED WITHIN 36" OF THE CONTROL PANEL. THE UNIT SHALL NOT BE INSTALLED DIRECTLY ABOVE LIGHT FIXTURE OR CEILING TILE WITH SPEAKER,
C	OCCUPANCY SENSOR, FIRE SPRINKLER, ETC. ALL VVR TERMINAL UNITS, MSCU, BCU, FIRE DAMPERS,
	SMOKE DAMPER, AND INLINE EXHAUST FANS SHALL BE INSTALLED WITHIN TWO FEET OF THE CEILING FOR MAINTENANCE ACCESS.
F	
C	2. COORDINATE WALL LOUVER LOCATIONS WITH ARCHITECTURAL EXTERIOR ELEVATIONS.


VERIFICATION NOTE

CONTRACTOR SHALL VERIFY ALL DIMENSIONS AND CLEARANCES AND ALL EXISTING FIELD CONDITIONS BEFORE STARTING CONSTRUCTION. COMMENCEMENT OF WORK CONSTITUTES ACCEPTANCE OF CONDITIONS. SHOULD DIFFERENT CONDITIONS BE ENCOUNTERED, CONTACT THE ARCHITECT BEFORE PROCEEDING WITH WORK.

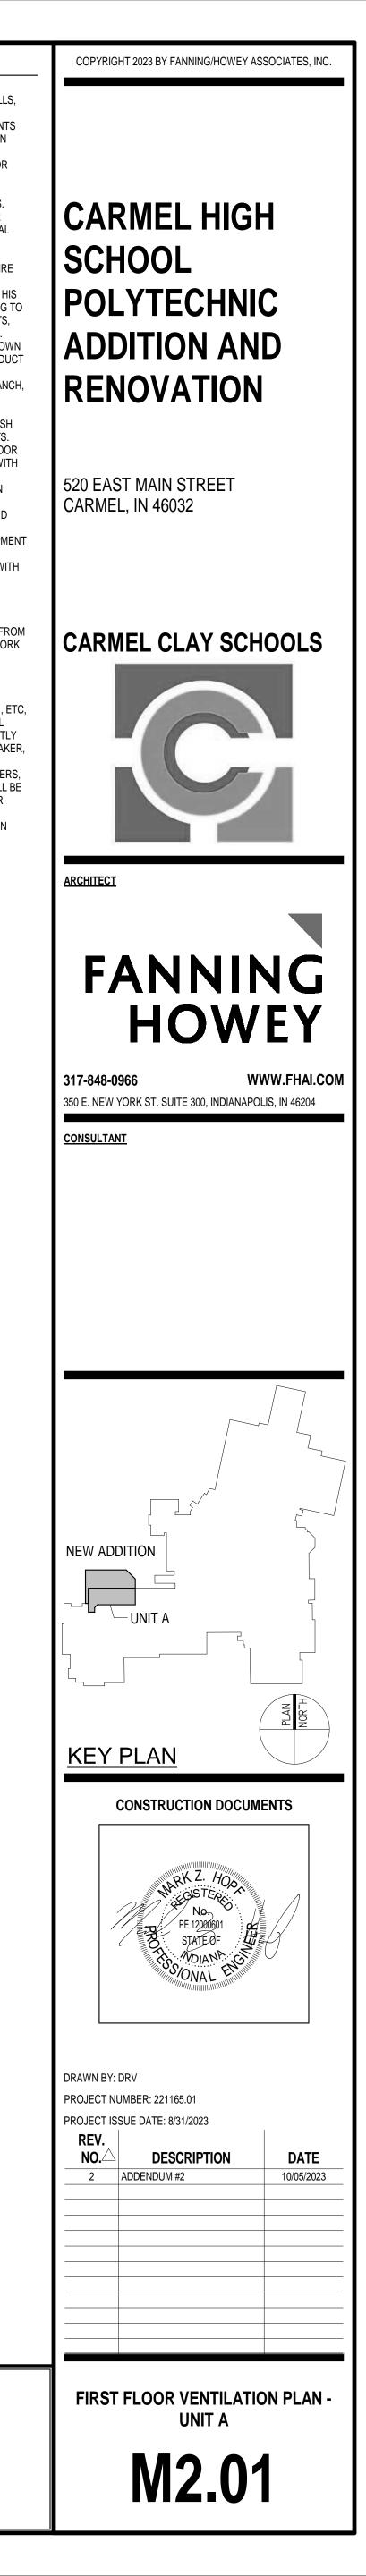

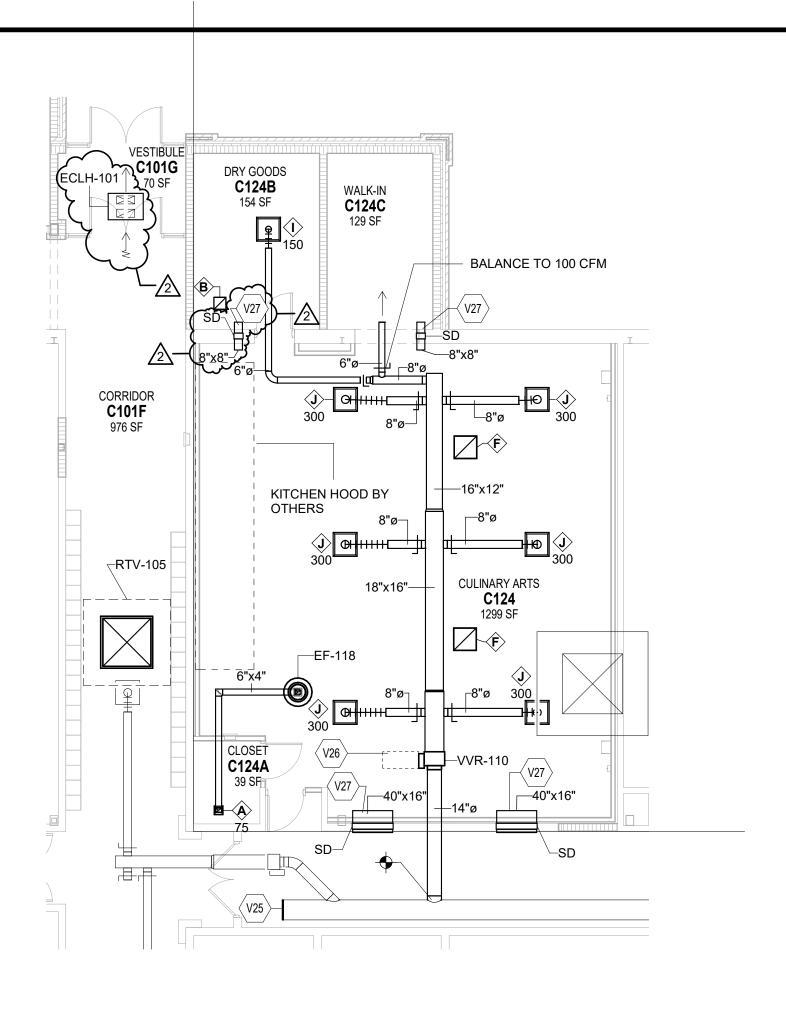

UNIT B - FIRST FLOOR VENTILATION PLAN SCALE: 1/8" = 1'-0"

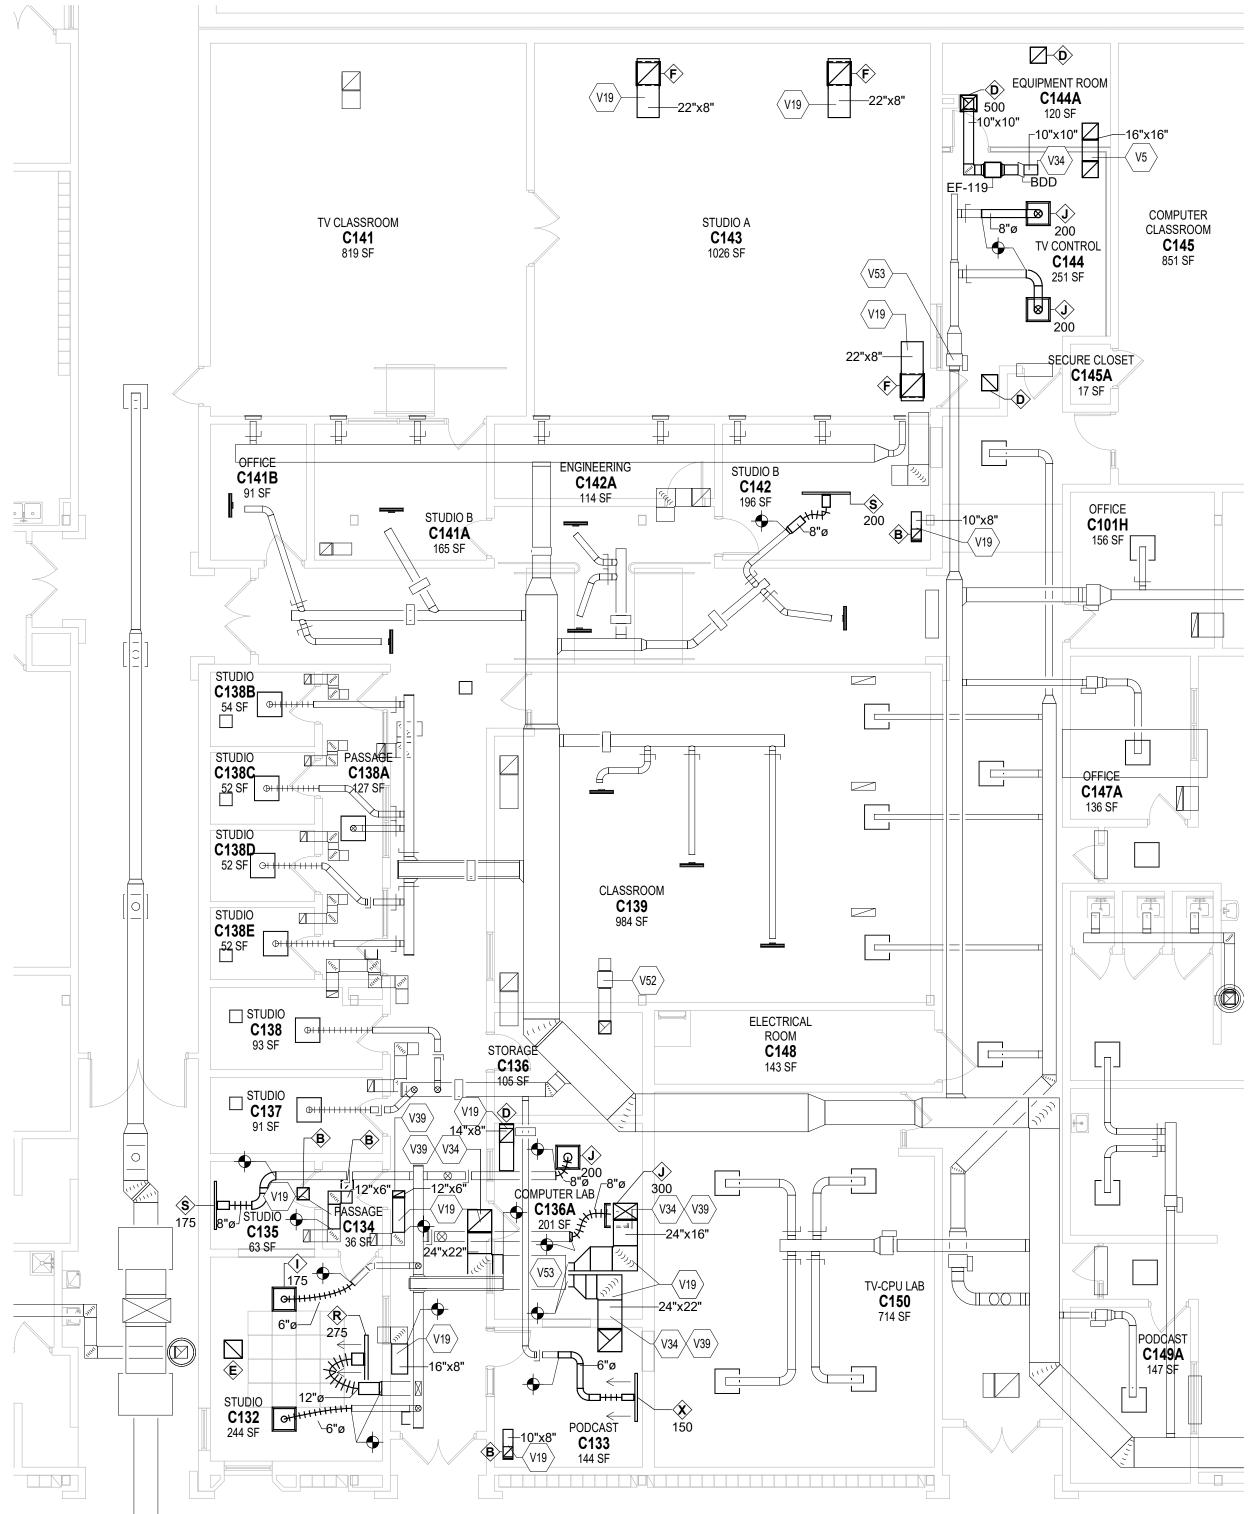



**UNIT C - FIRST FLOOR VENTILATION PLAN** SCALE: 1/8" = 1'-0"

A.	ALL DUCTWORK, PIPING AND VALVES SHALL BE CONCEALED ABOVE THE CEILING AND WITHIN WALLS,
B.	UNLESS OTHERWISE NOTED. REFER TO THE SPECIFICATIONS FOR REQUIREMENTS
•	RELATED TO EQUIPMENT QUALITY, CONSTRUCTION AND FINISH OF MATERIALS.
C.	ARRANGE DUCTWORK, PIPING, ETC. TO ALLOW FOR EASY ACCESS TO COILS, VALVES, DAMPERS AND CONTROLS. KEEP AREAS ADJACENT TO ACCESS
D.	PANELS FREE AND CLEAR OF ANY OBSTRUCTIONS. SEAL DUCT PENETRATIONS THROUGH THE FLOOR
D.	AND/OR WALLS IN ACCORDANCE WITH MECHANICAL CODE AND SMACNA REQUIREMENTS. SEAL DUCT
	PENETRATIONS THROUGH FIRE RATED FLOORS AND/OR WALLS WITH A MATERIAL HAVING SAME FIRE
E.	RATING AS THE WALL AND/OR FLOOR. MECHANICAL CONTRACTOR IS RESPONSIBLE FOR HIS
	RESPECTIVE WORK FOR REPAIRING AND PATCHING TO MATCH EXISTING SURFACES, SIDEWALKS, STREETS,
F.	FLOORS, WALLS, ROOFS, CEILING AND PAVEMENT. ALL RECTANGULAR SHEET METAL DUCT SIZES SHOWN
	ARE INSIDE FREE AREA DIMENSIONS. ALL ROUND DUCT SIZES SHOWN ARE INSIDE DIAMETERS.
G.	PROVIDE BALANCING DAMPER AT EACH DUCT BRANCH, SERVING DIFFUSER, GRILLE AND REGISTER.
H.	INSTALL WALL THERMOSTATS, TEMPERATURE SENSORS, HUMIDISTATS, ETC. 44" ABOVE THE FINISH
Ι.	FLOOR IN ACCORDANCE WITH ADA REQUIREMENTS. COORDINATE ALL REQUIRED WALL, ROOF AND FLOOR
	OPENINGS (BOTH DIMENSIONS AND LOCATIONS) WITH ALL OTHER TRADES.
J.	COORDINATE MECHANICAL SYSTEM INSTALLATION WITH STRUCTURE, PLUMBING, FIRE PROTECTION ,
	TECHNOLOGY SYSTEMS, ELECTRIAL SYSTEMS, AND LIGHTING LAYOUT.
K.	PROVIDE ALL NECESSARY TRANSITIONS TO EQUIPMENT FROM SIZES SHOWN ON PLAN.
<u> </u>	COORDINATE DIFFUSER AND GRILLE LOCATIONS WITH ARCHITECTURAL REFLECTED CEILING PLANS AND
	EQUIPMENT PLANS. DIFFUSER/GRILLES TO BE CENTERED IN CEILING PADS.
И.	MAIN SUPPLY AIR DUCTWORK TO BE MEDIUM PRESSURE RATED PER SMACNA REQUIREMENTS FROM
	AIR HANDLING UNITS TO TERMINAL UNITS. DUCTWORK BRANCES FROM TERMINAL UNITS TO AIR DEVICES SHALL BE LOW PRESSURE RATED PER SMACNA
N.	REQUIREMENTS. VAV BOXES SHALL BE INSTALLED SUCH THAT NO
ν.	PIPING, DUCTWORK, HANGERS, FIRE PROTECTION, ETC, SHALL BE INSULATED WITHIN 36" OF THE CONTROL
	PANEL. THE UNIT SHALL NOT BE INSTALLED DIRECTLY ABOVE LIGHT FIXTURE OR CEILING TILE WITH SPEAKER,
0.	OCCUPANCY SENSOR, FIRE SPRINKLER, ETC. ALL VVR TERMINAL UNITS, MSCU, BCU, FIRE DAMPERS,
	SMOKE DAMPER, AND INLINE EXHAUST FANS SHALL BE INSTALLED WITHIN TWO FEET OF THE CEILING FOR
P.	MAINTENANCE ACCESS. COORDINATE WALL MOUNTED DIFFUSER LOCATION
Q.	WITH ARCHITECTURAL INTERIOR ELEVATIONS. COORDINATE WALL LOUVER LOCATIONS WITH
	ARCHITECTURAL EXTERIOR ELEVATIONS.
VEN	TILATION PLAN NOTES
	OTES MAY NOT BE INDICATED ON THIS SHEET)
	DECODIDITION
<u>.</u>	DESCRIPTION








/5 /19 /25 /26 /27 /34 /39 /52	ACOUSTICALLY LINED AIR TRANSFER SOUND TRAP. EXTEND DUCTWORK UP TO PROVIDE NO LINE OF SIGHT FROM OPENING TO OPENING. DUCTWORK PROVIDED WITH INTERNAL LINED INSULATION. CAP EXISTING DUCT AT APPROXIMATE LOCATION. DASHED LINE INDICATES APPROXIMATE CLEARANCE REQUIRED IN FRONT OF UNIT CONTROL PANEL. COORDINATE LOCATION WITH ALL TRADES. INSTALL DUCTWORK SLEEVE AS REQUIRED FOR INSTALLATION OF DUCT MOUNTED SMOKE DETECTOR AND SMOKE DAMPER. SMOKE DETECTOR PROVIDED AND INSTALLED BY THE ELECTRICAL CONTRACTOR. COORDINATE EXACT SIZE AND LOCATION WITH ALL TRADES END OF DUCT OPEN TO THE PLENUM SPACE ABOVE THE CEILING. OPENING TO BE PROTECTED WITH BIRD SCREEN. EXTEND DUCTWORK UP APPROXIMATELY 24". COORDINATE EXACT LOCATION WITH EXISTING CONDITIONS AND WITH ALL TRADES. BALANCE EXISTING EXHAUST FAN TO 500 CFM REBALANCE EXISTING MECHANICAL UNIT TO






VERIFICATION NOTE


CONTRACTOR SHALL VERIFY ALL DIMENSIONS AND CLEARANCES AND ALL EXISTING FIELD CONDITIONS BEFORE STARTING CONSTRUCTION. COMMENCEMENT OF WORK CONSTITUTES ACCEPTANCE OF CONDITIONS. SHOULD DIFFERENT CONDITIONS BE ENCOUNTERED, CONTACT THE ARCHITECT BEFORE PROCEEDING WITH WORK.

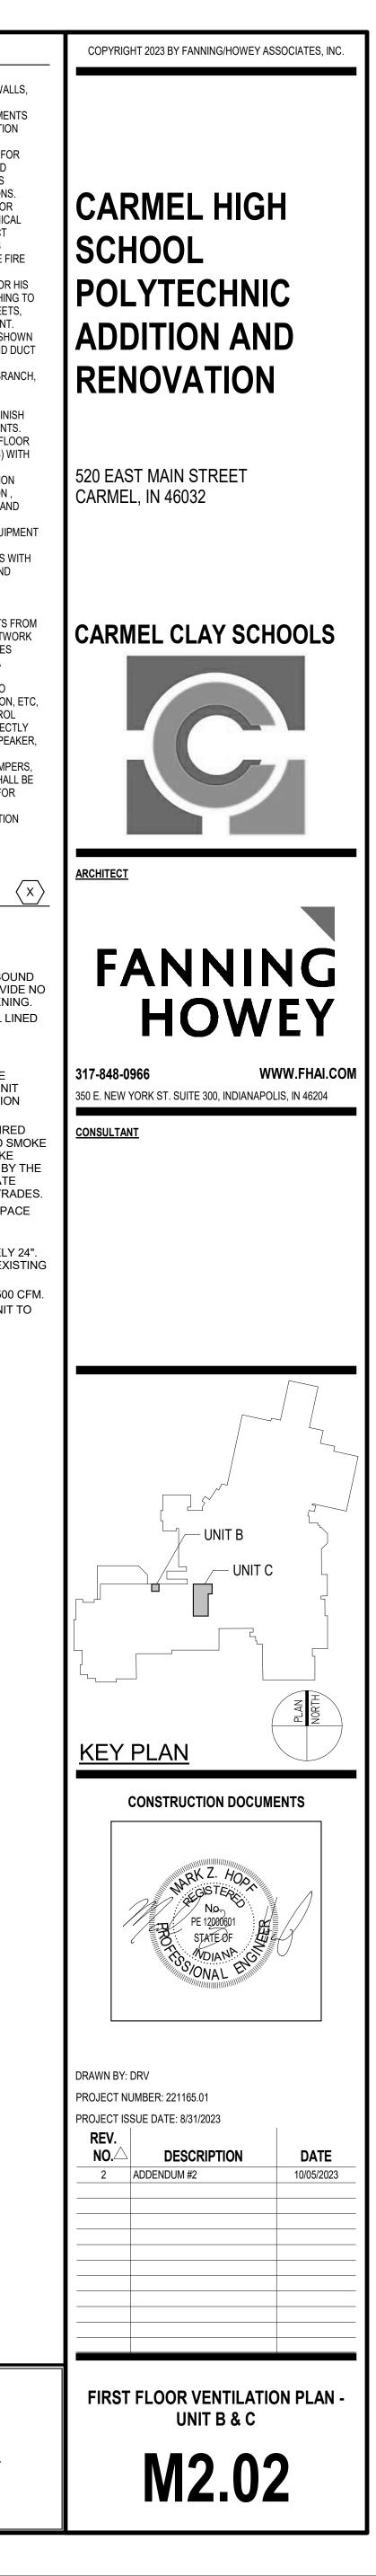

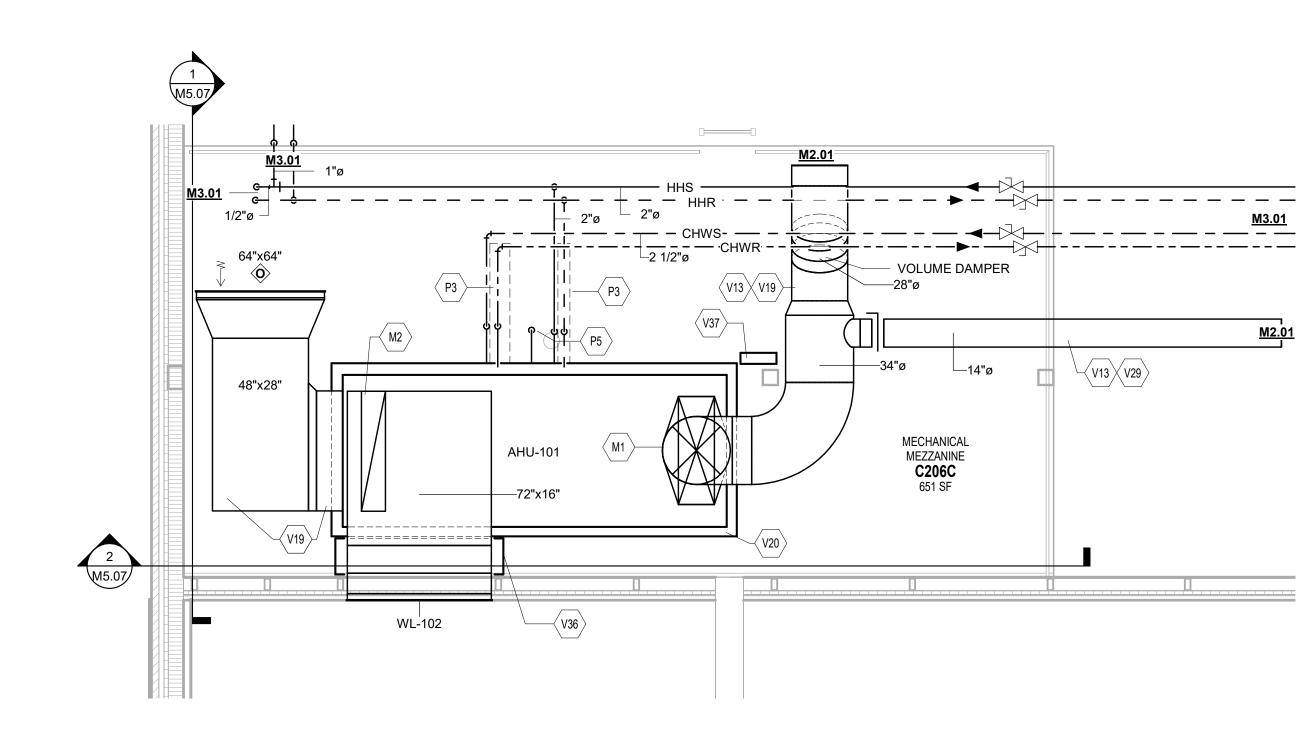

AHU-101 MEZZANINE PLAN SCALE: 1/4" = 1'-0"

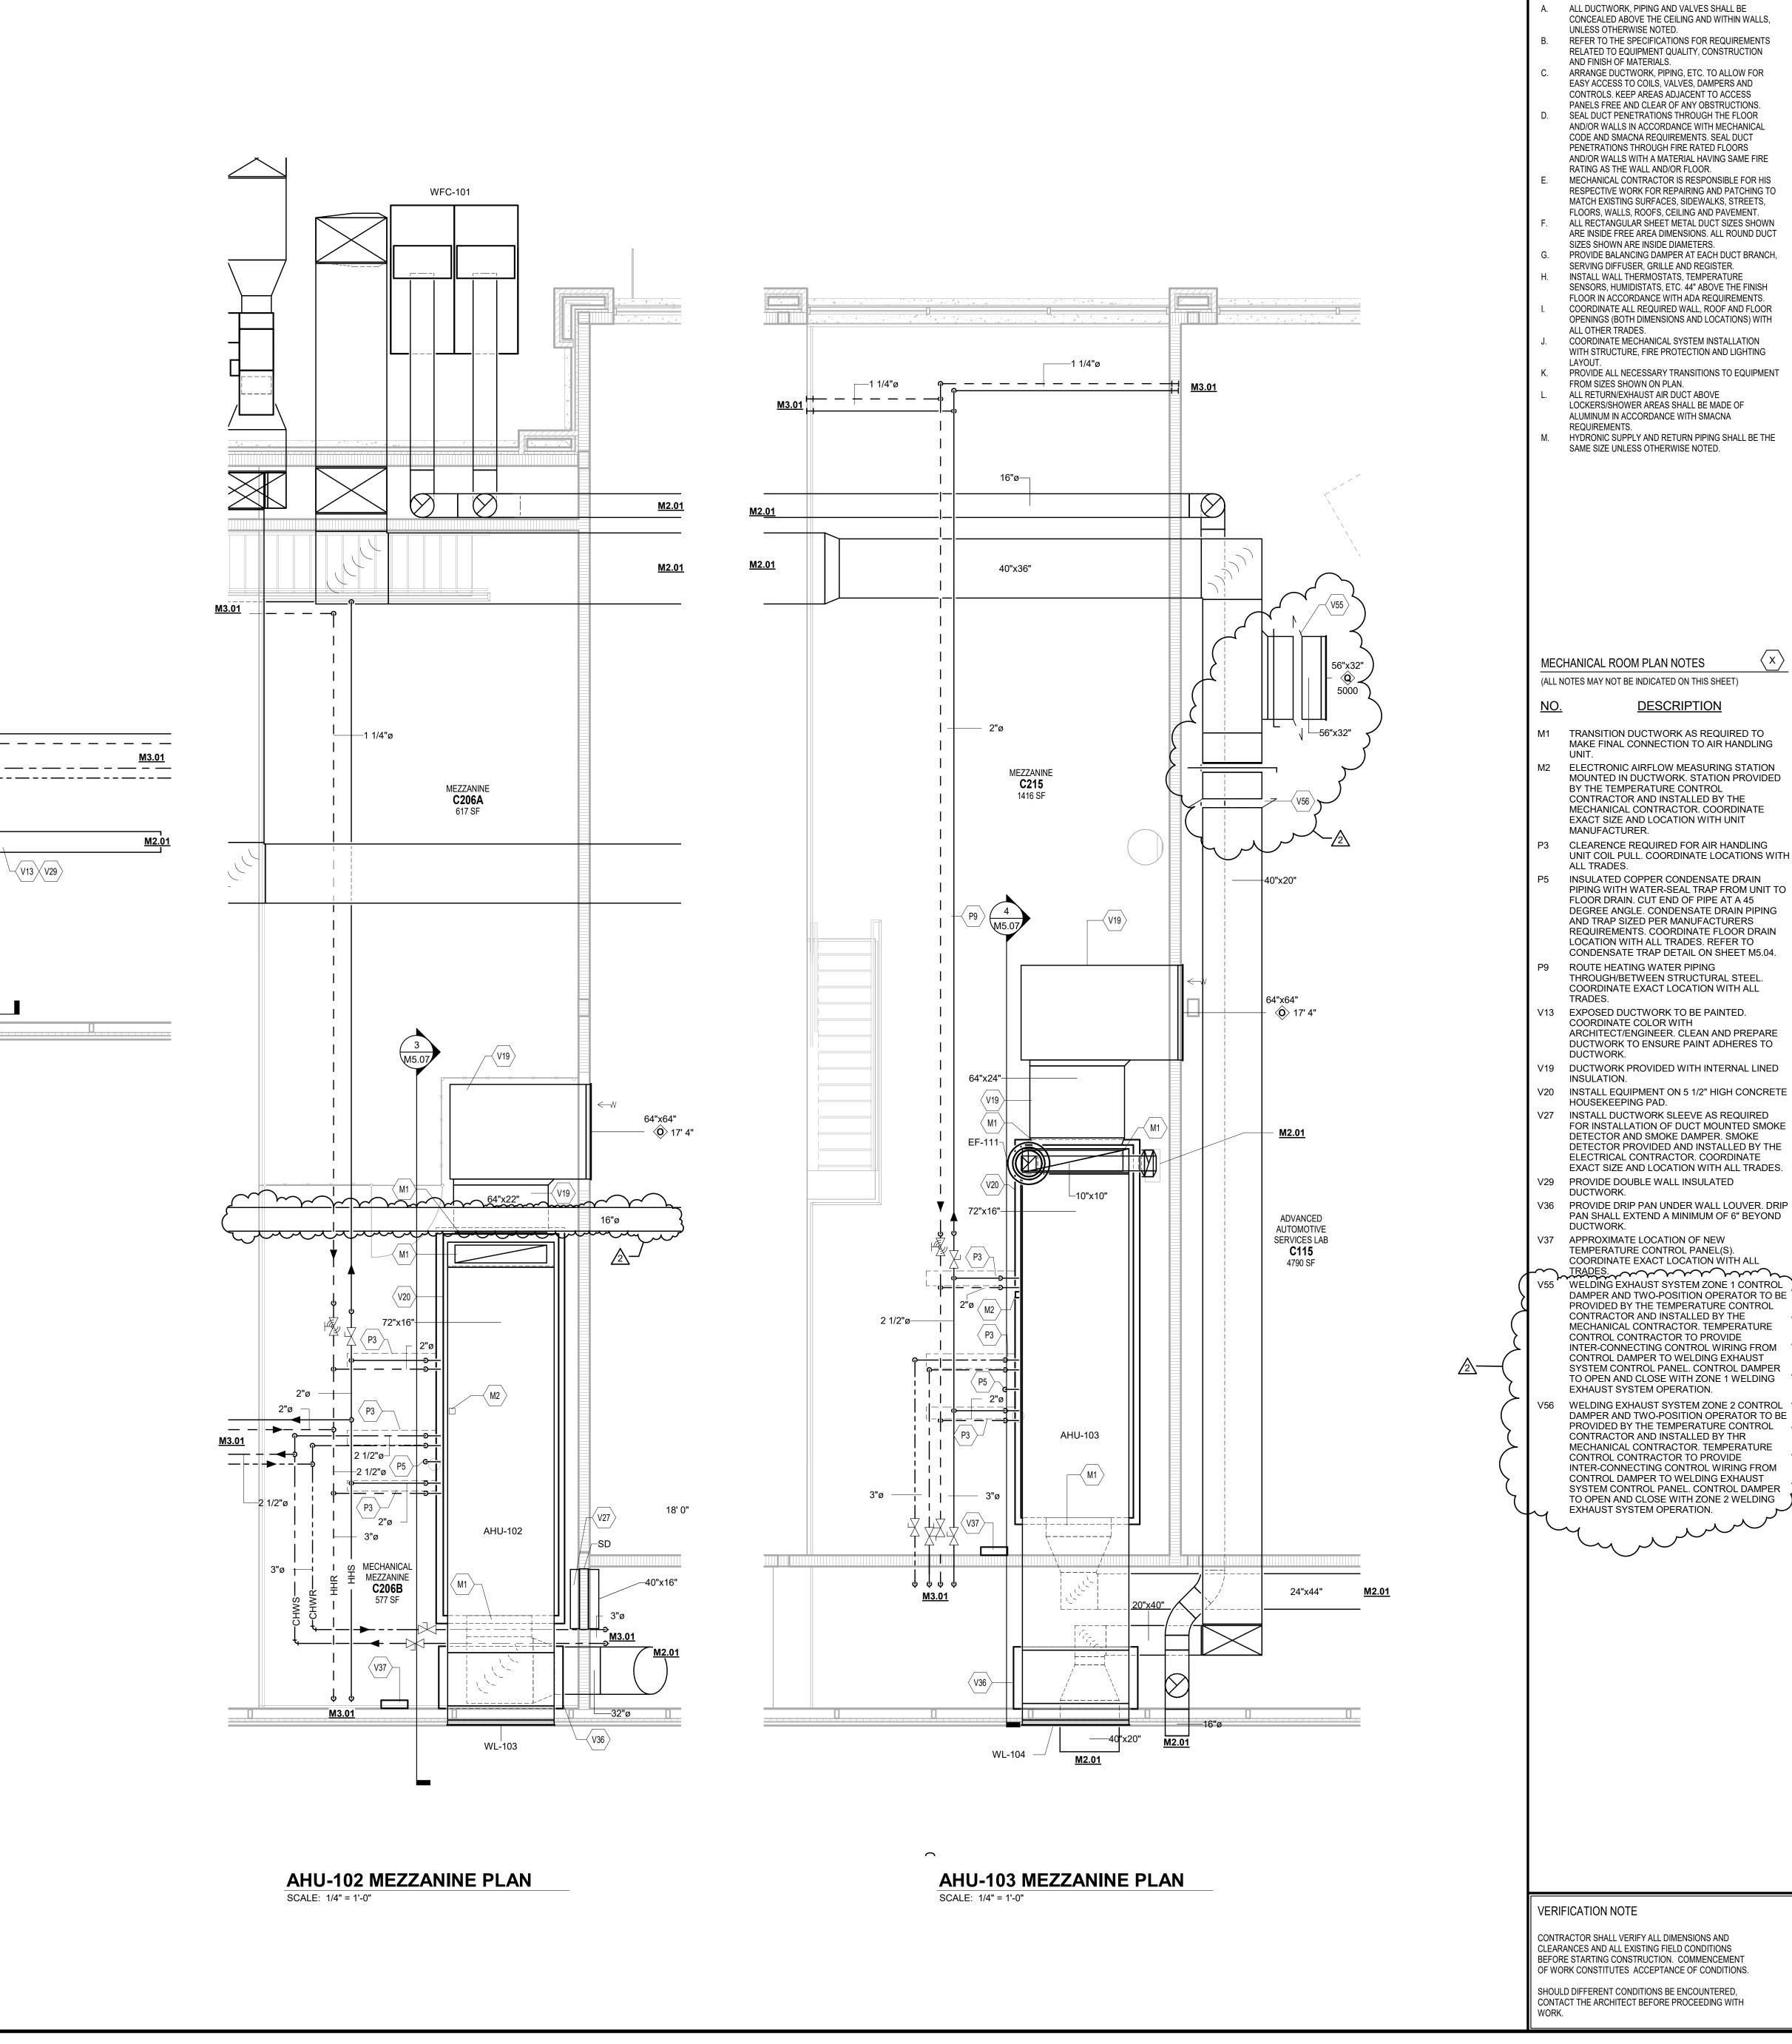

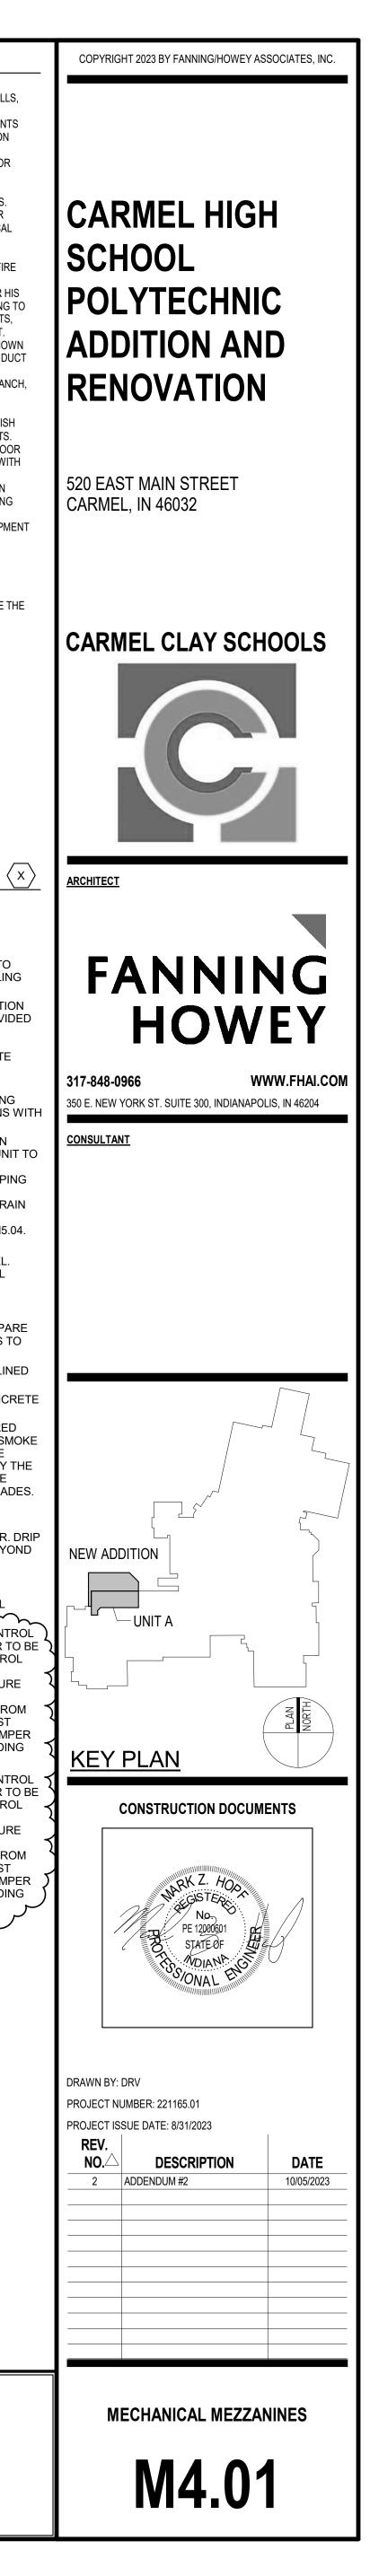

MECHANICAL ROOM PLAN GENERAL NOTES

				A	AIR HANDLING UNIT	I SCHEDULE															ROOFTOF	P VENTILA	TOR/INTAKE I	HOOD SCHE	EDULE		
		FANS						COIL	S											MARK	THROAT	THROAT	BACKDRAFT	RELIEF CONTROL	CFM	DRIP	MODI
MARK		MIN. EXT. TOTAL BHP						,		PRE HEATIN					MODEL NO.	NOTES				RTV-101	LENGTH 48"	48"	DAMPER     BAROMETRIC	DAMPER YES	7,000	PAN YES	FABRA HOOD
	CFM O	.A. CFM S.P. S.P.	HP TYP		LEC. EAT LA	SENS. T	OTAL			MBH GPM	LWT APD	WPD EAT LAT MBH		PD WPD						RTV-102	42"	42"	BAROMETRIC	YES	6,000	YES	FABRA HOOD
AHU-101	7,000	1,750 1.25 3.95 6.5	(2)3.8 EC450		60/3 78.8 55.3 54.2 5	53.5 188.26 2	248.58 41.3	54.0 0.85 4.2				- 51.0 95.9 343.53	22.5 180.0 149.4 0	0.20 8.5	CAH016GDCM	1,2,3,4,5,6,7,8,9,10,11				RTV-103 RTV-104	48" 48"	48" 48"	BAROMETRIC BAROMETRIC	YES YES	7,000 6,600	YES YES	FABRA HOOI
AHU-102	6,000 2,	100-6,000 1.25 3.34 4.8	(2)3.8 ECM FAN EC450		60/3 90.0 53.5 74.0	53.0 239.64 4	418.34 68.3	2.0 54.2 0.23 10.7	0.0 47.2	305.60 19.8	180.0 148.9 0.20	7.16     45.0     95.7     332.43	21.9 180.0 0	0.12 7.4	CAH017GDCM	1,2,3,4,5,6,7,8,9,10,11				RTV-105	48"	48"	BAROMETRIC	YES	6,600	YES	FABRA HOOI
AHU-103	7,000 2,	450-7,000 1.25 3.63 6.0	(2)3.8 ECM FAN EC450		60/3 90.0 53.6 74.0	53.2 278.97	42483.56 79.7	2.0 54.1 0.31 6.9	0.0 47.3	356.80 23.1	180.0 148.9 0.32	2         9.33         45.0         97.8         404.31	25.5 180.0 0	0.13 2.2	CAH018GDCM	1,2,3,4,5,6,7,8,9,10,11					SPECIFICATION		23. JRED BY GREENI				
NOTES																				3. HOODS TO 4. COLOR(S)	BE MOUNTED O	N MINIMUM 12 D BY THE ARC	" HIGH ROOF CUI HITECT/ENGINEE TO PROVIDE REL	RB. R.	DAMPER FOR		
<ol> <li>2. REFER</li> <li>3. REFER</li> <li>4. SUPPLY</li> </ol>	TO PROJECT MAI TO SHEET M5.06	AS MANUFACTURED BY DAIKIN. NUAL SECTION 237313. FOR AIR HANDLING UNIT DETAILS. INTEGRATED DRIVE WITH CONNECT.	6 7 8	5. MAXIMUM FILTER FAC 7. TOTAL UNIT STATIC F 8. MAXIMUM COIL FACE	OUNTED CONTROL AIR D CE VELOCITY SHALL BE 5 PRESSURE REFLECTS AV VELOCITY SHALL BE 500 BE SELECTED WITH 100	500 FPM. /ERAGE DIRTY FILTE ) FPM.		10. HEATING COIL SHALL 11. PROVIDE FACTORY I INTERNAL LIGHTS.	MOUNTED C			SUMMER: INDOOR: 75° db/60% RH OUTDOOR: 90.0° db/74.0° wb WINTER: INDOOR: 70° db OUTDOOR: 0° db								ALL ROOFT	OP VENTILATOR:	S UNLESS NO	TED OTHERWISE				
					TER, AND GRILLE S															[							
		EXAMPLE MANUFACTUEF	R NECK	OVERALL	MAX CORE/		MAX. NOISE	FRAME/				FA	N	CABINE I/P		NIT HEATER SCHEDULE	EL(	EC MODEL					GPM TDH		SERVICE		
MARK	RETURN/AIR TRANSFER GRILLE	TITUS 355-FL	6"x6"	8"x8"	NECK VEL.(FPM)	MAX. CFM 100	CRITERIA 20	MOUNTING REFER TO REFLECTED CEILING PLAN	PROVID	REMARKS DE ALUMINUM SURFAC ER FOR DUCTED INSTAI		MARK CFM SPE (RP	ED HP -	MBH EA	T LAT	GPM WPD LWT		RV NO.	NOTES	AF	IU-101 CHILLE	ED WATER	15.0 3.0 25.0 5.0	1/4 1/4	115/1 115/1	1,:	DTES ,2,3,4 ,2,3,4
В	RETURN/AIR TRANSFER GRILLE	TITUS 355-FL	10"x10"	12"x12"	500	300	20	REFER TO REFLECTED CEILING PLAN		DE ALUMINUM SURFAC ER FOR DUCTED INSTAI		PUH-101 1,240 LO	N 1/8	56.9 60	101.4	5.7 0.4 160.0	- 120/60		6,7,8,9,13	AF	IU-103 CHILLE		30.0         4.0		115/1		,2,3,4
С	RETURN/AIR TRANSFER GRILLE	TITUS 355-FL	12"x12"	14"x14"	500	425	20	REFER TO REFLECTED CEILING PLAN	PROVIE	DE ALUMINUM SURFAC ER FOR DUCTED INSTAI	CE MOUNT	PUH-102         1,240         LO           PUH-103         1,240         LO           PUH-104         310         LO	N 1/8	56.9         60           56.9         60           9.1         60	101.4 101.4 86.6	5.7         0.4         160.0           5.7         0.4         160.0           0.9         0.2         160.0	- 120/60 - 120/60 - 120/60	)/1 RH-108	6,7,8,9,13           6,7,8,9,13           6,7,8,9,13           6,7,8,9,13	1.			OR INSTALLATIO				IONS
D	RETURN/AIR TRANSFER GRILLE	TITUS 355-FL	14"x14"	16"x16"	500	600	20	REFER TO REFLECTED CEILING PLAN		DE ALUMINUM SURFAC ER FOR DUCTED INSTAI		PUH-105 310 LO PUH-106 310 LO		9.1 60 9.1 60	86.6	0.9         0.2         160.0           0.9         0.2         160.0	- 120/60		6,7,8,9,13 6,7,8,9,13	3.	REFER TO SPEC	IFICATION SE	CTION 232123.				
E	RETURN/AIR TRANSFER GRILLE	TITUS 355-FL	16"x16"	18"x18"	500	800	20	REFER TO REFLECTED CEILING PLAN		DE ALUMINUM SURFAC ER FOR DUCTED INSTAI			1/30	3.1 00	00.0		- 120/00		0,7,0,9,10	4.	POMP SELECTEL		120.				
F	RETURN/AIR TRANSFER GRILLE	TITUS 355-FL	22"x22"	24"x24"	500	1250	20	REFER TO REFLECTED CEILING PLAN	PROVID	DE ALUMINUM SURFAC ER FOR DUCTED INSTAI	CE MOUNT	NOTES 1. COLOR TO BE SELECTE				7. UNIT FURNISHED WITH PROVIDE FOUR-DIRECTION			го		ELECT					JLE	
G	SQUARE PLAQUE CEILING DIFFUSEF	TITUS OMNI	5"	12"x12"	800	100	18	REFER TO REFLECTED CEILING PLAN		AY BLOW DIFFUSERS, L TED OTHERWISE ON D		<ol> <li>2. INCLUDE FACTORY MO</li> <li>3. HORIZONTAL CEILING F</li> </ol>				8. UNITS SCHEDULED ARE		BY RITTLING.		MARK	CFM BTUH	I EAT	LAT	KW S	ELEC SERV M	NODEL NO.	. NOT
Н	SQUARE PLAQUE CEILING DIFFUSEF	TITUS OMNI	6"	12"x12"	800	150	21	REFER TO REFLECTED CEILING PLAN		AY BLOW DIFFUSERS, L TED OTHERWISE ON D		<ol> <li>HORIZONTAL PARTIALL</li> <li>UNIT SCHEDULED WITH</li> </ol>			IRN	9. REFER TO SPECIFICATIO		ID BACK RETURN.		ECLH-101	600 17,00	0 60	75	5.0 4	460/3 RCH	3480 SERIES	1,2,3,4
I	SQUARE PLAQUE CEILING DIFFUSEF	TITUS OMNI	6"	24"x24"	900	175	17	REFER TO REFLECTED CEILING PLAN		AY BLOW DIFFUSERS, L TED OTHERWISE ON D		6. SUPPORT HEATER FRC	M STRUCTURE ABOV			11. UNIT SCEDULED WITH I SUPPLY FAN MOTOR E.S.P		BOTTOM RETURN	۹.	NOTES							
J	SQUARE PLAQUE CEILING DIFFUSEF	TITUS OMNI	8"	24"x24"	900	300	20	REFER TO REFLECTED CEILING PLAN		AY BLOW DIFFUSERS, L TED OTHERWISE ON D		3/8" DIAMETER THREADED	RODS.			12. UNIT SHALL BE PROVID				1. UNITS S	SCHEDULED ARE		TURED BY RAYW	ALL.			
К	SQUARE PLAQUE CEILING DIFFUSEF	TITUS OMNI	10"	24"x24"	800	425	20	REFER TO REFLECTED CEILING PLAN		AY BLOW DIFFUSERS, L TED OTHERWISE ON D										3. REFER	TO SPECIFICATI	ON SECTION 2					
L	SQUARE PLAQUE CEILING DIFFUSEF	TITUS OMNI	12"	24"x24"	800	625	23	REFER TO REFLECTED CEILING PLAN		AY BLOW DIFFUSERS, L TED OTHERWISE ON D											OLTAGE WALL M		PERATURE SENS	OR BY THE TCC.			
М	SQUARE PLAQUE CEILING DIFFUSEF	TITUS OMNI	14"	24"x24"	700	750	20	REFER TO REFLECTED CEILING PLAN		AY BLOW DIFFUSERS, L TED OTHERWISE ON D										6. WHITE	POWDER COATE	D GRILLE.					
Ν	RETURN/AIR TRANSFER GRILLE	TITUS 355-FL	SEE FLOOR PLANS FOR SIZE	-	500	PER PLANS	20	DUCT OR SIDEWALL OR CEILING		ED 35(DEGREE), 1/2" SF DEFLECTION BLADES		VEHICLE	EXHAUST HOSE		DULE												
0	HEAVY DUTY RETURN GRILLE	TITUS 33-RL	SEE FLOOR PLANS FOR SIZE			PER PLANS	20	DUCT OR SIDEWALL		ED 38(DEGREE), 1/2" SF DEFLECTION BLADES		MARK HOSE LENGTH	HOSE DIAMETER			S:				MAX		WABLE SO	UND LEVELS				
Р	SIDEWALL SUPPLY DIFFUSEF	TITUS 300-FL	SEE FLOOR PLANS FOR SIZE	-	300	PER PLANS	20	DUCT OR SIDEWALL		EFLECTION, ADJUSTAB IT SPACING, 3/4" REAR		HR-101         30'-0"           HR-102         30'-0"           HR-103         30'-0"	5"	2.80 2.80 2.80	1,2,3 1,2,3 1,2,3			MARK	UNIT SOUND JNIT SUPPLY DISC	63Hz HARGE 80	125Hz 85	250Hz 87	500Hz 1KH: 82 87	lz 2KHz 80	4KHz 74	8KHz	
Q	HEAVY DUTY SUPPLY DIFFUSEF	TITUS 300RL-HD	SEE FLOOR PLANS FOR SIZE	- I	400	PER PLANS	20	DUCT OR SIDEWALL		EFLECTION, ADJUSTAB		HR-104 30'-0"	5"	2.80	1,2,3												
R	LINEAR SLOT DIFFUSER	TITUS FL-20-HT	SEE FLOOR PLANS FOR SIZE	2-SLOT X 48"L		PER PLANS	20	REFER TO REFLECTED CEILING PLAN		HROW WITH INSULATE 2-2" SLOT WITH DIA." IN		HR-105         30'-0"           HR-106         30'-0"           HR-107         30'-0"	5" 5"	2.80 2.80 2.80	1,2,3 1,2,3 1,2,3			AHU-102 U	JNIT SUPPLY DISC	HARGE 78	82	81	79 86	76	71	68	
S	LINEAR SLOT DIFFUSER	TITUS FL-10-JT	SEE FLOOR PLANS FOR SIZE	1-SLOT X 48"L		PER PLANS	20	REFER TO REFLECTED CEILING PLAN		HROW WITH INSULATED 1-1" SLOT WITH DIA." IN		HR-108 30'-0"	5"	2.80	1,2,3			AHU-103 l	JNIT SUPPLY DISC	HARGE 79	84	83	80 87	77	72	69	
Т	SUPPLY DIFFUSEF	TITUS 300-FS	SEE FLOOR PLANS FOR SIZE		450	PER PLANS	25	DUCT OR SIDEWALL		EFLECTION, ADJUSTAB IT SPACING, 3/4" REAR		NOTES:									FAN SCHE	$\hat{\mathbf{c}}$					
U	LINEAR SLOT DIFFUSER	TITUS FL-15-JT	SEE FLOOR PLANS FOR SIZE	1-SLOT X 48"L		PER PLANS	20	REFER TO REFLECTED CEILING PLAN	JET TH	IROW WITH INSULATED	D PLENUM	1. REFER TO SPECIFI 2. PROVIDE TAILPIPE 3. MOUNT HOSE REEI	ADAPTOR WITH VISE	GRIP.	ITS.	MARK EF-101	X TYPE	CFM 600	FRPM S.	XT.         MAX.           P.         SONES           33         4.8	HP 1/4		A	MODEL SQ-100-VG	DRIV		NOTES 1,2,3,4,6,7
V	SPIRAL SUPPLY DUCT GRILLE	TITUS S300-FL	SEE FLOOR PLANS FOR SIZE	-	450	PER PLANS	20	DUCT		EFLECTION, ADJUSTAB PACING, AIR SCOOP DE						EF-102 EF-103	ROOF ROOF	1,250 2,000		33         9.2           33         11.5	1/2 3/4	115/1 115/1	A	G-120-VG G-140-VG	DIREC		,2,4,5,6,7,8 ,2,4,5,6,7,8
W	ROUND SUPPLY DIFFUSER	AIR CONCEPTS RDDW & RDDW-RD	SEE FLOOR PLANS FOR SIZE	-	550	PER PLANS	15	CEILING AND DUCT		JSTABLE DOUBLE DEFL /ERTICAL AND HORIZON						EF-104 EF-105	ROOF ROOF	1,850 800	1,134 0.	30         10.2           38         6.3	1/2 1/4		B.1 G	G-140-VG G-100-VG	DIREC	CT 1, CT 1,2,	1,2,4,5,6,7,8 2,4,5,6,7,8,17
				1					. –							EF-106	CENTRIFUGA	AL 900	3,116 5	.0 30.0	1-1/2	208/3		USF-12	DIREC	T 1260	8,12,13,14,15, ²

	AIR CLEANING UNIT SCHEDULE												
		MC	DTOR INFO		MODEL	NOTES							
MARK	AIRFLOW	HP	ELEC INFO	DRIVE	MODEL	NOTES							
AC-101	2,200	3/4	115/1	DIERCT	UAS - DA	1,2,3,4,5,6,7							
GENERAL I	GENERAL NOTES												

1. REFER TO SPECIFICATION SECTION 234100 FOR ADDITIONAL REQUIREMENTS.

2. INCLUDE 4 INCH PLEATED PRE-FILTER, 95% EFFICIENT BAG FILTER AND FILTER CONDITION INDICATOR.

3. INCLUDE DIRECTIONAL OUTLET VANES.

4. PROVIDE HINGED ACCESS DOORS ON THE BOTTOM OF THE UNIT.

5. PROVIDE SUPPLEMENTAL STEEL, VIBRATION ISOLATORS AND THREADED ROD HANGERS ON ALL FOUR CORNERS OF

THE UNIT. 6. BOTTOM OF UNIT TO BE MOUNTED AT 10'-0" AFF. COORDINATE FINAL LOCATION OF UNIT WITH ALL TRADES.

7. TOGGLE SWITCH ON/OFF CONTROL PROVIDED BY DIVISION 26.

VAV REHEAT TERMINAL SCHEDULE													
MARK	PRIMARY CFM	MIN PRIMARY CFM	MBH	GPM	INLET DIA	AVAIL. INLET SP	RAD. N.C.	DIS. N.C.	LWT	LAT	# ROWS		
VVR-101	1,450	725	64.12	4.2	12	1.42	18	-	148.6	95.8	2		
VVR-102	800	400	33.62	1.9	10	1.32	-	-	143.0	93.7	2		
VVR-103	1,500	750	64.10	4.0	12	1.58	20	16	146.8	94.4	2		
VVR-104	1,300	650	58.05	3.4	12	1.93	24	20	145.3	96.2	2		
VVR-105	1,400	700	62.63	4.0	12	1.81	24	20	148.3	96.2	2		
VVR-106	1,450	725	64.12	4.2	12	1.49	18	15	148.6	95.8	2		
VVR-107	2,150	1,075	91.32	4.7	14	1.87	22	20	139.7	94.2	2		
VVR-108	550	275	23.22	1.4	8	2.18	22	20	145.9	93.9	4		
VVR-109	3,000	1,500	135.2	6.5	19	2.21	38	32	137.3	96.6	2		
VVR-110	2,050	1,025	94.80	5.8	14	1.58	20	18	146.2	97.6	2		

### GENERAL NOTES:

1. COILS SHALL BE SELECTED WITH 1' WPD MAXIMUM.

2. HEATING COIL DESIGN BASED ON HIGH-EFFICIENCY, HOT WATER COIL.

3. HEATING COIL LOADS CALCULATED WITH 180° EWT, 55° EAT AT TOTAL PRIMARY AIR FLOW.

4. UNIT MANUFACTURER SHALL PROVIDE REQUIRED HANGING BRACKETS TO PROPERLY SUPPORT UNIT. REFER TO DETAILS.

5. UNITS SCHEDULED ARE AS MANUFACTURED BY ETI.

6. UNIT SELECTION MUST ALLOW FOR A MINUMUM 0.50" DOWNSTREAM STATIC PRESSURE.

7. 277/1 VOLT ELECTRICAL SERVICE WILL BE SUPPLIED TO EACH UNIT BY THE ELECTRICAL CONTRACTOR.

8. REFER TO SPECIFICATION SECTION 233600.

# MODEL FABRA HOOD - FGR FABRA HOOD - FGR FABRA HOOD - FGR FABRA HOOD - FGR FABRA HOOD - FGR

MARK	MEDIUM	GPM	TDH	HP	SERVICE	NOTES	
AHU-101	CHILLED WATER	15.0	3.0	1/4	115/1	1,2,3,4	
AHU-102	CHILLED WATER	25.0	5.0	1/4	115/1	1,2,3,4	
AHU-103	CHILLED WATER	30.0	4.0	1/4	115/1	1,2,3,4	

		ELECTRIC HEATING				ELEC			
RK	CFM	BTUH	EAT	LAT	KW	SERV	MODEL NO.	NOTES	
I-101	600	17,000	60	75	5.0	460/3	RCH 3480 SERIES	1,2,3,4,5,6	-

EXHAUST TAN SOTIEDOLL											
				EXT.	MAX.	EL	EC	CONTROL	MODEL	DRIVE	NOTES
MARK	TYPE	CFM	FRPM	S.P.	SONES	HP	SERV	CONTROL	WODEL	DIVIC	NOTES
EF-101	IN-LINE	600	1,053	0.33	4.8	1/4	115/1	А	SQ-100-VG	DIRECT	1,2,3,4,6,7
EF-102	ROOF	1,250	1,206	0.33	9.2	1/2	115/1	А	G-120-VG	DIRECT	1,2,4,5,6,7,8
EF-103	ROOF	2,000	1,216	0.33	11.5	3/4	115/1	B.1	G-140-VG	DIRECT	1,2,4,5,6,7,8
EF-104	ROOF	1,850	1,134	0.30	10.2	1/2	115/1	B.1	G-140-VG	DIRECT	1,2,4,5,6,7,8
EF-105	ROOF	800	1,223	0.38	6.3	1/4	115/1	G	G-100-VG	DIRECT	1,2,4,5,6,7,8,17
EF-106	CENTRIFUGAL	900	3,116	5.0	30.0	1-1/2	208/3	E	USF-12	DIRECT	1,2,6,8,12,13,14,15,16
EF-107	ROOF	800	1,223	0.38	6.3	1/4	115/1	G	G-100-VG	DIRECT	1,2,4,5,6,7,8,17
EF-108	NOT USED										
EF-109	ROOF	1,750	1,098	0.33	9.6	1/2	115/1	B.1	G-140-VG	DIRECT	1,2,4,5,6,7,8
EF-110	NOT USED										
EF-111	ROOF	450	1,397	0.38	6.2	1/10	115/1	A	G-090-VG	DIRECT	1,2,4,5,6,7,8
EF-112	CENTRIFUGAL	1,500	3,103	5.0	30.0	2.0	208/3	E	USF-12	DIRECT	1,2,6,8,12,13,14,15,16
EF-113	ROOF	1,100	1,536	0.43	9.3	1/4	115/1	G	G-100-VG	DIRECT	1,2,4,5,6,7,8,18
EF-114	ROOF	1,100	1,536	0.43	9.3	1/4	115/1	G	G-100-VG	DIRECT	1,2,4,5,6,7,8,18
EF-115	ROOF	1,300	1,240	0.33	9.8	1/2	115/1	B.1	G-120-VG	DIRECT	1,2,4,5,6,7,8
EF-116	ROOF	800	1,223	0.38	6.3	1/4	115/1	B.1	G-100-VG	DIRECT	1,2,4,5,6,7,8
EF-117	IN-LINE	350	1,344	0.33	5.8	1/10	115/1	C	SQ-090-VG	DIRECT	1,2,3,4,6,7
EF-118	ROOF	75	1,539	0.33	3.5	1/15	115/1	A	G-060-VG	DIRECT	1,2,4,5,6,7,8
EF-119	IN-LINE	500	1,373	0.33	6.8	1/4	115/1	C	SQ-95-VG	DIRECT	1,2,3,4,6,7
EF-120	IN-LINE	350	1,344	0.33	5.8	1/10	115/1	C	SQ-090-VG	DIRECT	1,2,3,4,6,7

NOTES

<u>/2\</u>___

1. INCLUDE DISCONNECT SWITCH.

2. INCLUDE BACKDRAFT DAMPER.

4. REFER TO SPECIFICATION SECTION 233423 FOR

ADDITIONAL REQUIREMENTS.

5. MOUNT ON 12" HIGH ROOF CURB.

6. ALL FAN MODELS SPECIFIED AS MANUFACTURED BY GREENHECK.

7. INCLUDE FIELD MOUNTED AND WIRED SPEED CONTROL. 8. COLOR(S) TO BE SELECTED BY ARCHITECT/ENGINEER.

9. INSTALL DRIP PAN UNDER UNIT.

10. ALUMINUM WHITE ENAMEL GRILLE, ISOLATION KIT AND HOODED WALL CAP.

11. HI-PRO POLYESTER FINISH FOR HOUSING, FAN WHEEL, BACK DRAFT DAMPER AND ACCESSORIES.

12. INCLUDE FACTORY MOUNTED AND WIRED VFC FOR UNIT SOFT START AND BALANCING AID.

13. REFER TO SPECIFICATION SECTION 238056 FOR ADDITIONAL REQUIREMENTS.

14. FAN SHALL BE ROOF MOUNTED ON EQUIPMENT SUPPORT RAILS AND

VIBRATION ISOLATORS.

15. PROVIDE WEATHER HOOD TO PROTECT FAN AND MOTOR ASSEMBLY. 16. FAN SHALL BE CONFIGURED WITH A VERTICAL DISCHARGE.

17. EF-105 AND EF-107 SHALL BE INTERLOCKED SO BOTH FANS ARE

COMMANDED ON AT THE SAME TIME FOR SIMULTANEOUS OPERATION.

18. EF-113 AND EF-114 SHALL BE INTERLOCKED SO BOTH FANS ARE COMMANDED ON AT THE SAME TIME FOR SIMULTANEOUS OPERATION.

### CONTROL KEY: A. AUTOMATIC OCCUPIED OPERATION BY LOCAL TEMPERATURE

CONTROL ZONE.

B. MANUAL CONTROLS BY DIVISION 26. .1 WITH TIMER SWITCH.

.2 WITH ON/OFF SWITCH. .3 WITH ROOM LIGHT SWITCH.

C. AUTOMATIC OPERATION BY REVERSE-ACTING THERMOSTAT.


D. 24 HOUR CONTINUOUS OPERATION.


E. PUSH BUTTON PROVIDED BY DIVISION 26.


F. PRESURE SENSING SWITCH PROVIDED BY EXAHUST FAN MANUFACTURER.


G. TIMER SWITCH CONTROL BY DIVISION 26 AND AUTOMATIC OPERATION BY CARBON MONOXIDE DETECTOR BY THE TEMPERATURE CONTROL CONTRACTOR.



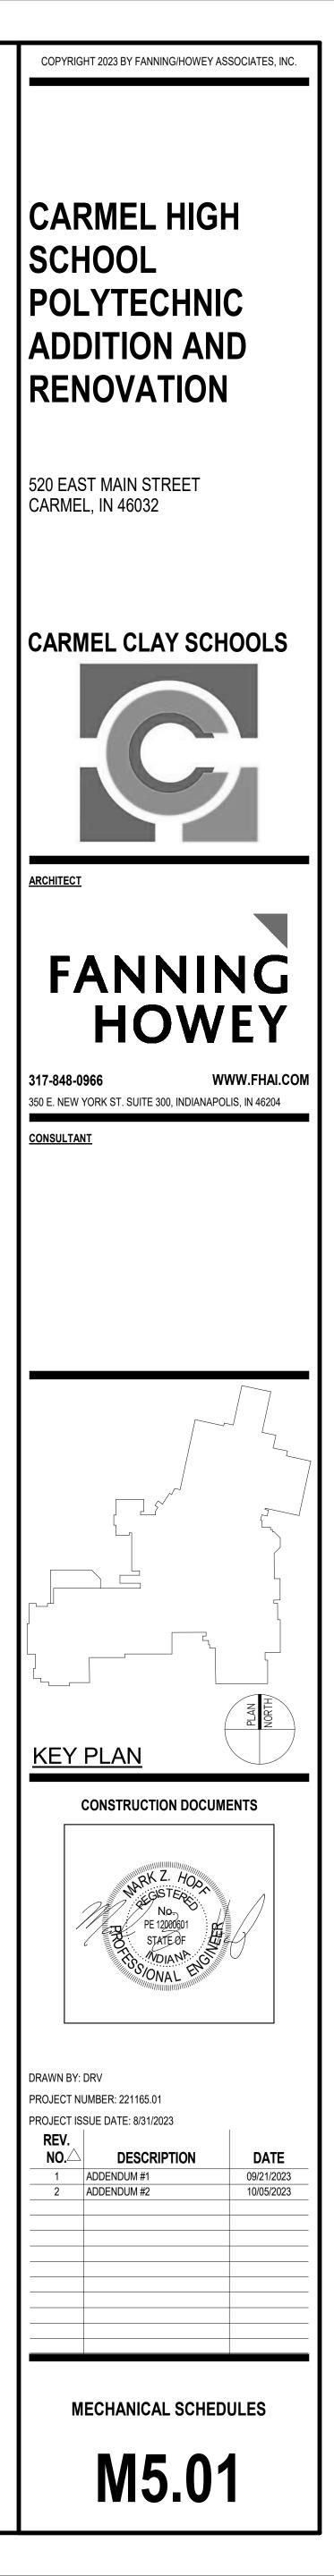


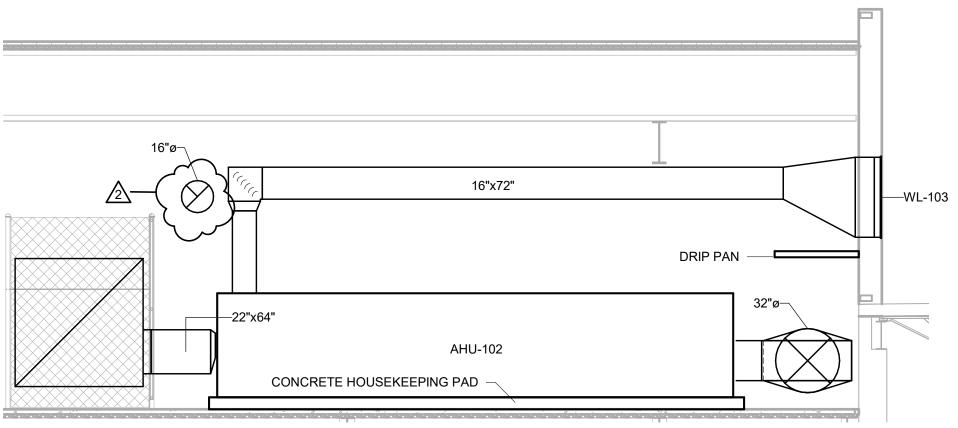

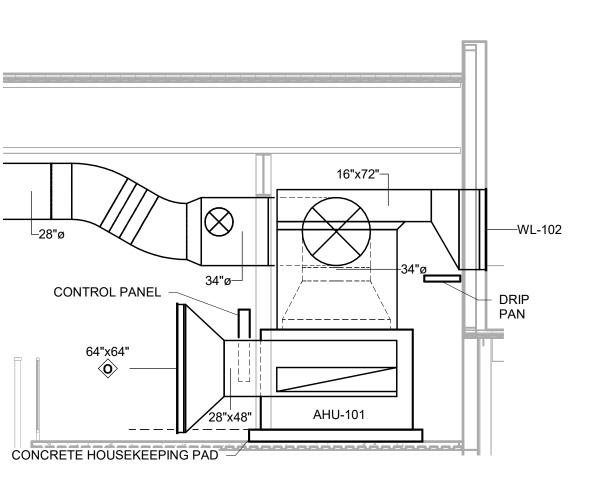


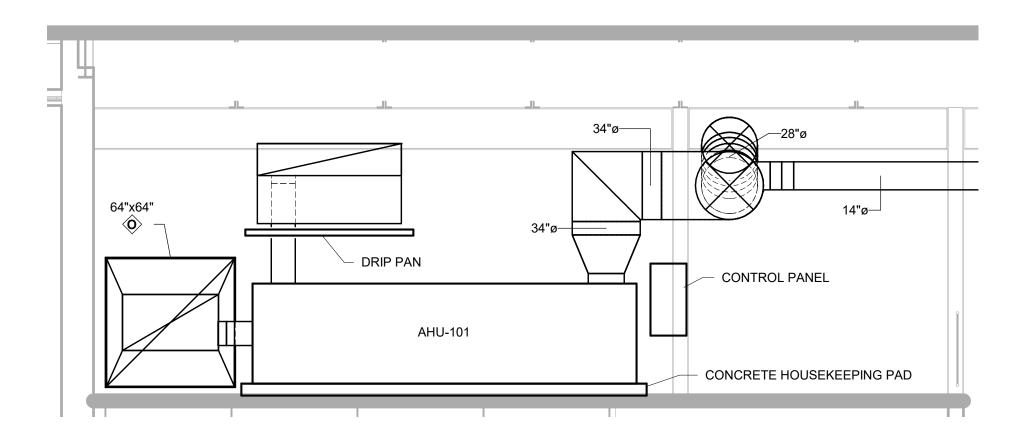

### **C206C - MECHANICAL MEZZANINE SECTION 1** SCALE: 1/4" = 1'-0"

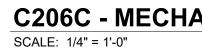




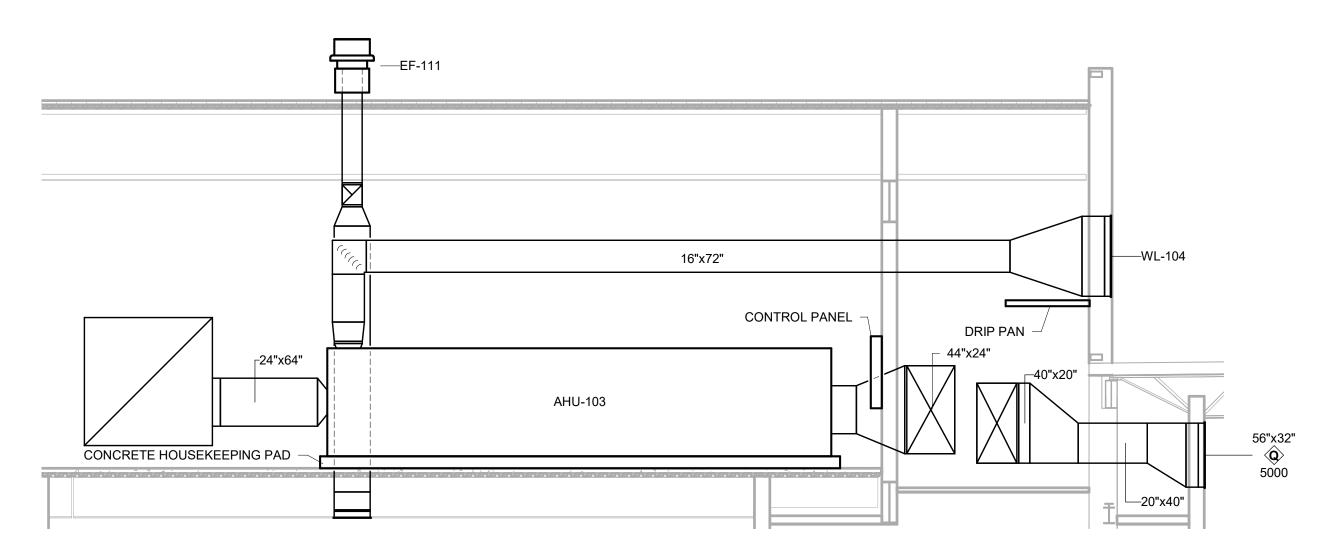


### **C206C - MECHANICAL MEZZANINE SECTION 2**

### **C215 MECHANICAL MEZZANINE SECTION**

SCALE: 1/4" = 1'-0"

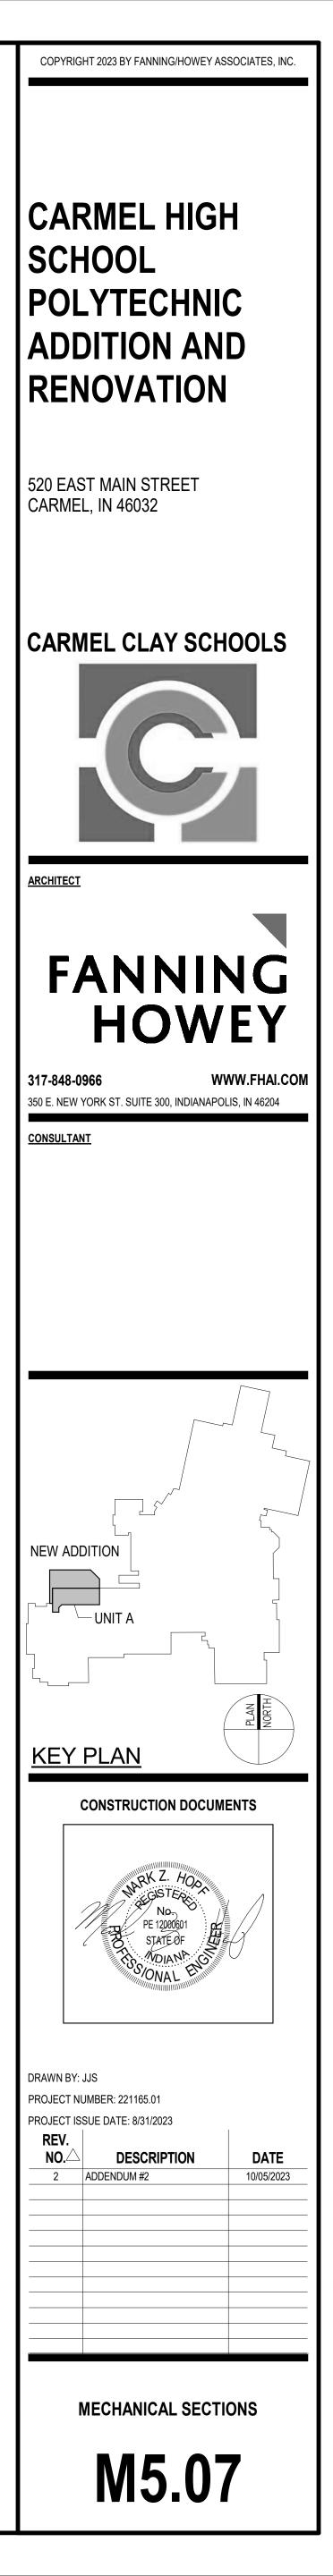




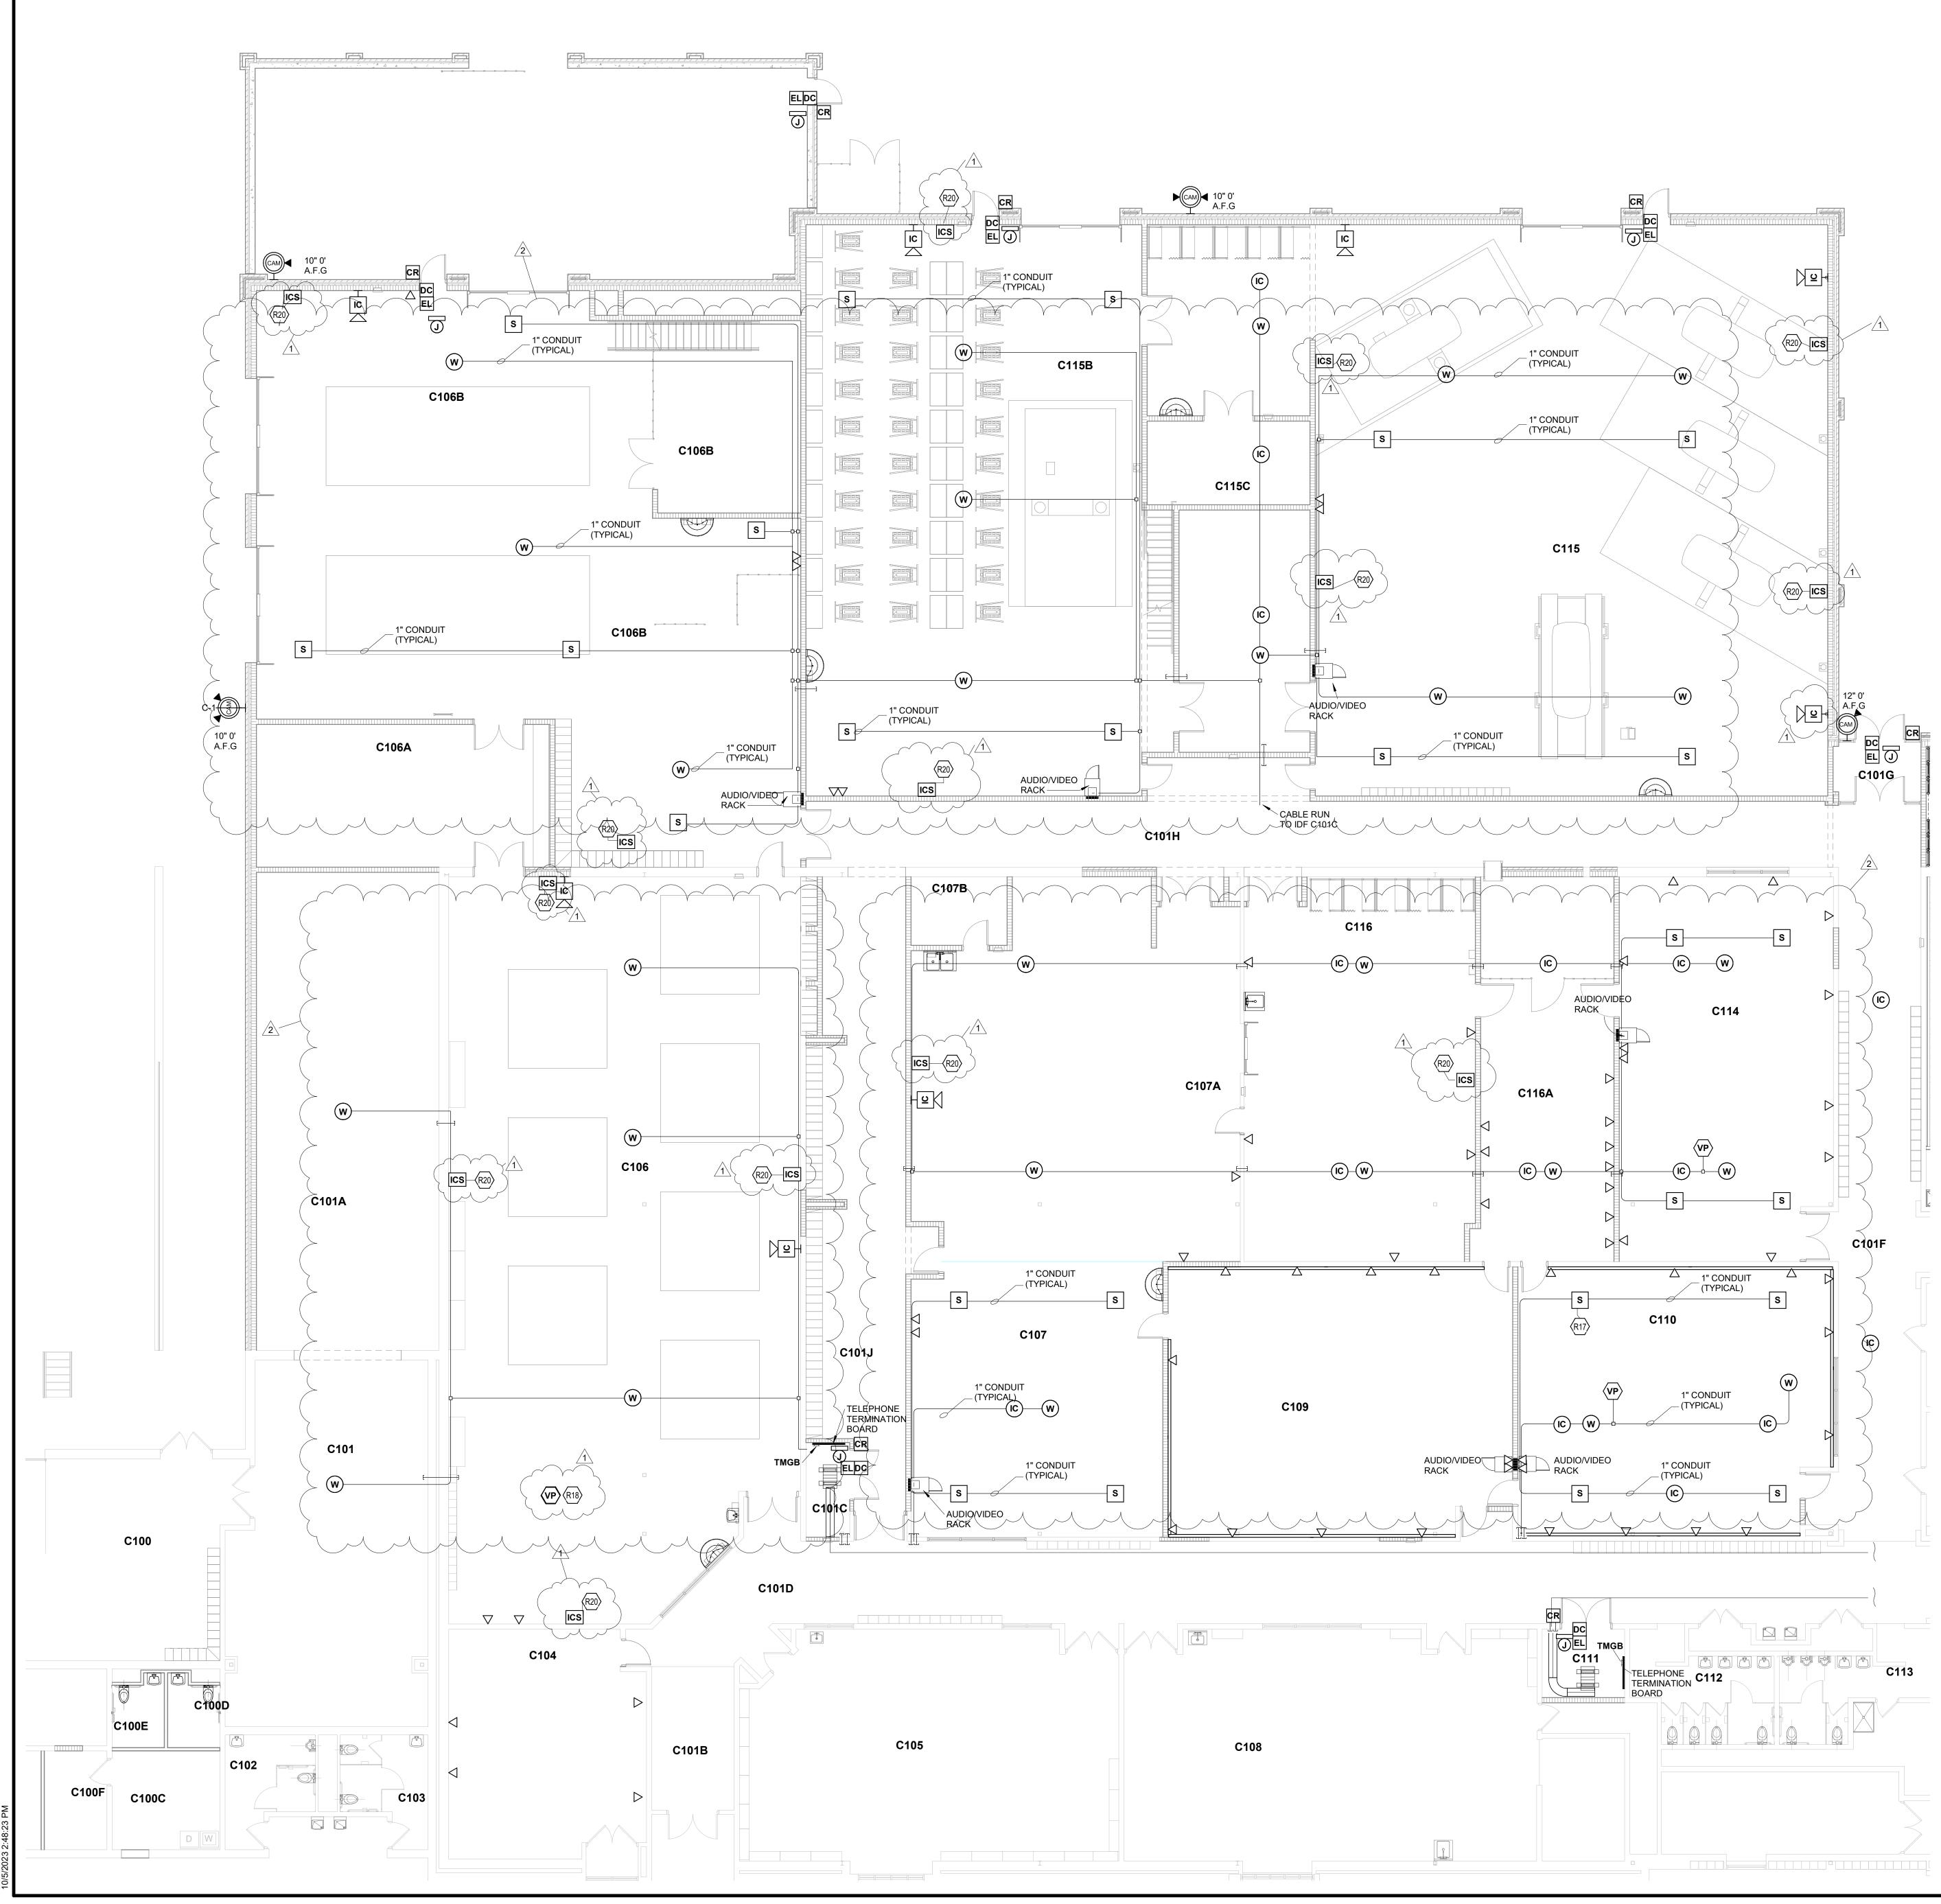

R	OOM LEGEND - FIRST FLOOR UN	ТС
ROOM NO.	ROOM NAME	AREA (SF)
C100	LOADING / RECEIVING	1202 SF
C100A	BREAK ROOM	640 SF
C100B C100C	ELECTRICAL LAUNDRY	825 SF 157 SF
C100D	TOILET	52 SF
C100E C100F	TOILET SECURE STORAGE	52 SF 91 SF
C100G	OFFICE	132 SF
C100H C101	KITCHEN STORAGE	177 SF 1015 SF
C101A	STORAGE	1287 SF
C101B C101C	CORRIDOR MEDIA DATA	174 SF 61 SF
C101D	YEARBOOK CLASSROOM / LAB	Not Placed
C101D C101E	CORRIDOR CORRIDOR	1860 SF 177 SF
C101F	CORRIDOR	976 SF
C101G C101G	JOURNALISM CLASSROOM VESTIBULE	Not Placed 70 SF
C101H	OFFICE	156 SF
C101H C101J	CORRIDOR CORRIDOR	992 SF 832 SF
C102	MENS TOILET	124 SF
C103 C104	WOMENS TOILET OFFICE	119 SF 638 SF
C105	ELECTRONICS / PHYSICS	1251 SF
C106 C106A	CONSTRUCTION TRADES LAB STORAGE	3699 SF 622 SF
C106A	ADVANCED CONSTRUCTION	3867 SF
C107	TRADES LAB CLASSROOM	1015 SF
C107 C107A	ADVANCED MFG. ARTISAN LAB	1695 SF
C107B C108	FINISHING ROOM GRAPHIC COMMUNICATIONS	97 SF 1385 SF
C108 C109	CAD LAB	1385 SF 1347 SF
C110	CAD LAB	1217 SF
C111 C111A	MEDIA DATA STORAGE	83 SF 101 SF
C112	GIRLS	188 SF
C113 C114	BOYS CAD LAB	163 SF 1188 SF
C115	ADVANCED AUTOMOTIVE	4790 SF
C115A	SERVICES LAB	468 SF
C115B	AUTOMOTIVE SERVICES LAB	2828 SF
C115C C116	FINISHING ROOM ADVANCED MFG. INNOVATION	201 SF 1278 SF
	LAB	
C116A C117	ADVANCED MFG. CLEAN LAB CERAMIC CLASSROOM / LAB	762 SF 1387 SF
C117A	STORAGE	145 SF
C117B C118	STORAGE / MATERIALS INDEPENDENT STUDY /	150 SF 1425 SF
CTIO	COMMERICAL ART	1420 SF
C119 C119A	PHOTOGRAPHY DARKROOM	992 SF 309 SF
C119A C120	COMPUTER ART ROOM	442 SF
C122	TEACHERS WORKROOM	672 SF
C122A C123	DEPT. HEAD OFFICE CERAMICS CLASSROOM / LAB	104 SF 1205 SF
C123A	STORAGE	145 SF
C123B C124	STORAGE / MATERIALS CULINARY ARTS	150 SF 1299 SF
C124A	CLOSET	39 SF
C124B C124C	DRY GOODS WALK-IN	154 SF 129 SF
C125	DRAWING CLASSROOM / LAB	1173 SF
C126 C127	DRAWING CLASSROOM / LAB DRAWING CLASSROOM / LAB	1182 SF 1182 SF
C127 C128	JEWELRY CLASSROOM / LAB	953 SF
C129	PHOTOGRAPHY	1023 SF
C129A C131	DARKROOM CORRIDOR	232 SF 1363 SF
C131A	STORAGE	166 SF
C131B C131C	MEDIA DATA CORRIDOR	60 SF 476 SF
C132	STUDIO	244 SF
C133 C134	PODCAST PASSAGE	144 SF 36 SF
C135	STUDIO	63 SF
C136 C136A	STORAGE COMPUTER LAB	105 SF 201 SF
C137	STUDIO	91 SF
C138	STUDIO PASSAGE	93 SF 127 SF
C138A C138B	PASSAGE STUDIO	127 SF 54 SF
C138C	STUDIO	52 SF
C138D C138E	STUDIO STUDIO	52 SF 52 SF
C139	CLASSROOM	984 SF
C141 C141A	TV CLASSROOM STUDIO B	819 SF 165 SF
C141B	OFFICE	91 SF
C142 C142A	STUDIO B ENGINEERING	196 SF 114 SF
C143	STUDIO A	1026 SF
C144 C144A	TV CONTROL EQUIPMENT ROOM	251 SF 120 SF
C144A C145	COMPUTER CLASSROOM	120 SF 851 SF
C145A	SECURE CLOSET	17 SF
C146 C147	COMPUTER SERVER STORAGE JOURNALISM CLASSROOM	303 SF 1468 SF
C147A	OFFICE	136 SF
C148 C149	ELECTRICAL ROOM YEARBOOK CLASSROOM / LAB	143 SF 1350 SF
C149A	PODCAST	147 SF
C150 C151	TV-CPU LAB MECHANICAL	714 SF 5687 SF
		JU01 SF

### TECHNOLOGY PLAN NOTES

R17	PROVIDE JUNCTION BOX FOR SPEAKER LOCATED UP IN BAR JOIST AREA (BELOW ROOF DECK AS REQUIRED BY CODE) SO THAT BOTTOM OF SUSPENDED SPEAKER IS LOCATED ABOVE THE BOTTOM OF BAR JOIST. PROVIDE CONDUITS BETWEEN JUNCTION BOXES AS REQUIRED, SEE DETAILS FOR SPEAKER CONNECTIONS.
R18	PROJECTOR TO BE REMOVED/RE-INSTALLED
R20	INTERCOM PAGING STROBE

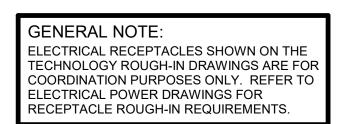



	COMMUNICATIONS ROUGH-IN SYMBOLS				
SYMBOL	DESCRIPTION	MH UNO	ROUGH-IN DETAIL #	SYMBOL	-
$\triangleleft$	COMMUNICATIONS OUTLET. 2 GANG, 3.5" DEEP BOX WITH 2 GANG MUD RING. WITH 2 (TWO) 1" CONDUIT STUBBED ABOVE ACCESSIBLE CEILING WITH PLASTIC BUSHING AND PULL STRING.	16"	-	MI	
$\triangleleft$ W	WALL MOUNTED COMMUNICATIONS OUTLET. 2 GANG, 3.5" DEEP BOX WITH 1 GANG MUD RING. WITH 1 (ONE) 1" CONDUIT STUBBED ABOVE ACCESSIBLE CEILING WITH PLASTIC BUSHING AND PULL STRING.	44"	-	IC	
	MULTI CAPACITY FLOOR BOX WITH 1 (ONE) 1" CONDUIT STUBBED ABOVE ACCESSIBLE CEILING AND ONE (1) 1" CONDUIT TO NEAREST TELECOMMUNICATIONS ROOM. PROVIDE PLASTIC BUSHINGS AND PULL STRINGS.	F	-		
$\triangleleft$ SR	SOUND REINFORCEMENT LOCATION. 2 GANG, 3.5" DEEP BOX WITH 2 GANG MUD RING. WITH 2 (TWO) 1" CONDUIT STUBBED ABOVE ACCESSIBLE CEILING WITH PLASTIC BUSHING AND PULL STRING. COORDINATE WITH TECHNOLOGY AND ARCHITECTURAL DRAWINGS.	5'-4"	-	SYMBOL	
W	WALL MOUNTED WIRELESS ACCESS POINT. 2 GANG, 3.5" DEEP BOX WITH 1 GANG MUD RING. WITH 1 (ONE) 1" CONDUIT STUBBED ABOVE ACCESSIBLE CEILING WITH PLASTIC BUSHING AND PULL STRING.	10'-0"	-		
W	CEILING MOUNTED WIRELESS ACCESS POINT. 2 GANG, 3.5" DEEP BOX WITH 1 GANG MUD RING. WITH 1 (ONE) 1" CONDUIT STUBBED ABOVE ACCESSIBLE CEILING WITH PLASTIC BUSHING AND PULL STRING.	С	-		
	18" CABLE TRAY, UNLESS OTHERWISE NOTED	-	-		/
E3	2" CONDUIT SLEEVES BETWEEN WALLS, UNLESS OTHERWISE NOTED	-	-		(
0 0	2 (TWO) 4" CONDUIT SLEEVES BETWEEN FLOORS	-	-		۷ ( /
	4' x 8' x 3/4" FIRE RATED PLYWOOD	-	-	HCAM W	P \   (
$\bigtriangledown$	POKE-THRU FLOOR BOX WITH 1 (ONE) 1" CONDUIT STUBBED ABOVE ACCESSIBLE CEILING AND ONE (1) 1" CONDUIT TO NEAREST TELECOMMUNICATIONS ROOM. PROVIDE PLASTIC BUSHINGS AND PULL STRINGS.	F	-		

SYMBOL

DIG

Ю


### PUBLIC ADDRESS AND MASS NOTIFICATION SYSTEMS ROUGH-IN SYMBOLS

	OTWDOEG		
SYMBOL	DESCRIPTION	MH UNO	ROUGH-IN DETAIL #
-¥-	SOUND SYSTEM ANTENNA. 1 GANG, 3.5" DEEP BOX WITH 1" CONDUIT TO SOUND SYSTEM JUNCTION BOX	BETWEEN JOISTS	
S	CEILING MOUNTED SOUND SYSTEM SPEAKER, 1 GANG BOX WITH 1" CONDUIT TO SOUND SYSTEM JUNCTION BOX	-	
S	WALL MOUNTED SOUND REINFORCEMENT SPEAKER BOX, 2 GANG, 3.5" DEEP BOX WITH 1 GANG MUD RING. WITH 1 (ONE) 1" CONDUIT STUBBED ABOVE ACCESSIBLE CEILING WITH PLASTIC BUSHING AND PULL STRING.	-	
M	MICROPHONE INPUT. 2 GANG, 3.5" DEEP BOX WITH 2 GANG MUD RING. WITH 1 (ONE) 1" CONDUIT TO SOUND SYSTEM JUNCTION BOX WITH PULL STRING.	16"	
A	AUXILIARY INPUT. 2 GANG, 3.5" DEEP BOX WITH 2 GANG MUD RING. WITH 1 (ONE) 1" CONDUIT TO SOUND SYSTEM JUNCTION BOX WITH PULL STRING.	16"	
MA	WALL MOUNTED MICROPHONE/AUXILIARY INPUT. 2 GANG, 3.5" DEEP BOX WITH 2 GANG MUD RING. WITH 1 (ONE) 1" CONDUIT TO SOUND SYSTEM JUNCTION BOX WITH PULL STRING.	16"	
S	WALL MOUNTED SOUND SYSTEM SPEAKER OUTLET. 2 GANG, 3.5" DEEP BOX WITH 1 GANG MUD RING. WITH 1 (ONE) 1" CONDUIT TO SOUND SYSTEM JUNCTION BOX WITH PULL STRING.	NOTED ON DRAWINGS	
S A	LINE ARRAY COLUMN SPEAKERS - WALL MOUNTED. 2 GANG, 3.5" DEEP BOX WITH 1 GANG MUD RING. WITH 1 (ONE) 1" CONDUIT TO SOUND SYSTEM JUNCTION BOX WITH PULL STRING.	NOTED ON DRAWINGS	
	RECESSED JUNCTION BOX FOR SOUND SYSTEM. REFER TO DETAILS AND FLOORPLANS FOR SIZE.	16"	
	PRODUCTION INTERCOM, 2 GANG, 3.5" DEEP BOX WITH 1 GANG MUD RING. WITH 1 (ONE) 1" CONDUIT TO SOUND SYSTEM JUNCTION BOX WITH PULL STRING.	-	


INTE	RCOMMUNICATIONS AND PROGRAM SYSTEMS ROUGH-IN	SYM	BOLS
SYMBOL	DESCRIPTION	MH UNO	ROUGH-IN DETAIL #
⊢● IC	CALL-IN SWITCH. 2 GANG, 3.5" DEEP BOX WITH 1 GANG MUD RING. WITH 1 (ONE) 1" CONDUIT STUBBED ABOVE ACCESSIBLE CEILING WITH PLASTIC BUSHING AND PULL STRING.	44"	-
⊢⊡vc	VOLUME CONTROL. 2 GANG, 3.5" DEEP BOX WITH 1 GANG MUD RING. WITH 1 (ONE) 1" CONDUIT STUBBED ABOVE ACCESSIBLE CEILING WITH PLASTIC BUSHING AND PULL STRING.	44"	-
	WALL MOUNTED HORN SPEAKER. 2 GANG, 3.5" DEEP BOX WITH 1 GANG MUD RING. WITH 1 (ONE) 1" CONDUIT STUBBED ABOVE ACCESSIBLE CEILING WITH PLASTIC BUSHING AND PULL STRING.	96"	-
X	SOUND SYSTEM MASTER STATION. 2 GANG, 3.5" DEEP BOX WITH 2 GANG MUD RING, 2 (TWO) 1" CONDUIT STUBBED ABOVE ACCESSIBLE CEILING WITH PLASTIC BUSHING AND PULL STRING.	-	-
$\hat{\mathbf{r}}$	ROOF MOUNTED AM/FM ANTENNA	ROOF	-
	REMOTE DESK INTERCOM CABINET ROUGH-IN. 2 GANG, 3.5" DEEP BOX WITH 2 GANG MUD RING, 2 (TWO) 1" CONDUIT STUBBED ABOVE ACCESSIBLE CEILING WITH PLASTIC BUSHING AND PULL STRING. COORDINATE WITH CASEWORK.	-	-
	METAL SURFACE WALL MOUNTED SPEAKER. 2 GANG, 3.5" DEEP BOX WITH 1 GANG MUD RING. WITH 1 (ONE) 1" CONDUIT STUBBED ABOVE ACCESSIBLE CEILING WITH PLASTIC BUSHING AND PULL STRING.	96"	-
(IC) _S	SURFACE MOUNTED CEILING SPEAKER. 2 GANG, 3.5" DEEP BOX WITH 1 GANG MUD RING WITH 1 (ONE) 1" CONDUIT STUBBED ABOVE ACCESSIBLE CEILING OR RUN TO NEXT SPEAKER LOCATION. PROVIDE PLASTIC BUSHING AND PULL STRING.	-	-
ICS	INTERCOMM STROBE LAMP.	С	-


	ACCESS CONTROL ROUGH-IN SYMBOLS		
SYMBOL	DESCRIPTION	MH UNO	ROUGH-IN DETAIL #
ACP	ACCESS CONTROL PANEL, 2 GANG, 3.5" DEEP BOX WITH 2 GANG MUD RING, 2 (TWO) 1" CONDUIT STUBBED ABOVE ACCESSIBLE LAY-IN CEILING WITH PULL STRING	-	-
CR	CARD READER. 2 GANG, 3.5" DEEP BOX WITH 2 GANG MUD RING, 1 (ONE) 1" CONDUIT TO JUNCTION BOX ABOVE DOOR	44"	-
EL	ELECTRONIC LATCH. 2 GANG, 3.5" DEEP BOX WITH 1 GANG MUD RING, 1 (ONE) 1" CONDUIT TO JUNCTION BOX ABOVE DOOR	-	-
Ū	24" W x 24" H x 6" D JUNCTION BOX ABOVE DOOR FOR ACCESS CONTROL DOOR CONTROLLER.	ABOVE CLG.	-
КВ	KEY BOX. 2 GANG, 3.5" DEEP BOX WITH 2 GANG MUD RING, 1 (ONE) 1" CONDUIT STUBBED ABOVE ACCESSIBLE CEILING WITH PLASTIC BUSHING AND PULL STRING.	60"	-
•	PUSH TO RELEASE BUTTON. 2 GANG, 3.5" DEEP BOX WITH 1 GANG MUD RING. 1" CONDUIT STUBBED ABOVE ACCESSIBLE CEILING WITH PLASTIC BUSHING AND PULL STRING.	44"	-
ADO	AUTOMATIC DOOR OPERATOR, 1" CONDUIT TO JUNCTION BOX ABOVE DOOR	-	-
REX	REQUEST TO EXIT SWITCH, 2 GANG, 3.5" DEEP BOX WITH 1 GANG MUD RING, 1 (ONE) 1" CONDUIT TO JUNCTION BOX ABOVE DOOR (LOCATED IN EXIT DOOR HARDWARE)	-	-

	INTRUSION DETECTION ROUGH-IN SYMBOLS		
SYMBOL	DESCRIPTION	MH UNO	ROUGH-IN DETAIL #
	INTRUSION DETECTION PANEL, 2 GANG, 3.5" DEEP BOX WITH 2 (TWO) 1" CONDUIT STUBBED ABOVE ACCESSIBLE LAY-IN CEILING	-	-
DC	DOOR CONTACT ROUGH-IN	-	-
К	KEYPAD. 2 GANG, 3.5" DEEP BOX WITH 1 GANG MUD RING. 1" CONDUIT STUBBED ABOVE ACCESSIBLE CEILING WITH PLASTIC BUSHING AND PULL STRING.	44"	-
⊢MD →	WALL MOUNTED MOTION DETECTOR. 2 GANG, 3.5" DEEP BOX WITH 1 GANG MUD RING. 1" CONDUIT STUBBED ABOVE ACCESSIBLE CEILING WITH PULL STRING	NOTED ON DWGS	-
MD	CEILING MOUNTED MOTION DETECTOR. 2 GANG, 3.5" DEEP BOX WITH 1 GANG MUD RING. 1" CONDUIT STUBBED ABOVE ACCESSIBLE CEILING WITH PULL STRING	NOTED ON DWGS	-

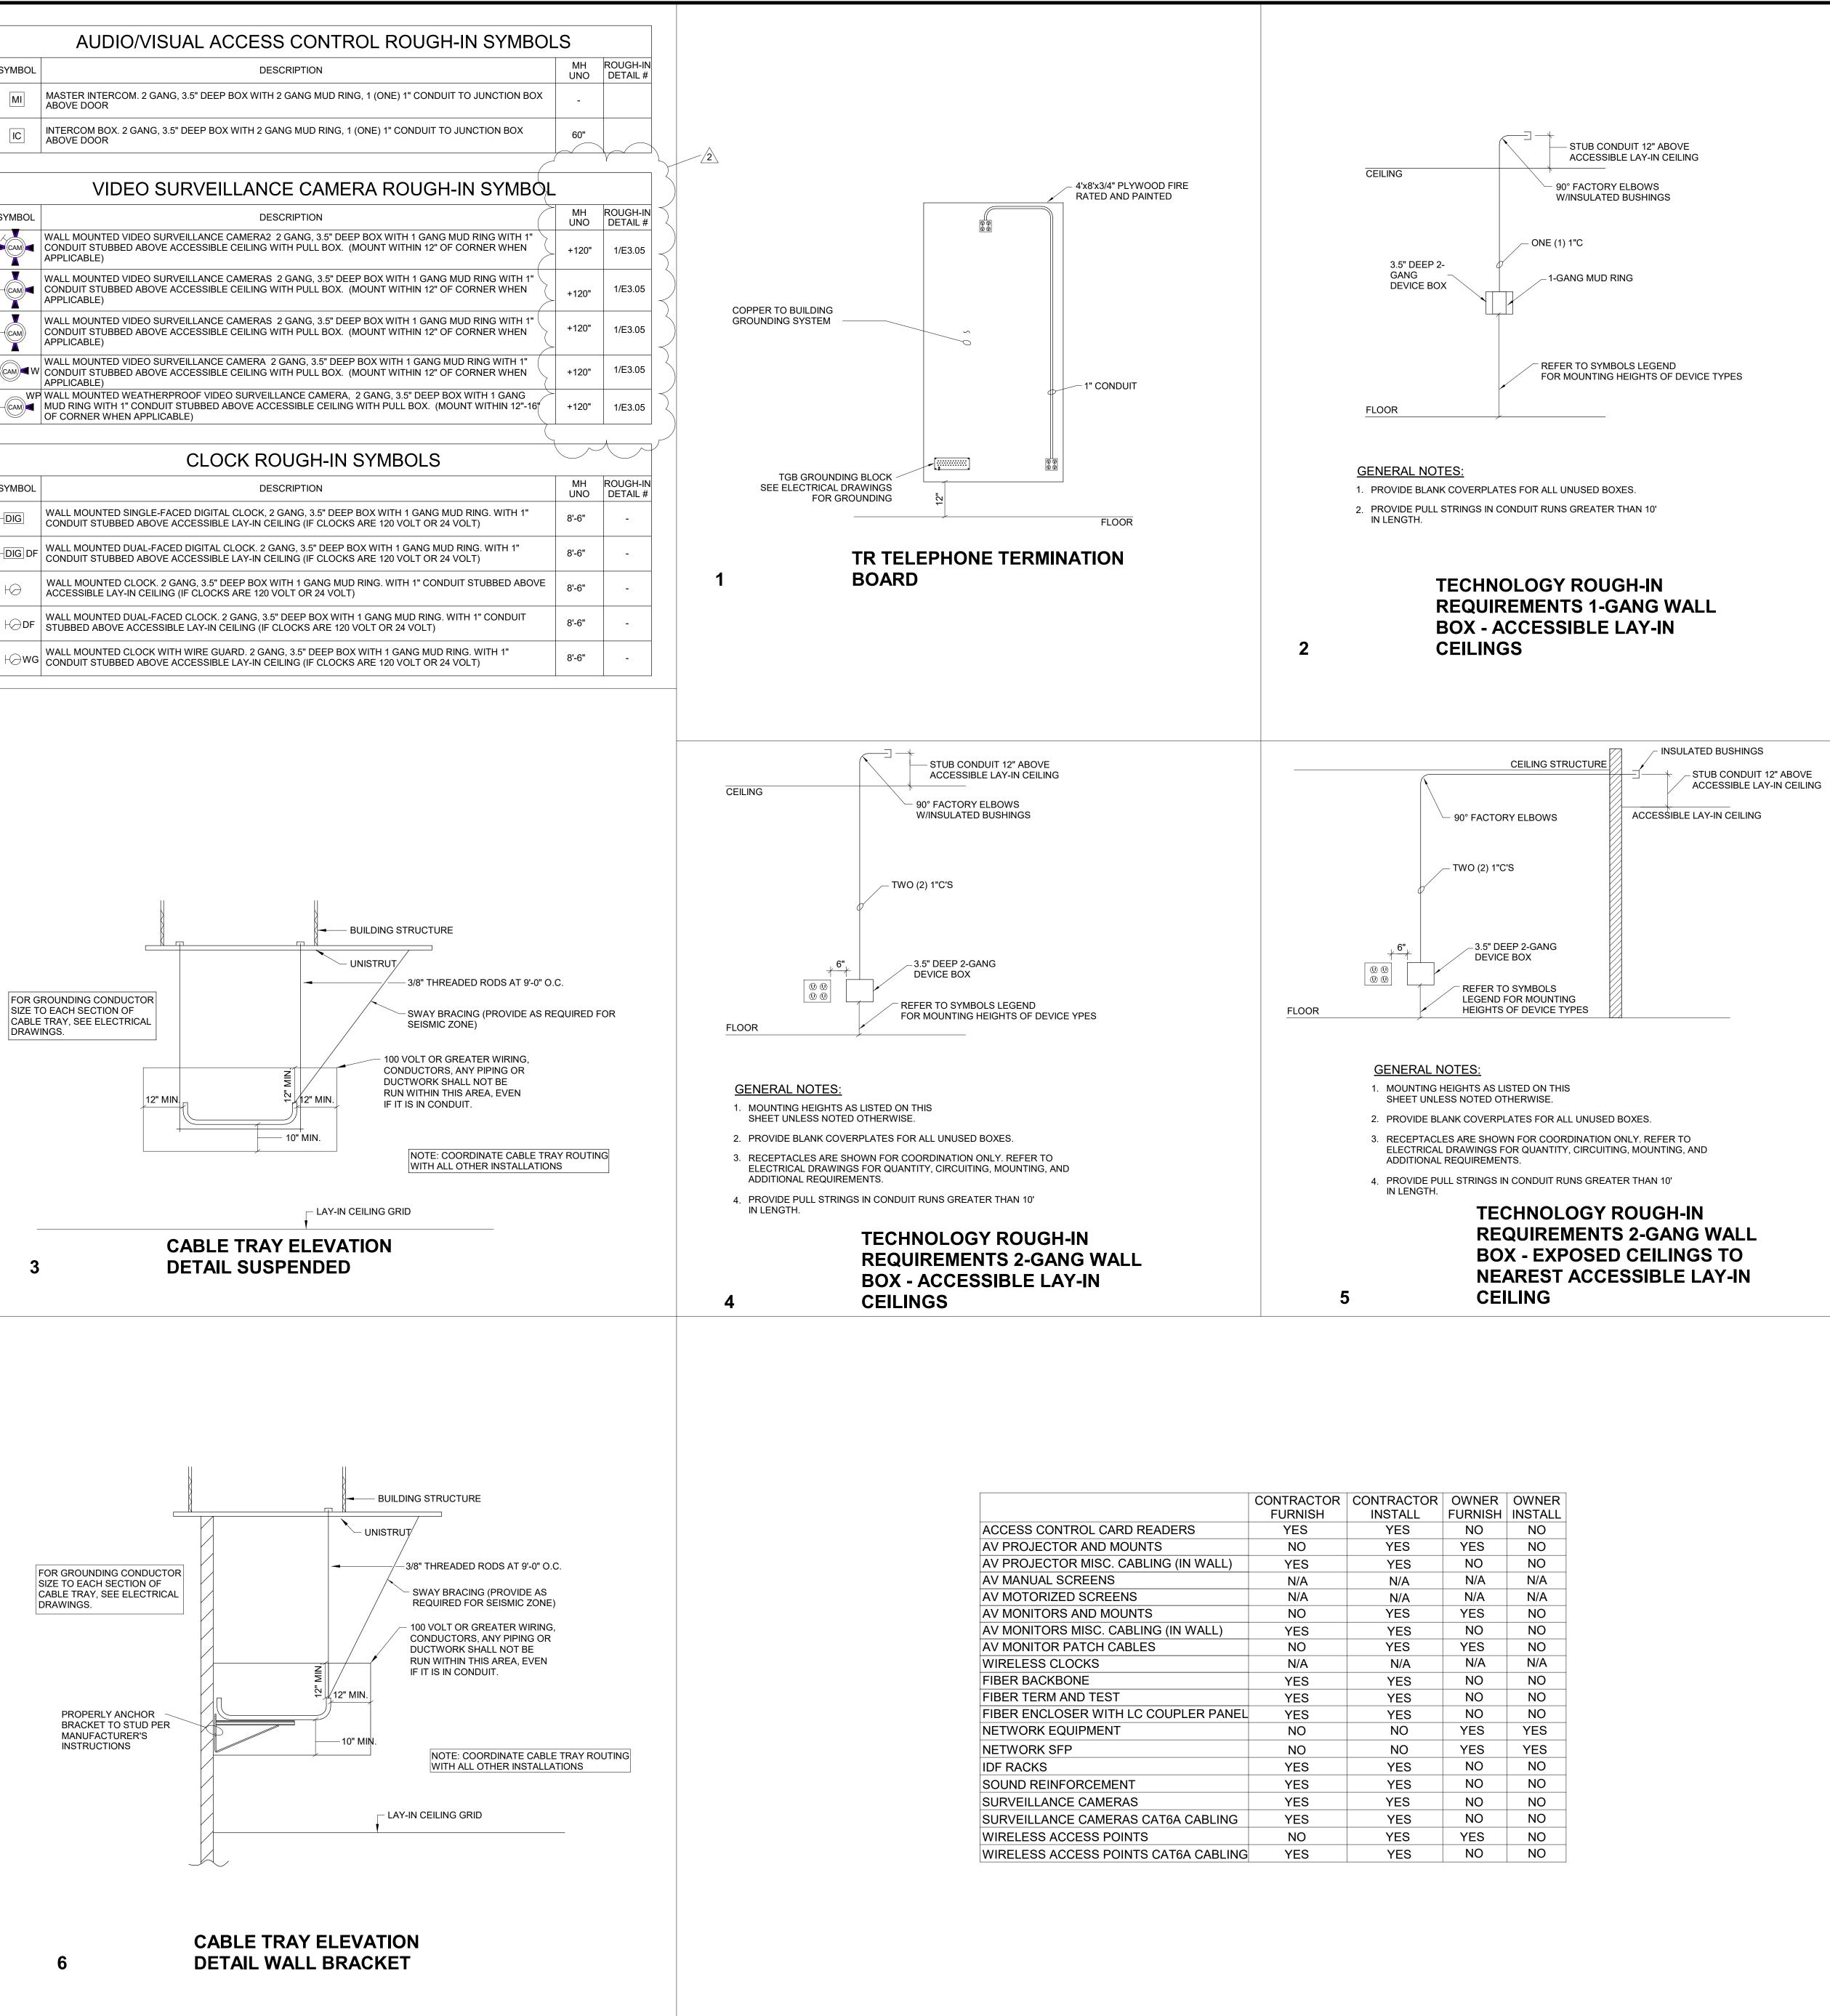

	CONTRACTOR	CONTRACTOR	OWNER	OWNER
	FURNISH	INSTALL	FURNISH	INSTALL
ACCESS CONTROL CARD READERS	YES	YES	NO	NO
AV PROJECTOR AND MOUNTS	NO	YES	YES	NO
AV PROJECTOR MISC. CABLING (IN WALL)	YES	YES	NO	NO
AV MANUAL SCREENS	N/A	N/A	N/A	N/A
AV MOTORIZED SCREENS	N/A	N/A	N/A	N/A
AV MONITORS AND MOUNTS	NO	YES	YES	NO
AV MONITORS MISC. CABLING (IN WALL)	YES	YES	NO	NO
AV MONITOR PATCH CABLES	NO	YES	YES	NO
WIRELESS CLOCKS	N/A	N/A	N/A	N/A
FIBER BACKBONE	YES	YES	NO	NO
FIBER TERM AND TEST	YES	YES	NO	NO
FIBER ENCLOSER WITH LC COUPLER PANEL	YES	YES	NO	NO
NETWORK EQUIPMENT	NO	NO	YES	YES
NETWORK SFP	NO	NO	YES	YES
IDF RACKS	YES	YES	NO	NO
SOUND REINFORCEMENT	YES	YES	NO	NO
SURVEILLANCE CAMERAS	YES	YES	NO	NO
SURVEILLANCE CAMERAS CAT6A CABLING	YES	YES	NO	NO
WIRELESS ACCESS POINTS	NO	YES	YES	NO
WIRELESS ACCESS POINTS CAT6A CABLING	YES	YES	NO	NO

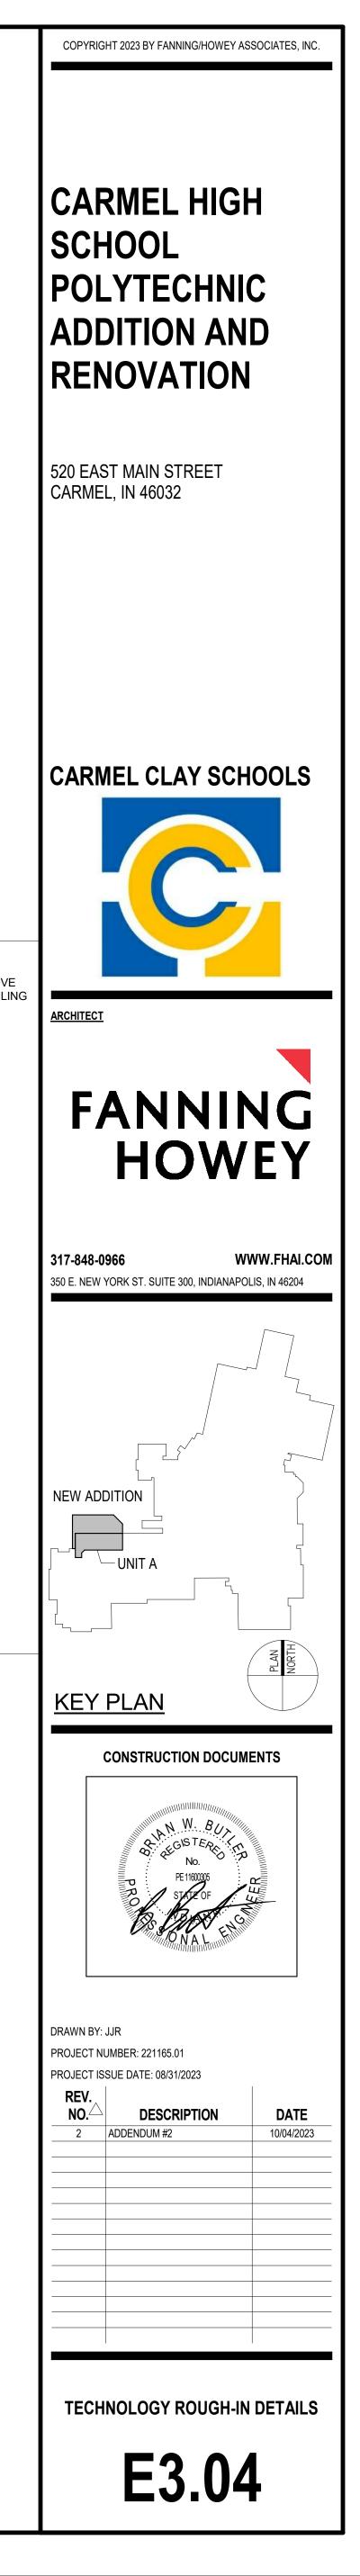

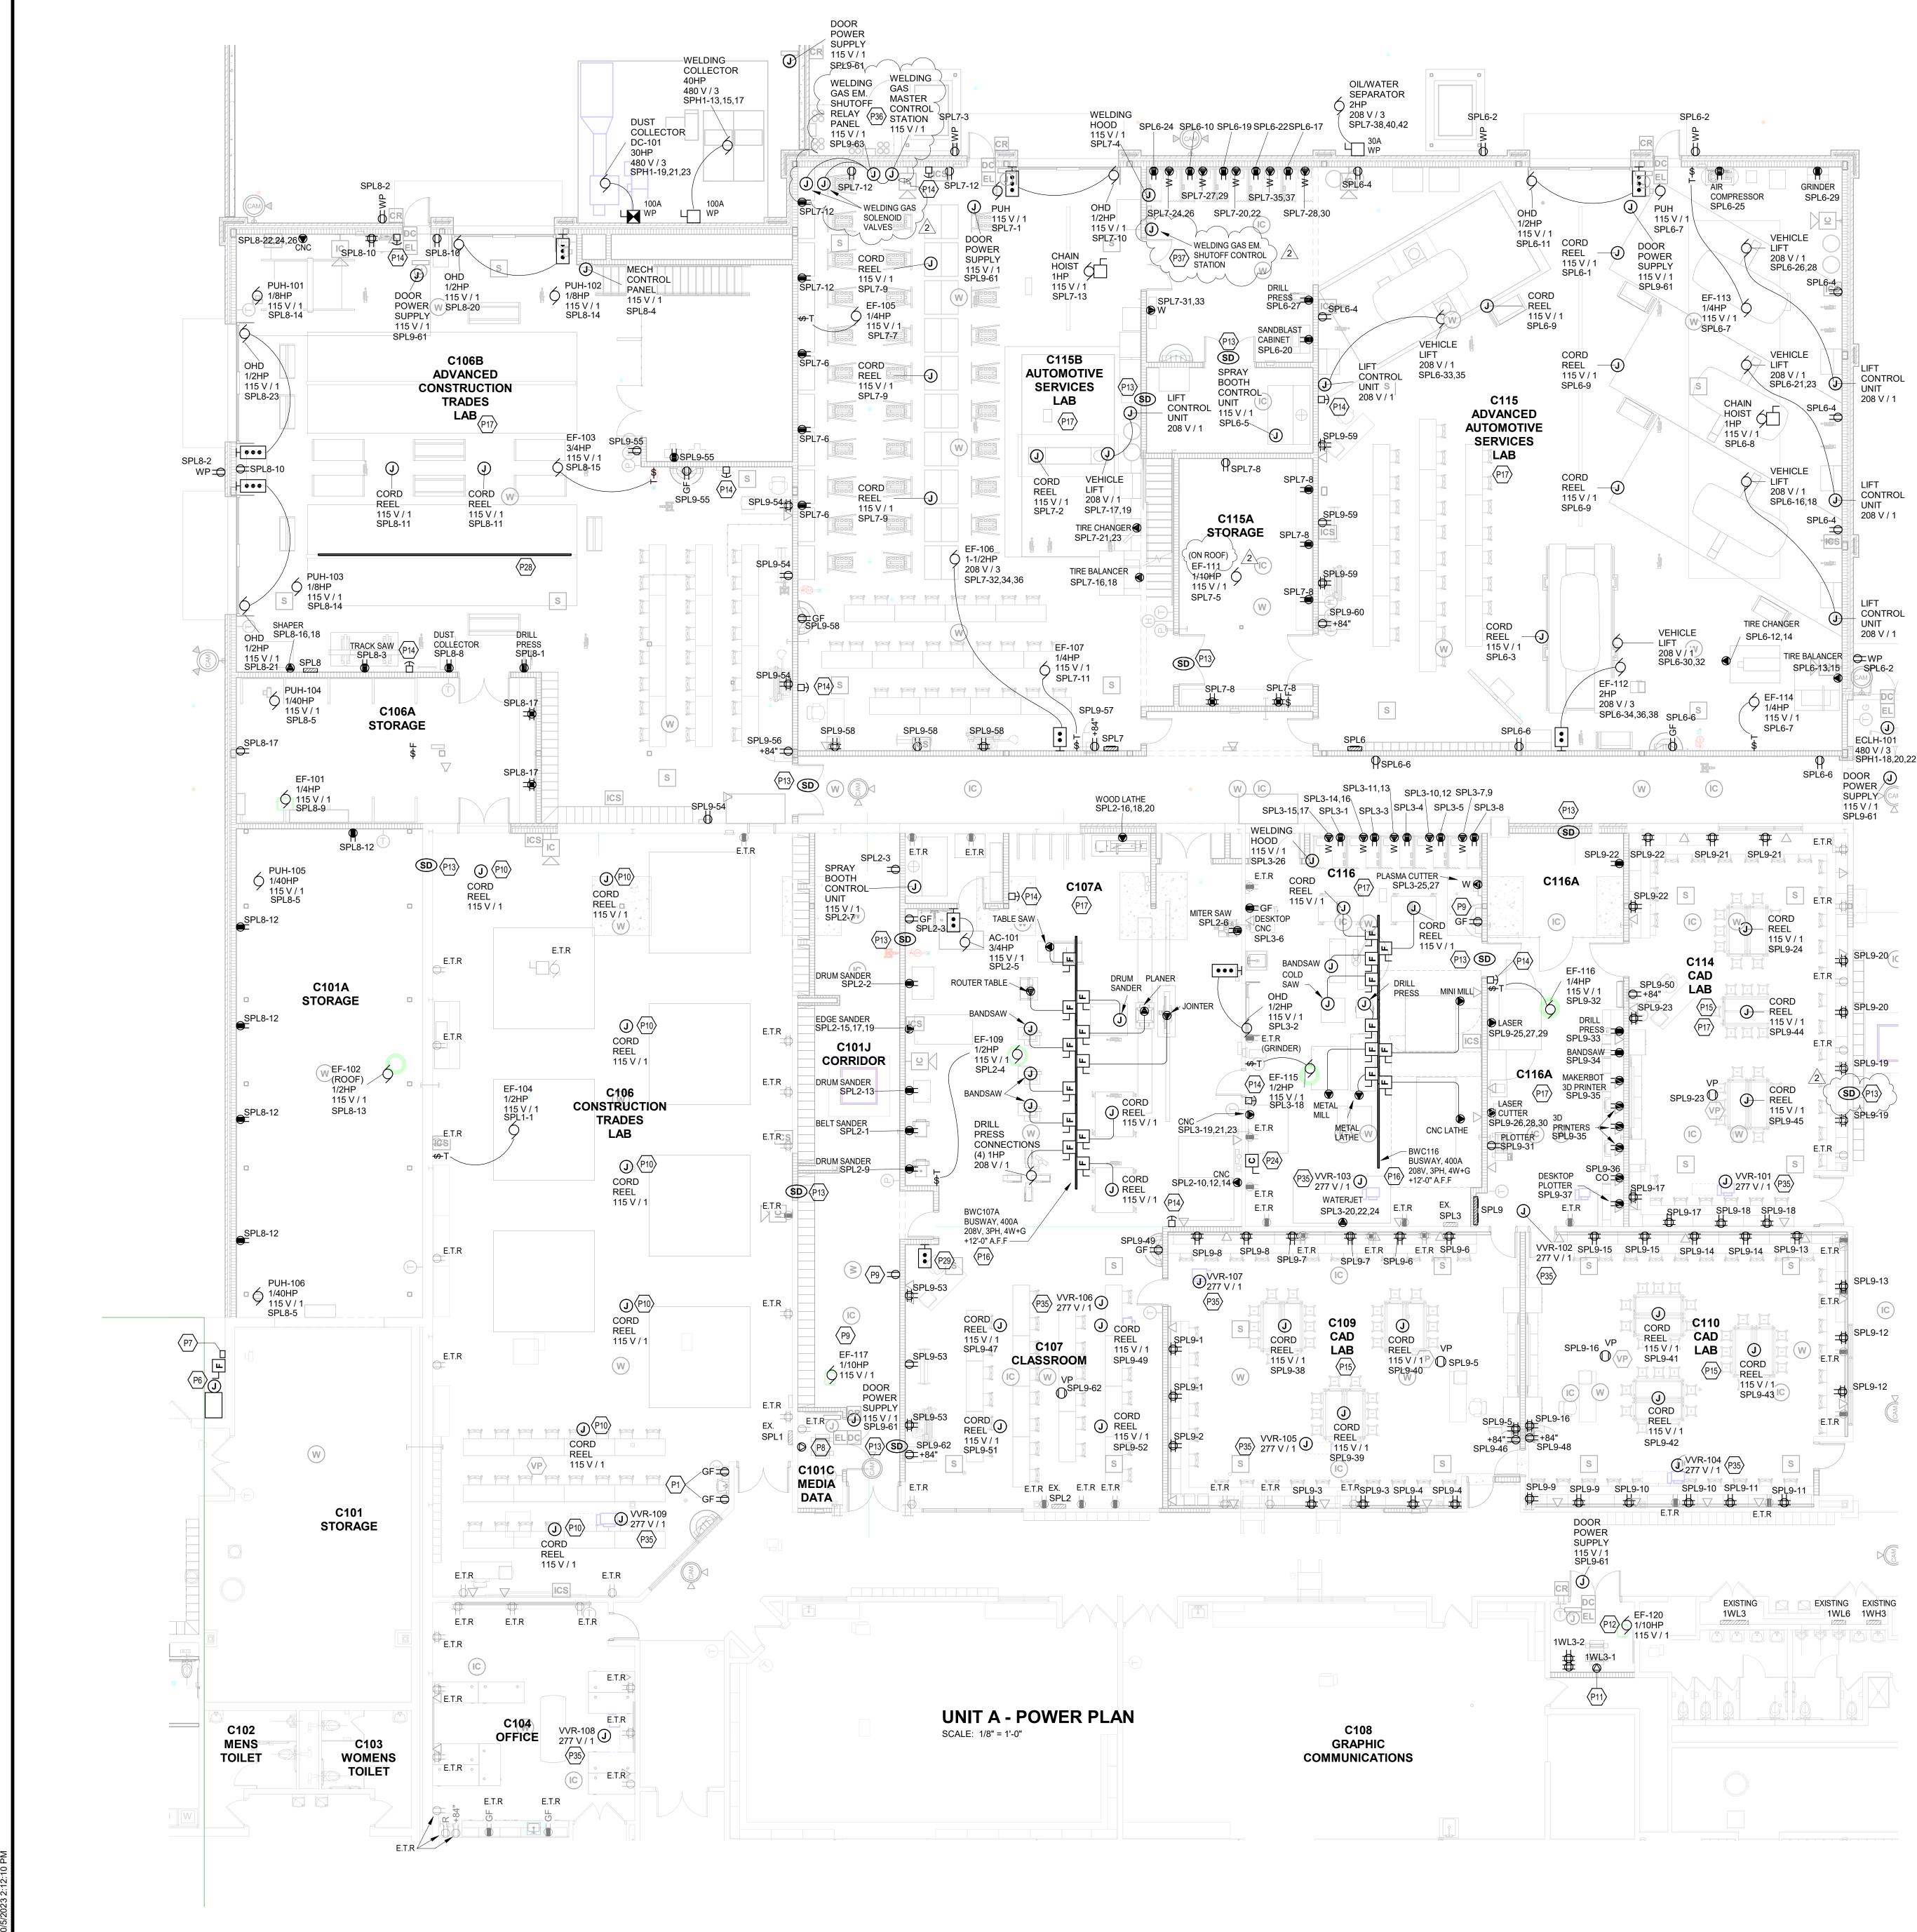



## **GENERAL NOTES - POWER**


- PROVIDE REVISED TYPED PANELBOARD DIRECTORIES FOR EACH PANELBOARD ADDED OR MODIFIED DURING CONSTRUCTION. FIELD VERIFY EXISTING CIRCUIT INFORMATION WITH OWNER'S ASSISTANCE TO ENSURE FINAL DIRECTORY IS ACCURATE. UNUSED SPARE BREAKERS SHALL BE IN THE OFF POSITION.
- CONTRACTOR SHALL VERIFY ALL DIMENSIONS AND CLEARANCES AND ALL EXISTING FIELD CONDITIONS BEFORE STARTING CONSTRUCTION. COMMENCEMENT OF WORK CONSTITUTES ACCEPTANCE OF CONDITIONS. SHOULD DIFFERENT CONDITIONS BE ENCOUNTERED, CONTACT THE ARCHITECT BEFORE
- PROCEEDING WITH WORK. LABEL EACH RECEPTACLE WITH THE PANEL NAME AND CIRCUIT NUMBER ON THE FACE OF EACH COVER
- PLATE WITH A TYPED LAMINATED LABEL. PROVIDE "GFCI PROTECTED" LABEL ON COVER PLATE FOR ANY GFCI PROTECTED DEVICE. CONTRACTOR SHALL INCREASE CIRCUIT CONDUCTOR SIZE TO COMPENSATE FOR VOLTAGE DROP DUE TO
- EXCESSIVE CIRCUIT LENGTHS. IN NO CASE SHALL VOLTAGE DROP EXCEED NFPA 70 (N.E.C.) REQUIREMENTS
- REFER TO MECHANICAL PLANS FOR LOCATION OF MECHANICAL EQUIPMENT. LOCATE DISCONNECT SWITCHES PER NEC. REFER TO "CONTROL SCHEMATICS" MECHANICAL DRAWINGS FOR ADDITIONAL CONTROL WIRING AND
- CONTROL CONNECTIONS. ALL DEVICES, EQUIPMENT, FIXTURES, AND THE LIKE, SHALL BE BONDED WITH A PROPERLY SIZED
- EQUIPMENT GROUNDING CONDUCTOR. MAINTAIN MECHANICAL/ELECTRICAL BONDS OF METALLIC RACEWAY SYSTEM. FOR EXISTING RECEPTACLES TO BE REMOVED, REMOVE CONDUIT, BOX, AND WIREING COMPLETELY.
- REPAIR WALL PRIOR TO PAINTING. CONDUITS AND BOXES CAN REMAIN BEHIND FURRED PORTIONS OF WALLS. NO BLANK PLATES ARE TO BE VISIBLE UPON PROJECT COMPLETION. REPLACE ALL EXISTING RECEPTACLES SHOWN TO REMAIN WITH NEW DEVICES AND FACEPLATES. CIRCUIT NUMBERS SHOWN FOR EXISTING PANELBOARDS ARE NUMBERED SPARE/SPACE CIRCUITS.

EXISTING CIRCUITS TO REMAIN ARE NOT TO BE AFFECTED BY THIS NUMBERING.

	KEYNOTES
P1	PROVIDE NEW GFCI RECEPTACLE AT THIS LOCATION. CONNECT TO EXISTING CIRCUIT TIED BACK DURING DEMOLITION.
P6	HYDRAULIC TRASH COMPACTOR MOTOR AND CONTROLS - RE-ROUTE POWER WIRING, CONDUIT AND POWE DISCONNECT TO NEW LOCATION. MATCH EXISTING WIRE SIZE. ASSUME #8 CONDUCTORS FOR BIDDING PURPOSES.
P7	HYDRAULIC TRASH COMPACTOR CONTROLS EXISTING TO REMAIN AND BE RECONNECTED AS NECESSARY TRELOCATED MOTOR.
P8	CONNECT DATA ROOM RECEPTACLES TO CIRCUITS TIED BACK DURING DEMOLITION. PROVIDE MATCHING RECEPTACLES LOCATED BEHIND THE NEW RACK LOCATION(S).
P9	CONNECT RECEPTACLE TO NEAREST RECEPTACLE CIRCUIT WITH 2#12, #12G IN 3/4"C.
P10	PROVIDE A NEW 20A CIRCUIT BREAKER IN AVAILABLE SPACE IN PANEL SPL1 FOR THIS CORD REEL. CONNEC WITH 2#12, #12G IN 3/4"C.
P11	PROVIDE A NEW 30A CIRCUIT BREAKER IN AVAILABLE SPACE IN PANEL 1WL3 FOR THIS NEMA 5-30R RECEPTACLE. CONNECT WITH 2#10, #12G IN 3/4"C.
P12	CONNECT TO NEAREST RECEPTACLE CIRCUIT WITH 2#12, #12G IN 3/4"C.
P13	CONNECT ALL SMOKE DAMPERS IN UNITS A AND B OF THIS PROJECT TO AN AVAILABLE DEDICATED SPARE 2 CIRCUIT IN EXISTING PANEL 1WL3. PROVIDE A 20A BREAKER IF NECESSARY AND CONNECT WITH 2#12, #12G 3/4"C.
P14	CONNECT EMERGENCY STOP PUSHBUTTON TO SHUNT TRIP MAIN BREAKER IN PANELBOARD FOR THIS SPA
P15	NEW COUNTERTOPS IN THIS ROOM HAVE A 2-3/8" OPENING IN THE CORNER OF THE MOUNTING BRACKET. MOUNT HORIZONTAL WIREWAY FOR NEW SURFACE MOUNTED RECEPTACLES THROUGH THESE OPENINGS THIS ROOM. MOUNT NEW RECEPTACLES UNDER THE COUNTER AS CLOSE TO THE COUNTERTOP AS POSSIE
P16	PROVIDE BUSWAY PLUGS AS FUSED DISCONNECTS. PROVIDE 20A FUSES IN DISCONNECTS UNLESS NOTED OTHERWISE. SUPPORT SOO FEEDERS TO EQUIPMENT FROM STRUCTURE AND DROP DOWN VERTICALLY TO EQUIPMENT. PROVIDE FEEDER SIZE PER A7 DRAWING REQUIREMENTS. PROVIDE MOUNTING HARDWARE TO SUPPORT BUSWAY AT ELEVATION SHOWN.
P17	REFER TO A7 SERIES DRAWINGS FOR ADDITIONAL REQUIRMENTS AND PLUG CONFIGURATIONS FOR EQUIPMENT IN THIS SPACE.
P24	PROVIDE 400A CONTACTOR FOR BOTH BUSWAYS IN C107A AND C116. CONNECT CONTACTOR TO THE EMERGENCY STOP PUSHBUTTONS IN BOTH SPACES, SUCH THAT THE ACTUATION OF ANY SWITCH OPENS T CIRCUIT FOR THE BUSWAYS.
P28	INSTALL BUSWAY REMOVED FROM OTHER SPACES DURING DEMOLITION IN THIS SPACE PRIOR TO WORK IN ROOM C107A. CONNECT BUSWAY TEMPORARILY TO THE 200A FEEDER FOR PANEL SPL8. THIS BUSWAY IS TO SERVE EQUIPMENT FROM THE EXISTING SPACES WHILE THEY ARE BEING RENOVATED. INSTALL EXISTING DISCONNECTS AND CORD DROPS TO EQUIPMENT AS NEEDED BY OWNER. DISCONNECT AND REMOVE THE BUSWAY ONCE THE EQUIPMENT HAS BEEN MOVED.
P29	PROVIDE ALL EQUIPMENT AND WIRING TO CONNECT THIS ON/OFF PUSH BUTTON TO THE DUST COLLECTOR DC-101 LOCATED OUTSIDE OF ROOM C106B.
P35	WITH 2#12, #12G IN 3/4"C.
P36	WELDING GAS EMERGENCY SHUTOFF EQUIPMENT PROVIDED BY DIV 22. PROVIDE ALL CONDUIT, WIRE, AND CONNECTIONS FOR WELDING GAS EQUIPMENT AS REQUIRED BY MANUFACTURER.
P37	CONNECT WELDING GAS EMERGENCY CONTROL STATION TO THE WELDING GAS EMERGENCY RELAY PANE AS REQUIRED BY MANUFACTURER.

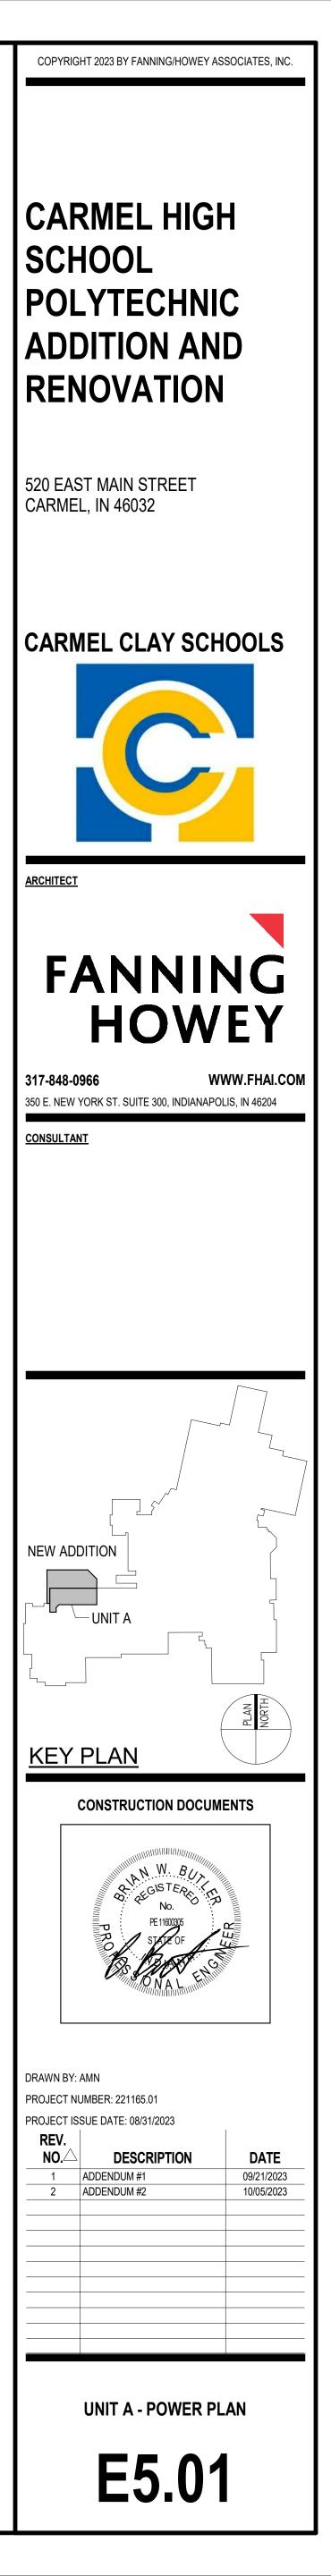

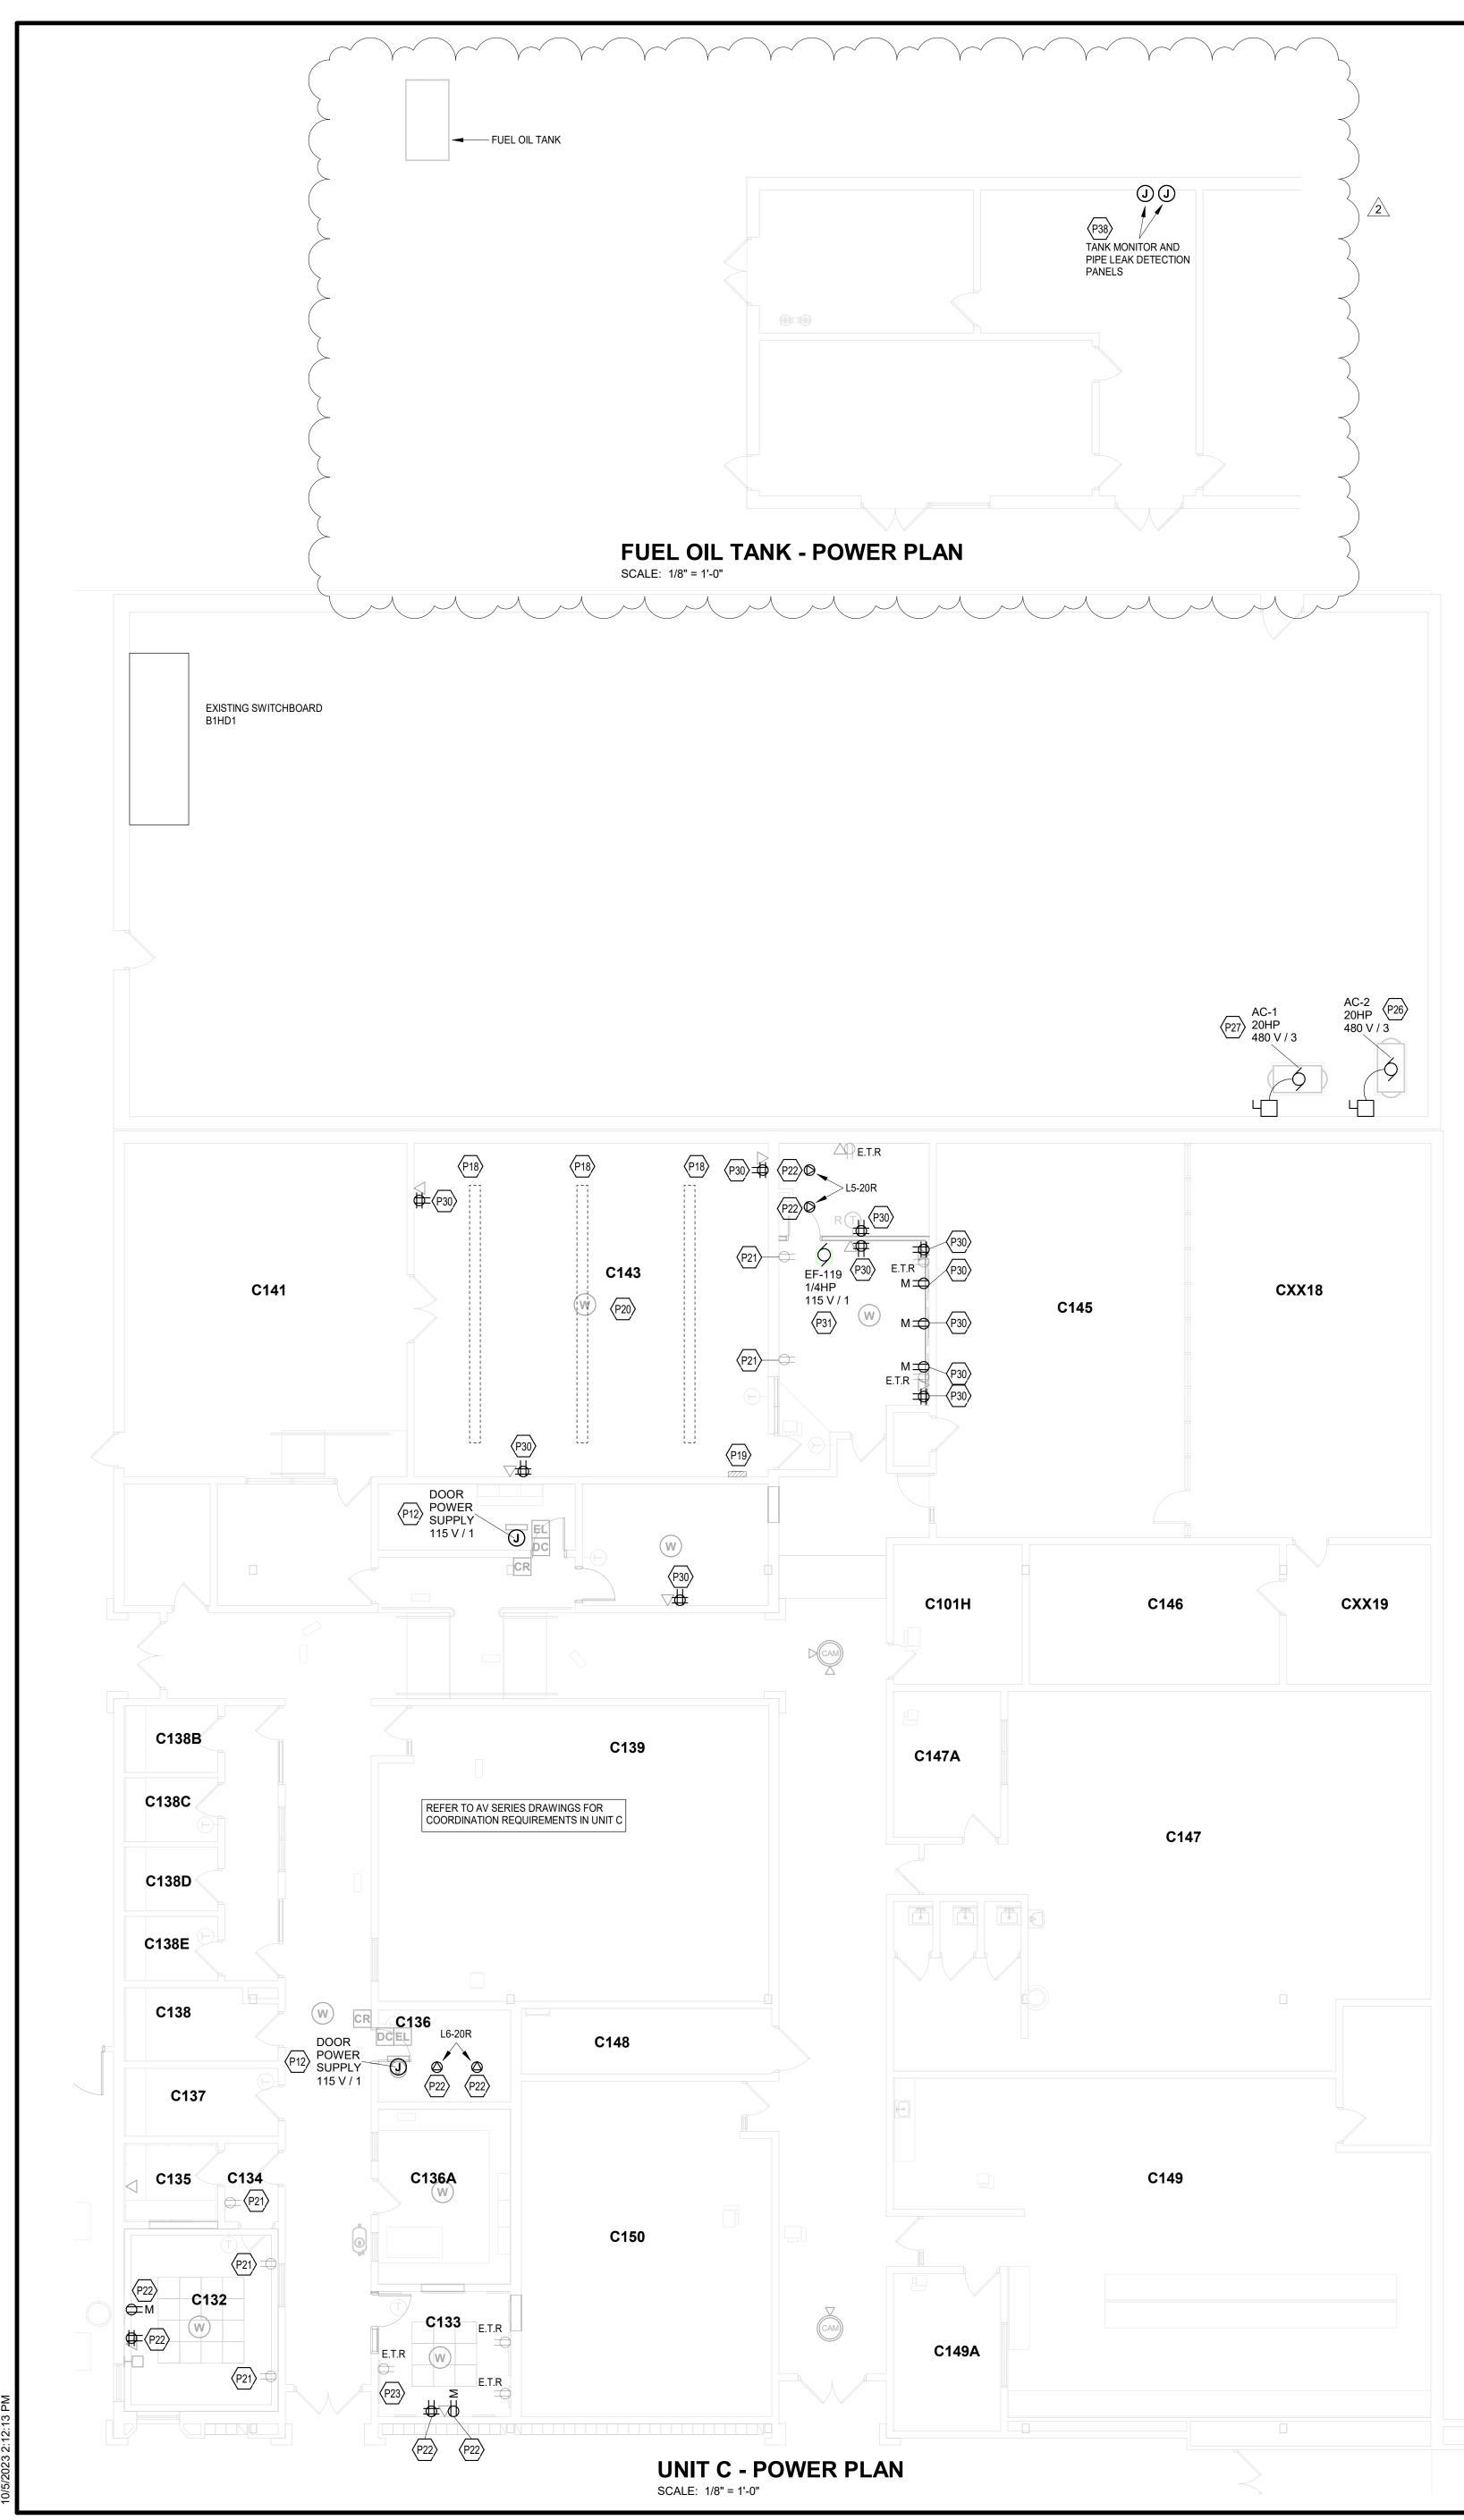

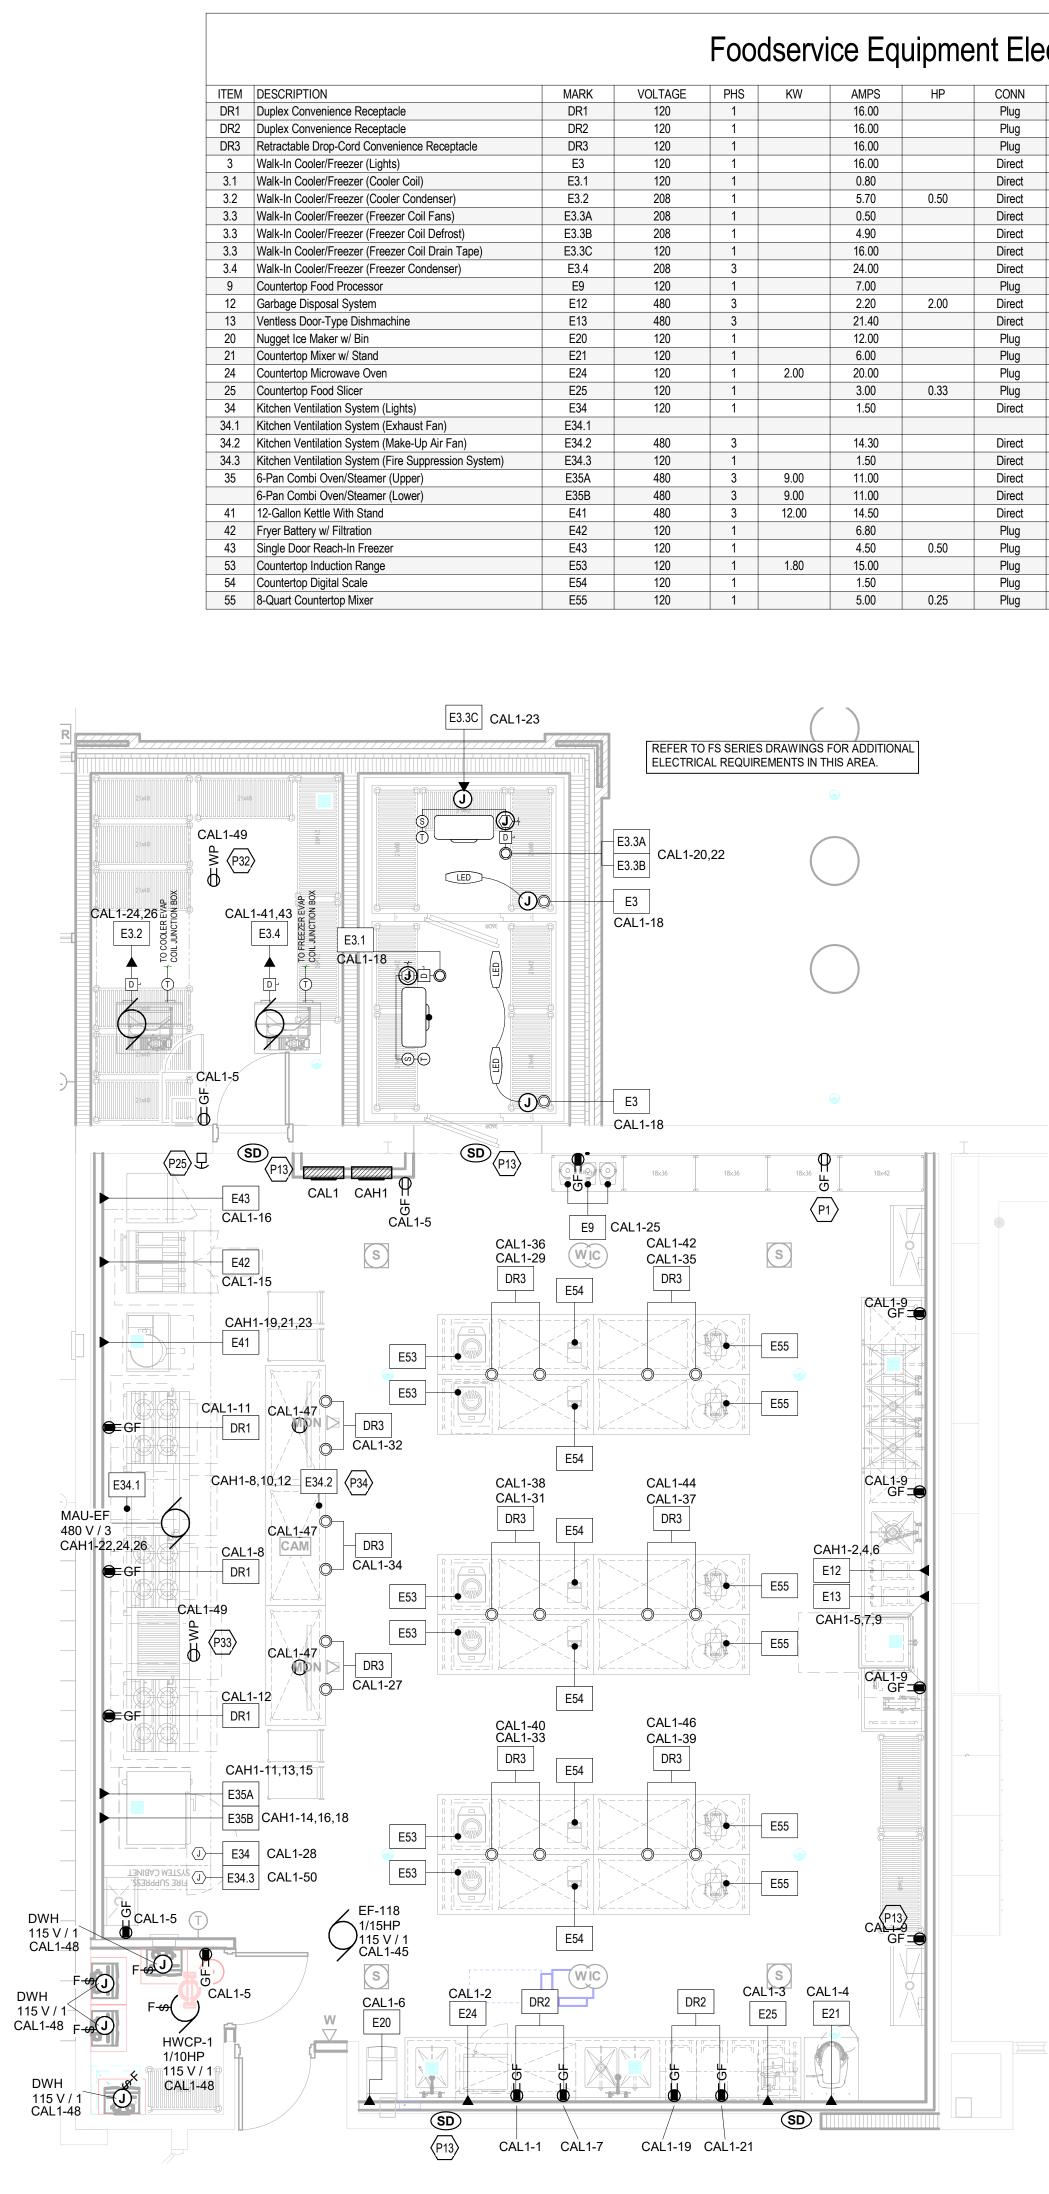


UNIT B - POWER PLAN SCALE: 1/4" = 1'-0"

		_							
		100	dservi	ice Eq	uipme	ent Ele	ctrica	I Sch	nedule
							1	-1	
MARK	VOLTAGE	PHS	KW	AMPS	HP	CONN	NEMA	AFF	ELECTRICAL REMARKS
DR2	120	1		16.00		Plug		48	Furnish horizontal receptacle when mounted above countertop
DR3	120	1		16.00		Plug		DFA	Drop service from directly above equipment to a point 72" aff
E3	120	1		16.00		Direct		DFA	Extend to KEC furnished light fixtures thru junction box on top of walk-in compartment
E3.1	120	1		0.80		Direct		DFA	Extend to junction box on cooler evaporator coil thru KEC furnished disconnect switch
E3.2	208	1		5.70	0.50	Direct		Rooftop	
E3.3A	208	1		0.50		Direct		DFA	Extend from #E10.4 - See Walk-In Freezer Wiring Detail on FS3.0
E3.3B	208	1		4.90		Direct		DFA	Extend from #E10.4 - See Walk-In Freezer Wiring Detail on FS3.0
E3.3C	120	1		16.00		Direct		96"	Extend to receptacle mounted high on wall behind freezer evaporator coil
E3.4	208	3		24.00		Direct		Rooftop	Extend to equipment thru KEC furnished electrical disconnect mounted on equipment
E9	120	1		7.00		Plug	5-15P	Conv	Service from convenience receptacle located in foodservice area
E12	480	3		2.20	2.00	Direct		16	Extend to equipment thru KEC furnished control panel
E13	480	3		21.40		Direct		16	Extend to equipment thru electrical disconnect
E20	120	1		12.00		Plug	5-15P	48	Furnish horizontal receptacle when mounted above countertop
E21	120	1		6.00		Plug	5-15P	48	Furnish horizontal receptacle when mounted above countertop
E24	120	1	2.00	20.00		Plug	5-20P	48	Furnish horizontal receptacle when mounted above countertop
E25	120	1		3.00	0.33	Plug	5-15P	48	Furnish horizontal receptacle when mounted above countertop
E34	120	1		1.50		Direct		DFA	Extend to junction box on top of exhaust ventilation hood
E34.1								Rooftop	Service for exhaust fan combined with service for make-up air fan
E34.2	480	3		14.30		Direct		Rooftop	Extend to equipment thru KEC furnished electrical disconnect mounted on equipment
E34.3	120	1		1.50		Direct		DFA	Extend to junction box on top of exhaust ventilation hood
E35A	480	3	9.00	11.00		Direct		48	Extend to equipment thru shunt trip circuit breaker
E35B	480	3	9.00	11.00		Direct		48	Extend to equipment thru shunt trip circuit breaker
E41	480	3	12.00	14.50		Direct		48	Extend to equipment thru shunt trip circuit breaker
E42	120	1		6.80		Plug	5-15P	48	Extend to equipment thru shunt trip circuit breaker
E43	120	1		4.50	0.50	Plug	5-15P	48	Extend to equipment thru shunt trip circuit breaker
E53	120	1	1.80	15.00		Plug	5-15P	Conv	Service from convenience receptacle located in foodservice area
E54	120	1		1.50		Plug	5-15P	Conv	Service from convenience receptacle located in foodservice area
E55	120	1		5.00	0.25	Plug	5-15P	Conv	Service from convenience receptacle located in foodservice area


## **GENERAL NOTES - POWER**

- PROVIDE REVISED TYPED PANELBOARD DIRECTORIES FOR EACH PANELBOARD ADDED OR MODIFIED DURING CONSTRUCTION. FIELD VERIFY EXISTING CIRCUIT INFORMATION WITH OWNER'S ASSISTANCE TO ENSURE FINAL DIRECTORY IS ACCURATE. UNUSED SPARE BREAKERS SHALL BE IN THE OFF POSITION. CONTRACTOR SHALL VERIFY ALL DIMENSIONS AND CLEARANCES AND ALL EXISTING FIELD CONDITIONS BEFORE STARTING CONSTRUCTION. COMMENCEMENT OF WORK CONSTITUTES ACCEPTANCE OF
- CONDITIONS. SHOULD DIFFERENT CONDITIONS BE ENCOUNTERED, CONTACT THE ARCHITECT BEFORE PROCEEDING WITH WORK. LABEL EACH RECEPTACLE WITH THE PANEL NAME AND CIRCUIT NUMBER ON THE FACE OF EACH COVER
- PLATE WITH A TYPED LAMINATED LABEL. PROVIDE "GFCI PROTECTED" LABEL ON COVER PLATE FOR ANY GFCI PROTECTED DEVICE. CONTRACTOR SHALL INCREASE CIRCUIT CONDUCTOR SIZE TO COMPENSATE FOR VOLTAGE DROP DUE TO
- EXCESSIVE CIRCUIT LENGTHS. IN NO CASE SHALL VOLTAGE DROP EXCEED NFPA 70 (N.E.C.) REQUIREMENTS.
- REFER TO MECHANICAL PLANS FOR LOCATION OF MECHANICAL EQUIPMENT. LOCATE DISCONNECT SWITCHES PER NEC. REFER TO "CONTROL SCHEMATICS" MECHANICAL DRAWINGS FOR ADDITIONAL CONTROL WIRING AND
- CONTROL CONNECTIONS. ALL DEVICES, EQUIPMENT, FIXTURES, AND THE LIKE, SHALL BE BONDED WITH A PROPERLY SIZED EQUIPMENT GROUNDING CONDUCTOR. MAINTAIN MECHANICAL/ELECTRICAL BONDS OF METALLIC
- RACEWAY SYSTEM. FOR EXISTING RECEPTACLES TO BE REMOVED, REMOVE CONDUIT, BOX, AND WIREING COMPLETELY.
- REPAIR WALL PRIOR TO PAINTING. CONDUITS AND BOXES CAN REMAIN BEHIND FURRED PORTIONS OF WALLS. NO BLANK PLATES ARE TO BE VISIBLE UPON PROJECT COMPLETION. REPLACE ALL EXISTING RECEPTACLES SHOWN TO REMAIN WITH NEW DEVICES AND FACEPLATES. CIRCUIT NUMBERS SHOWN FOR EXISTING PANELBOARDS ARE NUMBERED SPARE/SPACE CIRCUITS. EXISTING CIRCUITS TO REMAIN ARE NOT TO BE AFFECTED BY THIS NUMBERING.

	KEYNOTES
P1	PROVIDE NEW GFCI RECEPTACLE AT THIS LOCATION. CONNECT TO EXISTING CIR TIED BACK DURING DEMOLITION.
P12	CONNECT TO NEAREST RECEPTACLE CIRCUIT WITH 2#12, #12G IN 3/4"C.
P13	CONNECT ALL SMOKE DAMPERS IN UNITS A AND B OF THIS PROJECT TO AN AVAILABLE DEDICATED SPARE 20A CIRCUIT IN EXISTING PANEL 1WL3. PROVIDE A BREAKER IF NECESSARY AND CONNECT WITH 2#12, #12G IN 3/4"C.
P18	PROVIDE NEW CEILING MOUNTED RACEWAY WITH 6 RECEPTACLES THE SAME DIMENSIONS AND AT THE SAME LOCATION AS THE PREVIOUS RACEWAY THAT W/ REMOVED. PROVIDE 3 CIRCUITS TO THE NEW PANEL C2, CONNECTING 2 RECEPTACLES TO EACH CIRCUIT. CONNECT WITH 2#12, #12G IN 3/4"C. UTILIZE EXISTING CONDUIT IF IT IS IN GOOD CONDITION.
P19	PROVIDE A NEW PANEL C2 AT THIS LOCATION, MATCHING THE DIMENSIONS AND PROPERTIES OF THE EXISTING PANEL THAT WAS REMOVED. PROVIDE A SURGE PROTECTIVE DEVICE IN THE PANEL IN AVAILABLE SPACE. LEAVE BREAKERS NO LONGER UTILIZED FOR CIRCUITS IN THE CEILING MOUNTED RACEWAYS AS SPAR
P20	REPLACE EXISTING RECEPTACLES IN THIS SPACE WITH NEW DEVICES AND FACEPLATES.
P21	PROVIDE EXTENSION RINGS ON EXISTING RECEPTACLE BOXES TO EXTEND TO N WALL FACE. PROVIDE NEW DEVICE AND FACEPLATE.
P22	CONNECT NEW RECEPTACLE TO AVAILABLE SPARE 20A CIRCUIT IN PANELS IN RC C148. CONNECT WITH 2#12, #12G IN 3/4"C.
P23	PROVIDE NEW STAINLESS STEEL BLANK PLATE ON EMPTY BOX ON CMU WALL AT LOCATION.
P25	CONNECT EMERGENCY STOP PUSHBUTTON TO SHUNT TRIP MAIN BREAKERS IN PANELBOARDS CAL1 AND CAH1.
P26	CONNECT NEW AIR COMPRESSOR AND NEW 60A DISCONNECT TO THE AIR COMPRESSOR CIRCUIT TIED BACK DURING DEMOLITION. EXTEND CIRCUIT AS NE MATCHING EXISTING CONDUIT AND WIRE SIZES.
P27	CONNECT NEW AIR COMPRESSOR AND NEW 60A DISCONNECT TO AVAILABLE SP/ 60A SWITCH IN SWITCHBOARD B1HD1. CONNECT CIRCUIT WITH 3#6, #10G IN 1"C. PROVIDE 60A FUSES IN SWITCH AS REQUIRED.
P30	CONNECT NEW RECEPTACLE TO AVAILABLE SPARE 20A CIRCUIT IN PANEL C2 IN ROOM C143. CONNECT WITH 2#12, #12G IN 3/4"C.
P31	CONNECT NEW EXHAUST FAN TO AVAILABLE SPARE 20A CIRCUIT IN PANEL C2 IN ROOM C143. CONNECT WITH 2#12, #12G IN 3/4"C.
P32	PROVIDE RECEPTACLE ON ROOF, MOUNTED NEAR COOLER AND FREEZER CONDENSING UNITS.
P33	PROVIDE RECEPTACLE ON ROOF, MOUNTED NEAR MAU.
P34	CONNECT MAU 120V CONTROLS TO THE HOOD POWER CIRCUIT SHOWN CONNEC TO ITEM E34. CONNECT WITH 2#12, #12G IN 3/4 %.
P38	FUEL OIL TANK LEAK DETECTION EQUIPMENT PROVIDED BY DIV 22. PROVIDE CONDUIT, WIRING, AND CONNECTIONS TO ALL EQUIPMENT AND THE TANK AS REQUIRED BY MANUFACTURER AND SHEET P4.02. PROVIDE POWER FROM AN AVAILABLE SPARE 20A BREAKER IN NEAREST 208/120V PANELBOARD. CONNECT V 2#12, #12G IN 3/4"C.

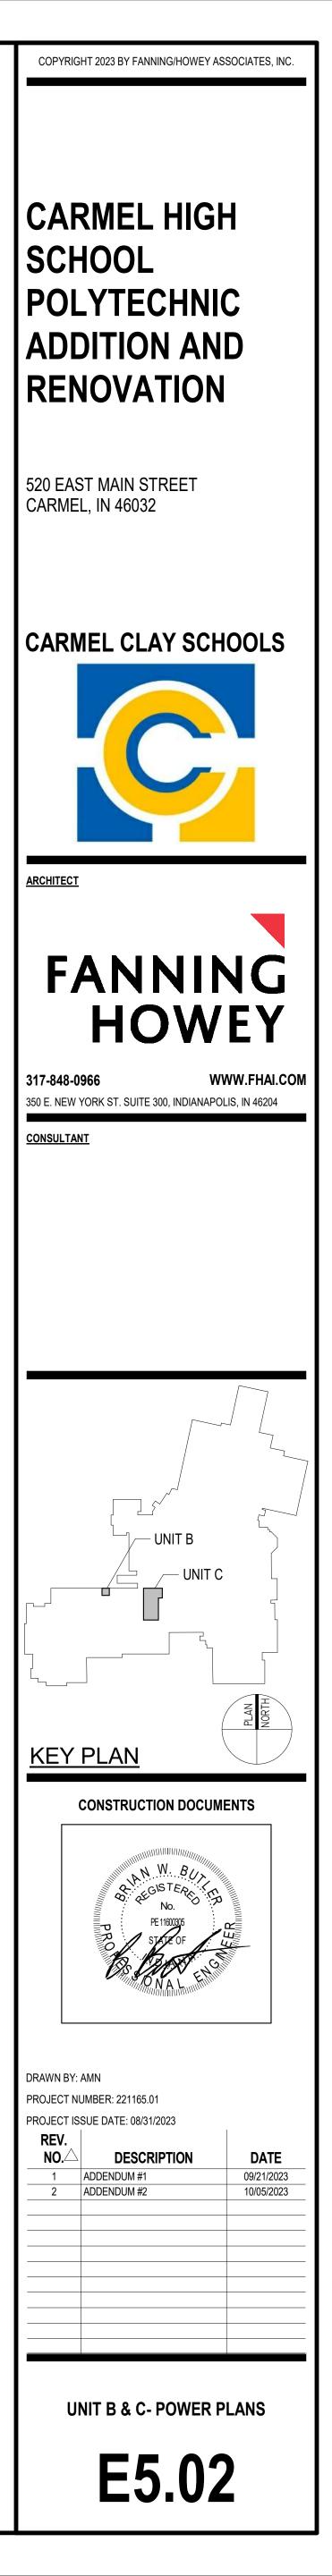




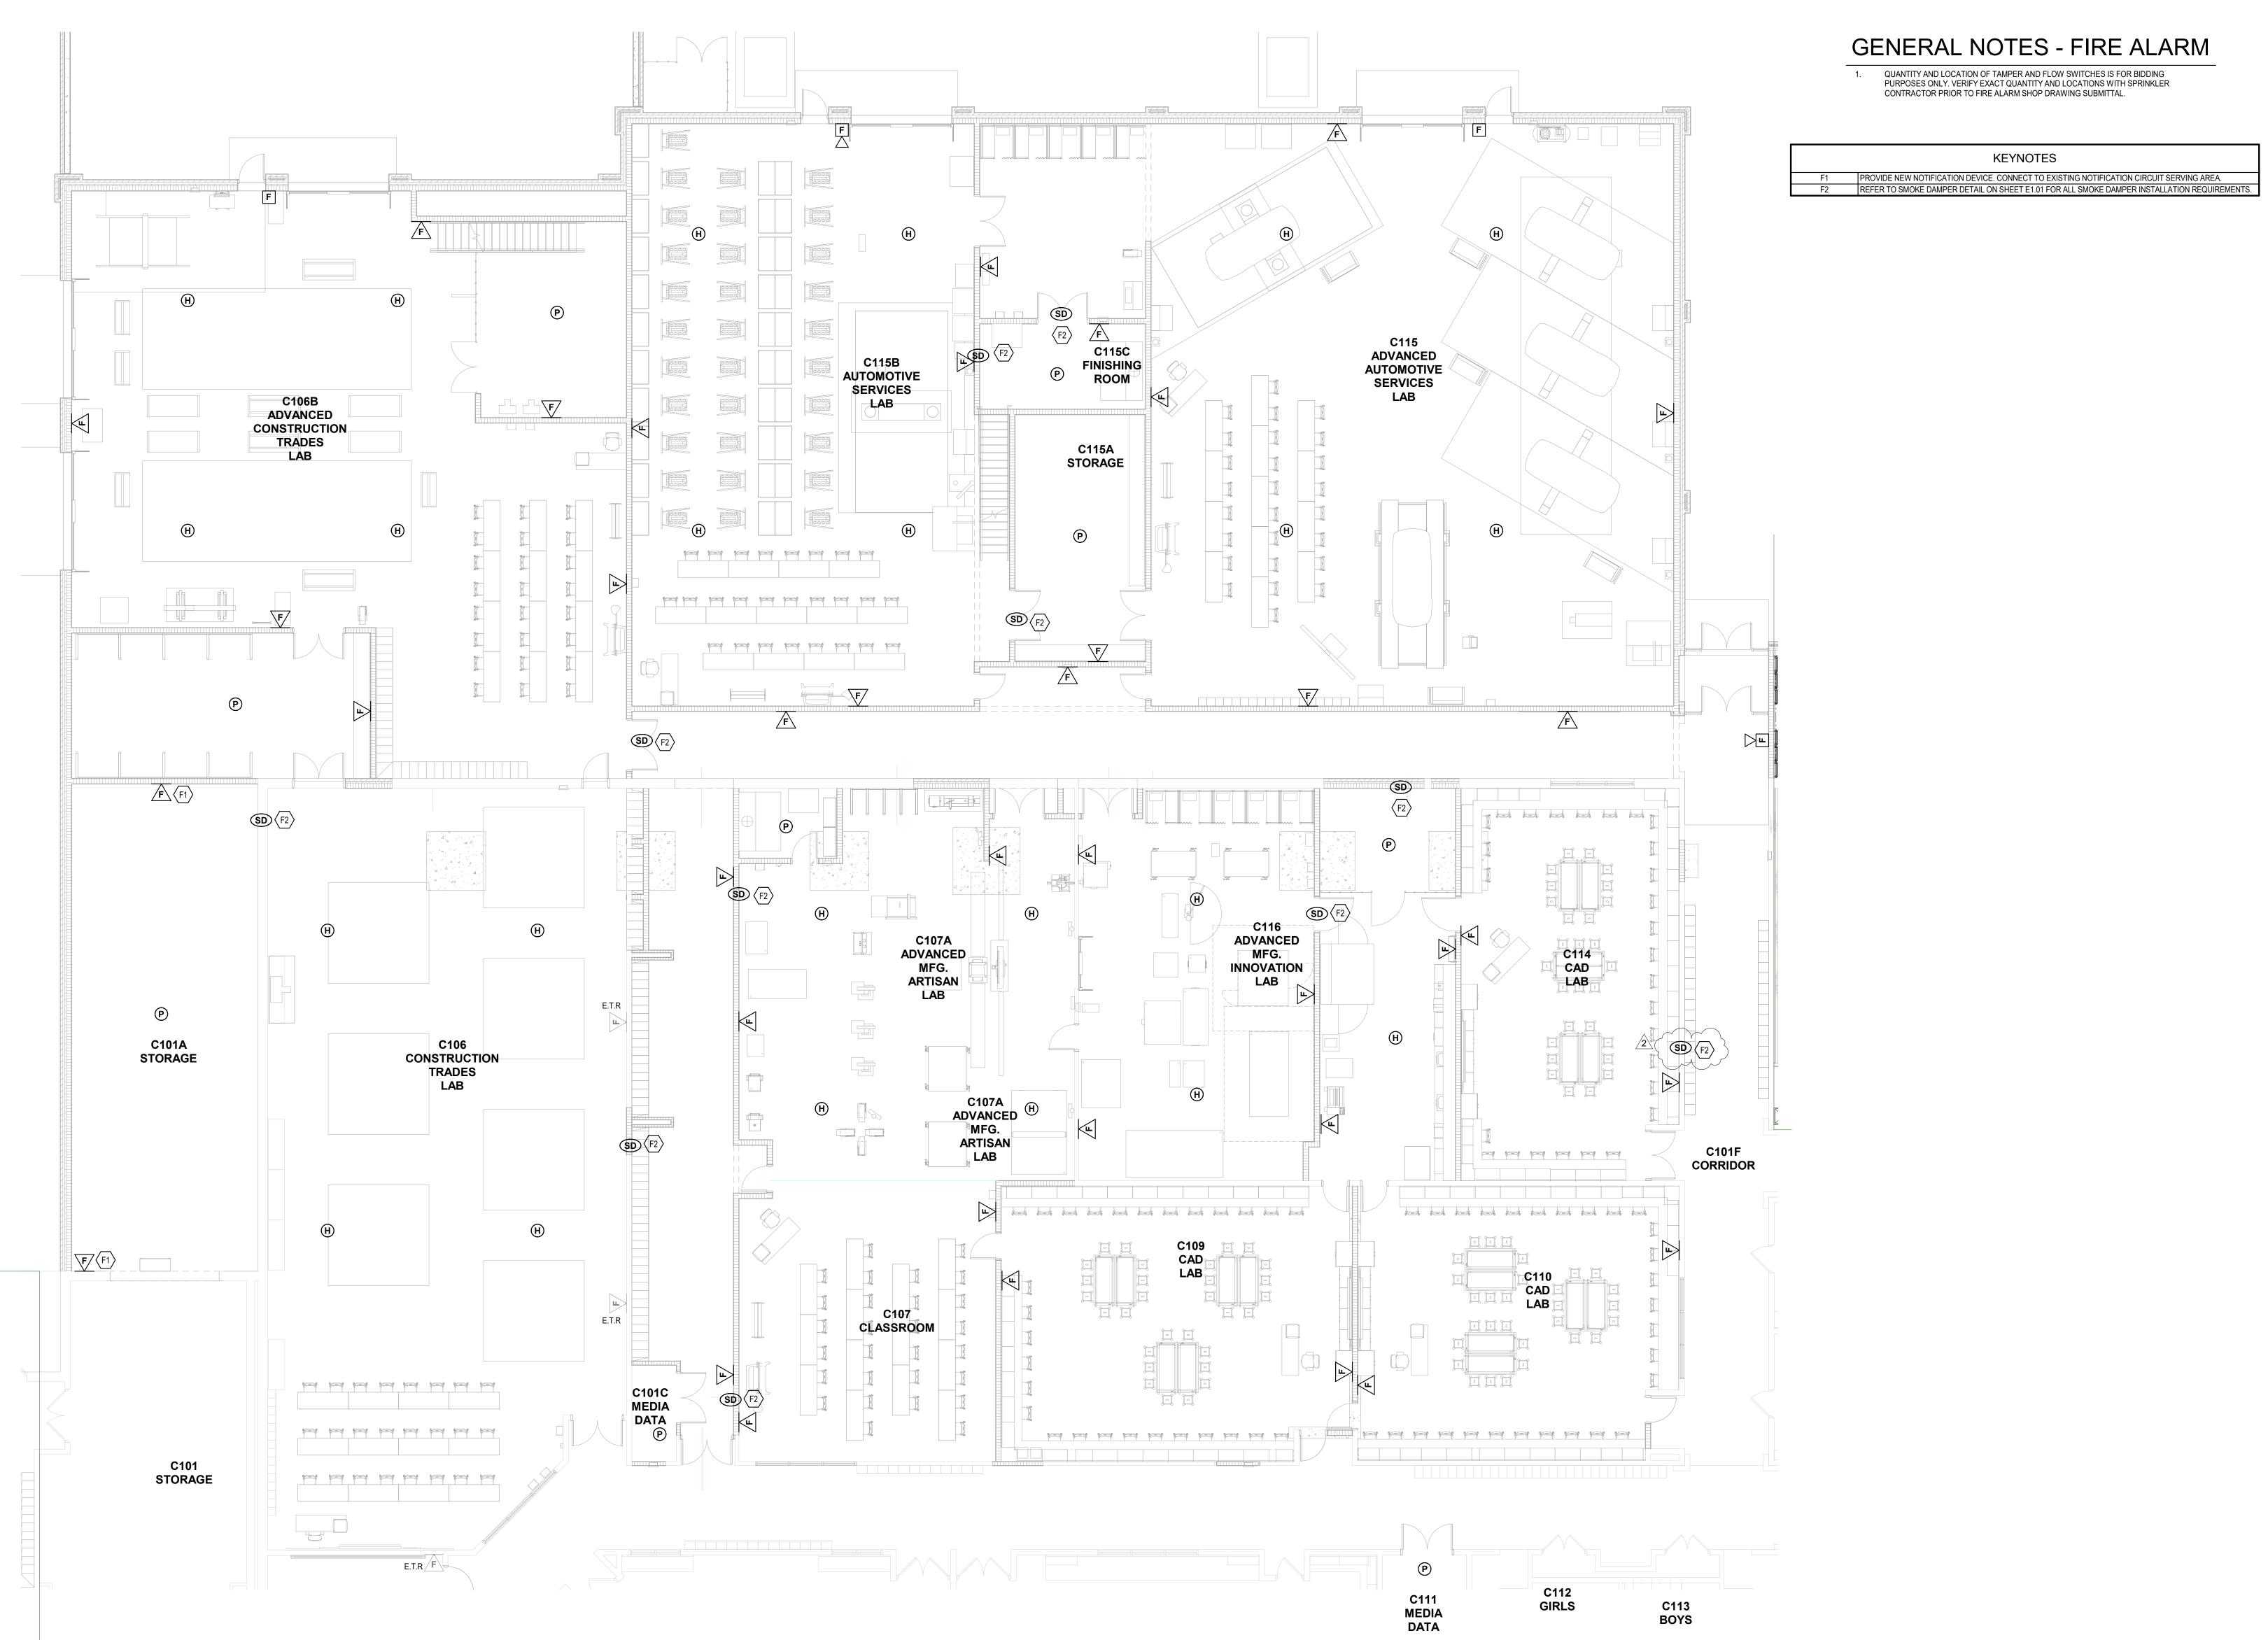


UNIT A - FIRE ALARM PLAN SCALE: 1/8" = 1'-0"



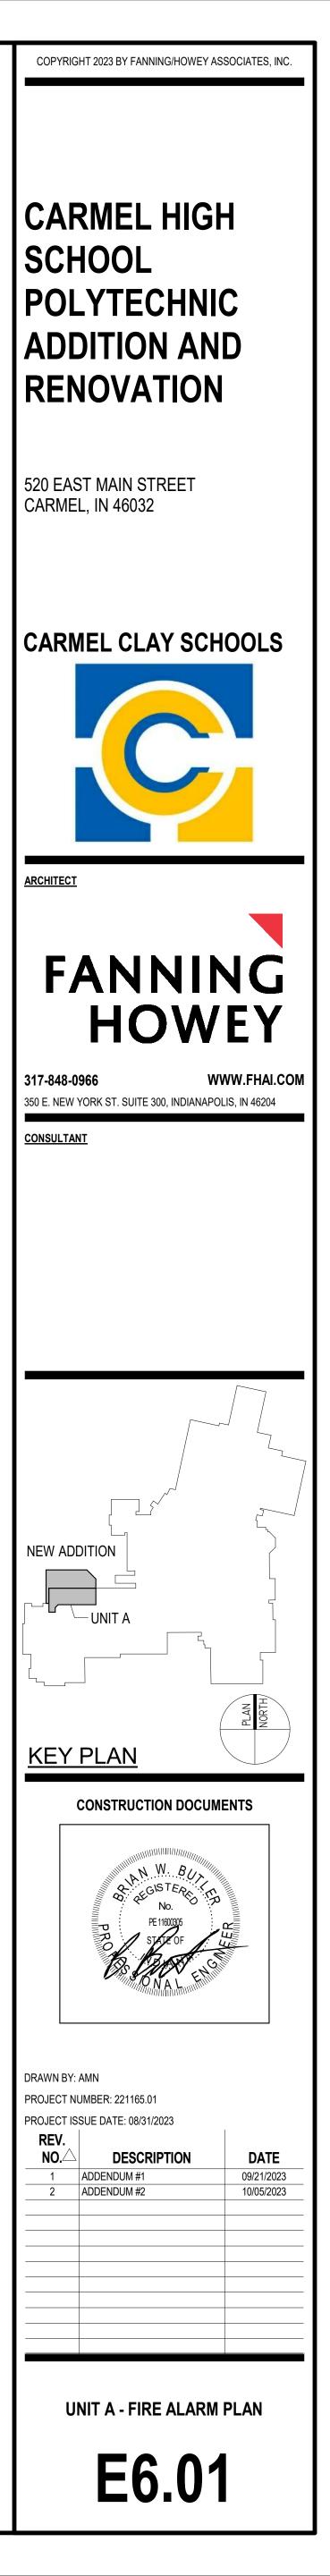




# TECHNOLOGY PLAN NOTES REMOVE EXISTING WIRELESS ACCESS POINTS, DATA OUTLETS, TIE BACK AND PROTECT CABLING.

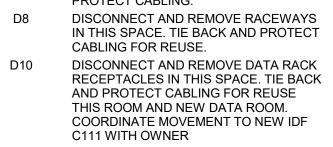

D1

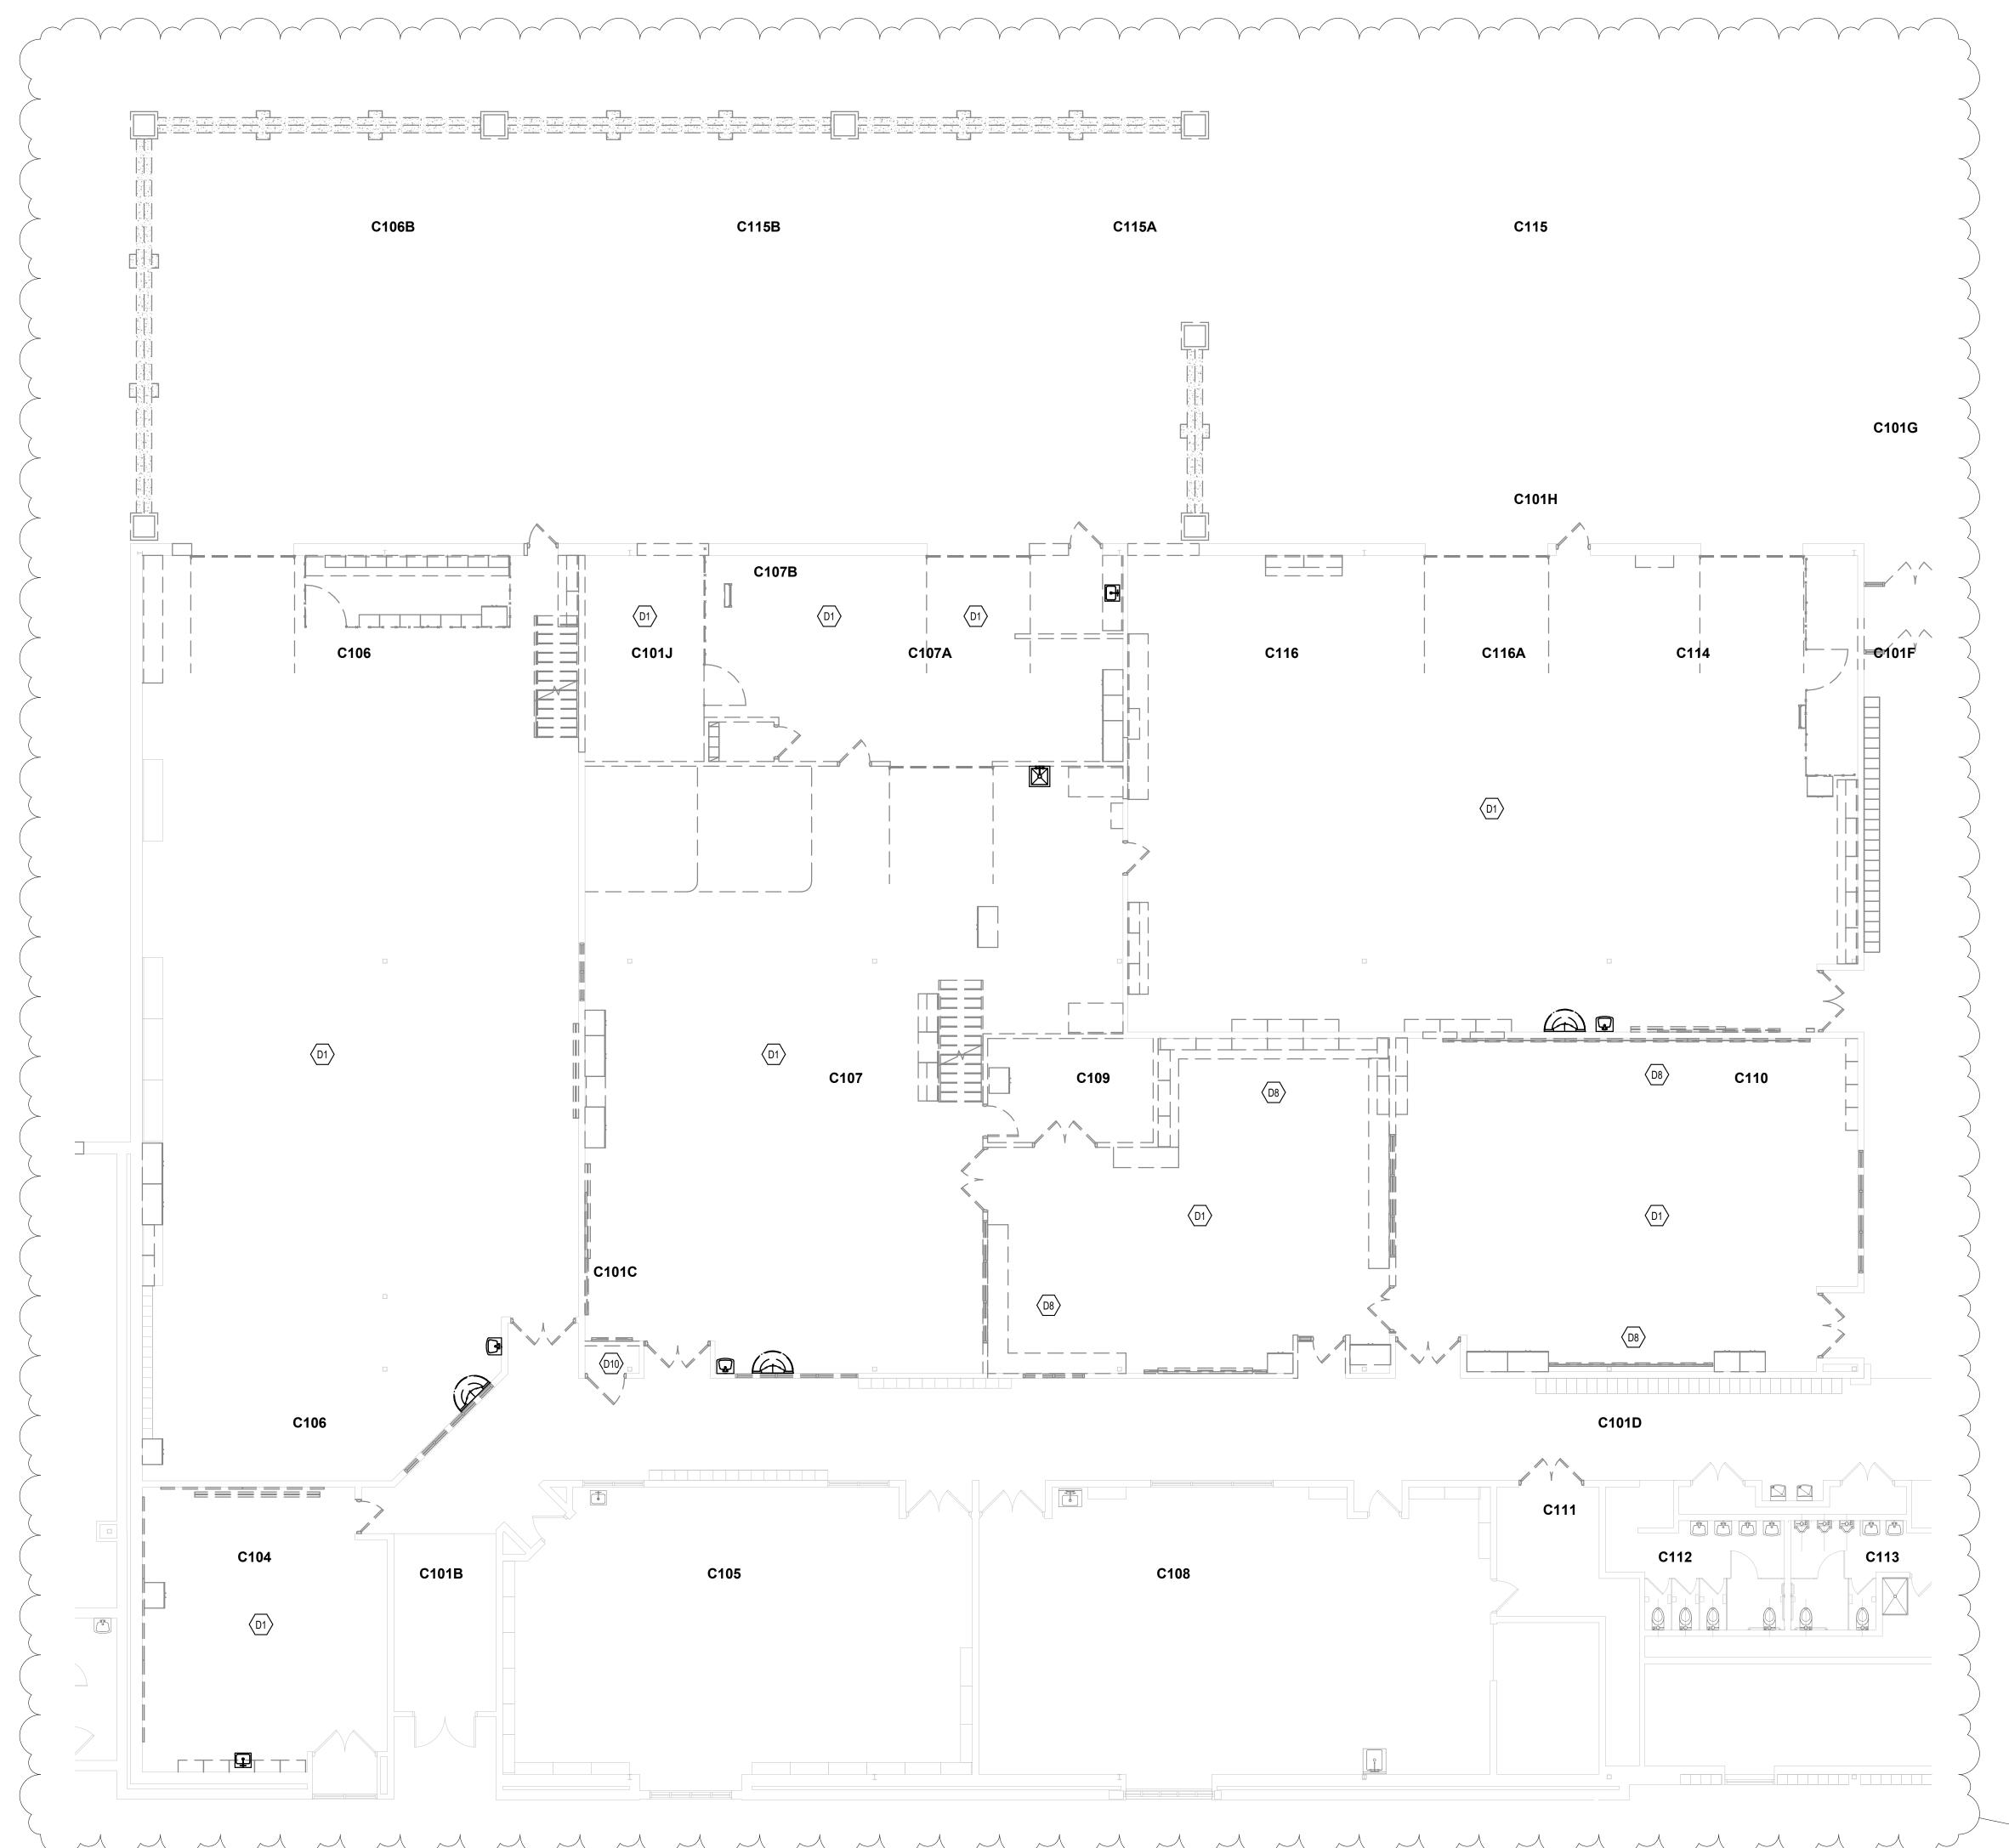


R	OOM LEGEND - FIRST FLOOR UN	тс
ROOM NO.		AREA (SF)
C100	LOADING / RECEIVING	1202 SF
C100A	BREAK ROOM	640 SF
C100B	ELECTRICAL	825 SF
C100C	LAUNDRY	157 SF
C100D	TOILET	52 SF
C100E		52 SF
C100F	SECURE STORAGE	91 SF
C100G	OFFICE	132 SF
C100H	KITCHEN	177 SF
C101	STORAGE	1015 SF
C101A	STORAGE	1287 SF
C101B	CORRIDOR	174 SF
C101C	MEDIA DATA	61 SF
C101D C101D	YEARBOOK CLASSROOM / LAB	Not Placed
C101D	CORRIDOR	1860 SF
C101E	CORRIDOR	177 SF
C101F	CORRIDOR	976 SF
C101G	JOURNALISM CLASSROOM	Not Placed
C101G	VESTIBULE	70 SF
C101H	OFFICE	156 SF
C101H	CORRIDOR	992 SF
C101J	CORRIDOR	832 SF
C102	MENS TOILET	124 SF
C102 C103	WOMENS TOILET	124 SF 119 SF
C104	OFFICE	638 SF
C105	ELECTRONICS / PHYSICS	1251 SF
C106	CONSTRUCTION TRADES LAB	3699 SF
C106A	STORAGE	622 SF
C106B	ADVANCED CONSTRUCTION	3867 SF
C107	TRADES LAB CLASSROOM	1015 SF
C107A	ADVANCED MFG. ARTISAN LAB	1695 SF
C107B	FINISHING ROOM	97 SF
C108	GRAPHIC COMMUNICATIONS	1385 SF
C109	CAD LAB	1347 SF
C110	CAD LAB	1217 SF
C111	MEDIA DATA	83 SF
C111A	STORAGE	101 SF
C112	GIRLS	188 SF
C113	BOYS	163 SF
C114	CAD LAB	1188 SF
C115	ADVANCED AUTOMOTIVE	4790 SF
	SERVICES LAB	
C115A	STORAGE	468 SF
C115B	AUTOMOTIVE SERVICES LAB	2828 SF
C115C	FINISHING ROOM	201 SF
C116	ADVANCED MFG. INNOVATION	1278 SF
	LAB	
C116A	ADVANCED MFG. CLEAN LAB	762 SF
C117	CERAMIC CLASSROOM / LAB	1387 SF
C117A C117B	STORAGE STORAGE / MATERIALS	145 SF
C118	INDEPENDENT STUDY /	150 SF 1425 SF
C119	COMMERICAL ART PHOTOGRAPHY	992 SF
C119A	DARKROOM	309 SF
C120	COMPUTER ART ROOM	442 SF
C122	TEACHERS WORKROOM	672 SF
C122A	DEPT. HEAD OFFICE	104 SF
C123	CERAMICS CLASSROOM / LAB	1205 SF
C123A	STORAGE	145 SF
C123B	STORAGE / MATERIALS	150 SF
C124	CULINARY ARTS	1299 SF
C124A	CLOSET	39 SF
C124B	DRY GOODS	154 SF
C124C	WALK-IN	129 SF
C125	DRAWING CLASSROOM / LAB	1173 SF
C126	DRAWING CLASSROOM / LAB	1182 SF
C127	DRAWING CLASSROOM / LAB	1182 SF
C128	JEWELRY CLASSROOM / LAB	953 SF
C129	PHOTOGRAPHY	1023 SF
C129A	DARKROOM	232 SF
C131	CORRIDOR	1363 SF
C131A	STORAGE	166 SF
C131B	MEDIA DATA	60 SF
C131C	CORRIDOR	476 SF
C132	STUDIO	244 SF
C133	PODCAST	144 SF
C134	PASSAGE	36 SF
C135	STUDIO	63 SF
C136	STORAGE	105 SF
C136A	COMPUTER LAB	201 SF
C137	STUDIO	91 SF
C138	STUDIO	93 SF
C138A	PASSAGE	127 SF
C138B	STUDIO	54 SF
C138C	STUDIO	52 SF
C138D	STUDIO	52 SF
C138E	STUDIO	52 SF
C139	CLASSROOM	984 SF
C141	TV CLASSROOM	819 SF
C141A	STUDIO B	165 SF
C141B	OFFICE	91 SF
C142	STUDIO B	196 SF
C142A	ENGINEERING	114 SF
C143	STUDIO A	1026 SF
C144	TV CONTROL	251 SF
C144A	EQUIPMENT ROOM	120 SF
C145	COMPUTER CLASSROOM	851 SF
C145A	SECURE CLOSET	17 SF
C146	COMPUTER SERVER STORAGE	303 SF
C147	JOURNALISM CLASSROOM	1468 SF
C147A	OFFICE	136 SF
C148	ELECTRICAL ROOM	143 SF
C149	YEARBOOK CLASSROOM / LAB	1350 SF
C149A	PODCAST	147 SF
C150	TV-CPU LAB	714 SF
C151	MECHANICAL	5687 SF 927 SF



sers\jregedanz\Documents\2021_TECH_221165.01_jregedanz.rvt

0/5/2023 2:49:29 PM

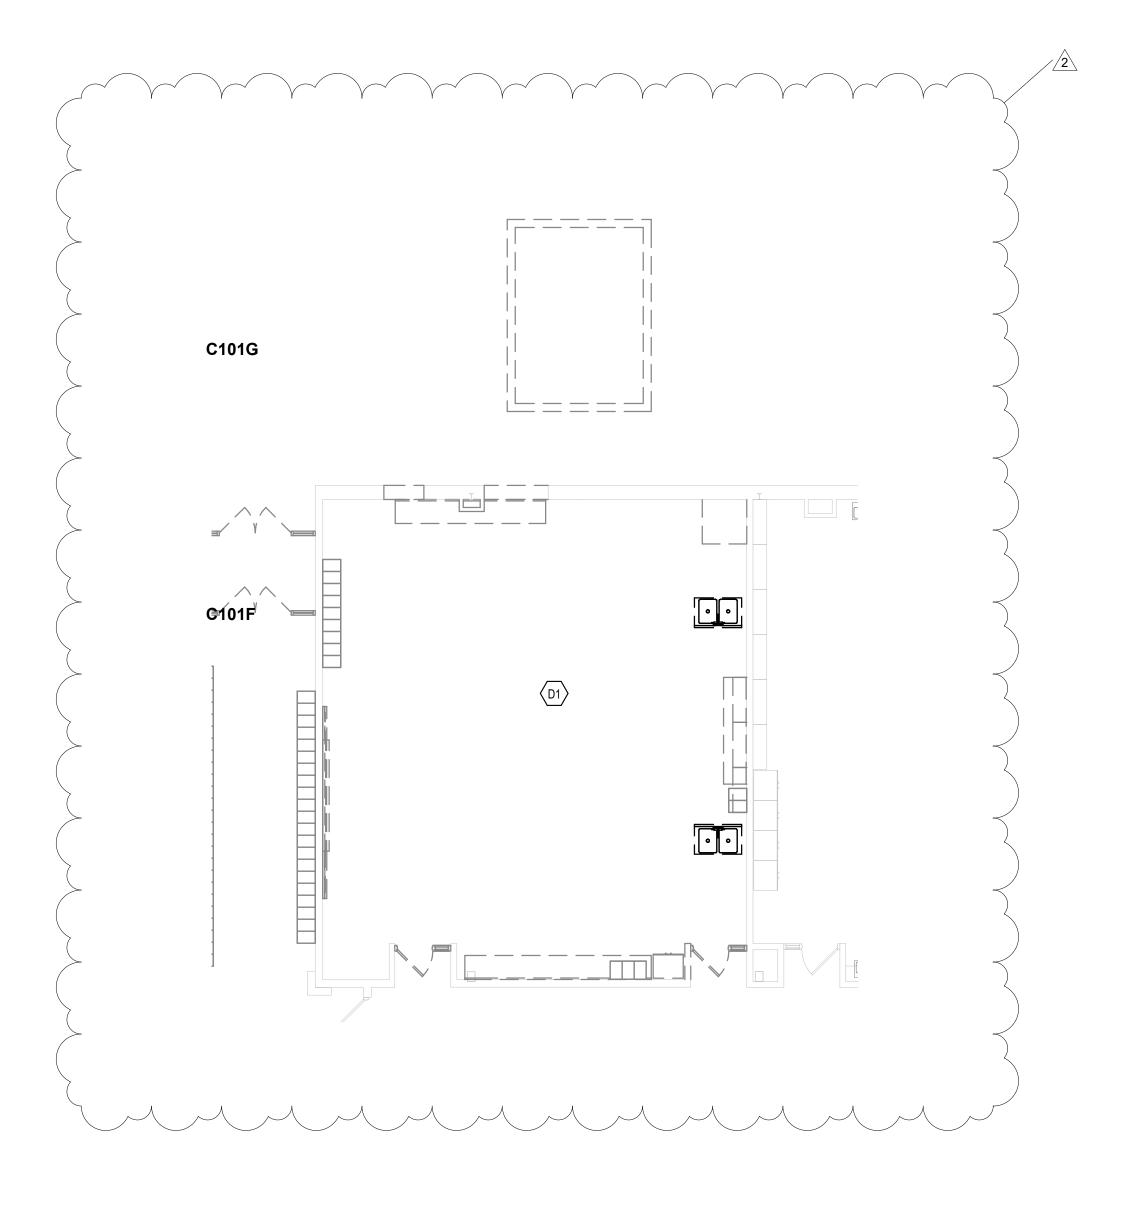



ROOM NO.	DOM LEGEND - FIRST FLOOR UN	IT C AREA (SF)
C100	LOADING / RECEIVING	1202 SF
C100A	BREAK ROOM	640 SF
C100B	ELECTRICAL	825 SF
C100C	LAUNDRY	157 SF
C100D	TOILET	52 SF
C100E	TOILET	52 SF
C100F	SECURE STORAGE	91 SF
C100G	OFFICE	132 SF
C100H	KITCHEN	177 SF
C101	STORAGE	1015 SF
C101A	STORAGE	1287 SF
C101B	CORRIDOR	174 SF
C101C	MEDIA DATA	61 SF
C101D	YEARBOOK CLASSROOM / LAB	Not Placed
C101D	CORRIDOR	1860 SF
C101E	CORRIDOR	177 SF
C101F	CORRIDOR	976 SF
C101G	JOURNALISM CLASSROOM	Not Placed
C101G C101H	VESTIBULE	70 SF 156 SF
C101H	CORRIDOR	992 SF
C101J	CORRIDOR	832 SF
C102	MENS TOILET	124 SF
C103	WOMENS TOILET	119 SF
C104	OFFICE	638 SF
C105	ELECTRONICS / PHYSICS	1251 SF
C106	CONSTRUCTION TRADES LAB	3699 SF
C106A	STORAGE	622 SF
C106B	ADVANCED CONSTRUCTION TRADES LAB	3867 SF
C107	CLASSROOM	1015 SF
C107A	ADVANCED MFG. ARTISAN LAB	1695 SF
C107B C108	FINISHING ROOM	97 SF 1385 SF
C109	CAD LAB	1347 SF
C110	CAD LAB	1217 SF
C111	MEDIA DATA	83 SF
C111A	STORAGE GIRLS	101 SF
C112 C113	BOYS	188 SF 163 SF
C114	CAD LAB	1188 SF
C115	ADVANCED AUTOMOTIVE	4790 SF
C115A	SERVICES LAB STORAGE	468 SF
C115B	AUTOMOTIVE SERVICES LAB	2828 SF
C115C	FINISHING ROOM	201 SF
C116	ADVANCED MFG. INNOVATION	1278 SF
C116A	LAB ADVANCED MFG. CLEAN LAB	762 SF
C117	CERAMIC CLASSROOM / LAB	1387 SF
C117A	STORAGE	145 SF
C117B	STORAGE / MATERIALS	150 SF
C118	INDEPENDENT STUDY / COMMERICAL ART	1425 SF
C119	PHOTOGRAPHY	992 SF
C119A	DARKROOM	309 SF
C120 C122	COMPUTER ART ROOM	442 SF 672 SF
C122A	DEPT. HEAD OFFICE	104 SF
C123	CERAMICS CLASSROOM / LAB	1205 SF
C123A	STORAGE	145 SF
C123B	STORAGE / MATERIALS	150 SF
C124	CULINARY ARTS	1299 SF
C124A	CLOSET	39 SF
C124B	DRY GOODS	154 SF
C124C	WALK-IN	129 SF
C125	DRAWING CLASSROOM / LAB	1173 SF
C126	DRAWING CLASSROOM / LAB	1182 SF
C127	DRAWING CLASSROOM / LAB	1182 SF
C128	JEWELRY CLASSROOM / LAB	953 SF
C129	PHOTOGRAPHY	1023 SF
C129A	DARKROOM	232 SF
C131	CORRIDOR	1363 SF
C131A	STORAGE	166 SF
C131B	MEDIA DATA	60 SF
C131C	CORRIDOR	476 SF
C132	STUDIO	244 SF
C133	PODCAST	144 SF
C134	PASSAGE	36 SF
C135	STUDIO	63 SF
C136	STORAGE	105 SF
C136A	COMPUTER LAB	201 SF
C137	STUDIO	91 SF
C138	STUDIO	93 SF
C138A	PASSAGE	127 SF
C138B	STUDIO	54 SF
C138C	STUDIO	52 SF
C138D	STUDIO	52 SF
C138E	STUDIO	52 SF
C139	CLASSROOM	984 SF
C141	TV CLASSROOM	819 SF
C141A	STUDIO B	165 SF
C141B	OFFICE	91 SF
C142	STUDIO B	196 SF
C142A	ENGINEERING	114 SF
C143	STUDIO A	1026 SF
C144	TV CONTROL	251 SF
C144A	EQUIPMENT ROOM	120 SF
C145	COMPUTER CLASSROOM	851 SF
C145A	SECURE CLOSET	17 SF
C146	COMPUTER SERVER STORAGE	303 SF
C147	JOURNALISM CLASSROOM	1468 SF
C147A	OFFICE	136 SF
C148	ELECTRICAL ROOM	143 SF
C149	YEARBOOK CLASSROOM / LAB	1350 SF
C149A	PODCAST	147 SF
C150	TV-CPU LAB	714 SF
C151	MECHANICAL	5687 SF
C152	-	927 SF

### TECHNOLOGY PLAN NOTES

D1 REMOVE EXISTING WIRELESS ACCESS POINTS, DATA OUTLETS, TIE BACK AND PROTECT CABLING.



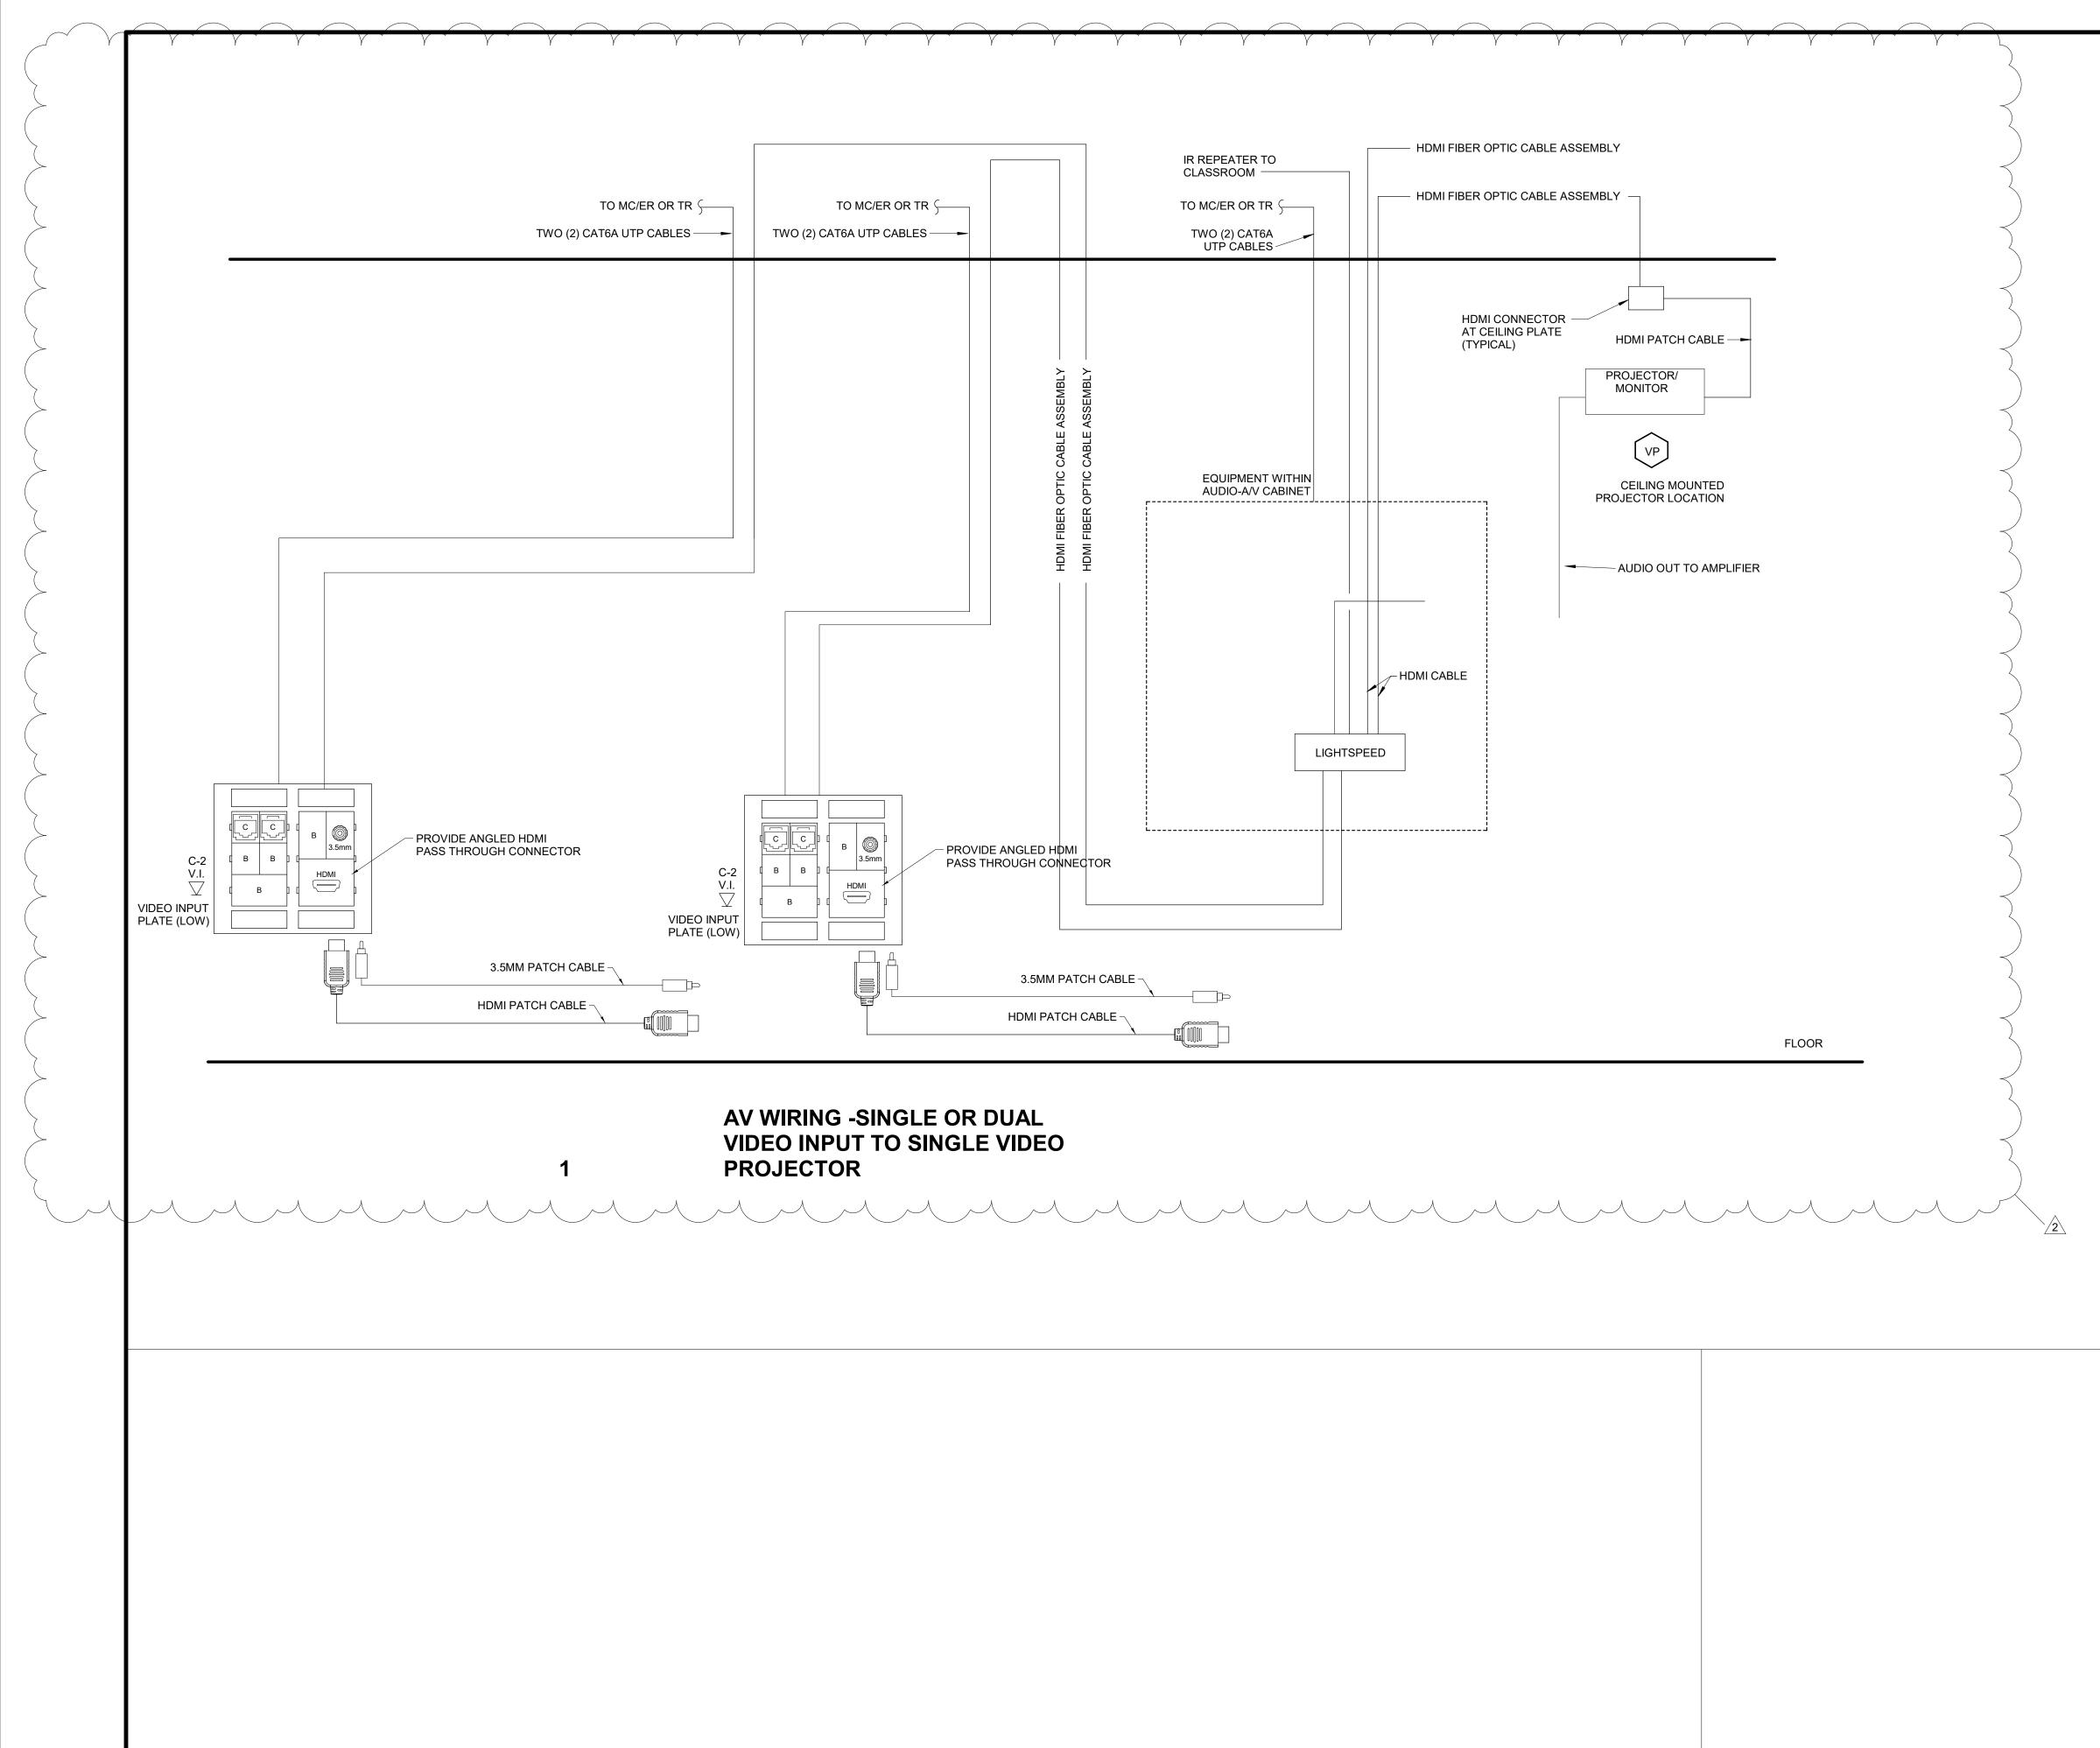

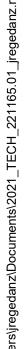

VC 1/2 WATT 1/2 WATT IC ICPS-CABINET INTERCOMMUNICATIONS AND **PROGRAM SYSTEM RISER** 3

EXISTING INTERCOM

EQUIPMENT

EXISTING TELEPHONE INTERFACE

–4 PAIR


1/2 WATT

2 WATTS

INTERCOM MASTER STATION

C) CORRIDOR/ NON CLASSROOM LOCATIONS (MAXIMUM OF 8 SPEAKERS TOTALING 10 WATTS)

WP

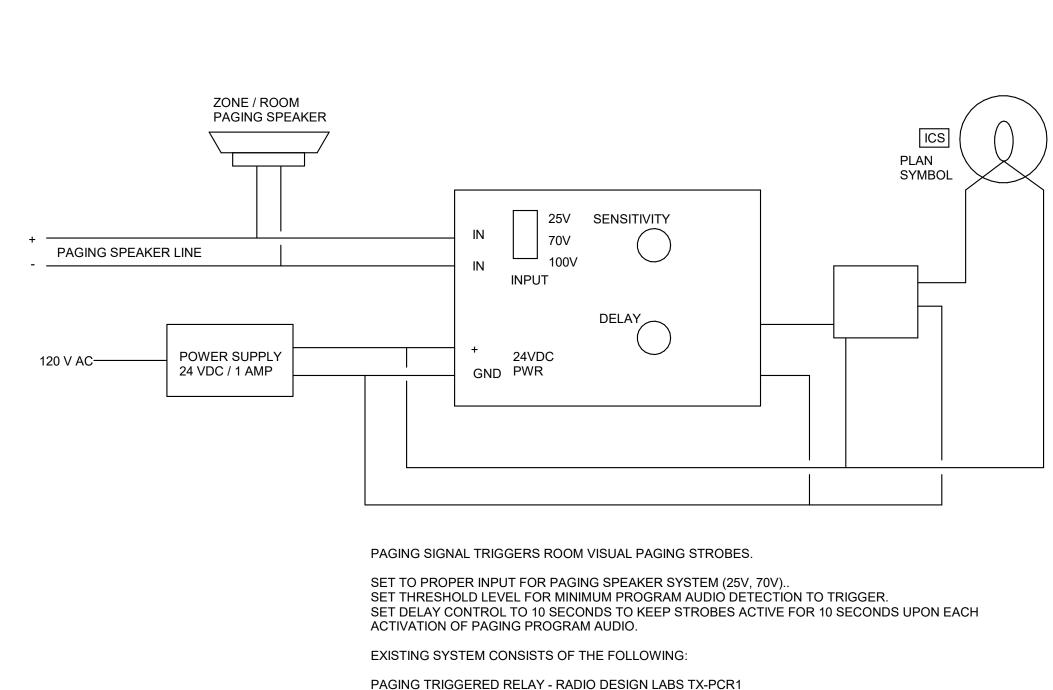


PAGING TRIGGERED RELAY - RADIO DESIGN LABS TX-PCR1 INTERVAL ON RELAY - DAYTON 24EN69 SINGLE FUNCTION TIMING RELAY IN DAYTON RELAY SOCKET (5X852) STROBE LIGHTS - POTTER SL-5A

2

### VISUAL PAGING STROBE DETAIL



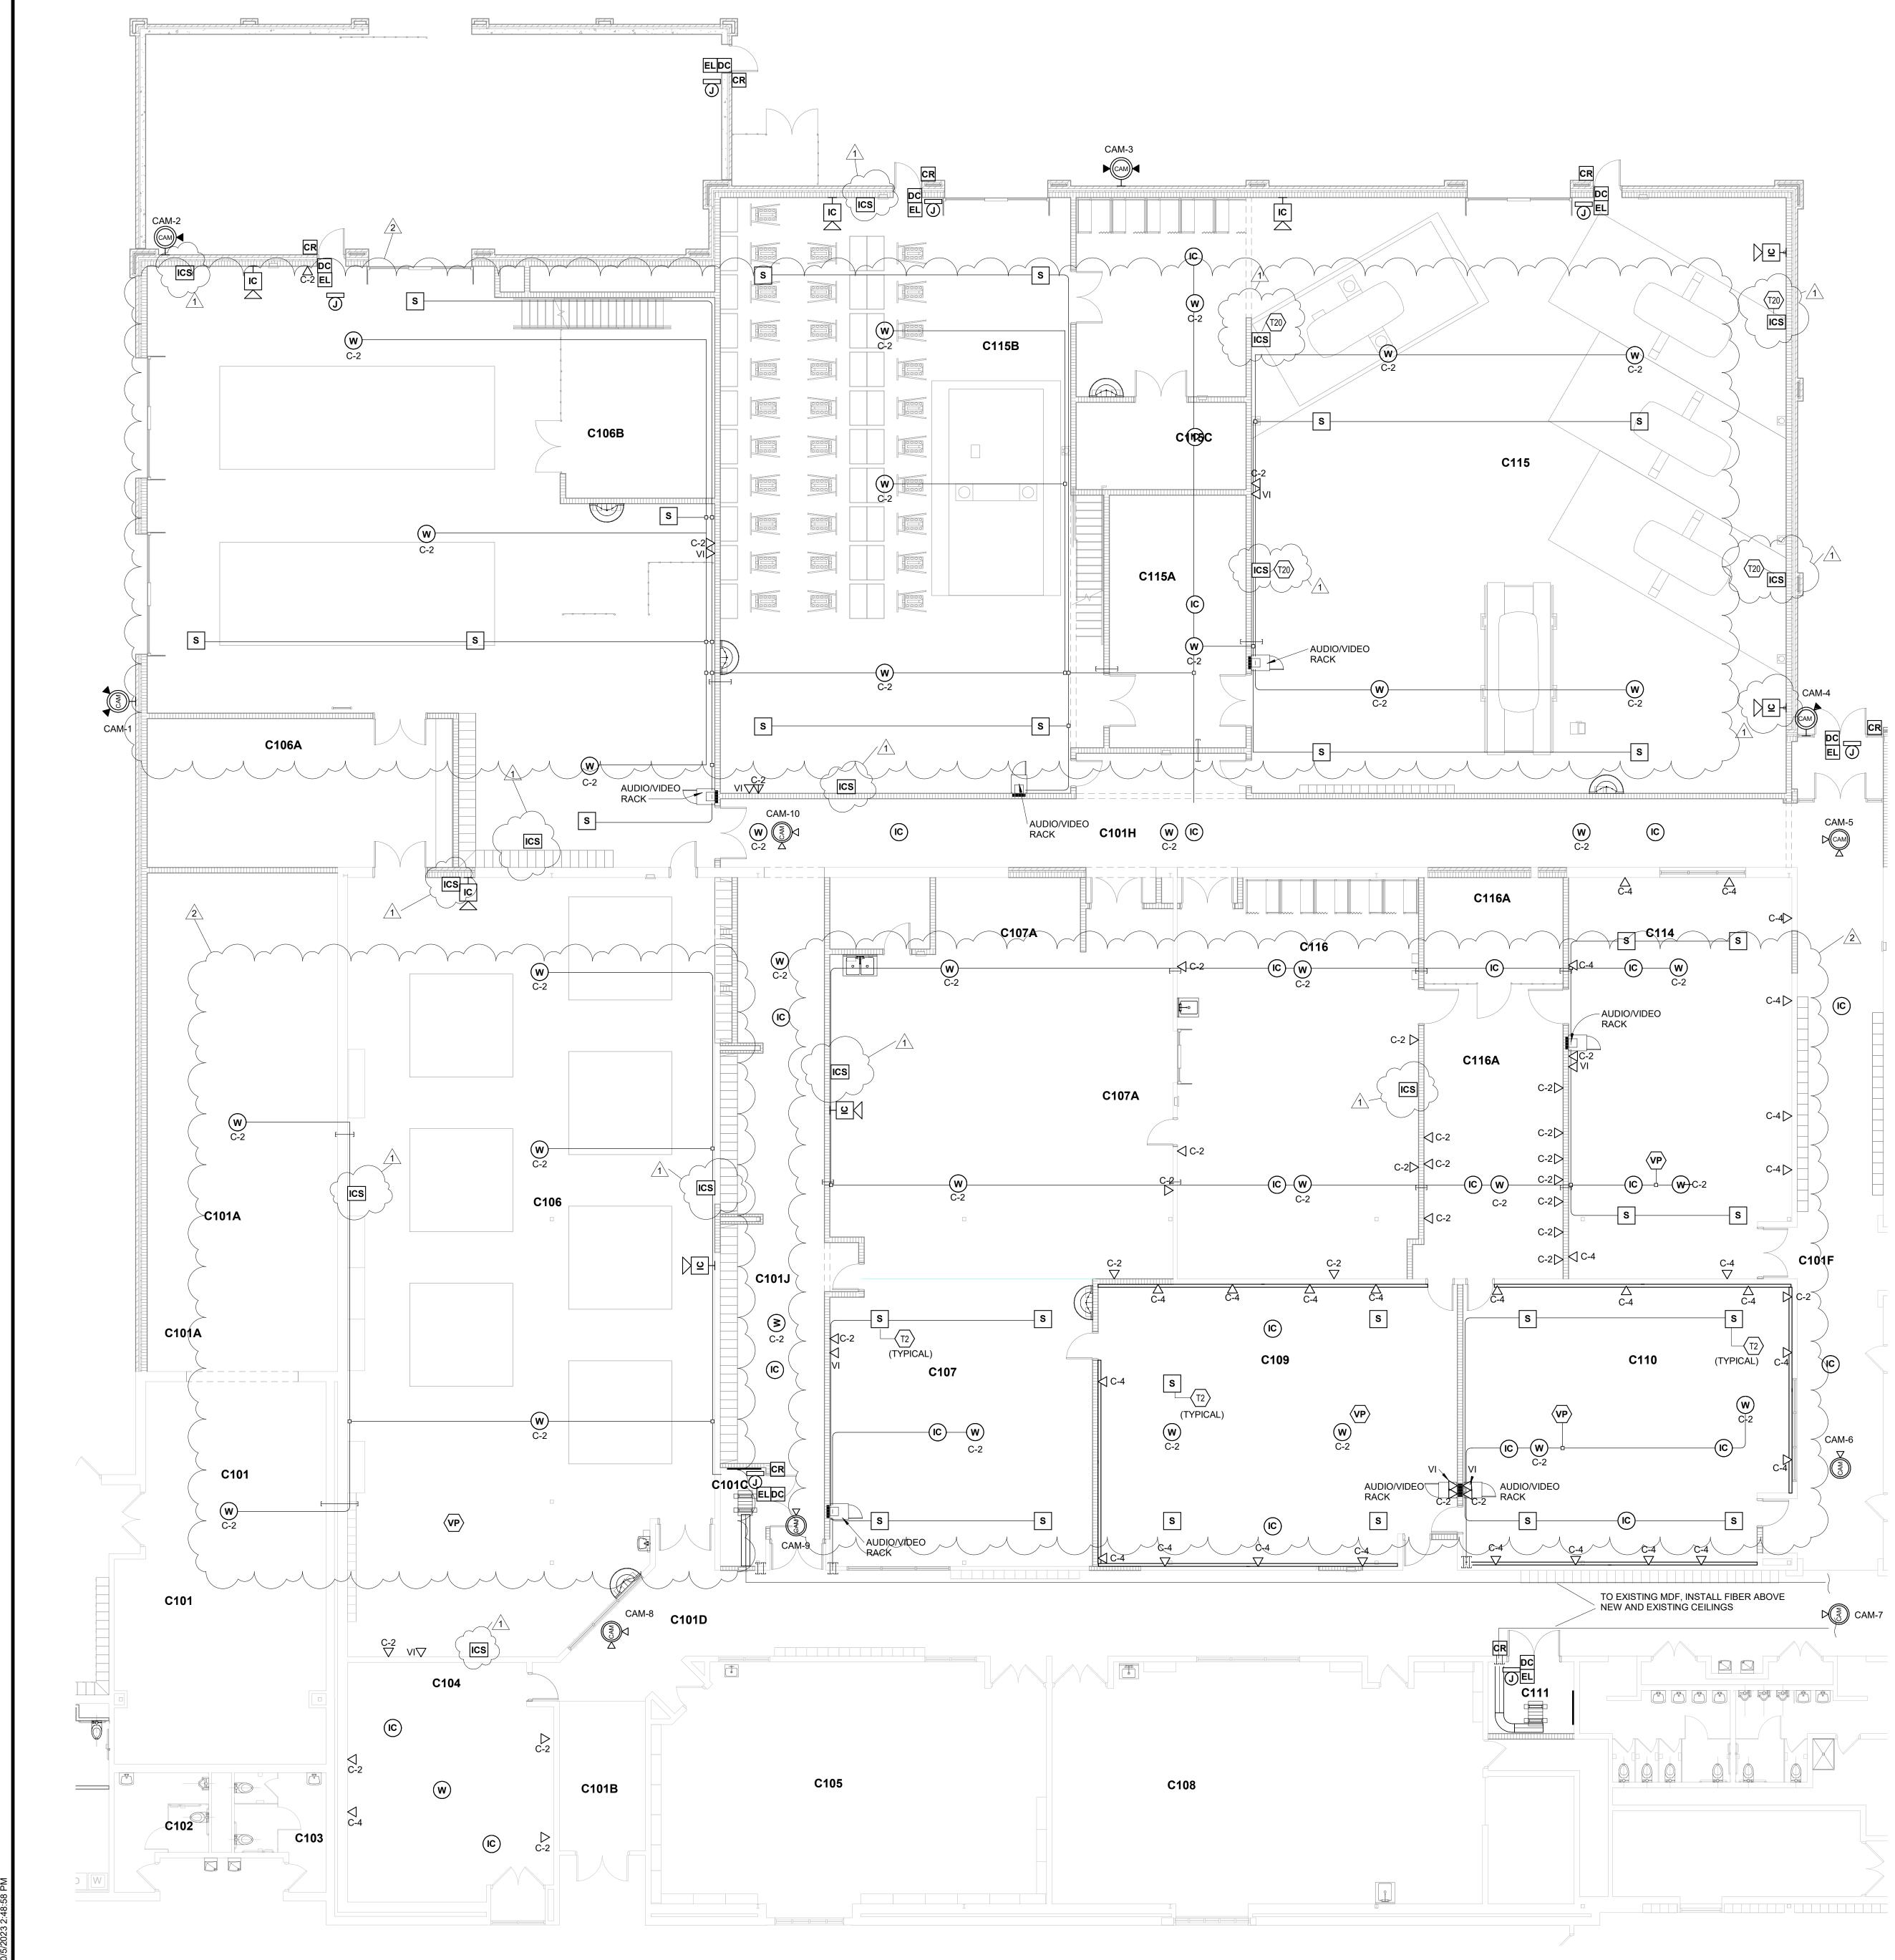

ers\jregedanz\Documents\2021_TECH_221165.01_jregedanz.rv

R	DOM LEGEND - FIRST FLOOR UN	IT C
ROOM NO.	ROOM NAME	AREA (SF)
C100	LOADING / RECEIVING	1202 SF
C100A	BREAK ROOM	640 SF
C100B	ELECTRICAL	825 SF
C100C	LAUNDRY	157 SF
C100D	TOILET	52 SF
C100E	TOILET	52 SF
C100F	SECURE STORAGE	91 SF
C100G	OFFICE	132 SF
C100H	KITCHEN	177 SF
C101 C101A	STORAGE STORAGE	1015 SF
C101A C101B	CORRIDOR	1287 SF 174 SF
C101C	MEDIA DATA	61 SF
C101D	YEARBOOK CLASSROOM / LAB	Not Placed
C101D		1860 SF
C101E	CORRIDOR	177 SF
C101F	CORRIDOR	976 SF
C101G	JOURNALISM CLASSROOM	Not Placed
C101G	VESTIBULE	70 SF
C101H	OFFICE	156 SF
C101H	CORRIDOR	992 SF
C101J	CORRIDOR	832 SF
C102	MENS TOILET	124 SF
C103	WOMENS TOILET	119 SF
C104	OFFICE	638 SF
C105	ELECTRONICS / PHYSICS	1251 SF
C106	CONSTRUCTION TRADES LAB	3699 SF
C106A	STORAGE	622 SF
C106B	ADVANCED CONSTRUCTION	3867 SF
	TRADES LAB	
C107	CLASSROOM	1015 SF
C107A	ADVANCED MFG. ARTISAN LAB	1695 SF
C107B	FINISHING ROOM	97 SF
C108	GRAPHIC COMMUNICATIONS	1385 SF
C109	CAD LAB	1347 SF
C110	CAD LAB	1217 SF
C111	MEDIA DATA	83 SF
C111A	STORAGE	101 SF 188 SF
C112 C113	GIRLS BOYS	163 SF
C114	CAD LAB	1188 SF
C115	ADVANCED AUTOMOTIVE	4790 SF
C115A	SERVICES LAB	468 SF
C115A C115B	AUTOMOTIVE SERVICES LAB	2828 SF
C115C	FINISHING ROOM	201 SF
C116	ADVANCED MFG. INNOVATION	1278 SF
C116A	ADVANCED MFG. CLEAN LAB	762 SF
C117	CERAMIC CLASSROOM / LAB	1387 SF
C117A	STORAGE	145 SF
C117B	STORAGE / MATERIALS	150 SF
C118	INDEPENDENT STUDY / COMMERICAL ART	1425 SF
C119	PHOTOGRAPHY	992 SF
C119A	DARKROOM	309 SF
C120	COMPUTER ART ROOM	442 SF
C122	TEACHERS WORKROOM	672 SF
C122A	DEPT. HEAD OFFICE	104 SF
C122A C123	CERAMICS CLASSROOM / LAB	1205 SF
C123A	STORAGE	145 SF
C123B	STORAGE / MATERIALS	150 SF
C124	CULINARY ARTS	1299 SF
C124A	CLOSET	39 SF
C124B	DRY GOODS	154 SF
C124C	WALK-IN	129 SF
C125	DRAWING CLASSROOM / LAB	1173 SF
C126	DRAWING CLASSROOM / LAB	1182 SF
C127	DRAWING CLASSROOM / LAB	1182 SF
C128	JEWELRY CLASSROOM / LAB	953 SF
C129	PHOTOGRAPHY	1023 SF
C129A	DARKROOM	232 SF
C131	CORRIDOR	1363 SF
C131A	STORAGE	166 SF
C131B	MEDIA DATA	60 SF
C131C	CORRIDOR	476 SF
C132	STUDIO	244 SF
C133	PODCAST	144 SF
C134	PASSAGE	36 SF
C135	STUDIO	63 SF
C136	STORAGE	105 SF
C136A	COMPUTER LAB	201 SF
C136A C137	STUDIO	91 SF
C138	STUDIO	93 SF
C138A	PASSAGE	127 SF
C138B	STUDIO	54 SF 52 SF
C138C	STUDIO	52 SF
C138D	STUDIO	52 SF
C138E	STUDIO	52 SF
C139	CLASSROOM	984 SF
C141	TV CLASSROOM	819 SF
C141A	STUDIO B	165 SF
C141B	OFFICE	91 SF
C142	STUDIO B	196 SF
C142A	ENGINEERING	114 SF
C143	STUDIO A	1026 SF
C144	TV CONTROL	251 SF
C144A	EQUIPMENT ROOM	120 SF
C145	COMPUTER CLASSROOM	851 SF
C145A	SECURE CLOSET	17 SF
C146	COMPUTER SERVER STORAGE	303 SF
C147	JOURNALISM CLASSROOM	1468 SF
C147A	OFFICE	136 SF
C148	ELECTRICAL ROOM	143 SF
C149	YEARBOOK CLASSROOM / LAB	1350 SF
C149A	PODCAST	147 SF
C150	TV-CPU LAB	714 SF
C151	MECHANICAL	5687 SF
C152	-	927 SF

### TECHNOLOGY PLAN NOTES

2	ROUTE CABLING IN CONDUIT PARALLEL OR PERPENDICULAR TO BAR JOISTS. ALL CONDUIT AND BOXES SHALL BE INSTALLED SO THAT EQUIPMENT IS NO LOWER THAN BOTTOM CHORD OF TRUSS.

T20 SEE DETAIL 2/T1.03 FOR INTERCOM PAGING STROBE CABLING DETAIL.

CAMERA SCHEDULE								
NUMBER	ROOM	MODEL	LENS	RESOLUTION	MOUNTING	NOTES		
CAM-1	EXTERIOR	XND-8082RV		6MP	WALL			
CAM-2	EXTERIOR	XND-8082RV		6MP	WALL			
CAM-3	EXTERIOR	XND-8082RV		6MP	WALL			
CAM-4	EXTERIOR	XND-8082RV		6MP	WALL			
CAM-5	C101F	XND-8082RV		6MP	CEILING			
CAM-6	C101F	QND-8080R		5MP	CEILING			
CAM-7	C101D	QND-8080R		5MP	CEILING			
CAM-8	C101D	PNM-900VD		2X5MP	CEILING			
CAM-9	C101J	QND-8080R	$\sum$	5MP	CEILING			
CAM-10	C101H	PNM-12082RVD	5	2X6MP	CEILING			
CAM-11	C124	AG-UX90 Pro 4K UHD			CEILING	PANASON		
CAM-12	RADIO HALL	PNM-900VD		2X5MP	CEILING			
CAM-13	RADIO HALL	QND-8080R		5MP	CEILING			
L		1		1	1			

